

## **ADDENDUM NO. THREE (3) ILM TERMINAL IMPROVEMENTS CONTRACT 3**

Date: July 30, 2019

RE: ILM Terminal Improvements Contract 3

From: The Wilson Group  
PO Box 5510  
Charlotte, NC 28299

To: All Plan Holders

This Addendum is hereby made a part of the contract documents and specifications of the above referenced project. All other requirements of the original specification shall remain in effect in their respective order. Acknowledge receipt of this Addendum by inserting its number and date in the Proposal form.

### ***NOTE***

#### ***1. THIS ADDENDUM DOES NOT CHANGE BID DATE AND TIME.***

### PROJECT MANUAL

1. **REPLACE** the following sections with the sections provided in this Addendum:
  - a. 102600 – WALL PROTECTION (AD-03).
  
2. In the SUPPLEMENTARY INSTRUCTIONS TO BIDDERS, **ADD** Article 4.3.1.3 as follows:
  - a. “4.3.1.3 Include the following forms with bid:
    - Prohibition of Segregated Facilities (Page B-1),
    - Trade Restriction Certification (Pages B-2 and B-3),
    - Certification of Offerer/Bidder Regarding Debarment (Page B-4),
    - Lobbying and Influencing Federal Employees (Page B-5),
    - Certificate of Buy American Compliance for Total Facility and Required Documentation - Schedule 1 (Pages B-6 and B-7),
    - Certificate of Buy American Compliance for Total Facility and Required Documentation - Schedule 2 (Pages B-8 and B-9),
    - Certificate of Buy American Compliance for Total Facility and Required Documentation - Schedule 2 Bid Alternate (Pages B-10 and B-11),
    - Form of Non-Collusion Affidavit (Page B-12),
    - Certification of Offerer/Bidder Regarding Tax Delinquency and Felony Convictions (Page B-13),
    - Listing of DBE - Schedule 1 (Page B-14),
    - Listing of DBE - Schedule 2 (Page B-15),
    - Listing of DBE - Schedule 2 - Bid Alternate 1 (Page B-16).”

3. In FAA GENERAL CONDITIONS, Sections 10 through 90, **REVISE** page footers at lower right-hand corner to read” “Terminal Improv. Contract 3.”
4. In FAA GENERAL CONDITIONS, Sections 70 and 80, **CHANGE** references to the FAA Advisory Circular entitles “Operational Safety on Airports During Construction” from “AC 150/5370-2F” to read: “AC 150/5370-2G.”
5. In FAA GENERAL CONDITIONS, Section 70, **CHANGE** telecommunications utility references from “CenturyLink” to “AT&T and/or other telecommunications land line owners/operators.”
6. In the Form of Agreement, **ADD** the following to Article II, Time and Liquidated Damages, sub-article 2.1, Contract Time:
  - a. “Schedule 1.....730 Calendar Days.”
  - b. “Total Project Completion Time of 1095 Calendar days is for Schedule 1 and Schedule 2 and applies with or without Schedule 2 Bid Alternate #1 (Bag Claim Expansion).”
7. In Section 020050 CIVIL SPECIAL PROVISIONS, Item PSP-15, **ADD** the Construction Safety and Phasing Plan (CSPP) document attached to this Addendum.
8. In Section 072119 – FOAMED-IN PLACE INSULATION, **ADD** the following:

#### 2.4 “OPEN-CELL SPRAY POLYURETHANE FOAM

- A. Open-Cell Spray Polyurethane Foam: Spray-applied polyurethane foam using water as a blowing agent. Minimum density of 0.4 lb/cu. ft. and minimum aged R-value at 1-inch thickness of 3.4 deg F x h x sq. ft./Btu at 75 deg F.
  1. Manufacturers: Subject to compliance with requirements, provide products by one of the following:
    - a. BASF Corporation
    - b. BaySystems North America, LLC
    - c. Demilec USA LLC
    - d. Gaco Western LLC
    - e. Henry Company
    - f. Icynene-Lapolla
    - g. Johns Manville
    - h. NCFI Polyurethanes; a division of Barnhardt Manufacturing Company
  2. Surface-Burning Characteristics: Comply with ASTM E84; testing by a qualified testing agency. Identify products with appropriate markings of applicable testing agency.
    - a. Flame-Spread Index: 25 or less.
    - b. Smoke-Developed Index: 450 or less.”
9. In Section 075323 – ETHYLENE-PROPYLENE-DIENE-MONOMER (EPDM) ROOFING, **MAKE** the following changes:
  - a. **CHANGE** paragraph 2.1 C.1 to read: “Wind Uplift Pressures: As calculated by manufacturer. Bid shall include roofing system complying with wind uplift pressures as required by code, with double the safety factor.”
  - b. **CHANGE** paragraph 2.1 C.2 to read: “Design Wind Speed: 155 mph.”

10. In Section 075419 – POLYVINYL-CHLORIDE (PVC) ROOFING, **MAKE** the following changes:
- a. **CHANGE** paragraph 2.1 C.1 to read: “Wind Uplift Pressures: As calculated by manufacturer. Bid shall include roofing system complying with wind uplift pressures as required by code, with double the safety factor.”
  - b. **CHANGE** paragraph 2.1 C.2 to read: “Design Wind Speed: 155 mph.”
11. In Section 125280 – LOBBY AND WAITING ROOM FURNITURE, **MAKE** the following changes:
- a. **ADD** item 6 to Article 1.1 A to read: “6. Waste/recycle receptacles.”
  - b. **ADD** Article 2.10 as follows:

“2.10 WASTE/RECYCLE RECEPTACLES

A. Freestanding Waste/Recycle Receptacles:

1. Basis of Design: Auweko; Temptation Floor Standing Bin FF2
2. Material: Galvanized steel inner container and stainless-steel outer cover.
3. Bins: Two.”

12. In Section 230500 – HEATING AND AIR CONDITIONING, **MAKE** the following changes:
- a. **REPLACE** Article 230506 AIR HANDLING UNITS, Paragraph Q, with the following: “Q. See drawings for air handling units to be furnished with filtration section for activated carbon filters. Filter material shall be carbon/ceramic extruded mixture baked on to the filter channels. Material shall be tested to and meet ASTM International Standard D664603 for removal of hydrogen sulfide. Carbon filtration media shall be in metallic frame designed to fit in a side access track. Filter tracks shall be factory installed by the air handling unit manufacturer. Performance shall provide removal capacities by weight of 40% for hydrogen sulfide, 15% for sulfur dioxide, 13% for xylene, and 9% for toluene. Activated carbon filters shall be Dynamic ACM or approved equal. Contractor shall not install filters until testing and balancing and area served is clean. Contractor shall leave one complete change of filters sealed in boxes at the building at completion for a future change by Owner.”
  - b. **REPLACE** Article 230510 TWO STAGE FILTRATION SECTION, with the following:

“230510 HIGH EFFICIENCY FILTRATION SECTION

- A. Unit shall have an active electrostatic field that polarizes a dielectric media. It shall not ionize airborne particles or produce ozone. Unit shall be tested and meet UL Standard 867 and CSA Standard C22.2 No. 187-M19986 for Electrostatic Air Cleaners. Unit shall be complete with control panel, power connections, and filter media. Integral control panel shall have controls and transformers as necessary to operate the filters. Power Connection to control panel shall be 120V single phase.
- B. Filter shall be high efficiency MERV 15-NC polarized media air cleaners. Overall unit pressure drop shall be 0.30” w.g. initially to 0.75” w.g. for final when change required. The air cleaning system shall be of all-aluminum construction. Contractor shall leave one complete change of media at the building at completion for a future change by Owner.
- C. Section shall not include track for pre-filter. To protect the polarized media and duct system as necessary during construction, the Contractor shall provide temporary roll filter media securely over all return air openings to the AHU.

Temporary filters shall be removed for testing and balancing, and permanently removed when area served is clean. Temporary roll filter media shall be 1" thick UL Class 2 88% minimum Average Arrestance based on ASHRAE 52.1 -1992 test method.

- D. Air cleaner modules shall be factory installed inside air handling unit cabinet with upstream and downstream access doors located on both sides. All air cleaner modules, mounting posts, and hardware for the air cleaning system shall be all aluminum construction. No tools shall be required for access or filter media removal. Provide factory supplied fixed filter blockoffs, as needed, to prevent air bypass around filters.
  - E. Units shall be Dynamic Air Quality Solutions Model V8 or approved equal."
- c. **REPLACE** Article 230513 CHILLERS, Paragraph C, with the following: "C. Provide complete parts and labor warranty for each entire chiller for ten (10) years. Warranty shall include refrigerant. Warranty period shall commence from date of startup."
  - d. In Section 230519 PUMPS, Paragraphs A and B, **ADD** the following:  
"1. Acceptable manufacturers include Patterson Pumps."

13. **INSERT** the following Specification sections included in this Addendum:

- a. 077200 – ROOF ACCESSORIES (AD-03)

#### DRAWINGS

1. **REPLACE** the following sheets with the sheets provided in this Addendum:

- a. G-001 SHEET INDEX VOLUME 1 (AD-03)
- b. G-002 SHEET INDEX VOLUME 2 (AD-03)
- c. G-004 GENERAL NOTES AND COMCHECK (AD-03). *Note: Added typical door detail.*
- d. G-005 PARTITION TYPES (AD-03). *Note: Added partition and stud framing notes.*
- e. LS-001 LIFE SAFETY – RAMP LEVEL (AD-03)
- f. LS-002 LIFE SAFETY – TICKET/BOARDING LEVEL (AD-03)
- g. LS-003 LIFE SAFETY – ADMIN LEVEL (AD-03)
- h. C-100 OVERALL PROJECT SAFETY AND ACCESS PLAN (AD-03)
- i. C-103 PROJECT SAFETY AND ACCESS PLAN – SCHEDULE 2 WITH BID ALTERNATE (AD-03)
- j. C-104 PROJECT SAFETY AND ACCESS PLAN – RESTORATION SCHEDULE 2 WITH BID ALTERNATE (AD-03)
- k. C-105 PROJECT SAFETY AND ACCESS PLAN – SCHEDULE 2 WITHOUT BID ALTERNATE (AD-03)
- l. C-106 PROJECT SAFETY AND ACCESS PLAN – RESTORATION SCHEDULE 2 WITHOUT BID ALTERNATE (AD-03)
- m. C-107 PROJECT SAFETY PLAN NOTES (AD-03)
- n. C-401 PROPOSED WATERLINE – SCHEDULE 1 (AD-03)
- o. S1-102 PARTIAL FOUNDATION PLAN SCHEDULE 1 ZONE 2 (AD-03)
- p. S1-124 PARTIAL BOARDING LEVEL REBAR PLAN SCHEDULE 1 ZONE 1 (AD-03)
- q. S1-125 PARTIAL BOARDING LEVEL REBAR PLAN SCHEDULE 1 ZONE 2 (AD-03)
- r. S1-126 PARTIAL BOARDING LEVEL REBAR PLAN SCHEDULE 1 ZONE 3 (AD-

- 03)
- s. S1-131 PARTIAL ROOF FRAMING PLAN SCHEDULE 1 ZONE 1 (AD-03)
  - t. S1-132 PARTIAL ROOF FRAMING PLAN SCHEDULE 1 ZONE 2 (AD-03)
  - u. S1-133 PARTIAL ROOF FRAMING PLAN SCHEDULE 1 ZONE 3 (AD-03)
  - v. S1-141 PARTIAL HIGH ROOF FRAMING PLAN SCHEDULE 1 ZONE 1 (AD-03)
  - w. S1-142 PARTIAL HIGH ROOF FRAMING PLAN SCHEDULE 1 ZONE 2 (AD-03)
  - x. S2-101 PARTIAL FOUNDATION PLAN SCHEDULE 2 ZONE 1 (AD-03)
  - y. S2-123 PARTIAL BOARDING LEVEL PLAN SCHEDULE 2 ZONE 3 (AD-03)
  - z. S2-124 PARTIAL BOARDING LEVEL REBAR PLAN SCHEDULE 2 ZONE 1 (AD-03)
  - aa. S2-125 PARTIAL BOARDING LEVEL REBAR PLAN SCHEDULE 2 ZONE 3 (AD-03)
  - bb. S2-131 PARTIAL ROOF FRAMING PLAN SCHEDULE 2 ZONE 1 (AD-03)
  - cc. S2-133 PARTIAL ROOF FRAMING PLAN SCHEDULE 2 ZONE 3 (AD-03)
  - dd. S2-141 PARTIAL HIGH ROOF PLAN SCHEDULE 2 ZONE 1 (AD-03)
  - ee. S-201 STRUCTURAL ELEVATIONS (AD-03)
  - ff. S-202 STRUCTURAL ELEVATIONS (AD-03)
  - gg. S-211 VERTICAL FRAME ELEVATIONS AND DETAILS (AD-03)
  - hh. S-251 STRUCTURAL WALL SECTIONS (AD-03)
  - ii. S-253 STRUCTURAL WALL SECTIONS (AD-03)
  - jj. S-302 FOUNDATION DETAILS (AD-03)
  - kk. S-321 ELEVATED CONCRETE DETAILS (AD-03)
  - ll. S-322 ELEVATED CONCRETE DETAILS (AD-03)
  - mm. S-341 CONCRETE FLOOR SECTIONS (AD-03)
  - nn. S-501 STEEL COLUMN SCHEDULES AND DETAILS (AD-03)
  - oo. S-511 STRUCTURAL FLOOR SECTIONS (AD-03)
  - pp. S-512 STRUCTURAL FLOOR SECTIONS (AD-03)
  - qq. S-521 STRUCTURAL ROOF SECTIONS (AD-03)
  - rr. S-522 STRUCTURAL ROOF SECTIONS (AD-03)
  - ss. S-523 STRUCTURAL ROOF SECTIONS (AD-03)
  - tt. S-524 STRUCTURAL ROOF SECTIONS (AD-03)
  - uu. A1-161 SCHEDULE 1 – BOARDING LEVEL RCP ZONE 1 (AD-03). *Note: Adjusted location of ceiling-hung TV monitors to coordinate w/ RCP layout.*
  - vv. A1-171 SCHEDULE 1 – CLERESTORY RCP (AD-03). *Note: Added detail for pendant light fixture in Clerestory.*
  - ww. A1-251 SCHEDULE 1 – INTERIOR ELEVATIONS (AD-03). *Note: Revised gate wall notes.*
  - xx. A1-252 SCHEDULE 1 – INTERIOR ELEVATIONS (AD-03). *Note: Revised gate wall notes.*
  - yy. A1-253 SCHEDULE 1 – INTERIOR ELEVATIONS (AD-03). *Note: Revised trim detail at signage band along Concourse.*
  - zz. A1-272 SCHEDULE 1 – ENLARGED INTERIOR ELEVATIONS (AD-03). *Note: Revised trim detail at signage band along Concourse.*
  - aaa. A1-401 SCHEDULE 1 – ENLARGED FLOOR PLANS (AD-03). *Note: Revised gate wall dimensions.*
  - bbb. A1-402 SCHEDULE 1 – ENLARGED FLOOR PLANS (AD-03). *Note: Adjusted wall dimensions.*
  - ccc. A1-411 SCHEDULE 1 – RESTROOM ELEVATIONS (AD-03). *Note: Adjusted wall location.*

- ddd. A2-121 SCHEDULE 2 – BOARDING LEVEL FLOOR PLAN ZONE 1 (AD-03). *Note: Added roof access hatch and ladder.*
- eee. A2-124 SCHEDULE 2 – TICKET LEVEL FLOOR PLAN ZONE 4 (AD-03). *Note: Adjusted wall bump-out along Column Line A.*
- fff. A2-125 SCHEDULE 2 – TICKET LEVEL FLOOR PLAN ZONE 5 (AD-03). *Note: Added fire extinguisher cabinet.*
- ggg. A2-141 SCHEDULE 2 – ROOF LEVEL PLAN ZONE 1 (AD-03). *Note: Added roof access hatch.*
- hhh. A2-143 SCHEDULE 2 – ROOF LEVEL PLAN ZONE 3 (AD-03). *Note: Added roof drainage area tags.*
- iii. A2-161 SCHEDULE 2 – BOARDING LEVEL RCP ZONE 1 (AD-03). *Note: Added roof access hatch.*
- jjj. A2-222 SCHEDULE 2 – BUILDING ELEVATIONS (AD-03). *Note: Revised louver layouts to coordinate with Mechanical Drawings.*
- kkk. A2-251 SCHEDULE 2 – INTERIOR ELEVATIONS (AD-03). *Note: Revised gate wall notes.*
- lll. A2-731 SCHEDULE 2 – BOARDING LEVEL FURNITURE PLAN (AD-03). *Note: Added waste receptacles and updated furniture quantities.*
- mmm. A-503 PLAN DETAILS (AD-03). *Note: Revised gate wall detail.*
- nnn. A-504 PLAN DETAILS (AD-03). *Note: Revised gate wall detail.*
- ooo. A-511 SECTION DETAILS (AD-03). *Note: Revised details to coordinate with Structural framing.*
- ppp. A-512 SECTION DETAILS (AD-03). *Note: Revised details to coordinate with Structural framing.*
- qqq. A-518 TYPICAL SOFFIT DETAILS (AD-03). *Note: Added roof hatch section detail.*
- rrr. A-521 SPECIALTY WALL PANEL SYSTEM DETAILS (AD-03). *Note: Revised details at specialty wall panels (WPS-1). Added elevation detail at Gate Wall Signage.*
- sss. A-651 FINISH SCHEDULES (AD-03). *Note: Deleted Rooms under Heading “Not Placed.” Added General Finish Notes.*
- ttt. A-654 WALL BASE, WALL, AND PANEL REVEAL DETAILS (AD-03). *Note: Revised WB-1 detail.*
- uuu. F2-121 SCHEDULE 2 – BOARDING LEVEL PLAN ZONE 1 FIRE PROTECTION (AD-03). *Note: Adjusted sprinklers and piping so as not to cross over roof hatch.*
- vvv. P1-112 SCHEDULE 1 – RAMP LEVEL PLAN ZONE 2 PLUMBING (AD-03). *Note: Adjusted roof drain leader invert elevations and coordinated with site plans.*
- www. M1-122 SCHEDULE 1 – BOARDING LEVEL MECHANICAL PLAN – ZONE 2 (AD-03). *Note: Shifted BCAHU #10 and associate ductwork plan south to avoid interference with post-mounted, ceiling-hung LED displays.*
- xxx. M1-215 SCHEDULE 1 – RAMP LEVEL MECHANICAL PIPING PLAN – ZONE 5 (AD-03). *Note: Revised keyed notes.*
- yyy. M1-222 SCHEDULE 1 – BOARDING LEVEL MECHANICAL PIPING PLAN – ZONE 2 (AD-03). *Note: Shifted piping to match new location of BCAHU #10.*
- zzz. M1-402 SCHEDULE 1 – ENLARGED COOLING TOWERS (AD-03). *Note: Revised keyed note #6 in multiple places.*
- aaaa. M2-114 SCHEDULE 2 – RAMP LEVEL MECHANICAL PLAN – ZONE 4 – ALTERNATE 1 (AD-03). *Note: Shifted Fan F-35 and F-36 plan left. Revised ductwork size from fans to sidewall exhaust air louver.*
- bbbb. M2-123 SCHEDULE 2 – TICKET LEVEL MECHANICAL PLAN – ZONE 3 (AD-03). *Note: Reduced length of outside air ductwork.*

- cccc. M-601 MECHANICAL SCHEDULES (AD-03). *Note: Added keyed notes #17 & #18 to Air Handling Unit Schedule.*
- dddd. E-001 ELECTRICAL NOTES, SHEET LIST, & APPENDIX B SUMMARY (AD-03). *Note: Added E2-146 to the sheet list.*
- eeee. E-002 ELECTRICAL LEGENDS (AD-03). *Note: Updated receptacle legend to include outlets for illuminated signs and illuminated gate signs. Updated data & telephone outlet legend to include exit lane data outlets.*
- ffff. E1-109 SCHEDULE 1 – ELECTRICAL SITE PLAN (AD-03). *Note: Added handhole for underground fiber optic route from Building Management A11 to Public Safety Building. Added two hot box heater outlets. Added location for panel 2IB and 2OB.*
- gggg. E1-111 SCHEDULE 1 – ELECTRICAL RAMP LEVEL POWER PLAN ZONE 1 (AD-03). *Note: Added power control panel integral to AHU #11 and AHU #7.*
- hhhh. E1-112 SCHEDULE 1 – ELECTRICAL RAMP LEVEL POWER PLAN ZONE 2 (AD-03). *Note: Added power control panel integral to AHU #8, AHU #9, and AHU #10.*
- iiii. E1-132 SCHEDULE 1 – ELECTRICAL RAMP LEVEL AUXILIARY SYSTEMS PLAN ZONE 2 (AD-03). *Note: Added tamper switch in Airline A1120.*
- jjjj. E1-141 SCHEDULE 1 – ELECTRICAL BOARDING LEVEL POWER PLAN ZONE 1 (AD-03). *Note: Relocated outlets for seat power from floor to adjacent wall. Added second outlet in three locations for TV monitors. Updated monitor outlet location. Added outlet for illuminated gate sign over gate door. Updated power to match water heater specs.*
- kkkk. E1-142 SCHEDULE 1 – ELECTRICAL BOARDING LEVEL POWER PLAN ZONE 2 (AD-03). *Note: Added second outlet in three locations for TV monitors. Removed monitor outlet from now un-used location. Added outlet for illuminated gate sign over three gate doors. Added illuminated mirror in Family Restroom A1224 and Mother's Room A1225.*
- llll. E1-143 SCHEDULE 1 – ELECTRICAL BOARDING LEVEL POWER PLAN ZONE 3 (AD-03). *Note: Updated mechanical equipment BCAHU #6 location.*
- mmmm. E1-151 SCHEDULE 1 – ELECTRICAL BOARDING LEVEL LIGHTING PLAN ZONE 1 (AD-03). *Note: Removed wall sconces in Clerestory. Added LED millwork lights and circuitry.*
- nnnn. E1-152 SCHEDULE 1 – ELECTRICAL BOARDING LEVEL LIGHTING PLAN ZONE 2 (AD-03). *Note: Removed wall sconces in Clerestory. Added LED millwork lights and circuitry. Added Cupola Luminaire Schedule. Added Cupola lighting.*
- oooo. E1-161 SCHEDULE 1 – ELECTRICAL BOARDING LEVEL AUXILIARY SYSTEMS PLAN ZONE 1 (AD-03). *Note: Added tamper switch and monitor module above ceiling. Added second data outlet for TV monitors in three locations. Moved TV data outlet to new TV location. Moved floor data box for gate pedestal to new location.*
- pppp. E1-162 SCHEDULE 1 – ELECTRICAL BOARDING LEVEL AUXILIARY SYSTEMS PLAN ZONE 2 (AD-03). *Note: Added six data outlets on wall in observation area. Added data outlet at each of the three gates for back display monitors. Added second data outlet in three locations for TV monitors. Removed TV outlet that is no longer needed. Move three floor outlet poke-throughs to new gate pedestal location. Added tamper switch in future room A1210.*
- qqqq. ED2-124 SCHEDULE 2 – ELECTRICAL BOARDING LEVEL DEMOLITION PLAN ZONE 4 (AD-03). *Note: Added note for reworking or relocating electrical circuitry and devices in slab cutout area.*
- rrrr. E2-111 SCHEDULE 2 – ELECTRICAL RAMP LEVEL POWER PLAN ZONE 1 (AD-03). *Note: Added power control panel integral to AHU #3.*

- ssss. E2-113 SCHEDULE 2 – ELECTRICAL RAMP LEVEL POWER PLAN ZONE 3 (AD-03). *Note: Added power control panel integral to AHU #4.*
- tttt. E2-131 SCHEDULE 2 – ELECTRICAL RAMP LEVEL AUXILIARY SYSTEMS PLAN ZONE 1 (AD-03). *Note: Added tamper switch in future room A2101.*
- uuuu. E2-140 SCHEDULE 2 – ELECTRICAL BOARDING/TICKET LEVEL OVERALL PLAN (AD-03). *Note: Added E2-146 Power to match line.*
- vvvv. E2-141 SCHEDULE 2 – ELECTRICAL BOARDING LEVEL POWER PLAN ZONE 1 (AD-03). *Note: Added outlet for illuminated gate sign. Added outlet for back display TV monitor on wall. Added outlet for floor mounted outlet for gate pedestal. Added second outlet for TV monitor in ceiling. Removed four outlets for power seats as they are indicated on E1-141. Change power to match water heater specs.*
- wwww. E2-142 SCHEDULE 2 – ELECTRICAL BOARDING LEVEL POWER PLAN ZONE 2 (AD-03). *Note: Removed floor outlets for power seats as they are indicated on E1-142.*
- xxxx. E2-143 SCHEDULE 2 – ELECTRICAL BOARDING LEVEL POWER PLAN ZONE 3 (AD-03). *Note: Added Folding Door #3 equipment requirements.*
- yyyy. E2-145 SCHEDULE 2 – ELECTRICAL BOARDING LEVEL POWER PLAN ZONE 5 (AD-03). *Note: Added power for LED mirrors. Added power and switch for illuminated sign.*
- zzzz. E2-146 SCHEDULE 2 – ELECTRICAL BOARDING LEVEL POWER PLAN ZONE 6 (AD-03). *Note: Added power and switch for illuminated sign.*
- aaaa. E2-151 SCHEDULE 2 – ELECTRICAL BOARDING LEVEL LIGHTING PLAN ZONE 1 (AD-03). *Note: Removed wall sconces in Clerestory. Added LED millwork lights and circuitry.*
- bbbb. E2-154 SCHEDULE 2 – ELECTRICAL BOARDING LEVEL LIGHTING PLAN ZONE 4 (AD-03). *Note: Added LED millwork lights and circuitry. Added dimmer schedule circuitry to light fixture types HB.*
- cccc. E2-155 SCHEDULE 2 – ELECTRICAL BOARDING LEVEL LIGHTING PLAN ZONE 5 (AD-03). *Note: Added lighting and controls to Pass SVC A2506 and Corridor A2274.*
- dddd. E2-161 SCHEDULE 2 – ELECTRICAL BOARDING LEVEL AUXILIARY SYSTEMS PLAN ZONE 1 (AD-03). *Note: Added second data outlet for TV monitors.*
- eeee. E2-165 SCHEDULE 2 – ELECTRICAL BOARDING LEVEL AUXILIARY SYSTEMS PLAN ZONE 5 (AD-03). *Note: Added six sets of card readers. Added exit lane data outlets.*
- ffff. E-601 ELECTRICAL LUMINAIRE, DIMMER, AND RELAY SCHEDULE (AD-03). *Note: Updated light fixture Type “HE” manufacturer/model. Updated light fixture Type “HL” model. Added light fixture Type “HM” to the Luminaire Schedule. Added note #2 to bottom of Luminaire Schedule. Added channels 49-60 to DMX Schedule.*
- gggg. E-602 ELECTRICAL EQUIPMENT CIRCUITRY SCHEDULES (AD-03). *Note: Added AHU Control Panel circuitry requirements to Air Handling Unit Equipment Schedule. Added Folding Door #3 to Miscellaneous Equipment Schedule.*
- hhhh. E-703 ELECTRICAL MISCELLANEOUS RISER DIAGRAMS (AD-03). *Note: Removed “Schedule 1” from sheet title. Added grounding system for new generators.*
- iiii. AG-6 (AD-03). *Note: Changed size of gate signage.*

2. **INSERT** the following sheets included in this Addendum:

- a. E2-146 SCHEDULE 2 – ELECTRICAL BOARDING LEVEL POWER PLAN ZONE 6 (AD-03). *Note: Added power and switch for illuminated sign.*
- b. SK C-405-1. *Note: Drawing Sketch (sheets 1 and 2) is being issued to supplement Drawing*



- C-405.
- c. S0-003 STATEMENT OF SPECIAL INSPECTIONS (AD-03)
  - d. S0-004 STATEMENT OF SPECIAL INSPECTIONS (AD-03)
  - e. S-513 STRUCTURAL FLOOR SECTIONS (AD-03)
3. On sheet C-405 PROPOSED REDUCED PRESSURE DETECTOR ASSEMBLY DETAILS (AD-02), **ADD** the following: “Add SUE information pertinent to the RPDA valve installations. See attached sketch SK C-405-1. Adjust location of proposed 12” cut-in valve, bag claim wing area, by a few feet to avoid existing pole light electrical line and unknown conduit (probably FO data line to parking lot exit booths).”
  4. On sheet A-010 RAMP LEVEL SCHEDULE DIAGRAM, **CHANGE** the designation of the existing area to the plan right of the proposed alternate inbound bag makeup from “Schedule 2 Alt. 1 New Covered” to “Schedule 2 Existing Renovated Area”.
  5. On sheet A-011 BOARDING/TICKET LEVEL SCHEDULE DIAGRAM, **CHANGE** the designation of the new area at the Bag Claim area from “Schedule 2 Alt. 1 New Covered” to “Schedule 2 Alt. 1 New Enclosed”.
  6. On sheets A1-120 SCHEDULE 1 – BOARDING/TICKET LEVEL OVERALL PLAN and A1-160 SCHEDULE 1 – BOARDING/TICKET LEVEL OVERALL RCP, **CHANGE** the existing bay at Gate 1 from “Existing Enclosed Area” to “Schedule 1 Existing Renovated Area”.
  7. On sheet A2-721 SCHEDULE 2 – BOARDING LEVEL FINISH FLOOR PLAN ZONE 1, **CHANGE** the designation of the flooring at the former restaurant area from “CPT-1” to “Existing”.
  8. On sheet A-292 CASEWORK, **ADD** the following note: “Provide anchorage to decking as required.”
  9. On sheet A-661 FINISH LEGEND, under “Wall Base” **ADD** the following: “WB-1. Notes: See Detail A/A-654.”
  10. On sheets A-514, A-653, and all sheets where “MDF BASE” is referenced, **CHANGE** all instances to read “WB-1.”
  11. On RCP sheets A1-161, A1-162, A1-163, A1-170, A1-171, A1-405, A1-406, A2-161, A2-163, A2-164, A2-165, A2-171, A2-419, A2-420, A2-421, A2-422, and all sheets where “STROBE” or “HORN STROBE” is referenced, **CHANGE** all instances to read “SPEAKER/STROBE, SEE FIRE PROTECTION FOR MORE INFORMATION, TYP.” On the RCP Legend, **CHANGE** “HORN STROBE” to read “SPEAKER/STROBE.”
  12. On Restroom Elevation sheets A1-411 through A1-414 and A2-411 through A2-417 **CHANGE** 9” high TRB-1 to 6” high and begin wall tile coursing from top of terrazzo base. *Note: changed base height to reduce number of cut wall tiles.*
  13. On all sheets where “RIGID BOARD INSULATION W/ WHITE FOIL FACING” is referenced, **CHANGE** all instances to read “OPEN-CELL SPRAY POLYURETHANE FOAM INSULATION WITH IGNITION BARRIER”. *Note: Changed insulation type at underside of Ticketing/Boarding floor. R-Values indicated on drawings do not change.*

QUESTIONS AND ANSWERS

1.     QUESTION:   Who is to build barrier walls for work on the claim area?  
ANSWER:        The barrier walls are to be provided by the General Contractor. It is the GCs responsibility to coordinate the scope with his sub-contractors.
  
2.     QUESTION:   Can we get CLX approved as a preferred controls contractor?  
ANSWER:        As described in Section 347739-1.6.C, the Bidder and the BHS Controls Subcontractor (CLX) shall meet the requirements for BHS Contractor Qualifications. The Bidder shall include information in their bid verifying that they meet these criteria.
  
3.     QUESTION:   Porters-I don't see there would be a need, but if there is, please verify who will be responsible for them.  
ANSWER:        Porter requirements described in Section 347739-1.2.K (while the conveyor equipment is out of service such as when all carriers are using a single claim device and associated inbound feed conveyor) and would be supplied by GC at unit price identified on bid form.
  
4.     QUESTION:   I cannot find the phasing implementation schedule. Can you please point me in that direction?  
ANSWER:        Requirements for the BHS Phased Implementation Summary are described in Section 347739-3.9.
  
5.     QUESTION:   There is mention of a PM office; please clarify.  
ANSWER:        Project Management Office requirements described in Section 347739-4.1.F. It is anticipated that this can be accommodated in the GC's job trailer / offices.
  
6.     QUESTION:   I saw no mention of stand-by in the specifications. Please verify there is no stand-by required.  
ANSWER:        Requirements for the one month Conditional Acceptance Operational Period / Stand-By support services are described in Section 347739-4.2.B.8.
  
7.     QUESTION:   I do not see the vehicular barriers on the Structural Drawings. Can you provide details and specifications?  
ANSWER:        See details for the vehicular barriers added to Drawing S-302 in Addendum 1.
  
8.     QUESTION:   Are there any upper level communications needed for BHS?  
ANSWER:        Per the specified requirements (347739-1.1.C and 1.2.G, as well as various other sections of the bid documents), the scope of work shall include the necessary connections of the proposed new Inbound BHS to a PC-type Computer Terminal Workstation, which is planned to be installed under Contract 2 and located at the Building Management Room, lower level of the Terminal Building. The requirements for this project include modifications and updates to the BHS PC-type Computer Terminal Workstation for the addition of the inbound BHS, as well as furnishing and installing all required PLC hardware/programming to satisfy the specified requirements (e.g., memory capacity, the necessary interlocks/interfaces, to incorporate each sequence of the phased-in scope of work.

9. QUESTION: On Drawing B-700, it shows removal of side guard. Is there anything else that needs to be done to that conveyor?  
ANSWER: No, the design intent of this requirement is to provide double-sided access to the unload belt. Ensure that all work is clean and free of any field cut edges and welds of burrs, and slag and grind smooth.
10. QUESTION: Who is responsible for the dog house and access panels on Drawing B-300?  
ANSWER: The doghouse and access panels are part of the General Contractor's scope of work (not the BHS), that shall be reviewed and coordinated with the BHS Contractor's conveyor equipment, necessary maintenance access, and associated right-of-way.
11. QUESTION: Is the bidder's qualification mentioned in Addendum #1 just for the GC?  
ANSWER: BHS Contractor qualifications are described in section 347739-1.6.C.
12. QUESTION: Can the BHS price schedule in the bid form be turned in after award of the project?  
ANSWER: Yes. Refer to Supplementary Instructions to Bidders section 6.3.
13. QUESTION: Please confirm the BHS scope in its entirety will fall under Schedule 2 Bid Alternate #1.  
ANSWER: Correct.
14. QUESTION: Please confirm that an AB CompactLogix PLC is approved for use on the BHS system?  
ANSWER: PLC requirements are specified under 347739-2.11.C, with an approved list of vendors under 347716-2.1.D.3.h.2.
15. QUESTION: On Drawing A1-112 it shows Jet Bridge tie downs in concrete and notes reference Structural Drawings. These tie downs are not shown on the Structural Drawings. Can you provide details?  
ANSWER: See detail for Jet Bridge tie downs added to Drawing S-302 in Addendum 1.
16. QUESTION: Can you provide a list of what DBE forms are to be submitted with bid?  
ANSWER: See attached DBE forms and clarifications to the Supplementary Instructions to Bidders included in this Addendum.

#### ATTACHMENTS

1. Bid Proposal attachments (B-1 through B-16)
2. Construction Safety and Phasing Plan (CSPP)
3. 077200 – ROOF ACCESSORIES (AD-03)
4. 102600 – WALL PROECTION (AD-03)
5. G-001 SHEET INDEX VOLUME 1 (AD-03)
6. G-002 SHEET INDEX VOLUME 2 (AD-03)
7. G-004 GENERAL NOTES AND COMCHECK (AD-03)

8. G-005 PARTITION TYPES (AD-03)
9. LS-001 LIFE SAFETY – RAMP LEVEL (AD-03)
10. LS-002 LIFE SAFETY – TICKET/BOARDING LEVEL (AD-03)
11. LS-003 LIFE SAFETY – ADMIN LEVEL (AD-03)
12. C-100 OVERALL PROJECT SAFETY AND ACCESS PLAN (AD-03)
13. C-103 PROJECT SAFETY AND ACCESS PLAN – SCHEDULE 2 WITH BID ALTERNATE (AD-03)
14. C-104 PROJECT SAFETY AND ACCESS PLAN – RESTORATION SCHEDULE 2 WITH BID ALTERNATE (AD-03)
15. C-105 PROJECT SAFETY AND ACCESS PLAN – SCHEDULE 2 WITHOUT BID ALTERNATE (AD-03)
16. C-106 PROJECT SAFETY AND ACCESS PLAN – RESTORATION SCHEDULE 2 WITHOUT BID ALTERNATE (AD-03)
17. C-107 PROJECT SAFETY PLAN NOTES (AD-03)
18. C-401 PROPOSED WATERLINE – SCHEDULE 1 (AD-03)
19. SK C-405-1 (AD-03)
20. S0-003 STATEMENT OF SPECIAL INSPECTIONS (AD-03)
21. S0-004 STATEMENT OF SPECIAL INSPECTIONS (AD-03)
22. S1-102 PARTIAL FOUNDATION PLAN SCHEDULE 1 ZONE 2 (AD-03)
23. S1-124 PARTIAL BOARDING LEVEL REBAR PLAN SCHEDULE 1 ZONE 1 (AD-03)
24. S1-125 PARTIAL BOARDING LEVEL REBAR PLAN SCHEDULE 1 ZONE 2 (AD-03)
25. S1-126 PARTIAL BOARDING LEVEL REBAR PLAN SCHEDULE 1 ZONE 3 (AD-03)
26. S1-131 PARTIAL ROOF FRAMING PLAN SCHEDULE 1 ZONE 1 (AD-03)
27. S1-132 PARTIAL ROOF FRAMING PLAN SCHEDULE 1 ZONE 2 (AD-03)
28. S1-133 PARTIAL ROOF FRAMING PLAN SCHEDULE 1 ZONE 3 (AD-03)
29. S1-141 PARTIAL HIGH ROOF FRAMING PLAN SCHEDULE 1 ZONE 1 (AD-03)
30. S1-142 PARTIAL HIGH ROOF FRAMING PLAN SCHEDULE 1 ZONE 2 (AD-03)
31. S2-101 PARTIAL FOUNDATION PLAN SCHEDULE 2 ZONE 1 (AD-03)
32. S2-123 PARTIAL BOARDING LEVEL PLAN SCHEDULE 2 ZONE 3 (AD-03)
33. S2-124 PARTIAL BOARDING LEVEL REBAR PLAN SCHEDULE 2 ZONE 1 (AD-03)
34. S2-125 PARTIAL BOARDING LEVEL REBAR PLAN SCHEDULE 2 ZONE 3 (AD-03)
35. S2-131 PARTIAL ROOF FRAMING PLAN SCHEDULE 2 ZONE 1 (AD-03)
36. S2-133 PARTIAL ROOF FRAMING PLAN SCHEDULE 2 ZONE 3 (AD-03)
37. S2-141 PARTIAL HIGH ROOF PLAN SCHEDULE 2 ZONE 1 (AD-03)
38. S-201 STRUCTURAL ELEVATIONS (AD-03)
39. S-202 STRUCTURAL ELEVATIONS (AD-03)
40. S-211 VERTICAL FRAME ELEVATIONS AND DETAILS (AD-03)
41. S-251 STRUCTURAL WALL SECTIONS (AD-03)
42. S-253 STRUCTURAL WALL SECTIONS (AD-03)
43. S-302 FOUNDATION DETAILS (AD-03)
44. S-321 ELEVATED CONCRETE DETAILS (AD-03)
45. S-322 ELEVATED CONCRETE DETAILS (AD-03)
46. S-341 CONCRETE FLOOR SECTIONS (AD-03)
47. S-501 STEEL COLUMN SCHEDULES AND DETAILS (AD-03)
48. S-511 STRUCTURAL FLOOR SECTIONS (AD-03)
49. S-512 STRUCTURAL FLOOR SECTIONS (AD-03)
50. S-513 STRUCTURAL FLOOR SECTIONS (AD-03)
51. S-521 STRUCTURAL ROOF SECTIONS (AD-03)
52. S-522 STRUCTURAL ROOF SECTIONS (AD-03)

53. S-523 STRUCTURAL ROOF SECTIONS (AD-03)
54. S-524 STRUCTURAL ROOF SECTIONS (AD-03)
55. A1-161 SCHEDULE 1 – BOARDING LEVEL RCP ZONE 1 (AD-03)
56. A1-171 SCHEDULE 1 – CLERESTORY RCP (AD-03)
57. A1-251 SCHEDULE 1 – INTERIOR ELEVATIONS (AD-03)
58. A1-252 SCHEDULE 1 – INTERIOR ELEVATIONS (AD-03)
59. A1-253 SCHEDULE 1 – INTERIOR ELEVATIONS (AD-03)
60. A1-272 SCHEDULE 1 – ENLARGED INTERIOR ELEVATIONS (AD-03)
61. A1-401 SCHEDULE 1 – ENLARGED FLOOR PLANS (AD-03)
62. A1-402 SCHEDULE 1 – ENLARGED FLOOR PLANS (AD-03)
63. A1-411 SCHEDULE 1 – RESTROOM ELEVATIONS (AD-03)
64. A2-121 SCHEDULE 2 – BOARDING LEVEL FLOOR PLAN ZONE 1 (AD-03)
65. A2-124 SCHEDULE 2 – TICKET LEVEL FLOOR PLAN ZONE 4 (AD-03)
66. A2-125 SCHEDULE 2 – TICKET LEVEL FLOOR PLAN ZONE 5 (AD-03)
67. A2-141 SCHEDULE 2 – ROOF LEVEL PLAN ZONE 1 (AD-03)
68. A2-143 SCHEDULE 2 – ROOF LEVEL PLAN ZONE 3 (AD-03)
69. A2-161 SCHEDULE 2 – BOARDING LEVEL RCP ZONE 1 (AD-03)
70. A2-222 SCHEDULE 2 – BUILDING ELEVATIONS (AD-03)
71. A2-251 SCHEDULE 2 – INTERIOR ELEVATIONS (AD-03)
72. A2-731 SCHEDULE 2 – BOARDING LEVEL FURNITURE PLAN (AD-03)
73. A-503 PLAN DETAILS (AD-03)
74. A-504 PLAN DETAILS (AD-03)
75. A-511 SECTION DETAILS (AD-03)
76. A-512 SECTION DETAILS (AD-03)
77. A-518 TYPICAL SOFFIT DETAILS (AD-03)
78. A-521 SPECIALTY WALL PANEL SYSTEM DETAILS (AD-03)
79. A-651 FINISH SCHEDULES (AD-03)
80. A-654 WALL BASE, WALL, AND PANEL REVEAL DETAILS (AD-03)
81. F2-121 SCHEDULE 2 – BOARDING LEVEL PLAN ZONE 1 FIRE PROTECTION (AD-03)
82. P1-112 SCHEDULE 1 – RAMP LEVEL PLAN ZONE 2 PLUMBING (AD-03)
83. M1-122 SCHEDULE 1 – BOARDING LEVEL MECHANICAL PLAN – ZONE 2 (AD-03)
84. M1-215 SCHEDULE 1 – RAMP LEVEL MECHANICAL PIPING PLAN – ZONE 5 (AD-03)
85. M1-222 SCHEDULE 1 – BOARDING LEVEL MECHANICAL PIPING PLAN – ZONE 2 (AD-03)
86. M1-402 SCHEDULE 1 – ENLARGED COOLING TOWERS (AD-03)
87. M2-114 SCHEDULE 2 – RAMP LEVEL MECHANICAL PLAN – ZONE 4 – ALTERNATE 1 (AD-03)
88. M2-123 SCHEDULE 2 – TICKET LEVEL MECHANICAL PLAN – ZONE 3 (AD-03)
89. M-601 MECHANICAL SCHEDULES (AD-03)
90. E-001 ELECTRICAL NOTES, SHEET LIST, & APPENDIX B SUMMARY (AD-03)
91. E-002 ELECTRICAL LEGENDS (AD-03)
92. E1-109 SCHEDULE 1 – ELECTRICAL SITE PLAN (AD-03)
93. E1-111 SCHEDULE 1 – ELECTRICAL RAMP LEVEL POWER PLAN ZONE 1 (AD-03)
94. E1-112 SCHEDULE 1 – ELECTRICAL RAMP LEVEL POWER PLAN ZONE 2 (AD-03)
95. E1-132 SCHEDULE 1 – ELECTRICAL RAMP LEVEL AUXILIARY SYSTEMS PLAN ZONE 2 (AD-03)
96. E1-141 SCHEDULE 1 – ELECTRICAL BOARDING LEVEL POWER PLAN ZONE 1 (AD-03)
97. E1-142 SCHEDULE 1 – ELECTRICAL BOARDING LEVEL POWER PLAN ZONE 2 (AD-03)
98. E1-143 SCHEDULE 1 – ELECTRICAL BOARDING LEVEL POWER PLAN ZONE 3 (AD-03)
99. E1-151 SCHEDULE 1 – ELECTRICAL BOARDING LEVEL LIGHTING PLAN ZONE 1 (AD-03)

100. E1-152 SCHEDULE 1 – ELECTRICAL BOARDING LEVEL LIGHTING PLAN ZONE 2 (AD-03)
101. E1-161 SCHEDULE 1 – ELECTRICAL BOARDING LEVEL AUXILIARY SYSTEMS PLAN ZONE 1 (AD-03)
102. E1-162 SCHEDULE 1 – ELECTRICAL BOARDING LEVEL AUXILIARY SYSTEMS PLAN ZONE 2 (AD-03)
103. ED2-124 SCHEDULE 2 – ELECTRICAL BOARDING LEVEL DEMOLITION PLAN ZONE 4 (AD-03)
104. E2-111 SCHEDULE 2 – ELECTRICAL RAMP LEVEL POWER PLAN ZONE 1 (AD-03)
105. E2-113 SCHEDULE 2 – ELECTRICAL RAMP LEVEL POWER PLAN ZONE 3 (AD-03)
106. E2-131 SCHEDULE 2 – ELECTRICAL RAMP LEVEL AUXILIARY SYSTEMS PLAN ZONE 1 (AD-03)
107. E2-140 SCHEDULE 2 – ELECTRICAL BOARDING/TICKET LEVEL OVERALL PLAN (AD-03)
108. E2-141 SCHEDULE 2 – ELECTRICAL BOARDING LEVEL POWER PLAN ZONE 1 (AD-03)
109. E2-142 SCHEDULE 2 – ELECTRICAL BOARDING LEVEL POWER PLAN ZONE 2 (AD-03)
110. E2-143 SCHEDULE 2 – ELECTRICAL BOARDING LEVEL POWER PLAN ZONE 3 (AD-03)
111. E2-145 SCHEDULE 2 – ELECTRICAL BOARDING LEVEL POWER PLAN ZONE 5 (AD-03)
112. E2-146 SCHEDULE 2 – ELECTRICAL BOARDING LEVEL POWER PLAN ZONE 6 (AD-03)
113. E2-151 SCHEDULE 2 – ELECTRICAL BOARDING LEVEL LIGHTING PLAN ZONE 1 (AD-03)
114. E2-154 SCHEDULE 2 – ELECTRICAL BOARDING LEVEL LIGHTING PLAN ZONE 4 (AD-03)
115. E2-155 SCHEDULE 2 – ELECTRICAL BOARDING LEVEL LIGHTING PLAN ZONE 5 (AD-03)
116. E2-161 SCHEDULE 2 – ELECTRICAL BOARDING LEVEL AUXILIARY SYSTEMS PLAN ZONE 1 (AD-03)
117. E2-165 SCHEDULE 2 – ELECTRICAL BOARDING LEVEL AUXILIARY SYSTEMS PLAN ZONE 5 (AD-03)
118. E-601 ELECTRICAL LUMINAIRE, DIMMER, AND RELAY SCHEDULE (AD-03)
119. E-602 ELECTRICAL EQUIPMENT CIRCUITRY SCHEDULES (AD-03)
120. E-703 ELECTRICAL MISCELLANEOUS RISER DIAGRAMS (AD-03)
121. AG-6 (AD-03)

END OF ADDENDUM NO. THREE (3)

## PROHIBITION OF SEGREGATED FACILITIES

- (a) The Contractor agrees that it does not and will not maintain or provide for its employees any segregated facilities at any of its establishments, and that it does not and will not permit its employees to perform their services at any location under its control where segregated facilities are maintained. The Contractor agrees that a breach of this clause is a violation of the Equal Opportunity clause in this contract.
  
- (b) "Segregated facilities," as used in this clause, means any waiting rooms, work areas, rest rooms and wash rooms, restaurants and other eating areas, time clocks, locker rooms and other storage or dressing areas, parking lots, drinking fountains, recreation or entertainment areas, transportation, and housing facilities provided for employees, that are segregated by explicit directive or are in fact segregated on the basis of race, color, religion, sex, or national origin because of written or oral policies or employee custom. The term does not include separate or single-user rest rooms or necessary dressing or sleeping areas provided to assure privacy between the sexes.
  
- (c) The Contractor shall include this clause in every subcontract and purchase order that is subject to the Equal Opportunity clause of this contract.

\_\_\_\_\_  
Signature of Contractor

\_\_\_\_\_  
Date

\_\_\_\_\_  
Title

NOTE: The penalty for making false statements in offers is prescribed in 18 U.S. C. 1001.

**(Reference: 41 CFR § 60)**

## **TRADE RESTRICTION CERTIFICATION**

By submission of an offer, the Offeror certifies that with respect to this solicitation and any resultant contract, the Offeror:

- a. is not owned or controlled by one or more citizens of a foreign country included in the list of countries that discriminate against U.S. firms as published by the Office of the United States Trade Representative (U.S.T.R.);
- b. has not knowingly entered into any contract or subcontract for this project with a person that is a citizen or national of a foreign country included on the list of countries that discriminate against U.S. firms as published by the U.S.T.R.; and
- c. has not entered into any subcontract for any product to be used on the Federal on the project that is produced in a foreign country included on the list of countries that discriminate against U.S. firms published by the U.S.T.R.

This certification concerns a matter within the jurisdiction of an agency of the United States of America and the making of a false, fictitious, or fraudulent certification may render the maker subject to prosecution under Title 18, United States Code, Section 1001.

The Offeror/Contractor must provide immediate written notice to the Owner if the Offeror/Contractor learns that its certification or that of a subcontractor was erroneous when submitted or has become erroneous by reason of changed circumstances. The Contractor must require subcontractors provide immediate written notice to the Contractor if at any time it learns that its certification was erroneous by reason of changed circumstances.

Unless the restrictions of this clause are waived by the Secretary of Transportation in accordance with 49 CFR 30.17, no contract shall be awarded to an Offeror or subcontractor:

- (1) who is owned or controlled by one or more citizens or nationals of a foreign country included on the list of countries that discriminate against U.S. firms published by the U.S.T.R. or
- (2) whose subcontractors are owned or controlled by one or more citizens or nationals of a foreign country on such U.S.T.R. list or
- (3) who incorporates in the public works project any product of a foreign country on such U.S.T.R. list;

Nothing contained in the foregoing shall be construed to require establishment of a system of records in order to render, in good faith, the certification required by this provision. The knowledge and information of a contractor is not required to exceed that which is normally possessed by a prudent person in the ordinary course of business dealings.

The Offeror agrees that, if awarded a contract resulting from this solicitation, it will



incorporate this provision for certification without modification in in all lower tier subcontracts. The contractor may rely on the certification of a prospective subcontractor that it is not a firm from a foreign country included on the list of countries that discriminate against U.S. firms as published by U.S.T.R, unless the Offeror has knowledge that the certification is erroneous.

This certification is a material representation of fact upon which reliance was placed when making an award. If it is later determined that the Contractor or subcontractor knowingly rendered an erroneous certification, the Federal Aviation Administration may direct through the Owner cancellation of the contract or subcontract for default at no cost to the Owner or the FAA.

This certification concerns a matter within the jurisdiction of an agency of the United States of America and the making of a false, fictitious, or fraudulent certification may render the maker subject to prosecution under Title 18, United States Code, Section 1001.

\_\_\_\_\_  
Signature of Contractor

\_\_\_\_\_  
Date

\_\_\_\_\_  
Title

**(Reference: 49 U.S.C. § 50104; 49 CFR part 30)**

**CERTIFICATION OF OFFERER/BIDDER REGARDING DEBARMENT**  
(Bidder or Offeror Certification)

By submitting a bid/proposal under this solicitation, the bidder or offeror certifies that neither it nor its principals are presently debarred or suspended by any Federal department or agency from participation in this transaction.

**CERTIFICATION OF LOWER TIER CONTRACTORS REGARDING DEBARMENT**  
(Lower Tier Contract Certification)

The successful bidder, by administering each lower tier subcontract that exceeds \$25,000 as a “covered transaction”, must verify each lower tier participant of a “covered transaction” under the project is not presently debarred or otherwise disqualified from participation in this federally assisted project. The successful bidder will accomplish this by:

1. Checking the System for Award Management at website: <http://www.sam.gov>
2. Collecting a certification statement similar to the Certificate Regarding Debarment and Suspension (Bidder or Offeror), above.
3. Inserting a clause or condition in the covered transaction with the lower tier contract

If the FAA later determines that a lower tier participant failed to disclose to a higher tier participant that it was excluded or disqualified at the time it entered the covered transaction, the FAA may pursue any available remedies, including suspension and debarment of the non-compliant participant.

\_\_\_\_\_  
Signature of Contractor

\_\_\_\_\_  
Date

\_\_\_\_\_  
Title

**(Reference: 2 CFR part 180 (Subpart C), 2 CFR part 1200, DOT Order 4200.5)**

## LOBBYING AND INFLUENCING FEDERAL EMPLOYEES

The bidder or offeror certifies by signing and submitting this bid or proposal, to the best of his or her knowledge and belief, that:

1. No Federal appropriated funds have been paid or will be paid, by or on behalf of the Bidder or Offeror, to any person for influencing or attempting to influence an officer or employee of an agency, a Member of Congress, an officer or employee of Congress, or an employee of a Member of Congress in connection with the awarding of any Federal contract, the making of any Federal grant, the making of any Federal loan, the entering into of any cooperative agreement, and the extension, continuation, renewal, amendment, or modification of any Federal contract, grant, loan, or cooperative agreement.
2. If any funds other than Federal appropriated funds have been paid or will be paid to any person for influencing or attempting to influence an officer or employee of any agency, a Member of Congress, an officer or employee of Congress, or an employee of a Member of Congress in connection with this Federal contract, grant, loan, or cooperative agreement, the undersigned shall complete and submit Standard Form-LLL, "Disclosure Form to Report Lobbying," in accordance with its instructions.
3. The undersigned shall require that the language of this certification be included in the award documents for all sub-awards at all tiers (including subcontracts, sub-grants, and contracts under grants, loans, and cooperative agreements) and that all sub-recipients shall certify and disclose accordingly.

This certification is a material representation of fact upon which reliance was placed when this transaction was made or entered into. Submission of this certification is a prerequisite for making or entering into this transaction imposed by section 1352, title 31, U.S. Code. Any person who fails to file the required certification shall be subject to a civil penalty of not less than \$10,000 and not more than \$100,000 for each such failure.

\_\_\_\_\_  
Signature of Contractor

\_\_\_\_\_  
Date

\_\_\_\_\_  
Title

**(Reference: 31 U.S.C. § 1352 – Byrd Anti-Lobbying Amendment; 2 CFR part 200, Appendix II(J); 49 CFR part 20, Appendix A)**

## **CERTIFICATE OF BUY AMERICAN COMPLIANCE FOR TOTAL FACILITY**

### **Certificate for Schedule 1**

As a matter of bid responsiveness, the bidder or offeror must complete, sign, date, and submit this certification statement with their proposal. The bidder or offeror must indicate how they intend to comply with 49 USC § 50101 by selecting one of the following certification statements. These statements are mutually exclusive. Bidder must select one or the other (i.e. not both) by inserting a checkmark (✓) or the letter "X".

- (A) Bidder or offeror hereby certifies that it will comply with 49 USC. 50101 by:
- a) Only installing steel and manufactured products produced in the United States; or
  - b) Installing manufactured products for which the FAA has issued a waiver as indicated by inclusion on the current FAA Nationwide Buy American Waivers Issued listing; or
  - c) Installing products listed as an Excepted Article, Material or Supply in Federal Acquisition Regulation Subpart 25.108.

By selecting this certification statement, the bidder or offeror agrees:

- 1. To provide to the Owner evidence that documents the source and origin of the steel and manufactured product.
  - 2. To faithfully comply with providing US domestic products.
  - 3. To refrain from seeking a waiver request after establishment of the contract, unless extenuating circumstances emerge that the FAA determines justified.
- (B) The bidder or offeror hereby certifies it cannot comply with the 100% Buy American Preferences of 49 USC § 50101(a) but may qualify for either a Type 3 or Type 4 waiver under 49 USC § 50101(b). By selecting this certification statement, the apparent bidder or offeror with the apparent low bid agrees:
- 1. To the submit to the Owner within 15 calendar days of the bid opening, a formal waiver request and required documentation that support the type of waiver being requested. That failure to submit the required documentation within the specified timeframe is cause for a non-responsive determination that may result in rejection of the proposal.
  - 2. To faithfully comply with providing US domestic products at or above the approved US domestic content percentage as approved by the FAA.
  - 3. To furnish US domestic product for any waiver request that the FAA rejects.
  - 4. To refrain from seeking a waiver request after establishment of the contract, unless extenuating circumstances emerge that the FAA determines justified.

## REQUIRED DOCUMENTATION

**Type 3 Waiver** - The cost of components and subcomponents produced in the United States is more than 60% of the cost of all components and subcomponents of the "facility". The required documentation for a type 3 waiver is:

- a) Listing of all manufactured products that are not comprised of 100% US domestic content (Excludes products listed on the FAA Nationwide Buy American Waivers Issued listing and products excluded by Federal Acquisition Regulation Subpart 25.108; products of unknown origin must be considered as non-domestic products in their entirety).
- b) Cost of non-domestic components and subcomponents, excluding labor costs associated with final assembly and installation at project location.
- c) Percentage of non-domestic component and subcomponent cost as compared to total "facility" component and subcomponent costs, excluding labor costs associated with final assembly and installation at project location.

**Type 4 Waiver** - Total cost of project using US domestic source product exceeds the total project cost using non-domestic product by 25%. The required documentation for a type 4 waiver is:

- a) Detailed cost information for total project using US domestic product
- b) Detailed cost information for total project using non-domestic product

**False Statements:** Per 49 USC § 47126, this certification concerns a matter within the jurisdiction of the Federal Aviation Administration and the making of a false, fictitious or fraudulent certification may render the maker subject to prosecution under Title 18, United States Code.

### Certificate for Schedule 1

\_\_\_\_\_

Date

\_\_\_\_\_

Signature

\_\_\_\_\_

Company Name

\_\_\_\_\_

Title

## **CERTIFICATE OF BUY AMERICAN COMPLIANCE FOR TOTAL FACILITY**

### **Certificate for Schedule 2**

As a matter of bid responsiveness, the bidder or offeror must complete, sign, date, and submit this certification statement with their proposal. The bidder or offeror must indicate how they intend to comply with 49 USC § 50101 by selecting one of the following certification statements. These statements are mutually exclusive. Bidder must select one or the other (i.e. not both) by inserting a checkmark (✓) or the letter "X".

- (A) Bidder or offeror hereby certifies that it will comply with 49 USC. 50101 by:
- d) Only installing steel and manufactured products produced in the United States; or
  - e) Installing manufactured products for which the FAA has issued a waiver as indicated by inclusion on the current FAA Nationwide Buy American Waivers Issued listing; or
  - f) Installing products listed as an Excepted Article, Material or Supply in Federal Acquisition Regulation Subpart 25.108.

By selecting this certification statement, the bidder or offeror agrees:

- 4. To provide to the Owner evidence that documents the source and origin of the steel and manufactured product.
  - 5. To faithfully comply with providing US domestic products.
  - 6. To refrain from seeking a waiver request after establishment of the contract, unless extenuating circumstances emerge that the FAA determines justified.
- (B) The bidder or offeror hereby certifies it cannot comply with the 100% Buy American Preferences of 49 USC § 50101(a) but may qualify for either a Type 3 or Type 4 waiver under 49 USC § 50101(b). By selecting this certification statement, the apparent bidder or offeror with the apparent low bid agrees:

- 5. To the submit to the Owner within 15 calendar days of the bid opening, a formal waiver request and required documentation that support the type of waiver being requested. That failure to submit the required documentation within the specified timeframe is cause for a non-responsive determination that may result in rejection of the proposal.
- 6. To faithfully comply with providing US domestic products at or above the approved US domestic content percentage as approved by the FAA.
- 7. To furnish US domestic product for any waiver request that the FAA rejects.
- 8. To refrain from seeking a waiver request after establishment of the contract, unless extenuating circumstances emerge that the FAA determines justified.

## REQUIRED DOCUMENTATION

**Type 3 Waiver** - The cost of components and subcomponents produced in the United States is more than 60% of the cost of all components and subcomponents of the "facility". The required documentation for a type 3 waiver is:

- d) Listing of all manufactured products that are not comprised of 100% US domestic content (Excludes products listed on the FAA Nationwide Buy American Waivers Issued listing and products excluded by Federal Acquisition Regulation Subpart 25.108; products of unknown origin must be considered as non-domestic products in their entirety).
- e) Cost of non-domestic components and subcomponents, excluding labor costs associated with final assembly and installation at project location.
- f) Percentage of non-domestic component and subcomponent cost as compared to total "facility" component and subcomponent costs, excluding labor costs associated with final assembly and installation at project location.

**Type 4 Waiver** - Total cost of project using US domestic source product exceeds the total project cost using non-domestic product by 25%. The required documentation for a type 4 waiver is:

- c) Detailed cost information for total project using US domestic product
- d) Detailed cost information for total project using non-domestic product

**False Statements:** Per 49 USC § 47126, this certification concerns a matter within the jurisdiction of the Federal Aviation Administration and the making of a false, fictitious or fraudulent certification may render the maker subject to prosecution under Title 18, United States Code.

### Certificate for Schedule 2

\_\_\_\_\_

Date

\_\_\_\_\_

Signature

\_\_\_\_\_

Company Name

\_\_\_\_\_

Title

## **CERTIFICATE OF BUY AMERICAN COMPLIANCE FOR TOTAL FACILITY**

### **Certificate for Schedule 2 Bid Alternate (Bag Claim Expansion)**

As a matter of bid responsiveness, the bidder or offeror must complete, sign, date, and submit this certification statement with their proposal. The bidder or offeror must indicate how they intend to comply with 49 USC § 50101 by selecting one of the following certification statements. These statements are mutually exclusive. Bidder must select one or the other (i.e. not both) by inserting a checkmark (✓) or the letter "X".

- (A) Bidder or offeror hereby certifies that it will comply with 49 USC. 50101 by:
- g) Only installing steel and manufactured products produced in the United States; or
  - h) Installing manufactured products for which the FAA has issued a waiver as indicated by inclusion on the current FAA Nationwide Buy American Waivers Issued listing; or
  - i) Installing products listed as an Excepted Article, Material or Supply in Federal Acquisition Regulation Subpart 25.108.

By selecting this certification statement, the bidder or offeror agrees:

- 7. To provide to the Owner evidence that documents the source and origin of the steel and manufactured product.
- 8. To faithfully comply with providing US domestic products.
- 9. To refrain from seeking a waiver request after establishment of the contract, unless extenuating circumstances emerge that the FAA determines justified.

- (B) The bidder or offeror hereby certifies it cannot comply with the 100% Buy American Preferences of 49 USC § 50101(a) but may qualify for either a Type 3 or Type 4 waiver under 49 USC § 50101(b). By selecting this certification statement, the apparent bidder or offeror with the apparent low bid agrees:

- 9. To the submit to the Owner within 15 calendar days of the bid opening, a formal waiver request and required documentation that support the type of waiver being requested. That failure to submit the required documentation within the specified timeframe is cause for a non-responsive determination that may result in rejection of the proposal.
- 10. To faithfully comply with providing US domestic products at or above the approved US domestic content percentage as approved by the FAA.
- 11. To furnish US domestic product for any waiver request that the FAA rejects.
- 12. To refrain from seeking a waiver request after establishment of the contract, unless extenuating circumstances emerge that the FAA determines justified.



## REQUIRED DOCUMENTATION

**Type 3 Waiver** - The cost of components and subcomponents produced in the United States is more than 60% of the cost of all components and subcomponents of the "facility". The required documentation for a type 3 waiver is:

- g) Listing of all manufactured products that are not comprised of 100% US domestic content (Excludes products listed on the FAA Nationwide Buy American Waivers Issued listing and products excluded by Federal Acquisition Regulation Subpart 25.108; products of unknown origin must be considered as non-domestic products in their entirety).
- h) Cost of non-domestic components and subcomponents, excluding labor costs associated with final assembly and installation at project location.
- i) Percentage of non-domestic component and subcomponent cost as compared to total "facility" component and subcomponent costs, excluding labor costs associated with final assembly and installation at project location.

**Type 4 Waiver** - Total cost of project using US domestic source product exceeds the total project cost using non-domestic product by 25%. The required documentation for a type 4 waiver is:

- e) Detailed cost information for total project using US domestic product
- f) Detailed cost information for total project using non-domestic product

**False Statements:** Per 49 USC § 47126, this certification concerns a matter within the jurisdiction of the Federal Aviation Administration and the making of a false, fictitious or fraudulent certification may render the maker subject to prosecution under Title 18, United States Code.

### **Certificate for Schedule 2 Bid Alternate (Bag Claim Expansion)**

\_\_\_\_\_

Date

\_\_\_\_\_

Signature

\_\_\_\_\_

Company Name

\_\_\_\_\_

Title

**FORM OF NON-COLLUSION AFFIDAVIT**  
(This Affidavit is Part of the Proposal)

STATE OF \_\_\_\_\_

COUNTY OF \_\_\_\_\_

\_\_\_\_\_ being first duly sworn, deposes and says that he/she is

\_\_\_\_\_ *(Sole owner, a partner, president, secretary, etc.)*

of \_\_\_\_\_ the party making the foregoing Proposal that such Proposal is genuine and not collusive or sham; that said Offeror has not colluded, conspired, connived, or agreed directly or indirectly, with any Offeror or person, to put in a sham Proposal, or that such other person shall refrain from submitting a proposal and has not in any manner, directly or indirectly sought by agreement or collusion, or communication or conference, with any person, to fix the proposal price of affiant or any other Offeror, or to fix any overhead, profit or cost element of said proposal price, or of that of any other Offeror or to secure any advantage against OWNER any person interested in the proposed Contract; and that all statements in said Proposal are true; and further, that such Offeror has not, directly or indirectly submitted this proposal, or the contents thereof, or divulged information or data relative to any association or to any member or agent thereof.

\_\_\_\_\_  
*Signature of Offeror*

Sworn to and subscribed before me this \_\_\_\_\_ day of \_\_\_\_\_, 2017.

*(Official Seal)*

\_\_\_\_\_  
*Official Signature of Notary*

\_\_\_\_\_, Notary Public  
*Notary's Printed or Typed Name*

My Commission expires \_\_\_\_\_, 20\_\_\_\_

**CERTIFICATION OF OFFERER/BIDDER REGARDING TAX DELINQUENCY AND  
FELONY CONVICTIONS**

The applicant must complete the following two certification statements. The applicant must indicate its current status as it relates to tax delinquency and felony conviction by inserting a checkmark (✓) in the space following the applicable response. The applicant agrees that, if awarded a contract resulting from this solicitation, it will incorporate this provision for certification in all lower tier subcontracts.

**Certifications**

- 1) The applicant represents that it is ( ) is not ( ) a corporation that has any unpaid Federal tax liability that has been assessed, for which all judicial and administrative remedies have been exhausted or have lapsed, and that is not being paid in a timely manner pursuant to an agreement with the authority responsible for collecting the tax liability.
- 2) The applicant represents that it is ( ) is not ( ) is not a corporation that was convicted of a criminal violation under any Federal law within the preceding 24 months.

\_\_\_\_\_

Date

\_\_\_\_\_

Signature

\_\_\_\_\_

Company Name

\_\_\_\_\_

Title

**(Reference: Sections 415 and 416 of Title IV, Division L of the Consolidated Appropriations Act, 2014 (Pub. L. 113-76), and similar provisions in subsequent appropriations acts.**

**DOT Order 4200.6 - Requirements for Procurement and Non-Procurement Regarding Tax Delinquency and Felony Convictions)**

**Listing of DBE Subcontractors & Suppliers  
To Be Submitted With The Bid**

**Wilmington International Airport  
Terminal Improvements – Contract 3**

**SCHEDULE 1**

The Bidder hereby proposes the following DBE participation in accordance with Appendix C:

DBE Subcontractor or Supplier Name and Address	NCDOT Reporting Number	Cert. Type (DBE)	Work To Be Performed	Subcontract Amount	Amount Applicable to Goal
Total Applicable DBE Participation					
Base Bid Amount					
DBE Participation Proposed (%)					
DBE Participation Goal (%)					<b>7.4%</b>

Bidder (Firm Name)	Signature	Date

Bidder must complete above “Listing of DBE Subcontractors” form and submit with bid. Letters of Intent must be submitted by the apparent low bidder for all DBE subcontractors no later than 2:00 pm of the fifth calendar day following opening of bids, unless the fifth day falls on Saturday, Sunday or an official state holiday. In that situation, it is due in the office of the Airport Director no later than 10:00 am on the next official state business day.

**Listing of DBE Subcontractors & Suppliers  
To Be Submitted With The Bid**

**Wilmington International Airport  
Terminal Improvements – Contract 3**

**SCHEDULE 2**

The Bidder hereby proposes the following DBE participation in accordance with Appendix C:

DBE Subcontractor or Supplier Name and Address	NCDOT Reporting Number	Cert. Type (DBE)	Work To Be Performed	Subcontract Amount	Amount Applicable to Goal
Total Applicable DBE Participation					
Base Bid Amount					
DBE Participation Proposed (%)					
DBE Participation Goal (%)					<b>7.4%</b>

Bidder (Firm Name)	Signature	Date

Bidder must complete above “Listing of DBE Subcontractors” form and submit with bid. Letters of Intent must be submitted by the apparent low bidder for all DBE subcontractors no later than 2:00 pm of the fifth calendar day following opening of bids, unless the fifth day falls on Saturday, Sunday or an official state holiday. In that situation, it is due in the office of the Airport Director no later than 10:00 am on the next official state business day.

**Listing of DBE Subcontractors & Suppliers  
To Be Submitted With The Bid**

**Wilmington International Airport  
Terminal Improvements – Contract 3**

**SCHEDULE 2  
BID ALT. 1**

The Bidder hereby proposes the following DBE participation in accordance with Appendix C:

DBE Subcontractor or Supplier Name and Address	NCDOT Reporting Number	Cert. Type (DBE)	Work To Be Performed	Subcontract Amount	Amount Applicable to Goal
Total Applicable DBE Participation					
Base Bid Amount					
DBE Participation Proposed (%)					
DBE Participation Goal (%)					<b>7.4%</b>

Bidder (Firm Name)	Signature	Date

Bidder must complete above “Listing of DBE Subcontractors” form and submit with bid. Letters of Intent must be submitted by the apparent low bidder for all DBE subcontractors no later than 2:00 pm of the fifth calendar day following opening of bids, unless the fifth day falls on Saturday, Sunday or an official state holiday. In that situation, it is due in the office of the Airport Director no later than 10:00 am on the next official state business day.

**CONSTRUCTION SAFETY AND  
PHASING PLAN (CSPP)**

**TERMINAL IMPROVEMENTS  
CONTRACT 3**

**WILMINGTON INTERNATIONAL AIRPORT (ILM)  
WILMINGTON, NORTH CAROLINA**

Prepared For:  
**NEW HANOVER COUNTY AIRPORT AUTHORITY**

In Cooperation With:  
**FEDERAL AVIATION ADMINISTRATION  
And  
NORTH CAROLINA DEPARTMENT OF  
TRANSPORTATION – DIVISION OF AVIATION**

*Engineer:*  
**TALBERT & BRIGHT, INC.**  
*Engineering and Planning Consultants*  
4810 Shelley Drive  
Wilmington, NC 28405  
(910) 763-5350

TBI No. 3301-1801  
May 2019  
NC Engineering License No. C-0713



Construction Safety and Phasing Plan (CSPP)  
Terminal Improvements – Contract 3  
Wilmington International Airport (ILM)

May 2019

## **Introduction**

This project includes work as part of a multi-phase project to renovate and expand the terminal at the Wilmington International Airport. Work under this contract includes airline gate concourse expansion; the new connector structure; the bag claim wing expansion; passenger screening checkpoint improvements, two new bag claim carousels; three new passenger boarding bridges; new mechanical and electrical rooms; replacement of aging electrical and mechanical equipment; expanded apron level office spaces; a secure side SARA; and secure side restaurant and retail concession spaces. Work will be phased to keep the terminal and operations continuous during construction. The inbound baggage expansion is a bid alternate to the project and will be constructed if funds are available.

The project will include installation of continuous concrete barriers with chain-link fence to fence out the construction and staging areas from the active Air Carrier Apron. This barrier/fence line will establish a non-SIDA work area within the Airport security perimeter. Baggage carts will be routed around the concrete barriers. Construction traffic will cross the baggage tug path through a gated entrance portal.

This Construction Safety and Phasing Plan has been prepared in accordance with FAA Advisory Circular (AC) 150/5370-2G. The Plan is organized into 18 chapters corresponding to article 204 of Chapter 2 of the AC.



## Chapter 1 - COORDINATION

- a. **Pre-Bid Conference.** A pre-bid conference for the project will be held prior to bid opening. The conference will be attended by the Owner, Engineer, Architect, and the construction community.
- b. **Pre-Construction Conference.** A pre-construction conference will be held following contract award and prior to Notice-to-Proceed. Invitees will include representatives of the Owner, Engineer, Architect, contractor, key sub-contractors and suppliers, airport tenants, TSA, airlines, and other interested parties.
- c. **Construction Progress Meetings.** Progress meetings with representatives of the Owner, Architect, and Engineer will be held throughout the project. Local TSA personnel, tenants and airlines will be invited. These meetings will generally be held weekly, but may be more frequent during critical phases of the work. The purpose of these meetings will be scheduling and coordination of the work activities and discussion of operational, safety and security matters. The contractor will be required to have a qualified representative at each of these meetings. Safety, security, schedule and local coordination (TSA/Airlines/Airport Management, etc.) will be standing agenda items.
- d. **Scope or Schedule Changes.** Any work scope changes contemplated will be discussed and coordinated at progress meetings and/or via written correspondence as appropriate prior to implementation. The contractor is required to prepare, submit and regularly update a detailed construction progress schedule for the project. The schedule, and any contemplated changes, will be discussed at the pre-construction conference and all progress meetings.
- e. **FAA ATO/SSC Coordination.** N/A. Construction of this project will not affect any aircraft movement areas.

## Chapter 2 - PHASING

**Phase Elements.** This project involves airline gate concourse expansion; the new connector structure; the bag claim wing expansion; passenger screening checkpoint improvements, two new bag claim carousels; three new passenger boarding bridges; new mechanical and electrical rooms; replacement of aging electrical and mechanical equipment; expanded apron level office spaces; a secure side SARA; and secure side restaurant and retail concession spaces.

The project will be phased into two schedules to keep the terminal and operations continuous during construction. Schedule I will generally consist of work to the south of the existing terminal concourse connector. Schedule II will generally consist of demolition of the existing terminal concourse connector and work to the north of the existing connector. The inbound baggage expansion is a bid alternate and will be awarded if funding allows. If awarded it will be constructed along with Schedule II.

Portions of the existing Air Carrier apron will be closed; however, the closures will not affect any aircraft movement areas.

- a. **Construction Safety Drawings.** The project Safety Plan and Notes are on Plan Sheets C-100 through C-108.

### **Chapter 3 - AREAS AND OPERATIONS AFFECTED BY THE CONSTRUCTION ACTIVITY**

- a. Identification of Affected Areas.** The project will not close any runways or taxiways. The Contractor's work area is on the Air Carrier Apron. Existing Gate parking by Aircraft will be modified as shown to remove conflicting Aircraft parking spaces. The access route along Taxiway F to the apron will be utilized by the Contractor prior to the installation of the barriers and when moving barriers and also for any access outside of the non-SIDA work area.
- b. Mitigation of Effects.** The work will not affect aircraft movement areas. Existing Gate parking by Aircraft will be modified as shown to remove conflicting Aircraft parking spaces. While the Contractor is utilizing Taxiway F, the Contractor is to wait out of the way while any aircraft are using the Taxiway or Apron. Aircraft have the right of way at all times.

The Contractor will be required to communicate, coordinate and cooperate with the Engineer, Architect, airport management, airport Public Safety Office, TSA, and Airlines regarding the work schedule.

## **Chapter 4 - PROTECTION OF NAVIGATION AIDS (NAVAIDS)**

The work areas of this project do not impact ILS critical areas or existing NAVAIDS.

## Chapter 5 - CONTRACTOR ACCESS

a. **Location of Stockpiled Construction Materials.** All materials and equipment shall be located in the contractor staging area as shown on the Plans or as coordinated with the airport. All loose items within the staging areas shall be secured at all times. Prior to leaving work each day, the Contractor shall return all construction materials and equipment to the staging areas.

b. **Vehicle and Pedestrian Operations**

1) **Construction site parking.** Personal cars shall be parked outside of secured airfield areas as shown on sheet C-100 and C-108.

2) **Construction equipment parking.** Prior to leaving work each day, Contractor shall return all equipment to the staging areas. For locations of staging areas, see Sheet C-100 of the Plans.

3) **Access roads.** Access roads to be used under this Contract shall be those shown on Sheet C-100 of the Plans. The Contractor shall confine his equipment where practical to existing roads on the Airport. If existing pavement or road surface is damaged by the Contractor's operations, it shall be repaired to its original condition. Metal track vehicles will not be permitted to operate on or across existing pavement without protective matting to prevent marring of the pavement surface.

The Contractor shall conduct his operations in such a manner as to assure that such operations do not impede access to any area of the airfield at any time for the airport's aircraft rescue and firefighting (ARFF) vehicles and other emergency vehicles. ARFF vehicle access shall be a standing agenda item for all progress meetings. The Contractor shall cooperate fully and immediately with any directives issued by airport department of public safety personnel relative to emergency access.

4) **Marking and lighting of vehicles.** All vehicles operating in the AOA shall be lighted or flagged in accordance with FAA Advisory Circular 150/5370-2G. Copies of the Advisory Circular will be made available upon request.

5) **Description of proper vehicle operations.** All construction vehicles must be cleared for access by the Airport Public Safety Office.

6) **Required escorts.** All Contractor personnel, including but not limited to, general laborers, subcontractors, drivers, and journeymen working within active air operations areas must at all times remain within visual and voice range of

contractor supervisory personnel badged by the airport. For the purposes of this project, the air operations areas (AOA) refer to all areas within the airport security fence.

- 7) **Training requirements for vehicle drivers.** All vehicle drivers within the air operations areas (AOA) must be properly badged and trained by airport safety officers
- 8) **Situational awareness.** Construction activities and construction-related material are not allowed within the RSA of an open runway or TOFA of an open taxiway at any time.

Movement of construction vehicles will be restricted to construction areas. Contractor shall provide badged escort drivers as appropriate. See Plans C-101, C-103, and C-105 for barrier locations. Contractor shall ensure that no personnel/equipment enter onto or cross active taxiways or runways at any time.

During construction, adjacent aprons, taxilanes, taxiways, and runways will be open to aircraft unless otherwise noted. Aircraft will have the right of way at all times. Contractor shall be aware of the aircraft movements and the jetblast and/or prop-wash associated with these aircraft. The Contractor shall secure loose items.

#### c. Two-Way Radio Communications

- 1) **General.** Radio communication is not required for this project. All Contractor work areas and access is outside the ATC movement area.
- 2) **Areas requiring two-way radio communication with the ATCT.** N/A. Contractor is prohibited from entering any area requiring ATCT communication. Crossing or entering active movement areas without prior approval from Air Traffic Control Tower will subject Contractor to being fined a minimum \$10,000 per incursion and loss of privilege of moving across active movement areas.

#### d. Airport Security

- 1) **Fencing and gates.** The Contractor shall coordinate ingress-egress requirements with the Airport Public Safety Office. All open gates to secured airport areas shall be monitored continuously by Contractor's personnel to control access to secured area or shall be closed and locked. Contractor personnel shall not allow any unauthorized personnel or animals to enter through the construction gate. If unauthorized personnel or animals enter through open gates, Contractor shall immediately notify the PSO. The Contractor shall be responsible for securing and locking all gates when not in use and at the end of

each day's operations. It is recommended that gate monitors log in and out all vehicles entering and leaving the project areas.

Prior to entering the secured AOA of the airport each day, the Contractor shall check in with the PSO. All gate monitors shall be properly badged. Close coordination for access to work areas and schedules between the Contractor, other Contractors working in the project area, and PSO will be required throughout the project. Contractor shall provide a list of all key holders for Contractor's locks seven days prior to construction.

- 2) Badging requirements.** All work on this project is located within or immediately adjacent to the Security Identification Display Area (SIDA). Therefore, all work shall be performed by workers bearing Airport issued SIDA Badges or under the direct control of a worker bearing an airport issues SIDA badge. A SIDA badged individual may escort unbadged individuals in accordance with the escort table on plan sheet C-105.

Badging for each individual requires completion of the application form, payment of a processing fee (\$90.00 per individual requesting a badge), presentation of two acceptable forms of identification, a background check by PSO staff, digital fingerprinting by PSO staff, and federal processing thereof and training. Allow two hours for application submittal and fingerprinting and four hours (on a subsequent date) for training and badge issuance. Allow two weeks for the badging process.

- 3)** Airports subject to 49 CFR Part 1542, Airport Security, must meet standards for access control, movement of ground vehicles, and identification of construction contractor and tenant personnel.

## Chapter 6 - WILDLIFE MANAGEMENT

- a. **Trash.** The Contractor shall clean all construction areas of litter, loose papers, debris, etc. on a daily basis, or as directed by the Engineer/Airport. Food scraps must be collected and disposed of off-site. Prior to the close of daily operations, Contractor shall inspect all active Air Operations Areas and construction areas for litter. All debris shall be cleaned up and properly disposed of prior to release of crews from each shift.
- b. **Standing Water.** If wet conditions are encountered during construction, Contractor is responsible for dewatering areas to remove standing water.
- c. **Poorly Maintained Fencing and Gates.** The airport perimeter fencing and gates shall be carefully protected by the Contractor. Any facilities damaged by the Contractor will be repaired immediately and restored to original condition at Contractor's cost.
- d. **Disruption of Existing Wildlife Habitat.** The airport actively manages wildlife. This project is not expected to disrupt any existing wildlife habitat.

Contractor shall notify Airport Management and Engineer immediately of any wildlife encounters and/or sightings.



## **Chapter 7 - FOREIGN OBJECT DEBRIS (FOD) MANAGEMENT**

1. Waste and loose materials, commonly referred to as FOD, are capable of causing damage to aircraft landing gears, propellers, and jet engines. During construction operations, Contractor is responsible for monitoring and controlling FOD to the satisfaction of Airport Management and the Engineer. Prior to the close of daily operations, Contractor shall inspect all construction areas with the Airport PSO to ensure that they are clear of FOD.
2. Prior to reopening any construction work area, Contractor must perform a walk through with Airport PSO to confirm that the areas are free of FOD or other hazards.

## **Chapter 8 - HAZARDOUS MATERIALS (HAZMAT) MANAGEMENT**

1. Contractor shall be responsible for oil management and for expeditious containment and clean-up of spills on the airport property resulting from fuel, lubricant or hydraulic fluid leaks from construction vehicles and/or equipment.
2. The Contractor shall furnish to the Engineer and airport maintenance and safety staff, MSDS sheets for all chemicals used during construction.
3. Transport and handling of other hazardous materials on an airport also requires special procedures. See AC 150/5320-15A, Management of Airport Industrial Waste.

## Chapter 9 - NOTIFICATION OF CONSTRUCTION ACTIVITIES

### a. Maintenance of List of Responsible Representatives/Points of Contact

- 1) The Contractor and all subcontractors shall designate a representative and alternate to contact on a 24-hour basis should problems arise. The point of contact provided must be able to coordinate an immediate response to correct any construction-related activity that may adversely affect the operational safety of the airport. The Contractor shall provide a listing of all contact persons of all supervisory personnel and all subcontractors.
- 2) The Contractor must also provide a safety/construction inspector familiar with airport safety to monitor construction activities.

### b. Notices to Airmen (NOTAM). The Owner will issue any necessary NOTAMS to reflect hazardous and operational conditions. The Contractor shall work with the Engineer and Owner to schedule NOTAM issuance and Airport Operations Area (AOA) closures and shall provide the Owner and Engineer with advance notice of the need to issue or close a NOTAM. It is important that NOTAMS be kept current and reflects the actual conditions with respect to construction situations. Active NOTAMS shall be reviewed periodically and revised to reflect the current conditions.

The Contractor shall not begin work unless and until 7 days prior notice has been given to the Airport Management. Crossing Runways or Taxiways is not allowed for this project.

### c. Emergency Notification Procedures. In an emergency situation the Contractor is to notify the Public Safety Office (PSO) immediately. The Public Safety Office can be reached by phone at (910) 341-4336.

### d. Coordination with ARFF Personnel. The ARFF building is located off Taxiway F. See Sheet C-100 for construction work areas. The Airport PSO will be invited to all project meetings for coordination of safety and security matters. Contractor will be required to maintain ARFF/PSO access at all times.

### e. Notification to the FAA

- 1) **Part 77.** If Contractor utilizes equipment exceeding 75' in height, Contractor is responsible for filing a "Notice of Proposed Construction or Alteration" (FAA Form 7460) with FAA prior to erecting equipment. Contractor should allow at least 45 days for FAA review. Detailed instructions can be found on the FAA website: <https://oeaaa.faa.gov/oeaaa/external/portal.jsp>.

**2) NAVAIDs.**

- a) Airport owned/FAA maintained. *Not applicable to this project*
- b) FAA owned. *Not applicable to this project*

## **Chapter 10 - INSPECTION REQUIREMENTS**

### **a. Daily Inspections**

1. A daily start-up and shut-down checklist will be jointly prepared by the Contractor and Airport Management and included in the Safety Plan Compliance Document (SPCD). The checklist will be followed throughout the project. This checklist shall include, but not be limited to, barricades, haul routes, securing of access gates, clean up, etc. The Contractor's site supervisor and labor crew shall not leave the work site until such time as the Public Safety Office has inspected the area and signed off on the daily checklist.
2. Frequent inspections will be made by the Public Safety Office during critical phases of the work to ensure that the Contractor is following the recommended airfield safety procedures.

### **b. Final Inspections**

1. Prior to opening the work area, Contractor must perform a walkthrough of the construction area with airport personnel and the Engineer to confirm that the areas are free of FOD or other hazards.
2. Contractor shall be required to remedy any deficiencies immediately, whether caused by negligence, oversight, or project scope change to the satisfaction of Airport Management and the Engineer.

## Chapter 11 - UNDERGROUND UTILITIES

1. Underground utilities are known to be located in the project areas. Existing underground utilities including but not limited to power and communications cables, waterline, sewer lines, telephone, and other utilities may be in the path of construction. Locations of utilities if shown on the Plans are approximate only. All utilities and facilities are not necessarily indicated on Plans. It shall be the Contractor's responsibility to locate and protect existing utilities and facilities from damage.
2. All existing facilities will be carefully protected by the Contractor. Any facilities damaged by the Contractor will be repaired immediately and restored to original condition at the Contractor's expense. All utilities and surfaces to remain shall be protected by suitable means. If damaged by the Contractor, these and any other above or below ground facilities shall be repaired at the Contractor's expense, to the satisfaction of the Engineer and the Owner.
3. Special attention is directed to the presence of power and communication cables within the project area. Other facilities in the area include but are not limited to storm drain pipes. The Contractor shall be solely responsible for location and protecting all existing above and underground facilities and shall bear all associated costs. The Contractor shall employ a private utility locator service or shall obtain and utilize cable locating equipment in order to field locate existing cable runs not to be disturbed/replaced by this project.
4. It is understood and agreed that the Owner does not guarantee the accuracy or the completeness of the location information relating to existing utility services, facilities or structures that may be shown on the plans or encountered in the work. Any inaccuracy or omission in such information shall not relieve the Contractor of his/her responsibility to protect such existing features from damage or unscheduled interruption of service.
5. Should the Contractor damage or interrupt the operations of a utility service or facility outside the project limits by accident or otherwise, he shall immediately notify the proper authority and the Engineer and shall take all reasonable measures to prevent further damage or interruption of service. The Contractor, in such events, shall cooperate with the utility service or facility owner and the Engineer continuously until such damage has been repaired and service restored to the satisfaction of the utility or facility owner.
6. The Contractor shall bear all costs of damage and restoration of service to any utility service or facility due to his/her operations whether or not due to negligence or

accident. The Contract Owner reserves the right to deduct such costs from any monies due or which may become due to the Contractor.

## **Chapter 12 - PENALTIES**

1. Crossing or entering active ATC movement areas without prior approval from Air Traffic Control Tower will subject Contractor to being fined a minimum \$10,000 per incursion and loss of privilege of moving across active movement areas. If the control tower is not manned, construction activities should be coordinated through the Public Safety Office.
2. For each incident where cables are located within five feet of the position defined on the ground and are cut or damaged and are not able to perform their required function resulting in the diversion of aircraft or the interruption of the normal flow of air traffic and aircraft operations on the Airport, the sum of \$10,000.00 per incident shall be deducted from any money due the Contractor. An additional \$10,000.00 per day will be deducted from any money due the Contractor until such time as cables are repaired and operational. If no money is due the Contractor, the Owner shall have the right to recover said sum or sums from the Contractor, from the surety, or from both. The amount of these deductions are to cover liquidated damages to the Sponsor incurred by additional work and other expenses and damages arising from the incident or incidents caused by the Contractor, and such deductions are not to be considered as penalties.
3. Security Violations on the airfield may result in an \$11,000 fine from the Transportation Security Administration (TSA), which may be passed on to the Contractor.



## **Chapter 13 - SPECIAL CONDITIONS**

1. The Contractor's supervisory personnel are expected to become knowledgeable regarding the airport's operational, safety and security requirements, actively participate in project meetings, establish effective communications with airport management and safety personnel. The Contractor shall cooperate with the airport in operational matters and during emergency response situations.

## Chapter 14 - RUNWAY AND TAXIWAY VISUAL AIDS

- a. **General.** Runway and taxiway visual aids include marking, lighting, and signs. The runway and taxiway visual aids ensure that areas where aircraft will be operating are clearly and visibly separated from construction areas, including but not limited to closed runways and taxiways. Throughout the duration of the construction project, no Runways or Taxiways will be closed.
- b. **Markings.** Aircraft gate marking changes will be required over the course of the project.
- c. **Lighting and Visual Aids** – Lights will be mounted to the continuous concrete barriers to delineate the Contractor's staging/work areas.

## **Chapter 15 - MARKING AND SIGNS FOR ACCESS ROUTES**

1. The contractor access routes are shown on Sheet C-100 of the Plans. Access points and on-airport access routes shall be discussed at the pre-construction conference and at progress meetings to address construction needs and airport operational, safety and security considerations. Access route physical conditions shall be regularly reviewed. The Contractor is expected to maintain the access routes in safe, clean, orderly condition at all times. Many of the routes are also used for maintenance access, security checks and emergency response; these routes must be passable at all times and in all weather conditions.
2. The Contractor shall provide signs and markings for access routes on the airport as needed to control and guide the construction traffic. All signs and markings shall be coordinated with the airport staff and reviewed for aircraft safety and security.

## Chapter 16 - HAZARD MARKINGS AND LIGHTING

- a. **Purpose.** Hazard marking and lighting prevents pilots from entering areas closed to aircraft and prevents construction personnel from entering areas open to aircraft. Hazard marking and lighting shall also identify open manholes and trenches, small areas under repair, stockpiled material, waste areas, and areas subject to jet blast.
- b. **Equipment**
- 1) **Continuous Concrete Barrier with Chain Link Fence.** Contractor shall install Continuous Concrete Barriers to fence out the construction area from the active Apron (SIDA area). See detail on Sheet C-108 of the Plans.
  - 2) **Lights must be red.** A steady burning red light shall be centered on each barrier and must meet the luminance requirements of the State Highway Department. Lights must be securely mounted on barricades and spaced at no more than 10 feet. Lights must be operated between sunset and sunrise and during periods of low visibility whenever the airport is open for operations.
  - 3) **Air Operations Area - General.** Continuous Concrete Barriers as noted above, where indicated in the Plans shall be provided.
  - 4) **Air Operations Area - Runway/Taxiway Intersections.** N/A.
  - 5) **Maintenance.** The Contractor must have a person on call 24 hours a day for emergency maintenance of barriers. The Contractor must file the contact person's information with Airport operations. Lighting should be checked for proper operation at least once per day, preferably at dusk.

## Chapter 17 - PROTECTION

This project will not affect any Runways, Taxiways. Dimensions, location and protection of the RSA, ROFA, OFZ, TSA and TOFA areas of open facilities will be discussed at the pre-construction conference and progress meetings.

- a. **Runway Safety Area (RSA).** No work is proposed in any Runway Safety Area for this project. A runway safety area is the defined surface surrounding the runway prepared or suitable for reducing the risk of damage to airplanes in the event of an undershoot, overshoot, or excursion from the runway (see AC 150/5300-13A). At ILM, the RSA is 500 feet wide, centered on the runway, and extending 1,000 feet beyond each runway end.
- b. **Runway Object Free Area (ROFA).** No work is proposed in any Runway Object Free Area for this project. At ILM, the ROFA is 800 feet wide, centered on the runway, and extends beyond each runway end.
- c. **Taxiway Safety Area (TSA).** No work is proposed in any Taxiway Safety Area for this project, except access through the non-movement portion of Taxiway F. A taxiway safety area is a defined surface alongside the taxiway prepared or suitable for reducing the risk of damage to an airplane unintentionally departing the taxiway (See AC 150/5300-13A). The taxiway safety area width for ILM is Group III – 118' wide.
- d. **Taxiway & Taxilane Object Free Area (TOFA)** No work is proposed in any Taxiway/Taxilane Object Free Area for this project, except access through the non-movement portion of Taxiway F. The taxiway object free area width for ILM is Group III – 186' wide.
- e. **Obstacle Free Zone (OFZ).** No work is proposed in the OFZ for this project.
- f. **Runway Approach/Departure Surfaces.** No work is proposed in the runway approaches for this project. Therefore, all personnel, materials, and/or equipment shall remain clear of the applicable threshold siting surfaces, as defined in Table 3-2, "Approach/departure standards table," of AC 150/5300-13A.

## Chapter 18 - OTHER LIMITATIONS ON CONSTRUCTION

### a. Prohibitions

- 1) **No use of tall equipment.** If Contractor utilizes equipment exceeding 75' in height, Contractor is responsible for filing a "Notice of proposed Construction" (7460) with FAA prior to erecting equipment. Contractor should allow at least 45 days for FAA review. Detailed instructions can be found on the FAA website: <https://oeaaa.faa.gov/oeaaa/external/portal.jsp>.
- 2) **No use of open flame welding or torches.**
- 3) **No use of electrical blasting caps** on or within 1,000 ft of the airport property.
- 4) **No use of flare pots** within the AOA.

## SECTION 077200 - ROOF ACCESSORIES

### PART 1 - GENERAL

#### 1.1 SUMMARY

A. Section Includes:

1. Roof hatches.

B. Related Sections:

1. Section 055000 "Metal Fabrications" for ladder to access roof hatches.

#### 1.2 ACTION SUBMITTALS

A. Product Data: For each type of roof accessory indicated. Include construction details, material descriptions, dimensions of individual components and profiles, and finishes.

B. Shop Drawings: For roof accessories. Include plans, elevations, keyed details, and attachments to other work. Indicate dimensions, loadings, and special conditions.

C. Delegated-Design Submittal: For roof hatches indicated to comply with performance requirements and design criteria, including analysis data signed and sealed by the qualified professional engineer responsible for their preparation.

1. Detail mounting, securing, and flashing of roof-mounted items to roof structure. Indicate coordinating requirements with roof membrane system.
2. Wind-Restraint Details: Detail fabrication and attachment of wind restraints. Show anchorage details and indicate quantity, diameter, and depth of penetration of anchors.

#### 1.3 INFORMATIONAL SUBMITTALS

A. Coordination Drawings: Roof plans, drawn to scale, and coordinating penetrations and roof-mounted items. Show the following:

1. Size and location of roof accessories specified in this Section.
2. Method of attaching roof accessories to roof or building structure.
3. Other roof-mounted items including mechanical and electrical equipment, ductwork, piping, and conduit.
4. Required clearances.

B. Warranty: Sample of special warranty.

#### 1.4 COORDINATION

A. Coordinate layout and installation of roof accessories with roofing membrane and base flashing and interfacing and adjoining construction to provide a leakproof, weathertight, secure, and noncorrosive installation.

B. Coordinate dimensions with rough-in information or Shop Drawings of piping to be supported.

## 1.5 WARRANTY

- A. Special Warranty on Painted Finishes: Manufacturer's standard form in which manufacturer agrees to repair finishes or replace roof accessories that show evidence of deterioration of factory-applied finishes within specified warranty period.
1. Finish: Deterioration includes, but is not limited to, the following:
    - a. Color fading more than 5 Hunter units when tested according to ASTM D 2244.
    - b. Chalking in excess of a No. 8 rating when tested according to ASTM D 4214.
    - c. Cracking, checking, peeling, or failure of paint to adhere to bare metal.
  2. Finish Warranty Period: 5 years from date of Substantial Completion.

## PART 2 - PRODUCTS

### 2.1 PERFORMANCE REQUIREMENTS

- A. General Performance: Roof accessories shall withstand exposure to weather and resist thermally induced movement without failure, rattling, leaking, or fastener disengagement due to defective manufacture, fabrication, installation, or other defects in construction.
- B. Delegated Design: Engage a qualified professional engineer, as defined in Section 014000 "Quality Requirements," to design roof hatches to comply with wind performance requirements, including comprehensive engineering analysis by a qualified professional engineer, using performance requirements and design criteria indicated.
- C. Wind-Restraint Performance: As indicated on Drawings.

### 2.2 ROOF HATCH

- A. Roof Hatches: Metal roof-hatch units with lid and insulated double-walled curb, welded or mechanically fastened and sealed corner joints, continuous lid-to-curb counterflashing and weathertight perimeter gasketing, integral metal cant, and integrally formed deck-mounting flange at perimeter bottom.
1. Manufacturers: Subject to compliance with requirements, provide products by one of the following:
    - a. Babcock-Davis
    - b. Bilco Company
    - c. J. L. Industries, Inc.
    - d. Milcor Inc.; Commercial Products Group of Hart & Cooley, Inc.
    - e. Nystrom
    - f. O'Keefes Inc.
    - g. Pate Company
    - h. SafePro
  - B. Type and Size: Single-leaf lid, 48 by 48 inches.
  - C. Loads: Minimum 40-lbf/sq. ft. external live load and 20-lbf/sq. ft. internal uplift load.
  - D. Hatch Material: Aluminum sheet, 0.090 inch thick.
    1. Finish: Powder coat.
    2. Color: As selected by Architect from manufacturer's full range.



- E. Construction:
1. Insulation: Glass-fiber board.
  2. Hatch Lid: Opaque, insulated, and double walled, with manufacturer's standard metal liner of same material and finish as outer metal lid.
  3. Curb Liner: Manufacturer's standard, of same material and finish as metal curb.
  4. Fabricate curbs to minimum height of 12 inches unless otherwise indicated.
  5. Sloping Roofs: Where slope or roof deck exceeds 1:48, fabricate curb with perimeter curb height that is tapered to accommodate roof slope so that top surfaces of perimeter curb are level. Equip hatch with water diverter or cricket on side that obstructs water flow.
- F. Hardware: Stainless-steel spring latch with turn handles, pintle-type hinge system, and padlock hasps inside and outside.
- G. Safety Railing System: Roof-hatch manufacturer's safety railing system including rails, clamps, fasteners, hinged gate safety barrier at railing opening, and accessories required for a complete installation; attached to roof hatch and complying with 29 CFR 1910.23 requirements and authorities having jurisdiction.
1. Height: 42 inches above finished roof deck.
  2. Posts and Rails: Galvanized-steel pipe, 1-1/4 inches in diameter or galvanized-steel tube, 1-5/8 inches in diameter. Fiberglass railings are not acceptable.
  3. Flat Bar: Galvanized steel, 2 inches high by 3/8 inch thick.
  4. Maximum Opening Size: System constructed to prevent passage of a sphere 21 inches in diameter.
  5. Post and Rail Tops and Ends: Weather resistant, closed or plugged with prefabricated end fittings.
  6. Provide weep holes or another means to drain entrapped water in hollow sections of handrail and railing members.
  7. Fabricate joints exposed to weather to be watertight.
  8. Fasteners: Manufacturer's standard, finished to match railing system.
  9. Finish: Manufacturer's standard.
    - a. Color: As selected by Architect from manufacturer's full range.
- H. Ladder-Assist Post: Roof-hatch manufacturer's standard device for attachment to roof-access ladder.
1. Operation: Post locks in place on full extension; release mechanism returns post to closed position.
  2. Height: 42 inches above finished roof deck.
  3. Material: Steel tube.
  4. Post: 1-5/8-inch diameter pipe.
  5. Finish: Manufacturer's standard baked enamel or powder coat.
    - a. Color: As selected by Architect from manufacturer's full range.

## 2.3 METAL MATERIALS

- A. Aluminum Sheet: ASTM B 209, manufacturer's standard alloy for finish required, with temper to suit forming operations and performance required.
1. Powder-Coat Finish: AAMA 2603 except with a minimum dry film thickness of 1.5 mils. Comply with coating manufacturer's written instructions for cleaning, conversion coating, and applying and baking finish.
  2. Concealed Finish: Pretreat with manufacturer's standard white or light-colored acrylic or polyester-backer finish consisting of prime coat and wash coat, with a minimum total dry film thickness of 0.5 mil.
- B. Aluminum Extrusions and Tubes: ASTM B 221, manufacturer's standard alloy and temper for type of use, finished to match assembly where used, otherwise mill finished.

- C. Steel Shapes: ASTM A 36/A 36M, hot-dip galvanized according to ASTM A 123/A 123M unless otherwise indicated.
- D. Galvanized-Steel Tube: ASTM A 500, round tube, hot-dip galvanized according to ASTM A 123/A 123M.
- E. Steel Pipe: ASTM A 53/A 53M, galvanized.

#### 2.4 MISCELLANEOUS MATERIALS

- A. General: Provide materials and types of fasteners, protective coatings, sealants, and other miscellaneous items required by manufacturer for a complete installation.
- B. Glass-Fiber Board Insulation: ASTM C 726, nominal density of 3 lb/cu. ft., thermal resistivity of 4.3 deg F x h x sq. ft./Btu x in. at 75 deg F, thickness as indicated.
- C. Wood Nailers: Softwood lumber, pressure treated with waterborne preservatives for aboveground use, acceptable to authorities having jurisdiction, containing no arsenic or chromium, and complying with AWPA C2; not less than 1-1/2 inches thick.
- D. Bituminous Coating: Cold-applied asphalt emulsion complying with ASTM D 1187.
- E. Underlayment:
  - 1. Self-Adhering, High Temperature Sheet: Refer to Section 076200 "Sheet Metal Flashing and Trim."
  - 2. Slip Sheet: Building paper, 3-lb/100 sq. ft. minimum, rosin sized.
- F. Fasteners: Roof accessory manufacturer's recommended fasteners suitable for application and metals being fastened. Match finish of exposed fasteners with finish of material being fastened. Provide nonremovable fastener heads to exterior exposed fasteners. Furnish the following unless otherwise indicated:
  - 1. Fasteners for Aluminum Sheet: Aluminum or Series 300 stainless steel.
- G. Gaskets: Manufacturer's standard tubular or fingered design of neoprene, EPDM, PVC, or silicone or a flat design of foam rubber, sponge neoprene, or cork.
- H. Elastomeric Sealant: ASTM C 920, elastomeric polymer sealant as recommended by roof accessory manufacturer for installation indicated; low modulus; of type, grade, class, and use classifications required to seal joints and remain watertight.
- I. Asphalt Roofing Cement: ASTM D 4586, asbestos free, of consistency required for application.

### PART 3 - EXECUTION

#### 3.1 EXAMINATION

- A. Examine substrates, areas, and conditions, with Installer present, to verify actual locations, dimensions, and other conditions affecting performance of the Work.
- B. Verify that substrate is sound, dry, smooth, clean, sloped for drainage, and securely anchored.
- C. Verify dimensions of roof openings for roof accessories.

- D. Proceed with installation only after unsatisfactory conditions have been corrected.

### 3.2 INSTALLATION

- A. General: Install roof accessories according to manufacturer's written instructions.
  - 1. Install roof accessories level, plumb, true to line and elevation, and without warping, jogs in alignment, excessive oil canning, buckling, or tool marks.
  - 2. Anchor roof accessories securely in place so they are capable of resisting indicated loads.
  - 3. Use fasteners, separators, sealants, and other miscellaneous items as required to complete installation of roof accessories and fit them to substrates.
  - 4. Install roof accessories to resist exposure to weather without failing, rattling, leaking, or loosening of fasteners and seals.
- B. Metal Protection: Protect metals against galvanic action by separating dissimilar metals from contact with each other or with corrosive substrates by painting contact surfaces with bituminous coating or by other permanent separation as recommended by manufacturer.
  - 1. Coat concealed side of uncoated aluminum roof accessories with bituminous coating where in contact with wood, ferrous metal, or cementitious construction.
  - 2. Underlayment: Where installing roof accessories directly on cementitious or wood substrates, install a course of underlayment and cover with a slip sheet.
  - 3. Bed flanges in thick coat of asphalt roofing cement where required by manufacturers of roof accessories for waterproof performance.
- C. Roof-Hatch Installation:
  - 1. Install roof hatch so top surface of hatch curb is level.
  - 2. Verify that roof hatch operates properly. Clean, lubricate, and adjust operating mechanism and hardware.
- D. Seal joints with elastomeric sealant as required by roof accessory manufacturer.

### 3.3 REPAIR AND CLEANING

- A. Galvanized Surfaces: Clean field welds, bolted connections, and abraded areas and repair galvanizing according to ASTM A 780.
- B. Touch up factory-primed surfaces with compatible primer ready for field painting according to Division 09 painting Sections.
- C. Clean exposed surfaces according to manufacturer's written instructions.
- D. Replace roof accessories that have been damaged or that cannot be successfully repaired by finish touchup or similar minor repair procedures.

END OF SECTION 077200

## SECTION 102600 - WALL PROTECTION

### PART 1 - GENERAL

#### 1.1 RELATED DOCUMENTS

- A. Drawings and general provisions of the Contract, including General and Supplementary Conditions and Division 01 Specification Sections, apply to this Section.

#### 1.2 SUMMARY

- A. Section Includes:
  - 1. Abuse-resistant wall coverings.

#### 1.3 ACTION SUBMITTALS

- A. Product Data: Include construction details, material descriptions, impact strength, dimensions of individual components and profiles, and finishes for each wall protection unit.
- B. Shop Drawings: For each wall protection unit showing locations and extent. Include sections, details, and attachments to other work.
- C. Samples: For each type of wall protection unit indicated.

#### 1.4 INFORMATIONAL SUBMITTALS

- A. Warranty: Sample of special warranty.

#### 1.5 DELIVERY, STORAGE, AND HANDLING

- A. Store wall protection units in original undamaged packages and containers inside well-ventilated area protected from weather, moisture, soiling, extreme temperatures, and humidity.
  - 1. Store in compliance with manufacturer's written recommendations.

#### 1.6 PROJECT CONDITIONS

- A. Environmental Limitations: Do not deliver or install wall protection units until building is enclosed and weatherproof, wet work is complete and dry, and HVAC system is operating and maintaining temperature at 70 deg F for not less than 72 hours before beginning installation and for the remainder of the construction period.
- B. Field Measurements: Verify actual locations of walls, columns, and other construction contiguous with wall protection units by field measurements before fabrication and indicate measurements on shop drawings.

#### 1.7 WARRANTY

- A. Special Warranty: Manufacturer's standard form in which manufacturer agrees to repair or replace components of impact-resistant wall protection units that fail in materials or workmanship within

specified warranty period.

1. Failures include, but are not limited to, the following:
  - a. Structural failures.
  - b. Deterioration of plastic and other materials beyond normal use.
2. Warranty Period: Five years from date of Substantial Completion.

## PART 2 - PRODUCTS

### 2.1 MANUFACTURERS

- A. Basis of Design: Subject to compliance with requirements, provide basis of design or one of the following comparable products:
  1. Panolam Industries International, Inc.; FRL (Fiber Reinforced Laminate) Wall Protection Panels (Basis of Design).
  2. Wilsonart; High Pressure Laminate Panels.
  3. Formica; High Pressure Laminate Panels.

### 2.2 ABUSE-RESISTANT WALL COVERINGS (WPS-1)

- A. Laminated, Impact-Resistant Wall Panels: Rigid wall panels consisting of semirigid, plastic sheet wall covering material factory laminated to high-impact-resistant core, with moisture-resistant vapor barrier factory laminated to reverse side of panel for stability.
  1. Composition: 0.075-inch thick sheet laminated to 3/4-inch thick medium-density fiberboard core.
  2. Sheet Size: As indicated on Drawings.
  3. Height: As indicated on Drawings.
  4. Sheet Edge: Square, with rubber "T" molding insert by manufacturer at all exposed edges typ.
  5. Trim and Joint Moldings: Extruded rigid plastic that matches wall-covering color.
  6. Color and Texture: As selected by Architect from manufacturer's full range of Nevamar colors and patterns (Basis of Design).
  7. Mounting: Demountable, on aluminum "Z" clips. Monarch MF 250 Z-clips with 1/4-inch lift off (Basis of Design) or approved equal. Provide mounting hardware in locations, quantities, and spacing as required by panel manufacturer's instructions.
  8. Surface Burning Characteristics: US Standard UL-723/ASTM E 84 Class A.
  9. Chemical resistant compliant with SEFA 8 requirements.
  10. Wear Resistance (Cycles): NEMA 3.13: 3500 typical.
  11. Flexural Strength: ASTM 0790: 20,148 psi typical.
  12. Molding Profiles: Outside corners flat, outside corners round, division bars, inside corners, standard end caps. See Drawings for trim profiles.
  13. Adhesive: Construction adhesive #4319 by Franklin Adhesives and Polymers or equal approved by panel manufacturer.
  14. Joint Caulking: Color Sil by Color Rite or equal approved by panel manufacturer. 100 percent silicone-based color caulking.

### 2.3 FABRICATION

- A. Fabricate wall protection units to comply with requirements indicated for design, dimensions, and member sizes, including thicknesses of components.
- B. Assemble components in factory to greatest extent possible to minimize field assembly. Disassemble only as necessary for shipping and handling.

- C. Fabricate components with tight seams and joints with exposed edges rolled. Provide surfaces free of wrinkles, chips, dents, uneven coloration, and other imperfections. Fabricate members and fittings to produce flush, smooth, and rigid hairline joints.

### PART 3 - EXECUTION

#### 3.1 EXAMINATION

- A. Examine substrates and wall areas, with Installer present, for compliance with requirements for installation tolerances, fire rating, and other conditions affecting performance of work.
- B. Examine walls to which wall protection will be attached for blocking, grounds, and other solid backing that have been installed in the locations required for secure attachment.
  - 1. For wall protection units attached with adhesive, verify compatibility with and suitability of substrates, including compatibility with existing finishes or primers.
- C. Proceed with installation only after unsatisfactory conditions have been corrected.

#### 3.2 PREPARATION

- A. Complete finishing operations, including painting, before installing wall protection system components.
- B. Before installation, clean substrate to remove dust, debris, and loose particles.

#### 3.3 INSTALLATION

- A. General: Install wall protection units level, plumb, and true to line without distortions. Do not use materials with chips, cracks, voids, stains, or other defects that might be visible in the finished Work.
  - 1. Install wall protection units in locations and at mounting heights indicated on Drawings.

#### 3.4 CLEANING

- A. Immediately after completion of installation, clean wall protection units using manufacturer's recommended cleaning agent.
- B. Remove excess adhesive using methods and materials recommended in writing by manufacturer.

END OF SECTION 102600

SHEET INDEX - VOLUME 1

GENERAL

Table with columns: REV., CURRENT REVISION DATE, ORIGINAL ISSUANCE DATE, SHEET NO., SHEET NAME, CURRENT REVISION DESCRIPTION. Lists general project documents.

CIVIL

Table with columns: REV., CURRENT REVISION DATE, ORIGINAL ISSUANCE DATE, SHEET NO., SHEET NAME, CURRENT REVISION DESCRIPTION. Lists civil engineering documents.

STRUCTURAL

Table with columns: REV., CURRENT REVISION DATE, ORIGINAL ISSUANCE DATE, SHEET NO., SHEET NAME, CURRENT REVISION DESCRIPTION. Lists structural engineering documents.

ARCHITECTURAL

Table with columns: REV., CURRENT REVISION DATE, ORIGINAL ISSUANCE DATE, SHEET NO., SHEET NAME, CURRENT REVISION DESCRIPTION. Lists architectural documents.


ARCHITECTURAL (continued)

Table with columns: REV., CURRENT REVISION DATE, ORIGINAL ISSUANCE DATE, SHEET NO., SHEET NAME, CURRENT REVISION DESCRIPTION. Continuation of architectural documents.



TERMINAL IMPROVEMENTS CONTRACT 3

Wilmington International Airport 1740 Airport Boulevard, Suite 12 Wilmington, NC 28405

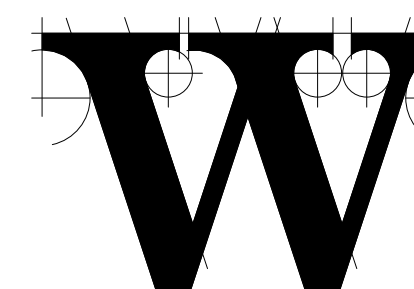

THE WILSON GROUP ARCHITECTS

PO Box 5510 Charlotte, NC 28299 704-331-9747 • www.twgarchitects.com

PROJECT MANAGER & CIVIL ENGINEER

TALBERT & BRIGHT CONSULTING ARCHITECT LS3P

STRUCTURAL ENGINEER

STEWART FPP/ME ENGINEER CHEATHAM & ASSOC.

BAGGAGE HANDLING CONSULTANTS

BNP AIRCRAFT SUPPORT SYSTEMS DK CONSULTANTS

SPECIALTY LIGHTING CONSULTANT

HARTRANFT SIGNAGE & WAYFINDING TAKEFORM

COPYRIGHT © 2019 THE WILSON GROUP ARCHITECTS ALL RIGHTS RESERVED PRINTED OR ELECTRONIC DRAWINGS AND DOCUMENTATION MAY NOT BE REPRODUCED IN ANY FORM WITHOUT WRITTEN PERMISSION FROM THE WILSON GROUP ARCHITECTS

REVISIONS

1 7/30/2019 AD-03

DATE 6/28/2019 PROJECT NUMBER 9202-000 SHEET TITLE

SHEET INDEX VOLUME 1

SHEET NUMBER

G-001

SHEET INDEX - VOLUME 2

FIRE PROTECTION

Table with columns: REV, CURRENT REVISION DATE, ORIGINAL ISSUANCE DATE, SHEET NO, SHEET NAME, CURRENT REVISION DESCRIPTION. Lists fire protection schedules from F1-001 to F2-255.

PLUMBING

Table with columns: REV, CURRENT REVISION DATE, ORIGINAL ISSUANCE DATE, SHEET NO, SHEET NAME, CURRENT REVISION DESCRIPTION. Lists plumbing schedules from P1-801 to P2-200.

MECHANICAL

Table with columns: REV, CURRENT REVISION DATE, ORIGINAL ISSUANCE DATE, SHEET NO, SHEET NAME, CURRENT REVISION DESCRIPTION. Lists mechanical schedules from M1-110 to M2-802.

ELECTRICAL

Table with columns: REV, CURRENT REVISION DATE, ORIGINAL ISSUANCE DATE, SHEET NO, SHEET NAME, CURRENT REVISION DESCRIPTION. Lists electrical schedules from E-001 to E-801.

AIRCRAFT SUPPORT SYSTEMS

Table with columns: REV, CURRENT REVISION DATE, ORIGINAL ISSUANCE DATE, SHEET NO, SHEET NAME, CURRENT REVISION DESCRIPTION. Lists aircraft support system schedules from ACP-100 to ACP-335.

BAGGAGE HANDLING

Table with columns: REV, CURRENT REVISION DATE, ORIGINAL ISSUANCE DATE, SHEET NO, SHEET NAME, CURRENT REVISION DESCRIPTION. Lists baggage handling schedules from B-000 to B-705.


SIGNAGE

Table with columns: REV, CURRENT REVISION DATE, ORIGINAL ISSUANCE DATE, SHEET NO, SHEET NAME, CURRENT REVISION DESCRIPTION. Lists signage schedules from AG-1 to AG-42.



TERMINAL IMPROVEMENTS CONTRACT 3

Wilmington International Airport 1740 Airport Boulevard, Suite 12 Wilmington, NC 28405

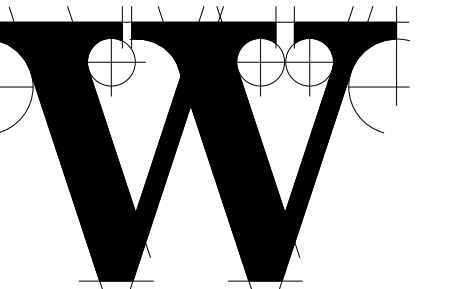

THE WILSON GROUP ARCHITECTS

PO Box 5510 Charlotte, NC 28299 704-331-9747 • www.twargchitects.com

PROJECT MANAGER & CIVIL ENGINEER TALBERT & BRIGHT

CONSULTING ARCHITECT LS3P

STRUCTURAL ENGINEER STEWART

FP/PM/E ENGINEER CHEATHAM & ASSOC.

BAGGAGE HANDLING CONSULTANTS BNP

AIRCRAFT SUPPORT SYSTEMS DK CONSULTANTS

SPECIALTY LIGHTING CONSULTANT HARTRANFT

SIGNAGE & WAYFINDING TAKEFORM

DATE 6/28/2019 PROJECT NUMBER 9202-000 SHEET TITLE

COPYRIGHT © 2019 THE WILSON GROUP ARCHITECTS ALL RIGHTS RESERVED

PRINTED OR ELECTRONIC DRAWINGS AND DOCUMENTATION MAY NOT BE REPRODUCED IN ANY FORM WITHOUT WRITTEN PERMISSION FROM THE WILSON GROUP ARCHITECTS

REVISIONS 1 7/30/2019 AD-03

DATE 6/28/2019 PROJECT NUMBER 9202-000 SHEET TITLE

SHEET INDEX VOLUME 2

SHEET NUMBER G-002



Table with 4 columns: Material Abbreviation, Material Name, Material Abbreviation, Material Name. Lists materials like A/C, AFF, ALT, ALUM, APPROX, ARCH, AUTO, AUX, AV, BITUM, BL, BLDG, BN, BOS, BOT, CAB, CA, CL, CLG, CLG HT, CLO, CLR, CMU, COL, CONC, CONF, CONT, CORR, CU FT, CU YD, DEMO, DEPT, DET, DF, DIA, DIAG, DIM, DIV, DS, EAST, ECH, EIFS, EJ, EL, ELEC, ELEV, ENCL, EOS, EQUAL, EQUIP, EWC, EXIST, EXP JT, EXT, F/F, FD, FE, FEC, FFEL, FHC, FM FLR, FLR, FOC, FOF.

Table with 4 columns: Material Abbreviation, Material Name, Material Abbreviation, Material Name. Lists materials like PSF, PSI, PT, PVC, QTR, QTY, RADUS, RISER, RCP, RD, REF, REQD, RL, RM, RO, ROW, S, SC, SD, SECT, SF, SIM, SPEC, SPKR, SQ, SS, STD, STOR, SUSP, SYS, T, TEL, TEMP, TFF, THK, THRU, TO, TOB, TOC, TOP, TOW, TRTD, TV, TYP, UL, UNO, VERT, VEST, VIF, W, W/T, W/O, W/W, WC, WD, WPF, WR, WT, WWF, YD.




COMcheck Software Version 4.1.1.0 Envelope Compliance Certificate  
Project Information: 2015 IECC, TERMINAL IMPROVEMENTS - CONTRACT 3, Wilmington, North Carolina, Addition, 3%  
Building Area: 1-RAMP LEVEL (Transportation) - Nonresidential, 32337  
Envelope Assemblies Table: Lists assemblies like Floor 1: Slab-On-Grade/Unheated, Exterior Wall 1: Concrete Block, etc.

Envelope Compliance Statement  
Compliance Statement: The proposed envelope design represented in this document is consistent with the building plans, specifications, and other calculations submitted with this permit application.  
Signature: Ryan Genest, Date: 6/22/19

THE WILSON GROUP ARCHITECTS - ARCHITECTS -  
PO Box 5510 Charlotte, NC 28299  
704-331-9747 • www.twgarchitects.com  
PROJECT MANAGER & CIVIL ENGINEER: TALBERT & BRIGHT  
CONSULTING ARCHITECT: LS3P  
STRUCTURAL ENGINEER: STEWART  
FP/PI/E ENGINEER: CHEATHAM & ASSOC.  
BAGGAGE HANDLING CONSULTANTS: BNP  
AIRCRAFT SUPPORT SYSTEMS: DK CONSULTANTS  
SPECIALTY LIGHTING CONSULTANT: HARTRANFT



MATERIAL LEGEND

Table with 4 columns: PLAN AND SECTION, NOT ALL MATERIALS APPLICABLE, ELEVATION. Shows material symbols for Earth, Porous Fill, Rock, etc.

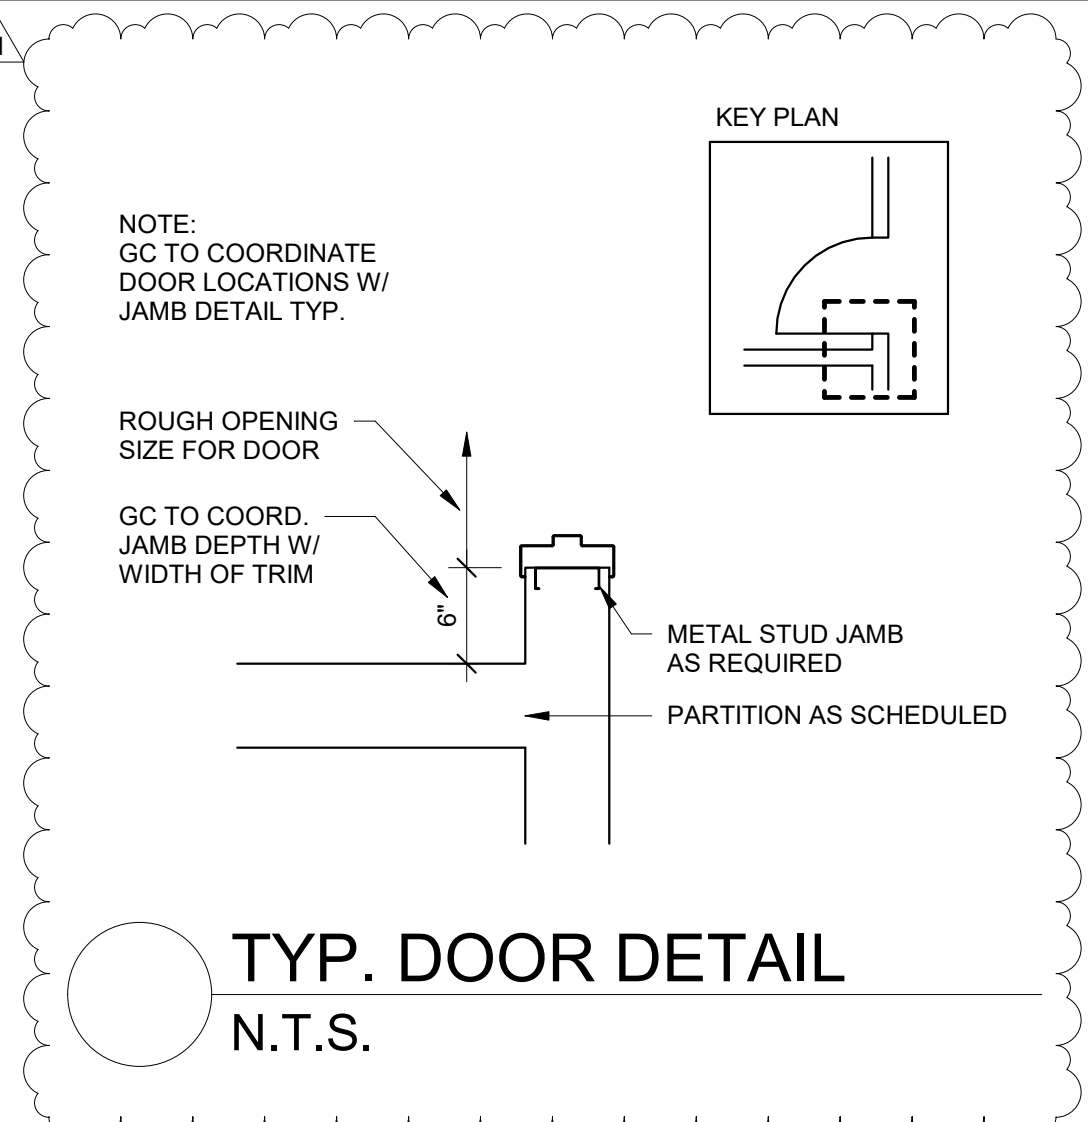

GRAPHIC SYMBOLS



NUMBERING SYSTEM

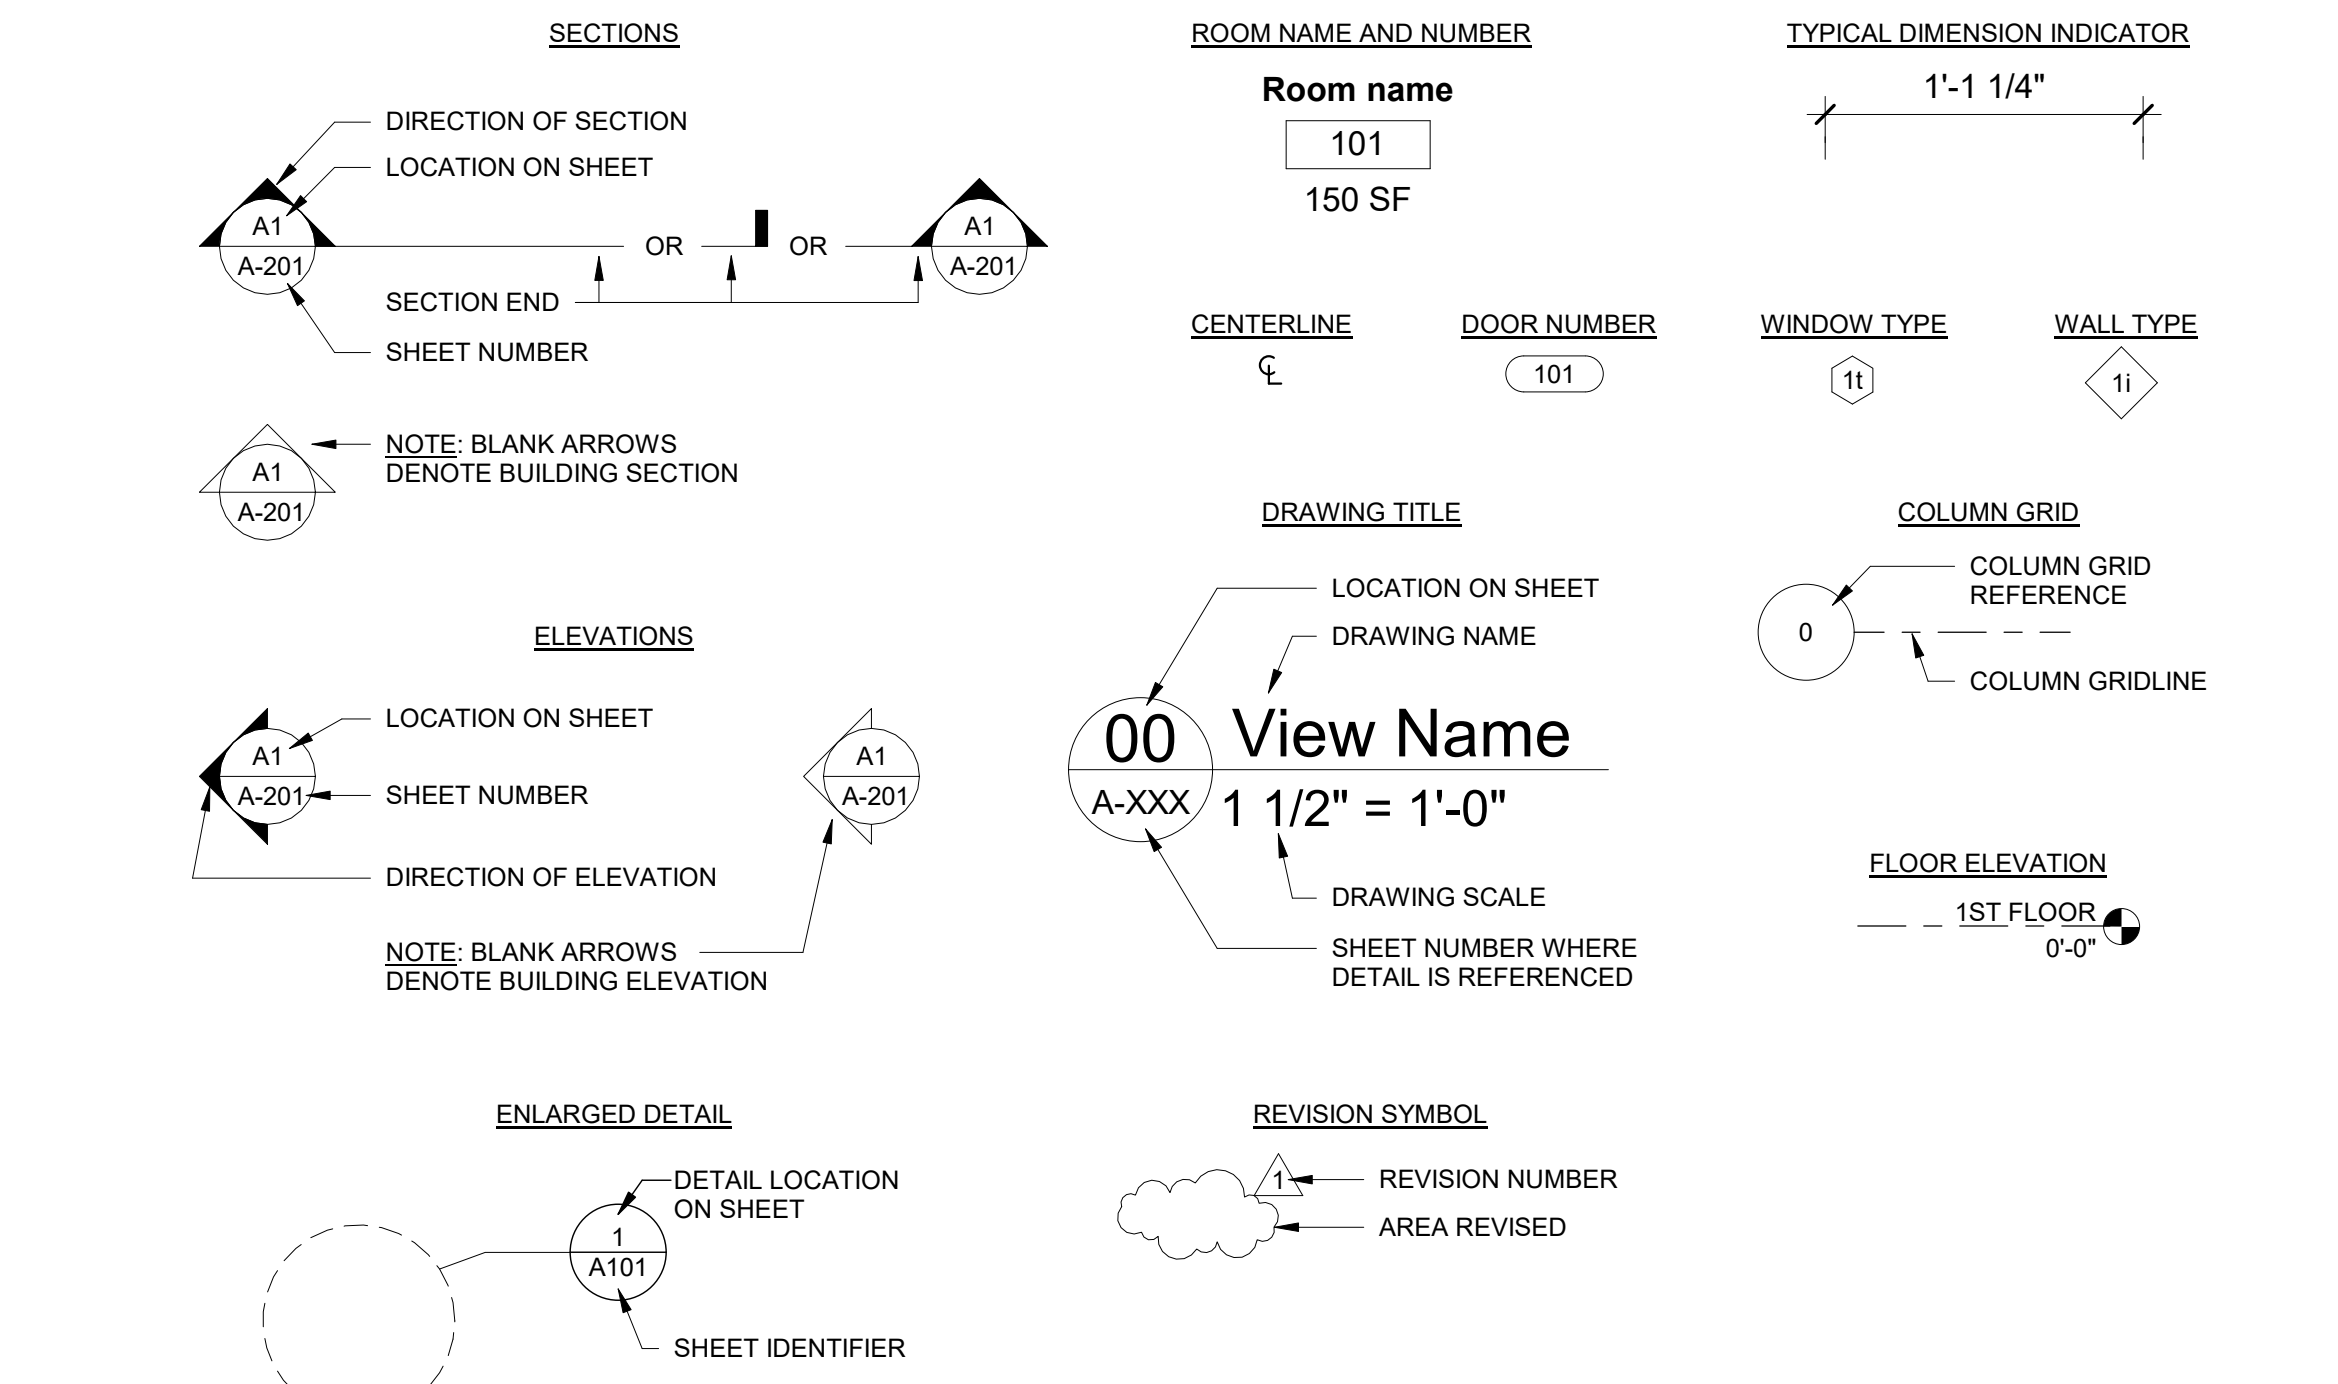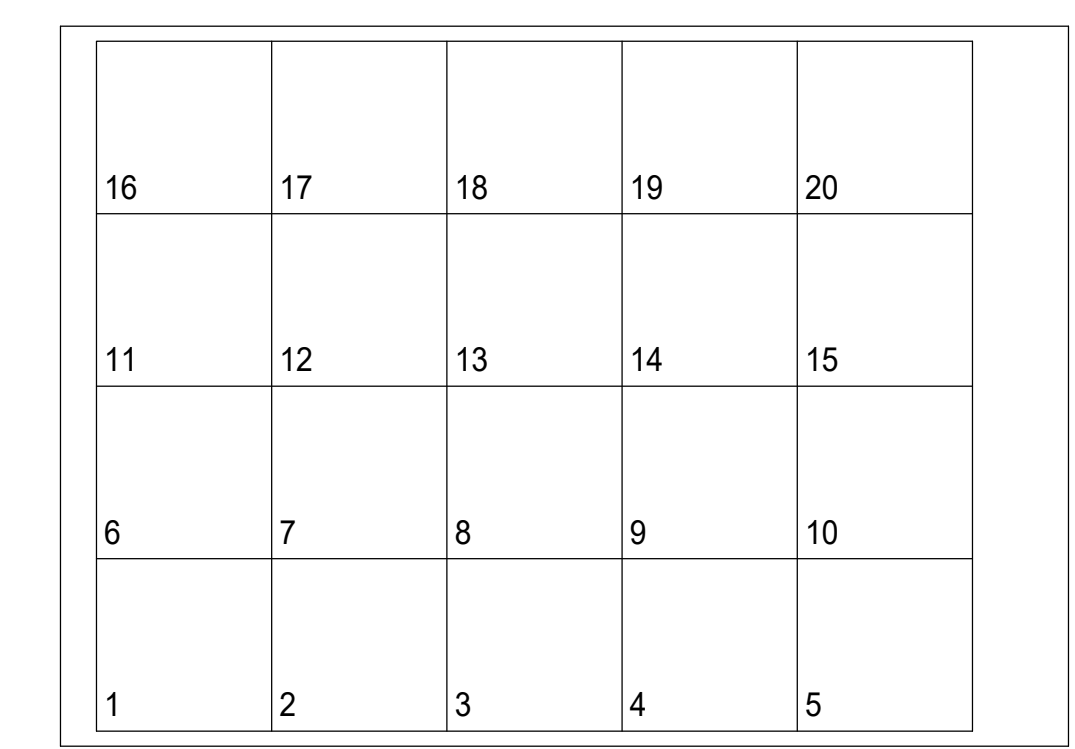

NOTES:  
1. WHEN LESS THAN ALL SIXTEEN (16) DETAIL ZONES ARE UTILIZED OR WHEN ZONES ARE COMBINED, DETAIL NUMBERS WILL NOT BE CONSECUTIVE.  
2. THE ZONE IN WHICH THE LOWER LEFT HAND CORNER OF A DETAIL IS LOCATED DETERMINES THE NUMBER OF THE DETAIL.

COMcheck Software Version 4.1.1.0 Envelope Compliance Certificate  
Project Information: 2015 IECC, TERMINAL IMPROVEMENTS - CONTRACT 3, Wilmington, North Carolina, Addition, 15%  
Building Area: 1-TICKET & BOARDING LEVEL (Transportation) - Nonresidential, 52837  
Envelope Assemblies Table: Lists assemblies like Floor 1: Concrete Floor, Roof 1: Insulation, etc.

Envelope Compliance Statement  
Compliance Statement: The proposed envelope design represented in this document is consistent with the building plans, specifications, and other calculations submitted with this permit application.  
Signature: Ryan Genest, Date: 6/22/19

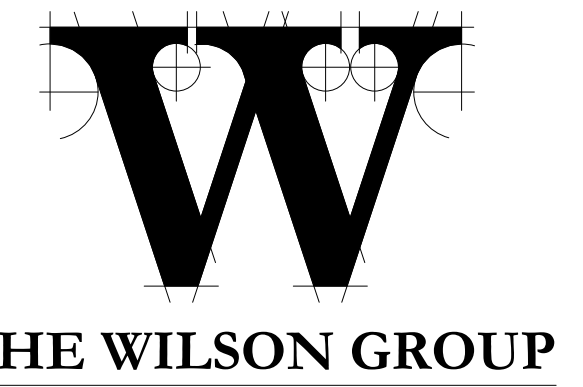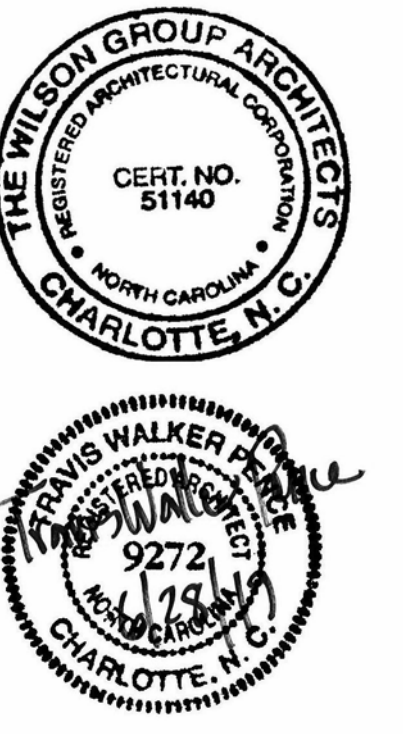

**THE WILSON GROUP ARCHITECTS -**  
PO Box 5510 Charlotte, NC 28299  
704-331-9747 • www.twgarchitects.com

PROJECT MANAGER & CIVIL ENGINEER  
**TALBERT & BRIGHT**  
CONSULTING ARCHITECT  
LS3P

STRUCTURAL ENGINEER  
**STEWART**  
FP/PM/E ENGINEER

**CHEATHAM & ASSOC.**  
BAGGAGE HANDLING CONSULTANTS  
BNP

AIRCRAFT SUPPORT SYSTEMS  
**DK CONSULTANTS**  
SPECIALTY LIGHTING CONSULTANT  
**HARTRANFT**  
SIGNAGE & WAYFINDING  
**TAKEFORM**

COPYRIGHT © 2019  
THE WILSON GROUP ARCHITECTS  
ALL RIGHTS RESERVED  
PRINTED OR ELECTRONIC DRAWINGS AND DOCUMENTATION MAY NOT BE REPRODUCED IN ANY FORM WITHOUT WRITTEN PERMISSION FROM THE WILSON GROUP ARCHITECTS

REVISIONS  
1 7/30/2019 AD-03

DATE 6/28/2019  
PROJECT NUMBER 9202-000  
SHEET TITLE

**PARTITION TYPES**


SHEET NUMBER  
**G-005**

**PARTITION NOTES**


- UNLESS OTHERWISE NOTED, DIMENSIONS ARE TO COLUMN CENTERLINE, FACE OF GWB/STUD PARTITIONS, FACE OF MASONRY AND CONCRETE WALLS AND FACE OF EXISTING WALLS.
- AT DEFLECTION TRACKS AND WHERE PARTITION EXTENDS TO STRUCTURE ABOVE, HOLD TOP OF STUDS DOWN 1 1/2" MIN. FROM TOP RUNNER/TRACK. VERIFY DEFLECTION INFORMATION WITH STRUCTURAL DRAWINGS.
- ALL CAULK AND SEALANT SHALL BE CONTINUOUS.
- ALL CMU WALLS AND SOUND RATED PARTITIONS SHALL EXTEND FROM FINISHED FLOOR TO WHERE THEY MAY BE SEALED, SUCH AS THE UNDERSIDE OF THE STRUCTURE OR DECK; AND SHALL BE ENTIRELY SEALED OFF UNLESS NOTED OTHERWISE. ALL PENETRATIONS SUCH AS PIPING, CONDUITS, DUCTS, ETC., IN SUCH SEALED OFF WALLS OR PARTITIONS SHALL IN THEMSELVES BE PACKED AND SEALED OFF ALONG THE PERIMETER OF EACH PENETRATION.
- ALL FIRE AND/OR SMOKE PARTITIONS SHALL EXTEND FROM FINISH FLOOR TO WHERE THEY MAY BE SEALED, SUCH AS THE UNDERSIDE OF THE STRUCTURE OR DECK, AND BE ENTIRELY SEALED OFF WITH SAFING MATERIAL ONLY. SAFING MATERIAL SHALL BE HELD IN PLACE WITH A FIRE STOPPING MATERIAL ON BOTH SIDES, SUCH AS GYPSUM WALL BOARD OR UL LISTED FIRE PROOFING MATERIAL AND ASSEMBLY.
- ALL SOUND RATED (STC) WALLS OR PARTITIONS SHALL HAVE CLOSURE GASKETS AT TOP, BOTTOM, AND SIDES WHERE A SOUND LEAK WOULD OTHERWISE EXIST. ALL PENETRATIONS THROUGH SUCH PARTITIONS SHALL IN THEMSELVES BE GASKET-SEALED ALONG THE PENETRATION PERIMETER.
- STRUCTURAL STUDS (20 GA. MIN.) SHALL BE USED WHERE ANY NON-SELF-SUPPORTING WALL-HUNG FIXTURES, EQUIPMENT, OR CABINETS OCCUR AND SHALL EXTEND FROM FLOOR TO STRUCTURE ABOVE.
- ALL 20 GA. METAL STUD FRAMED PARTITIONS SHALL BE BRACED ABOVE FINISHED CEILING. ALL KICKER LOCATIONS SHALL BE COORDINATED WITH ALL OTHER TRADES PERFORMING WORK ABOVE CEILING.
- DO NOT FASTEN TOP RUNNER TO STUDS; CRIMP RUNNER ON BOTH SIDES OF STUD TO STABILIZE STUD.
- ALL RATED PARTITIONS SHALL BE IDENTIFIED ABOVE HUNG CEILING WITH CODE COMPLIANT SIGNAGE.
- SEE ROOM FINISH SCHEDULE FOR ADDITIONAL REQUIREMENTS FOR FINISH MATERIALS SUCH AS PORCELAIN TILE, SPECIALTY WALL PANELS, ETC. NOT SHOWN OR INCLUDED IN THESE PARTITION TYPES.
- WHERE PARTITION TYPES CHANGE IN A STRAIGHT RUN, THE EXPOSED OR MORE IMPORTANT EXPOSED FINISHED FACE, AND NOT NECESSARILY THE CENTERLINE OF STUDS, SHALL ALIGN. REVIEW CASES WHICH ARE UNCLEAR WITH THE ARCHITECT PRIOR TO CONSTRUCTING PARTITIONS.
- WHERE ITEMS ARE RECESSED INTO RATED PARTITIONS, PROVIDE BOXING, INSULATION, ETC. AS REQUIRED TO MAINTAIN THE REQUIRED FIRE RESISTANCE RATING.
- PURSUANT TO NCSBC 603, ALL WOOD PRODUCTS SHALL BE FIRE-RETARDANT TREATED (FRT).

**LIGHT GAUGE/STRUCTURAL STUD FRAMING NOTES**


- SIGN AND SEAL SHOP DRAWINGS AND CALCULATIONS BY A PROFESSIONAL ENGINEER, REGISTERED IN THE STATE WHERE PROJECT IS LOCATED. CONTRACTOR'S PROFESSIONAL ENGINEER IS RESPONSIBLE AND IN CHARGE OF THE DESIGN, DETAILING, PROPER IMPLEMENTATION, AND COORDINATION OF SHOP DRAWINGS. DESIGN TEAM'S STRUCTURAL ENGINEER WILL BEGIN REVIEW OF SUBMITTALS ONLY AFTER CONTRACTOR'S COMPLIANCE WITH THIS DELEGATED DESIGN REQUIREMENT.
- CONTRACTOR SHALL BE RESPONSIBLE FOR ALL MEMBERS, BRACING, BRIDGING, STRAPPING, CONNECTION DESIGN(S), DETAILING, SPACING OF COMPONENTS, DIMENSIONING, COORDINATION WITH OTHER RELATED WORK AND ADJACENT CONSTRUCTION, ERECTION OF ALL LIGHT GAUGE COMPONENTS / STRUCTURAL STUDS.
- COMPLY WITH MOST RECENT VERSION (UNLESS SPECIFICALLY STATE OTHERWISE) OF ALL APPLICABLE PROVISIONS OF STATE AND LOCAL BUILDING AND SAFETY CODES REFERENCED THEREIN; OTHER FEDERAL (OSHA) SAFETY REQUIREMENTS, AND OTHER CODES AND STANDARDS REFERENCED THEREIN.
- COMPUTE STRUCTURAL PROPERTIES OF STUDS AND JOISTS IN ACCORDANCE WITH AISI "SPECIFICATION FOR DESIGN OF COLD-FORMED STEEL STRUCTURAL MEMBERS."
- WHERE FRAMING UNITS ARE COMPONENTS OF ASSEMBLIES INDICATED FOR A FIRE RESISTANCE RATING, INCLUDING THOSE REQUIRED FOR COMPLIANCE WITH GOVERNING REGULATIONS, PROVIDE UNITS WHICH HAVE BEEN APPROVED BY GOVERNING AUTHORITIES HAVING JURISDICTION.
- CONTRACT DOCUMENTS SHOW ONLY BASIC LOCATIONS, CONFIGURATIONS, SIZES, AND CONNECTIONS REQUIRED. DETAILING AND SPACING OF COMPONENTS IS THE RESPONSIBILITY OF THE CONTRACTOR.

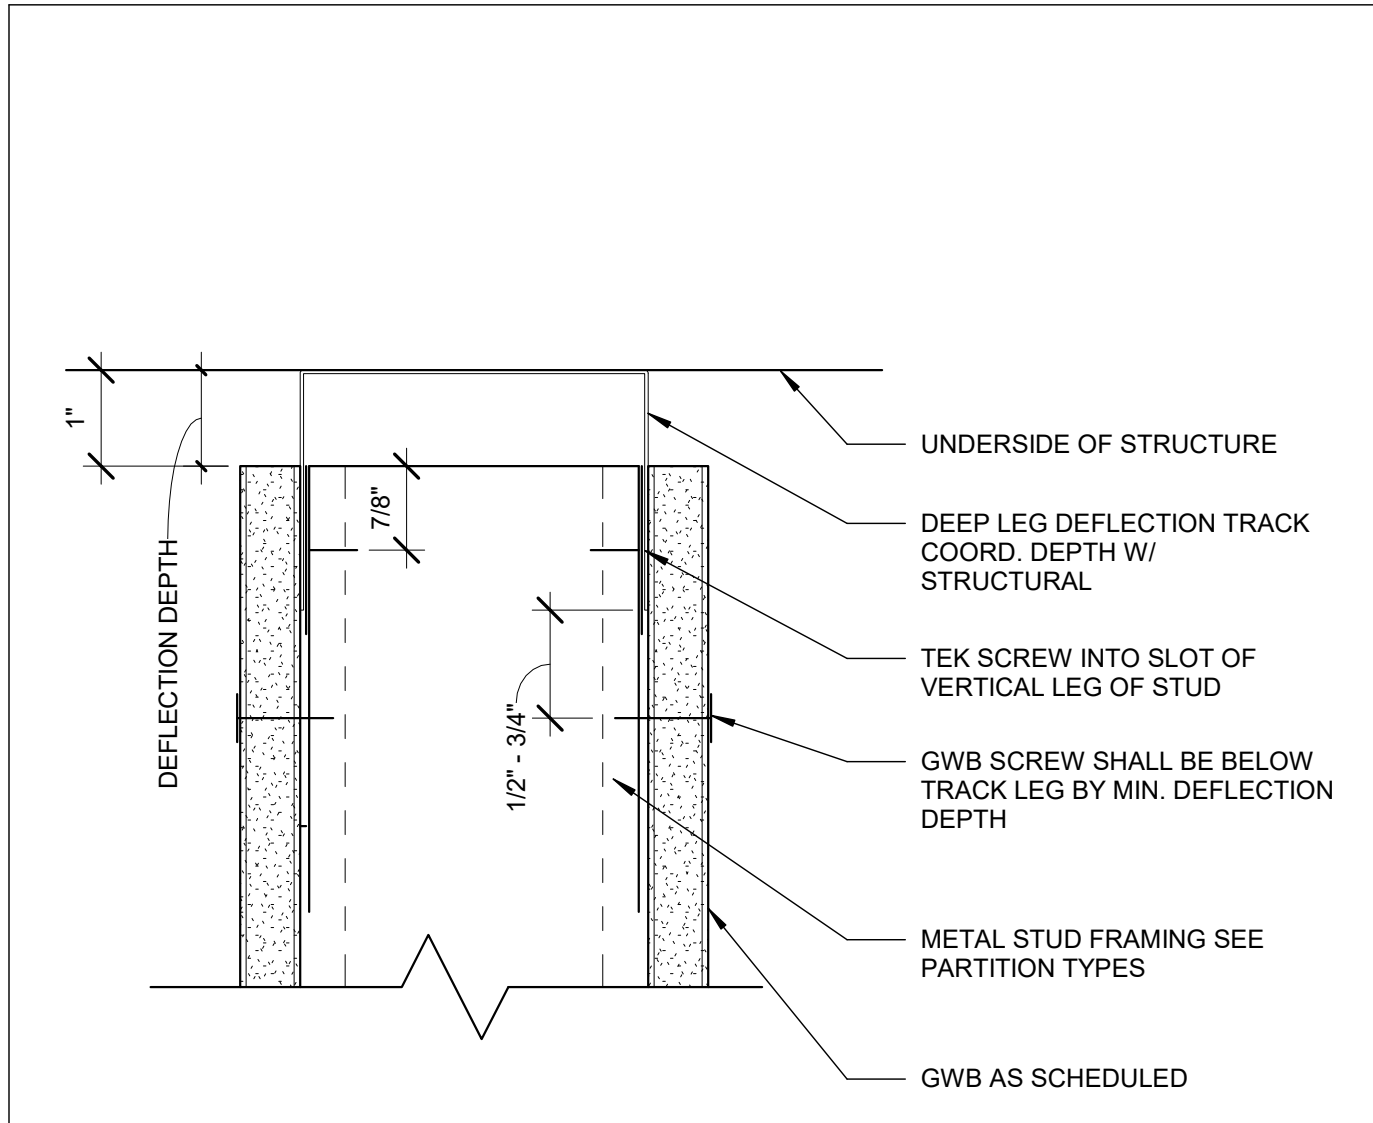

**16 DEFLECTION TRACK DETAIL**  
6" = 1'-0"

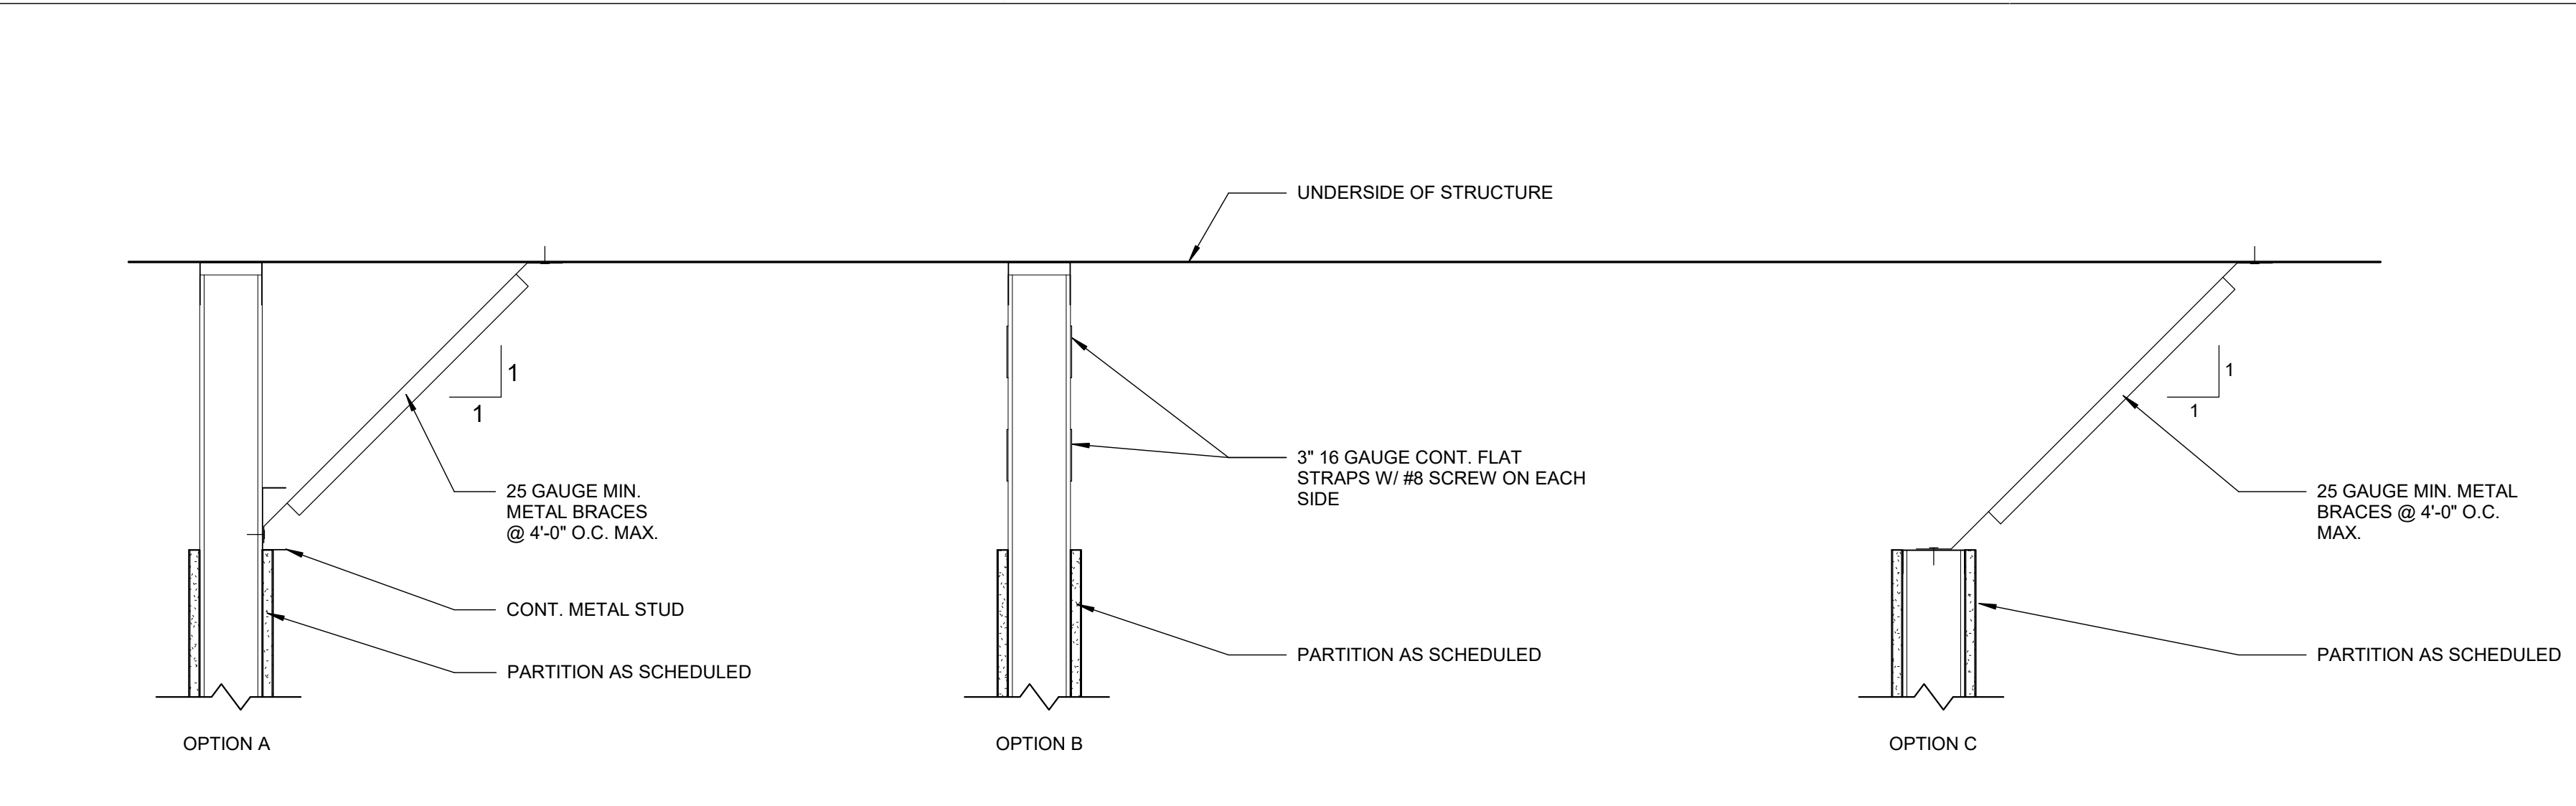


**17 STUD TERMINATION ABOVE CEILING DETAIL**  
1 1/2" = 1'-0"

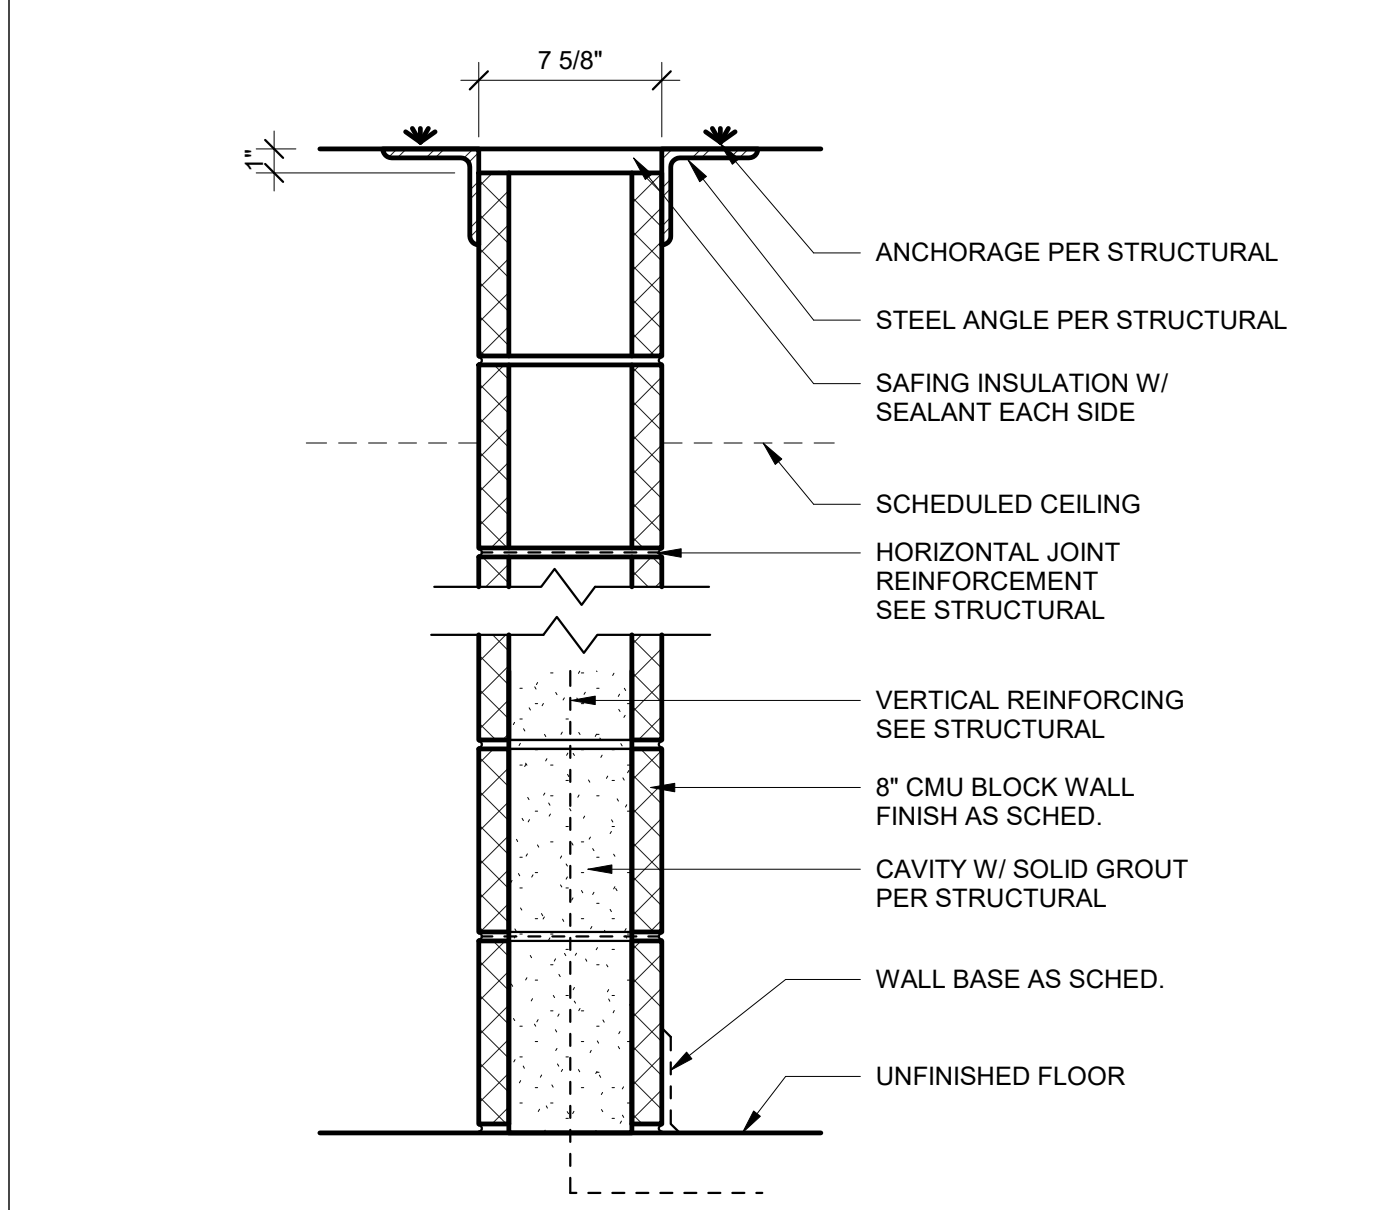


**M-01**

FIRE RATING	ASSEMBLY NO.	STC	STC. TEST #
0 HR	N/A	N/A	N/A

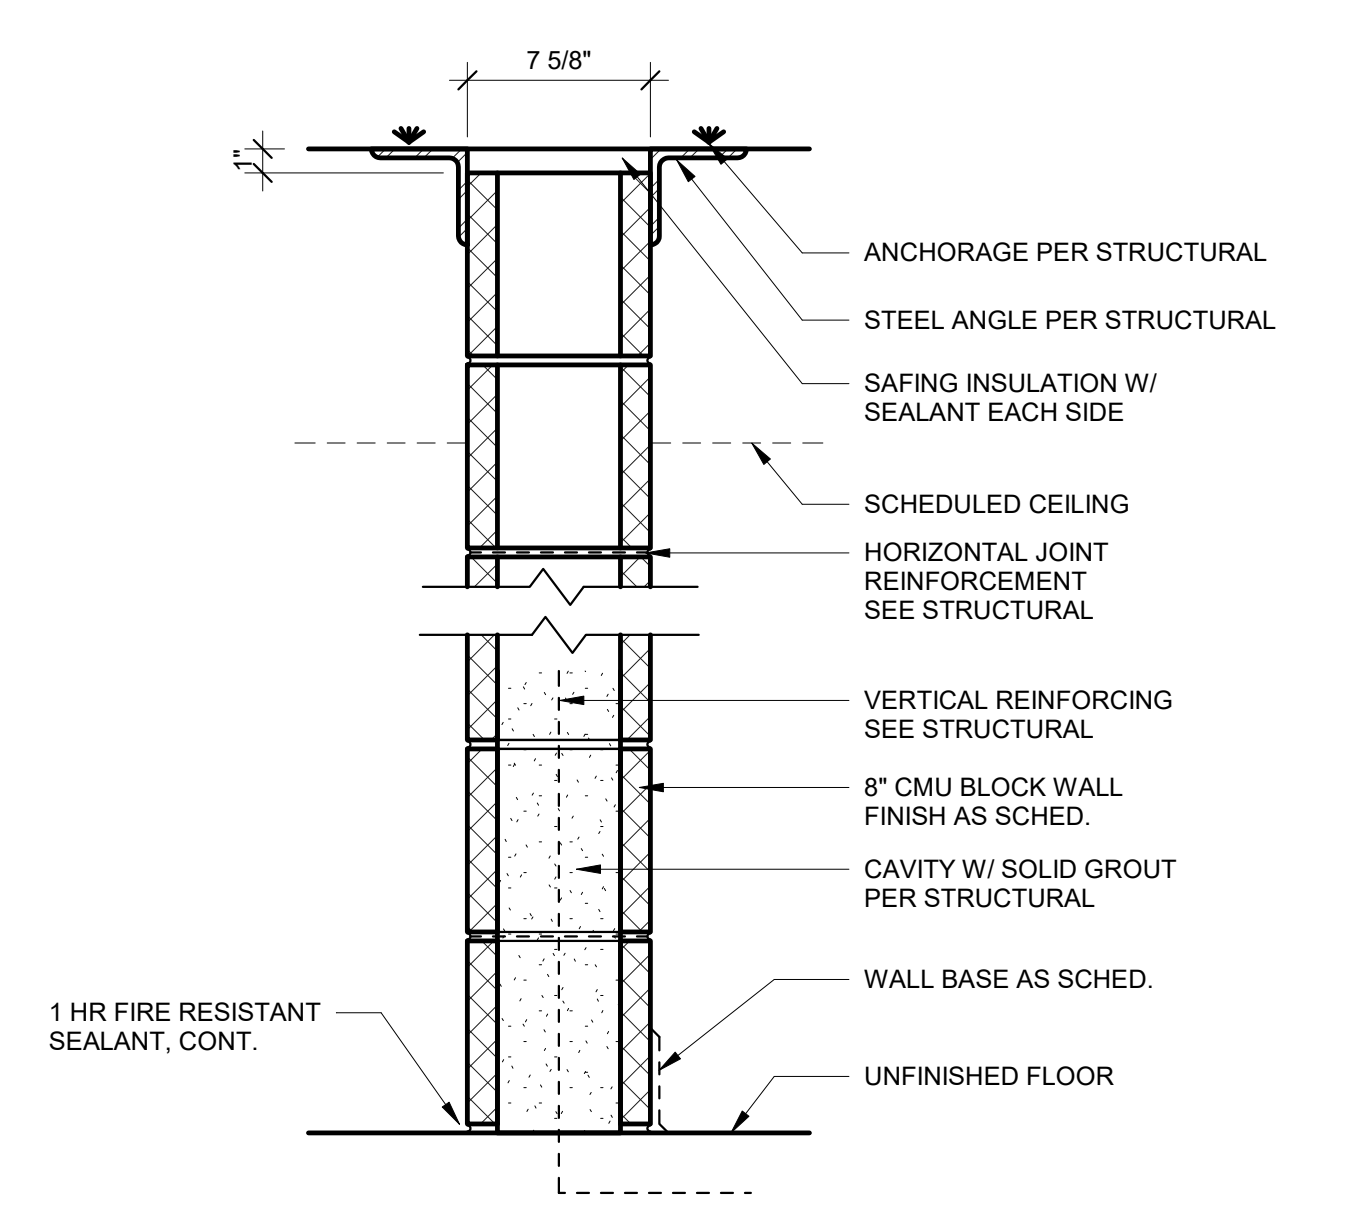


**M-02**

FIRE RATING	ASSEMBLY NO.	STC	STC. TEST #
1 HR	U914	N/A	N/A

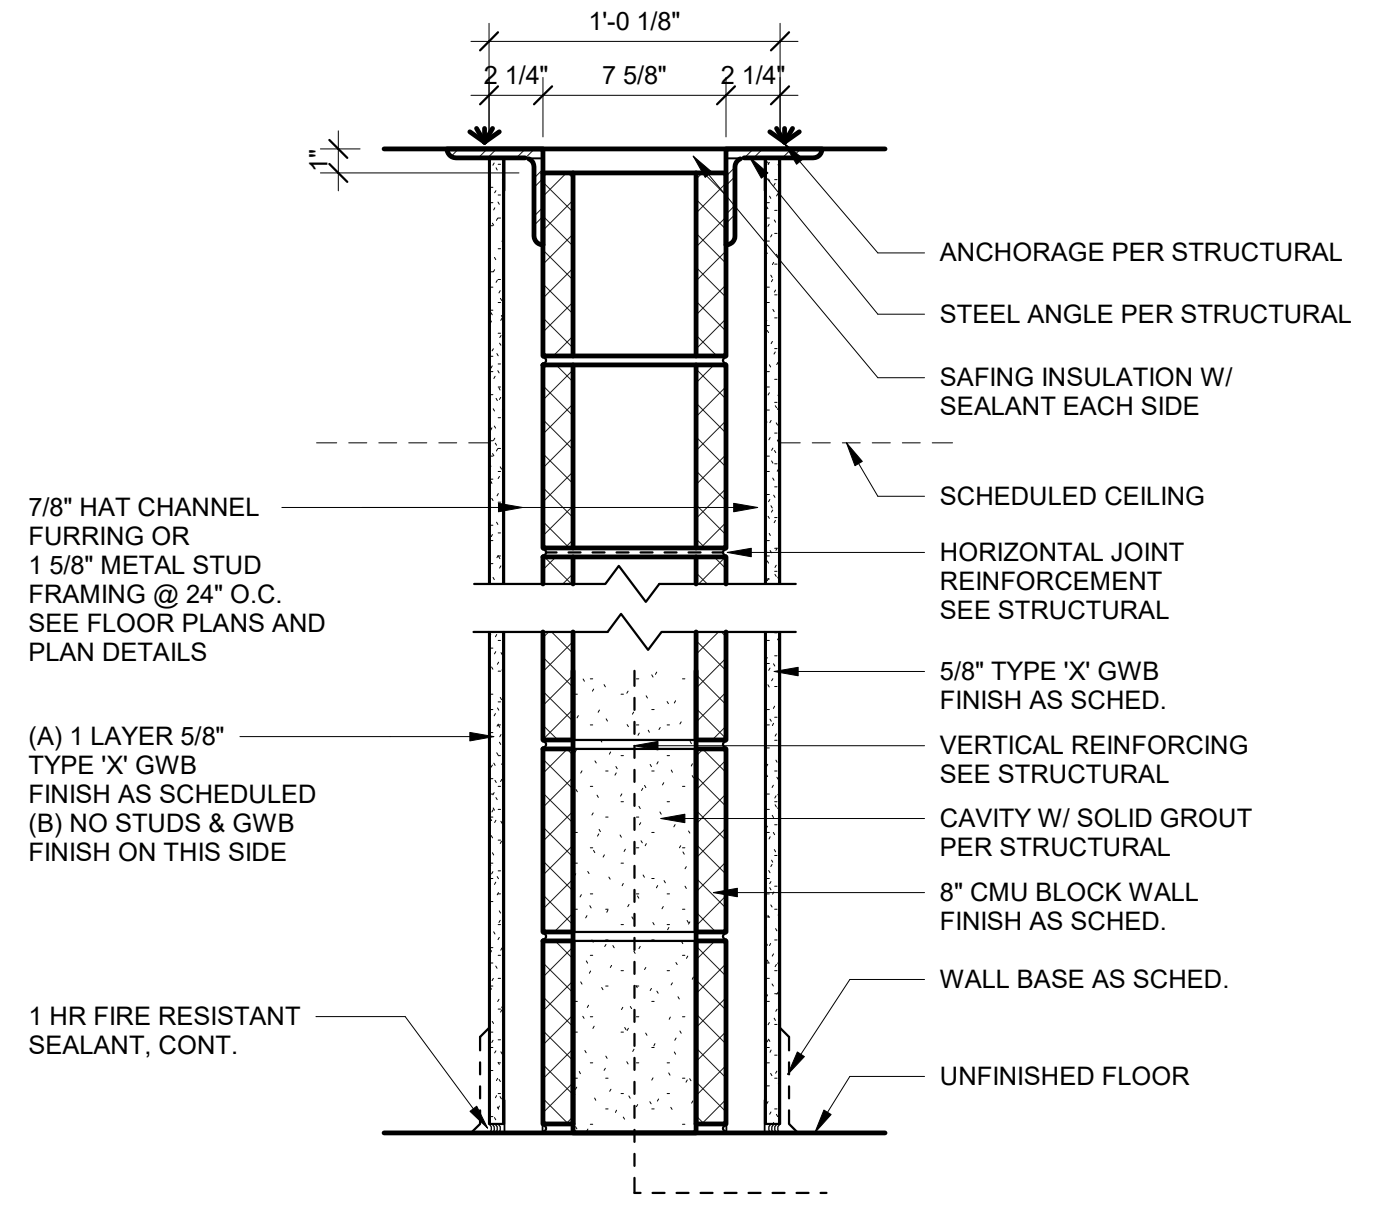


**M-03 A/B**

FIRE RATING	ASSEMBLY NO.	STC	STC. TEST #
1 HR	U914	N/A	N/A

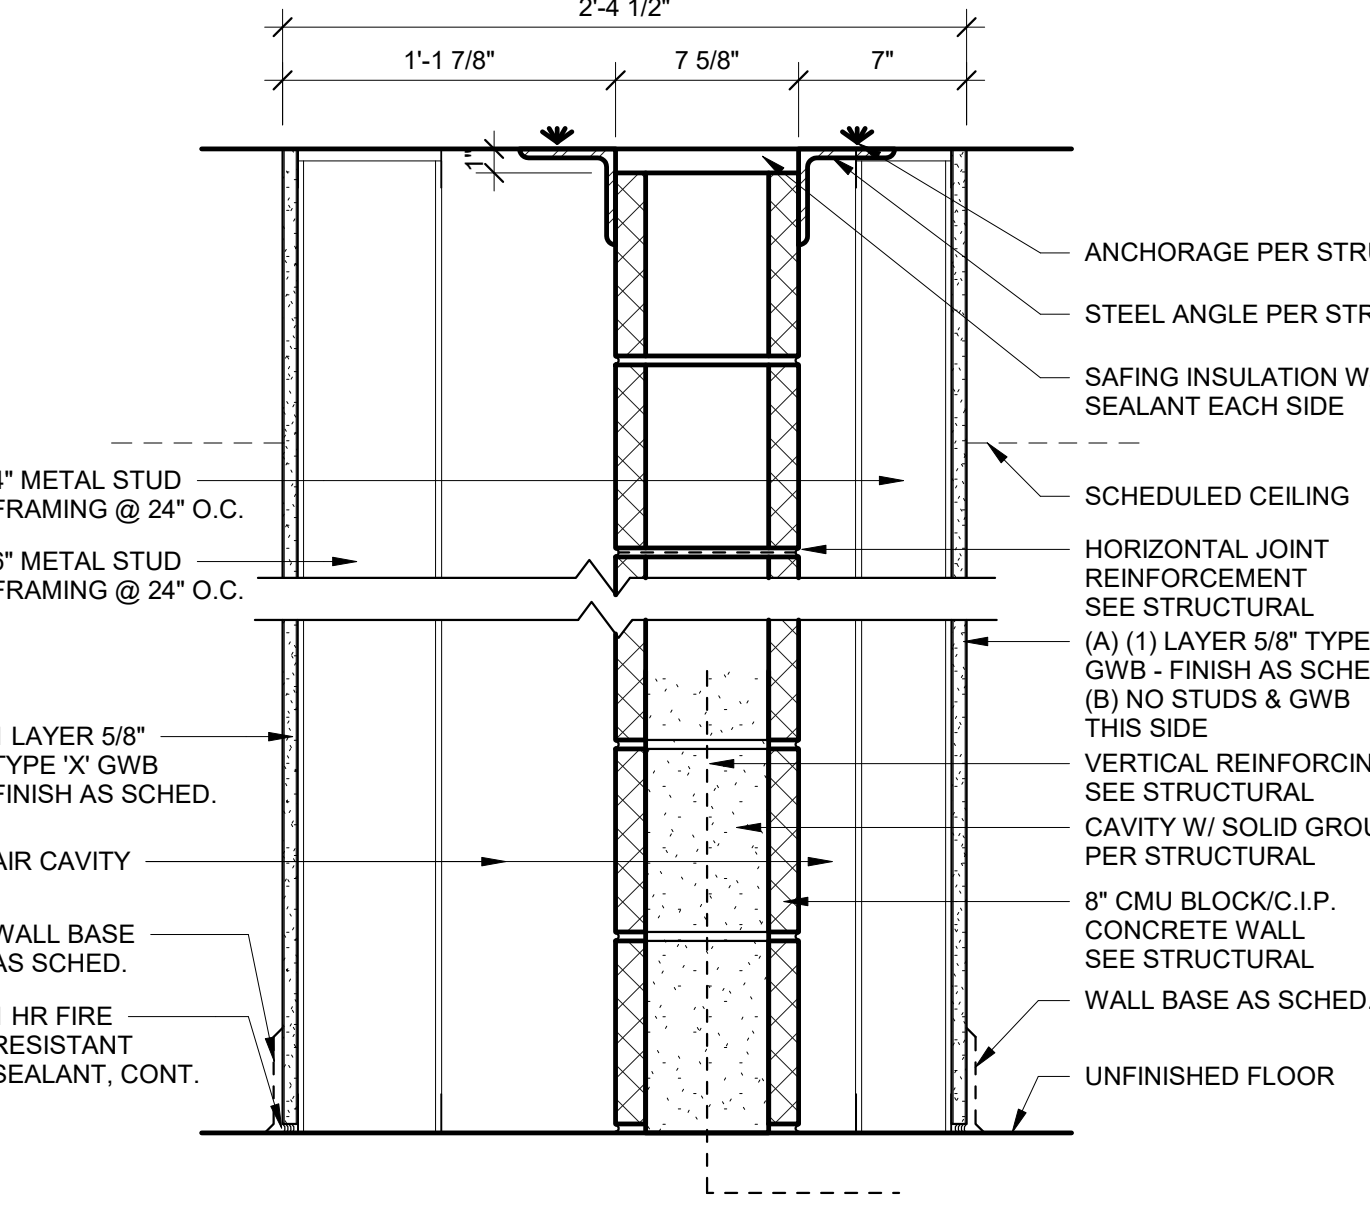


**M-04 A/B**

FIRE RATING	ASSEMBLY NO.	STC	STC. TEST #
1 HR	U914	N/A	N/A

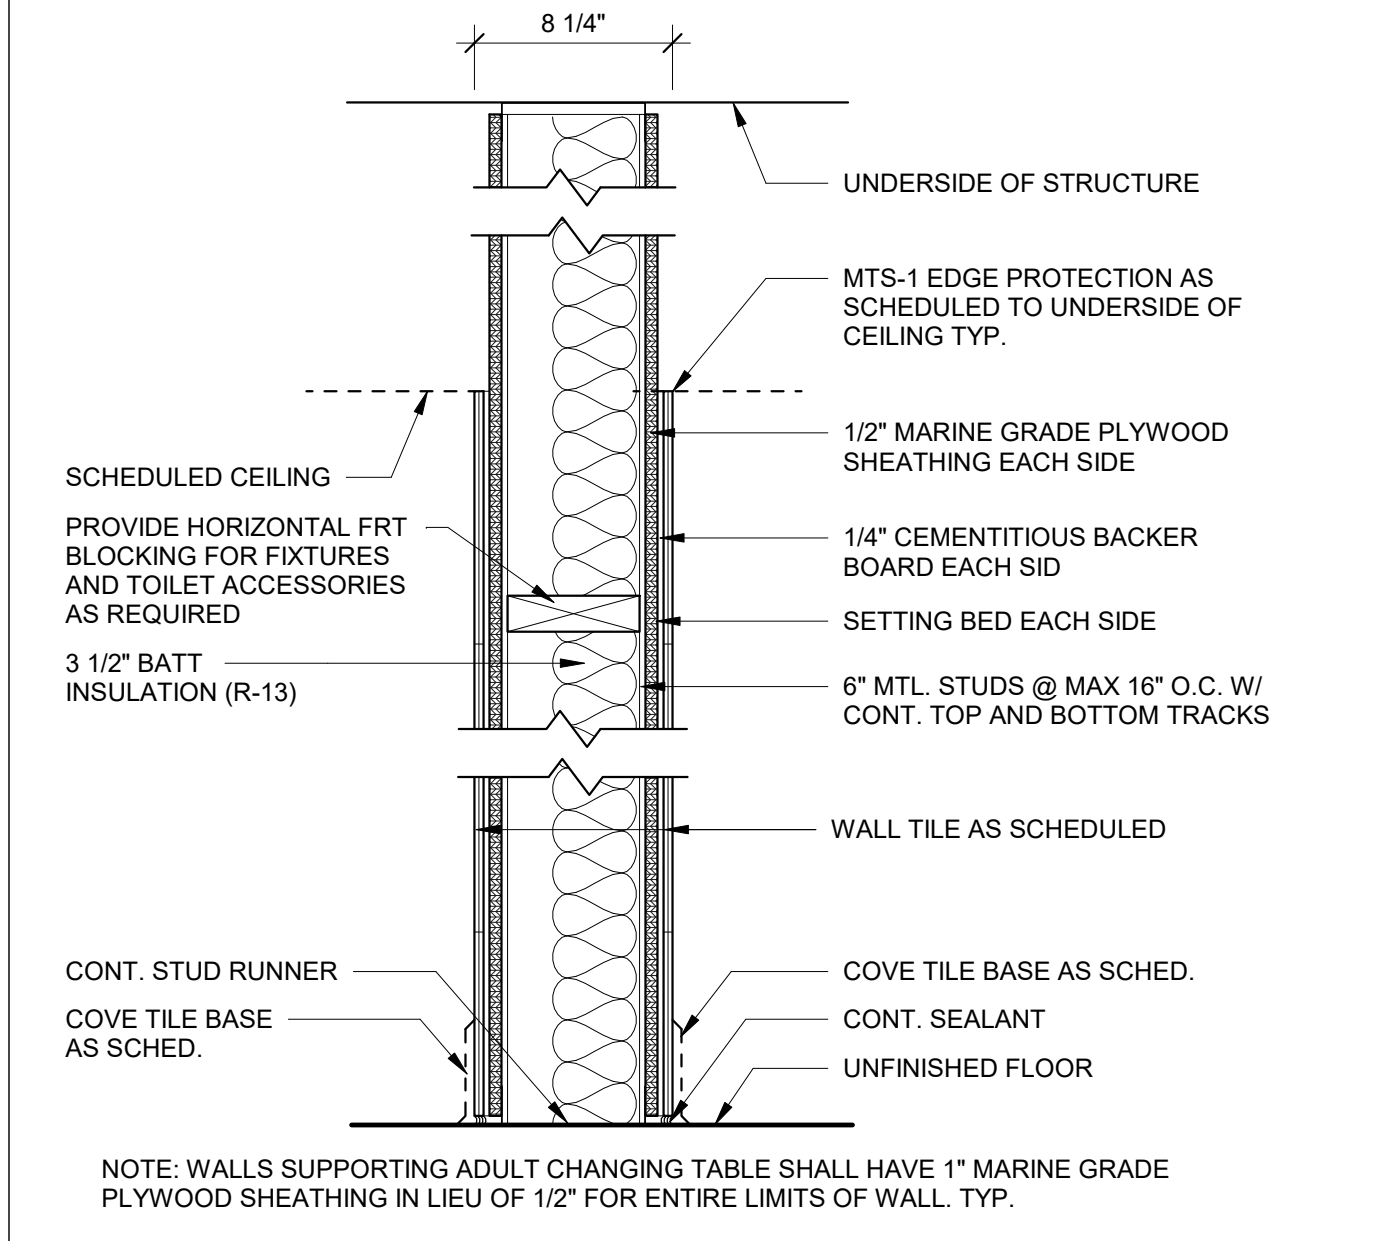


**G-06**

FIRE RATING	ASSEMBLY NO.	STC	STC. TEST #
0 HR	N/A	N/A	N/A

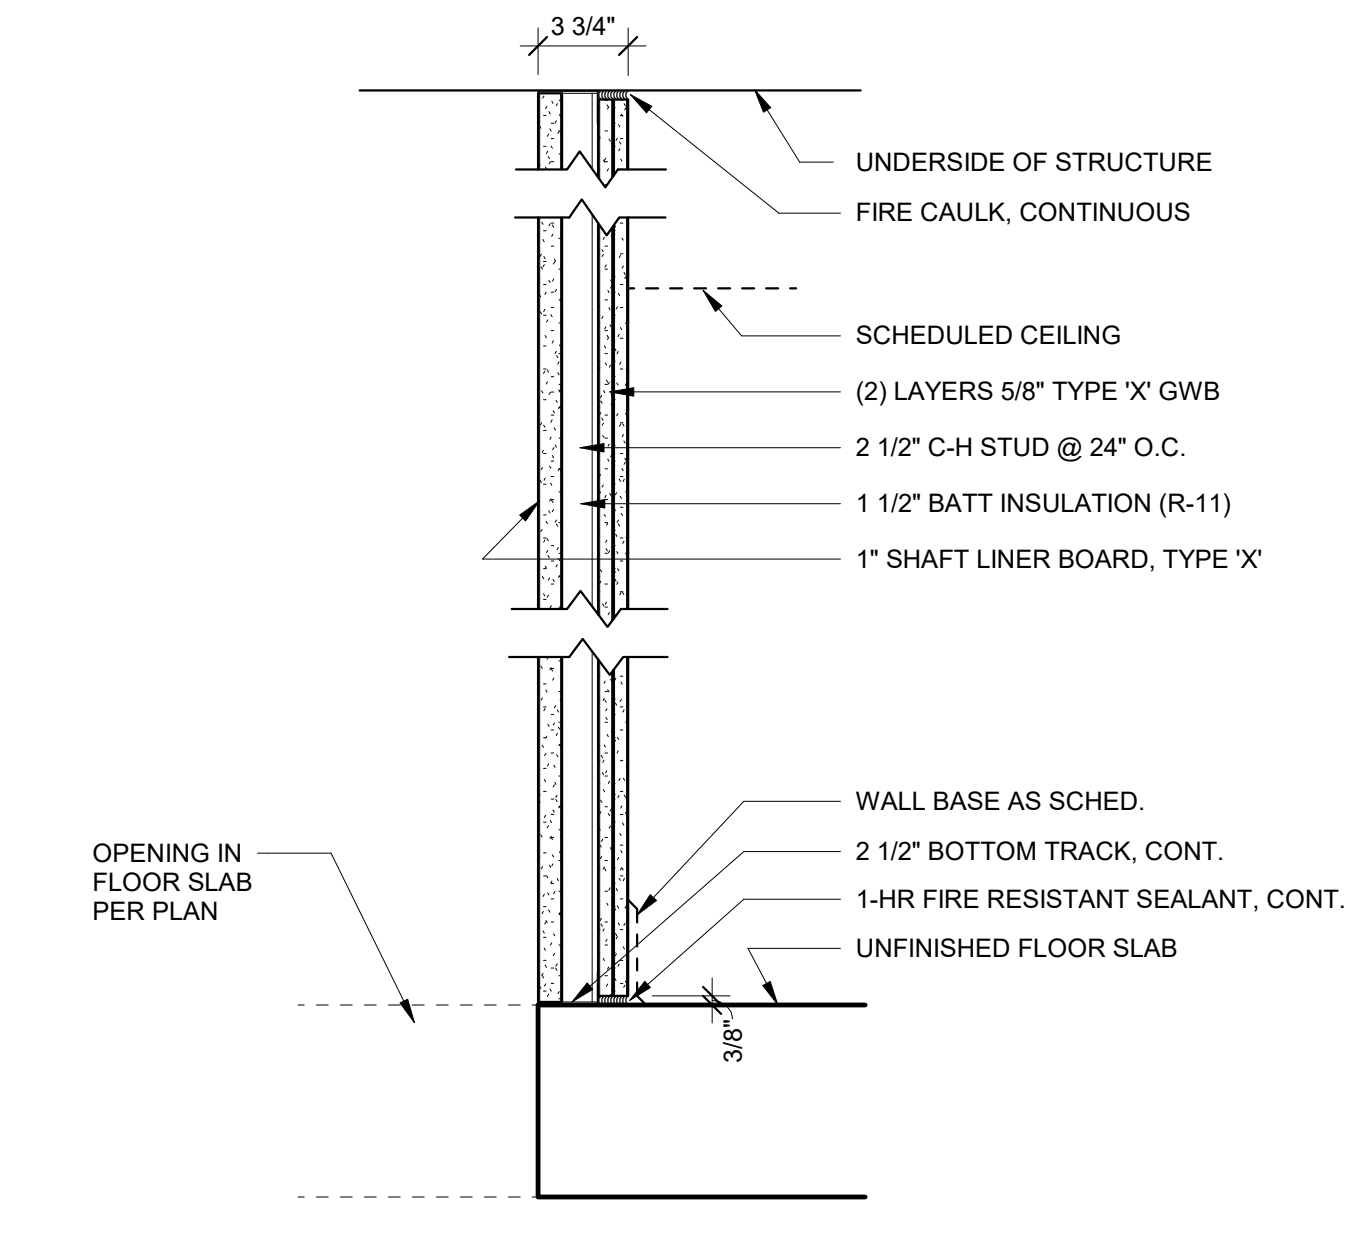

**G-07**

FIRE RATING	ASSEMBLY NO.	STC	STC. TEST #
1 HR	U438	N/A	N/A

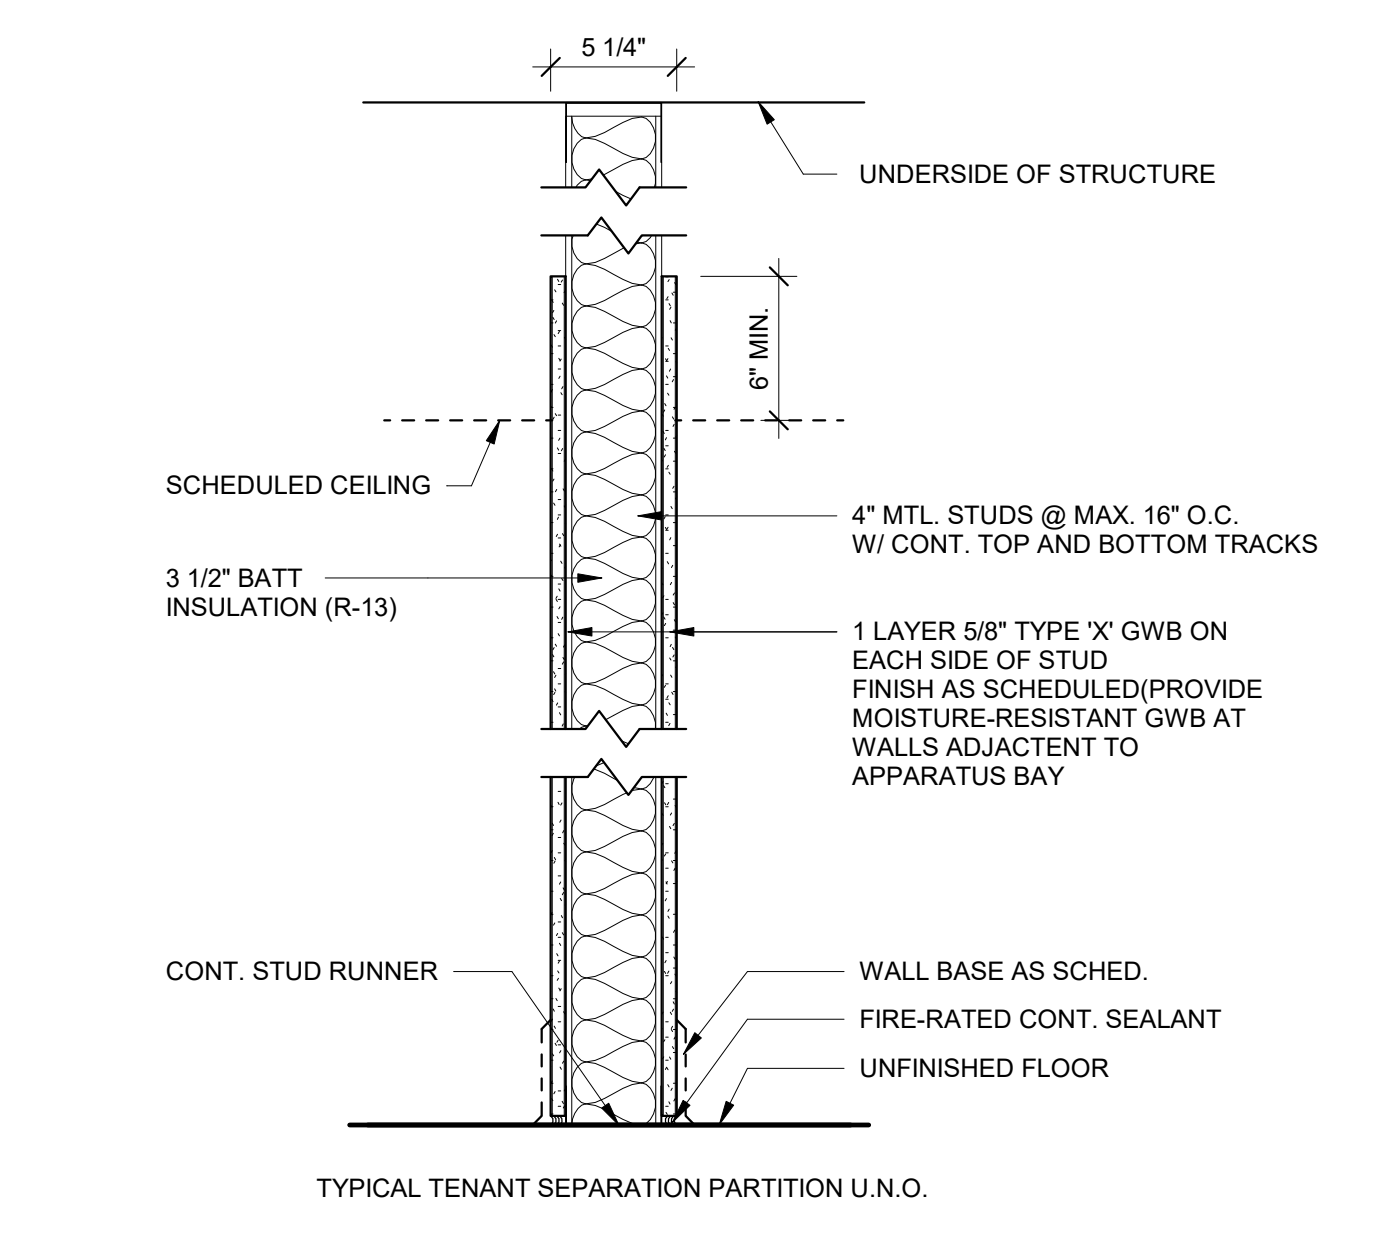

**G-08**

FIRE RATING	ASSEMBLY NO.	STC	STC. TEST #
1 HR	U404	N/A	N/A




**G-09**

FIRE RATING	ASSEMBLY NO.	STC	STC. TEST #
0 HR	N/A	N/A	N/A




**G-10**

FIRE RATING	ASSEMBLY NO.	STC	STC. TEST #
0 HR	N/A	N/A	N/A

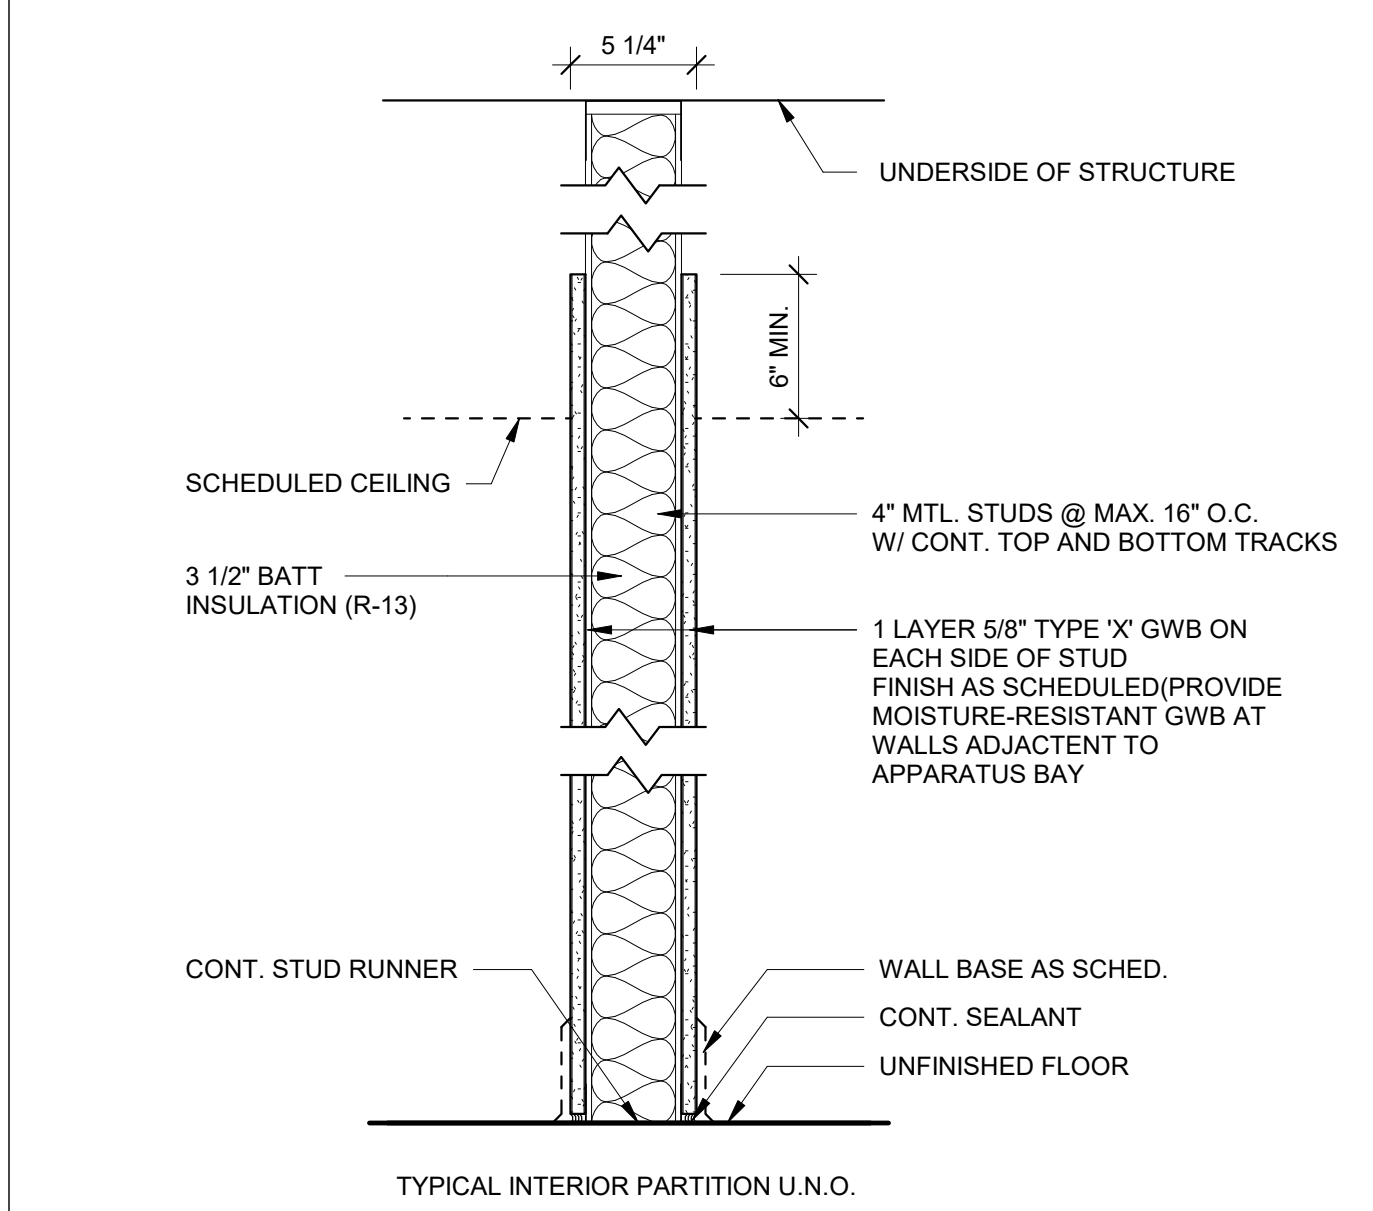


**G-01**

FIRE RATING	ASSEMBLY NO.	STC	STC. TEST #
0 HR	N/A	N/A	N/A

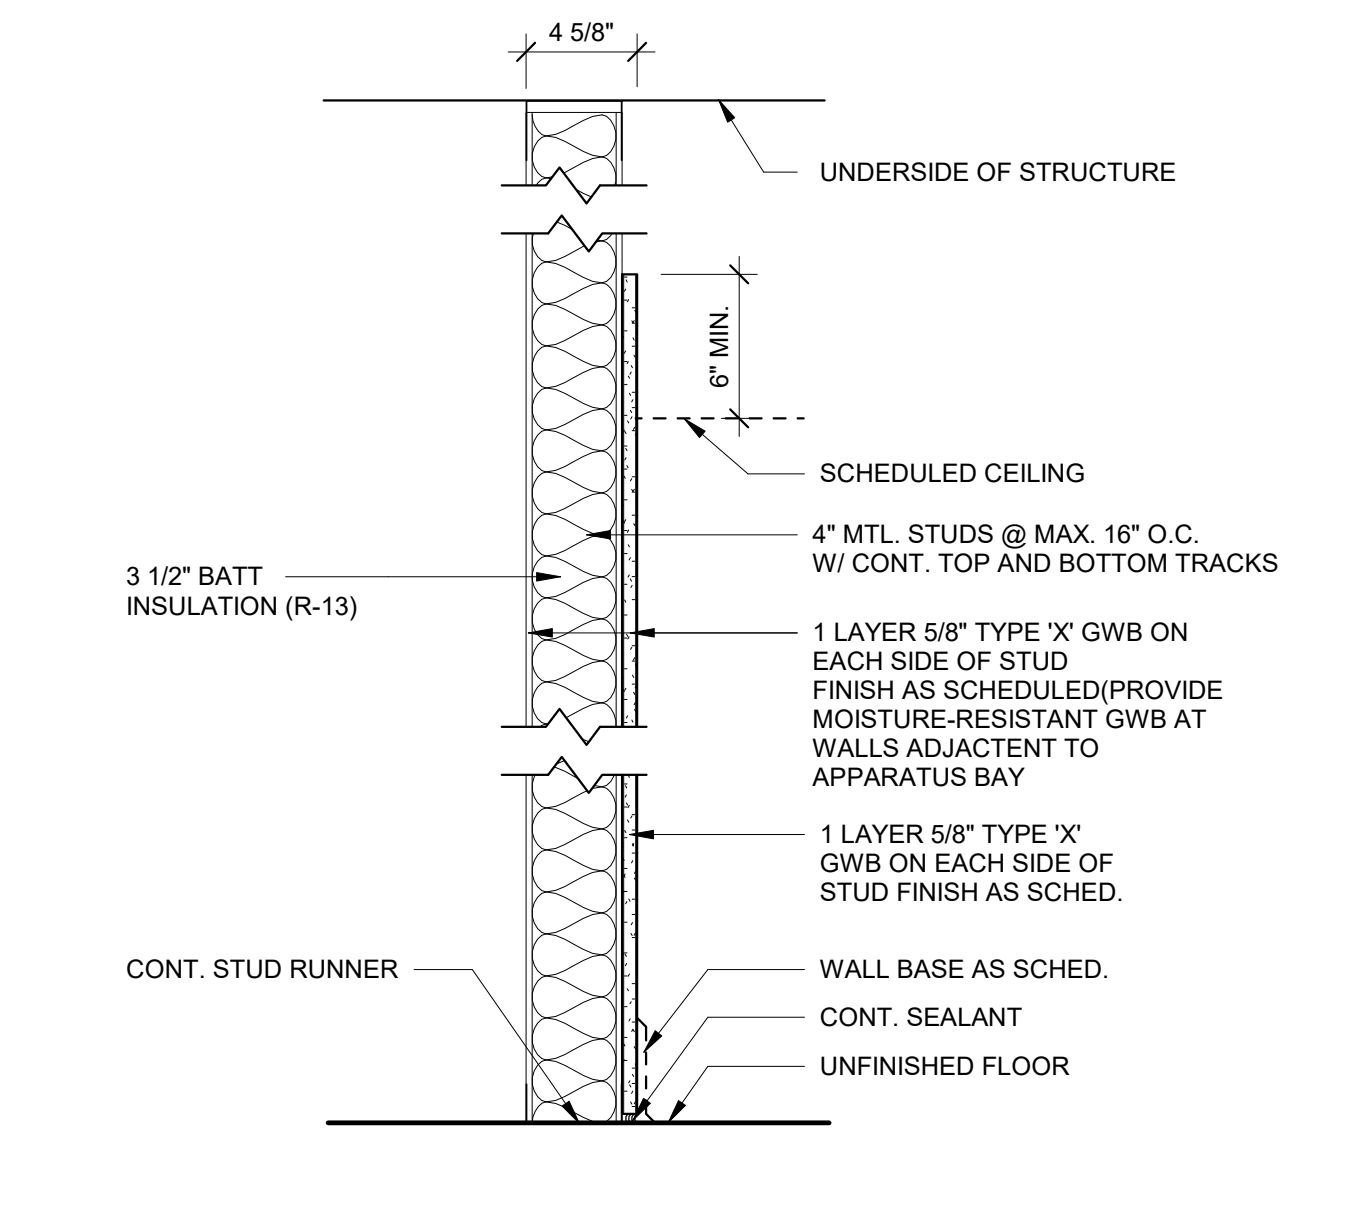


**G-02**

FIRE RATING	ASSEMBLY NO.	STC	STC. TEST #
0 HR	N/A	N/A	N/A

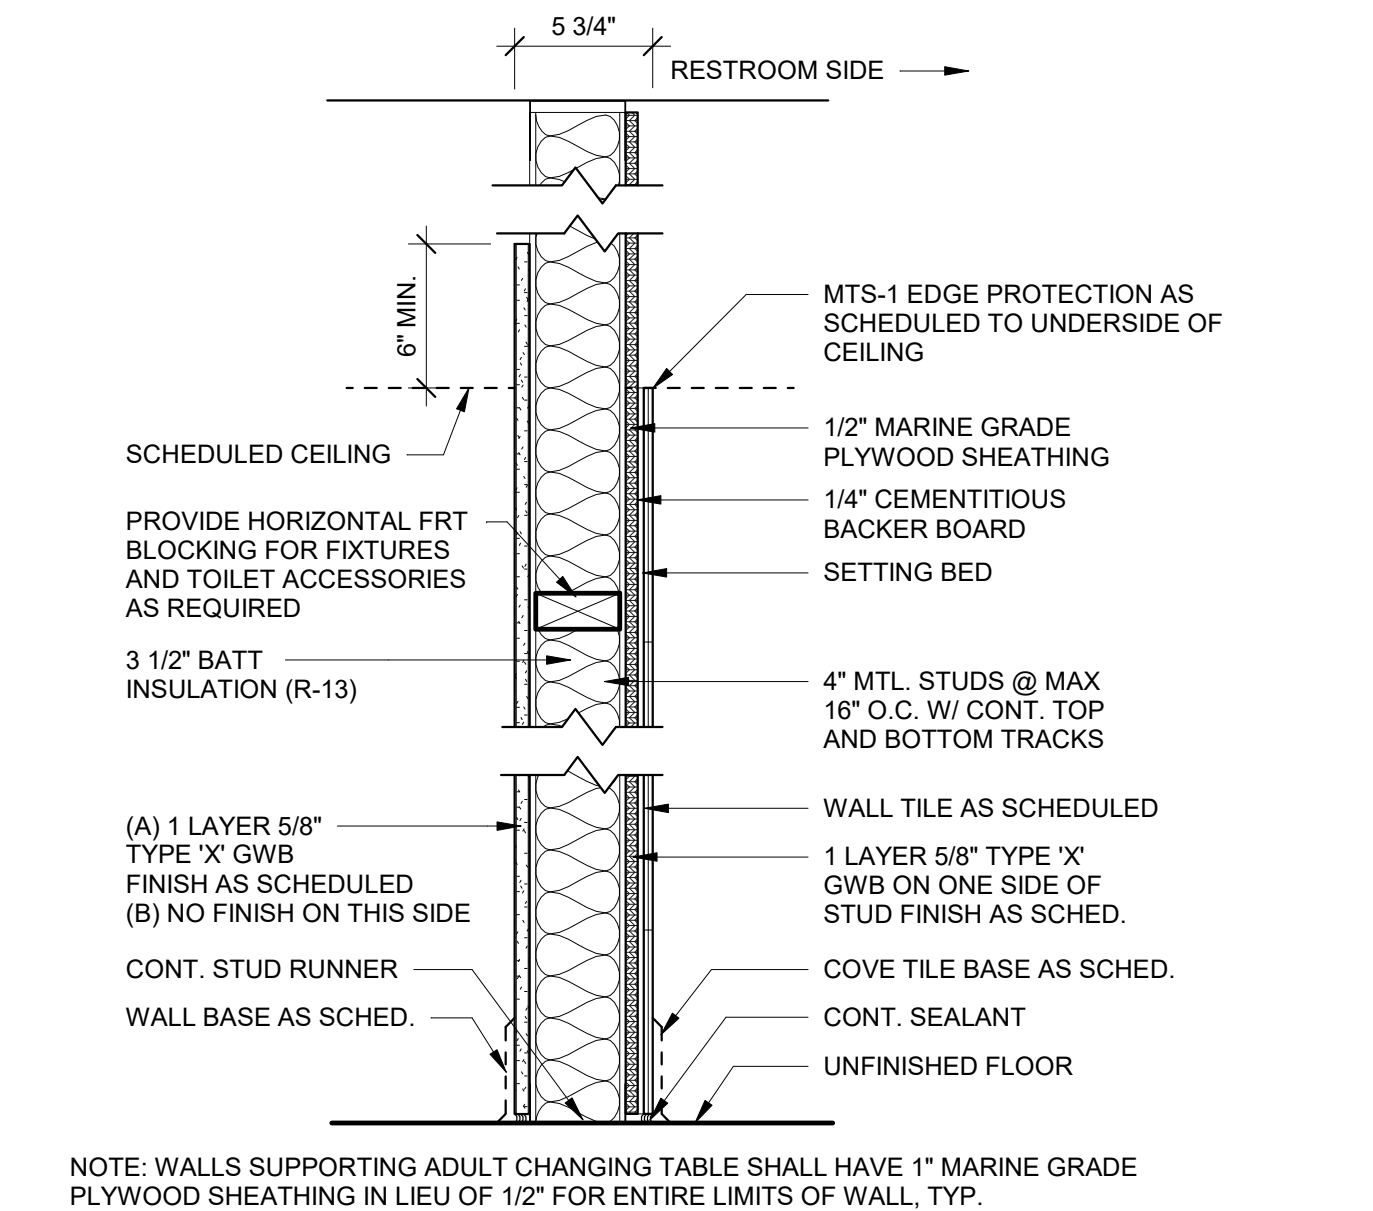


**G-03 A/B**

FIRE RATING	ASSEMBLY NO.	STC	STC. TEST #
0 HR	N/A	N/A	N/A

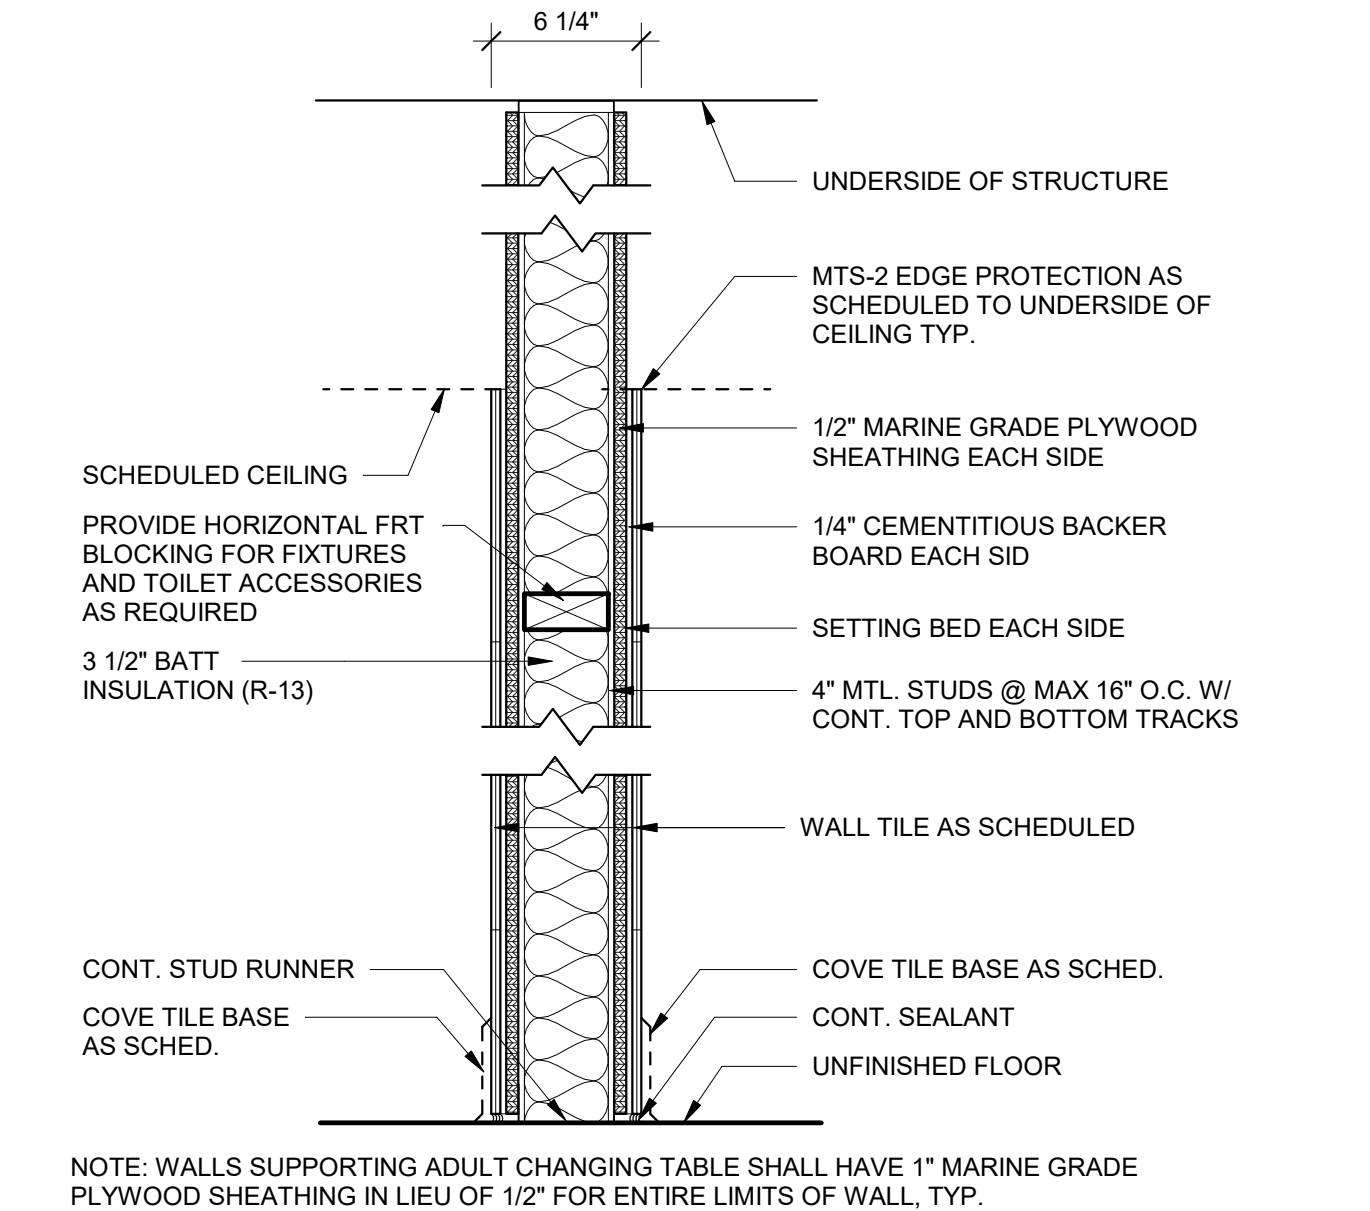

**G-04**

FIRE RATING	ASSEMBLY NO.	STC	STC. TEST #
0 HR	N/A	N/A	N/A

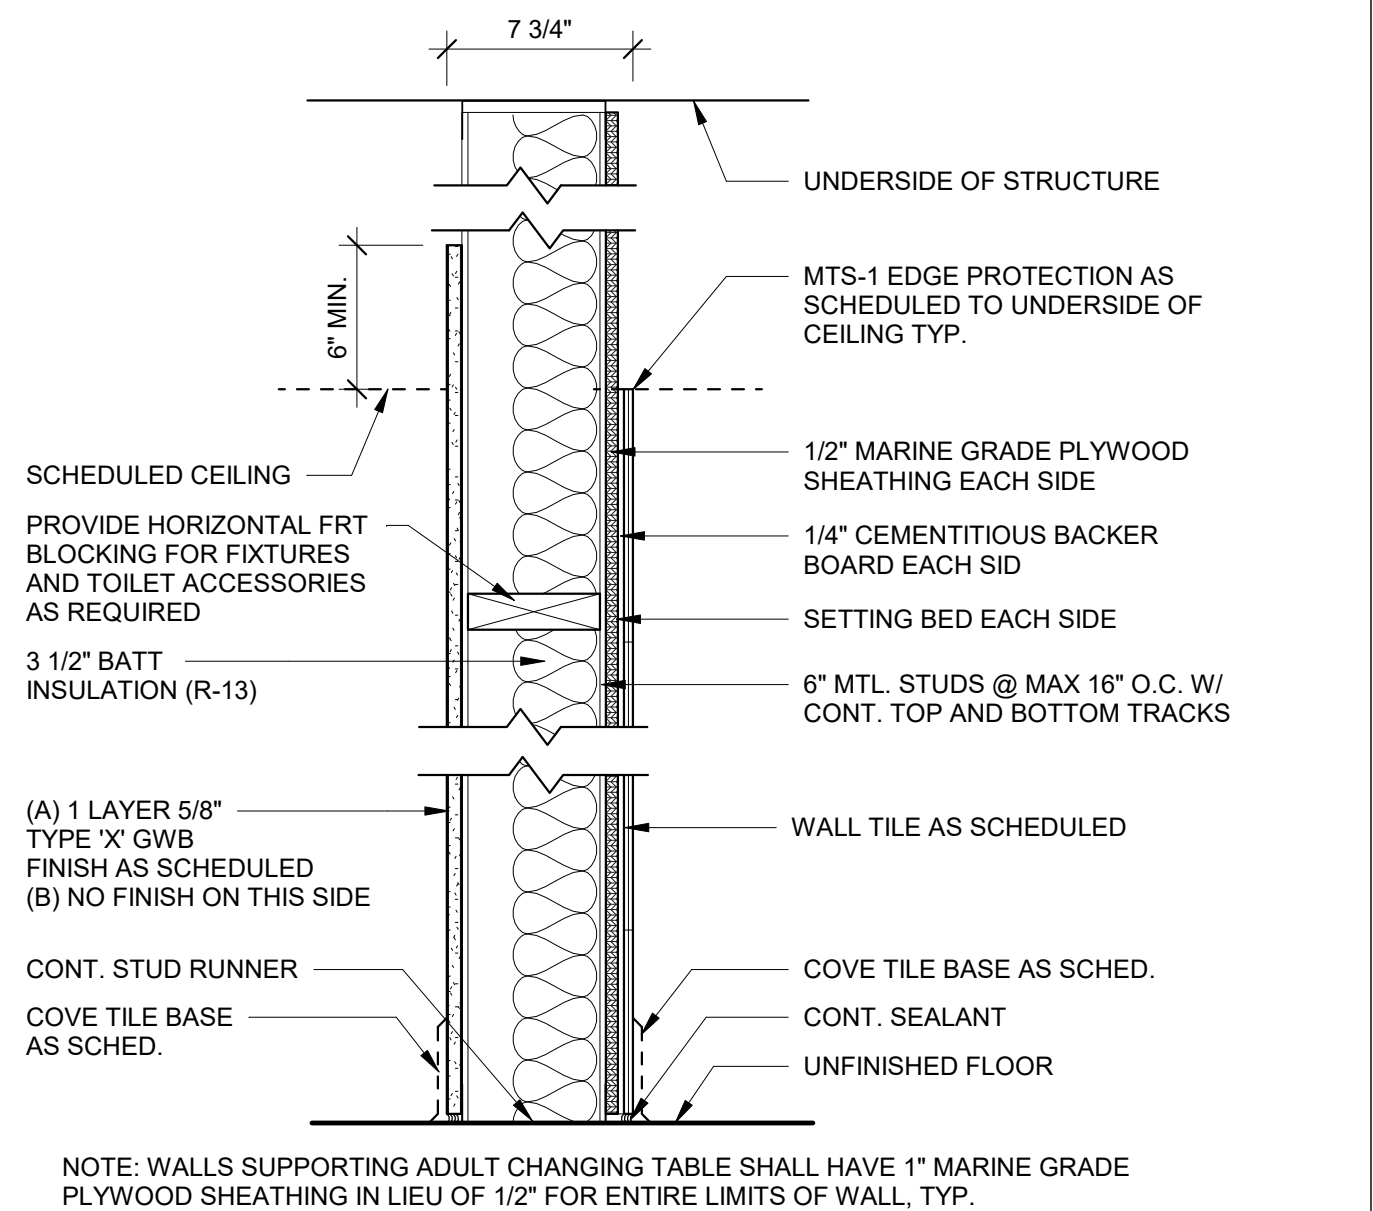


**G-05 A/B**

FIRE RATING	ASSEMBLY NO.	STC	STC. TEST #
0 HR	N/A	N/A	N/A



# TERMINAL IMPROVEMENTS CONTRACT 3

Wilmington International Airport  
1740 Airport Boulevard, Suite 12  
Wilmington, NC 28405

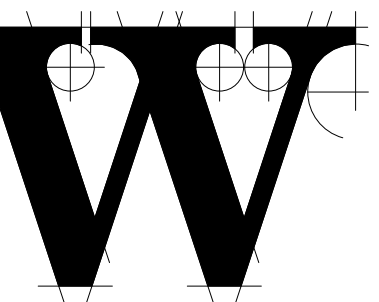

## THE WILSON GROUP ARCHITECTS - ARCHITECTS -

PO Box 5510 Charlotte, NC 28299  
704-331-9747 • www.twgarchitects.com

### PROJECT MANAGER & CIVIL ENGINEER

TALBERT & BRIGHT  
CONSULTING ARCHITECT  
LS3P

STRUCTURAL ENGINEER  
STEWART

FP/PI/E ENGINEER  
CHEATHAM & ASSOC.

BAGGAGE HANDLING CONSULTANTS  
BNP

AIRCRAFT SUPPORT SYSTEMS  
DK CONSULTANTS

SPECIALTY LIGHTING CONSULTANT  
HARTRANFT

SIGNAGE & WAYFINDING  
TAKEFORM

COPYRIGHT © 2019  
THE WILSON GROUP ARCHITECTS  
ALL RIGHTS RESERVED

PRINTED OR ELECTRONIC DRAWINGS AND  
INFORMATION MAY NOT BE REPRODUCED IN  
ANY FORM WITHOUT WRITTEN PERMISSION  
FROM THE WILSON GROUP ARCHITECTS

### REVISIONS

1 7/30/2019 AD-03

DATE 6/28/2019  
PROJECT NUMBER 9202-000  
SHEET TITLE


## LIFE SAFETY - RAMP LEVEL

SHEET NUMBER

# LS-001

Occupancy Area Legend	
	Accessory Storage Areas, Mech Equip Room (gross)
	Airport Terminal Baggage Handling (gross)
	Airport Terminal Concourse (gross)
	Business Areas (gross)
	Incidental
	Mercantile - Storage, Stock, Shipping Areas (gross)
	N/A

Life Safety Area Schedule - Ramp Level						
Number	Name	Area OCC Type	Area	Area Per Occupant	Calculated Occupant Load	
<b>RAMP LEVEL</b>						
2	OPEN AREA - ZONE 1	N/A	9,121 SF	0 SF	0	
2A	WORK STATIONS	Business Areas (gross)	1,495 SF	100 SF	15	
3	OPEN AREA - ZONE 2	N/A	10,853 SF	0 SF	0	
3A	OFFICE	Business Areas (gross)	297 SF	100 SF	3	
4	OFFICE	Business Areas (gross)	386 SF	100 SF	4	
5	OFFICE	Business Areas (gross)	265 SF	100 SF	3	
6	Area	Accessory Storage Areas, Mech Equip Room (gross)	837 SF	300 SF	3	
7	Area	Accessory Storage Areas, Mech Equip Room (gross)	191 SF	300 SF	1	
8	Area	Business Areas (gross)	263 SF	100 SF	3	
13	Area	Airport Terminal Concourse (gross)	472 SF	100 SF	5	
19	OFFICE	Business Areas (gross)	241 SF	100 SF	3	
20	ROOM	Business Areas (gross)	241 SF	100 SF	3	
21	STORAGE	Accessory Storage Areas, Mech Equip Room (gross)	45 SF	300 SF	1	
22	ELEV 5	Incidental	79 SF	0 SF	0	
23	BAG HANDLING	Airport Terminal Baggage Handling (gross)	9,093 SF	300 SF	31	
24	EMR	Accessory Storage Areas, Mech Equip Room (gross)	84 SF	300 SF	1	
25	STAIR #2	Incidental	208 SF	0 SF	0	
26	ELEVATOR #2	Incidental	104 SF	0 SF	0	
27	CORRIDOR	Business Areas (gross)	437 SF	100 SF	5	
30	MEN'S LOCKER	Business Areas (gross)	590 SF	100 SF	6	
31	WOMEN'S LOCKER	Business Areas (gross)	572 SF	100 SF	6	
40	ELEVATOR #1	Incidental	104 SF	0 SF	0	
41	STAIR #1	Incidental	208 SF	0 SF	0	
43	BAG HANDLING	Airport Terminal Baggage Handling (gross)	8,437 SF	300 SF	29	
44	BAG HANDLING	Airport Terminal Baggage Handling (gross)	9,443 SF	300 SF	32	
45	MECHANICAL	Accessory Storage Areas, Mech Equip Room (gross)	1,721 SF	300 SF	6	
46	ELECTRICAL	Accessory Storage Areas, Mech Equip Room (gross)	828 SF	300 SF	3	
100	MECHANICAL	Accessory Storage Areas, Mech Equip Room (gross)	453 SF	300 SF	2	
101	ELECTRICAL	Accessory Storage Areas, Mech Equip Room (gross)	224 SF	300 SF	1	
101A	WOMEN	Business Areas (gross)	101 SF	100 SF	1	
102	MEN	Business Areas (gross)	93 SF	100 SF	1	
103	SUPPLY	Accessory Storage Areas, Mech Equip Room (gross)	45 SF	300 SF	1	
105	STORAGE	Accessory Storage Areas, Mech Equip Room (gross)	368 SF	300 SF	3	
106	STORAGE	Accessory Storage Areas, Mech Equip Room (gross)	838 SF	300 SF	3	
110	EMR	Accessory Storage Areas, Mech Equip Room (gross)	87 SF	300 SF	1	
118	CORRIDOR	Business Areas (gross)	1,973 SF	100 SF	20	
119	BUILDING MANAGEMENT	Business Areas (gross)	502 SF	100 SF	6	
120	ROOM	Business Areas (gross)	601 SF	100 SF	7	
121	STORAGE	Accessory Storage Areas, Mech Equip Room (gross)	242 SF	300 SF	1	
122	ROOM	Business Areas (gross)	373 SF	100 SF	4	
123	ROOM	Business Areas (gross)	169 SF	100 SF	2	
124	ROOM	Business Areas (gross)	169 SF	100 SF	2	
125	ROOM	Business Areas (gross)	332 SF	100 SF	4	
126	Area	Business Areas (gross)	706 SF	100 SF	8	
133	OVS	Incidental	109 SF	0 SF	0	
140	ROOM	Business Areas (gross)	203 SF	100 SF	3	
212	ELEV 4	Incidental	79 SF	0 SF	0	
214	Area	Incidental	214 SF	0 SF	0	
215	Area	Incidental	214 SF	0 SF	0	
A21	WOMEN	Business Areas (gross)	154 SF	100 SF	2	
A22	MEN	Business Areas (gross)	154 SF	100 SF	2	
A23	STORAGE	Accessory Storage Areas, Mech Equip Room (gross)	135 SF	300 SF	1	
A24	EMR	Accessory Storage Areas, Mech Equip Room (gross)	225 SF	0 SF	0	
A25	BREAK	Business Areas (gross)	339 SF	100 SF	4	
A26	OFFICE	Business Areas (gross)	422 SF	100 SF	5	
A28	CORRIDOR	Business Areas (gross)	714 SF	100 SF	8	
A29	OFFICE	Business Areas (gross)	322 SF	100 SF	4	
A30	OFFICE	Accessory Storage Areas, Mech Equip Room (gross)	132 SF	300 SF	1	
A31	ELECTRICAL	Accessory Storage Areas, Mech Equip Room (gross)	80 SF	300 SF	1	
A107	MECHANICAL	Accessory Storage Areas, Mech Equip Room (gross)	360 SF	300 SF	2	
A1101	MECHANICAL	Business Areas (gross)	3,296 SF	100 SF	33	
A1104	MECHANICAL	Accessory Storage Areas, Mech Equip Room (gross)	3,061 SF	300 SF	11	
A1105	MECHANICAL	Accessory Storage Areas, Mech Equip Room (gross)	1,474 SF	300 SF	5	
A1106	STAIR 6	Incidental	523 SF	0 SF	0	
A1107	STAIR 7	Incidental	525 SF	0 SF	0	
A1109	CORRIDOR	Business Areas (gross)	591 SF	100 SF	6	
A1110	ELECTRICAL	Accessory Storage Areas, Mech Equip Room (gross)	598 SF	300 SF	2	
A1111	MECHANICAL	Accessory Storage Areas, Mech Equip Room (gross)	1,414 SF	300 SF	5	
A1112	IT	Accessory Storage Areas, Mech Equip Room (gross)	520 SF	300 SF	2	
A1113	MECHANICAL	Accessory Storage Areas, Mech Equip Room (gross)	2,613 SF	300 SF	9	
A1115	PEV ENTRY	Business Areas (gross)	271 SF	100 SF	3	
A1116	ELEV 6	Incidental	214 SF	0 SF	0	
A1117	CONCESSIONS ENTRY	Mercantile - Storage, Stock, Shipping Areas (gross)	130 SF	300 SF	1	
A1118	EMR	Accessory Storage Areas, Mech Equip Room (gross)	69 SF	300 SF	1	
A1120	AIRLINE	Business Areas (gross)	5,689 SF	100 SF	57	
A1132	RETAIL STORAGE	Mercantile - Storage, Stock, Shipping Areas (gross)	1,569 SF	300 SF	6	
A1134	AIRLINE	Mercantile - Storage, Stock, Shipping Areas (gross)	388 SF	300 SF	2	
A1135	AIRLINE	Mercantile - Storage, Stock, Shipping Areas (gross)	465 SF	300 SF	2	
AA1130	RETAIL	Mercantile - Storage, Stock, Shipping Areas (gross)	574 SF	300 SF	2	
<b>TOTALS:</b>					<b>91,659 SF</b>	<b>410</b>

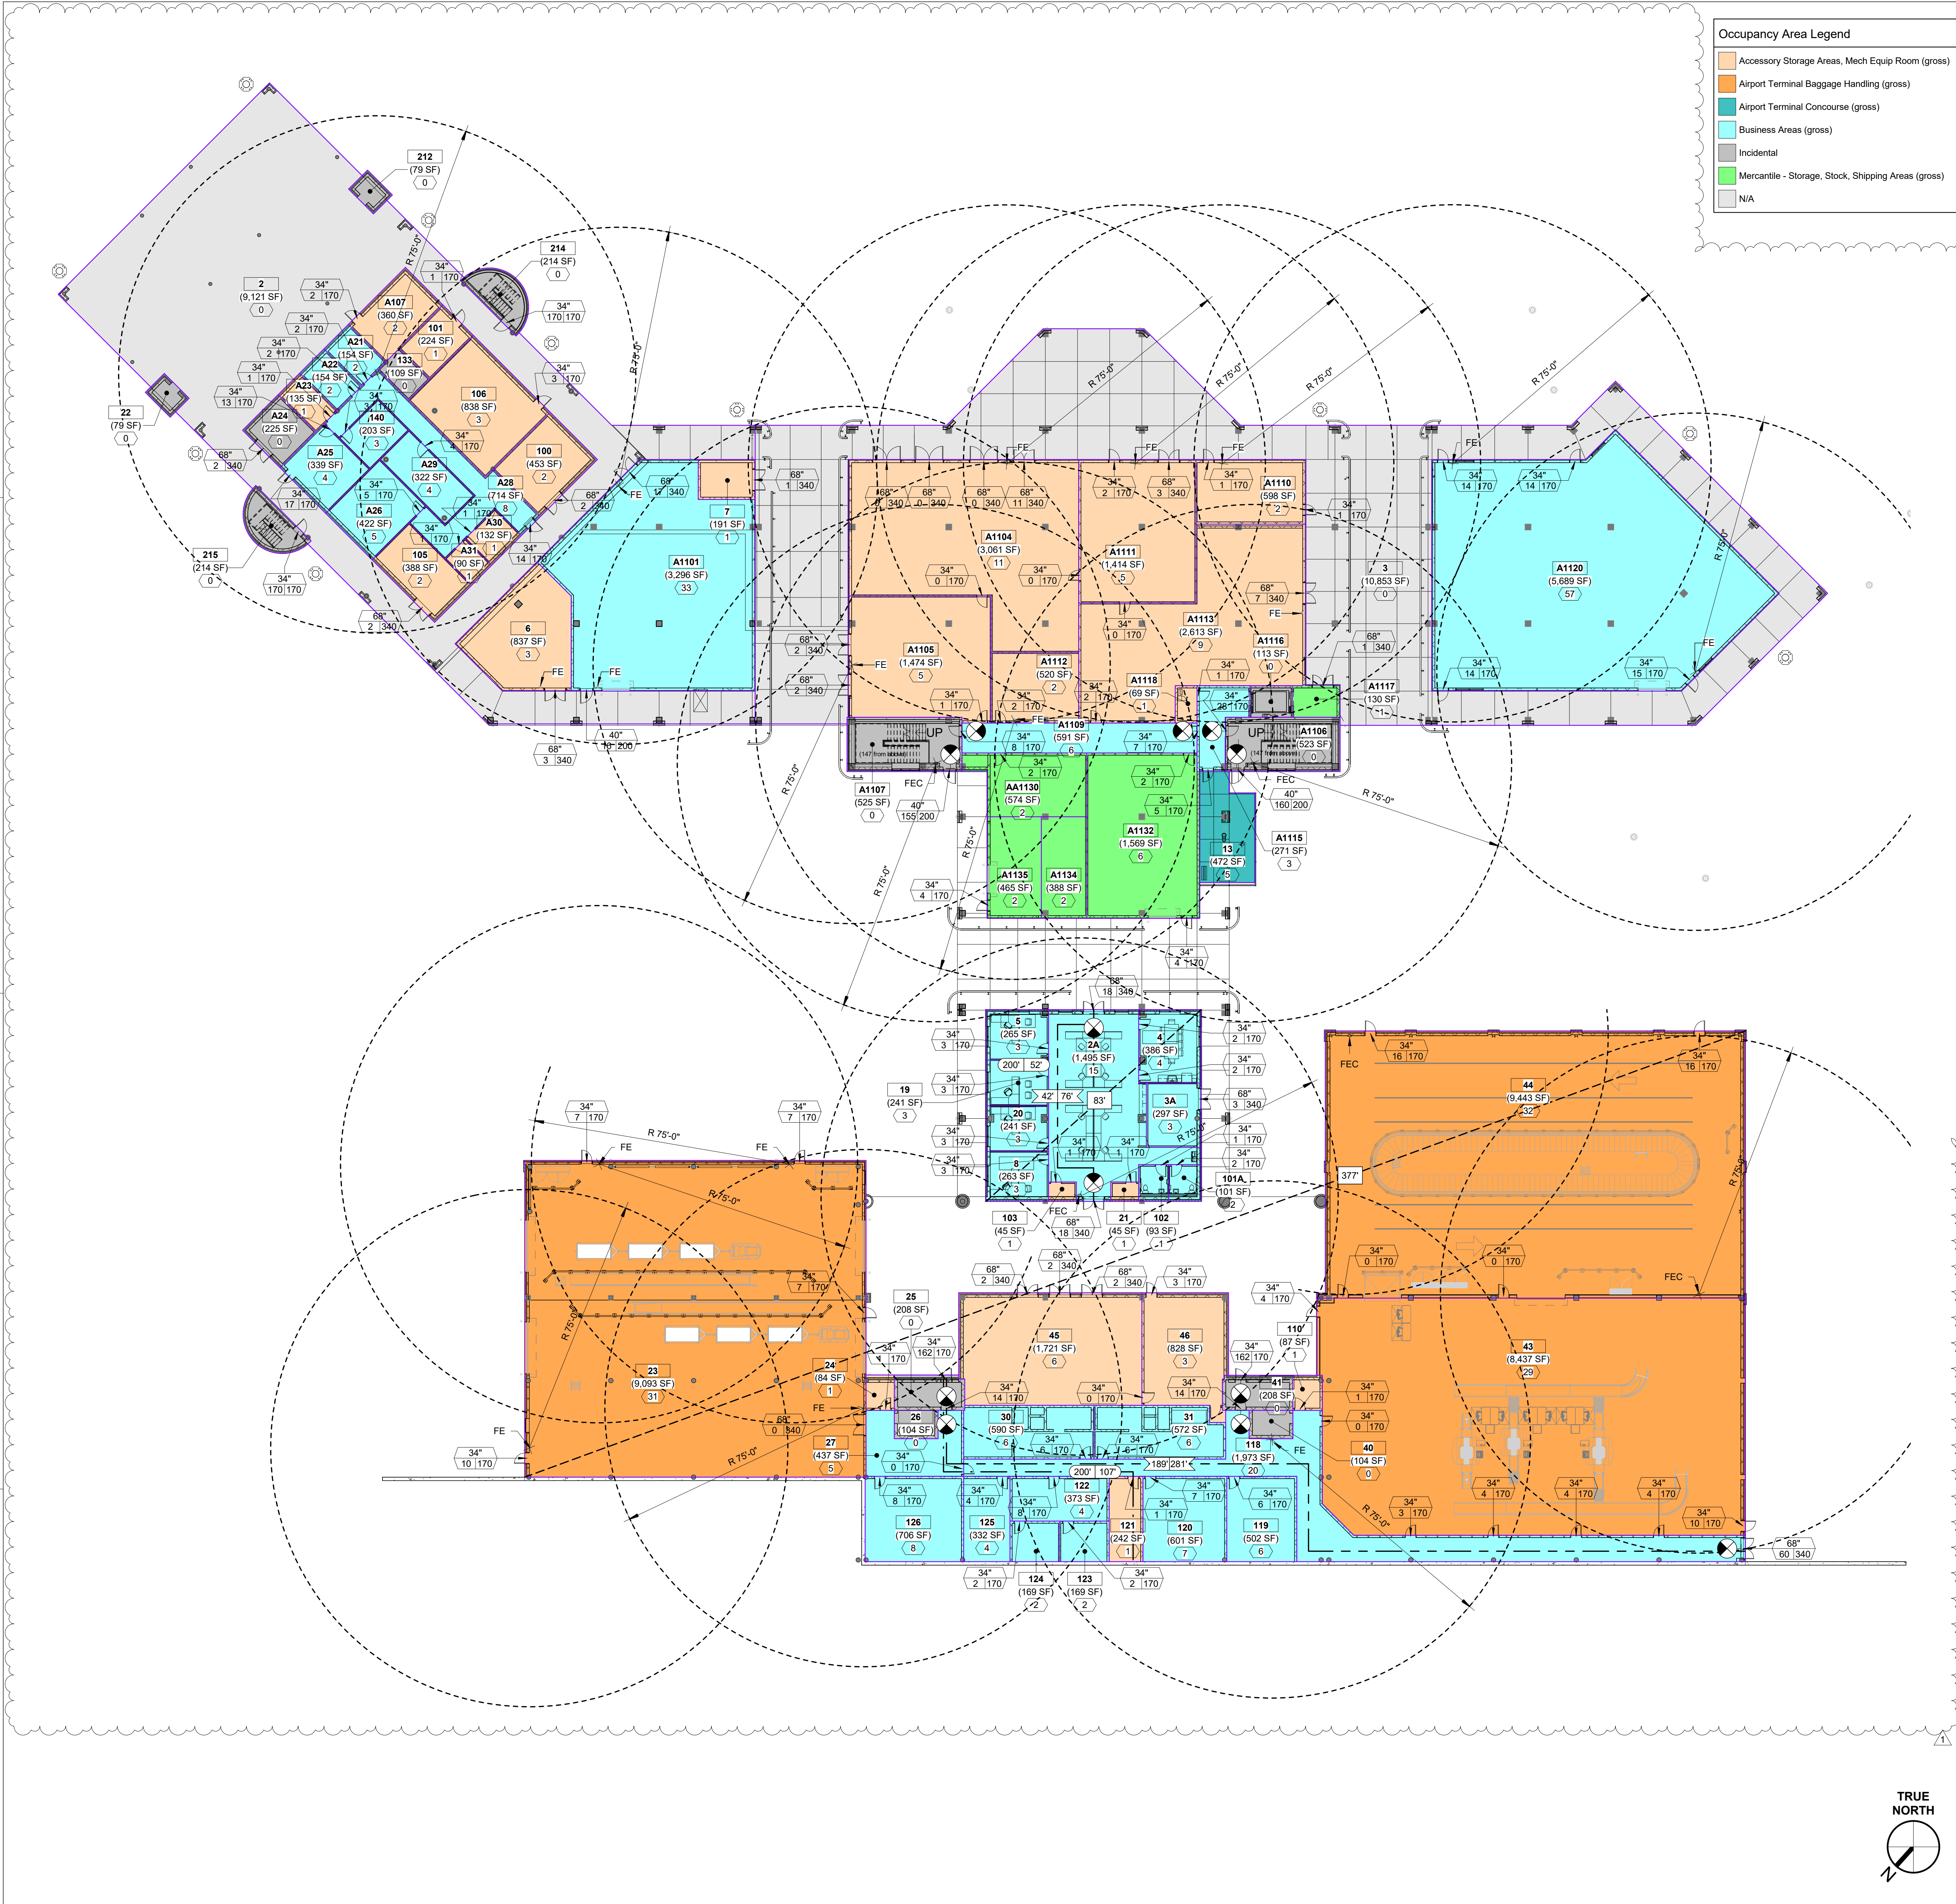


LIFE SAFETY PLAN LEGEND	
ROOM TAG	ROOM NAME → Room name ROOM AREA → (99,999 SF) (999) → NUMBER OF OCCUPANTS
EXIT WIDTH	ACTUAL CLEAR INCHES → 34" / 888/888 ACTUAL OCCUPANTS → MAX OCCUPANTS
MAXIMUM AREA DIAGONAL	X
DISTANCE BETWEEN EXITS	REQUIRED > X' < ACTUAL
EXIT ACCESS TRAVEL DISTANCE	ALLOWABLE (X' X') ACTUAL
EXIT SIGN	COORDINATE LOCATIONS AND REQUIREMENTS W/ ELECTRICAL DRAWINGS
FEC	4A.80B.C FIRE EXTINGUISHER IN FIRE EXTINGUISHER CABINET 4A.80B.C WALL-MOUNTED FIRE EXTINGUISHER

1 RAMP LEVEL LIFE SAFETY PLAN  
1" = 20'-0"



**TERMINAL IMPROVEMENTS CONTRACT 3**  
Wilmington International Airport  
1740 Airport Boulevard, Suite 12  
Wilmington, NC 28405

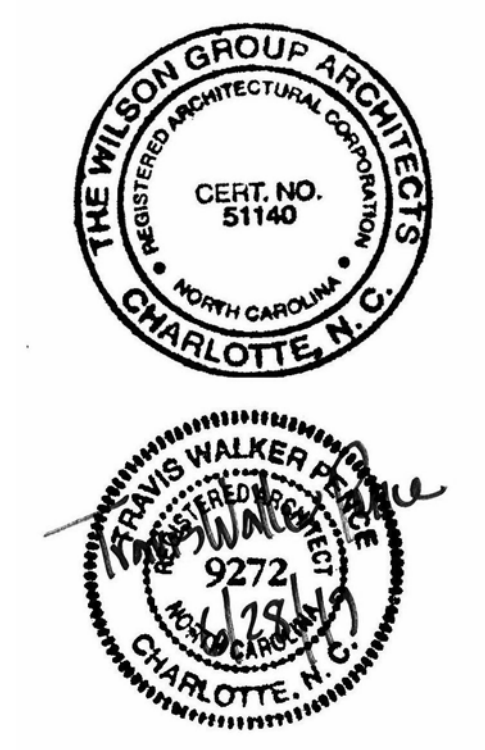

**THE WILSON GROUP ARCHITECTS**  
- ARCHITECTS -  
PO Box 5510 Charlotte, NC 28299  
704-331-9747 • www.twgarchitects.com

- PROJECT MANAGER & CIVIL ENGINEER  
**TALBERT & BRIGHT**  
CONSULTING ARCHITECT  
**LS3P**
- STRUCTURAL ENGINEER  
**STEWART**
- FP/PI/E ENGINEER  
**CHEATHAM & ASSOC.**
- BAGGAGE HANDLING CONSULTANTS  
**BNP**
- AIRCRAFT SUPPORT SYSTEMS  
**DK CONSULTANTS**
- SPECIALTY LIGHTING CONSULTANT  
**HARTRANFT**
- SIGNAGE & WAYFINDING  
**TAKEFORM**


COPYRIGHT © 2019  
THE WILSON GROUP ARCHITECTS  
ALL RIGHTS RESERVED

PRINTED OR ELECTRONIC DRAWINGS AND DOCUMENTATION MAY NOT BE REPRODUCED IN ANY FORM WITHOUT WRITTEN PERMISSION FROM THE WILSON GROUP ARCHITECTS


REVISIONS  
1 7/30/2019 AD-03

DATE 6/28/2019  
PROJECT NUMBER 9202-000  
SHEET TITLE  
**LIFE SAFETY  
TICKET /  
BOARDING LEVEL**

SHEET NUMBER  
**LS-002**

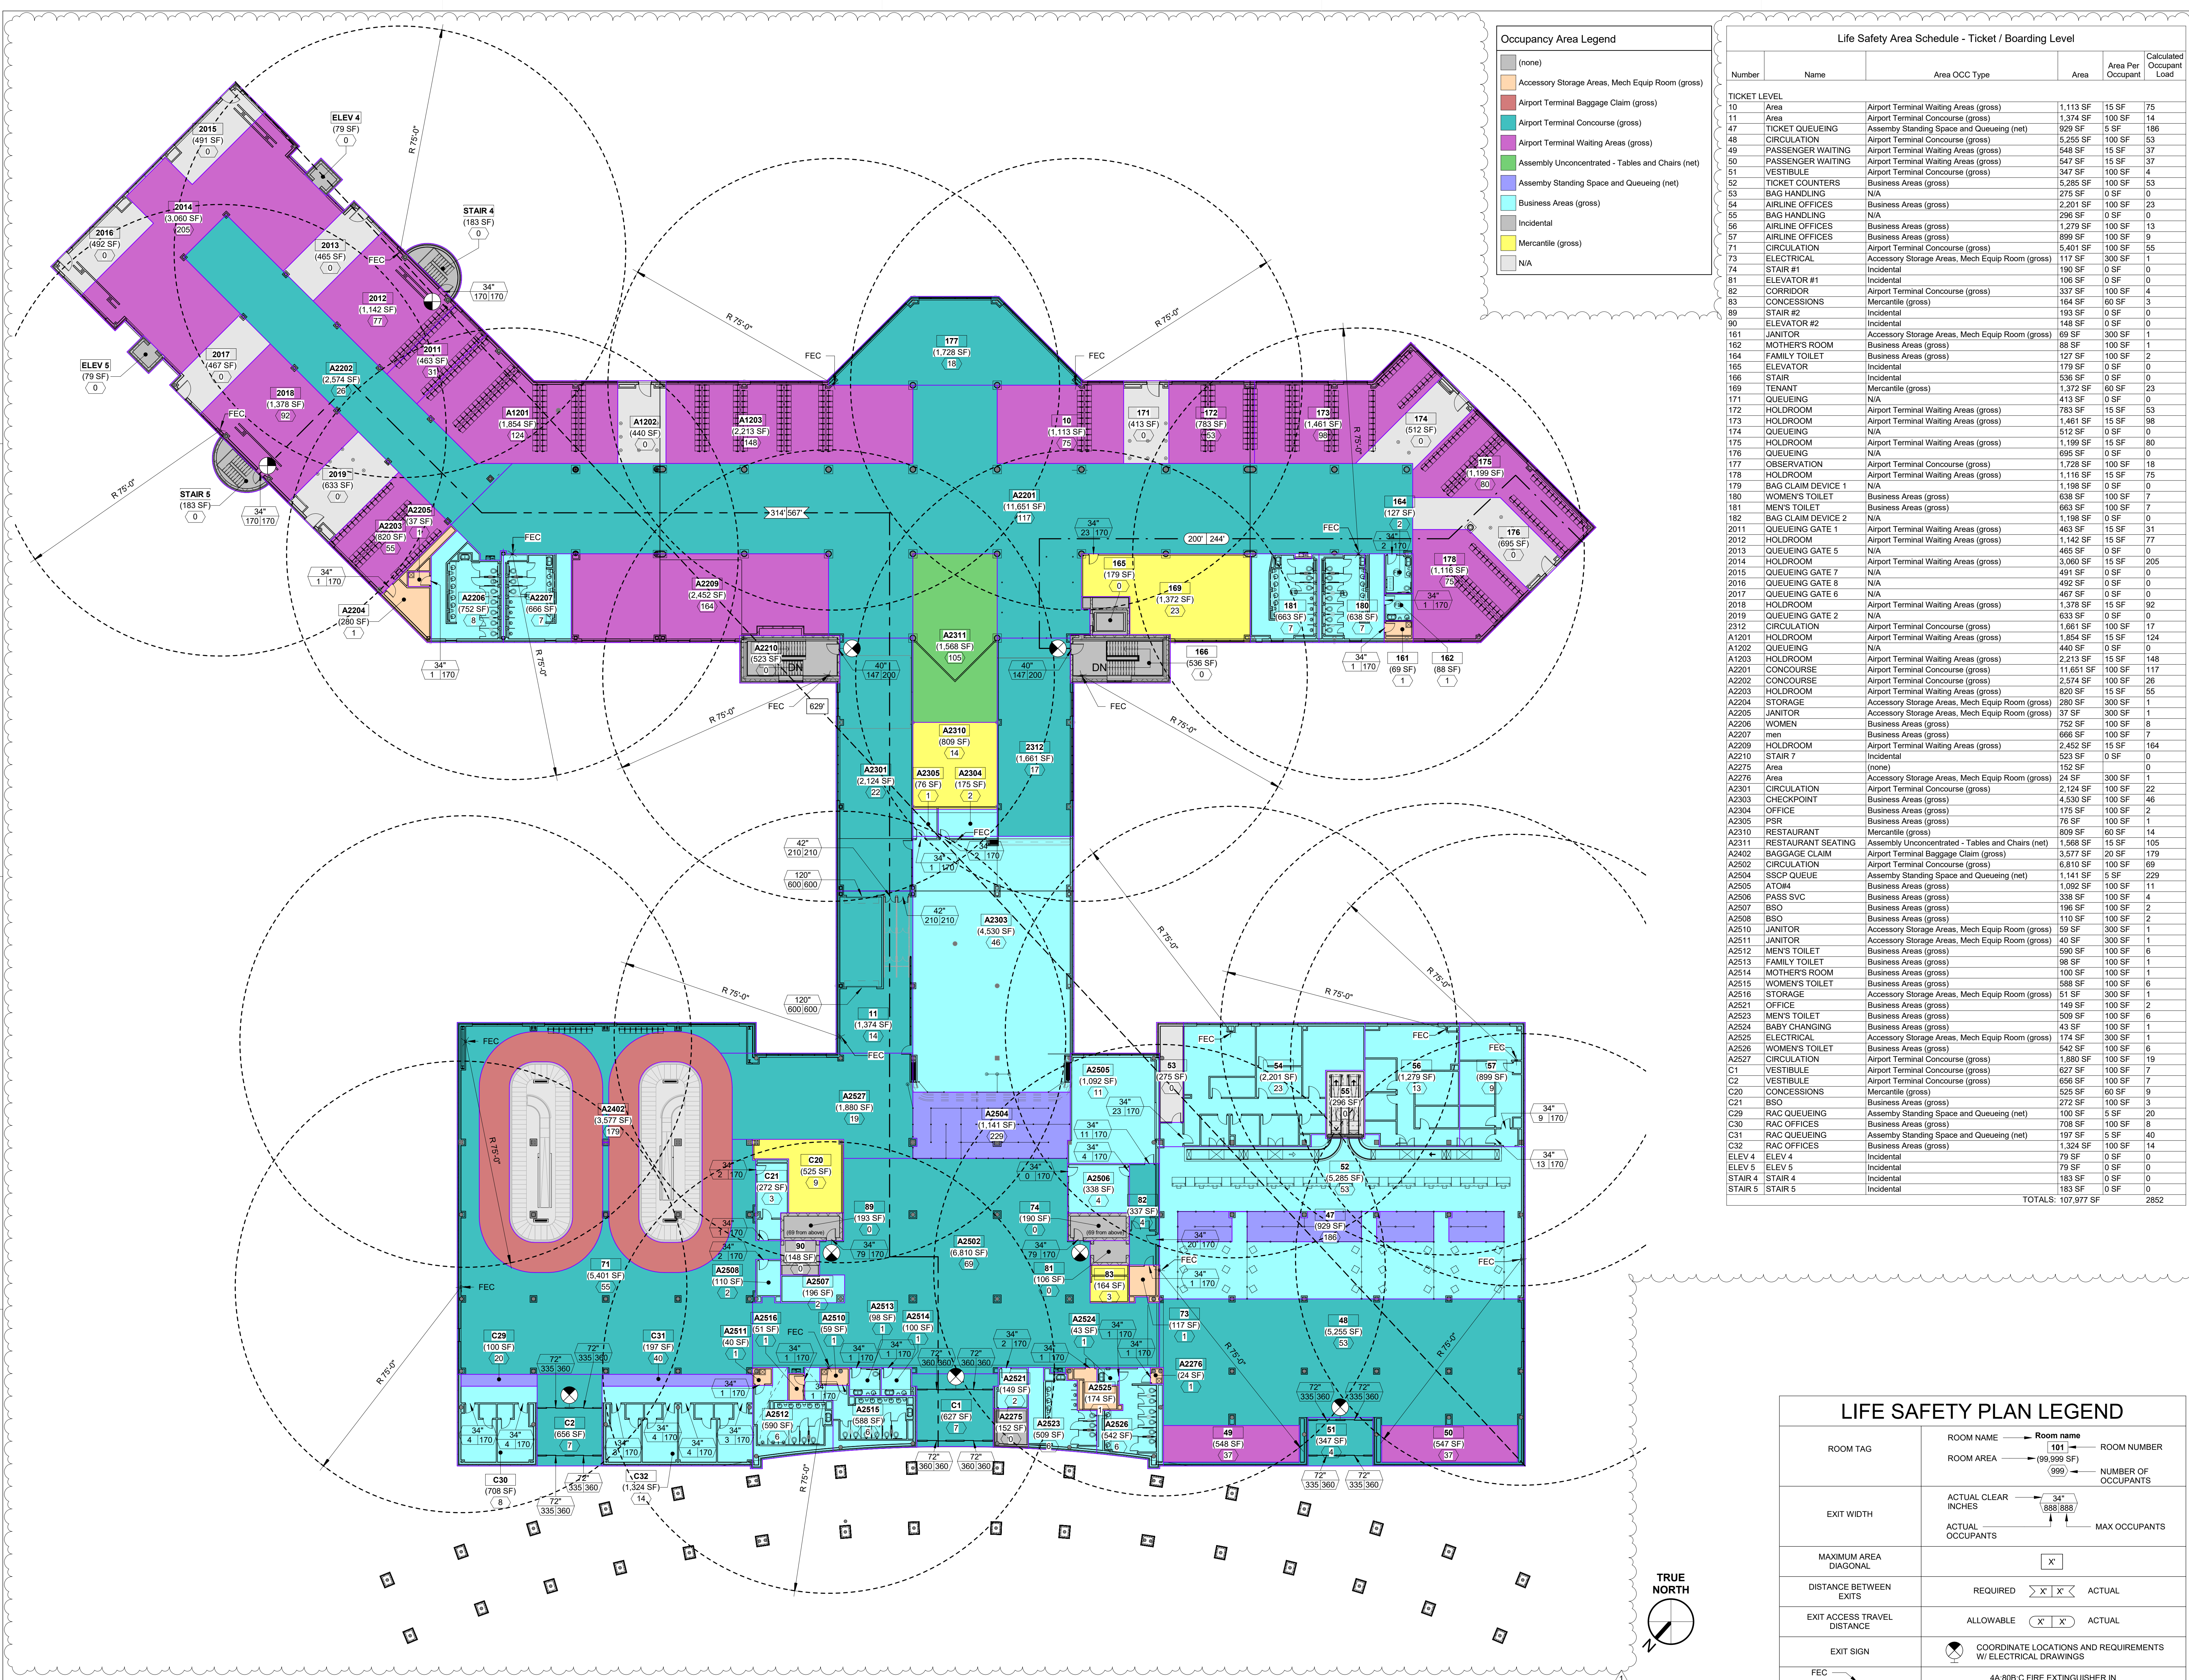

1 TICKET / BOARDING LEVEL LIFE SAFETY PLAN  
1" = 20'-0"

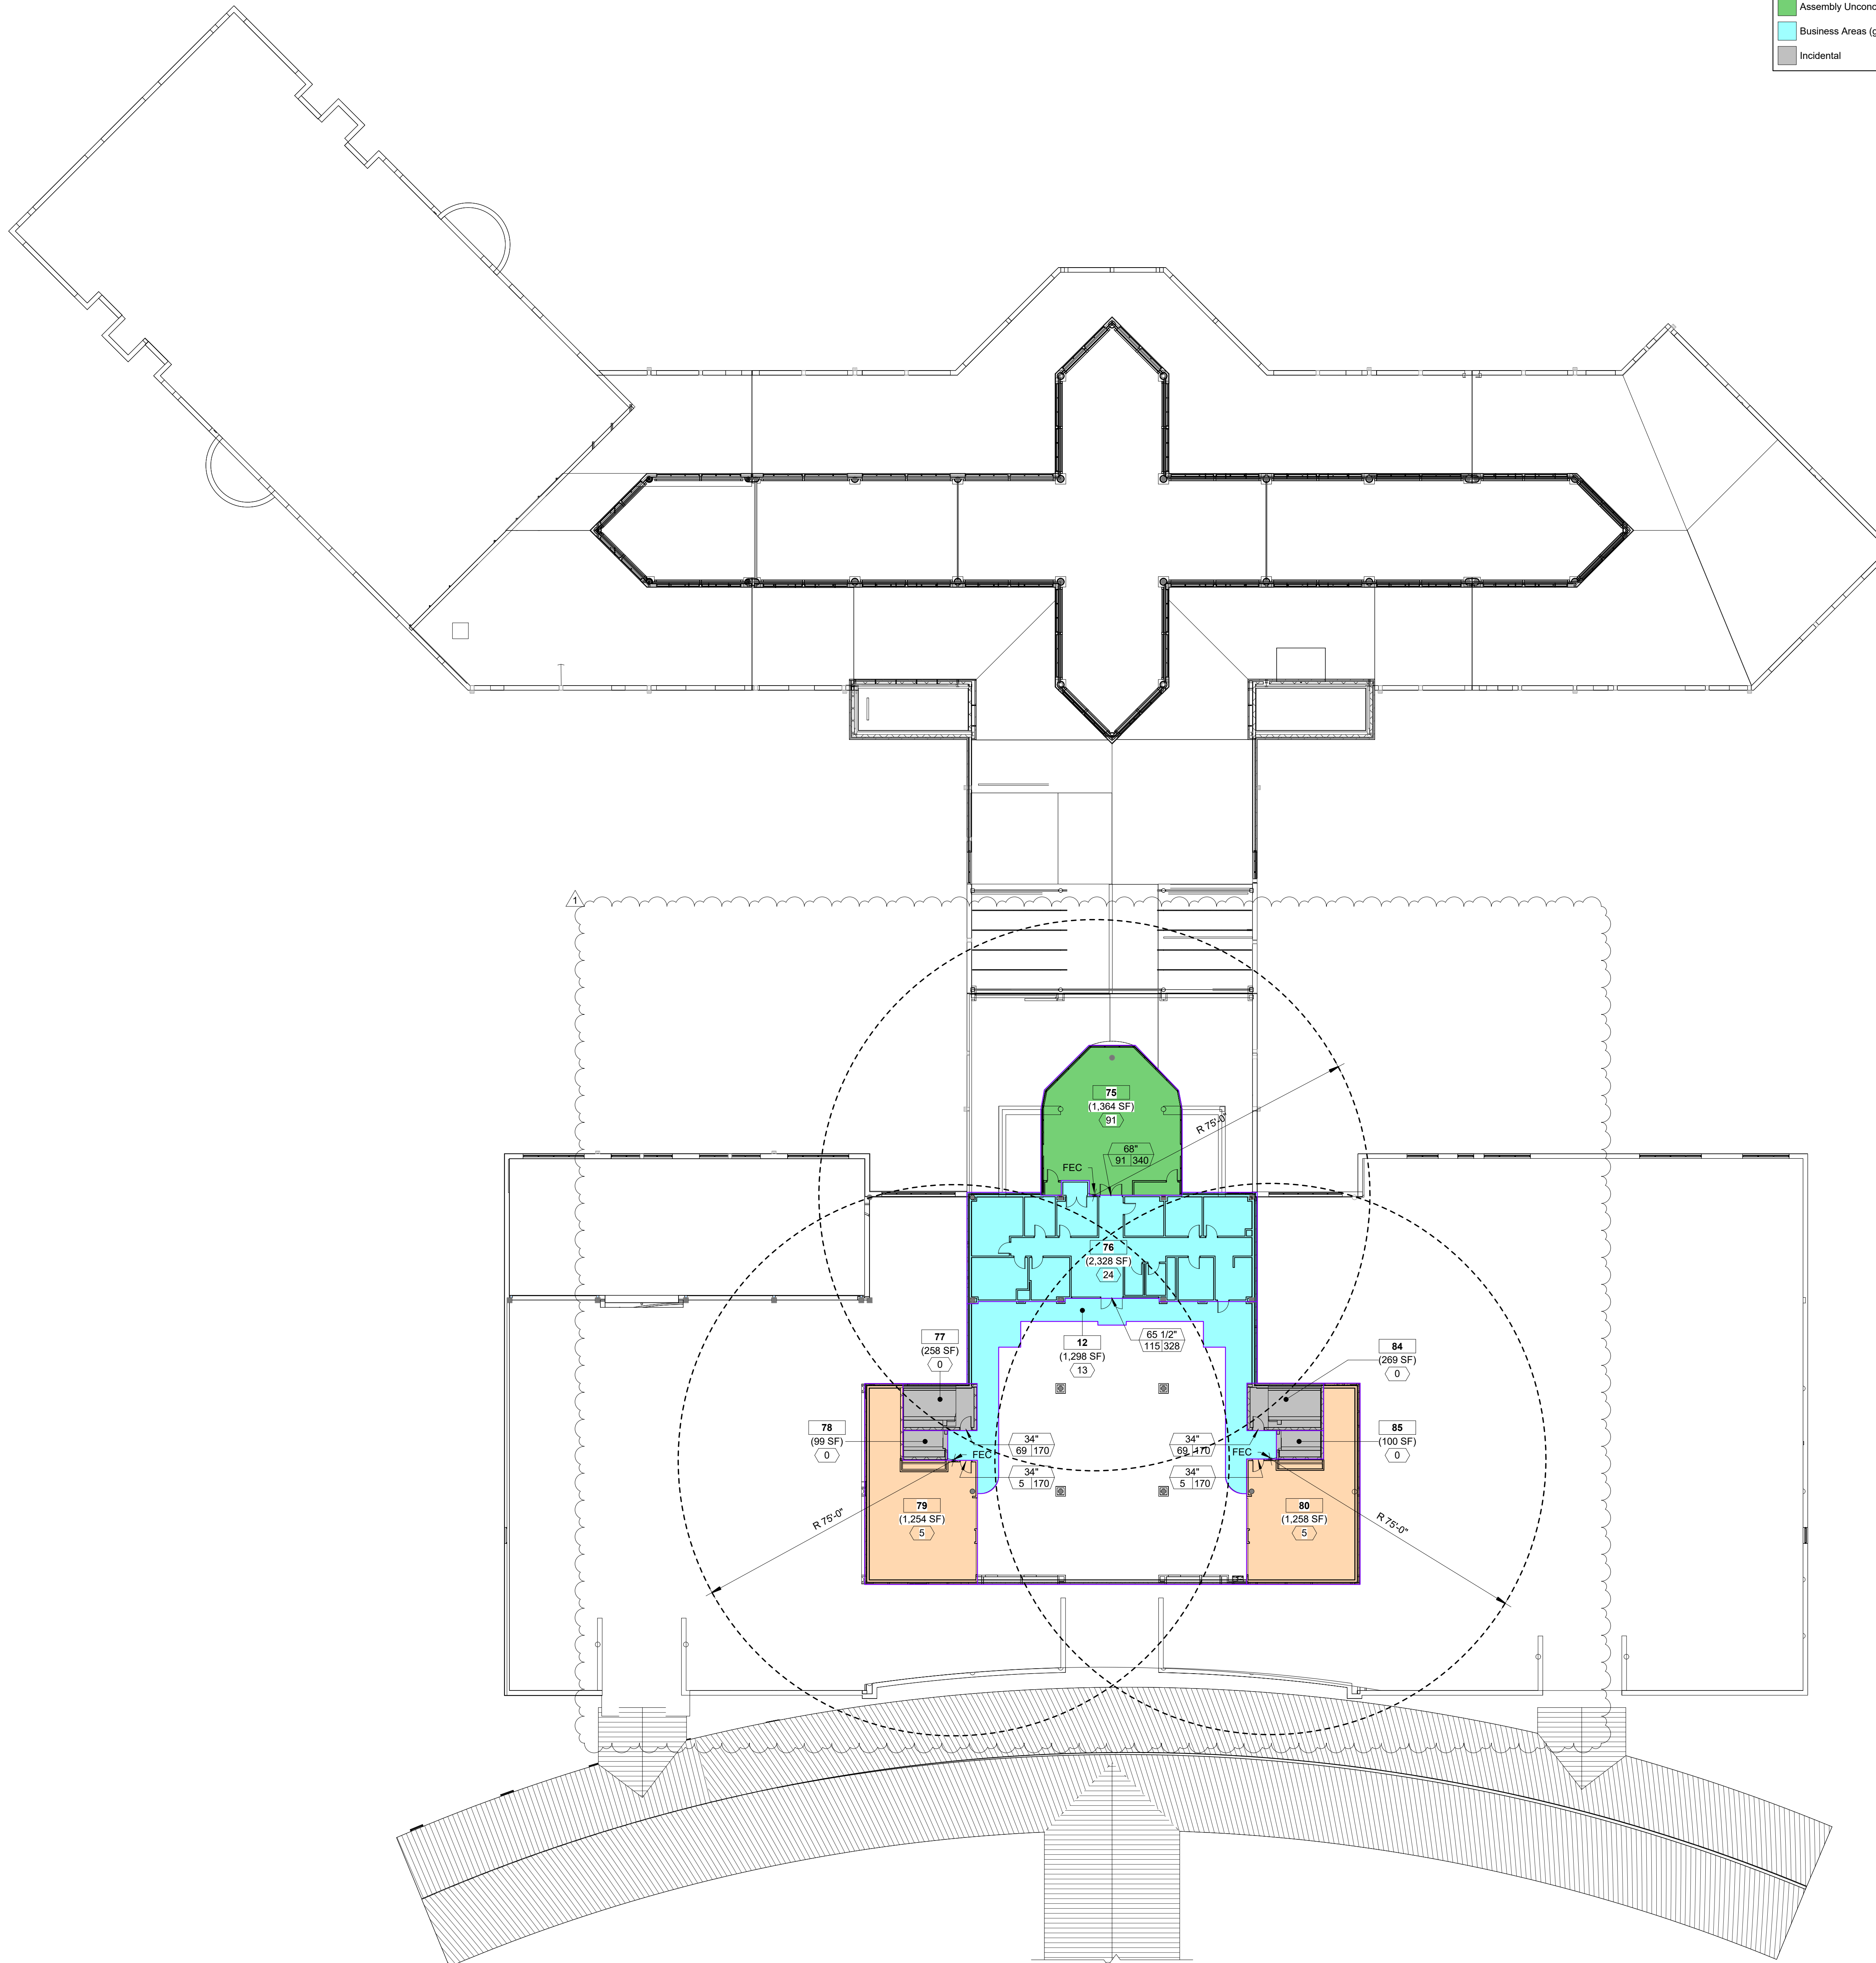

Occupancy Area Legend	
<span style="background-color: #f4a460; border: 1px solid black; display: inline-block; width: 10px; height: 10px;"></span>	Accessory Storage Areas, Mech Equip Room (gross)
<span style="background-color: #90ee90; border: 1px solid black; display: inline-block; width: 10px; height: 10px;"></span>	Assembly Unconcentrated - Tables and Chairs (net)
<span style="background-color: #add8e6; border: 1px solid black; display: inline-block; width: 10px; height: 10px;"></span>	Business Areas (gross)
<span style="background-color: #cccccc; border: 1px solid black; display: inline-block; width: 10px; height: 10px;"></span>	Incidental


Life Safety Area Schedule - Admin Level					
Number	Name	Area OCC Type	Area	Area Per Occupant	Calculated Occupant Load
ADMIN LEVEL					
12	Area	Business Areas (gross)	1,298 SF	100 SF	13
75	CONFERENCE ROOM	Assembly Unconcentrated - Tables and Chairs (net)	1,364 SF	15 SF	91
76	ADMIN AREA	Business Areas (gross)	2,328 SF	100 SF	24
77	STAIR #2	Incidental	258 SF	0 SF	0
78	ELEVATOR #2	Incidental	99 SF	0 SF	0
79	MECHANICAL	Accessory Storage Areas, Mech Equip Room (gross)	1,254 SF	300 SF	5
80	MECHANICAL	Accessory Storage Areas, Mech Equip Room (gross)	1,258 SF	300 SF	5
84	STAIR #1	Incidental	269 SF	0 SF	0
85	ELEVATOR #1	Incidental	100 SF	0 SF	0
TOTALS:			8,226 SF		138

1 ADMIN LEVEL LIFE SAFETY PLAN  
1" = 20'-0"



**TERMINAL IMPROVEMENTS CONTRACT 3**

Wilmington International Airport  
1740 Airport Boulevard, Suite 12  
Wilmington, NC 28405

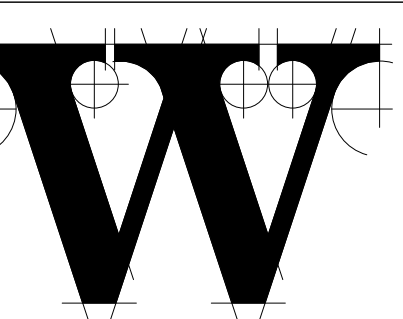

**THE WILSON GROUP - ARCHITECTS -**

PO Box 5510 Charlotte, NC 28299  
704-331-9747 • www.twgarchitects.com

PROJECT MANAGER & CIVIL ENGINEER  
**TALBERT & BRIGHT**  
CONSULTING ARCHITECT  
LS3P

STRUCTURAL ENGINEER  
**STEWART**

FP/PM/E ENGINEER  
**CHEATHAM & ASSOC.**

BAGGAGE HANDLING CONSULTANTS  
**BNP**

AIRCRAFT SUPPORT SYSTEMS  
**DK CONSULTANTS**

SPECIALTY LIGHTING CONSULTANT  
**HARTRANFT**

SIGNAGE & WAYFINDING  
**TAKEFORM**

COPYRIGHT © 2019  
THE WILSON GROUP ARCHITECTS  
ALL RIGHTS RESERVED  
PRINTED OR ELECTRONIC DRAWINGS AND DOCUMENTATION MAY NOT BE REPRODUCED IN ANY FORM WITHOUT WRITTEN PERMISSION FROM THE WILSON GROUP ARCHITECTS

REVISIONS  
1 7/30/2019 AD-03

LIFE SAFETY PLAN LEGEND	
ROOM TAG	ROOM NAME → Room name ROOM AREA → (99,999 SF) (999) → NUMBER OF OCCUPANTS
EXIT WIDTH	ACTUAL CLEAR INCHES → 34" 888/888 ACTUAL OCCUPANTS → MAX OCCUPANTS
MAXIMUM AREA DIAGONAL	X'
DISTANCE BETWEEN EXITS	REQUIRED > X' < ACTUAL
EXIT ACCESS TRAVEL DISTANCE	ALLOWABLE X' X' ACTUAL
EXIT SIGN	COORDINATE LOCATIONS AND REQUIREMENTS W/ ELECTRICAL DRAWINGS
FEC	4A.80B.C FIRE EXTINGUISHER IN FIRE EXTINGUISHER CABINET
FE	4A.80B.C WALL-MOUNTED FIRE EXTINGUISHER

DATE 6/28/2019  
PROJECT NUMBER 9202-000  
SHEET TITLE

**LIFE SAFETY ADMIN LEVEL**


SHEET NUMBER  
**LS-003**



# TERMINAL IMPROVEMENTS CONTRACT 3

Wilmington International Airport  
1740 Airport Boulevard, Suite 12  
Wilmington, NC 28405

TALBERT & BRIGHT, INC.  
4810 SHELLEY DRIVE  
WILMINGTON, NC 28405  
NC C-0713

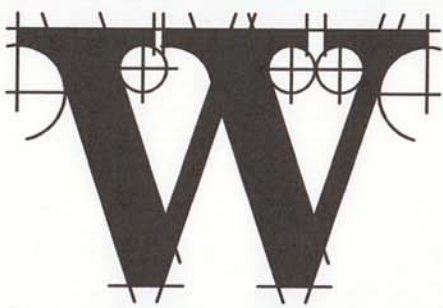

## THE WILSON GROUP - ARCHITECTS -

PO Box 5510 Charlotte, NC 28299  
704-331-9747 • www.twgarchitects.com

PROJECT MANAGER & CIVIL ENGINEER  
**TALBERT & BRIGHT**

CONSULTING ARCHITECT  
**LS3P**

STRUCTURAL ENGINEER  
**STEWART**


FF/PRIME ENGINEER  
**CHEATHAM & ASSOC.**

BAGGAGE HANDLING CONSULTANTS  
**BNP**

AIRCRAFT SUPPORT SYSTEMS  
**DK CONSULTANTS**

SPECIALTY LIGHTING CONSULTANT  
**HARTRANFT**

SIGNAGE & WAYFINDING  
**TAKEFORM**

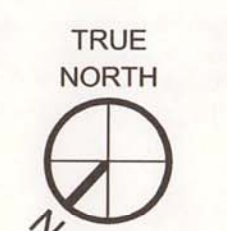

COPYRIGHT © 2019  
THE WILSON GROUP ARCHITECTS  
ALL RIGHTS RESERVED

PRINTED OR ELECTRONIC DRAWINGS AND DOCUMENTATION MAY NOT BE REPRODUCED IN ANY FORM WITHOUT WRITTEN PERMISSION FROM THE WILSON GROUP ARCHITECTS


### REVISIONS

7/22/19 AD-03

DATE 6/28/2019  
PROJECT NUMBER 9202-000  
SHEET TITLE

## OVERALL PROJECT SAFETY AND ACCESS PLAN

SHEET NUMBER  
**C-100**

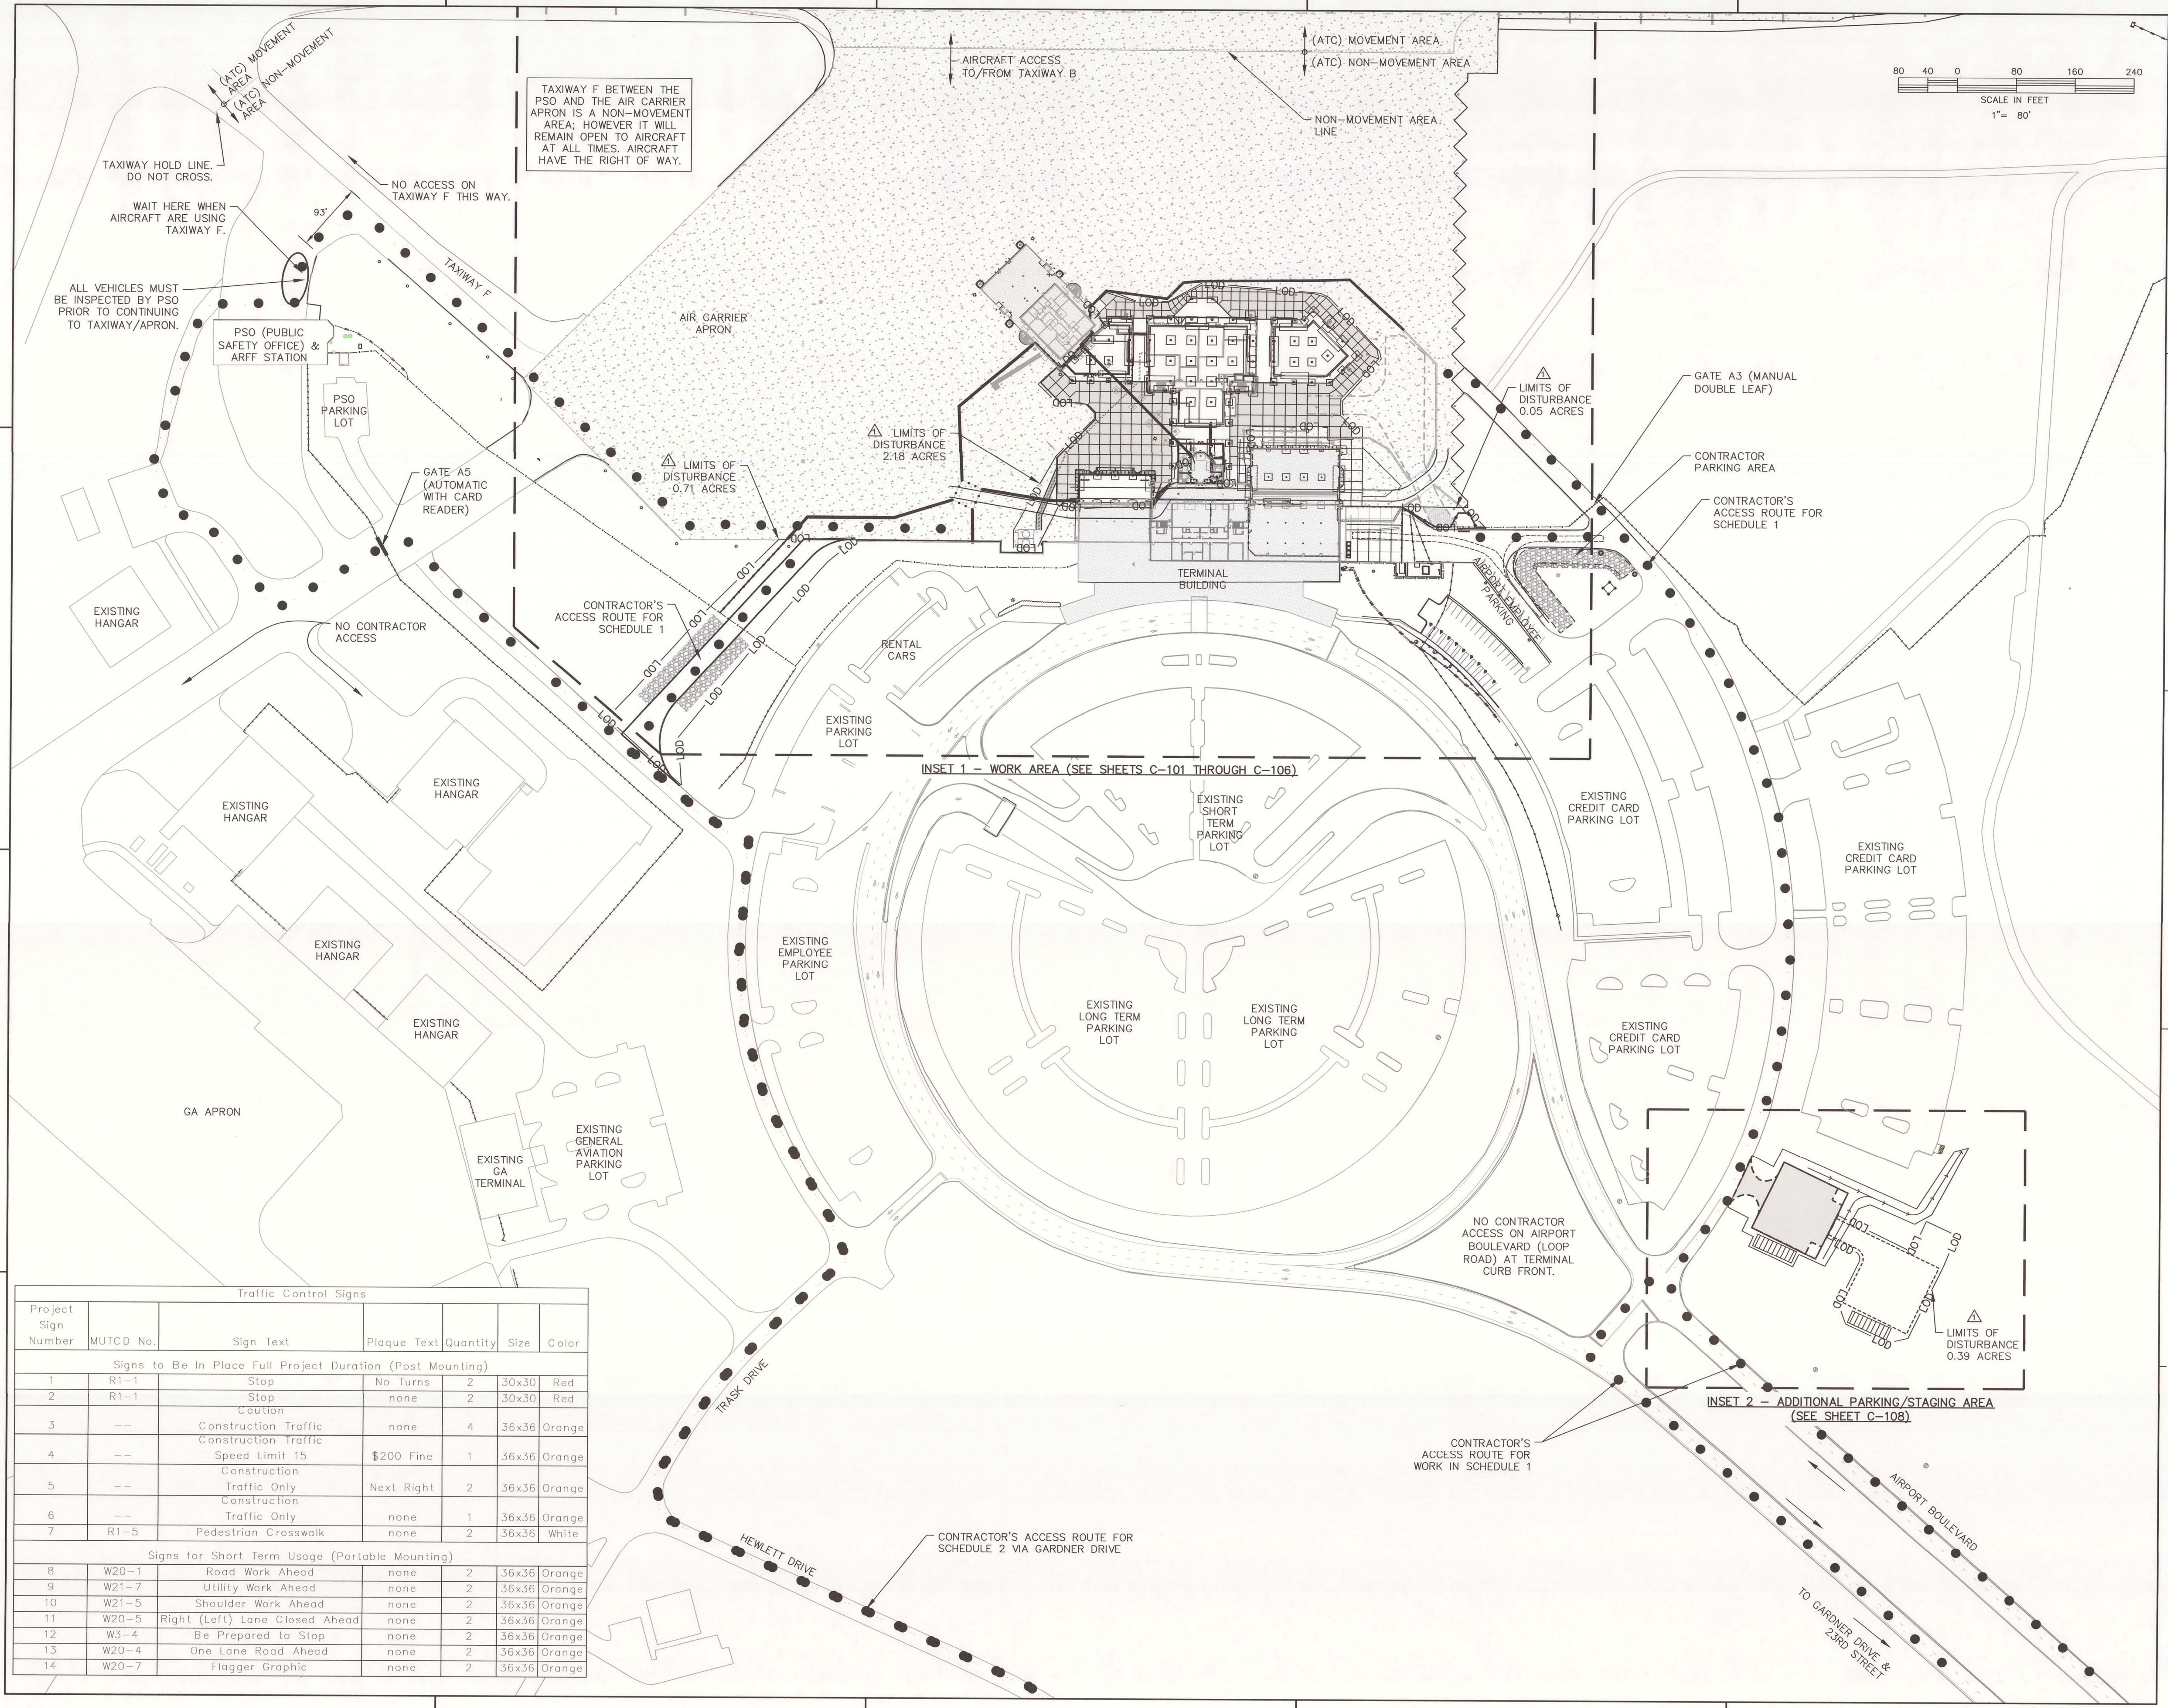


Traffic Control Signs						
Project Sign Number	MUTCD No.	Sign Text	Plaque Text	Quantity	Size	Color
Signs to be In Place Full Project Duration (Post Mounting)						
1	R1-1	Stop	No Turns	2	30x30	Red
2	R1-1	Stop	none	2	30x30	Red
3	--	Construction Traffic	none	4	36x36	Orange
4	--	Construction Traffic	Speed Limit 15	1	36x36	Orange
5	--	Construction Traffic Only	Next Right	2	36x36	Orange
6	--	Construction Traffic Only	none	1	36x36	Orange
7	R1-5	Pedestrian Crosswalk	none	2	36x36	White
Signs for Short Term Usage (Portable Mounting)						
8	W20-1	Road Work Ahead	none	2	36x36	Orange
9	W21-7	Utility Work Ahead	none	2	36x36	Orange
10	W21-5	Shoulder Work Ahead	none	2	36x36	Orange
11	W20-5	Right (Left) Lane Closed Ahead	none	2	36x36	Orange
12	W3-4	Be Prepared to Stop	none	2	36x36	Orange
13	W20-4	One Lane Road Ahead	none	2	36x36	Orange
14	W20-7	Flagger Graphic	none	2	36x36	Orange



# TERMINAL IMPROVEMENTS CONTRACT 3

Wilmington International Airport  
1740 Airport Boulevard, Suite 12  
Wilmington, NC 28405

TALBERT & BRIGHT, INC.  
4810 SHELLEY DRIVE  
WILMINGTON, NC, 28405  
NC C-0713

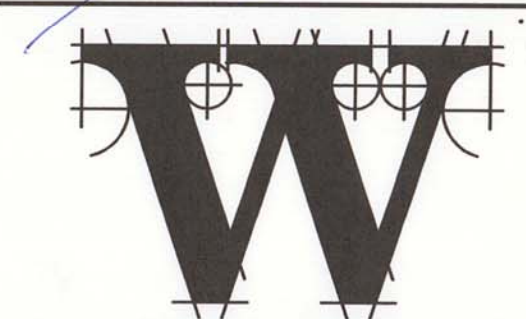

## THE WILSON GROUP ARCHITECTS

PO Box 5510 Charlotte, NC 28299  
704-331-9747 • www.twgarchitects.com

PROJECT MANAGER & CIVIL ENGINEER  
**TALBERT & BRIGHT**

CONSULTING ARCHITECT  
**LS3P**

STRUCTURAL ENGINEER  
**STEWART**


FF/P/ME ENGINEER  
**CHEATHAM & ASSOC.**

BAGGAGE HANDLING CONSULTANTS  
**BNP**

AIRCRAFT SUPPORT SYSTEMS  
**DK CONSULTANTS**

SPECIALTY LIGHTING CONSULTANT  
**HARTRANFT**

SIGNAGE & WAYFINDING  
**TAKEFORM**

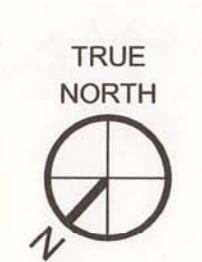

COPYRIGHT © 2019  
THE WILSON GROUP ARCHITECTS  
ALL RIGHTS RESERVED



PRINTED OR ELECTRONIC DRAWINGS AND DOCUMENTATION MAY NOT BE REPRODUCED IN ANY FORM WITHOUT WRITTEN PERMISSION FROM THE WILSON GROUP ARCHITECTS

REVISIONS		
△	7/22/19	AD-03

DATE 6/28/2019  
PROJECT NUMBER 9202-000  
SHEET TITLE

### PROJECT SAFETY AND ACCESS PLAN - SCHEDULE 2 WITH BID ALTERNATE

SHEET NUMBER  
**C-103**

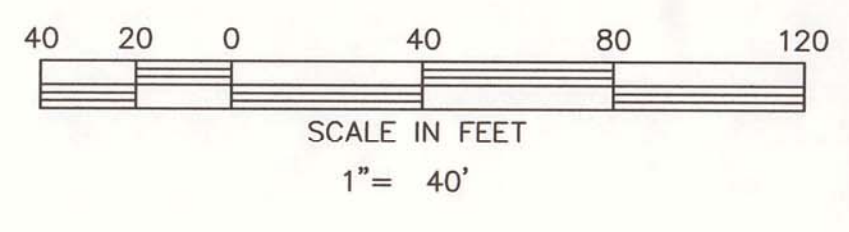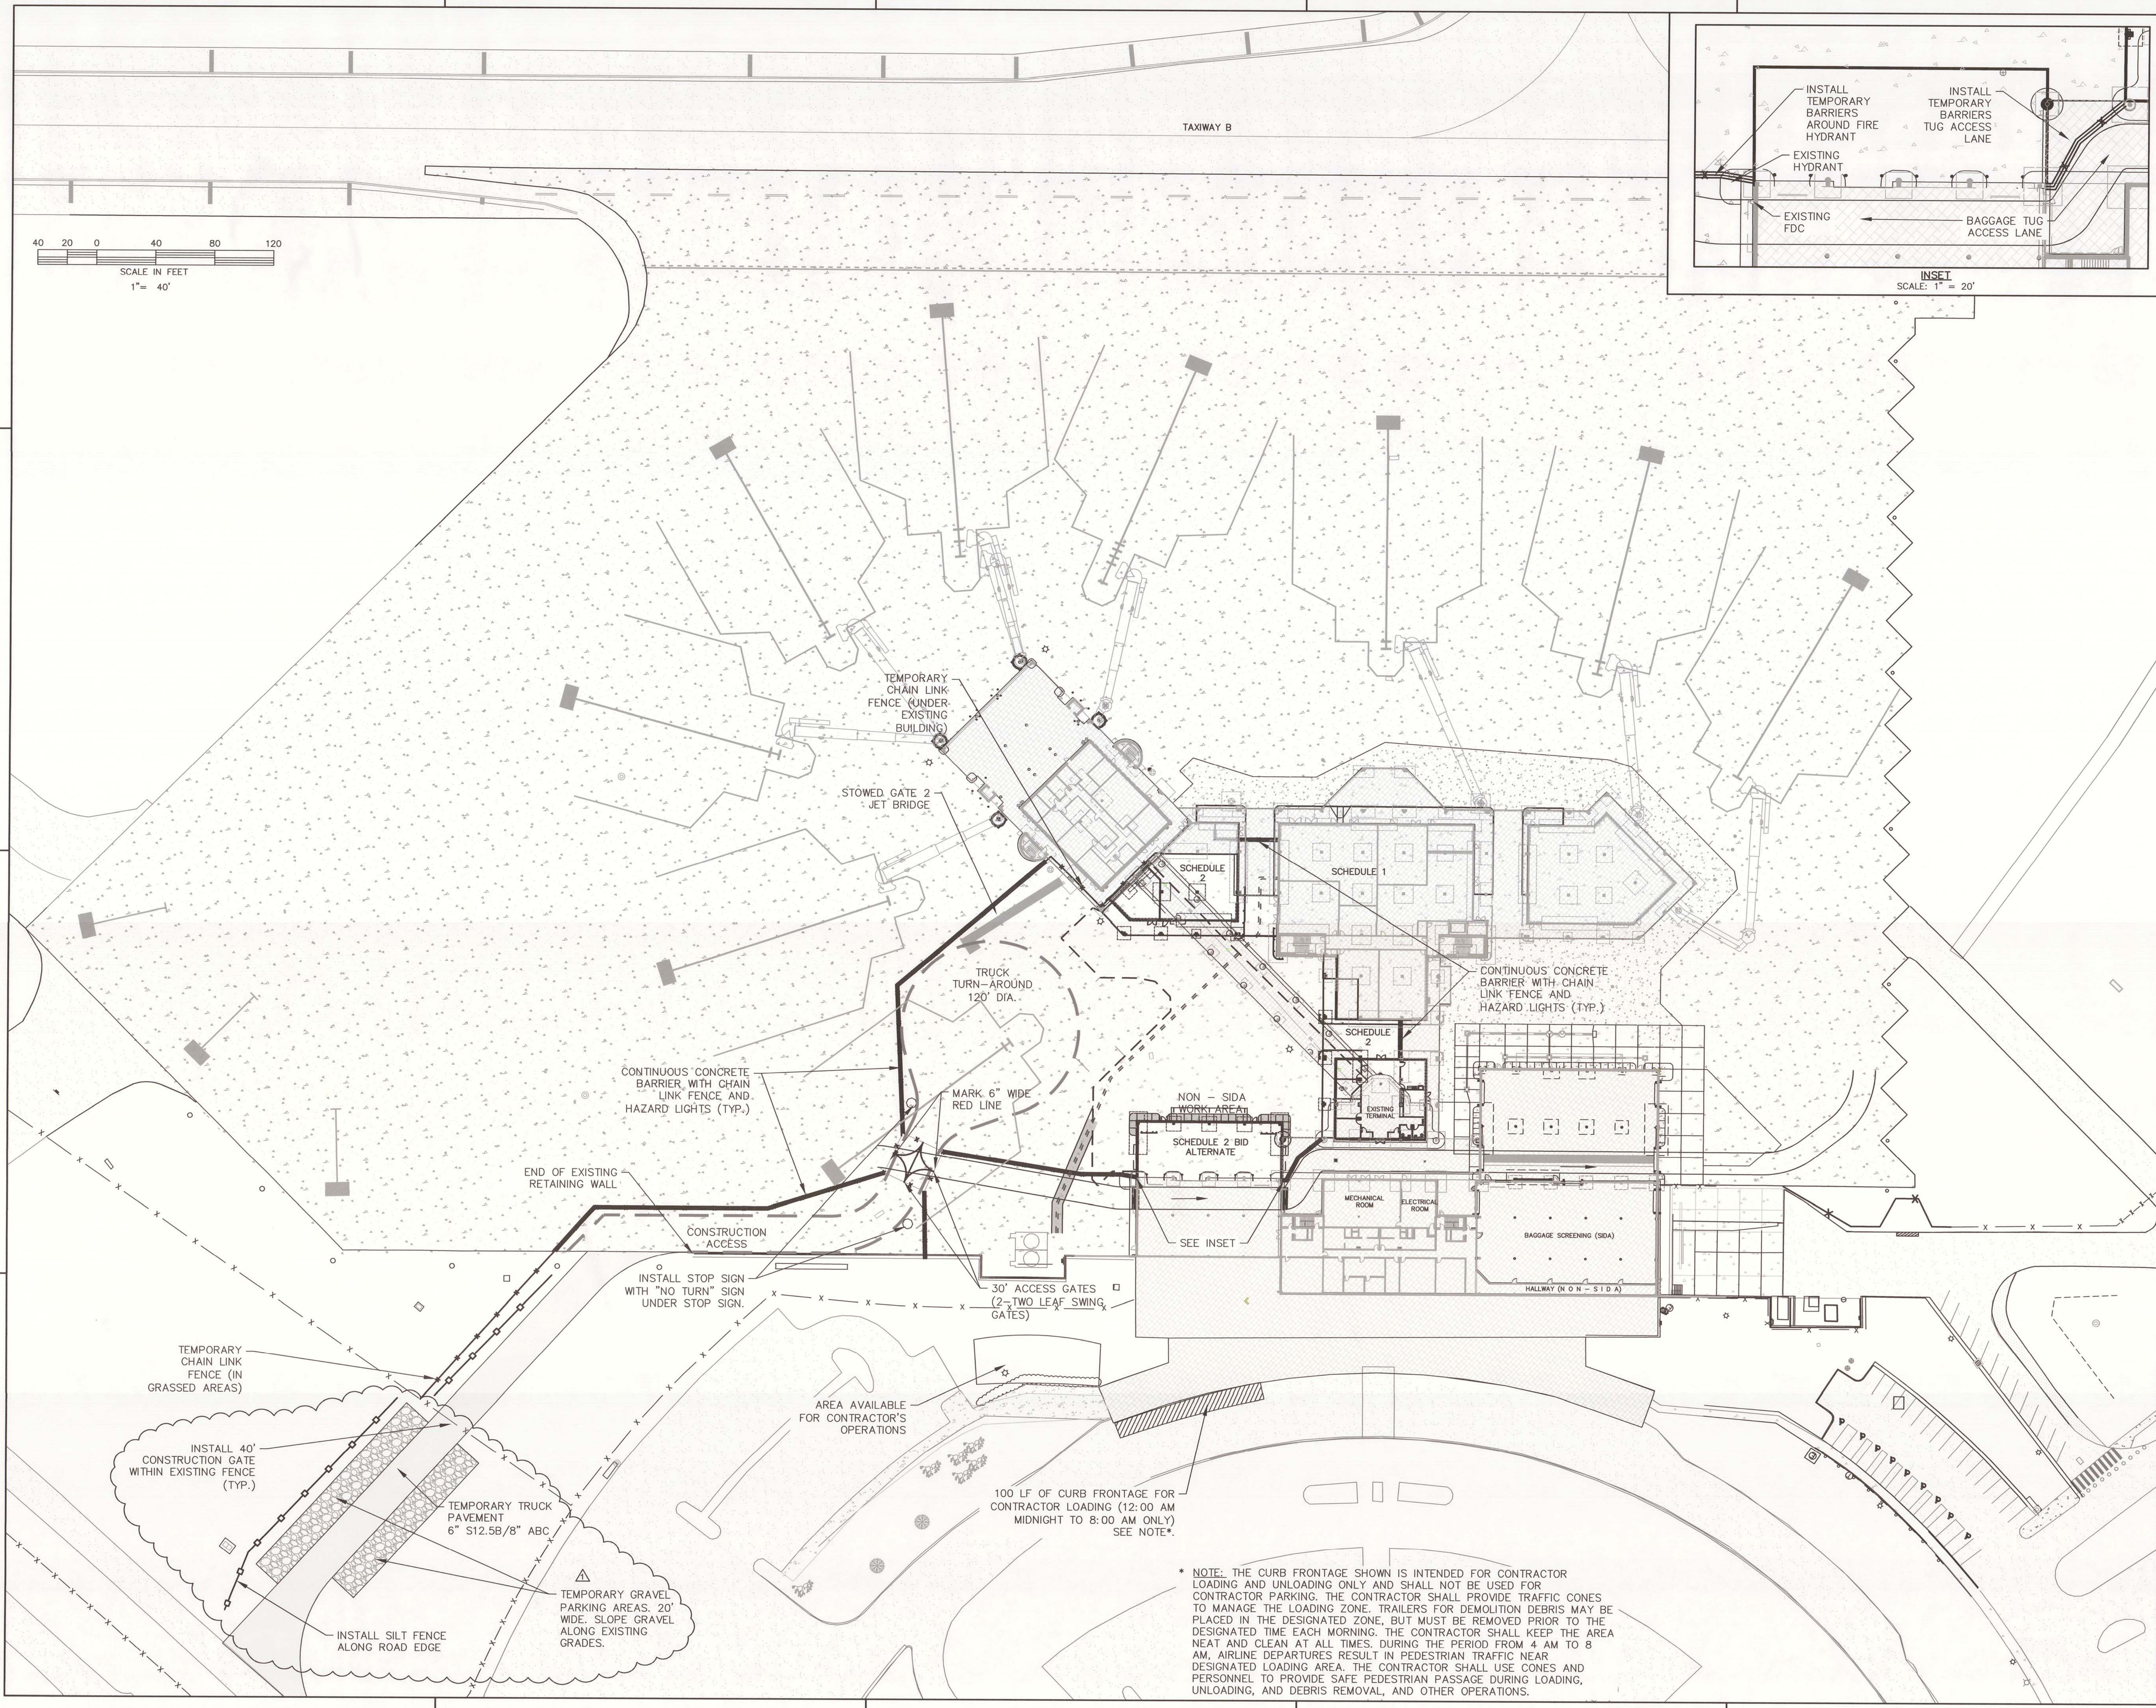

INSET  
SCALE: 1" = 20'


\* NOTE: THE CURB FRONTAGE SHOWN IS INTENDED FOR CONTRACTOR LOADING AND UNLOADING ONLY AND SHALL NOT BE USED FOR CONTRACTOR PARKING. THE CONTRACTOR SHALL PROVIDE TRAFFIC CONES TO MANAGE THE LOADING ZONE. TRAILERS FOR DEMOLITION DEBRIS MAY BE PLACED IN THE DESIGNATED ZONE, BUT MUST BE REMOVED PRIOR TO THE DESIGNATED TIME EACH MORNING. THE CONTRACTOR SHALL KEEP THE AREA NEAT AND CLEAN AT ALL TIMES. DURING THE PERIOD FROM 4 AM TO 8 AM, AIRLINE DEPARTURES RESULT IN PEDESTRIAN TRAFFIC NEAR DESIGNATED LOADING AREA. THE CONTRACTOR SHALL USE CONES AND PERSONNEL TO PROVIDE SAFE PEDESTRIAN PASSAGE DURING LOADING, UNLOADING, AND DEBRIS REMOVAL, AND OTHER OPERATIONS.



**TERMINAL IMPROVEMENTS CONTRACT 3**

Wilmington International Airport  
1740 Airport Boulevard, Suite 12  
Wilmington, NC 28405

TALBERT & BRIGHT, INC.  
4810 SHELLY DRIVE  
WILMINGTON, NC 28405  
NC C-0713

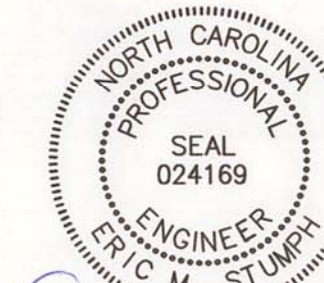

*Eric M. Stumpf* 7-24-19



**THE WILSON GROUP - ARCHITECTS -**

PO Box 5510 Charlotte, NC 28299  
704-331-9747 • www.twgarchitects.com

PROJECT MANAGER & CIVIL ENGINEER  
**TALBERT & BRIGHT**  
CONSULTING ARCHITECT  
LS3P

STRUCTURAL ENGINEER  
**STEWART**

FP/PIPE ENGINEER  
**CHEATHAM & ASSOC.**

BAGGAGE HANDLING CONSULTANTS  
**BNP**

AIRCRAFT SUPPORT SYSTEMS  
**DK CONSULTANTS**

SPECIALTY LIGHTING CONSULTANT  
**HARTRANFT**

SIGNAGE & WAYFINDING  
**TAKEFORM**



COPYRIGHT © 2019  
THE WILSON GROUP ARCHITECTS  
ALL RIGHTS RESERVED

PRINTED OR ELECTRONIC DRAWINGS AND DOCUMENTATION MAY NOT BE REPRODUCED IN ANY FORM WITHOUT WRITTEN PERMISSION FROM THE WILSON GROUP ARCHITECTS



**REVISIONS**

△ 7/22/19 AD-03

DATE 6/28/2019  
PROJECT NUMBER 9202-000  
SHEET TITLE

**PROJECT SAFETY AND ACCESS PLAN - RESTORATION SCHEDULE 2 WITH BID ALTERNATE**

SHEET NUMBER  
**C-104**

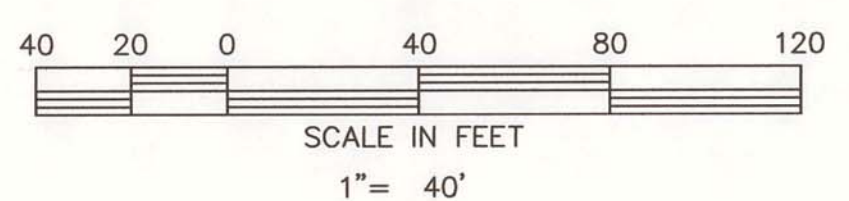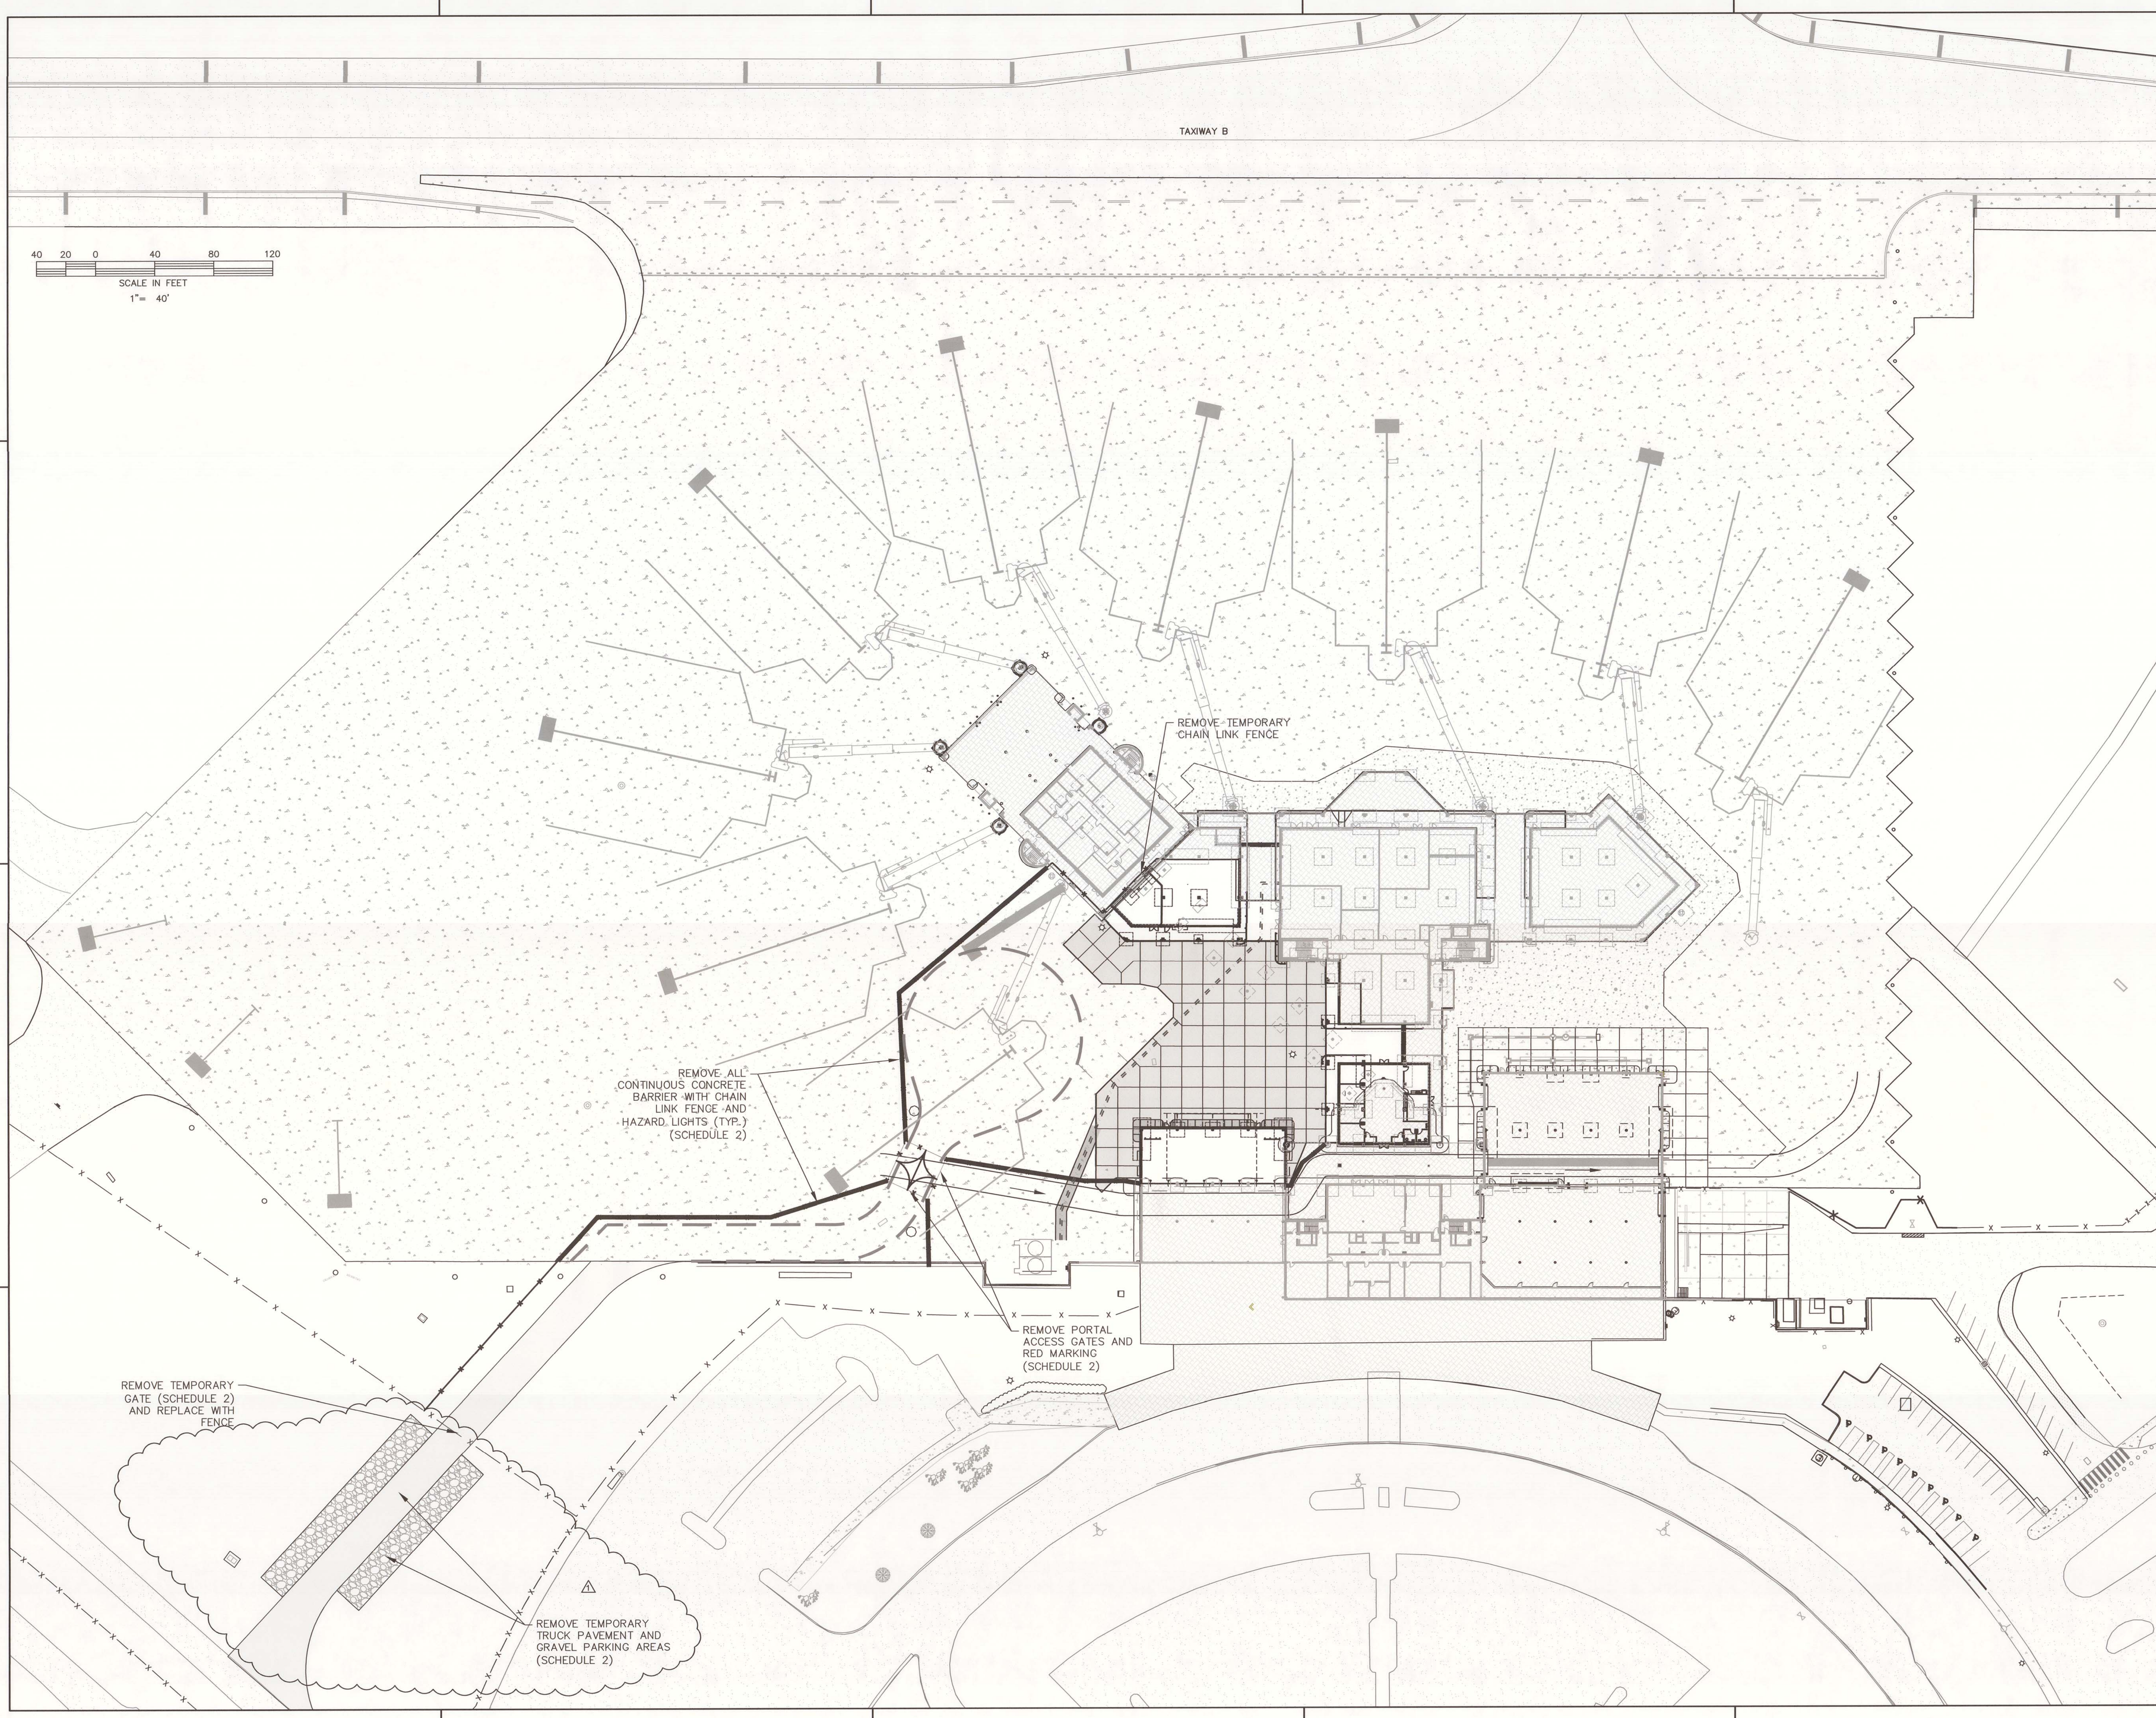

REMOVE ALL CONTINUOUS CONCRETE BARRIER WITH CHAIN LINK FENCE AND HAZARD LIGHTS (TYP.) (SCHEDULE 2)



REMOVE TEMPORARY CHAIN LINK FENCE

REMOVE PORTAL ACCESS GATES AND RED MARKING (SCHEDULE 2)

REMOVE TEMPORARY GATE (SCHEDULE 2) AND REPLACE WITH FENCE

REMOVE TEMPORARY TRUCK PAVEMENT AND GRAVEL PARKING AREAS (SCHEDULE 2)



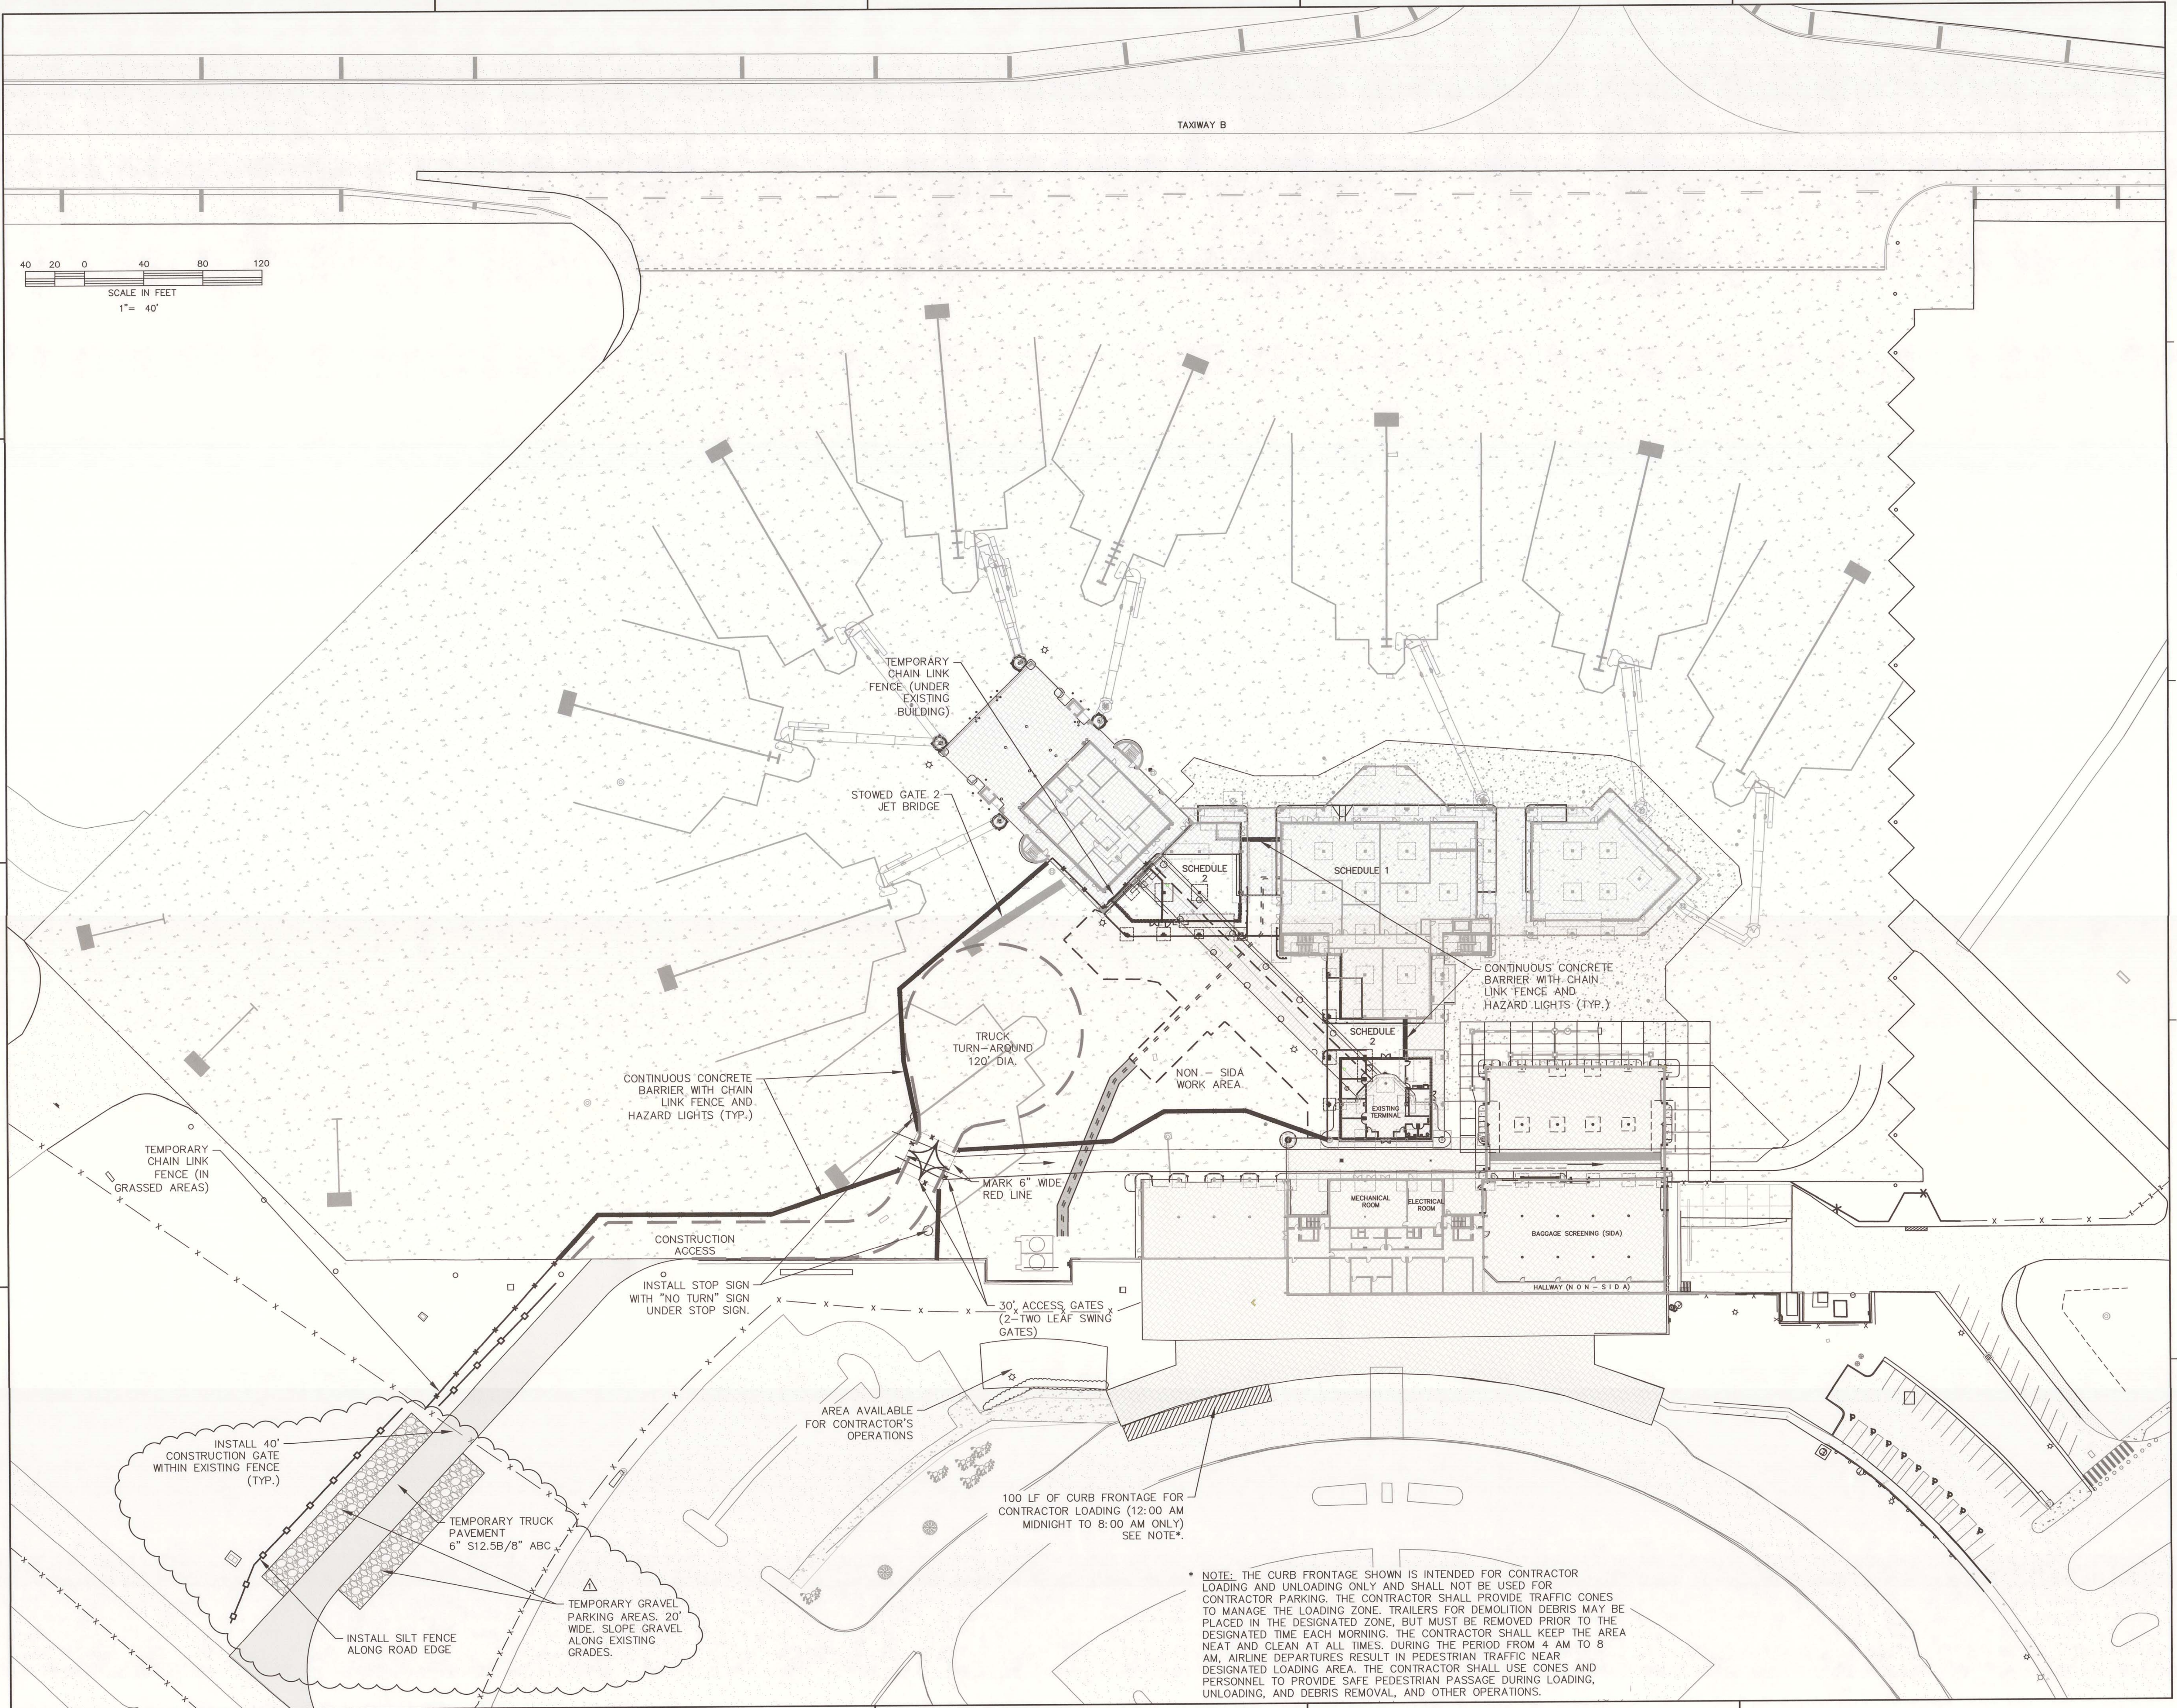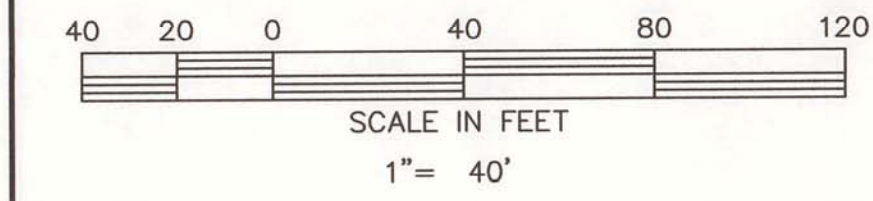




**TERMINAL IMPROVEMENTS CONTRACT 3**

Wilmington International Airport  
1740 Airport Boulevard, Suite 12  
Wilmington, NC 28405

TALBERT & BRIGHT, INC.  
4810 SHELLEY DRIVE  
WILMINGTON, NC, 28405  
NC C-0713



7/22/19

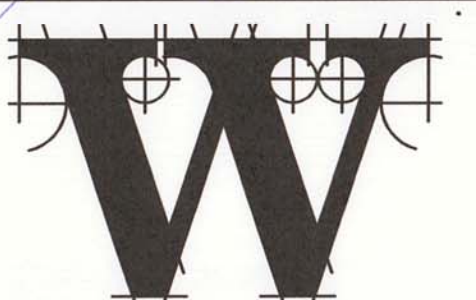

**THE WILSON GROUP**  
- ARCHITECTS -

PO Box 5510 Charlotte, NC 28299  
704-331-9747 • www.twgarchitects.com

PROJECT MANAGER & CIVIL ENGINEER  
**TALBERT & BRIGHT**

CONSULTING ARCHITECT  
LS3P

STRUCTURAL ENGINEER  
STEWART

FP/PM ENGINEER  
CHEATHAM & ASSOC.

BAGGAGE HANDLING CONSULTANTS  
BNP

AIRCRAFT SUPPORT SYSTEMS  
DK CONSULTANTS

SPECIALTY LIGHTING CONSULTANT  
HARTRANFT

SIGNAGE & WAYFINDING  
TAKEFORM



COPYRIGHT © 2019  
THE WILSON GROUP ARCHITECTS  
ALL RIGHTS RESERVED

PRINTED OR ELECTRONIC DRAWINGS AND  
DOCUMENTATION MAY NOT BE REPRODUCED  
IN ANY FORM WITHOUT WRITTEN PERMISSION  
FROM THE WILSON GROUP ARCHITECTS



REVISIONS

7/22/19 AD-03

DATE 6/28/2019  
PROJECT NUMBER 9202-000  
SHEET TITLE

**PROJECT SAFETY  
AND ACCESS PLAN  
- RESTORATION  
SCHEDULE 2  
WITHOUT BID  
ALTERNATE**

SHEET NUMBER  
**C-106**

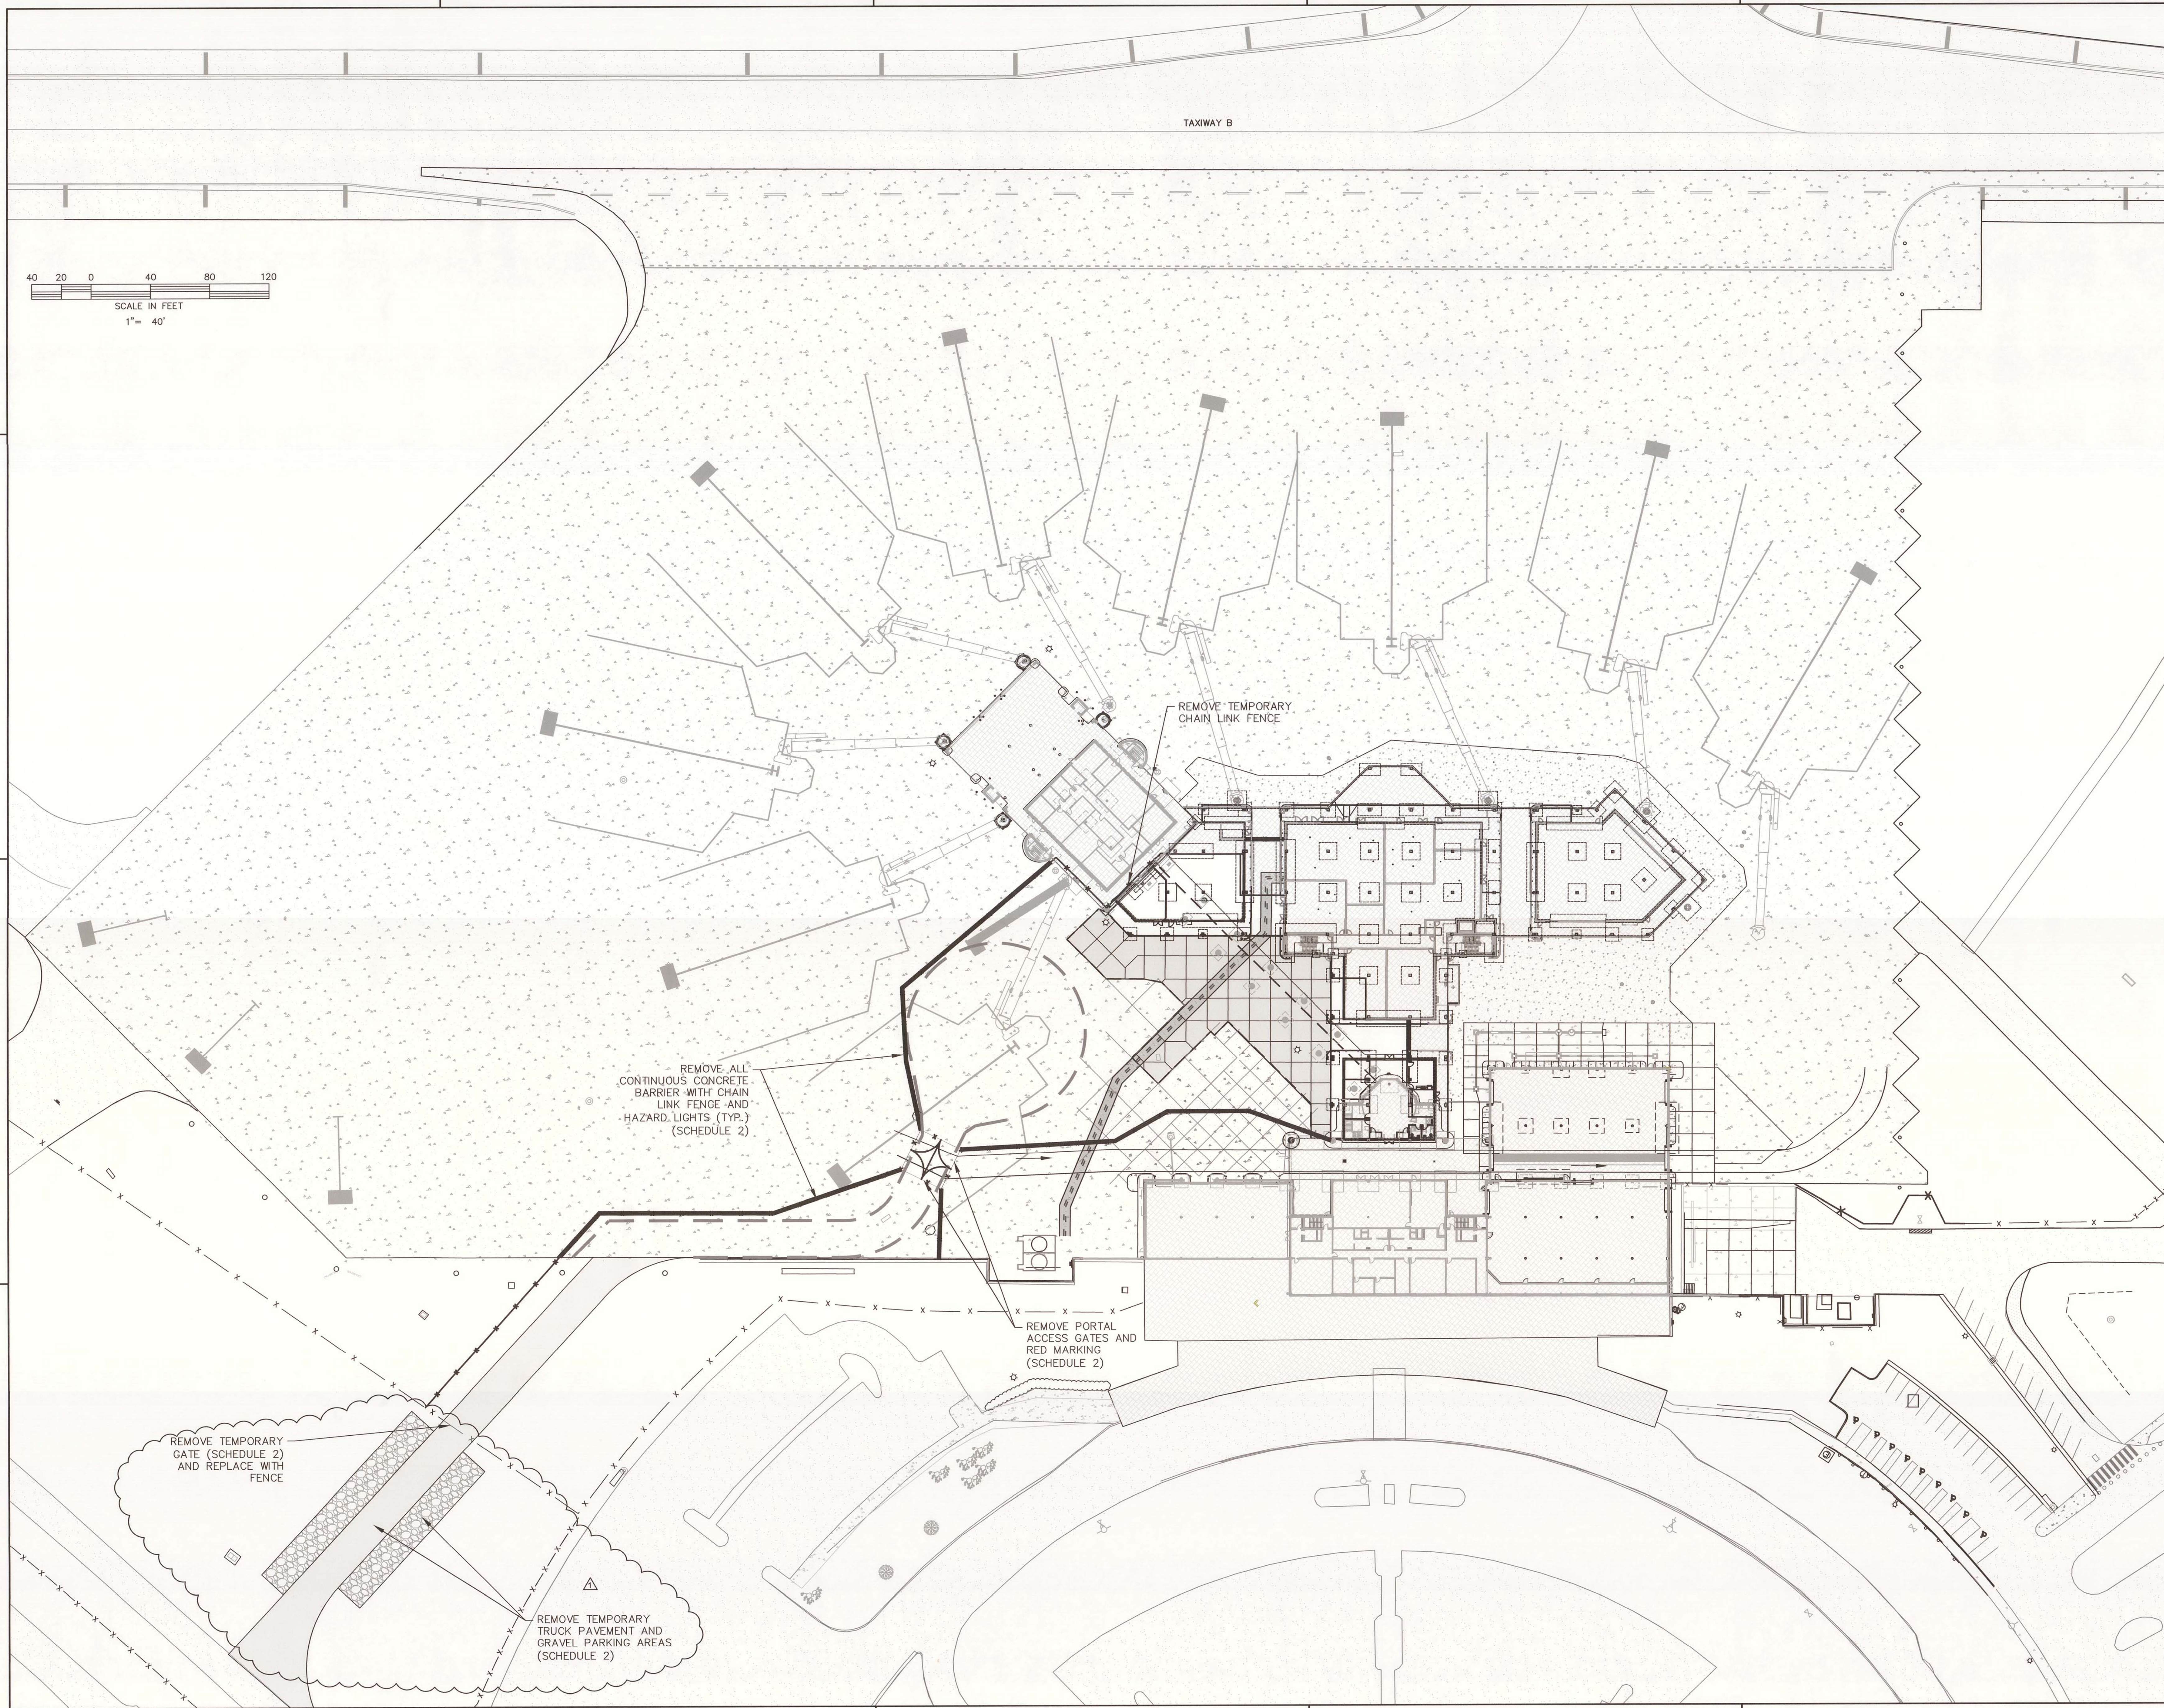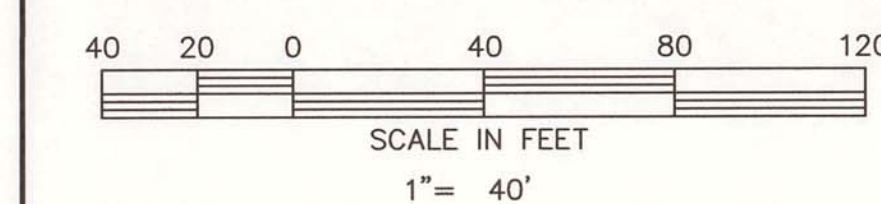

TAXIWAY B

REMOVE TEMPORARY CHAIN LINK FENCE

REMOVE ALL CONTINUOUS CONCRETE BARRIER WITH CHAIN LINK FENCE AND HAZARD LIGHTS (TYP.) (SCHEDULE 2)

REMOVE PORTAL ACCESS GATES AND RED MARKING (SCHEDULE 2)

REMOVE TEMPORARY GATE (SCHEDULE 2) AND REPLACE WITH FENCE

REMOVE TEMPORARY TRUCK PAVEMENT AND GRAVEL PARKING AREAS (SCHEDULE 2)

SAFETY PLAN REQUIREMENTS

- 1. THIS PLAN IS INTENDED TO ADDRESS AVIATION SAFETY ISSUES RELATIVE TO AIRCRAFT OPERATIONS...
2. THE PROJECT WORK AREA IS LOCATED WITHIN OR ADJACENT TO THE AIRCRAFT OPERATIONS AREA (AOA)...
3. SECURITY VIOLATIONS COMMITTED BY CONTRACTOR PERSONNEL MAY RESULT IN AN \$11,000 FINE...
4. THE CONTRACTOR SHALL NOT BEGIN WORK UNLESS AND UNTIL 7 DAYS PRIOR NOTICE HAS BEEN GIVEN...
5. IN AN EMERGENCY SITUATION THE CONTRACTOR IS TO NOTIFY THE PUBLIC SAFETY OFFICE IMMEDIATELY...
6. THE CONTRACTOR AND ALL SUBCONTRACTORS SHALL DESIGNATE A REPRESENTATIVE AND ALTERNATE...
7. A DAILY START-UP AND SHUT-DOWN CHECKLIST WILL BE JOINTLY PREPARED BY THE CONTRACTOR...
8. UNDERGROUND UTILITIES ARE KNOWN TO BE LOCATED IN THE PROJECT AREA...
9. THE CONTRACTOR SHALL CLEAN ALL CONSTRUCTION AREAS OF LITTER, LOOSE PAPERS, DEBRIS, ETC...
10. INSPECTION - FREQUENT INSPECTIONS WILL BE MADE BY THE AIRPORT PUBLIC SAFETY OFFICE...

GENERAL NOTES:

- 1. IT IS THE INTENT OF THE OWNER THAT THE WILMINGTON INTERNATIONAL AIRPORT WILL REMAIN OPEN TO AIR TRAFFIC...
2. PRIOR TO LEAVING WORK EACH DAY, CONTRACTOR SHALL RETURN HIS EQUIPMENT AND MATERIALS...
3. ALL CONTRACTOR PERSONNEL, INCLUDING BUT NOT LIMITED TO, GENERAL LABORERS, SUBCONTRACTORS...
4. PRIOR TO ENTERING THE SECURED AREA OF THE AIRPORT EACH DAY, THE CONTRACTOR SHALL CHECK IN WITH THE PSO...

THE CONTRACTOR SHALL COORDINATE INGRESS-EGRESS REQUIREMENTS WITH THE AIRPORT MANAGEMENT... ALL OPEN GATES TO SECURED AIRPORT AREAS SHALL BE MONITORED CONTINUOUSLY BY CONTRACTOR'S PERSONNEL...

ALL CONSTRUCTION VEHICLES MUST BE CLEARED FOR ACCESS BY THE AIRPORT MANAGEMENT... PERSONAL CARS SHALL BE PARKED OUTSIDE OF SECURED AIRFIELD AREAS...

- 5. FOR THIS PROJECT, CONSTRUCTION VEHICLES ARE PROHIBITED FROM OPERATING ON ACTIVE RUNWAYS AND TAXIWAYS.
6. THE CONTRACTOR SHALL CONDUCT HIS OPERATIONS IN SUCH A MANNER AS TO ASSURE THAT SUCH OPERATIONS DO NOT IMPED ACCESS TO ANY AREA OF THE AIRFIELD...
7. ACCESS ROADS TO BE USED UNDER THIS CONTRACT SHALL BE THOSE DESIGNATED AND APPROVED BY THE ENGINEER...
8. ALL EXISTING UTILITIES AND FACILITIES SHALL BE CAREFULLY PROTECTED BY THE CONTRACTOR...
9. CONTRACTOR SHALL DISPOSE OF CONSTRUCTION DEBRIS OFF AIRPORT PROPERTY IN A PROPERLY PERMITTED FACILITY...

CONSTRUCTION CONTRACTOR'S RESPONSIBILITIES

- 1. SUBMIT PLANS TO THE AIRPORT OPERATOR ON HOW TO COMPLY WITH THE SAFETY REQUIREMENTS OF THE PROJECT...
2. HAVE A COPY OF THE PROJECT AIRPORT SAFETY PLANS AVAILABLE ON SITE.
3. COMPLY WITH THE AIRPORT SAFETY PLAN ASSOCIATED WITH THE CONSTRUCTION PROJECT AND ENSURE THAT CONSTRUCTION PERSONNEL ARE FAMILIAR WITH SAFETY PROCEDURES AND REGULATIONS...
4. PROVIDE A POINT OF CONTACT WHO WILL COORDINATE AN IMMEDIATE RESPONSE TO CORRECT ANY CONSTRUCTION-RELATED ACTIVITY...
5. PROVIDE A SAFETY/CONSTRUCTION INSPECTOR FAMILIAR WITH AIRPORT SAFETY TO MONITOR CONSTRUCTION ACTIVITIES...
6. RESTRICT MOVEMENT OF CONSTRUCTION VEHICLES TO CONSTRUCTION AREAS BY FLAGGING AND BARRICADING...
7. ENSURE THAT NO CONSTRUCTION EMPLOYEES, EMPLOYEES OF SUBCONTRACTORS OR SUPPLIERS, OR OTHER PERSONS ENTER ANY PART OF THE AIR OPERATIONS AREAS (AOA)...
8. THE CONTRACTOR SHALL HAVE A MINIMUM OF 2 SUPERVISORY PERSONNEL BADGED BY THE AIRPORT SECURITY OFFICE...
9. THE CONTRACTOR IS ADVISED THAT DUST, SMOKE, DEBRIS, ETC. POSES A SERIOUS RISK OF DAMAGE TO AIRCRAFT ENGINES...
10. THE CONTRACTOR SHALL FAMILIARIZE HIS PERSONNEL, SUBCONTRACTORS, AND SUPPLIERS WITH THE NOISE, JET BLAST, AND PROP WASH EFFECTS...
11. THE CONTRACTOR SHALL FAMILIARIZE HIS PERSONNEL, SUBCONTRACTORS, AND SUPPLIERS WITH AIRPORT SECURITY ISSUES...

SIDA BADGES, ESCORTING, SECURITY, STAGING AND ACCESS REQUIREMENTS

- 1. ALL WORK OF THIS PROJECT IS LOCATED WITHIN OR IMMEDIATELY ADJACENT TO THE SECURITY IDENTIFICATION DISPLAY AREA (SIDA) AT THE WILMINGTON INTERNATIONAL AIRPORT...
2. THE CONTRACTOR SHALL COORDINATE WITH THE ARCHITECTURAL TEAM AND AIRPORT MANAGEMENT WITH REGARD TO THE ADVANCE SCHEDULING AND TSA REVIEW AND APPROVAL...
3. THE SIDA IS THAT AREA OF THE AIRPORT WHERE SECURITY MEASURES ASSOCIATED WITH AIRLINE OPERATIONS ARE IN PLACE...
4. PORTIONS OF THE LOWER LEVEL OF THE AIRLINE TERMINAL BUILDING, INCLUDING THE MAIN HALLWAYS, ARE NOT WITHIN THE SIDA...
5. THE CONTRACTOR SHALL BE RESPONSIBLE FOR PROVIDING AT ALL TIMES AN ADEQUATE NUMBER OF PERSONNEL WITH AIRPORT SIDA BADGES WITH ESCORT PRIVILEGES...
6. ANY BADGED INDIVIDUAL WHO FORGETS, MISPLACES OR OTHERWISE DOES NOT HAVE HIS/HER BADGE DISPLAYED ON HIS/HER PERSON...
7. SIDA BADGES MUST BE OBTAINED THROUGH THE AIRPORT PUBLIC SAFETY OFFICE (PSO)...
8. BADGE TRAINING SHALL INCLUDE SIDA RAMP DRIVING AND SIDA ESCORT PRIVILEGES...
9. THE GENERAL CONTRACTOR SHALL BE RESPONSIBLE FOR ESTABLISHING A BADGE AND SECURITY MANAGEMENT PROGRAM...
10. ALL CONSTRUCTION VEHICLES ENTERING THE SIDA MUST BE INSPECTED BY PSO PERSONNEL...
11. CONSTRUCTION VEHICLES FOR THIS PROJECT ARE EXPRESSLY PROHIBITED FROM DRIVING IN THE AIR TRAFFIC CONTROL MOVEMENT AREA...
12. FOR SECURITY TRANSITION PERIODS (INSTALLATION, RELOCATION AND REMOVAL OF TEMPORARY SIDA FENCING, BARRIERS AND GATES)...
13. DEPENDING ON PSO STAFF WORK LOAD, INFREQUENT LARGE-SCALE DELIVERIES TO THE SITE STAGING AREA...
14. CONSTRUCTION VEHICLES ROUTINELY ENTERING THE SIDA WORK AREA OR NON-SIDA WORK AREA MUST BEAR THE NAME AND PHONE NUMBER...
15. THE PERSONAL VEHICLES OF WORKERS SHALL BE PARKED IN THE DESIGNATED AREAS OUTSIDE THE AIRPORT PERIMETER FENCE...
16. VEHICLES ENTERING THE NON-SIDA WORK AREA DO NOT REQUIRE PSO INSPECTION BUT SHALL BE CONTROLLED BY THE CONTRACTOR'S GATE KEEPERS...
17. THE CONTRACTOR IS REMINDED THAT WEAPONS ARE PROHIBITED ON AIRPORT PROPERTY...
18. AREAS AS SHOWN ON THE PLANS HAVE BEEN RESERVED ON THE AIR CARRIER APRON FOR CONTRACTOR OPERATIONS...
19. LOOSE GRAVEL, MATERIALS, TOOLS AND HARDWARE WHICH CAN BE LIFTED/TRANSPORTED BY WIND, JET BLAST OR RAINWATER POSE A SERIOUS THREAT...
20. TOOLS, EQUIPMENT AND MATERIALS SHALL NOT BE LEFT UNATTENDED OR UNLOCKED IN THE WORK AREA...
21. THE CONTRACTOR SHALL INSTRUCT ALL PERSONNEL REGARDING AIRPORT SECURITY MATTERS...
22. THE CONTRACTOR SHALL INSPECT TEMPORARY SECURITY LINES (FENCES, GATES, DOORS, WALLS, LOCKING SYSTEMS)...
23. VEHICLES, EQUIPMENT AND MATERIALS SHALL NOT BE STORED WITHIN 10 FEET ON EITHER SIDE OF ANY EXISTING OR TEMPORARY FENCE...
24. WEAPONS INCLUDING FIREARMS AND KNIVES ARE EXPRESSLY PROHIBITED...
25. TO THE MAXIMUM EXTENT PRACTICABLE, THE CONTRACTOR SHALL ESTABLISH PHYSICAL SEPARATION AND/OR TEMPORARY SIDA LIMITS...
26. THE CONTRACTOR SHALL PERFORM ALL TEMPORARY WORK ASSOCIATED WITH TEMPORARY AND FINAL CHANGES IN SECURE AREA...

AIRPORT SECURITY AREA DEFINITIONS AND ACCESS RESTRICTIONS

- 1. "SECURED AREA" - THE SECURED AREA IS THE AREA OF THE AIRPORT WHERE MEASURES ARE IN PLACE TO LIMIT ACCESS TO AUTHORIZED PERSONS...
2. "AIR OPERATIONS AREA, AOA" - THE AIR OPERATIONS AREA (AOA) IS ANY AREA OF THE AIRPORT USED OR INTENDED TO BE USED FOR THE LANDING, TAKEOFF OR SURFACE MOVEMENT OF AIRCRAFT...
3. "SECURITY IDENTIFICATION DISPLAY AREA, SIDA" - THE SECURITY IDENTIFICATION DISPLAY AREA (SIDA) IS THE PORTION OF THE AIRPORT SECURED AREA WHERE SECURITY MEASURES ASSOCIATED WITH AIRLINE OPERATIONS ARE IN PLACE...
4. "STERILE AREA" - THE STERILE AREA IS THAT PORTION OF THE TERMINAL BUILDING BEYOND THE TSA PASSENGER SCREENING STATION...
5. "NON-SIDA WORK AREA" - FOR THIS CONSTRUCTION PROJECT, NON-SIDA WORK AREAS WILL BE ESTABLISHED FOR THE PURPOSE OF SEGREGATING MAJOR CONSTRUCTION WORK AREAS...
6. "MOVEMENT AREA" AND "NON-MOVEMENT AREA" - THE MOVEMENT AREA IS THE RUNWAY AND TAXIWAY NETWORK SUBJECT TO AIR TRAFFIC CONTROL (ATC)...
7. "UN-SECURED AREA" - THE UN-SECURED AREA INCLUDES THE AREAS OF THE TERMINAL BUILDING AND AIRPORT GROUNDS FOR WHICH AIRPORT SECURITY ACCESS CONTROL MEASURES ARE NOT IN PLACE ("OUTSIDE THE FENCE")...

ESCORT TABLE

Table with 3 columns: SECURITY ZONE, LOCATIONS, and MAXIMUM NUMBER OF UNBADGED PERSONNEL PER SIDA BADGED ESCORT. Rows include SIDA, NON-SIDA WORK AREA, UN-SECURED AREA, and STERILE AREA.


\* ALL TOOLS AND READILY PORTABLE MATERIALS MUST BE SECURED IN A LOCKED ENCLOSURE OR REMOVED FROM THE STERILE AREA WHEN NOT IN IMMEDIATE USE.



TERMINAL IMPROVEMENTS CONTRACT 3

Wilmington International Airport 1740 Airport Boulevard, Suite 12 Wilmington, NC 28405

TALBERT & BRIGHT, INC. 4810 SHEDDY DRIVE WILMINGTON, NC 28405 NC C-0713

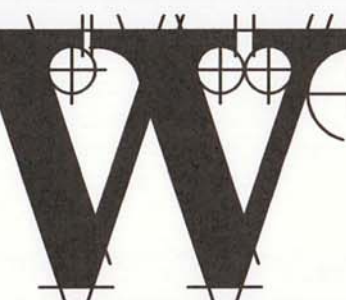

THE WILSON GROUP - ARCHITECTS -

PO Box 5510 Charlotte, NC 28299 704-331-9747 • www.twgarchitects.com

PROJECT MANAGER & CIVIL ENGINEER TALBERT & BRIGHT

CONSULTING ARCHITECT LS3P

STRUCTURAL ENGINEER STEWART

FP/P/ME ENGINEER CHEATHAM & ASSOC.

BAGGAGE HANDLING CONSULTANTS BNP

AIRCRAFT SUPPORT SYSTEMS DK CONSULTANTS

SPECIALTY LIGHTING CONSULTANT HARTRANFT

SIGNAGE & WAYFINDING TAKEFORM

PRINTED OR ELECTRONIC DRAWINGS AND DOCUMENTATION MAY NOT BE REPRODUCED IN ANY FORM WITHOUT WRITTEN PERMISSION FROM THE WILSON GROUP ARCHITECTS


REVISIONS

7/22/19 AD-03

DATE PROJECT NUMBER SHEET TITLE 6/28/2019 9202-000

PROJECT SAFETY PLAN NOTES

SHEET NUMBER C-107

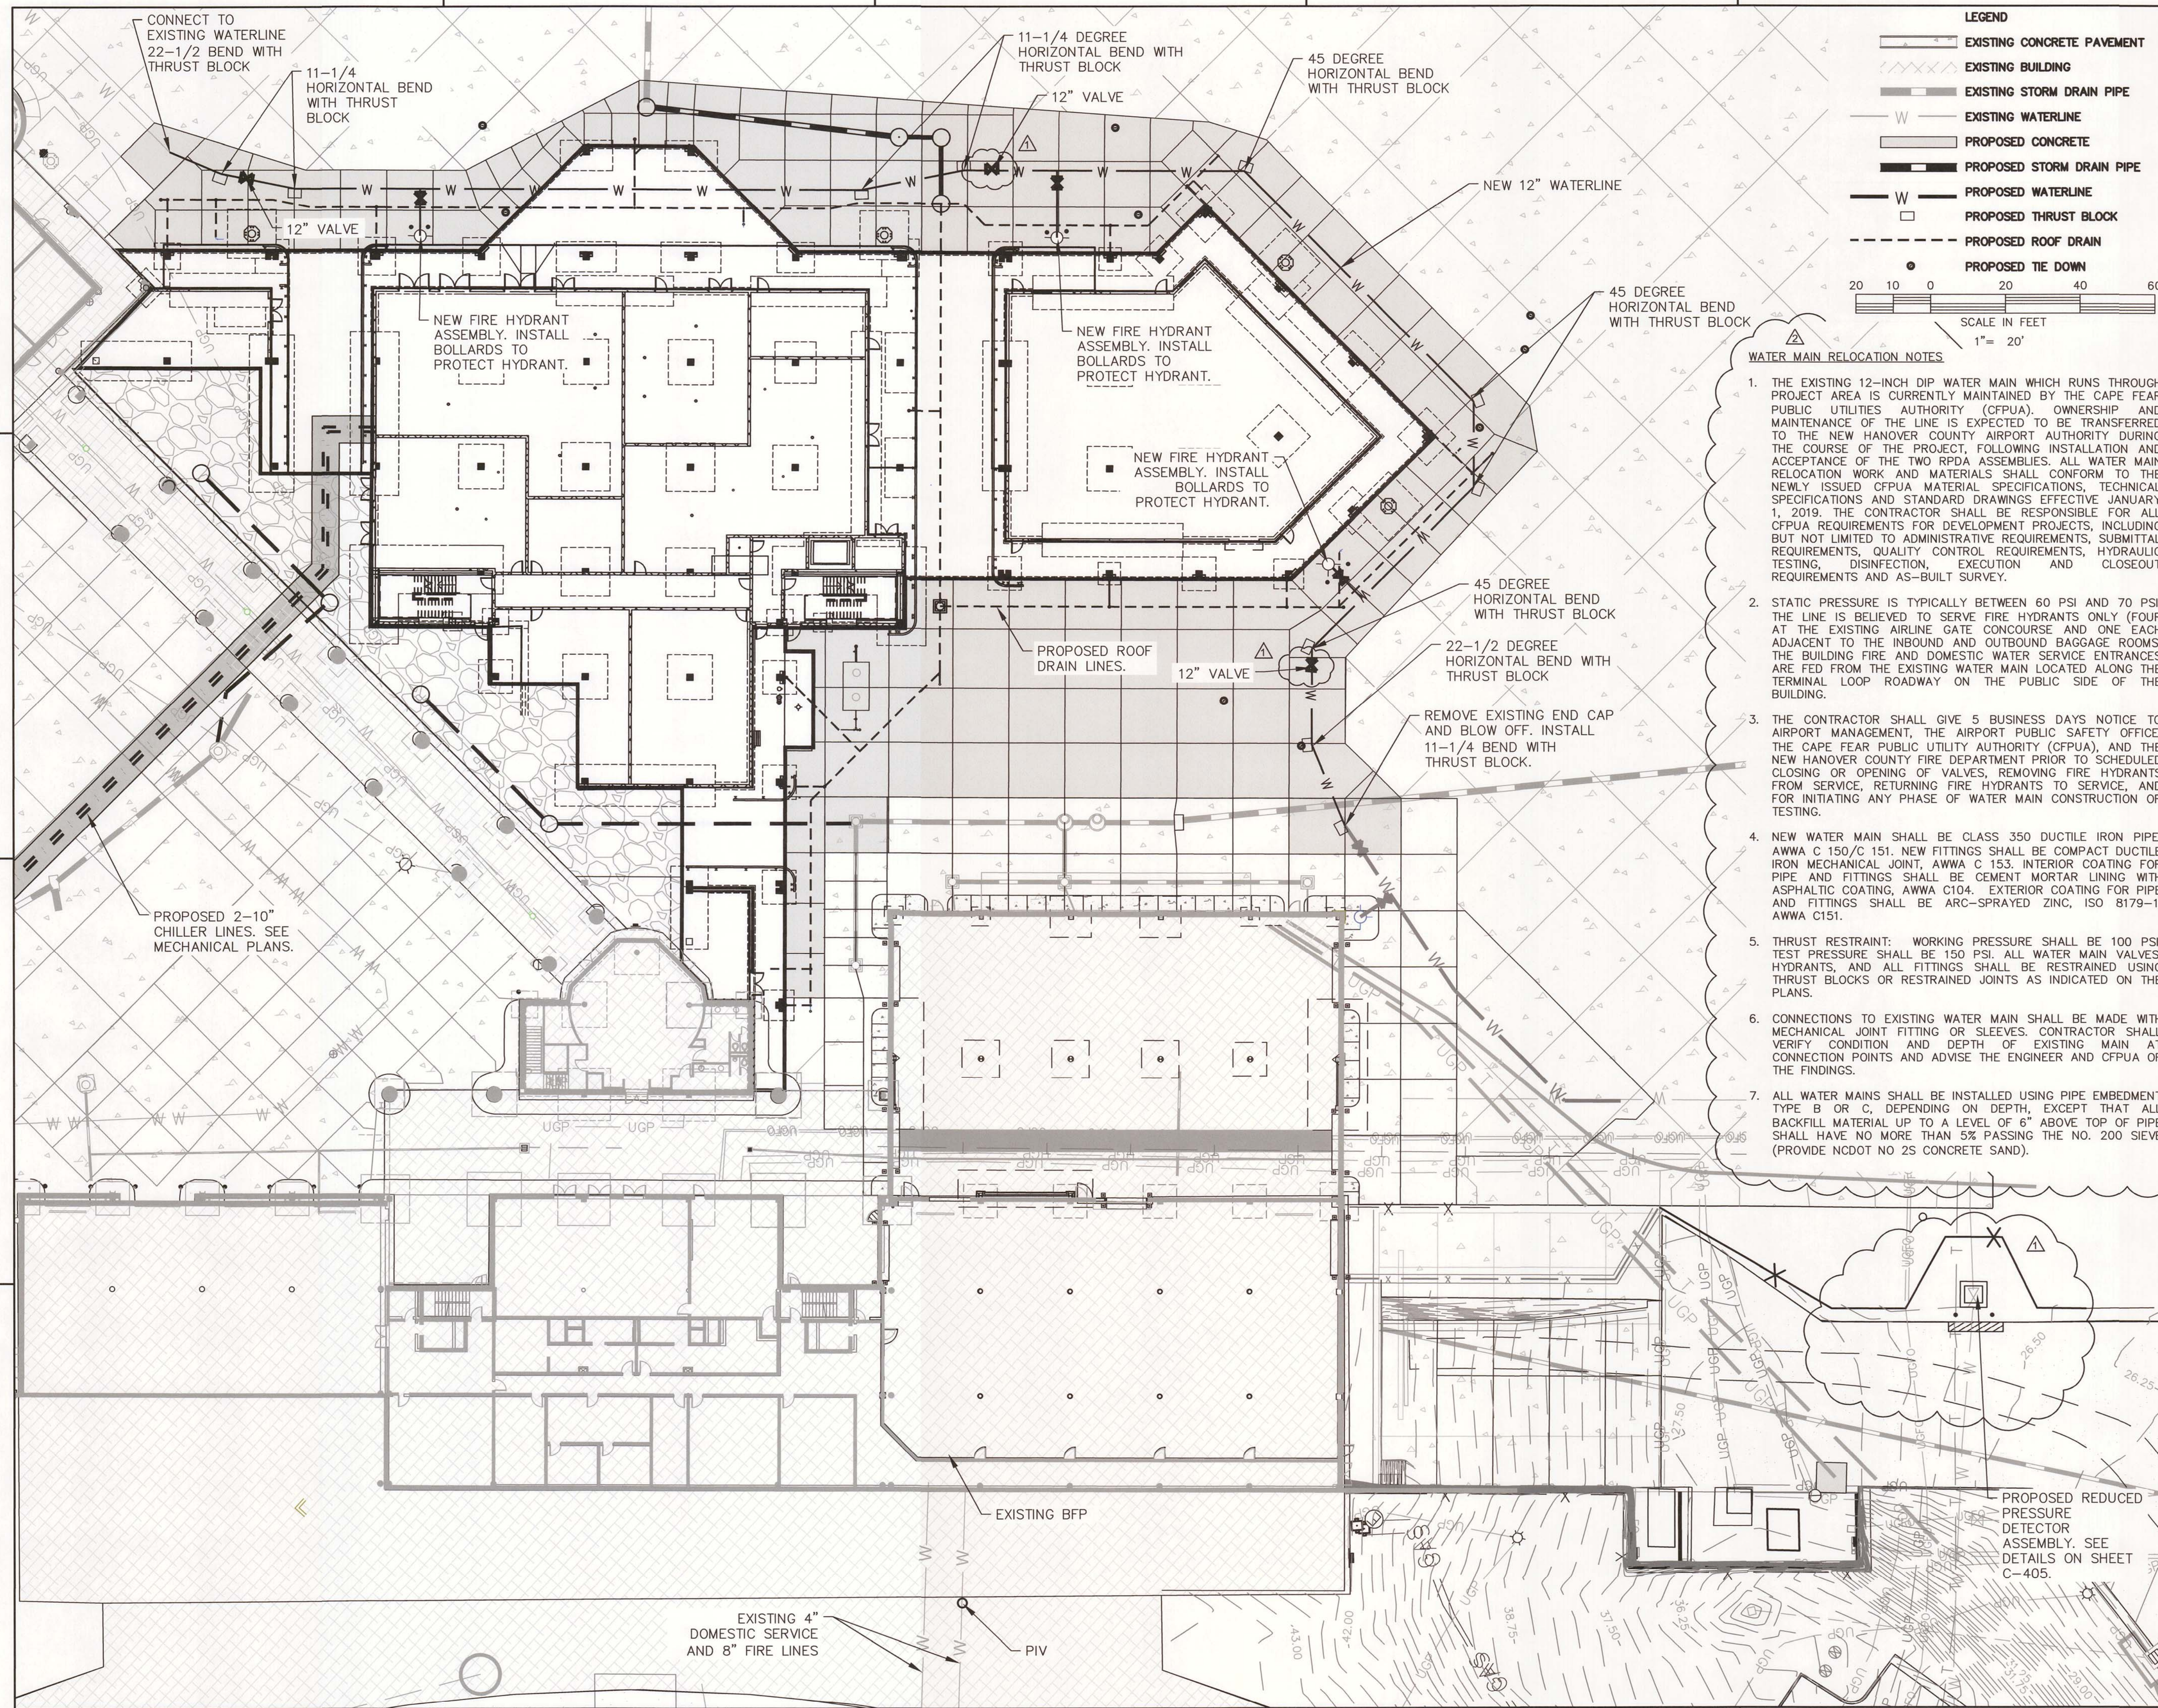

**LEGEND**

- EXISTING CONCRETE PAVEMENT
- EXISTING BUILDING
- EXISTING STORM DRAIN PIPE
- EXISTING WATERLINE
- PROPOSED CONCRETE
- PROPOSED STORM DRAIN PIPE
- PROPOSED WATERLINE
- PROPOSED THRUST BLOCK
- PROPOSED ROOF DRAIN
- PROPOSED TIE DOWN

20 10 0 20 40 60  
SCALE IN FEET  
1" = 20'

**WATER MAIN RELOCATION NOTES**

1. THE EXISTING 12-INCH DIP WATER MAIN WHICH RUNS THROUGH PROJECT AREA IS CURRENTLY MAINTAINED BY THE CAPE FEAR PUBLIC UTILITIES AUTHORITY (CFPUA). OWNERSHIP AND MAINTENANCE OF THE LINE IS EXPECTED TO BE TRANSFERRED TO THE NEW HANOVER COUNTY AIRPORT AUTHORITY DURING THE COURSE OF THE PROJECT, FOLLOWING INSTALLATION AND ACCEPTANCE OF THE TWO RPDA ASSEMBLIES. ALL WATER MAIN RELOCATION WORK AND MATERIALS SHALL CONFORM TO THE NEWLY ISSUED CFPUA MATERIAL SPECIFICATIONS, TECHNICAL SPECIFICATIONS AND STANDARD DRAWINGS EFFECTIVE JANUARY 1, 2019. THE CONTRACTOR SHALL BE RESPONSIBLE FOR ALL CFPUA REQUIREMENTS FOR DEVELOPMENT PROJECTS, INCLUDING BUT NOT LIMITED TO ADMINISTRATIVE REQUIREMENTS, SUBMITTAL REQUIREMENTS, QUALITY CONTROL REQUIREMENTS, HYDRAULIC TESTING, DISINFECTION, EXECUTION AND CLOSEOUT REQUIREMENTS AND AS-BUILT SURVEY.
2. STATIC PRESSURE IS TYPICALLY BETWEEN 60 PSI AND 70 PSI. THE LINE IS BELIEVED TO SERVE FIRE HYDRANTS ONLY (FOUR AT THE EXISTING AIRLINE GATE CONCOURSE AND ONE EACH ADJACENT TO THE INBOUND AND OUTBOUND BAGGAGE ROOMS. THE BUILDING FIRE AND DOMESTIC WATER SERVICE ENTRANCES ARE FED FROM THE EXISTING WATER MAIN LOCATED ALONG THE TERMINAL LOOP ROADWAY ON THE PUBLIC SIDE OF THE BUILDING.
3. THE CONTRACTOR SHALL GIVE 5 BUSINESS DAYS NOTICE TO AIRPORT MANAGEMENT, THE AIRPORT PUBLIC SAFETY OFFICE, THE CAPE FEAR PUBLIC UTILITY AUTHORITY (CFPUA), AND THE NEW HANOVER COUNTY FIRE DEPARTMENT PRIOR TO SCHEDULED CLOSING OR OPENING OF VALVES, REMOVING FIRE HYDRANTS FROM SERVICE, RETURNING FIRE HYDRANTS TO SERVICE, AND FOR INITIATING ANY PHASE OF WATER MAIN CONSTRUCTION OR TESTING.
4. NEW WATER MAIN SHALL BE CLASS 350 DUCTILE IRON PIPE, AWWA C 150/C 151. NEW FITTINGS SHALL BE COMPACT DUCTILE IRON MECHANICAL JOINT, AWWA C 153. INTERIOR COATING FOR PIPE AND FITTINGS SHALL BE CEMENT MORTAR LINING WITH ASPHALTIC COATING, AWWA C104. EXTERIOR COATING FOR PIPE AND FITTINGS SHALL BE ARC-SPRAYED ZINC, ISO 8179-1, AWWA C151.
5. THRUST RESTRAINT: WORKING PRESSURE SHALL BE 100 PSI. TEST PRESSURE SHALL BE 150 PSI. ALL WATER MAIN VALVES, HYDRANTS, AND ALL FITTINGS SHALL BE RESTRAINED USING THRUST BLOCKS OR RESTRAINED JOINTS AS INDICATED ON THE PLANS.
6. CONNECTIONS TO EXISTING WATER MAIN SHALL BE MADE WITH MECHANICAL JOINT FITTING OR SLEEVES. CONTRACTOR SHALL VERIFY CONDITION AND DEPTH OF EXISTING MAIN AT CONNECTION POINTS AND ADVISE THE ENGINEER AND CFPUA OF THE FINDINGS.
7. ALL WATER MAINS SHALL BE INSTALLED USING PIPE EMBEDMENT TYPE B OR C, DEPENDING ON DEPTH, EXCEPT THAT ALL BACKFILL MATERIAL UP TO A LEVEL OF 6" ABOVE TOP OF PIPE SHALL HAVE NO MORE THAN 5% PASSING THE NO. 200 SIEVE (PROVIDE NCDOT NO 2S CONCRETE SAND).

TALBERT & BRIGHT, INC.  
 4810 SHELLEY DRIVE  
 WILMINGTON, NC, 28405  
 NC C-0713



**THE WILSON GROUP**  
 ARCHITECTS

PO Box 5510 Charlotte, NC 28299  
 704-331-9747 • www.twgarchitects.com

PROJECT MANAGER & CIVIL ENGINEER  
**TALBERT & BRIGHT**  
 CONSULTING ARCHITECT

LS3P  
 STRUCTURAL ENGINEER  
**STEWART**

FP/PM/E ENGINEER  
**CHEATHAM & ASSOC.**

BAGGAGE HANDLING CONSULTANTS  
**BNP**

AIRCRAFT SUPPORT SYSTEMS  
**DK CONSULTANTS**

SPECIALTY LIGHTING CONSULTANT  
**HARTRANFT**

SIGNAGE & WAYFINDING  
**TAKEFORM**



COPYRIGHT © 2019  
 THE WILSON GROUP ARCHITECTS  
 ALL RIGHTS RESERVED  
 PRINTED OR ELECTRONIC DRAWINGS AND DOCUMENTATION MAY NOT BE REPRODUCED IN ANY FORM WITHOUT WRITTEN PERMISSION FROM THE WILSON GROUP ARCHITECTS


**REVISIONS**


7/17/19	AD-02
7/22/19	AD-03

DATE 6/28/2019  
 PROJECT NUMBER 9202-000  
 SHEET TITLE

**PROPOSED WATERLINE - SCHEDULE 1**

SHEET NUMBER  
**C-401**

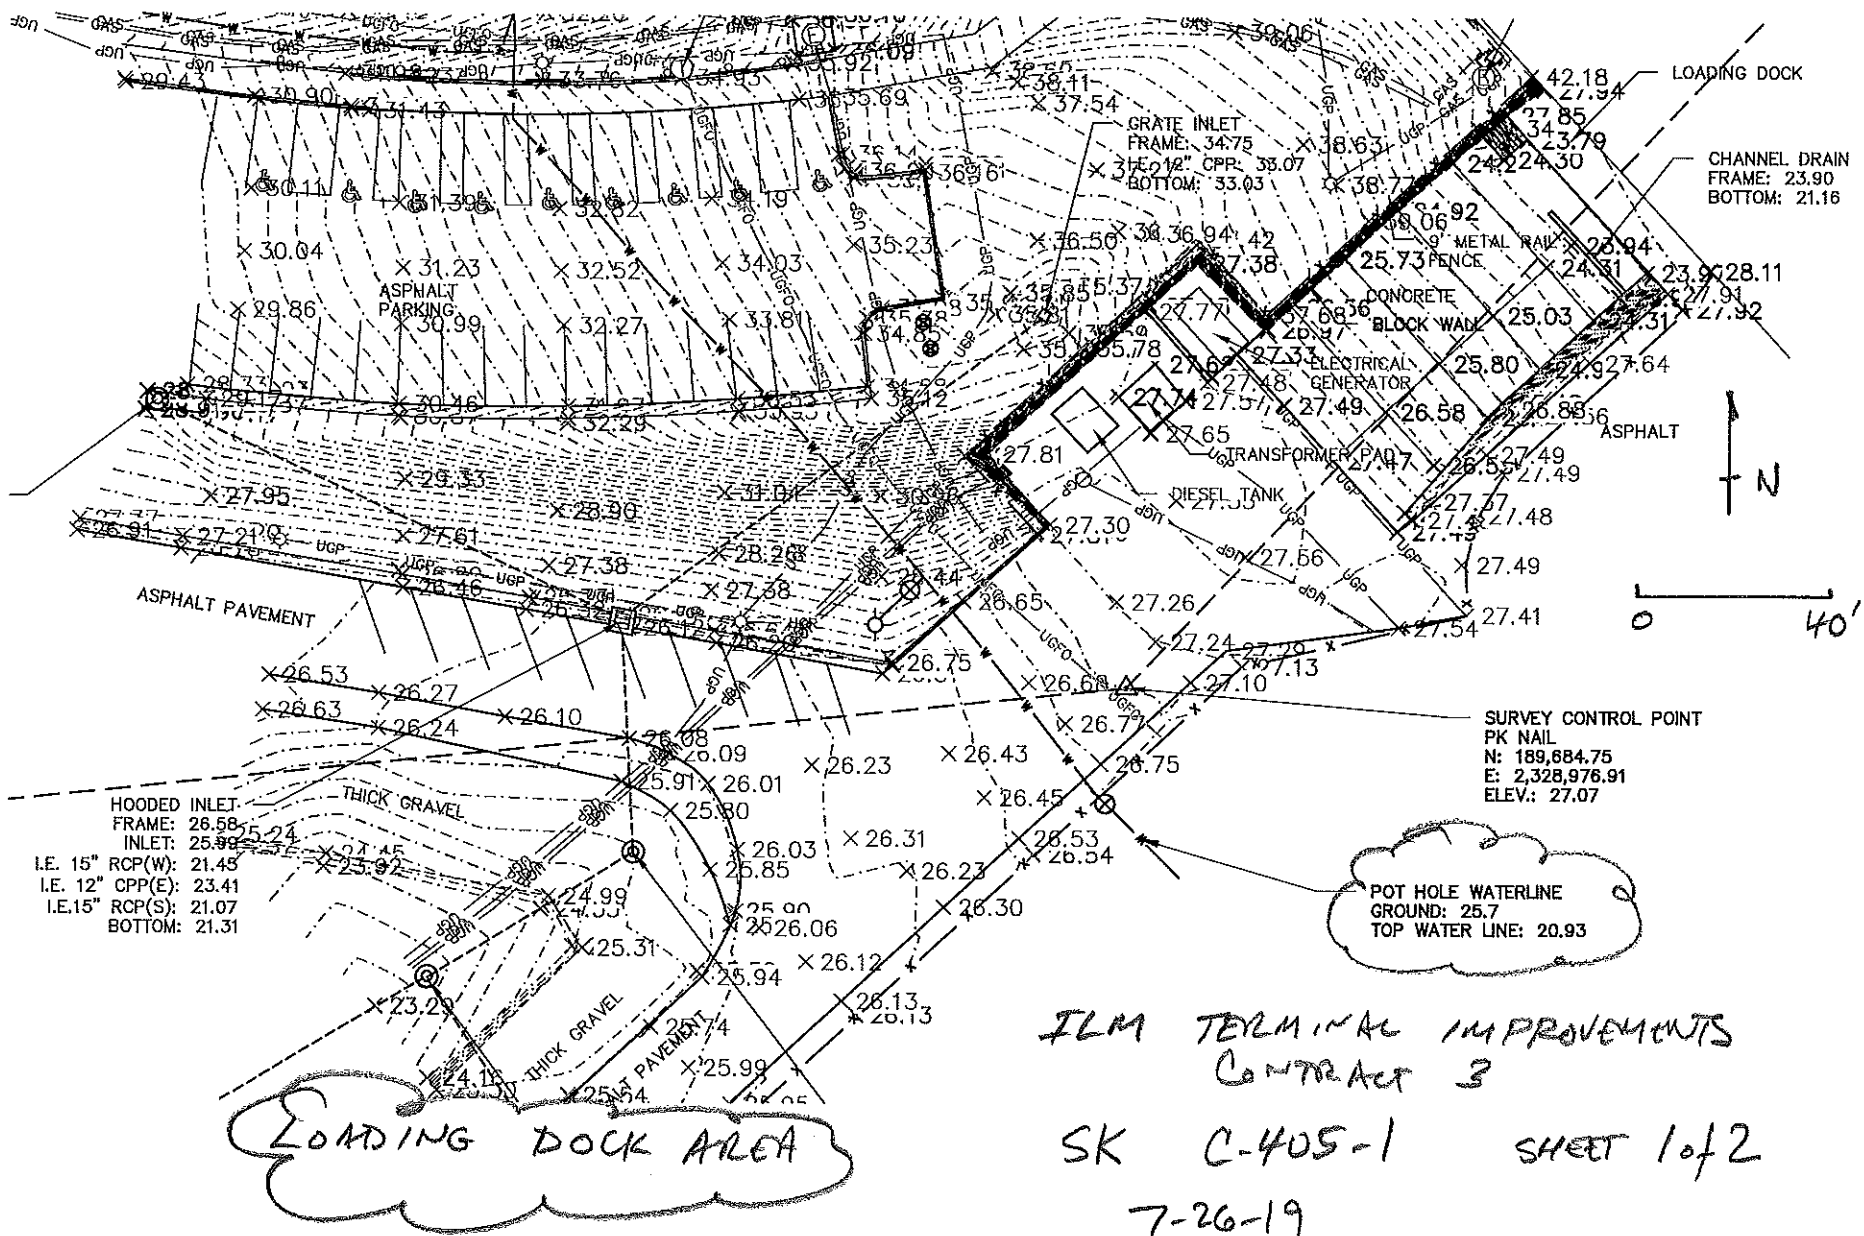

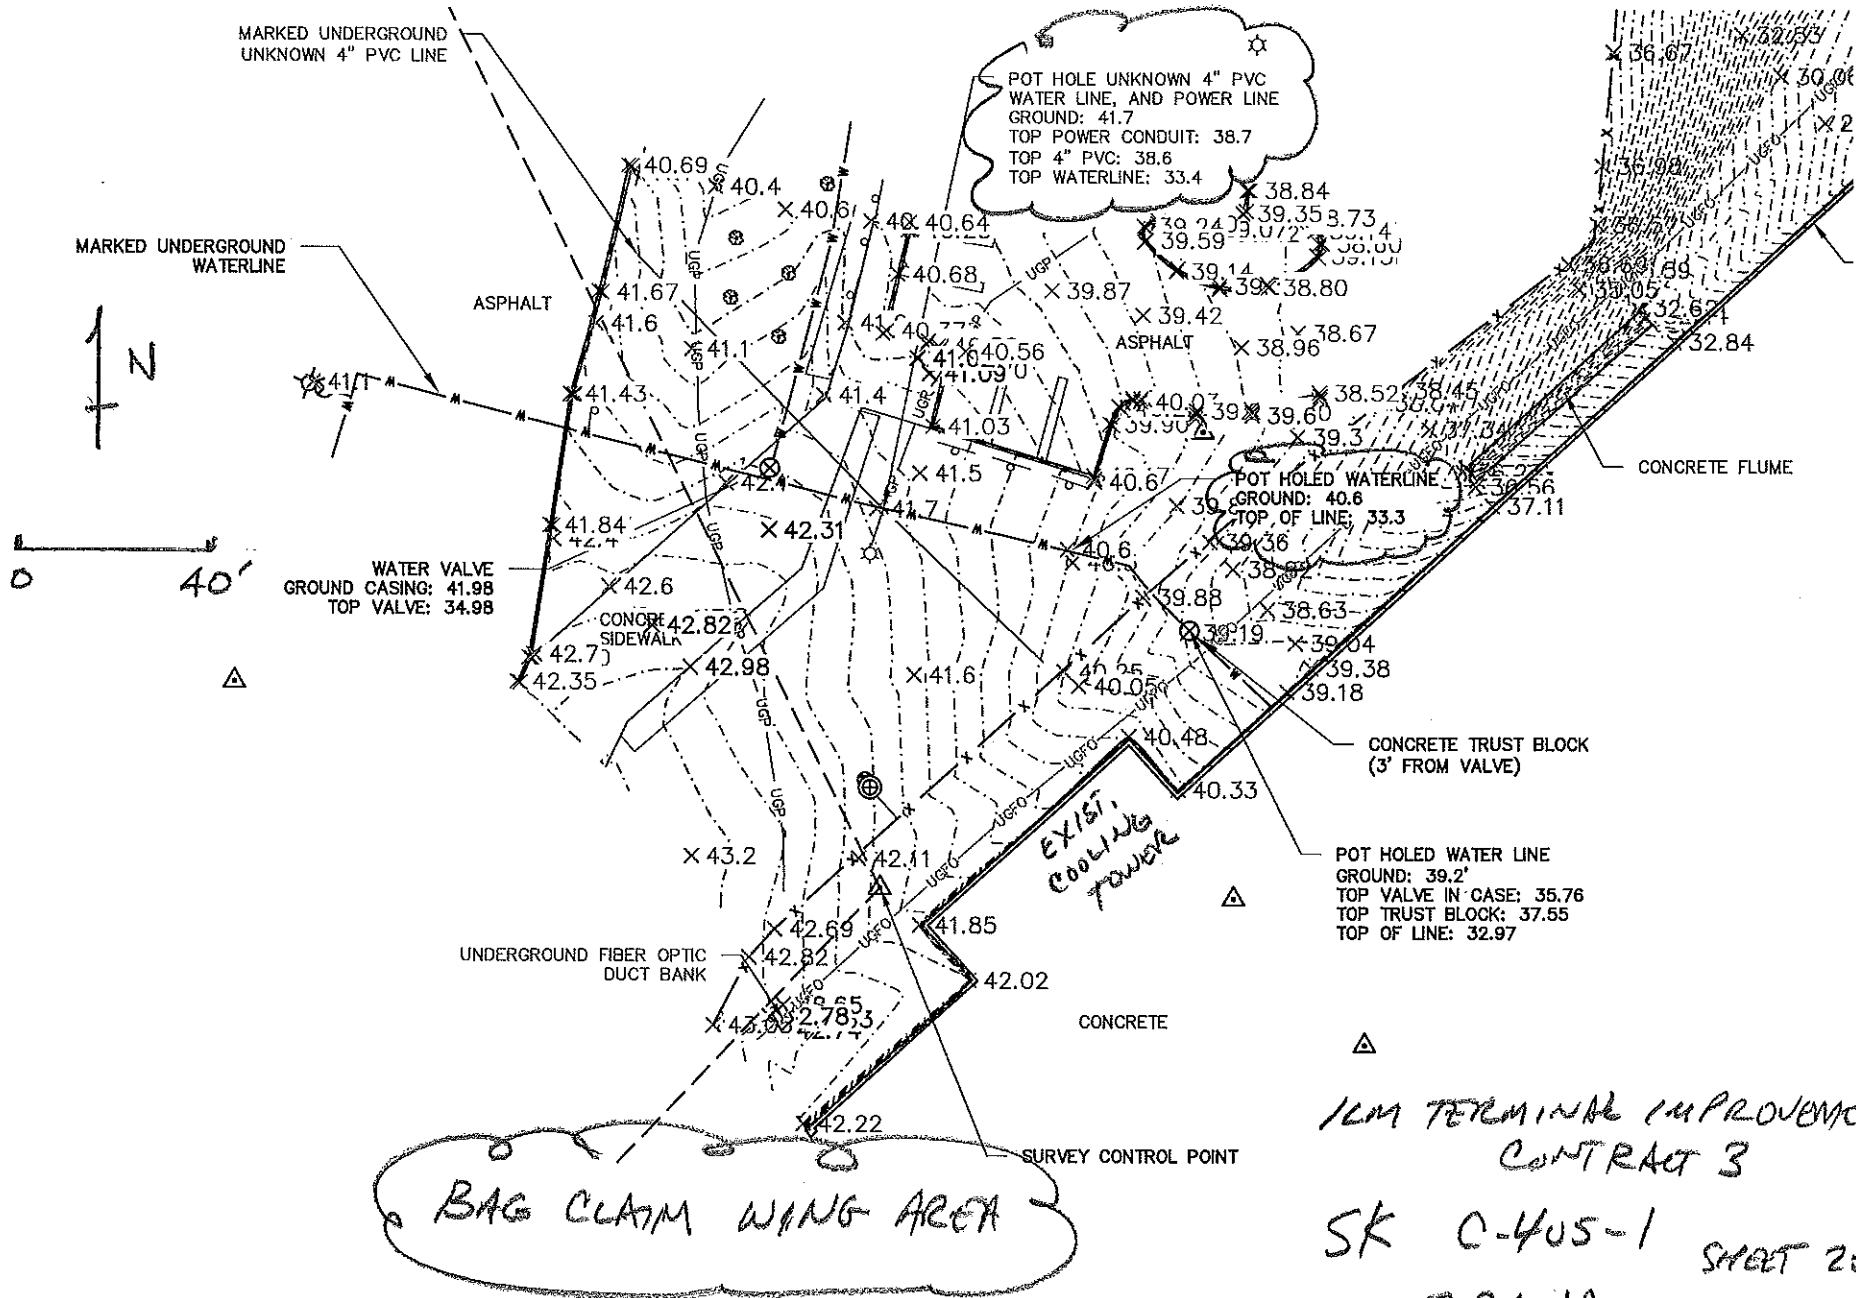

1CM TERMINAL IMPROVEMENTS  
CONTRACT 3



SK C-405-1 SHEET 2 of 2

7-26-19



TERMINAL IMPROVEMENTS CONTRACT 3

Wilmington International Airport 1740 Airport Boulevard, Suite 12 Wilmington, NC 28405

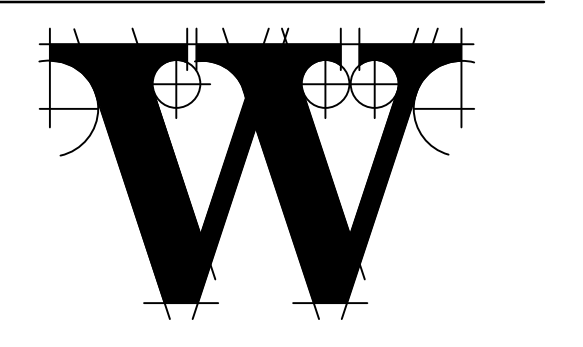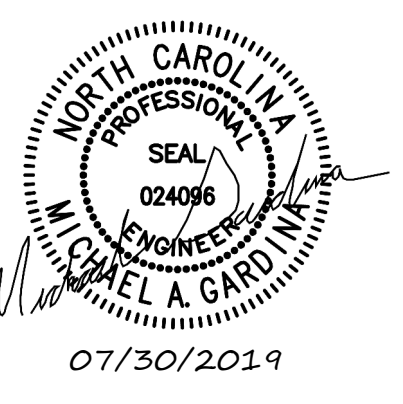

THE WILSON GROUP ARCHITECTS

PO Box 5510 Charlotte, NC 28299 704-331-9747 • www.twgarchitects.com

PROJECT MANAGER & CIVIL ENGINEER TALBERT & BRIGHT

CONSULTING ARCHITECT LS3P

STRUCTURAL ENGINEER FIRM LICENSE #C-1051 STEWART

FP/PM/E ENGINEER CHEATHAM & ASSOC.

BAGGAGE HANDLING CONSULTANTS BNP

AIRCRAFT SUPPORT SYSTEMS DK CONSULTANTS

SPECIALTY LIGHTING CONSULTANT HARTTRANFT

SINGAGE & WAYFINDING TAKEFORM

COPYRIGHT © 2019 THE WILSON GROUP ARCHITECTS ALL RIGHTS RESERVED

PRINTED OR ELECTRONIC DRAWINGS AND DOCUMENTATION MAY NOT BE REPRODUCED IN ANY FORM WITHOUT WRITTEN PERMISSION FROM THE WILSON GROUP ARCHITECTS

REVISIONS

3 7/30/19 AD-03

DATE 07/15/19 PROJECT NUMBER 9202-000 SHEET TITLE

STATEMENT OF SPECIAL INSPECTIONS

SHEET NUMBER S0-003

Statement of Special Inspections

The following information is being submitted in accordance with the Special Inspection provisions of the 2017 Ohio Building Code. Attached is the Schedule of Special Inspections (SSI) required for this project. This completed form is required to be placed on the drawings for plan review. After permit issuance, a listing of the Special Inspection Firms (SIF) and the Designated Special Inspectors (DSI) for each inspection type will be attached to this form prior to scheduling the Pre-Construction Meeting with the governing authority. No work is permitted to be performed prior to the Special Inspections Pre-Construction Meeting.

The DSI is responsible for verifying all information on each document prior to signing/sealing. The DSI is responsible for verifying each document is the correct document. The DSI is responsible for correcting any documents that contain errors. The DSI is responsible for verifying all ASIs maintain current certifications during the course of the project, as failure to maintain current certifications may result in a voided document. At the conclusion of each individual Special Inspection type, the DSI will complete a Final Report.

The Special Inspection program outlined herein, does not relieve the Contractor or any other entity of any contractual duties, including quality control, quality assurance, or safety. The Contractor is solely responsible for construction means, methods, and job site safety.

Required Certifications for each Inspection Type

Each Inspector performing the Inspection type to submit certification to the engineer of record prior to performing the inspection.

Verification of Soils

- Current NIDET Level II certification in Geotechnical Engineering Technology/Construction; or
Current NIDET Level II soils certificate in Construction Materials Testing; or
Current ICC Soils Special Inspector certificate; or
Licensed Geologist with one year related experience; or
Engineer-in-Training (EIT) with one year related experience; or
Geologist-in-Training (GIT) with one year related experience

Excavation and Filling

- Current NIDET Level II certificate in Geotechnical Engineering Technology/Construction; or
Current NIDET Level II soils certificate in Construction Materials Testing; or
Current ICC Soils Special Inspector certificate; or
Licensed Geologist with one year related experience; or
Engineer-in-Training (EIT) with one year related experience; or
Geologist-in-Training (GIT) with one year related experience

Reinforced Concrete

- Current ICC Reinforced Concrete Special Inspector certificate; or
ACI Concrete Construction Special Inspector certificate; or
Engineer-in-Training (EIT) with one year related experience
Inspection of Pre-Cast Concrete Fabricators
Pre-Cast/Pre-Stressed Concrete Institute (PCI) Quality Control Technician/Inspector Level II certificate

Inspection of Structural Steel Fabricators

- Current AWS D1.1 Certified Welding Inspector; or
Current ICC Structural Steel and Welding certificate plus one year of related experience; or
Current NDI Level II (along with in-house level III trainer's certificate) or Level III

Structural Masonry

- Current ICC Structural Masonry certificate and one year of related experience; or
Engineer-in-Training (EIT) with one year related experience

Welding

- Current AWS D1.1 Certified Welding Inspector; or
Current ICC Structural Steel and Welding certificate plus one year of related experience; or
Current NDI Level II (along with in-house level III trainer's certificate) or Level III

High-Strength Bolting and Steel Frame Inspection

- Current ICC Structural Steel & Bolting certificate plus one year of related experience; or
Engineer-in-Training (EIT) with one year related experience

- Professional Engineer or Architect registered in the State of Ohio; or

SPECIAL INSPECTIONS REPORTING REQUIREMENTS:

- Each Special Inspector to leave a written copy of their daily report on site, initialed by the contractor, and entered in the daily inspection log maintained by the General Contractor. Any corrections or discrepancies will be reviewed by the Special Inspector and the General Contractor prior to leaving site.
2. Each daily report must describe the area of the inspection, the structural items inspected, a brief description of what was built, and if it was in conformance with the construction documents.
3. Correction items not corrected before the special inspector leaves the site but do not require input from the design team will require a separate correction notice which will be given to the General Contractor and included in the monthly report. This is to be a separate report from the daily report. The correction will be added to the correction log.
4. Items which are discrepancies and require input from the design team will require in a separate discrepancy notice given to the General Contractor, Engineer of Record, and Architect of Record. This is to be a separate report from the daily report. The discrepancy will be added to the discrepancy log.
5. All corrections and discrepancy items on the logs will remain on the log until resolved. When the items are resolved the log or the notices are to indicate how and when the item was resolved.
6. A monthly report will be provided which will include the field reports for that month, the corrections, correction log, discrepancy, and the discrepancy log.
7. Bound monthly report to be submitted to the General Contractor, Engineer of Record, Architect of Record, Owner and Building official within the first week of the month.
8. Upon completion of the construction of the items specified in the Statement of Special Inspections, completion of all material tests, and correction of all open discrepancies, the Special Inspector shall submit a signed and sealed Final Statement of Special Inspections stating that the construction has been completed and that all discovered discrepancies have been resolved.

REQUIRED SPECIAL INSPECTIONS AND TESTS OF VERIFICATION OF SOILS (Refer to IBC Table 1705.6)

Table with 5 columns: Check if required, Inspection Task, C, P, Standard, Notes/Comments. Includes rows for foundation bearing capacity and compacted fill materials.

REQUIRED SPECIAL INSPECTIONS AND TESTS OF EXCAVATION AND FILL (Refer to IBC Table 1705.6)

Table with 5 columns: Check if required, Inspection Task, C, P, Standard, Notes/Comments. Includes rows for excavation depth, material use, and compacted fill preparation.

REQUIRED SPECIAL INSPECTIONS AND TESTS OF INSPECTION OF STRUCTURAL STEEL FABRICATORS

Table with 5 columns: Check if required, Inspection Task, C, P, Standard, Notes/Comments. Includes row for fabricator approval.

REQUIRED SPECIAL INSPECTIONS AND TESTS OF WIND RESISTANCE

Table with 5 columns: Check if required, Inspection Task, C, P, Standard, Notes/Comments. Includes rows for wind-resisting components and exterior wall connections.

REQUIRED SPECIAL INSPECTIONS AND TESTS OF SPECIAL CASES

Table with 5 columns: Check if required, Inspection Task, C, P, Standard, Notes/Comments. Includes rows for fire resistant penetration and retaining walls.

REQUIRED SPECIAL INSPECTIONS AND TESTS OF CONCRETE CONSTRUCTION (TABLE 1705.3)

Table with 5 columns: Check if required, TYPE, C, P, REFERENCED STANDARD, IBC REFERENCE. Includes rows for reinforcement, welding, anchors, and concrete placement.

REQUIRED SPECIAL INSPECTIONS AND TESTS OF STRUCTURAL MASONRY LEVEL C QUALITY ASSURANCE

Table with 5 columns: MINIMUM TEST, FREQUENCY, REFERENCE FOR CRITERIA, INSPECTION TASK, C, P. Includes rows for mortar verification, slump flow, proportions, and reinforcement placement.

REQUIRED SPECIAL INSPECTIONS OF OPEN-WEB STEEL JOISTS AND JOIST GIRDERS (TABLE 1705.2.3)

Table with 5 columns: TYPE, C, P, REFERENCED STANDARD. Includes rows for installation, end connections, and bridging.

DATE 07/15/19 PROJECT NUMBER 9202-000 SHEET TITLE


STATEMENT OF SPECIAL INSPECTIONS

SHEET NUMBER S0-003



TERMINAL IMPROVEMENTS CONTRACT 3

Wilmington International Airport 1740 Airport Boulevard, Suite 12 Wilmington, NC 28405

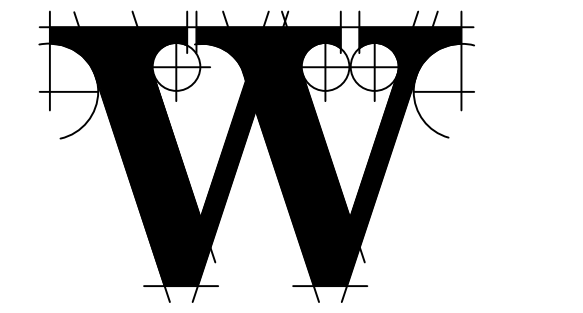

THE WILSON GROUP ARCHITECTS

PO Box 5510 Charlotte, NC 28299 704-331-9747 • www.twgarchitects.com

PROJECT MANAGER & CIVIL ENGINEER TALBERT & BRIGHT

CONSULTING ARCHITECT LS3P

STRUCTURAL ENGINEER FIRM LICENSE #C-1051 STEWART

FP/PM/E ENGINEER CHEATHAM & ASSOC.

BAGGAGE HANDLING CONSULTANTS BNP

AIRCRAFT SUPPORT SYSTEMS DK CONSULTANTS

SPECIALTY LIGHTING CONSULTANT HARTRANFT

SINGAGE & WAYFINDING TAKEFORM

COPYRIGHT © 2019 THE WILSON GROUP ARCHITECTS ALL RIGHTS RESERVED

PRINTED OR ELECTRONIC DRAWINGS AND DOCUMENTATION MAY NOT BE REPRODUCED IN ANY FORM WITHOUT WRITTEN PERMISSION FROM THE WILSON GROUP ARCHITECTS

REVISIONS

3 7/30/19 AD-03

DATE 07/15/19 PROJECT NUMBER 9202-000 SHEET TITLE

STATEMENT OF SPECIAL INSPECTIONS

SHEET NUMBER S0-004

QUALITY ASSURANCE (QA) FOR INSTALLATION OF STEEL DECK Appendix 1. Tables of Inspection or Execution Tasks

"Observe" shall mean to inspect these items on an intermittent basis. Operations need not be delayed pending these inspections. Frequency of observations shall be adequate to confirm that the work has been performed in accordance with the applicable documents. In the event that observations determine that the materials and/or workmanship are not in conformance with the applicable documents, additional inspections shall be performed to determine the extent of non-conformance.

"Perform" shall mean to perform these tasks prior to final acceptance for each item or element.

Within the listed tasks, "Document" shall mean the Inspector shall prepare reports or other appropriate written documentation indicating that the work has or has not been performed in accordance with the construction documents.

Table 1.1. Inspection or Execution Tasks Prior to Deck Placement

Table with 3 columns: TASK, Description, and QA. Row A: Verify compliance of materials (deck and all deck accessories) with construction documents, including profiles, material properties, and base metal thickness. Row B: Document acceptance or rejection of deck and deck accessories.

Table 1.2. Inspection or Execution Tasks After Deck Placement

Table with 3 columns: TASK, Description, and QA. Row A: Verify compliance of deck and all deck accessories installation with construction documents. Row B: Verify deck materials are represented by the mill certifications that comply with the construction documents. Row C: Document acceptance or rejection of installation of deck and deck accessories.

Table 1.3. Inspection or Execution Tasks Prior to Welding

Table with 3 columns: TASK, Description, and QA. Row A: Welding procedure specifications (WPS) available. Row B: Manufacturer certifications for welding consumables available. Row C: Material identification (type/grade). Row D: Check welding equipment.

Table 1.4. Inspection or Execution Tasks During Welding

Table with 3 columns: TASK, Description, and QA. Row A: Use of qualified welders. Row B: Control and handling of welding consumables. Row C: Environment conditions (wind speed, moisture, temperature). Row D: WPS followed.

Table 1.5. Inspection or Execution Tasks After Welding

Table with 3 columns: TASK, Description, and QA. Row A: Verify size and location of welds, including support, sidelap, and perimeter welds. Row B: Welds meet visual acceptance criteria. Row C: Verify repair activities. Row D: Document acceptance or rejection of welds.

Table 1.6. Inspection or Execution Tasks Prior to Mechanical Fastening

Table with 3 columns: TASK, Description, and QA. Row A: Manufacturer installation instructions available for mechanical fasteners. Row B: Proper tools available for fastener installation. Row C: Proper storage for mechanical fasteners.

Table 1.7. Inspection or Execution Tasks During Mechanical Fastening

Table with 3 columns: TASK, Description, and QA. Row A: Fasteners are positioned as required. Row B: Fasteners are installed in accordance with manufacturer's instructions.

Table 1.8. Inspection or Execution Tasks After Mechanical Fastening

Table with 3 columns: TASK, Description, and QA. Row A: Check spacing, type, and installation of support fasteners. Row B: Check spacing, type, and installation of sidelap fasteners. Row C: Check spacing, type, and installation of perimeter fasteners. Row D: Verify repair activities. Row E: Document acceptance or rejection of mechanical fasteners.

REQUIRED SPECIAL INSPECTIONS AND TEST OF WELDING

TABLE NS.4-1 Inspection Tasks Prior to Welding. Table with 2 columns: Inspection Tasks, QA. Includes rows for WPS availability, manufacturer certifications, material identification, welder identification, fit-up of groove welds, configuration and finish of access holes, fit-up of fillet welds, and check welding equipment.

The fabricator or erector, as applicable, shall maintain a system by which a welder who has welded a joint or member can be identified. Stamps, if used, shall be the low-stress type.

TABLE NS.4-2 Inspection Tasks During Welding. Table with 2 columns: Inspection Tasks, QA. Includes rows for use of qualified welders, control and handling of welding consumables, no welding over cracked tack welds, environmental conditions, WPS followed, and welding techniques.

TABLE NS.4-3 Inspection Tasks After Welding. Table with 2 columns: Inspection Tasks, QA. Includes rows for welds cleaned, size, length and location of welds, welds meet visual acceptance criteria, arc strikes, k-area, backing removed and weld tabs removed, repair activities, and document acceptance or rejection of welded joint or member.

- 5. Nondestructive Testing of Welded Joints
5a. Procedures
5b. CJP Groove Weld NDT

REQUIRED SPECIAL INSPECTIONS AND TEST OF BOLTING

TABLE NS.6-1 Inspection Tasks Prior to Bolting. Table with 2 columns: Inspection Tasks, QA. Includes rows for manufacturer's certifications, fasteners marked in accordance with ASTM requirements, proper fasteners selected for the joint detail, proper bolting procedure selected for joint detail, connecting elements, pre-installation testing, and proper storage provided for bolts, nuts, washers and other fastener components.

TABLE NS.6-2 Inspection Tasks During Bolting. Table with 2 columns: Inspection Tasks, QA. Includes rows for fastener assemblies, joint brought to the snug-tight condition, fastener component not turned by the wrench, and fasteners are pretensioned.

TABLE NS.6-2 Inspection Tasks After Bolting. Table with 2 columns: Inspection Tasks, QA. Includes row for document acceptance or rejection of bolted connections.

TABLE NS.6.1 Inspection of Steel Elements of Composite Construction Prior to Concrete Placement. Table with 2 columns: Inspection of Steel Elements of Composite Construction Prior to Concrete Placement, QA. Includes rows for placement and installation of steel deck, placement and installation of steel headed stud anchors, and document acceptance or rejection of steel elements.

N7. APPROVED FABRICATORS AND ERECTORS
Quality assurance (QA) inspections, except nondestructive testing (NDT), may be waived when the work is performed in a fabricating shop or by an erector approved by the authority having jurisdiction (AHJ) to perform the work without QA.

N8. NONCONFORMING MATERIAL AND WORKMANSHIP
Identification and rejection of material or workmanship that is not in conformance with the construction documents shall be permitted at any time during the progress of the work.

Nonconforming material or workmanship shall be brought into conformance, or made suitable for its intended purpose as determined by the engineer of record.


Concurrent with the submittal of such reports to the AHJ, EOR or owner, the QA agency shall submit to the fabricator and erector:
1. Nonconformance reports
2. Reports of repair, replacement or acceptance of nonconforming items





TERMINAL IMPROVEMENTS CONTRACT 3

Wilmington International Airport 1740 Airport Boulevard, Suite 12 Wilmington, NC 28405

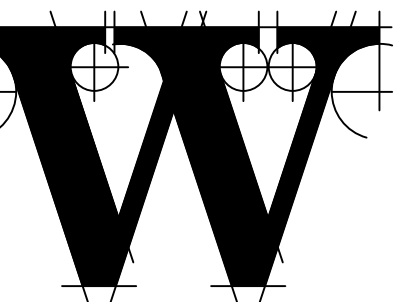

THE WILSON GROUP ARCHITECTS

PO Box 5510 Charlotte, NC 28299 704-331-9747 • www.twgarchitects.com

PROJECT MANAGER & CIVIL ENGINEER TALBERT & BRIGHT

CONSULTING ARCHITECT LS3P

STRUCTURAL ENGINEER FIRM LICENSE #C-1051 STEWART


FP/PM/E ENGINEER CHEATHAM & ASSOC.

BAGGAGE HANDLING CONSULTANTS BNP

AIRCRAFT SUPPORT SYSTEMS DK CONSULTANTS

SPECIALTY LIGHTING CONSULTANT HARTTRANFT

SINGAGE & WAYFINDING TAKEFORM

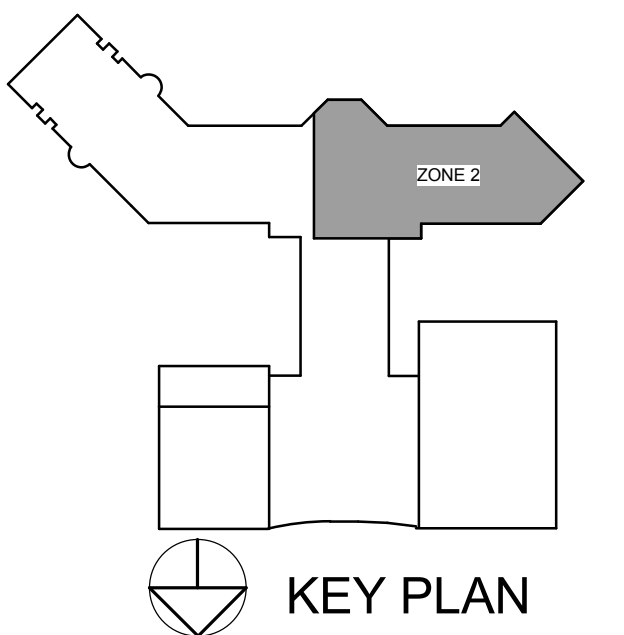

COPYRIGHT © 2019 THE WILSON GROUP ARCHITECTS ALL RIGHTS RESERVED

PRINTED OR ELECTRONIC DRAWINGS AND DOCUMENTATION MAY NOT BE REPRODUCED IN ANY FORM WITHOUT WRITTEN PERMISSION FROM THE WILSON GROUP ARCHITECTS

REVISIONS


3 7/30/19 AD-03

DATE 06/28/2019 PROJECT NUMBER 9202-000 SHEET TITLE

PARTIAL FOUNDATION PLAN SCHEDULE 1 ZONE 2

SHEET NUMBER

S1-102

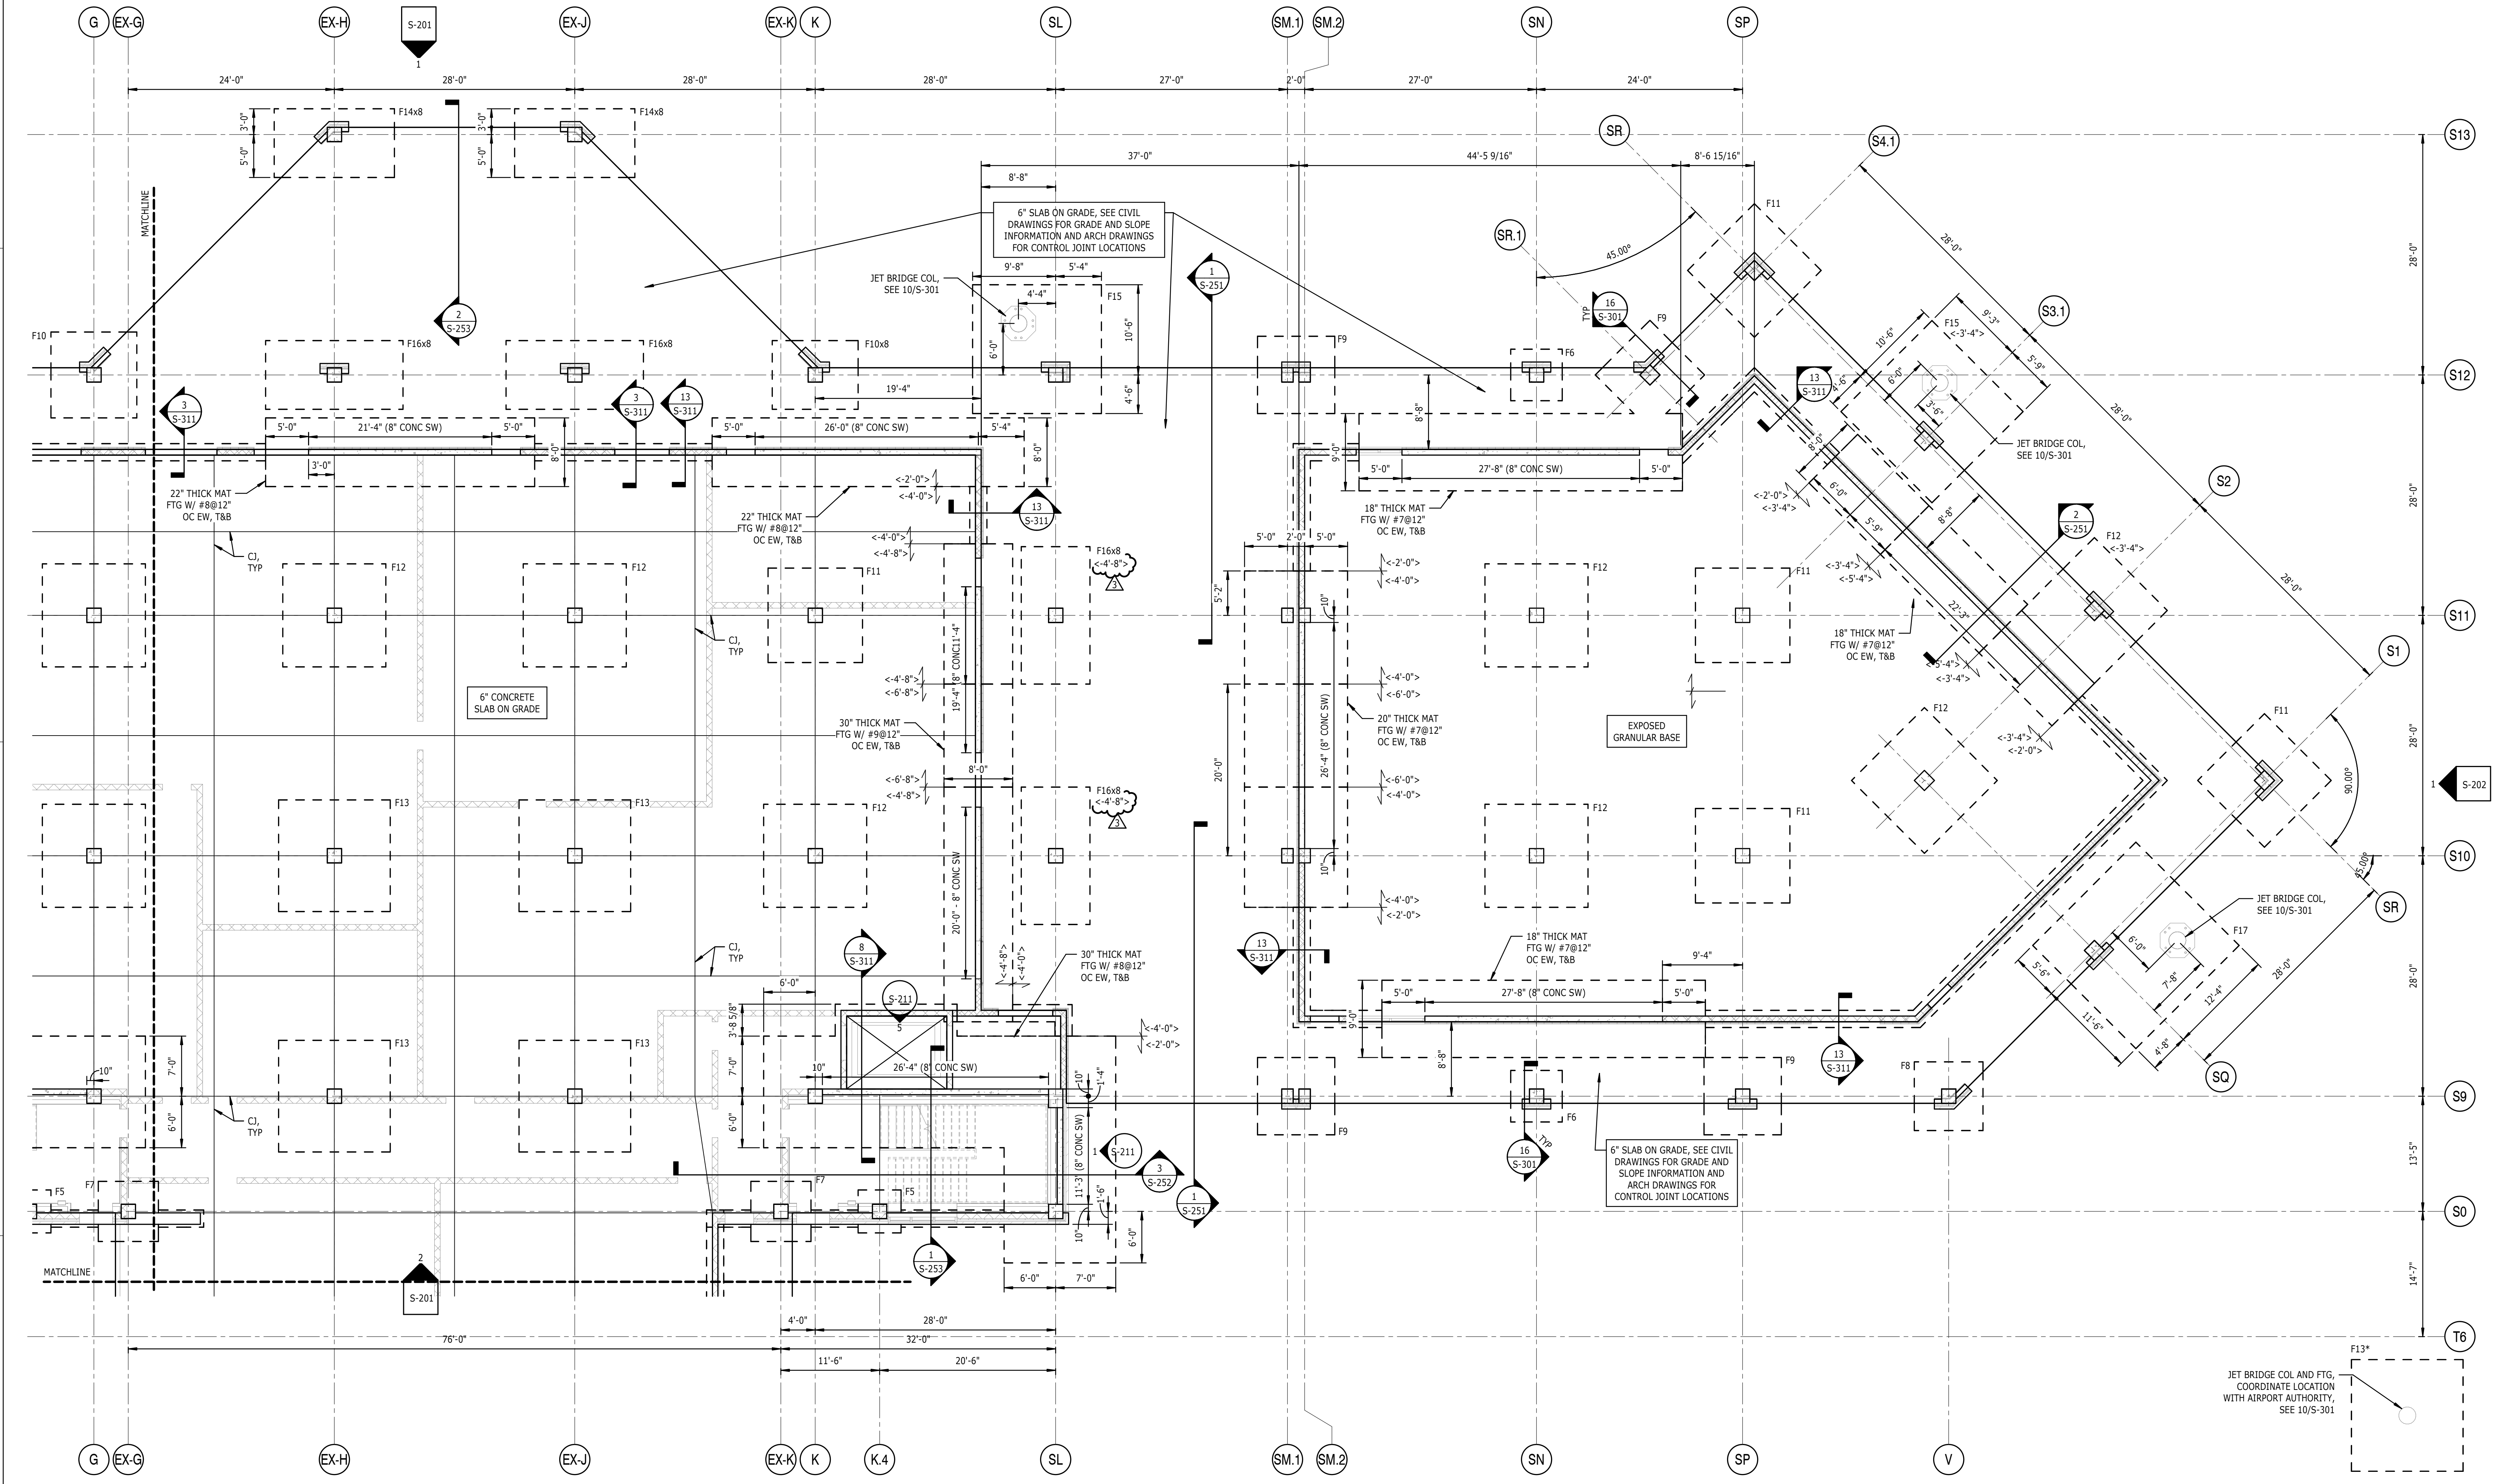

1 FOUNDATION PLAN SCHEDULE 1 ZONE 2

1/8" = 1'-0"


NOTES:

- 1. FOR GENERAL NOTES AND ABBREVIATIONS, SEE S-001.
2. SEE CIVIL DRAWINGS FOR FINISHED FLOOR ELEVATION, UNO. REFERENCE ELEVATION 0'-0".
3. [NG] INDICATES DEPRESSED OR RAISED SLAB ELEVATION, SEE PLAN.
4. TOP OF FOOTING 2'-0" BELOW FINISHED FLOOR ELEVATION, UNO.
5. [T] INDICATES STEP IN WALL FOOTING, SEE 9/S-301.
6. "F#" INDICATES FOOTING TYPE, SEE 7/S-301.
7. FOR STEEL COLUMN SCHEDULE, SEE 1/S-301.
8. FOR CONCRETE COLUMN SCHEDULE, SEE 1/S-323.
9. "CONC SW" INDICATES CONCRETE SHEARWALL, SEE \_\_\_ FOR SCHEDULE.
10. FOR TYPICAL SLAB CONSTRUCTION DETAILS, SEE 1/S-301.



TERMINAL IMPROVEMENTS CONTRACT 3

Wilmington International Airport  
1740 Airport Boulevard, Suite 12  
Wilmington, NC 28405

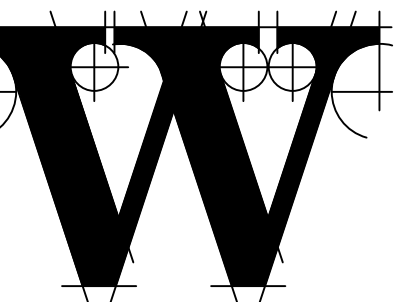

THE WILSON GROUP - ARCHITECTS -

PO Box 5510 Charlotte, NC 28299  
704-331-9747 • www.twgarchitects.com

PROJECT MANAGER & CIVIL ENGINEER

TALBERT & BRIGHT

CONSULTING ARCHITECT

LS3P

STRUCTURAL ENGINEER

FIRM LICENSE #C-1051

STEWART

FPI/P/ME ENGINEER

CHEATHAM & ASSOC.

BAGGAGE HANDLING CONSULTANTS

BNP

AIRCRAFT SUPPORT SYSTEMS

DK CONSULTANTS

SPECIALTY LIGHTING CONSULTANT

HARTRANFT

SINGAGE & WAYFINDING

TAKEFORM

COPYRIGHT © 2019  
THE WILSON GROUP ARCHITECTS  
ALL RIGHTS RESERVED

PRINTED OR ELECTRONIC DRAWINGS AND DOCUMENTATION MAY NOT BE REPRODUCED IN ANY FORM WITHOUT WRITTEN PERMISSION FROM THE WILSON GROUP ARCHITECTS

REVISIONS


3 7/30/19 AD-03

DATE 06/28/2019  
PROJECT NUMBER 9202-000  
SHEET TITLE

PARTIAL BOARDING LEVEL REBAR PLAN SCHEDULE 1 ZONE 1

SHEET NUMBER

S1-124


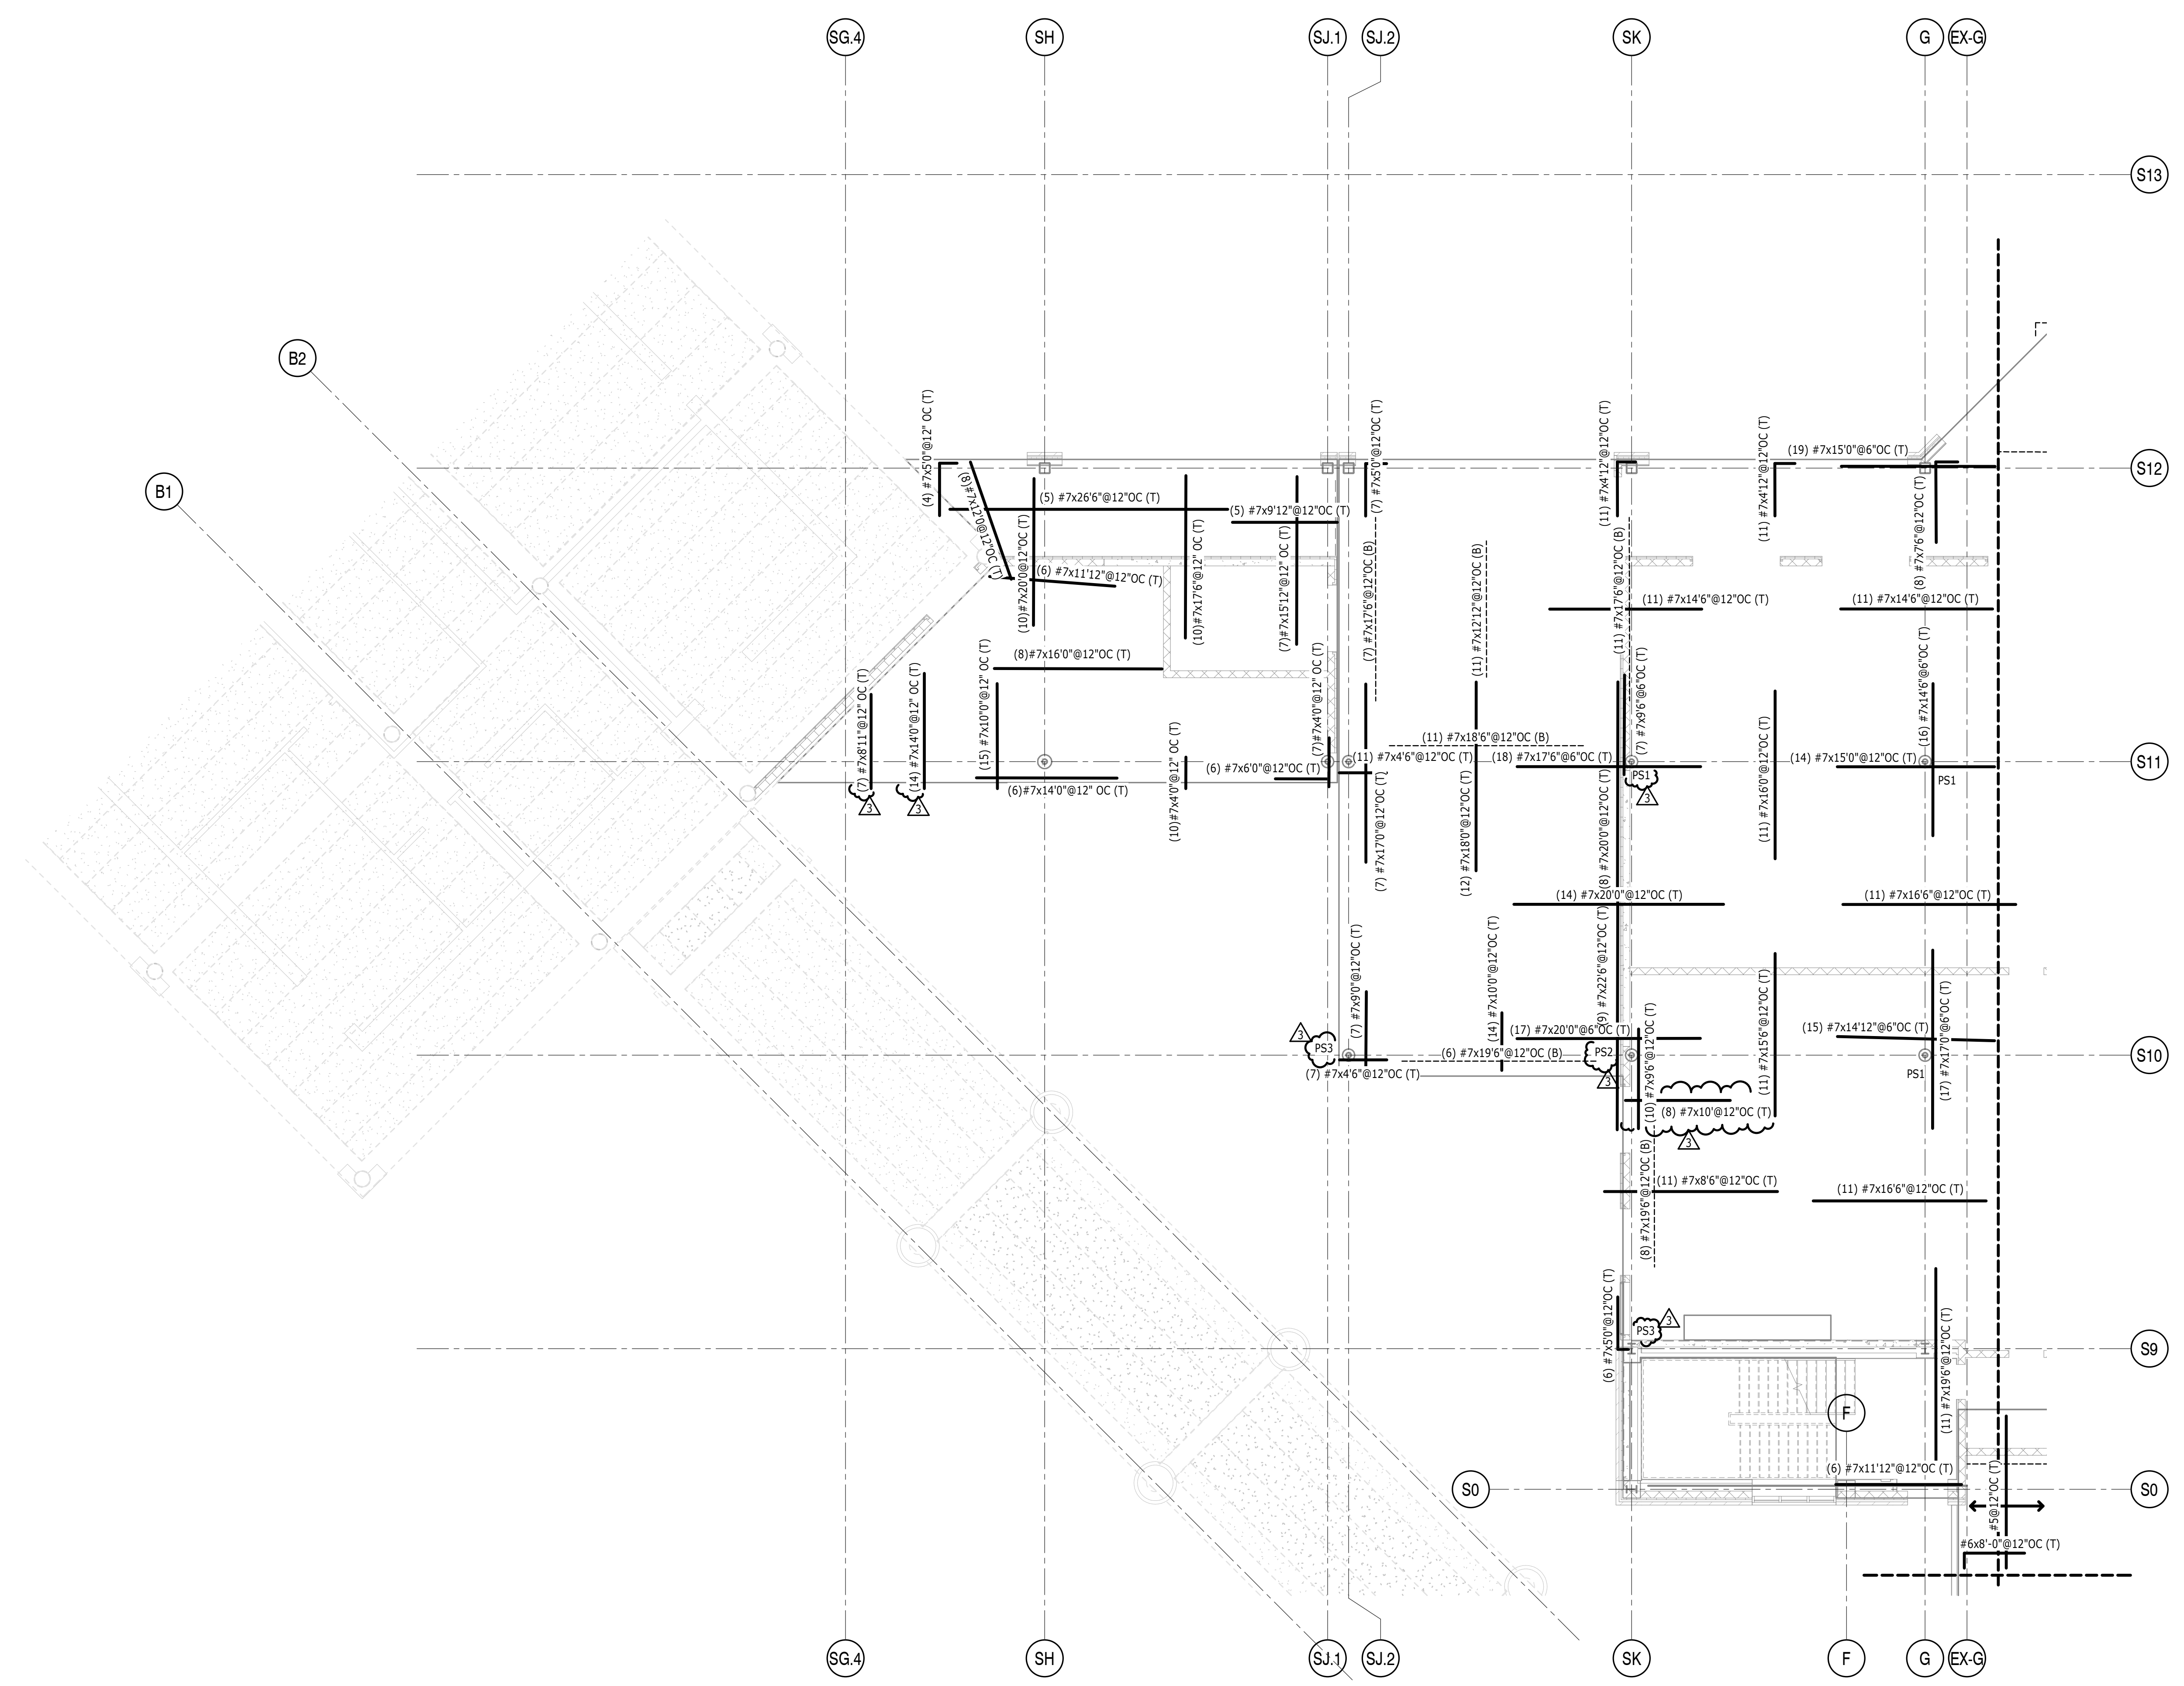


1 BOARDING LEVEL REBAR PLAN SCHEDULE 1 ZONE 1

S1-124 1/8" = 1'-0"

REBAR PLAN NOTES:

- FOR GENERAL NOTES AND ABBREVIATIONS, SEE S-001 AND S-002.
- FINISH FLOOR ELEVATION +13'-0" ABOVE REFERENCE FINISH FLOOR ELEVATION, UNLESS NOTED OTHERWISE.
- CONCRETE ELEVATED SLABS SHALL BE TWO-WAY FLAT PLATE CONCRETE SLAB. SEE PLAN FOR SLAB THICKNESS. TOP OF SLAB SHALL BE SLOPED WHERE NOTED ON ARCHITECTURAL DRAWINGS.
- ALL OPENINGS IN CONCRETE SLAB MUST BE LOCATED AND BLOCKED OUT PRIOR TO CONCRETE BEING PLACED. NO CORE DRILLING IS PERMITTED WITHOUT CONSENT OF THE ENGINEER OF RECORD. SEE 7/S-322 FOR REINFORCING AT OPENINGS.
- "CONC SW" INDICATES CONCRETE SHEAR WALL.
- SEE ARCHITECTURAL DRAWINGS FOR PRECISE EDGE OF SLAB DIMENSIONS. ARCHITECTURAL DRAWINGS GOVERN ALL DIMENSIONS.
- SEE ARCHITECTURAL AND PLUMBING DRAWINGS FOR FLOOR DRAINS AND SLAB SLOPES.
- "PS\*" INDICATES STUD RAILS. STUD RAILS ARE REQUIRED TO BEGIN AT FACE OF COLUMN, SEE 7/S-321.
- PROVIDE ADDITIONAL STEEL AT ALL RE-ENTRANT CORNERS PER DETAIL 4/S-322.
- "CB" INDICATES CONCRETE BEAM, SEE 6/S-321.
- REINFORCING THAT TERMINATES AT THE INTERFACE BETWEEN SCHEDULE 1 AND SCHEDULE 2 SHALL HAVE THREADED COUPLERS AT THE ENDS OF SCHEDULE 1 REINFORCING. SCHEDULE 2 REINFORCING SHALL BE THREADED TO CONNECT TO THE COUPLERS INSTALLED IN SCHEDULE 1. THIS IS TYPICAL AT THE SLAB AND BEAMS ALONG THIS JOINT.
- "H" INDICATES REINFORCING STEEL WITH TYPICAL 90 OR 180 DEGREE HOOKS. LENGTHS INDICATED ON PLAN DO NOT INCLUDE HOOKS.

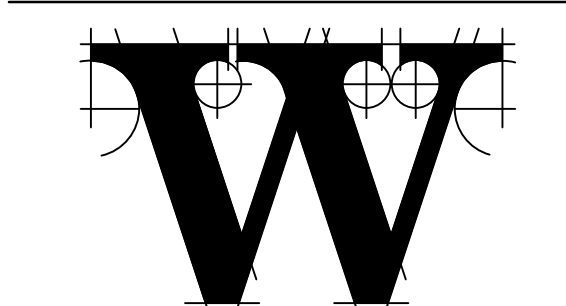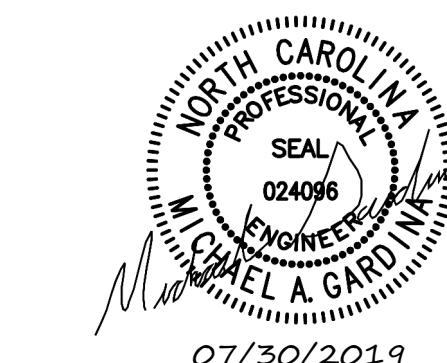

**THE WILSON GROUP**  
- ARCHITECTS -

PO Box 5510 Charlotte, NC 28299  
704-331-9747 • www.twgarchitects.com

PROJECT MANAGER & CIVIL ENGINEER  
**TALBERT & BRIGHT**

CONSULTING ARCHITECT

**LS3P**

STRUCTURAL ENGINEER

FIRM LICENSE #C-1051

**STEWART**

FPP/IME ENGINEER

**CHEATHAM & ASSOC.**

BAGGAGE HANDLING CONSULTANTS

**BNP**

AIRCRAFT SUPPORT SYSTEMS

**DK CONSULTANTS**

SPECIALTY LIGHTING CONSULTANT

**HARTRANFT**

SINGAGE & WAYFINDING

**TAKEFORM**

COPYRIGHT © 2019  
THE WILSON GROUP ARCHITECTS  
ALL RIGHTS RESERVED

PRINTED OR ELECTRONIC DRAWINGS AND DOCUMENTATION MAY NOT BE REPRODUCED IN ANY FORM WITHOUT WRITTEN PERMISSION FROM THE WILSON GROUP ARCHITECTS

REVISIONS


3 7/30/19 AD-03

DATE 06/28/2019  
PROJECT NUMBER 9202-000  
SHEET TITLE

**PARTIAL BOARDING LEVEL REBAR PLAN SCHEDULE 1 ZONE 2**



SHEET NUMBER

**S1-125**

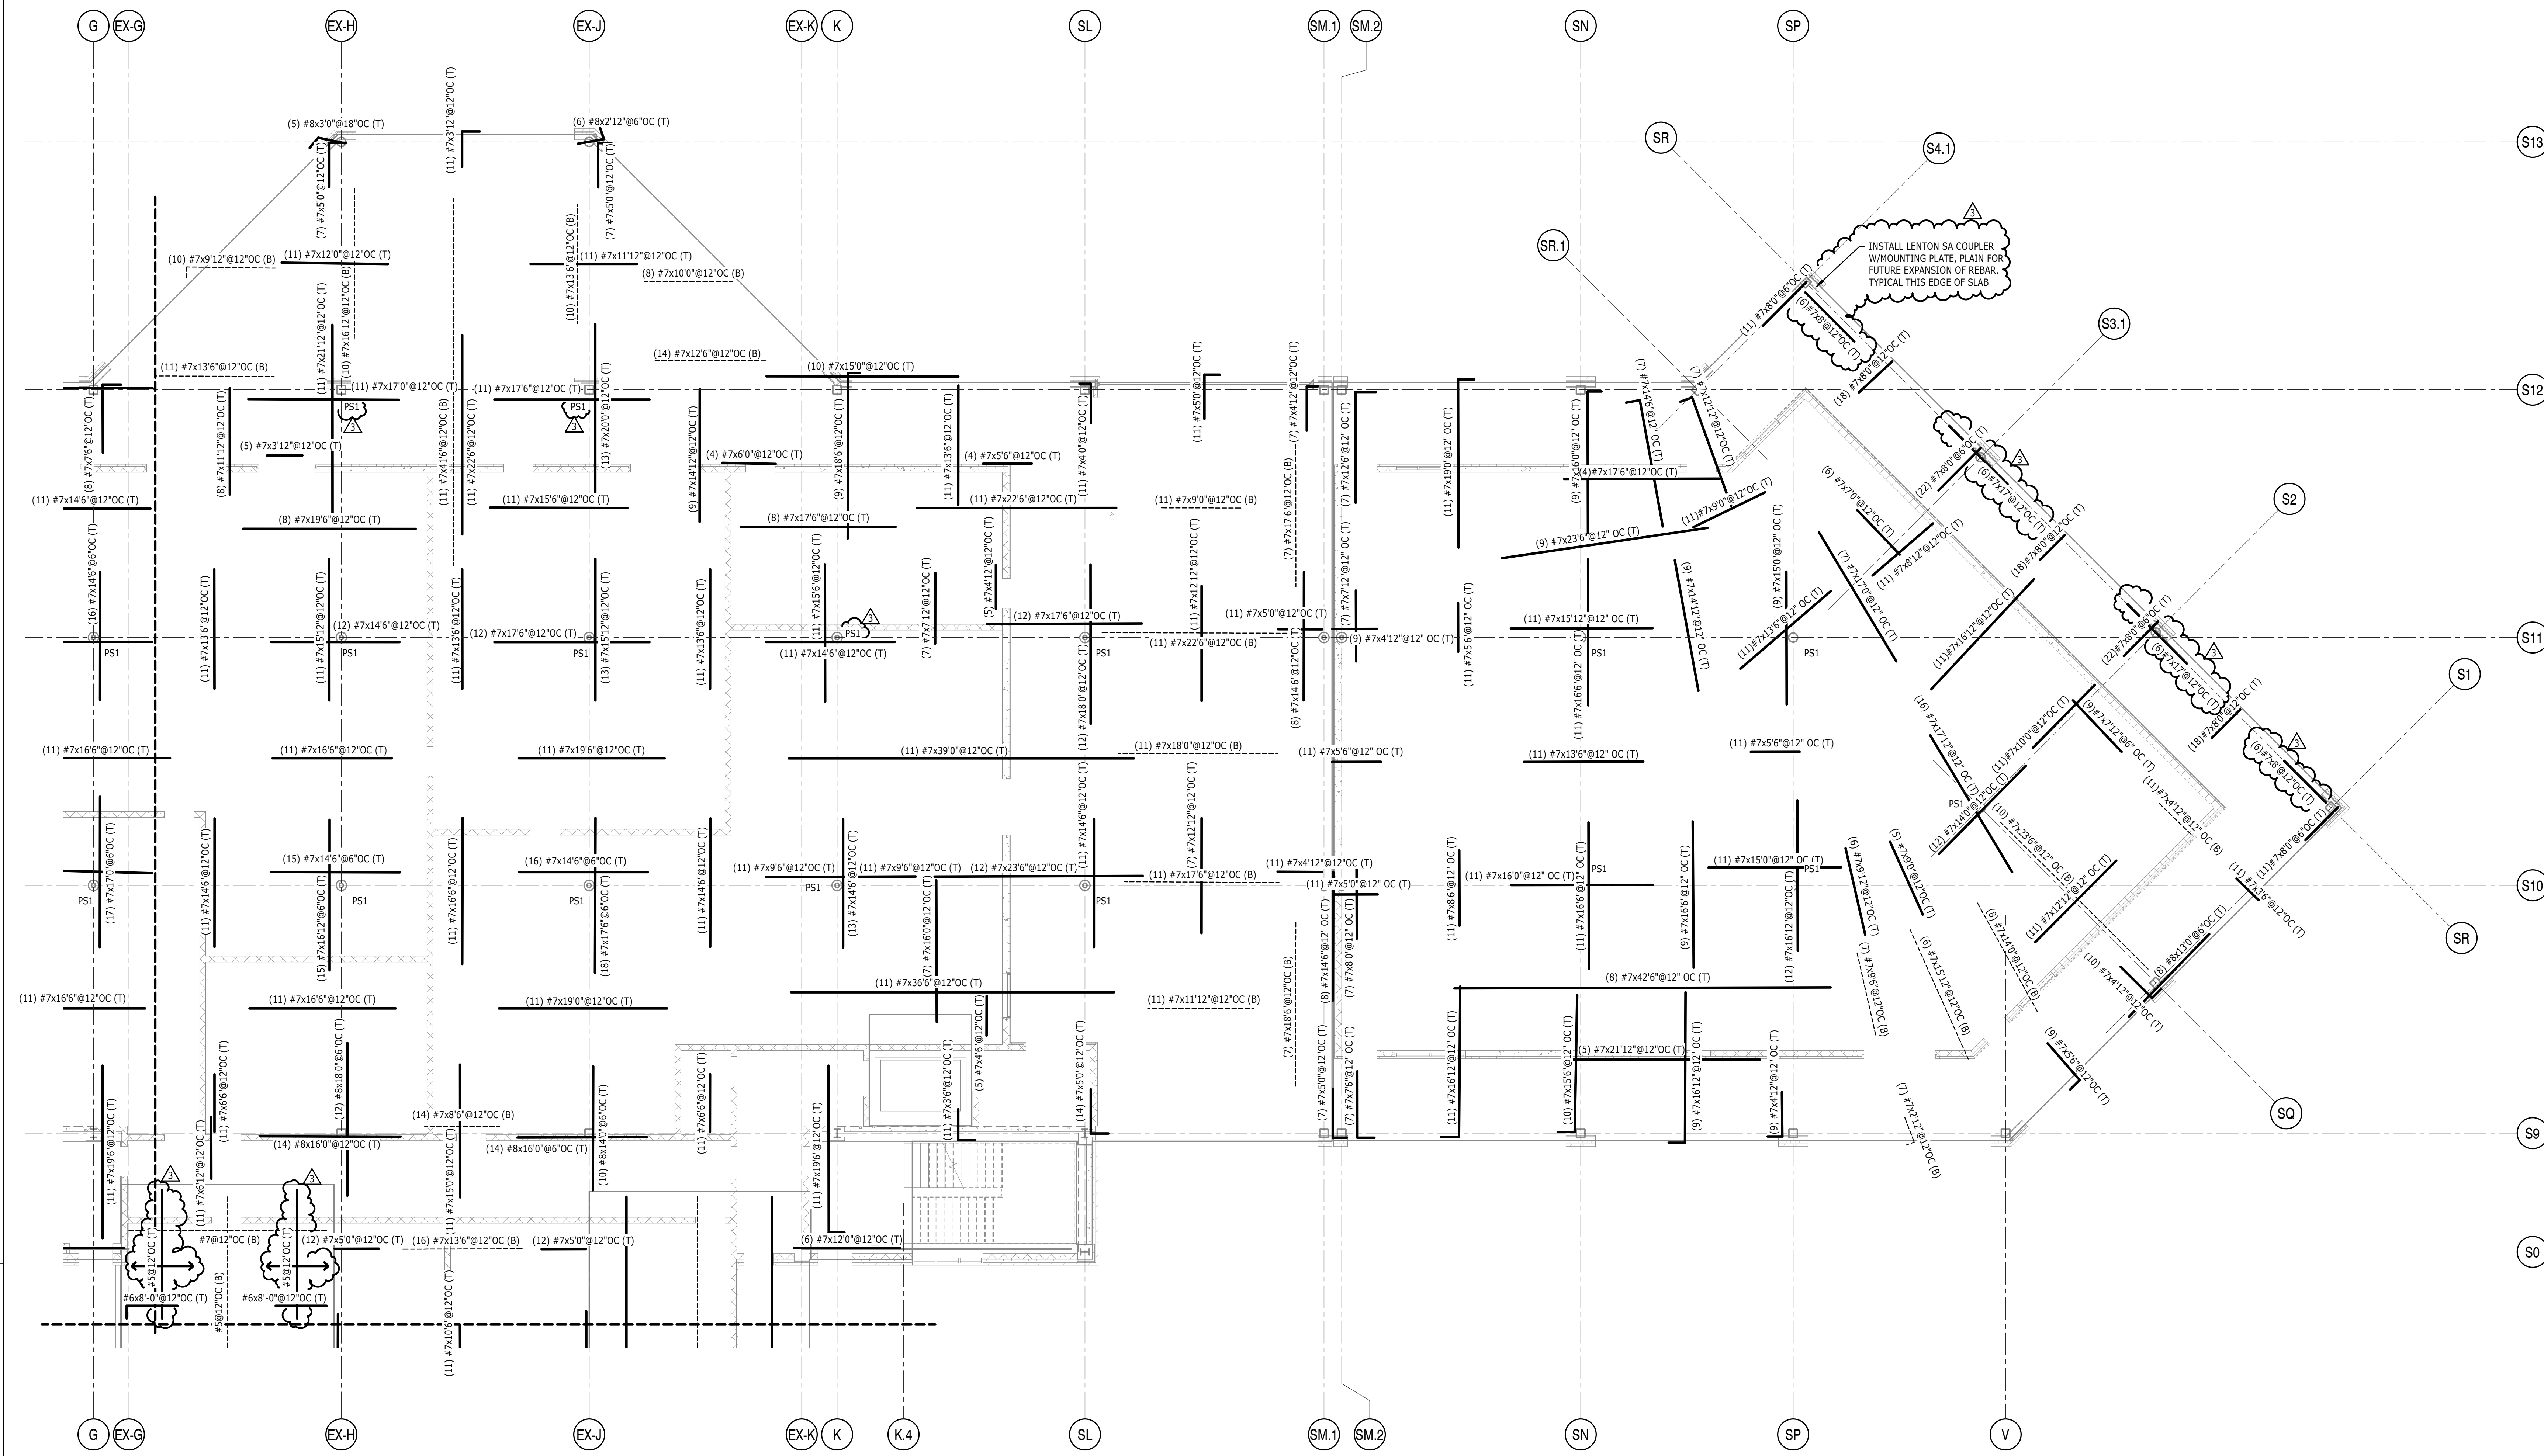

**1 BOARDING LEVEL REBAR PLAN SCHEDULE 1 ZONE 2**  
S1-125 1/8" = 1'-0"

- REBAR PLAN NOTES:**
- FOR GENERAL NOTES AND ABBREVIATIONS, SEE S-001 AND S-002.
  - FINISH FLOOR ELEVATION +13'-0" ABOVE REFERENCE FINISH FLOOR ELEVATION, UNLESS NOTED OTHERWISE.
  - CONCRETE ELEVATED SLABS SHALL BE TWO WAY FLAT PLATE CONCRETE SLAB. SEE PLAN FOR SLAB THICKNESS. TOP OF SLAB SHALL BE SLOPED WHERE NOTED ON ARCHITECTURAL DRAWINGS.
  - ALL OPENINGS IN CONCRETE SLAB MUST BE LOCATED AND BLOCKED OUT PRIOR TO CONCRETE BEING PLACED. NO CORE DRILLING IS PERMITTED WITHOUT CONSENT OF THE ENGINEER OF RECORD. SEE 7/S-322 FOR REINFORCING AT OPENINGS.
  - "CONC SW" INDICATES CONCRETE SHEAR WALL.
  - SEE ARCHITECTURAL DRAWINGS FOR PRECISE EDGE OF SLAB DIMENSIONS. ARCHITECTURAL DRAWINGS GOVERN ALL DIMENSIONS.
  - SEE ARCHITECTURAL AND PLUMBING DRAWINGS FOR FLOOR DRAINS AND SLAB SLOPES.
  - "PS" INDICATES STUD RAILS. STUD RAILS ARE REQUIRED TO BEGIN AT FACE OF COLUMN. SEE 7/S-321.
  - PROVIDE ADDITIONAL STEEL AT ALL RE-RESTRAINT CORNERS PER DETAIL 4/S-322.
  - "CB" INDICATES CONCRETE BEAM. SEE 6/S-321.
  - REINFORCING THAT TERMINATES AT THE INTERFACE BETWEEN SCHEDULE 1 AND SCHEDULE 2 SHALL HAVE THREADED COUPLERS AT THE ENDS OF SCHEDULE 1 REINFORCING. SCHEDULE 2 REINFORCING SHALL BE THREADED TO CONNECT TO THE COUPLERS INSTALLED IN SCHEDULE 1. THIS IS TYPICAL AT THE SLAB AND BEAMS ALONG THIS JOINT.
  - " " INDICATES REINFORCING STEEL WITH TYPICAL 90 OR 180 DEGREE HOOKS. LENGTHS INDICATED ON PLAN DO NOT INCLUDE HOOKS.

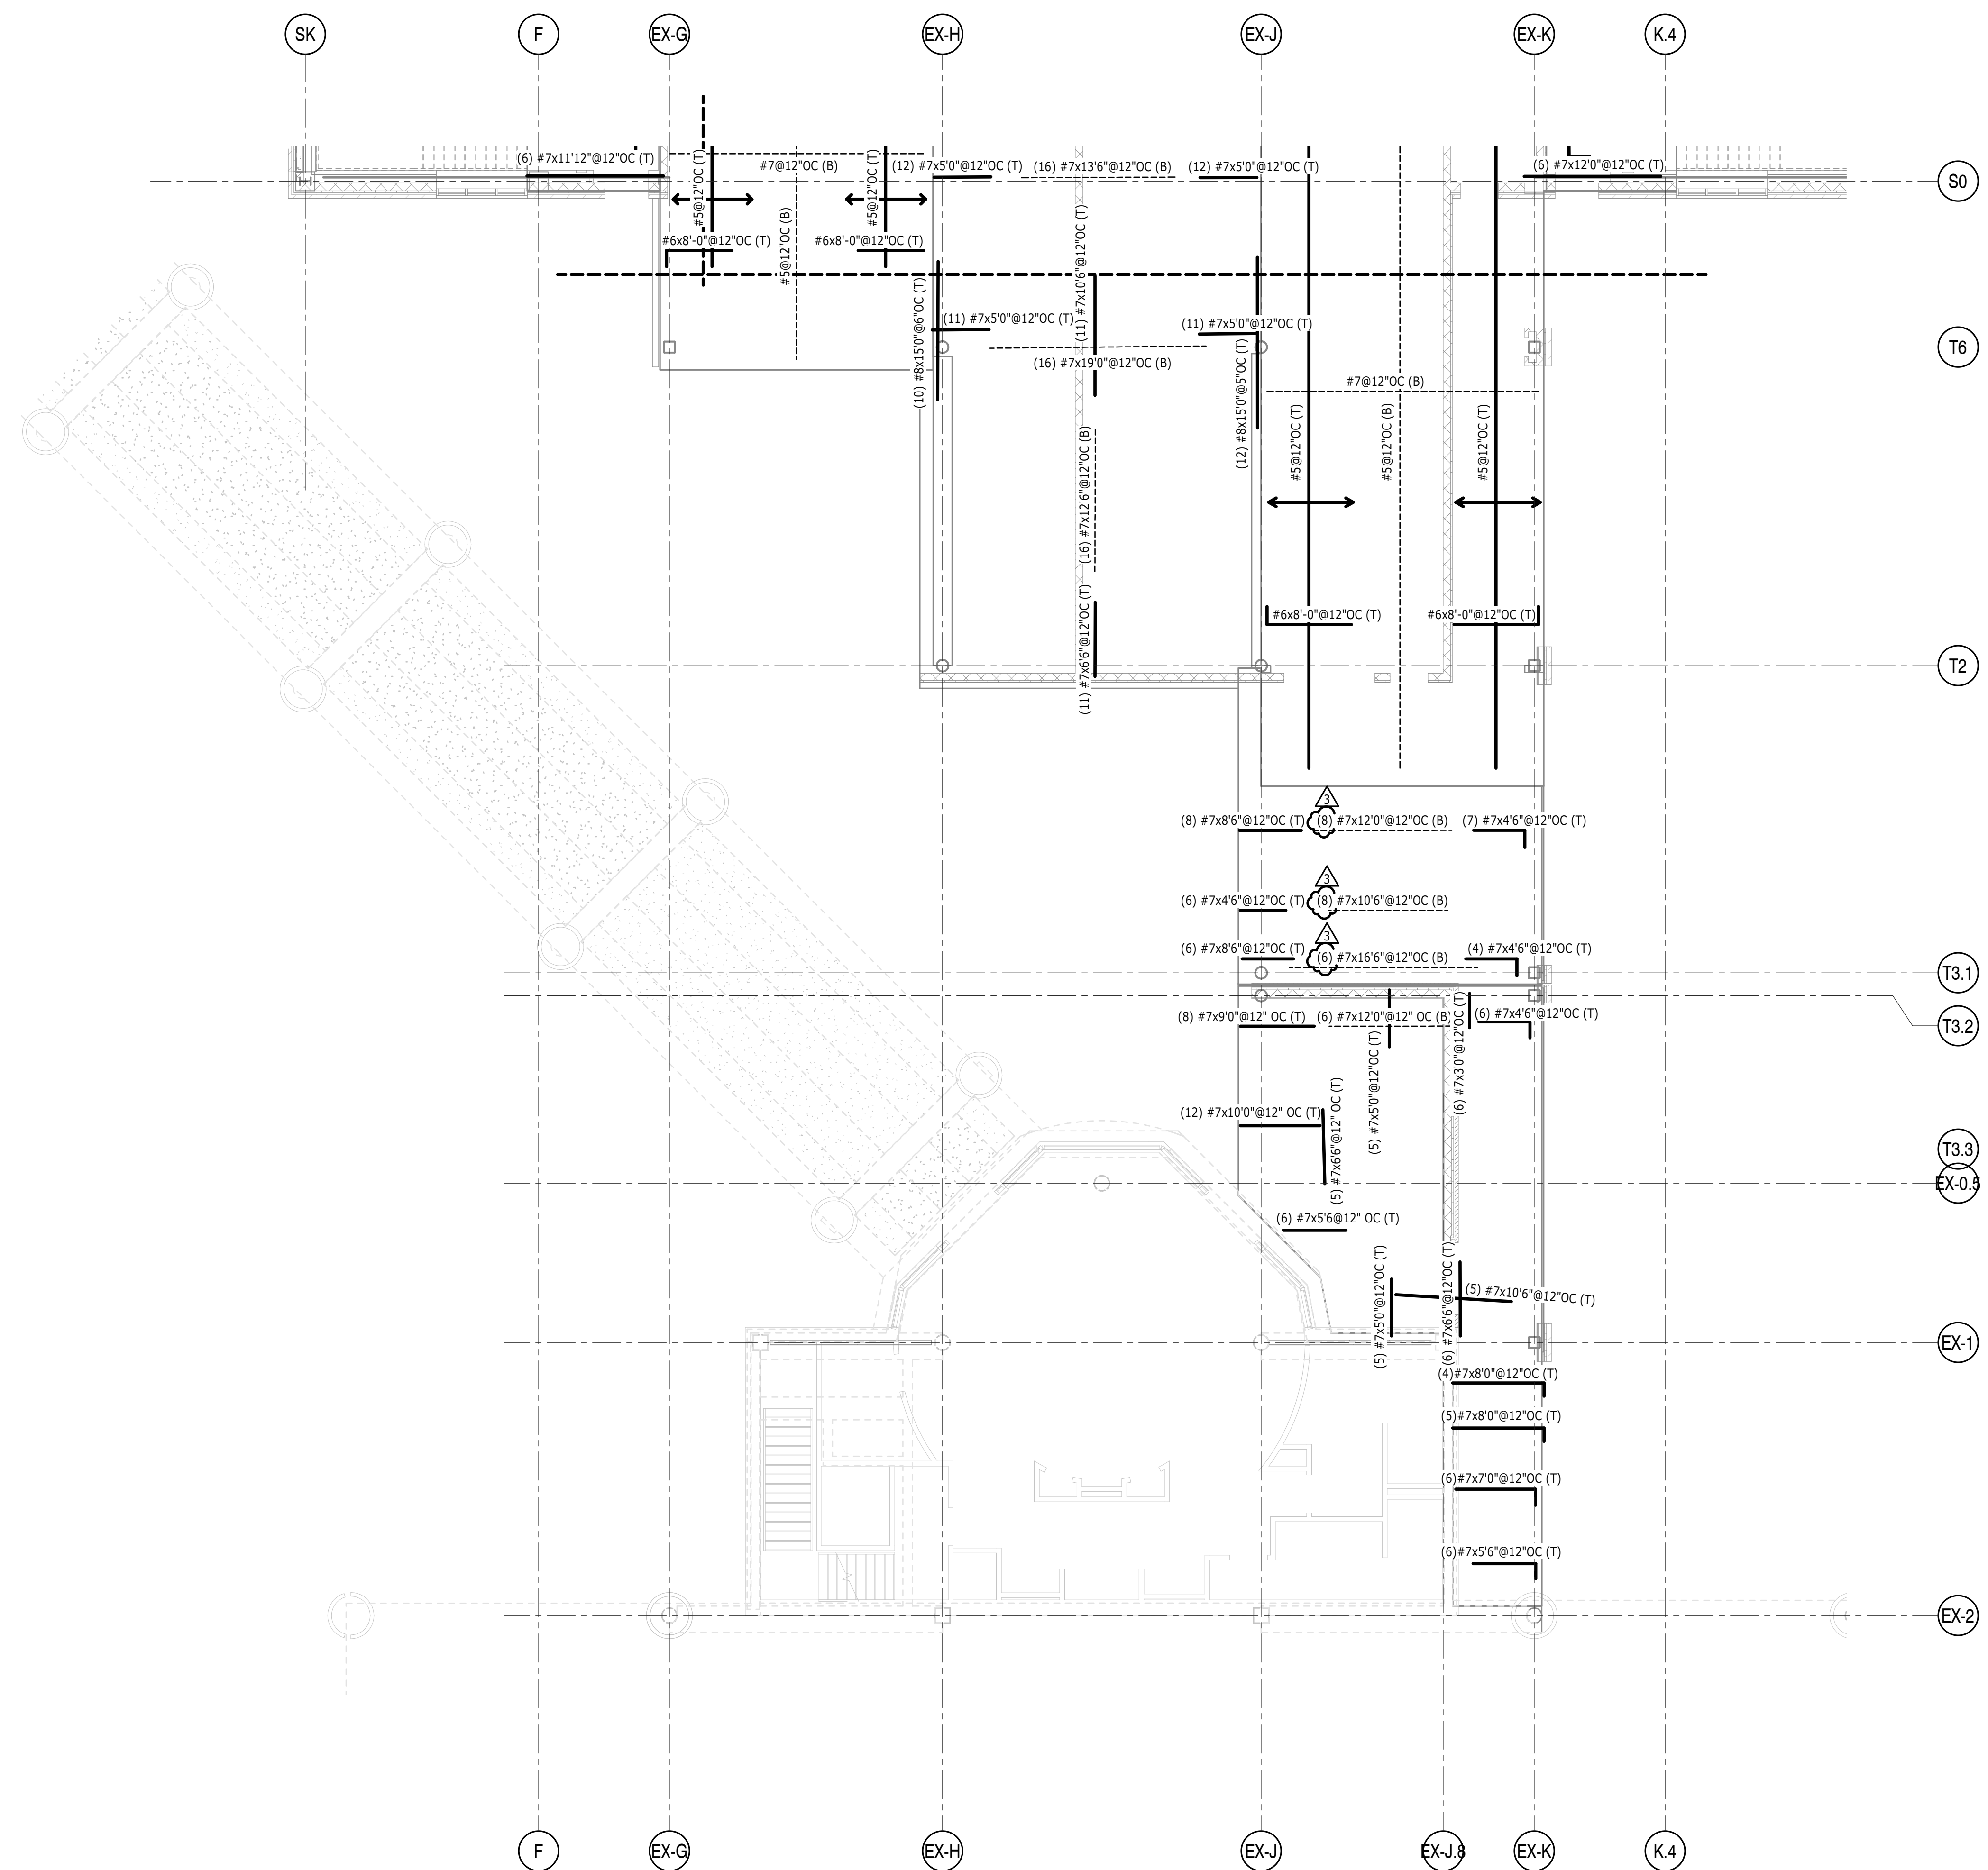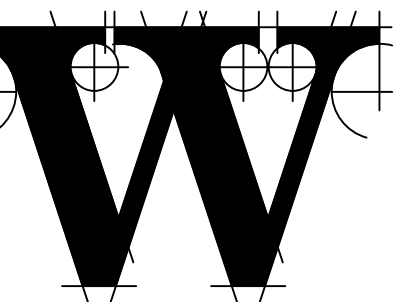

**1 BOARDING LEVEL REBAR PLAN SCHEDULE 1 ZONE 3**

1/8" = 1'-0"


**REBAR PLAN NOTES:**

1. FOR GENERAL NOTES AND ABBREVIATIONS, SEE S-001 AND S-002.
2. FINISH FLOOR ELEVATION +13'-0" ABOVE REFERENCE FINISH FLOOR ELEVATION, UNLESS NOTED OTHERWISE.
3. CONCRETE ELEVATED SLABS SHALL BE TWO WAY FLAT PLATE CONCRETE SLAB. SEE PLAN FOR SLAB THICKNESS. TOP OF SLAB SHALL BE SLOPED WHERE NOTED ON ARCHITECTURAL DRAWINGS.
4. ALL OPENINGS IN CONCRETE SLAB MUST BE LOCATED AND BLOCKED OUT PRIOR TO CONCRETE BEING PLACED. NO CORE DRILLING IS PERMITTED WITHOUT CONSENT OF THE ENGINEER OF RECORD. SEE 7/5-322 FOR REINFORCING AT OPENINGS.
5. "CONC SW" INDICATES CONCRETE SHEAR WALL.
6. SEE ARCHITECTURAL DRAWINGS FOR PRECISE EDGE OF SLAB DIMENSIONS. ARCHITECTURAL DRAWINGS GOVERN ALL DIMENSIONS.
7. SEE ARCHITECTURAL AND PLUMBING DRAWINGS FOR FLOOR DRAINS AND SLAB SLOPES.
8. "5/8" INDICATES STUD RAILS, STUD RAILS ARE REQUIRED TO BEGIN AT FACE OF COLUMN, SEE 7/5-321.
9. PROVIDE ADDITIONAL STEEL AT ALL RE-ENTRANT CORNERS PER DETAIL 4/5-322.
10. "CB" INDICATES CONCRETE BEAM, SEE 6/5-321.
11. REINFORCING THAT TERMINATES AT THE INTERFACE BETWEEN SCHEDULE 1 AND SCHEDULE 2 SHALL HAVE THREADED COUPLERS AT THE ENDS OF SCHEDULE 1 REINFORCING. SCHEDULE 2 REINFORCING SHALL BE THREADED TO CONNECT TO THE COUPLERS INSTALLED IN SCHEDULE 1. THIS IS TYPICAL AT THE SLAB AND BEAMS ALONG THIS JOINT.
12. " " INDICATES REINFORCING STEEL WITH TYPICAL 90 OR 180 DEGREE HOOKS. LENGTHS INDICATED ON PLAN DO NOT INCLUDE HOOKS.



TERMINAL IMPROVEMENTS CONTRACT 3

Wilmington International Airport 1740 Airport Boulevard, Suite 12 Wilmington, NC 28405

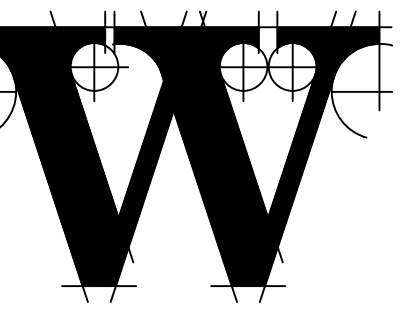

THE WILSON GROUP ARCHITECTS

PO Box 5510 Charlotte, NC 28299 704-331-9747 • www.twgarchitects.com

PROJECT MANAGER & CIVIL ENGINEER TALBERT & BRIGHT

CONSULTING ARCHITECT LS3P

STRUCTURAL ENGINEER FIRM LICENSE #C-1051 STEWART


FP/PM/E ENGINEER CHEATHAM & ASSOC.

BAGGAGE HANDLING CONSULTANTS BNP

AIRCRAFT SUPPORT SYSTEMS DK CONSULTANTS

SPECIALTY LIGHTING CONSULTANT HARTFRANT

SINGAGE & WAYFINDING TAKEFORM

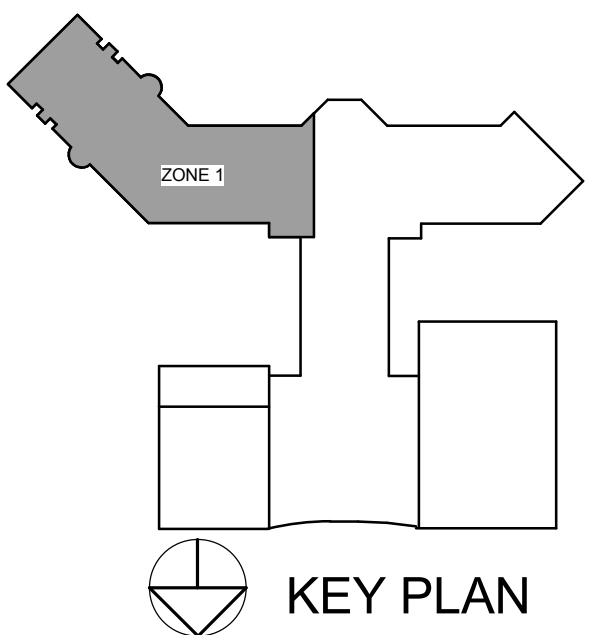

COPYRIGHT © 2019 THE WILSON GROUP ARCHITECTS ALL RIGHTS RESERVED

PRINTED OR ELECTRONIC DRAWINGS AND DOCUMENTATION MAY NOT BE REPRODUCED IN ANY FORM WITHOUT WRITTEN PERMISSION FROM THE WILSON GROUP ARCHITECTS


REVISIONS

1	7/12/19	AD-01
3	7/30/19	AD-03


DATE 06/28/2019 PROJECT NUMBER 9202-000 SHEET TITLE

PARTIAL ROOF FRAMING PLAN SCHEDULE 1 ZONE 1

SHEET NUMBER S1-131

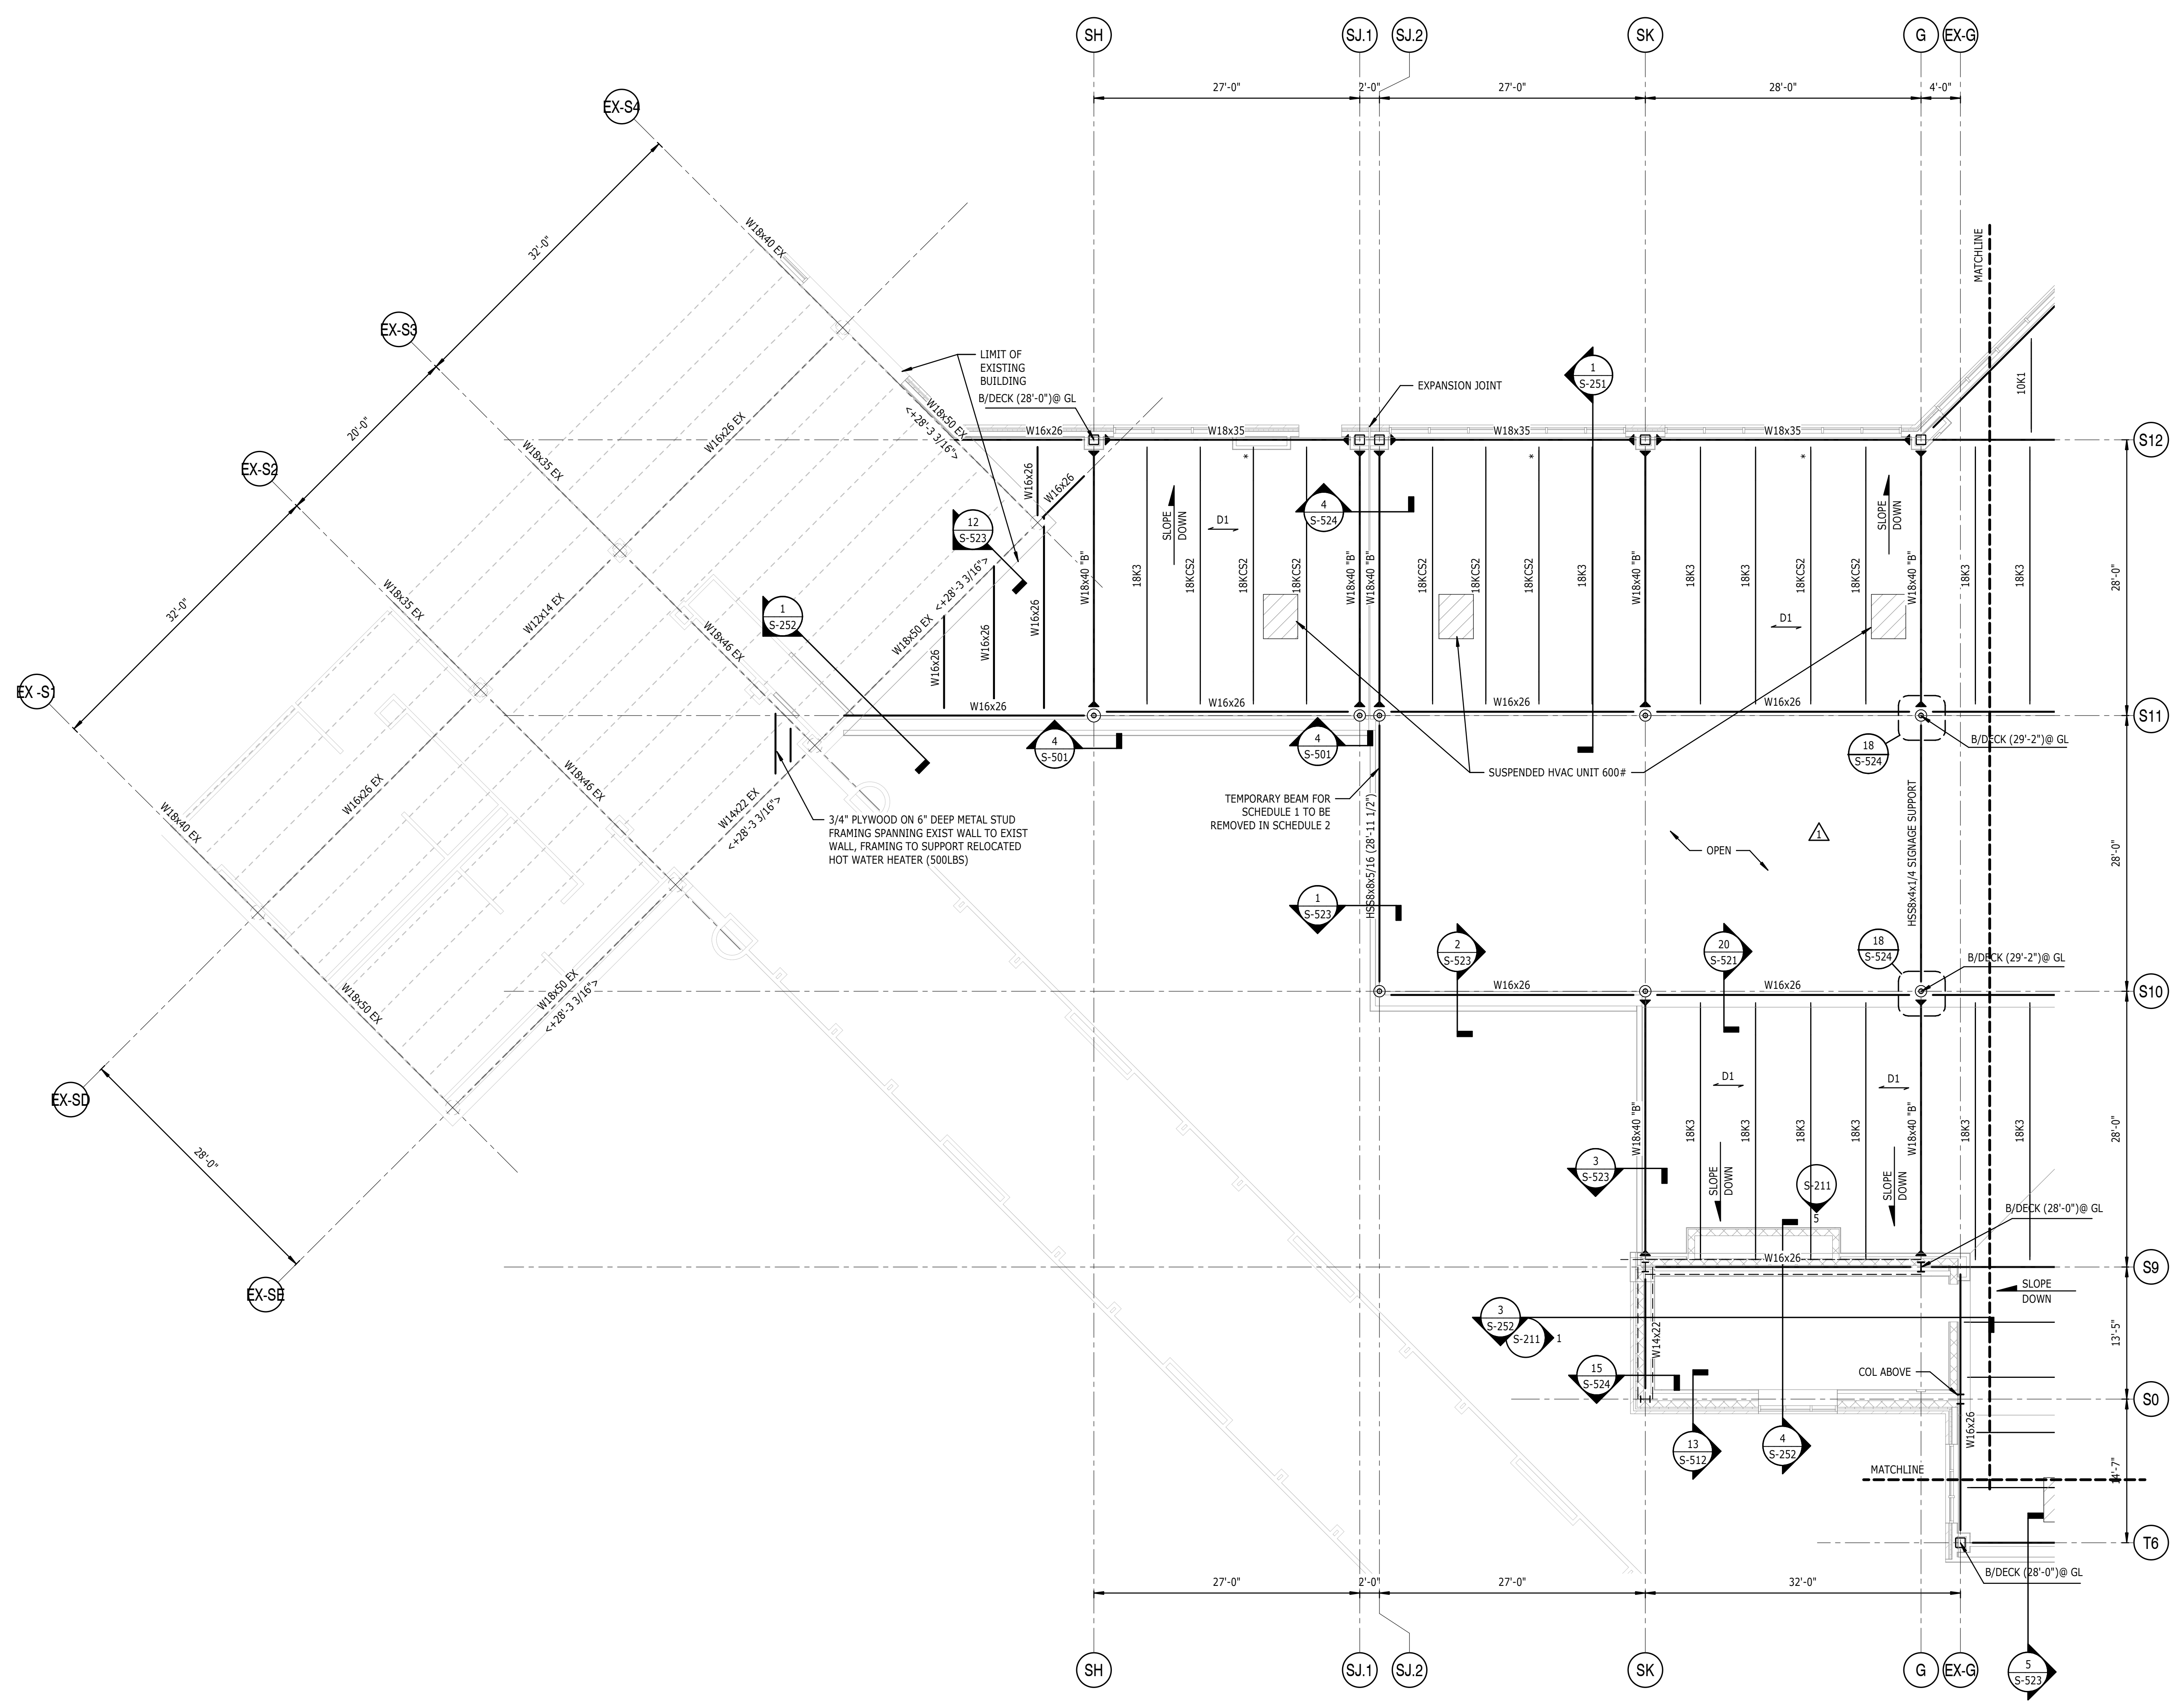

- 1** ROOF FRAMING PLAN SCHEDULE 1 ZONE 1  
S1-131
- 1/8" = 1'-0"
- NOTES:
- FOR GENERAL NOTES AND ABBREVIATIONS, SEE S-001.
  - (No) INDICATES TOP OF STEEL ELEVATION ABOVE REFERENCED FINISH FLOOR ELEVATION.
  - D1 INDICATES STEEL DECK SPAN DIRECTION. CONSTRUCTION SHALL BE 1/2" 18GA METAL DECK. SEE 1/S-521 FOR TYPICAL ROOF CONSTRUCTION DETAIL.
  - D2 INDICATES STEEL DECK SPAN DIRECTION. CONSTRUCTION SHALL BE 1/2" 18GA METAL DECK. SEE 1/S-521 FOR TYPICAL ROOF CONSTRUCTION DETAIL.
  - INDICATES MOMENT CONNECTION. SEE 19/S-511 FOR SCHEDULE.
  - SEE ELEVATIONS ON PLAN FOR VERTICAL FRAME LOCATIONS AND S-211 FOR ELEVATIONS AND DETAILS.
  - FOR TYPICAL ROOF FRAMING DETAILS, SEE S-521.
  - FOR STEEL COLUMN SCHEDULE, SEE 1/S-501.
  - "B" INDICATES BOTTOM FLANGE BEAM BRACING REQUIRED. BRACING SHALL BE PER DETAIL 19/S522. IF BRACING IS NOTED AT EXPANSION JOINTS, INSTALL BRACING ONLY ON ONE SIDE.
  - "C" INDICATES BOTTOM CHORD EXTENSION REQUIRED.
  - "A=#K" INDICATES FACTORED AXIAL FORCE IN COLLECTOR BEAM TO BE USED IN CONNECTION DESIGN.
  - "B/DECK (+#-#)" INDICATES BOTTOM OF DECK ELEVATION FROM REFERENCED FINISH FLOOR ELEVATION.
  - "TRUSS T#" INDICATES TRUSS TYPE. SEE S200 SERIES FOR ELEVATIONS.
  - ALL EXPOSED STRUCTURAL STEEL (COLUMNS, ROOF TRUSSES, TRUSS BEARING & ETC) SHALL BE CONSIDERED AESS.
  - D2 INDICATES STEEL DECK SPAN DIRECTION. CONSTRUCTION SHALL BE 1/2" 18GA METAL DECK. SEE 1/S-521 FOR TYPICAL ROOF CONSTRUCTION DETAIL.
  - "#K-R" DENOTES FACTORED MOMENT TO BE USED IN DESIGN OF MOMENT CONNECTIONS.

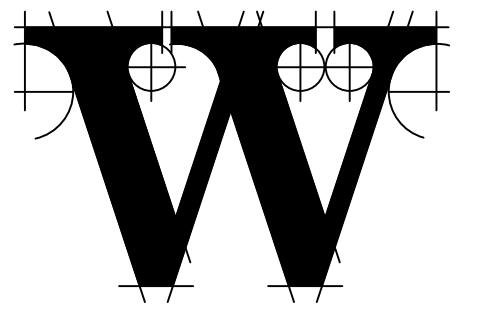

**THE WILSON GROUP**  
ARCHITECTS  
PO Box 5510 Charlotte, NC 28299  
704-331-9747 • www.twgarchitects.com

PROJECT MANAGER & CIVIL ENGINEER  
**TALBERT & BRIGHT**  
CONSULTING ARCHITECT  
LS3P

STRUCTURAL ENGINEER  
FIRM LICENSE #C-1051  
**STEWART**


FP/PM/E ENGINEER  
**CHEATHAM & ASSOC.**

BAGGAGE HANDLING CONSULTANTS  
**BNP**

AIRCRAFT SUPPORT SYSTEMS  
**DK CONSULTANTS**

SPECIALTY LIGHTING CONSULTANT  
**HARTRANFT**

SINGAGE & WAYFINDING  
**TAKEFORM**

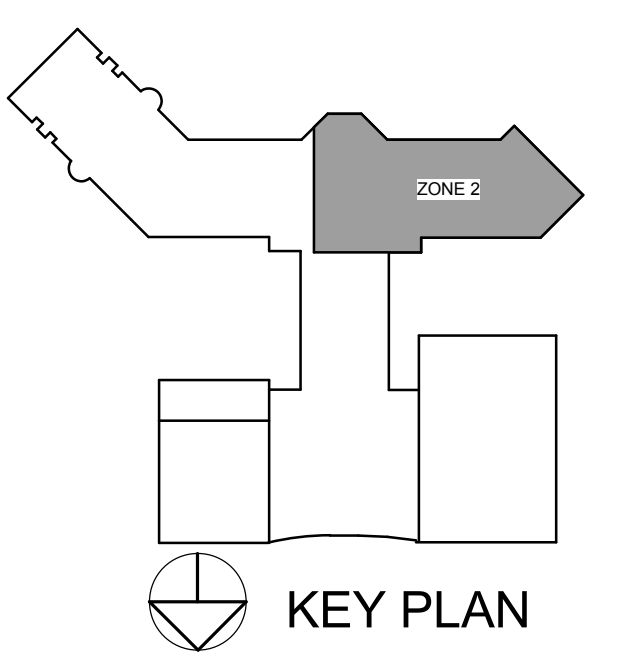

COPYRIGHT © 2019  
THE WILSON GROUP ARCHITECTS  
ALL RIGHTS RESERVED

PRINTED OR ELECTRONIC DRAWINGS AND DOCUMENTATION MAY NOT BE REPRODUCED IN ANY FORM WITHOUT WRITTEN PERMISSION FROM THE WILSON GROUP ARCHITECTS


REVISIONS

1	7/12/19	AD-01
3	7/30/19	AD-03

DATE 06/28/2019  
PROJECT NUMBER 9202-000  
SHEET TITLE

**PARTIAL ROOF FRAMING PLAN SCHEDULE 1 ZONE 2**

SHEET NUMBER  
**S1-132**

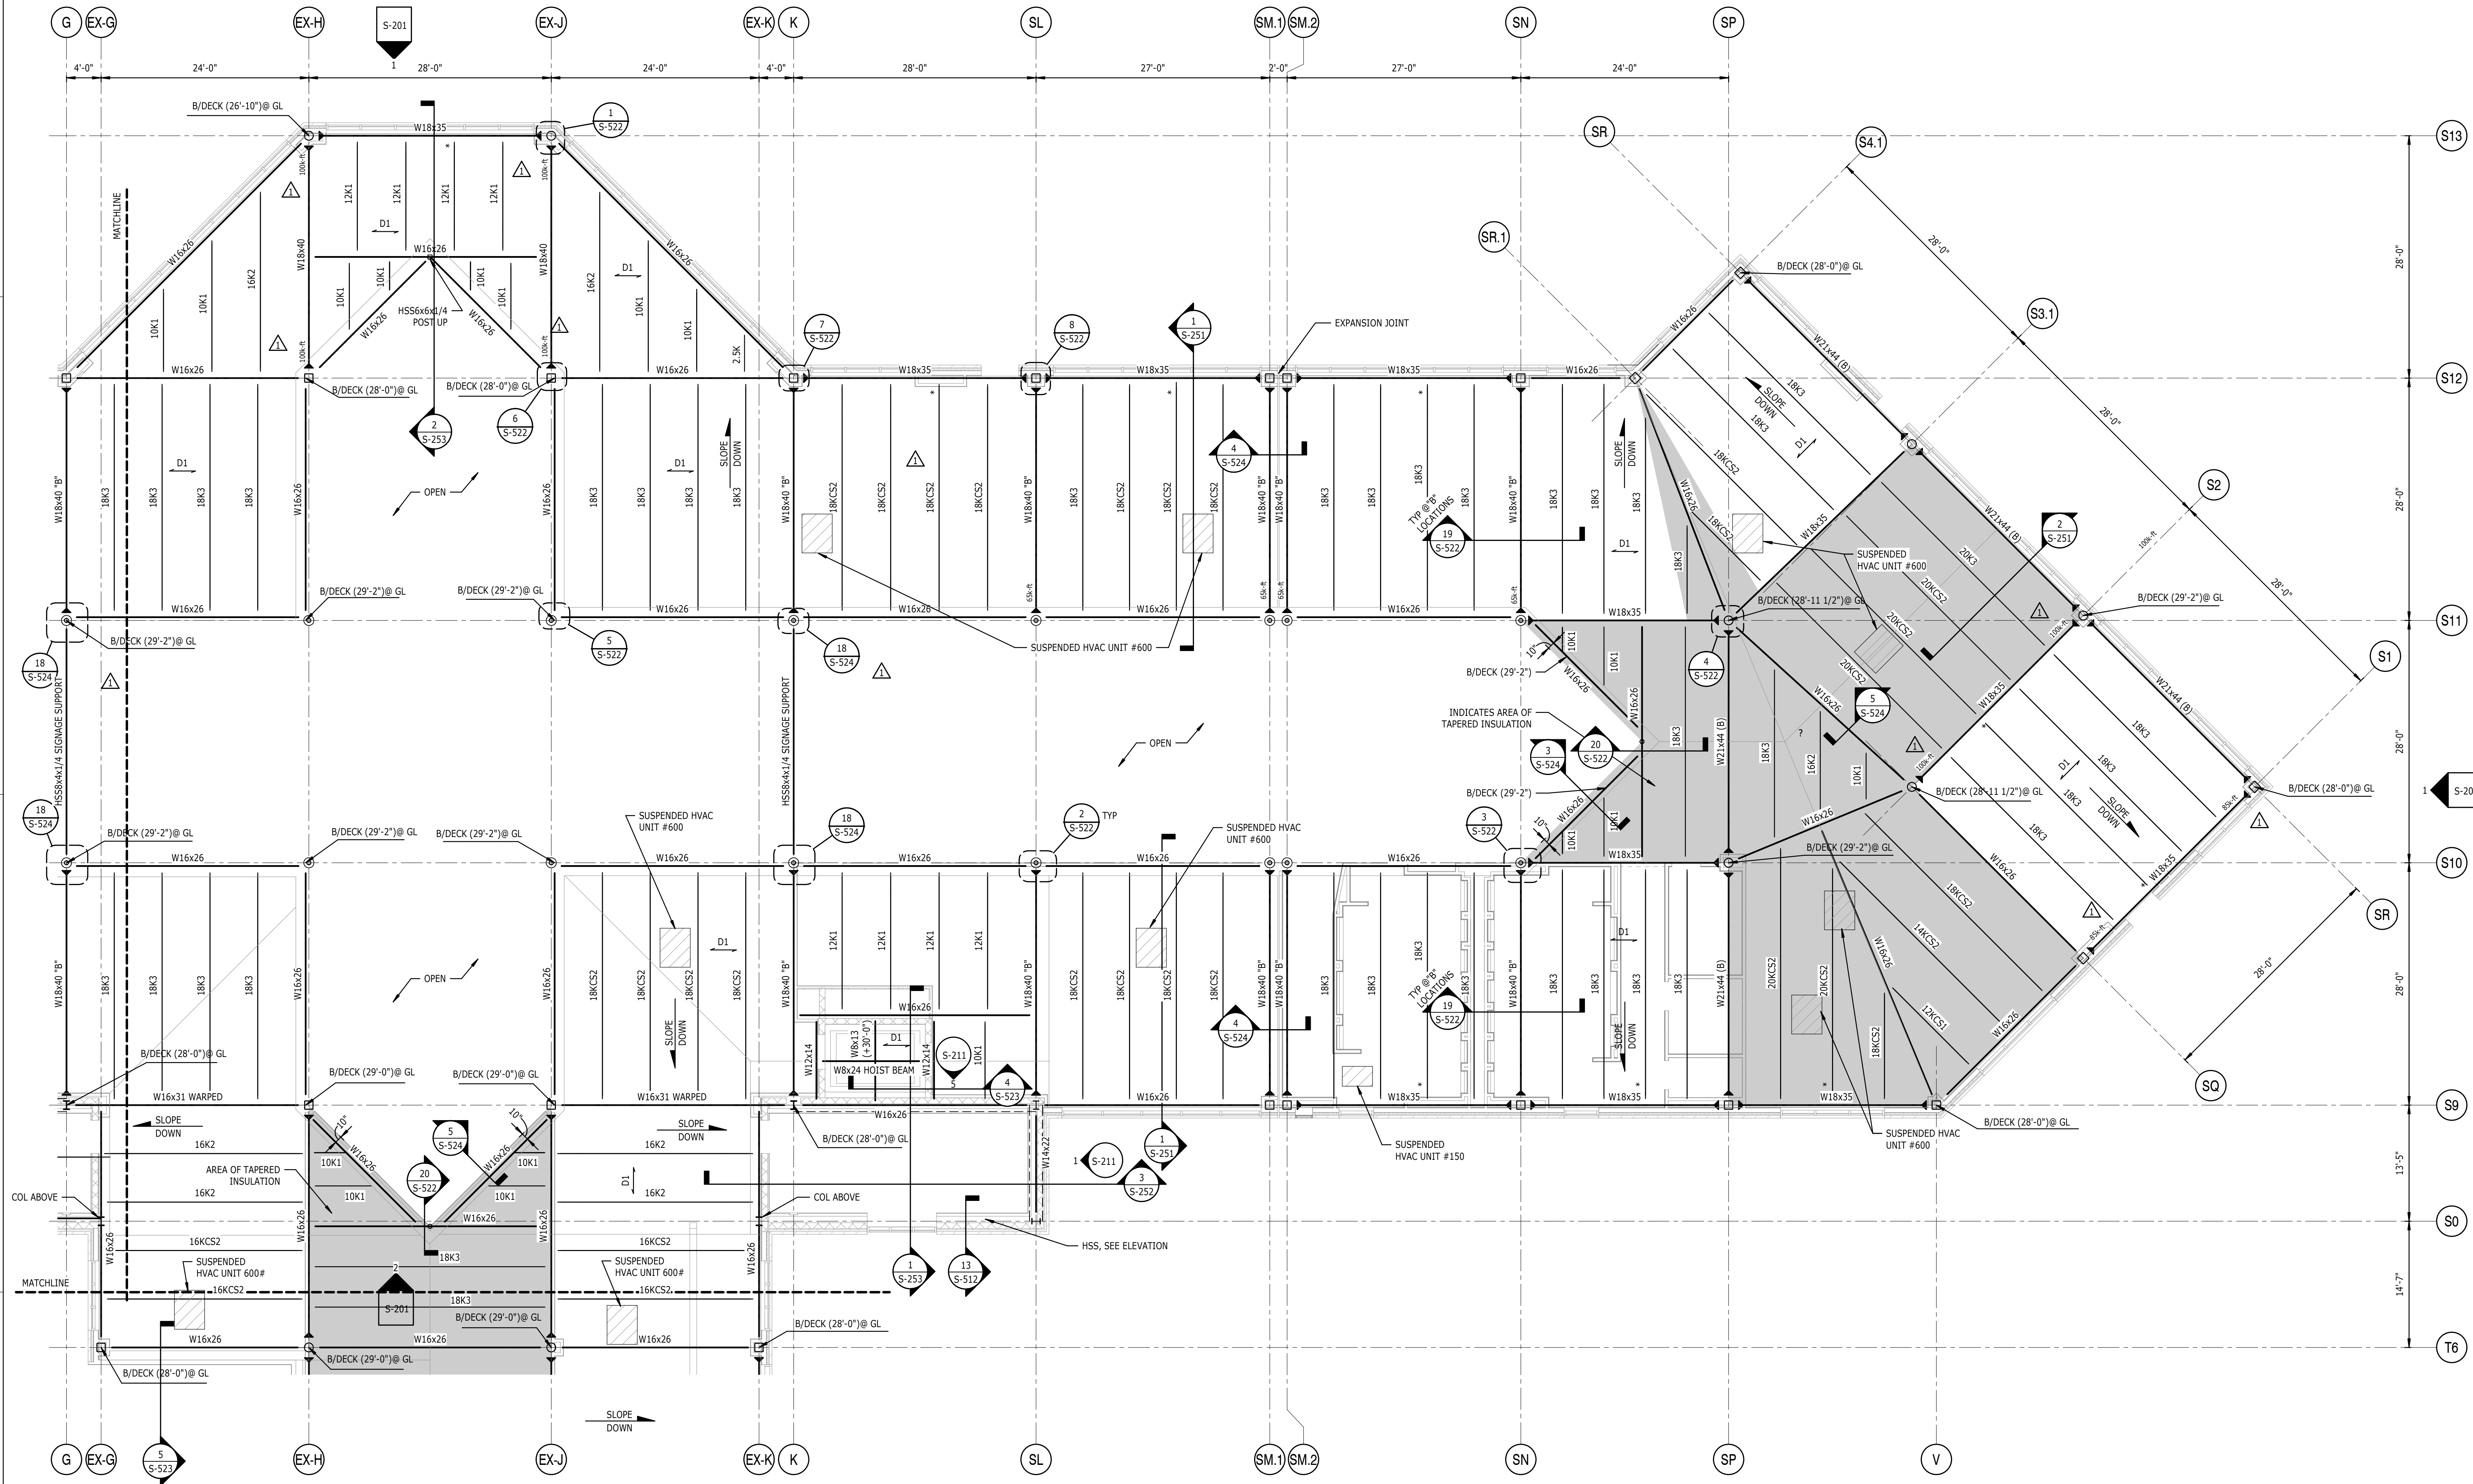


- 1** ROOF FRAMING PLAN SCHEDULE 1 ZONE 2
- 1/8" = 1'-0"
- NOTES:
- FOR GENERAL NOTES AND ABBREVIATIONS, SEE S-001.
  - (N) INDICATES TOP OF STEEL ELEVATION ABOVE REFERENCED FINISH FLOOR ELEVATION.
  - D1 INDICATES STEEL DECK SPAN DIRECTION. CONSTRUCTION SHALL BE 1/2" 18GA METAL DECK. SEE 1/S-521 FOR TYPICAL ROOF CONSTRUCTION DETAIL.
  - D2 INDICATES STEEL DECK SPAN DIRECTION. CONSTRUCTION SHALL BE 1/2" 18GA METAL DECK. SEE 1/S-521 FOR TYPICAL ROOF CONSTRUCTION DETAIL.
  - INDICATES MOMENT CONNECTION, SEE 19/S-511 FOR SCHEDULE.
  - SEE ELEVATIONS ON PLAN FOR VERTICAL FRAME LOCATIONS AND S-211 FOR ELEVATIONS AND DETAILS.
  - FOR TYPICAL ROOF FRAMING DETAILS, SEE S-521.
  - FOR STEEL COLUMN SCHEDULE, SEE 1/S-501.
  - "B" INDICATES BOTTOM FLANGE BEAM BRACING REQUIRED. BRACING SHALL BE PER DETAIL 19/S-522. IF BRACING IS NOTED AT EXPANSION JOINTS, INSTALL BRACING ONLY ON ONE SIDE.
  - "\*\*" INDICATES BOTTOM CHORD EXTENSION REQUIRED.
  - "\*+\*+\*" INDICATES FACTORED AXIAL FORCE IN COLLECTOR BEAM TO BE USED IN CONNECTION DESIGN.
  - "B/DECK (+#'-##") INDICATES BOTTOM OF DECK ELEVATION FROM REFERENCED FINISH FLOOR ELEVATION.
  - "TRUSS T#" INDICATES TRUSS TYPE, SEE S200 SERIES FOR ELEVATIONS.
  - ALL EXPOSED STRUCTURAL STEEL (COLUMNS, ROOF TRUSSES, TRUSS BEARING & ETC) SHALL BE CONSIDERED AESS.
  - D2 INDICATES STEEL DECK SPAN DIRECTION. CONSTRUCTION SHALL BE 1/2" 18GA METAL DECK. SEE 1/S-521 FOR TYPICAL ROOF CONSTRUCTION DETAIL.
  - "#\*#-R#" DENOTES FACTORED MOMENT TO BE USED IN DESIGN OF MOMENT CONNECTIONS.



**TERMINAL IMPROVEMENTS CONTRACT 3**

Wilmington International Airport  
1740 Airport Boulevard, Suite 12  
Wilmington, NC 28405

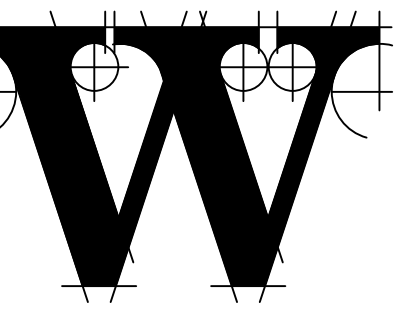

**THE WILSON GROUP ARCHITECTS**

PO Box 5510 Charlotte, NC 28299  
704-331-9747 • www.twgarchitects.com

PROJECT MANAGER & CIVIL ENGINEER  
**TALBERT & BRIGHT**  
CONSULTING ARCHITECT  
**LS3P**

STRUCTURAL ENGINEER  
FIRM LICENSE #C-1051  
**STEWART**


FPP/IME ENGINEER  
**CHEATHAM & ASSOC.**

BAGGAGE HANDLING CONSULTANTS  
**BNP**

AIRCRAFT SUPPORT SYSTEMS  
**DK CONSULTANTS**

SPECIALTY LIGHTING CONSULTANT  
**HARTFRANT**

SINGAGE & WAYFINDING  
**TAKEFORM**

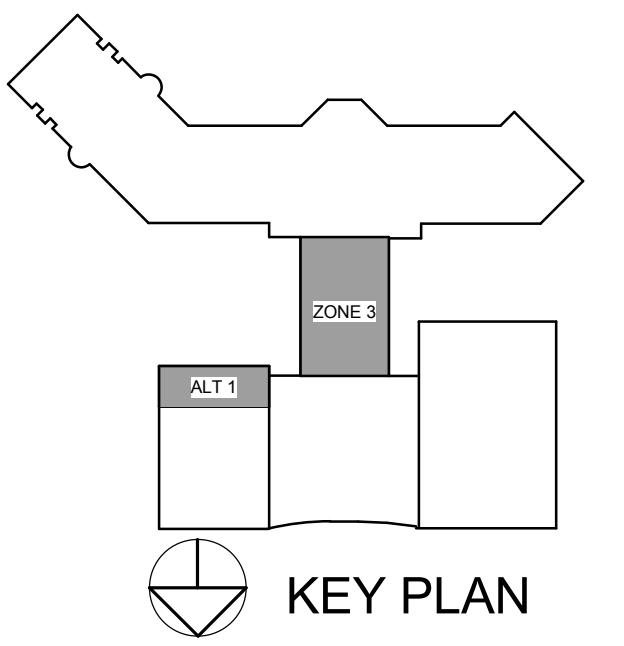

COPYRIGHT © 2019  
THE WILSON GROUP ARCHITECTS  
ALL RIGHTS RESERVED

PRINTED OR ELECTRONIC DRAWINGS AND DOCUMENTATION MAY NOT BE REPRODUCED IN ANY FORM WITHOUT WRITTEN PERMISSION FROM THE WILSON GROUP ARCHITECTS

**REVISIONS**


- 1 7/12/19 AD-01
- 3 7/30/19 AD-03

DATE 06/28/2019  
PROJECT NUMBER 9202-000  
SHEET TITLE

**PARTIAL ROOF FRAMING PLAN SCHEDULE 1 ZONE 3**

SHEET NUMBER

**S1-133**

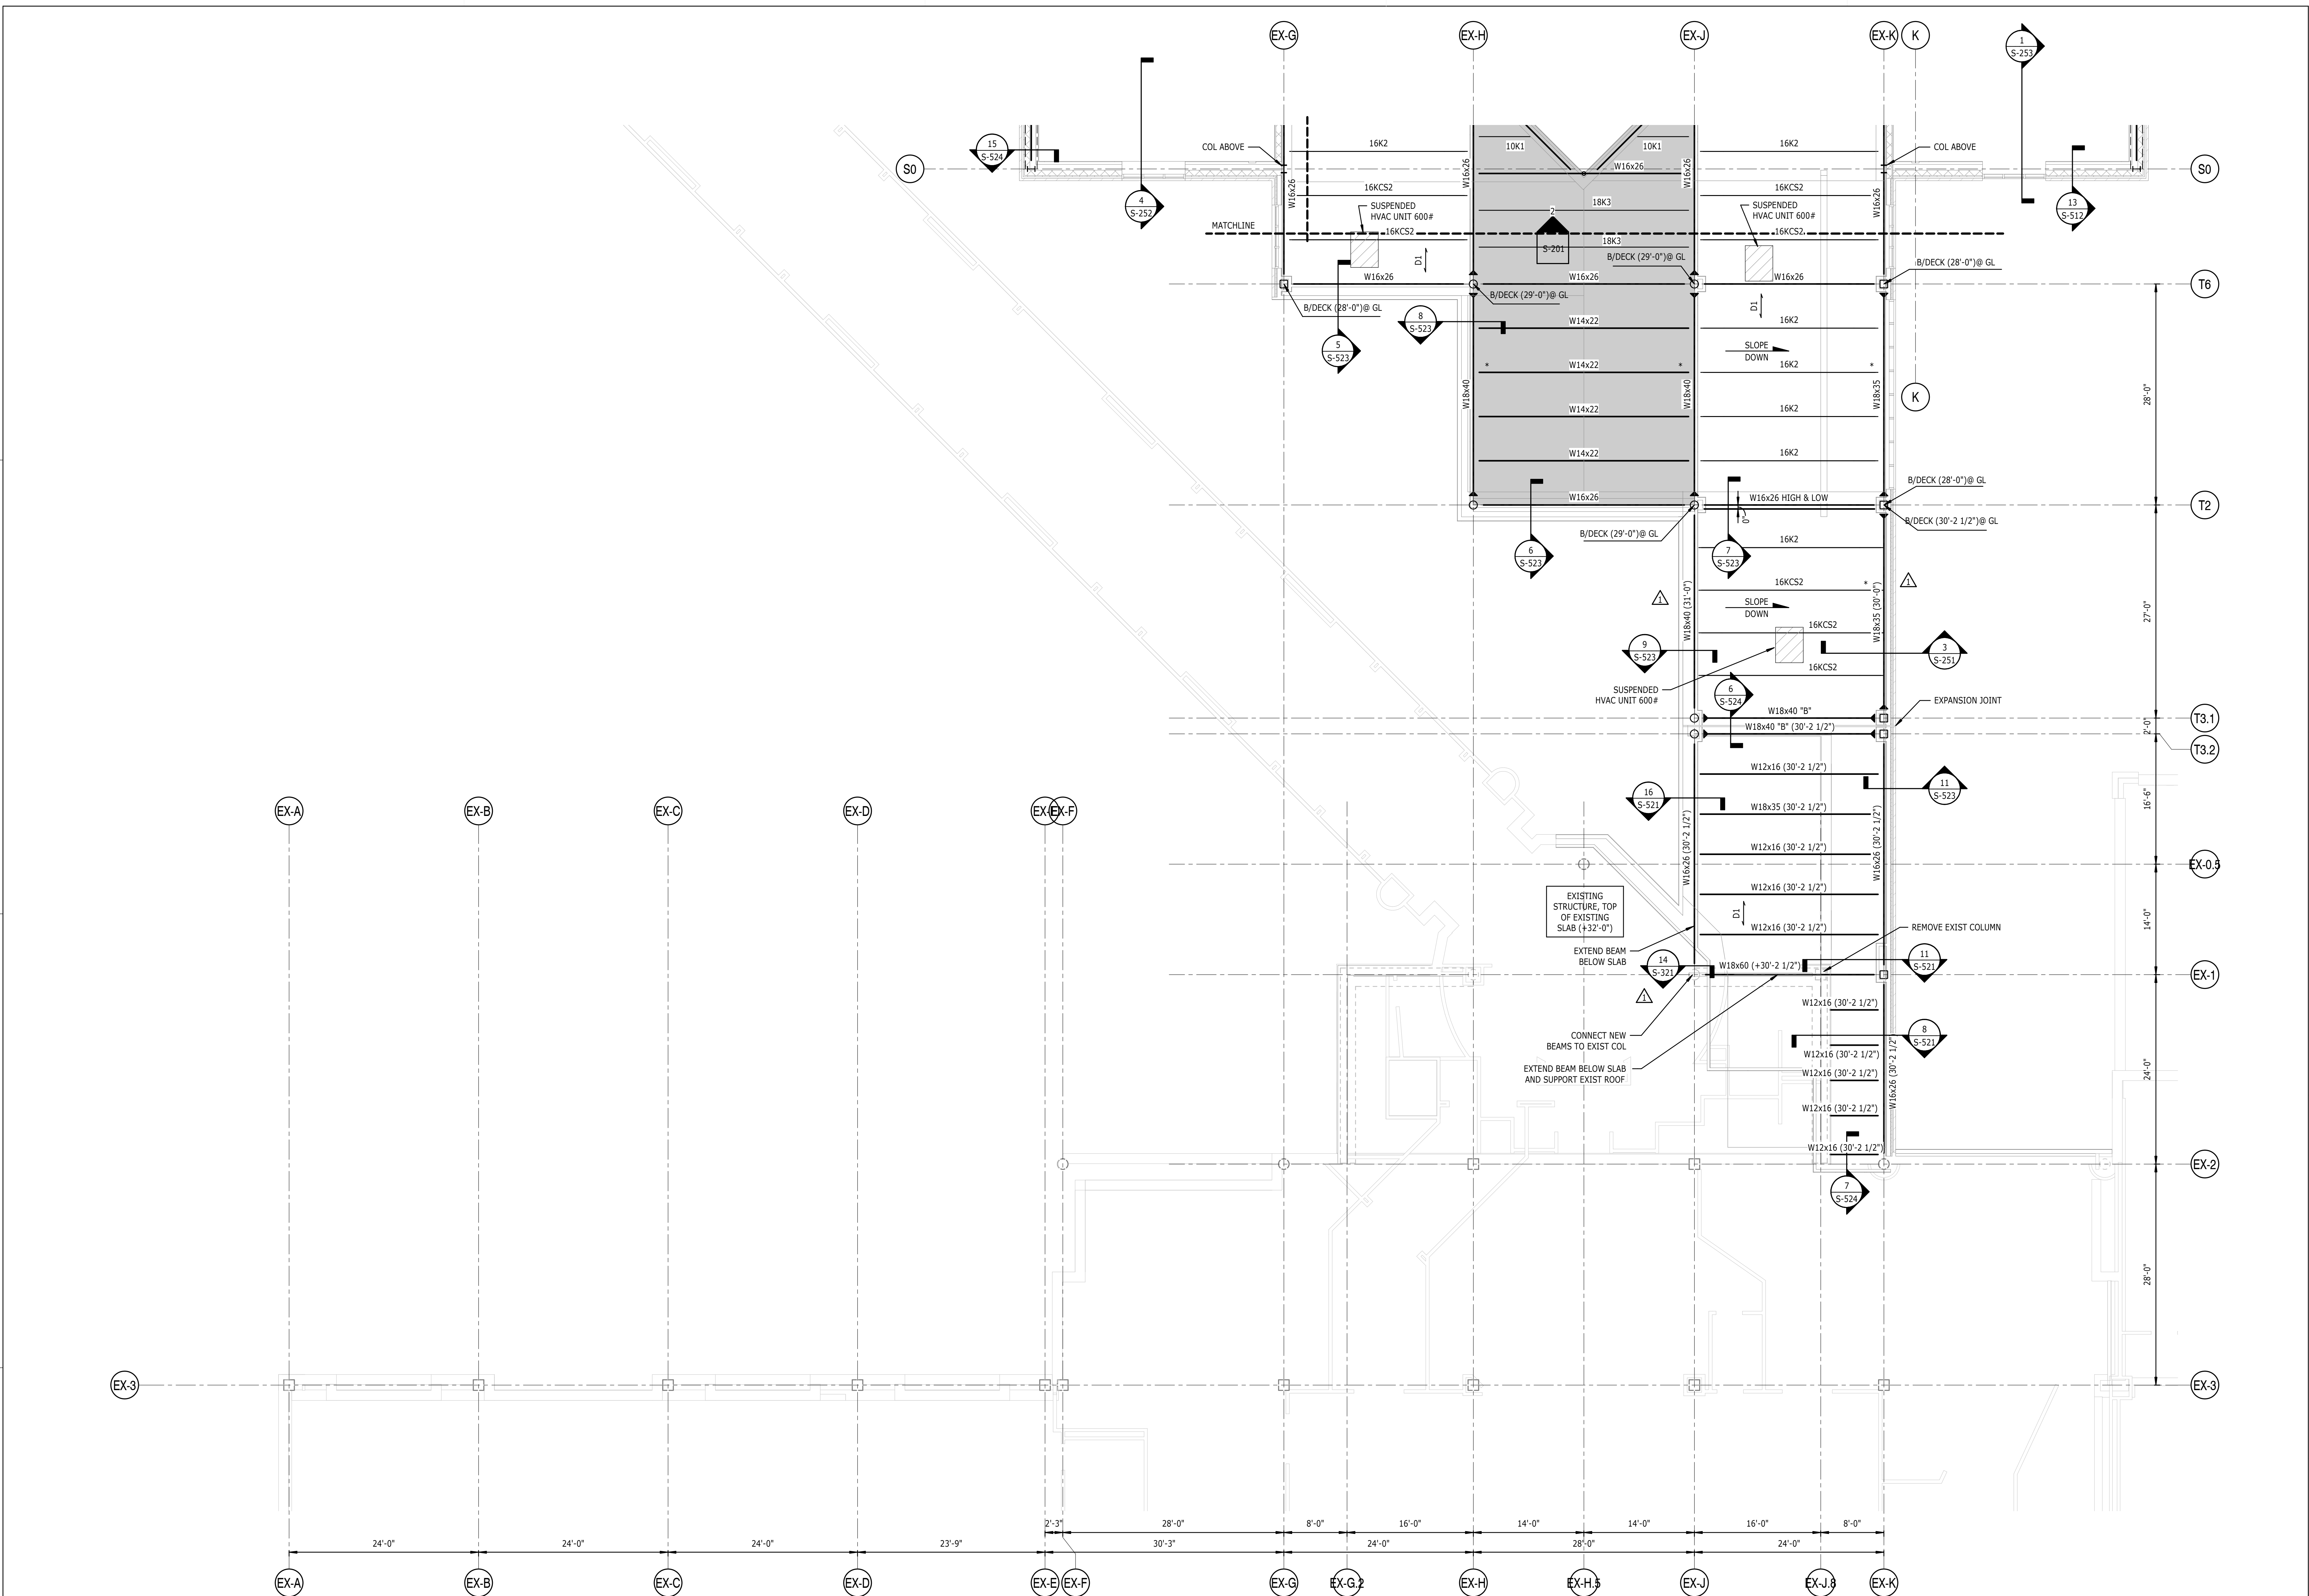

**1 ROOF FRAMING PLAN SCHEDULE 1 ZONE 3**

S1-133


1/8" = 1'-0"

- NOTES:
1. FOR GENERAL NOTES AND ABBREVIATIONS, SEE S-001.
  2. (No) INDICATES TOP OF STEEL ELEVATION ABOVE REFERENCED FINISH FLOOR ELEVATION.
  3. (D1) INDICATES STEEL DECK SPAN DIRECTION. CONSTRUCTION SHALL BE 1 1/2" 18GA METAL DECK. SEE 1/S-521 FOR TYPICAL ROOF CONSTRUCTION DETAIL.
  4. (D2) INDICATES MOMENT CONNECTION. SEE 19/S-511 FOR SCHEDULE.
  5. SEE ELEVATIONS ON PLAN FOR VERTICAL FRAME LOCATIONS AND S-211 FOR ELEVATIONS AND DETAILS.
  6. FOR TYPICAL ROOF FRAMING DETAILS, SEE S-521.
  7. FOR STEEL COLUMN SCHEDULE, SEE 1/S-501.
  8. "B" INDICATES BOTTOM FLANGE BEAM BRACING REQUIRED. BRACING SHALL BE PER DETAIL 19/S522. IF BRACING IS NOTED AT EXPANSION JOINTS, INSTALL BRACING ONLY ON ONE SIDE.
  9. "A-A" INDICATES BOTTOM CHORD EXTENSION REQUIRED.
  10. "A-AH" INDICATES FACTORED AXIAL FORCE IN COLLECTOR BEAM TO BE USED IN CONNECTION DESIGN.
  11. "B/DECK (+#-#)" INDICATES BOTTOM OF DECK ELEVATION FROM REFERENCED FINISH FLOOR ELEVATION.
  12. "TRUSS T#" INDICATES TRUSS TYPE, SEE S200 SERIES FOR ELEVATIONS.
  13. ALL EXPOSED STRUCTURAL STEEL (COLUMNS, ROOF TRUSSES, TRUSS BEARING & ETC) SHALL BE CONSIDERED AESS.
  14. "DZ" INDICATES STEEL DECK SPAN DIRECTION. CONSTRUCTION SHALL BE 1 1/2" 18GA METAL DECK. SEE 1/S-521 FOR TYPICAL ROOF CONSTRUCTION DETAIL.
  15. "##k-t" DENOTES FACTORED MOMENT TO BE USED IN DESIGN OF MOMENT CONNECTIONS.



TERMINAL IMPROVEMENTS CONTRACT 3

Wilmington International Airport 1740 Airport Boulevard, Suite 12 Wilmington, NC 28405

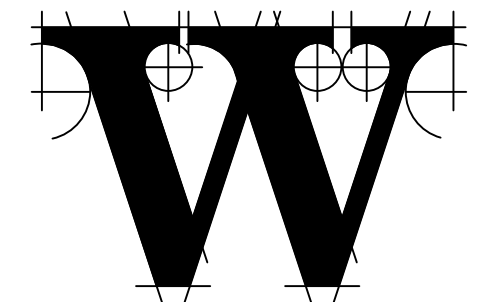

THE WILSON GROUP ARCHITECTS

PO Box 5510 Charlotte, NC 28299 704-331-9747 • www.twgarchitects.com

PROJECT MANAGER & CIVIL ENGINEER TALBERT & BRIGHT

CONSULTING ARCHITECT LS3P

STRUCTURAL ENGINEER FIRM LICENSE #C-1051 STEWART

FP/PM/E ENGINEER


CHEATHAM & ASSOC.

BAGGAGE HANDLING CONSULTANTS BNP

AIRCRAFT SUPPORT SYSTEMS DK CONSULTANTS

SPECIALTY LIGHTING CONSULTANT HARTRANFT

SINGAGE & WAYFINDING TAKEFORM

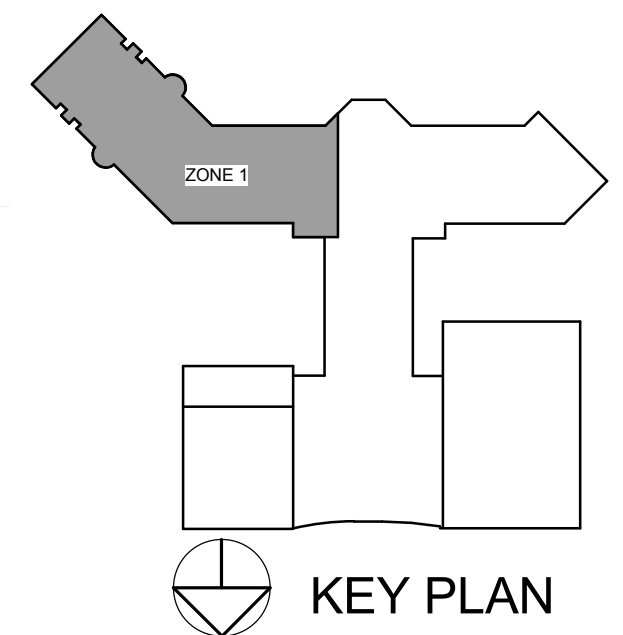

COPYRIGHT © 2019 THE WILSON GROUP ARCHITECTS ALL RIGHTS RESERVED

PRINTED OR ELECTRONIC DRAWINGS AND DOCUMENTATION MAY NOT BE REPRODUCED IN ANY FORM WITHOUT WRITTEN PERMISSION FROM THE WILSON GROUP ARCHITECTS

REVISIONS


- 1 7/12/19 AD-01
3 7/30/19 AD-03

DATE 06/28/2019 PROJECT NUMBER 9202-000 SHEET TITLE

PARTIAL HIGH ROOF FRAMING PLAN SCHEDULE 1 ZONE 1

SHEET NUMBER

S1-141

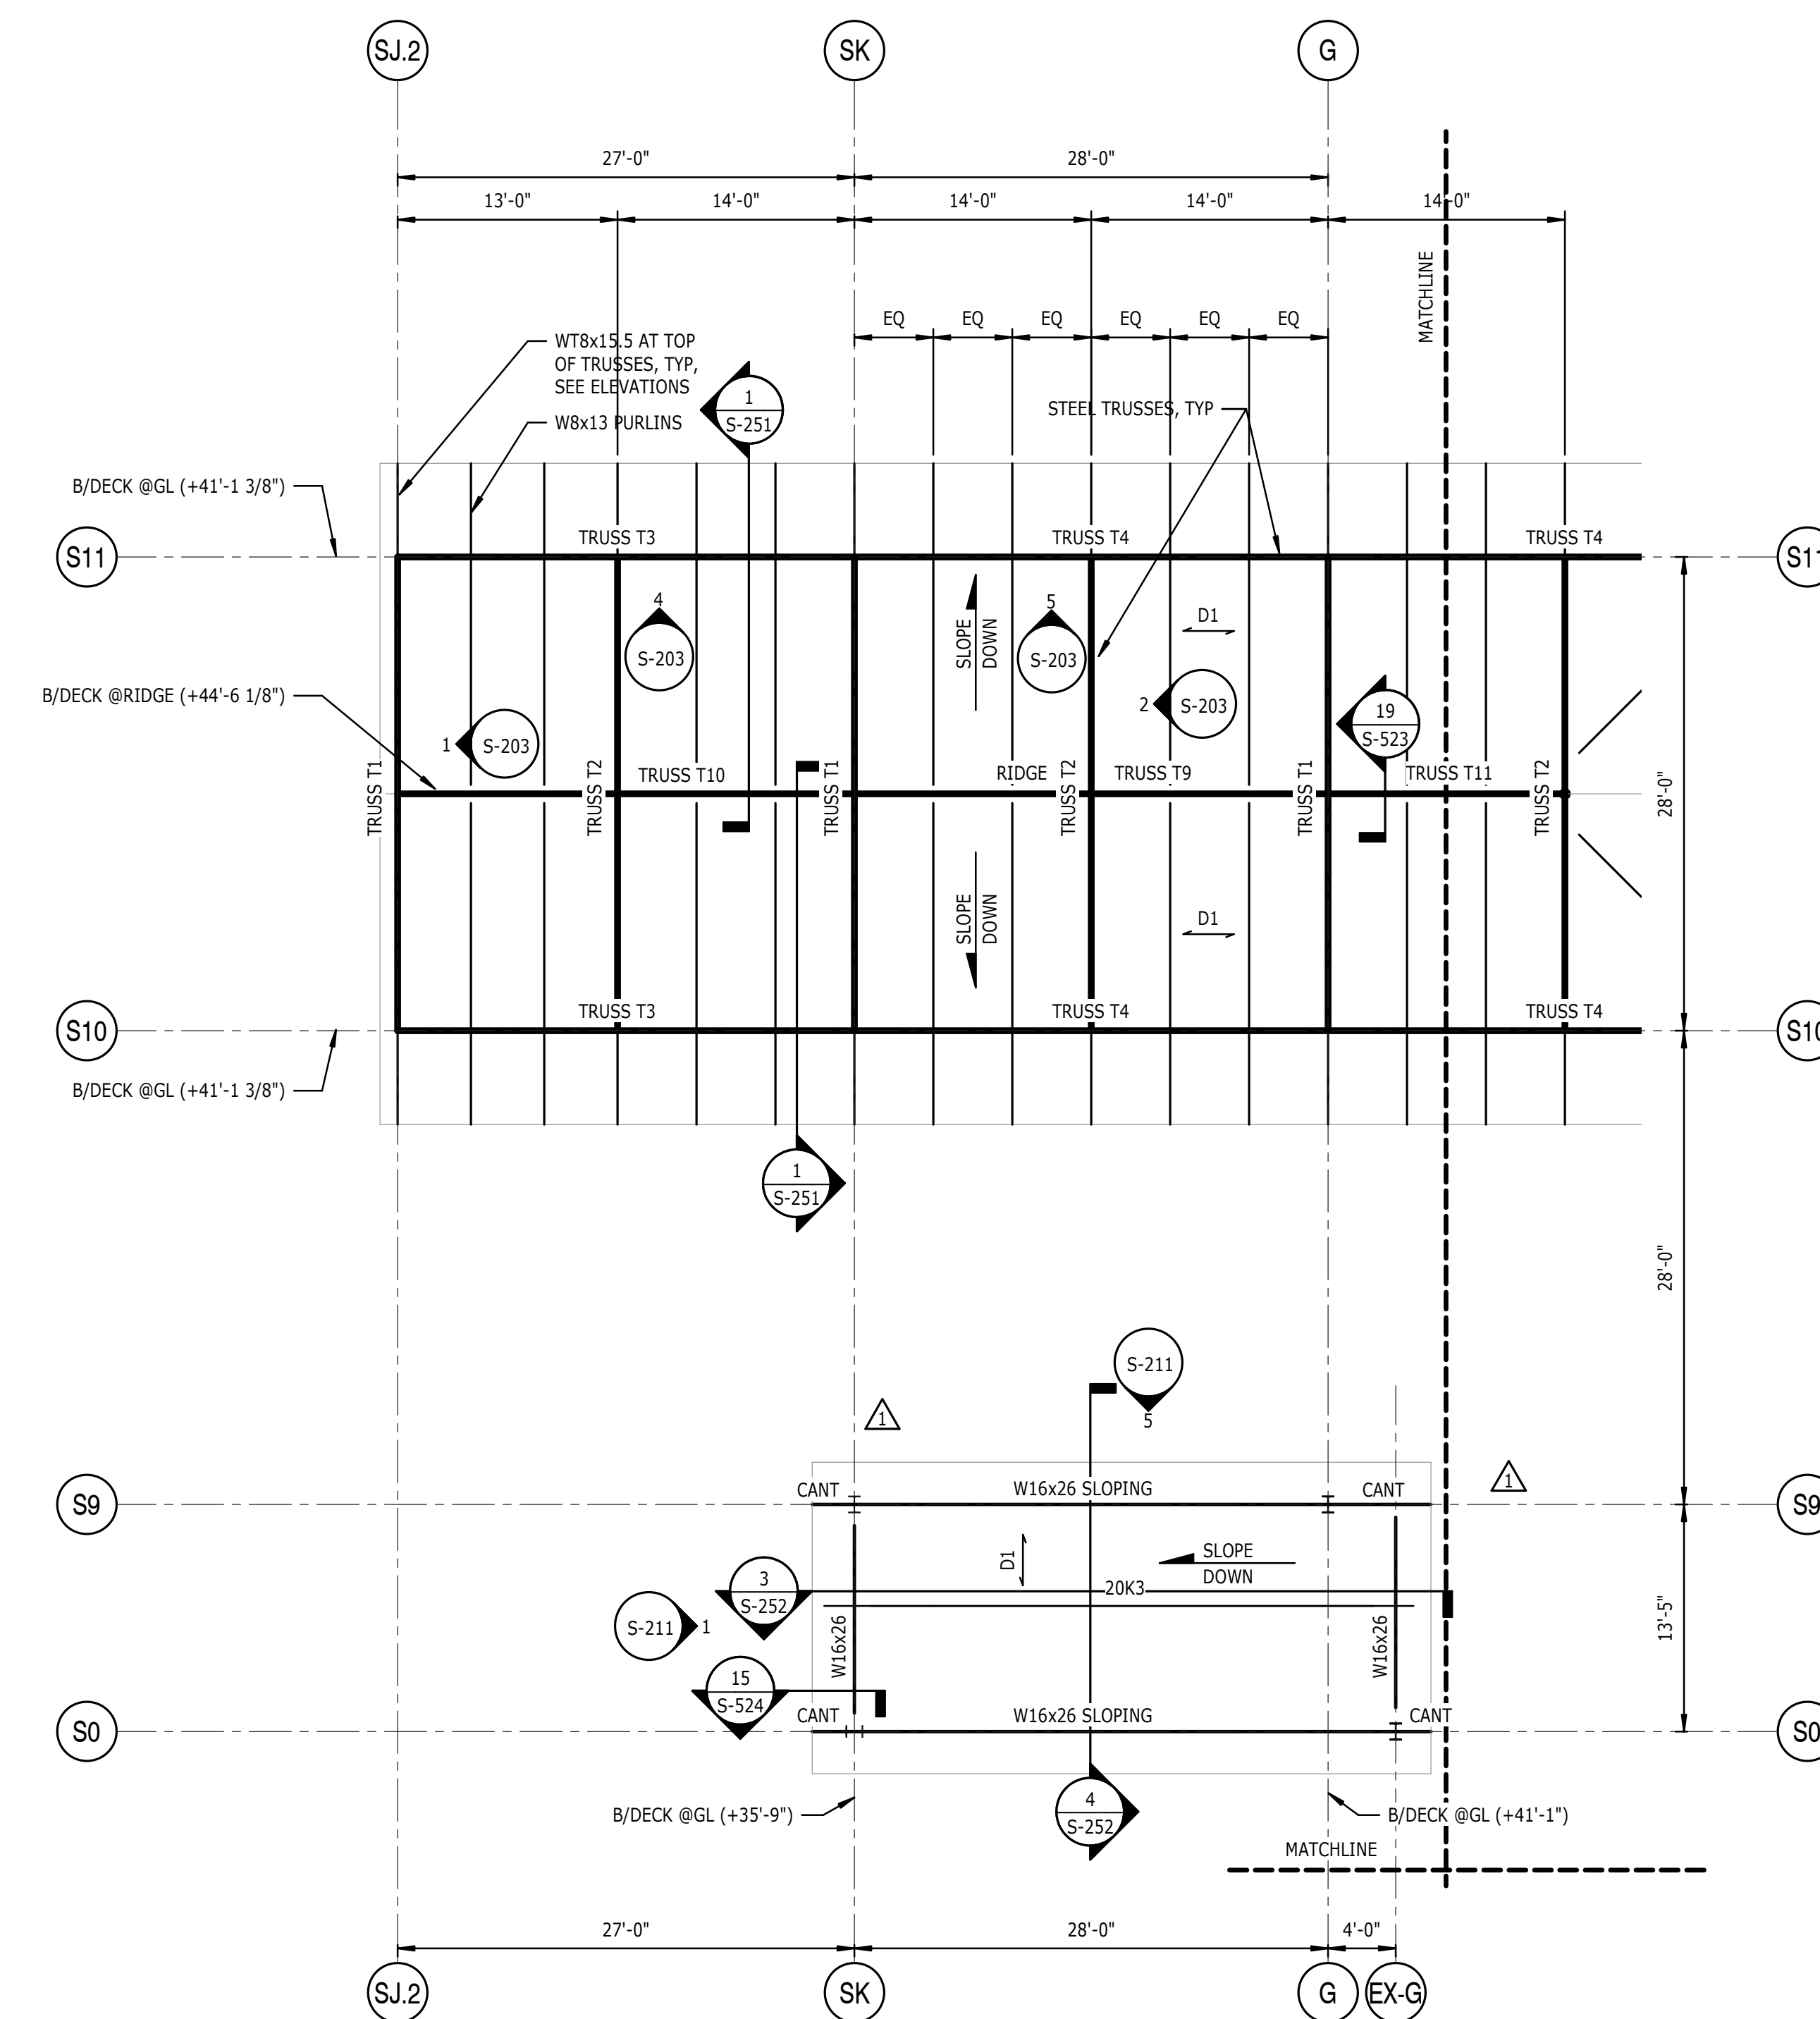



1 HIGH ROOF FRAMING PLAN SCHEDULE 1 ZONE 1

S1-141 1/8" = 1'-0"

NOTES:


- 1. FOR GENERAL NOTES AND ABBREVIATIONS, SEE S-001.
2. (No) INDICATES TOP OF STEEL ELEVATION ABOVE REFERENCED FINISH FLOOR ELEVATION.
3. D1 INDICATES STEEL DECK SPAN DIRECTION. CONSTRUCTION SHALL BE 1 1/2" 18GA METAL DECK. SEE 1/S-521 FOR TYPICAL ROOF CONSTRUCTION DETAIL.
4. D2 INDICATES MOMENT CONNECTION. SEE 1/S-511 FOR SCHEDULE.
5. SEE ELEVATIONS ON PLAN FOR VERTICAL FRAME LOCATIONS AND S-211 FOR ELEVATIONS AND DETAILS.
6. FOR TYPICAL ROOF FRAMING DETAILS, SEE S-521.
7. FOR STEEL COLUMN SCHEDULE, SEE 1/S-501.
8. D1 INDICATES BOTTOM FLANGE BEAM BRACING REQUIRED. BRACING SHALL BE PER DETAIL 19/S522. IF BRACING IS NOTED AT EXPANSION JOINTS, INSTALL BRACING ONLY ON ONE SIDE.
9. \*\*\* INDICATES BOTTOM CHORD EXTENSION REQUIRED.
10. "A=#K" INDICATES FACTORED AXIAL FORCE IN COLLECTOR BEAM TO BE USED IN CONNECTION DESIGN.
11. "B/DECK (+#'-#") INDICATES BOTTOM OF DECK ELEVATION FROM REFERENCED FINISH FLOOR ELEVATION.
12. "TRUSS T#" INDICATES TRUSS TYPE. SEE S200 SERIES FOR ELEVATIONS.
13. ALL EXPOSED STRUCTURAL STEEL (COLUMNS, ROOF TRUSSES, TRUSS BEARING & ETC) SHALL BE CONSIDERED AESS.
14. D2 INDICATES STEEL DECK SPAN DIRECTION. CONSTRUCTION SHALL BE 1 1/2" 18GA METAL DECK. SEE 1/S-521 FOR TYPICAL ROOF CONSTRUCTION DETAIL.
15. "M=#K" DENOTES FACTORED MOMENT TO BE USED IN DESIGN OF MOMENT CONNECTIONS.



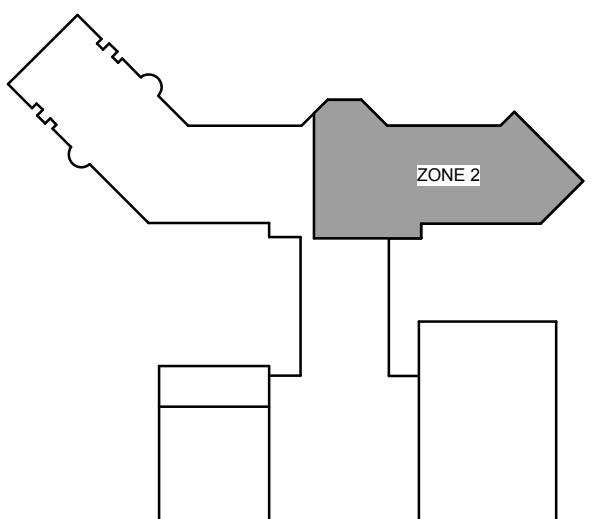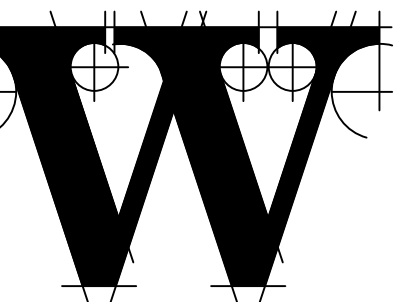


**REVISIONS**

1	7/12/19	AD-01
3	7/30/19	AD-03

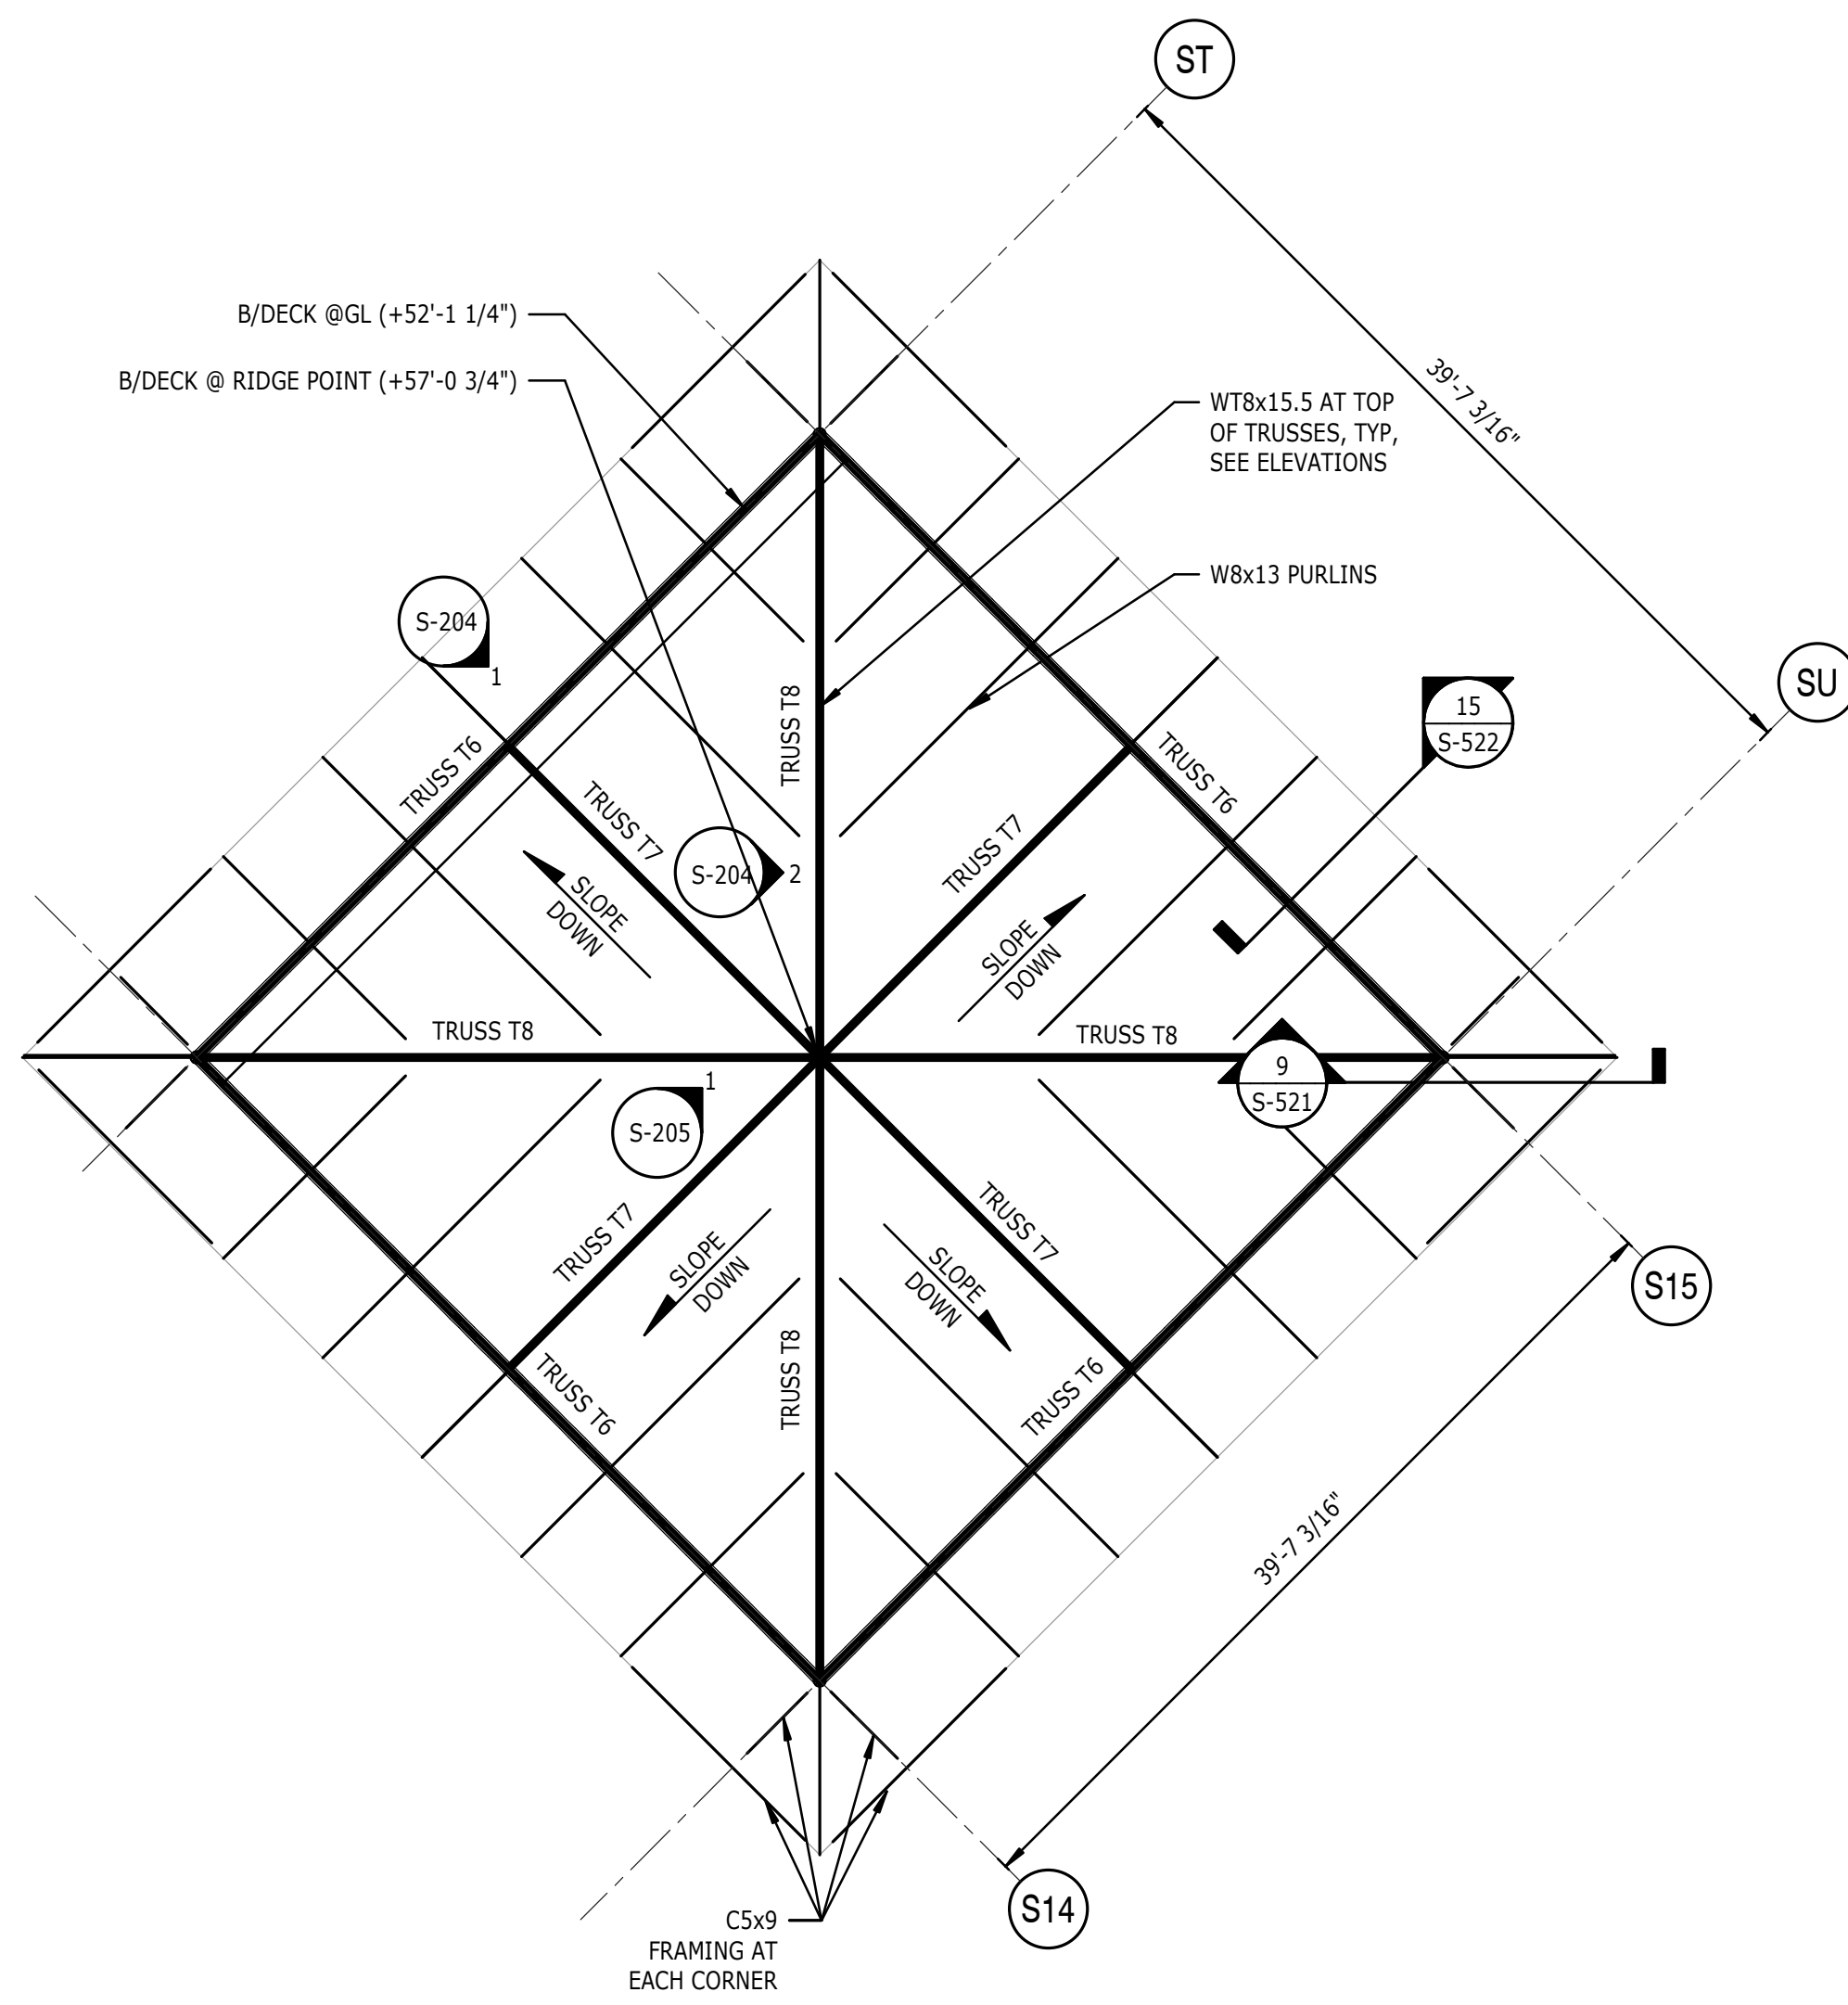


**2 HIGH ROOF FRAMING PLAN SCHEDULE 1**  
S1-142 1/8" = 1'-0"

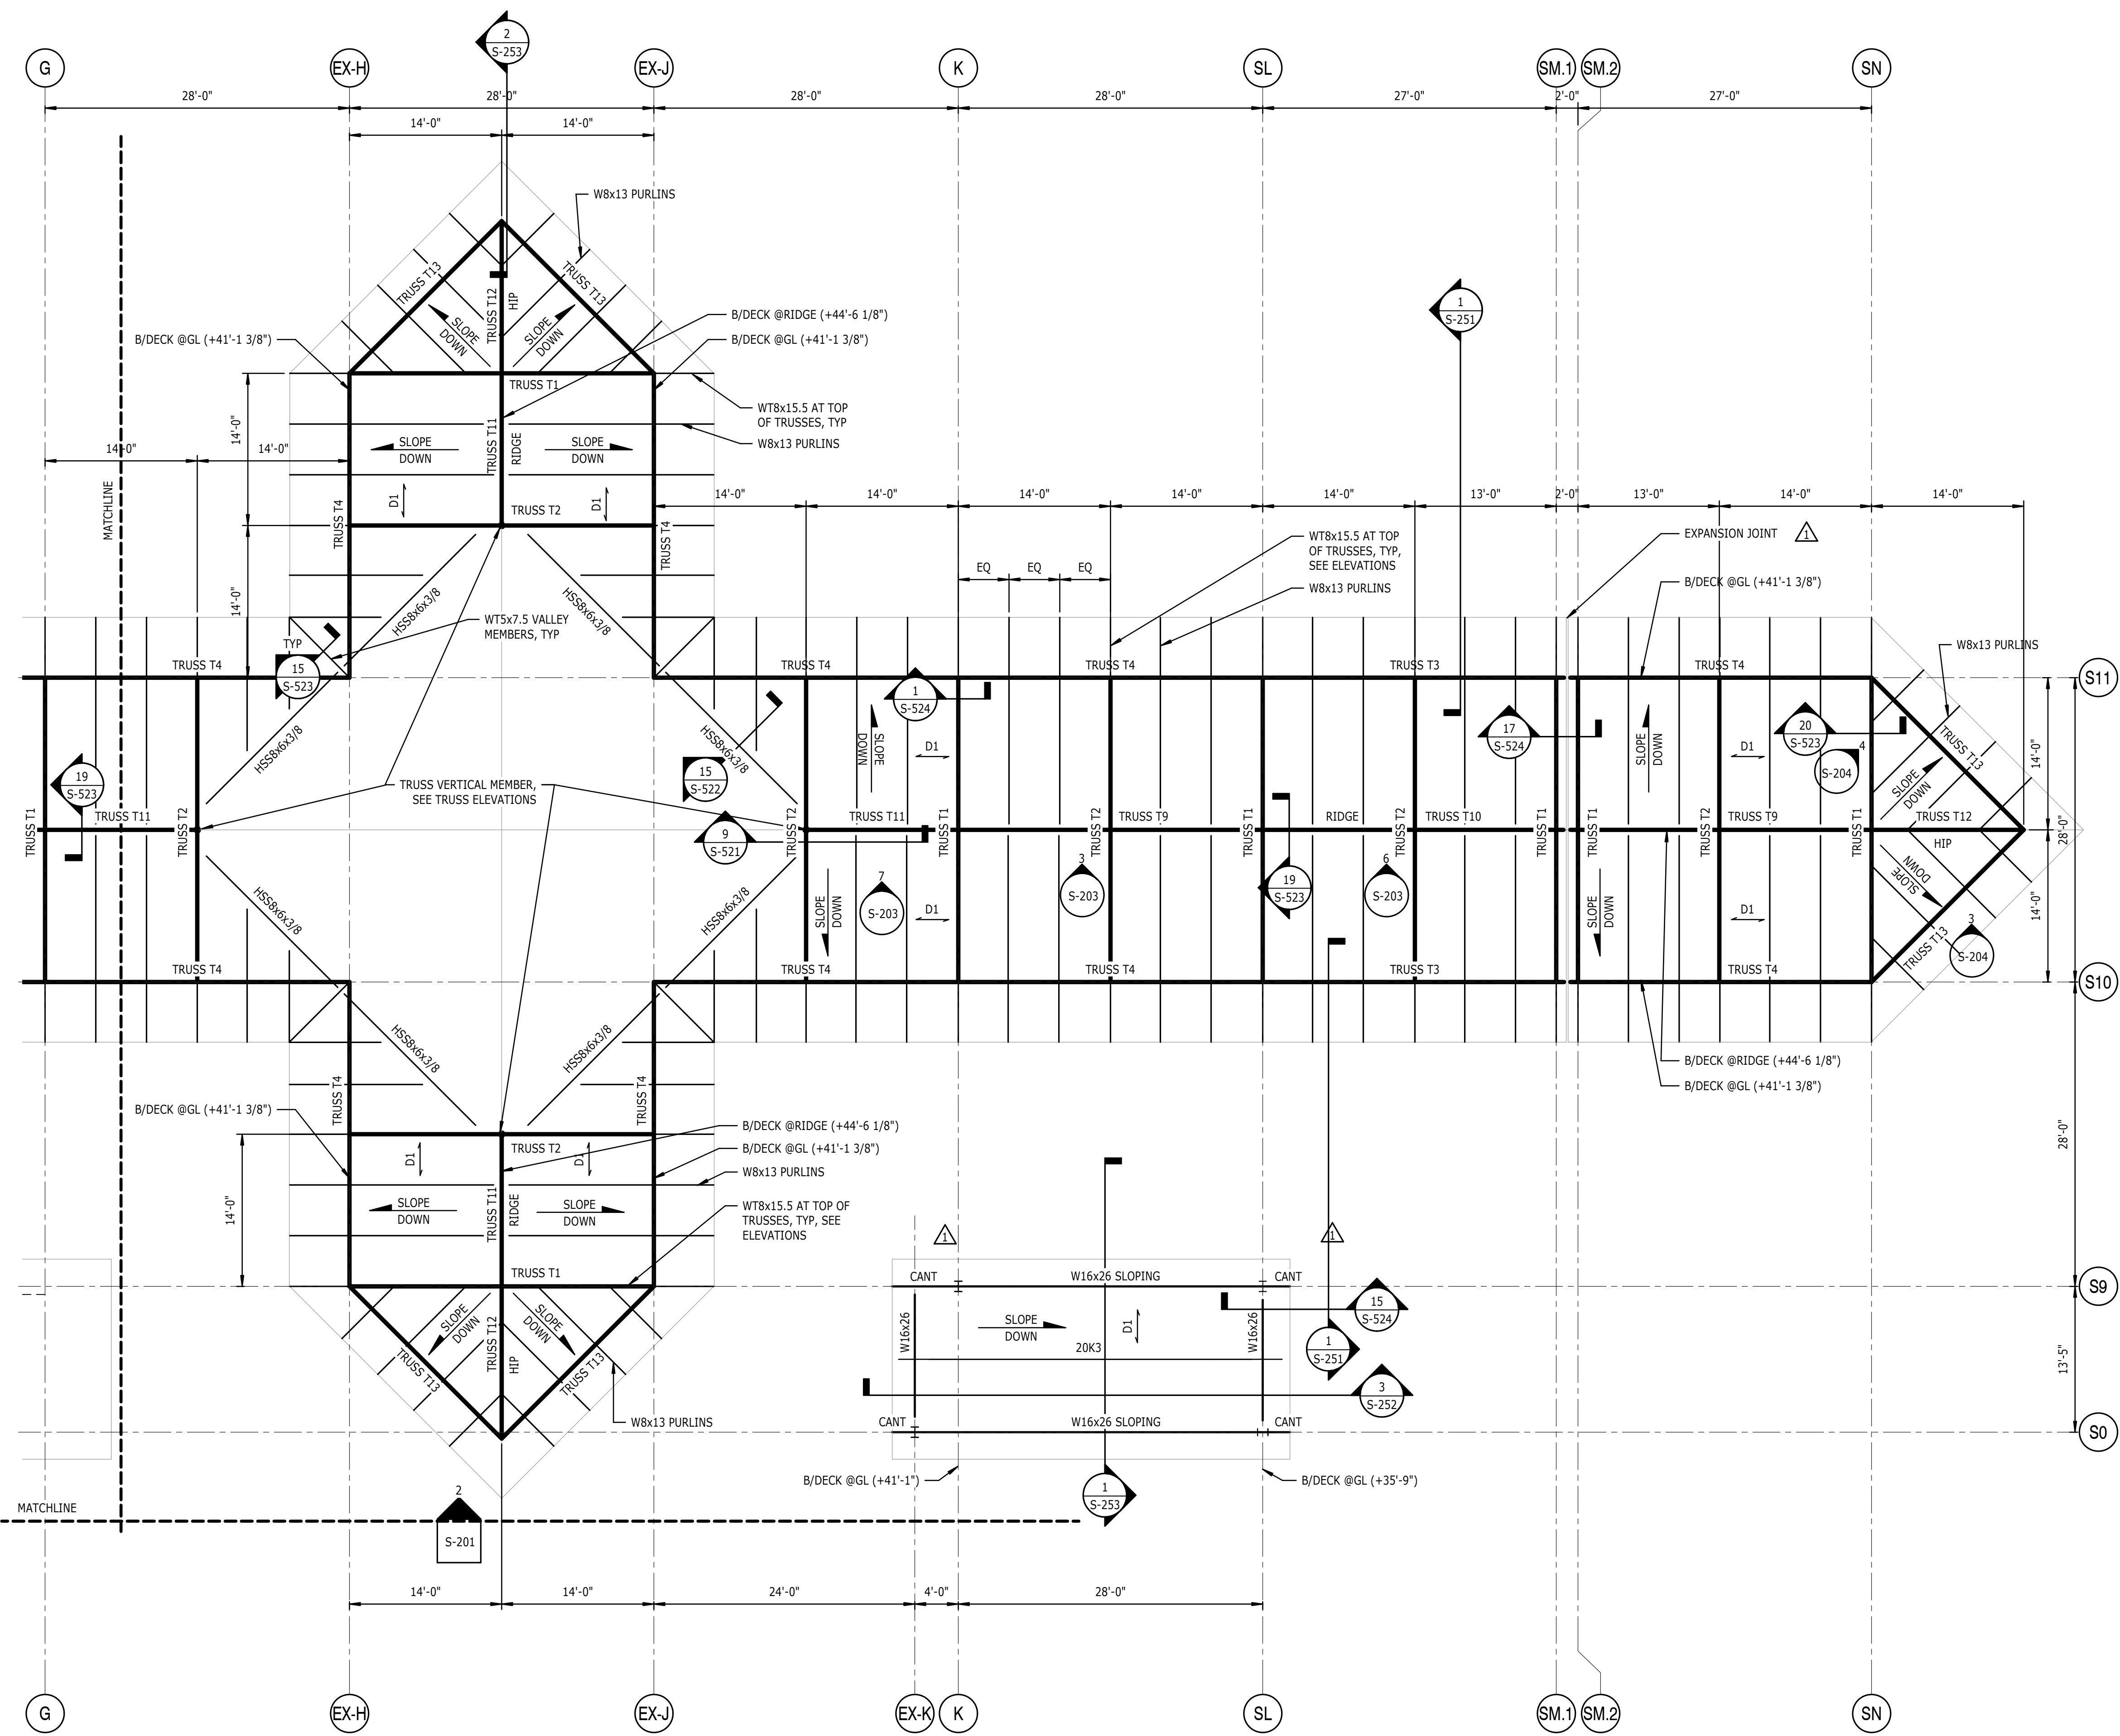


**1 HIGH ROOF FRAMING PLAN SCHEDULE 1 ZONE 2**  
S1-142 1/8" = 1'-0"

- NOTES:
- FOR GENERAL NOTES AND ABBREVIATIONS, SEE S-001.
  - (N6) INDICATES TOP OF STEEL ELEVATION ABOVE REFERENCED FINISH FLOOR ELEVATION.
  - D1 INDICATES STEEL DECK SPAN DIRECTION. CONSTRUCTION SHALL BE 1 1/2" 18GA METAL DECK. SEE 1/S-521 FOR TYPICAL ROOF CONSTRUCTION DETAIL.
  - INDICATES MOMENT CONNECTION, SEE 19/S-511 FOR SCHEDULE.
  - SEE ELEVATIONS ON PLAN FOR VERTICAL FRAME LOCATIONS AND S-211 FOR ELEVATIONS AND DETAILS.
  - FOR TYPICAL ROOF FRAMING DETAILS, SEE S-521.
  - FOR STEEL COLUMN SCHEDULE, SEE 1/S-501.
  - "B" INDICATES BOTTOM FLANGE BEAM BRACING REQUIRED. BRACING SHALL BE PER DETAIL 19/S-522. IF BRACING IS NOTED AT EXPANSION JOINTS, INSTALL BRACING ONLY ON ONE SIDE.
  - \*\* INDICATES BOTTOM CHORD EXTENSION REQUIRED.
  - "A#K" INDICATES FACTORED AXIAL FORCE IN COLLECTOR BEAM TO BE USED IN CONNECTION DESIGN.
  - "B/DECK (+#-#)" INDICATES BOTTOM OF DECK ELEVATION FROM REFERENCED FINISH FLOOR ELEVATION.
  - "TRUSS T#" INDICATES TRUSS TYPE. SEE S200 SERIES FOR ELEVATIONS.
  - ALL EXPOSED STRUCTURAL STEEL (COLUMNS, ROOF TRUSSES, TRUSS BEARING & ETC) SHALL BE CONSIDERED AESS.
  - D2 INDICATES STEEL DECK SPAN DIRECTION. CONSTRUCTION SHALL BE 1 1/2" 18GA METAL DECK. SEE 1/S-521 FOR TYPICAL ROOF CONSTRUCTION DETAIL.
  - "#k-r" DENOTES FACTORED MOMENT TO BE USED IN DESIGN OF MOMENT CONNECTIONS.

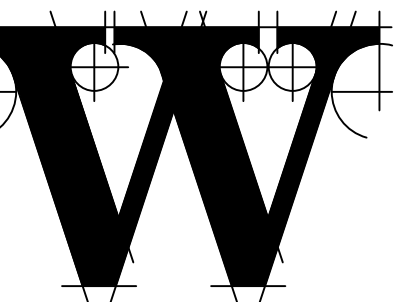


**REVISIONS**

1	7/12/19	AD-01
3	7/30/19	AD-03

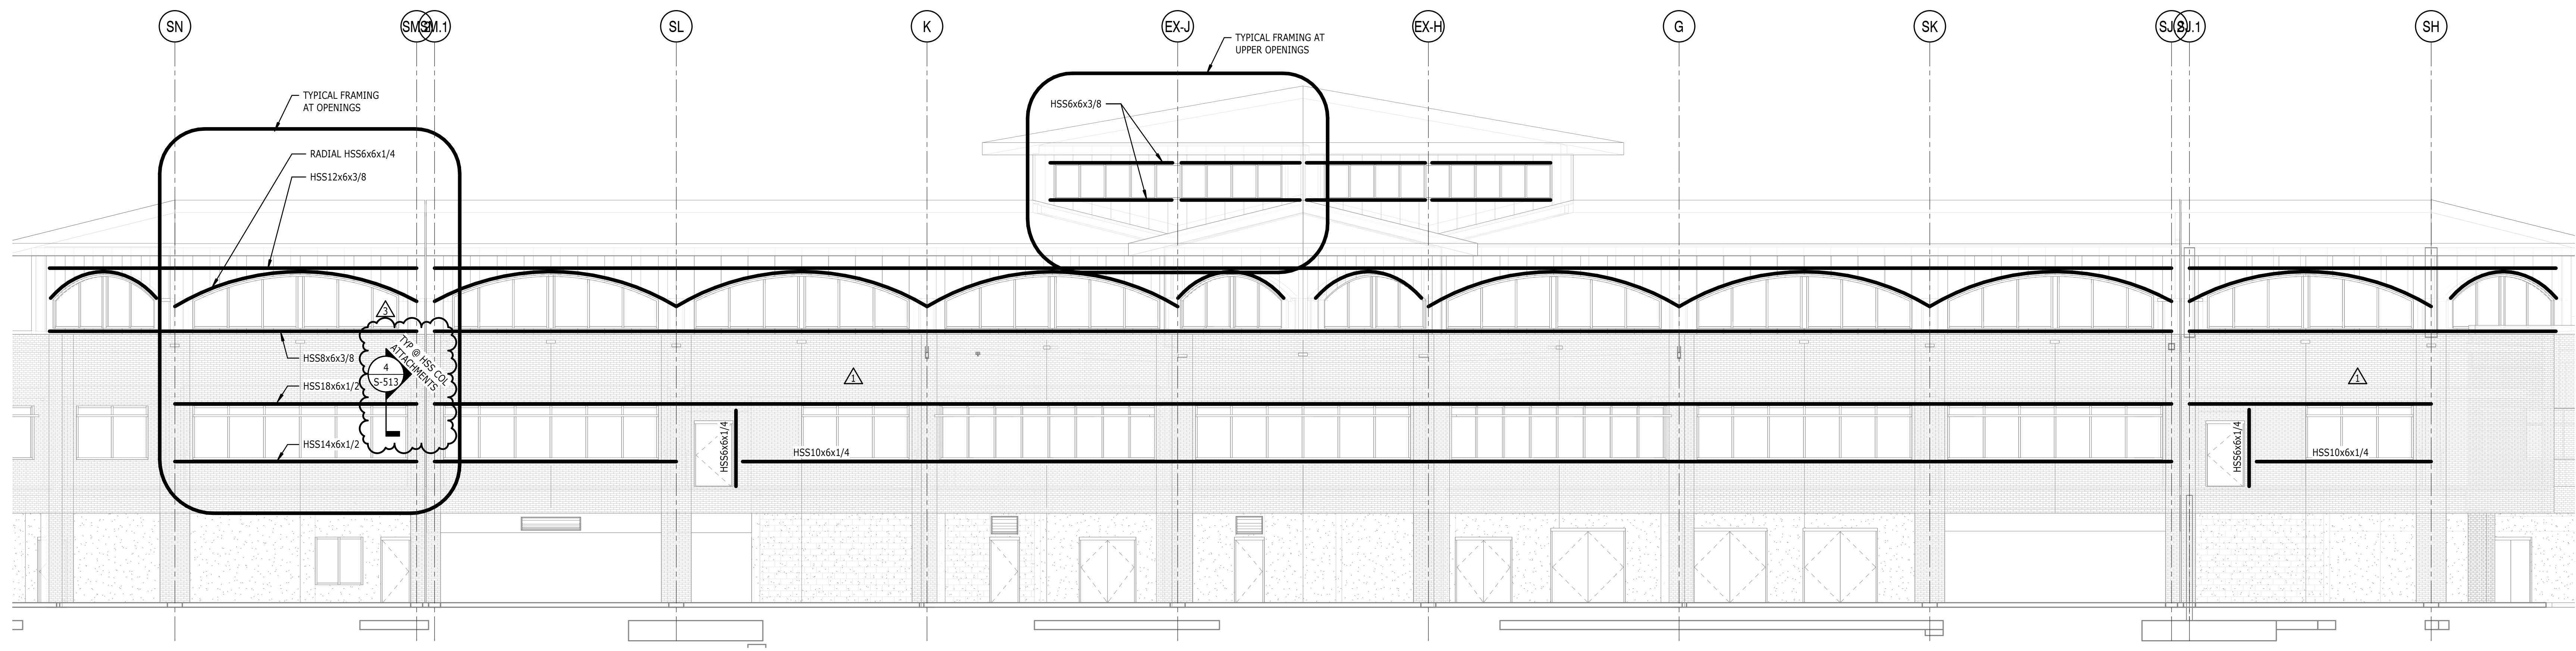

**1 SOUTH ELEVATION**  
S-201 1/8" = 1'-0"

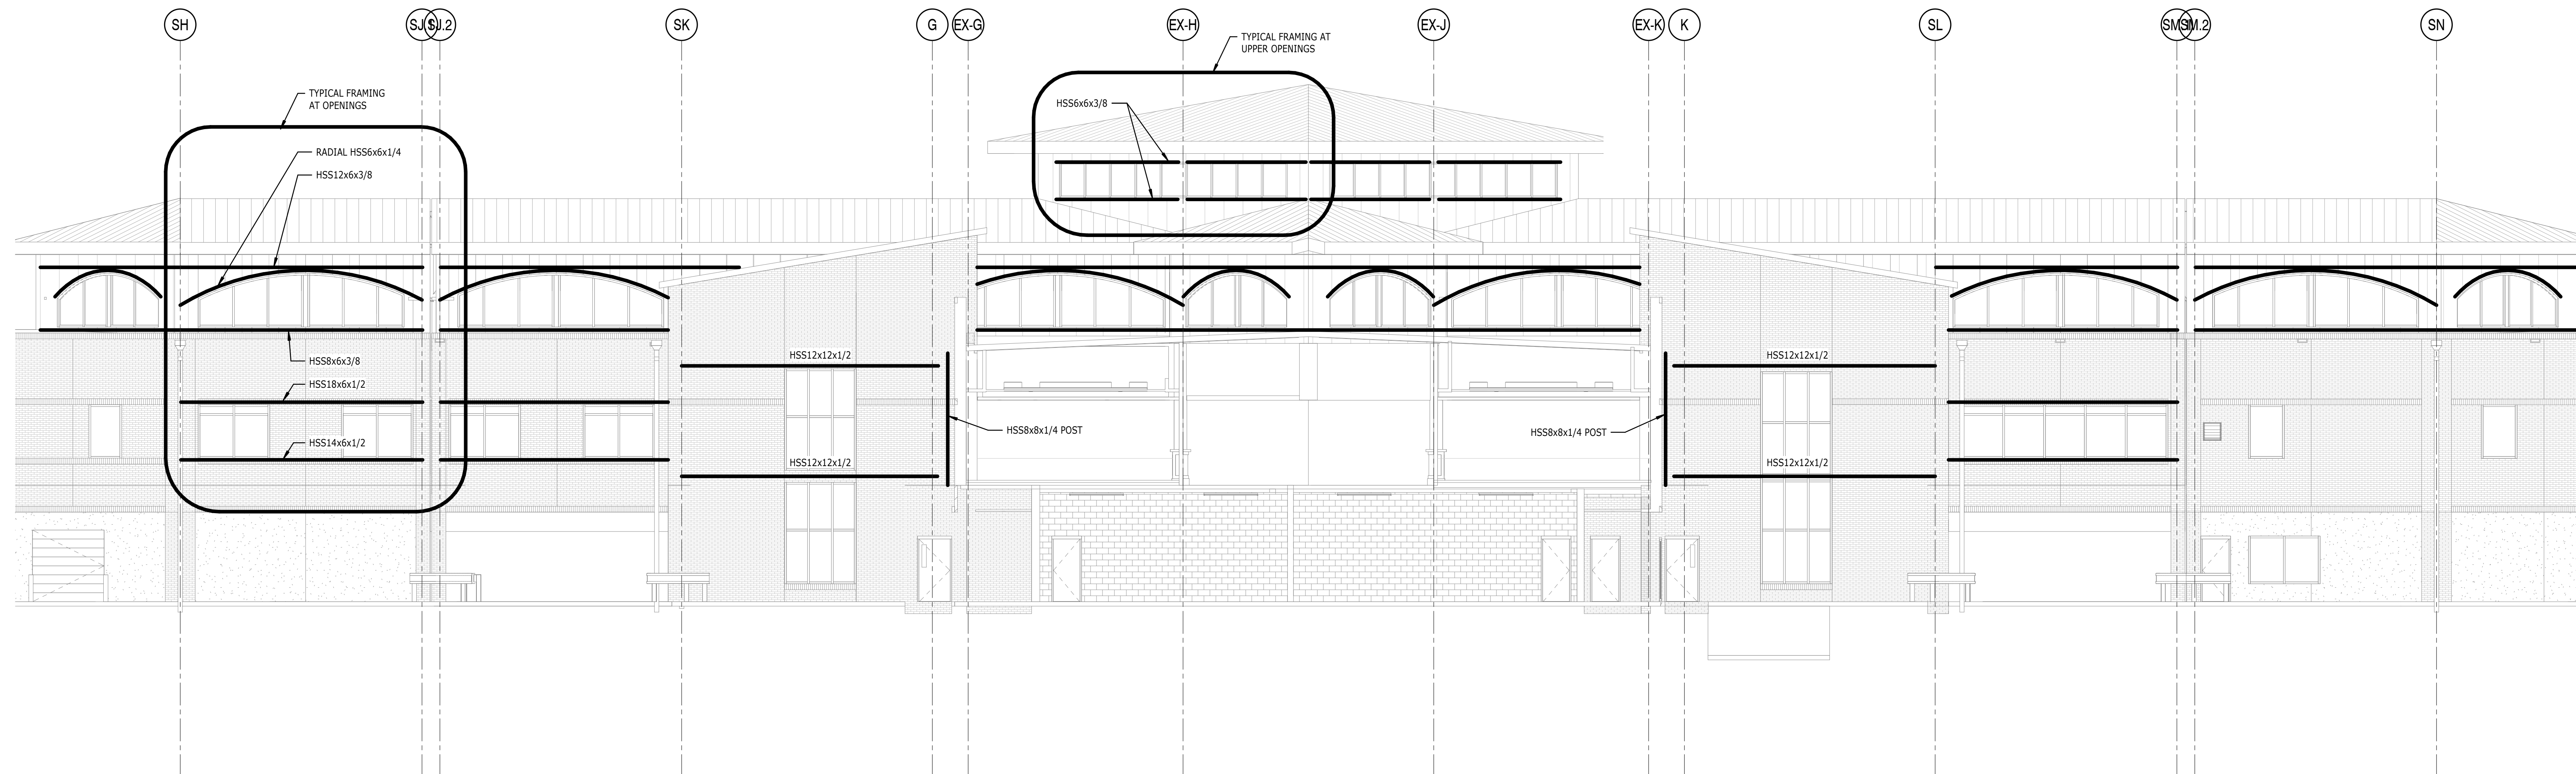


**2 NORTH ELEVATION**  
S-201 1/8" = 1'-0"



TERMINAL IMPROVEMENTS CONTRACT 3

Wilmington International Airport  
1740 Airport Boulevard, Suite 12  
Wilmington, NC 28405

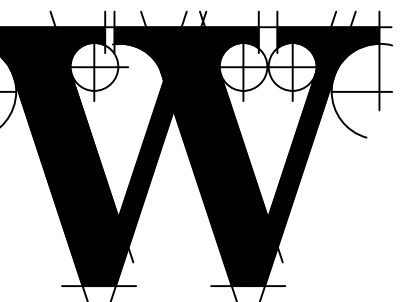

THE WILSON GROUP ARCHITECTS

PO Box 5510 Charlotte, NC 28299  
704-331-9747 • www.twgarchitects.com

PROJECT MANAGER & CIVIL ENGINEER  
**TALBERT & BRIGHT**

CONSULTING ARCHITECT  
**LS3P**

STRUCTURAL ENGINEER  
FIRM LICENSE #C-1051  
**STEWART**

FP/PM/E ENGINEER  
**CHEATHAM & ASSOC.**

BAGGAGE HANDLING CONSULTANTS  
**BNP**

AIRCRAFT SUPPORT SYSTEMS  
**DK CONSULTANTS**

SPECIALTY LIGHTING CONSULTANT  
**HARTRANFT**

SINGAGE & WAYFINDING  
**TAKEFORM**

COPYRIGHT © 2019  
THE WILSON GROUP ARCHITECTS  
ALL RIGHTS RESERVED

PRINTED OR ELECTRONIC DRAWINGS AND DOCUMENTATION MAY NOT BE REPRODUCED IN ANY FORM WITHOUT WRITTEN PERMISSION FROM THE WILSON GROUP ARCHITECTS


REVISIONS

- 1 7/12/19 AD-01
- 3 7/30/19 AD-03


DATE 06/28/2019  
PROJECT NUMBER 9202-000  
SHEET TITLE

STRUCTURAL ELEVATIONS


SHEET NUMBER  
**S-202**

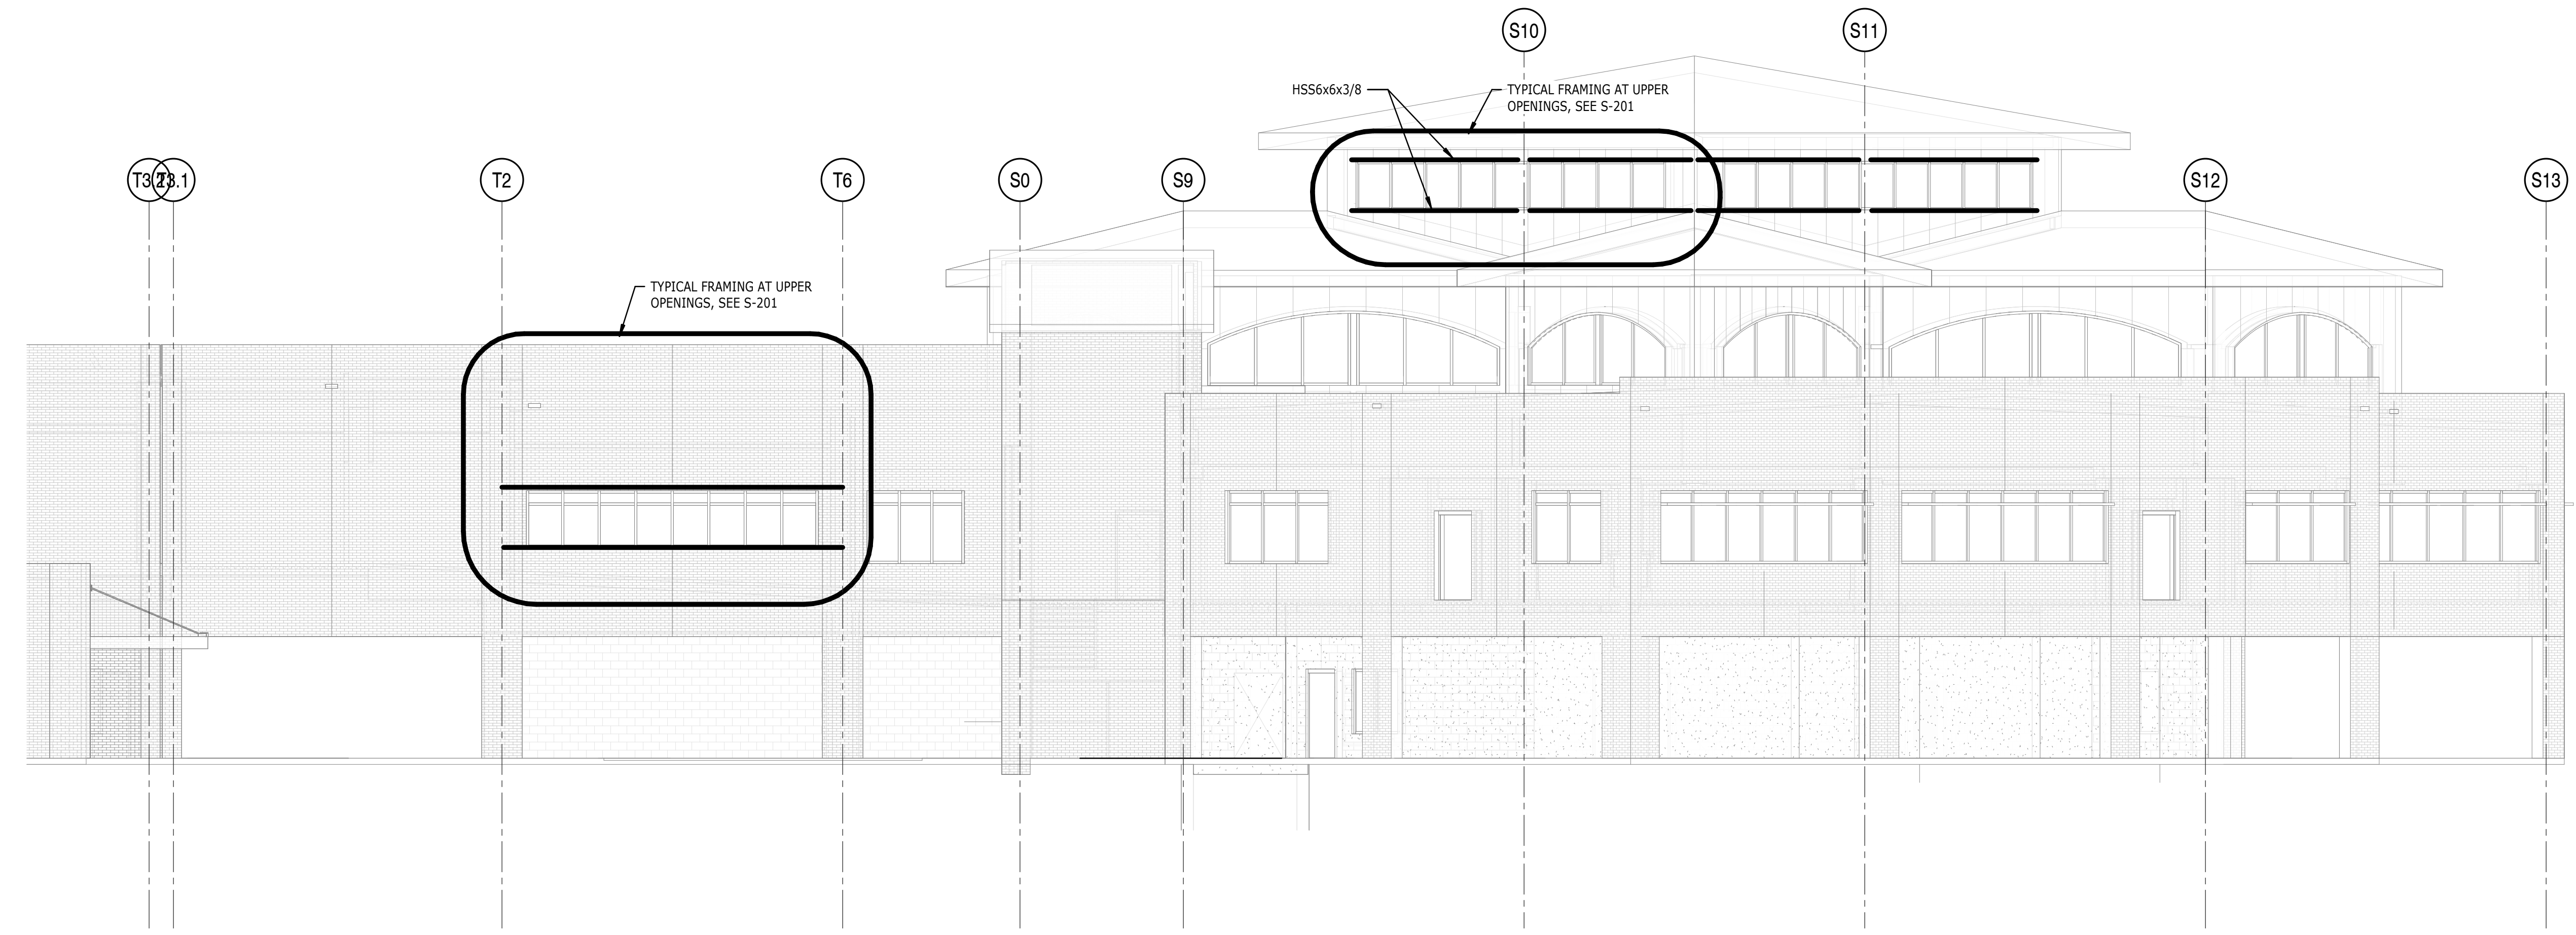


1 WEST ELEVATION  
S-202 1/8" = 1'-0"

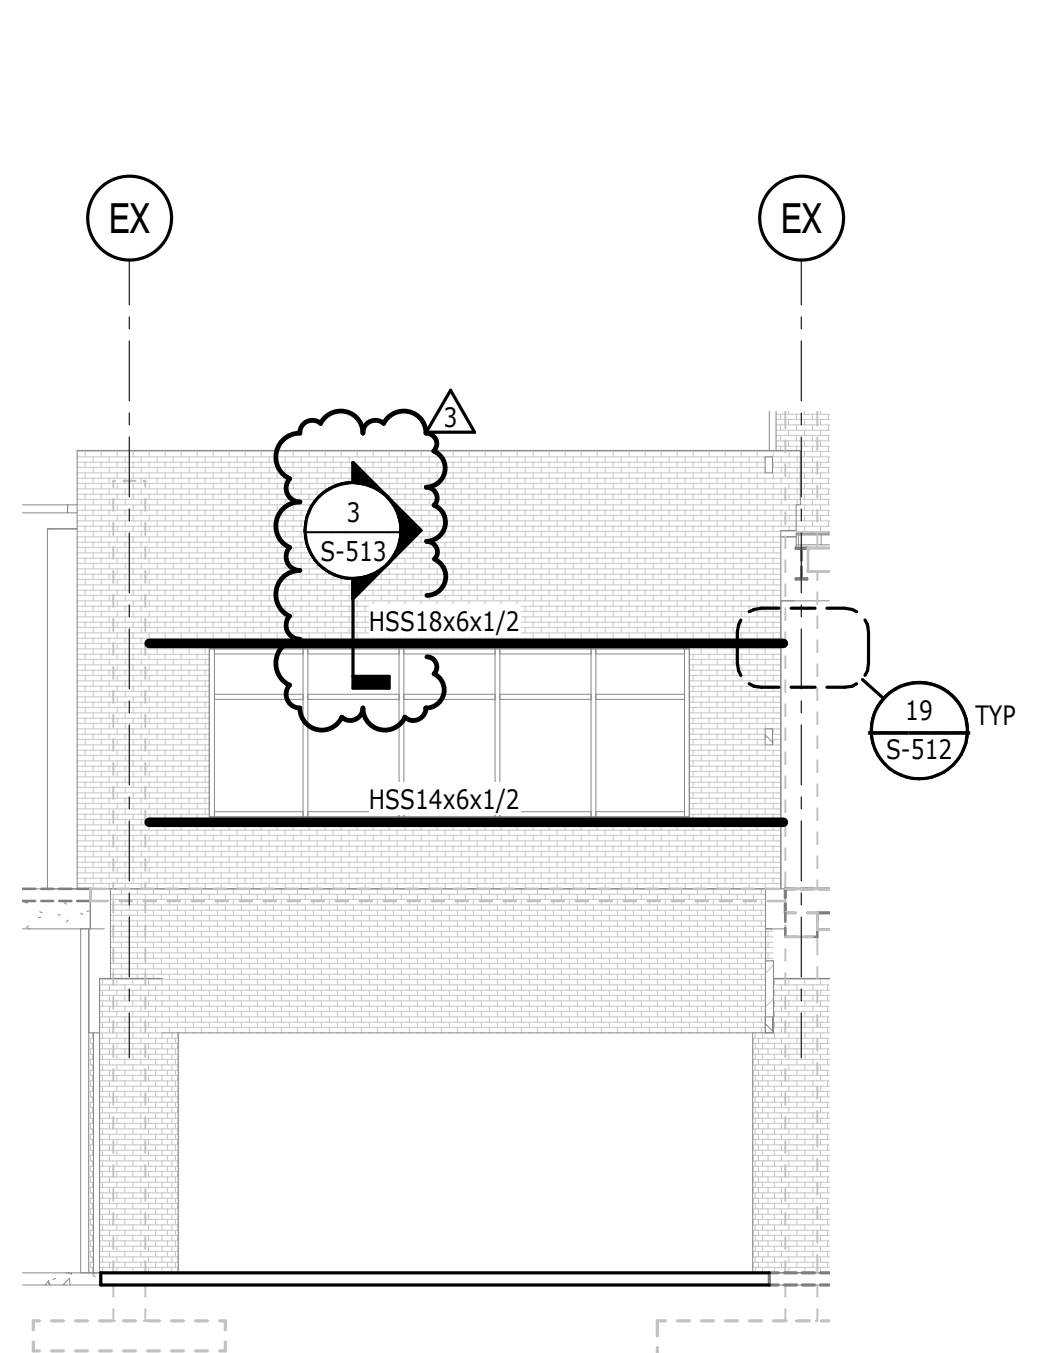

3 NEW OPENING IN EXISTING WALL ELEVATION  
S-202 1/8" = 1'-0"

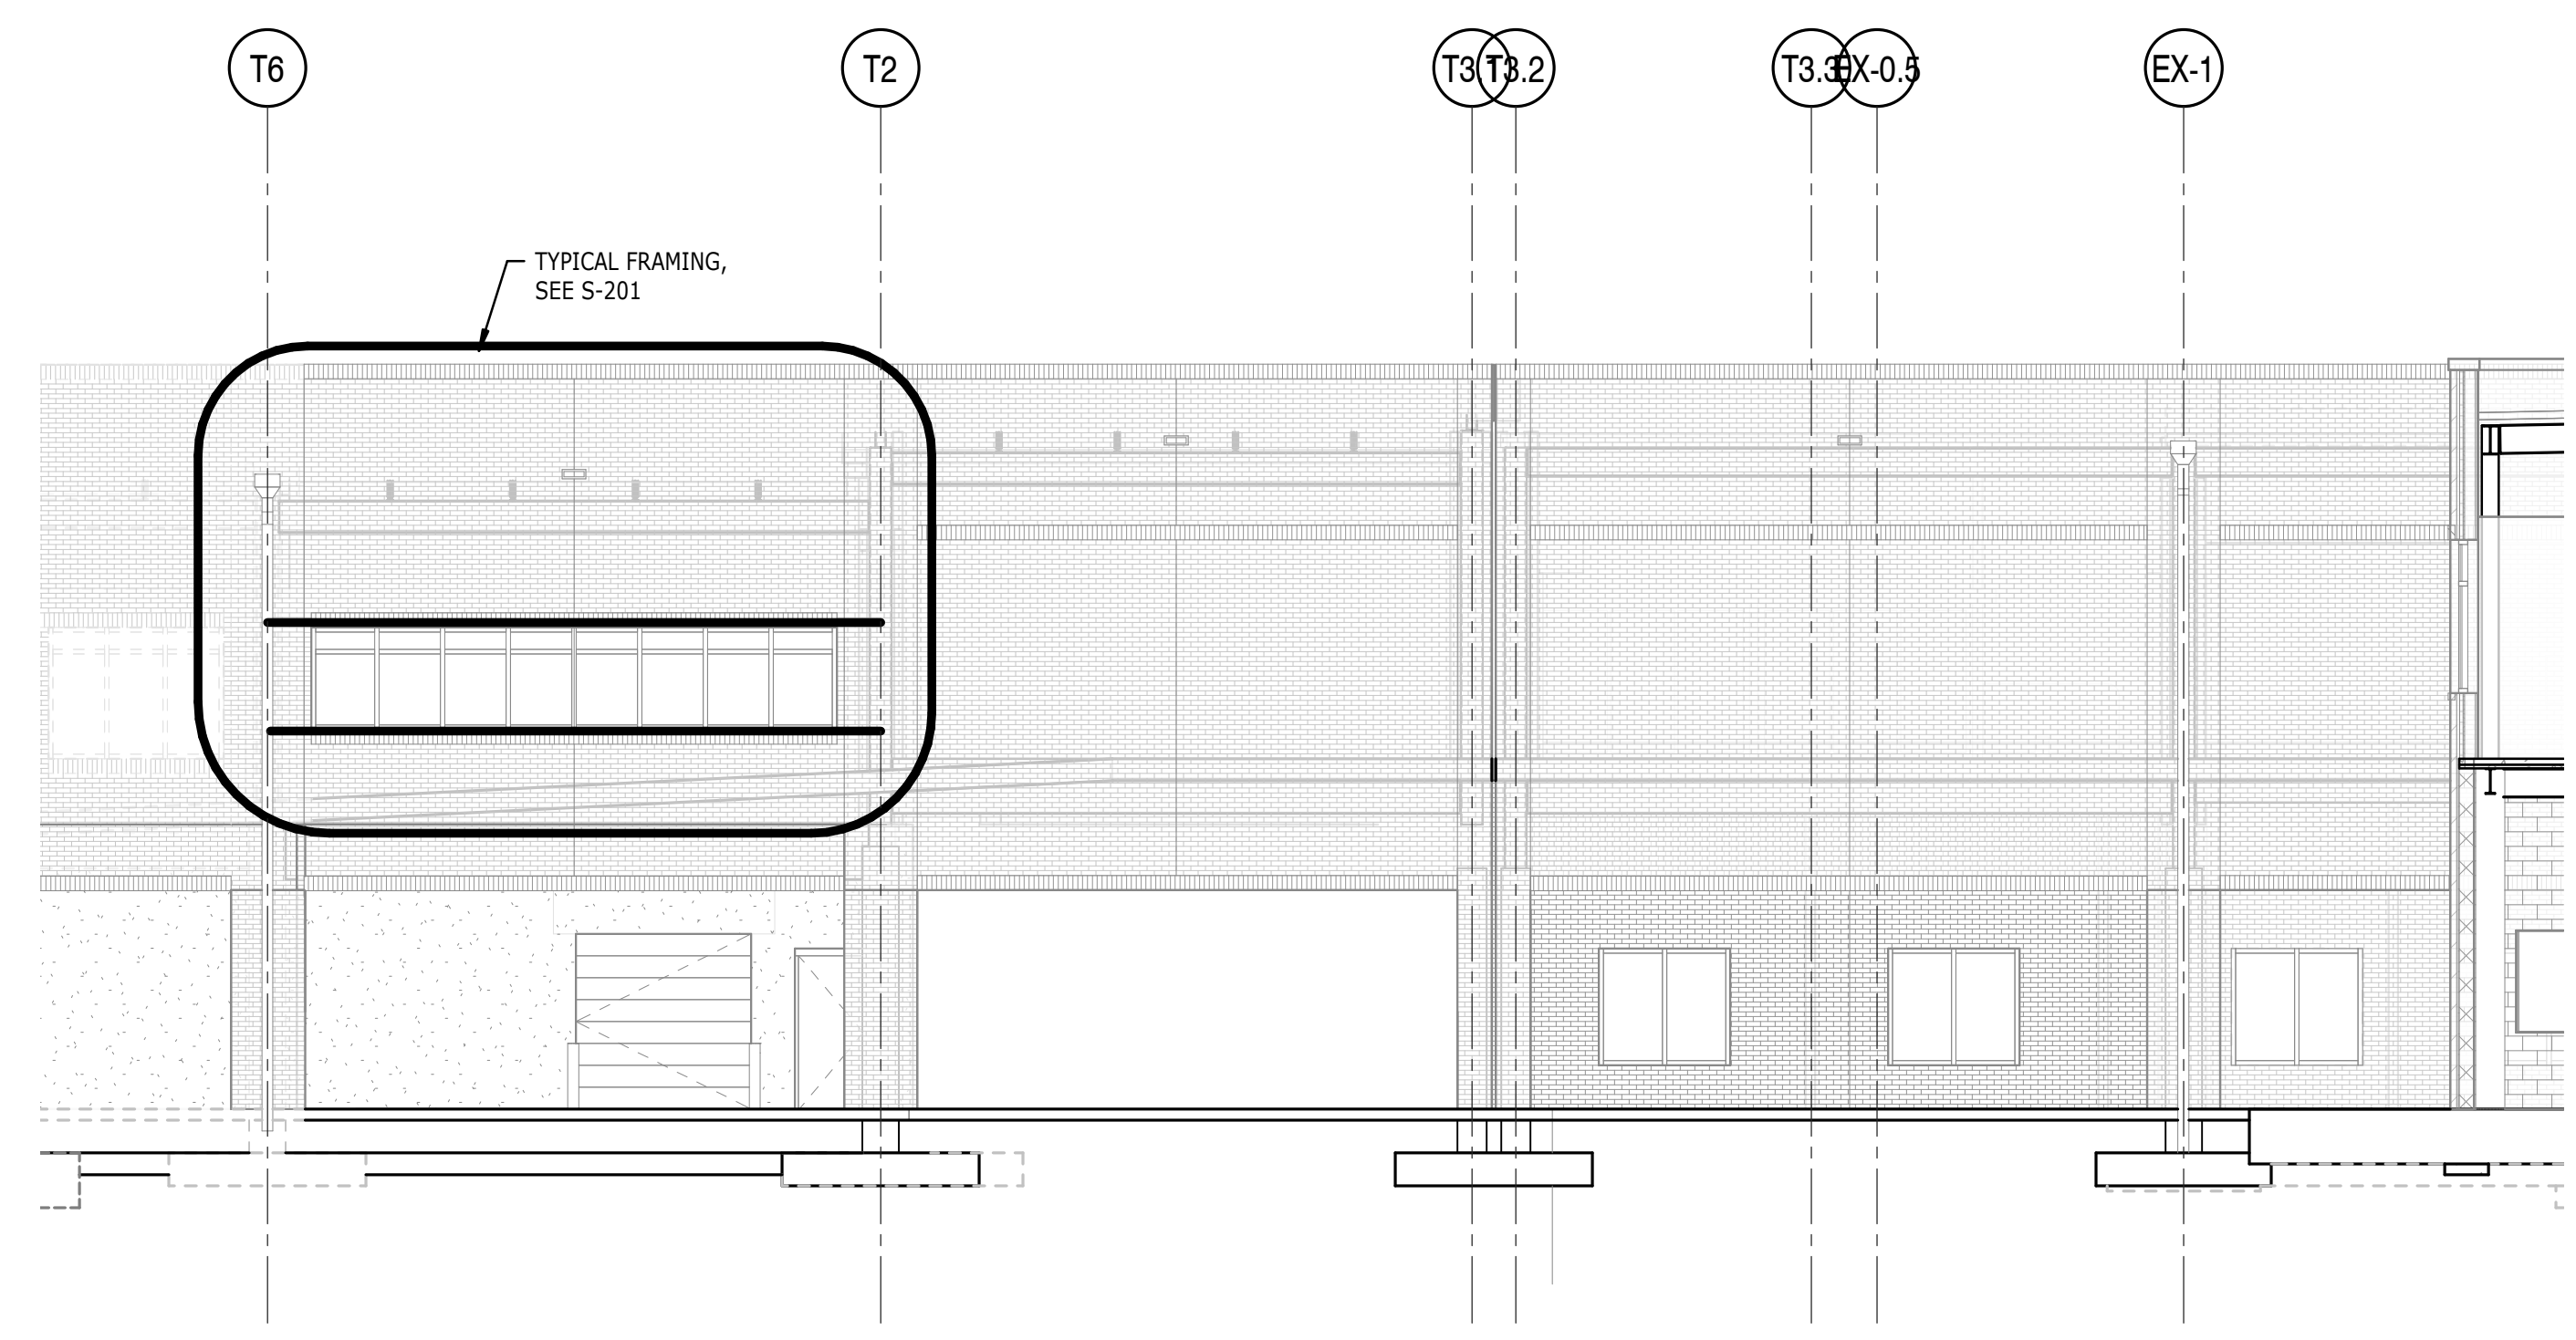

2 EAST ELEVATION SCHEDULE 2  
S-202 1/8" = 1'-0"

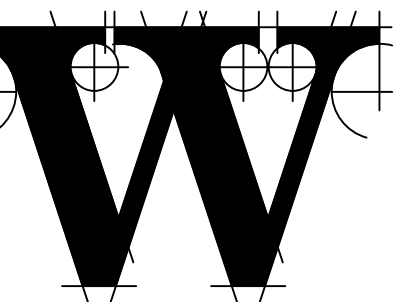

**THE WILSON GROUP**  
- ARCHITECTS -  
PO Box 5510 Charlotte, NC 28299  
704-331-9747 • www.twgarchitects.com

PROJECT MANAGER & CIVIL ENGINEER  
**TALBERT & BRIGHT**  
CONSULTING ARCHITECT  
LS3P


STRUCTURAL ENGINEER  
FIRM LICENSE #C-1051  
**STEWART**

FPI/PME ENGINEER  
**CHEATHAM & ASSOC.**  
BAGGAGE HANDLING CONSULTANTS  
**BNP**

AIRCRAFT SUPPORT SYSTEMS  
**DK CONSULTANTS**

SPECIALTY LIGHTING CONSULTANT  
**HARTRANFT**

SINGAGE & WAYFINDING  
**TAKEFORM**

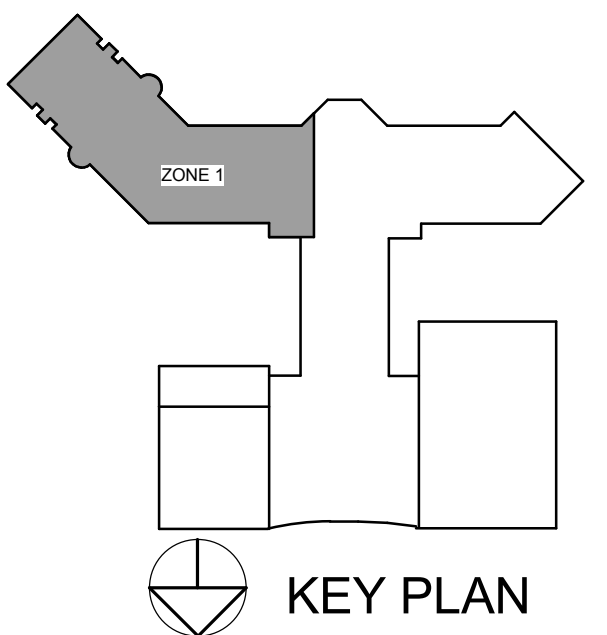

COPYRIGHT © 2019  
THE WILSON GROUP ARCHITECTS  
ALL RIGHTS RESERVED

PRINTED OR ELECTRONIC DRAWINGS AND DOCUMENTATION MAY NOT BE REPRODUCED IN ANY FORM WITHOUT WRITTEN PERMISSION FROM THE WILSON GROUP ARCHITECTS


REVISIONS

3	7/30/19	AD-03
---	---------	-------

DATE 06/28/2019  
PROJECT NUMBER 9202-000  
SHEET TITLE



**PARTIAL FOUNDATION PLAN SCHEDULE 2 ZONE 1**

SHEET NUMBER  
**S2-101**

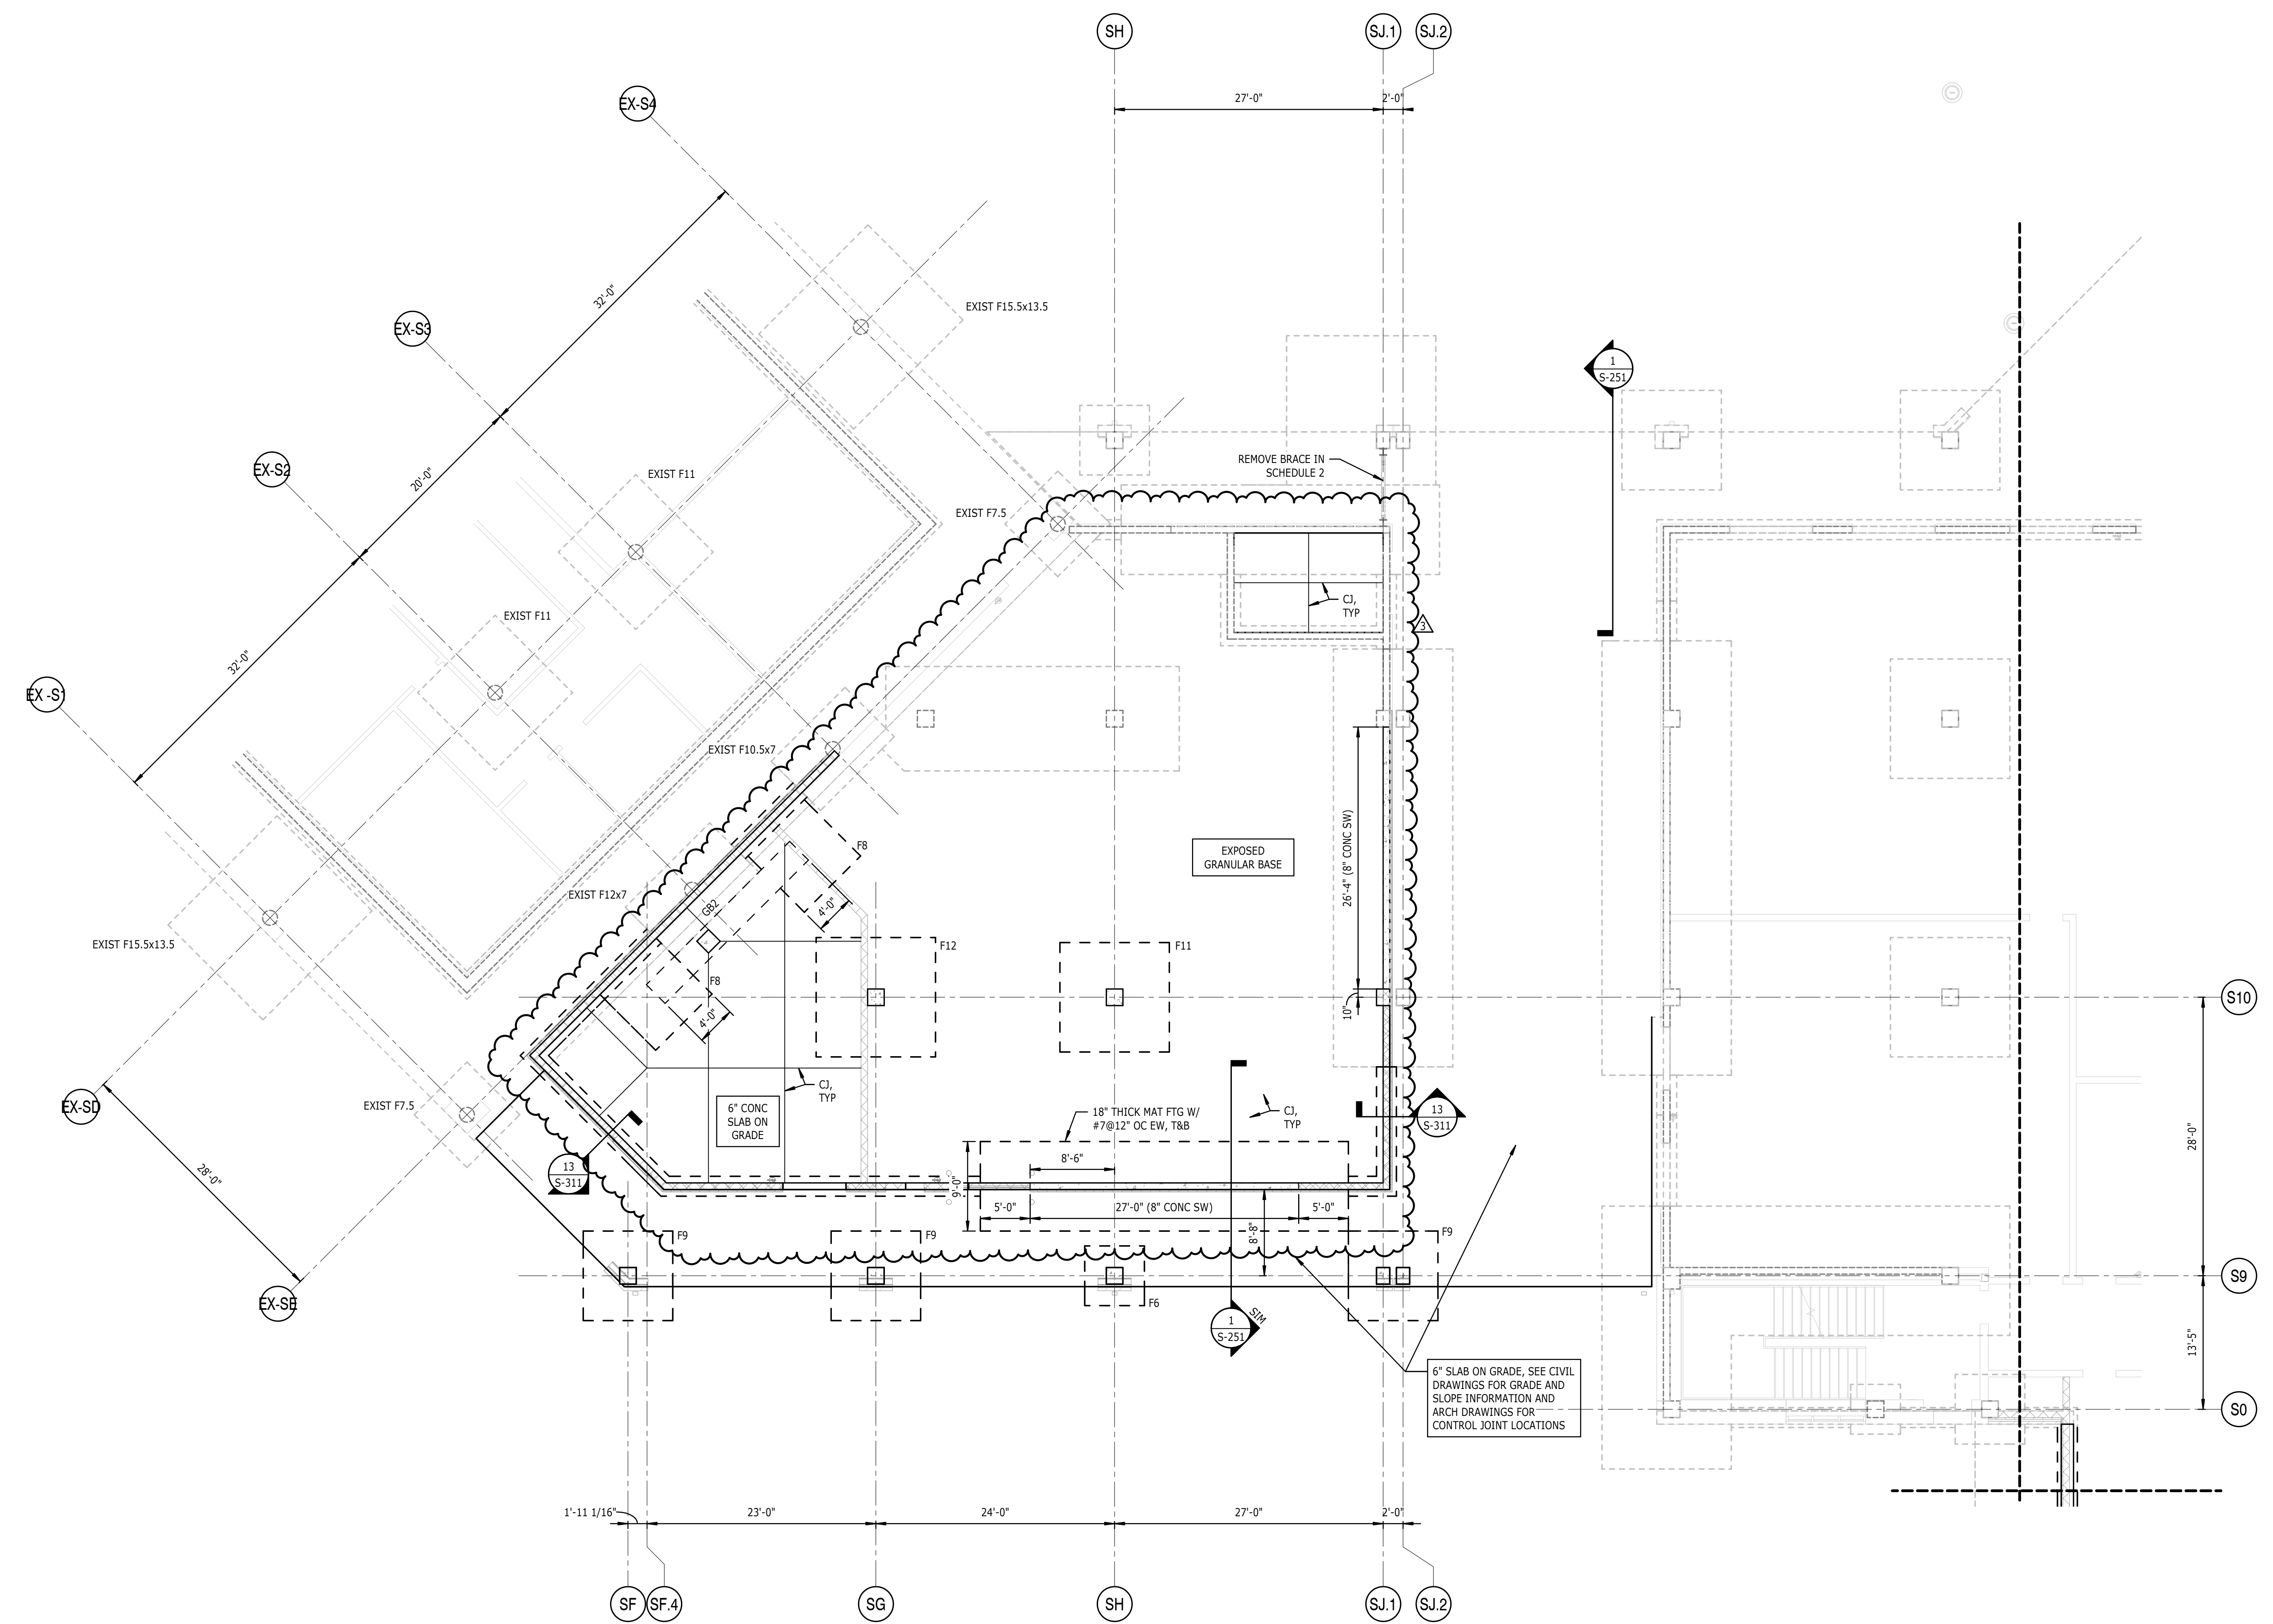


**1 FOUNDATION PLAN SCHEDULE 2 ZONE 1**

- 1/8" = 1'-0"
- NOTES:
1. FOR GENERAL NOTES AND ABBREVIATIONS, SEE S-001.
  2. SEE CIVIL DRAWINGS FOR FINISHED FLOOR ELEVATION, UNO, REFERENCE ELEVATION 0'-0".
  3. [No] INDICATES DEPRESSED OR RAISED SLAB ELEVATION, SEE PLAN.
  4. TOP OF FOOTING 2'-0" BELOW FINISHED FLOOR ELEVATION, UNO. <No> INDICATES TOP OF FOOTING ELEVATION, SEE PLAN.
  5. [No] INDICATES STEP IN WALL FOOTING, SEE 9/S-301.
  6. "F#" INDICATES FOOTING TYPE, SEE 7/S-301.
  7. FOR STEEL COLUMN SCHEDULE, SEE 1/S-501.
  8. FOR CONCRETE COLUMN SCHEDULE, SEE 1/S-323.
  9. "CONC SW" INDICATES CONCRETE SHEARWALL, SEE \_\_\_ FOR SCHEDULE.
  10. FOR TYPICAL SLAB CONSTRUCTION DETAILS, SEE 1/S-301.

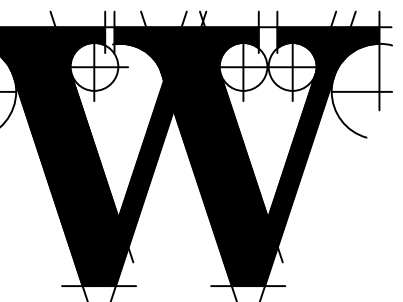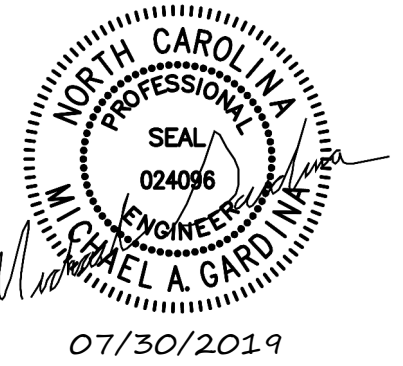


**REVISIONS**

1	7/12/19	AD-01
3	7/30/19	AD-03

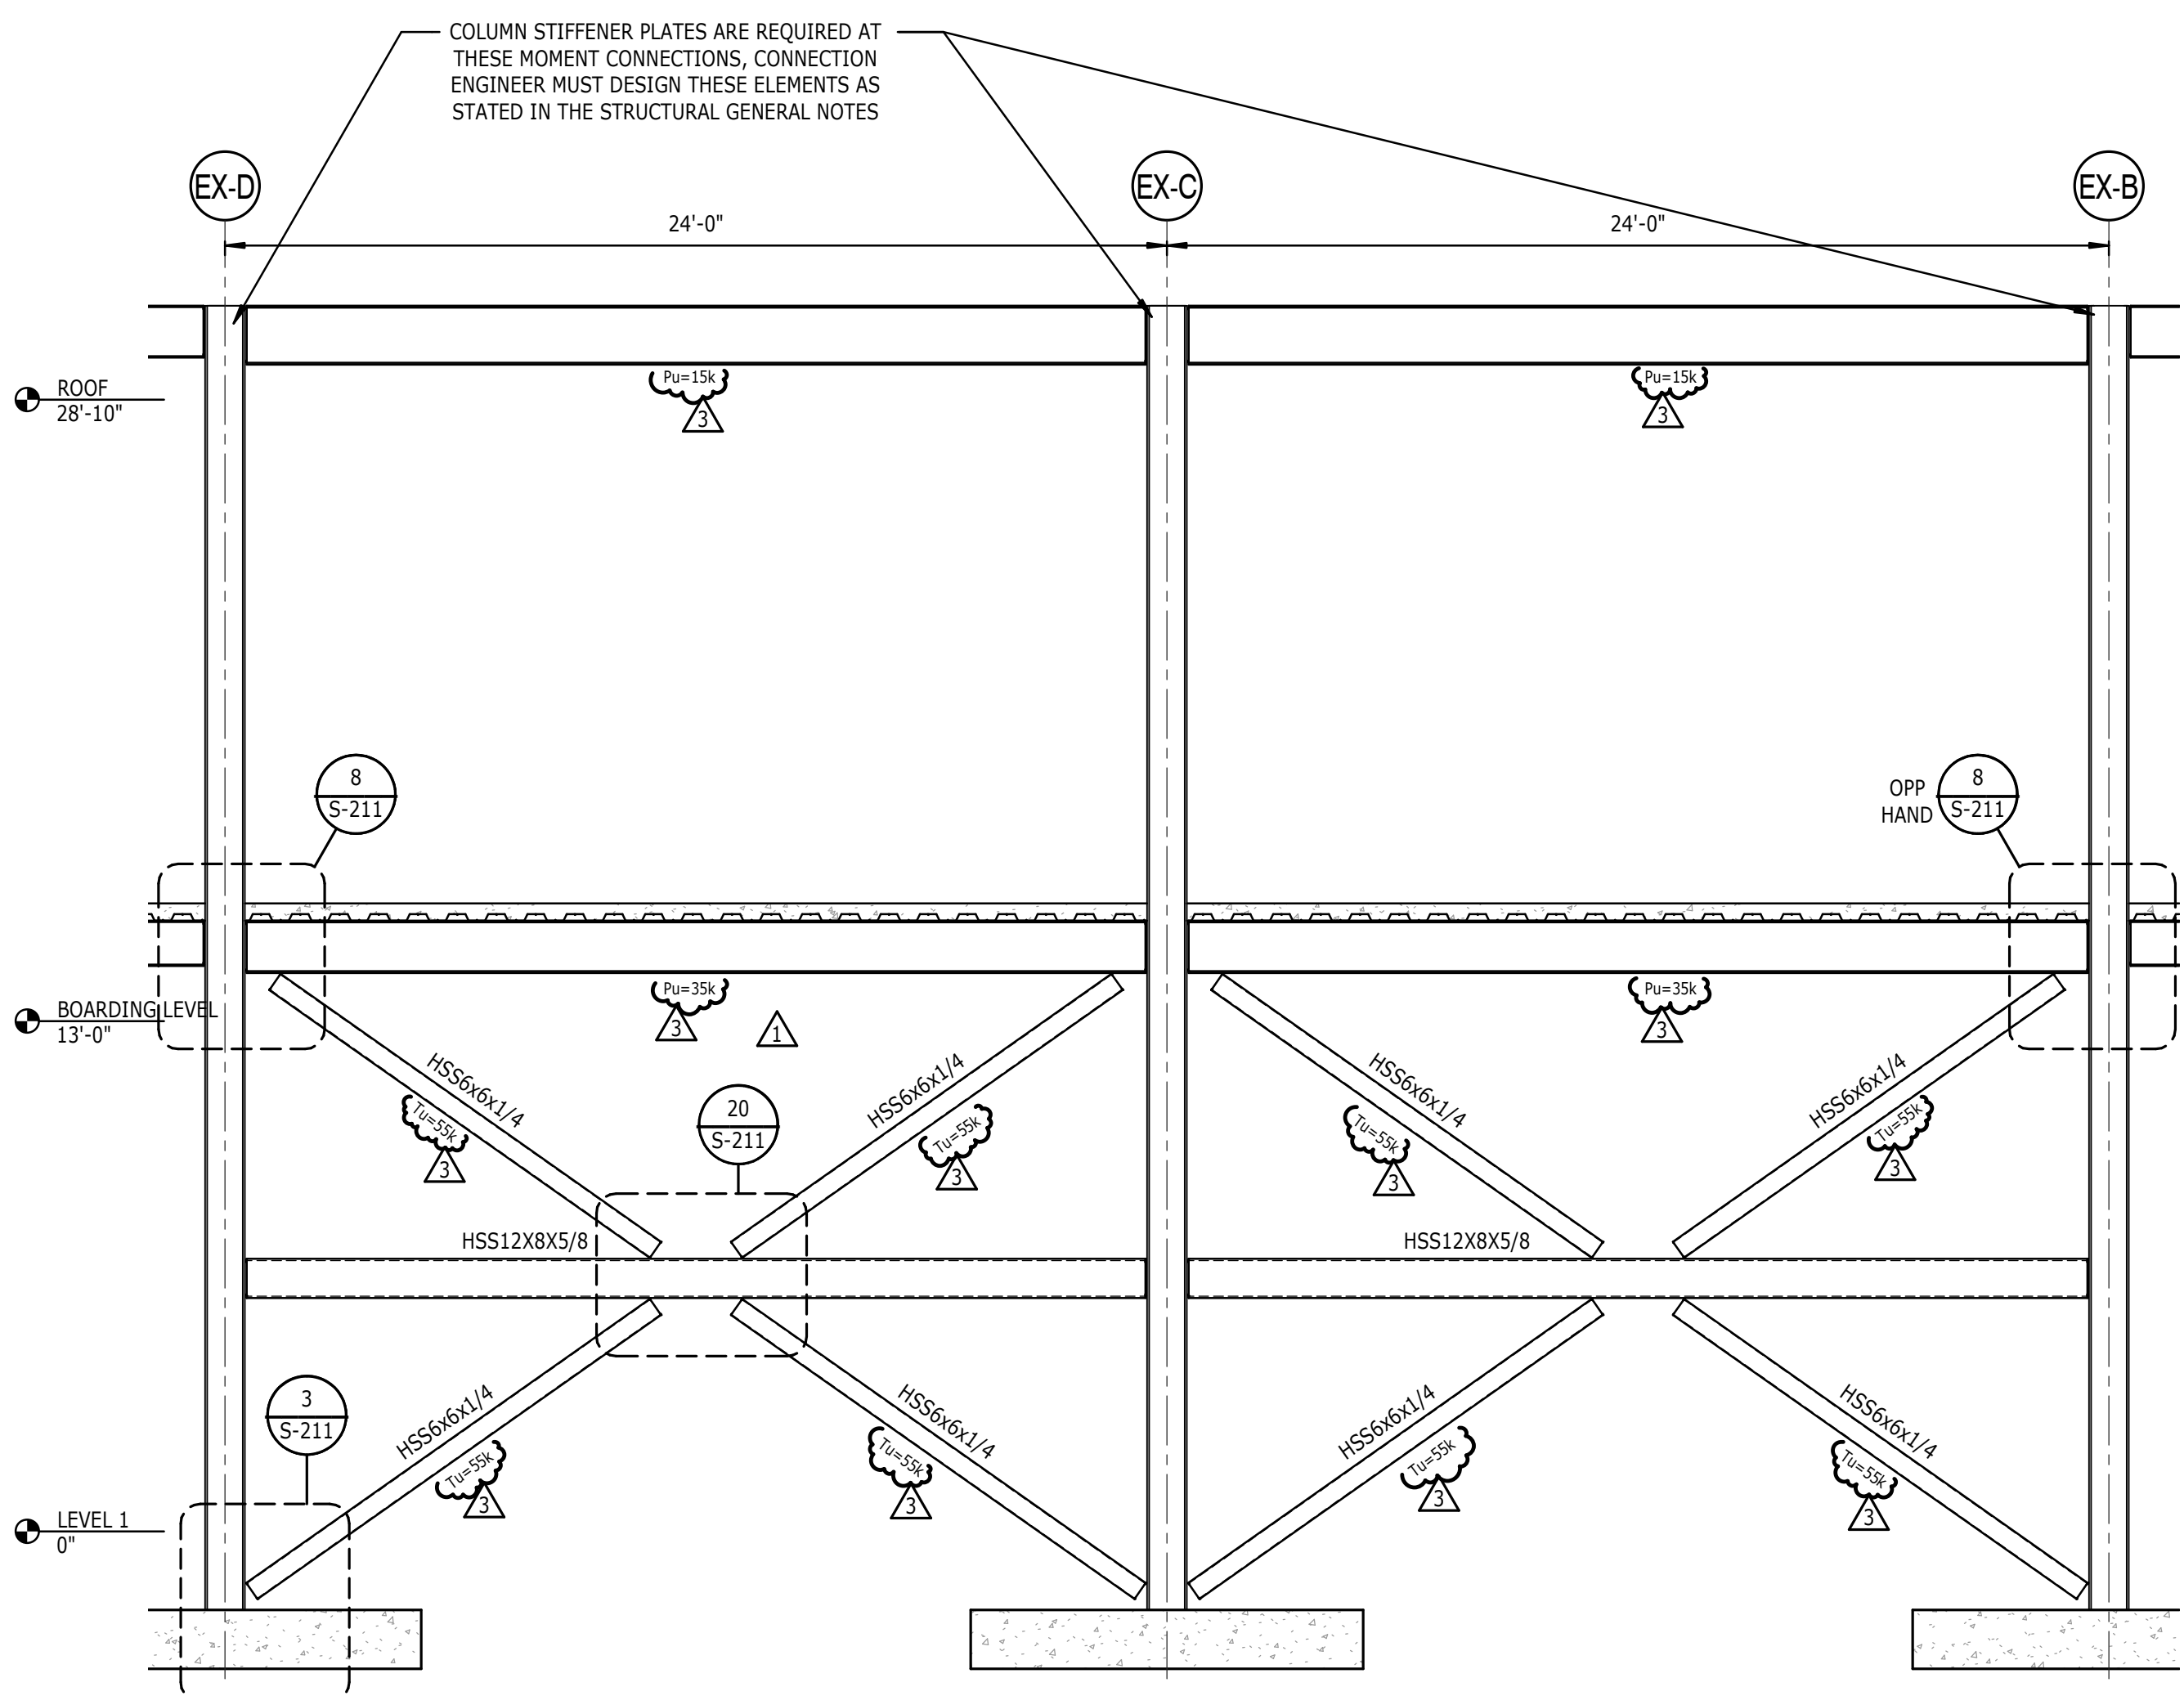


**13 VF#3 ALONG GL 0.8**

1/4" = 1'-0"  
NOTES:  
1. "Tu" = # INDICATES FACTORED TENSION FORCE IN DIAGONAL BRACE TO BE USED IN CONNECTION DESIGN.  
2. "Pu" = # INDICATES FACTORED AXIAL FORCE IN FRAME BEAM TO BE USED IN CONNECTION DESIGN.

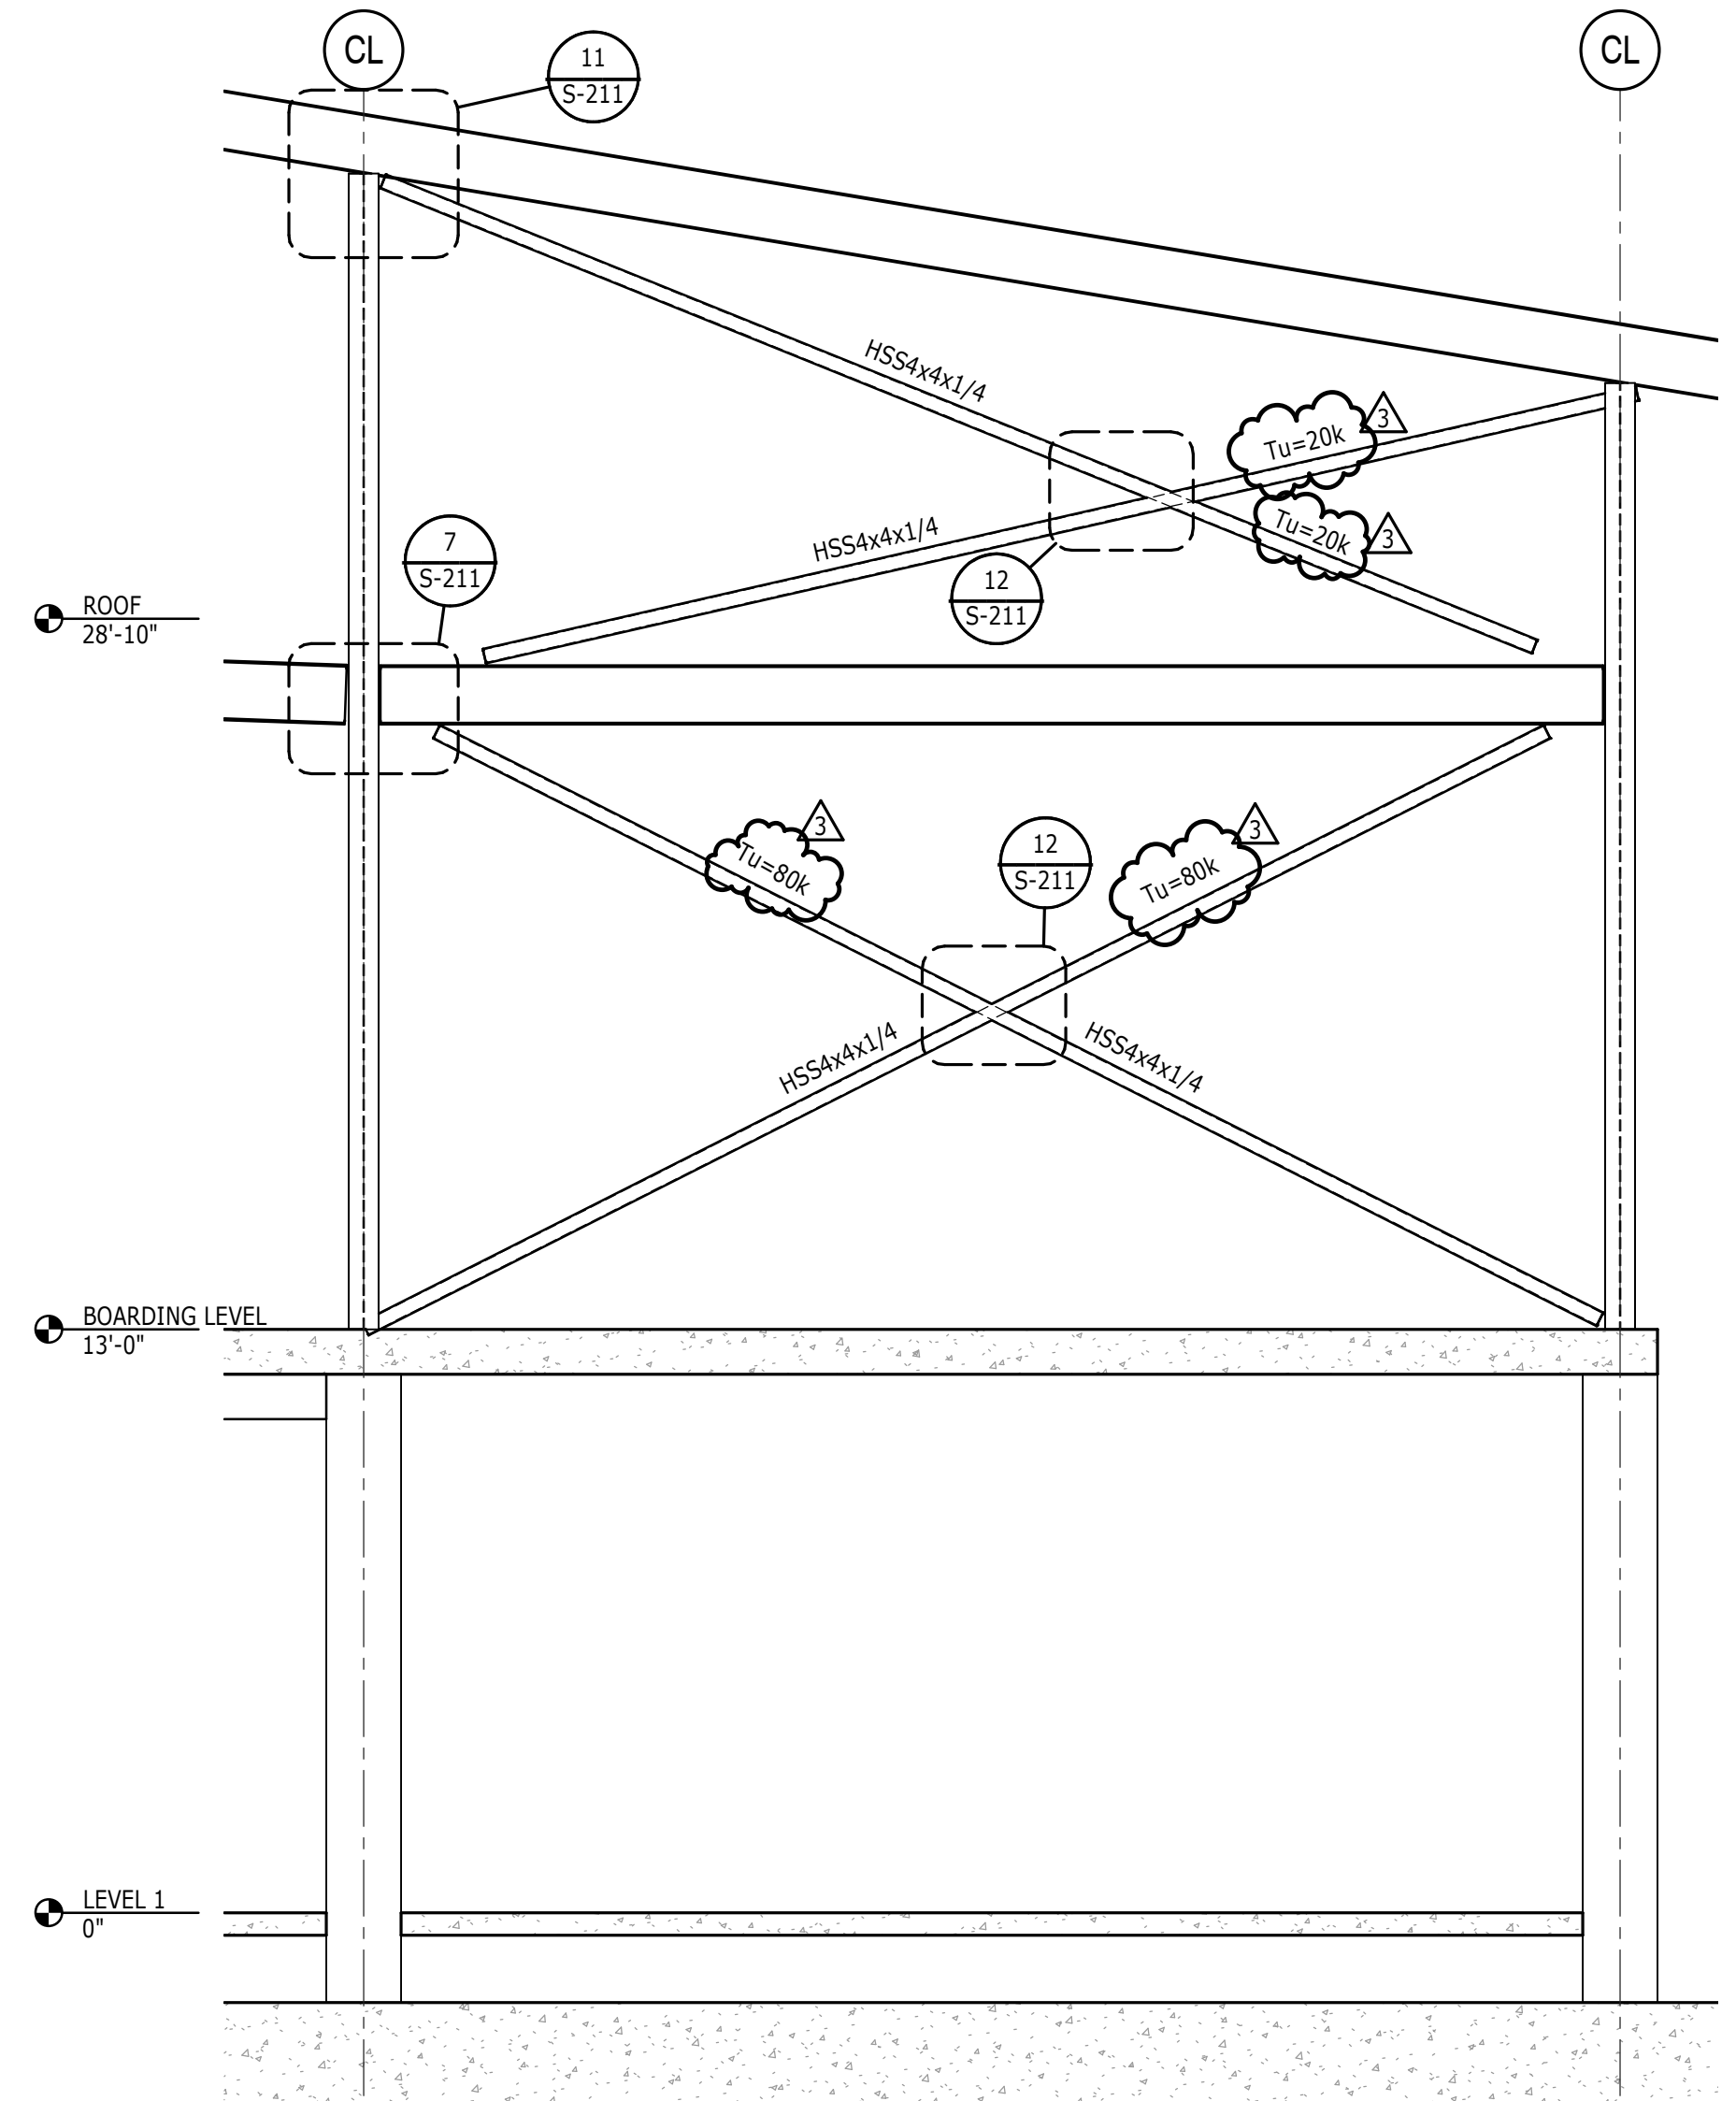


**5 VF#2 ALONG GL-S9**

1/4" = 1'-0"  
NOTES:  
1. "Tu" = # INDICATES FACTORED TENSION FORCE IN DIAGONAL BRACE TO BE USED IN CONNECTION DESIGN.  
2. "Pu" = # INDICATES FACTORED AXIAL FORCE IN FRAME BEAM TO BE USED IN CONNECTION DESIGN.

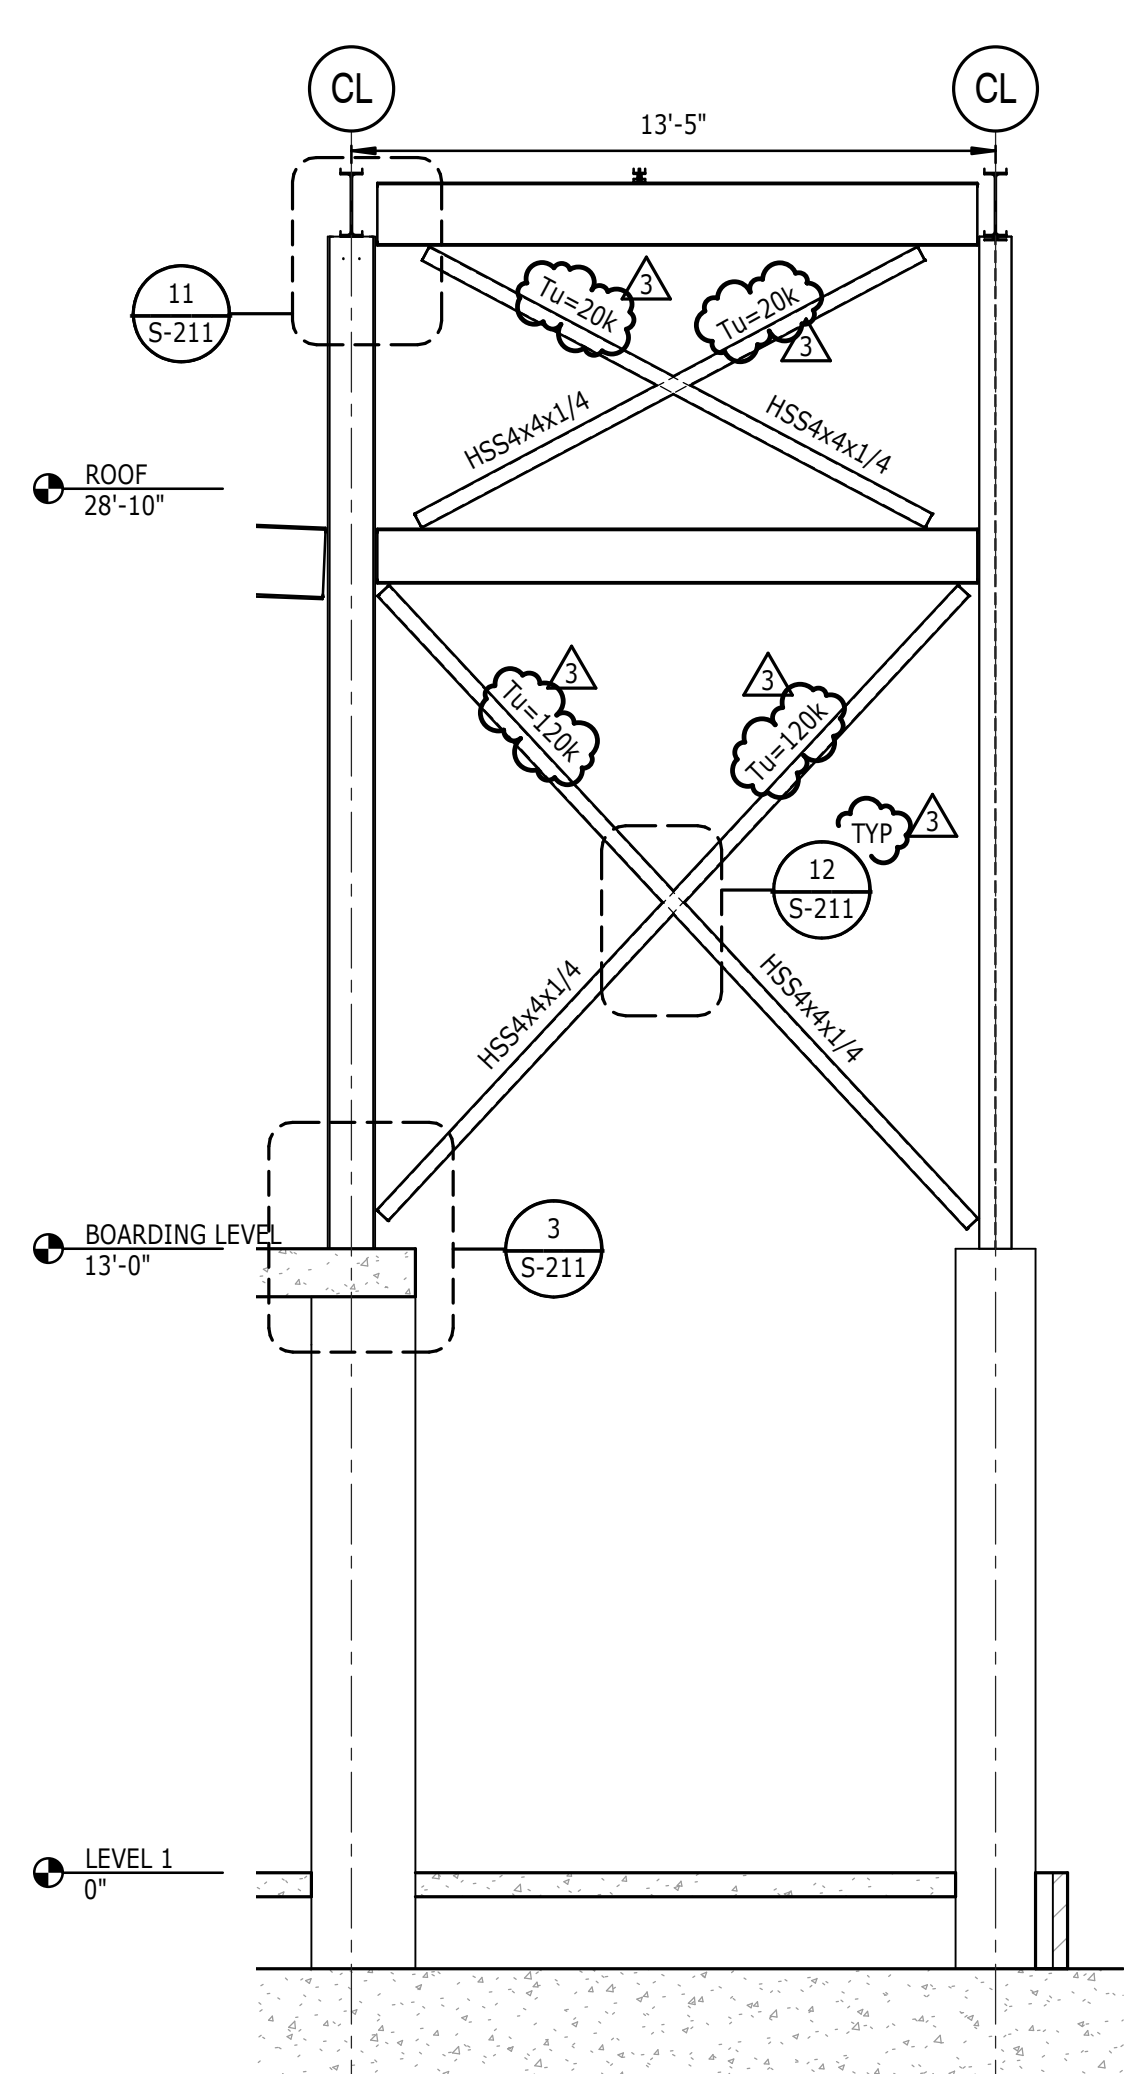


**1 VF#1 ALONG GL-SK & GL-SL**

1/4" = 1'-0"  
NOTES:  
1. "Tu" = # INDICATES FACTORED TENSION FORCE IN DIAGONAL BRACE TO BE USED IN CONNECTION DESIGN.  
2. "Pu" = # INDICATES FACTORED AXIAL FORCE IN FRAME BEAM TO BE USED IN CONNECTION DESIGN.

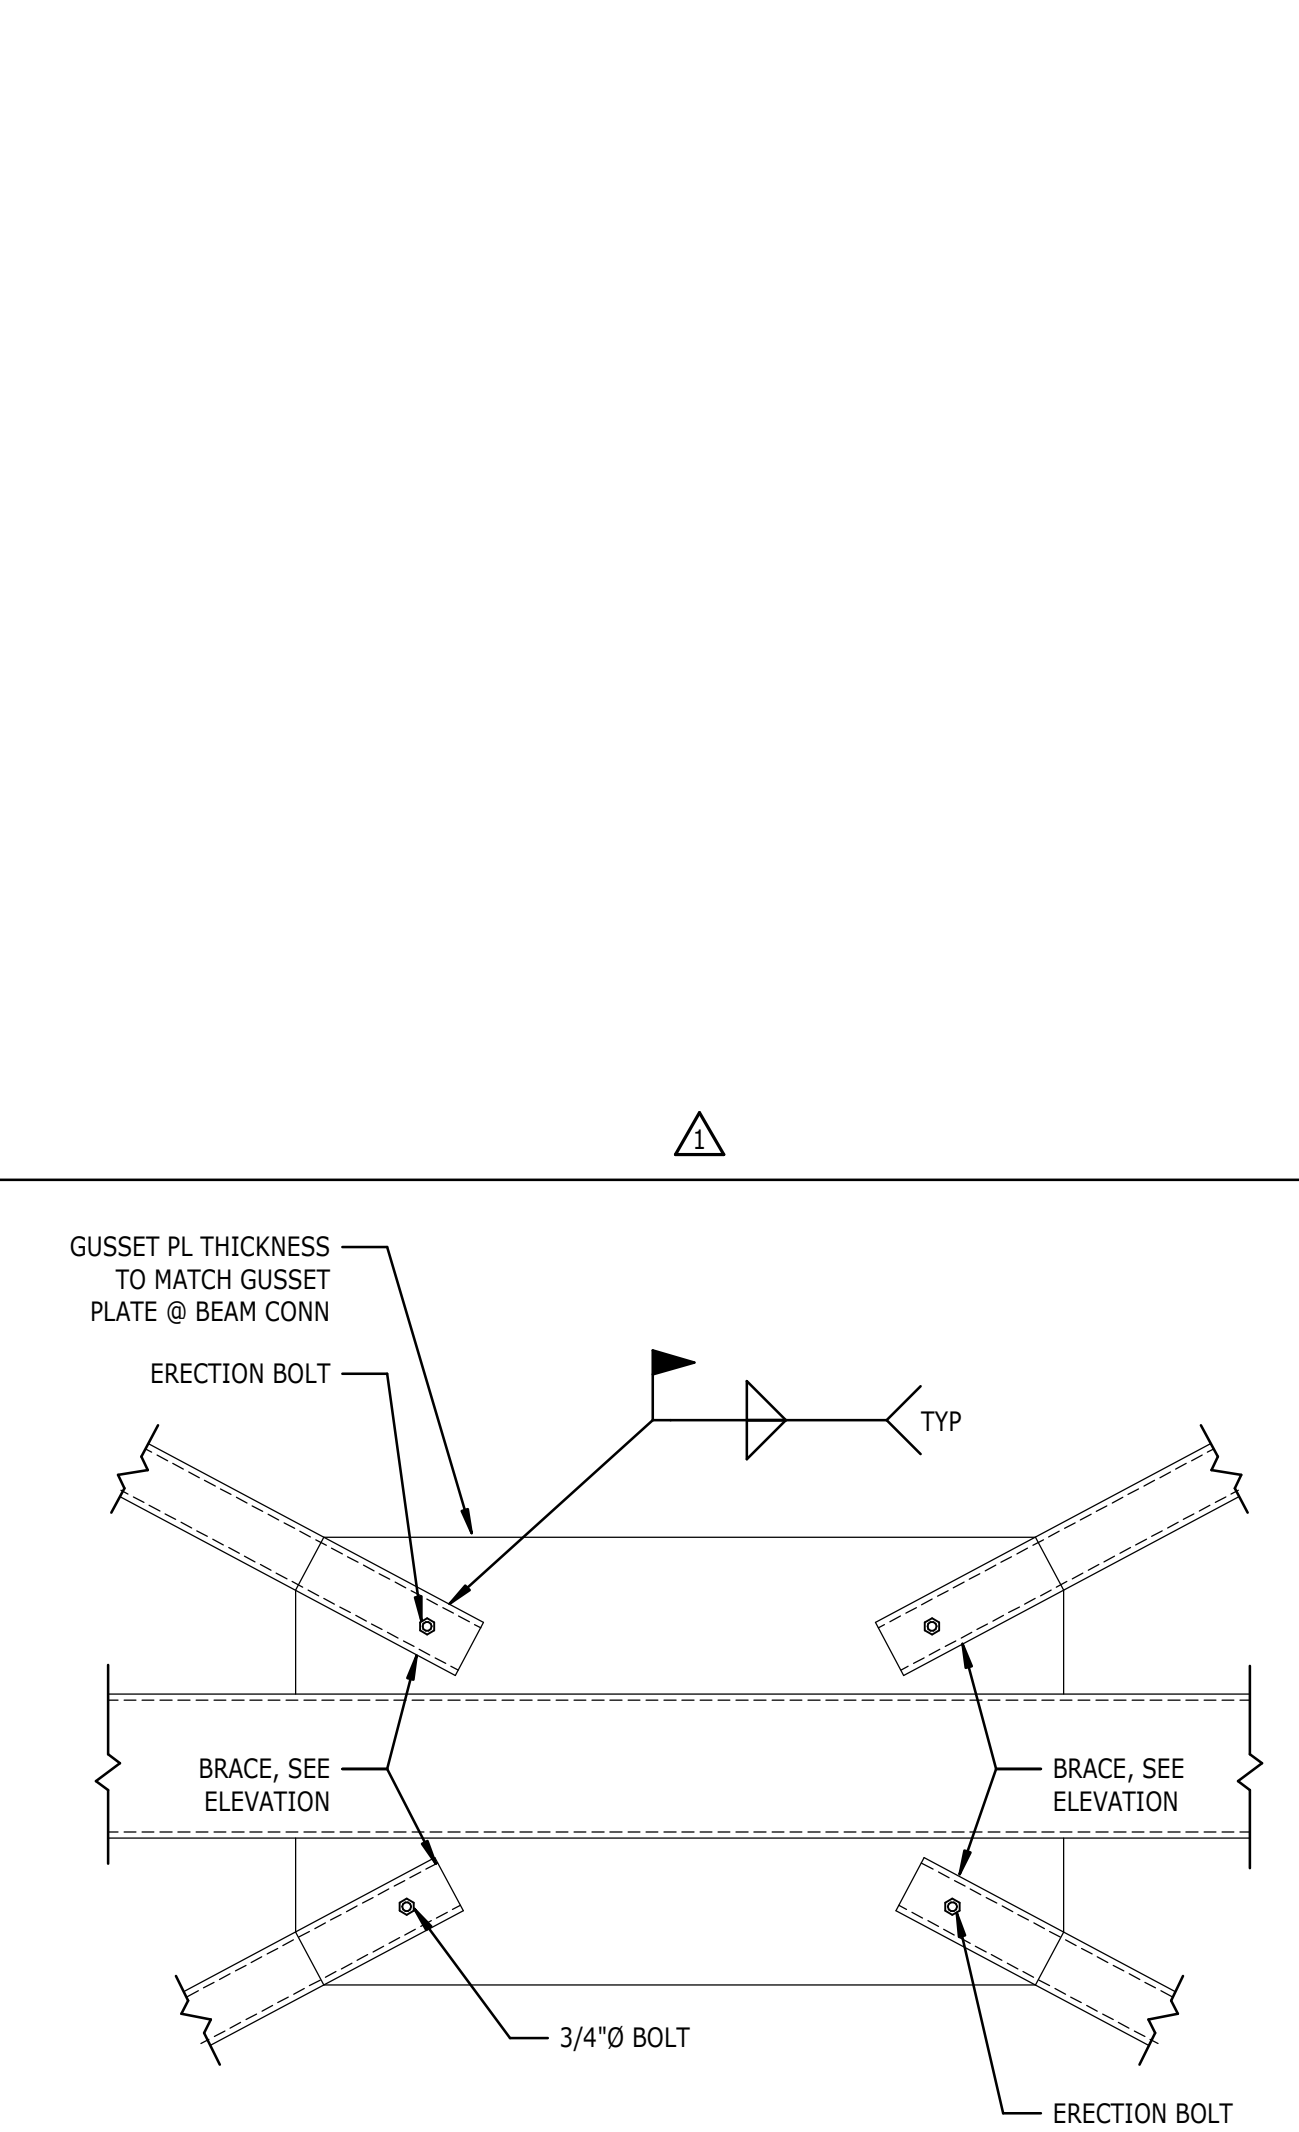


NOTES:  
FABRICATOR SHALL DESIGN ALL BEAM TO COLUMN CONNECTIONS, GUSSET PLATES, AND WELDS WITHIN VERTICAL FRAME TO SUPPORT THE HORIZONTAL AND VERTICAL COMPONENTS OF THE BRACE FORCE PLUS THE BEAM REACTION SHOWN ON THE ELEVATION. ALLOWABLE STRESS INCREASES OR LOAD REDUCTIONS ARE NOT PERMITTED.

**20 SECTION**  
S-211  
TYPICAL BRACE INTERSECTION, DOUBLE ANGLE  
NTS

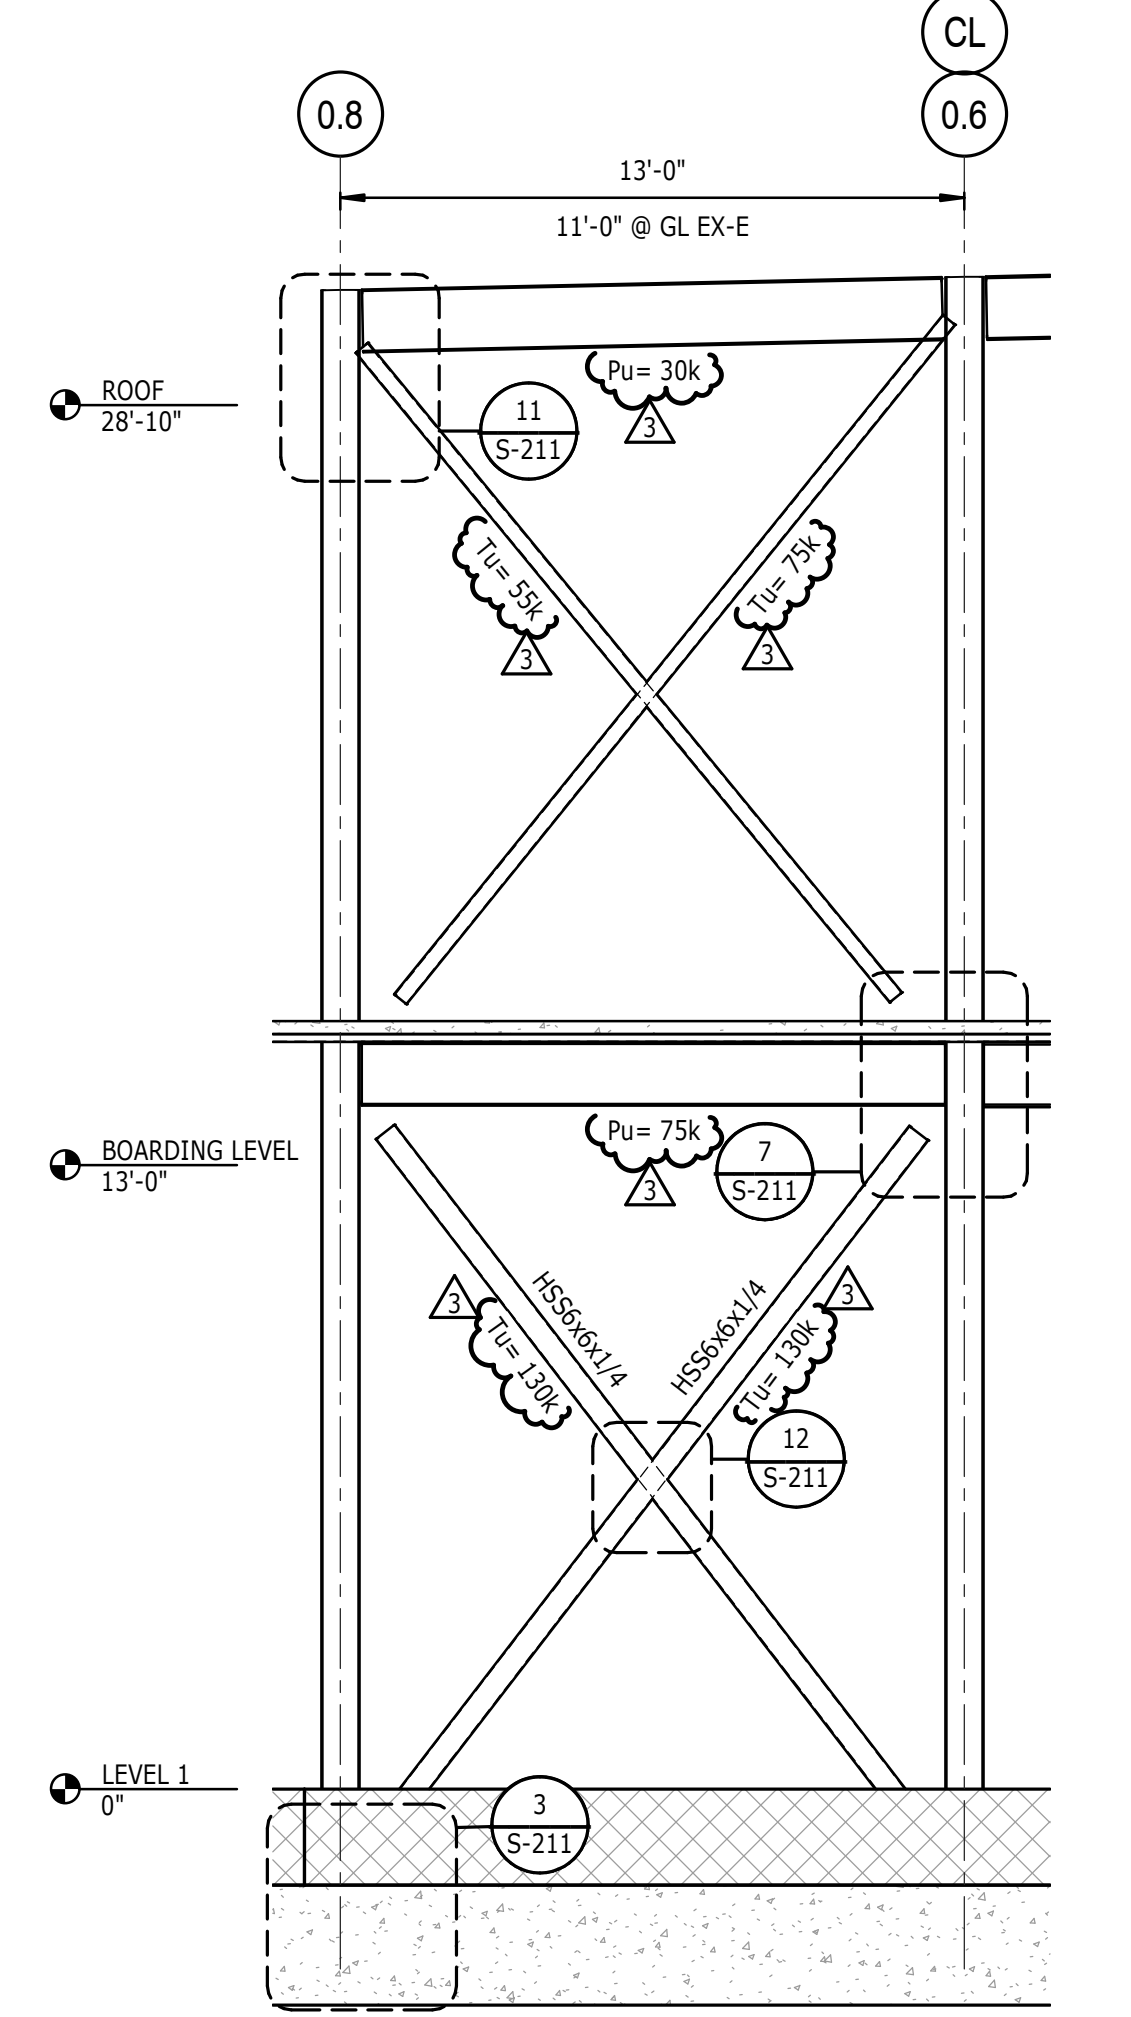


**15 VF#4 ALONG GL EX-A AND EX-E**


1/4" = 1'-0"  
NOTES:  
1. "Tu" = # INDICATES FACTORED TENSION FORCE IN DIAGONAL BRACE TO BE USED IN CONNECTION DESIGN.  
2. "Pu" = # INDICATES FACTORED AXIAL FORCE IN FRAME BEAM TO BE USED IN CONNECTION DESIGN.

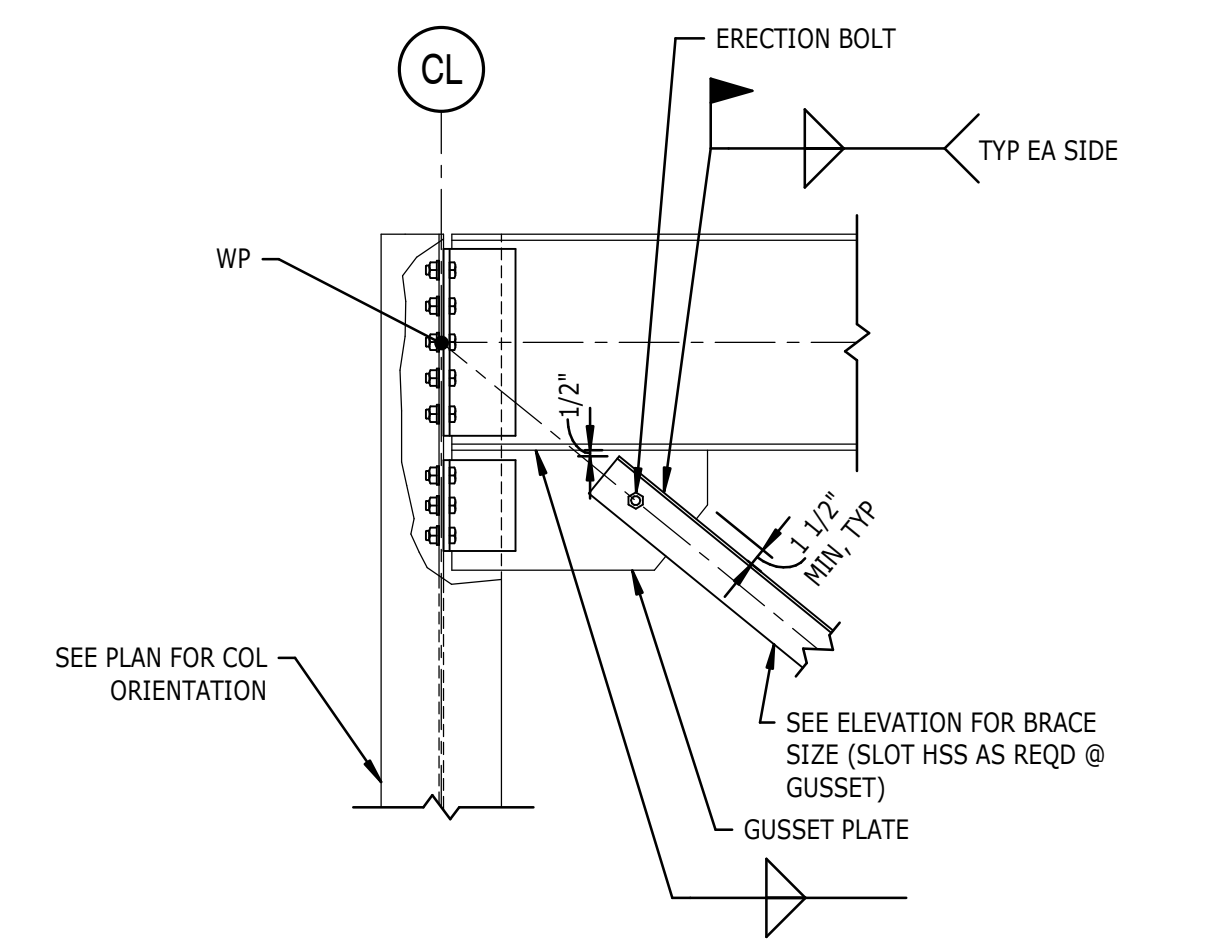


**11 SECTION**  
S-211  
TYPICAL BRACE CONNECTION AT BEAM  
NTS  
NOTES:  
1. FABRICATOR SHALL DESIGN ALL BEAM TO COLUMN CONNECTIONS, GUSSET PLATES, AND WELDS WITHIN VERTICAL FRAME TO SUPPORT THE HORIZONTAL AND VERTICAL COMPONENTS OF THE BRACE FORCE PLUS THE BEAM REACTION SHOWN ON THE ELEVATION. ALLOWABLE STRESS INCREASES OR LOAD REDUCTIONS ARE NOT PERMITTED.

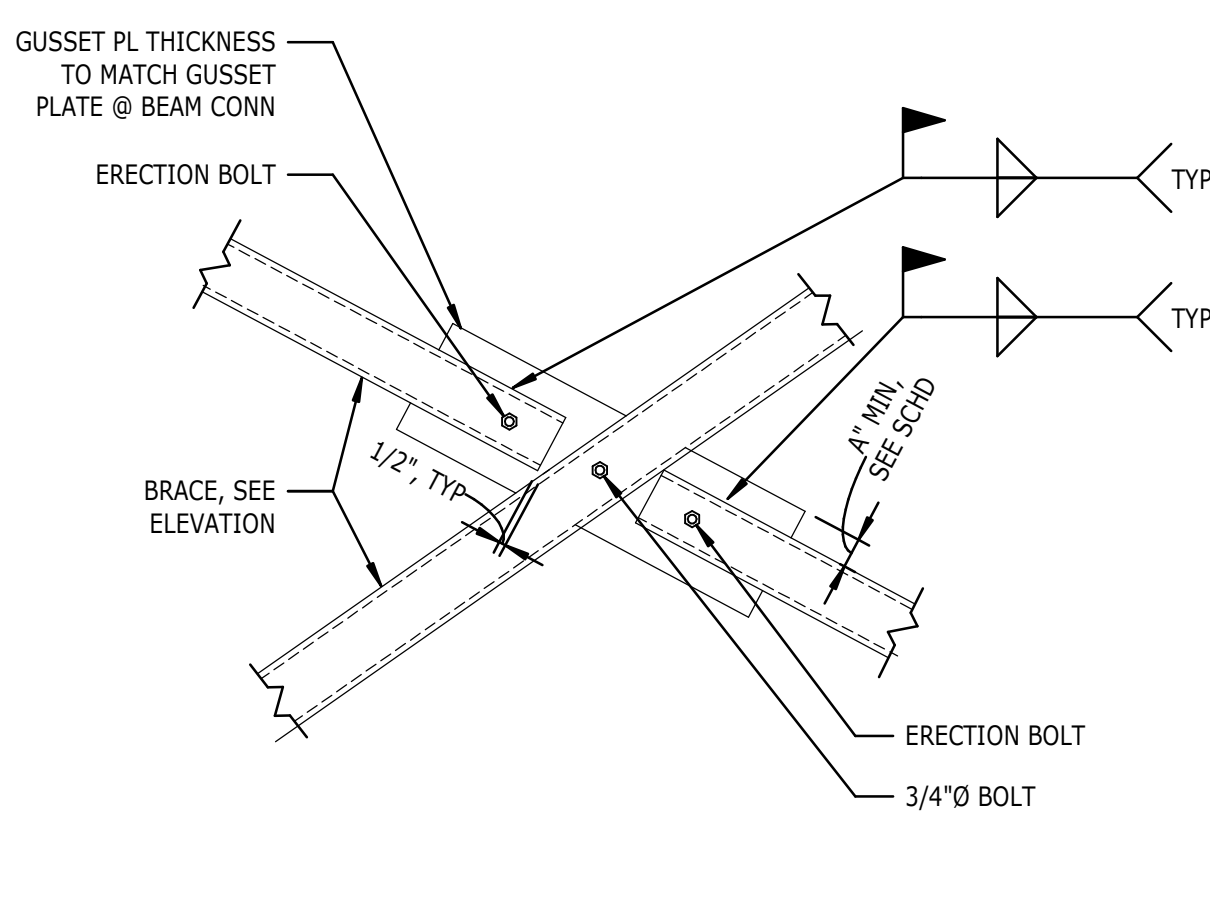


**12 SECTION**  
S-211  
TYPICAL BRACE INTERSECTION, DOUBLE ANGLE  
NTS  
NOTES:  
FABRICATOR SHALL DESIGN ALL BEAM TO COLUMN CONNECTIONS, GUSSET PLATES, AND WELDS WITHIN VERTICAL FRAME TO SUPPORT THE HORIZONTAL AND VERTICAL COMPONENTS OF THE BRACE FORCE PLUS THE BEAM REACTION SHOWN ON THE ELEVATION. ALLOWABLE STRESS INCREASES OR LOAD REDUCTIONS ARE NOT PERMITTED.

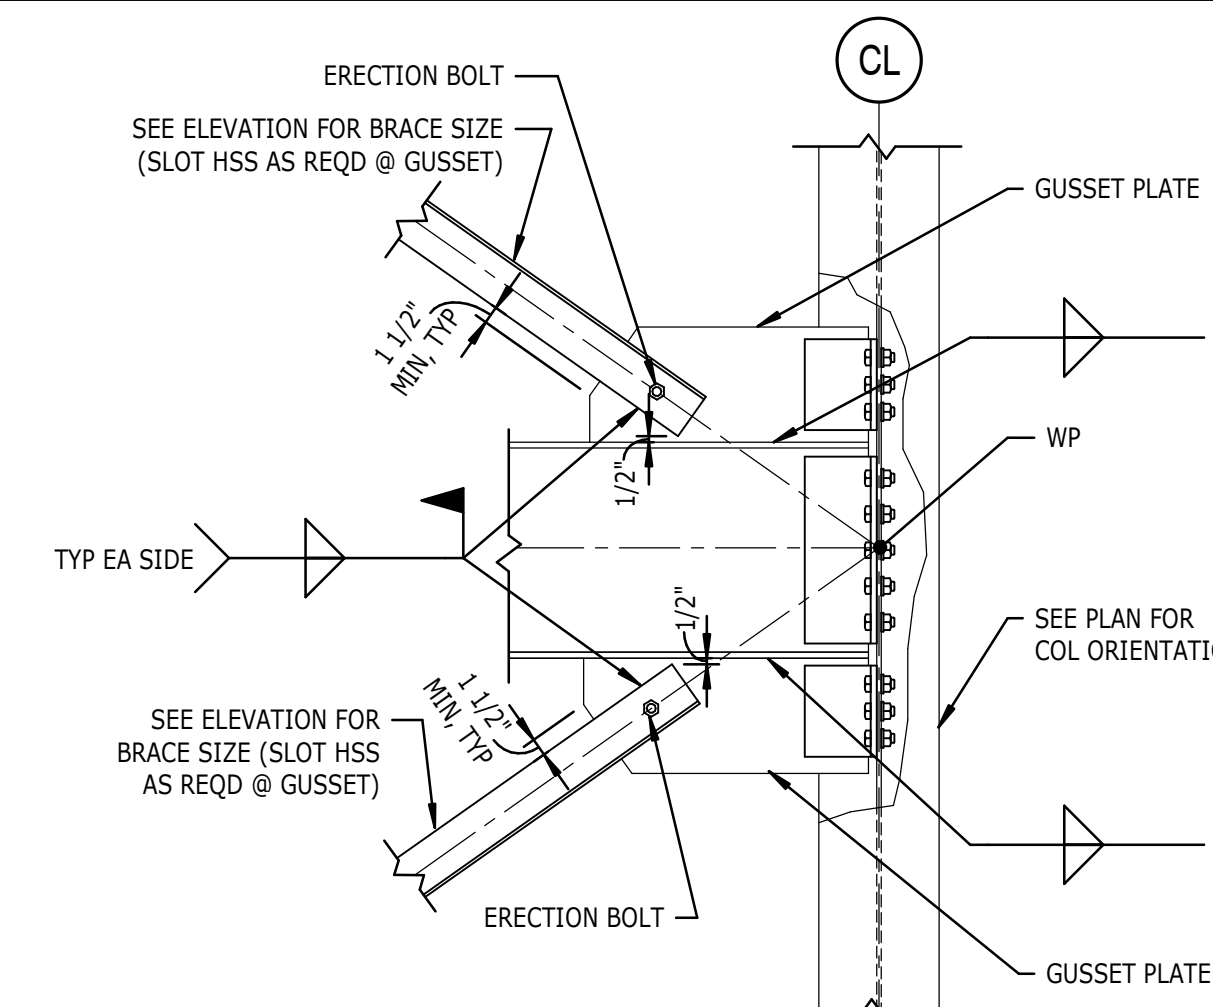





**7 SECTION**  
S-211  
TYPICAL BRACE CONNECTION AT BEAM  
NTS  
NOTES:  
1. FABRICATOR SHALL DESIGN ALL BEAM TO COLUMN CONNECTIONS, GUSSET PLATES, AND WELDS WITHIN VERTICAL FRAME TO SUPPORT THE HORIZONTAL AND VERTICAL COMPONENTS OF THE BRACE FORCE PLUS THE BEAM REACTION SHOWN ON THE ELEVATION. ALLOWABLE STRESS INCREASES OR LOAD REDUCTIONS ARE NOT PERMITTED.

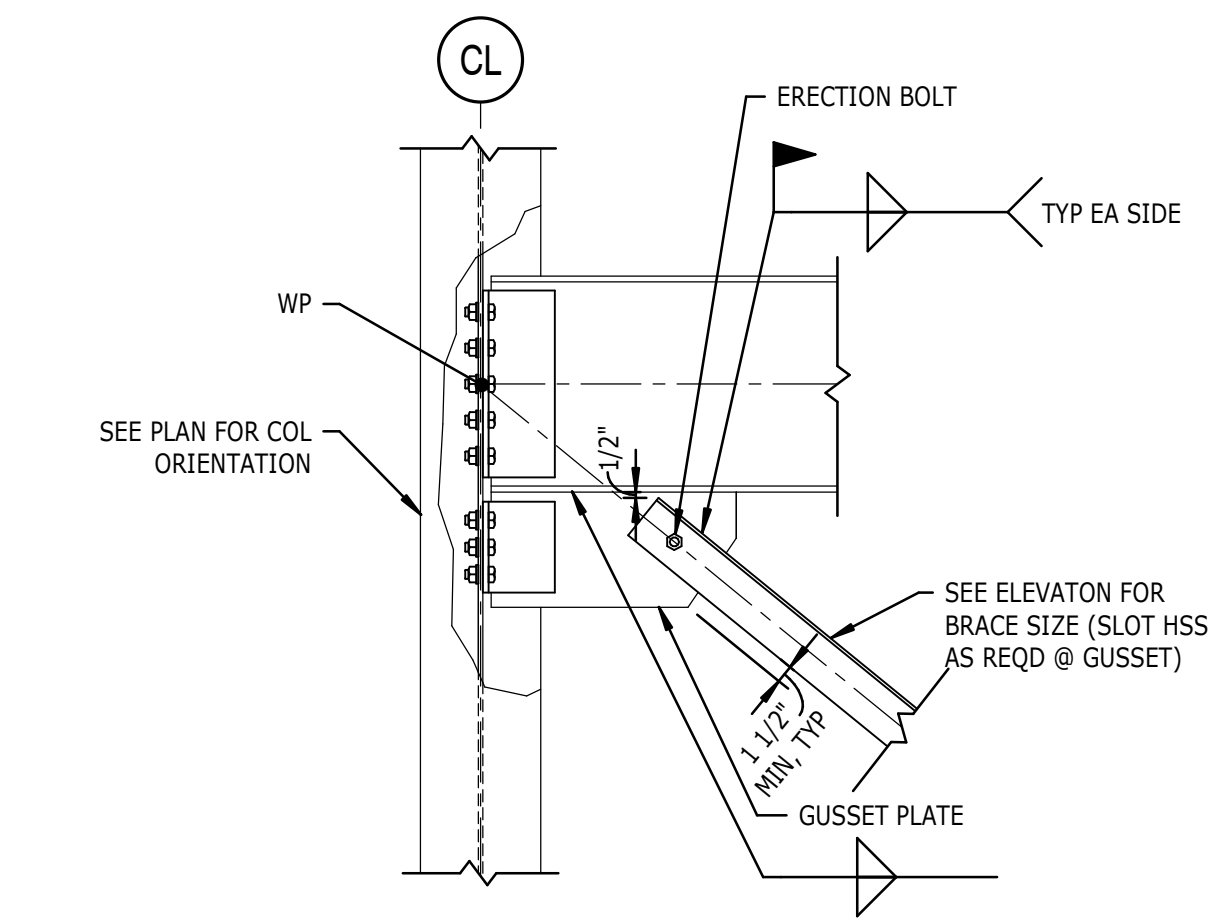

**8 SECTION**  
S-211  
TYPICAL BRACE CONNECTION AT BEAM  
NTS  
NOTES:  
1. FABRICATOR SHALL DESIGN ALL BEAM TO COLUMN CONNECTIONS, GUSSET PLATES, AND WELDS WITHIN VERTICAL FRAME TO SUPPORT THE HORIZONTAL AND VERTICAL COMPONENTS OF THE BRACE FORCE PLUS THE BEAM REACTION SHOWN ON THE ELEVATION. ALLOWABLE STRESS INCREASES OR LOAD REDUCTIONS ARE NOT PERMITTED.

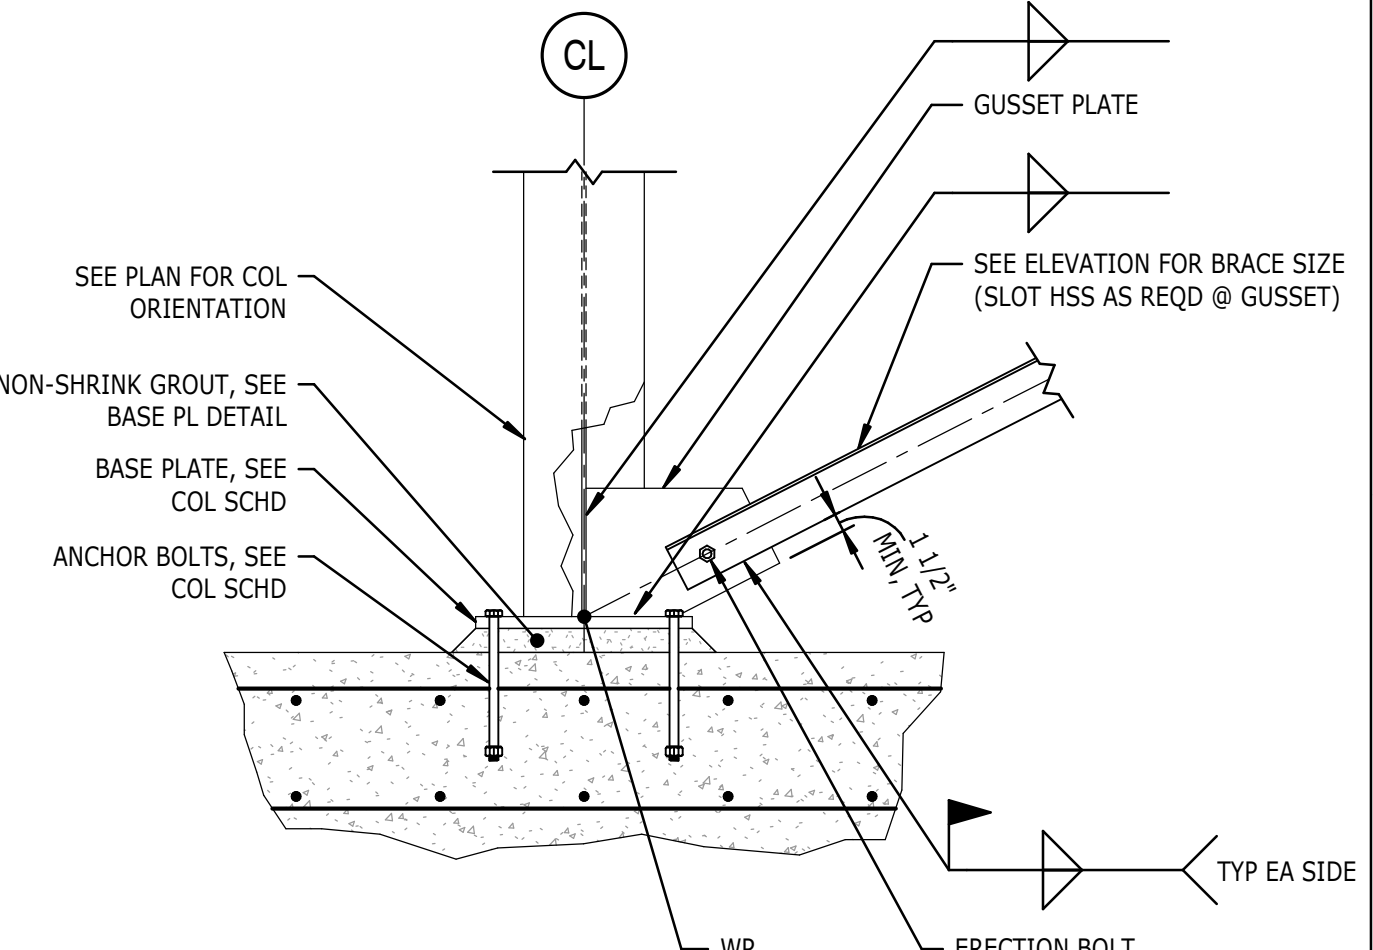

**3 SECTION**  
S-211  
TYPICAL BRACE CONNECTION AT SLAB  
NTS  
NOTES:  
1. FABRICATOR SHALL DESIGN ALL BEAM TO COLUMN CONNECTIONS, GUSSET PLATES, AND WELDS WITHIN VERTICAL FRAME TO SUPPORT THE HORIZONTAL AND VERTICAL COMPONENTS OF THE BRACE FORCE PLUS THE BEAM REACTION SHOWN ON THE ELEVATION. ALLOWABLE STRESS INCREASES OR LOAD REDUCTIONS ARE NOT PERMITTED.

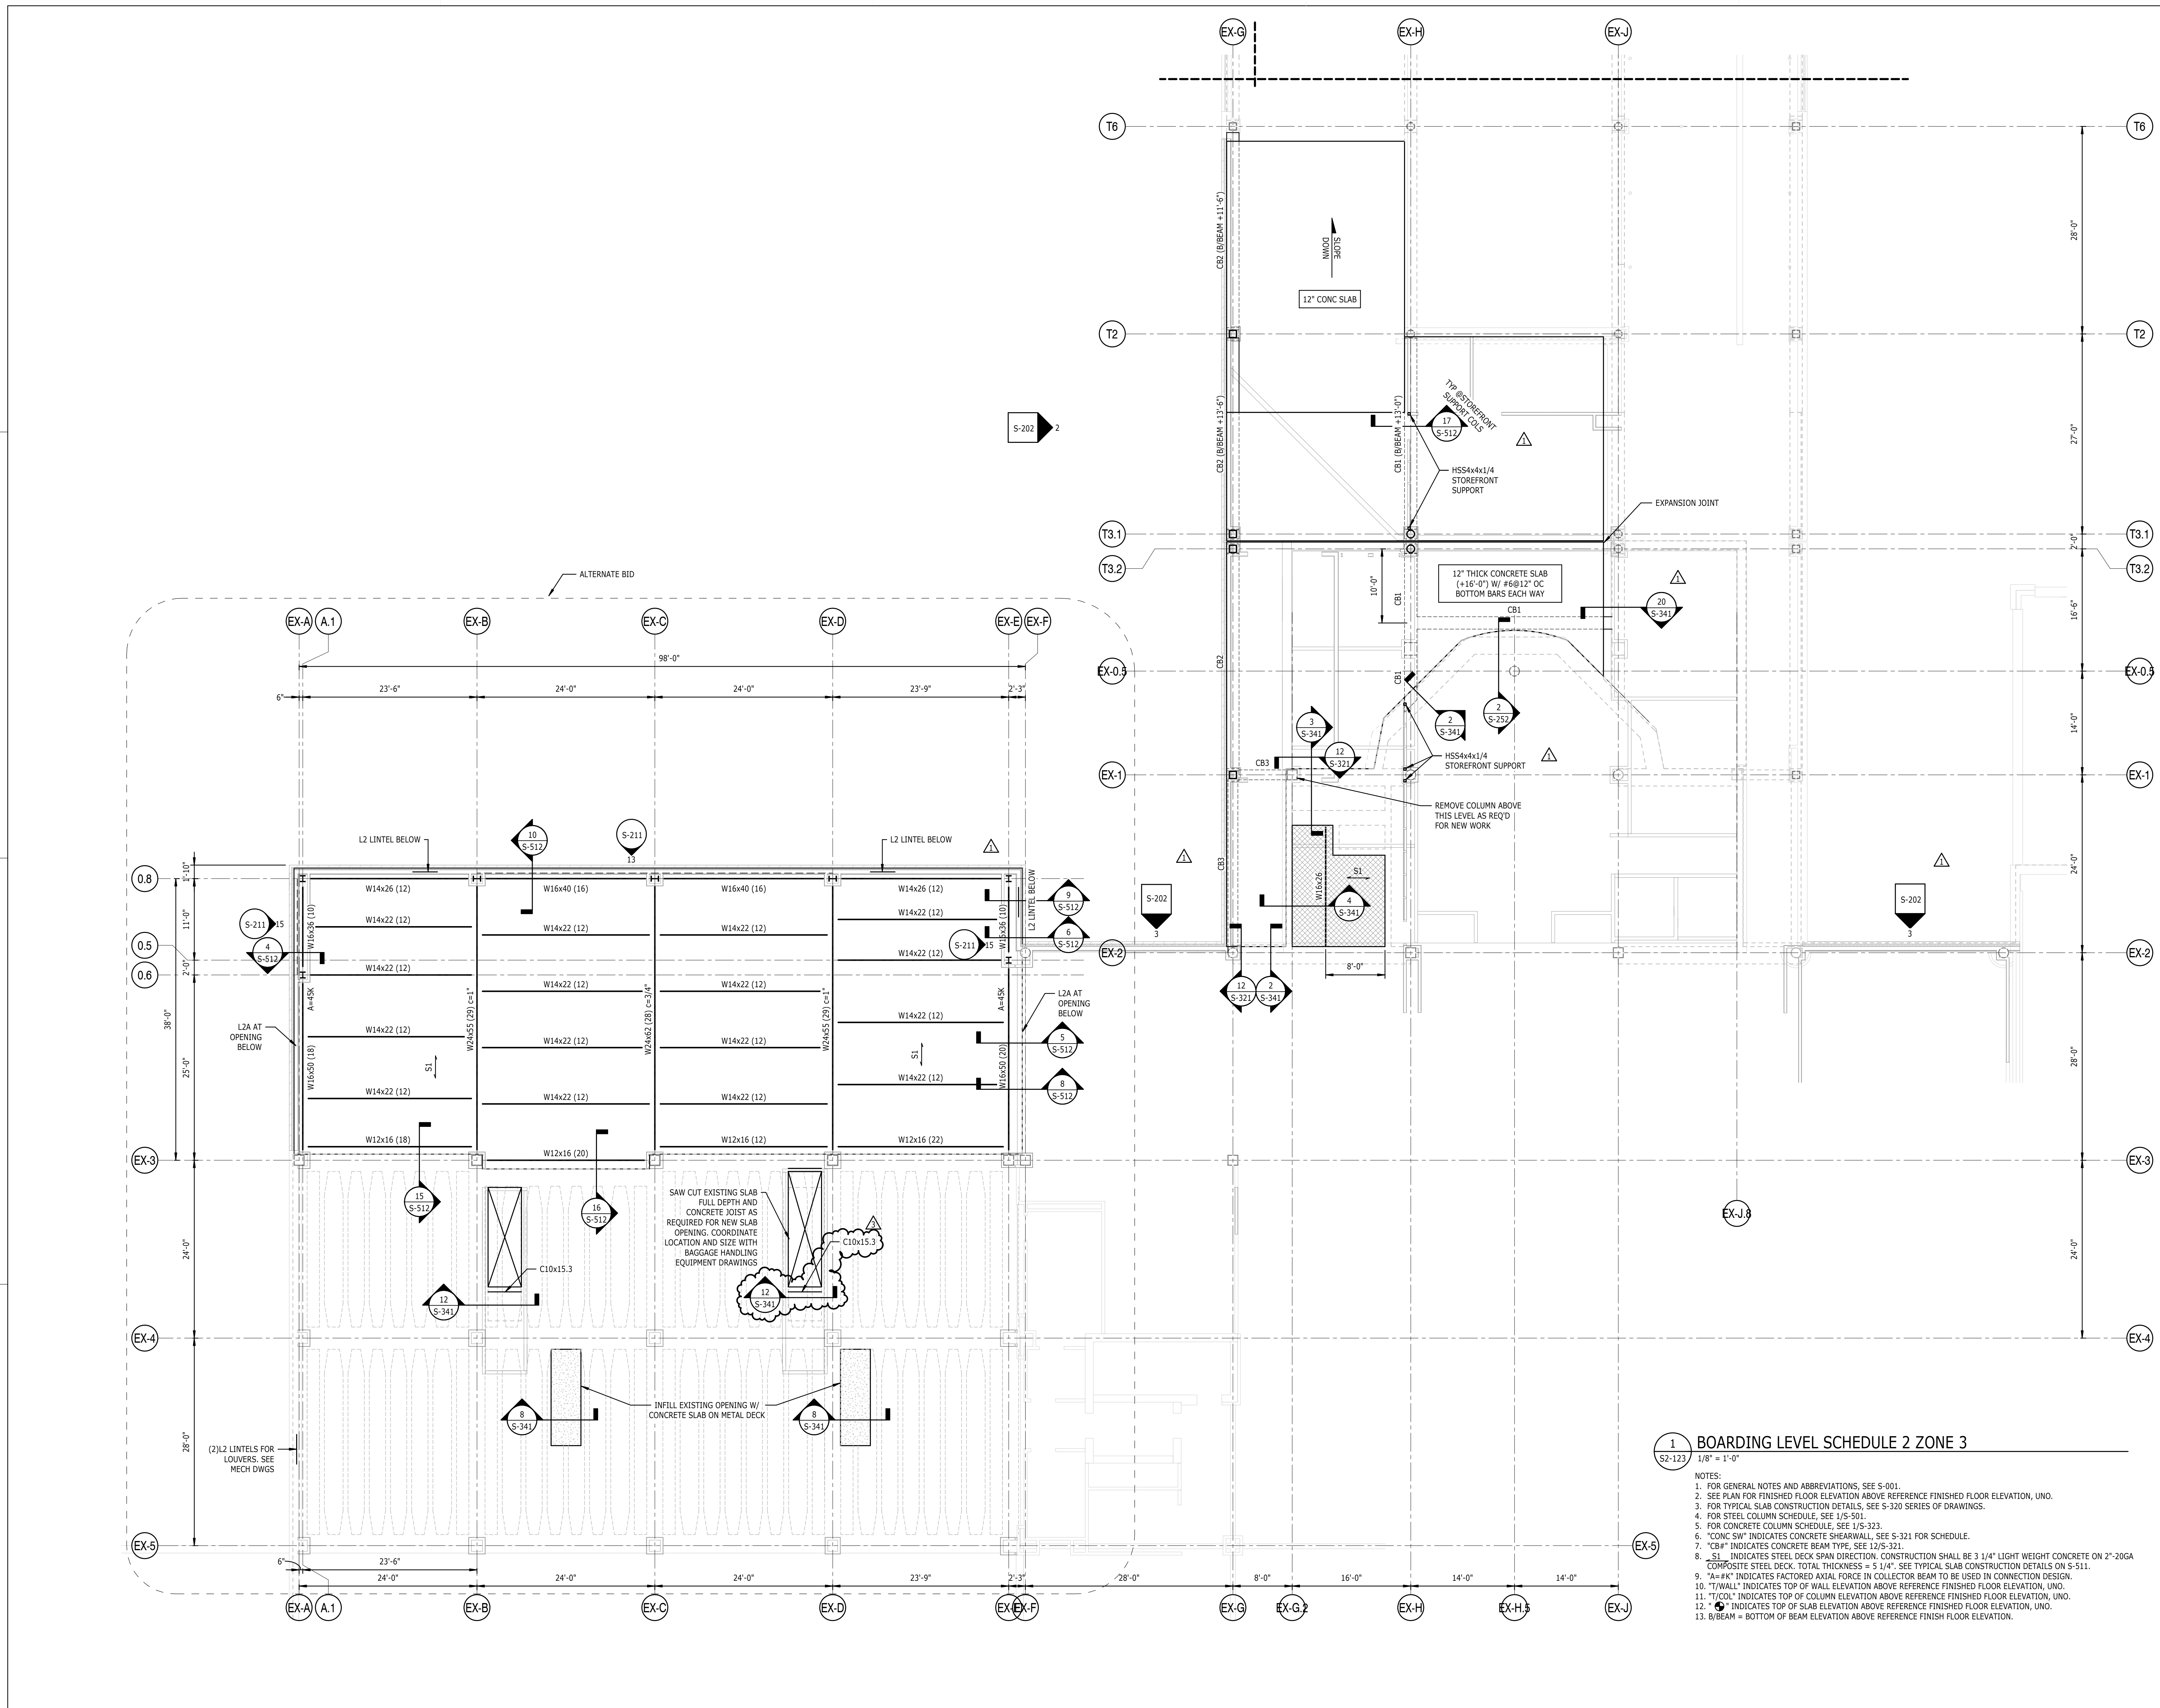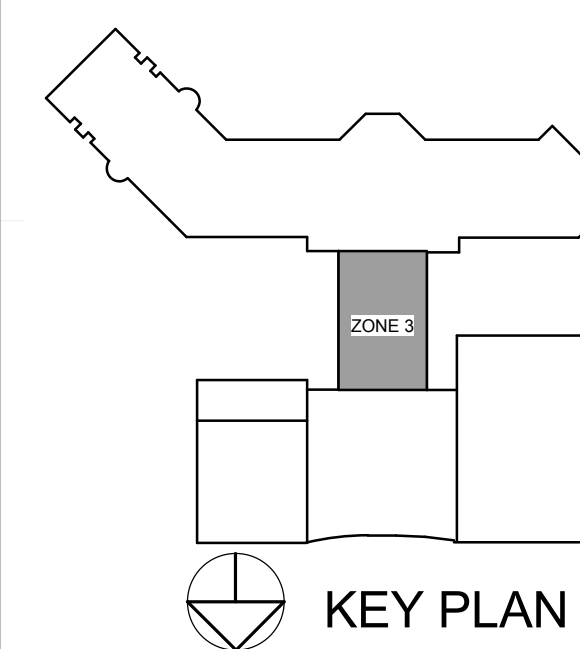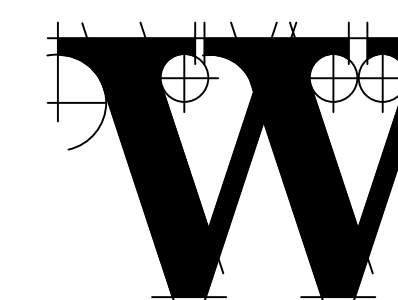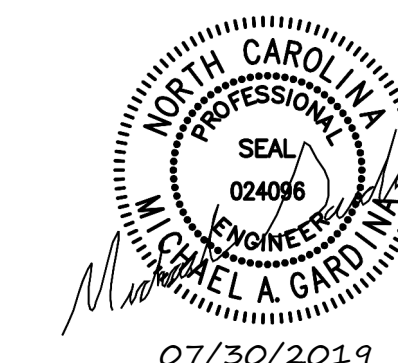


**1 BOARDING LEVEL SCHEDULE 2 ZONE 3**  
1/8" = 1'-0"

- NOTES:
- FOR GENERAL NOTES AND ABBREVIATIONS, SEE S-001.
  - SEE PLAN FOR FINISHED FLOOR ELEVATION ABOVE REFERENCE FINISHED FLOOR ELEVATION, UNO.
  - FOR TYPICAL SLAB CONSTRUCTION DETAILS, SEE S-320 SERIES OF DRAWINGS.
  - FOR STEEL COLUMN SCHEDULE, SEE 1/S-501.
  - FOR CONCRETE COLUMN SCHEDULE, SEE 1/S-323.
  - "CONC SW" INDICATES CONCRETE SHEARWALL, SEE S-321 FOR SCHEDULE.
  - "CSF" INDICATES CONCRETE BEAM TYPE, SEE 1/S-321.
  - "S1" INDICATES STEEL DECK SPAN DIRECTION, CONSTRUCTION SHALL BE 3 1/4" LIGHT WEIGHT CONCRETE ON 2"-20GA COMPOSITE STEEL DECK, TOTAL THICKNESS = 5 1/4". SEE TYPICAL SLAB CONSTRUCTION DETAILS ON S-511.
  - "A=K" INDICATES FACTORED AXIAL FORCE IN COLLECTOR BEAM TO BE USED IN CONNECTION DESIGN.
  - "TWALL" INDICATES TOP OF WALL ELEVATION ABOVE REFERENCE FINISHED FLOOR ELEVATION, UNO.
  - "T/COL" INDICATES TOP OF COLUMN ELEVATION ABOVE REFERENCE FINISHED FLOOR ELEVATION, UNO.
  - "S" INDICATES TOP OF SLAB ELEVATION ABOVE REFERENCE FINISHED FLOOR ELEVATION, UNO.
  - B/BEAM = BOTTOM OF BEAM ELEVATION ABOVE REFERENCE FINISH FLOOR ELEVATION.



TERMINAL IMPROVEMENTS CONTRACT 3

Wilmington International Airport  
1740 Airport Boulevard, Suite 12  
Wilmington, NC 28405

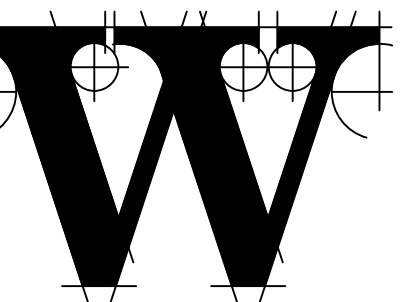

THE WILSON GROUP - ARCHITECTS -

PO Box 5510 Charlotte, NC 28299  
704-331-9747 • www.twgarchitects.com

PROJECT MANAGER & CIVIL ENGINEER  
**TALBERT & BRIGHT**

CONSULTING ARCHITECT  
LS3P

STRUCTURAL ENGINEER  
FIRM LICENSE #C-1051  
**STEWART**

FP/PM/E ENGINEER  
**CHEATHAM & ASSOC.**

BAGGAGE HANDLING CONSULTANTS  
**BNP**

AIRCRAFT SUPPORT SYSTEMS  
**DK CONSULTANTS**

SPECIALTY LIGHTING CONSULTANT  
**HARTRANFT**

SINGAGE & WAYFINDING  
**TAKEFORM**

COPYRIGHT © 2019  
THE WILSON GROUP ARCHITECTS  
ALL RIGHTS RESERVED

PRINTED OR ELECTRONIC DRAWINGS AND DOCUMENTATION MAY NOT BE REPRODUCED IN ANY FORM WITHOUT WRITTEN PERMISSION FROM THE WILSON GROUP ARCHITECTS

REVISIONS


3 7/30/19 AD-03

DATE 06/28/2019  
PROJECT NUMBER 9202-000  
SHEET TITLE

PARTIAL BOARDING LEVEL REBAR PLAN SCHEDULE 2 ZONE 1

SHEET NUMBER

S2-124

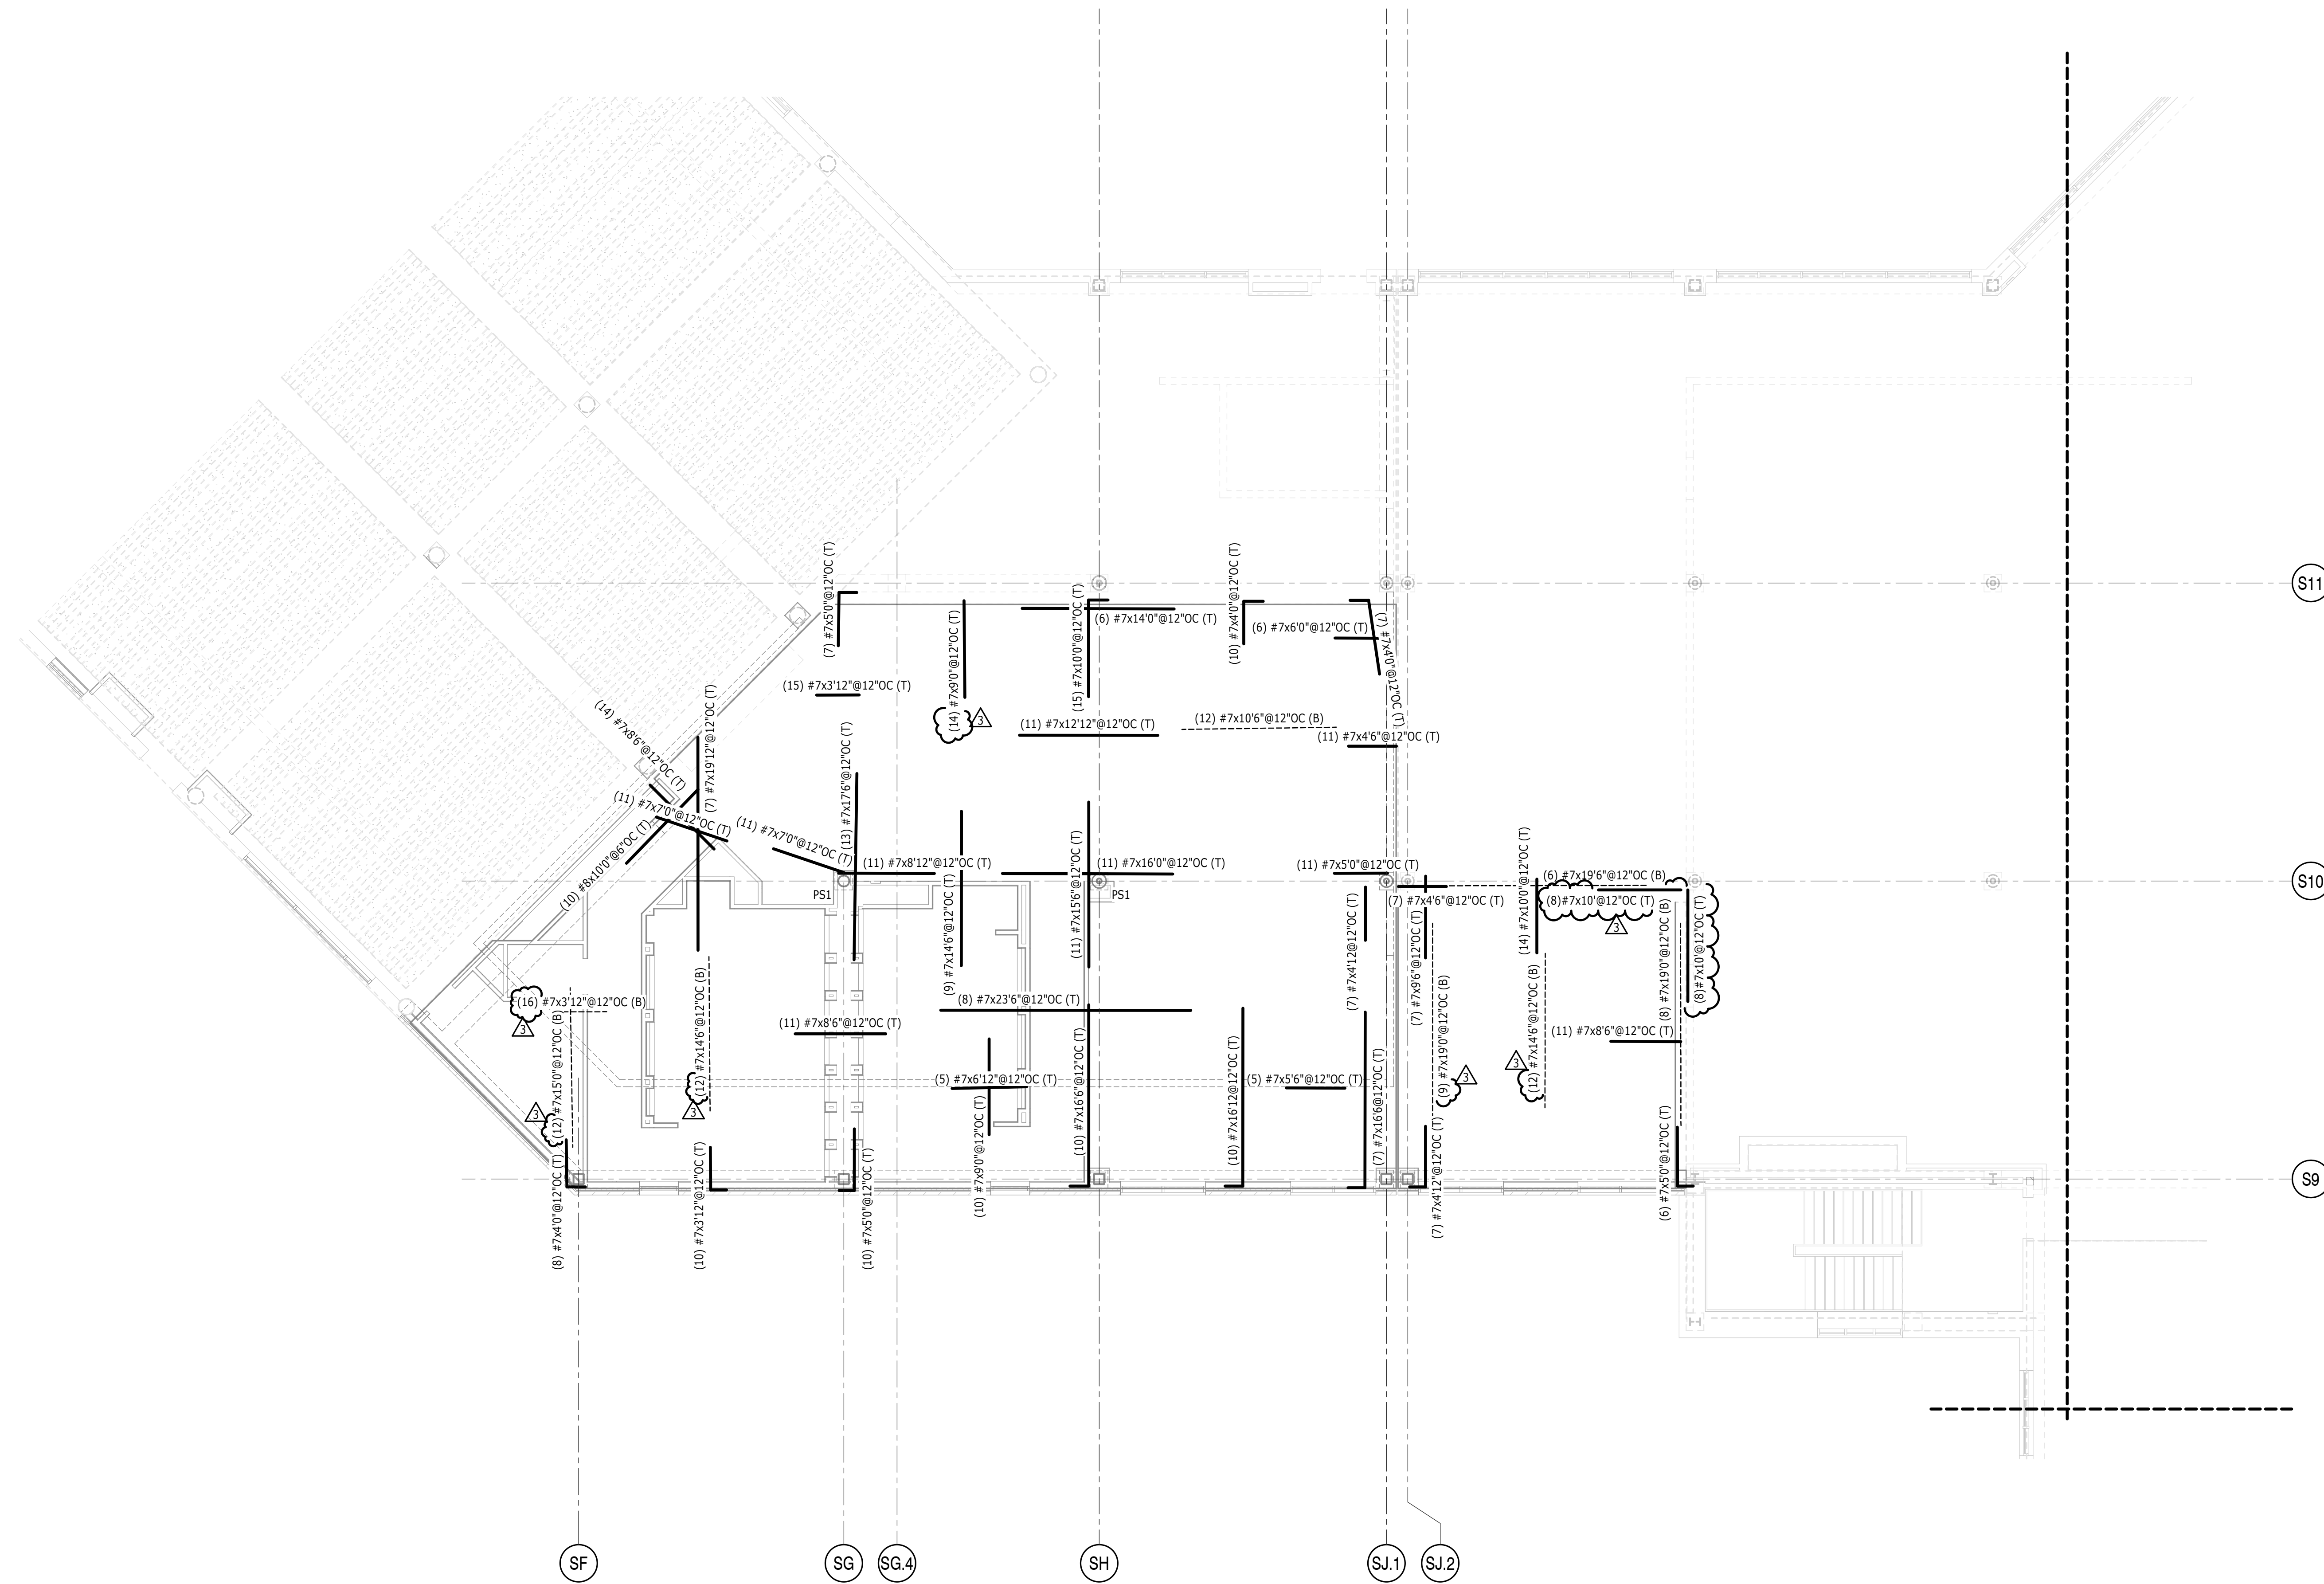


1 BOARDING LEVEL REBAR PLAN SCHEDULE 2 ZONE 1  
S2-124 1/8" = 1'-0"

- REBAR PLAN NOTES:
- FOR GENERAL NOTES AND ABBREVIATIONS, SEE S-001 AND S-002.
  - FINISH FLOOR ELEVATION +13'-0" ABOVE REFERENCE FINISH FLOOR ELEVATION, UNLESS NOTED OTHERWISE.
  - CONCRETE ELEVATED SLABS SHALL BE TWO WAY FLAT PLATE CONCRETE SLAB. SEE PLAN FOR SLAB THICKNESS. TOP OF SLAB SHALL BE SLOPED WHERE NOTED ON ARCHITECTURAL DRAWINGS.
  - ALL OPENINGS IN CONCRETE SLAB MUST BE LOCATED AND BLOCKED OUT PRIOR TO CONCRETE BEING PLACED. NO CORE DRILLING IS PERMITTED WITHOUT CONSENT OF THE ENGINEER OF RECORD. SEE 7/5-322 FOR REINFORCING AT OPENINGS.
  - "CONC SW" INDICATES CONCRETE SHEAR WALL.
  - SEE ARCHITECTURAL DRAWINGS FOR PRECISE EDGE OF SLAB DIMENSIONS. ARCHITECTURAL DRAWINGS GOVERN ALL DIMENSIONS.
  - SEE ARCHITECTURAL AND PLUMBING DRAWINGS FOR FLOOR DRAINS AND SLAB SLOPES.
  - "PS#" INDICATES STUD RAILS, STUD RAILS ARE REQUIRED TO BEGIN AT FACE OF COLUMN, SEE 7/5-321.
  - PROVIDE ADDITIONAL STEEL AT ALL RE-ENRAINT CORNERS PER DETAIL 4/5-322.
  - "CB" INDICATES CONCRETE BEAM, SEE 6/5-321.
  - REINFORCING THAT TERMINATES AT THE INTERFACE BETWEEN SCHEDULE 1 AND SCHEDULE 2 SHALL HAVE THREADED COUPLERS AT THE ENDS OF SCHEDULE 1 REINFORCING. SCHEDULE 2 REINFORCING SHALL BE THREADED TO CONNECT TO THE COUPLERS INSTALLED IN SCHEDULE 1. THIS IS TYPICAL AT THE SLAB AND BEAMS ALONG THIS JOINT.
  - "H" INDICATES REINFORCING STEEL WITH TYPICAL 90 OR 180 DEGREE HOOKS. LENGTHS INDICATED ON PLAN DO NOT INCLUDE HOOKS.



**TERMINAL IMPROVEMENTS CONTRACT 3**

Wilmington International Airport  
1740 Airport Boulevard, Suite 12  
Wilmington, NC 28405

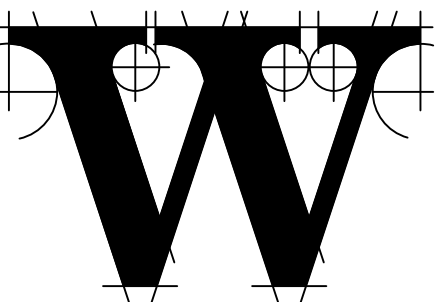

**THE WILSON GROUP**  
- ARCHITECTS -

PO Box 5510 Charlotte, NC 28299  
704-331-9747 • www.twgarchitects.com

PROJECT MANAGER & CIVIL ENGINEER  
**TALBERT & BRIGHT**

CONSULTING ARCHITECT  
**LS3P**

STRUCTURAL ENGINEER  
FIRM LICENSE #C-1051  
**STEWART**

FPI/P/ME ENGINEER  
**CHEATHAM & ASSOC.**

BAGGAGE HANDLING CONSULTANTS  
**BNP**

AIRCRAFT SUPPORT SYSTEMS  
**DK CONSULTANTS**

SPECIALTY LIGHTING CONSULTANT  
**HARTRANFT**

SINGAGE & WAYFINDING  
**TAKEFORM**

COPYRIGHT © 2019  
THE WILSON GROUP ARCHITECTS  
ALL RIGHTS RESERVED

PRINTED OR ELECTRONIC DRAWINGS AND DOCUMENTATION MAY NOT BE REPRODUCED IN ANY FORM WITHOUT WRITTEN PERMISSION FROM THE WILSON GROUP ARCHITECTS

**REVISIONS**


3 7/30/19 AD-03

DATE 06/28/2019  
PROJECT NUMBER 9202-000  
SHEET TITLE

**PARTIAL BOARDING LEVEL REBAR PLAN SCHEDULE 2 ZONE 3**

SHEET NUMBER

**S2-125**

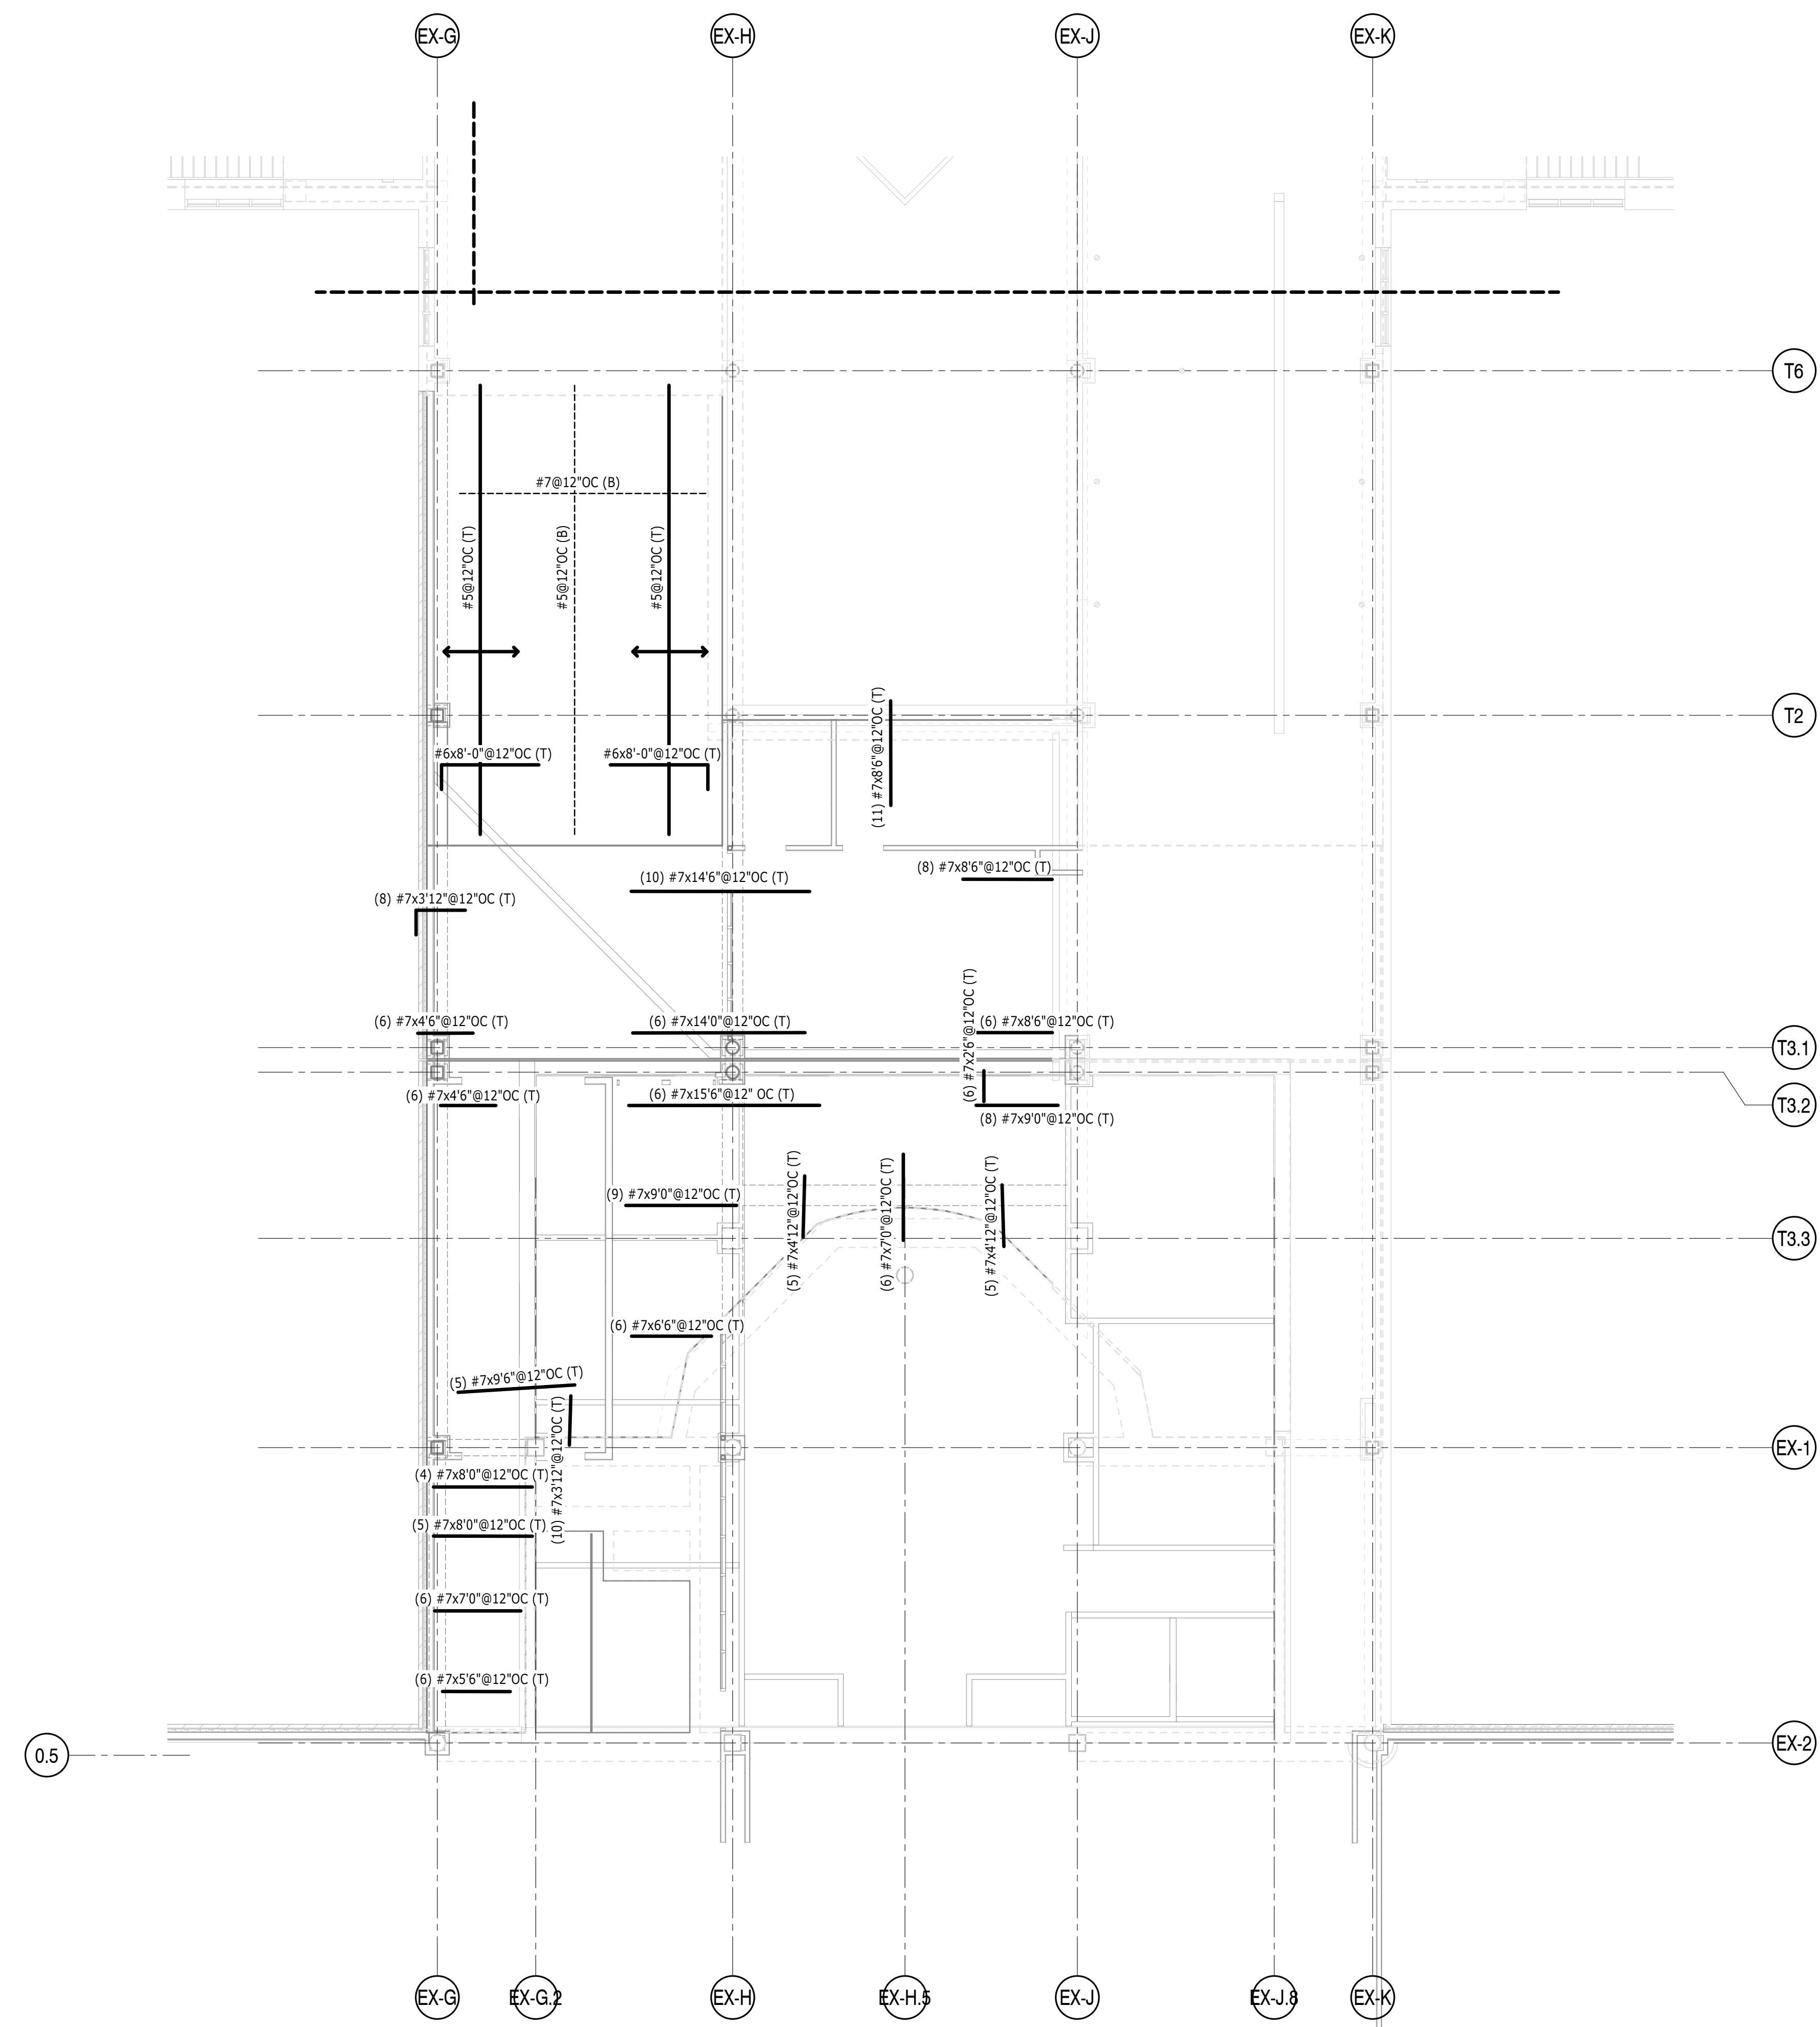

**1 BOARDING LEVEL REBAR PLAN SCHEDULE 2 ZONE 3**

1/8" = 1'-0"

**REBAR PLAN NOTES:**


1. FOR GENERAL NOTES AND ABBREVIATIONS, SEE S-001 AND S-002.
2. FINISH FLOOR ELEVATION +13'-0" ABOVE REFERENCE FINISH FLOOR ELEVATION, UNLESS NOTED OTHERWISE.
3. CONCRETE ELEVATED SLABS SHALL BE TWO WAY FLAT PLATE CONCRETE SLAB. SEE PLAN FOR SLAB THICKNESS. TOP OF SLAB SHALL BE SLOPED WHERE NOTED ON ARCHITECTURAL DRAWINGS.
4. ALL OPENINGS IN CONCRETE SLAB MUST BE LOCATED AND BLOCKED OUT PRIOR TO CONCRETE BEING PLACED. NO CORE DRILLING IS PERMITTED WITHOUT CONSENT OF THE ENGINEER OF RECORD. SEE 7/5-322 FOR REINFORCING AT OPENINGS.
5. "CONC SW" INDICATES CONCRETE SHEAR WALL.
6. SEE ARCHITECTURAL DRAWINGS FOR PRECISE EDGE OF SLAB DIMENSIONS. ARCHITECTURAL DRAWINGS GOVERN ALL DIMENSIONS.
7. SEE ARCHITECTURAL AND PLUMBING DRAWINGS FOR FLOOR DRAINS AND SLAB SLOPES.
8. "PSR" INDICATES STUD RAILS, STUD RAILS ARE REQUIRED TO BEGIN AT FACE OF COLUMN, SEE 7/5-321.
9. PROVIDE ADDITIONAL STEEL AT ALL RE-ENTRANT CORNERS PER DETAIL 4/5-322.
10. "CB" INDICATES CONCRETE BEAM, SEE 6/5-321.
11. REINFORCING THAT TERMINATES AT THE INTERFACE BETWEEN SCHEDULE 1 AND SCHEDULE 2 SHALL HAVE THREADED COUPLERS AT THE ENDS OF SCHEDULE 1 REINFORCING. SCHEDULE 2 REINFORCING SHALL BE THREADED TO CONNECT TO THE COUPLERS INSTALLED IN SCHEDULE 1. THIS IS TYPICAL AT THE SLAB AND BEAMS ALONG THIS JOINT.
12. " " INDICATES REINFORCING STEEL WITH TYPICAL 90 OR 180 DEGREE HOOKS. LENGTHS INDICATED ON PLAN DO NOT INCLUDE HOOKS.





TERMINAL IMPROVEMENTS CONTRACT 3

Wilmington International Airport 1740 Airport Boulevard, Suite 12 Wilmington, NC 28405

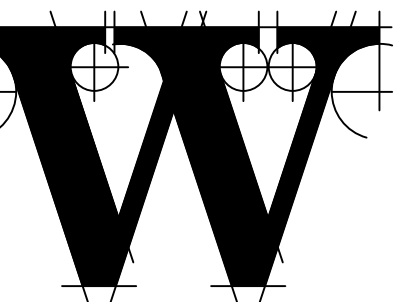

THE WILSON GROUP ARCHITECTS

PO Box 5510 Charlotte, NC 28299 704-331-9747 • www.twgarchitects.com

PROJECT MANAGER & CIVIL ENGINEER TALBERT & BRIGHT

CONSULTING ARCHITECT LS3P

STRUCTURAL ENGINEER FIRM LICENSE #C-1051 STEWART


FP/PM/E ENGINEER CHEATHAM & ASSOC.

BAGGAGE HANDLING CONSULTANTS BNP

AIRCRAFT SUPPORT SYSTEMS DK CONSULTANTS

SPECIALTY LIGHTING CONSULTANT HARTRANFT

SINGAGE & WAYFINDING TAKEFORM

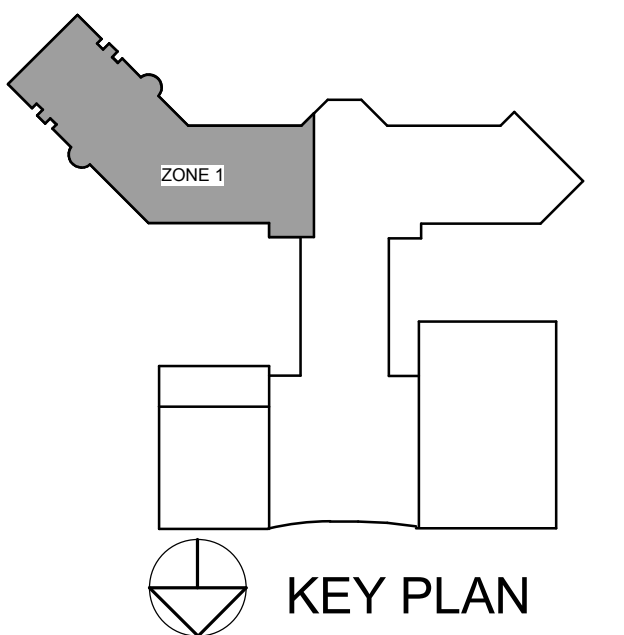

COPYRIGHT © 2019 THE WILSON GROUP ARCHITECTS ALL RIGHTS RESERVED

PRINTED OR ELECTRONIC DRAWINGS AND DOCUMENTATION MAY NOT BE REPRODUCED IN ANY FORM WITHOUT WRITTEN PERMISSION FROM THE WILSON GROUP ARCHITECTS

REVISIONS


3 7/30/19 AD-03

DATE 06/28/2019 PROJECT NUMBER 9202-000 SHEET TITLE

PARTIAL ROOF FRAMING PLAN SCHEDULE 2 ZONE 1

SHEET NUMBER

S2-131


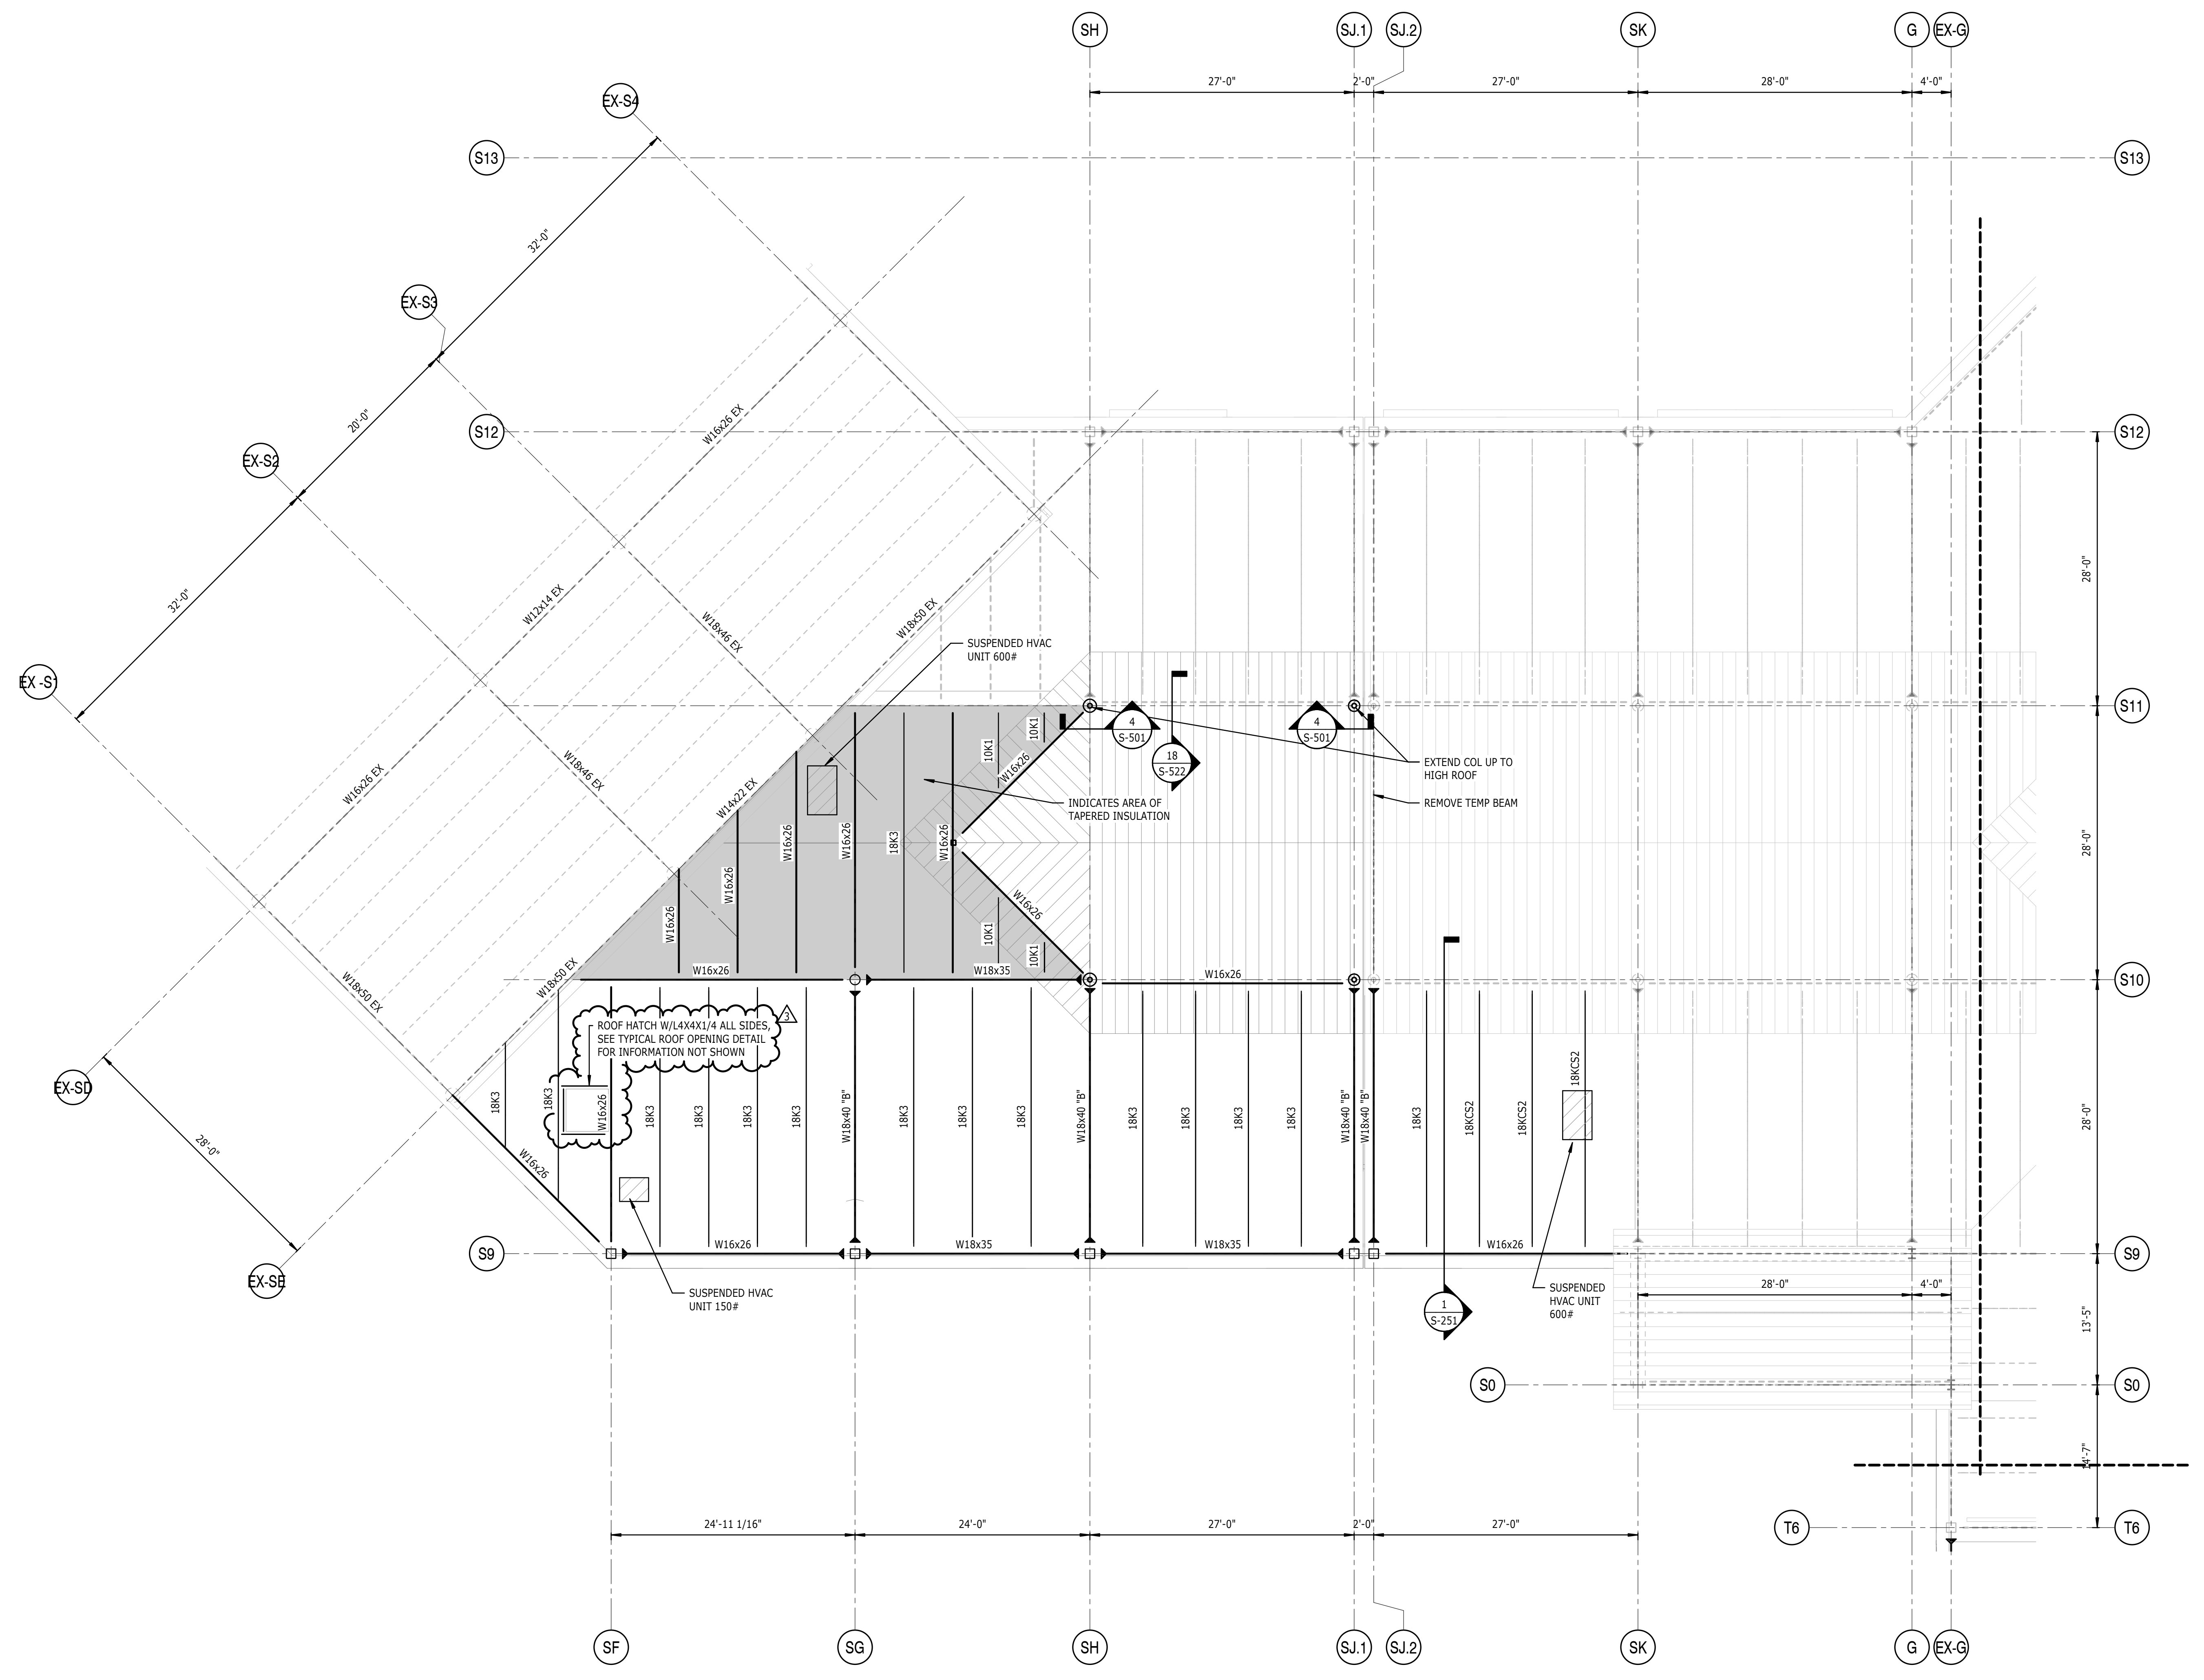


1 ROOF FRAMING PLAN SCHEDULE 2 ZONE 1

S2-131

1/8" = 1'-0"

- NOTES: 1. FOR GENERAL NOTES AND ABBREVIATIONS, SEE S-001. 2. (No) INDICATES TOP OF STEEL ELEVATION ABOVE REFERENCED FINISH FLOOR ELEVATION. 3. (D1) INDICATES STEEL DECK SPAN DIRECTION. CONSTRUCTION SHALL BE 1 1/2" 18GA METAL DECK. SEE 1/S-521 FOR TYPICAL ROOF CONSTRUCTION DETAIL. 4. INDICATES MOMENT CONNECTION, SEE 19/S-511 FOR SCHEDULE. 5. SEE ELEVATIONS ON PLAN FOR VERTICAL FRAME LOCATIONS AND S-211 FOR ELEVATIONS AND DETAILS. 6. FOR TYPICAL ROOF FRAMING DETAILS, SEE S-521. 7. FOR STEEL COLUMN SCHEDULE, SEE 1/S-501. 8. "B" INDICATES BOTTOM FLANGE BEAM BRACING REQUIRED. BRACING SHALL BE PER DETAIL 19/S522. IF BRACING IS NOTED AT EXPANSION JOINTS, INSTALL BRACING ONLY ON ONE SIDE. 9. "T" INDICATES TOP CHORD EXTENSION REQUIRED. 10. "A-HK" INDICATES FACTORED AXIAL FORCE IN COLLECTOR BEAM TO BE USED IN CONNECTION DESIGN. 11. "B/DECK (+#-#)" INDICATES BOTTOM OF DECK ELEVATION FROM REFERENCED FINISH FLOOR ELEVATION. 12. "TRUSS T#" INDICATES TRUSS TYPE, SEE S200 SERIES FOR ELEVATIONS. 13. ALL EXPOSED STRUCTURAL STEEL (COLUMNS, ROOF TRUSSES, TRUSS BEARING & ETC) SHALL BE CONSIDERED AESS. 14. (D2) INDICATES STEEL DECK SPAN DIRECTION. CONSTRUCTION SHALL BE 1 1/2" 18GA METAL DECK. SEE 1/S-521 FOR TYPICAL ROOF CONSTRUCTION DETAIL. 15. "#k-ft" DENOTES FACTORED MOMENT TO BE USED IN DESIGN OF MOMENT CONNECTIONS.

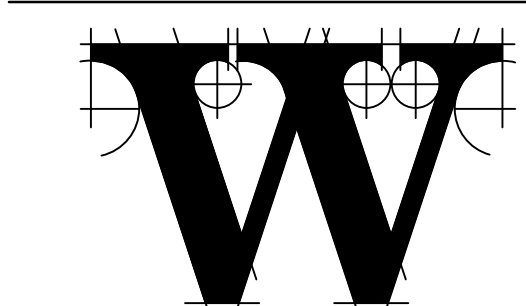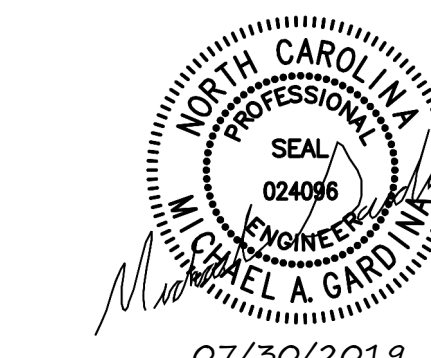

**THE WILSON GROUP ARCHITECTS**

PO Box 5510 Charlotte, NC 28299  
704-331-9747 • www.twgarchitects.com

PROJECT MANAGER & CIVIL ENGINEER

**TALBERT & BRIGHT**

CONSULTING ARCHITECT

**LS3P**

STRUCTURAL ENGINEER

FIRM LICENSE #C-1051

**STEWART**

FPI/P/ME ENGINEER

**CHEATHAM & ASSOC.**

BAGGAGE HANDLING CONSULTANTS

**BNP**

AIRCRAFT SUPPORT SYSTEMS

**DK CONSULTANTS**



SPECIALTY LIGHTING CONSULTANT

**HARTRANFT**

SINGAGE & WAYFINDING

**TAKEFORM**

KEY PLAN

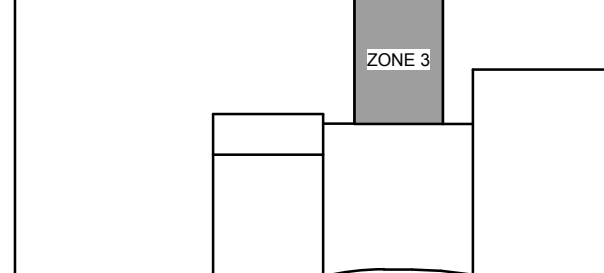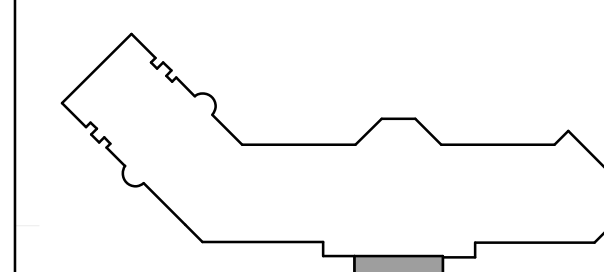

**KEY PLAN**

COPYRIGHT © 2019 THE WILSON GROUP ARCHITECTS ALL RIGHTS RESERVED

PRINTED OR ELECTRONIC DRAWINGS AND DOCUMENTATION MAY NOT BE REPRODUCED IN ANY FORM WITHOUT WRITTEN PERMISSION FROM THE WILSON GROUP ARCHITECTS

REVISIONS


1	7/12/19	AD-01
3	7/30/19	AD-03

DATE 06/28/2019  
PROJECT NUMBER 9202-000  
SHEET TITLE

**PARTIAL ROOF FRAMING PLAN SCHEDULE 2 ZONE 3**

SHEET NUMBER

**S2-133**

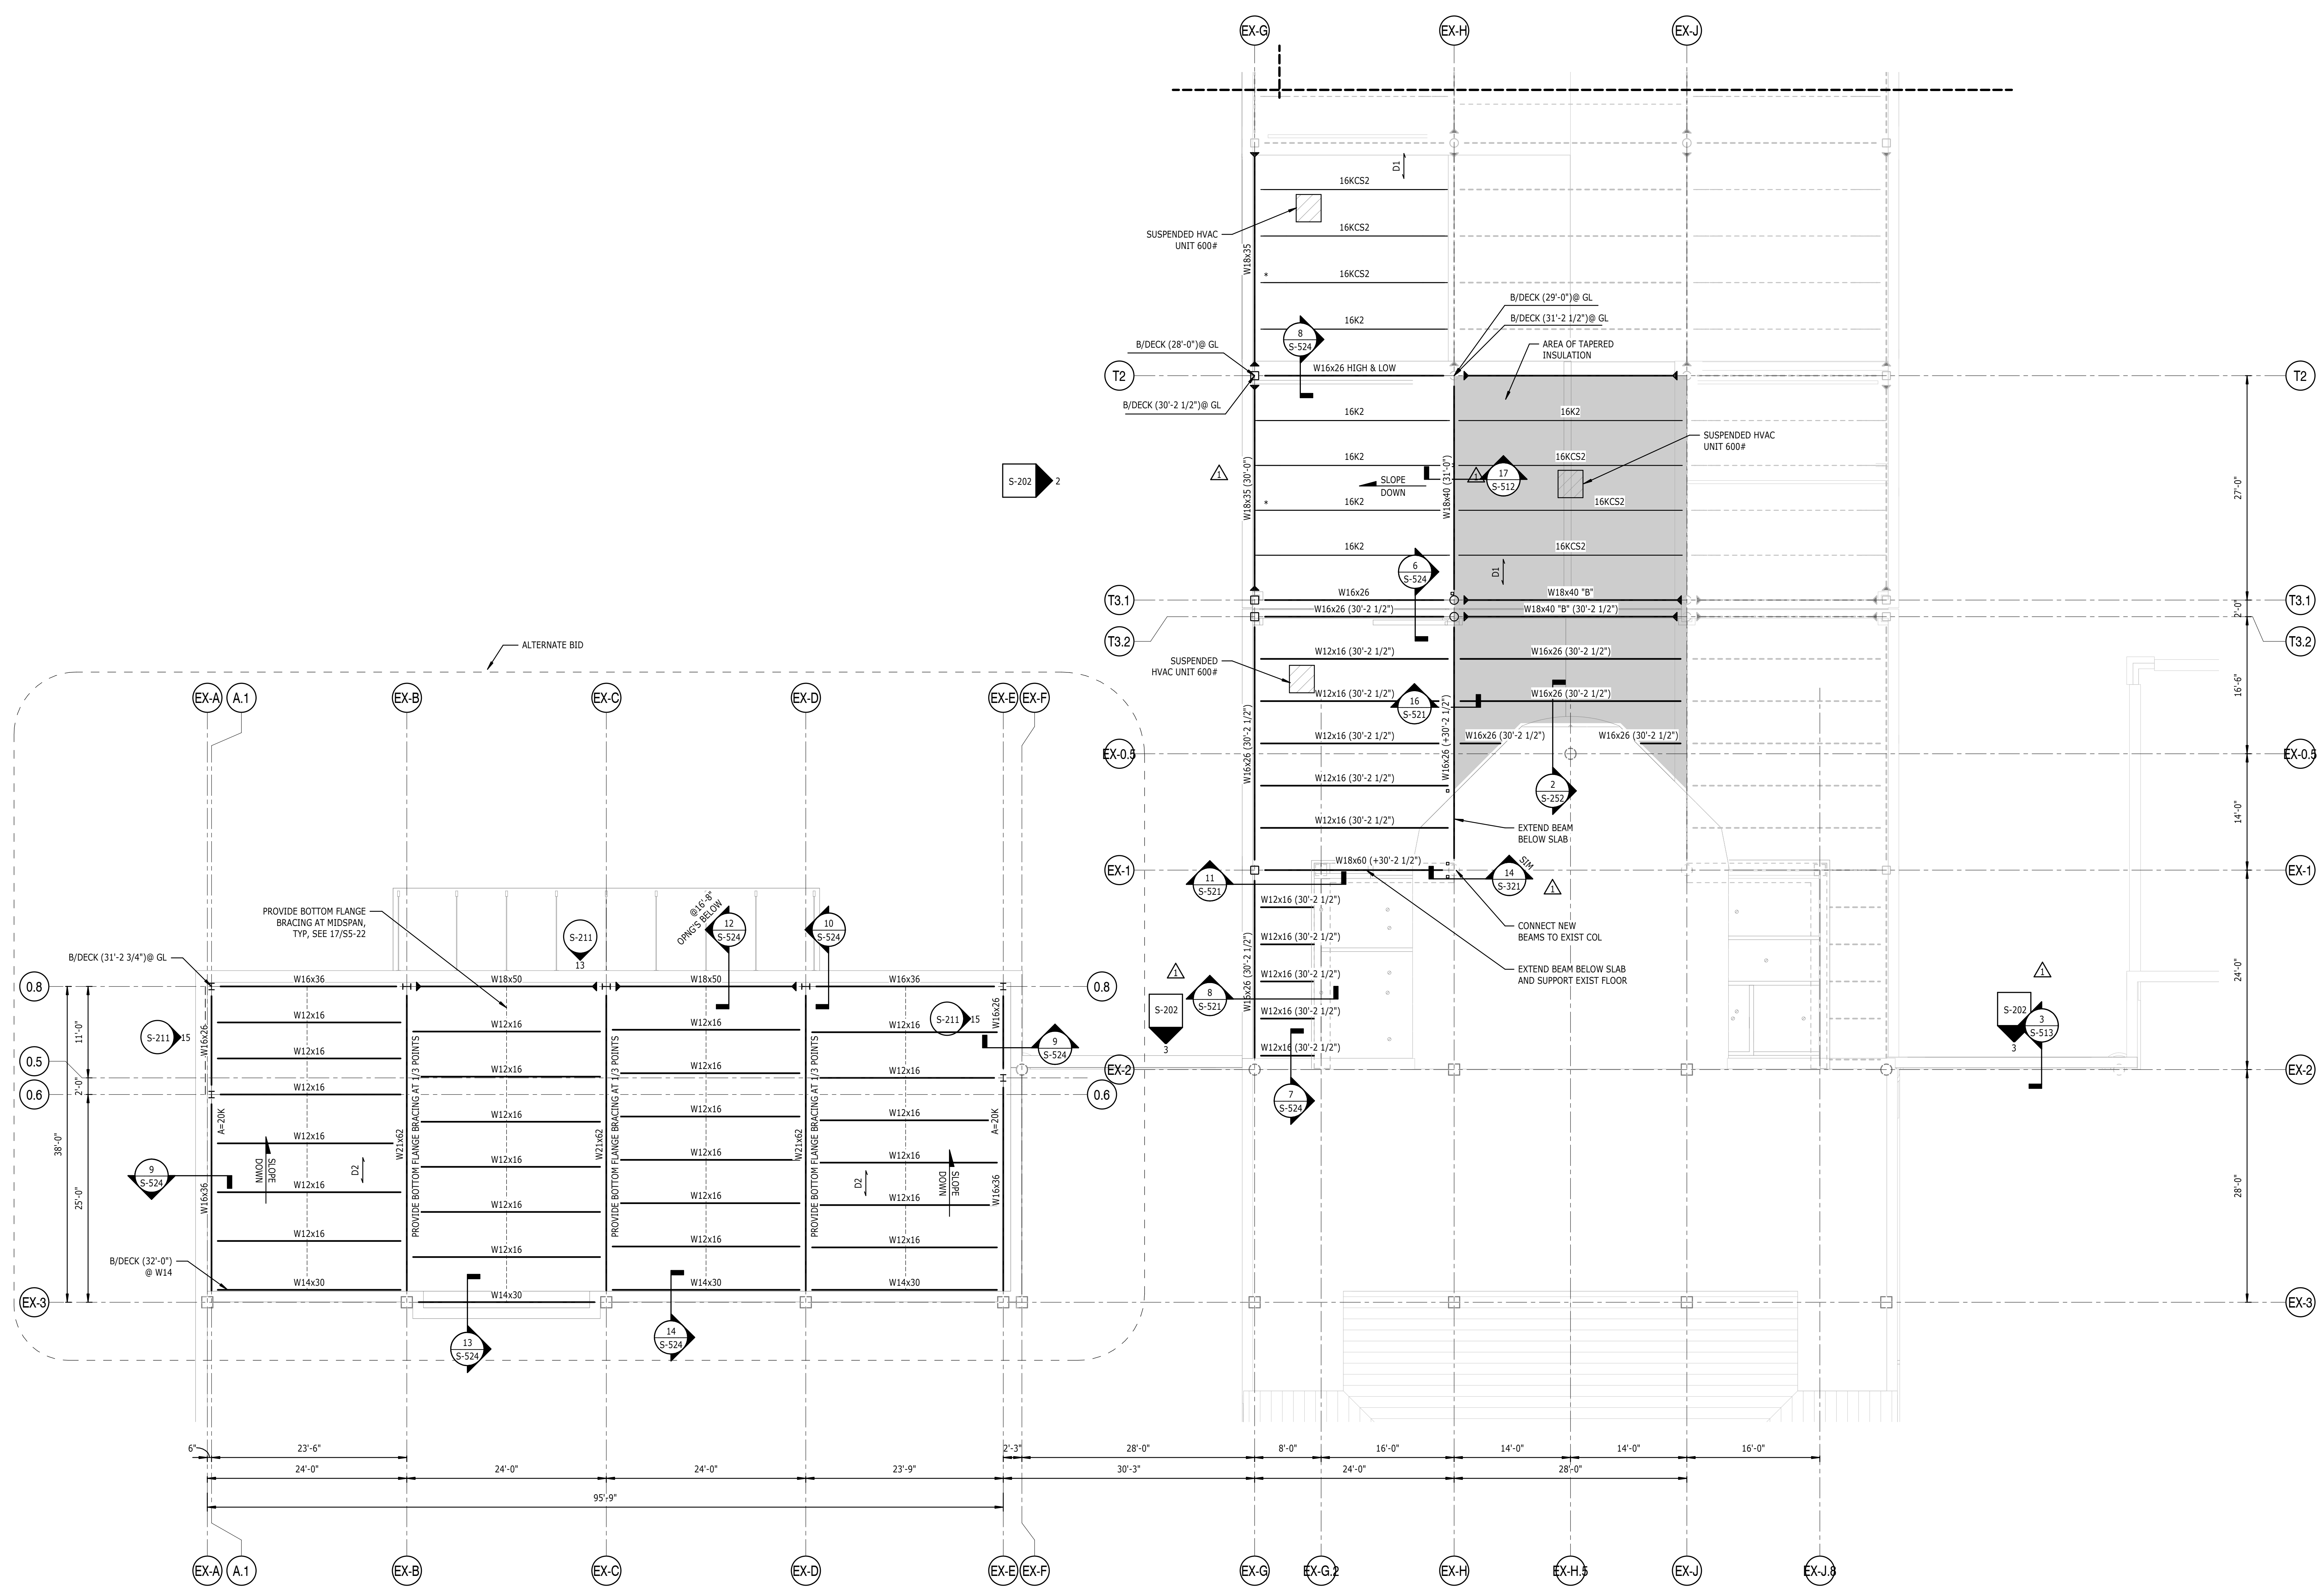


**1 ROOF FRAMING PLAN**  
1/8" = 1'-0"

- NOTES:
- FOR GENERAL NOTES AND ABBREVIATIONS, SEE S-001.
  - (No) INDICATES TOP OF STEEL ELEVATION ABOVE REFERENCED FINISH FLOOR ELEVATION.
  - \_DL\_ INDICATES STEEL DECK SPAN DIRECTION. CONSTRUCTION SHALL BE 1 1/2" 18GA METAL DECK. SEE 1/S-521 FOR TYPICAL ROOF CONSTRUCTION DETAIL.
  - INDICATES MOMENT CONNECTION, SEE 19/S-511 FOR SCHEDULE.
  - SEE ELEVATIONS ON PLAN FOR VERTICAL FRAME LOCATIONS AND S-211 FOR ELEVATIONS AND DETAILS.
  - FOR TYPICAL ROOF FRAMING DETAILS, SEE S-521.
  - FOR STEEL COLUMN SCHEDULE, SEE 1/S-501.
  - "B" INDICATES BOTTOM FLANGE BEAM BRACING REQUIRED. BRACING SHALL BE PER DETAIL 19/S522. IF BRACING IS NOTED AT EXPANION JOINTS, INSTALL BRACING ONLY ON ONE SIDE.
  - "\*\*" INDICATES BOTTOM CHORD EXTENSION REQUIRED.
  - "A=#K" INDICATES FACTORED AXIAL FORCE IN COLLECTOR BEAM TO BE USED IN CONNECTION DESIGN.
  - "B/DECK (+#'-#") INDICATES BOTTOM OF DECK ELEVATION FROM REFERENCED FINISH FLOOR ELEVATION.
  - "TRUSS" INDICATES TRUSS TYPE. SEE S200 SERIES FOR ELEVATIONS.
  - ALL EXPOSED STRUCTURAL STEEL (COLUMNS, ROOF TRUSSES, TRUSS BEARING & ETC) SHALL BE CONSIDERED STESS.
  - D2 INDICATES STEEL DECK SPAN DIRECTION. CONSTRUCTION SHALL BE 1 1/2" 18GA METAL DECK. SEE 1/S-521 FOR TYPICAL ROOF CONSTRUCTION DETAIL.
  - "#K-R" DENOTES FACTORED MOMENT TO BE USED IN DESIGN OF MOMENT CONNECTIONS.



TERMINAL IMPROVEMENTS CONTRACT 3

Wilmington International Airport 1740 Airport Boulevard, Suite 12 Wilmington, NC 28405

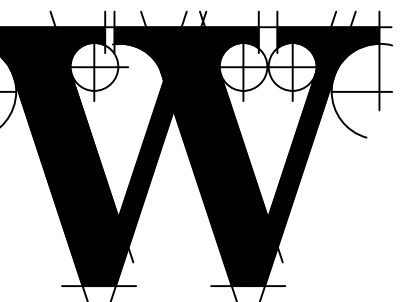

THE WILSON GROUP ARCHITECTS

PO Box 5510 Charlotte, NC 28299 704-331-9747 • www.twgarchitects.com

PROJECT MANAGER & CIVIL ENGINEER TALBERT & BRIGHT

CONSULTING ARCHITECT LS3P

STRUCTURAL ENGINEER FIRM LICENSE #C-1051 STEWART


FPI/PME ENGINEER CHEATHAM & ASSOC.

BAGGAGE HANDLING CONSULTANTS BNP

AIRCRAFT SUPPORT SYSTEMS DK CONSULTANTS

SPECIALTY LIGHTING CONSULTANT HARTRANFT

SINGAGE & WAYFINDING TAKEFORM

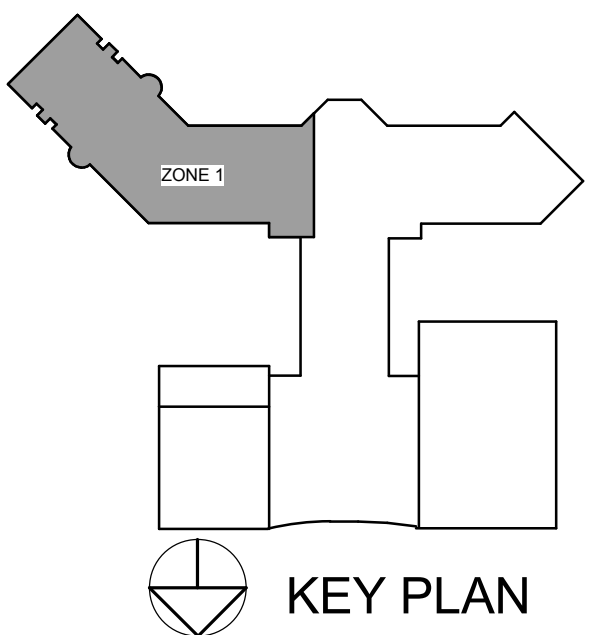

COPYRIGHT © 2019 THE WILSON GROUP ARCHITECTS ALL RIGHTS RESERVED

PRINTED OR ELECTRONIC DRAWINGS AND DOCUMENTATION MAY NOT BE REPRODUCED IN ANY FORM WITHOUT WRITTEN PERMISSION FROM THE WILSON GROUP ARCHITECTS

REVISIONS


1	7/12/19	AD-01
3	7/30/19	AD-03

DATE 06/28/2019 PROJECT NUMBER 9202-000 SHEET TITLE

PARTIAL HIGH ROOF PLAN SCHEDULE 2 ZONE 1

SHEET NUMBER

S2-141

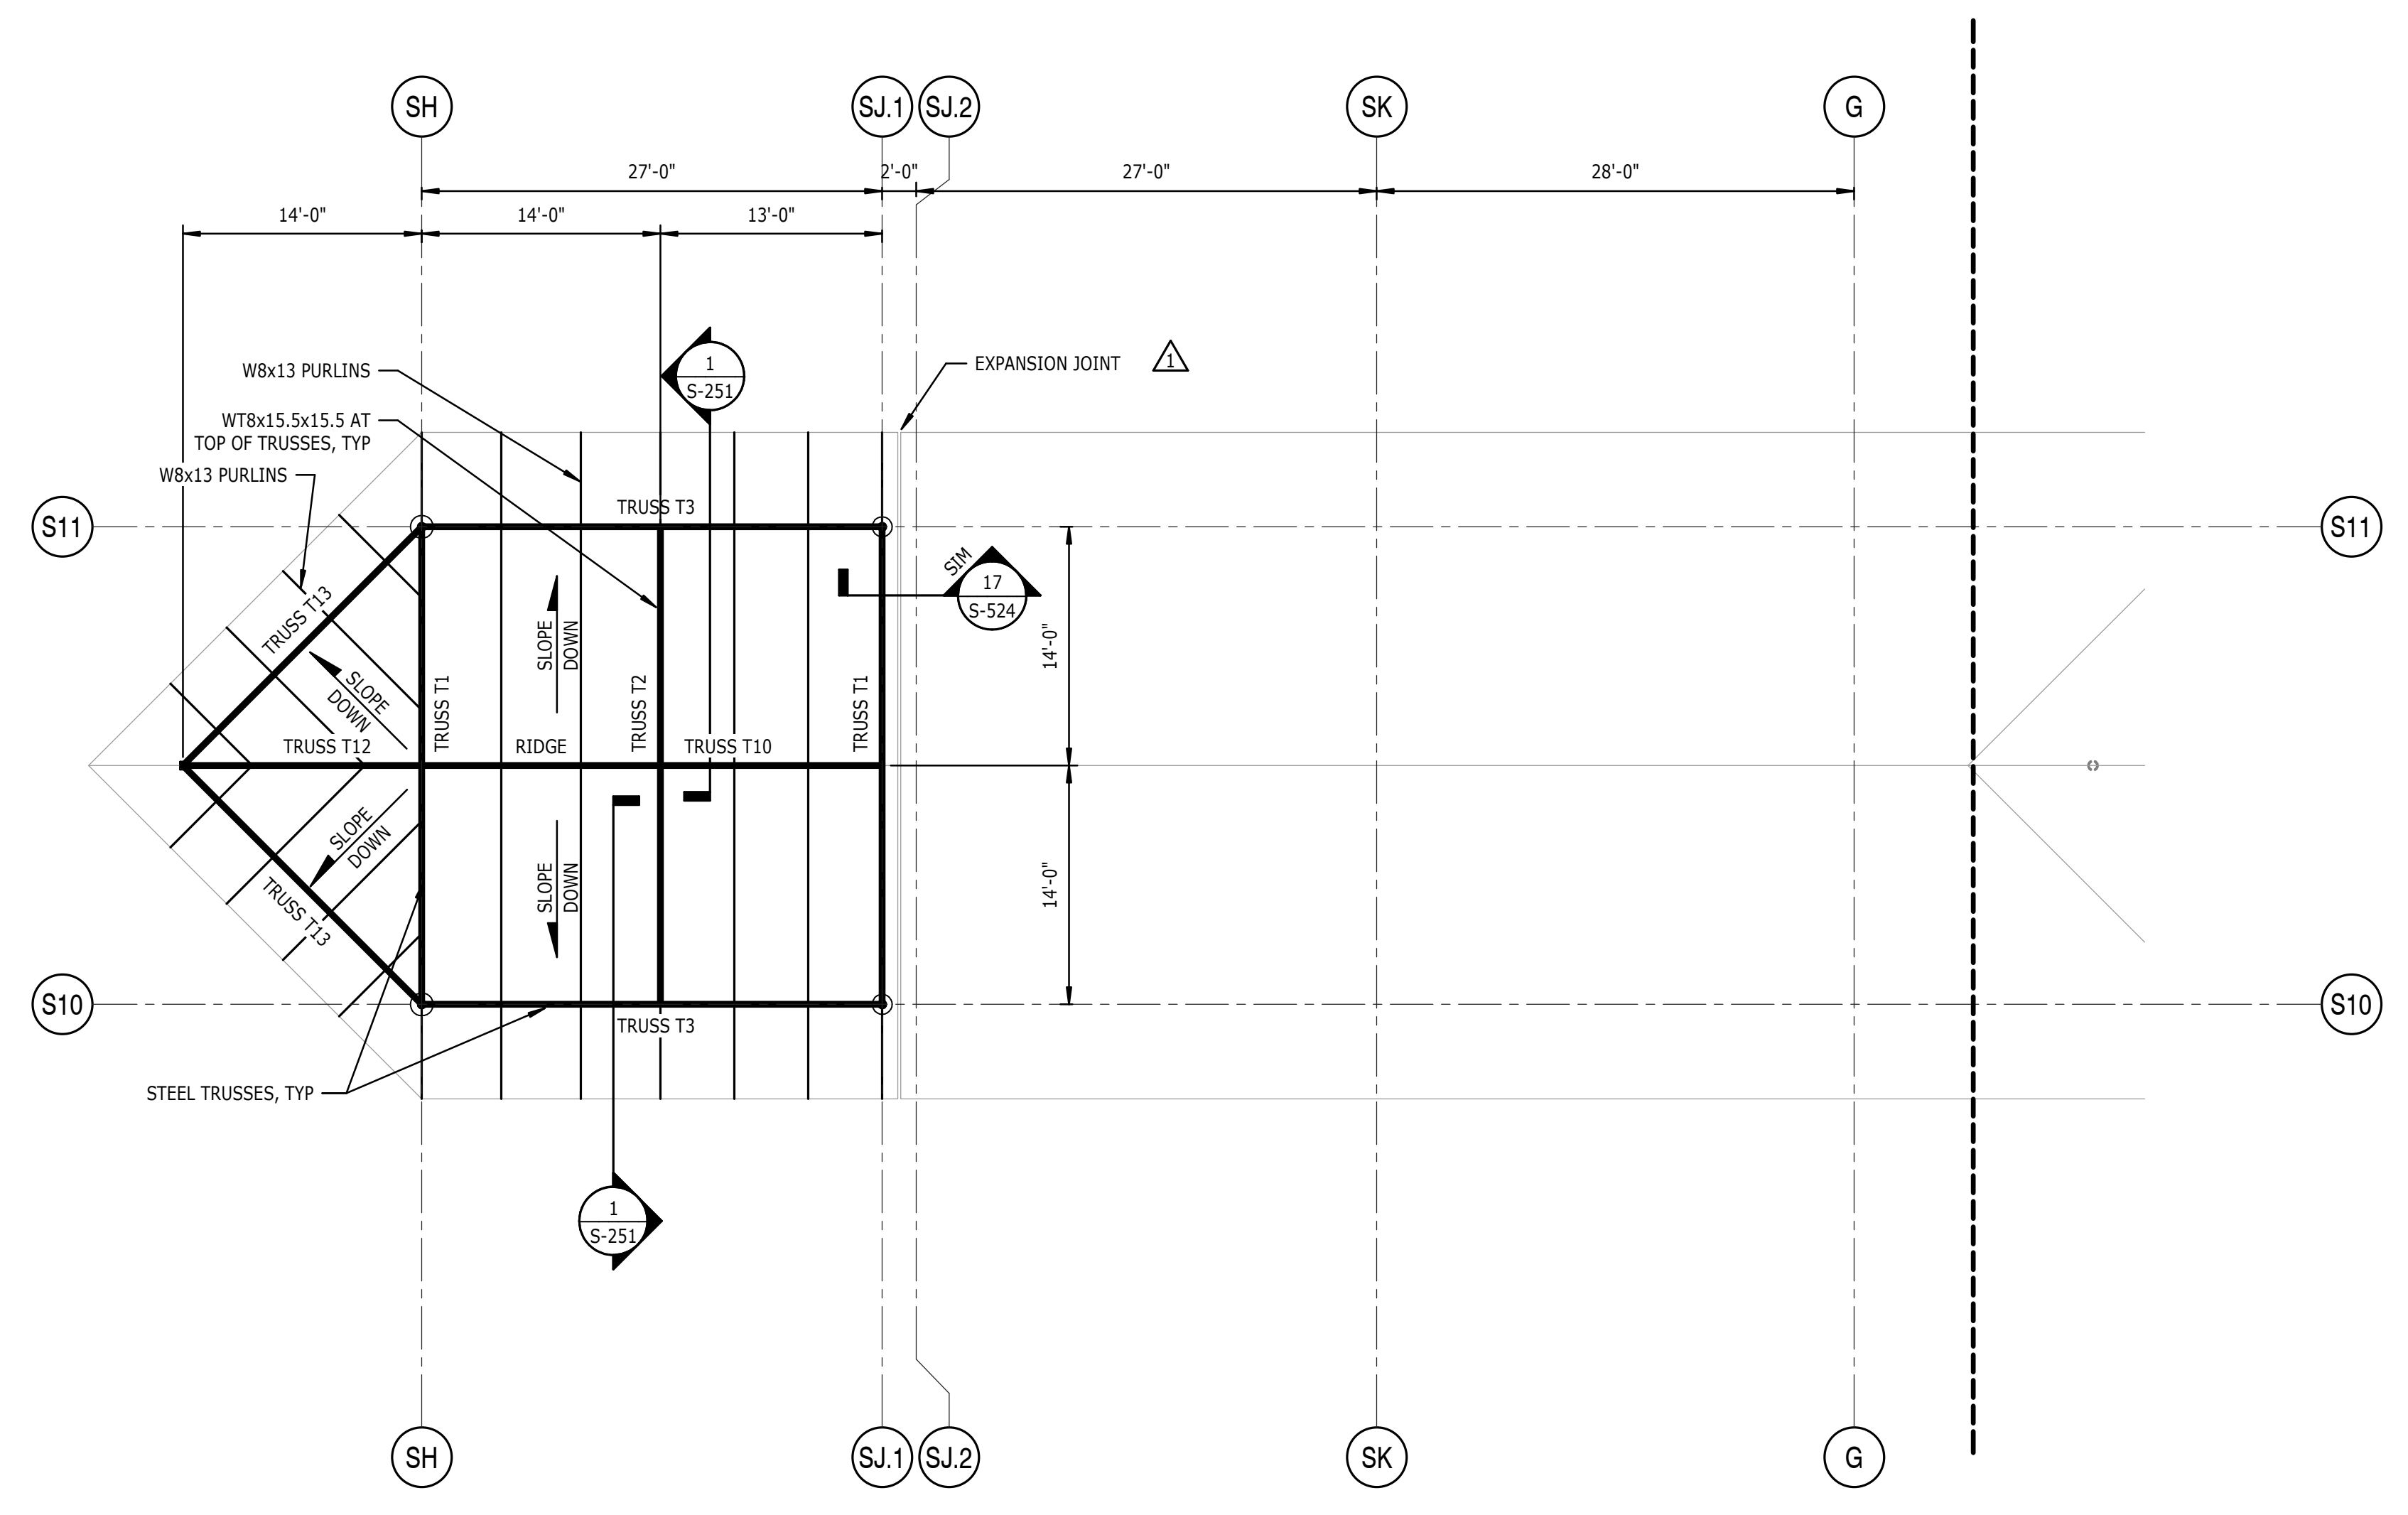

1 HIGH ROOF FRAMING PLAN SCHEDULE 2 ZONE 1


S2-141 1/8" = 1'-0"

- NOTES:
- FOR GENERAL NOTES AND ABBREVIATIONS, SEE S-001.
  - (No) INDICATES TOP OF STEEL ELEVATION ABOVE REFERENCED FINISH FLOOR ELEVATION.
  - DL INDICATES STEEL DECK SPAN DIRECTION. CONSTRUCTION SHALL BE 1 1/2" 18GA METAL DECK. SEE 1/S-521 FOR TYPICAL ROOF CONSTRUCTION DETAIL.
  - INDICATES MOMENT CONNECTION, SEE 19/S-511 FOR SCHEDULE.
  - SEE ELEVATIONS ON PLAN FOR VERTICAL FRAME LOCATIONS AND S-211 FOR ELEVATIONS AND DETAILS.
  - FOR TYPICAL ROOF FRAMING DETAILS, SEE S-521.
  - FOR STEEL COLUMN SCHEDULE, SEE 1/S-501.
  - "B" INDICATES BOTTOM FLANGE BEAM BRACING REQUIRED. BRACING SHALL BE PER DETAIL 19/S522. IF BRACING IS NOTED AT EXPANSION JOINTS, INSTALL BRACING ONLY ON ONE SIDE.
  - "C" INDICATES BOTTOM CHORD EXTENSION REQUIRED.
  - "A=#" INDICATES FACTORED AXIAL FORCE IN COLLECTOR BEAM TO BE USED IN CONNECTION DESIGN.
  - "B/DECK (+#-#)" INDICATES BOTTOM OF DECK ELEVATION FROM REFERENCED FINISH FLOOR ELEVATION.
  - "TRUSS T#" INDICATES TRUSS TYPE. SEE S200 SERIES FOR ELEVATIONS.
  - ALL EXPOSED STRUCTURAL STEEL (COLUMNS, ROOF TRUSSES, TRUSS BEARING & ETC) SHALL BE CONSIDERED AESS.
  - D2 INDICATES STEEL DECK SPAN DIRECTION. CONSTRUCTION SHALL BE 1 1/2" 18GA METAL DECK. SEE 1/S-521 FOR TYPICAL ROOF CONSTRUCTION DETAIL.
  - "#k#-r" DENOTES FACTORED MOMENT TO BE USED IN DESIGN OF MOMENT CONNECTIONS.



TERMINAL IMPROVEMENTS CONTRACT 3

Wilmington International Airport  
1740 Airport Boulevard, Suite 12  
Wilmington, NC 28405

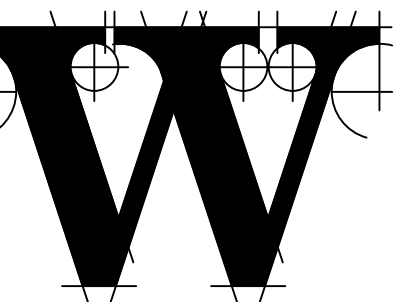

THE WILSON GROUP ARCHITECTS

PO Box 5510 Charlotte, NC 28299  
704-331-9747 • www.twgarchitects.com

PROJECT MANAGER & CIVIL ENGINEER  
**TALBERT & BRIGHT**  
CONSULTING ARCHITECT  
LS3P

STRUCTURAL ENGINEER  
FIRM LICENSE #C-1051  
**STEWART**

FPI/PME ENGINEER  
**CHEATHAM & ASSOC.**

BAGGAGE HANDLING CONSULTANTS  
**BNP**

AIRCRAFT SUPPORT SYSTEMS  
**DK CONSULTANTS**

SPECIALTY LIGHTING CONSULTANT  
**HARTRANFT**

SINGAGE & WAYFINDING  
**TAKEFORM**

COPYRIGHT © 2019  
THE WILSON GROUP ARCHITECTS  
ALL RIGHTS RESERVED

PRINTED OR ELECTRONIC DRAWINGS AND  
DOCUMENTATION MAY NOT BE REPRODUCED  
IN ANY FORM WITHOUT WRITTEN PERMISSION  
FROM THE WILSON GROUP ARCHITECTS

REVISIONS


- 1 7/12/19 AD-01
- 3 7/30/19 AD-03

DATE 06/28/2019  
PROJECT NUMBER 9202-000  
SHEET TITLE

STRUCTURAL WALL SECTIONS

SHEET NUMBER



S-251

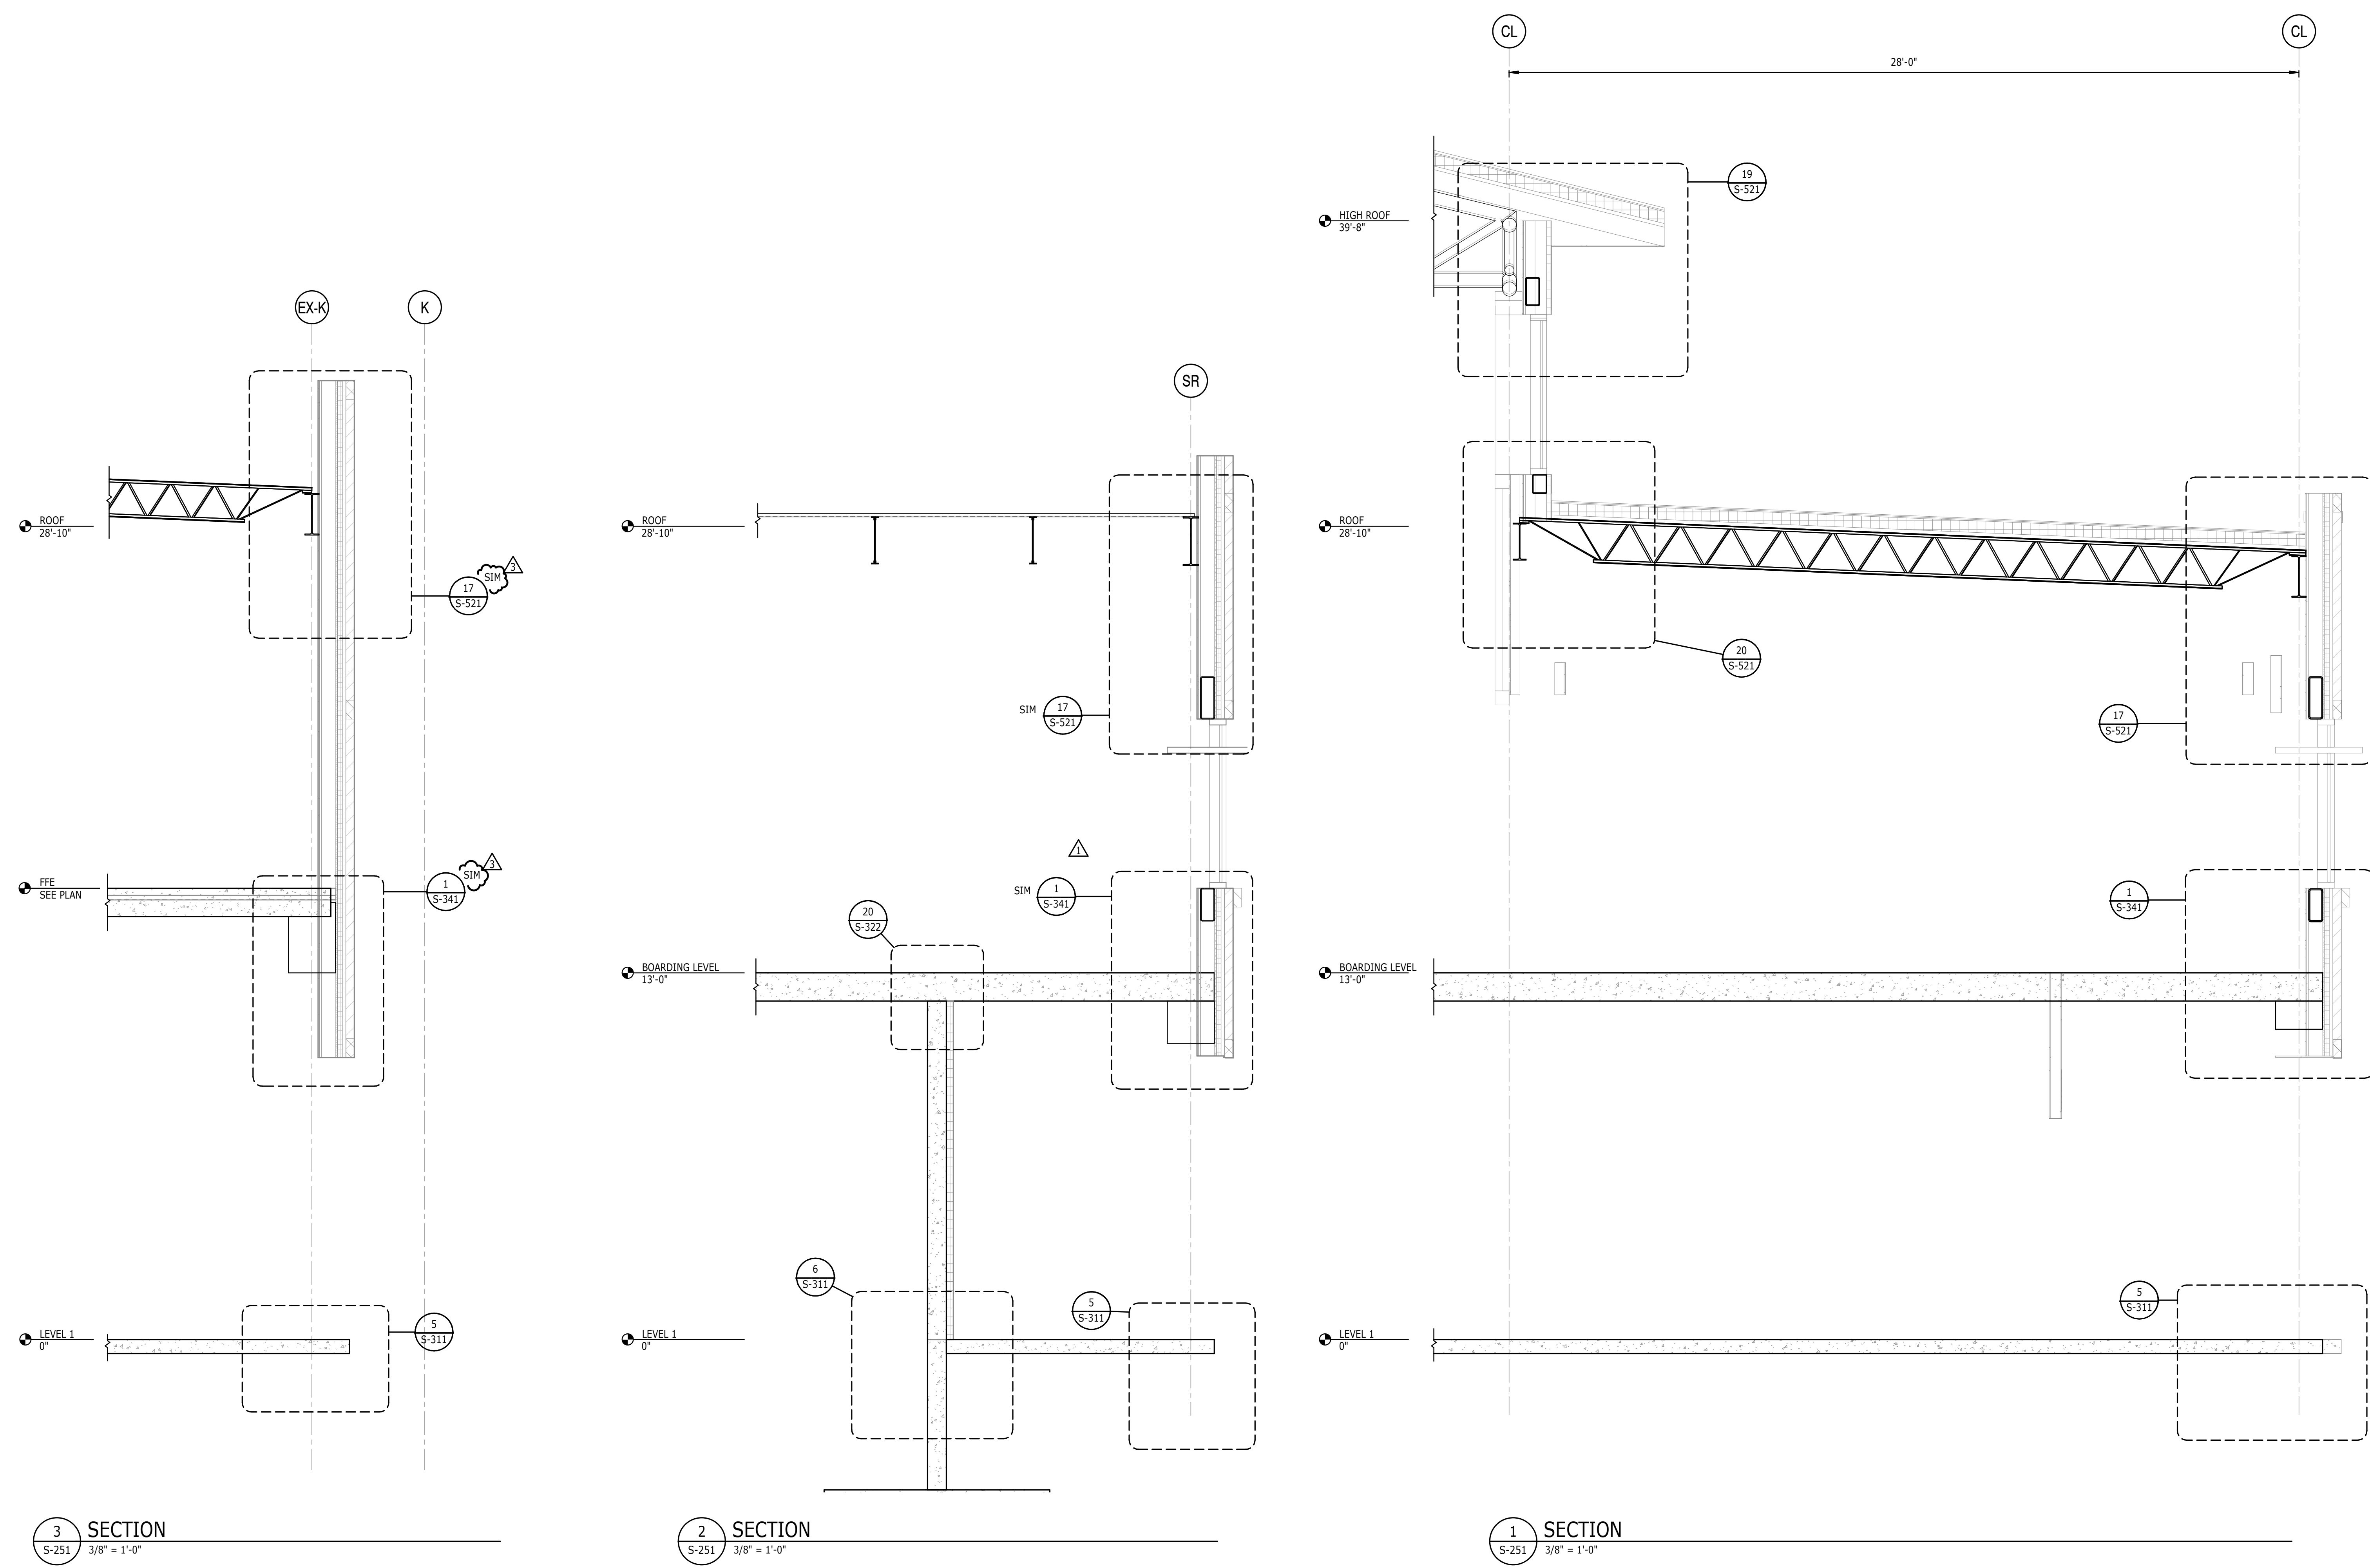

3 SECTION  
S-251 3/8" = 1'-0"

2 SECTION  
S-251 3/8" = 1'-0"

1 SECTION  
S-251 3/8" = 1'-0"

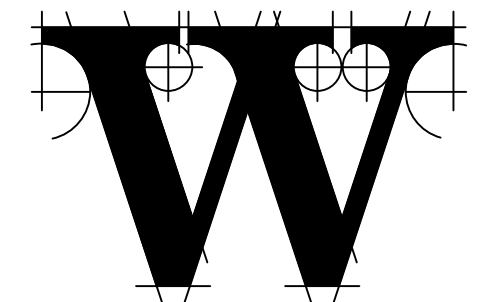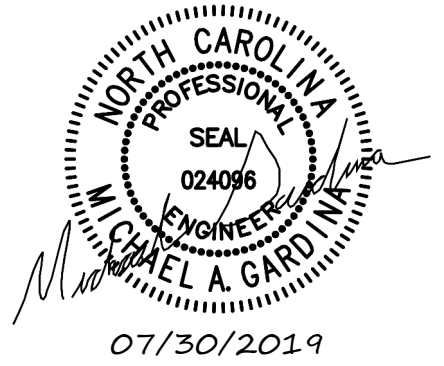

THE WILSON GROUP ARCHITECTS

PO Box 5510 Charlotte, NC 28299  
704-331-9747 • www.twgarchitects.com

PROJECT MANAGER & CIVIL ENGINEER

TALBERT & BRIGHT

CONSULTING ARCHITECT

LS3P

STRUCTURAL ENGINEER

FIRM LICENSE #C-1051

STEWART

FP/PM/E ENGINEER

CHEATHAM & ASSOC.

BAGGAGE HANDLING CONSULTANTS

BNP

AIRCRAFT SUPPORT SYSTEMS

DK CONSULTANTS

SPECIALTY LIGHTING CONSULTANT

HARTRANFT

SINGAGE & WAYFINDING

TAKEFORM

COPYRIGHT © 2019  
THE WILSON GROUP ARCHITECTS  
ALL RIGHTS RESERVED

PRINTED OR ELECTRONIC DRAWINGS AND DOCUMENTATION MAY NOT BE REPRODUCED IN ANY FORM WITHOUT WRITTEN PERMISSION FROM THE WILSON GROUP ARCHITECTS

REVISIONS


- 1 7/12/19 AD-01
- 3 7/30/19 AD-03

DATE 06/28/2019  
PROJECT NUMBER 9202-000  
SHEET TITLE


STRUCTURAL WALL SECTIONS

SHEET NUMBER


S-253

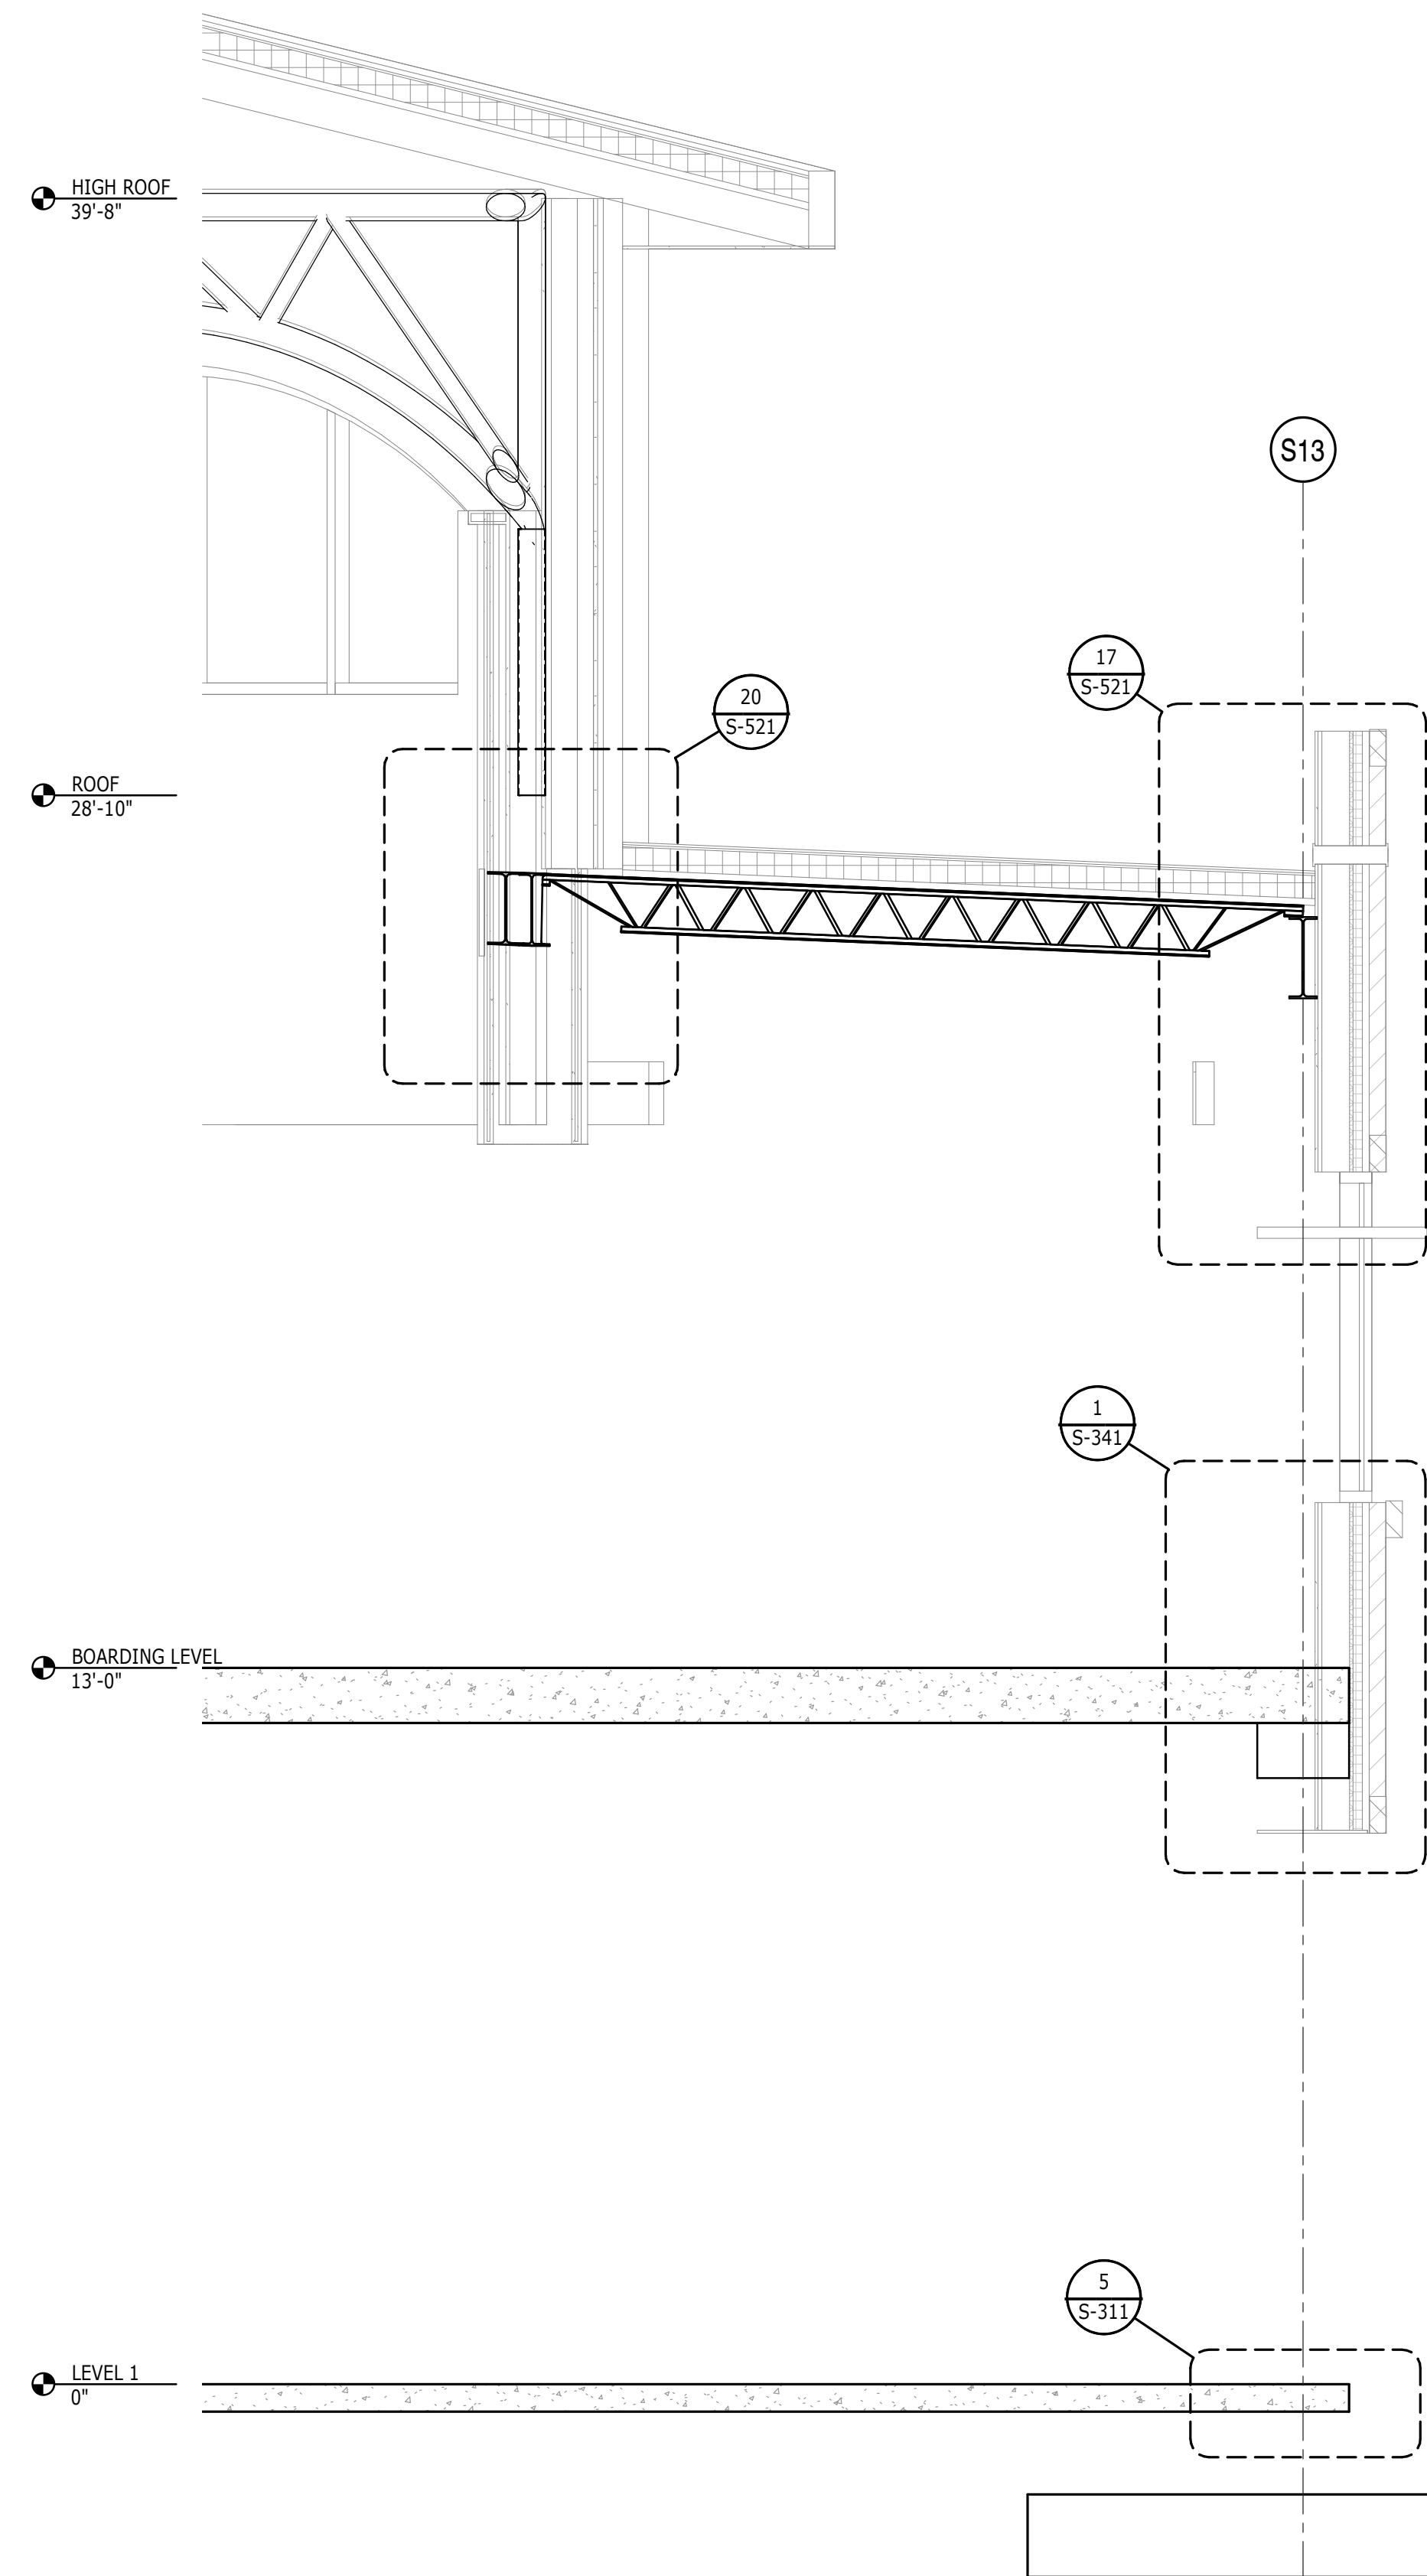


2 SECTION  
S-253 3/8" = 1'-0"

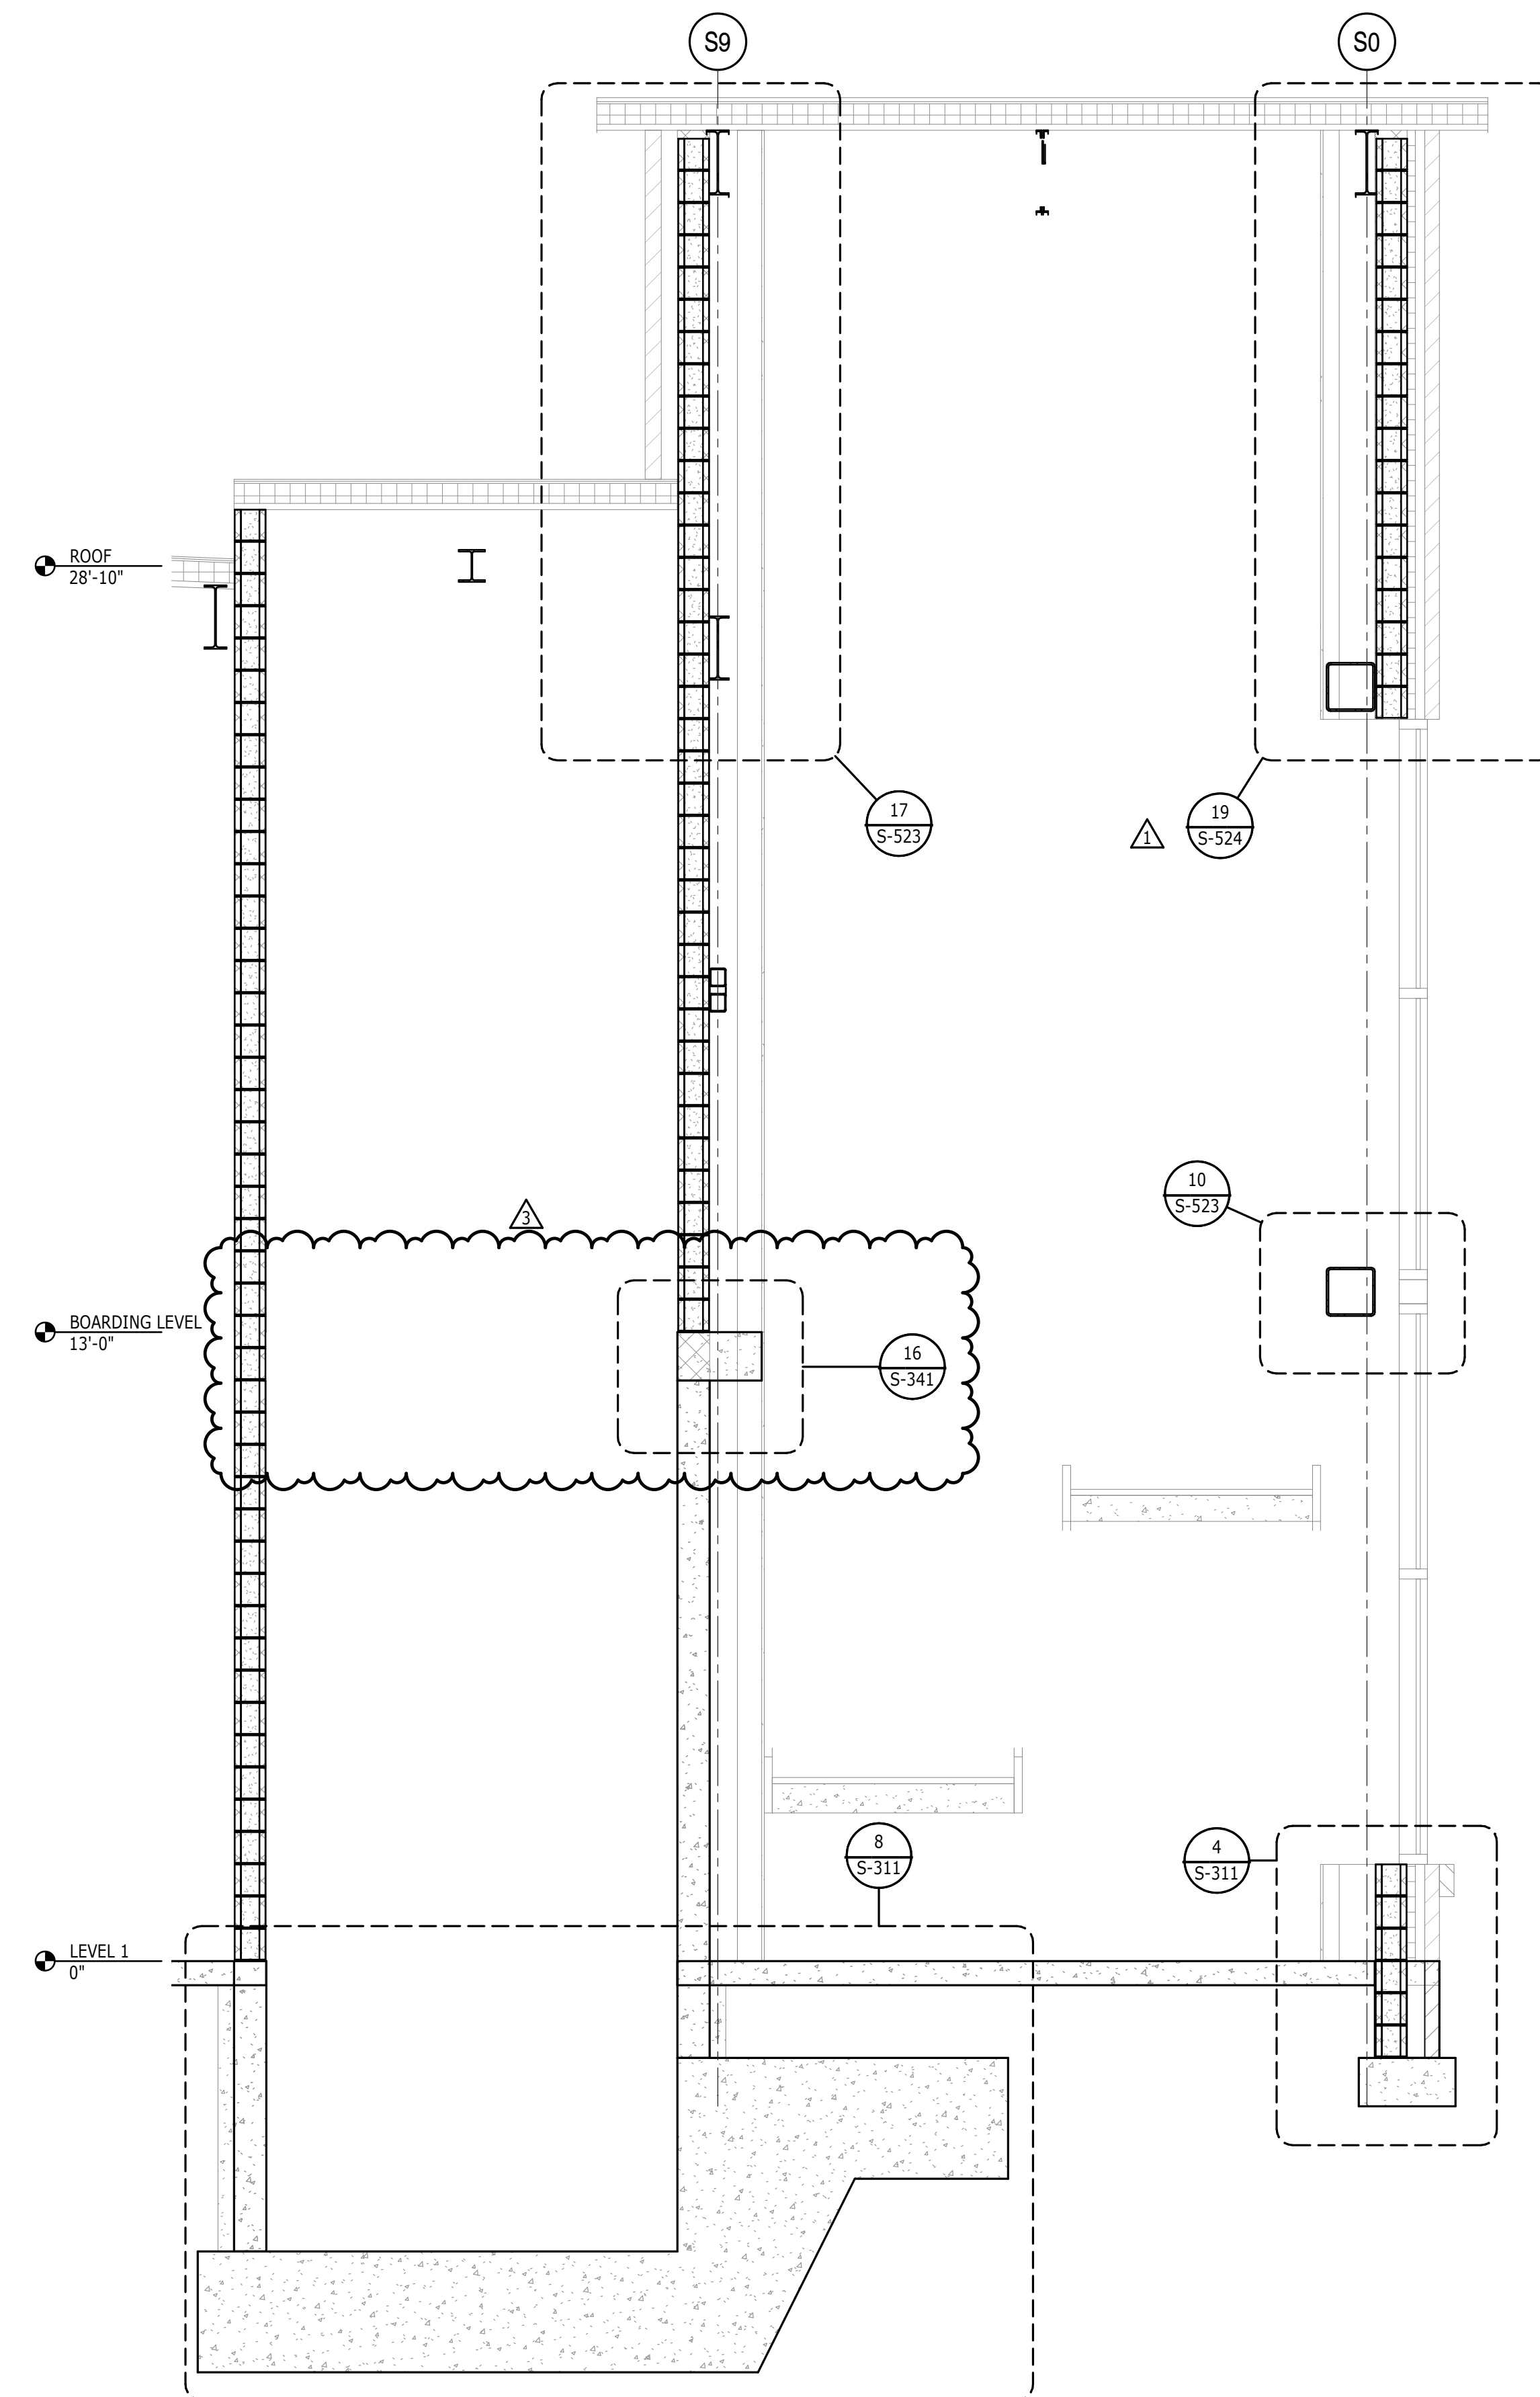


1 SECTION  
S-253 3/8" = 1'-0"

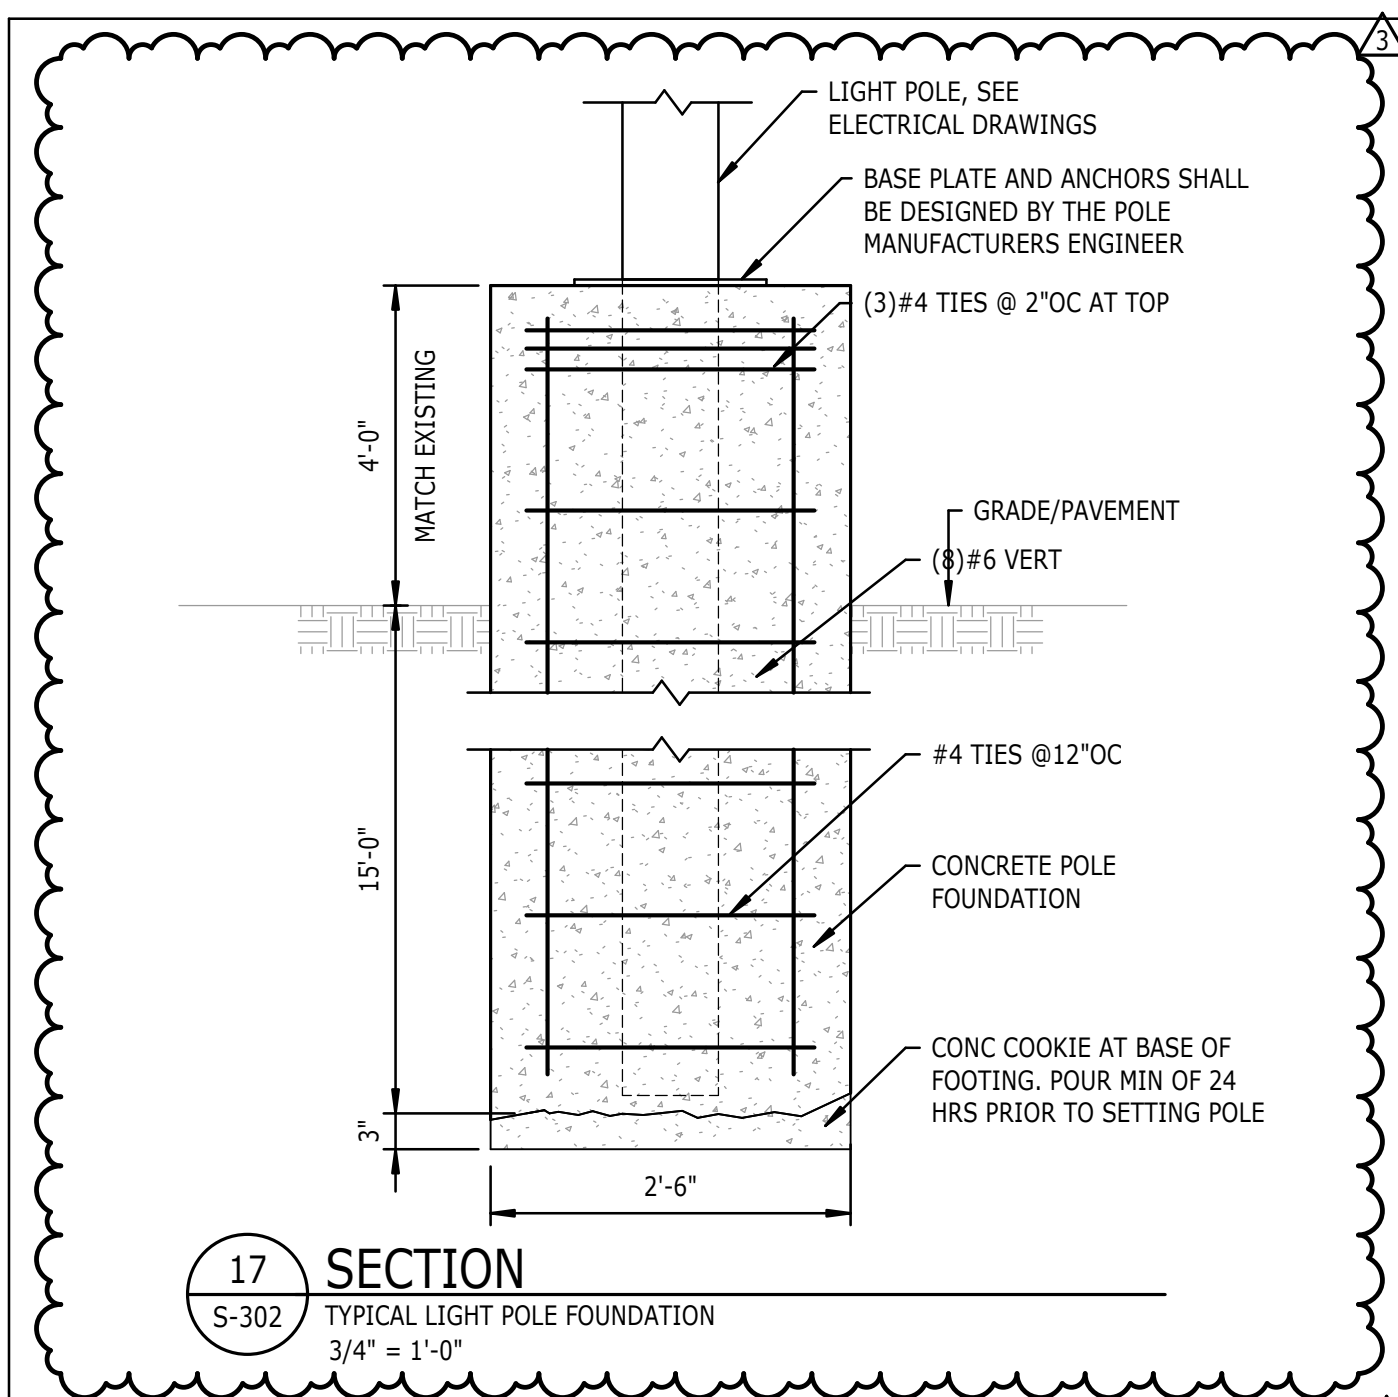


**17 SECTION**  
S-302  
TYPICAL LIGHT POLE FOUNDATION  
3/4" = 1'-0"

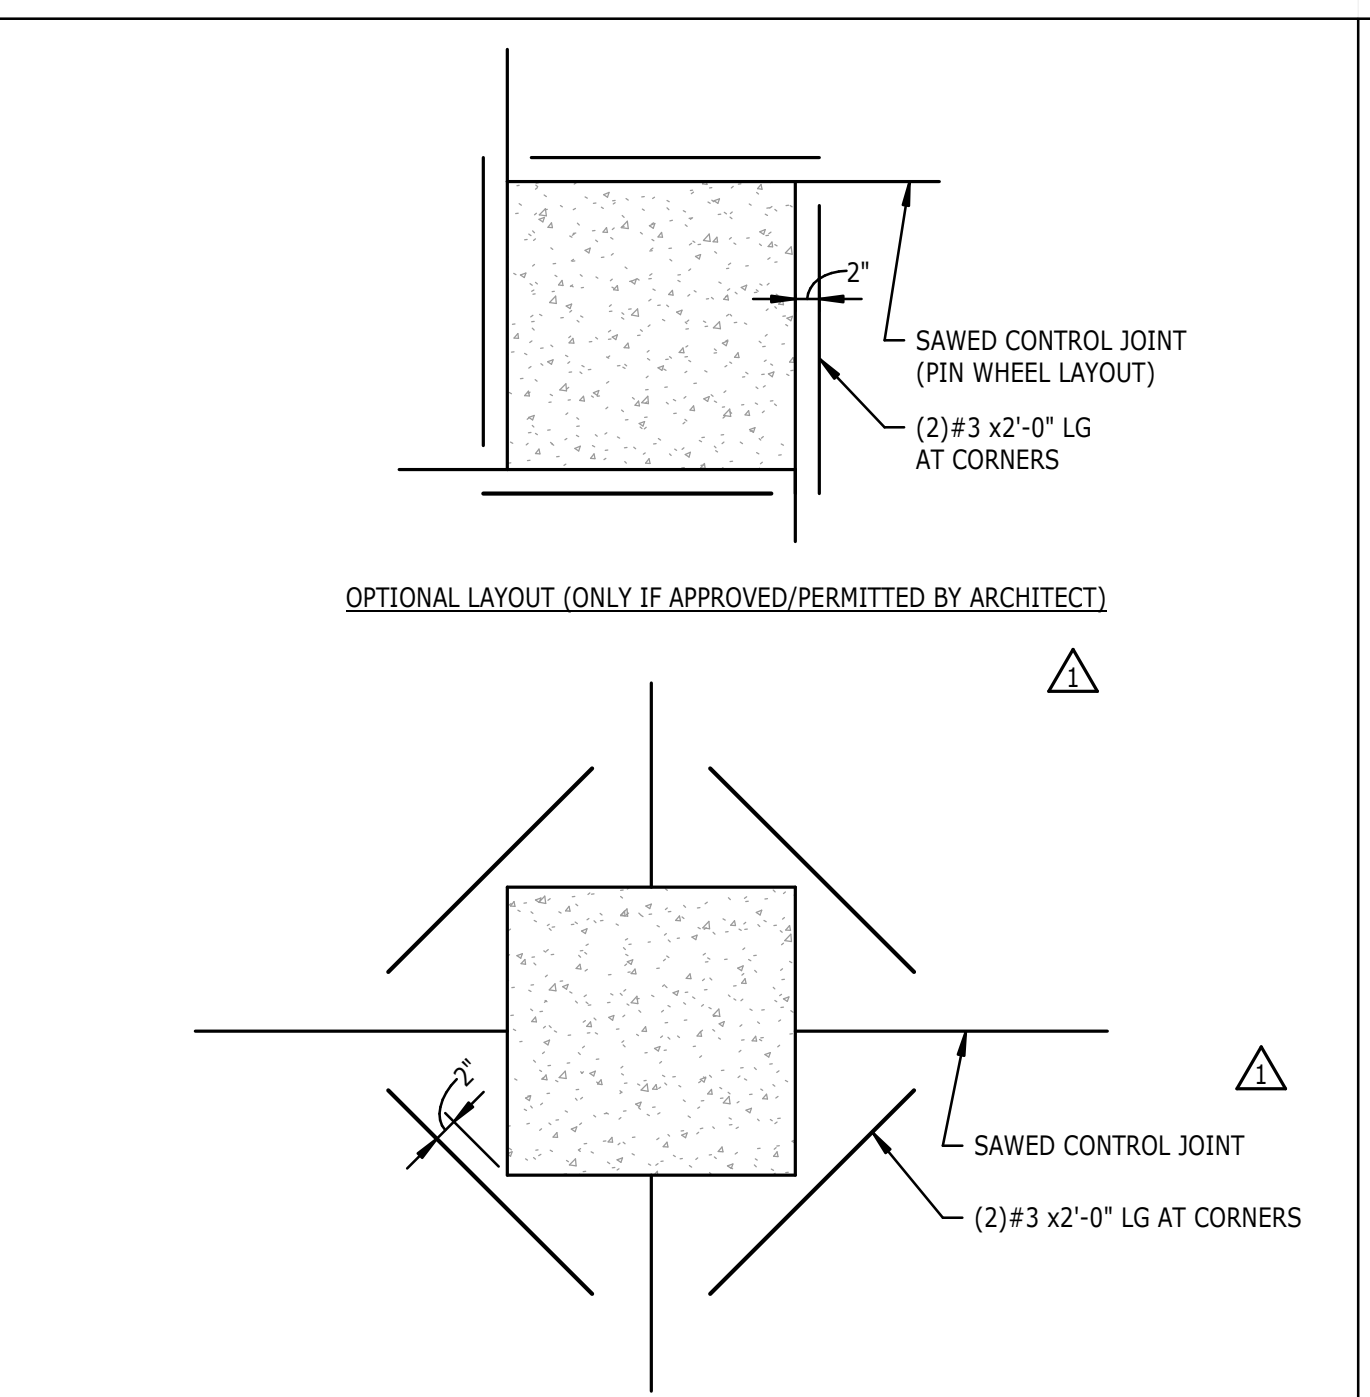


**9 DETAIL**  
S-302  
TYPICAL ELEVATED SLAB REINFORCING AT RE-ENTRANT CORNERS  
NTS

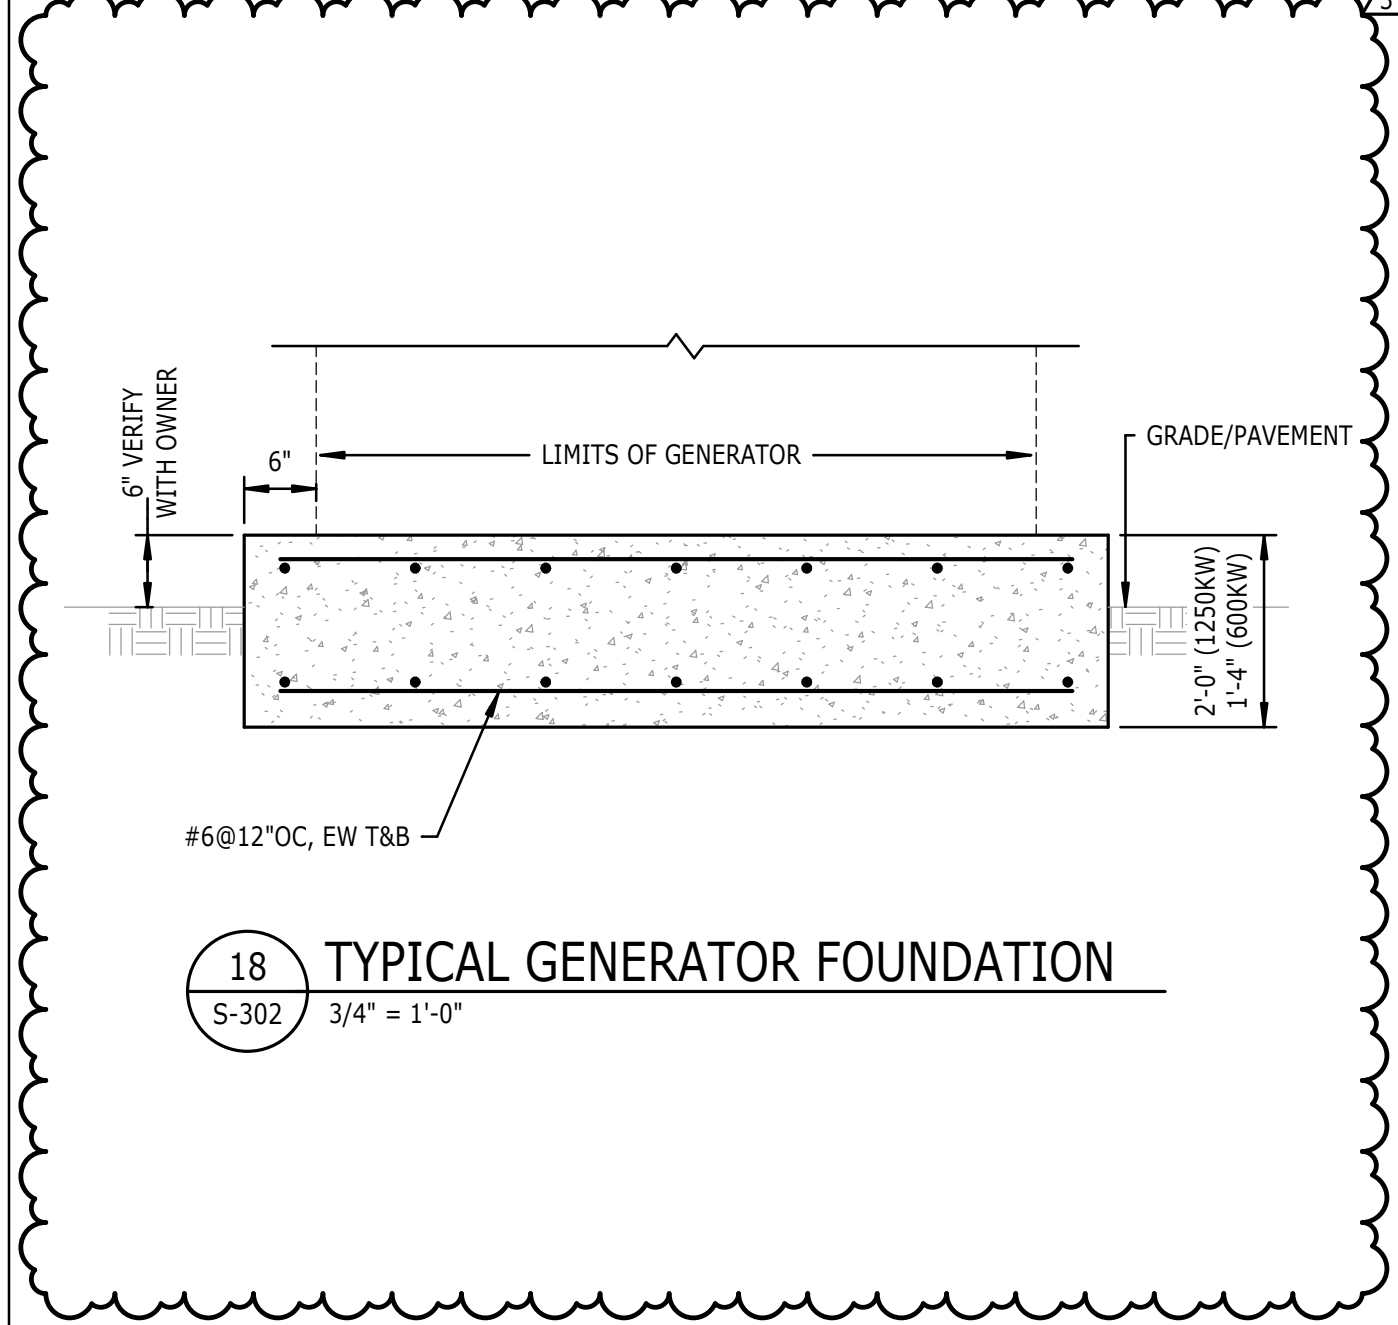


**18 TYPICAL GENERATOR FOUNDATION**  
S-302  
3/4" = 1'-0"

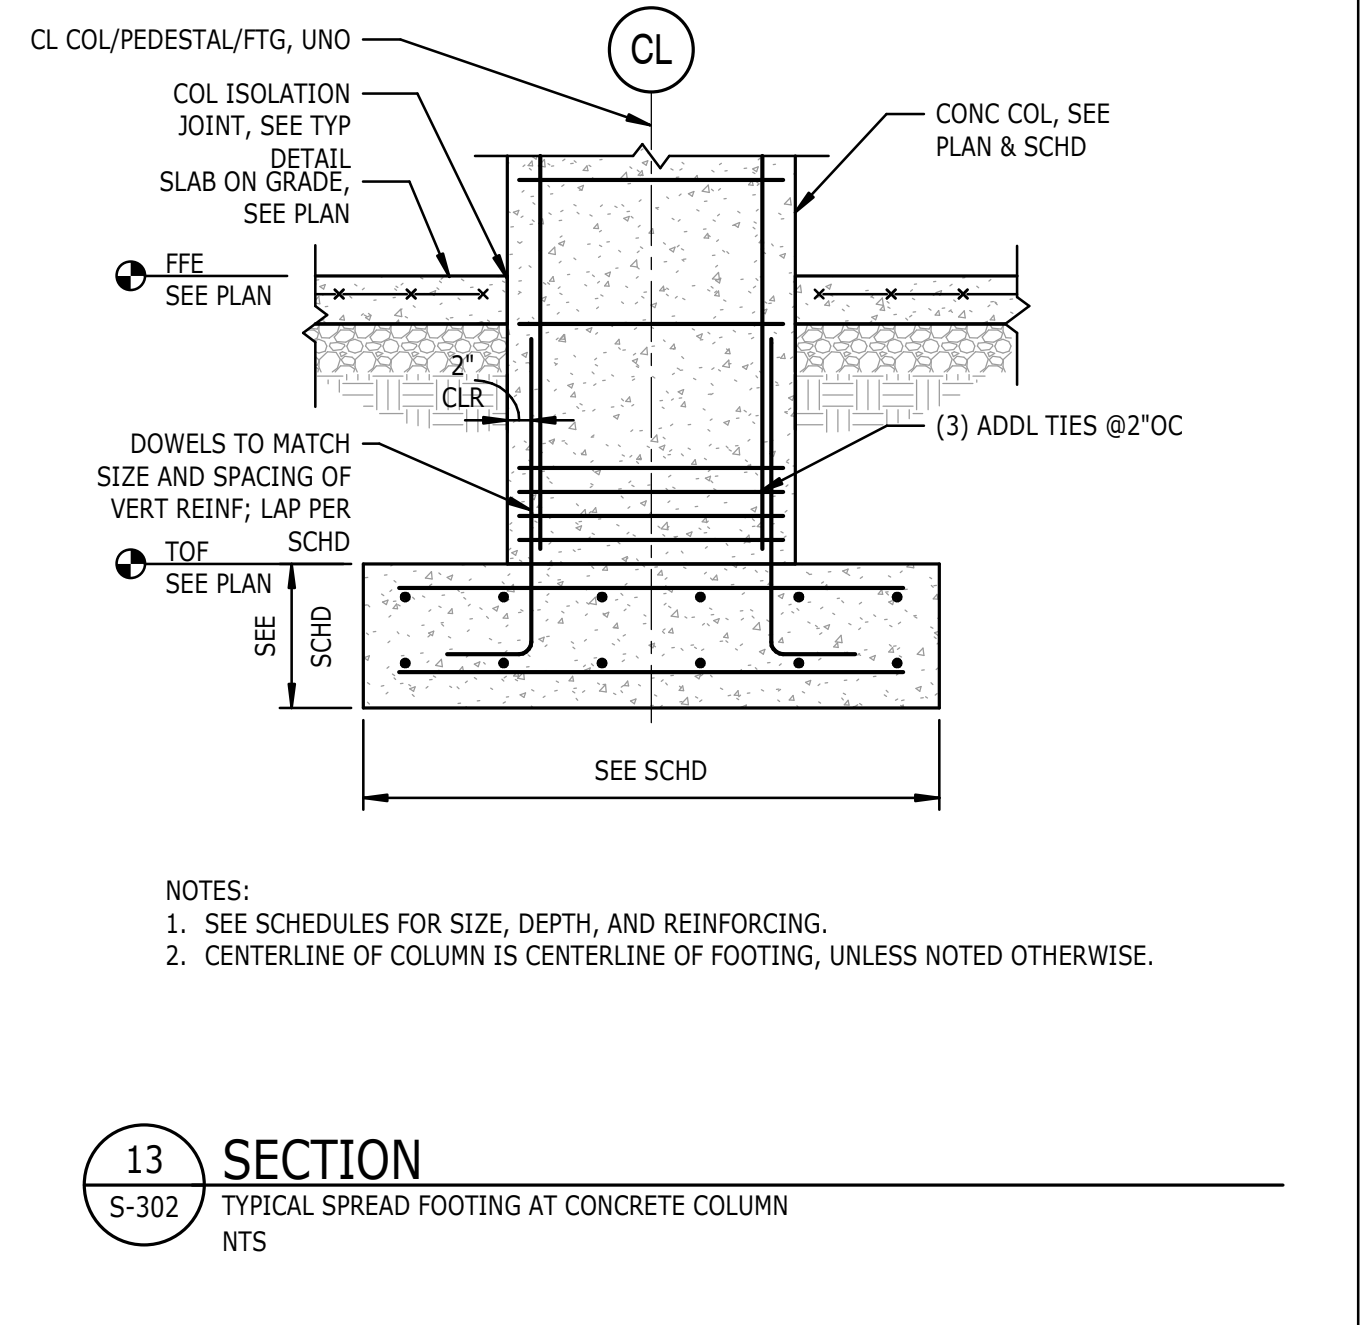


**13 SECTION**  
S-302  
TYPICAL SPREAD FOOTING AT CONCRETE COLUMN  
NTS

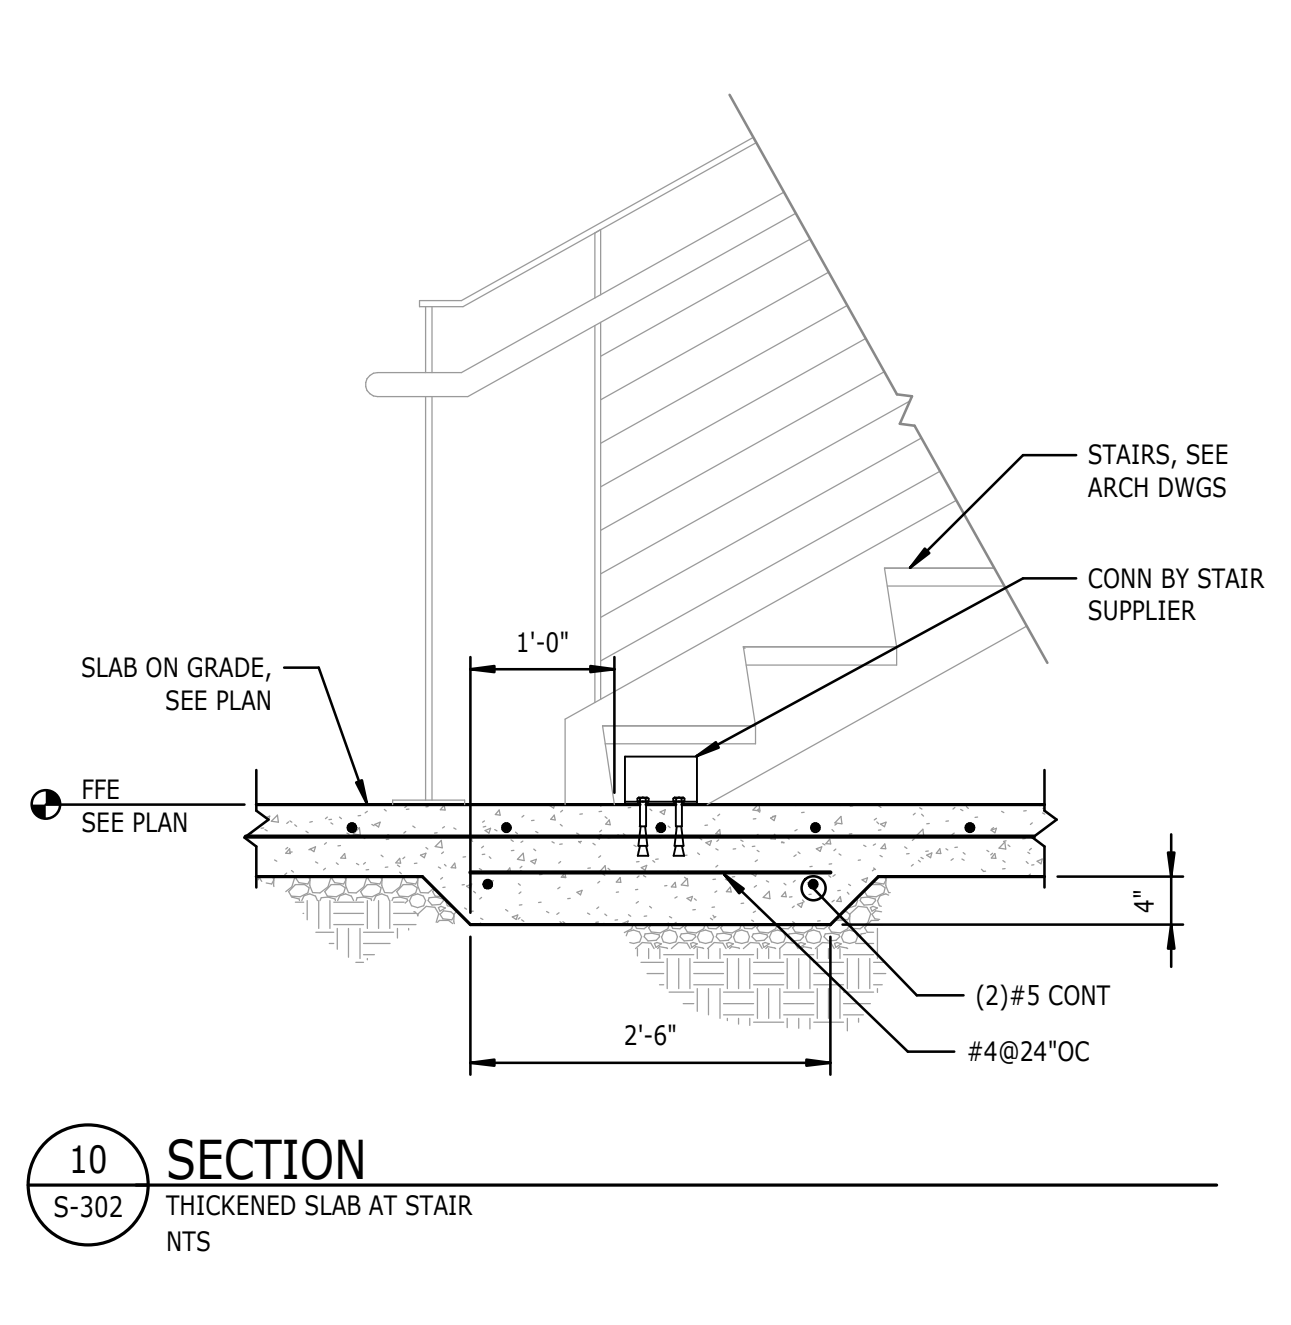


**10 SECTION**  
S-302  
THICKENED SLAB AT STAIR  
NTS

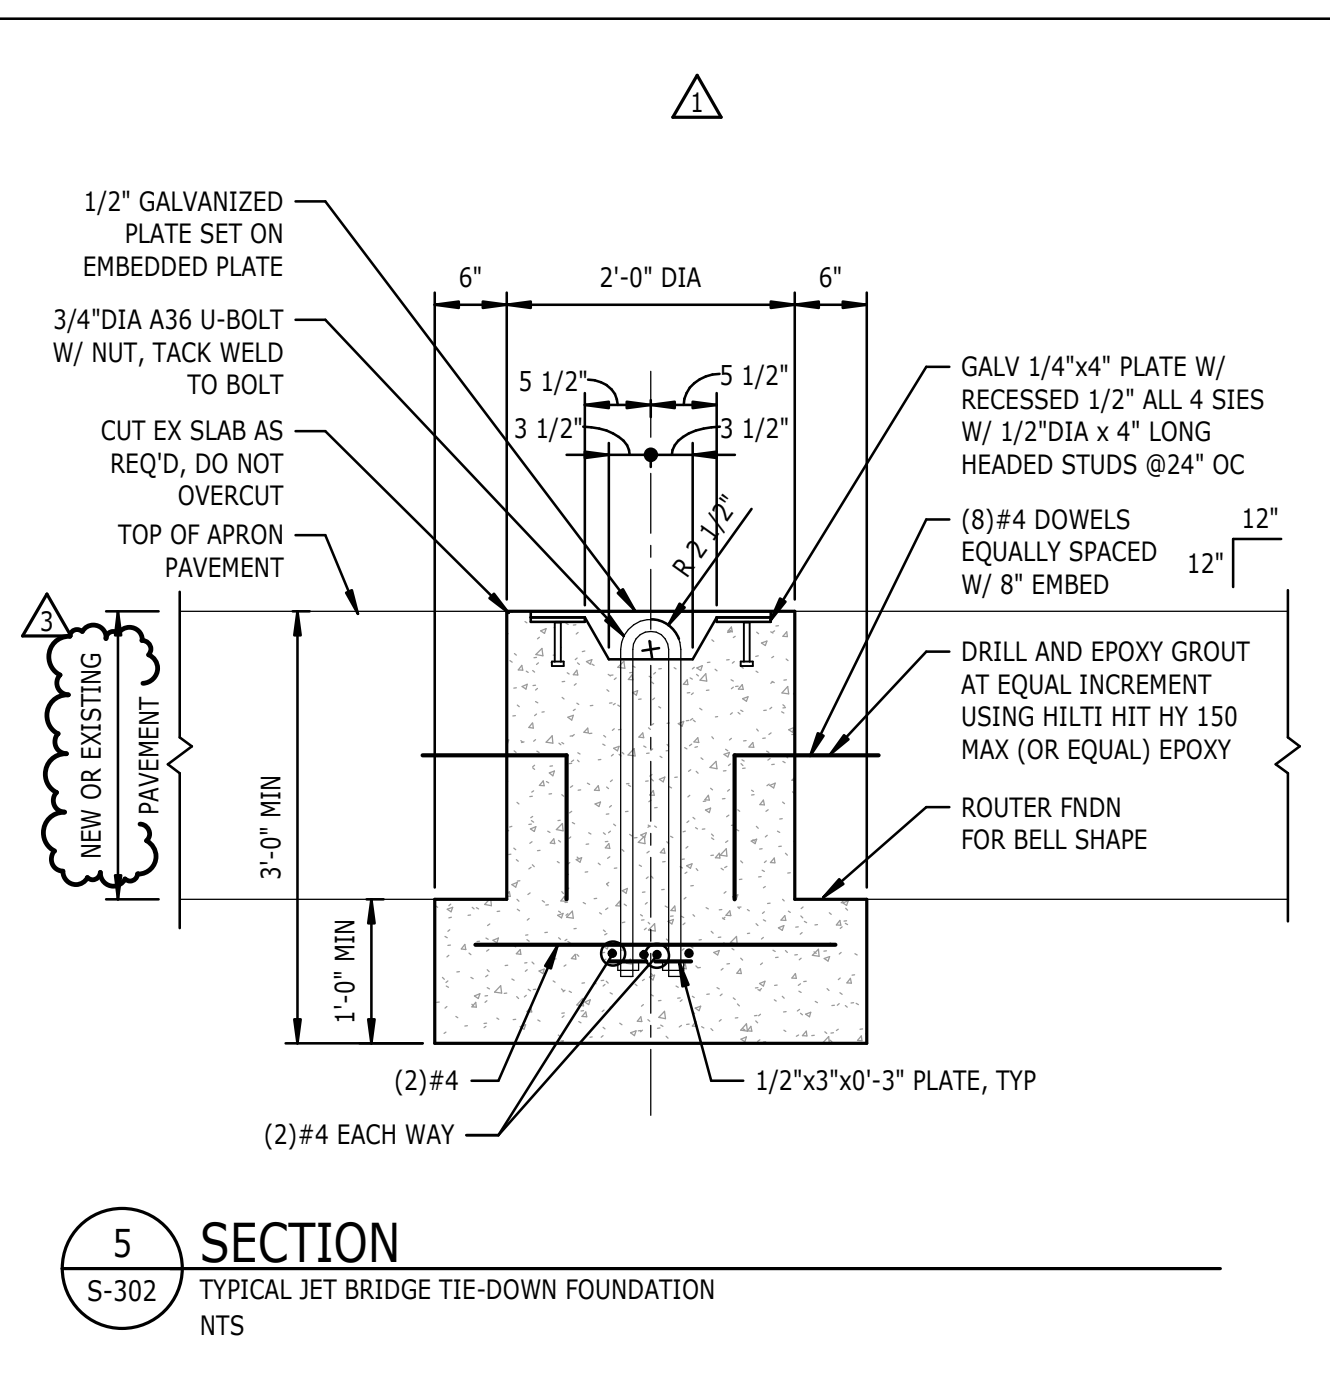


**5 SECTION**  
S-302  
TYPICAL JET BRIDGE TIE-DOWN FOUNDATION  
NTS

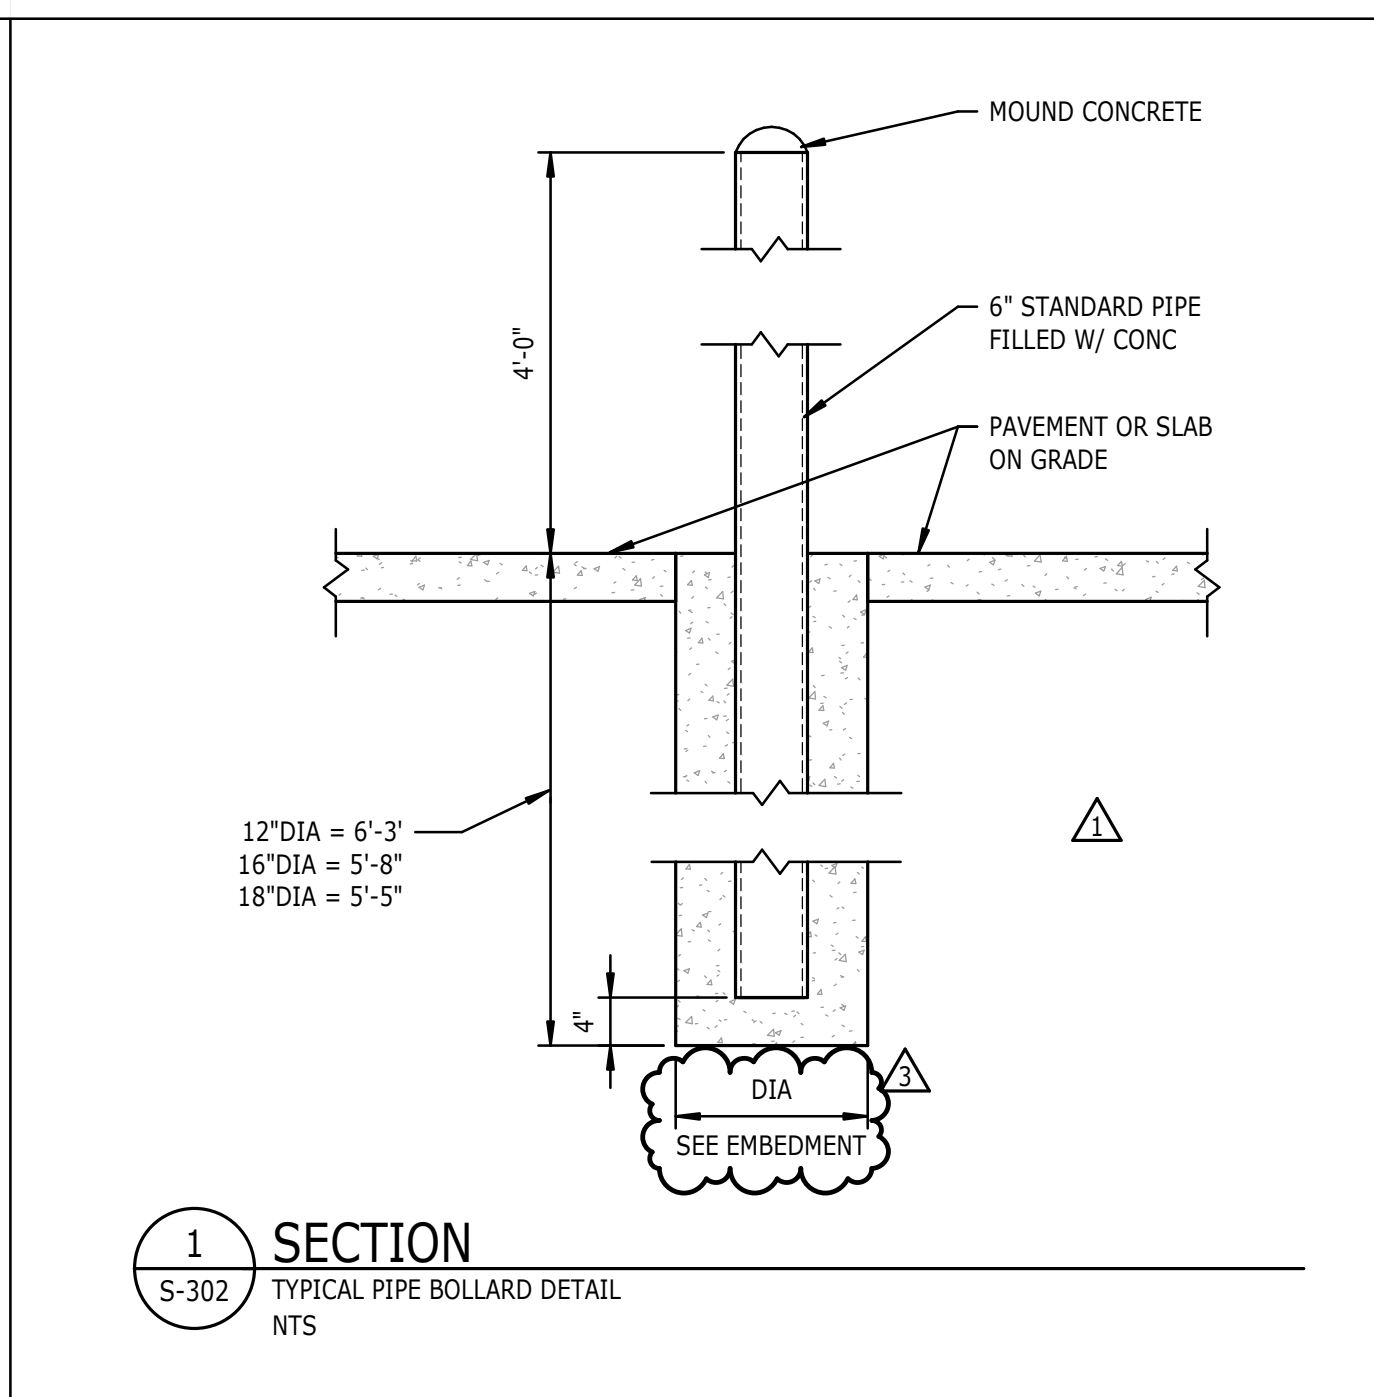


**1 SECTION**  
S-302  
TYPICAL PIPE BOLLARD DETAIL  
NTS

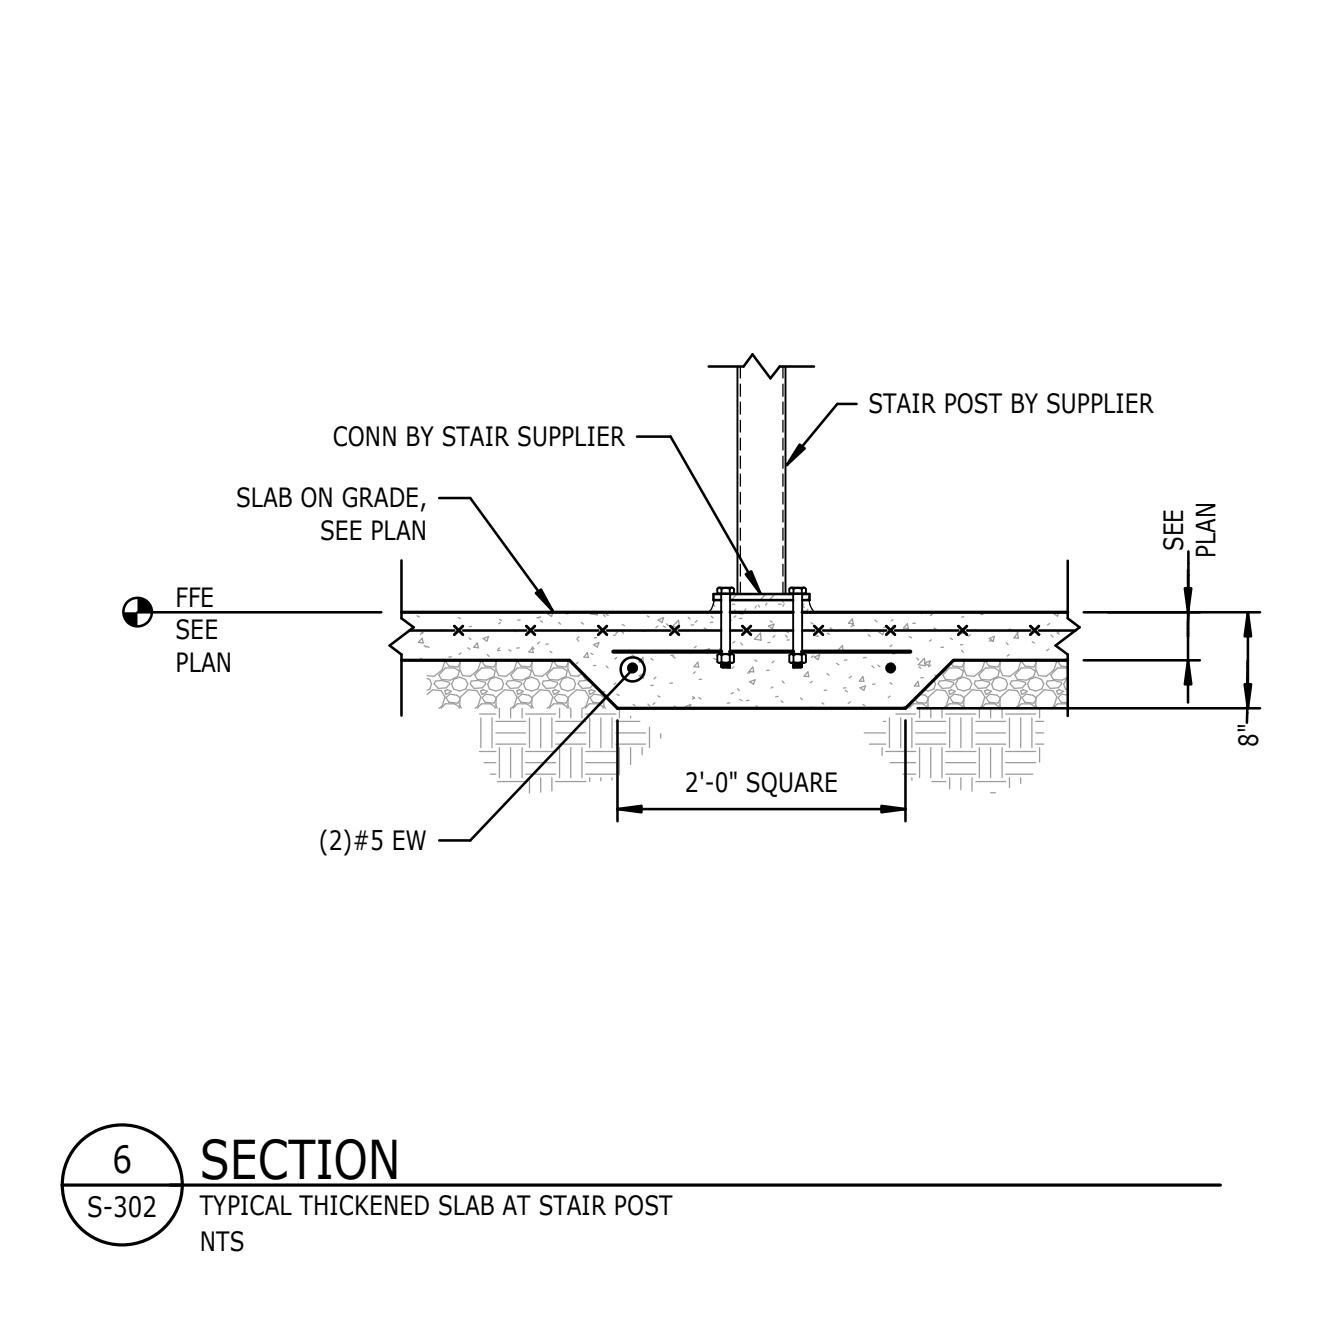


**6 SECTION**  
S-302  
TYPICAL THICKENED SLAB AT STAIR POST  
NTS

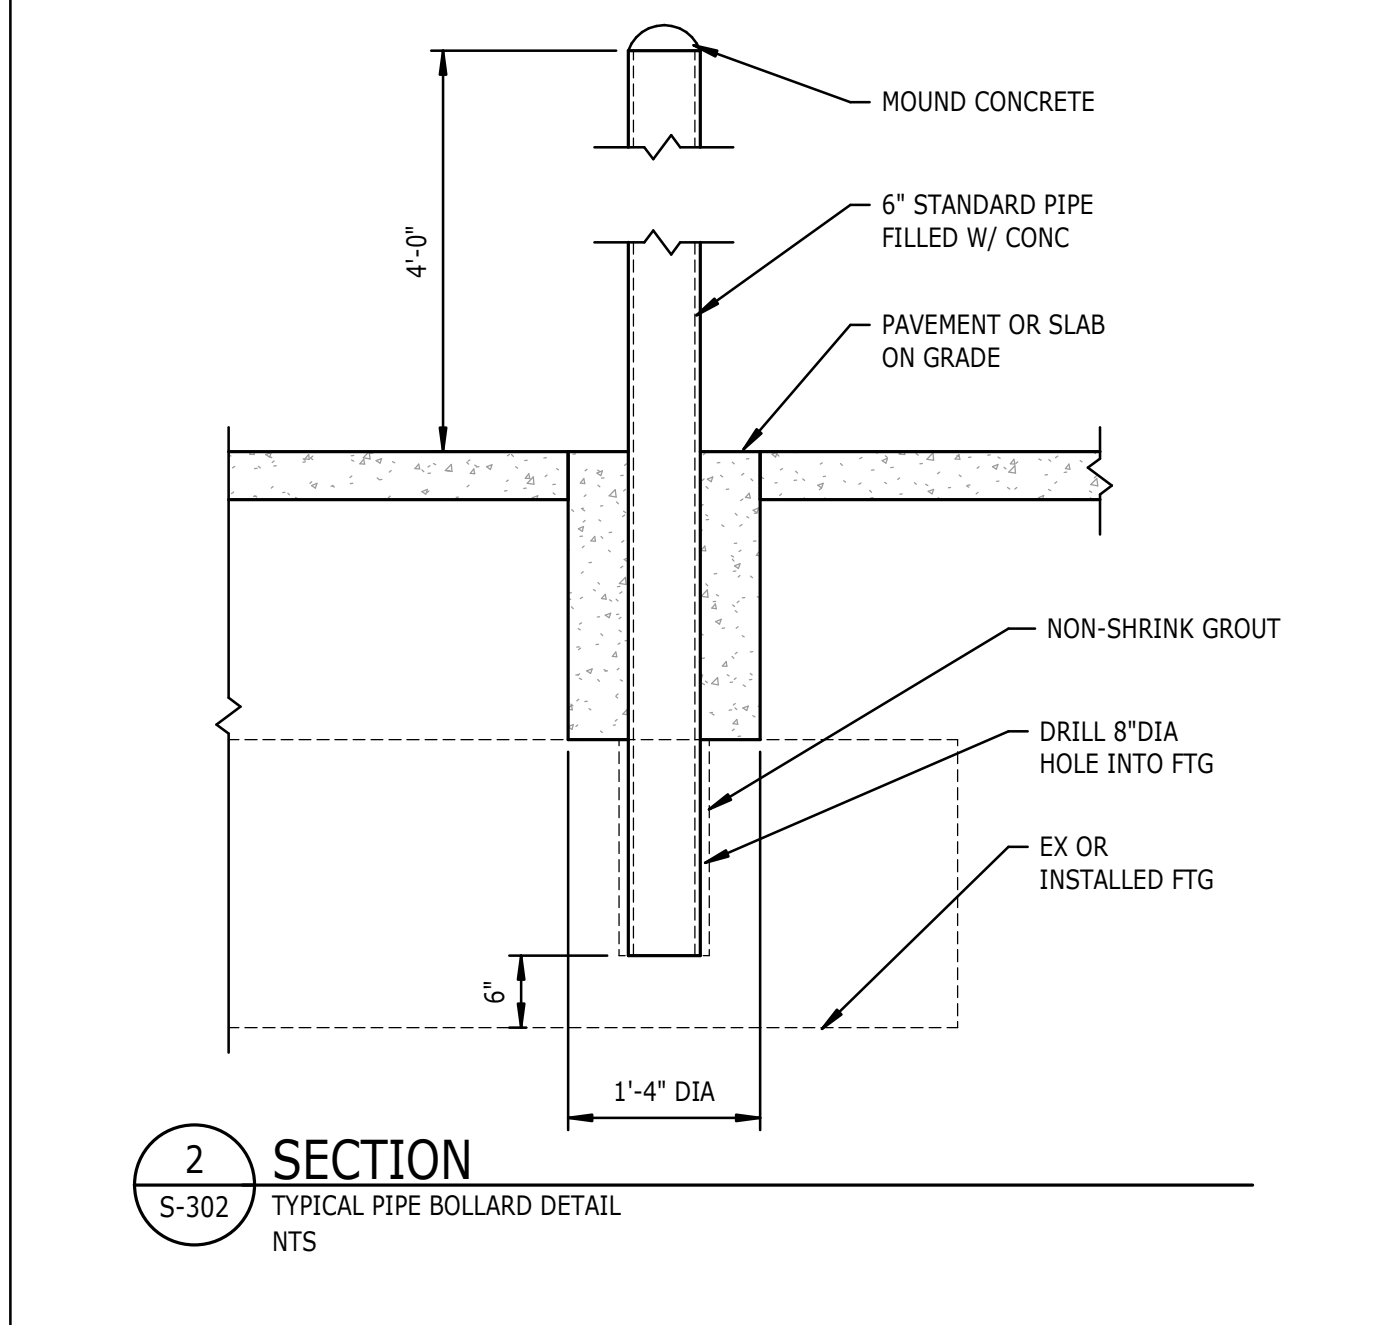


**2 SECTION**  
S-302  
TYPICAL PIPE BOLLARD DETAIL  
NTS

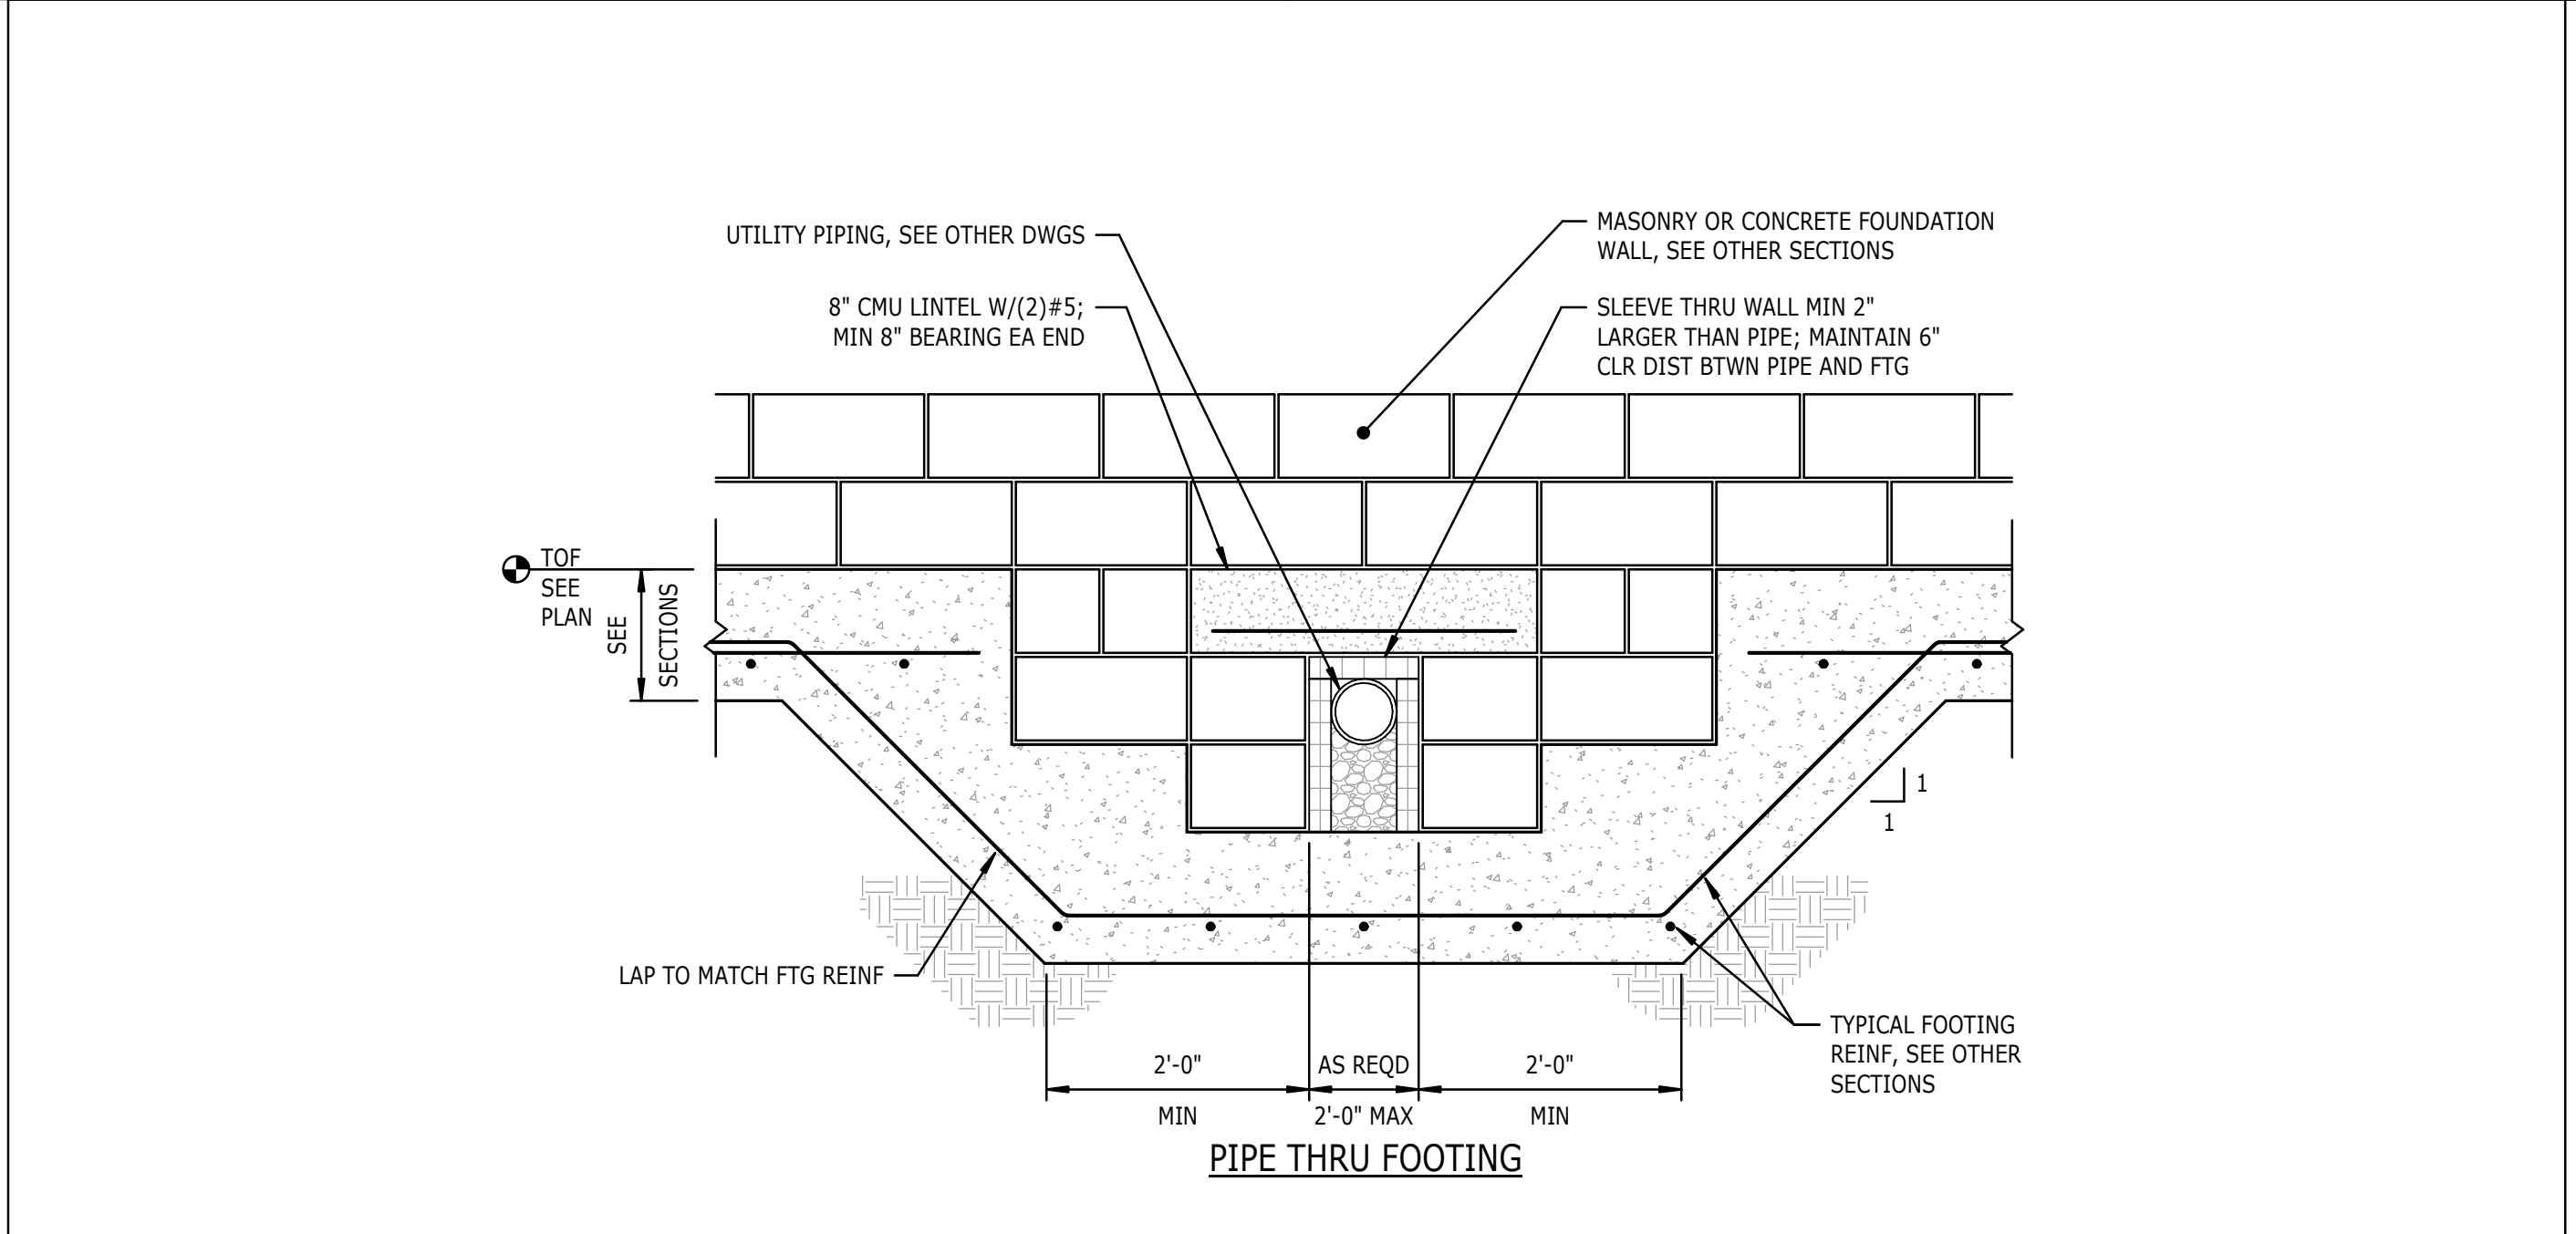


**15 SECTION**  
S-302  
TYPICAL UTILITY BELOW FOOTING  
NTS

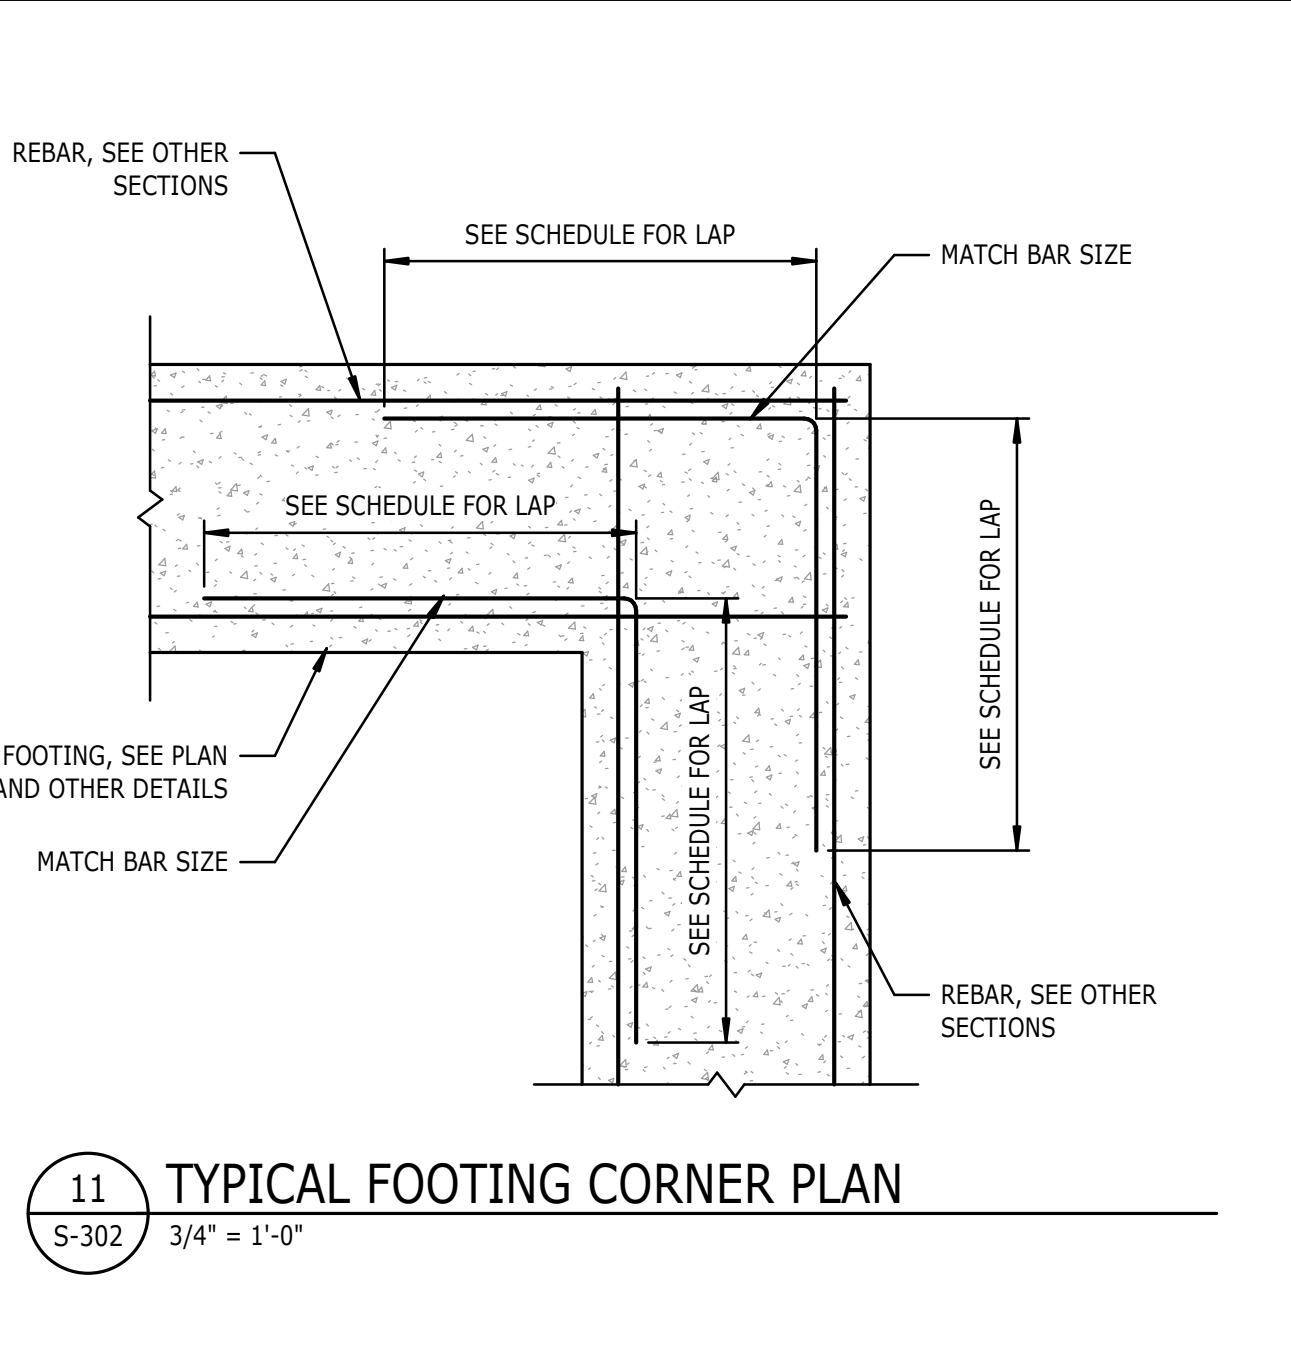


**11 TYPICAL FOOTING CORNER PLAN**  
S-302  
3/4" = 1'-0"

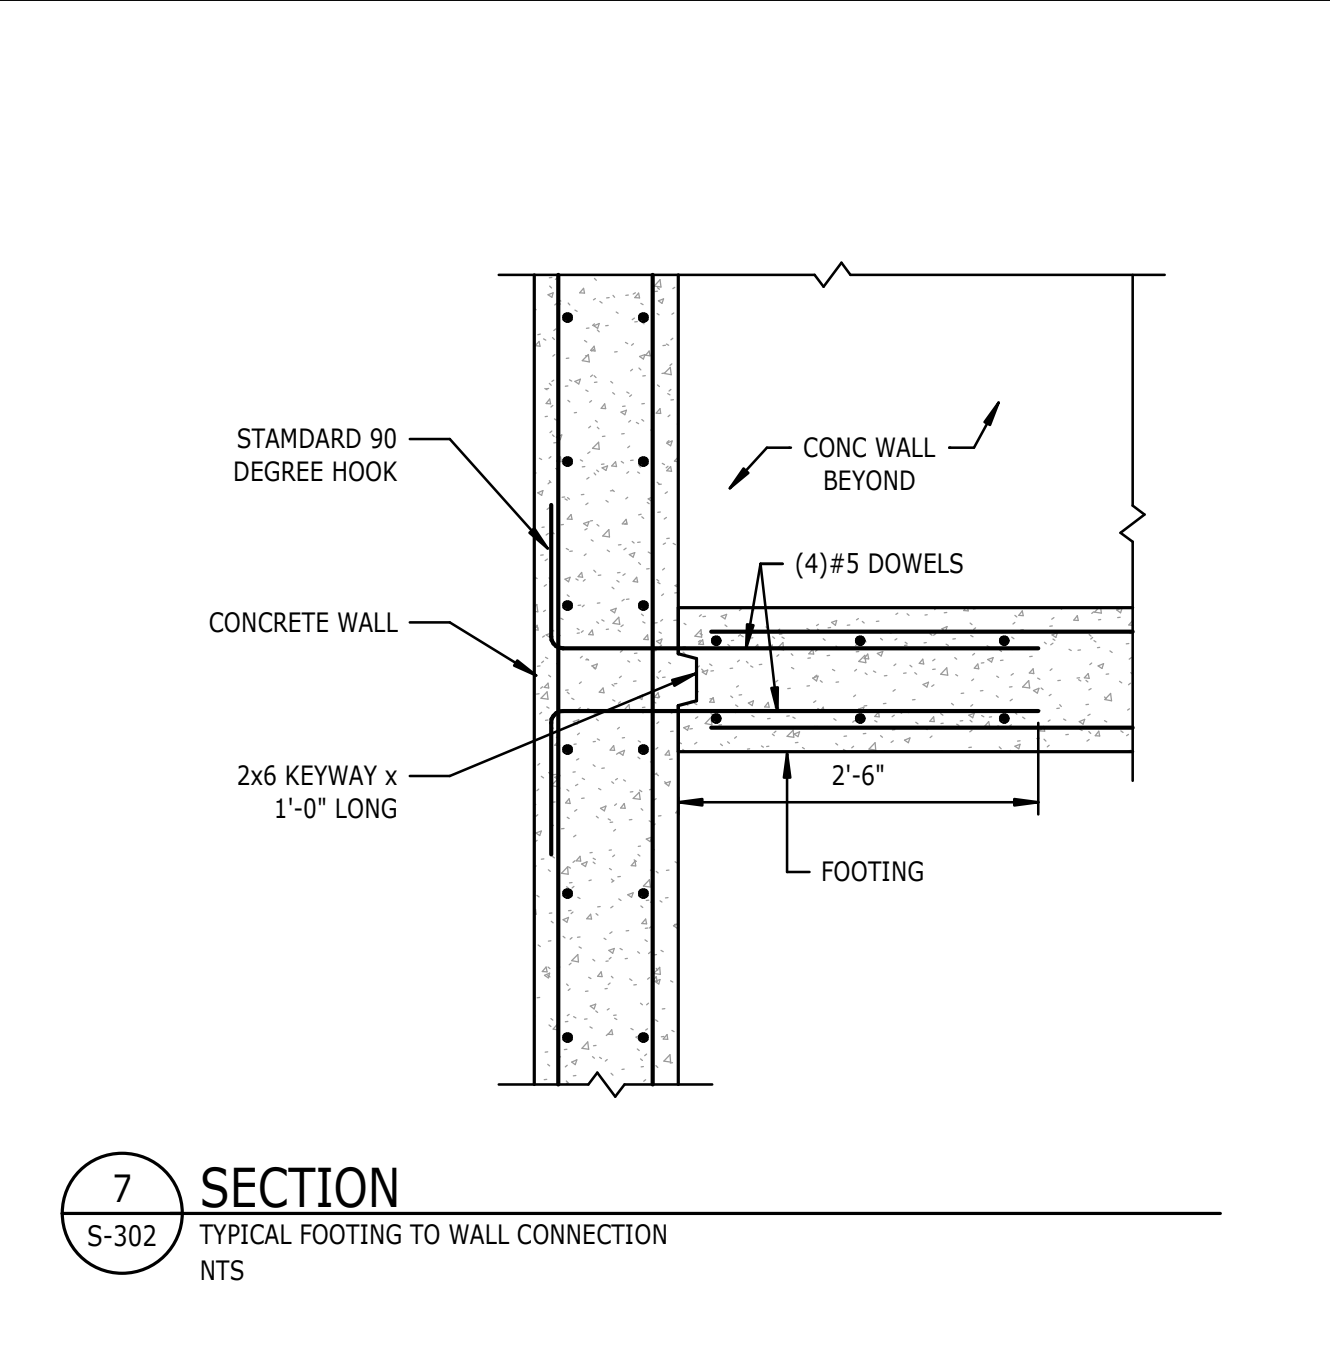


**7 SECTION**  
S-302  
TYPICAL FOOTING TO WALL CONNECTION  
NTS

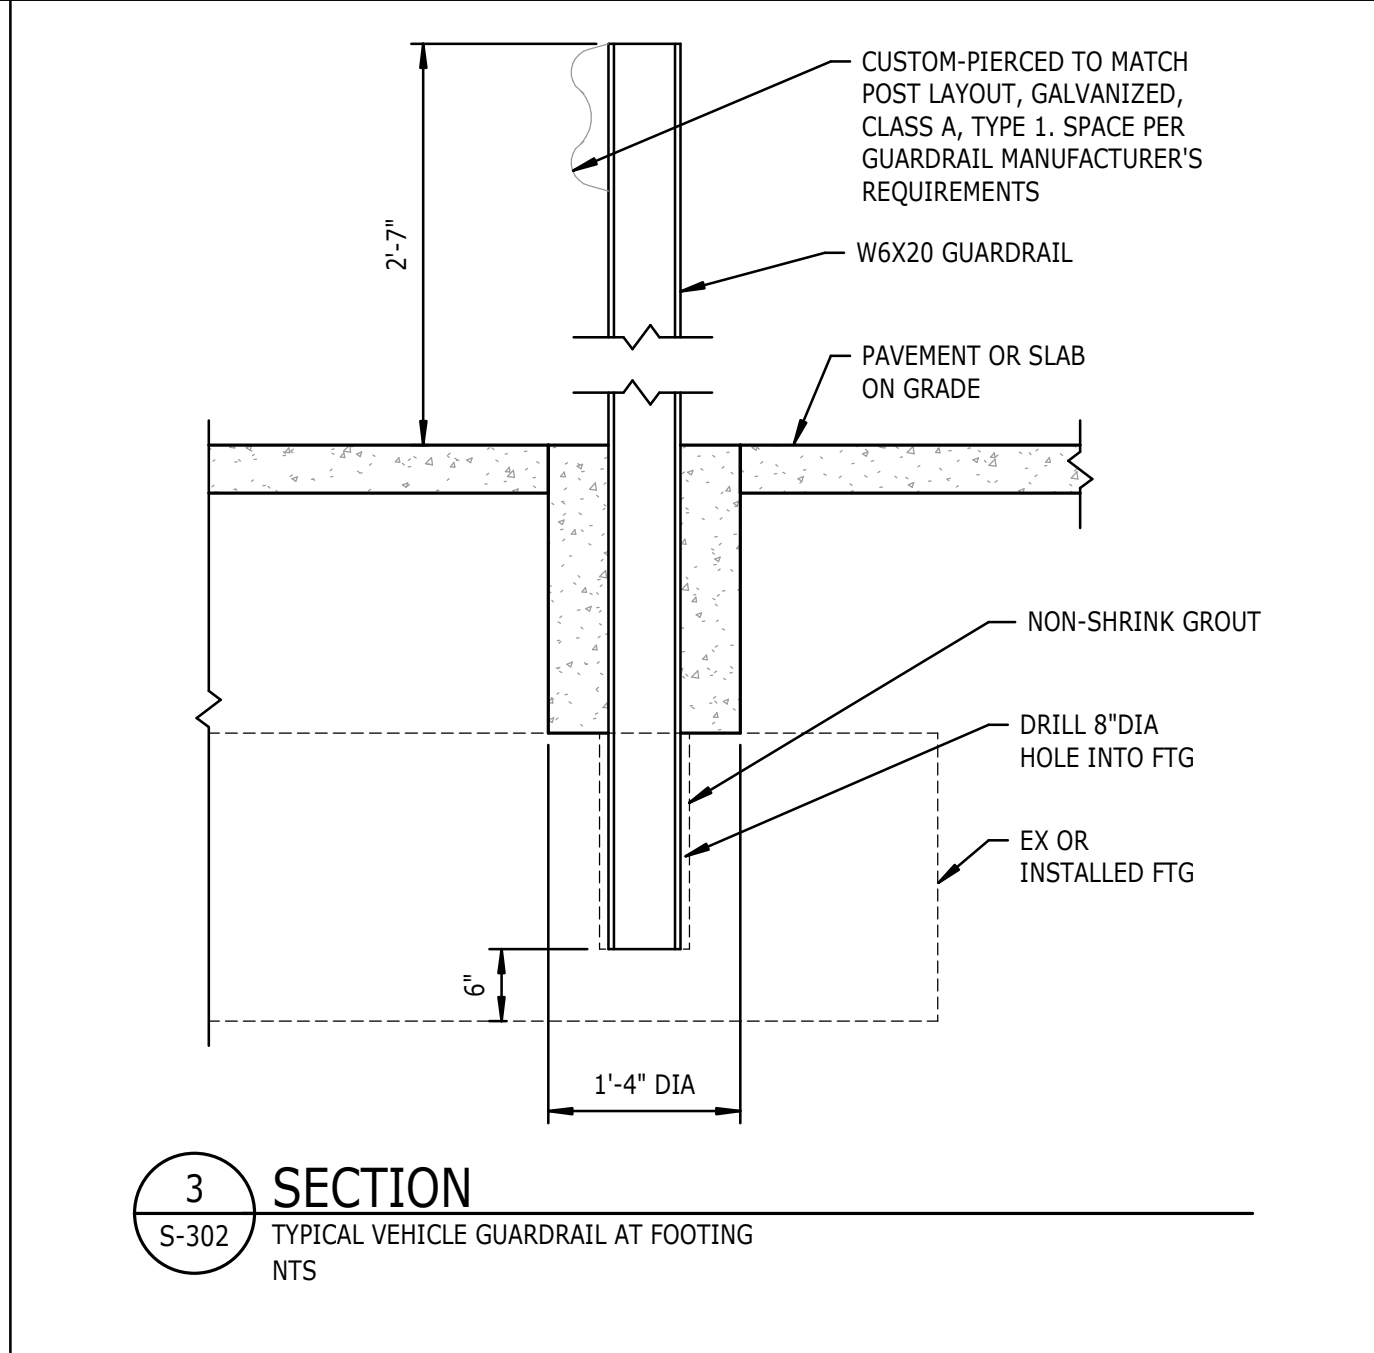


**3 SECTION**  
S-302  
TYPICAL VEHICLE GUARDRAIL AT FOOTING  
NTS

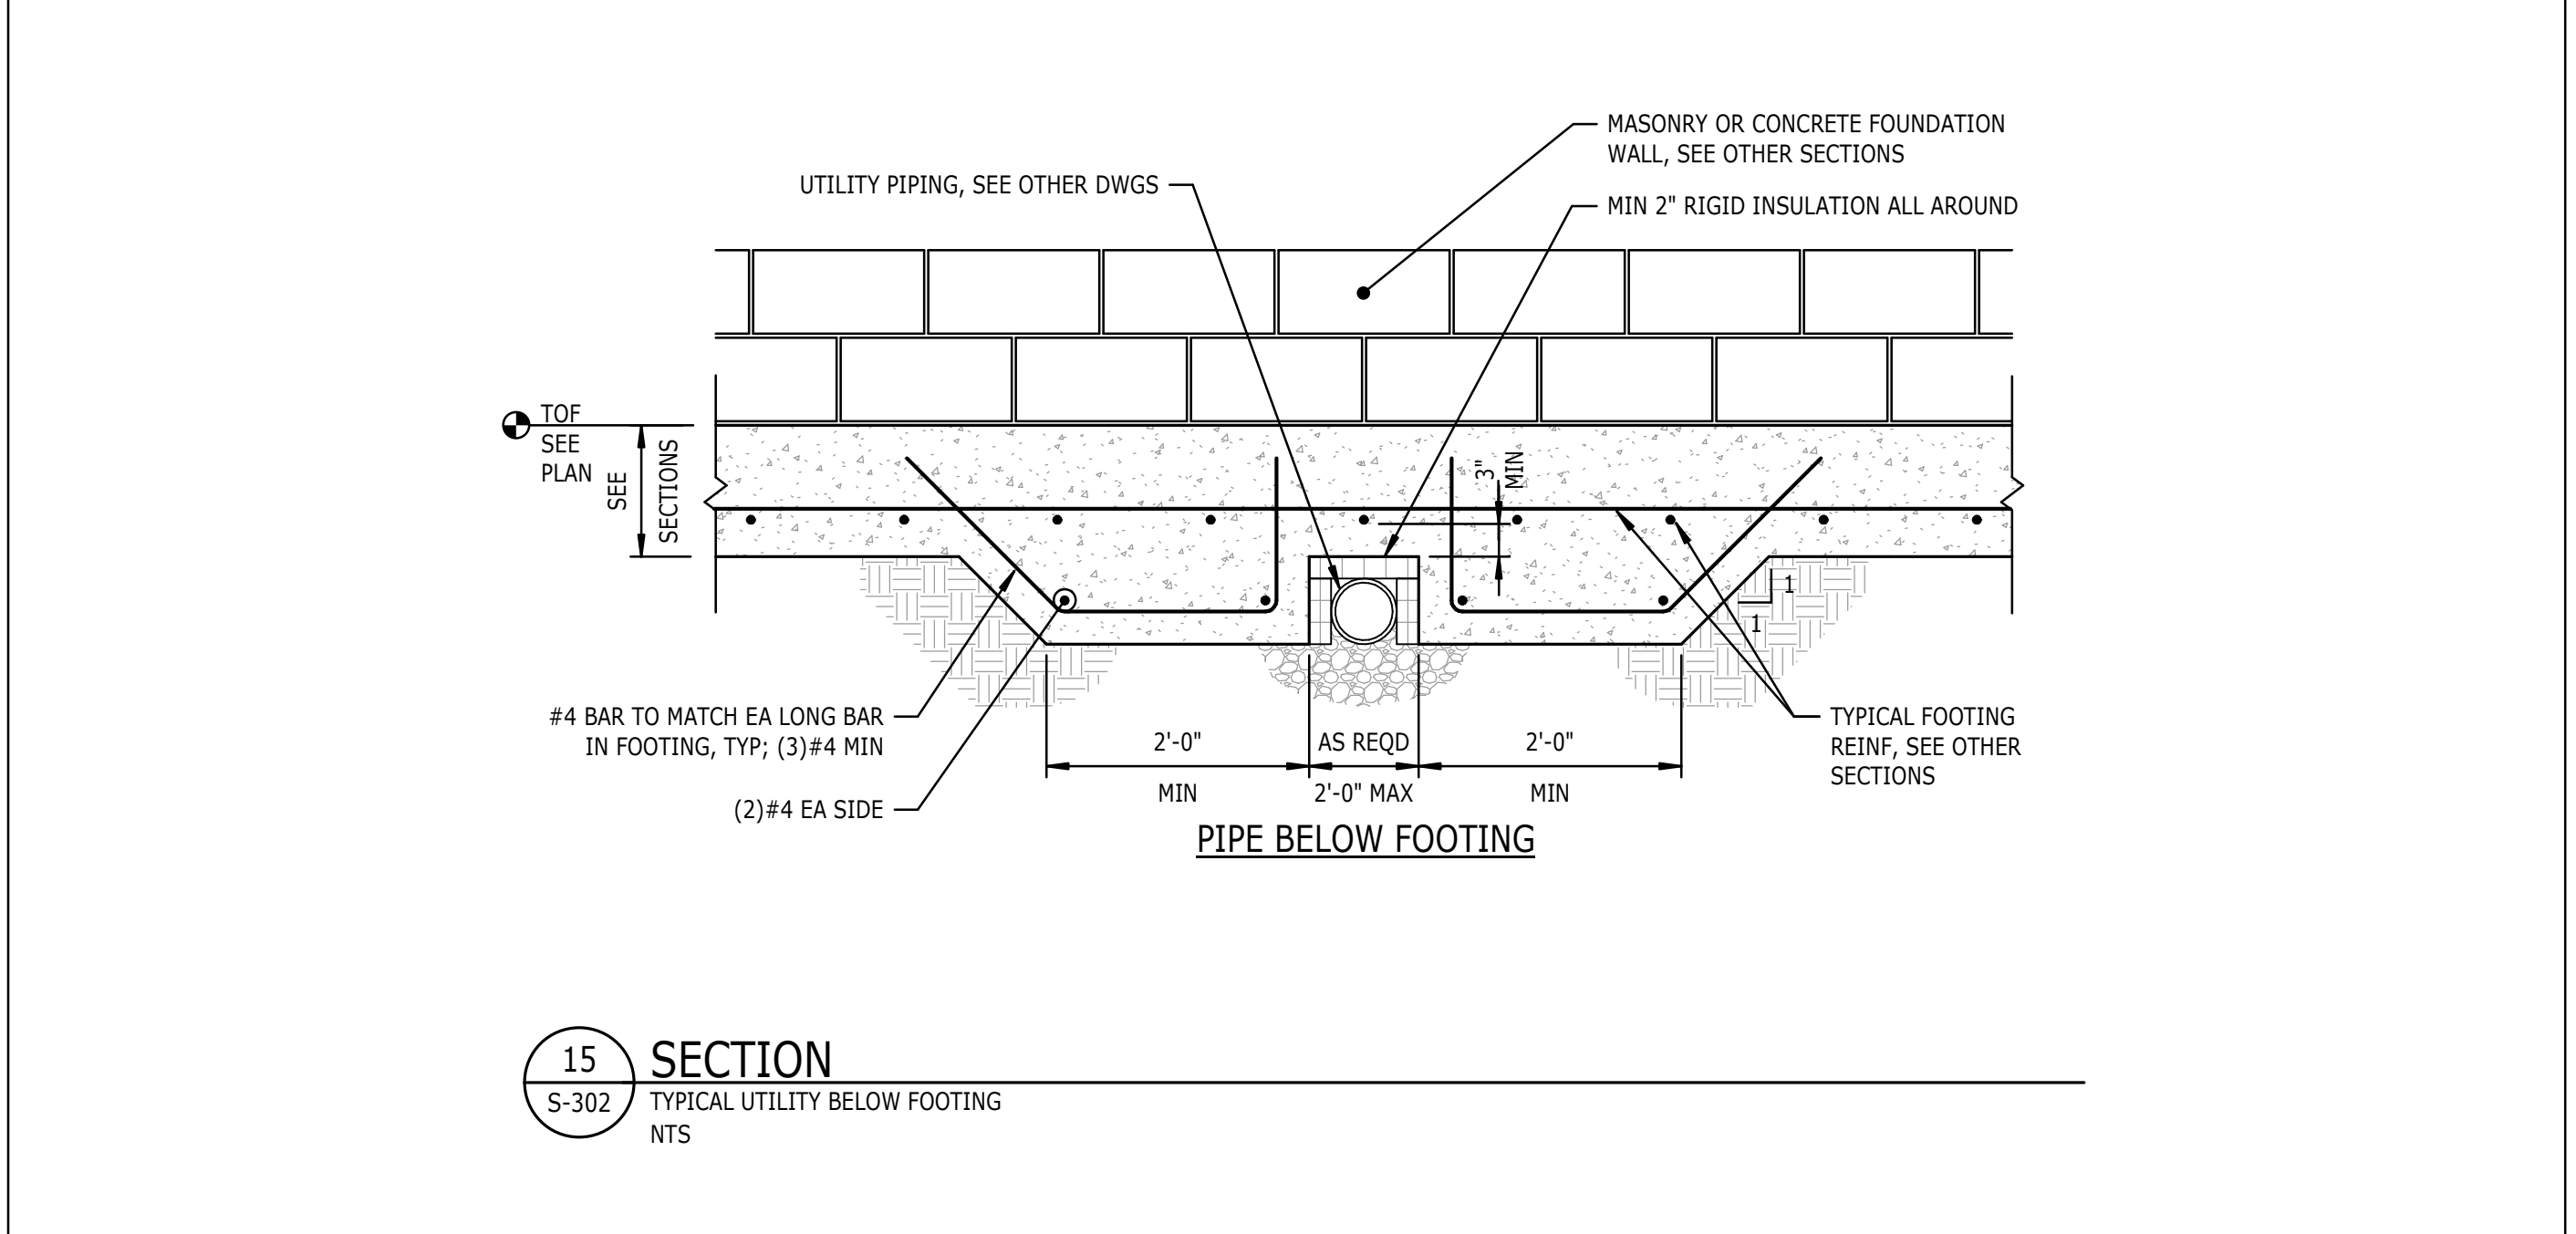

**15 SECTION**  
S-302  
TYPICAL UTILITY BELOW FOOTING  
NTS

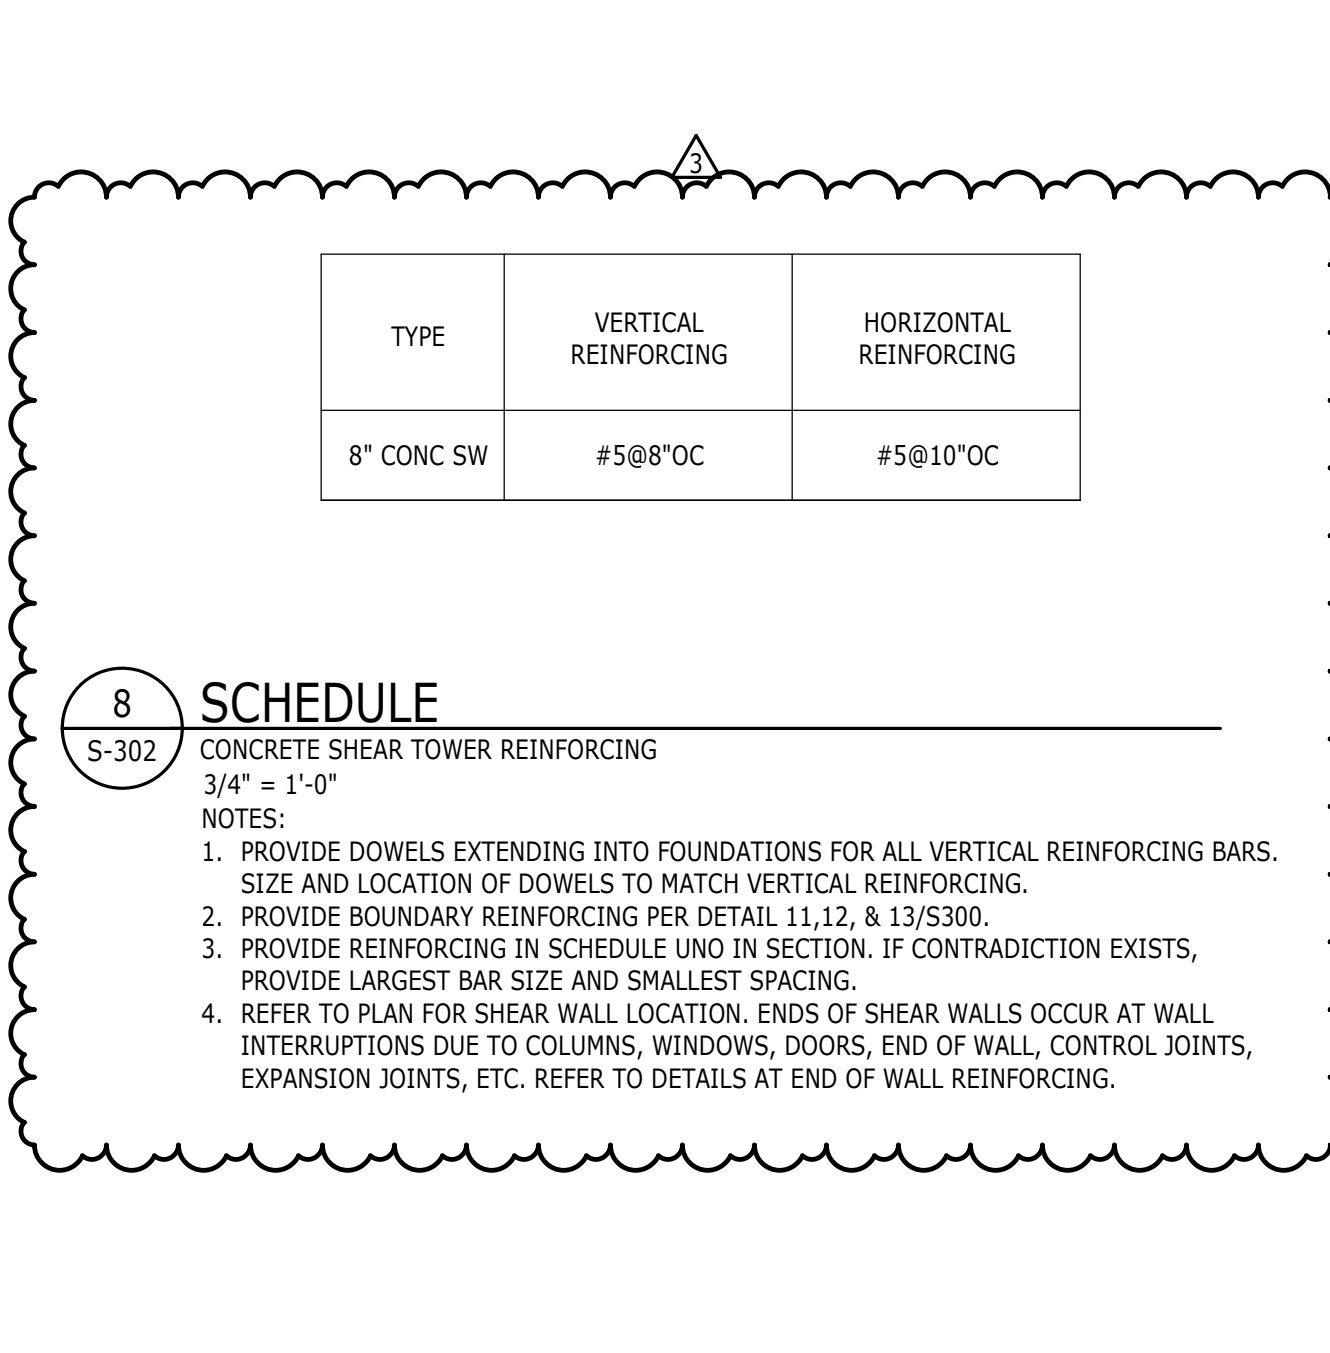

**8 SCHEDULE**  
S-302  
CONCRETE SHEAR TOWER REINFORCING  
3/4" = 1'-0"

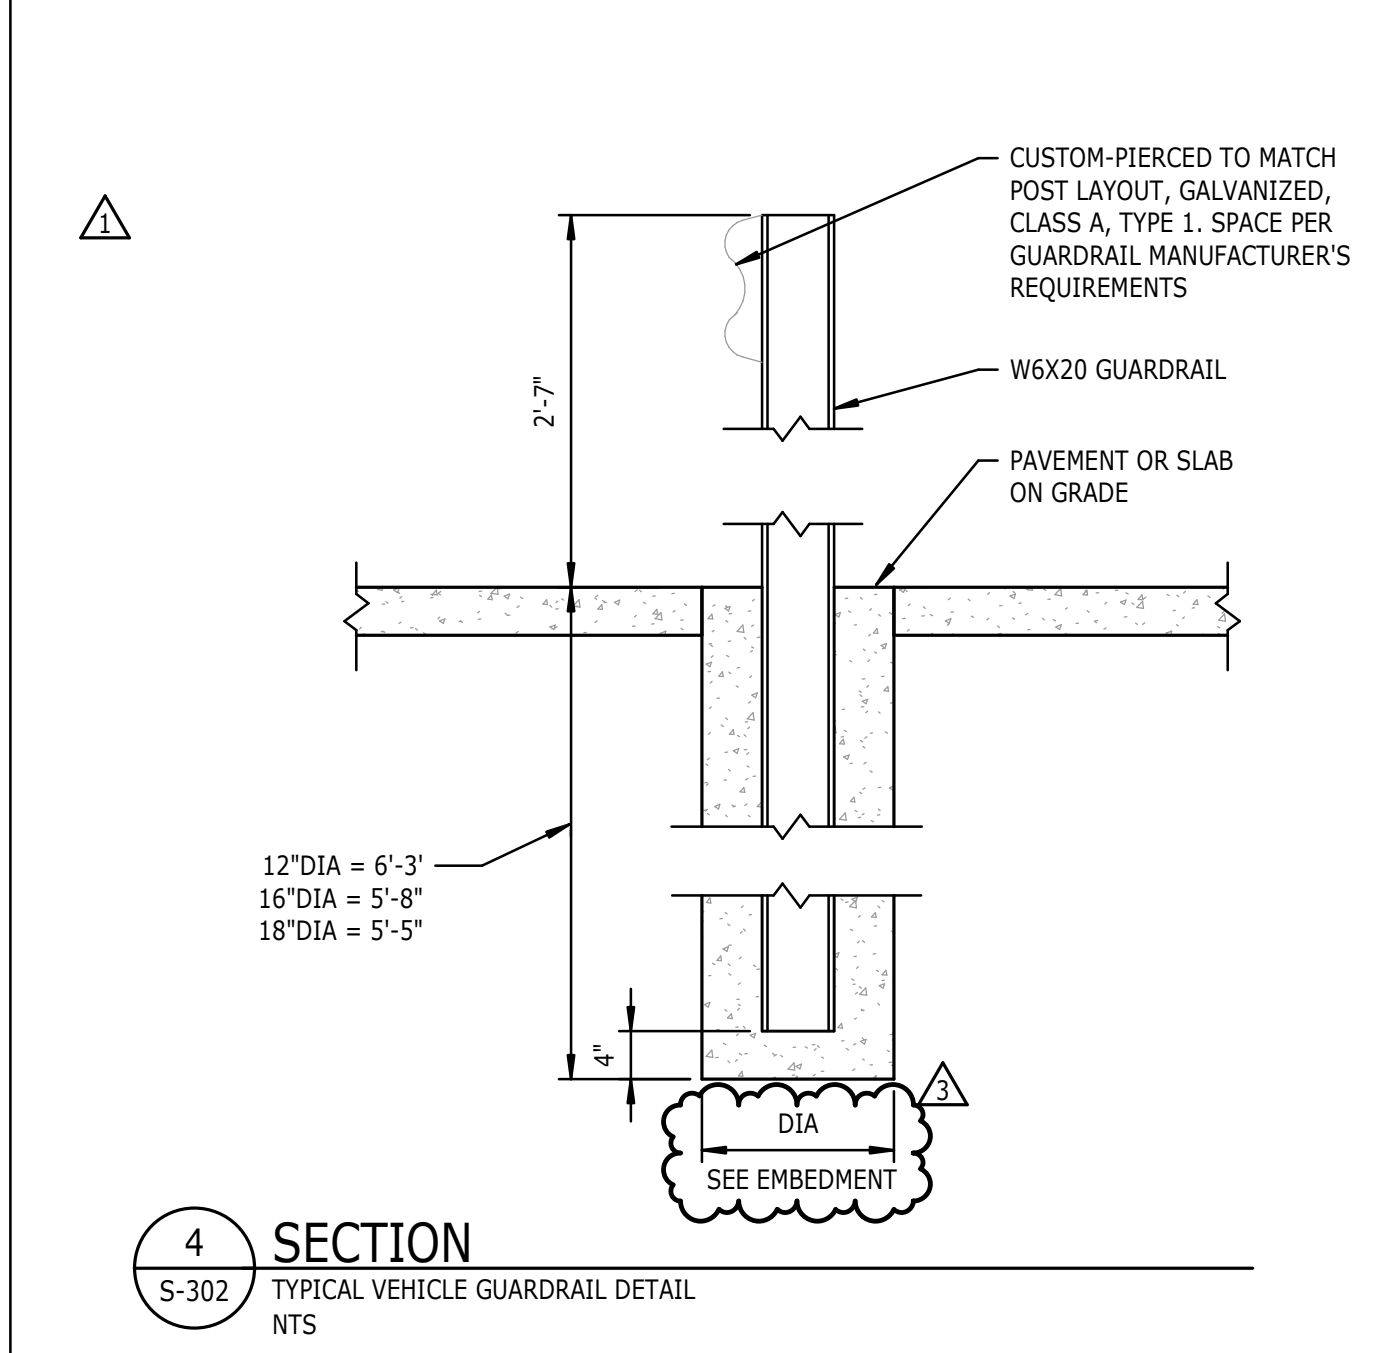

**4 SECTION**  
S-302  
TYPICAL VEHICLE GUARDRAIL DETAIL  
NTS

13  
S-321

CONCRETE BEAM SCHEDULE									
CB MARK	CB WIDTH	CB DEPTH	CB TOP BARS - LEFT	CB TOP BARS - RIGHT	CB TOP BARS - CENTER	CB STIRRUPS - SIZE	CB STIRRUP SPACING	CB BOT BARS	CB NOTES
CB1	1'-8"	2'-0"	(6)#8	(6)#8	(6)#8	#4	(14)@5" OC EACH END, REMAINDER @9" OC	(6)#8	SEE PLAN FOR ADDITIONAL TOP BARS
CB2	1'-8"	2'-6"	(6)#8	(6)#8	(6)#8	#4	(10)@6" OC EACH END, REMAINDER @9" OC	(6)#8	SEE PLAN FOR ADDITIONAL TOP BARS
CB3	1'-4"	2'-0"	(5)#8	(5)#8	(5)#8	#4	@9" OC	(5)#8	SEE PLAN FOR ADDITIONAL TOP BARS
CB4	1'-6"	2'-0"	(6)#8	(6)#8	(6)#8	#4	@9" OC	(6)#8	SEE PLAN FOR ADDITIONAL TOP BARS
CB5	1'-8"	2'-0"	(6)#8	(6)#8	(6)#8	#4	(26)@3" OC EACH END, REMAINDER @9" OC	(6)#8	SEE PLAN FOR ADDITIONAL TOP BARS
CB6	1'-8"	2'-0"	(8)#8	(8)#8	(8)#8	#4	(30)@ 2 1/2" OC EACH END, REMAINDER @4 1/2" OC	(10)#8	SEE PLAN FOR ADDITIONAL TOP BARS

9 TYPICAL CONSTRUCTION JOINTS IN BEAMS  
S-321 3/4" = 1'-0"

NOTES:  
1. FOAM JOINT FILLER TO BE CLOSED CELL NEOPRENE FOAM.  
2. SEALANT TO BE "TREMCO DYMERC" OR EQUAL.  
3. SUBMIT SAMPLES OF JOINT FILLER & SEALANT FOR APPROVAL.  
4. ALL CHAMFERS TO BE ON EXPOSED FACE OF WALL.



5 DETAIL  
S-321

TYPICAL JOINTS IN CONCRETE WALLS  
NTS



1 DETAIL  
S-321

TYPICAL HORIZONTAL WALL REINFORCING, SINGLE LAYER  
3/4" = 1'-0"




AT CORNERS



AT ENDS



AT INTERSECTIONS

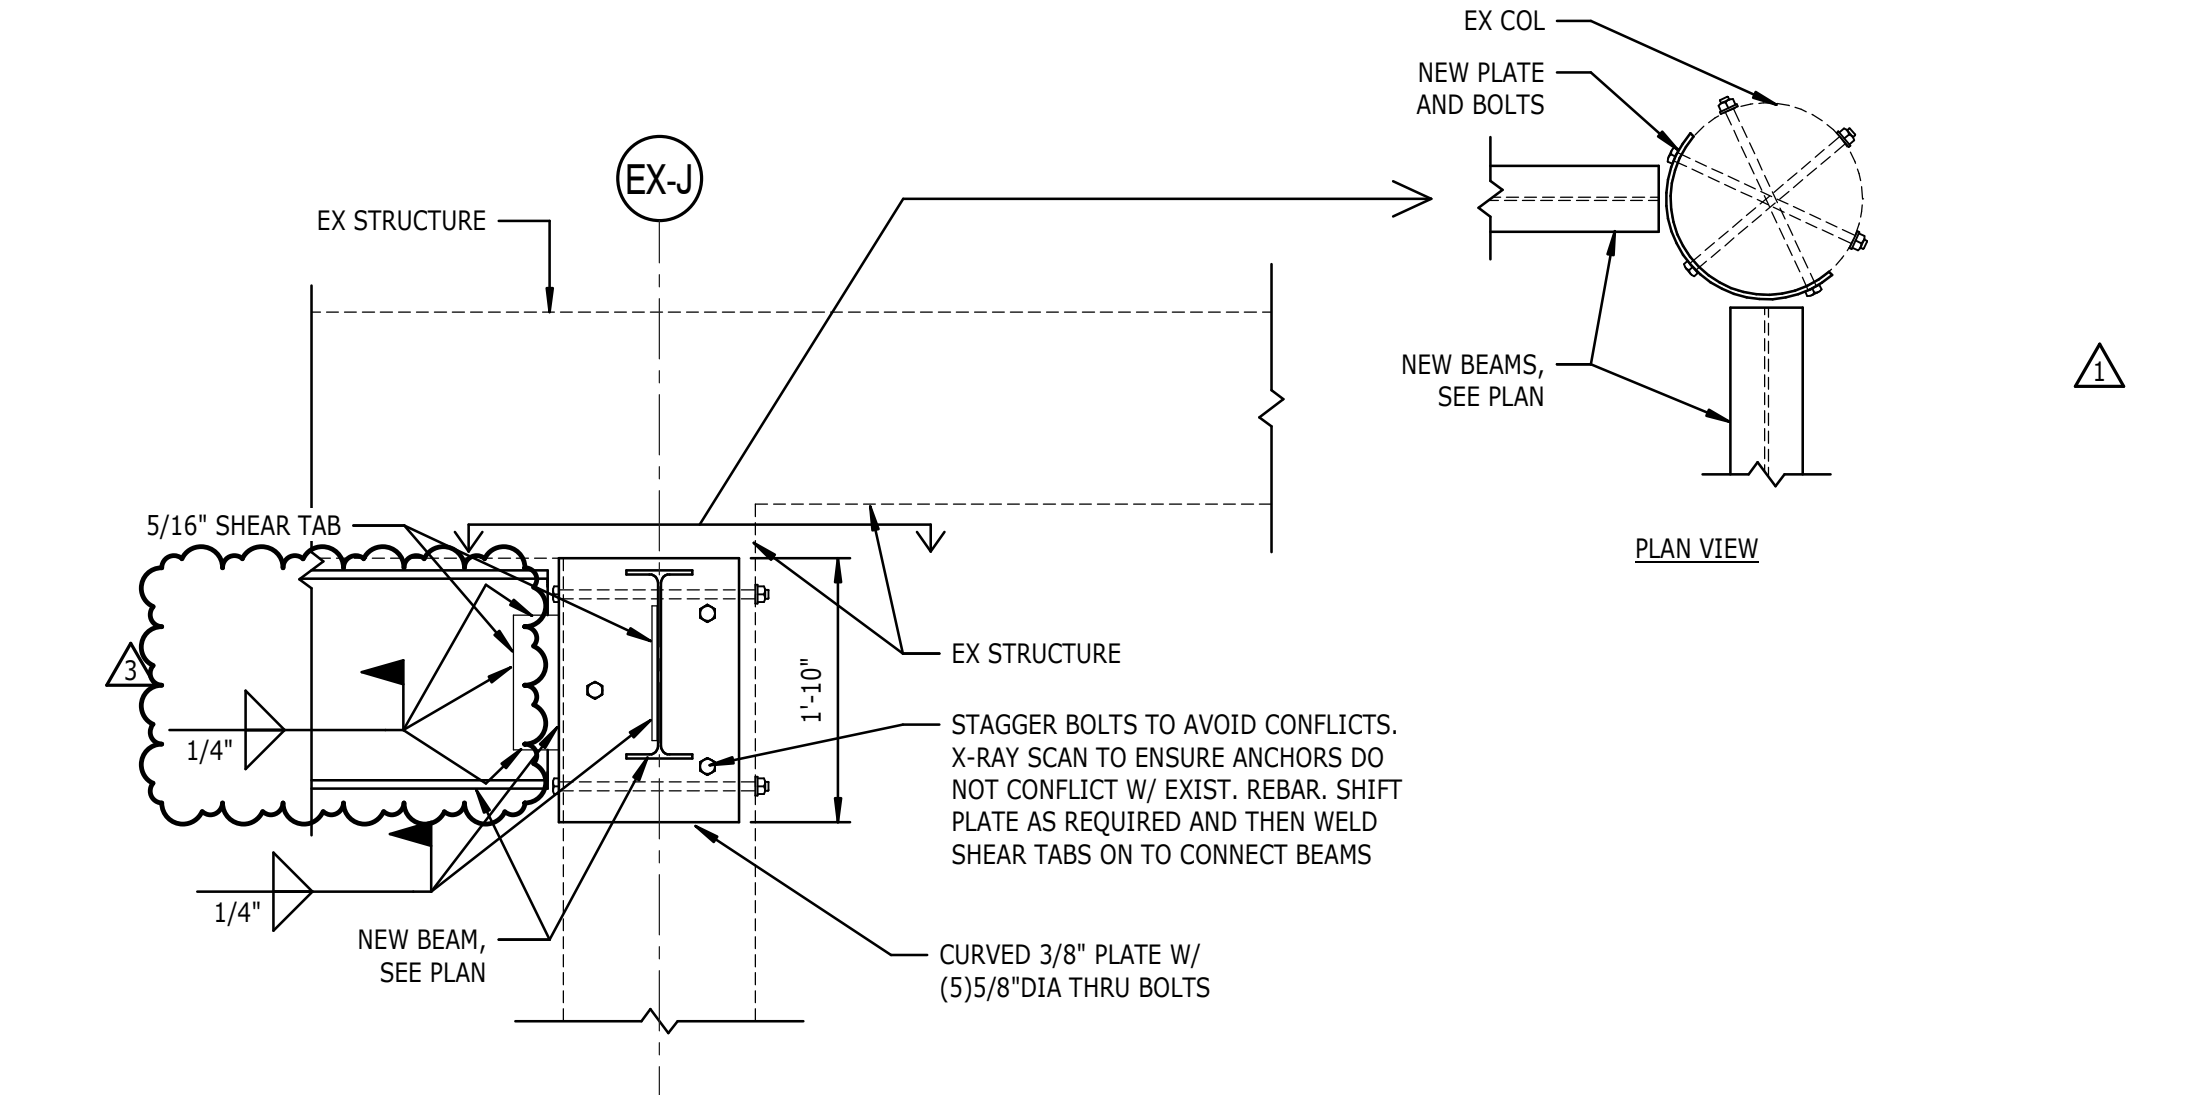


14 SECTION  
S-321 3/4" = 1'-0"

6 TYPICAL CONCRETE BEAM ELEVATION  
S-321 3/4" = 1'-0"



1 DETAIL  
S-321

 
TYPICAL HORIZONTAL WALL REINFORCING, SINGLE LAYER  
3/4" = 1'-0"



3 DETAIL  
S-321

WALL OPENINGS SHALL BE COORDINATED AND DETAILED ON THE REINFORCEMENT SHOP DRAWINGS.  
1. WALL OPENINGS SHALL BE COORDINATED AND DETAILED ON THE REINFORCEMENT SHOP DRAWINGS.  
2. PROVIDE SLEEVES FOR ALL OPENINGS EXCEEDING 6" IN DIAMETER.  
3. NO ADDITIONAL REINFORCING IS REQUIRED FOR OPENINGS NOT EXCEEDING 6" IN DIAMETER, PROVIDED NO TYPICAL REINFORCING IS INTERRUPTED.  
4. PROVIDE 1'-0" MINIMUM SPACING BETWEEN EDGES OF OPENINGS, TYPICAL IN ALL DIRECTIONS FOR OPENINGS NOT EXCEEDING 18" IN DIAMETER. FOR OPENINGS BETWEEN 18" AND 30" IN DIAMETER, PROVIDE 2'-0" MINIMUM SPACING BETWEEN EDGES OF OPENINGS.  
5. FOR OPENINGS EXCEEDING 6" IN DIAMETER AND FOR OPENINGS THAT INTERRUPT TYPICAL REINFORCING, PROVIDE ADDITIONAL VERTICAL REINFORCING BAR EACH SIDE OF OPENING. BAR SIZE TO MATCH TYPICAL VERTICAL REINFORCING. SPACING BETWEEN BARS SHALL BE 3". PROVIDE (2)#5 HORIZONTAL BARS EACH SIDE OF OPENING. MAINTAIN 3" SPACING BETWEEN BARS. BAR LENGTH SHALL BE TWO TIMES THE OPENING SIZE PLUS TWO TIMES THE BAR SPLICE LENGTH.  
6. ALL PENETRATIONS TO BE CORE DRILLED SHALL BE SUBMITTED FOR APPROVAL PRIOR TO PROCEEDING WITH THE WORK.

AT INTERSECTIONS

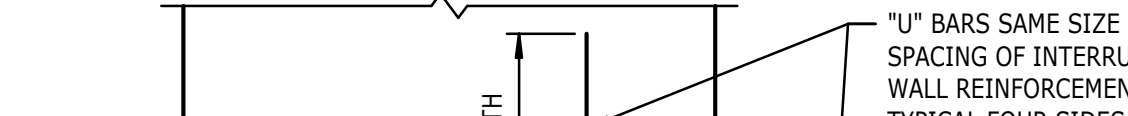


7 ELEVATED SLAB STUD RAILS SCHEDULE  
S-321 1/8" = 1'-0"



Type	PS1	PS2	PS3
Number of rails/column	12	9	6
Number of studs/rail	7	8	16
Stud diameter "D"	1/2"	1/2"	1/2"
Stud spacing "S"	5"	5"	5"
Distance to first stud "So"	5"	5"	5"
Overall height of rail "OH"	8 3/4"	8 3/4"	8 3/4"
Top cover	1"	1"	1"
Bottom cover	2"	2"	2"




12 SECTION  
S-321 3/4" = 1'-0"

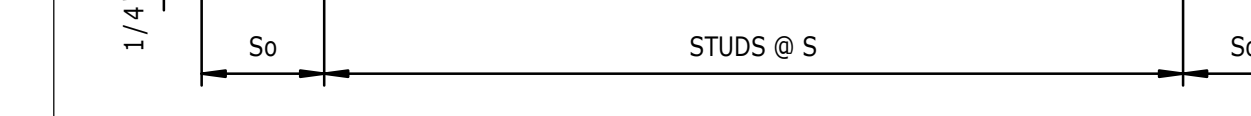

4 DETAIL  
S-321

PENETRATIONS IN CONCRETE WALLS  
NTS

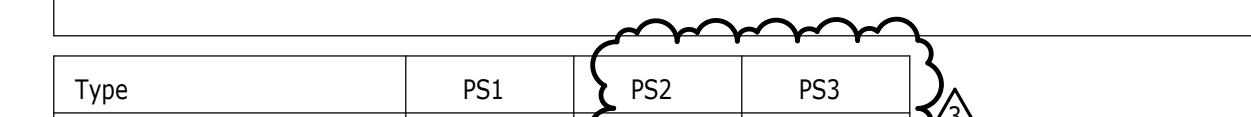



3 DETAIL  
S-321

WALL OPENINGS SHALL BE COORDINATED AND DETAILED ON THE REINFORCEMENT SHOP DRAWINGS.  
1. WALL OPENINGS SHALL BE COORDINATED AND DETAILED ON THE REINFORCEMENT SHOP DRAWINGS.  
2. PROVIDE SLEEVES FOR ALL OPENINGS EXCEEDING 6" IN DIAMETER.  
3. NO ADDITIONAL REINFORCING IS REQUIRED FOR OPENINGS NOT EXCEEDING 6" IN DIAMETER, PROVIDED NO TYPICAL REINFORCING IS INTERRUPTED.  
4. PROVIDE 1'-0" MINIMUM SPACING BETWEEN EDGES OF OPENINGS, TYPICAL IN ALL DIRECTIONS FOR OPENINGS NOT EXCEEDING 18" IN DIAMETER. FOR OPENINGS BETWEEN 18" AND 30" IN DIAMETER, PROVIDE 2'-0" MINIMUM SPACING BETWEEN EDGES OF OPENINGS.  
5. FOR OPENINGS EXCEEDING 6" IN DIAMETER AND FOR OPENINGS THAT INTERRUPT TYPICAL REINFORCING, PROVIDE ADDITIONAL VERTICAL REINFORCING BAR EACH SIDE OF OPENING. BAR SIZE TO MATCH TYPICAL VERTICAL REINFORCING. SPACING BETWEEN BARS SHALL BE 3". PROVIDE (2)#5 HORIZONTAL BARS EACH SIDE OF OPENING. MAINTAIN 3" SPACING BETWEEN BARS. BAR LENGTH SHALL BE TWO TIMES THE OPENING SIZE PLUS TWO TIMES THE BAR SPLICE LENGTH.  
6. ALL PENETRATIONS TO BE CORE DRILLED SHALL BE SUBMITTED FOR APPROVAL PRIOR TO PROCEEDING WITH THE WORK.

DETAIL






DETAIL

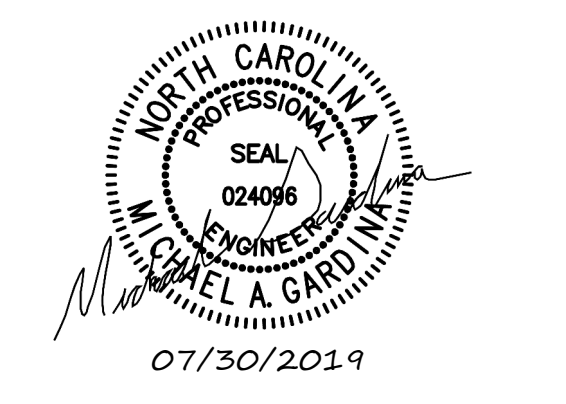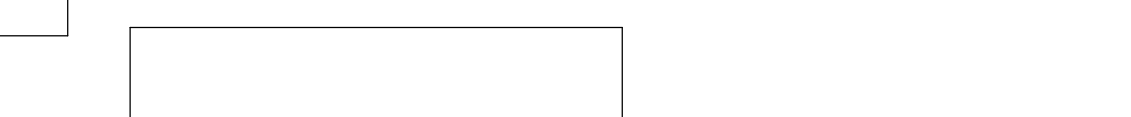


REVISIONS


1	7/12/19	AD-01
3	7/30/19	AD-03

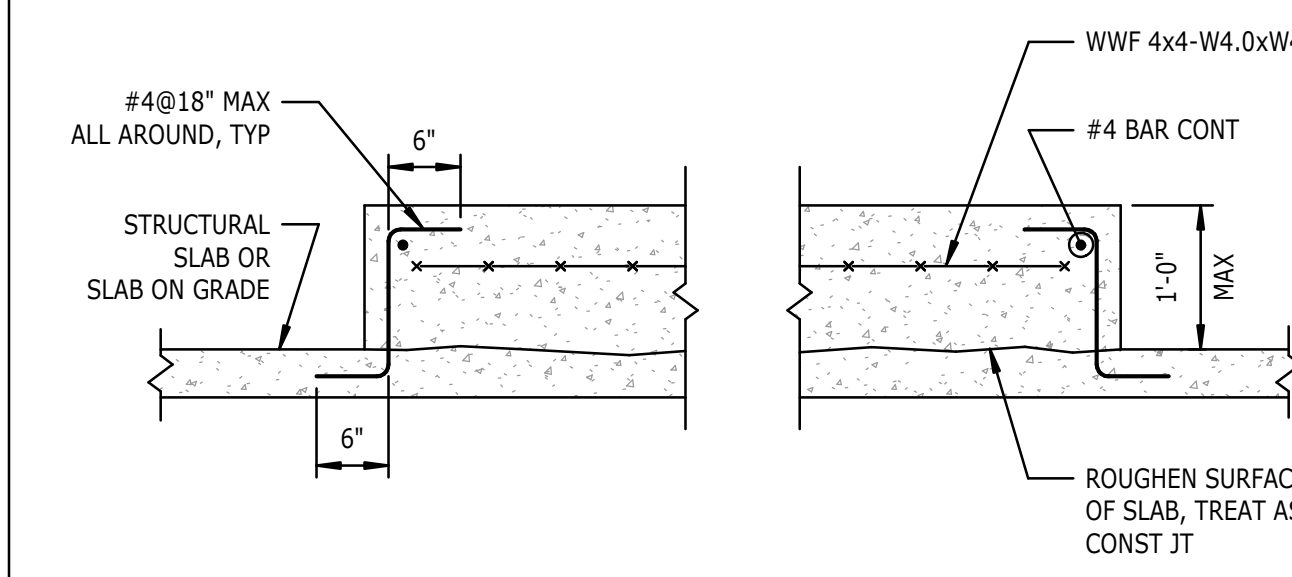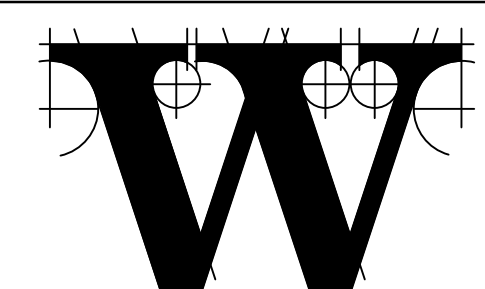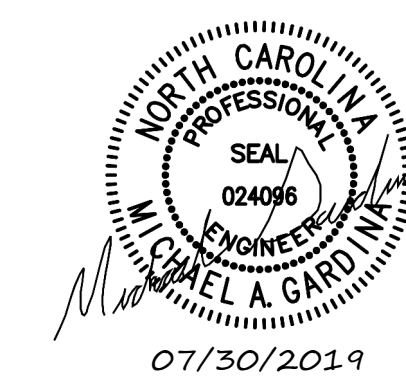


**17 DETAIL**  
S-322 TYPICAL CONCRETE EQUIPMENT PAD  
NTS  
NOTES:  
1. THE EXACT SIZE, SHAPE, AND LOCATION OF EQUIPMENT (HOUSEKEEPING) PAD(S) SHALL BE DETERMINED BY THE CONTRACTOR AFTER APPROVAL OF SHOP DRAWINGS FOR EQUIPMENT. ANCHOR BOLTS WHERE REQUIRED SHALL BE SIZED AND LOCATED ACCORDING TO MANUFACTURER'S REQUIREMENTS. PADS ON FRAMED SLABS SHALL NOT BE THICKER THAN 6", WHEN THICKER PADS ARE REQUIRED NOTIFY THE ARCHITECT.

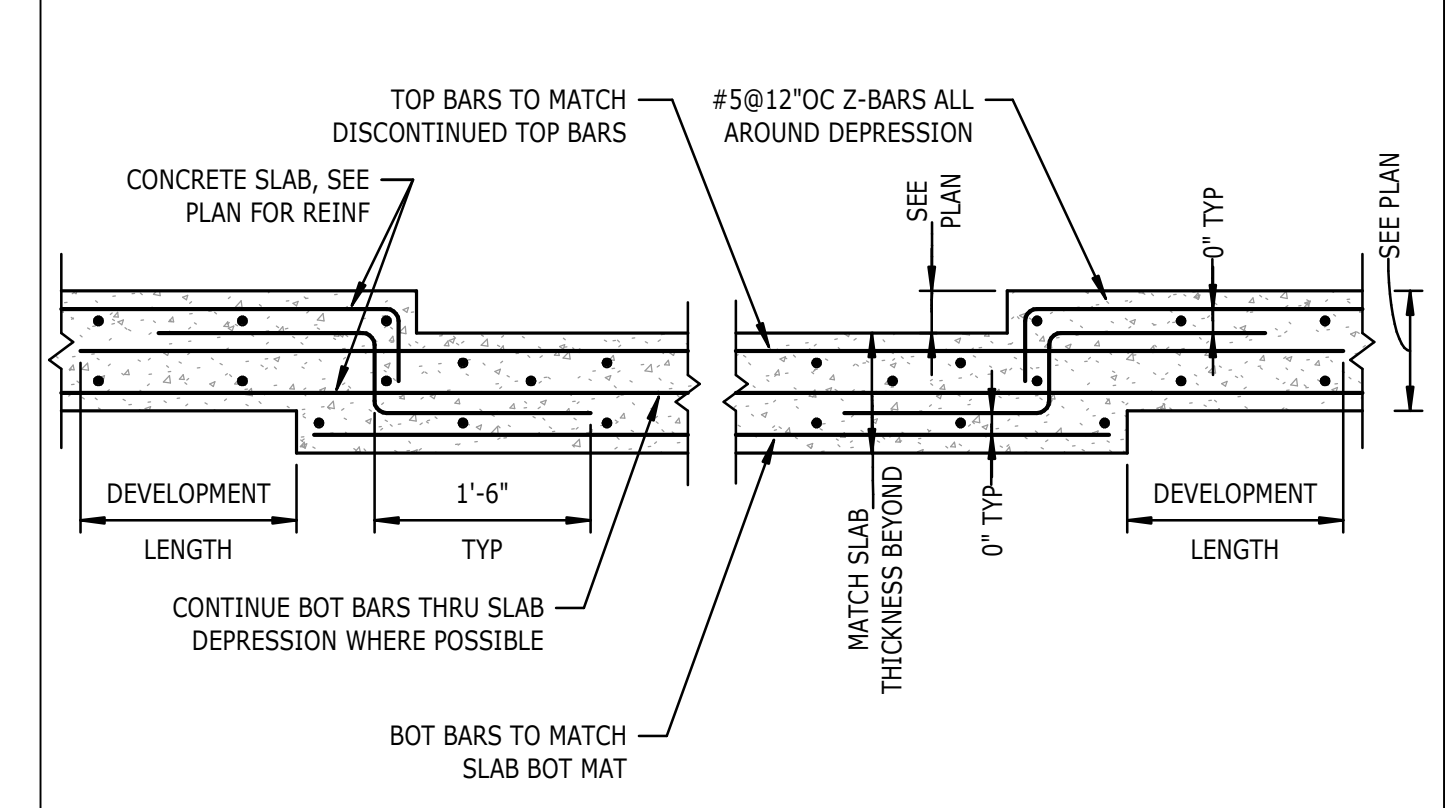


**13 DETAIL**  
S-322 TYPICAL DEPRESSION IN ELEVATED CONCRETE SLAB  
NTS

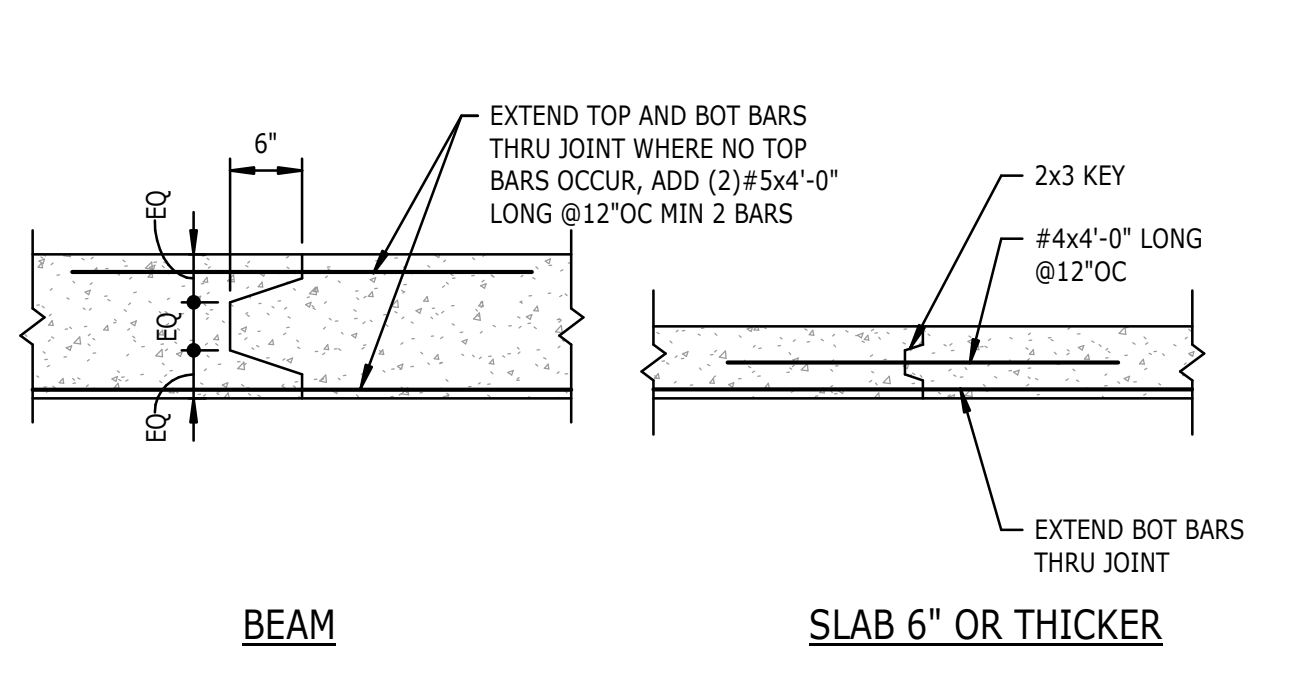


**9 DETAIL**  
S-322 TYPICAL CONSTRUCTION JOINTS IN FRAMED CONCRETE MEMBERS  
NTS  
NOTES:  
1. ALL KEYS ARE AT MID-DEPTH OF MEMBERS. LOCATE ALL JOINTS AT POINTS OF MINIMUM SHEAR. APPROVAL OF LOCATION BY THE ARCHITECT IS REQUIRED.

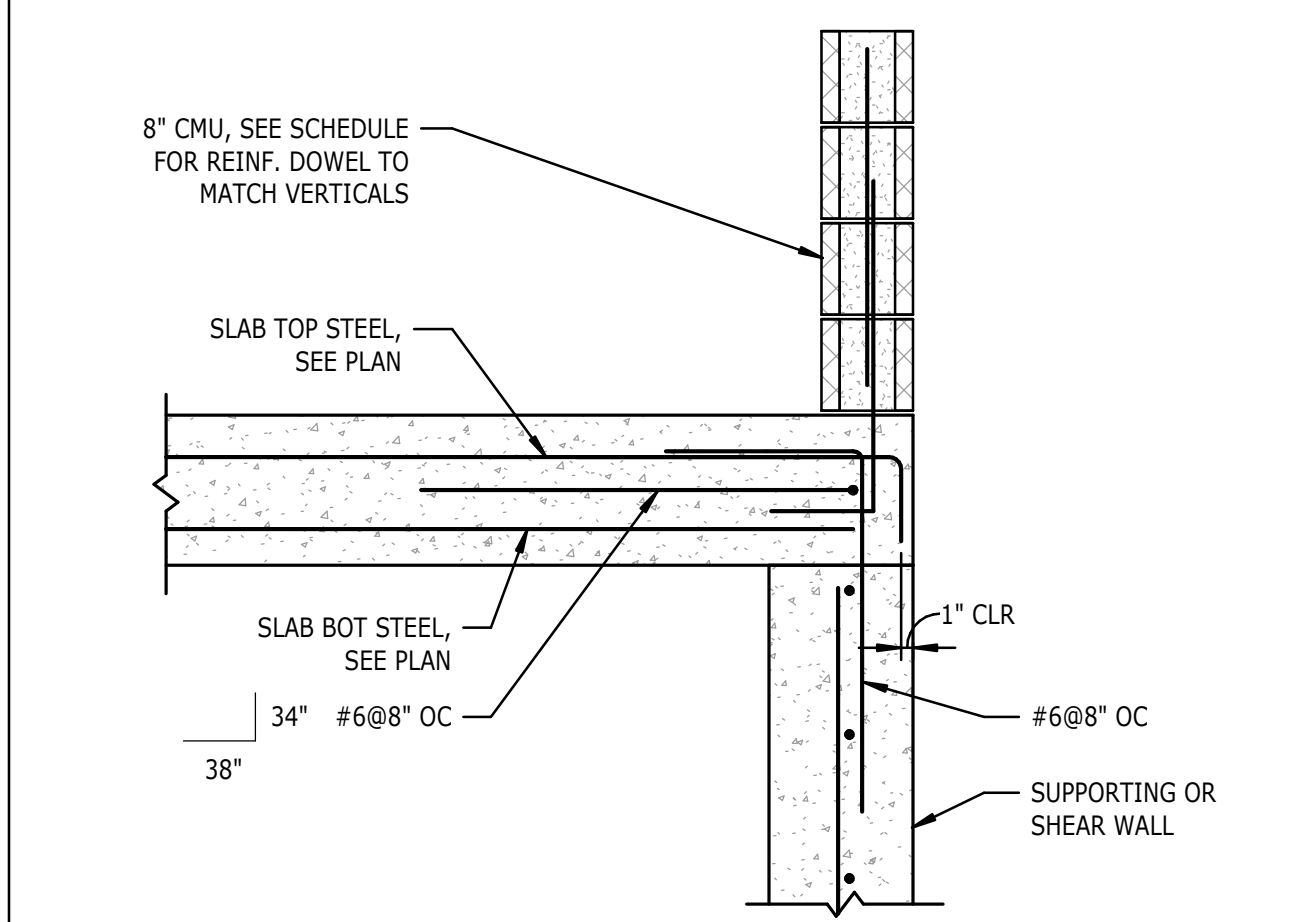


**18 SECTION**  
S-322 TYPICAL SLAB/WALL CONDITION  
3/4" = 1'-0"

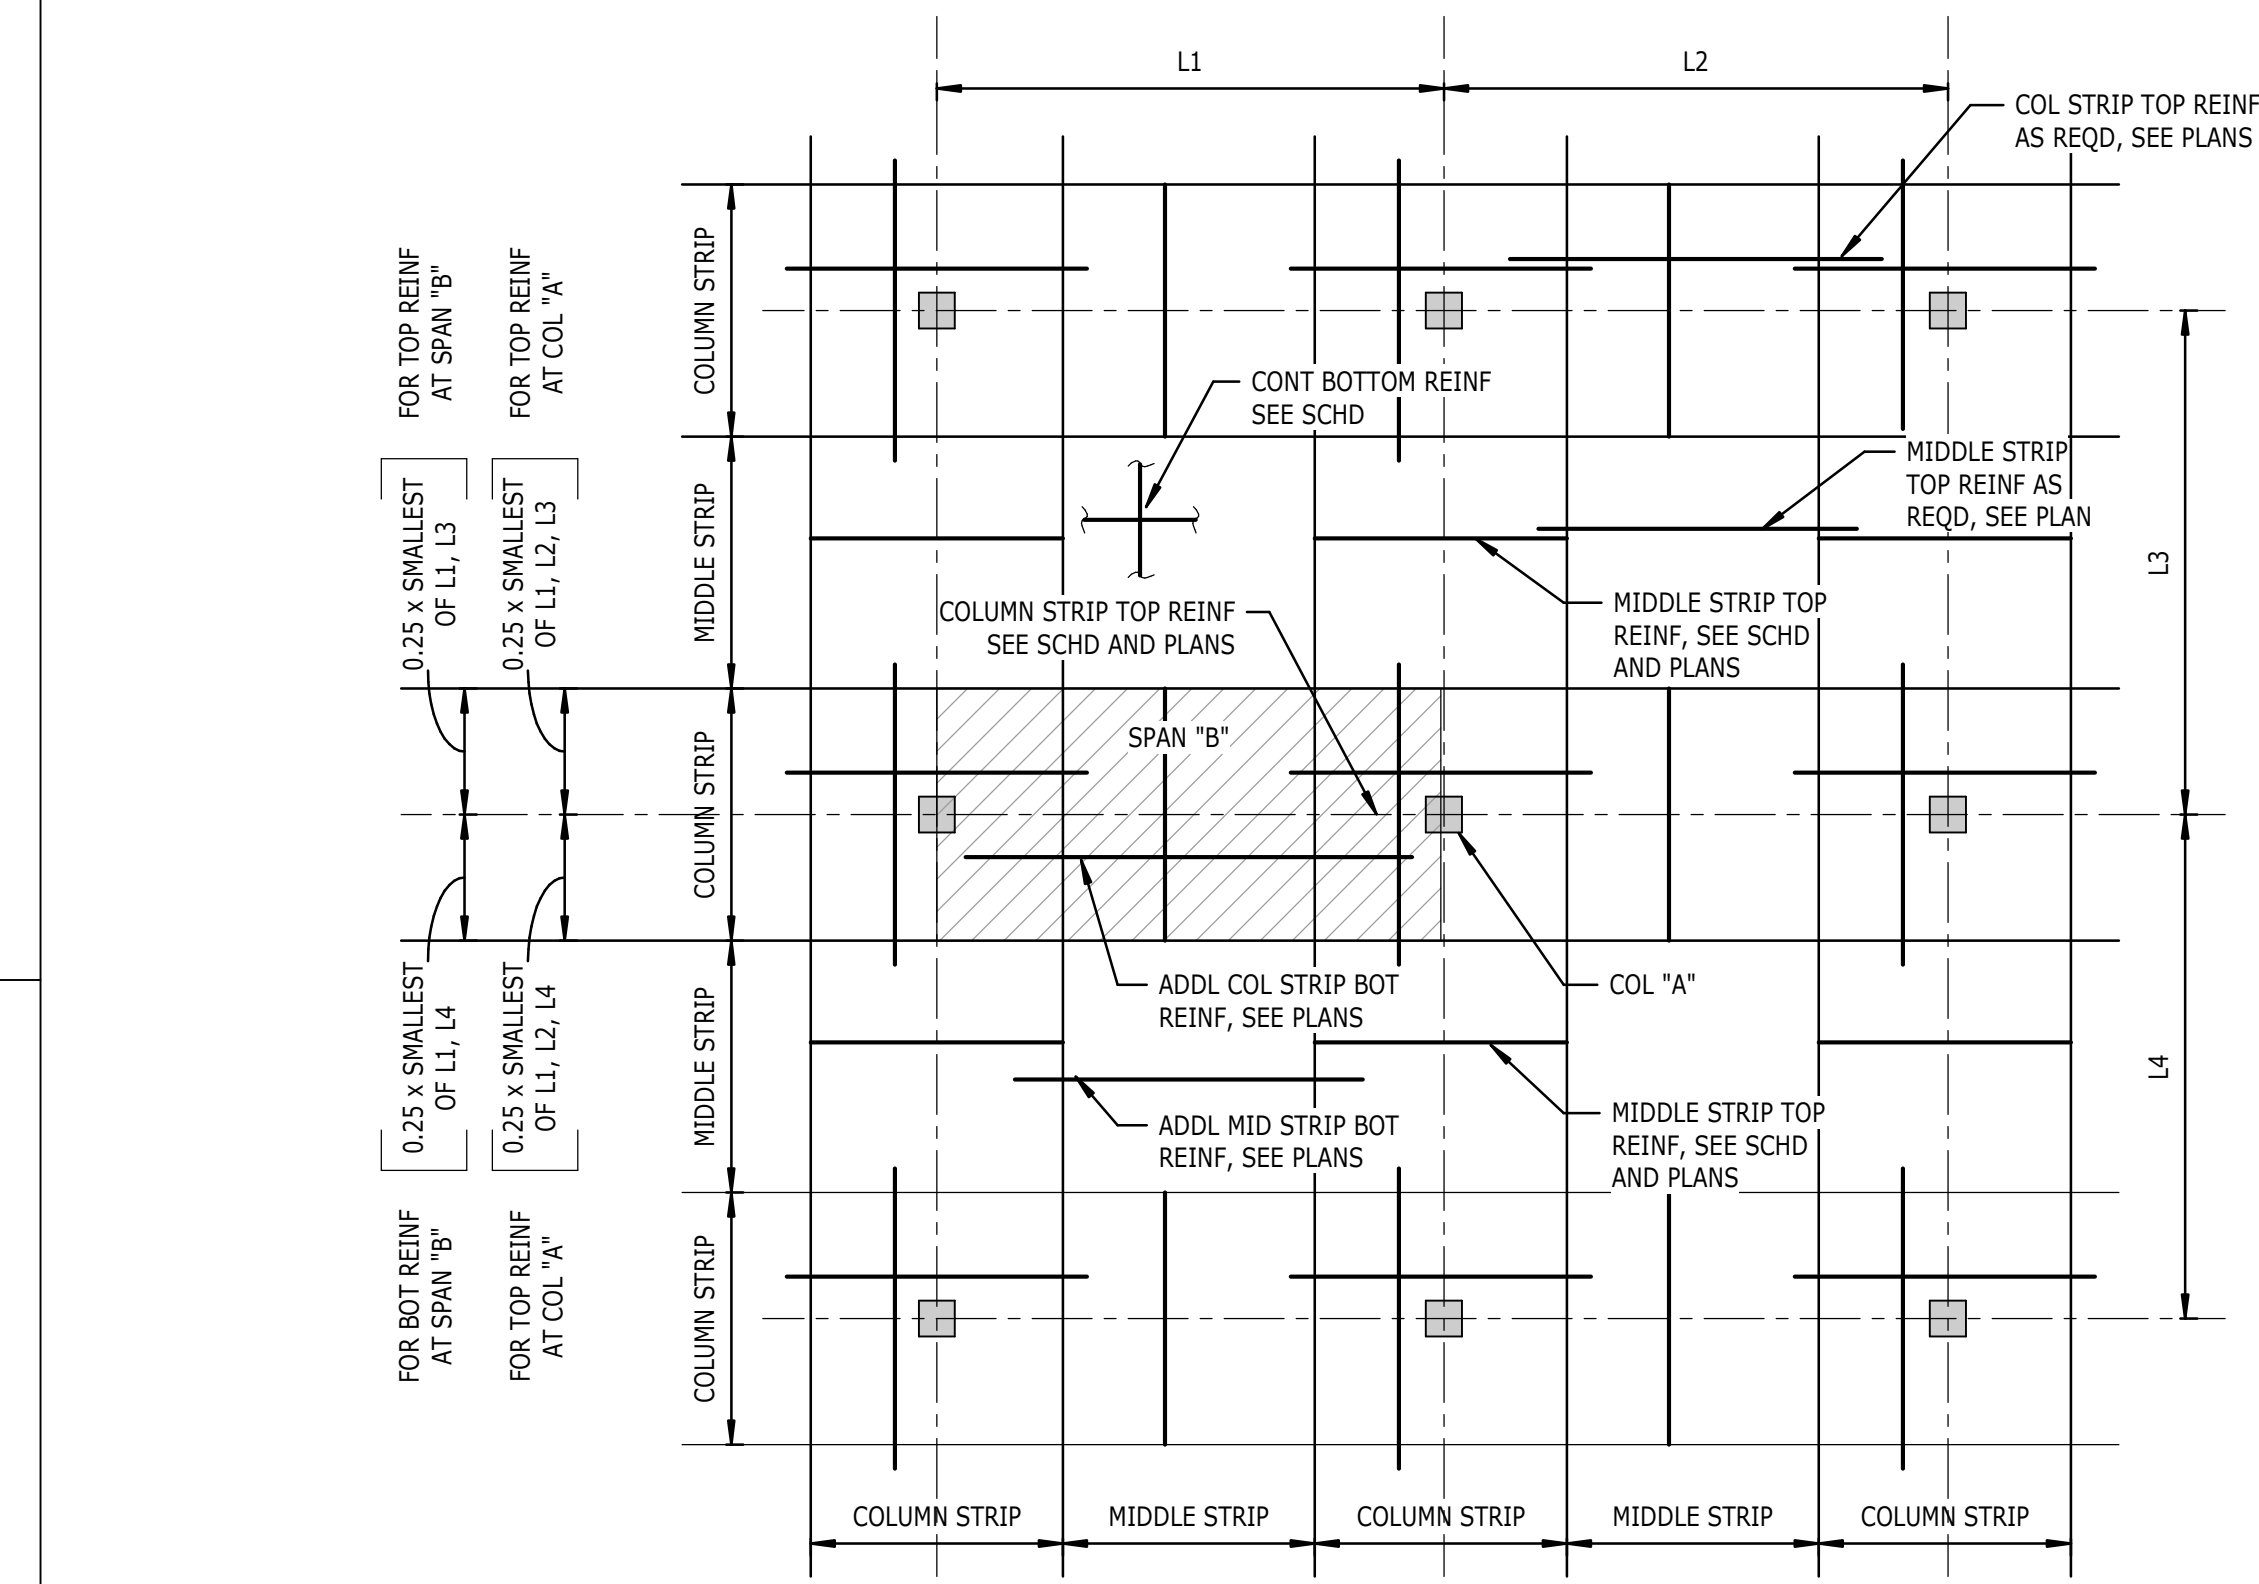


**10 DETAIL**  
S-322 TYPICAL TWO-WAY FLAT PLATE REINFORCEMENT  
NTS  
NOTES:  
1. SPACE MID STRIP REINFORCING EQUALLY BETWEEN ADJACENT COLUMN STRIPS.

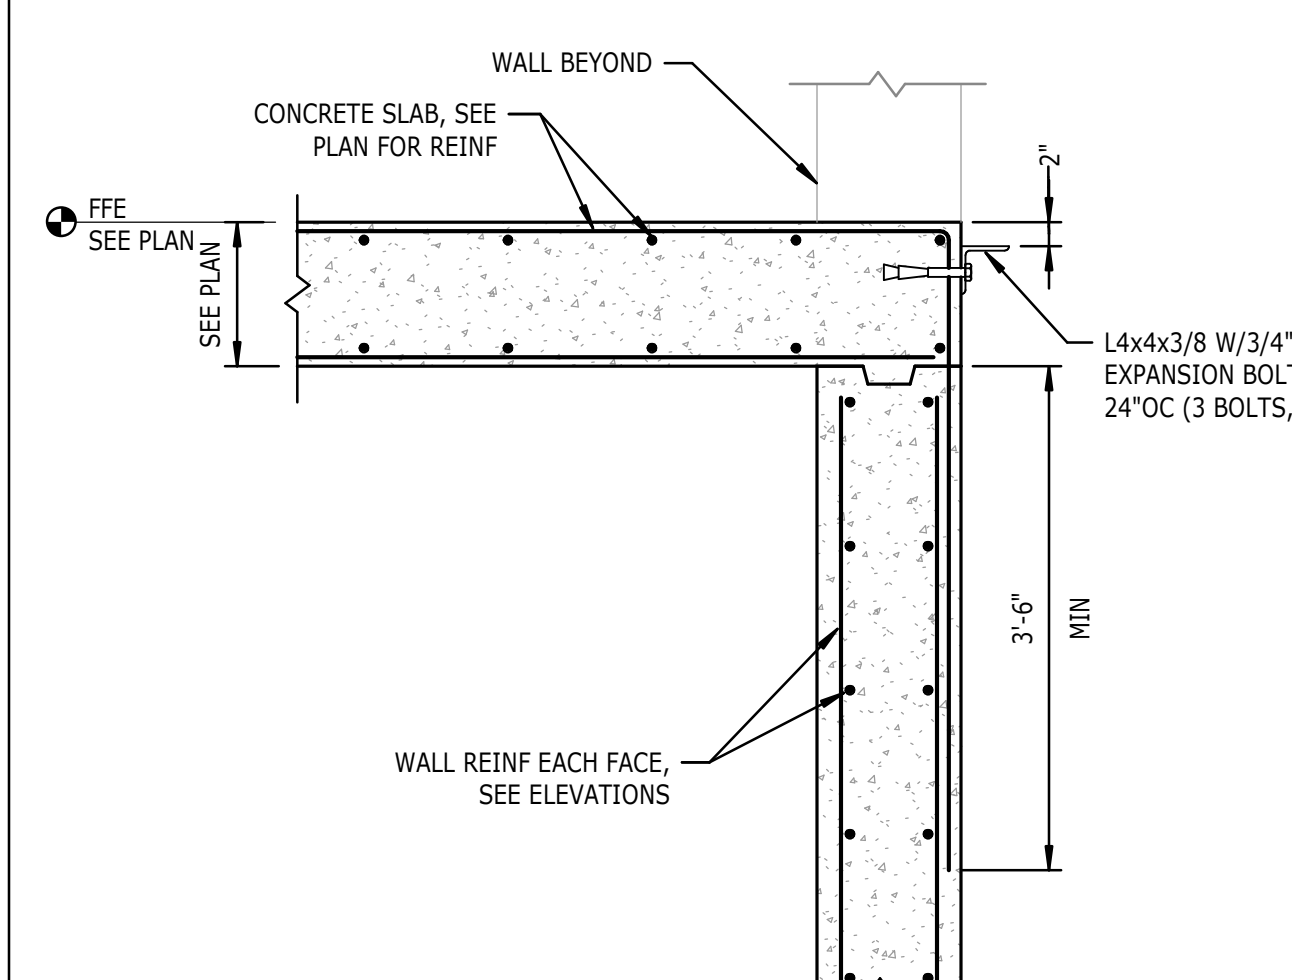

**19 DETAIL**  
S-322 TYPICAL ELEVATOR SILL  
NTS  
NOTES:  
1. COORDINATE ELEVATOR SILL REQUIREMENTS WITH ELEVATOR MANUFACTURER.

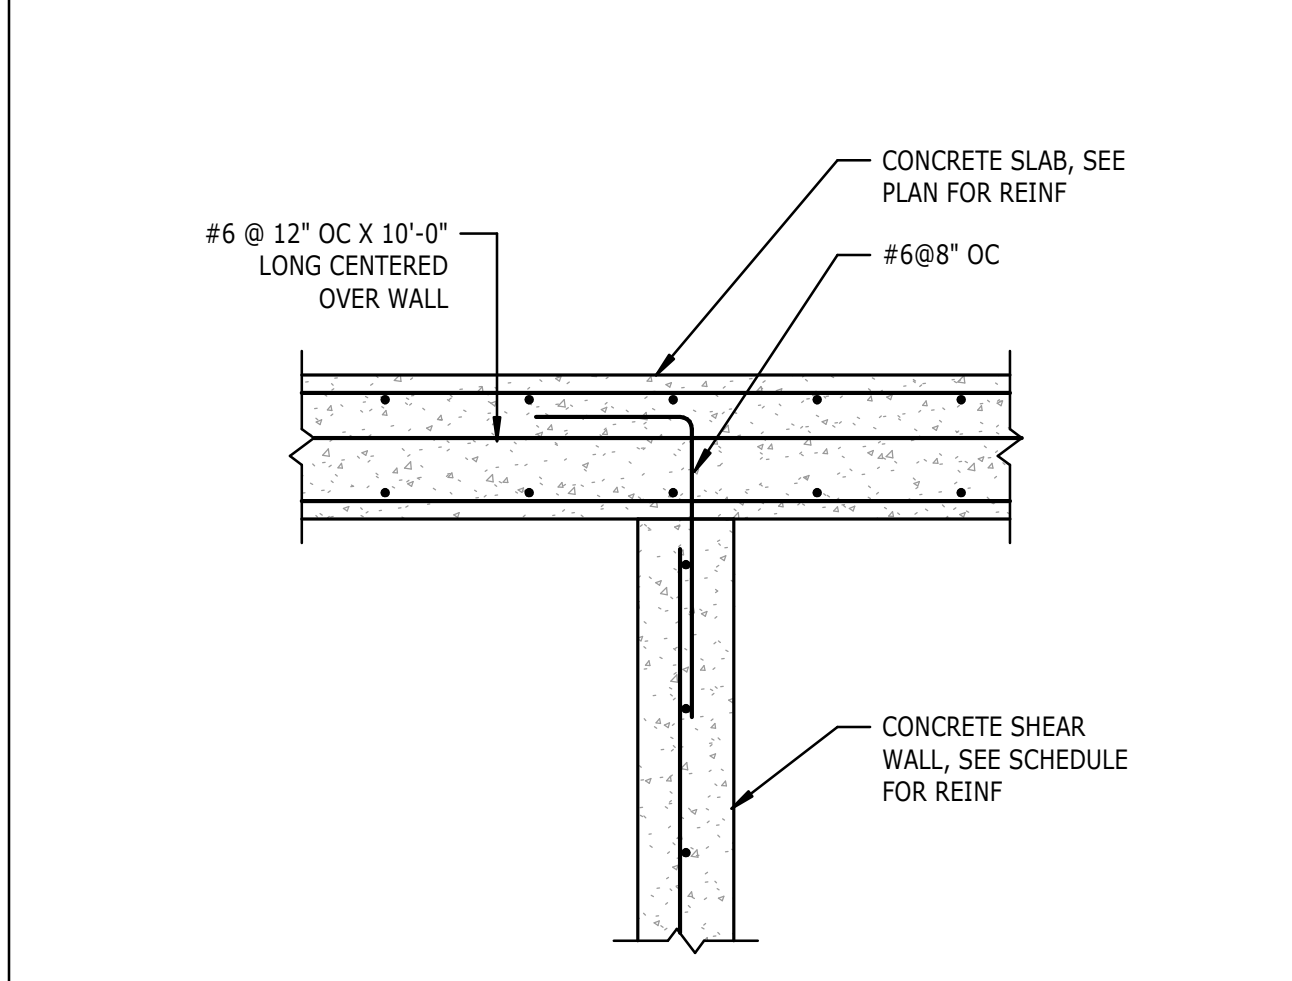

**20 SECTION**  
S-322 TYPICAL AT CONCRETE SHEAR WALLS  
3/4" = 1'-0"

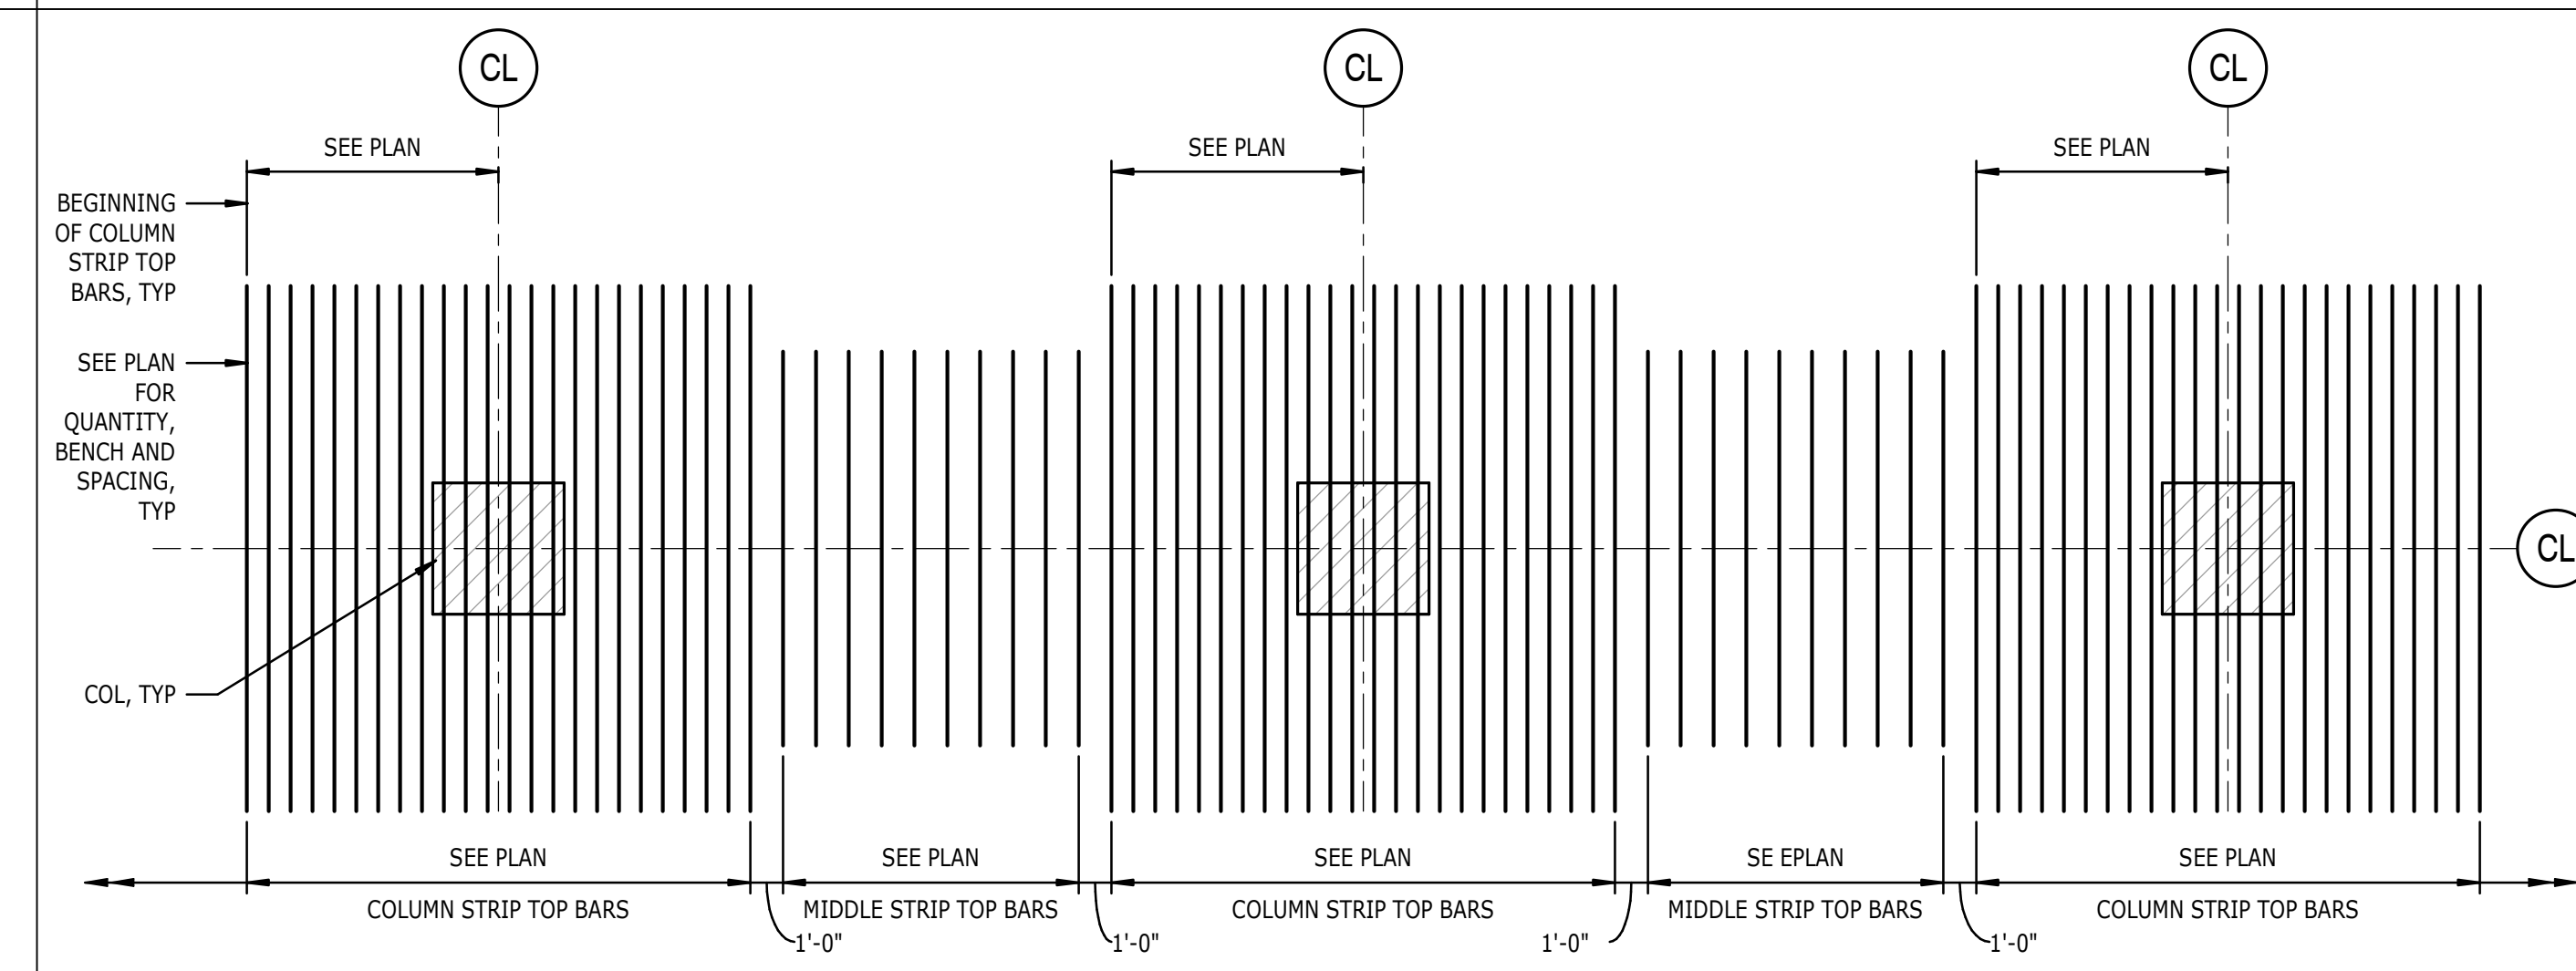


**12 DETAIL**  
S-322 TYPICAL FLAT PLATE TOP BAR ARRANGEMENT PLAN  
NTS  
NOTES:  
1. BARS SHOWN IN ONE DIRECTION ONLY FOR CLARITY. PROVIDE SAME DETAIL FOR TOP BARS IN THE OTHER DIRECTION ALSO.


STRIP	BAR	MINIMUM % OF AS AT SECT	DIAGRAM	REMARKS
COLUMN STRIP	TOP	65%		E=0.30ln W/OUT DROP PANELS E=0.33ln W/ DROP PANELS B=0.20L X=STANDARD HOOK**
	BOTTOM	35%		P=30 BAR DIA. OR 1'-6" MIN S=1.032L MAX X=DEVELOPMENT LENGTH
MIDDLE STRIP	TOP	100%		C=0.22ln X=STANDARD HOOK**
	BOTTOM	50%		

\* WHERE ADJACENT SLAB SPANS ARE UNEQUAL, TOP BAR LENGTHS SHALL BE BASED ON LONGER SPAN.  
\*\* WHERE EXTERIOR SUPPORT IS A WALL, EXTEND HOOKED TOP BARS ONE SPLICE LENGTH MINIMUM INTO TOP OF WALL, UNO.


**1 DETAIL**  
S-322 TYPICAL FLAT PLATE BAR CUT-OFF DIAGRAM  
NTS  
NOTES:  
1. WHEN DRAWINGS REQUIRE LONG BAR CUT-OFF DIMENSION "E" TO BE INCREASED, DIMENSIONS "B" AND "C" SHALL BE INCREASED PROPORTIONALLY (B=0.61E, AND C=0.67E).  
2. WHERE DRAWINGS INDICATE 100% OF COLUMN STRIP TOP REINFORCING TO BE LAPPED AT MIDSPAN, AT LEAST 50% OF ADJACENT MIDDLE STRIP REINFORCING SHALL ALSO BE LAPPED.

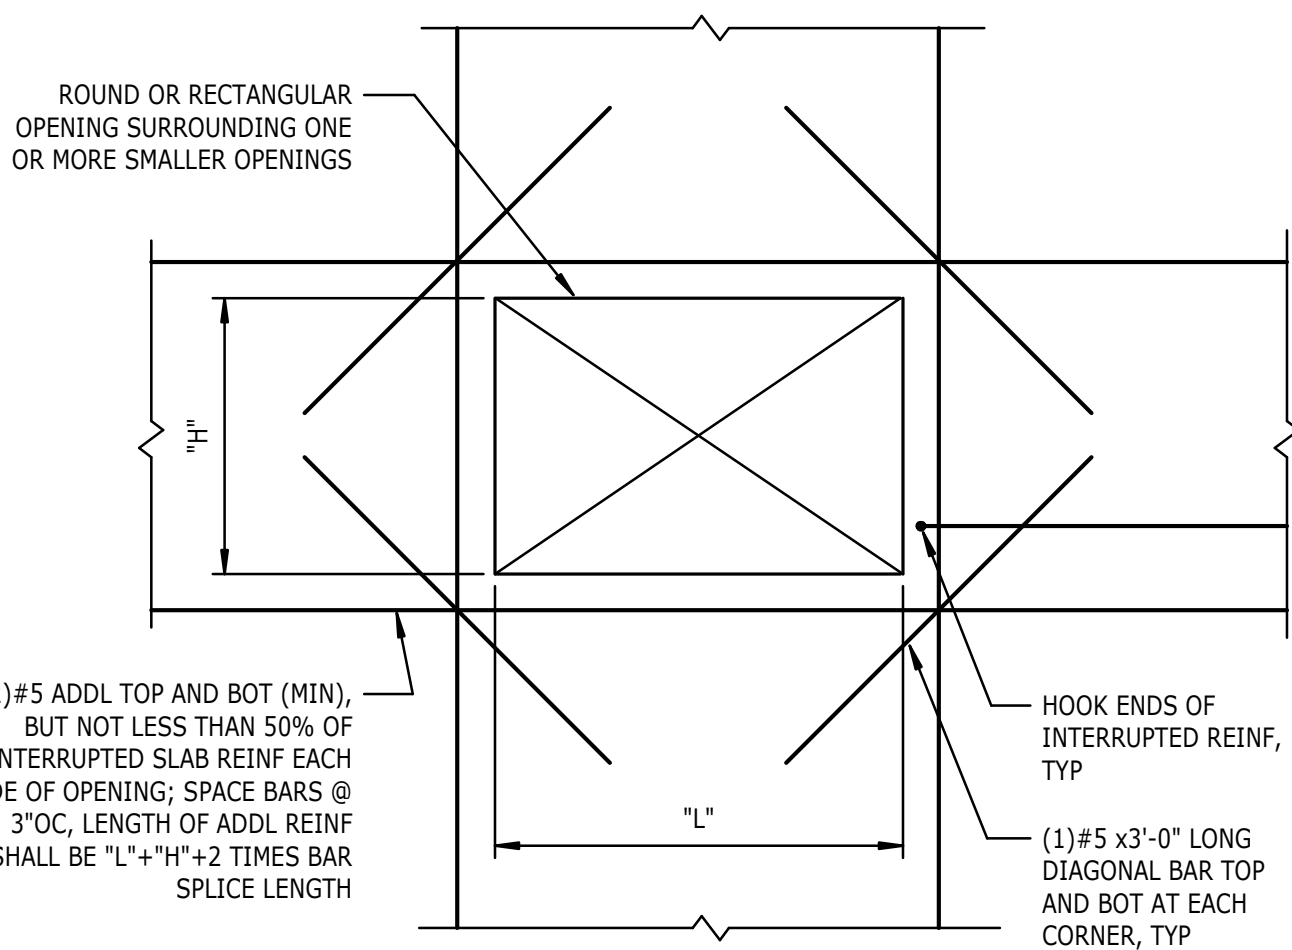


**7 DETAIL**  
S-322 TYPICAL REINFORCING AT OPENINGS IN FRAMED CONCRETE SLABS  
NTS  
NOTES:  
1. SLAB OPENINGS SHALL BE COORDINATED AND DETAILED ON THE REINFORCEMENT SHOP DRAWINGS.  
2. OPENINGS NOT TO EXCEED 3'-0" IN EITHER DIRECTION.  
3. MAXIMUM CORED OPENING WITHOUT SLEEVE SHALL BE 6"Ø. MINIMUM CENTER TO CENTER SPACING OF CORED OPENINGS TO BE 1'-6".

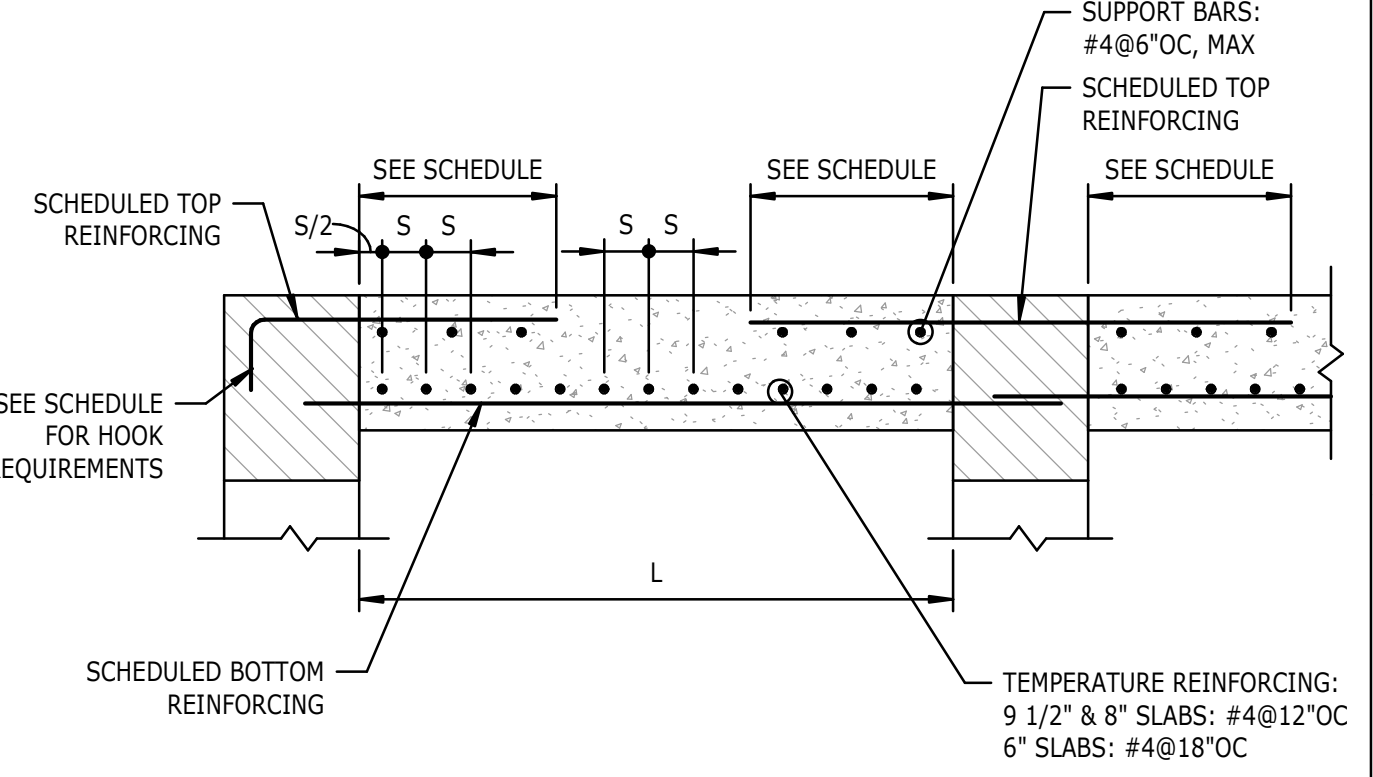

**3 DETAIL**  
S-322 TYPICAL ONE WAY SLAB REINFORCEMENT  
NTS  
NOTES:  
1. TEMPERATURE REINFORCEMENT SHALL BE PLACED PERPENDICULAR TO SCHEDULED REINFORCING STEEL, ABOVE BOTTOM SCHEDULED REINFORCEMENT. SEE DETAIL.  
2. REFER TO SLAB SCHEDULE FOR ALL PRIMARY REINFORCING SIZES, LENGTHS, AND SPACINGS.  
3. LAP ALL TEMPERATURE REINFORCEMENT AND SUPPORT BARS 30 BAR DIAMETERS, BUT NOT LESS THAN 12".  
4. "S" DENOTES TEMPERATURE REINFORCEMENT SPACING.

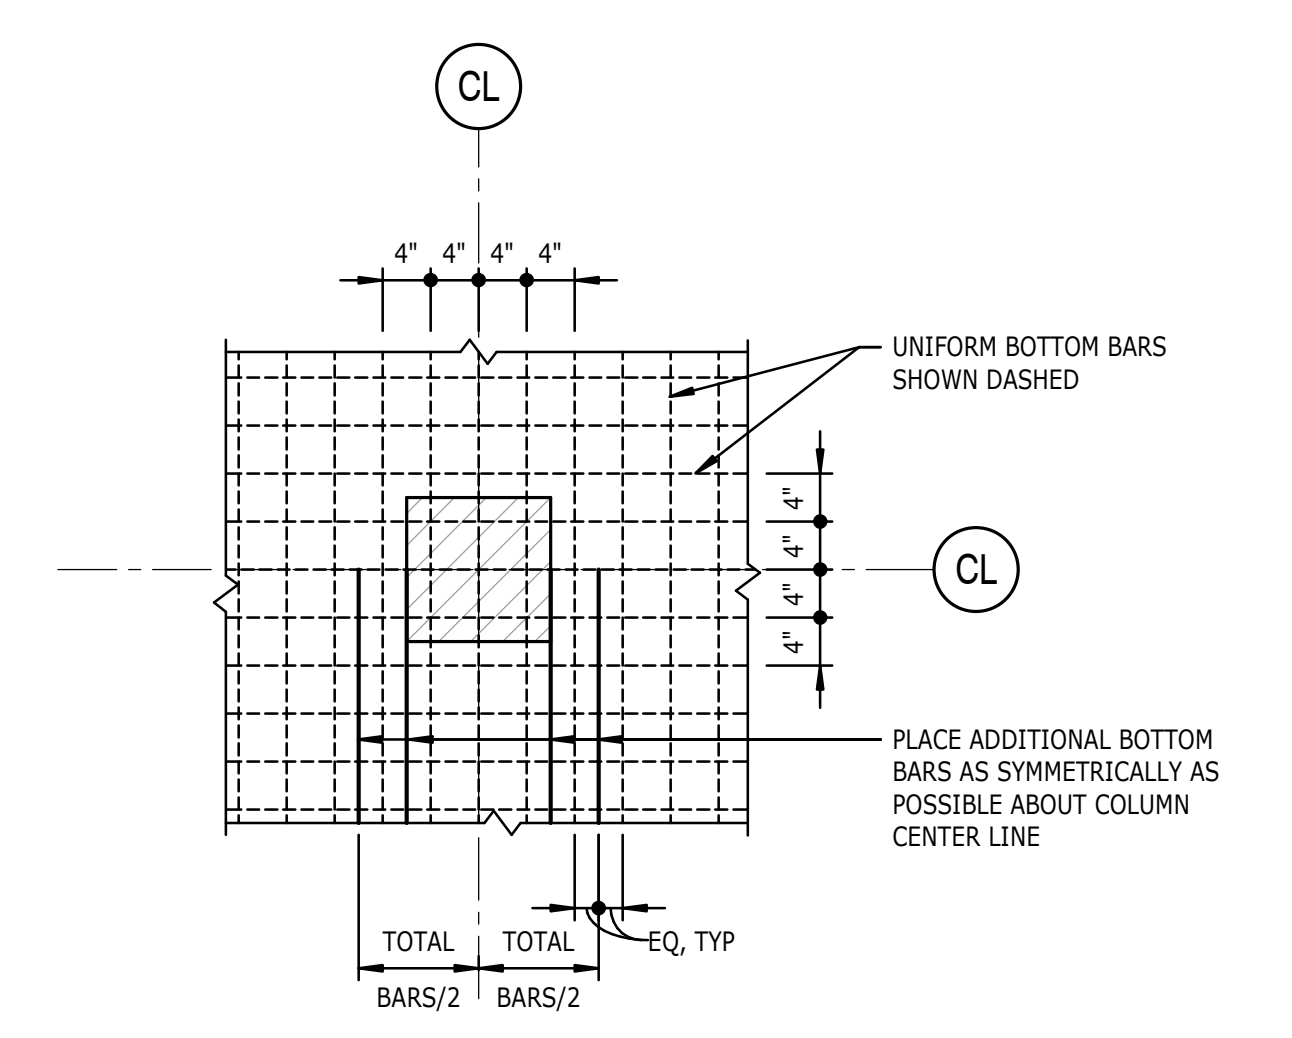

**8 DETAIL**  
S-322 TYPICAL FLAT PLATE BOTTOM BAR ARRANGEMENT PLAN  
NTS

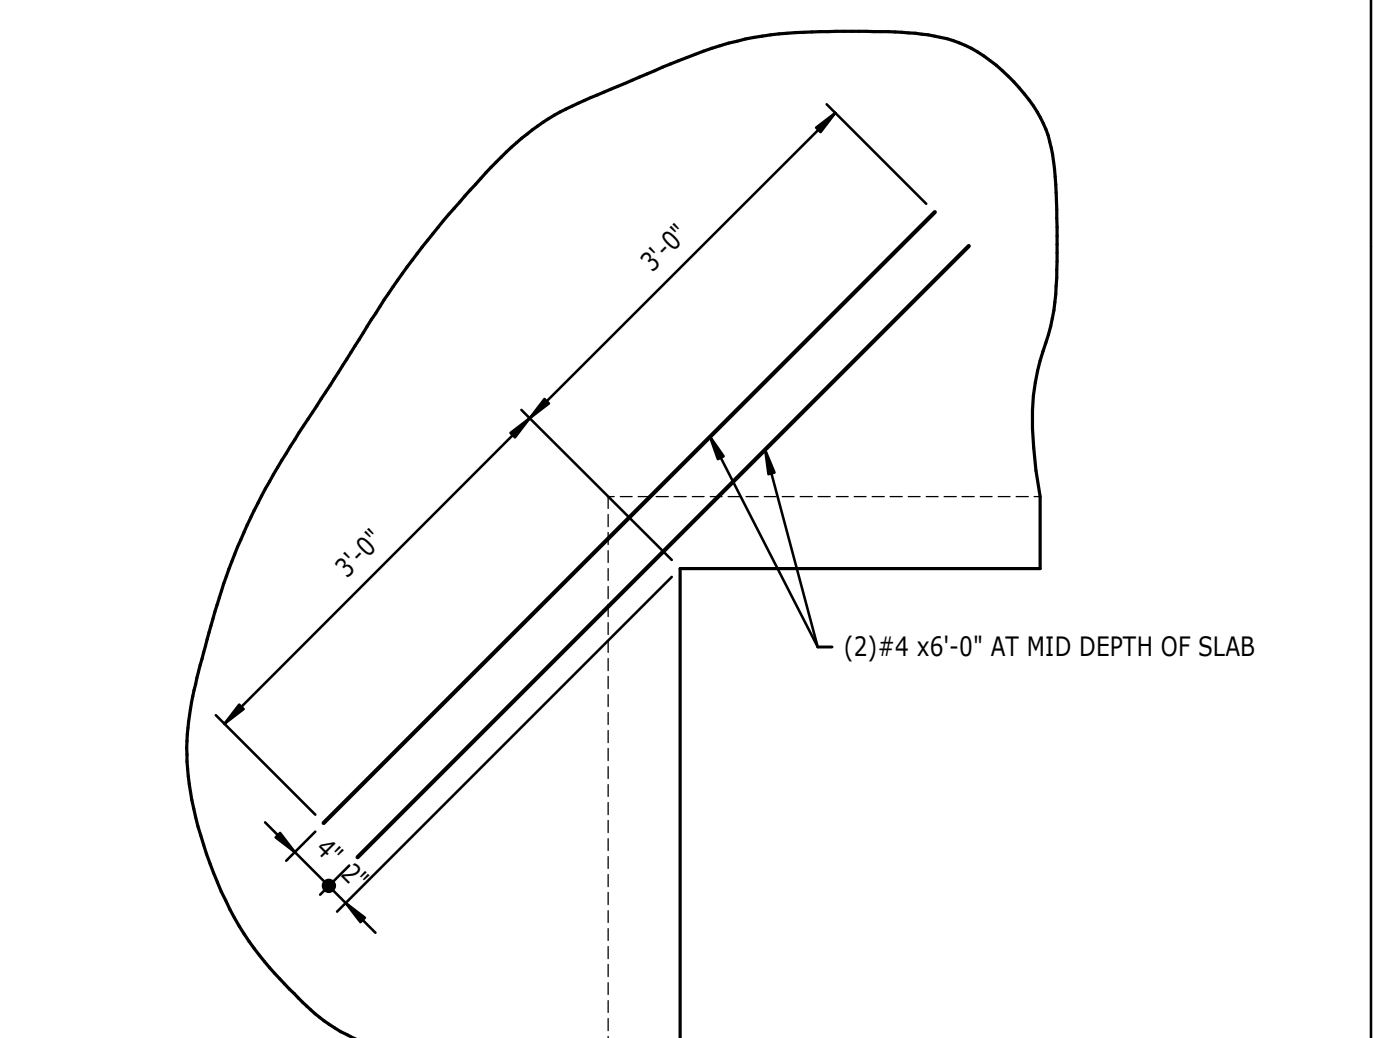


**4 DETAIL**  
S-322 TYPICAL REINFORCING AT INSIDE CORNERS  
NTS  
NOTES:  
1. DETAILS APPLIES AT ALL SLAB RE-ENTRANT CORNERS.





TERMINAL IMPROVEMENTS CONTRACT 3

Wilmington International Airport  
1740 Airport Boulevard, Suite 12  
Wilmington, NC 28405

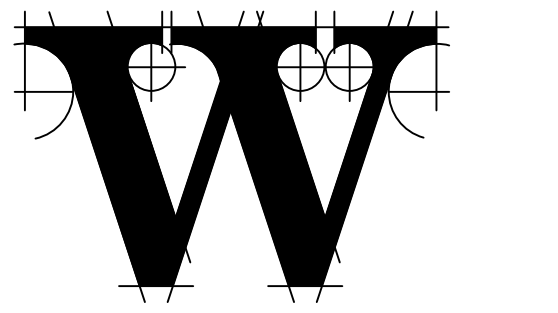

THE WILSON GROUP ARCHITECTS

PO Box 5510 Charlotte, NC 28299  
704-331-9747 • www.twgarchitects.com

PROJECT MANAGER & CIVIL ENGINEER  
**TALBERT & BRIGHT**

CONSULTING ARCHITECT  
**LS3P**

STRUCTURAL ENGINEER  
FIRM LICENSE #C-1051  
**STEWART**

FP/PM/E ENGINEER  
**CHEATHAM & ASSOC.**

BAGGAGE HANDLING CONSULTANTS  
**BNP**

AIRCRAFT SUPPORT SYSTEMS  
**DK CONSULTANTS**

SPECIALTY LIGHTING CONSULTANT  
**HARTRANFT**

SINGAGE & WAYFINDING  
**TAKEFORM**

COPYRIGHT © 2019  
THE WILSON GROUP ARCHITECTS  
ALL RIGHTS RESERVED

PRINTED OR ELECTRONIC DRAWINGS AND DOCUMENTATION MAY NOT BE REPRODUCED IN ANY FORM WITHOUT WRITTEN PERMISSION FROM THE WILSON GROUP ARCHITECTS

REVISIONS

1 7/12/19 AD-01

3 7/30/19 AD-03

DATE 06/28/2019


PROJECT NUMBER 9202-000

SHEET TITLE


**CONCRETE FLOOR SECTIONS**

SHEET NUMBER


**S-341**

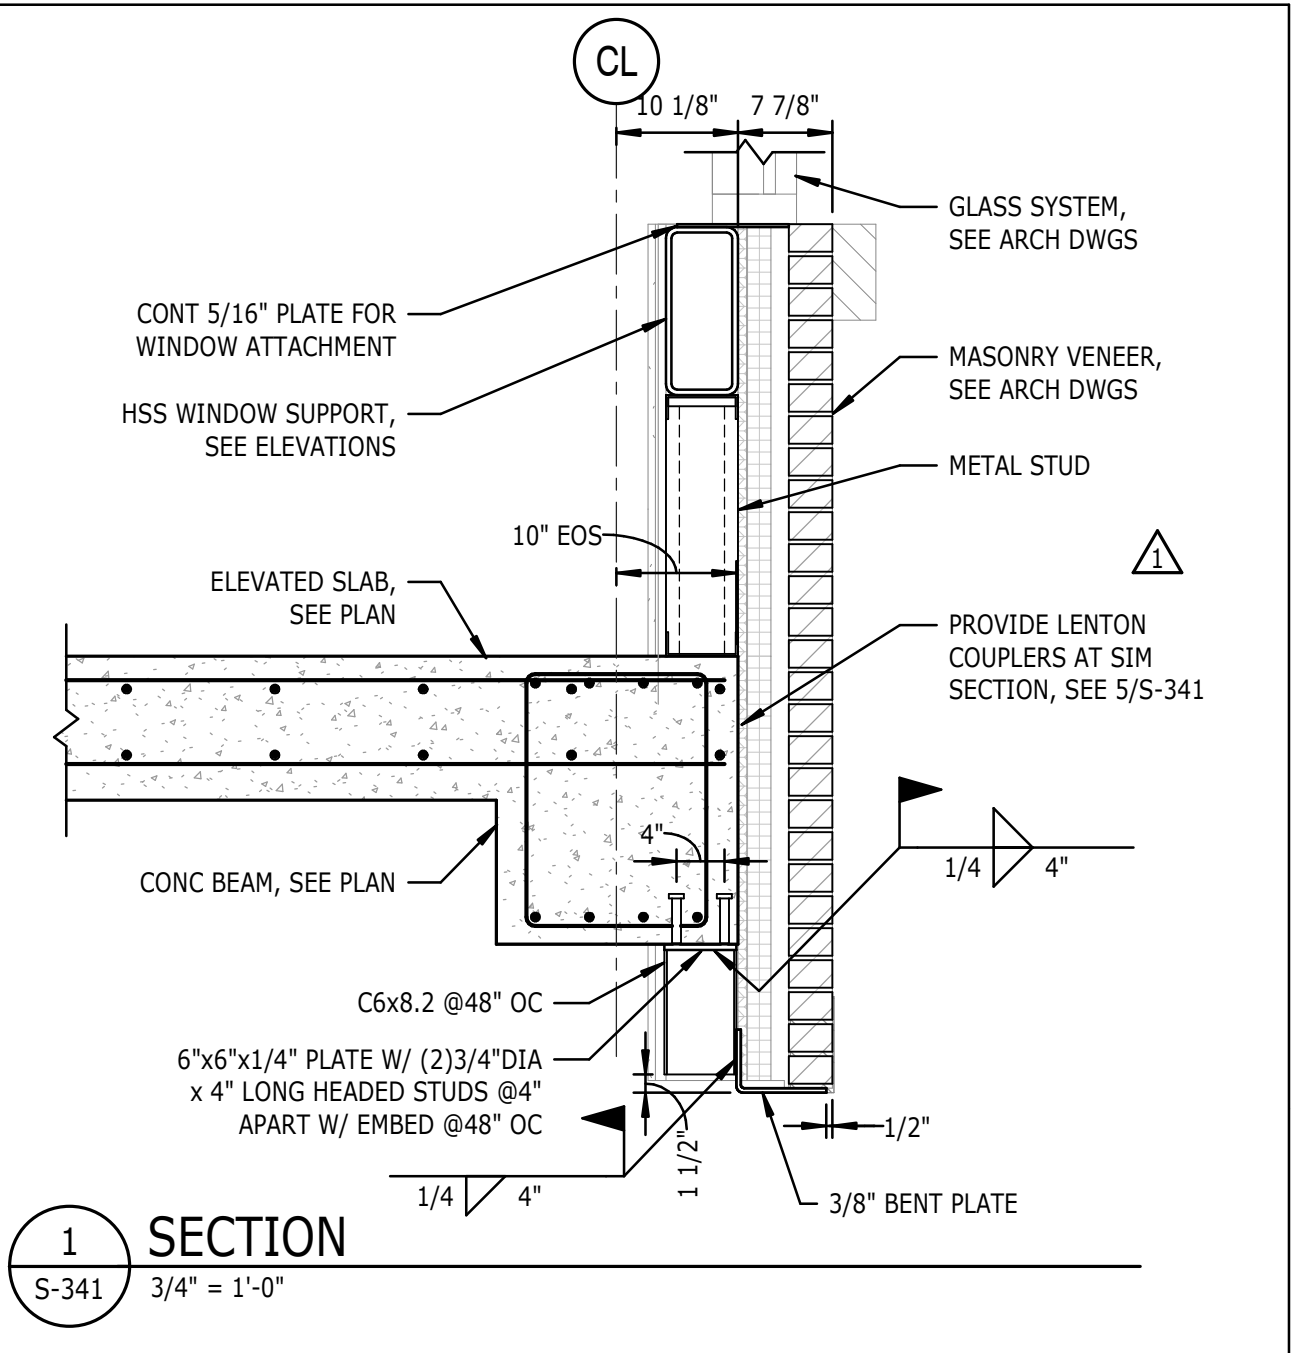


1 SECTION  
S-341 3/4" = 1'-0"

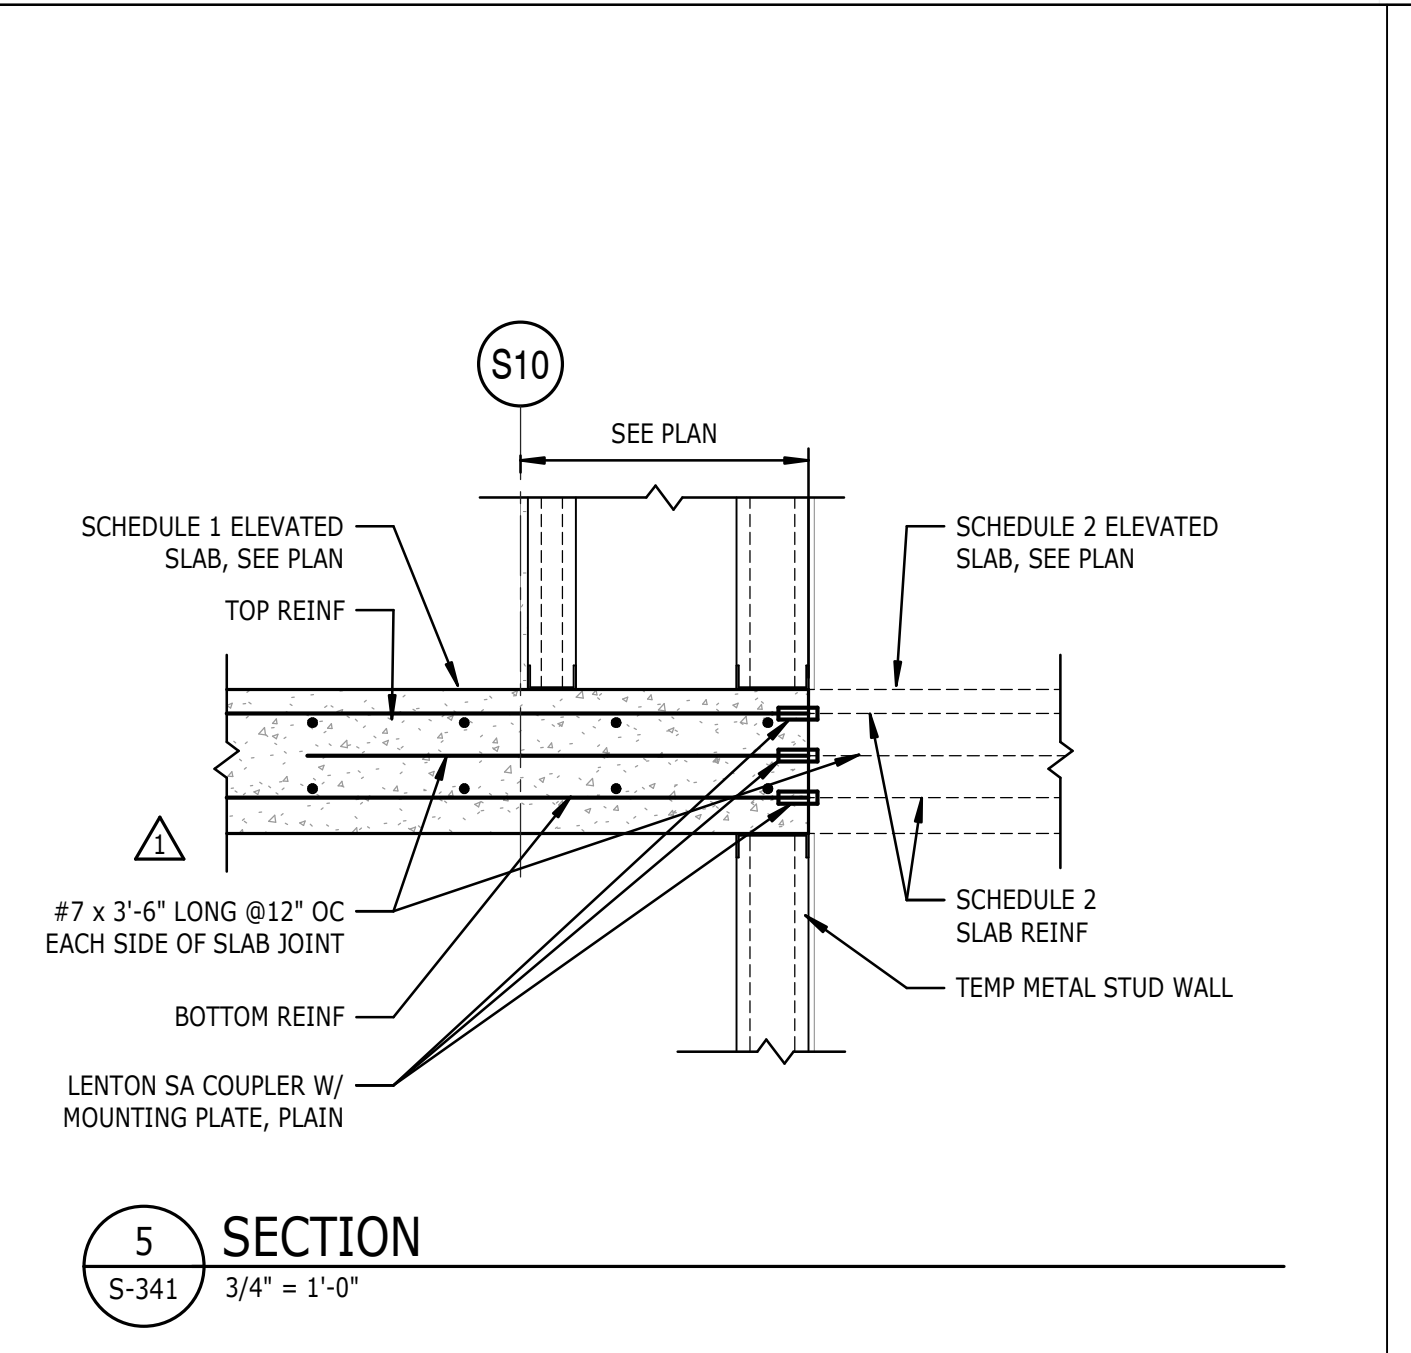


5 SECTION  
S-341 3/4" = 1'-0"

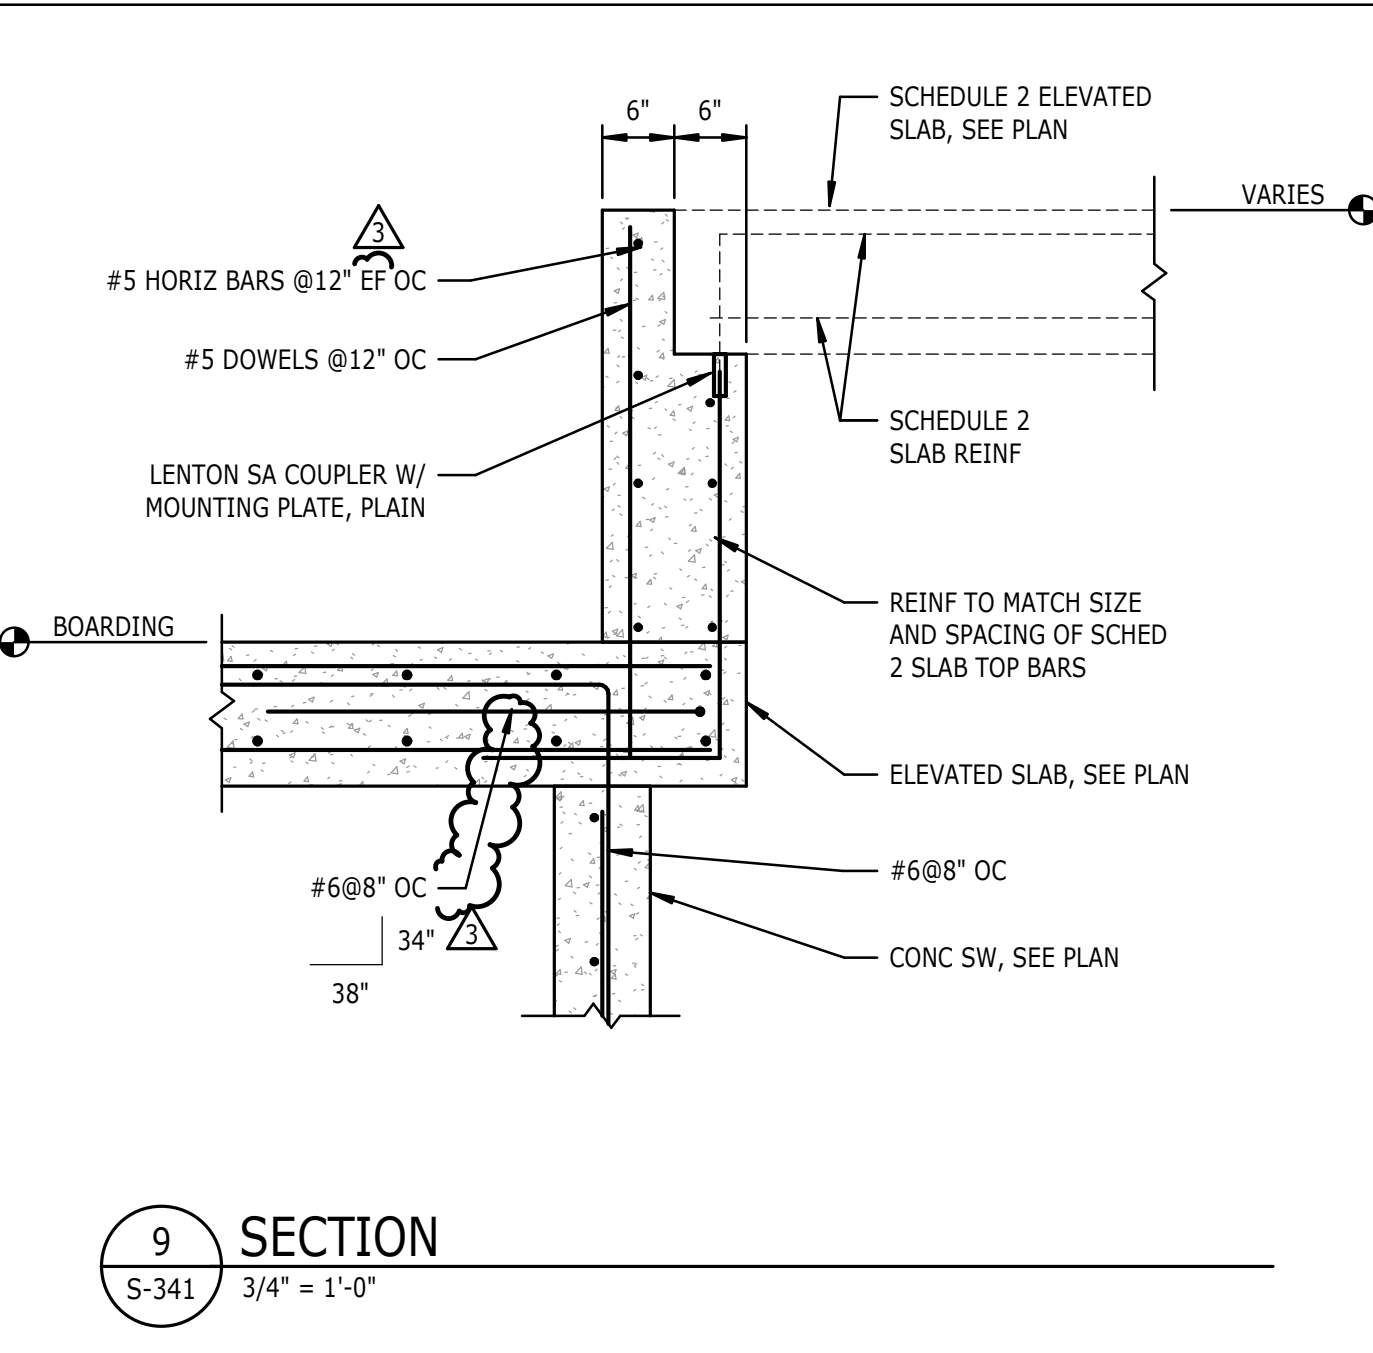


9 SECTION  
S-341 3/4" = 1'-0"

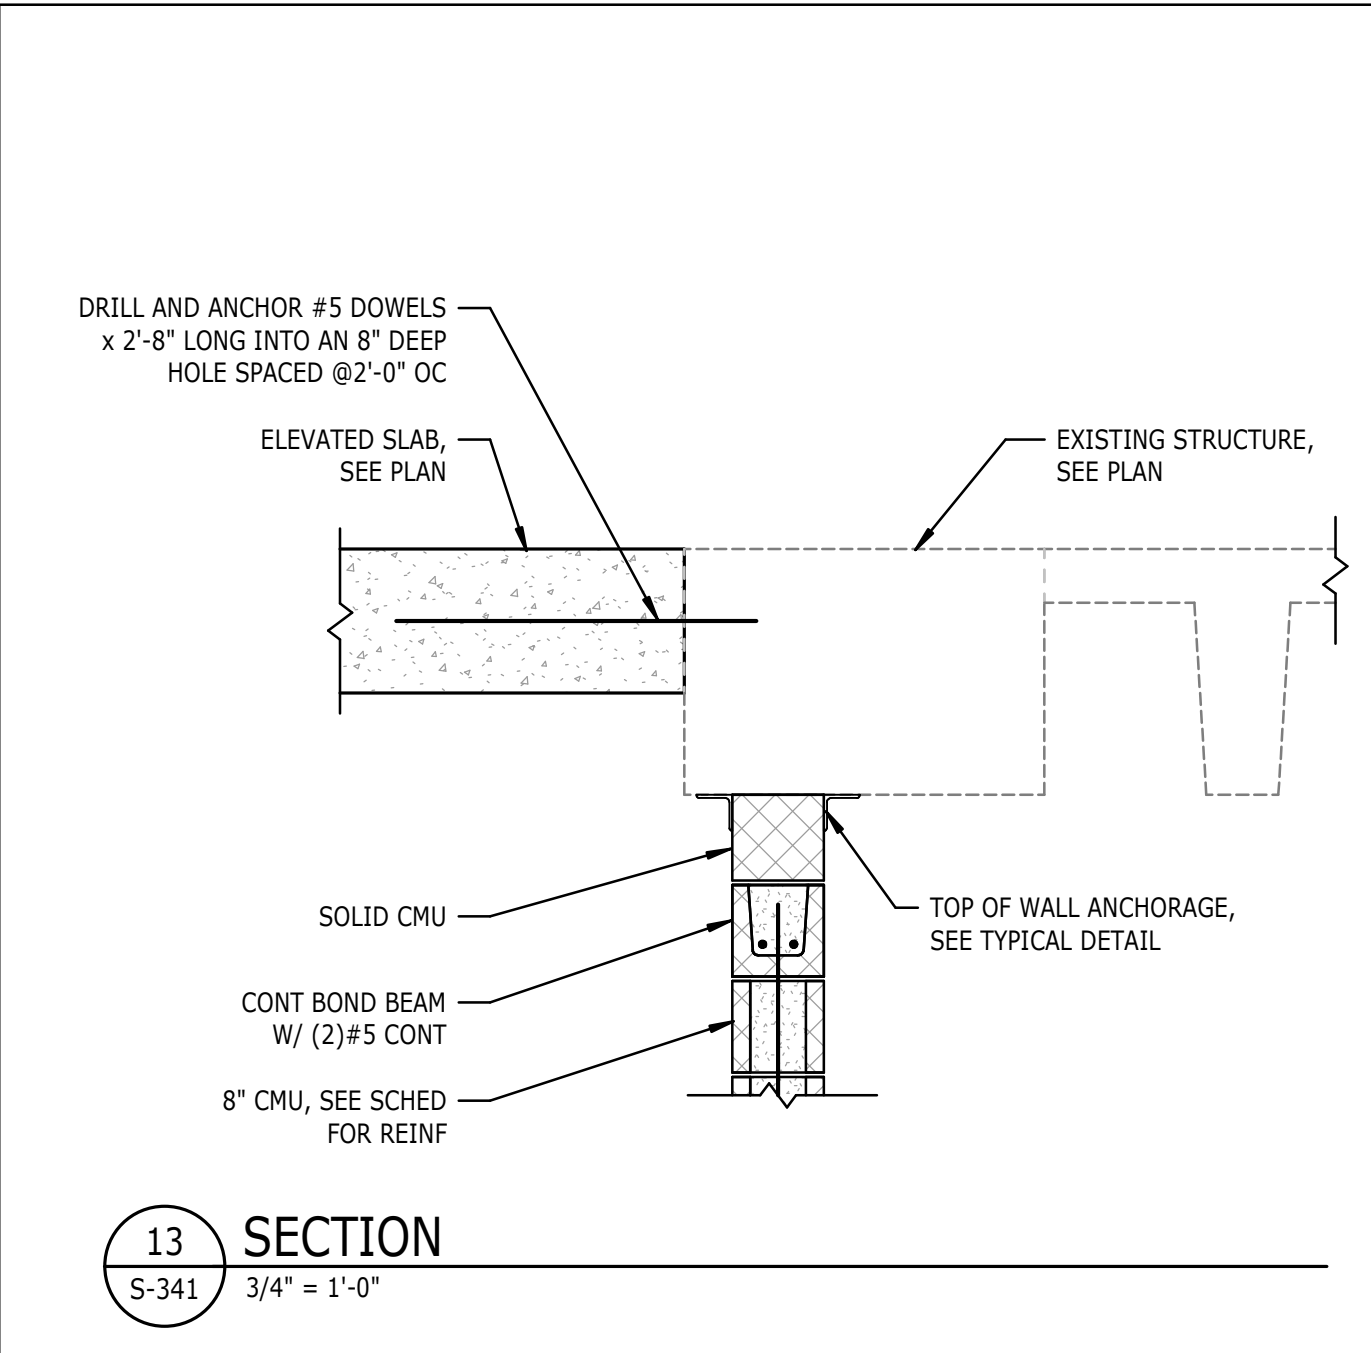


13 SECTION  
S-341 3/4" = 1'-0"

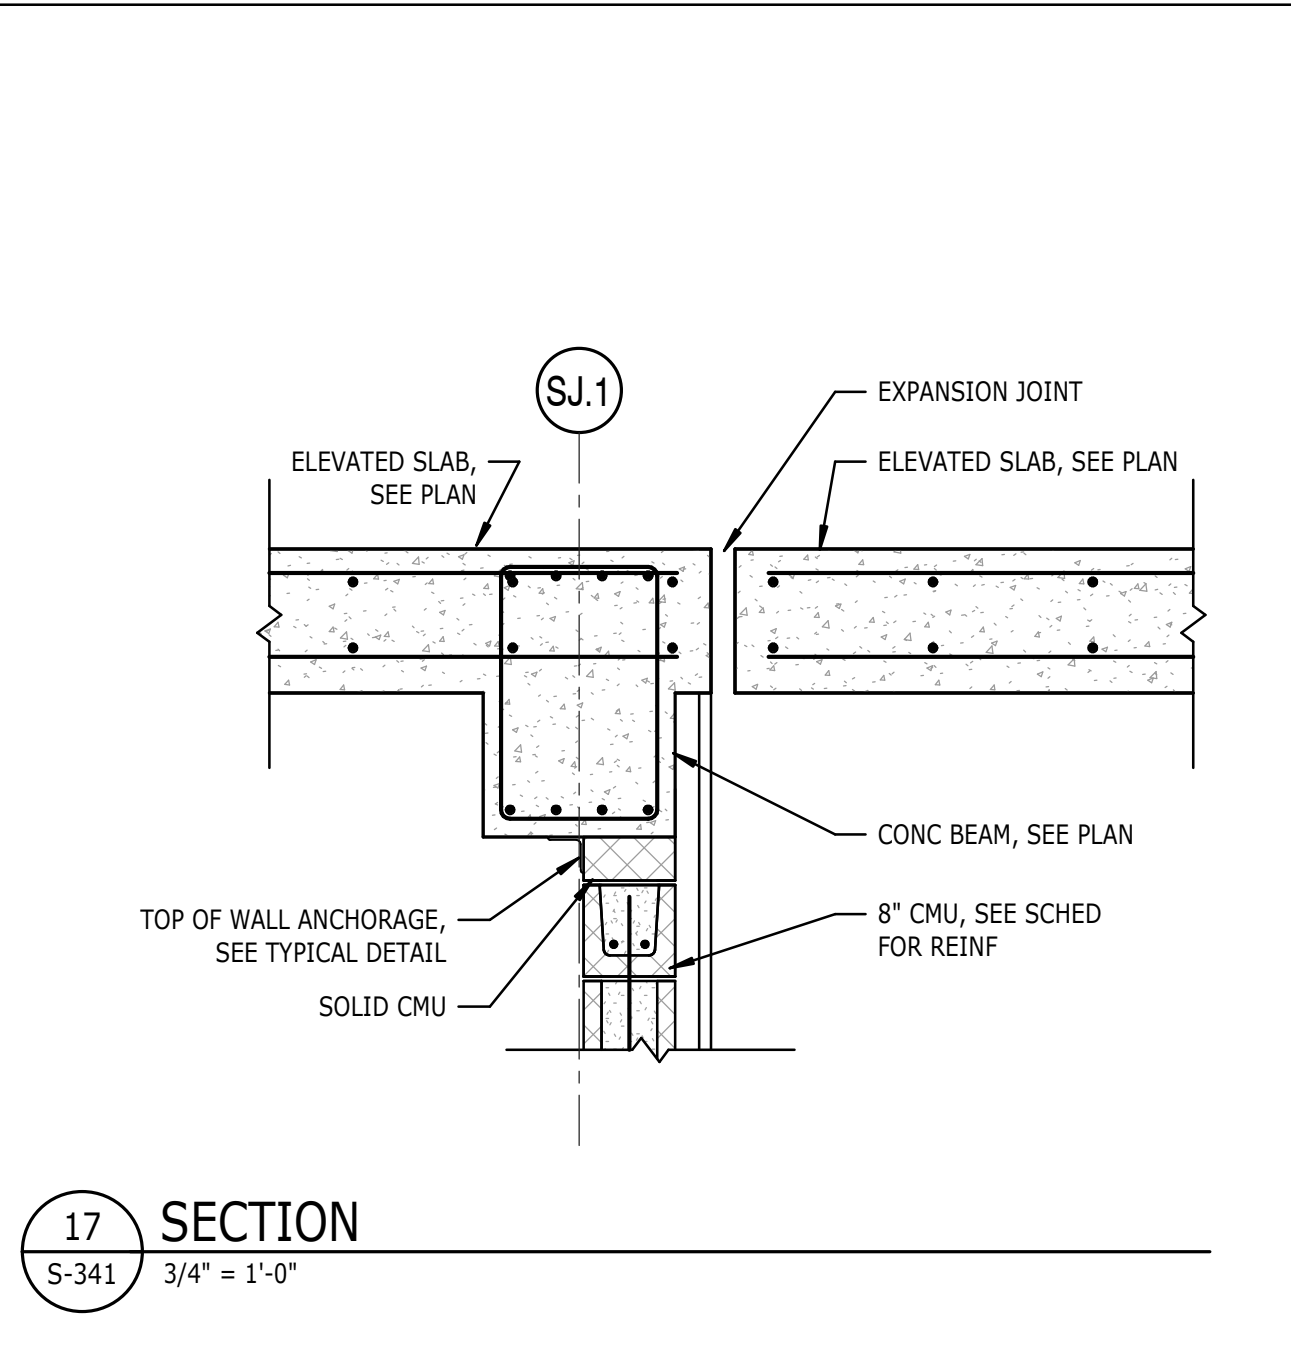


17 SECTION  
S-341 3/4" = 1'-0"

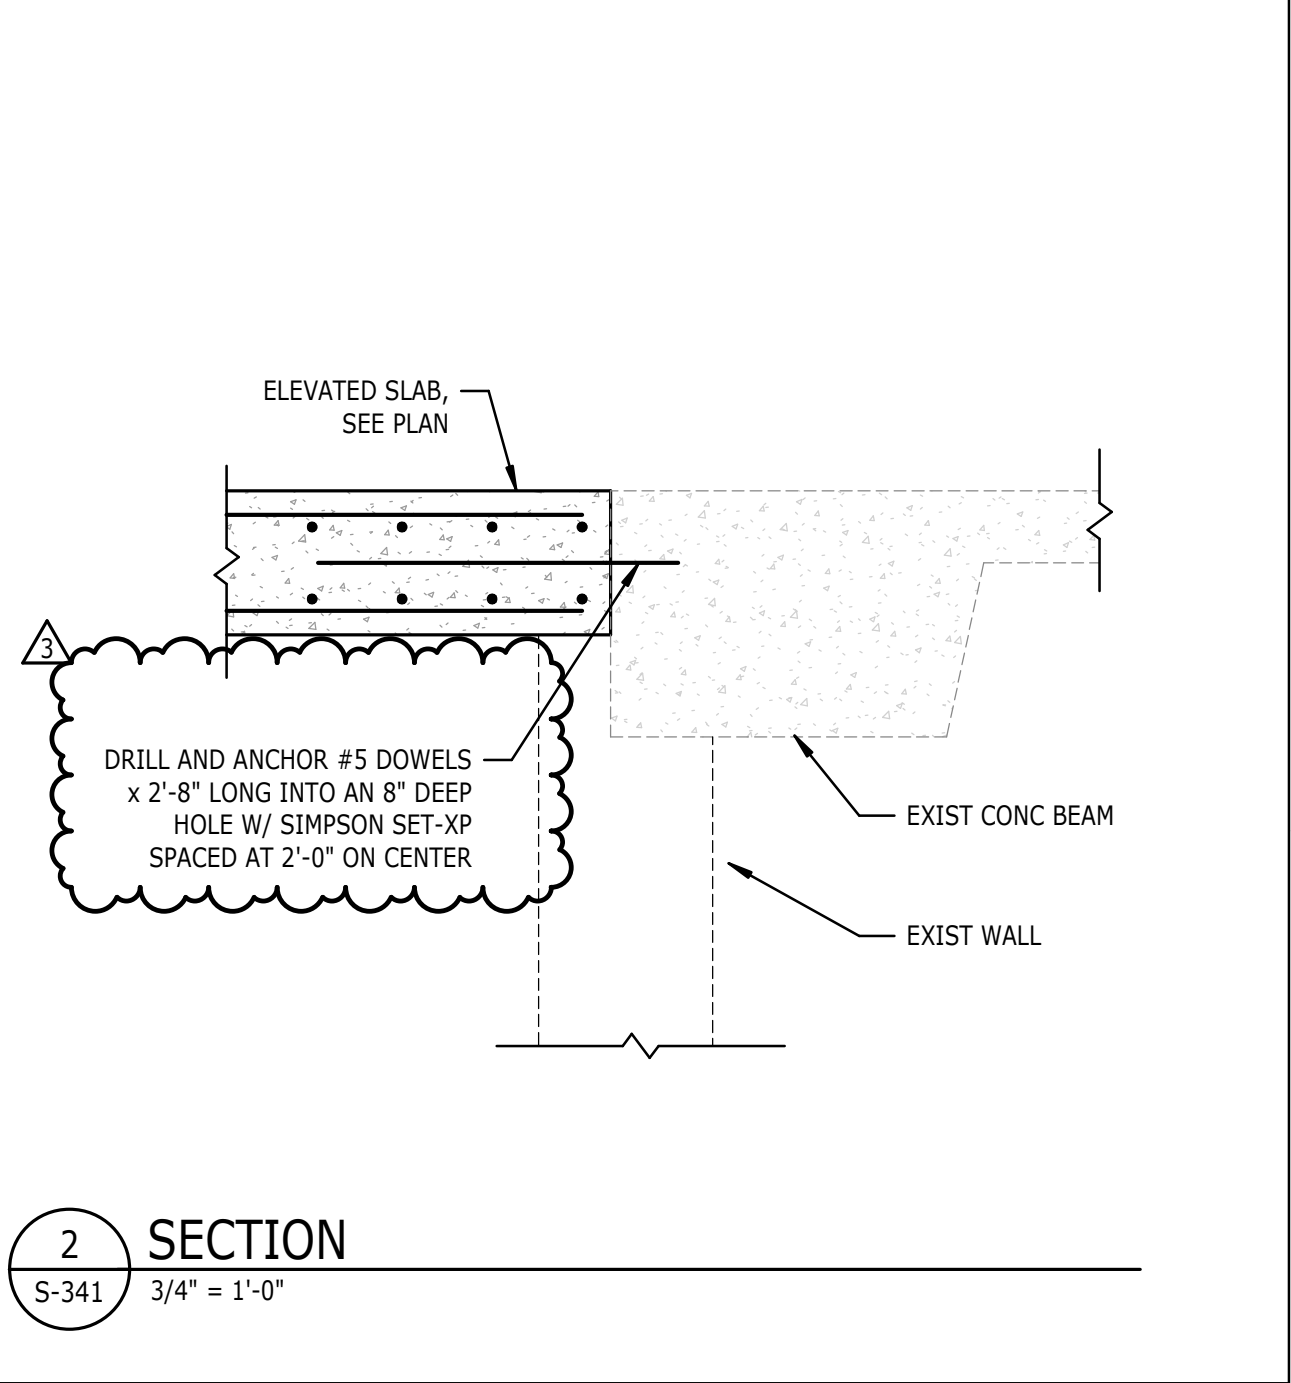


2 SECTION  
S-341 3/4" = 1'-0"

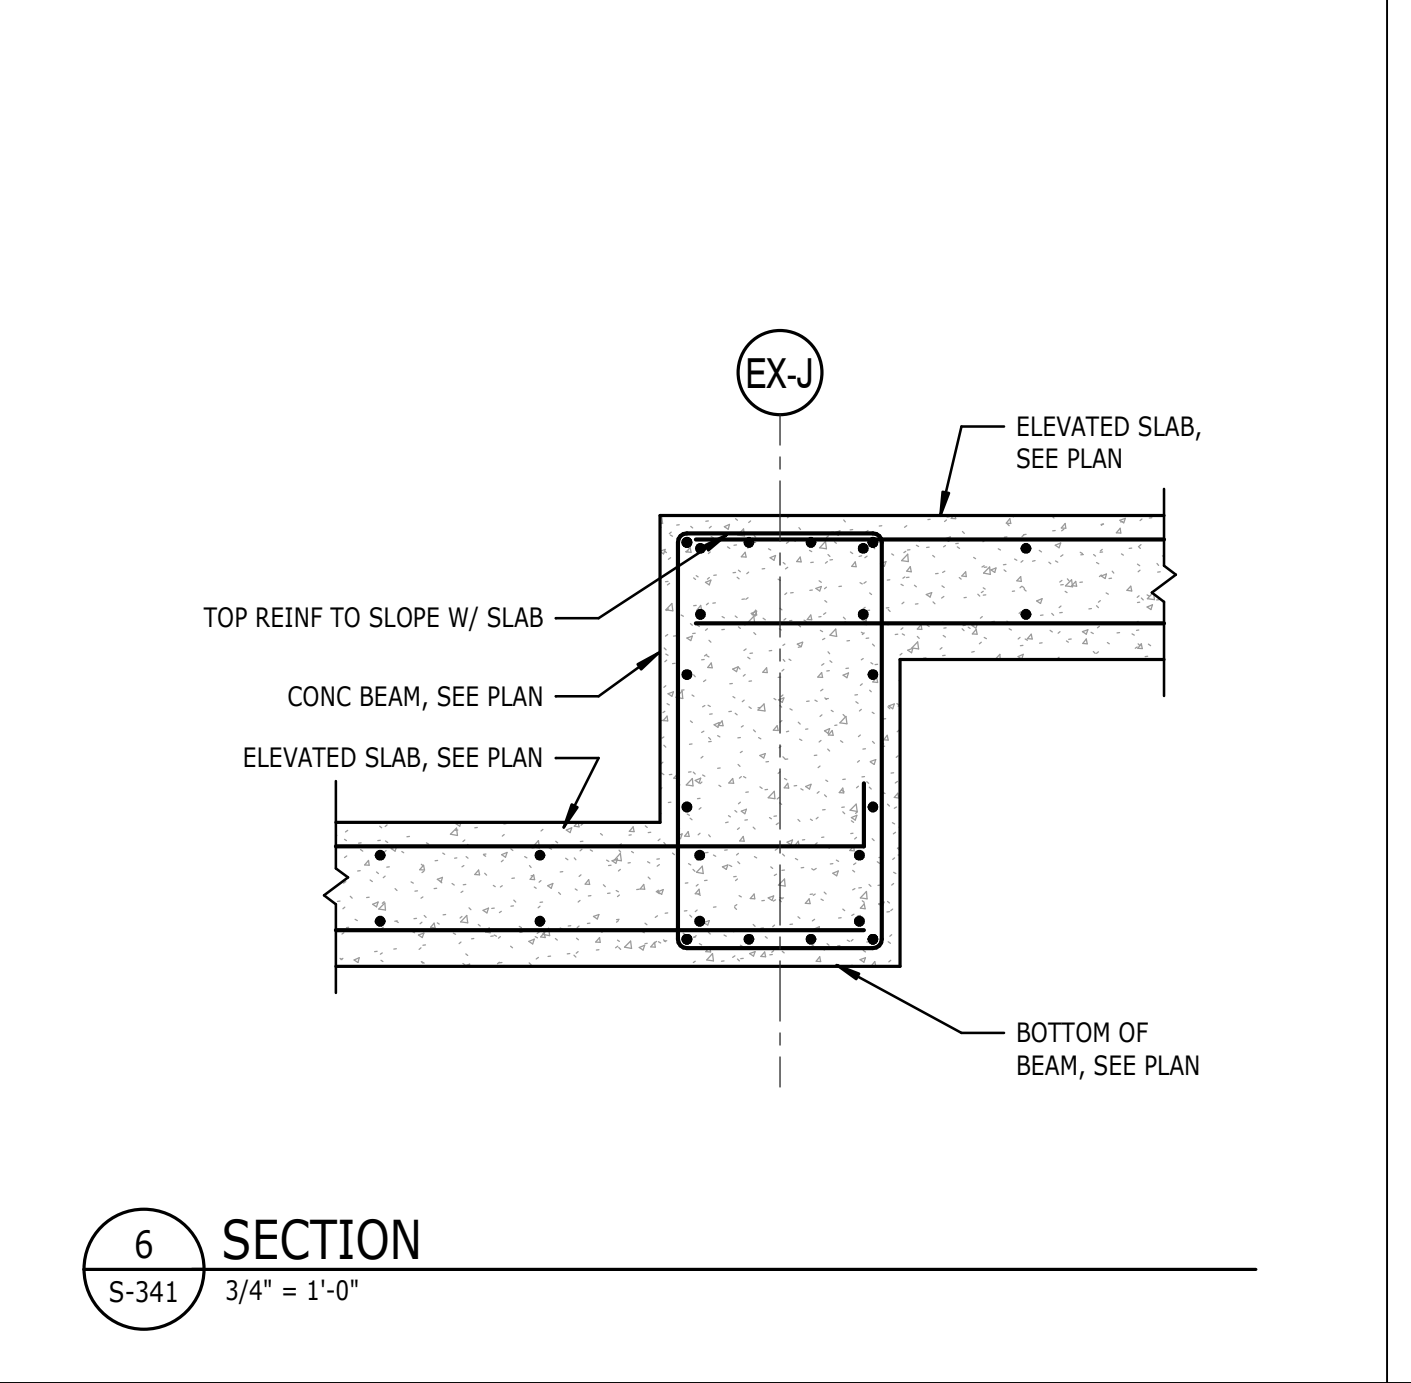


6 SECTION  
S-341 3/4" = 1'-0"

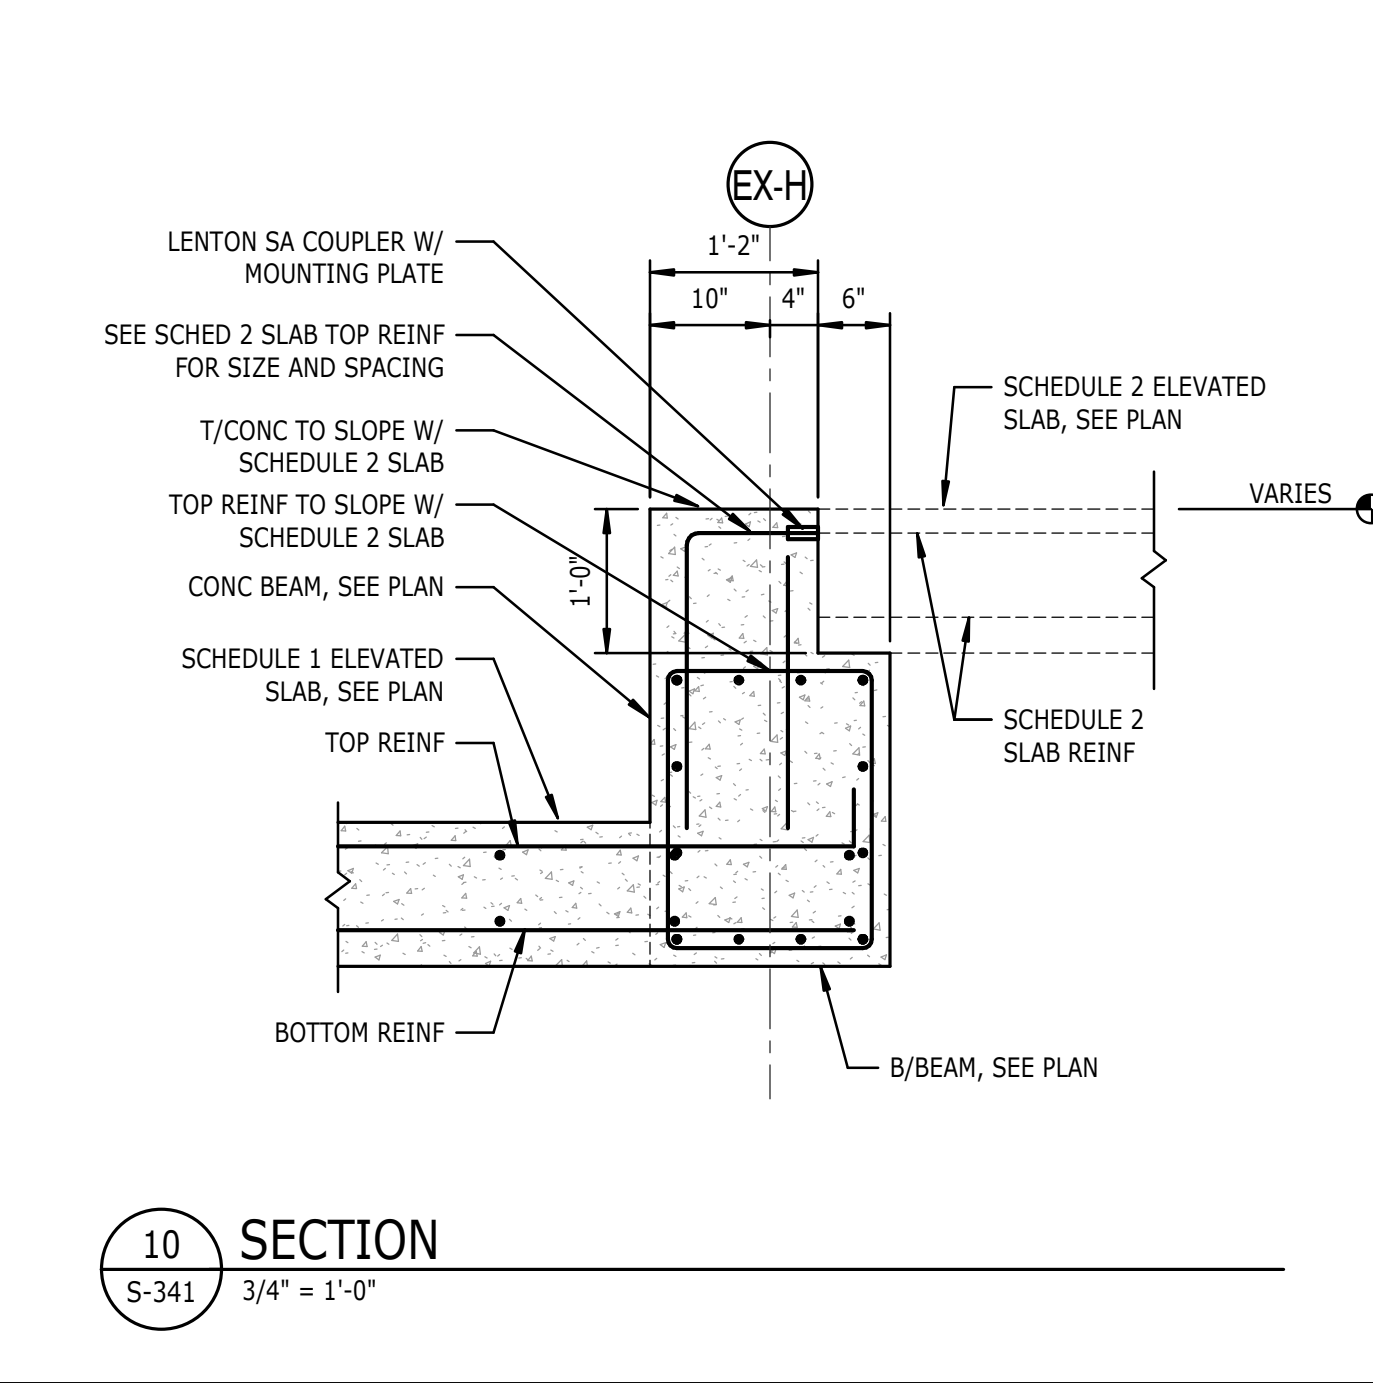


10 SECTION  
S-341 3/4" = 1'-0"

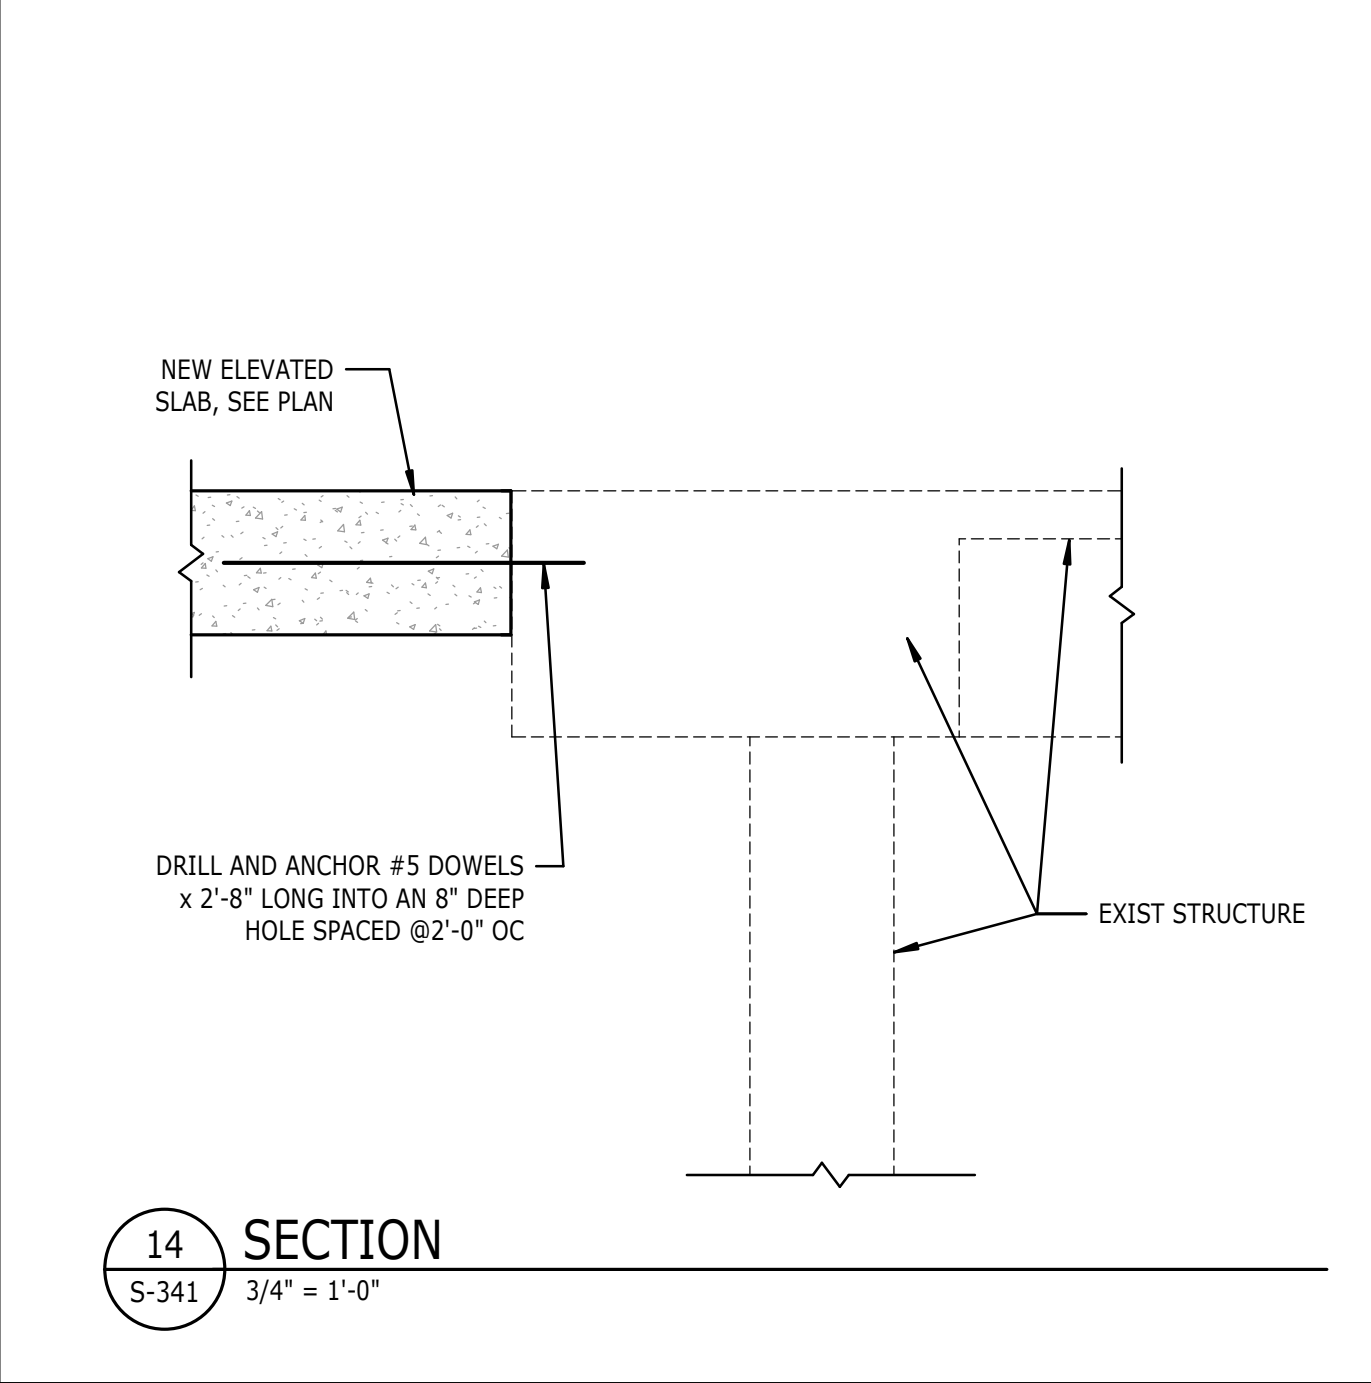


14 SECTION  
S-341 3/4" = 1'-0"

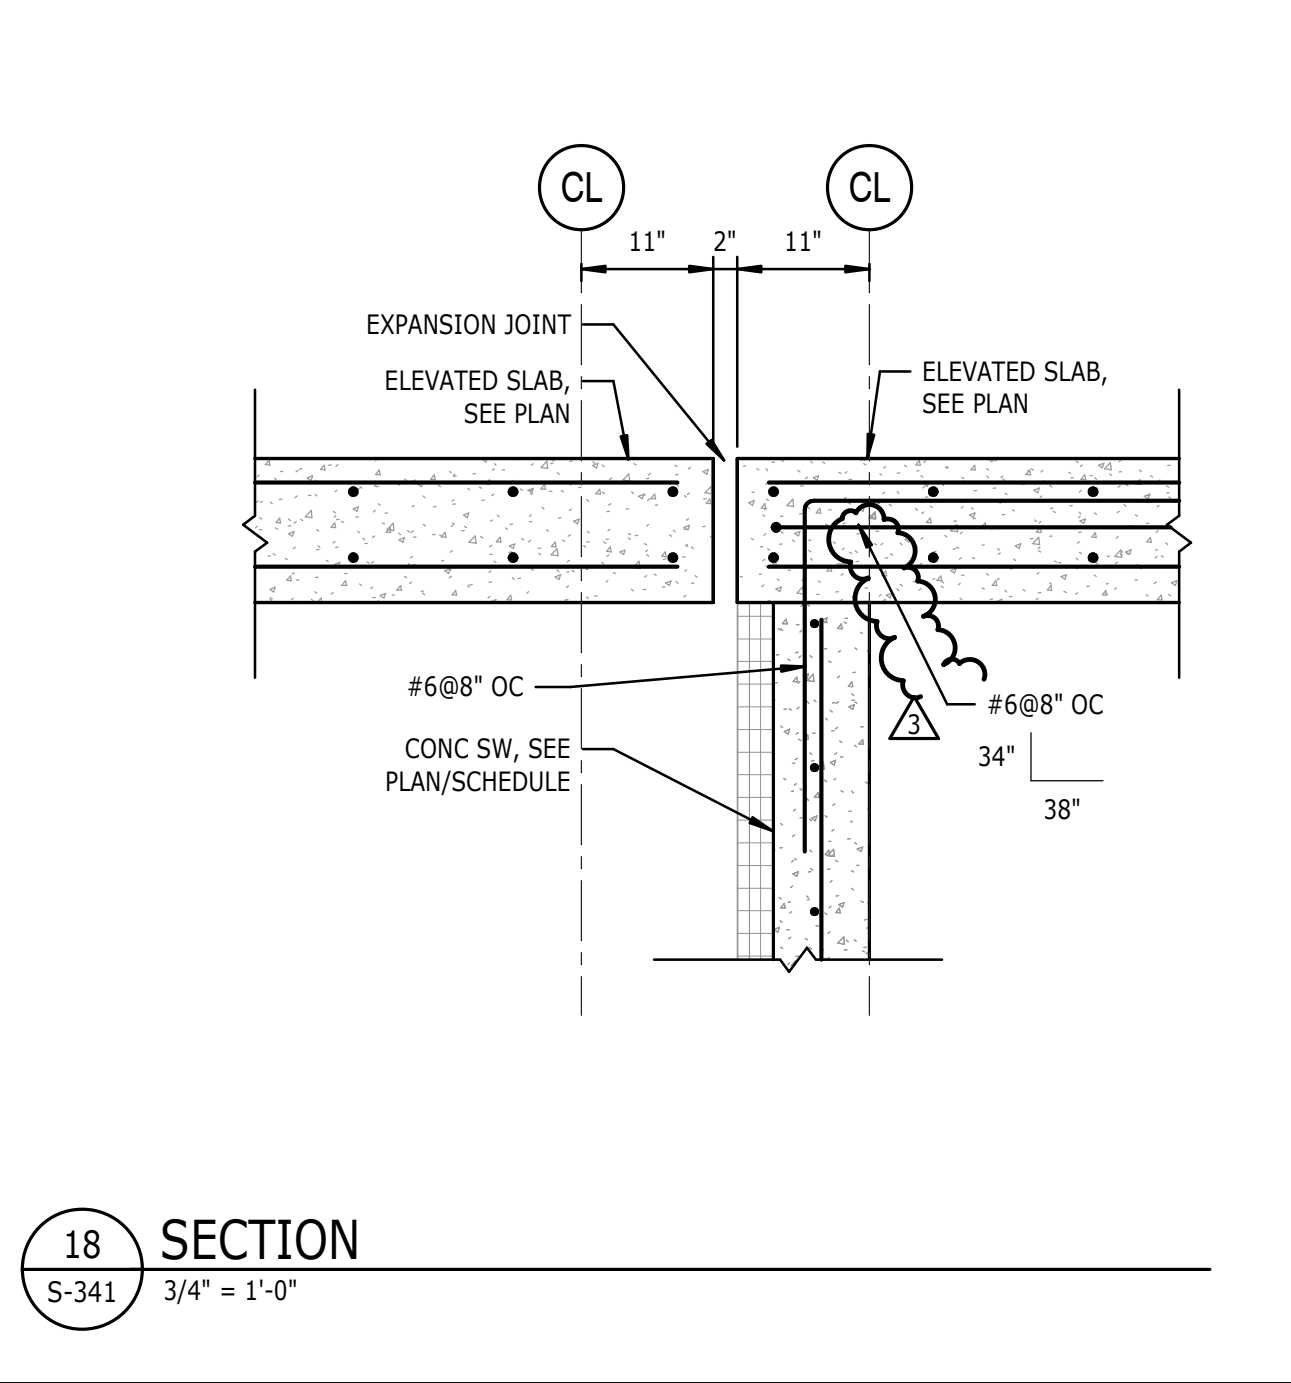


18 SECTION  
S-341 3/4" = 1'-0"

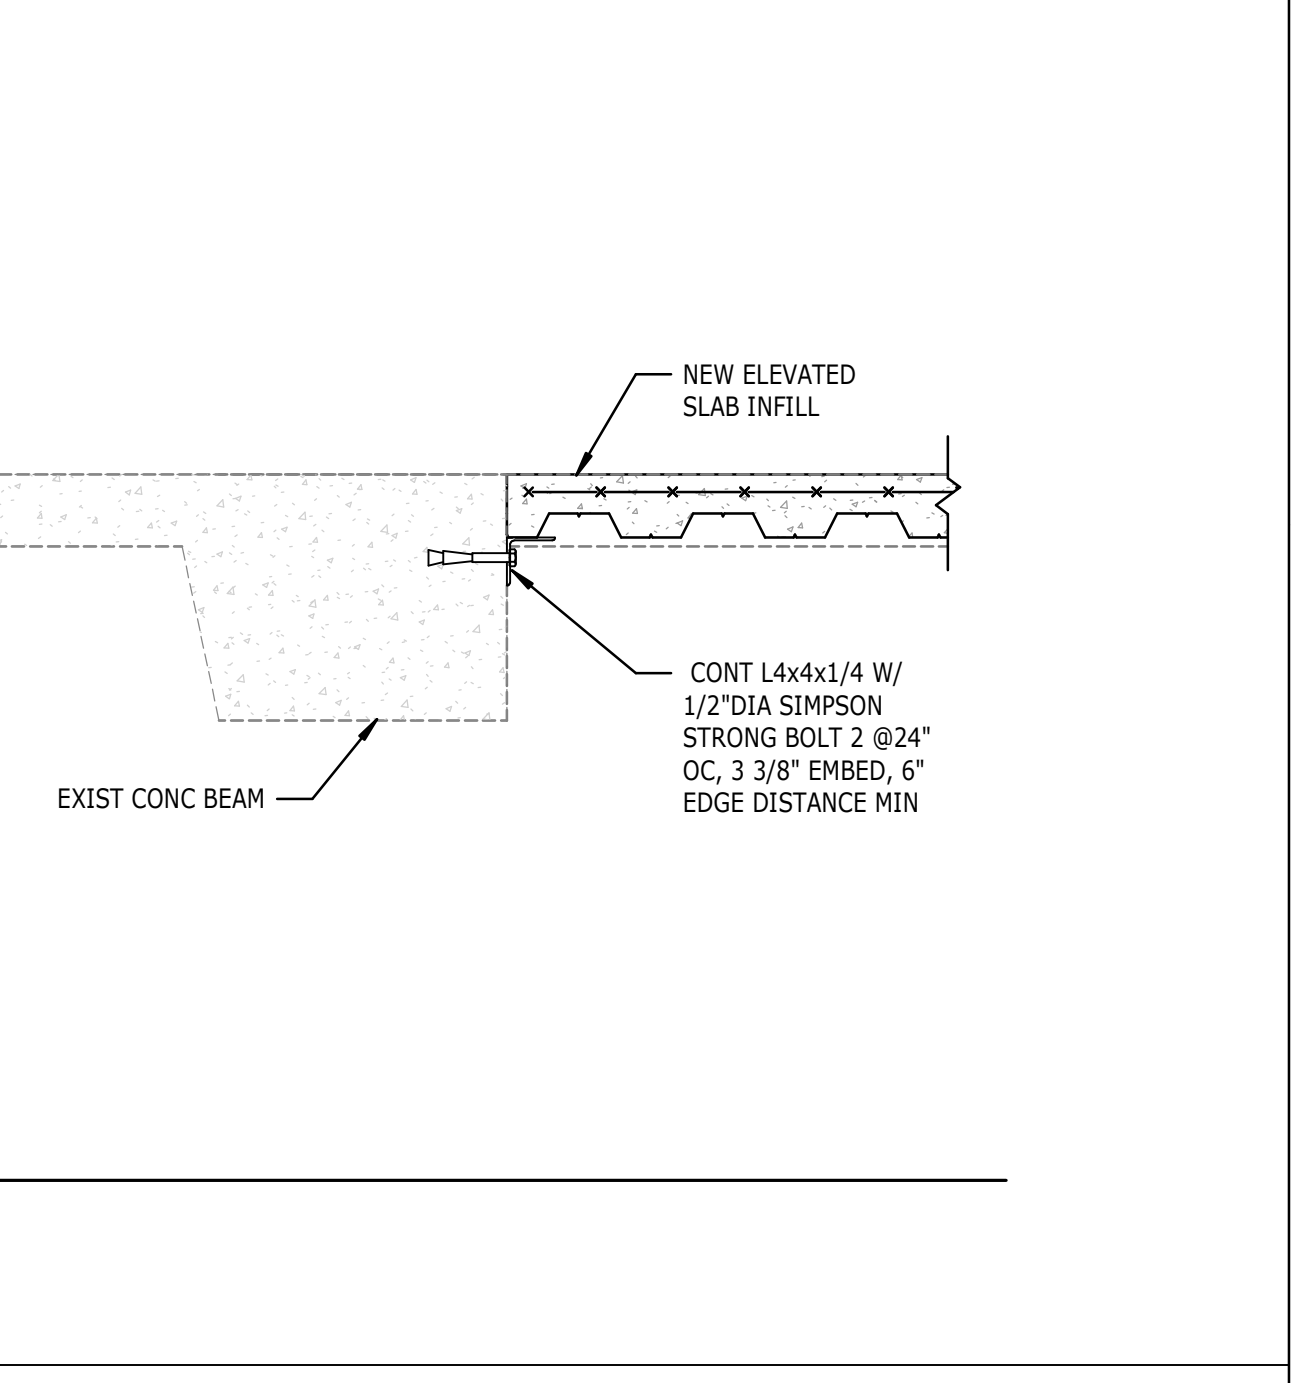


3 SECTION  
S-341 3/4" = 1'-0"

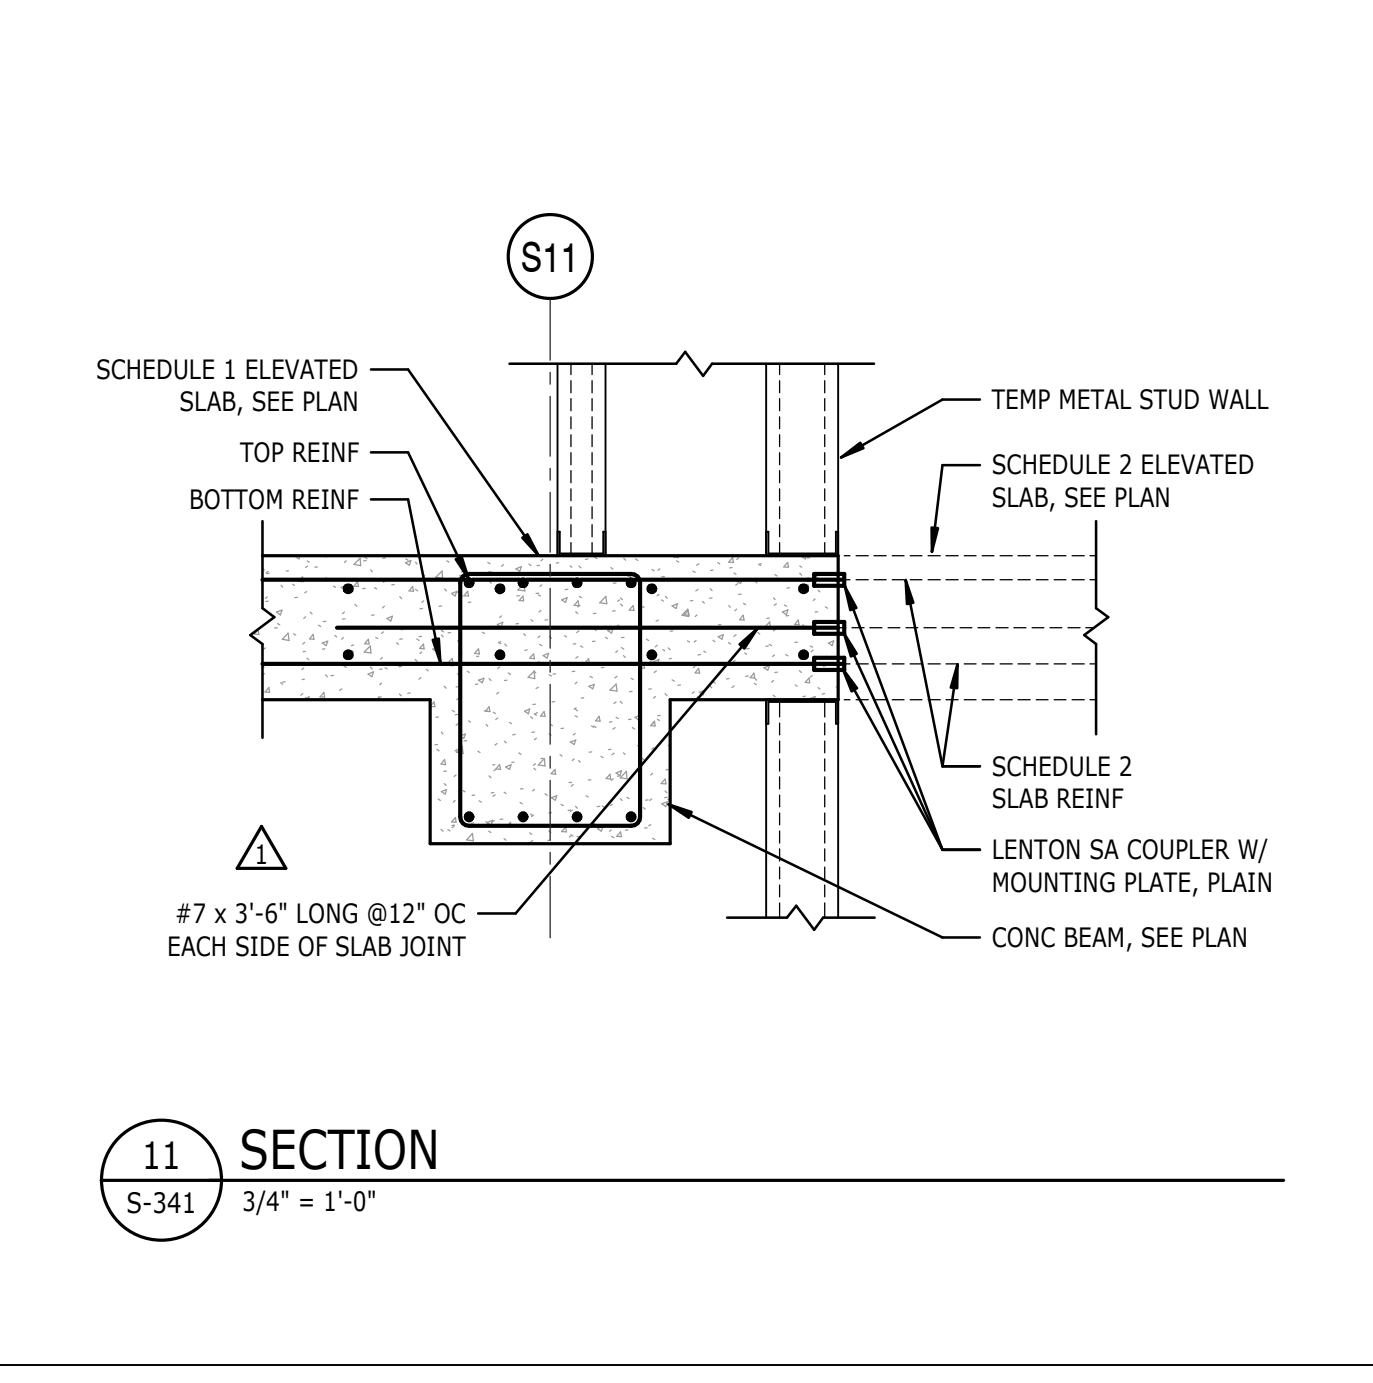


11 SECTION  
S-341 3/4" = 1'-0"

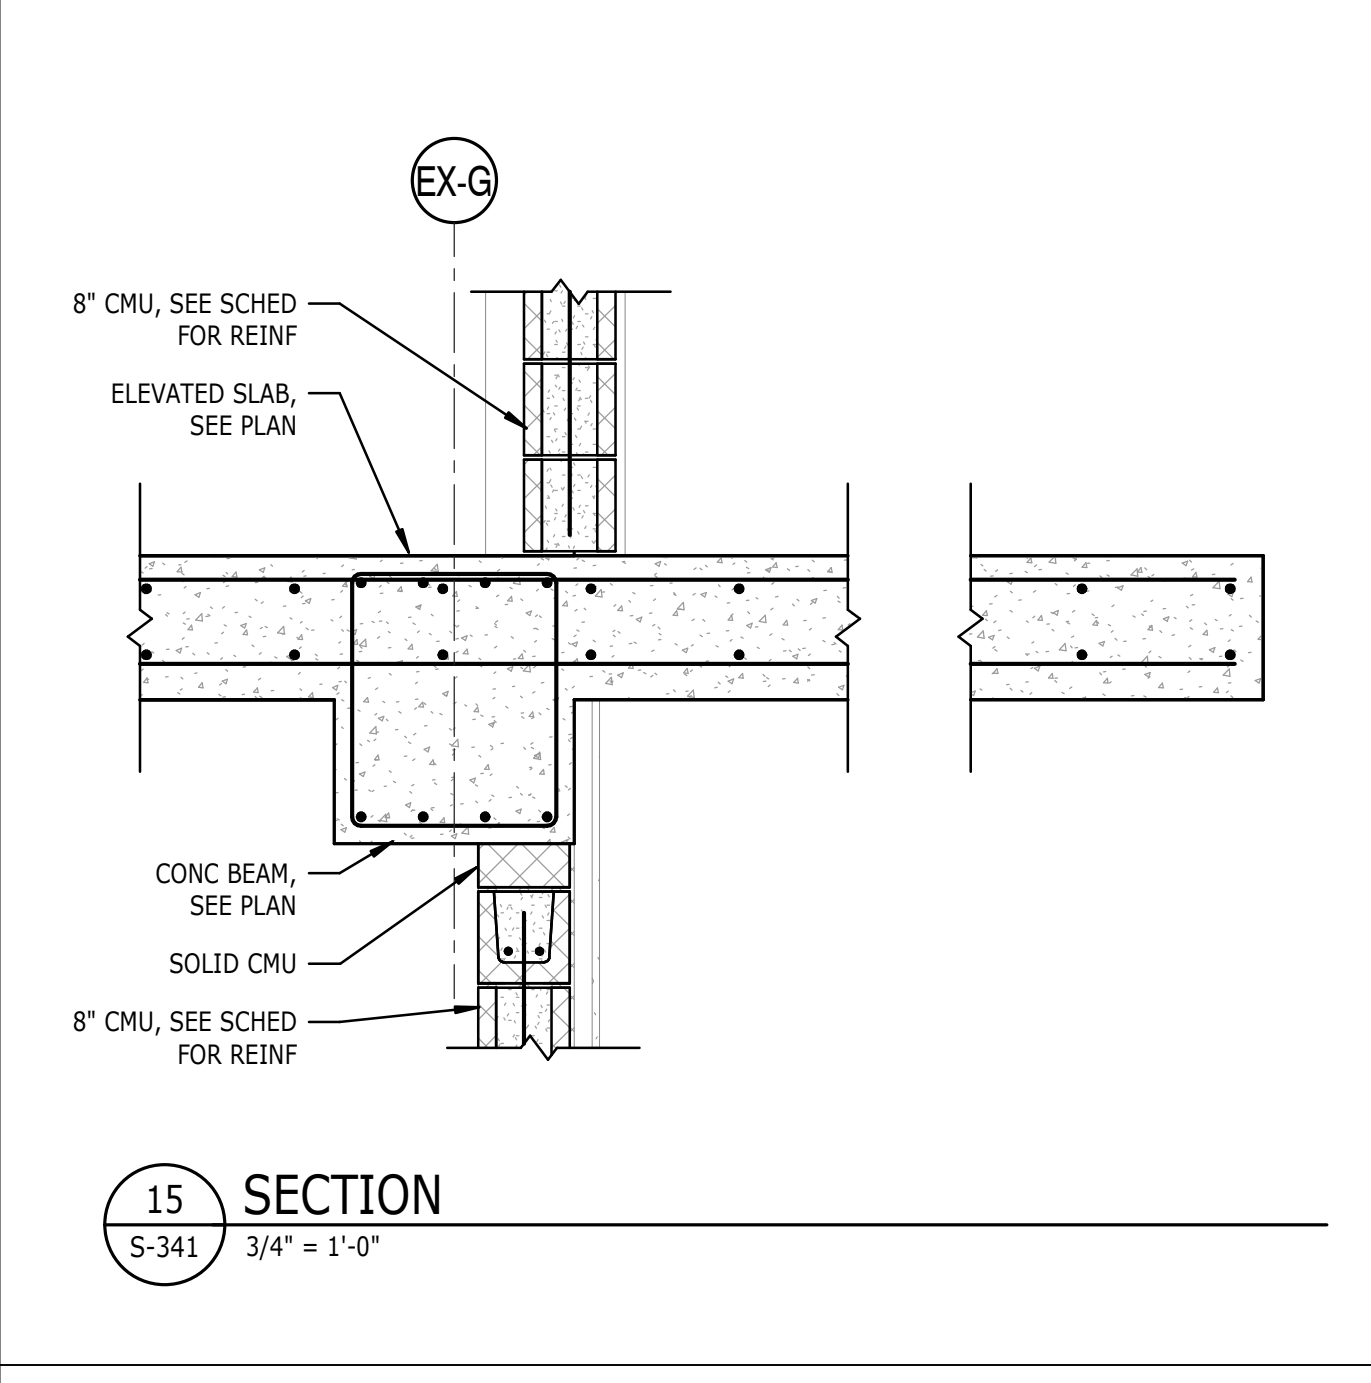


15 SECTION  
S-341 3/4" = 1'-0"

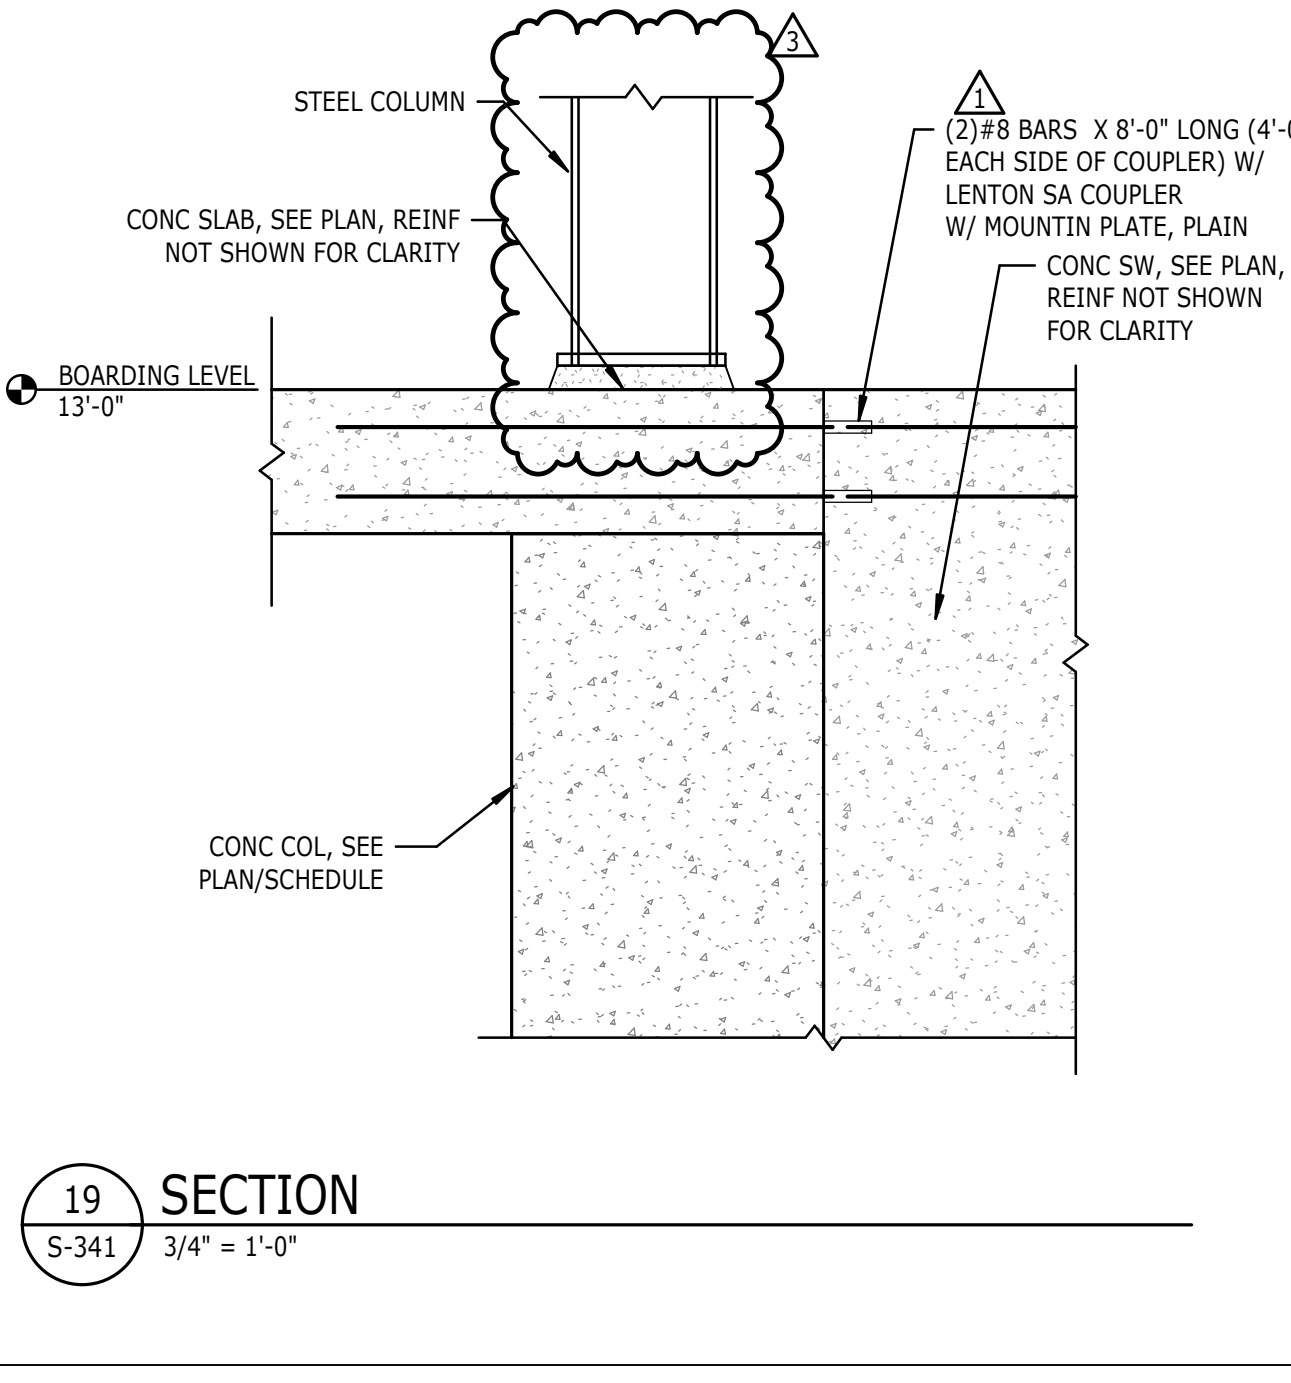


19 SECTION  
S-341 3/4" = 1'-0"

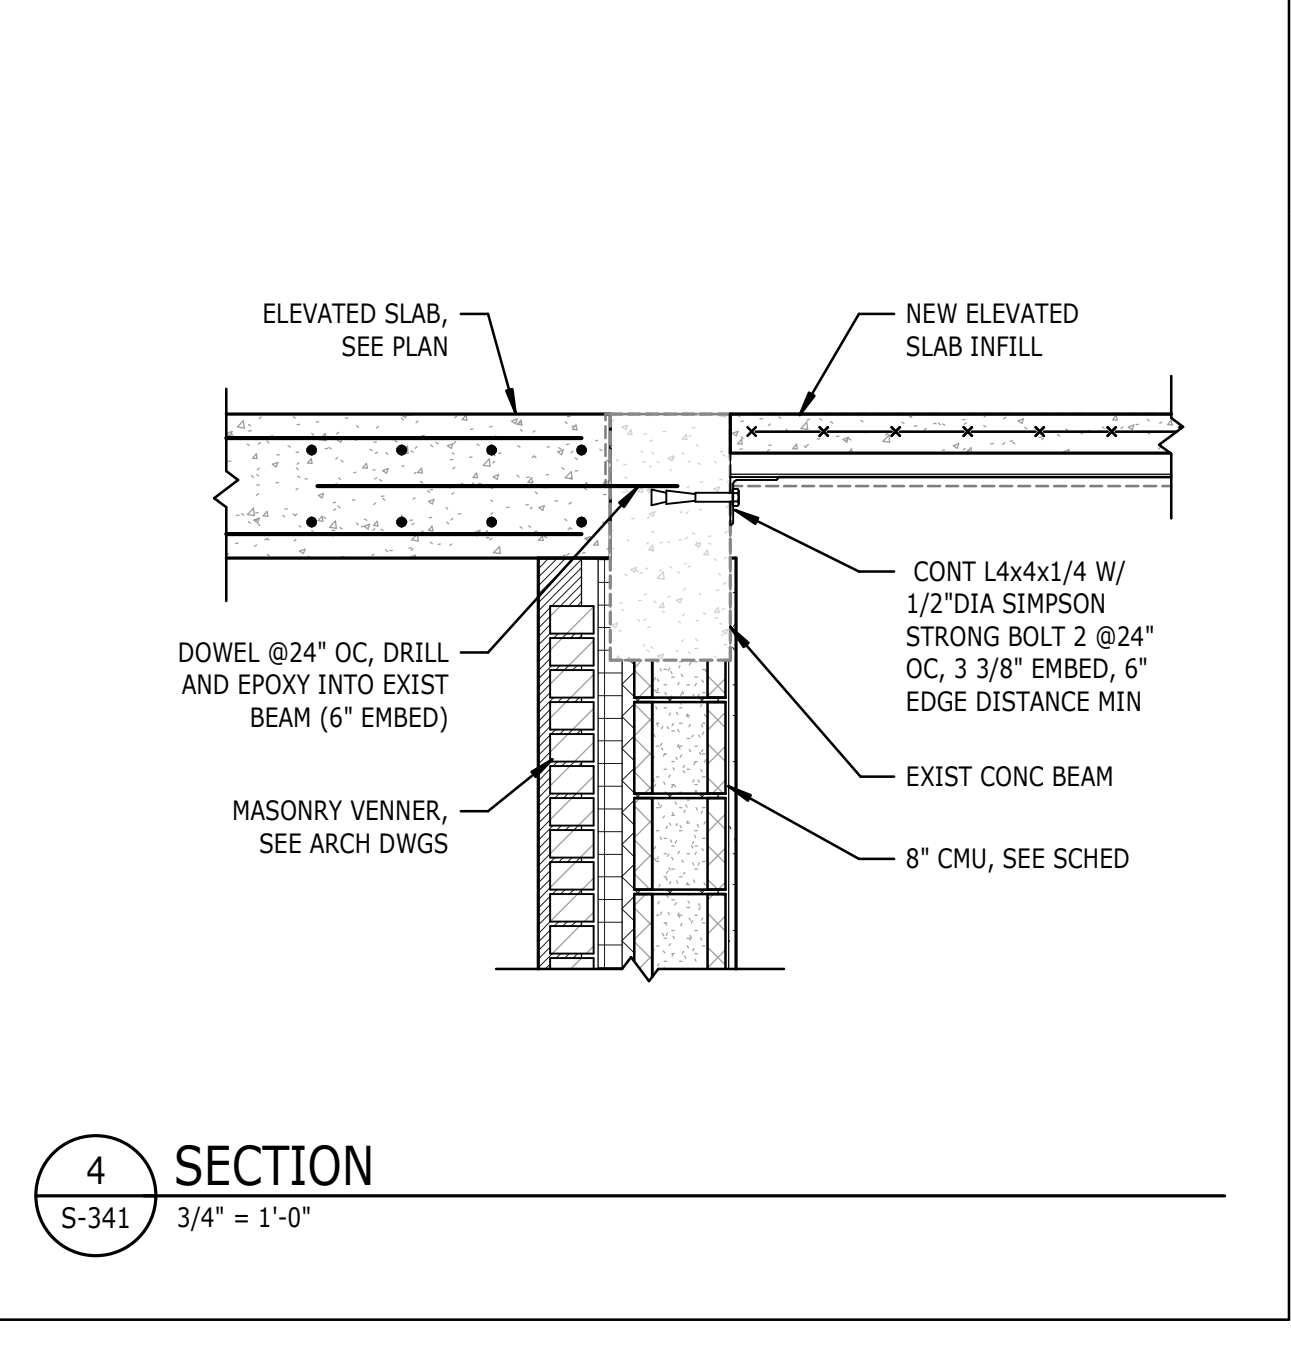


4 SECTION  
S-341 3/4" = 1'-0"

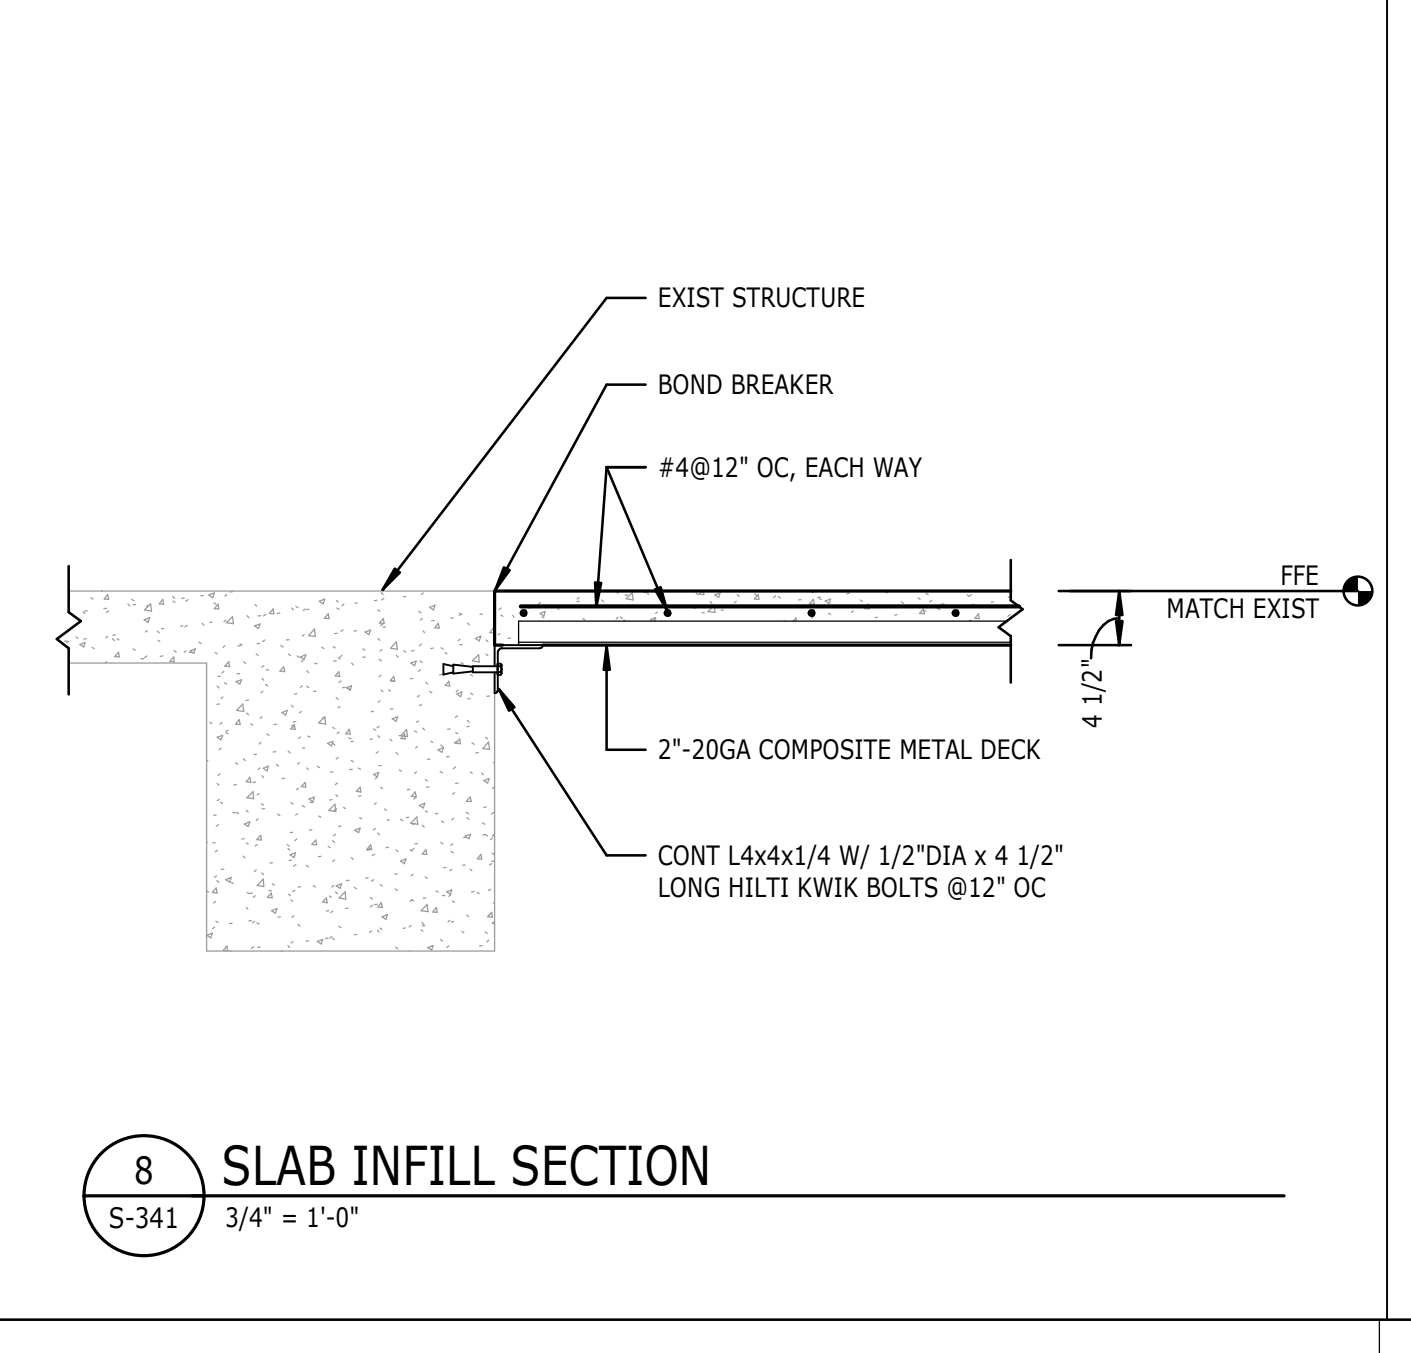


8 SLAB INFILL SECTION  
S-341 3/4" = 1'-0"

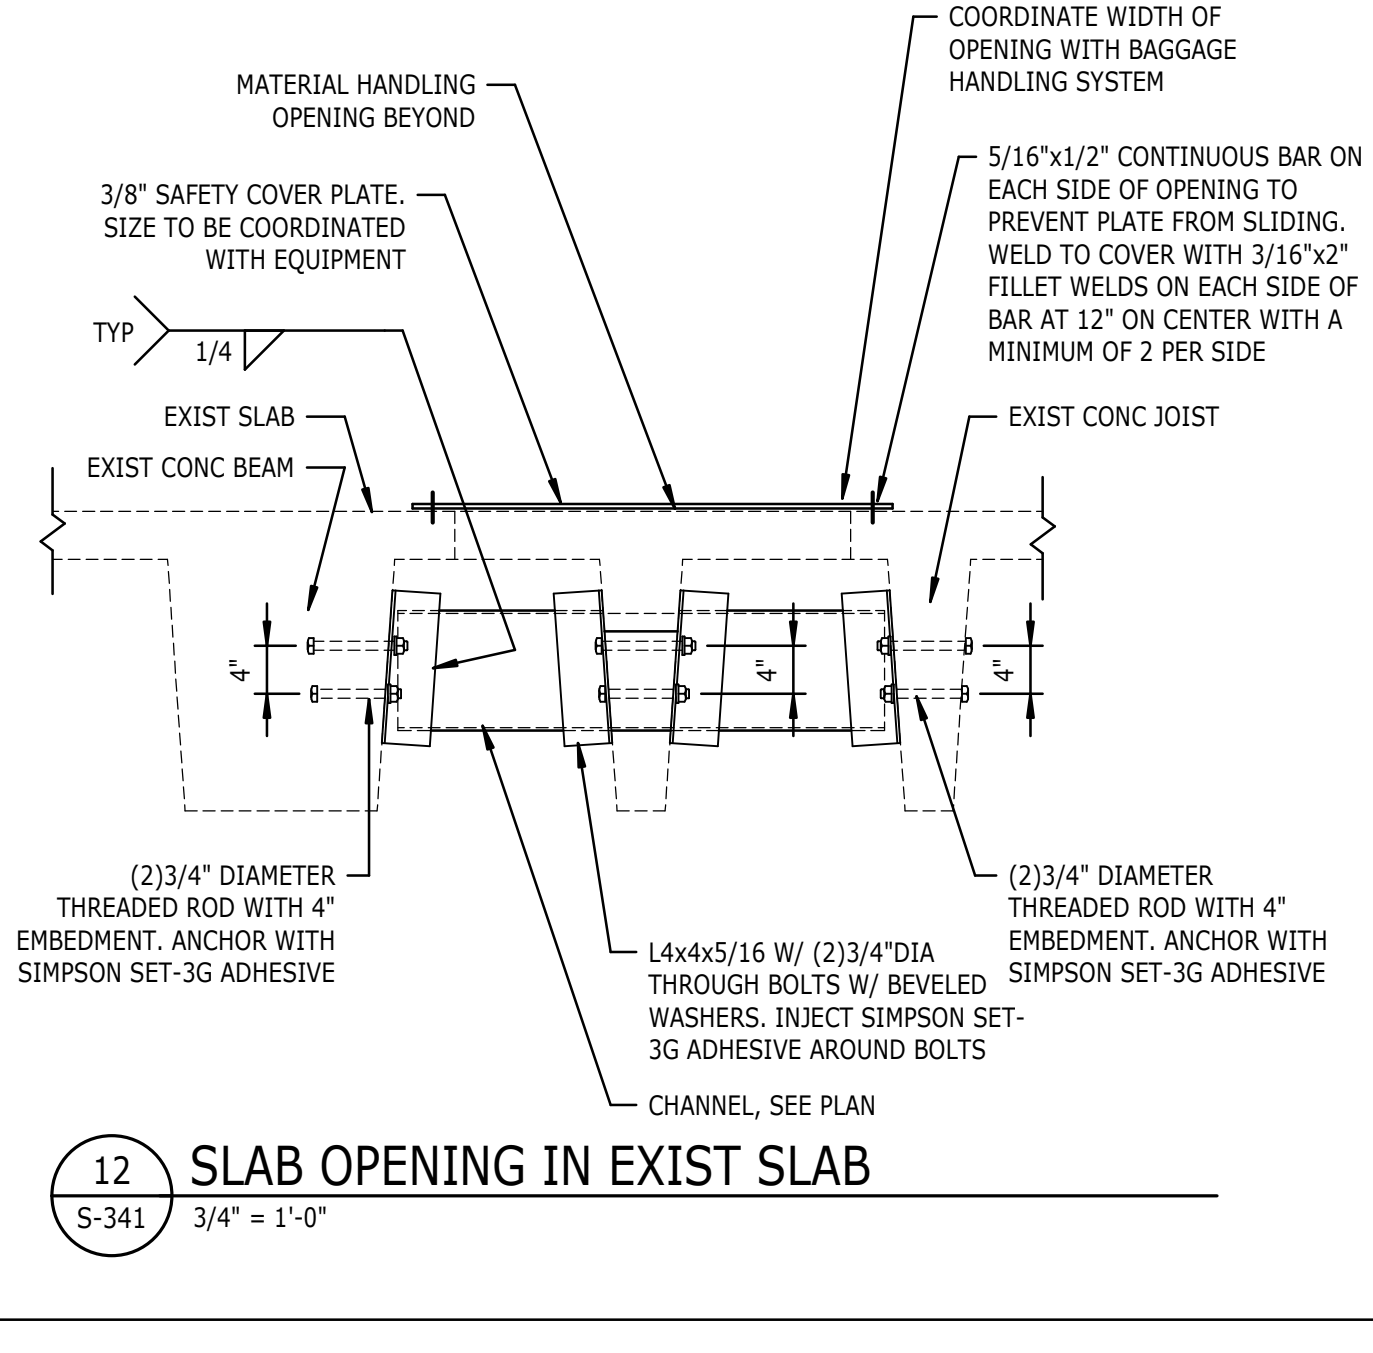

12 SLAB OPENING IN EXIST SLAB  
S-341 3/4" = 1'-0"

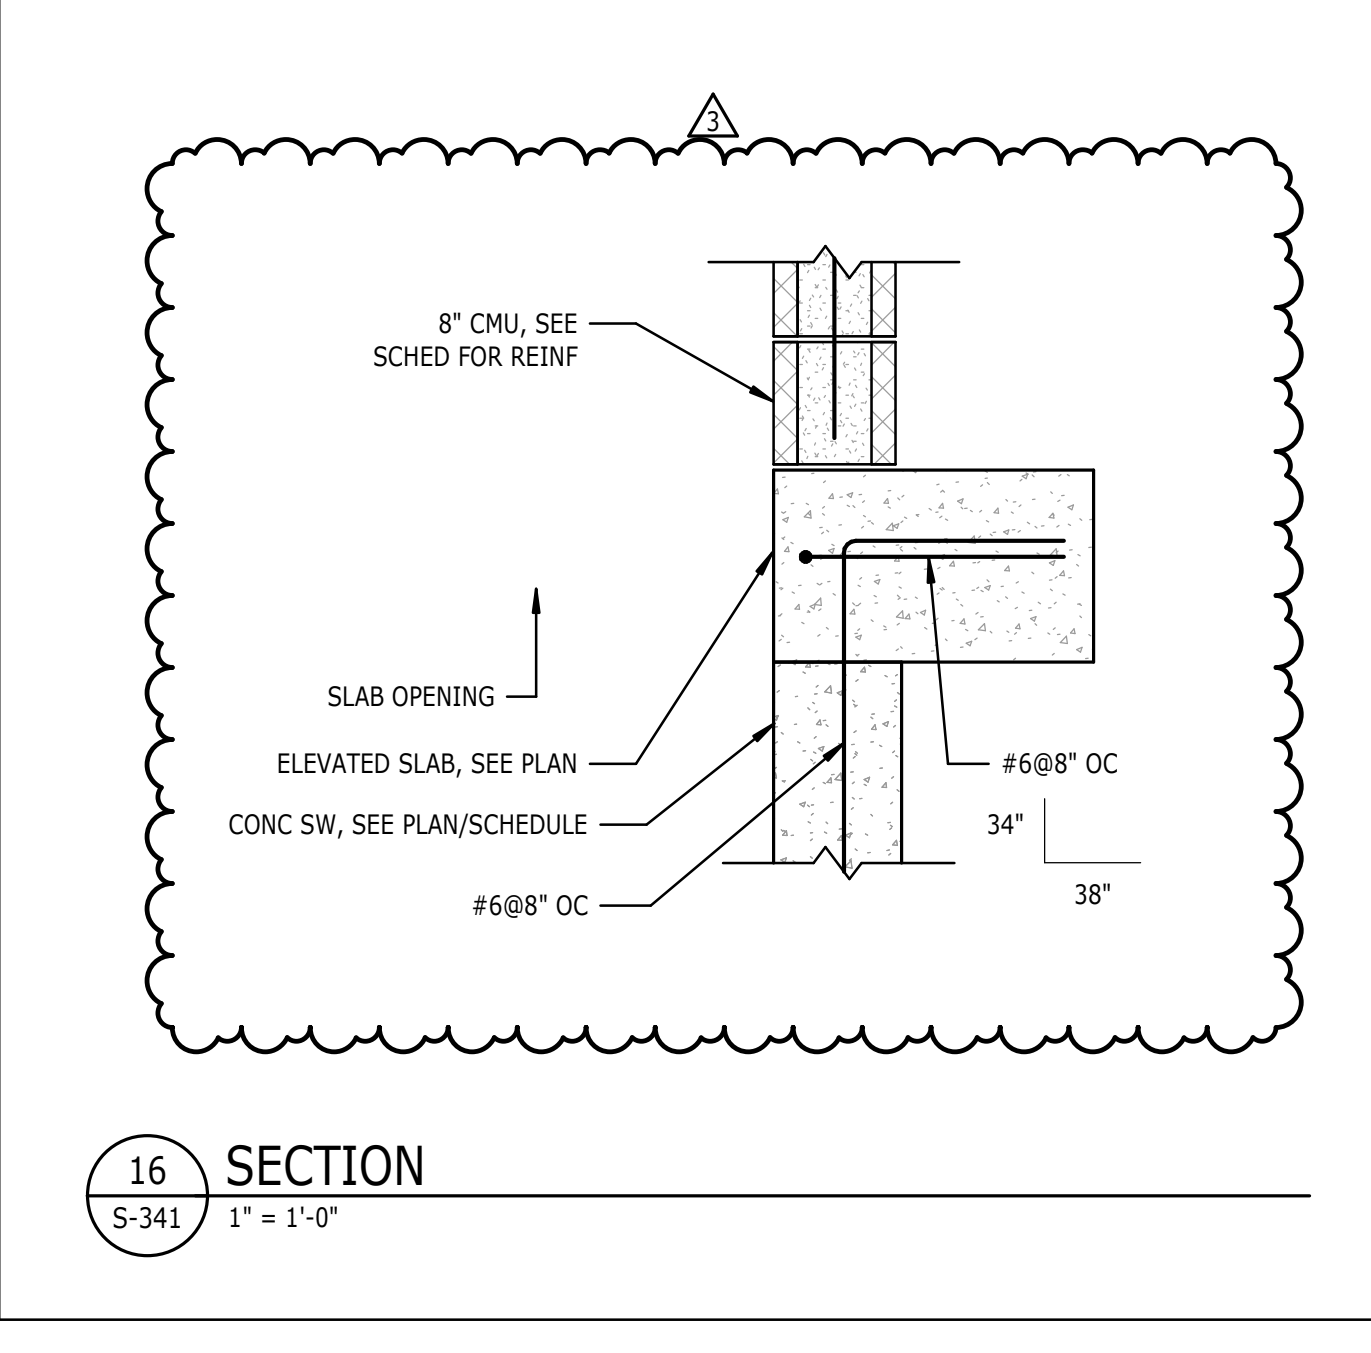


16 SECTION  
S-341 1" = 1'-0"

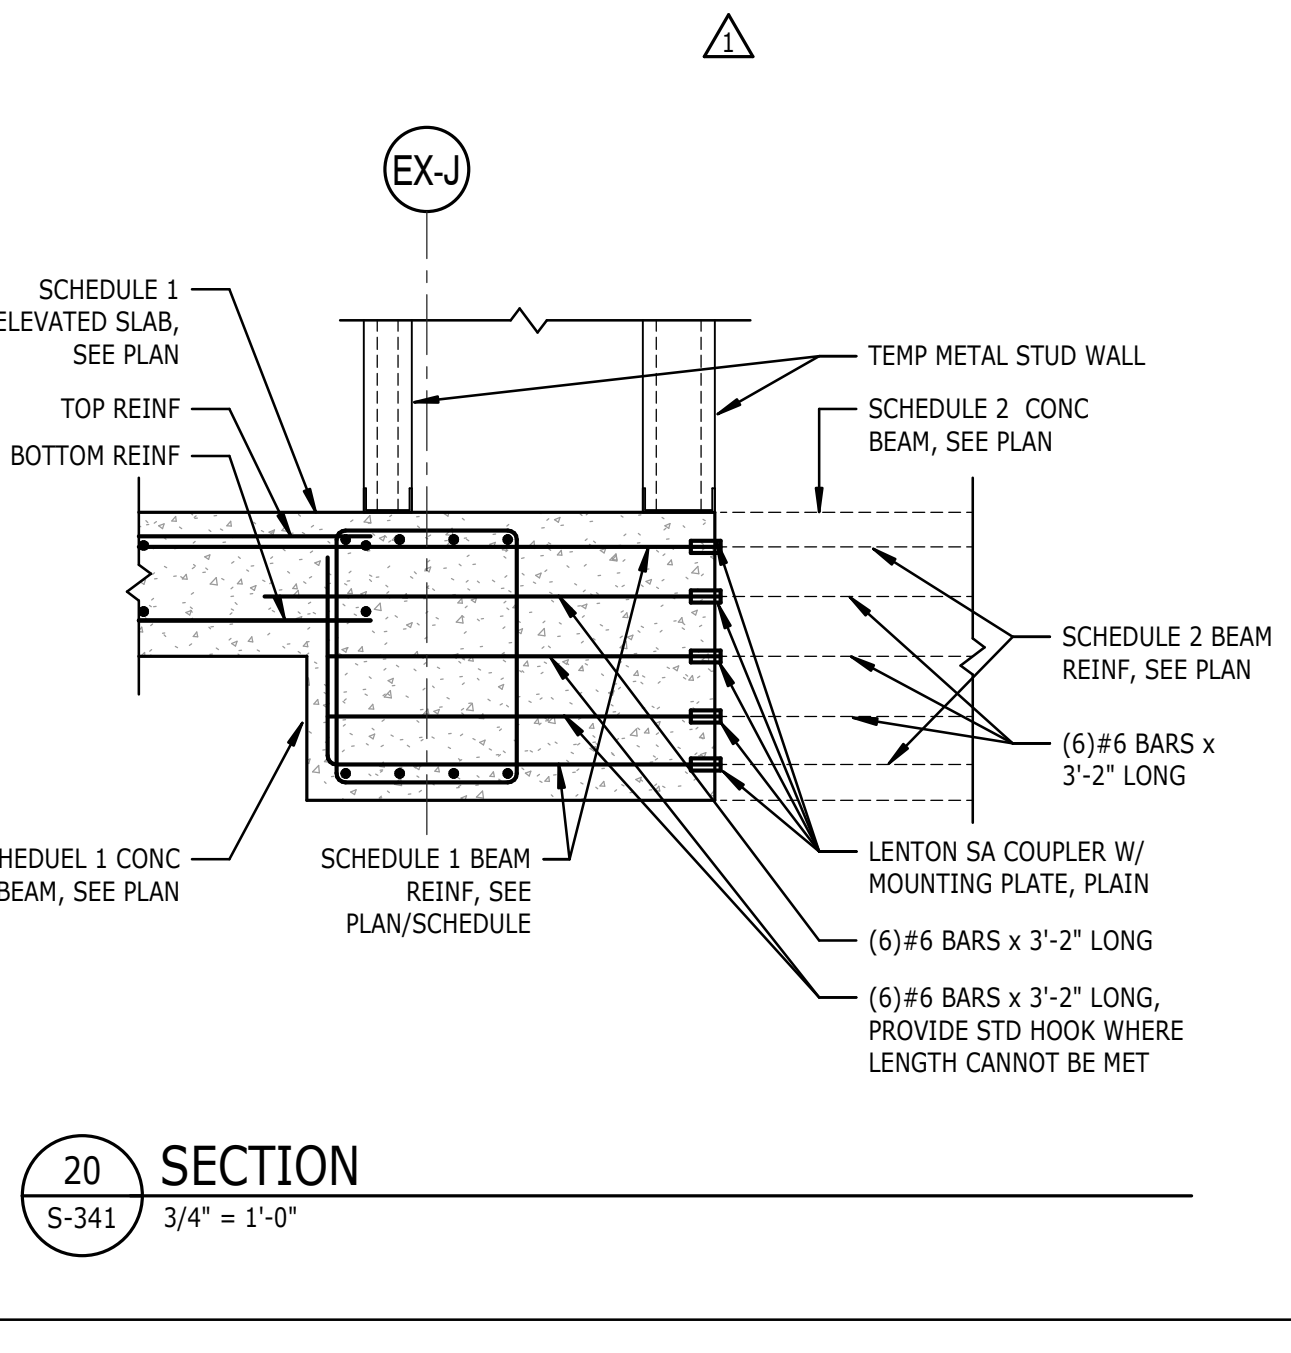

20 SECTION  
S-341 3/4" = 1'-0"




STEEL LOOSE LINTEL ANGLE SUPPORTING BRICK VENEER	
CLEAR OPENING	LOOSE LINTEL ANGLE
UP TO 5'-0"	L4x4x3/8
5'-1" TO 8'-0"	L6x4x3/8 (LLV)
8'-1" TO 10'-0"	L7x4x3/8 (LLV)
10'-1" TO 12'-0"	L8x4x1/2 (LLV)

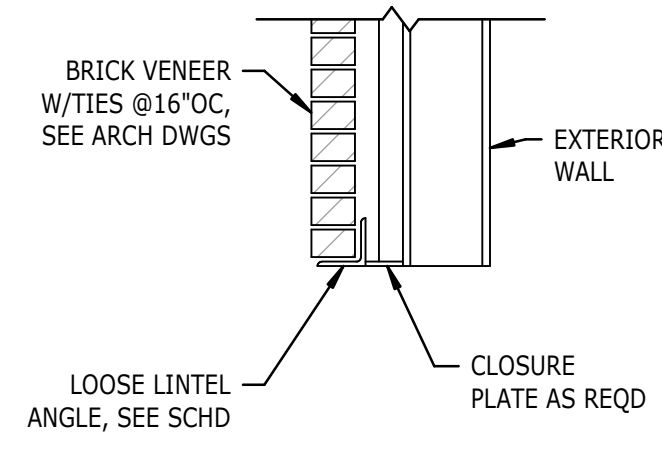


**17 SCHEDULE**

- S-511 STEEL LOOSE LINTEL ANGLES SUPPORTING BRICK VENEER**  
 NTS:  
 1. ALL LOOSE LINTELS SHALL BE PAINTED OR GALVANIZED, SEE ARCHITECTURAL DRAWINGS.  
 2. PROVIDE 6" MINIMUM BEARING FOR OPENINGS UP TO 8'-0" WIDE. PROVIDE 8" MINIMUM BEARING FOR OPENINGS OVER 8'-0" WIDE.  
 3. SEE ARCHITECTURAL DRAWINGS FOR ANGLE PLACEMENT AND FLASHING.  
 4. LOOSE LINTEL ANGLES ARE NOT SHOWN ON THE STRUCTURAL DRAWINGS. SEE ARCHITECTURAL DRAWINGS FOR ALL LOCATIONS OF OPENINGS REQUIRING ANGLES.  
 5. FOR CLEAR OPENING DIMENSIONS GREATER THAN THOSE SHOWN IN THE SCHEDULE, SEE OTHER DETAILS OR CONTACT THE ENGINEER OF RECORD.

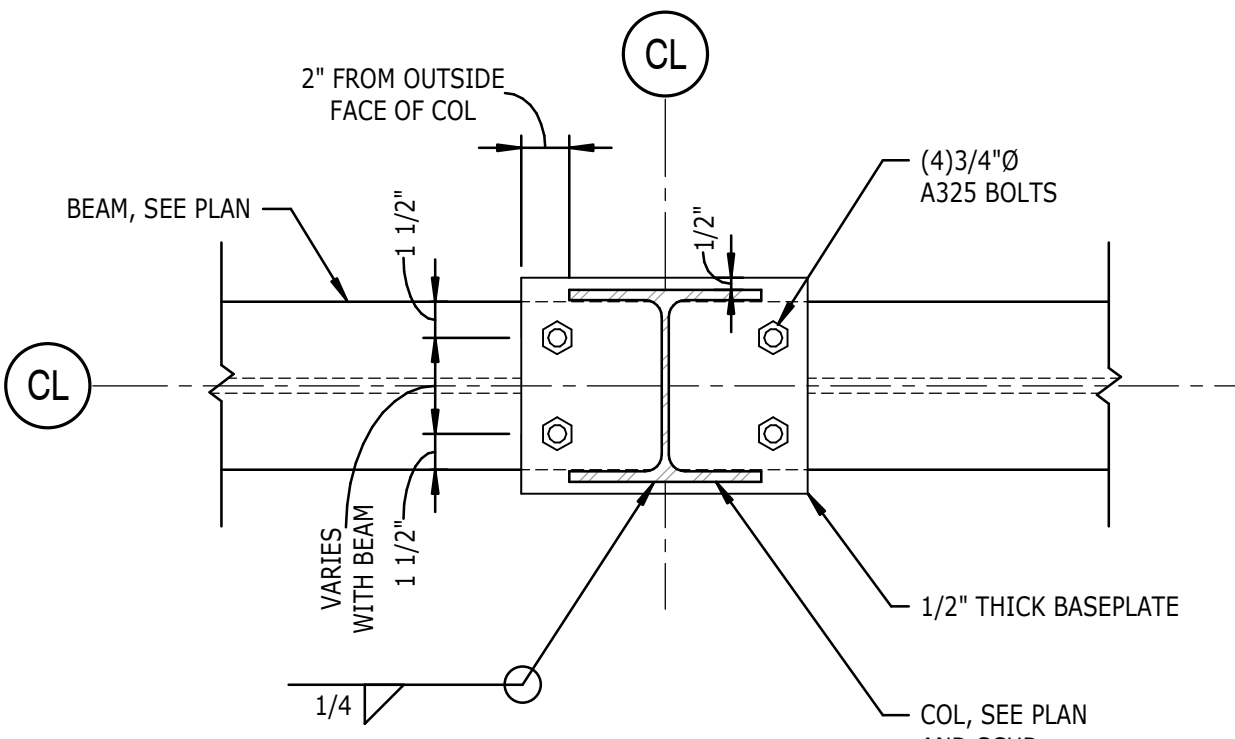


**18 DETAIL**

**S-511 TYPICAL COLUMN BEARING ON BEAM**  
 NTS

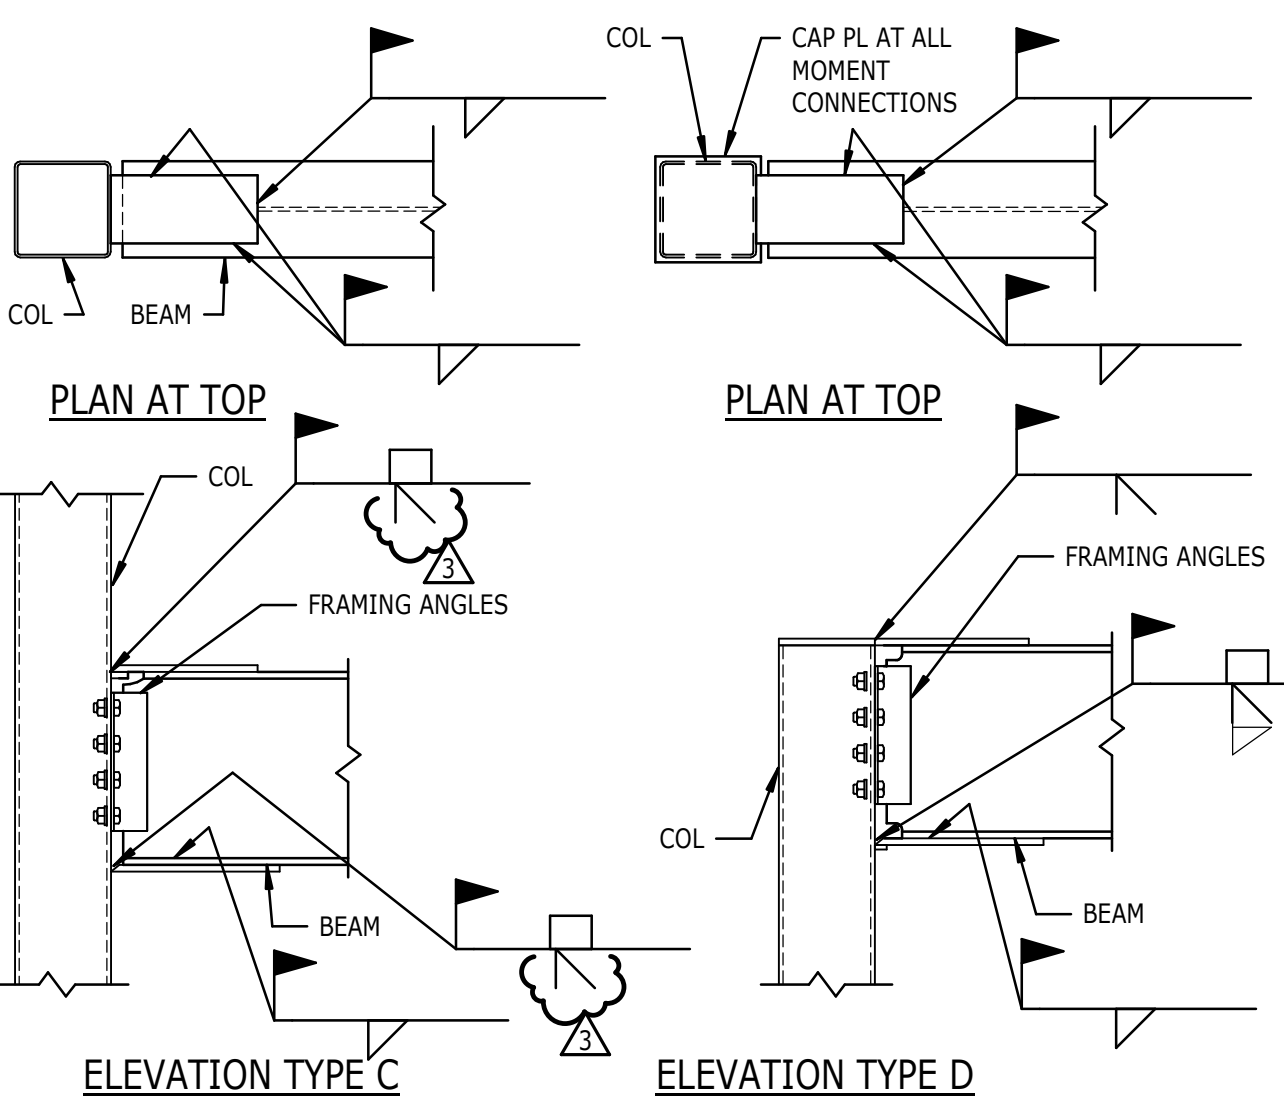


**19 SCHEDULE**

- S-511 MOMENT CONNECTION SCHEDULE AND DETAILS**  
 NTS:  
 1. PROVIDE ULTRASONIC TESTING AT FULL PENETRATION WELDS.  
 2. ALL MOMENT CONNECTIONS TO BE DESIGNED FOR A FACTORED LOAD OF 75k-ft UNO ON PLAN.

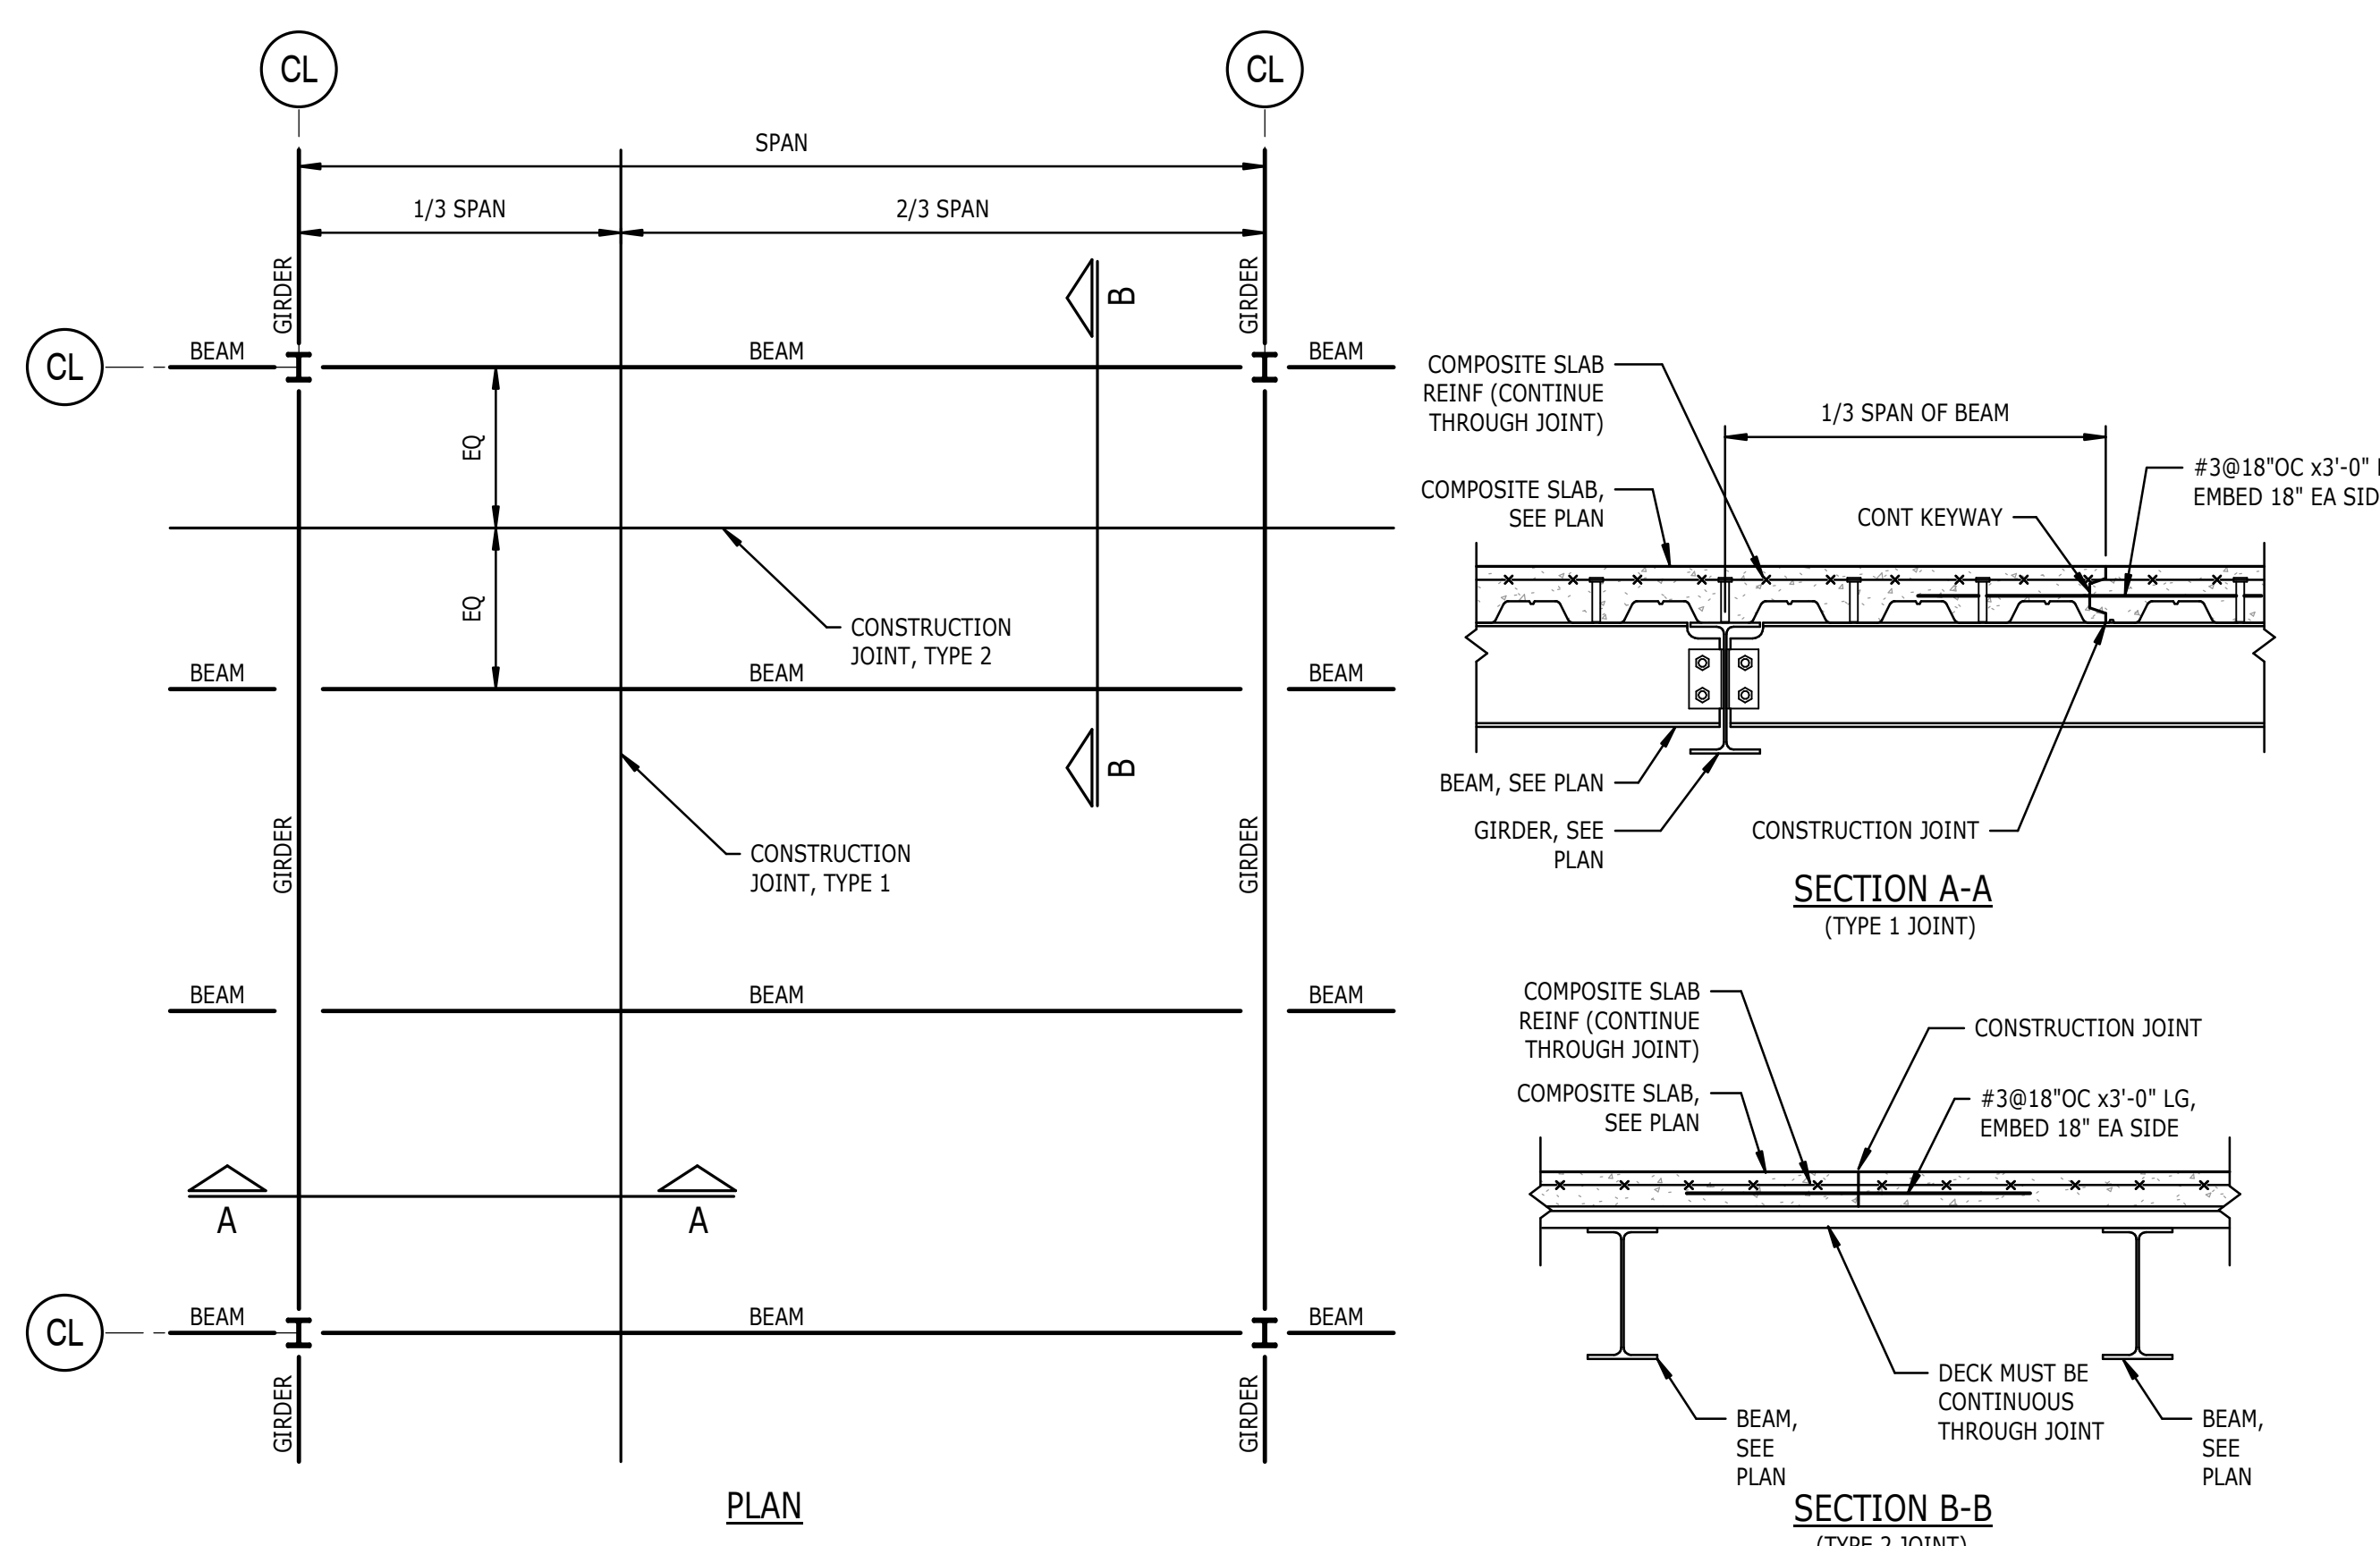

**9 DETAIL**


- S-511 TYPICAL CONSTRUCTION JOINTS IN COMPOSITE DECK**  
 NTS:  
 1. CONTRACTOR SHALL SUBMIT LOCATION OF ALL CONSTRUCTION JOINTS FOR APPROVAL PRIOR TO CONSTRUCTION AND FABRICATION.

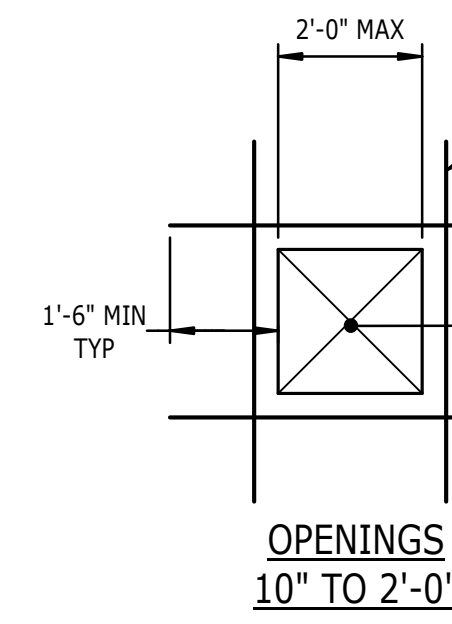


- NOTES:  
 1. PROVIDE REINFORCING AROUND ALL DUCT PENETRATIONS, CHASES, ELECTRICAL BOXES, PLUMBING PIPES, AND OTHER OPENINGS IN SLABS, FOR OPENINGS FROM 10"x10" (OR 10"Ø) TO 2'-0"x2'-0" (OR 24"Ø).  
 2. OPENINGS THAT ARE SPACED CLOSER THAN (2) TIMES THE OPENING SIZE SHALL BE CONSIDERED ONE OPENING.  
 3. MINIMUM CLEAR DISTANCE BETWEEN OPENINGS IS 2'-0".  
 4. ALL OPENINGS 10" TO 2'-0" MAY NOT BE SHOWN ON STRUCTURAL DRAWINGS.  
 5. OPENINGS GREATER THAN 2'-0" NOT SHOWN ON STRUCTURAL DRAWINGS REQUIRE APPROVAL BY THE ENGINEER OF RECORD.

**12 DETAIL**


**S-511 TYPICAL FRAMING AROUND SLAB OPENINGS**  
 NTS

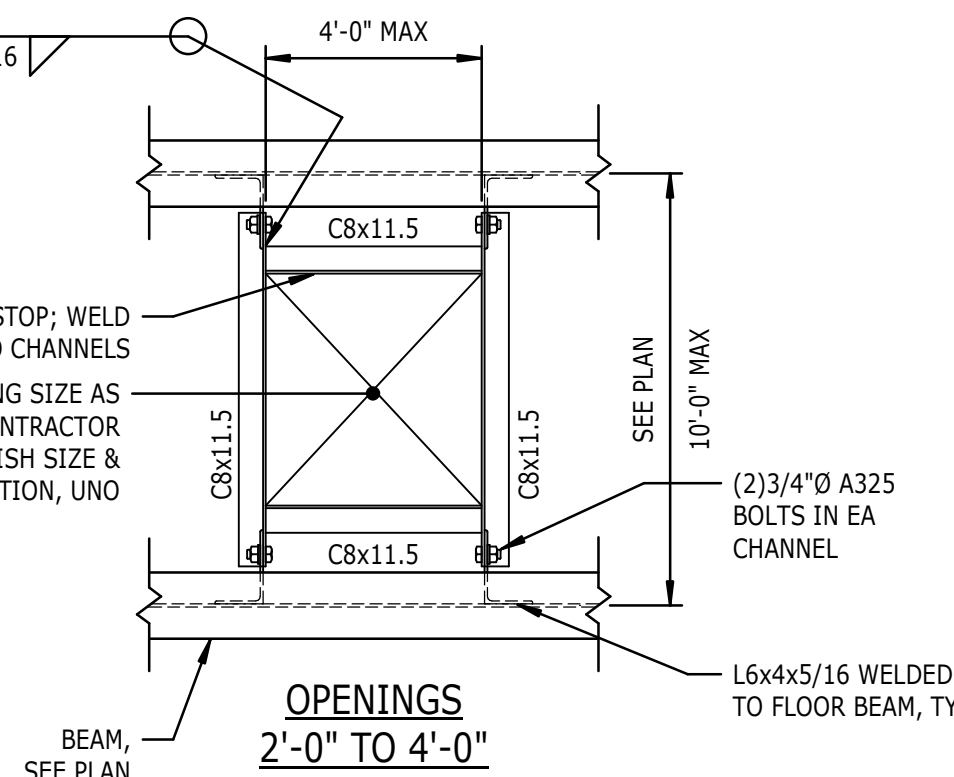

- NOTES:  
 1. PROVIDE CHANNEL FRAMING AROUND ALL DUCT PENETRATIONS, CHASES, ELECTRICAL BOXES, PLUMBING PIPES, AND OTHER OPENINGS IN SLABS, FOR OPENINGS LARGER THAN 2'-0"x2'-0" (OR 24"Ø).  
 2. OPENINGS THAT ARE SPACED CLOSER THAN (2) TIMES THE OPENING SIZE SHALL BE CONSIDERED ONE OPENING.  
 3. MINIMUM CLEAR DISTANCE BETWEEN OPENINGS IS 1'-0".  
 4. OPENINGS GREATER THAN 2'-0" NOT SHOWN ON STRUCTURAL DRAWINGS REQUIRE APPROVAL BY THE ENGINEER OF RECORD.

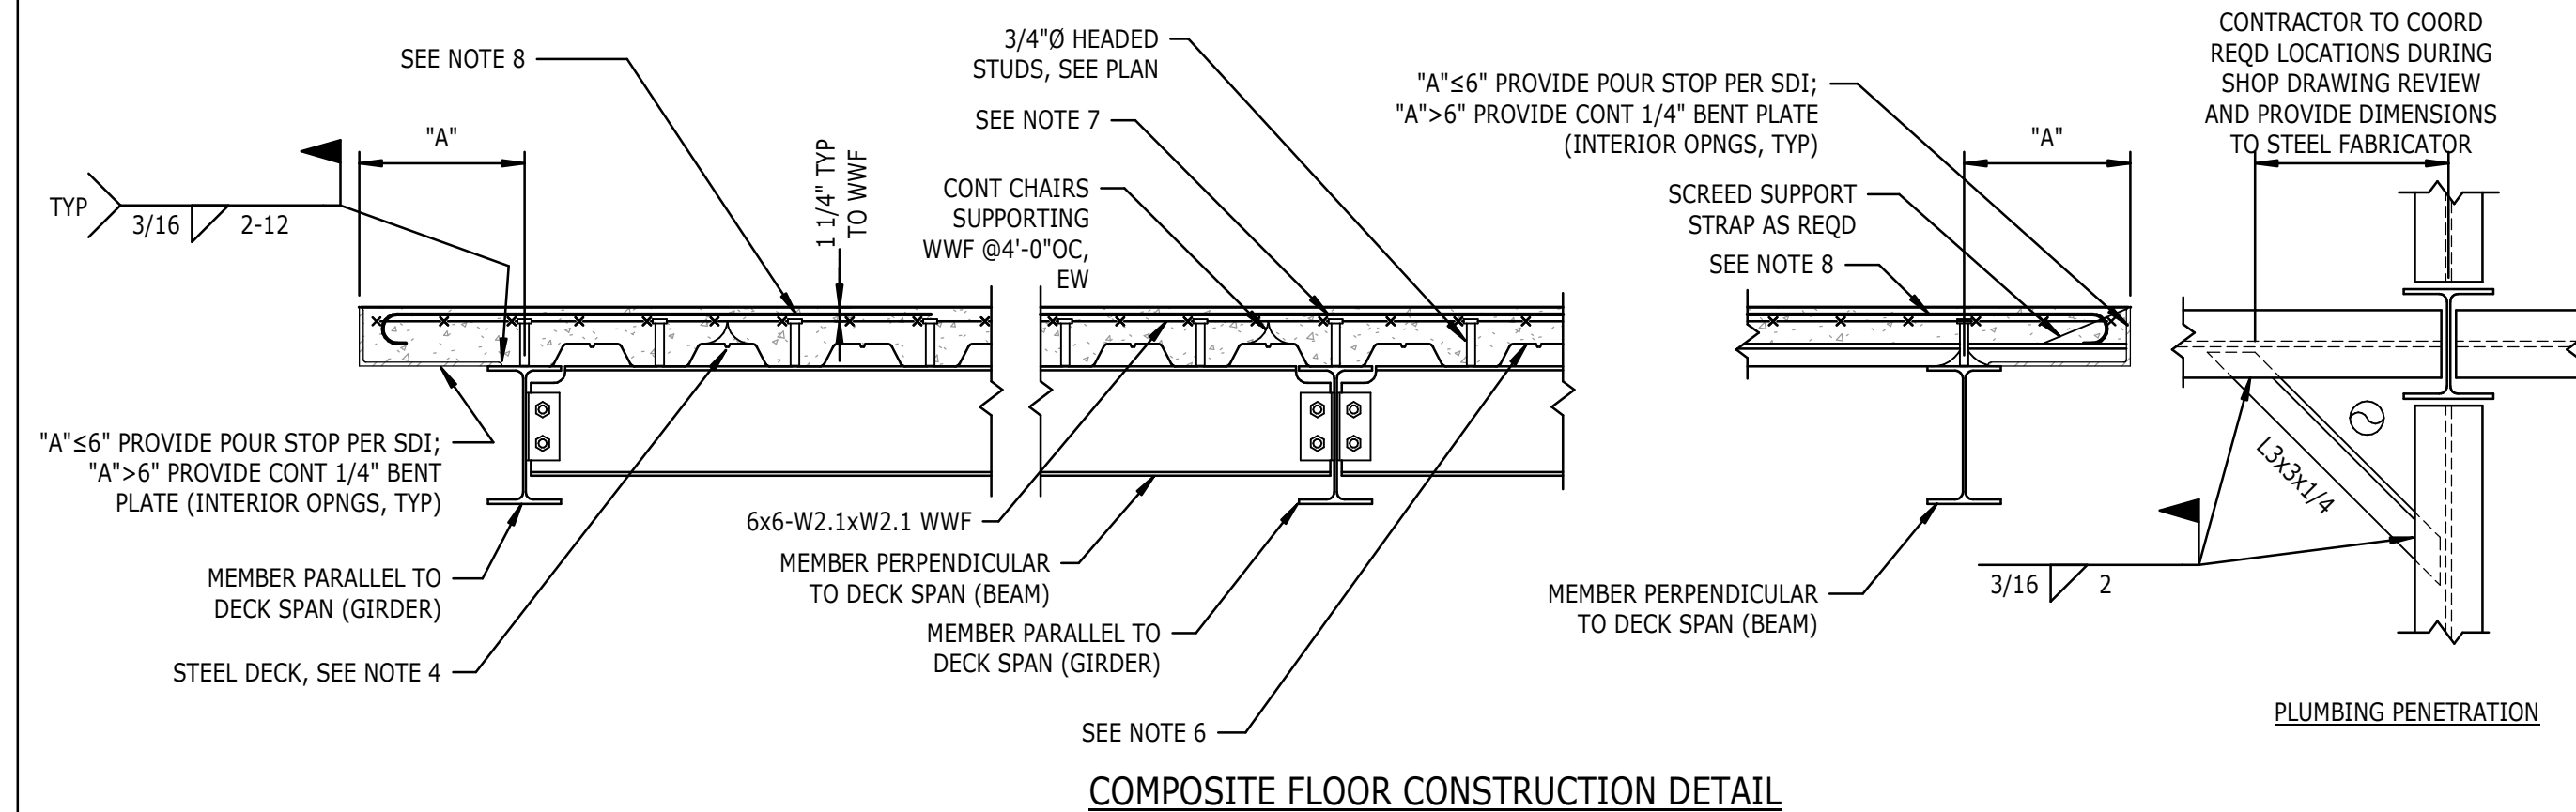


- NOTES:  
 1. THIS DETAIL APPLIES TO DECK SUPPORTED COMPOSITE SLABS, AS INDICATED ON PLANS.  
 2. WELD DECK TO SUPPORTS PER FLOOR DECKING ATTACHMENT DETAIL.  
 3. SUPPORT DECK AROUND COLUMNS WITH COLUMN CLOSURE. WHERE PLUMBING LINES ARE ADJACENT TO COLUMNS, PROVIDE ANGLES TO SUPPORT DECK PER PLUMBING PENETRATION DETAIL.  
 4. MINIMUM STEEL DECK PROPERTIES: 2'-20 GAGE COMPOSITE DECK WITH  $I_p=0.409$  in<sup>4</sup>/ft,  $I_n=0.406$  in<sup>4</sup>/ft,  $S_p=0.341$  in<sup>3</sup>/ft,  $S_n=0.346$  in<sup>3</sup>/ft, AND  $F_y=50$  ksi.  
 5. COMPOSITE SLABS HAVE BEEN DESIGNED AS "UNSHORED CONSTRUCTION".  
 6. DECK SHALL BE CONTINUOUS OVER (2) OR MORE SPANS, TYPICAL. IF A SINGLE SPAN CONDITION IS REQUIRED AND SUPPORT BEAM SPACING EXCEEDS 8'-5", CONTRACTOR SHALL SHORE AREA.  
 7. PROVIDE #4@12"ØC x6'-0" LONG TOP BARS CENTERED OVER ALL GIRDERS RUNNING PARALLEL TO DECK SPAN. PLACE BARS OVER WWF AND PROVIDE 3/4" MINIMUM COVER. PROVIDE SUPPORT CHAIRS #4-ØC EACH WAY. ROTATE IF REQUIRED TO FIT IN SLAB THICKNESS.  
 8. AT INTERIOR AND EXTERIOR SLAB EDGES, PROVIDE #4@12"ØC x5'-0" LONG TOP BARS WITH STANDARD 180° HOOKS AT ONE END AS SHOWN WHERE DIMENSION "A" EXCEEDS 2'-0". PROVIDE 3/4" MINIMUM COVER. DIMENSION "A" SHALL NOT EXCEED 2'-0" UNLESS SPECIFICALLY DETAILED OTHERWISE.  
 9. THE CONTRACTOR SHALL ASSUME CONCRETE OVERAGES IN ELEVATED DECK POURS DUE TO MEMBER AND DECK DEFLECTIONS. UNLESS SHOWN ON PLANS, BEAMS ARE NOT CAMBERED. CONCRETE OVERAGES MAY BE CALCULATED BY THE CONTRACTOR FOR BEAM DEFLECTIONS EQUALING 1/300 INCLUDING ADDITIONAL DEFLECTIONS DUE TO PONDING AND DECK DEFLECTIONS PER SDI.

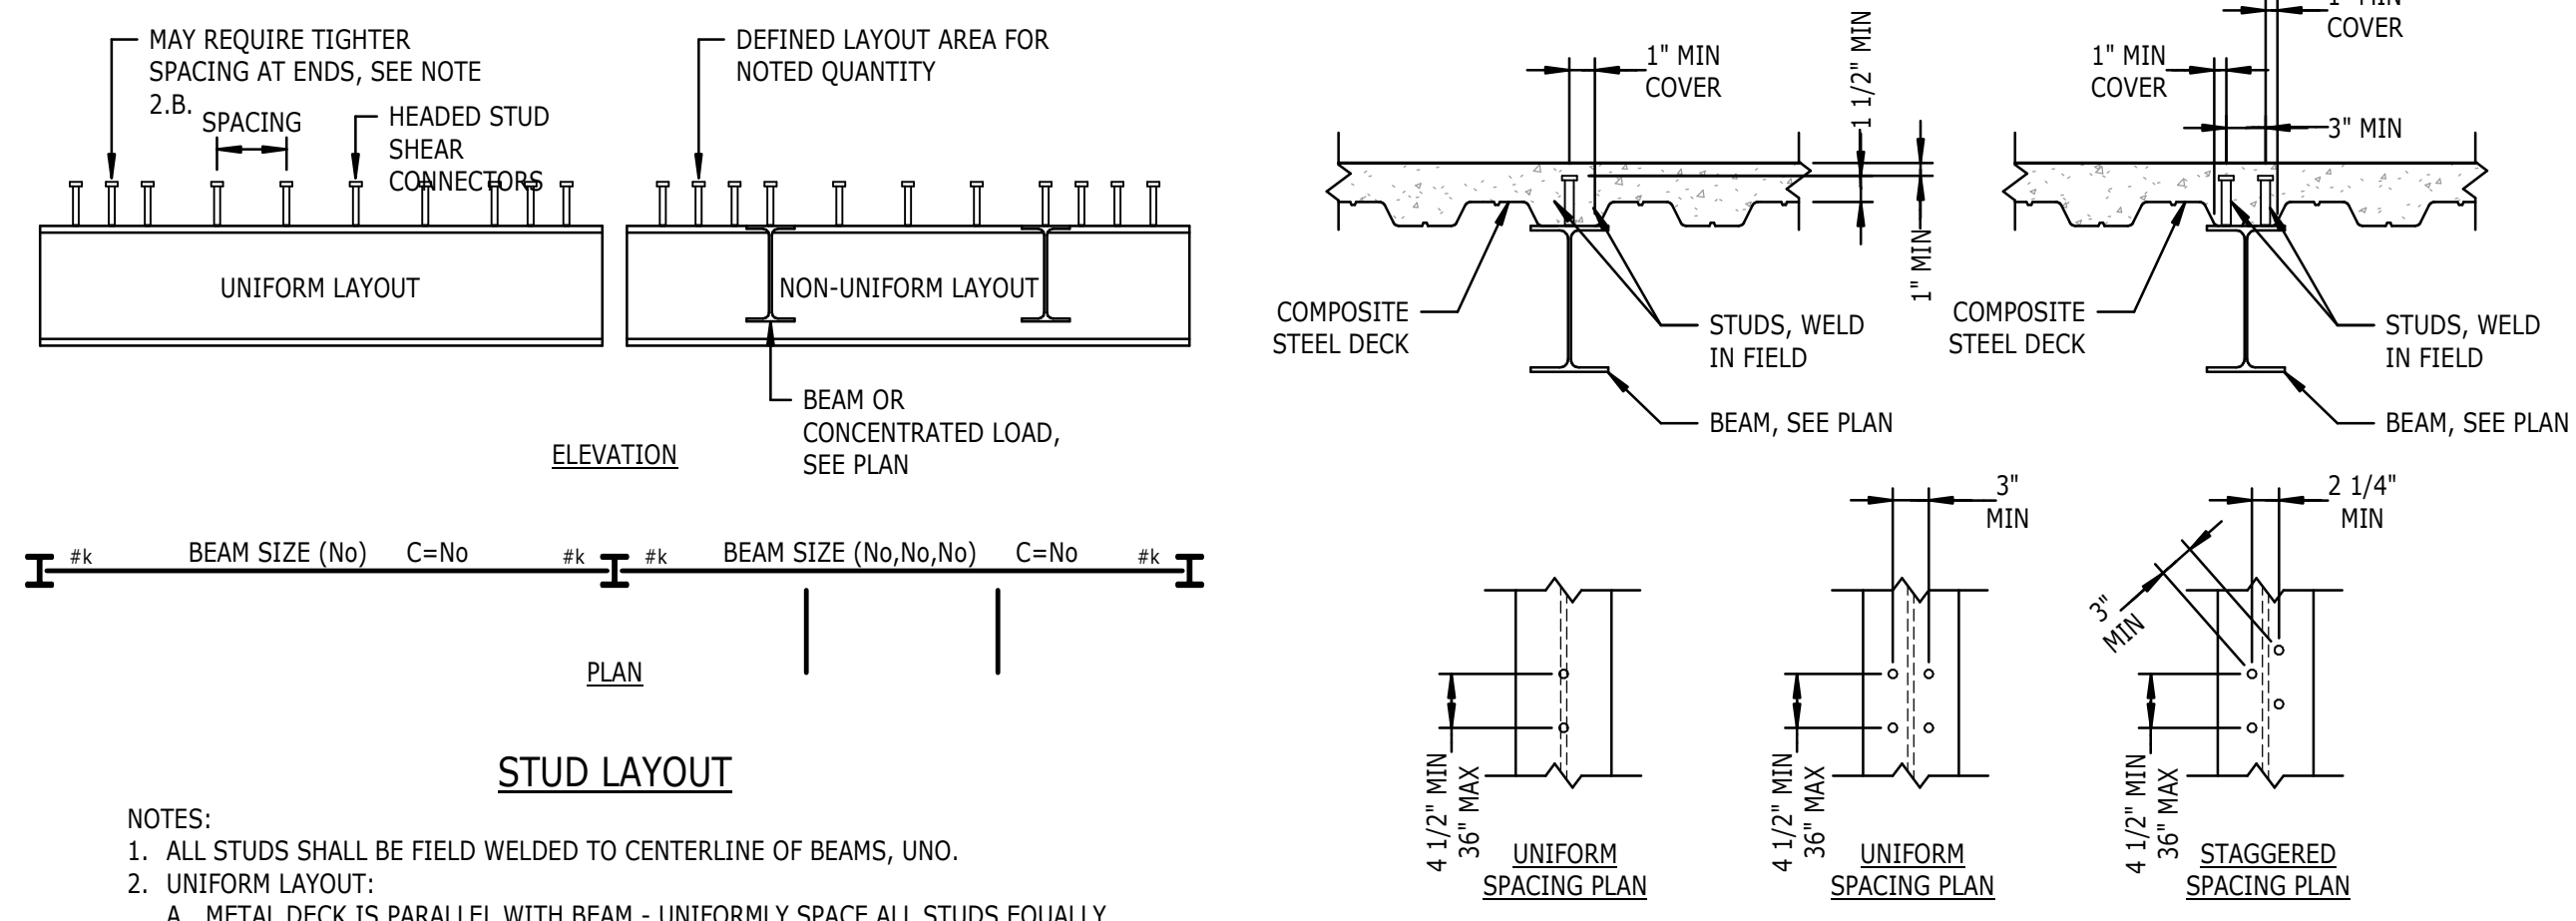



**1 DETAIL**

**S-511 TYPICAL COMPOSITE SLAB DETAILS**  
 NTS

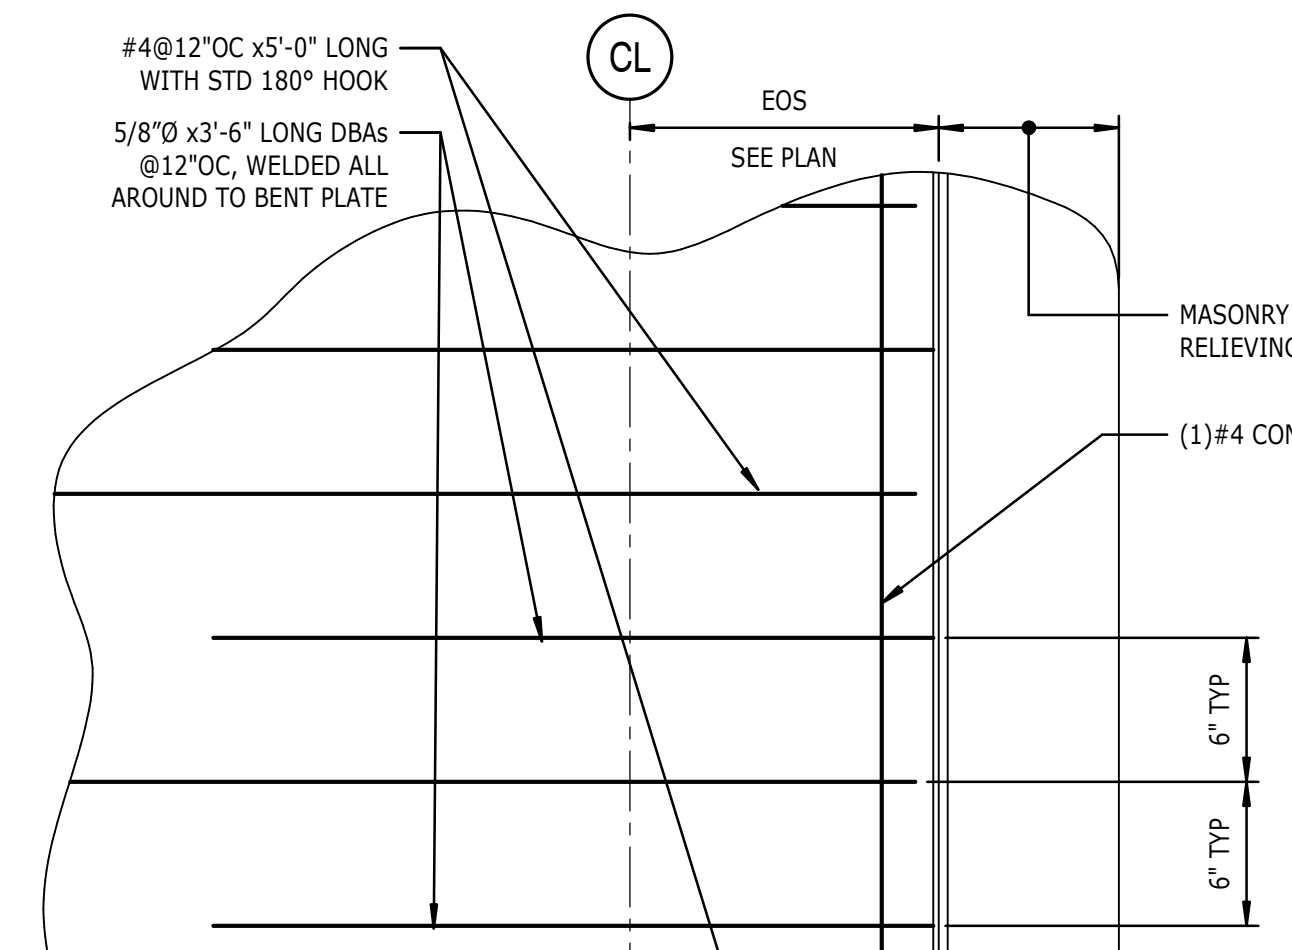

**4 DETAIL**

**S-511 TYPICAL EDGE OF SLAB AT BRICK RELIEVING ANGLE**  
 NTS

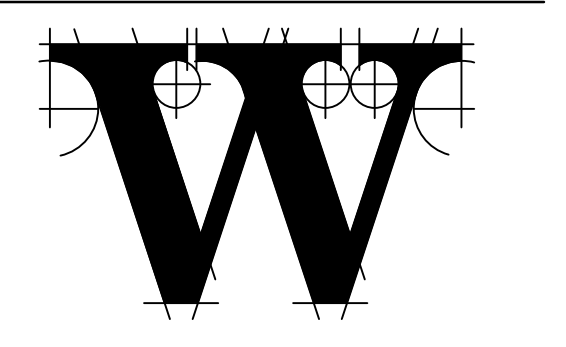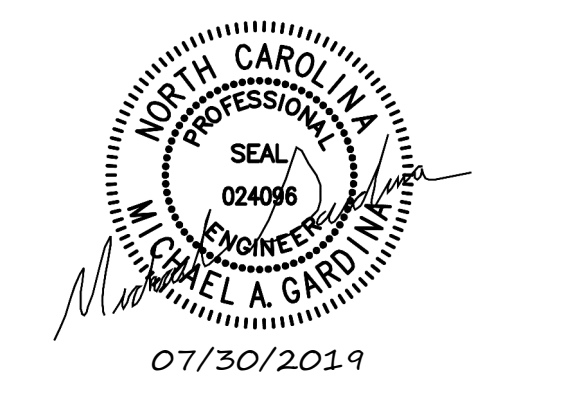

**THE WILSON GROUP**  
 ARCHITECTS  
 PO Box 5510 Charlotte, NC 28299  
 704-331-9747 • www.twgarchitects.com

PROJECT MANAGER & CIVIL ENGINEER  
**TALBERT & BRIGHT**  
 CONSULTING ARCHITECT  
**LS3P**  
 STRUCTURAL ENGINEER  
 FIRM LICENSE #C-1051  
**STEWART**  
 FPP/IME ENGINEER  
**CHEATHAM & ASSOC.**

BAGGAGE HANDLING CONSULTANTS  
**BNP**  
 AIRCRAFT SUPPORT SYSTEMS  
**DK CONSULTANTS**  
 SPECIALTY LIGHTING CONSULTANT  
**HARTRANFT**  
 SINGAGE & WAYFINDING  
**TAKEFORM**

COPYRIGHT © 2019  
 THE WILSON GROUP ARCHITECTS  
 ALL RIGHTS RESERVED  
 PRINTED OR ELECTRONIC DRAWINGS AND DOCUMENTATION MAY NOT BE REPRODUCED IN ANY FORM WITHOUT WRITTEN PERMISSION FROM THE WILSON GROUP ARCHITECTS


**REVISIONS**

1	7/12/19	AD-01
3	7/30/19	AD-03


DATE: 06/28/2019  
 PROJECT NUMBER: 9202-000  
 SHEET TITLE:

**STRUCTURAL FLOOR SECTIONS**


SHEET NUMBER  
**S-511**

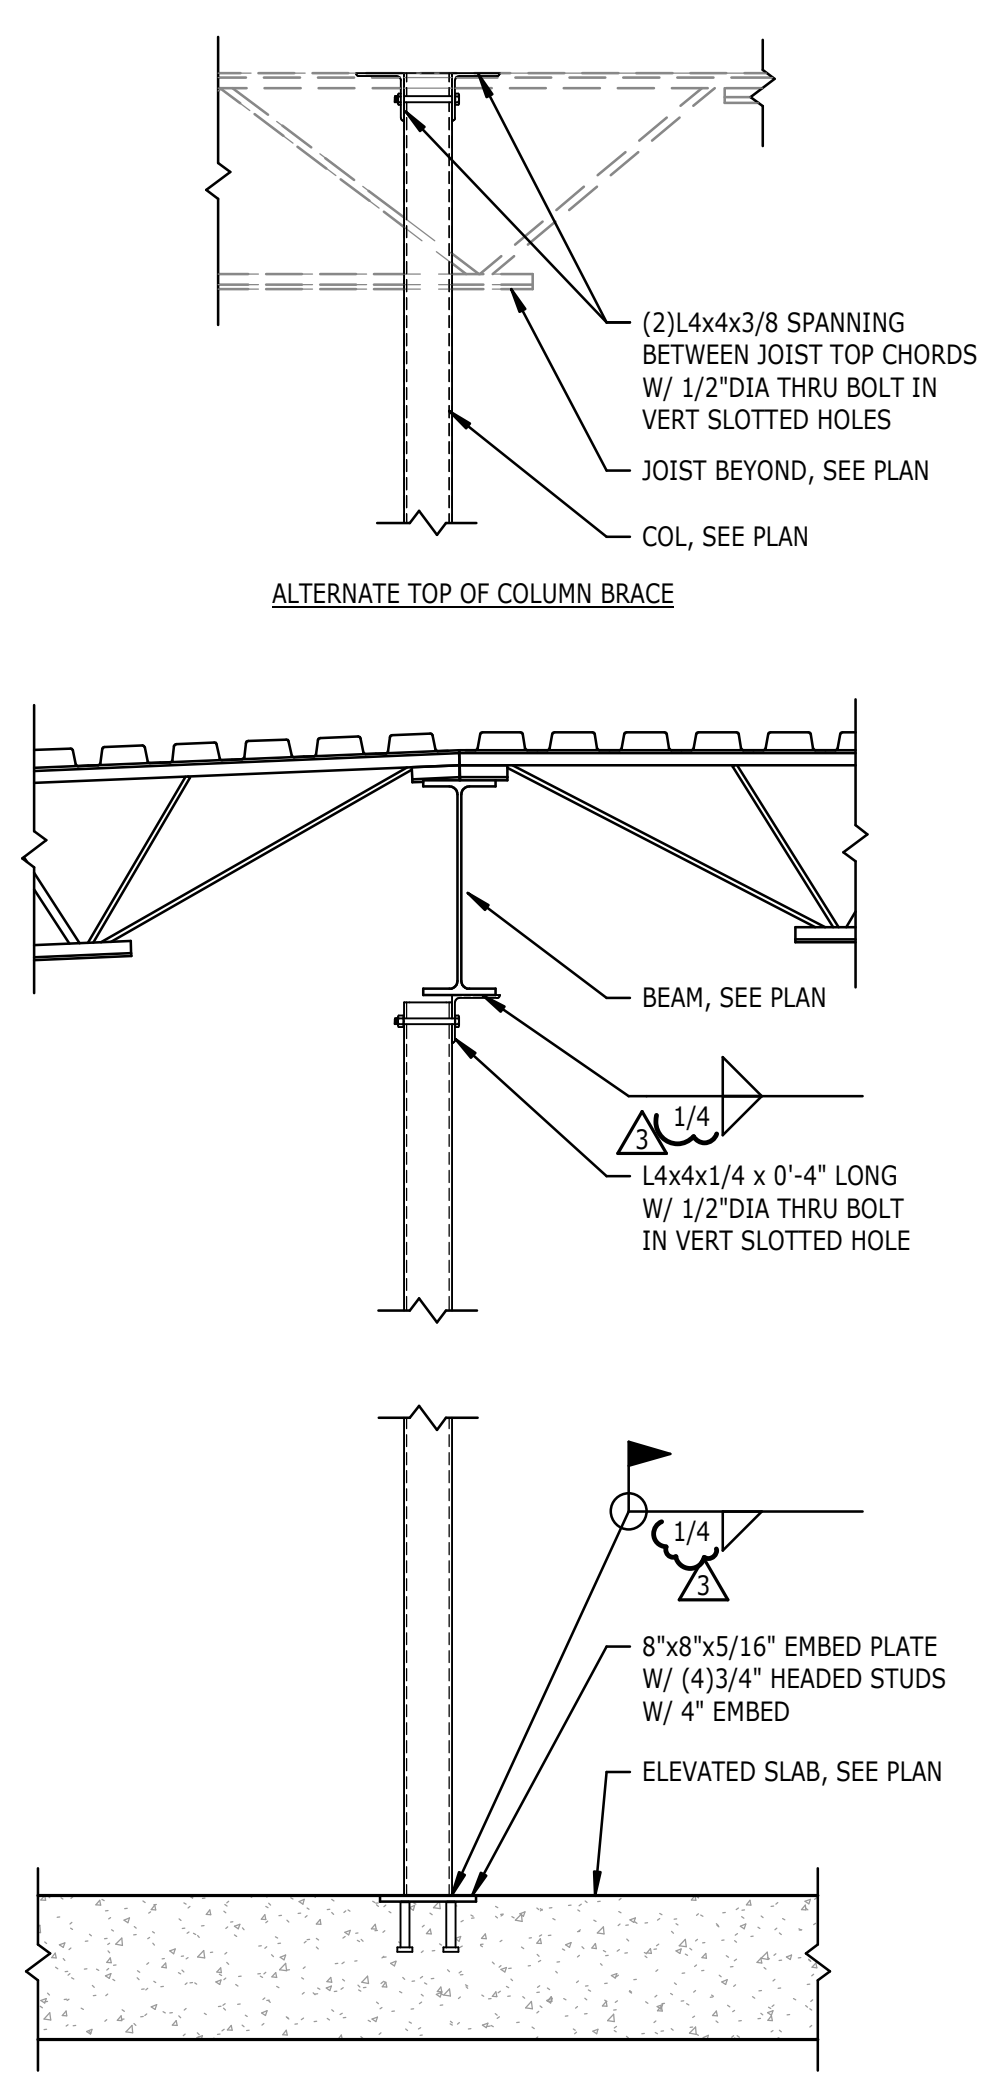


17 SECTION  
S-512 3/4" = 1'-0"

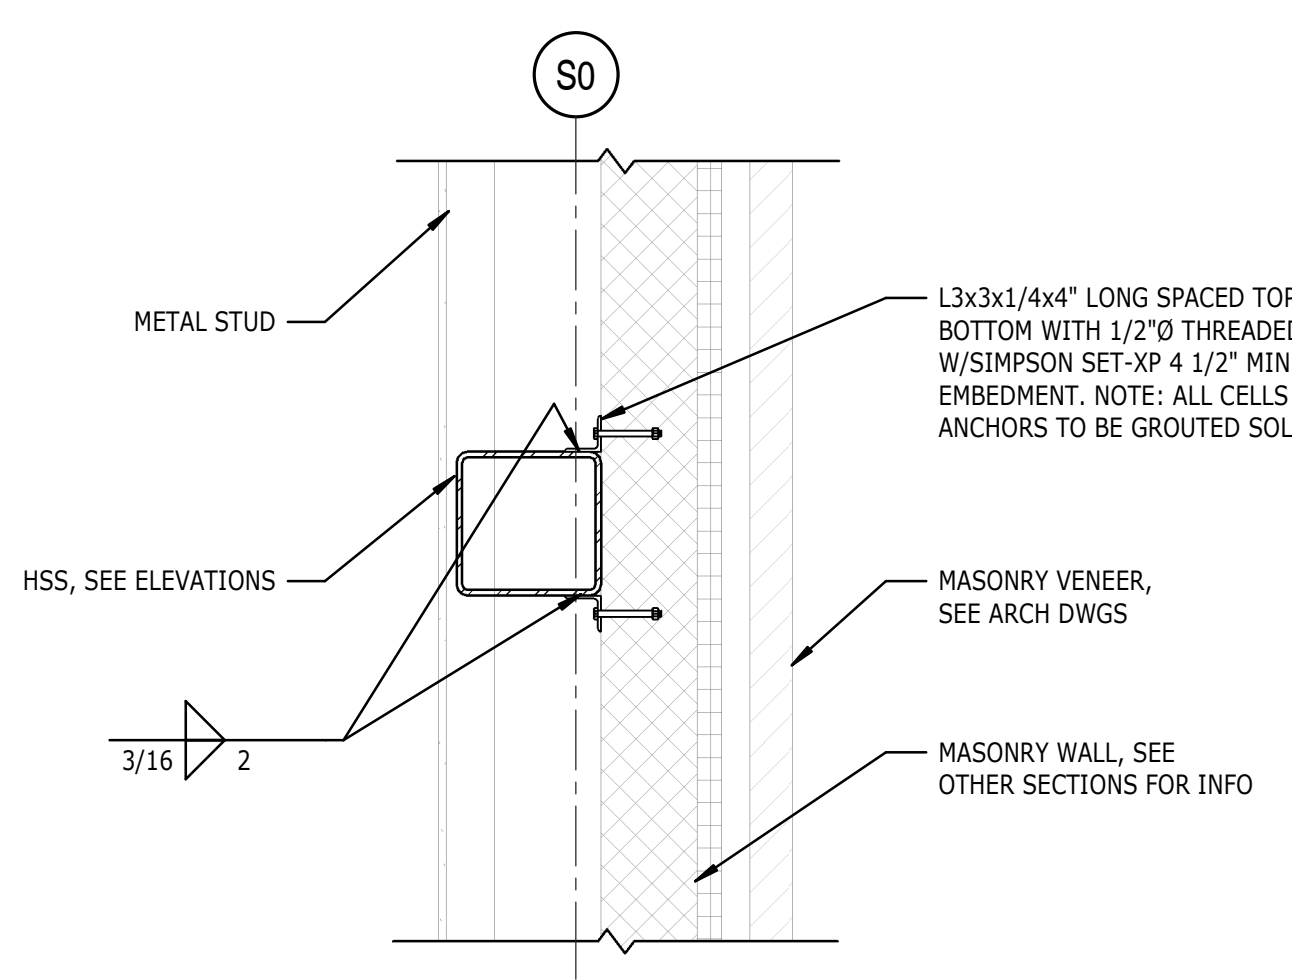



13 SECTION  
S-512 3/4" = 1'-0"

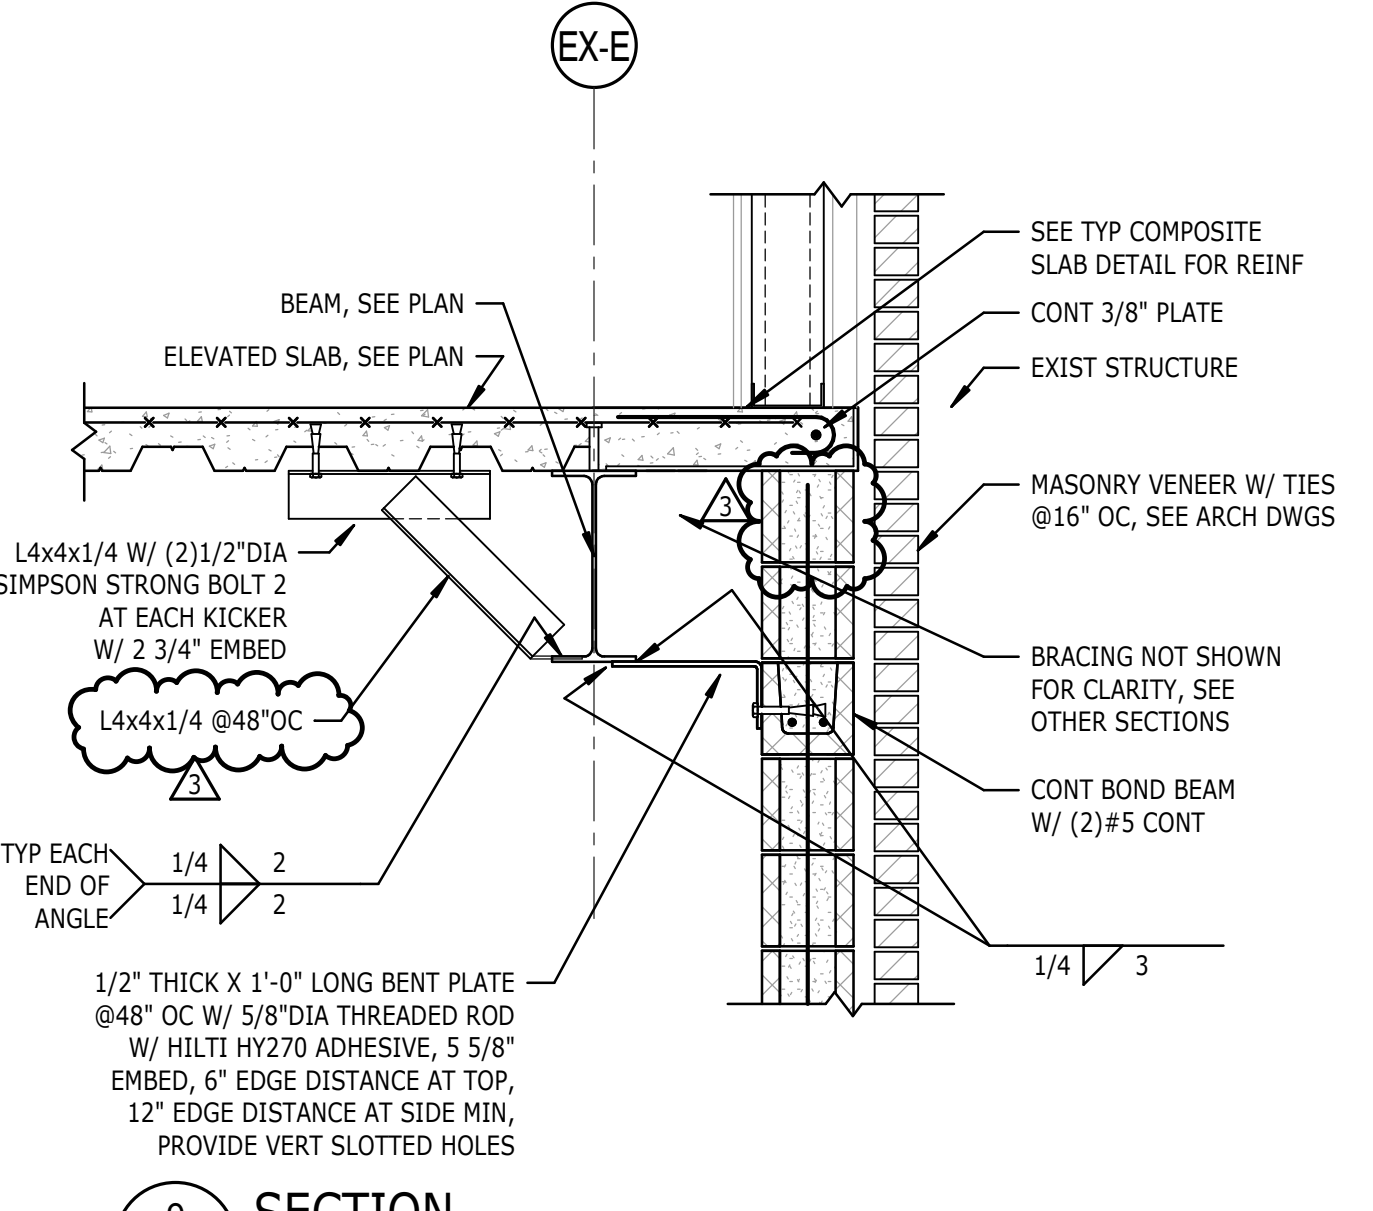


9 SECTION  
S-512 3/4" = 1'-0"

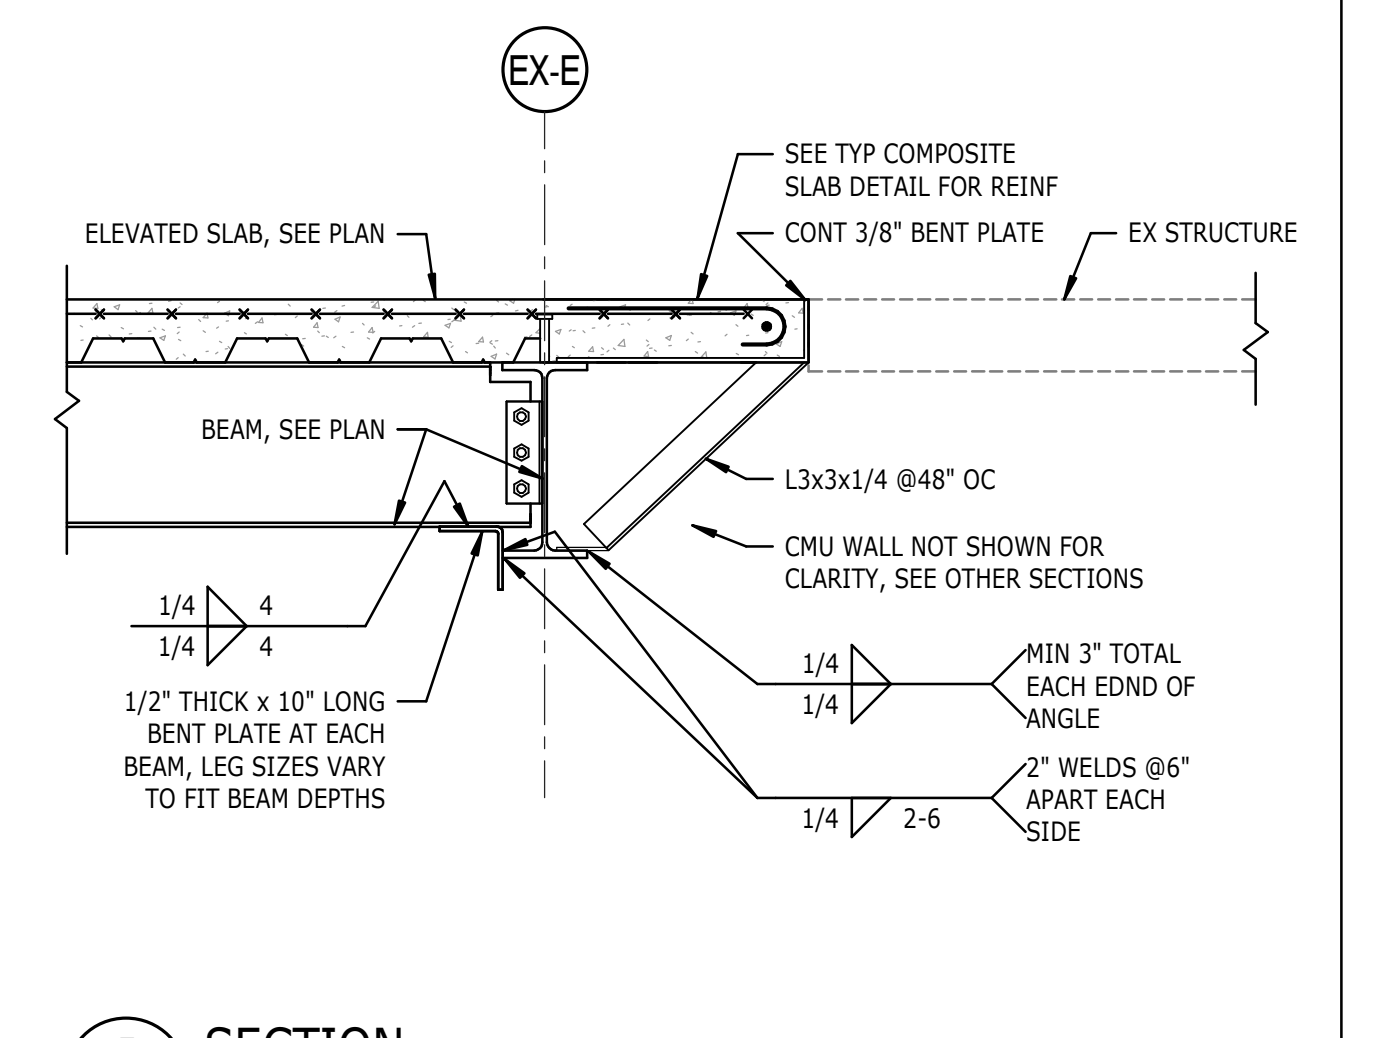


5 SECTION  
S-512 3/4" = 1'-0"

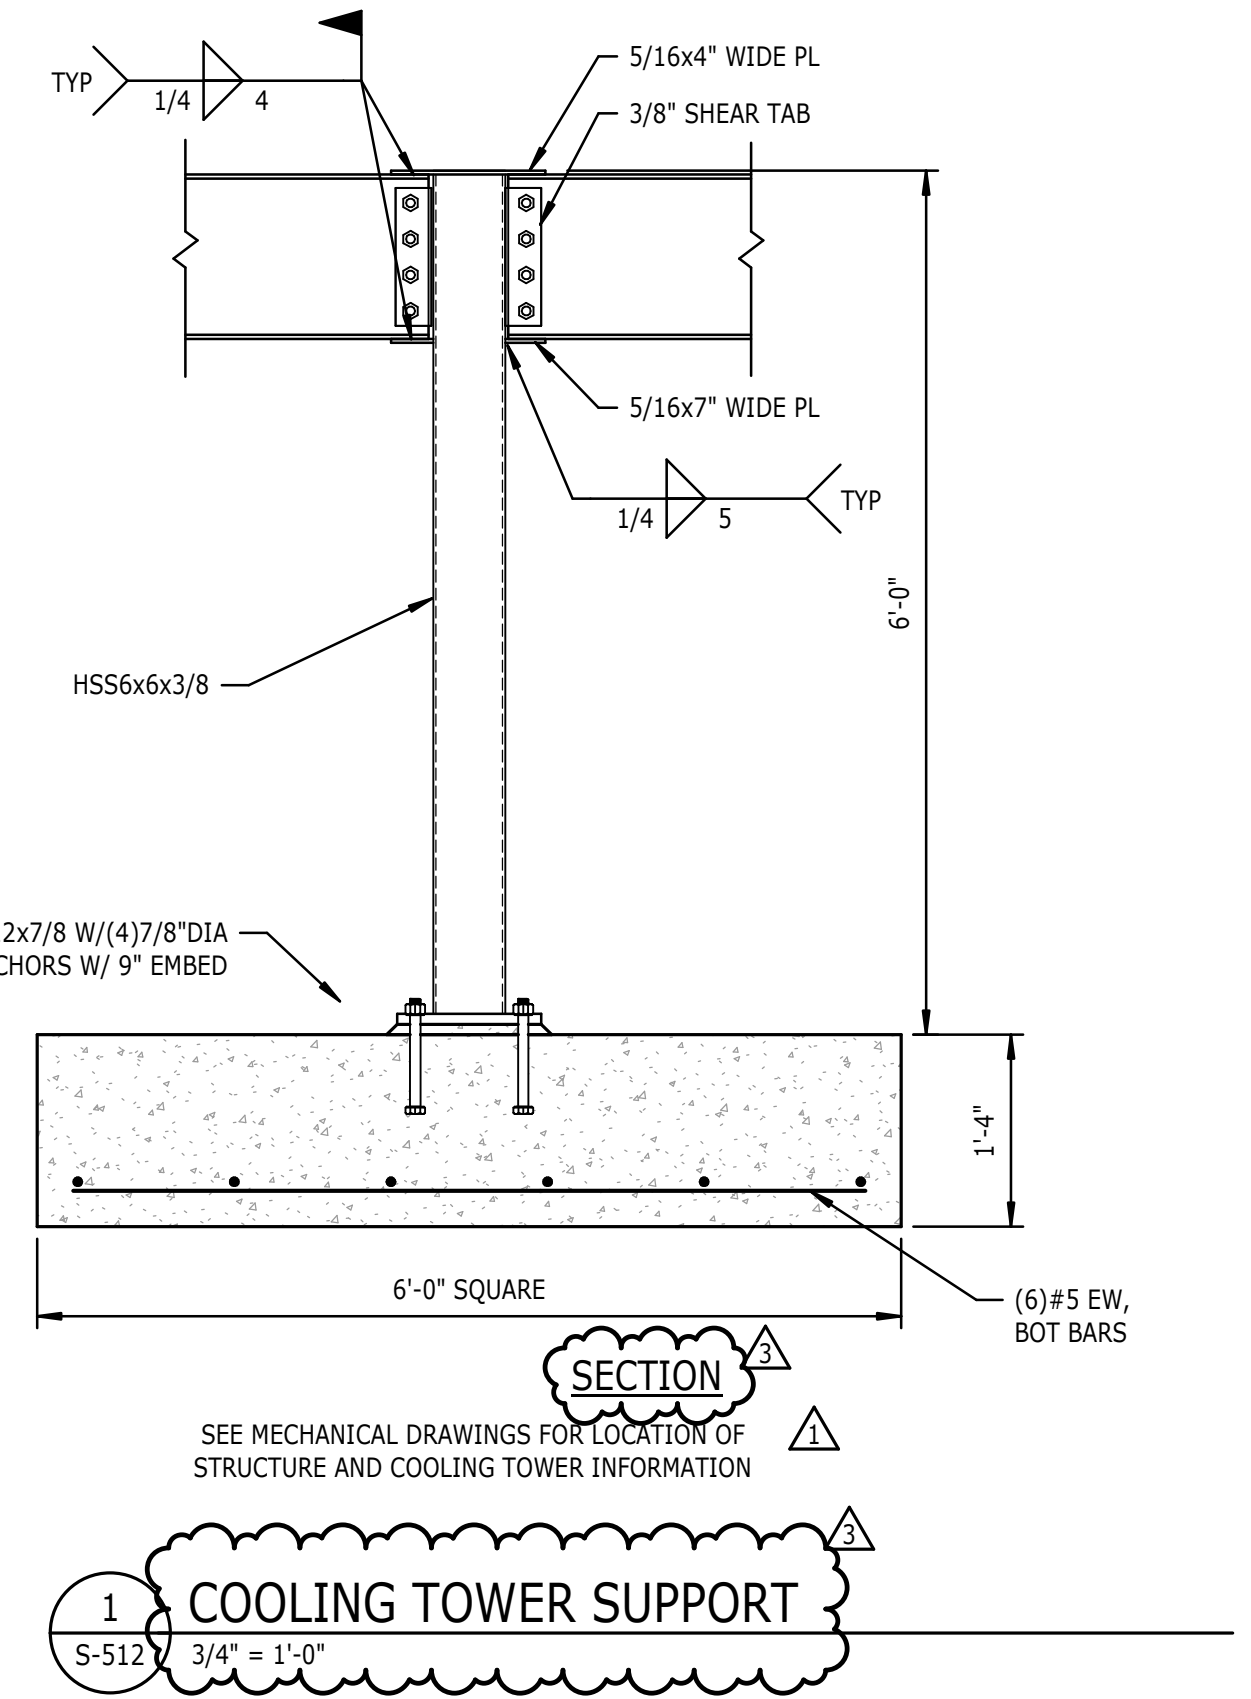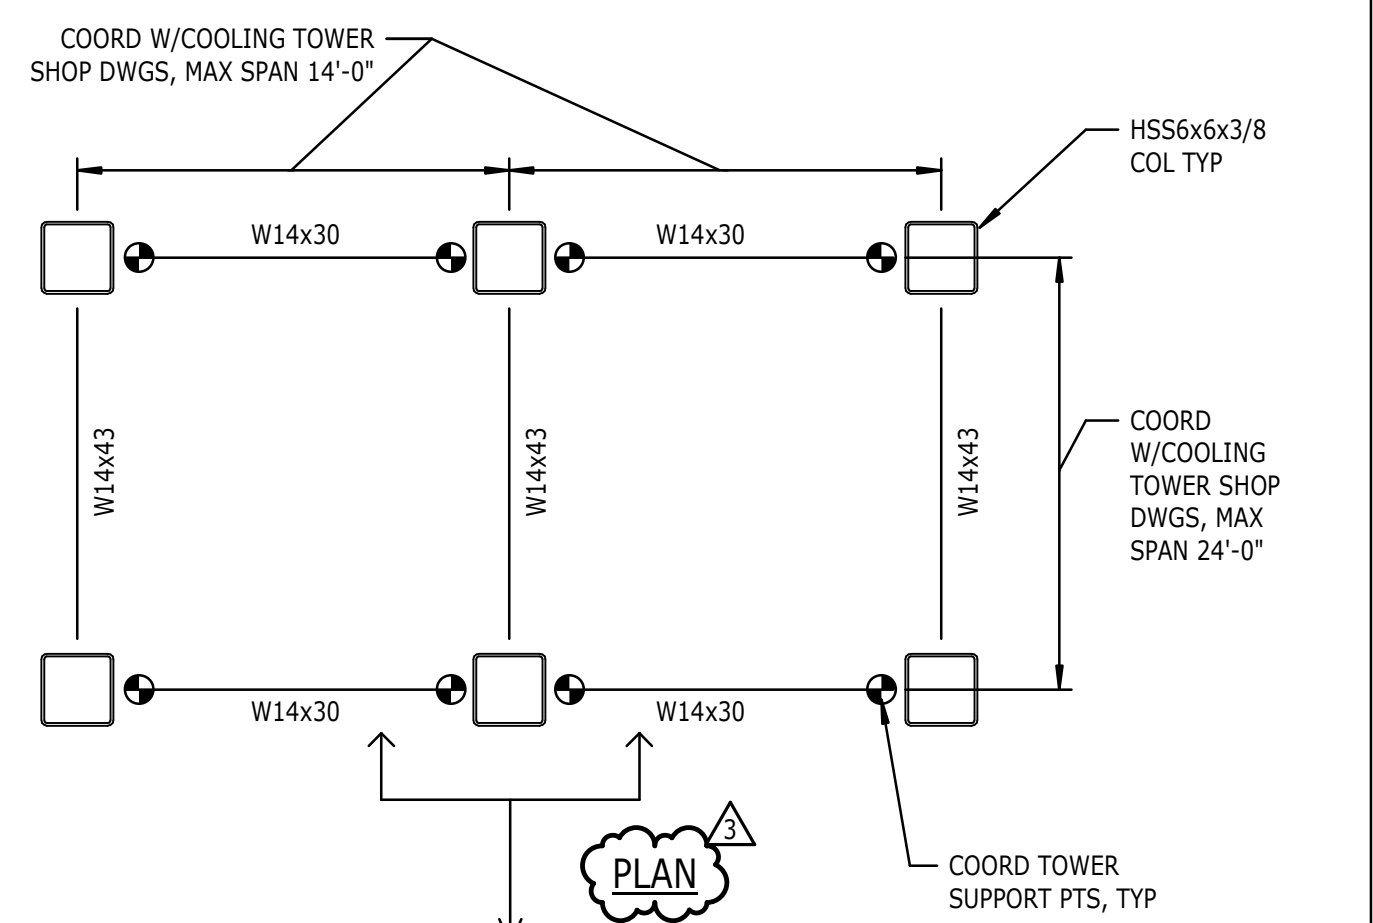


1 SECTION  
S-512 3/4" = 1'-0"

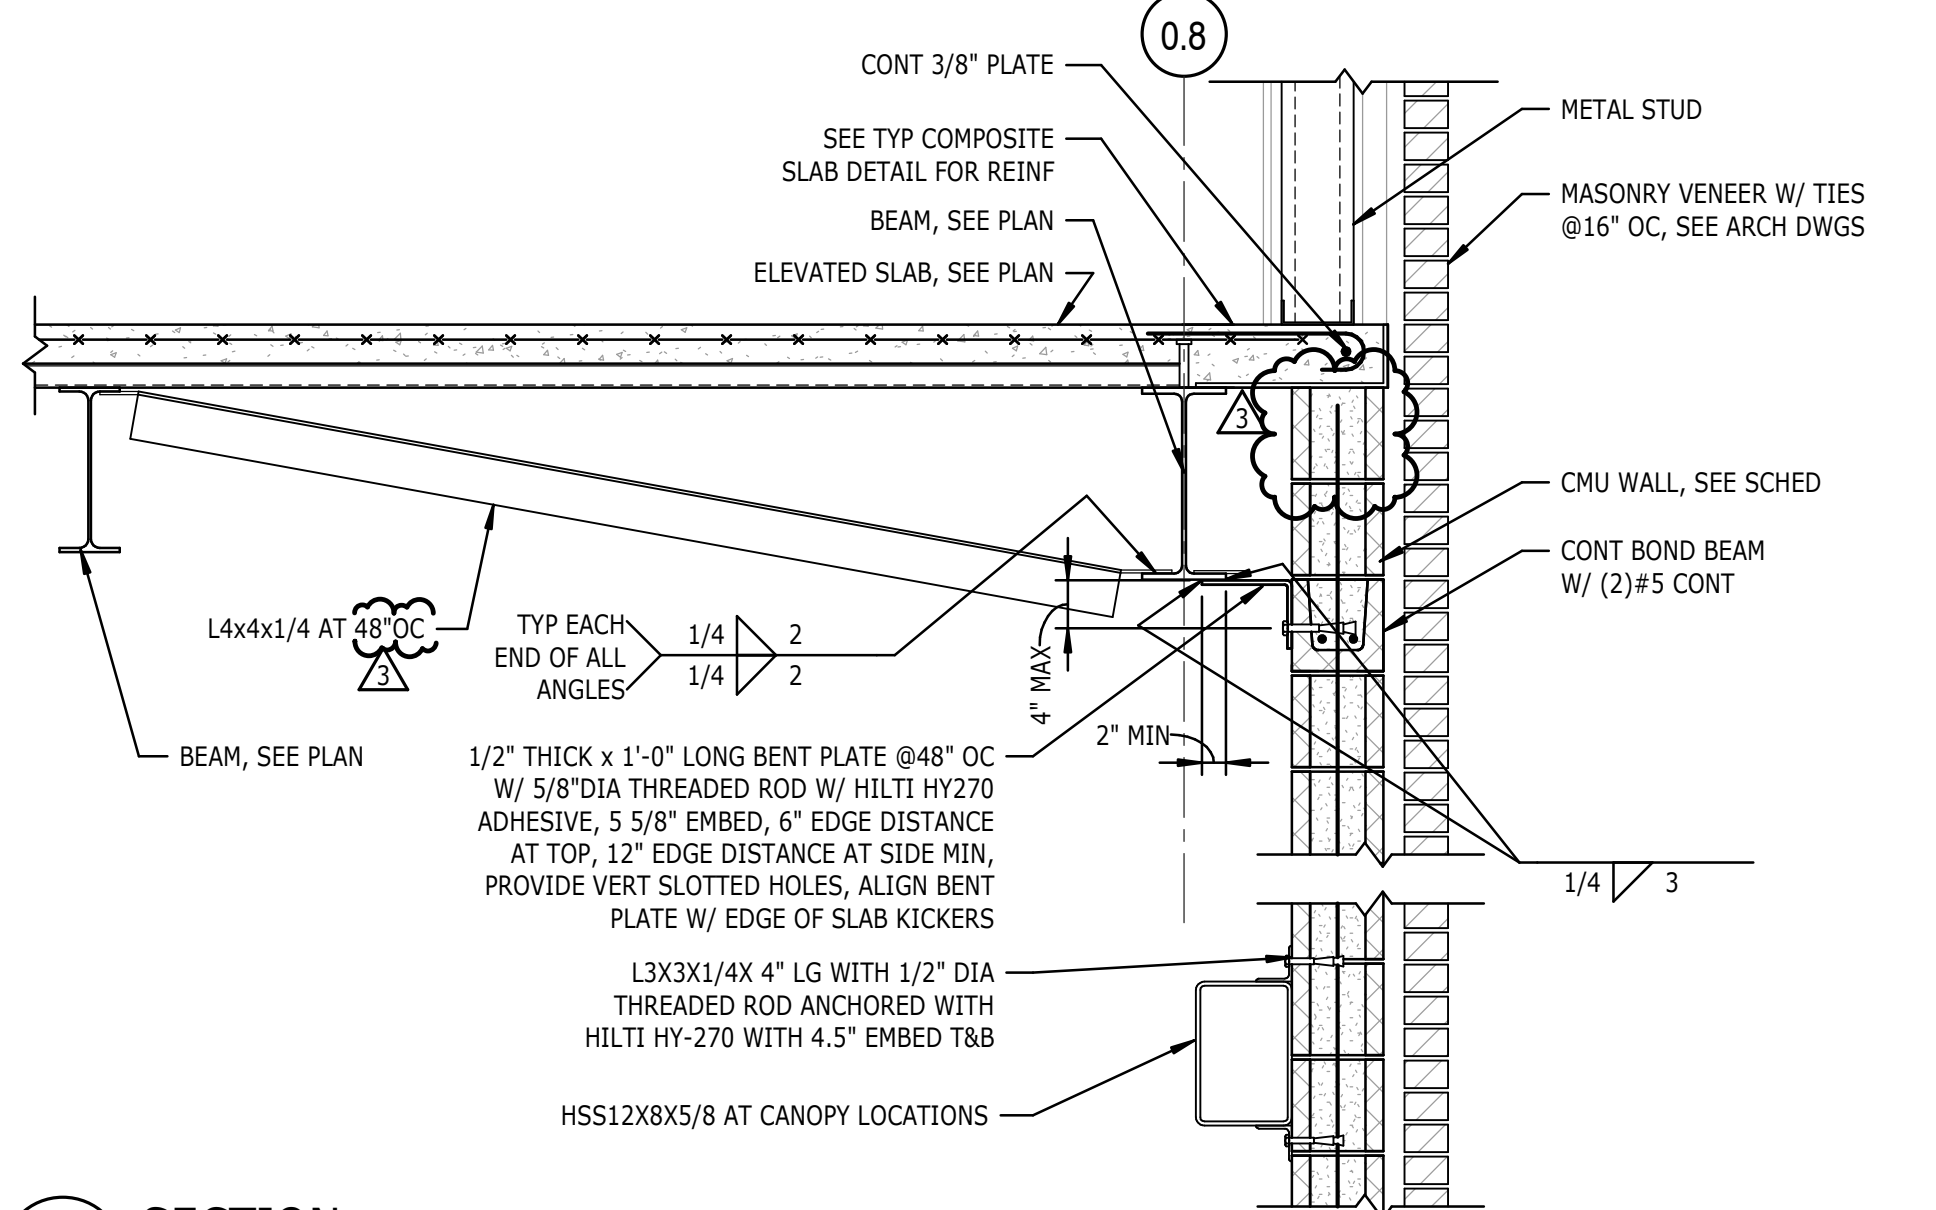


10 SECTION  
S-512 3/4" = 1'-0"

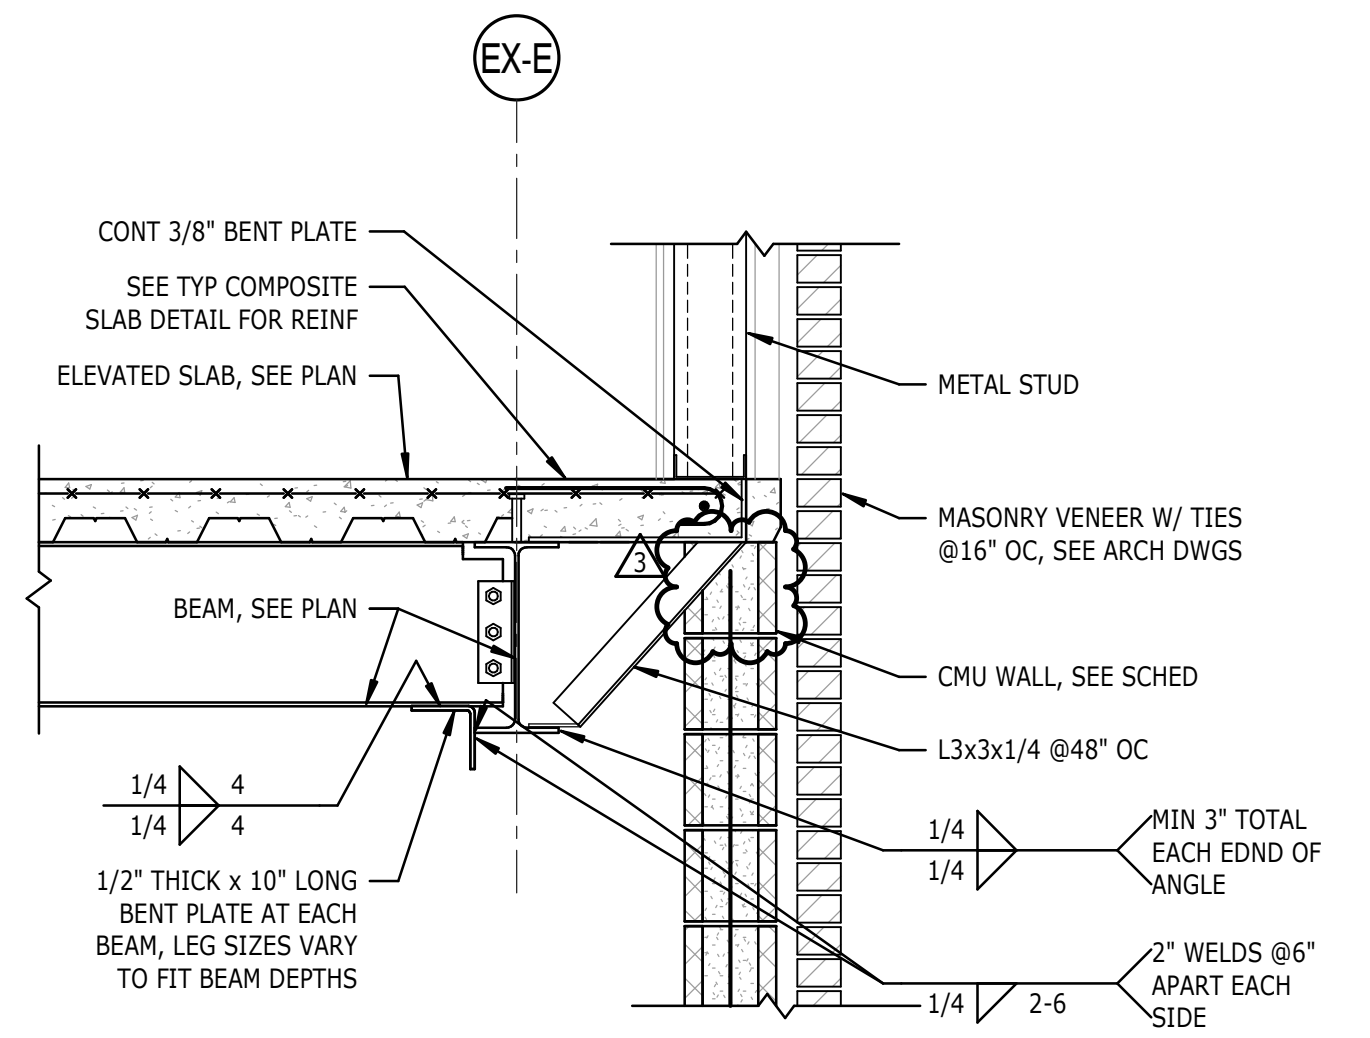


6 SECTION  
S-512 3/4" = 1'-0"

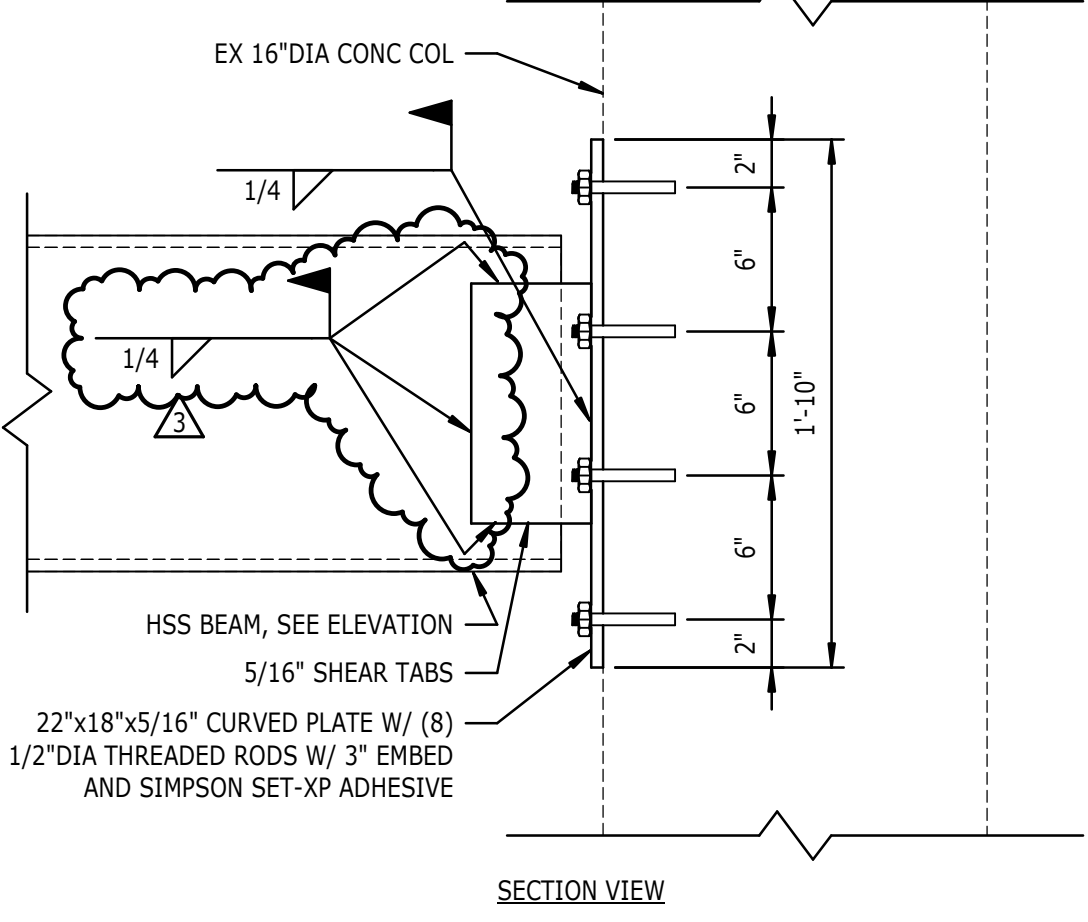


19 SECTION  
S-512 1 1/2" = 1'-0"

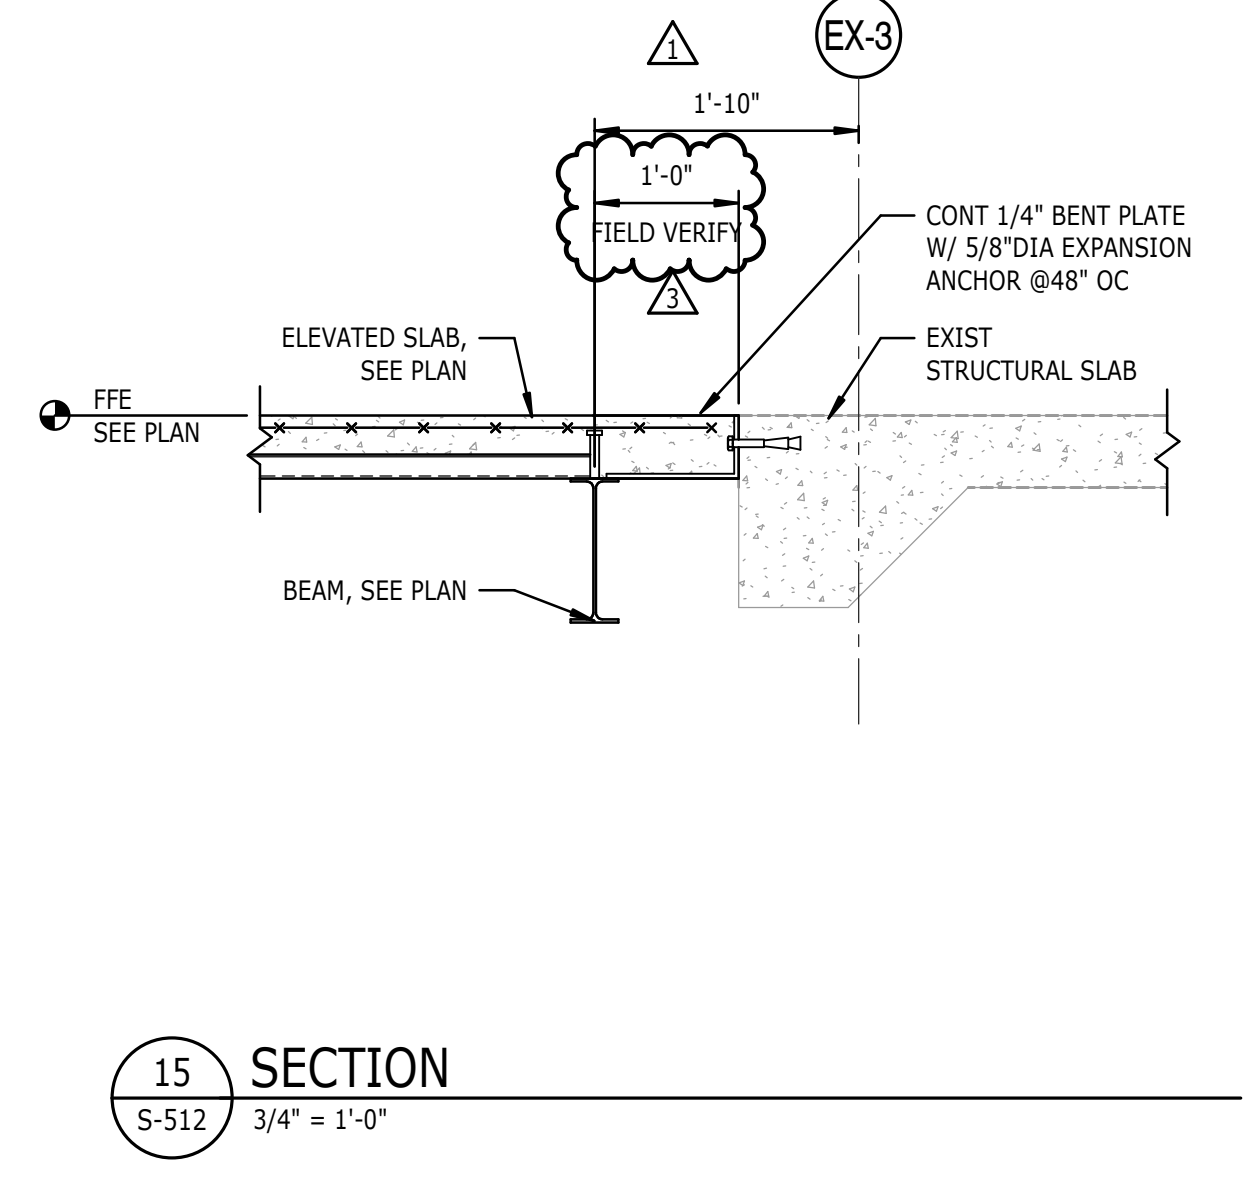


15 SECTION  
S-512 3/4" = 1'-0"

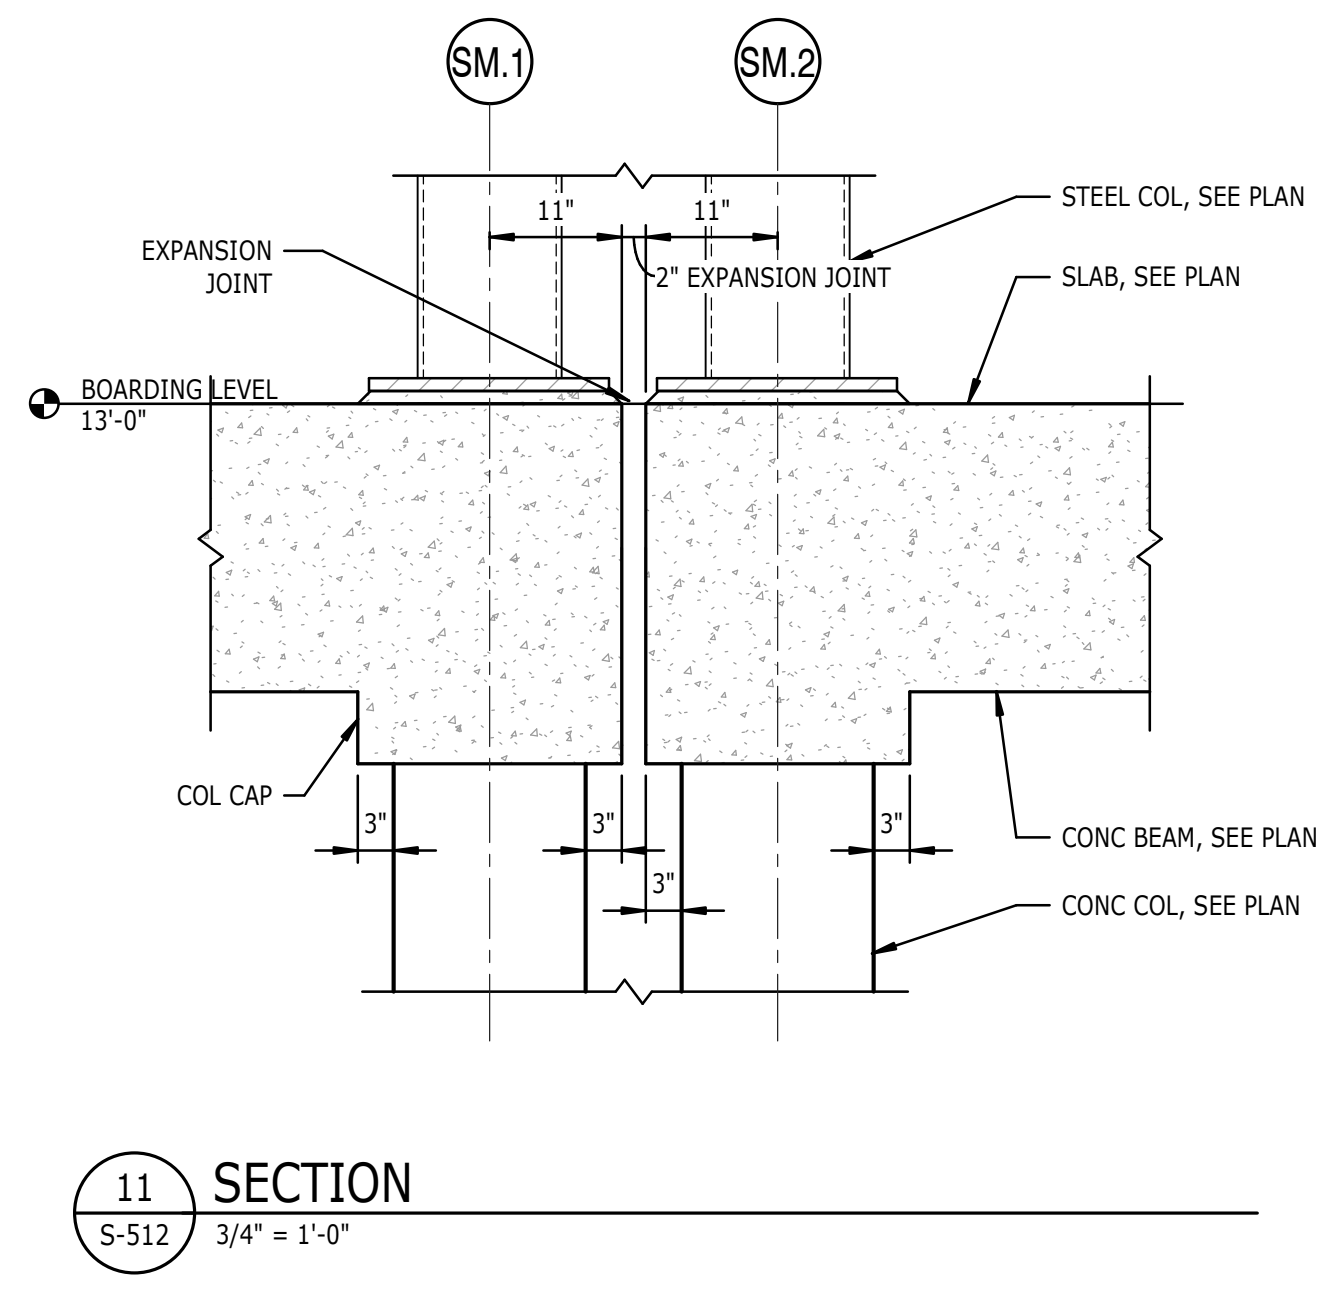


11 SECTION  
S-512 3/4" = 1'-0"

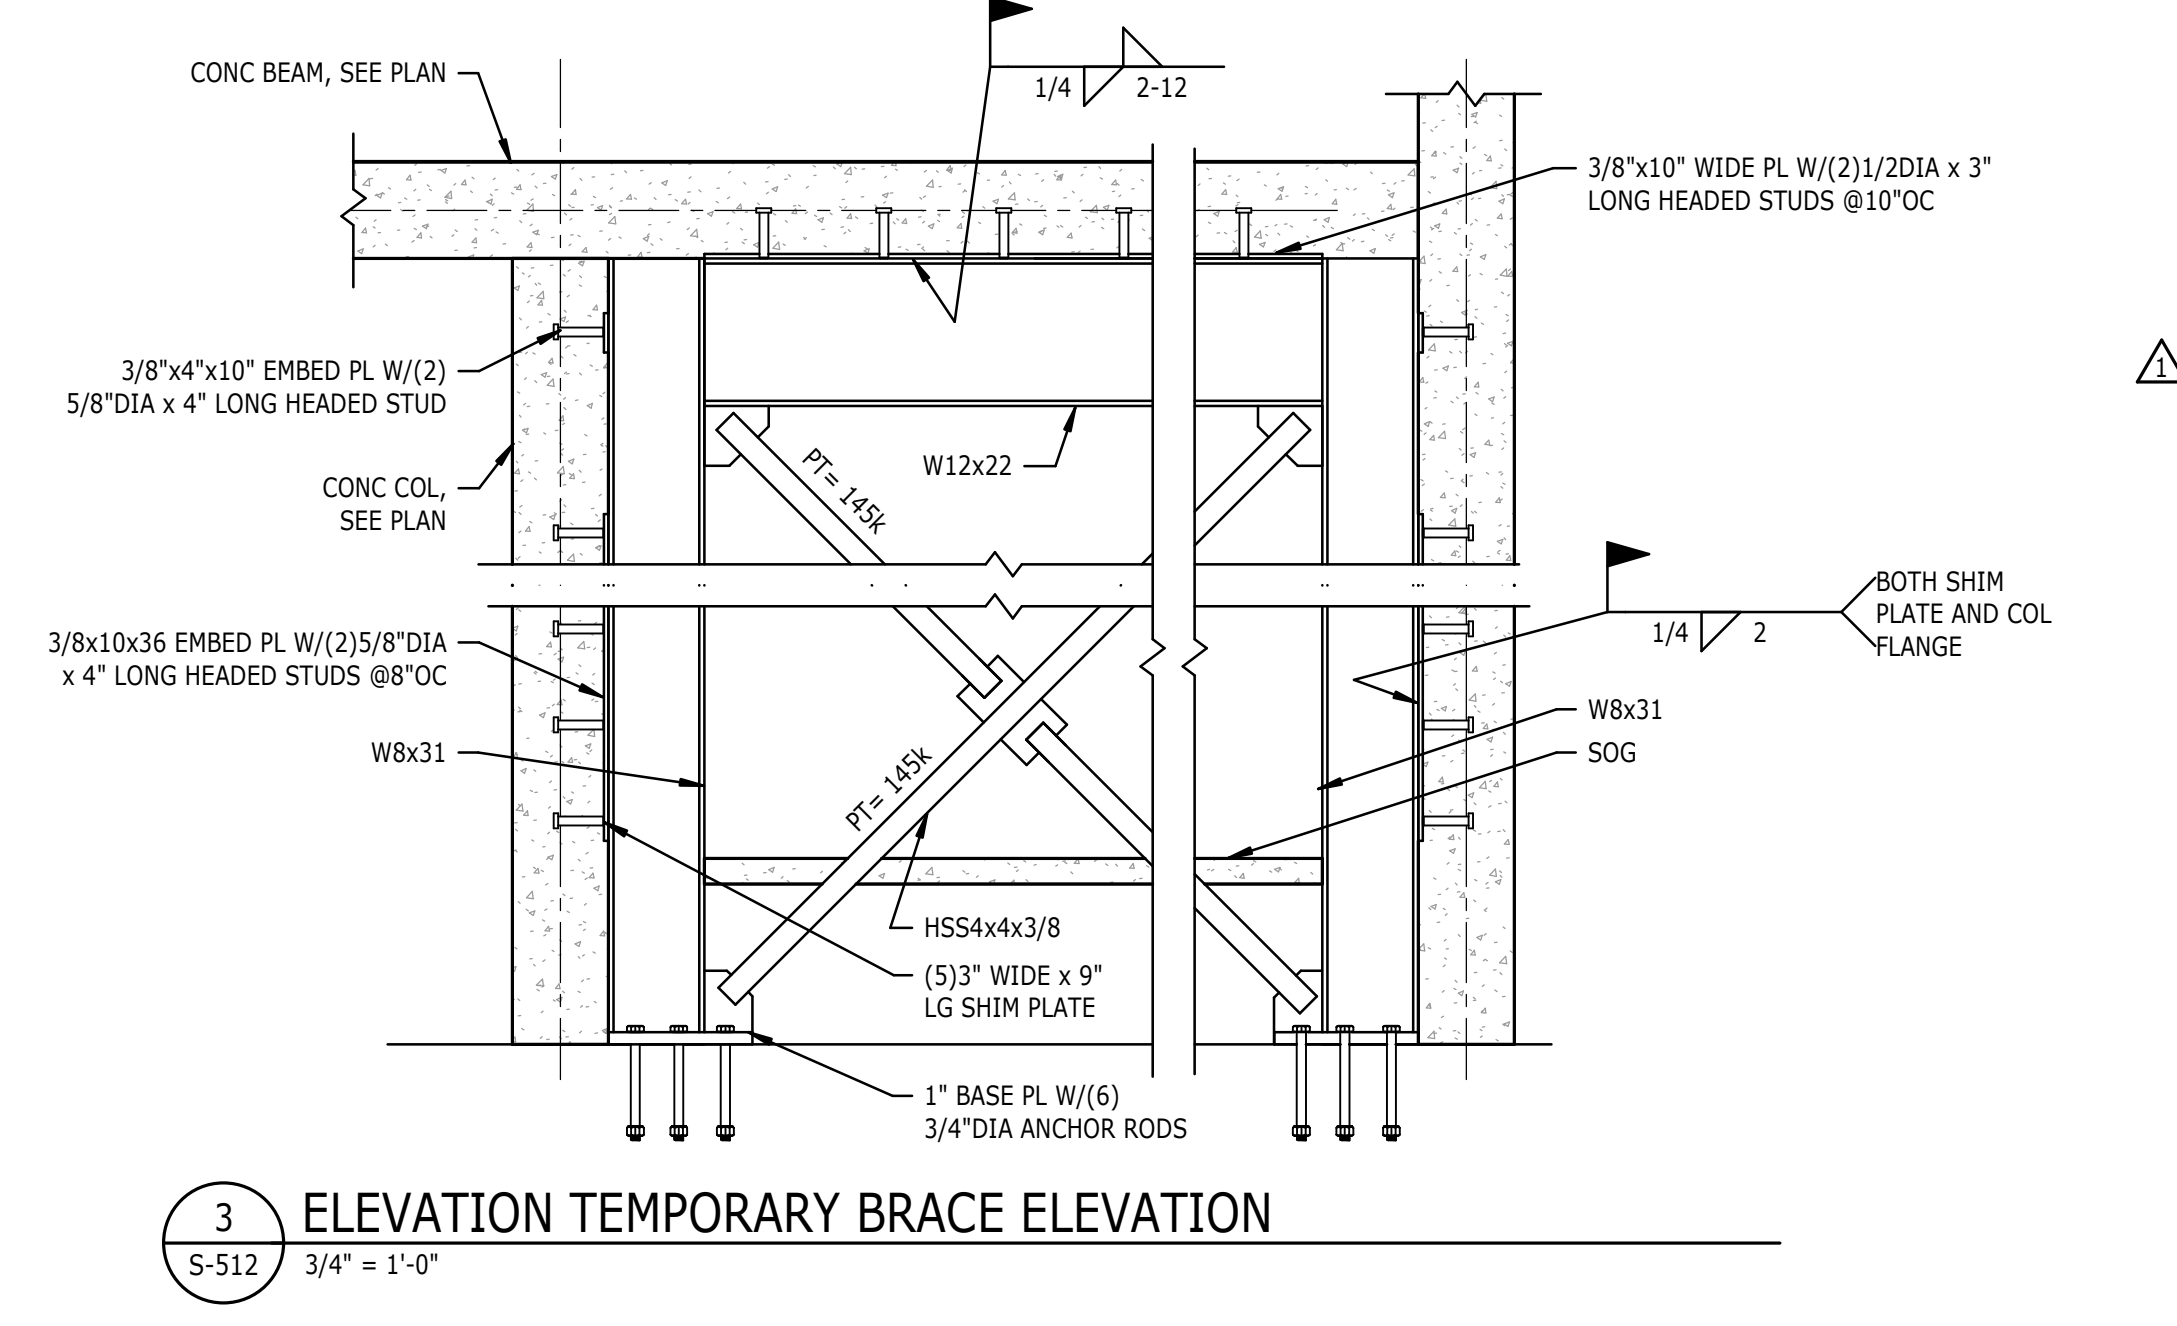


3 ELEVATION TEMPORARY BRACE ELEVATION  
S-512 3/4" = 1'-0"

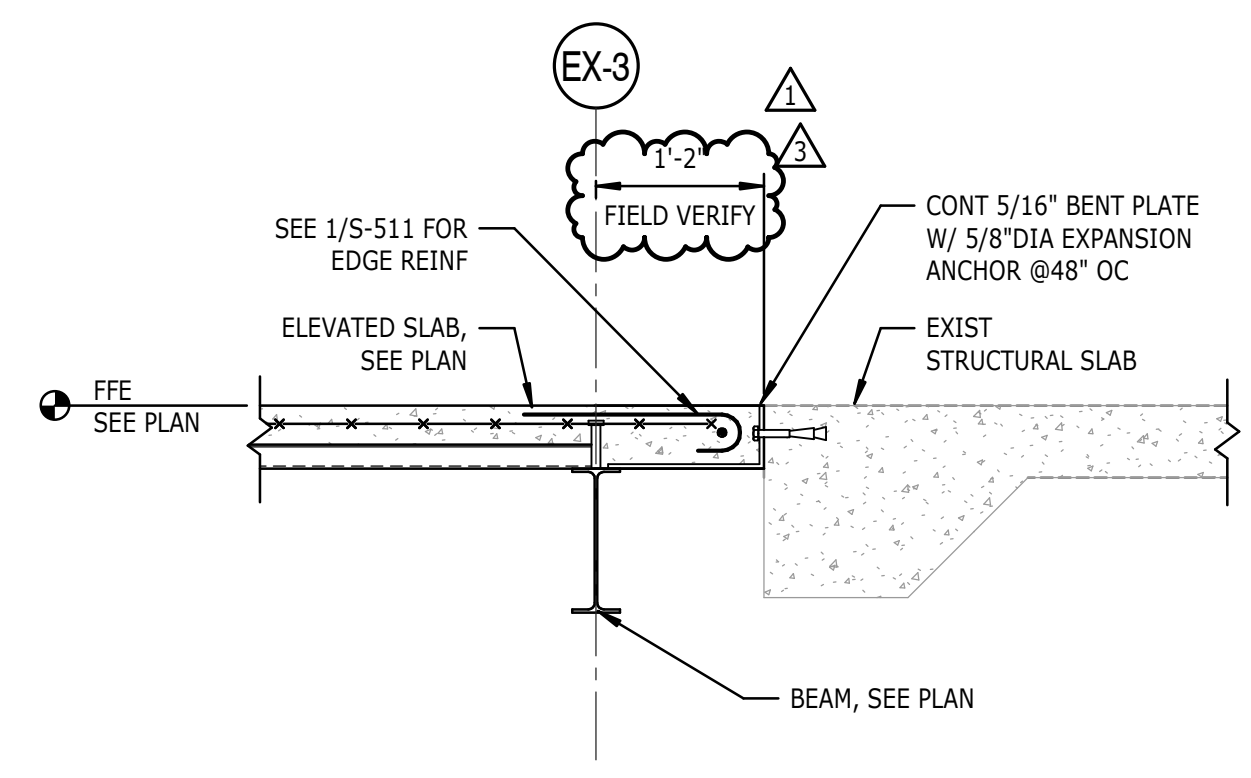


16 SECTION  
S-512 3/4" = 1'-0"

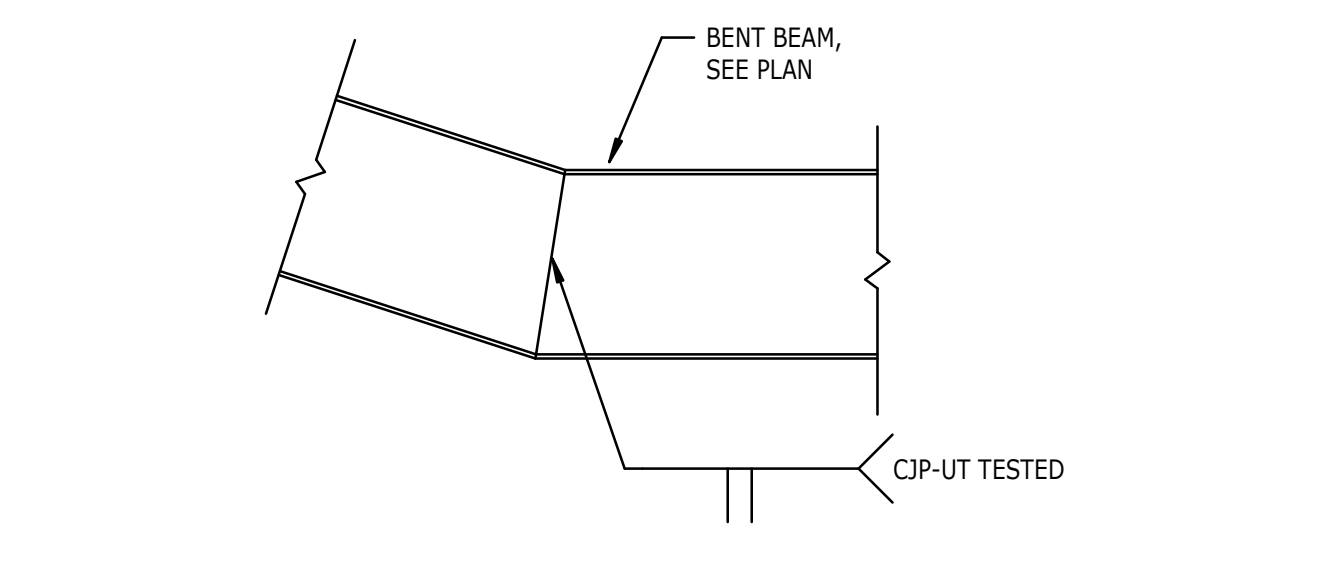

12 SECTION  
S-512 3/4" = 1'-0"

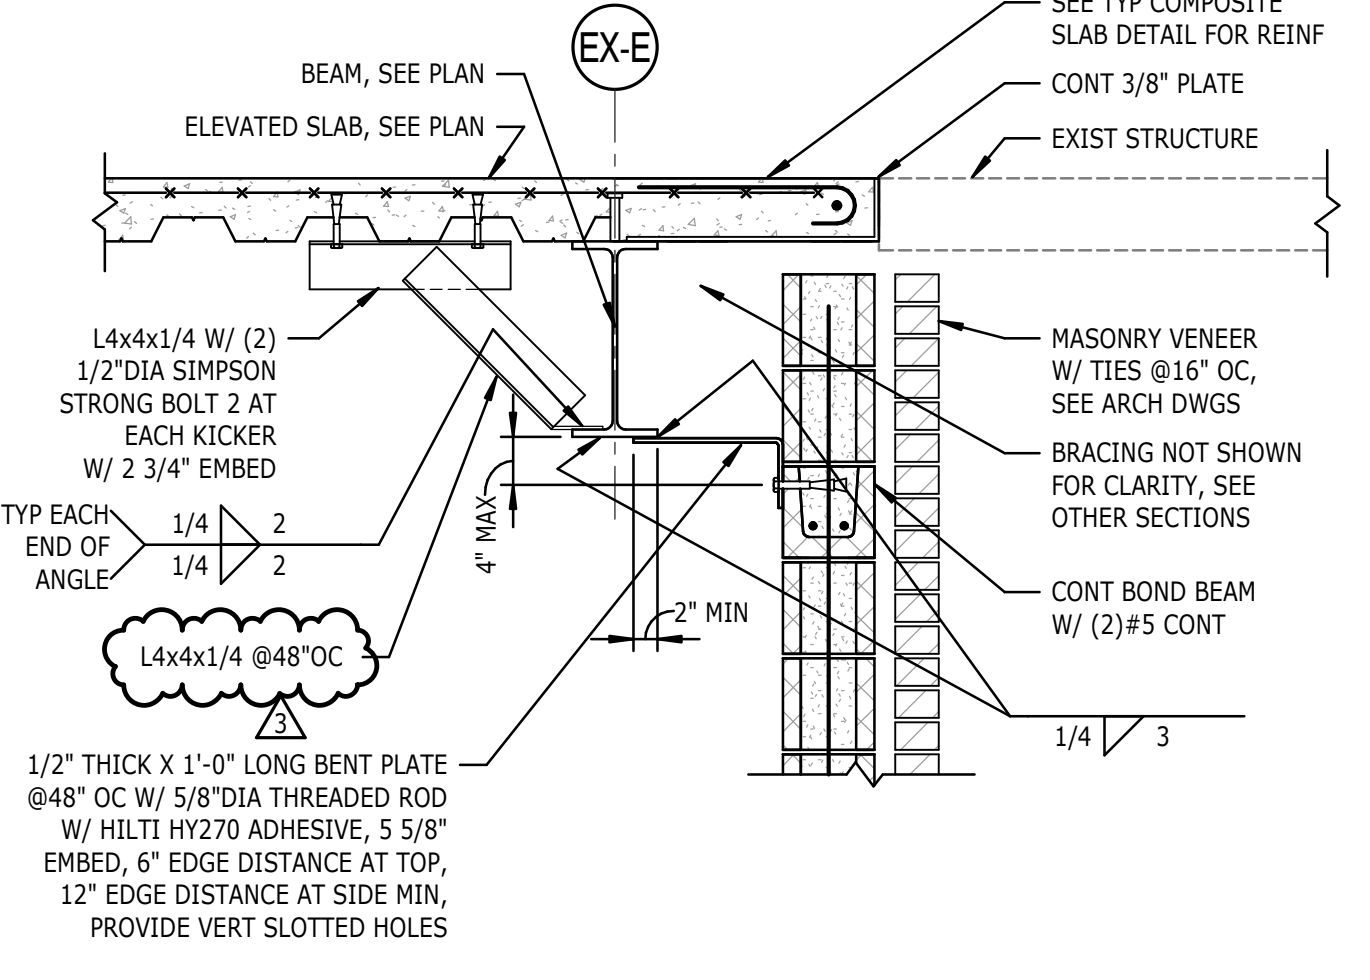

8 SECTION  
S-512 3/4" = 1'-0"


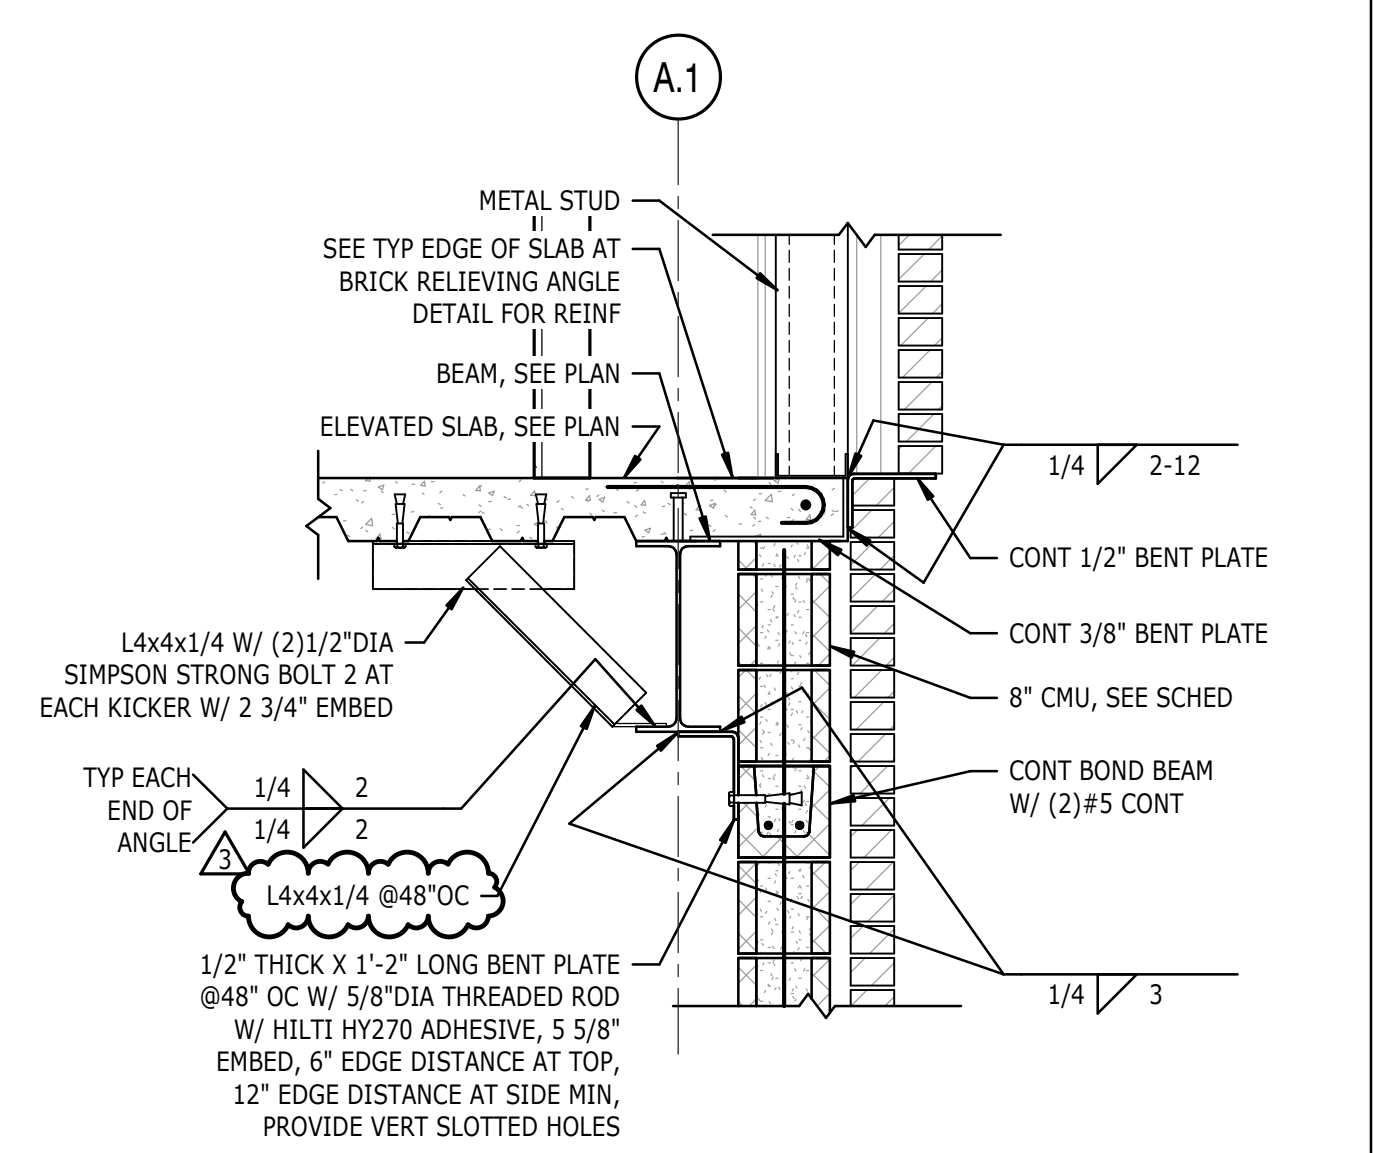


4 SECTION  
S-512 3/4" = 1'-0"



# TERMINAL IMPROVEMENTS CONTRACT 3

Wilmington International Airport  
1740 Airport Boulevard, Suite 12  
Wilmington, NC 28405

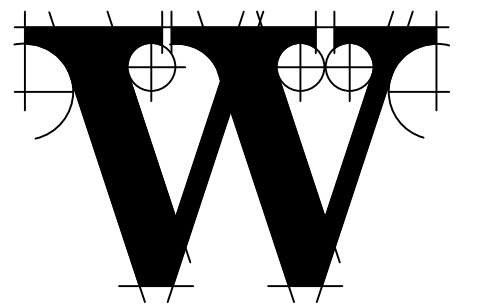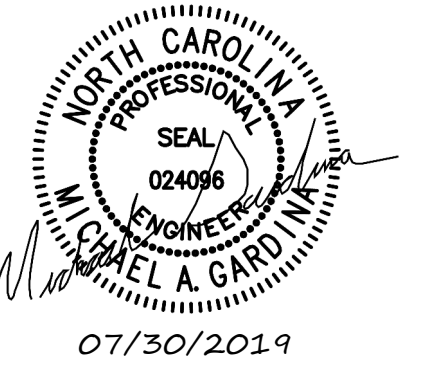

## THE WILSON GROUP - ARCHITECTS -

PO Box 5510 Charlotte, NC 28299  
704-331-9747 • www.twgarchitects.com

PROJECT MANAGER & CIVIL ENGINEER  
**TALBERT & BRIGHT**

CONSULTING ARCHITECT  
**LS3P**

STRUCTURAL ENGINEER  
FIRM LICENSE #C-1051  
**STEWART**

FP/PM/E ENGINEER  
**CHEATHAM & ASSOC.**

BAGGAGE HANDLING CONSULTANTS  
**BNP**

AIRCRAFT SUPPORT SYSTEMS  
**DK CONSULTANTS**

SPECIALTY LIGHTING CONSULTANT  
**HARTRANFT**

SINGAGE & WAYFINDING  
**TAKEFORM**

COPYRIGHT © 2019  
THE WILSON GROUP ARCHITECTS  
ALL RIGHTS RESERVED

PRINTED OR ELECTRONIC DRAWINGS AND DOCUMENTATION MAY NOT BE REPRODUCED IN ANY FORM WITHOUT WRITTEN PERMISSION FROM THE WILSON GROUP ARCHITECTS

### REVISIONS

3 7/30/19 AD-03

DATE 07/29/19  
PROJECT NUMBER 9202-000  
SHEET TITLE

## STRUCTURAL FLOOR SECTIONS

SHEET NUMBER

# S-513


TYPE	LOCATION	BOLTS AT CONCRETE COLUMN				COMMENTS
		BOLTS AT BEAM WEB	NUMBER AND SIZE	VERT SPACING	HORIZ SPACING	
A	EXB-EX3 (W12x16 FLOOR)	(3)3/4"DIA	(6)1"DIA HAS RODS	8"	6"	HILTI HIT-RE500 W/10" EMBED
A	EXC-EX3 (W12x16 FLOOR)	(3)3/4"DIA	(6)1"DIA HAS RODS	8"	6"	HILTI HIT-RE500 W/10" EMBED
A	EXB-EX3 (W21x62 ROOF)	(5)3/4"DIA	(8)5/8"DIA HAS RODS	8"	5"	HILTI HIT-RE500 W/8" EMBED
A	EXC-EX3 (W21x62 ROOF)	(5)3/4"DIA	(8)5/8"DIA HAS RODS	8"	5"	HILTI HIT-RE500 W/8" EMBED
A	EXD-EX3 (ROOF)	(5)3/4"DIA	(8)5/8"DIA HAS RODS	8"	5"	HILTI HIT-RE500 W/8" EMBED
A	EXE-EX3 (ROOF)	(4)3/4"DIA	(6)5/8"DIA HAS RODS	8"	5"	HILTI HIT-RE500 W/6" EMBED
A	EXB-EX3 (W14x30 ROOF)	(3)3/4"DIA	(6)5/8"DIA HAS RODS	8"	5"	HILTI HIT-RE500 W/6" EMBED
A	EXC-EX3 (W14x30 ROOF)	(3)3/4"DIA	(6)5/8"DIA HAS RODS	8"	5"	HILTI HIT-RE500 W/6" EMBED
B	A.1-EX3 (ROOF)	(4)3/4"DIA	(5)5/8"DIA HAS RODS	6"	N/A	HILTI HIT-RE500 W/6" EMBED
B	A.1-EX3 (FLOOR)	(4)1"DIA	(5)1"DIA HAS RODS	8"	N/A	HILTI HIT-RE500 W/12" EMBED
A	EXB-EX3 (W24x55 FLOOR)	(7)1"DIA	(8)1"DIA HAS RODS	8"	6"	THROUGH BOLT W/HILTI-RE500
A	EXC-EX3 (W24x62 FLOOR)	(7)1"DIA	(8)1"DIA HAS RODS	8"	6"	THROUGH BOLT W/HILTI-RE500
A	EXD-EX3 (FLOOR)	(7)1"DIA	(8)1"DIA HAS RODS	8"	6"	THROUGH BOLT W/HILTI-RE500
A	EXE-EX3 (FLOOR)	(4)1"DIA	(6)1"DIA HAS RODS	8"	6"	HILTI HIT-RE500 W/10" EMBED

### 1 DETAIL

S-513 NEW BEAM TO EXISTING COLUMN CONNECTION SCHEDULE AND DETAILS  
3/4" = 1'-0"


#### NOTES:

- ALL COLUMNS TO BE X-RAYED FOR LOCATING REBAR AND STRIRUPS BEFORE DRILLING.
- AT CIRCULAR COLUMNS, BEND PLATES FLUSH TO CONCRETE SURFACE.
- AT ROOF LOCATIONS, THE TOP ANCHOR INTO THE EXISTING CONCRETE STRUCTURE MUST BE 5" FROM THE TOP OF CONC, TYP.
- SLOTTED HOLES IN BEAM WEBS ARE NOT PERMITTED.

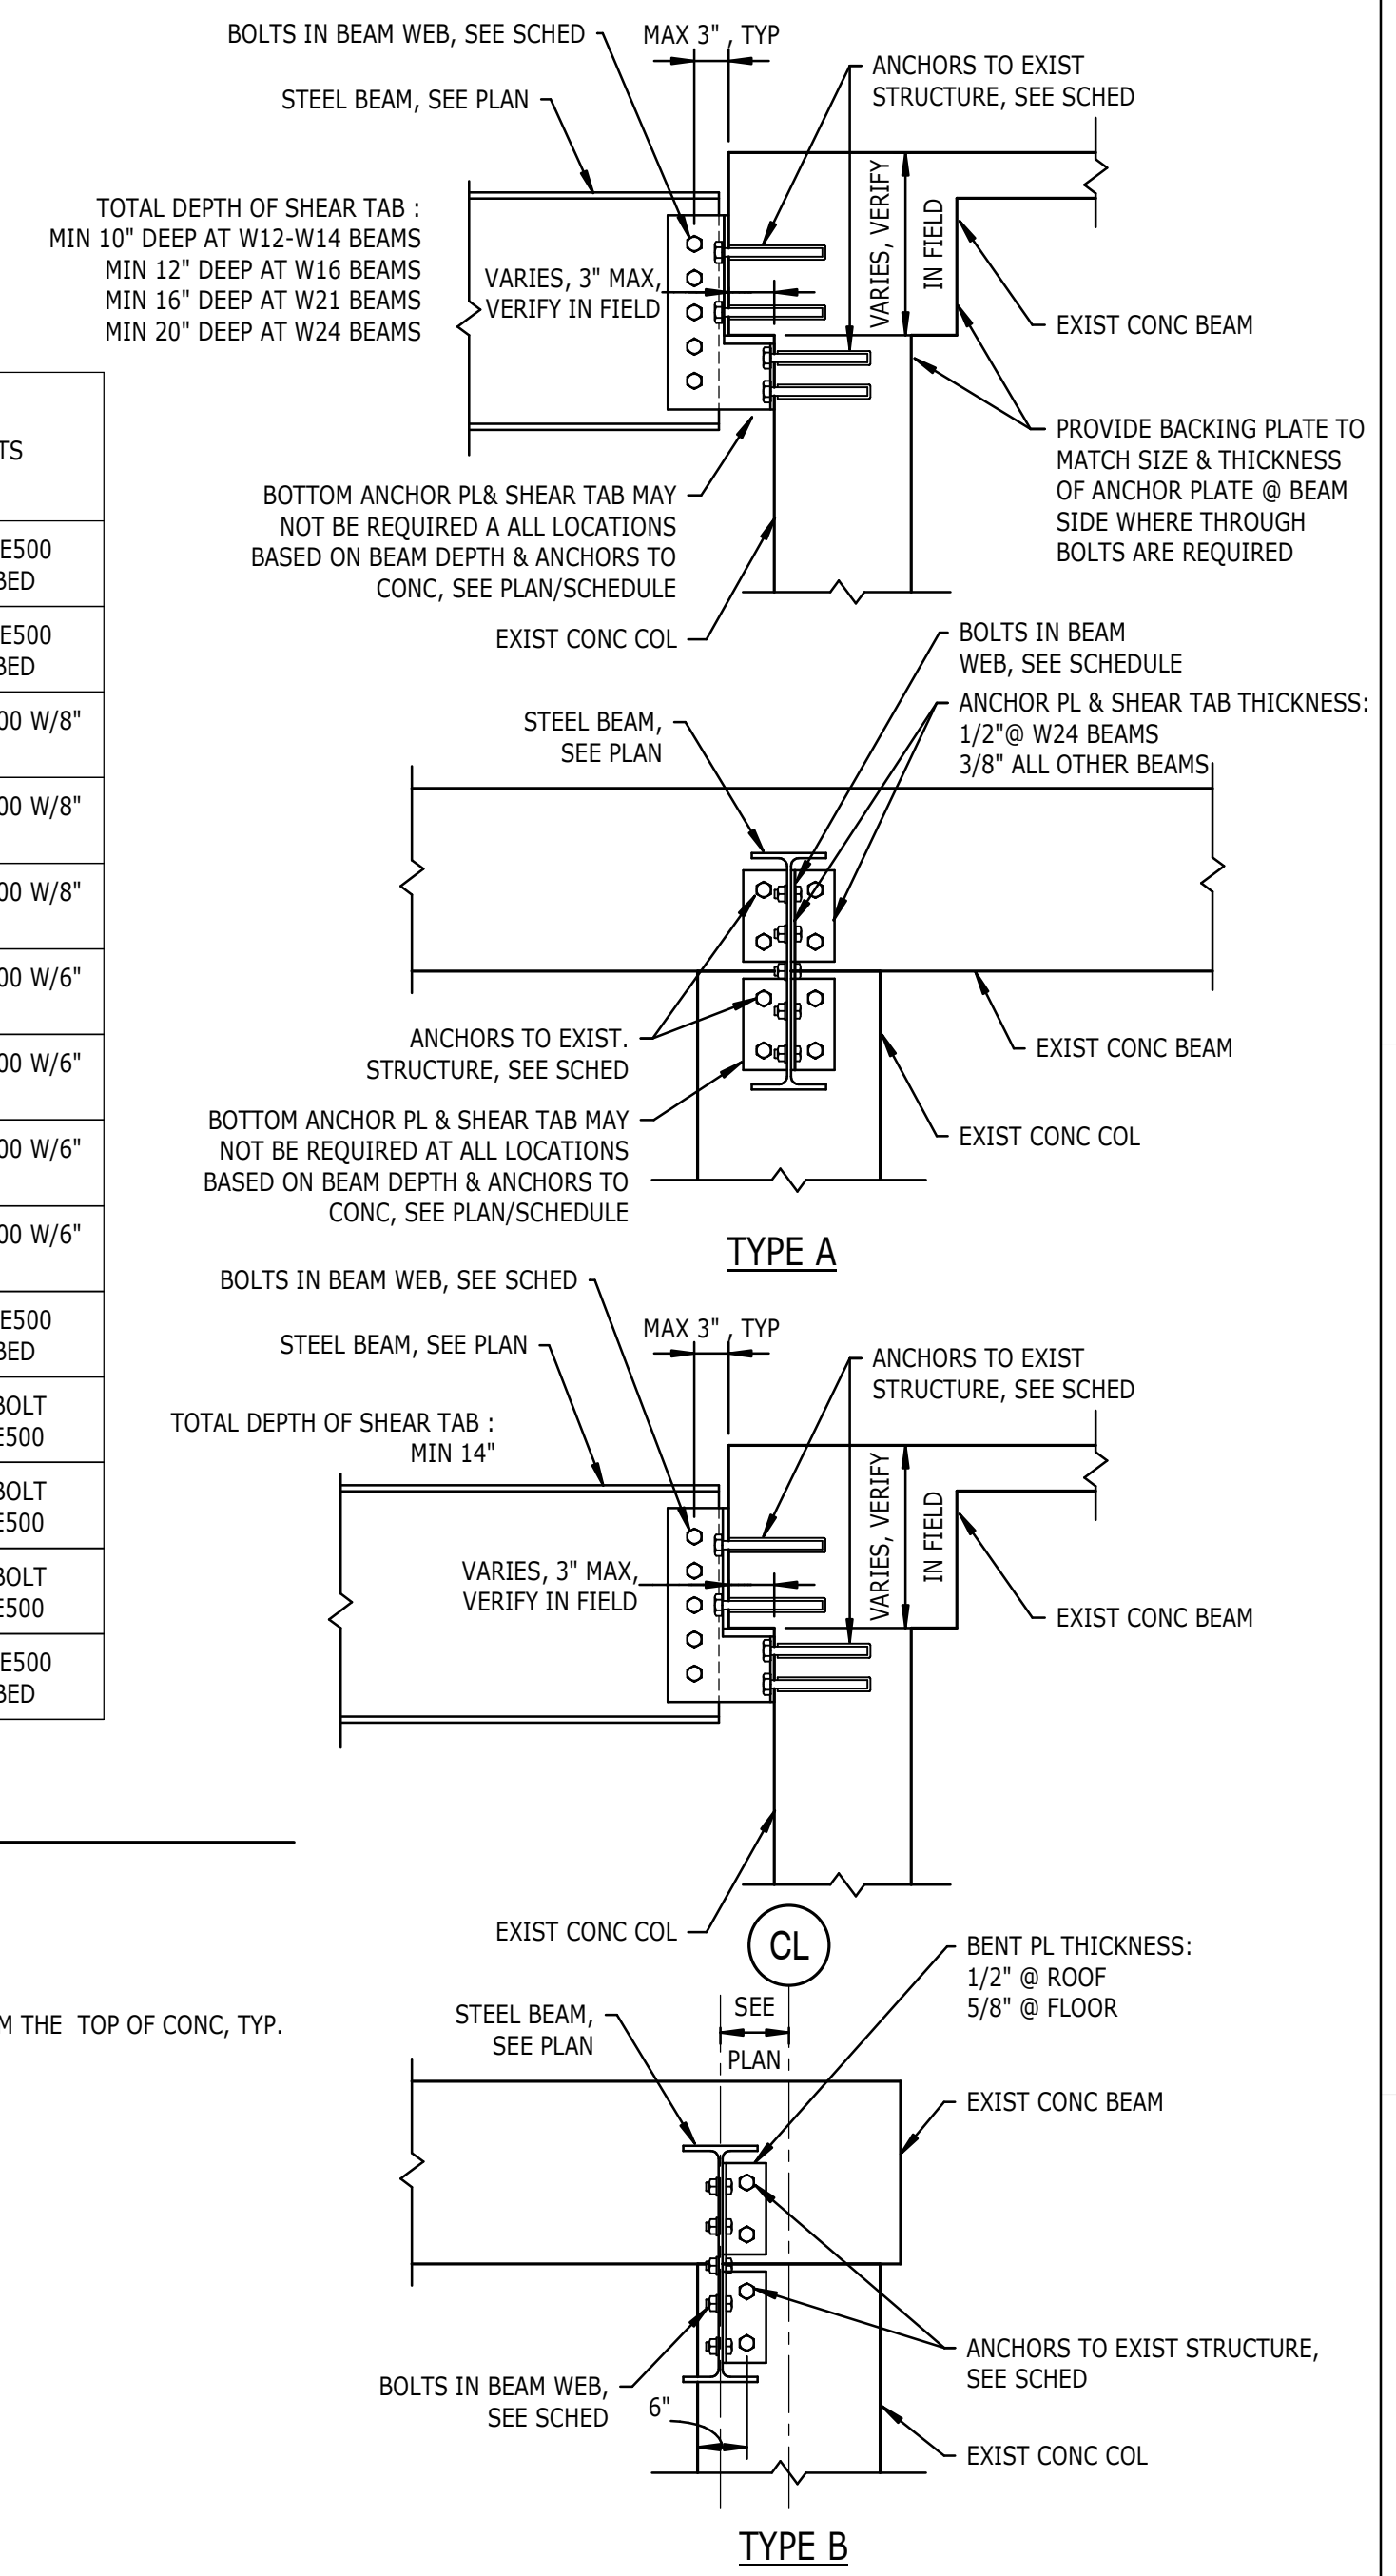


### 3 SECTION


S-513 3/4" = 1'-0"

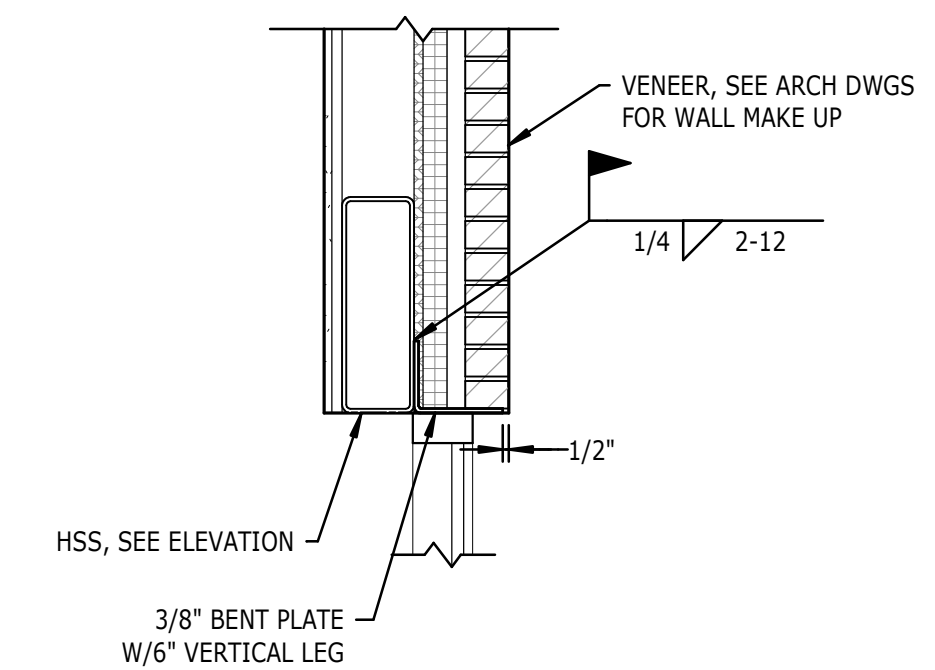

### 4 SECTION

S-513 1" = 1'-0"

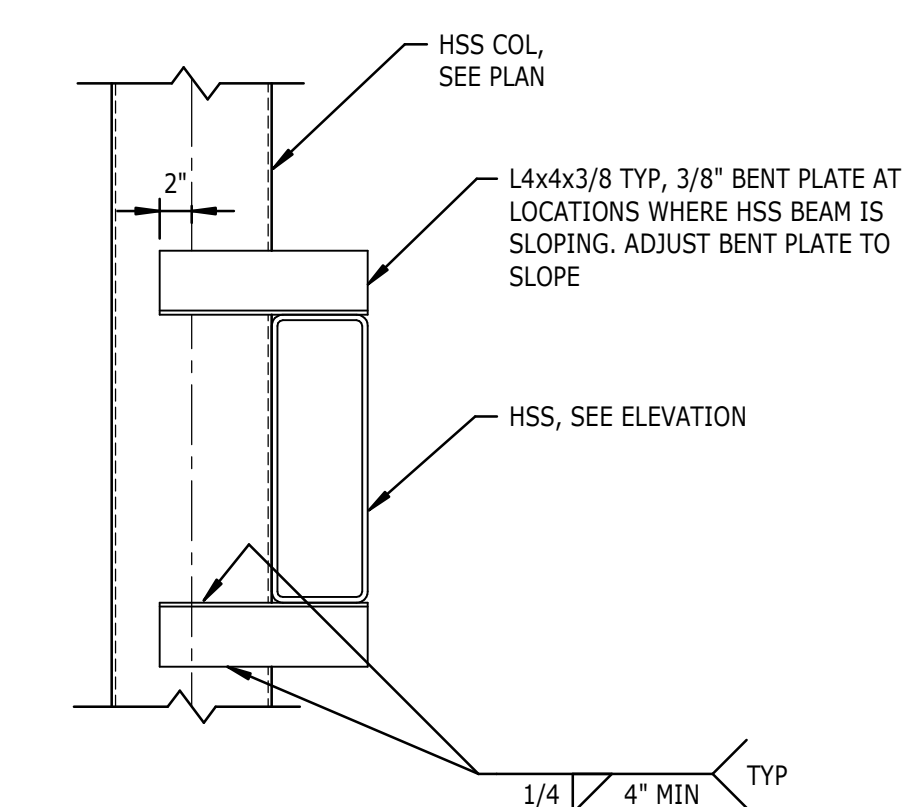

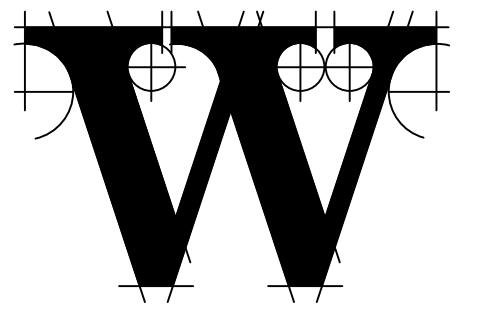

**THE WILSON GROUP**  
- ARCHITECTS -  
PO Box 5510 Charlotte, NC 28299  
704-331-9747 • www.twgarchitects.com

PROJECT MANAGER & CIVIL ENGINEER  
**TALBERT & BRIGHT**  
CONSULTING ARCHITECT  
LS3P

STRUCTURAL ENGINEER  
FIRM LICENSE #C-1051  
**STEWART**

FP/PM/E ENGINEER  
**CHEATHAM & ASSOC.**

BAGGAGE HANDLING CONSULTANTS  
**BNP**

AIRCRAFT SUPPORT SYSTEMS  
**DK CONSULTANTS**

SPECIALTY LIGHTING CONSULTANT  
**HARTANFT**

SINGAGE & WAYFINDING  
**TAKEFORM**

COPYRIGHT © 2019  
THE WILSON GROUP ARCHITECTS  
ALL RIGHTS RESERVED

PRINTED OR ELECTRONIC DRAWINGS AND DOCUMENTATION MAY NOT BE REPRODUCED IN ANY FORM WITHOUT WRITTEN PERMISSION FROM THE WILSON GROUP ARCHITECTS


REVISIONS

1	7/12/19	AD-01
3	7/30/19	AD-03

DATE 06/28/2019  
PROJECT NUMBER 9202-000  
SHEET TITLE


**STRUCTURAL ROOF SECTIONS**

SHEET NUMBER  
**S-521**

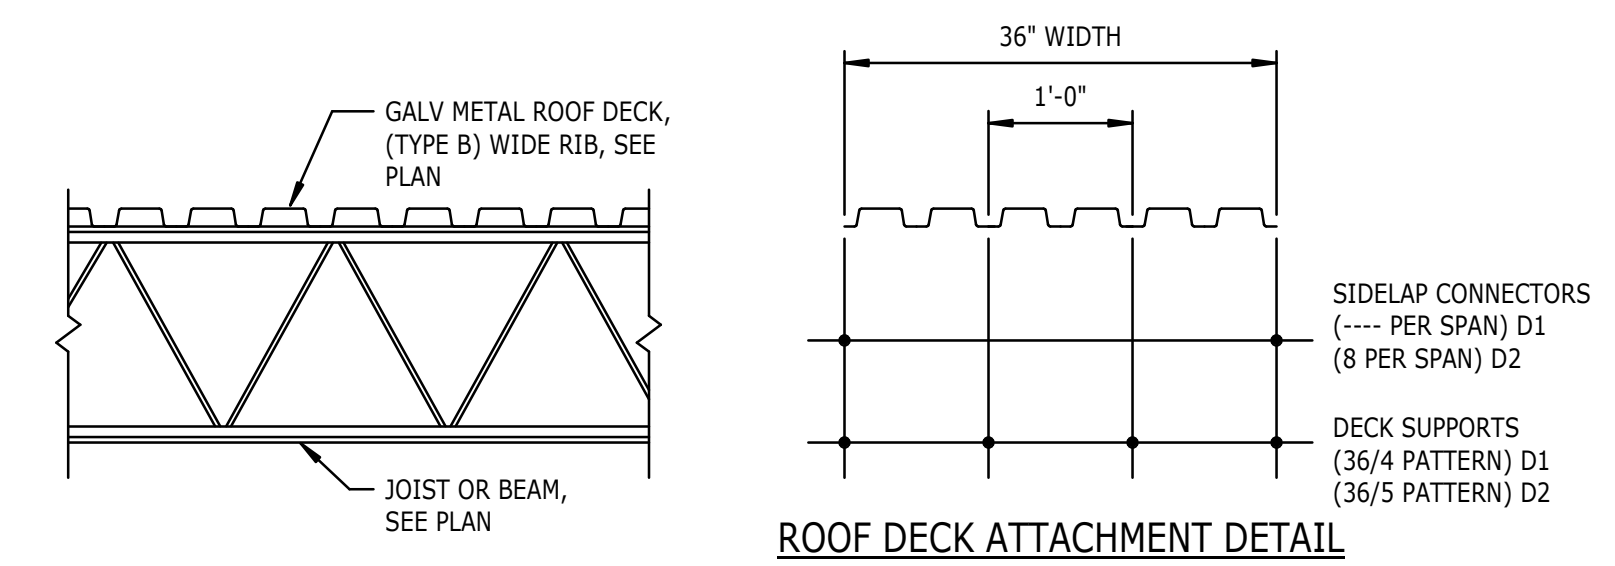


- NOTES:**
- ATTACH DECK TO SUPPORTING MEMBERS WITH 5/8" DIA PUDDLE WELDS. USE #10-16 FOR SIDELAP ATTACHMENT.
  - AT DECK BEARING SUPPORTS, PROVIDE 5/8" DIA PUDDLE WELDS AT SPECIFIED ATTACHMENT PATTERN.
  - AT SUPPORTS PARALLEL TO DECK SPAN, PROVIDE 5/8" DIA PUDDLE WELDS AT SPECIFIED ATTACHMENT PATTERN.
  - AT DECK SIDELAPS/PERIMETER EDGE, PROVIDE SCREWS AT SPECIFIED ATTACHMENT PATTERN, TYPICAL. WELDING OF SIDELAPS IS NOT PERMITTED FOR 22GA DECK.
  - MINIMUM DECK PROPERTIES: 1 1/2" x 22 GAGE; tp=0.155 in/ft; Sp=0.186 in/ft; In=0.183 in/ft; Sn=0.192 in/ft; Fy=23 ksi.
  - DECK SHALL BE CONTINUOUS OVER (2) OR MORE SPANS, TYPICAL.
  - SIDELAP FASTENING MUST BE SCREWED AS DESCRIBED ABOVE.
  - CONTRACTOR OPTION TO SUBMIT MECHANICAL FASTENERS BY HILTI, SIMPSON STRONG-TIE, OR APPROVED EQUAL. SUBSTITUTION REQUESTS FOR PRODUCTS MAY BE SUBMITTED BY THE CONTRACTOR TO THE ENGINEER-OF-RECORD (EOR) FOR REVIEW. SUBSTITUTIONS WILL ONLY BE CONSIDERED FOR PRODUCTS THAT MEET THE CODE REQUIREMENTS FOR DECK ATTACHMENT, POSSESS A FM GLOBAL APPROVAL AND POSSESS A CODE REPORT (ICC-ES) RECOGNIZING THE PRODUCT FOR THE APPROPRIATE APPLICATION. SUBSTITUTION REQUESTS SHALL INCLUDE CALCULATIONS THAT DEMONSTRATE THE SUBSTITUTED PRODUCT IS CAPABLE OF ACHIEVING THE EQUIVALENT PERFORMANCE VALUES OF THE DESIGN BASIS PRODUCT. CONTRACTOR SHALL CONTACT MANUFACTURER'S REPRESENTATIVE FOR PRODUCT INSTALLATION TRAINING AND A LETTER SHALL BE SUBMITTED TO THE EOR INDICATING TRAINING HAS TAKEN PLACE. FASTENERS SHALL BE COLLATED AND INSTALLED USING THE MANUFACTURER'S DELIVERY TOOL AND FOLLOWING MANUFACTURER'S INSTRUCTIONS.


**1 DETAIL**  
S-521 TYPICAL ROOF CONSTRUCTION, 1 1/2" METAL ROOF DECK  
NTS

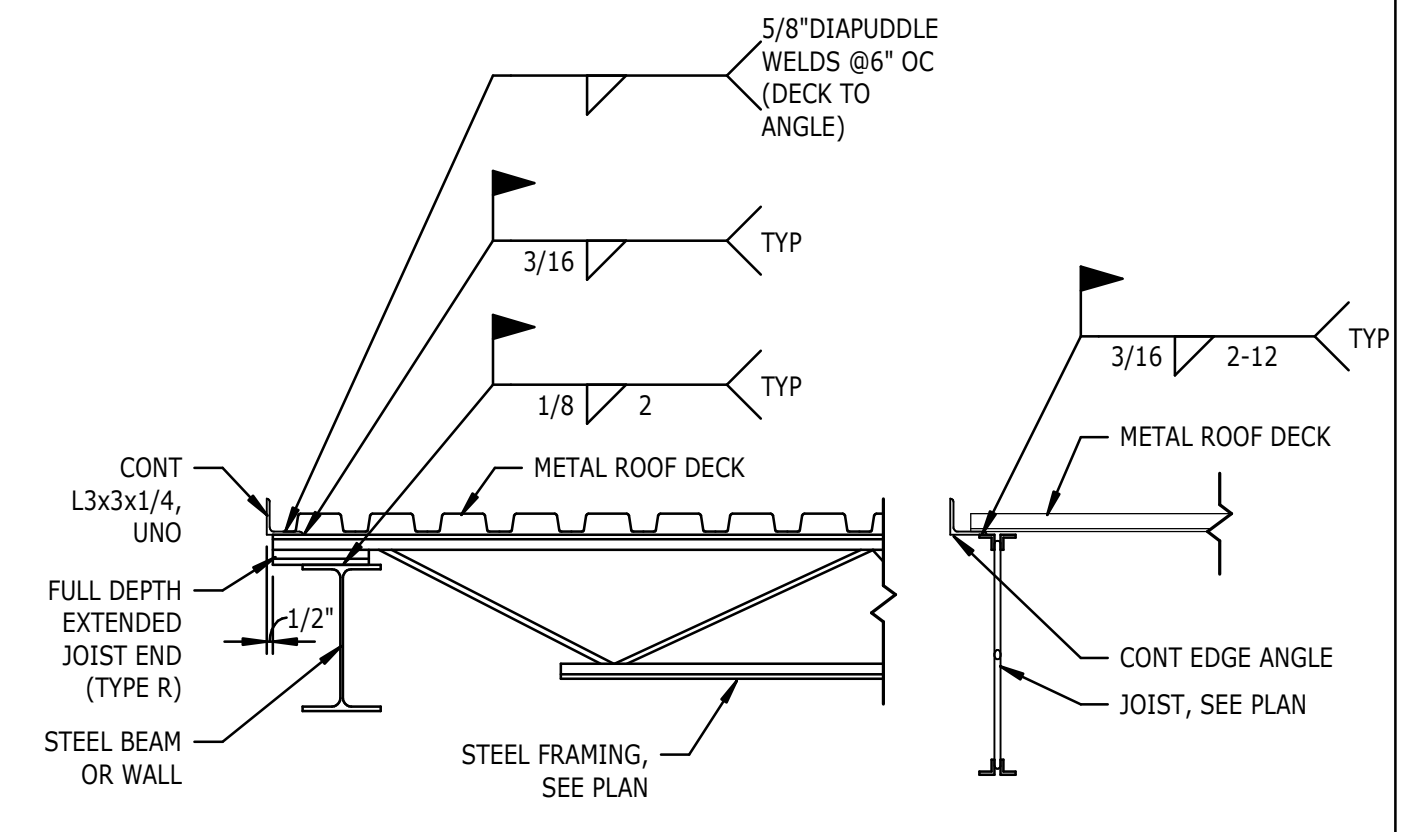


**4 SECTION**  
S-521 TYPICAL EDGE DETAIL AT ROOF  
NTS  
NOTES:  
1. SEE OTHER DETAILS FOR INFORMATION NOT SHOWN.

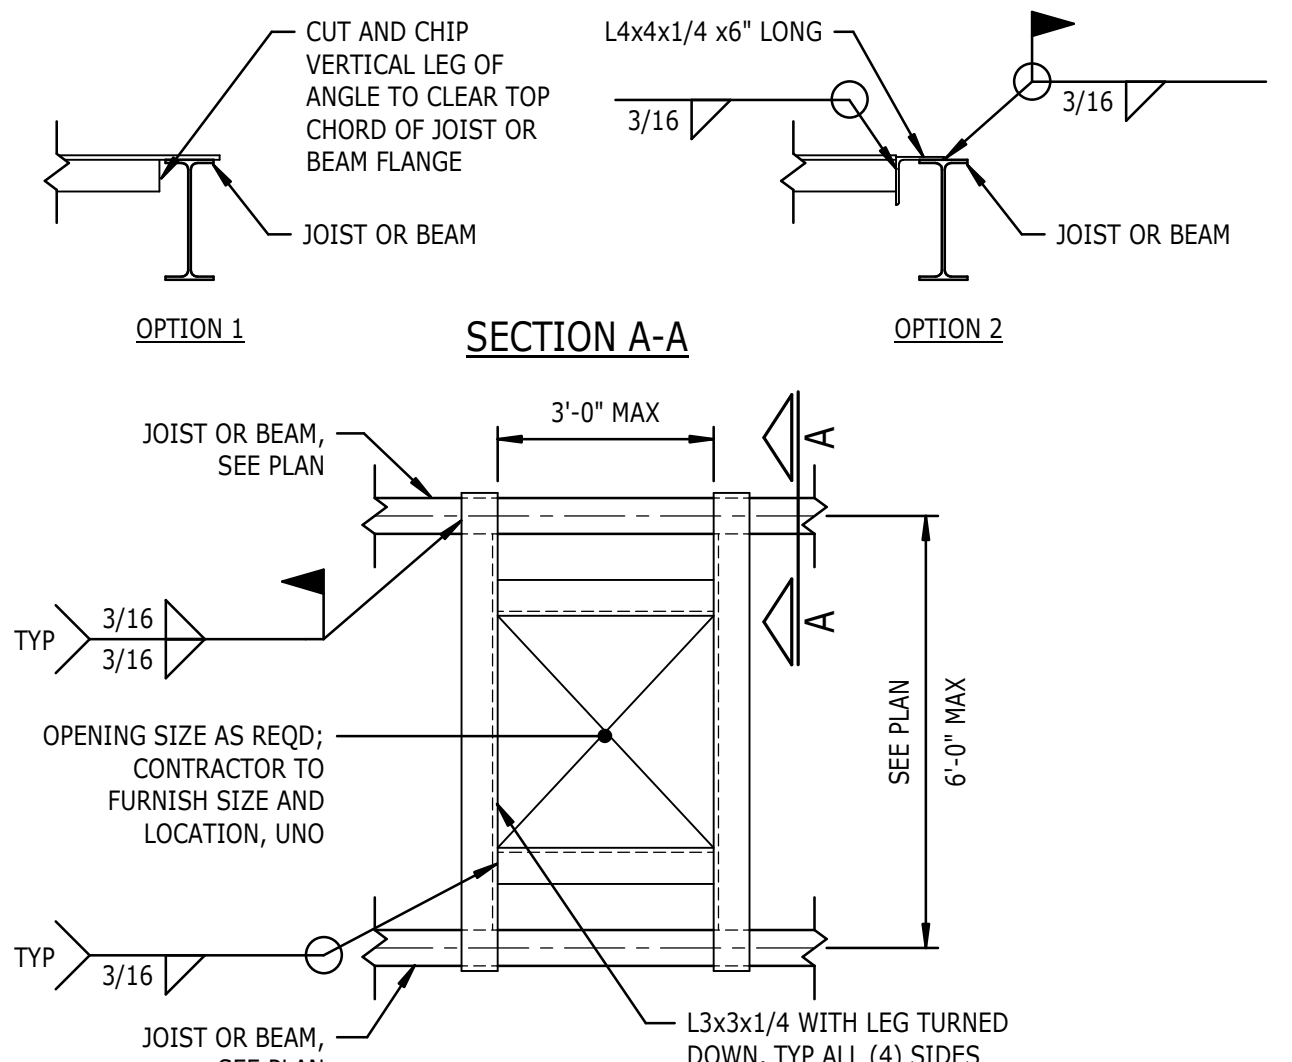


**2 DETAIL**  
S-521 TYPICAL FRAMING AROUND ROOF OPENINGS, 1 1/2" METAL ROOF DECK  
NTS  
NOTES:  
1. PROVIDE ANGLE FRAMING AROUND ALL OPENINGS LARGER THAN 10"x10" (10"0).

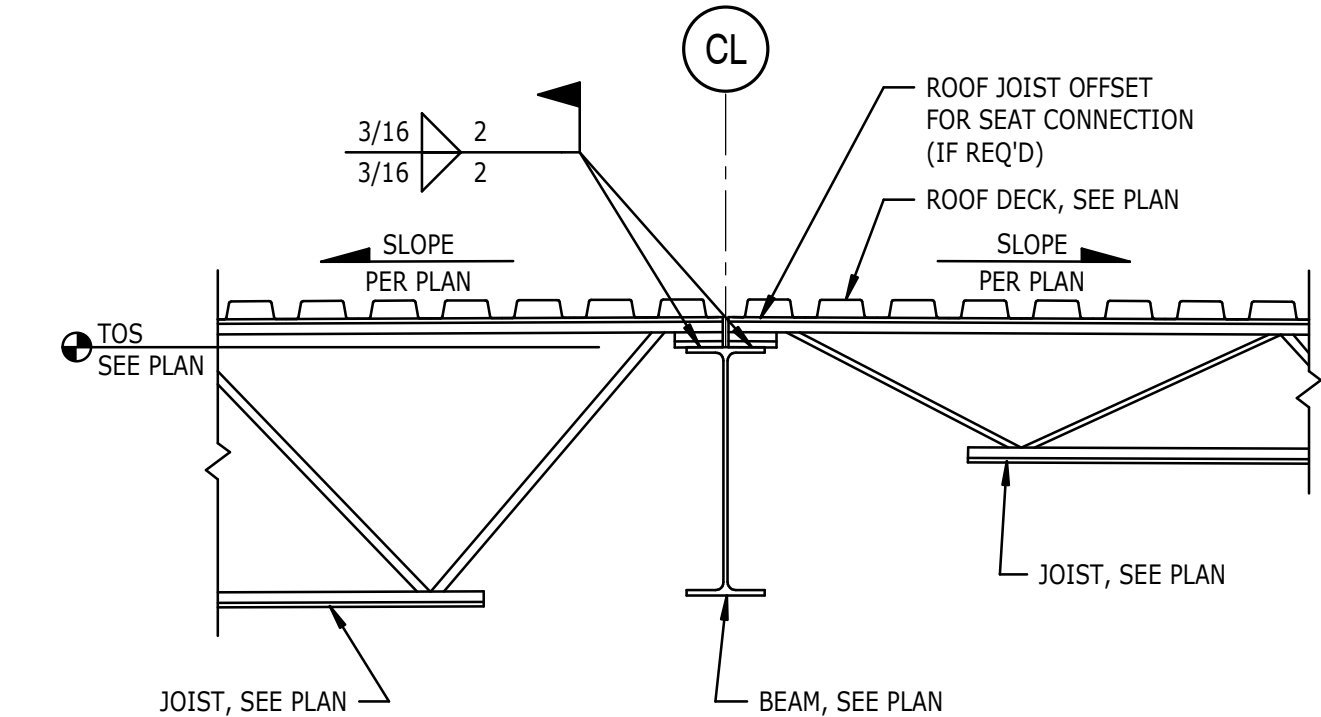


**6 SECTION**  
S-521 JOIST BEARING AT RIDGE  
NTS

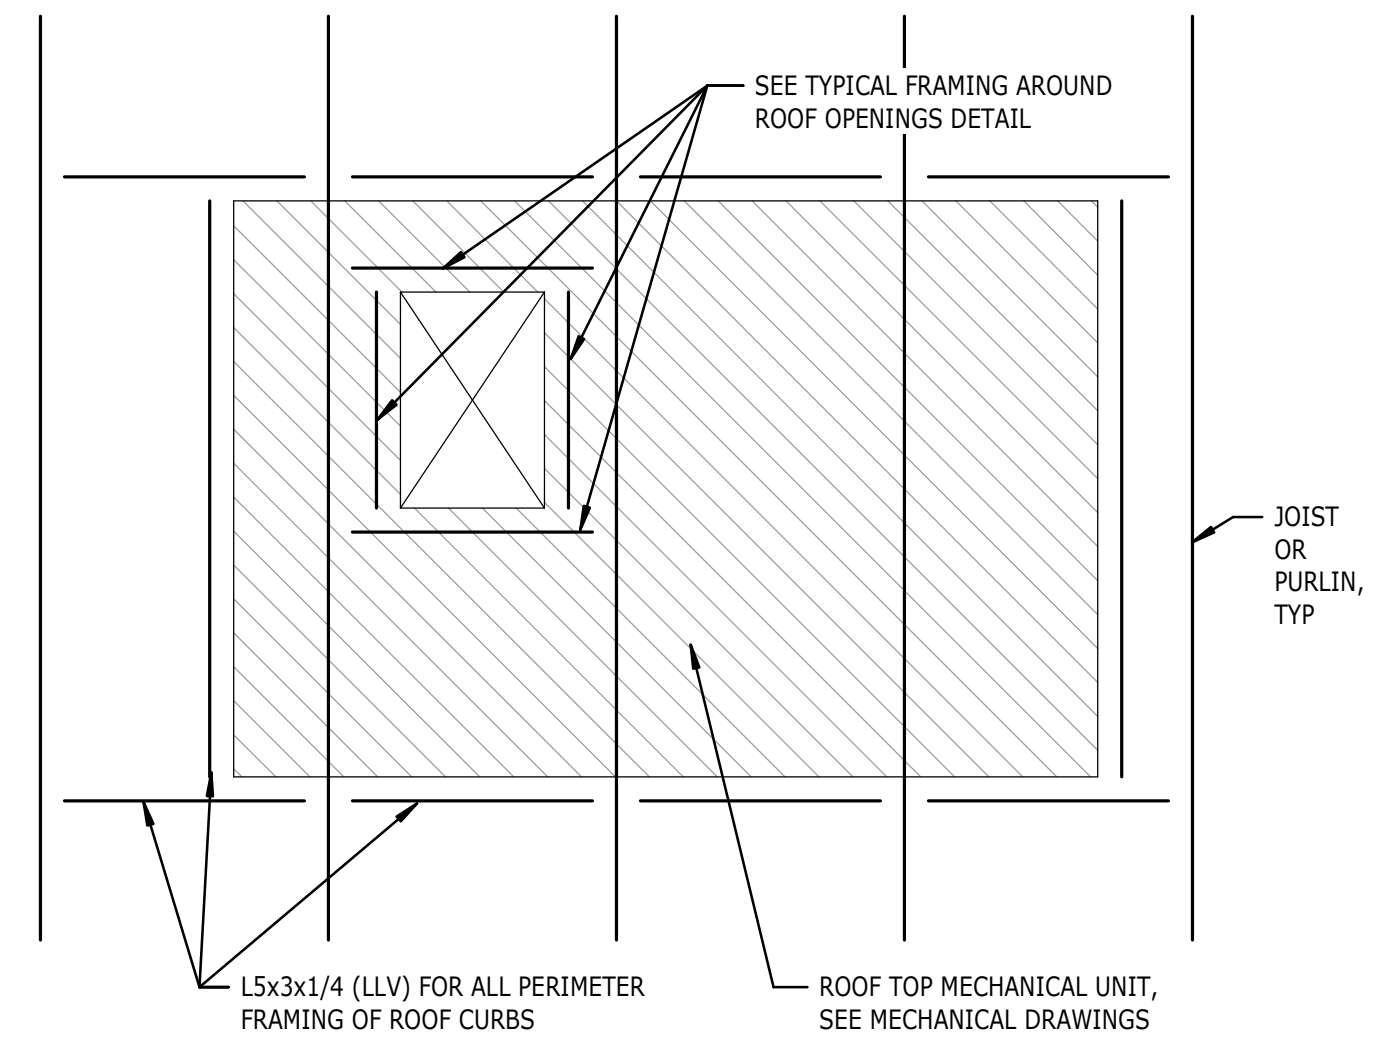


**5 DETAIL**  
S-521 TYPICAL ROOF TOP MECHANICAL UNIT FRAMING  
NTS  
NOTES:  
1. ALL MEMBERS NOT SIZED ON FRAMING PLAN SHALL BE L5x3x1/4.

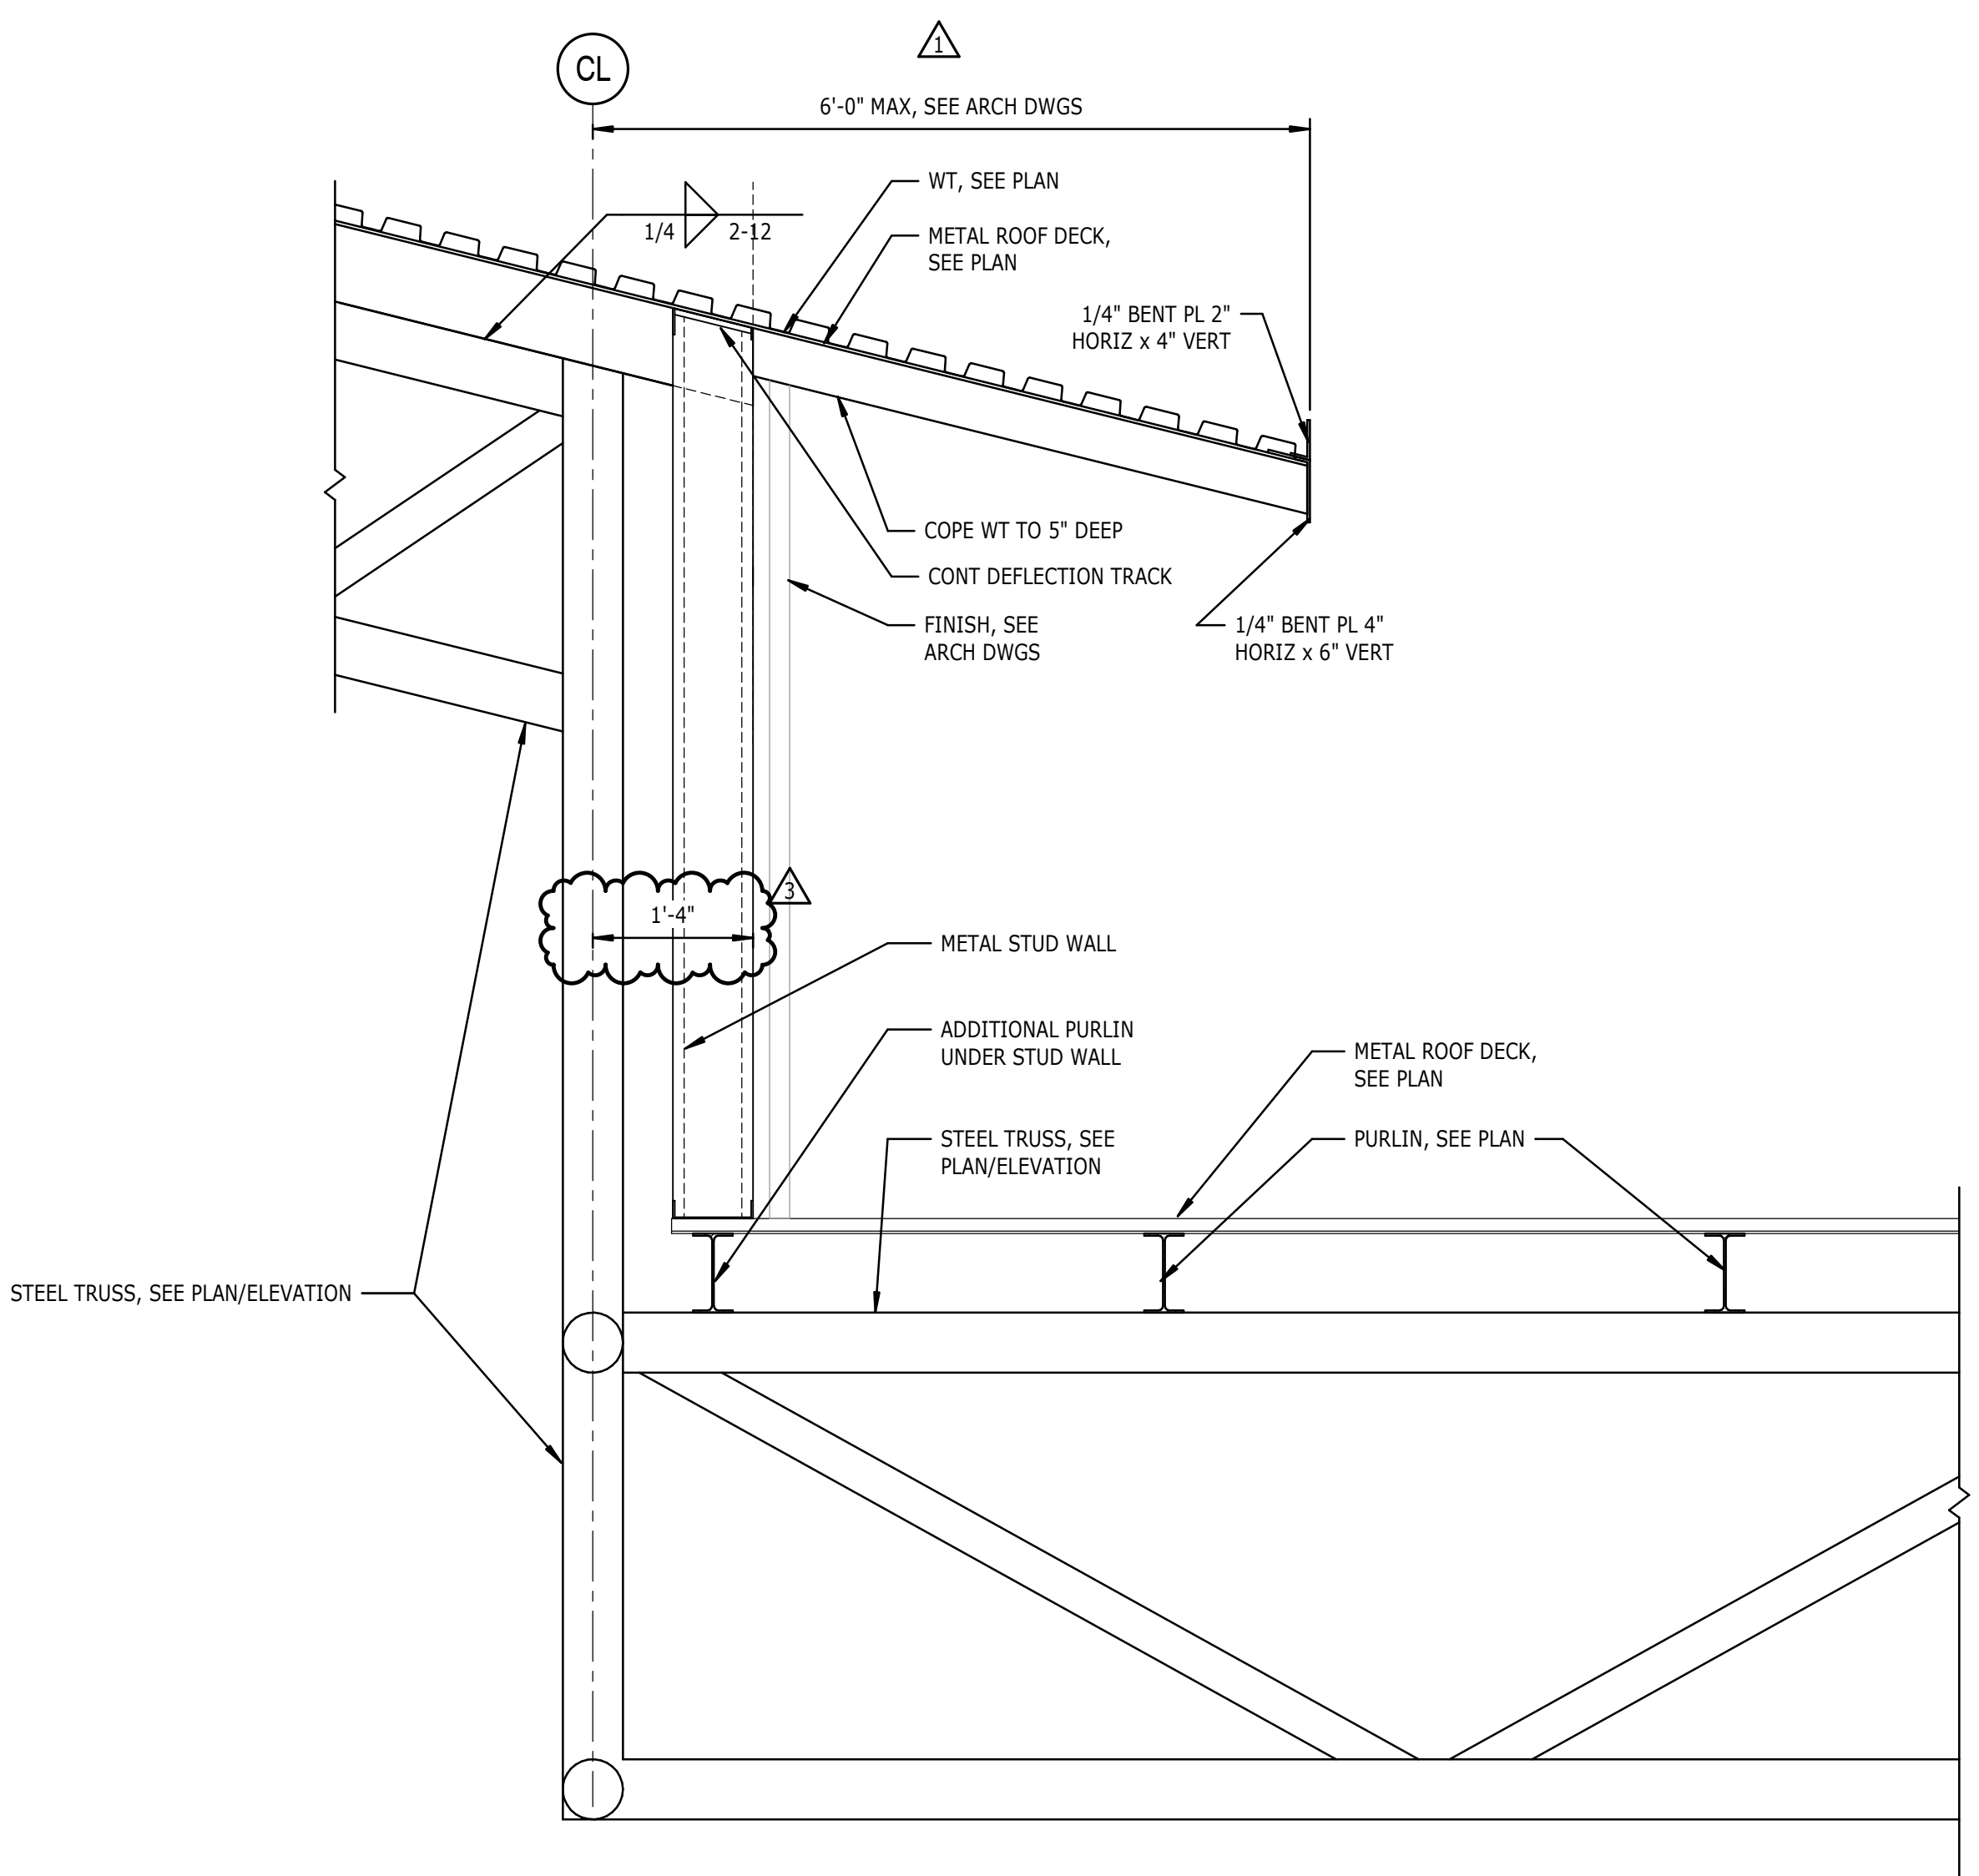


**9 SECTION**  
S-521 3/4" = 1'-0"

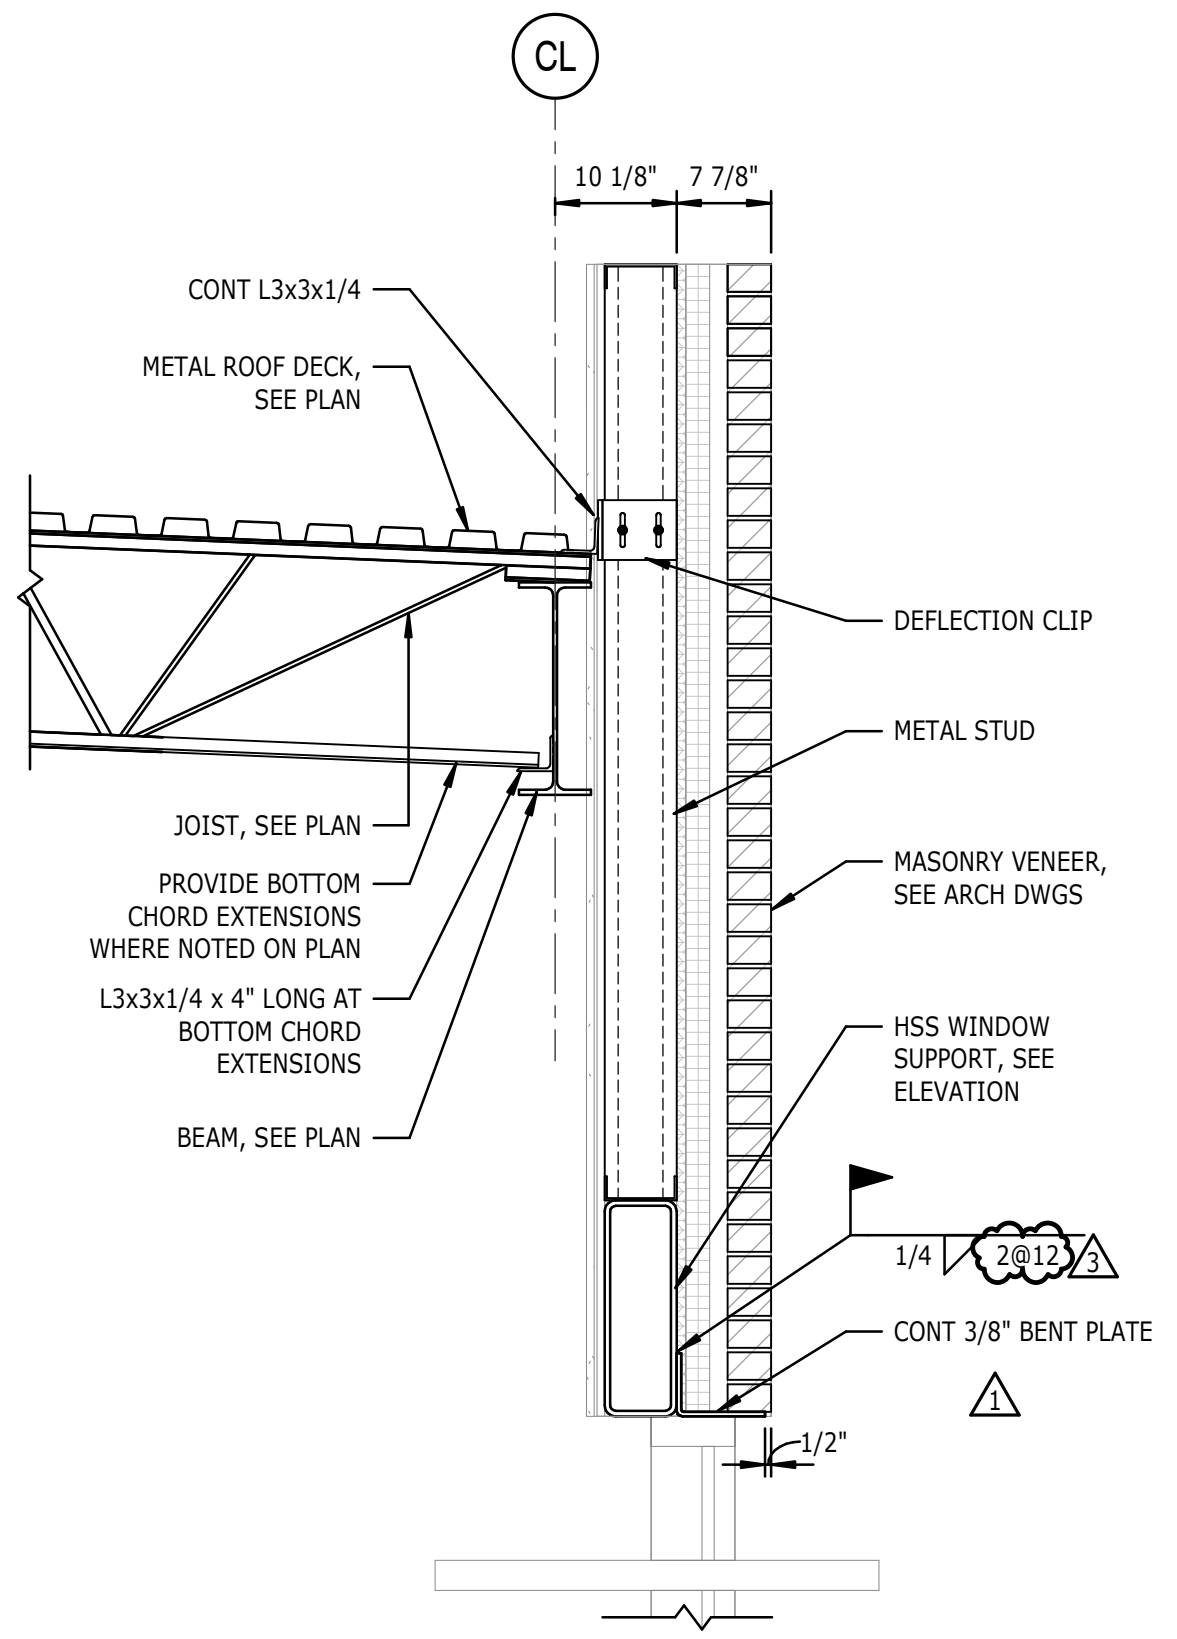


**17 SECTION**  
S-521 3/4" = 1'-0"

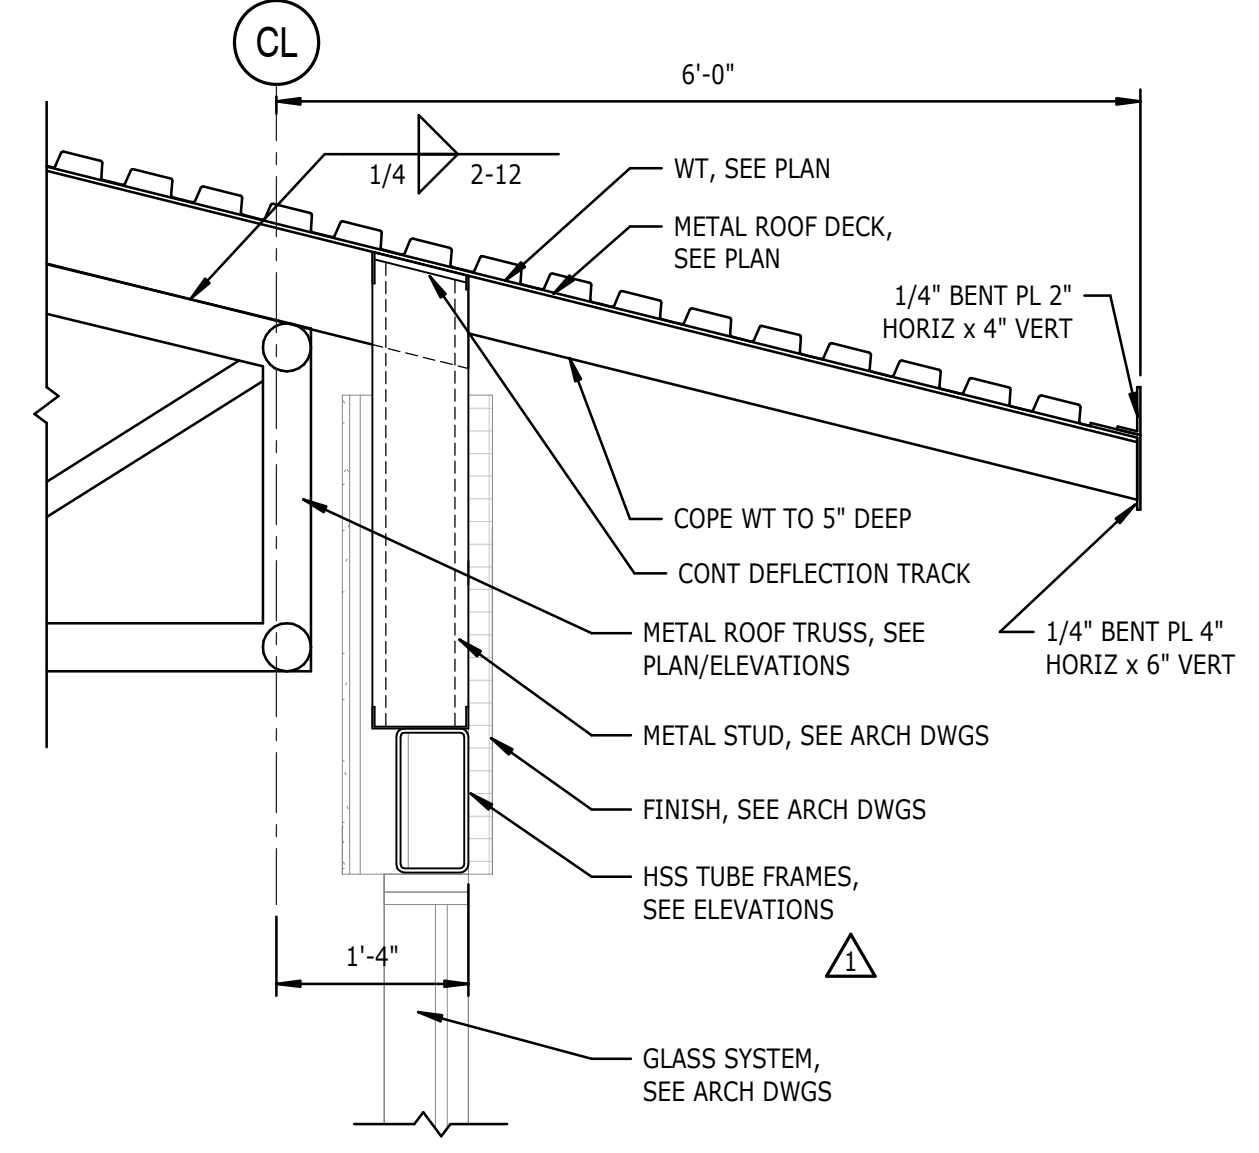


**19 SECTION**  
S-521 3/4" = 1'-0"

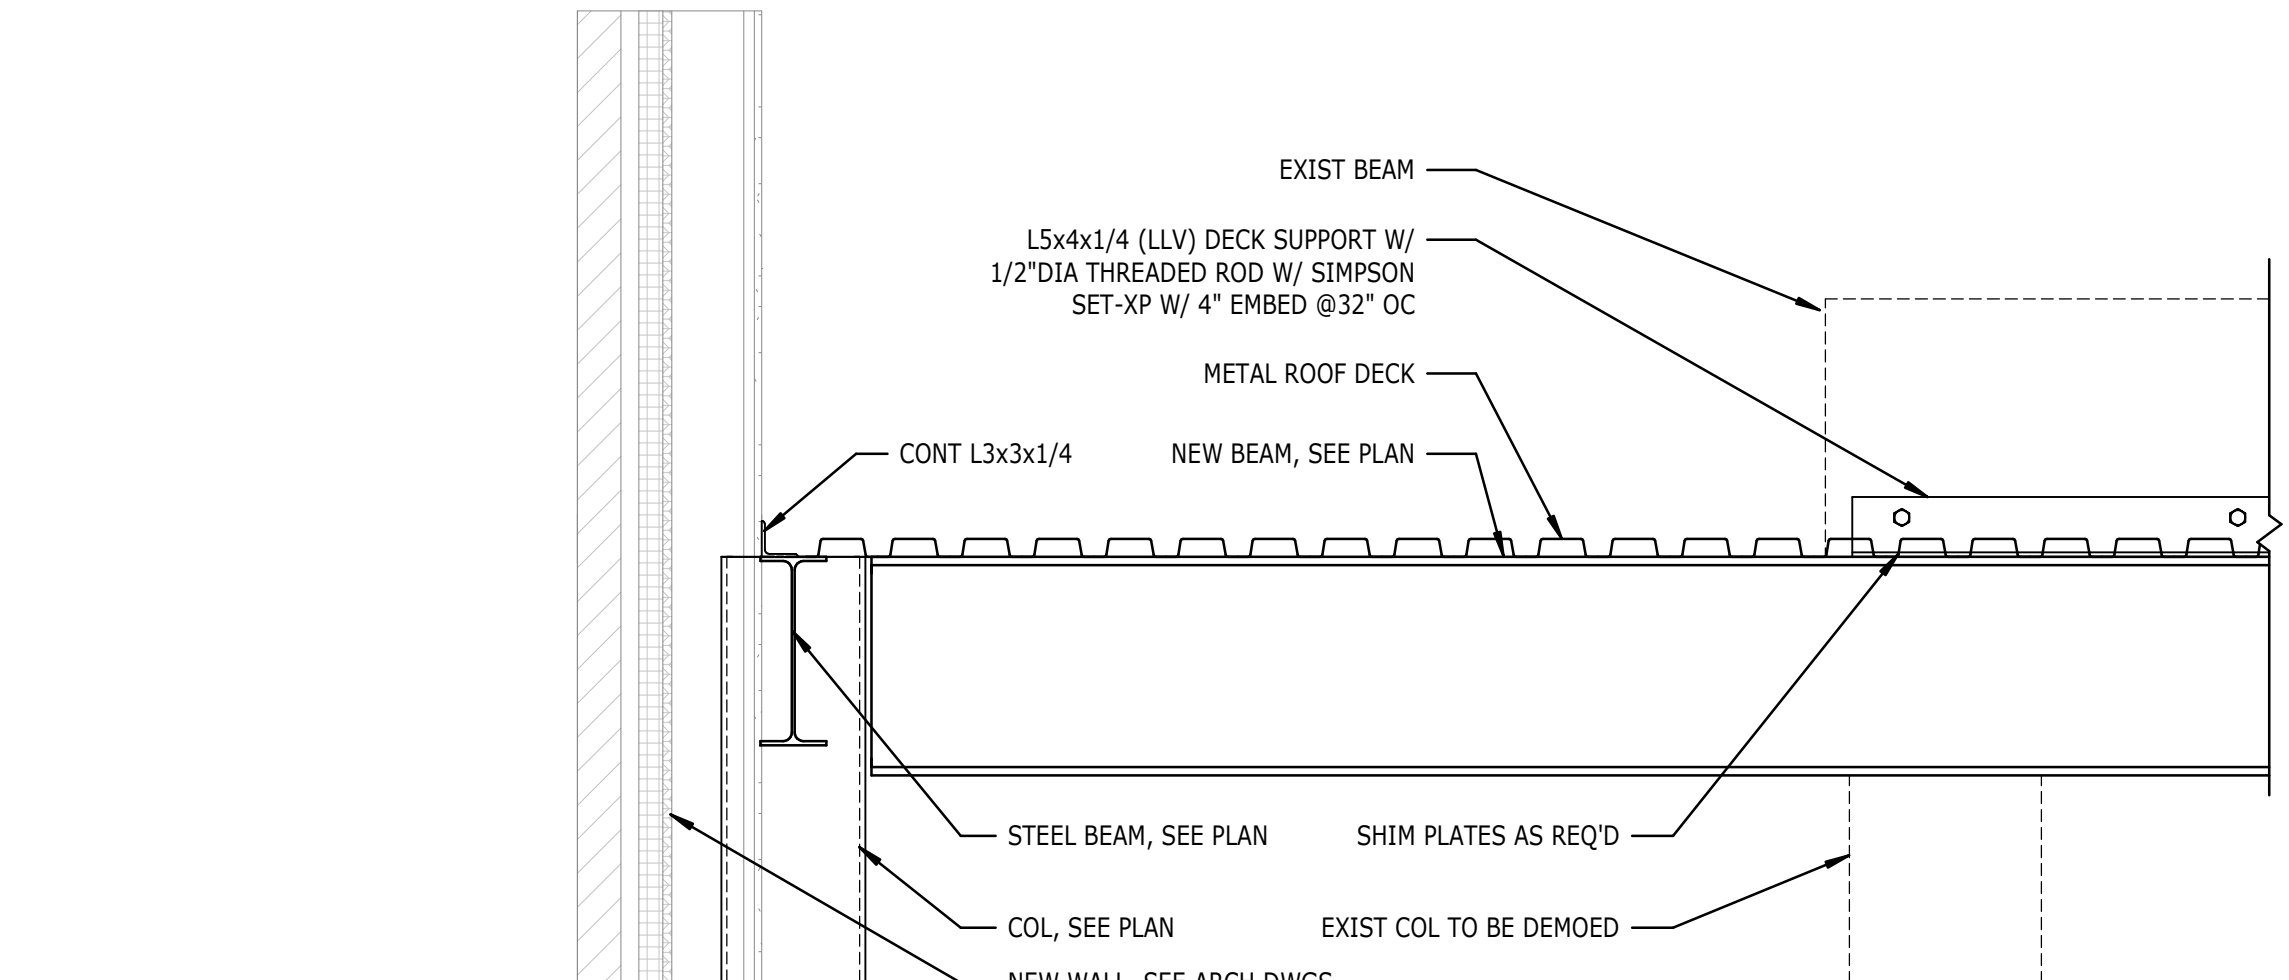


**11 SECTION**  
S-521 3/4" = 1'-0"

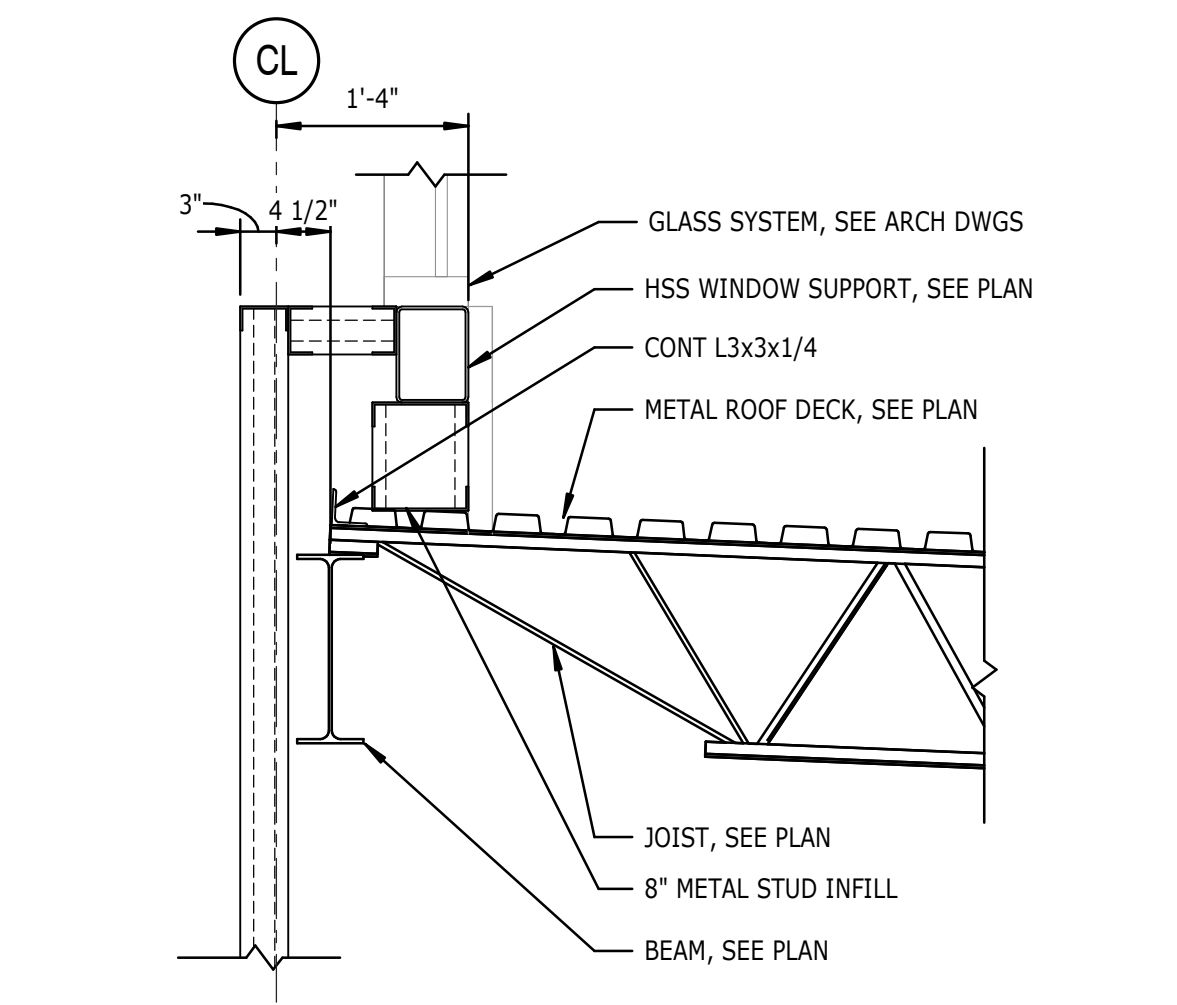


**20 SECTION**  
S-521 3/4" = 1'-0"

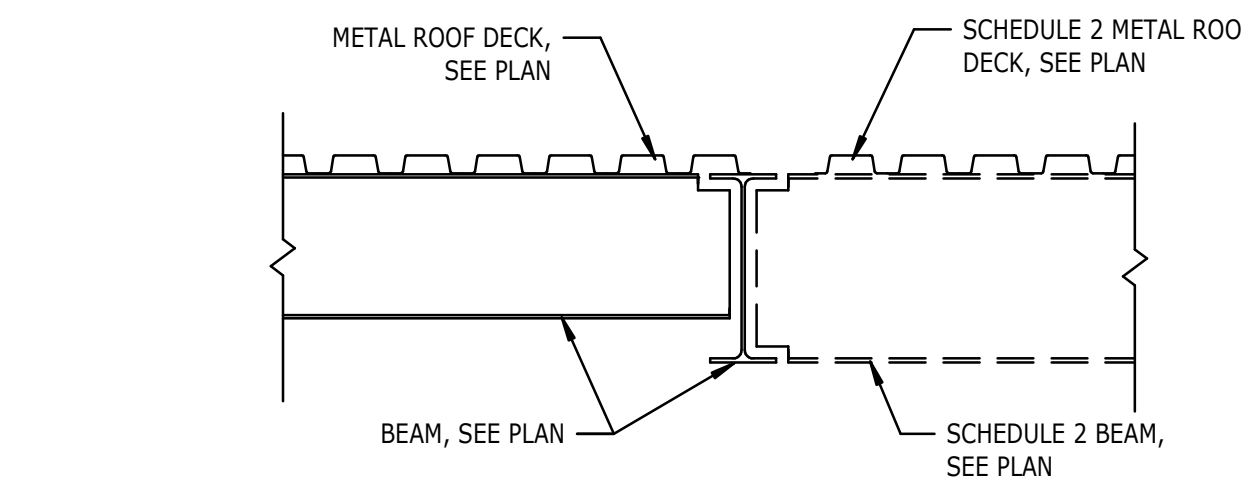


**16 SECTION**  
S-521 3/4" = 1'-0"

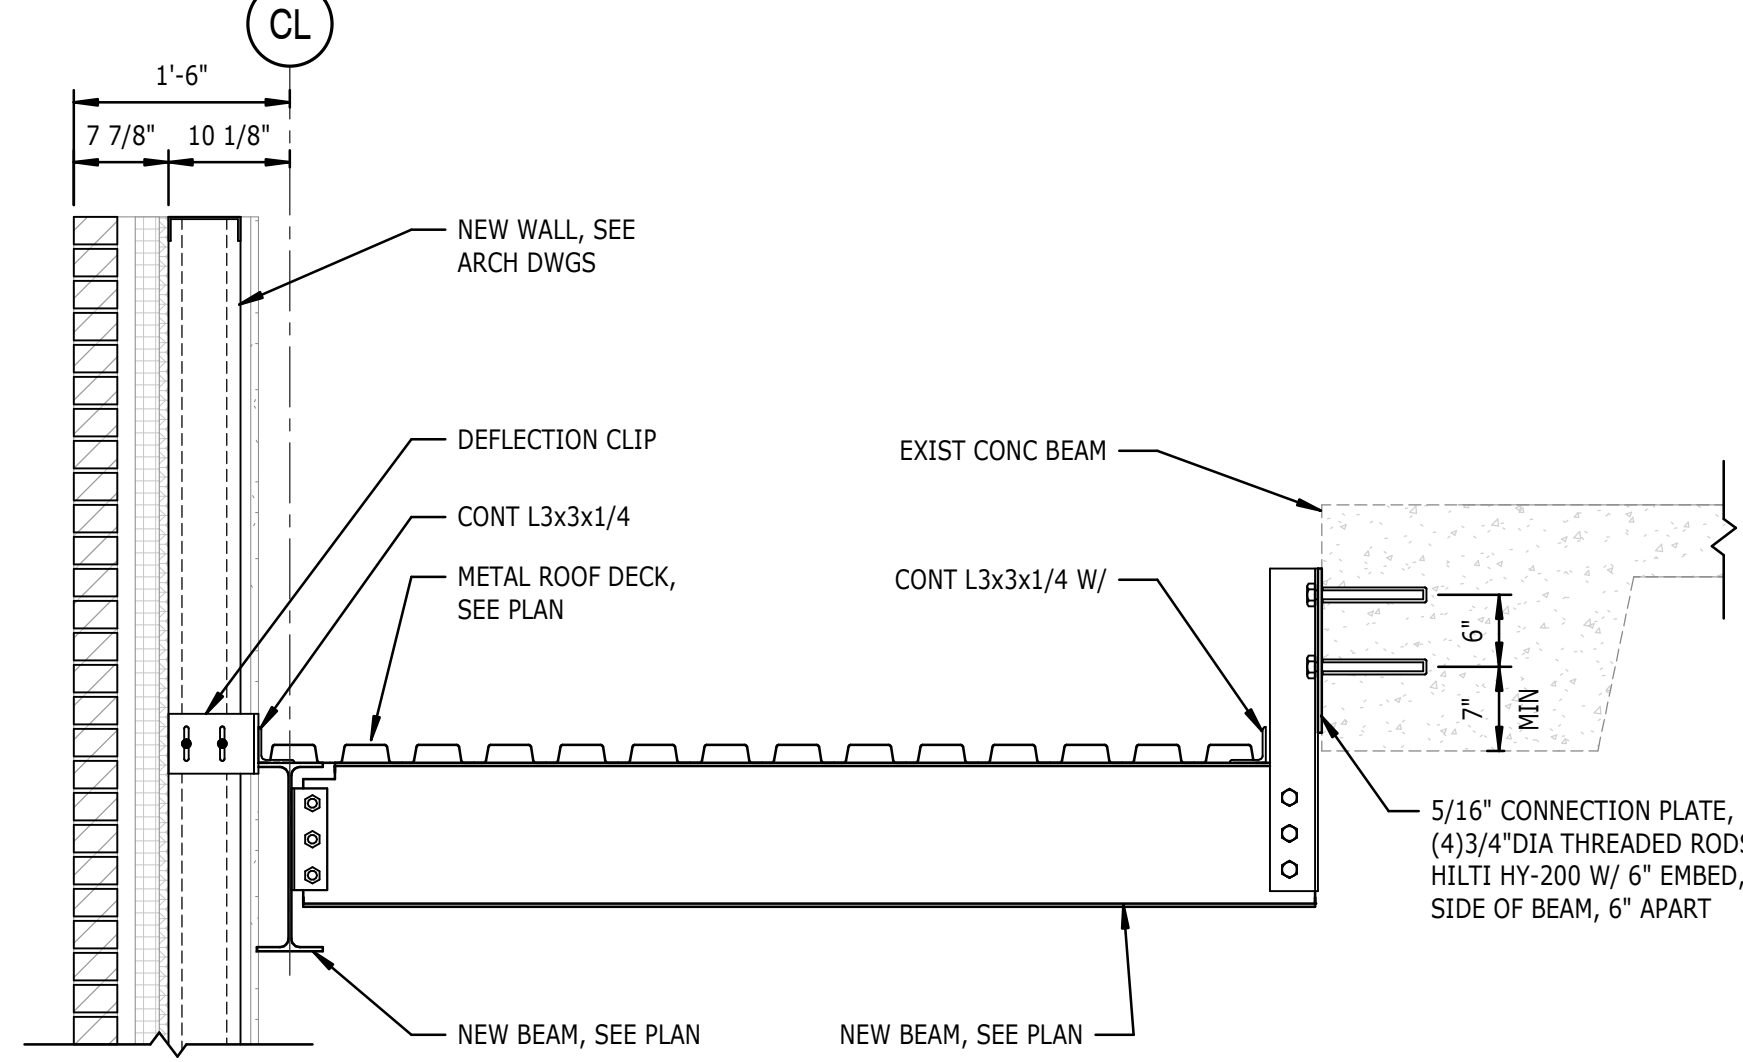


**8 SECTION**  
S-521 3/4" = 1'-0"

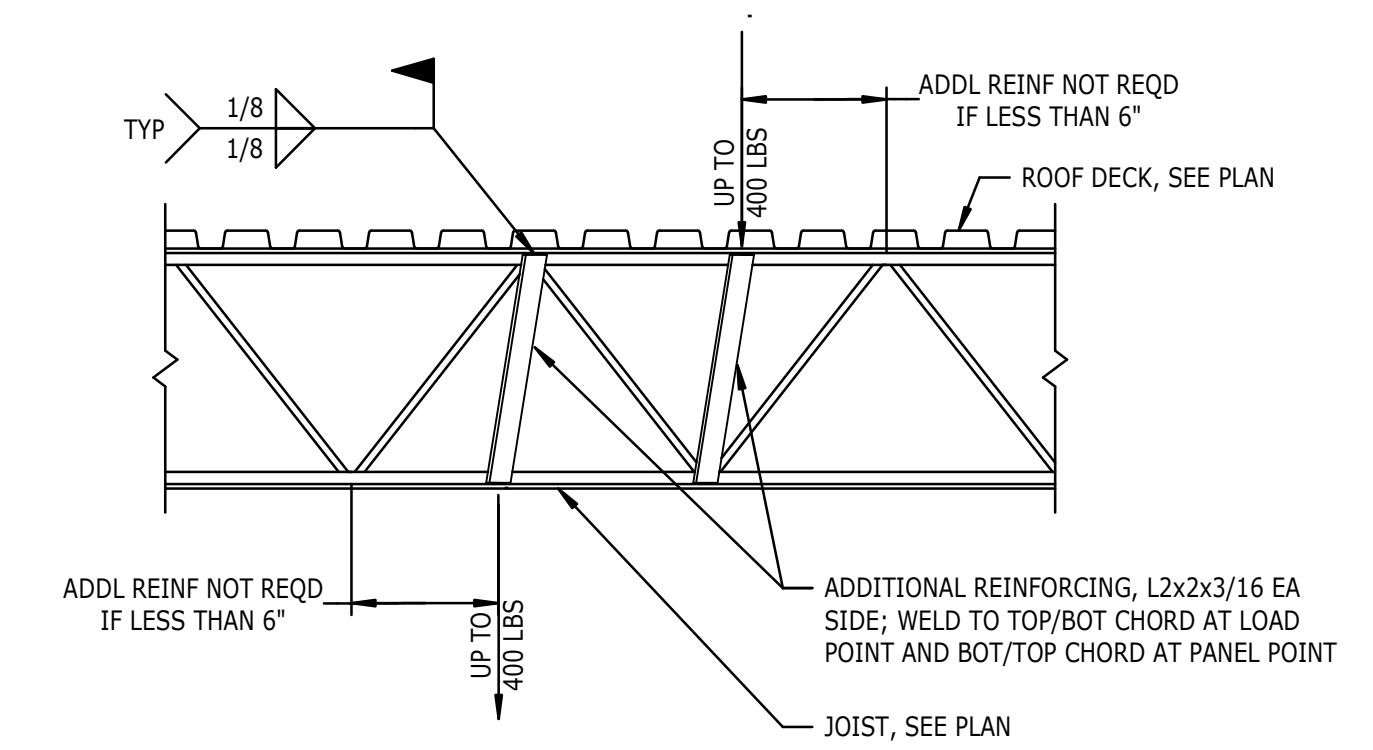


**3 DETAIL**  
S-521 TYPICAL REINFORCING FOR CONCENTRATED LOADS ON STEEL JOISTS  
NTS  
NOTES:  
1. WHERE POSSIBLE, ALL LOADS ARE TO BE SUPPORTED FROM PANEL POINTS. WHERE NOT POSSIBLE, PROVIDE REINFORCEMENT AS DETAILED.  
2. LOADS LESS THAN 100 LBS REQUIRE NO ADDITIONAL REINFORCING. LOADS LARGER THAN 400 LBS PER JOIST REQUIRE SPECIAL SUPPORT CONDITIONS TO BE APPROVED BY THE ENGINEER OF RECORD.  
3. BOTTOM CHORDS EXTENDING UNSUPPORTED PAST THE FIRST BOTTOM PANEL POINT TOWARD JOIST BEARING LOCATION ARE NOT TO BE USED TO SUPPORT ANY LOAD WITHOUT WRITTEN PERMISSION FROM THE ENGINEER OF RECORD.

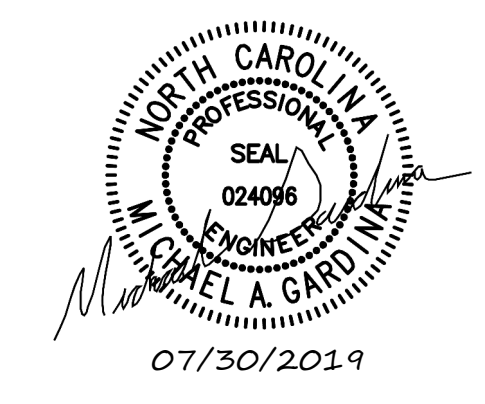


**17 SECTION**  
S-522 BOTTOM FLANGE BRACING DETAIL  
NTS

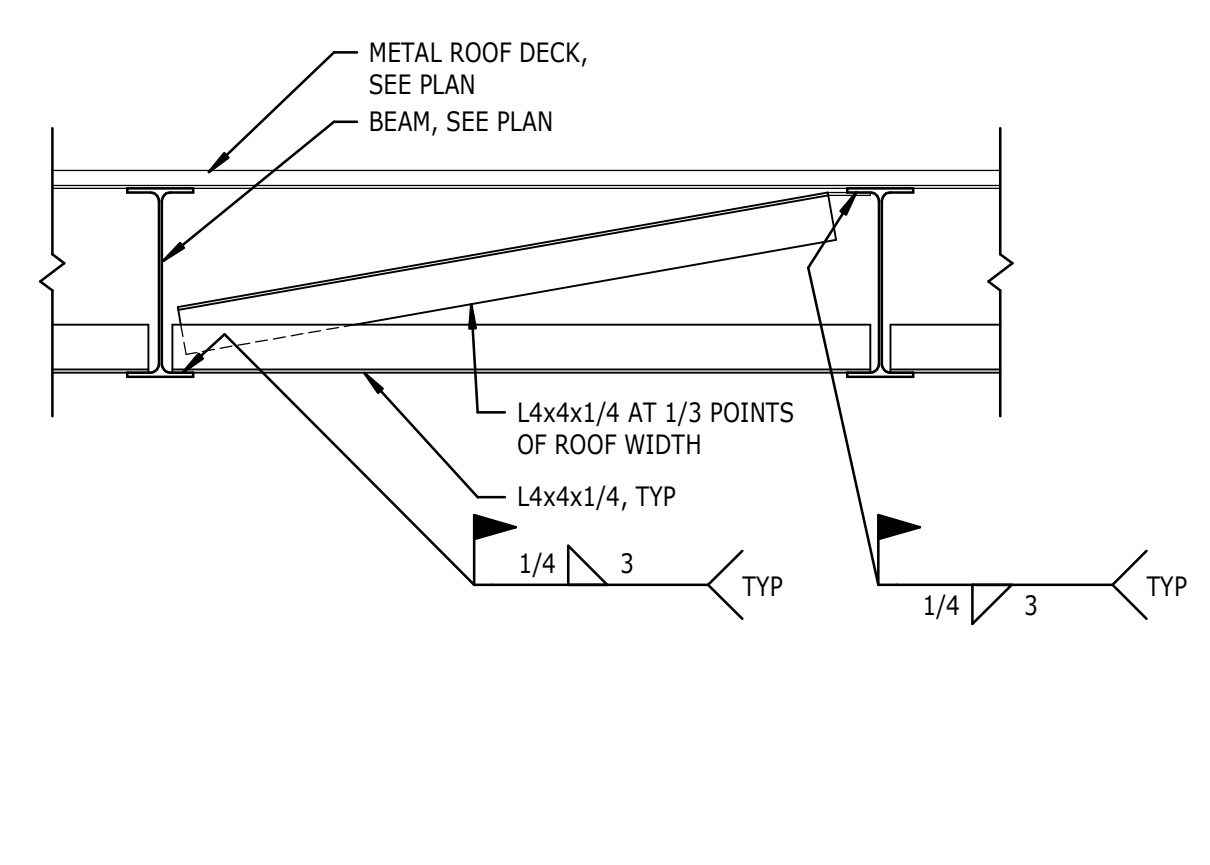


**9 SECTION**  
S-522 3/4" = 1'-0"

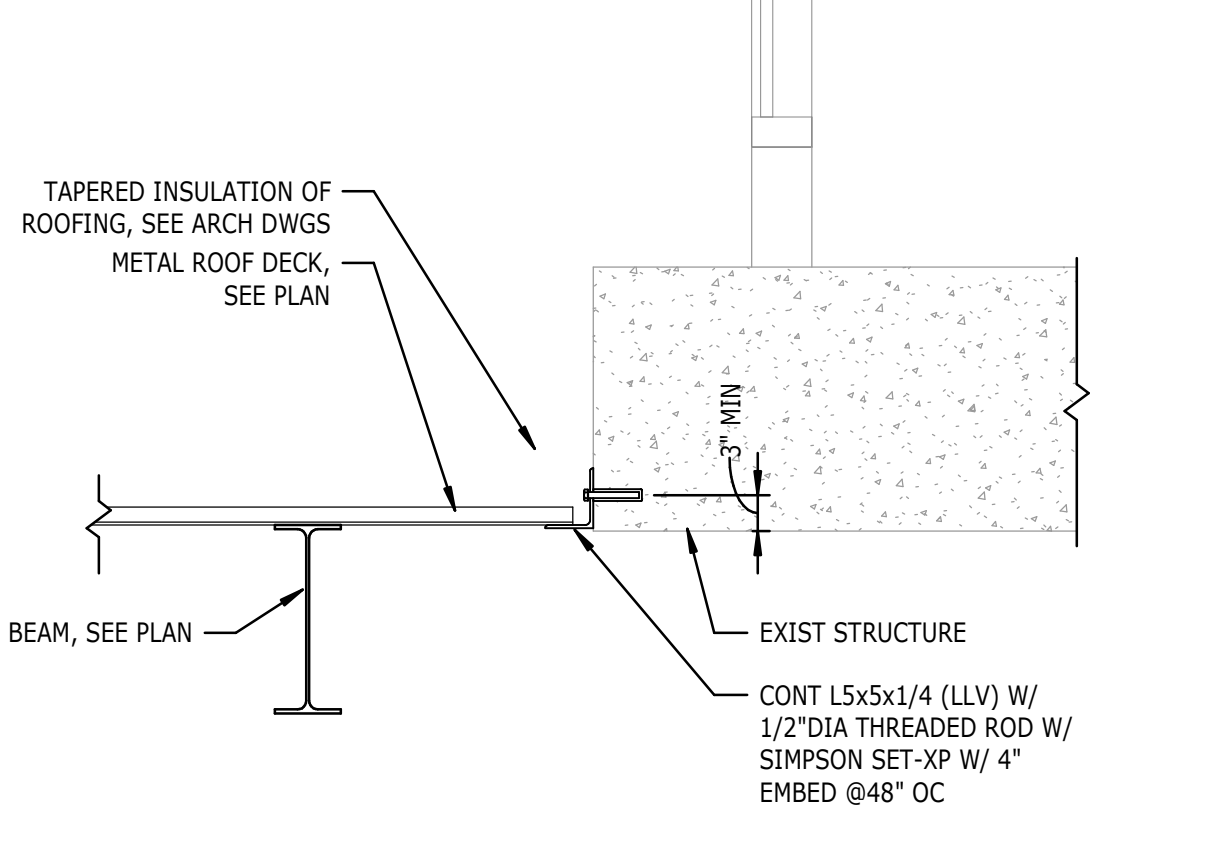


**5 PLAN**  
S-522 CONNECTION PLATE DETAIL  
1 1/2" = 1'-0"

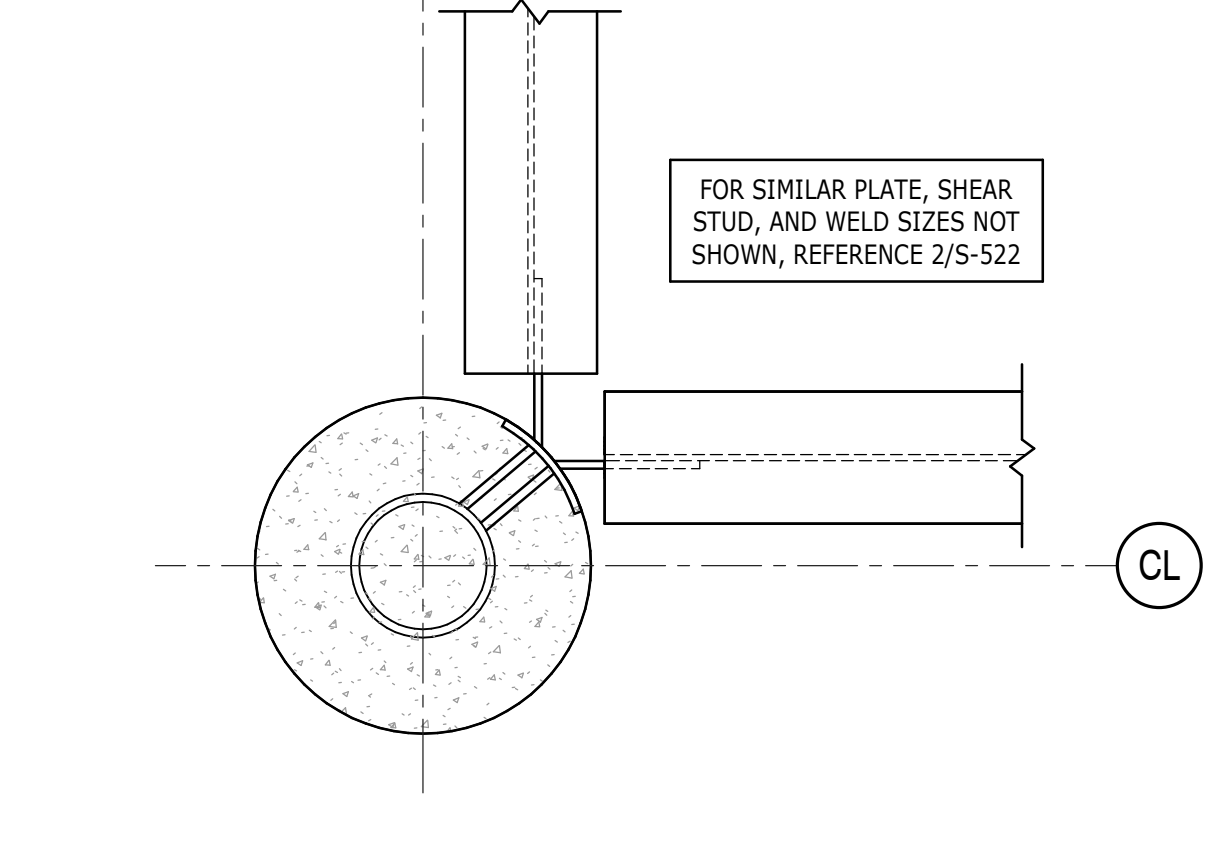


**1 CONNECTION PLAN DETAIL**  
S-522 NTS

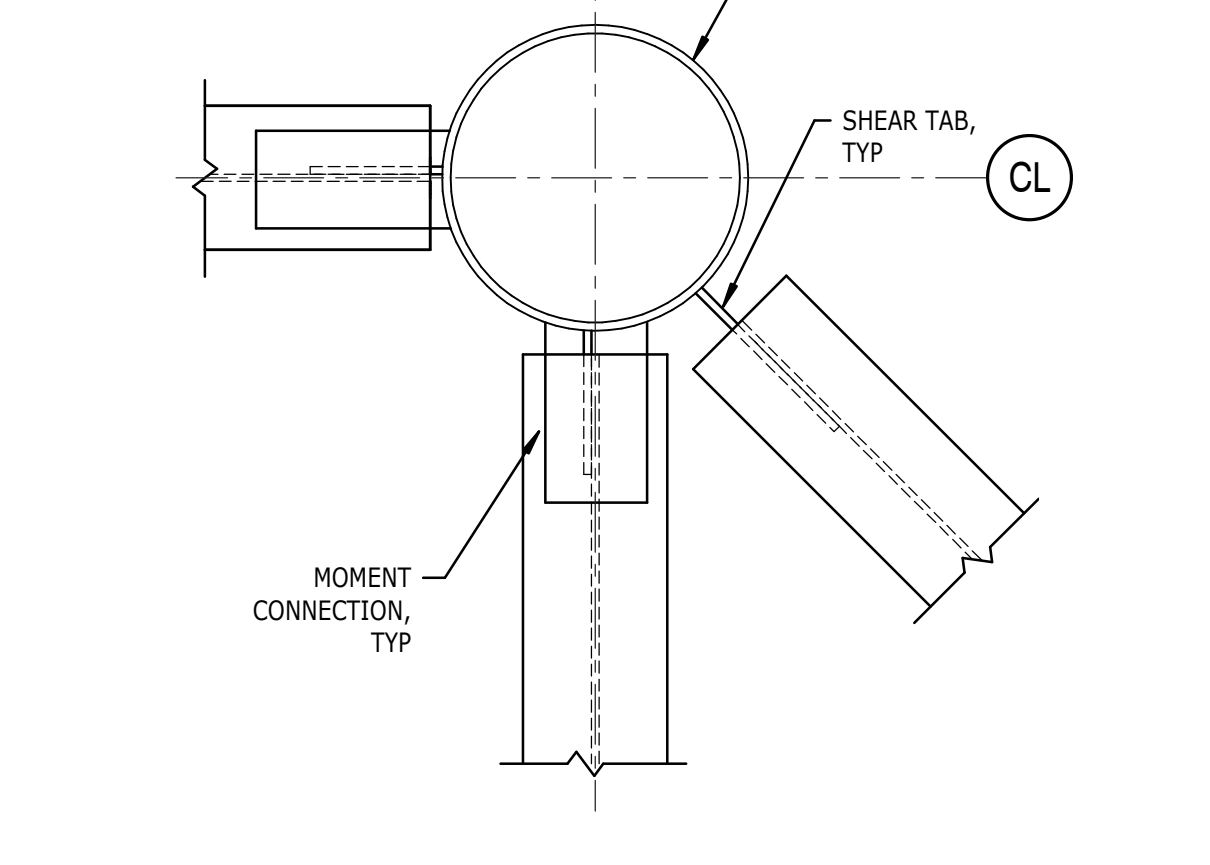


**18 SECTION**  
S-522 3/4" = 1'-0"

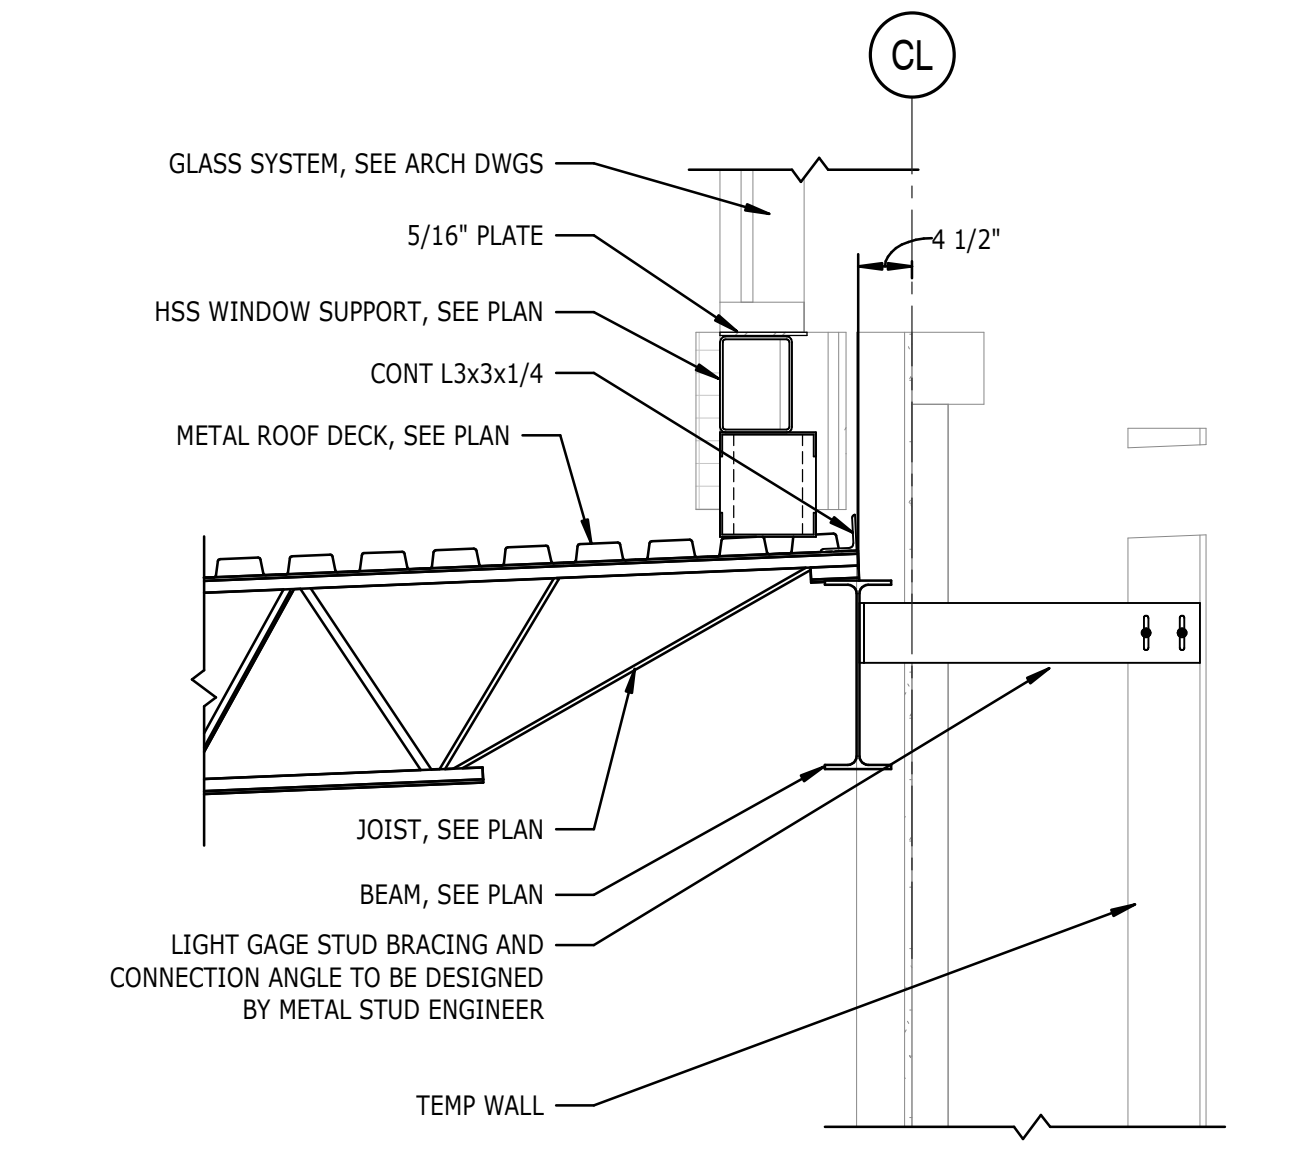


**13 SECTION**  
S-522 3/4" = 1'-0"

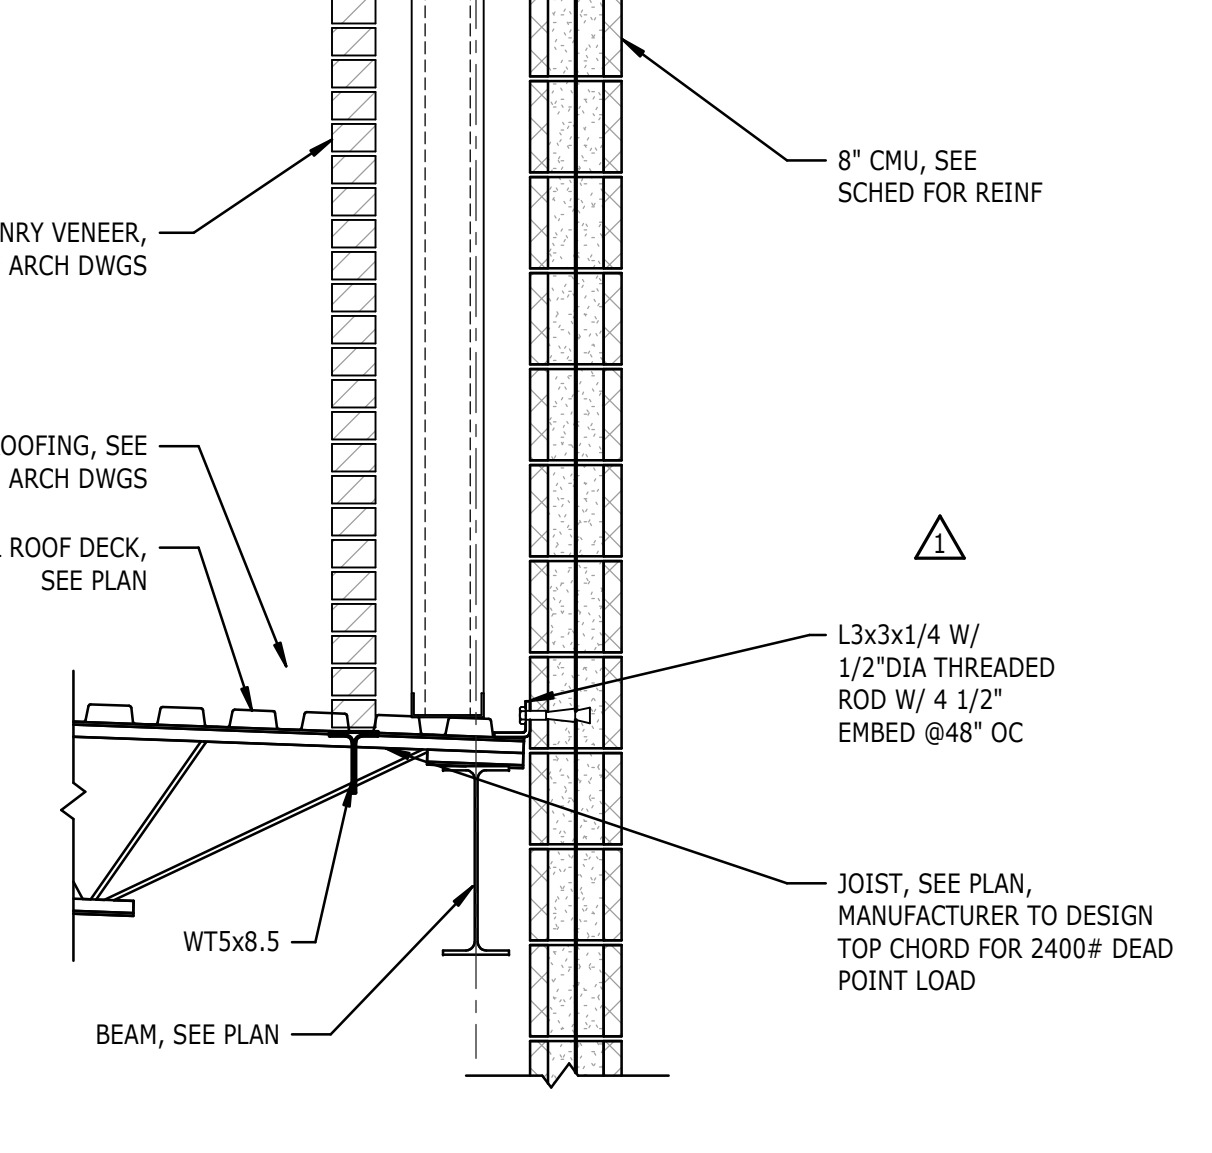


**10 SECTION**  
S-522 3/4" = 1'-0"

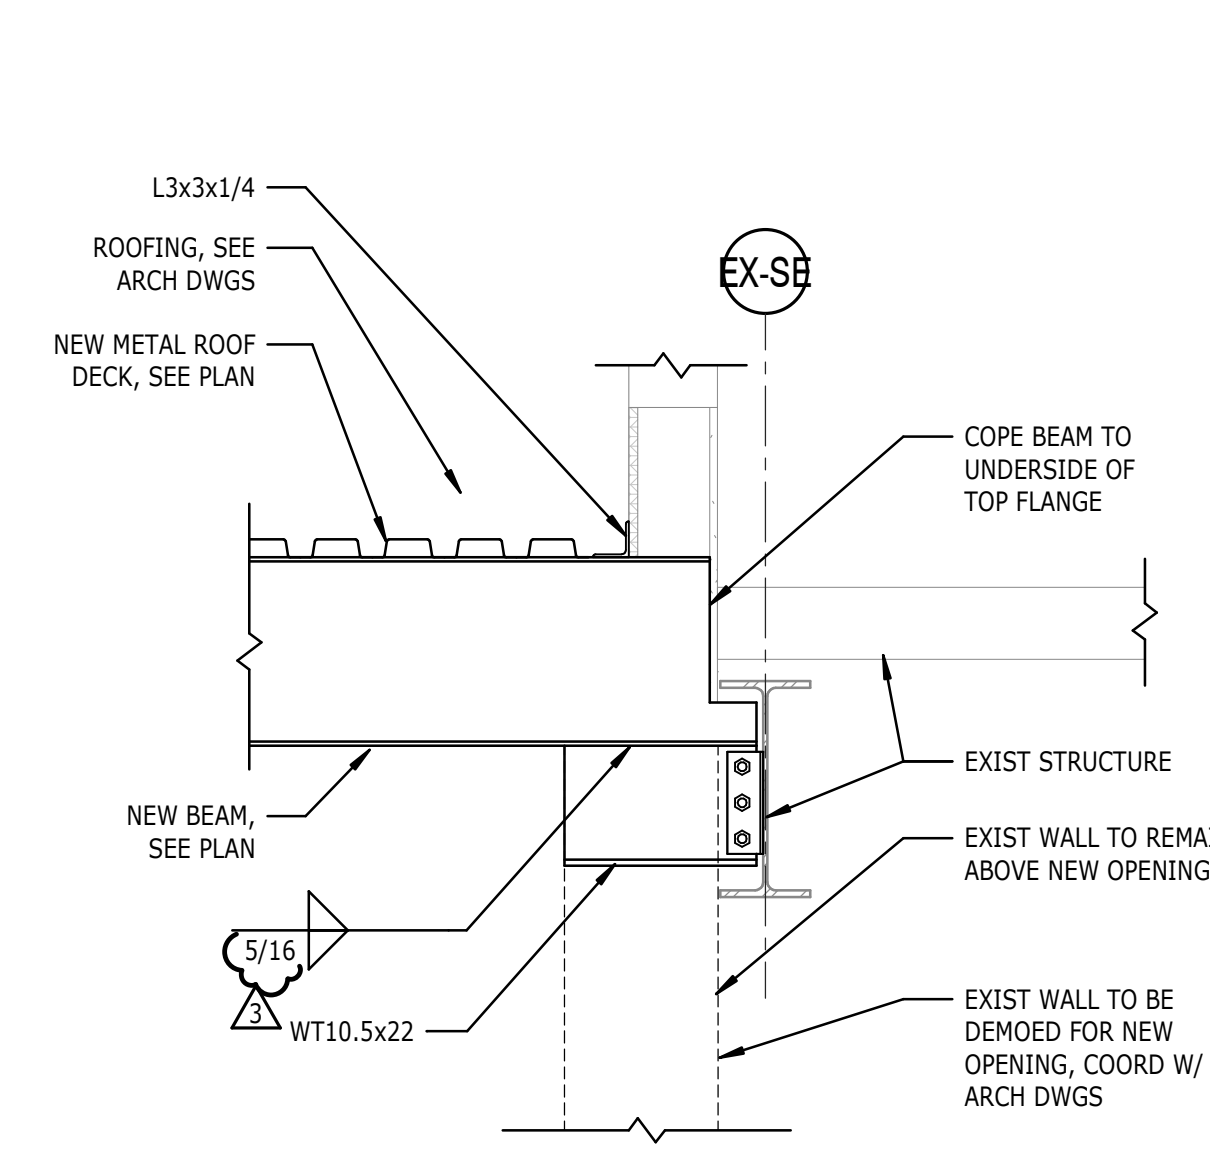


**6 PLAN**  
S-522 CONNECTION PLATE DETAIL  
1 1/2" = 1'-0"

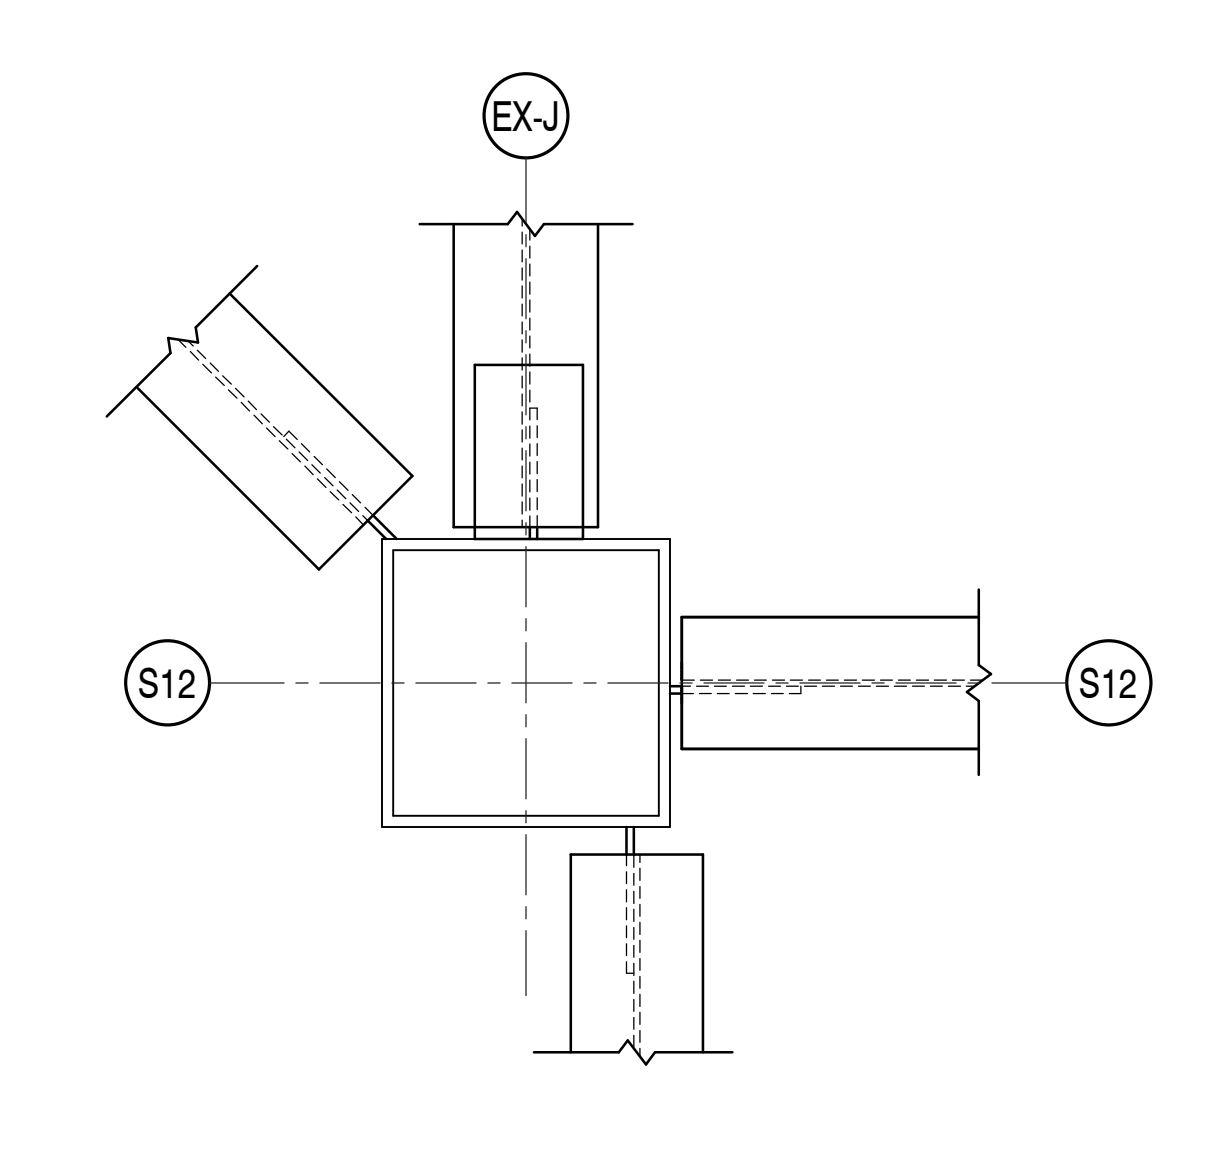


**2 CONNECTION PLAN DETAIL**  
S-522 1 1/2" = 1'-0"

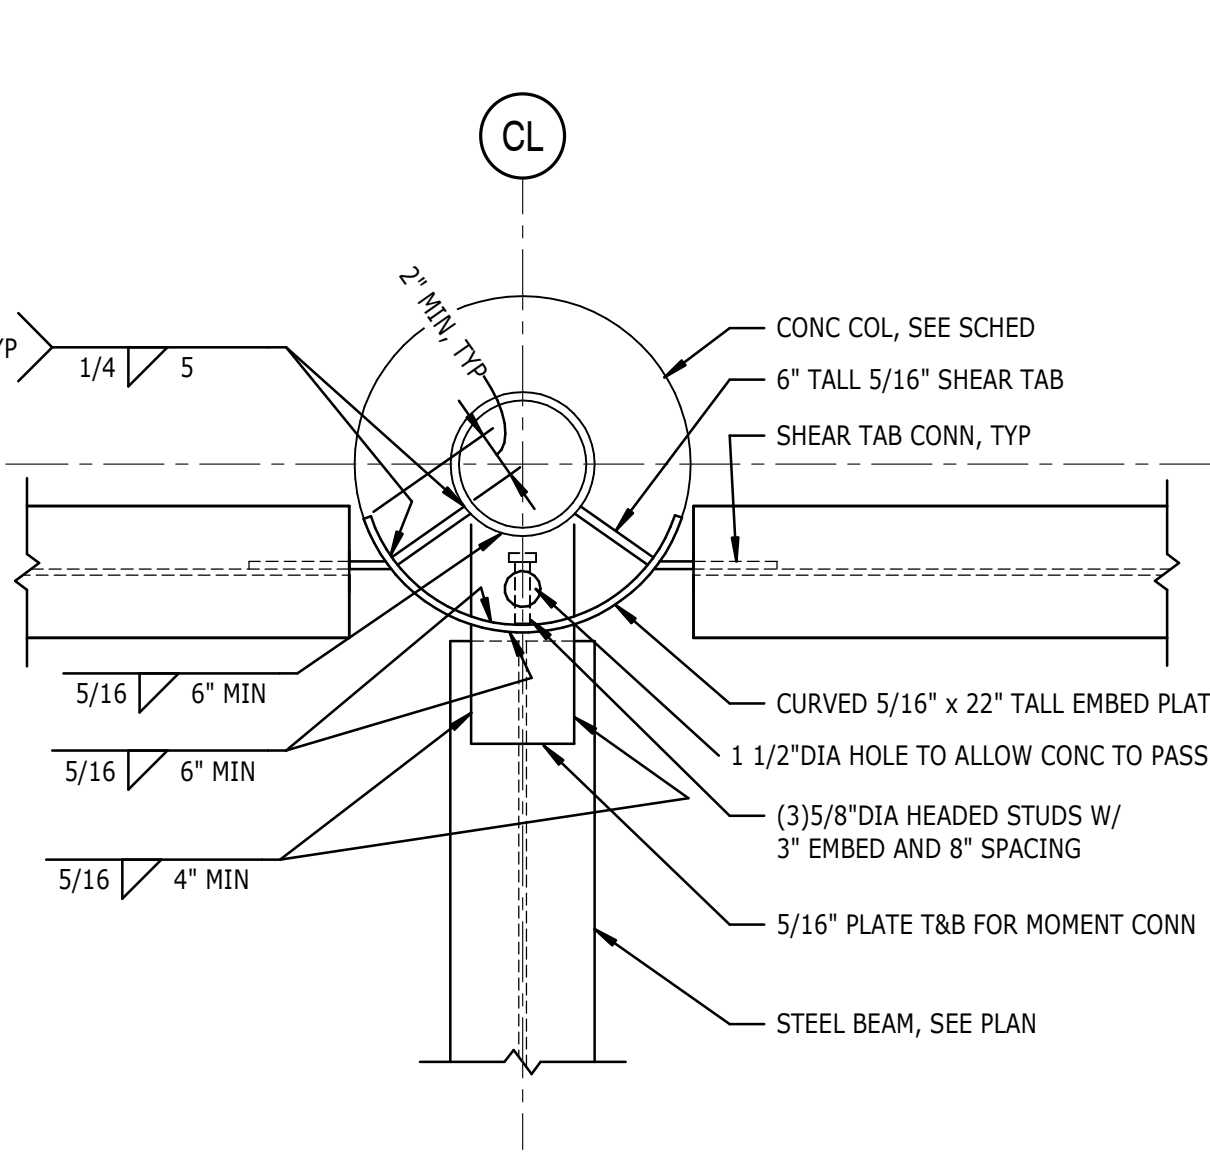


**19 SECTION**  
S-522 3/4" = 1'-0"

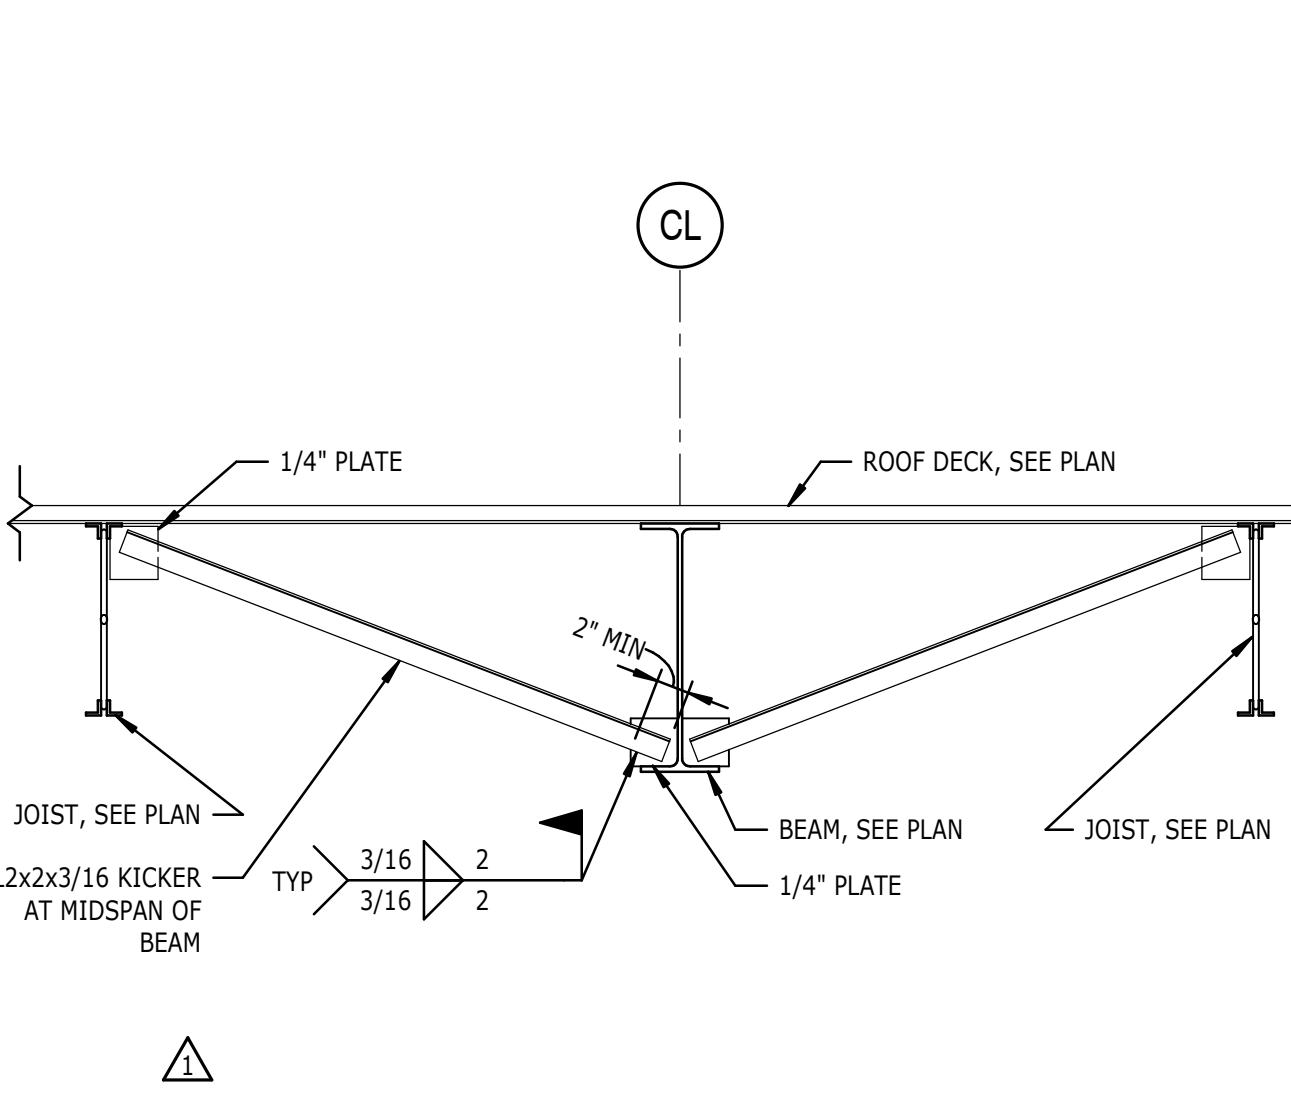


**15 SECTION**  
S-522 3/4" = 1'-0"

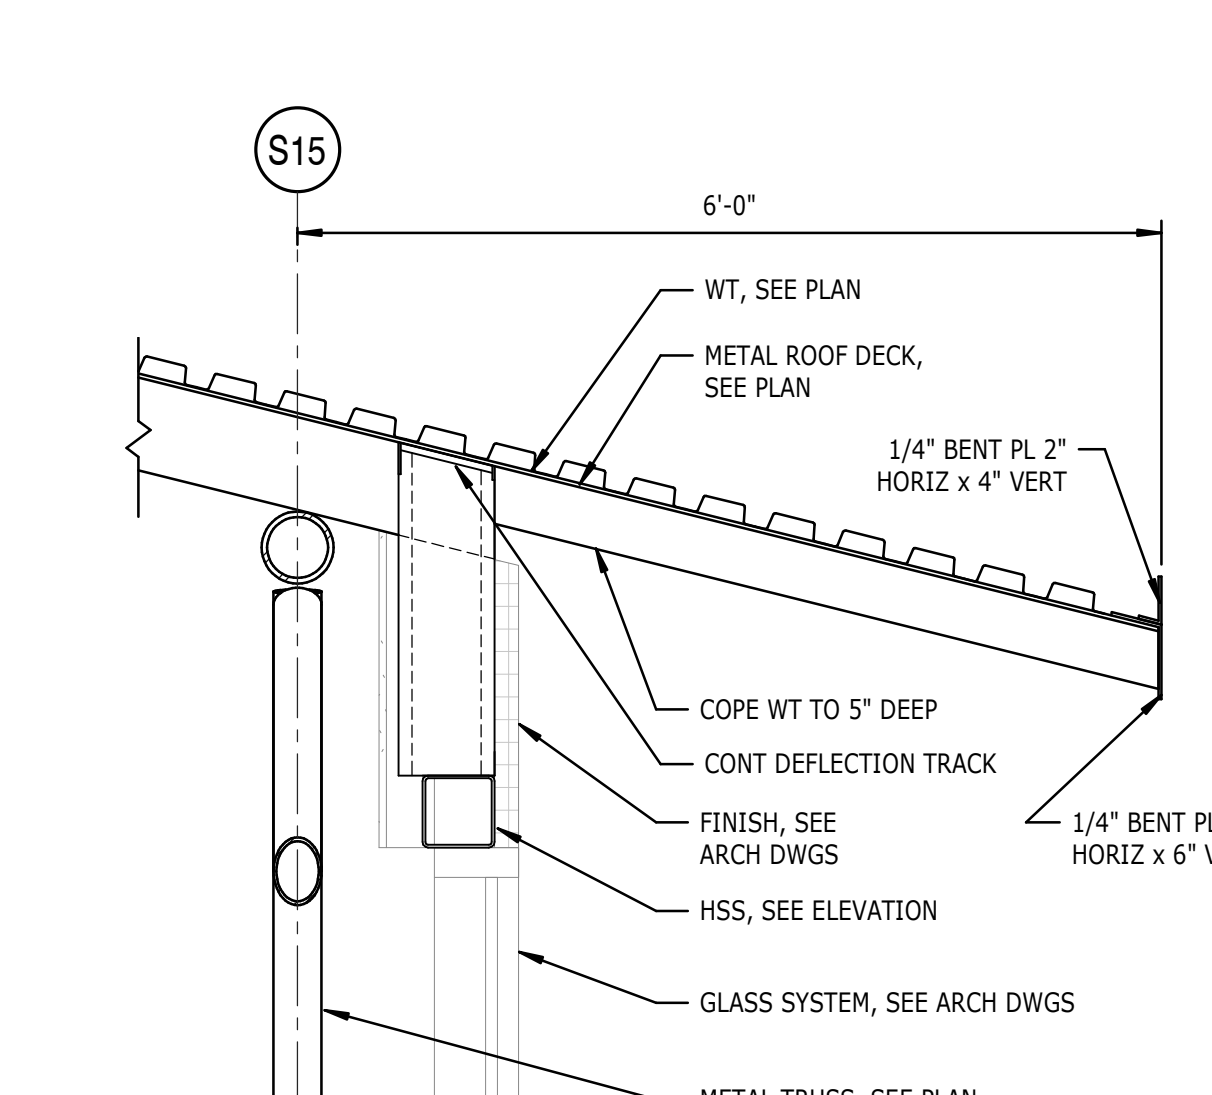


**11 SECTION**  
S-522 3/4" = 1'-0"

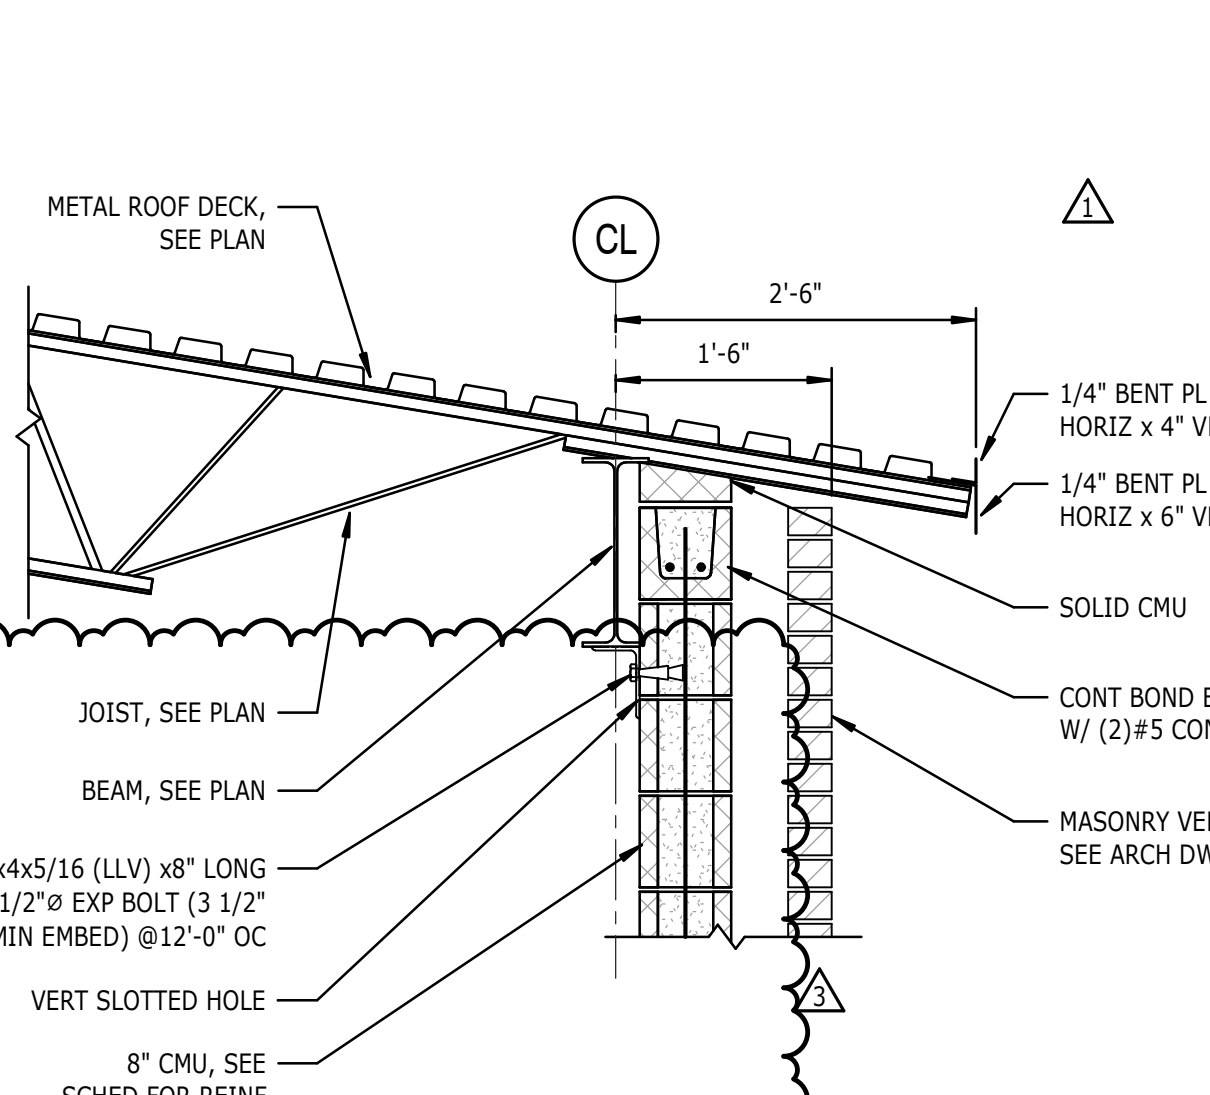


**7 PLAN**  
S-522 CONNECTION PLATE DETAIL  
1 1/2" = 1'-0"

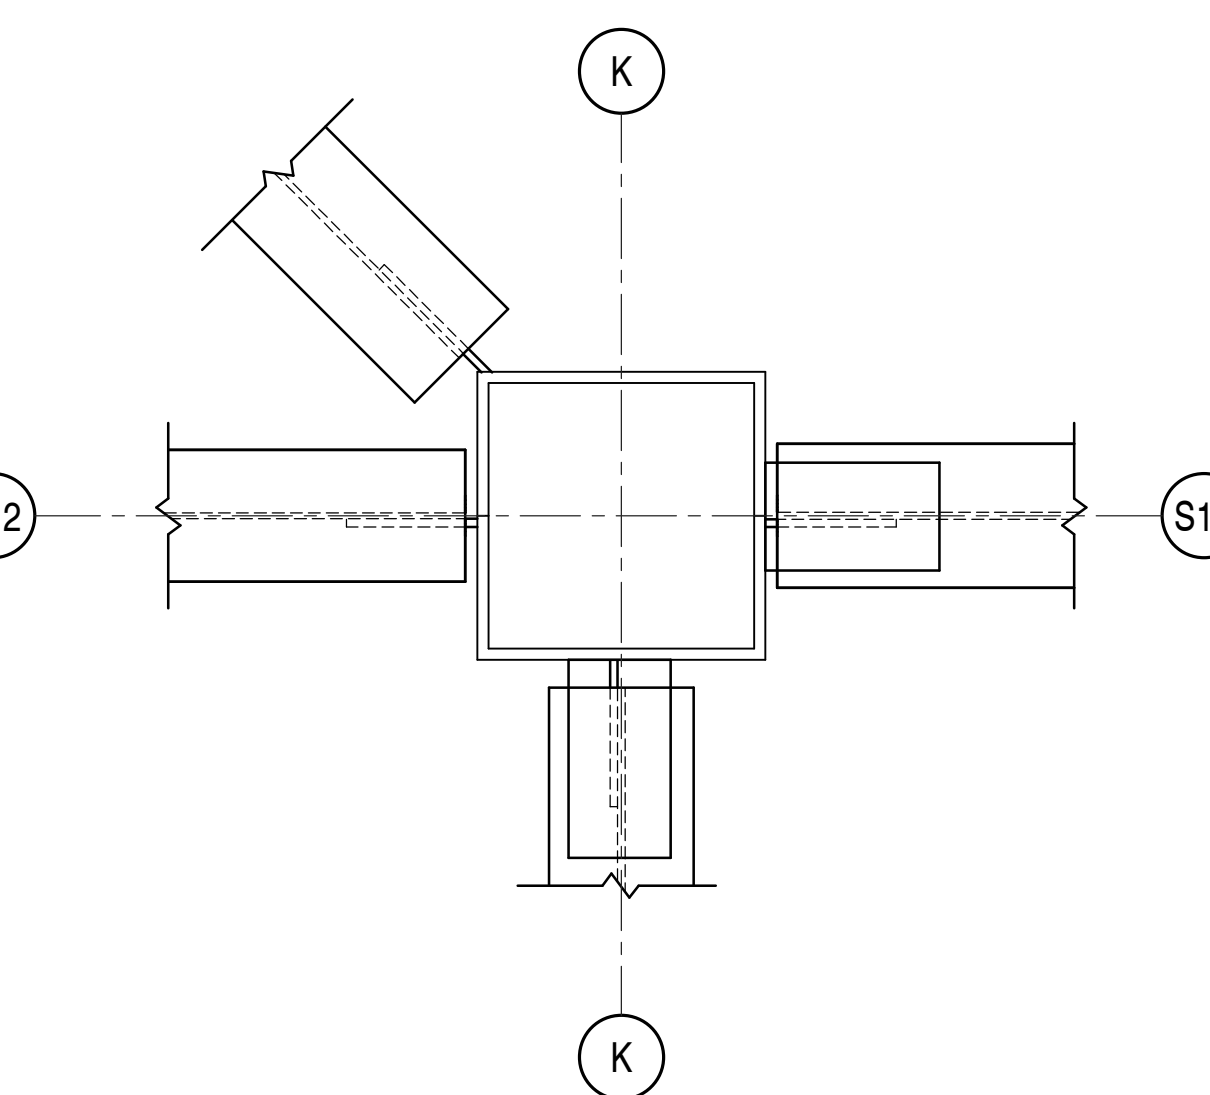


**3 CONNECTION PLAN DETAIL**  
S-522 1 1/2" = 1'-0"

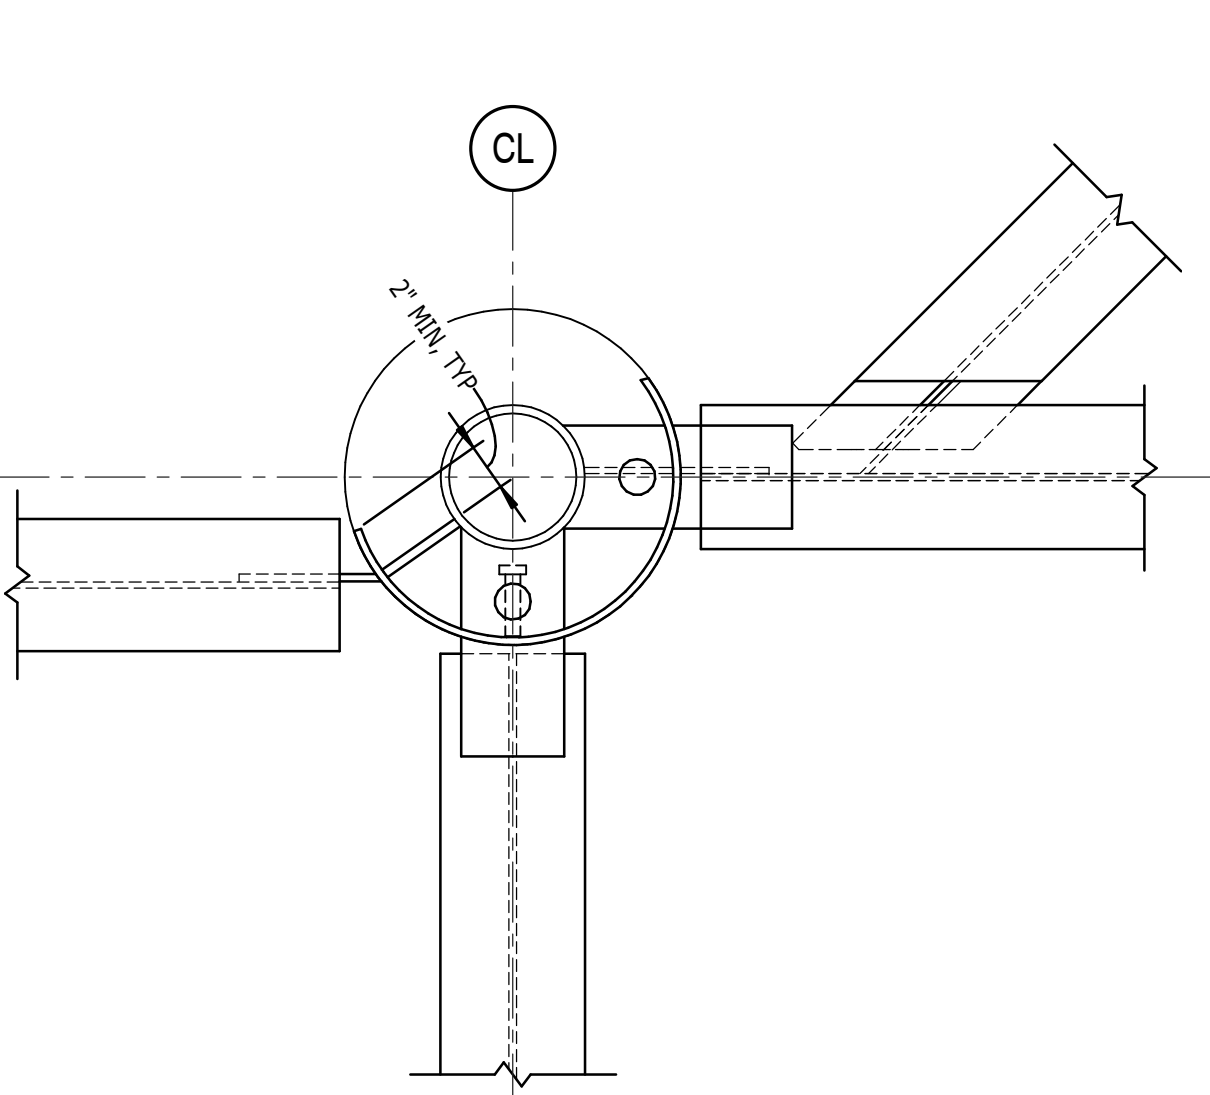


**20 SECTION**  
S-522 3/4" = 1'-0"

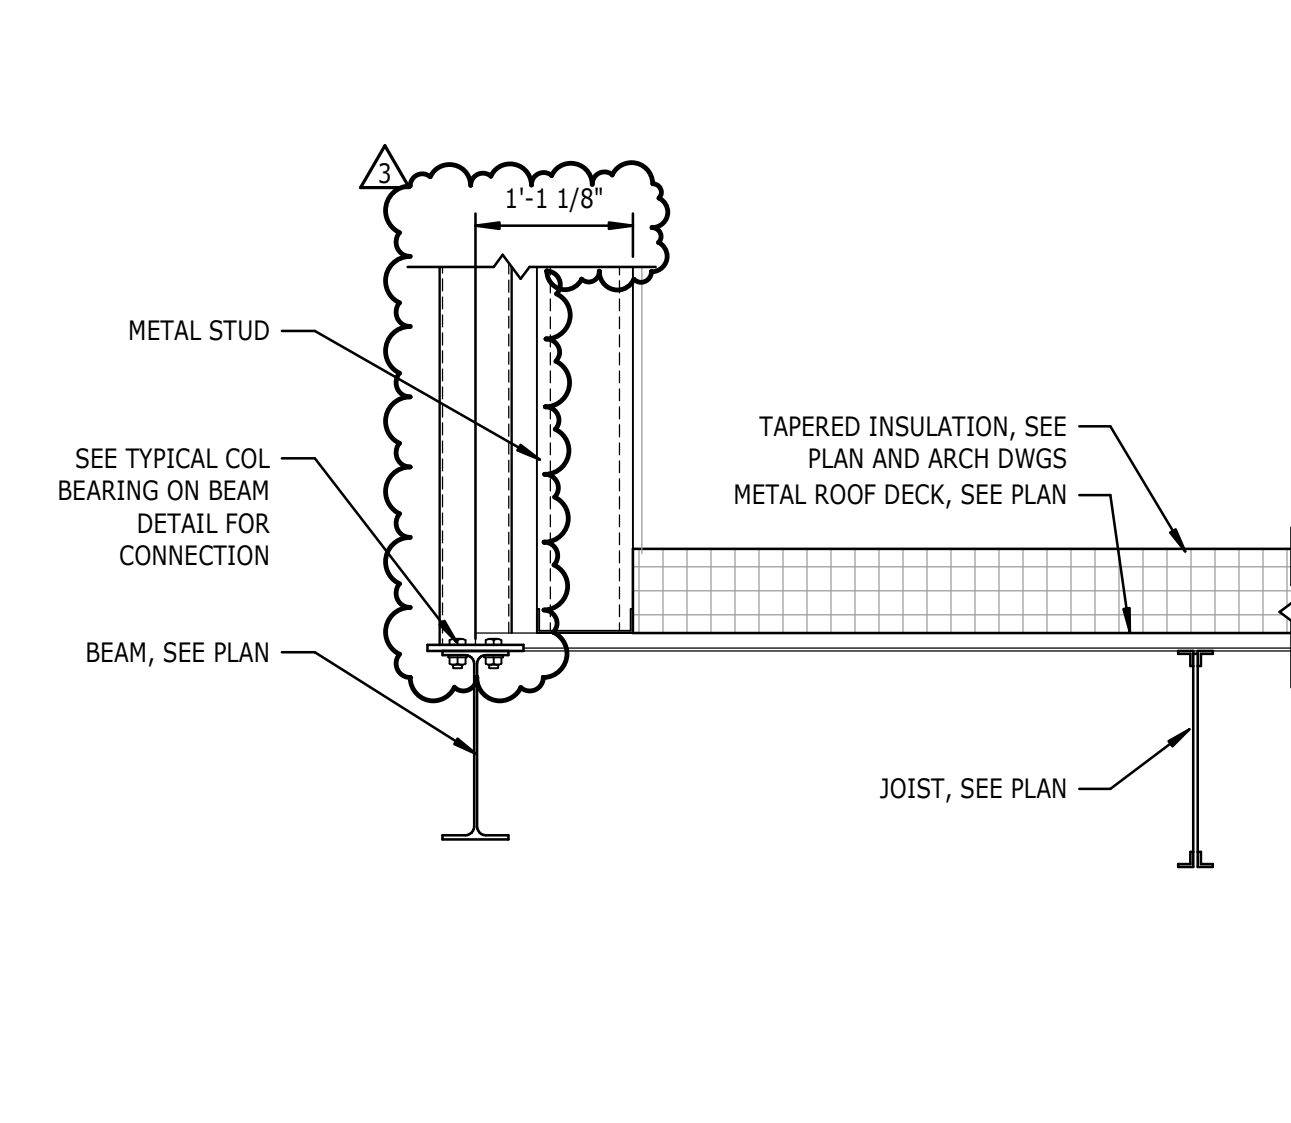


**12 SECTION**  
S-522 3/4" = 1'-0"

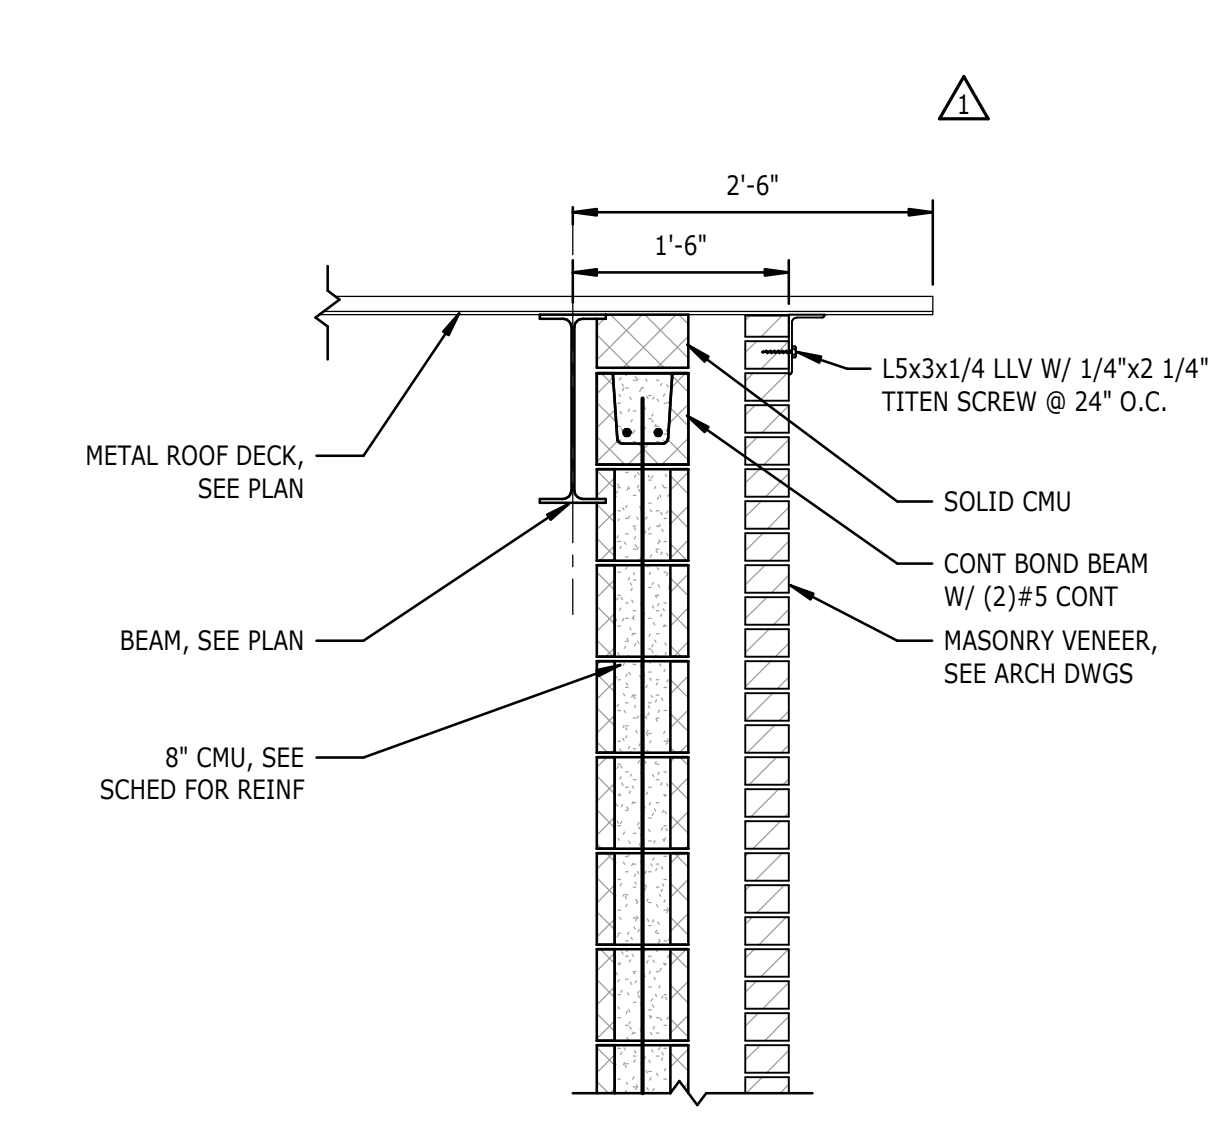


**8 PLAN**  
S-522 CONNECTION PLATE DETAIL  
1 1/2" = 1'-0"

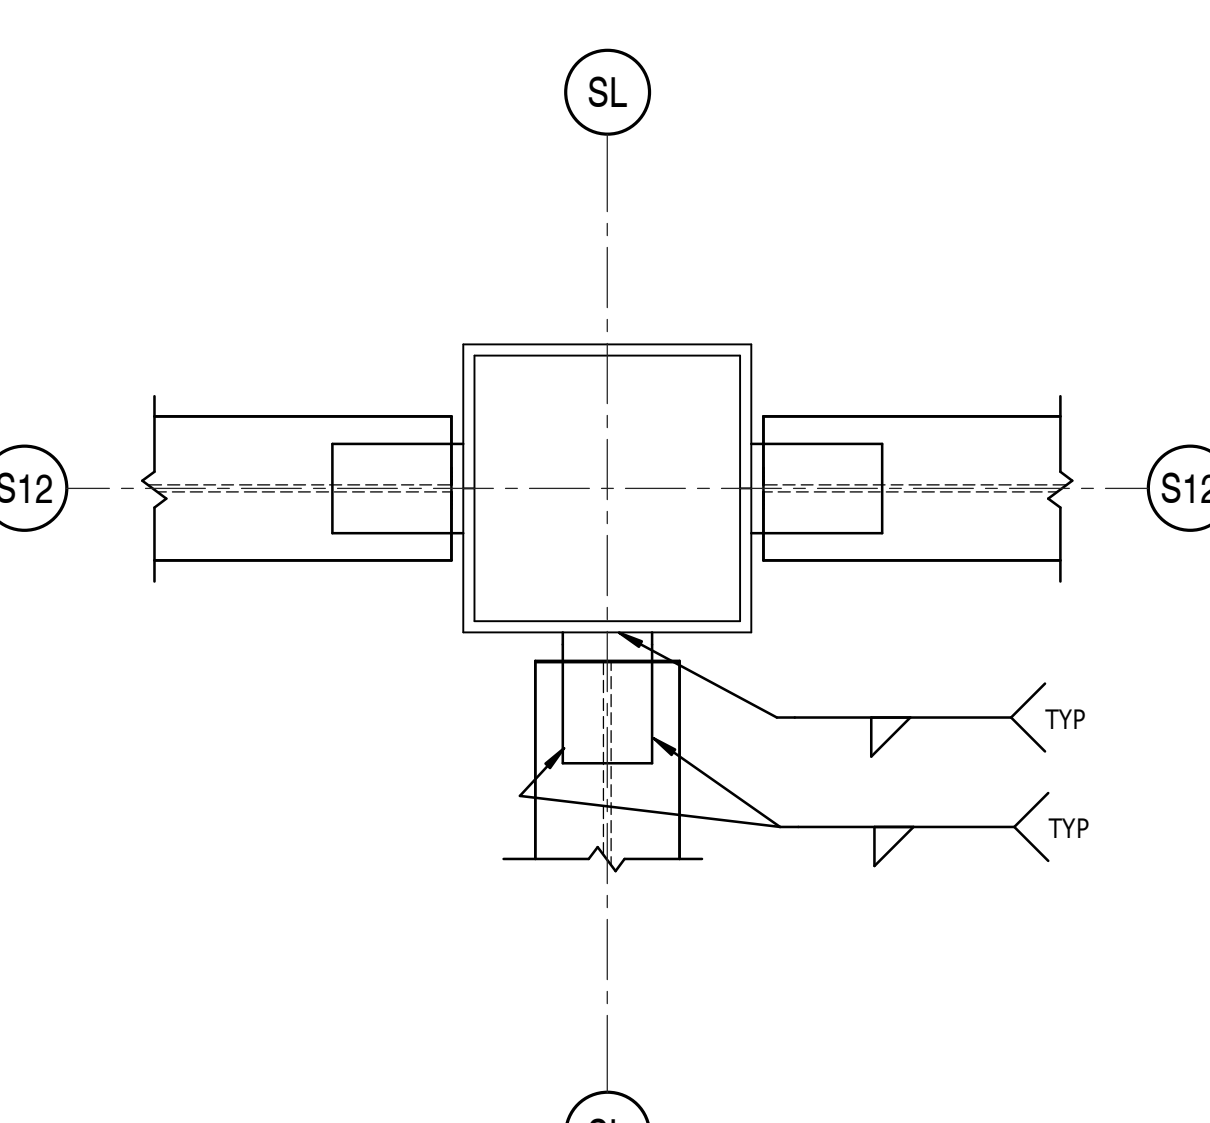


**4 CONNECTION PLAN DETAIL**  
S-522 1 1/2" = 1'-0"

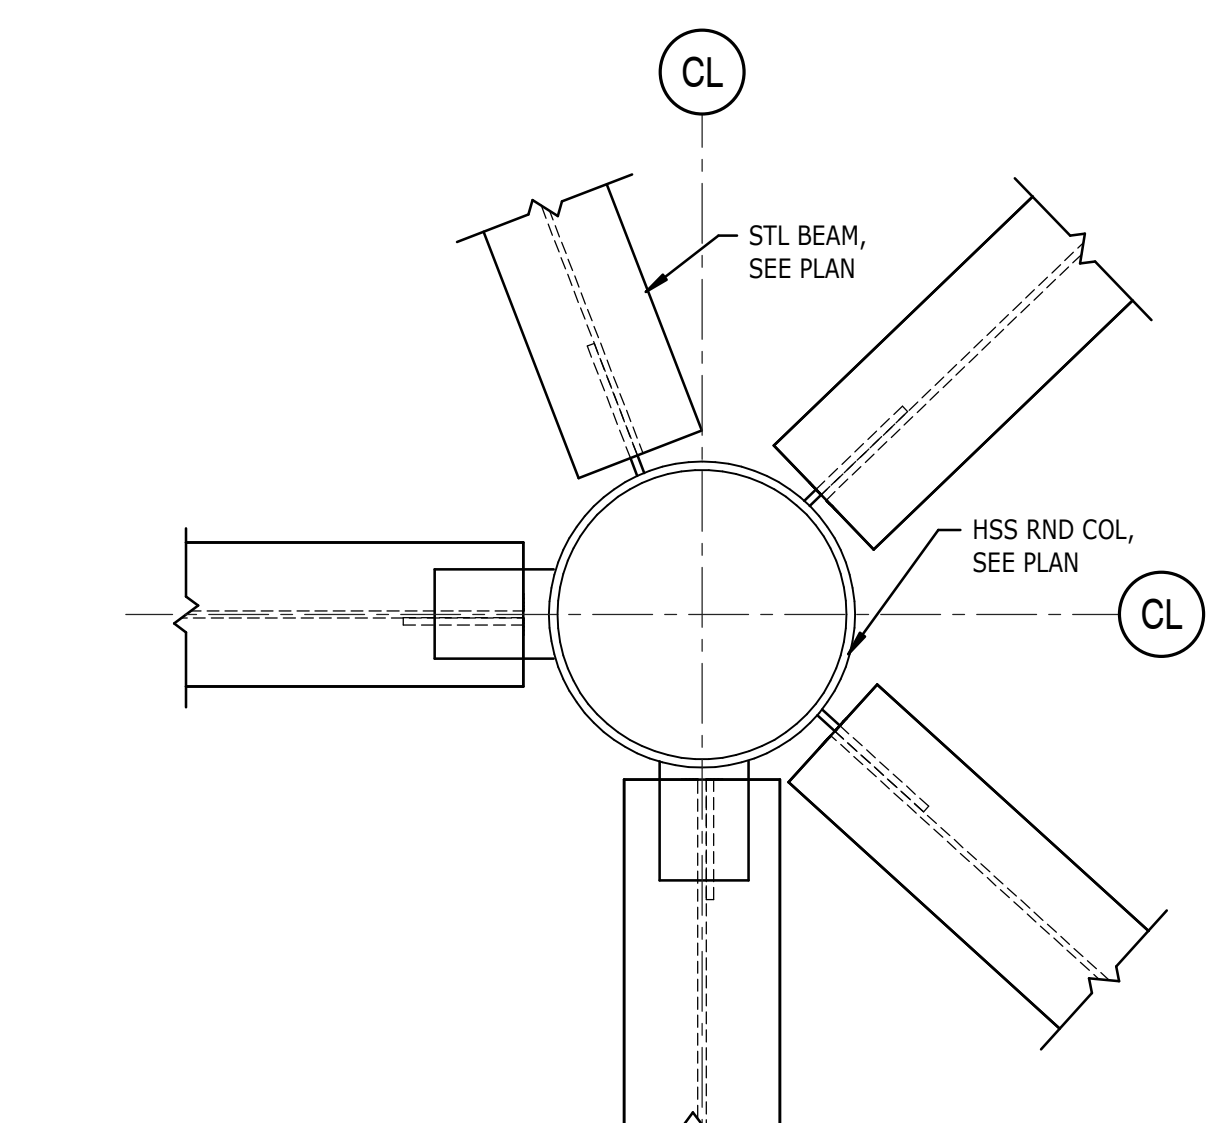


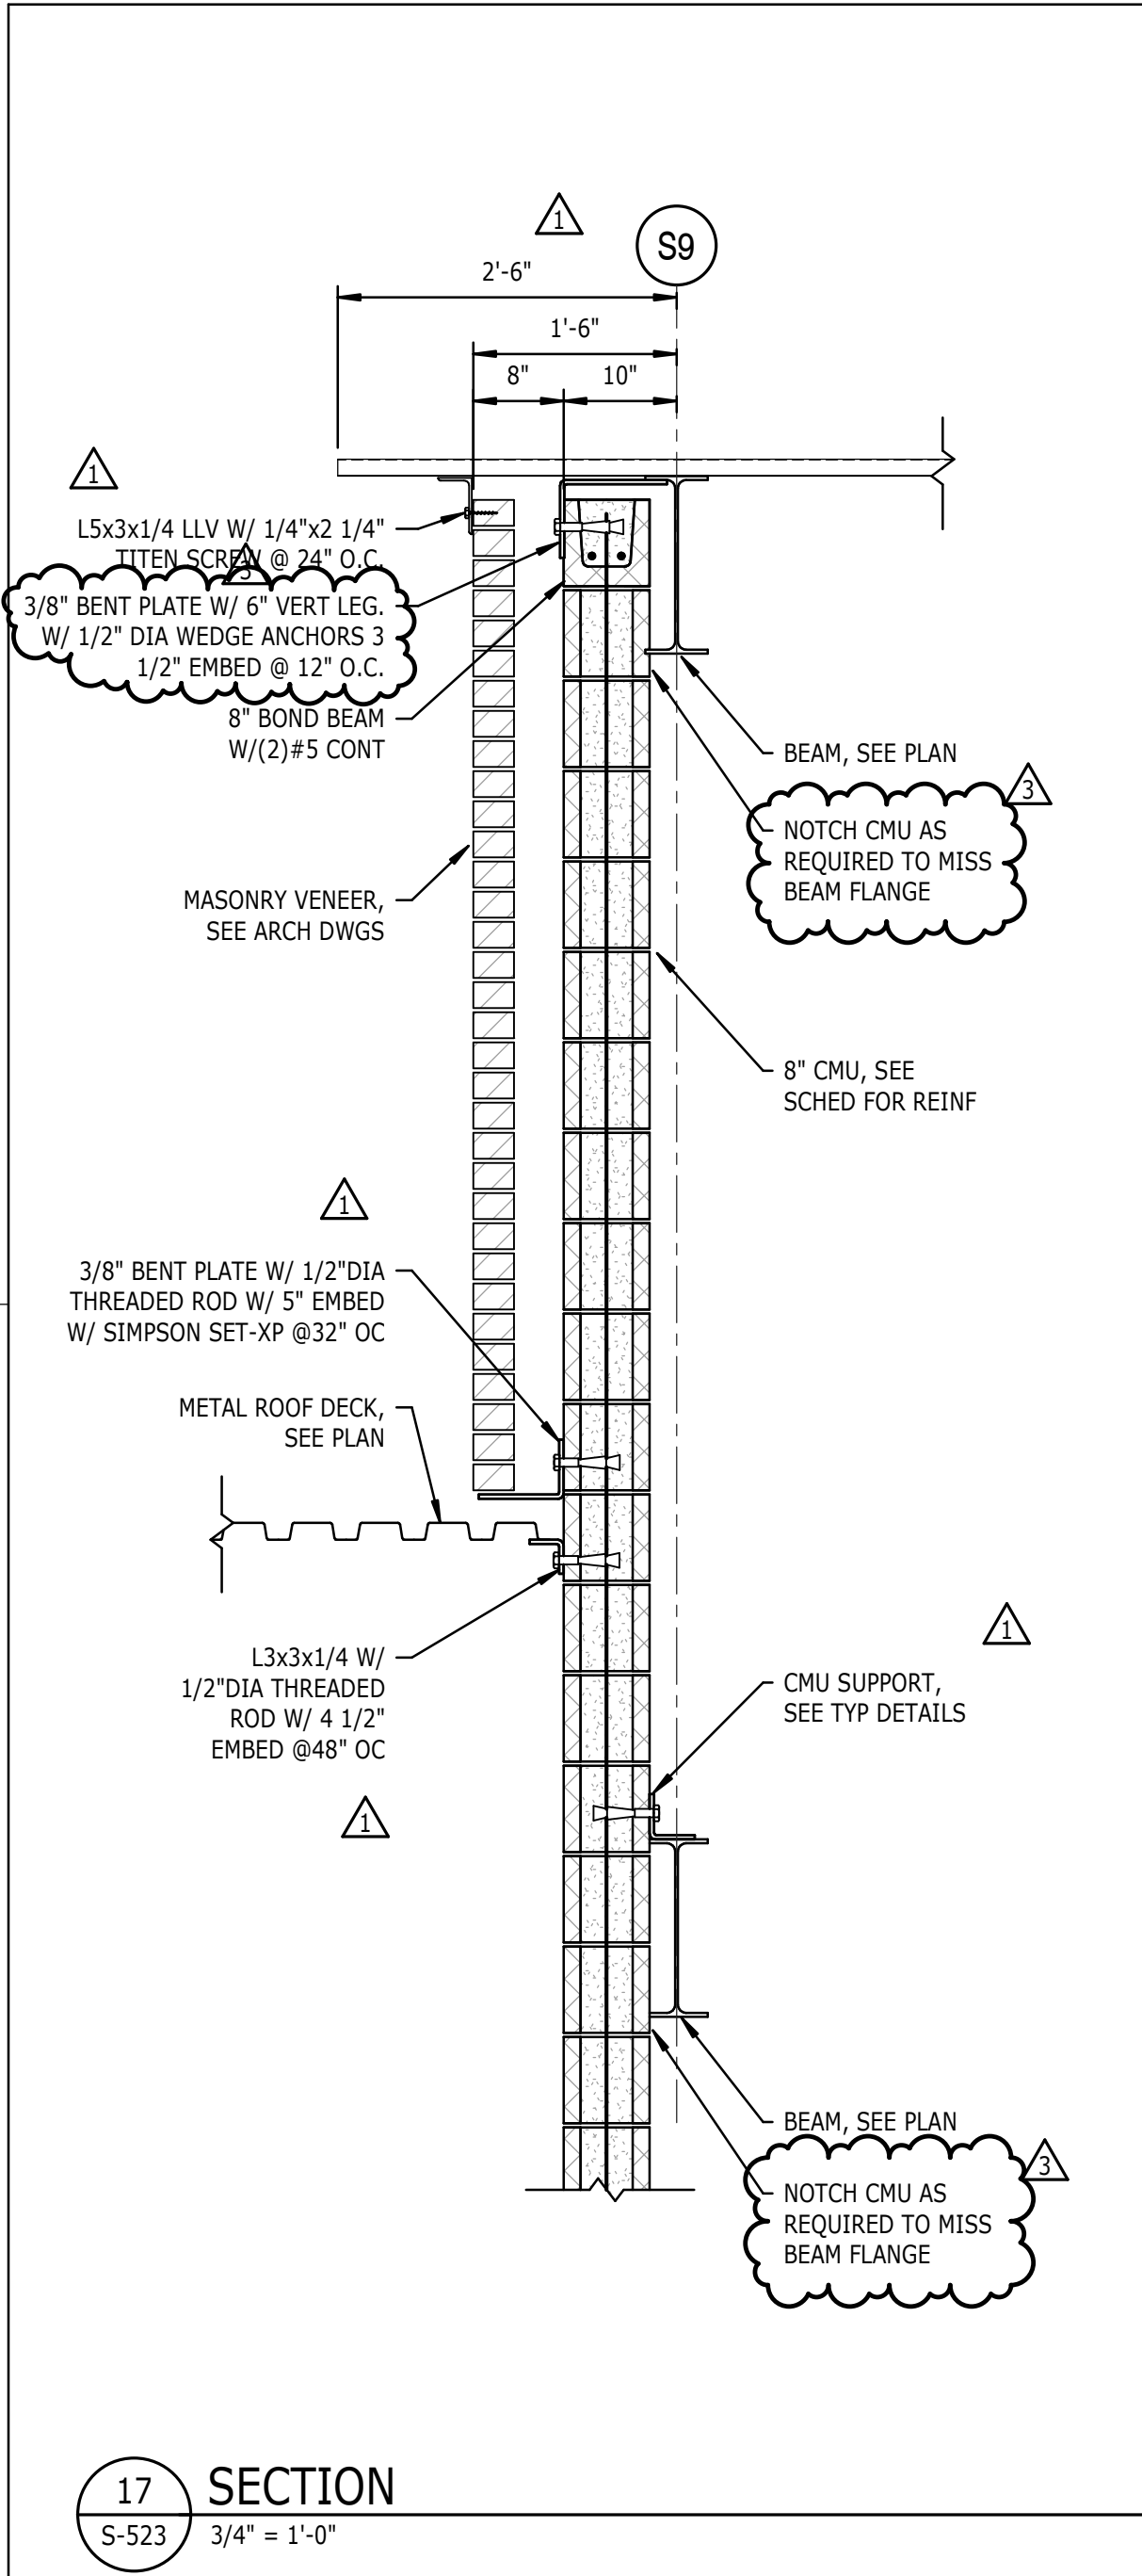


17 SECTION  
S-523 3/4" = 1'-0"

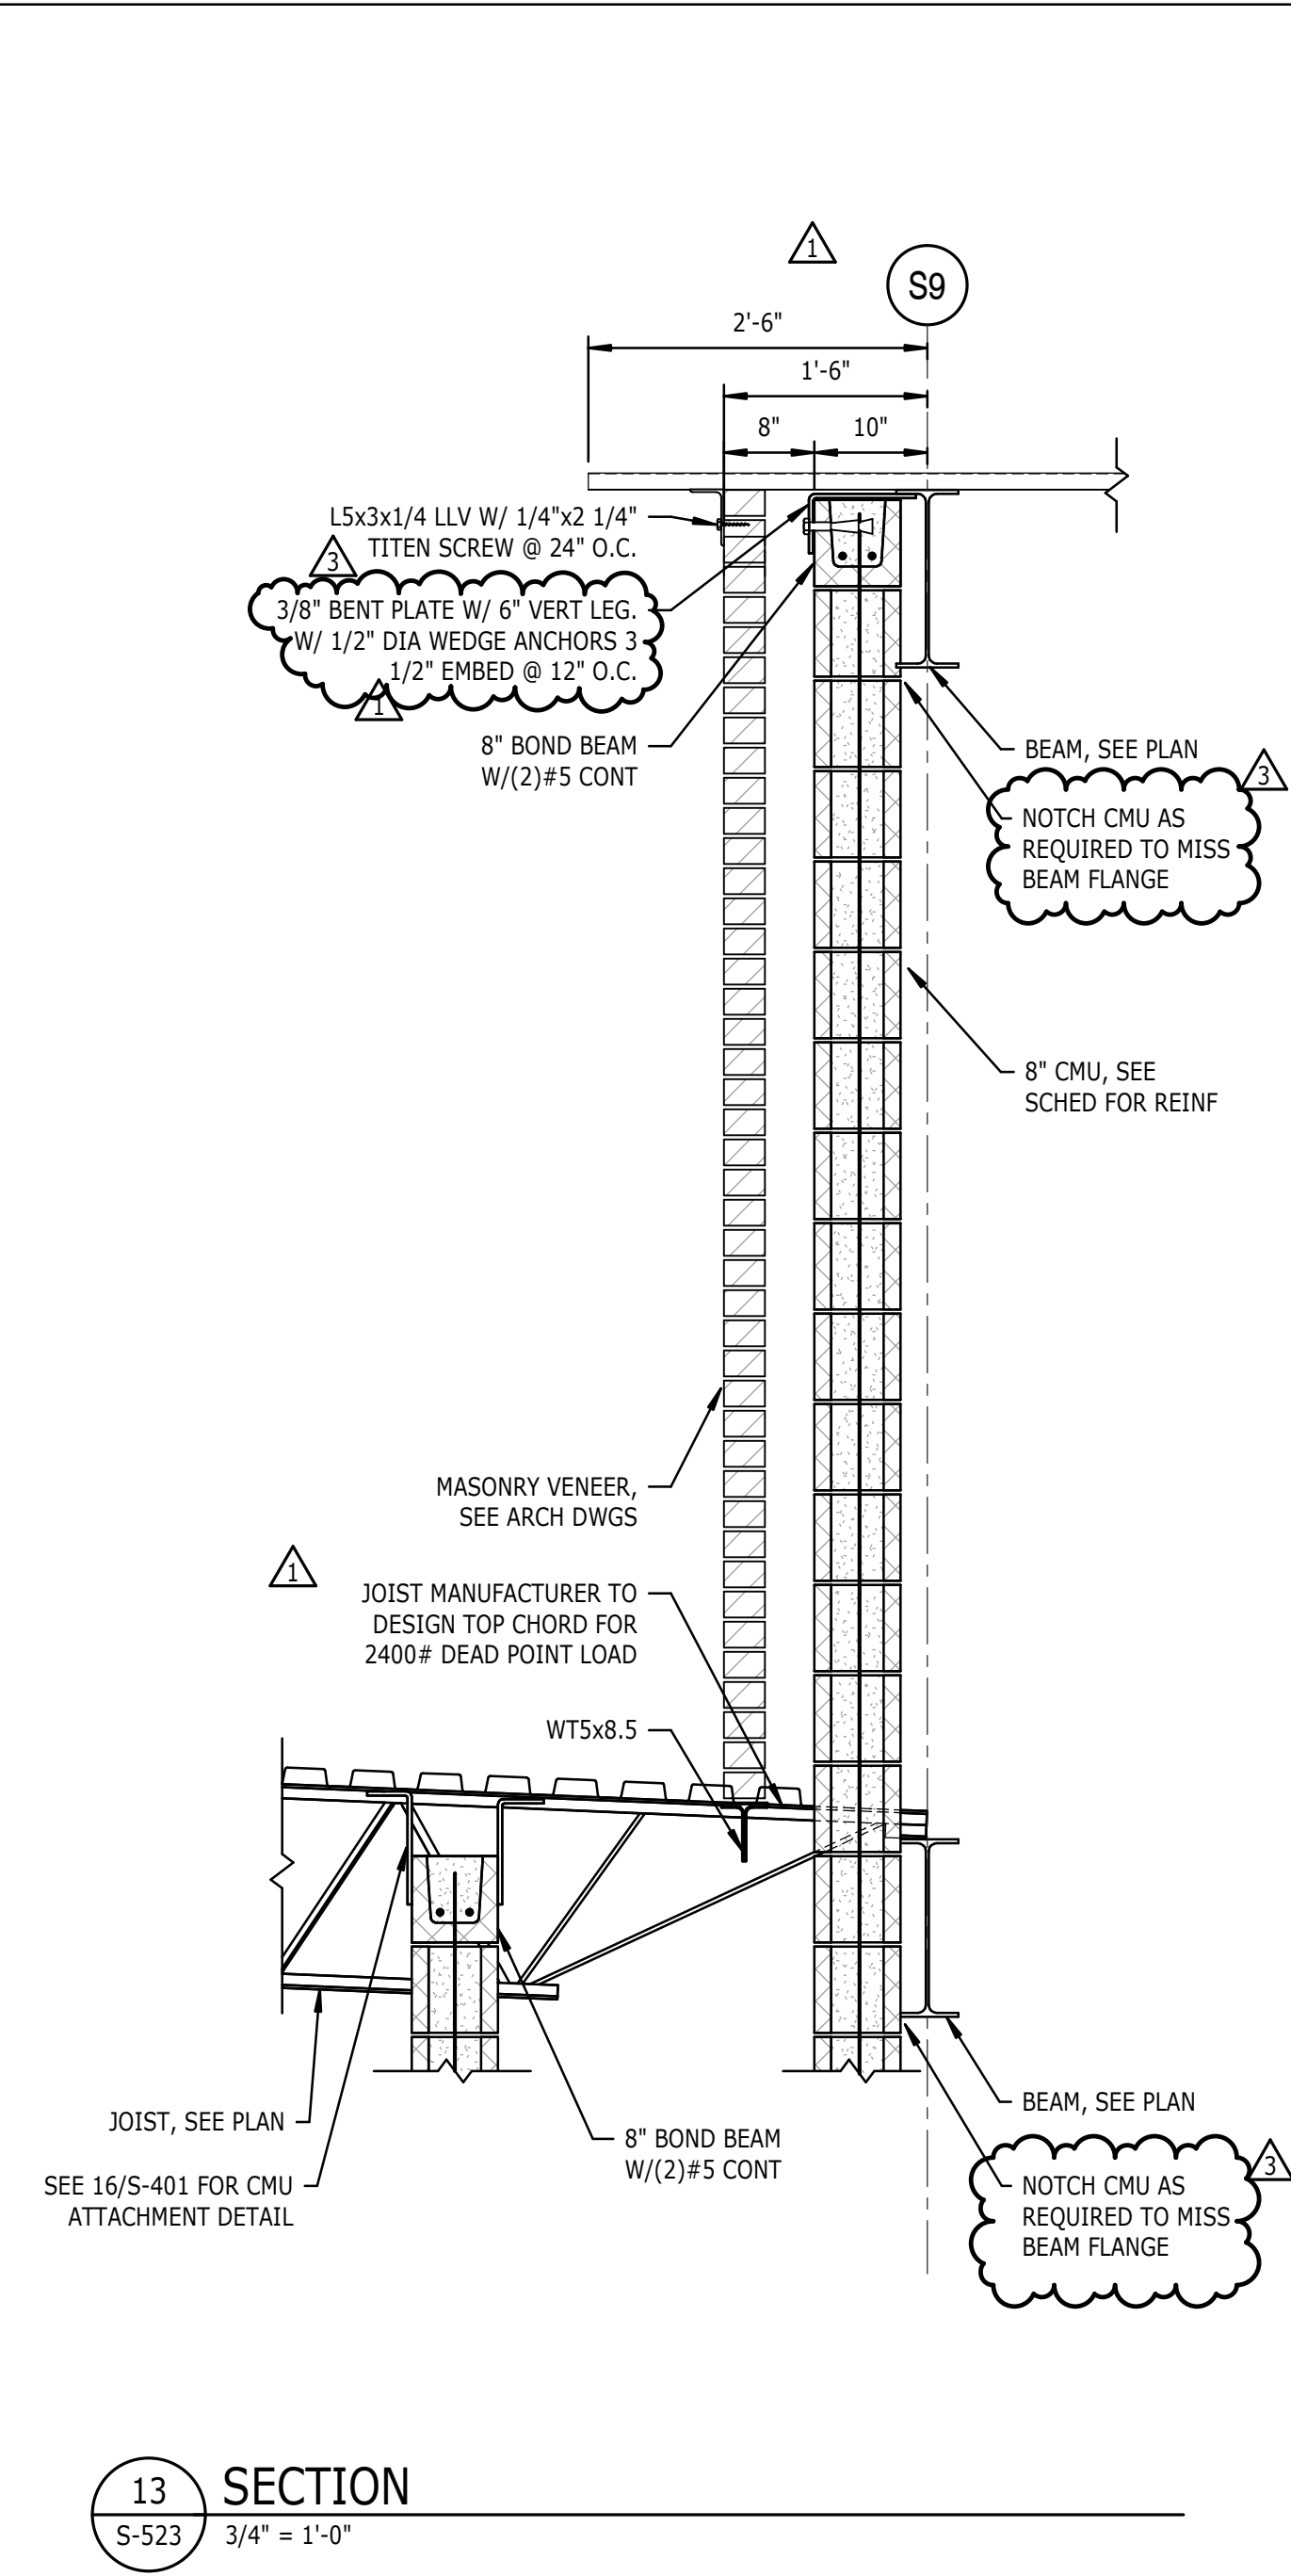


13 SECTION  
S-523 3/4" = 1'-0"

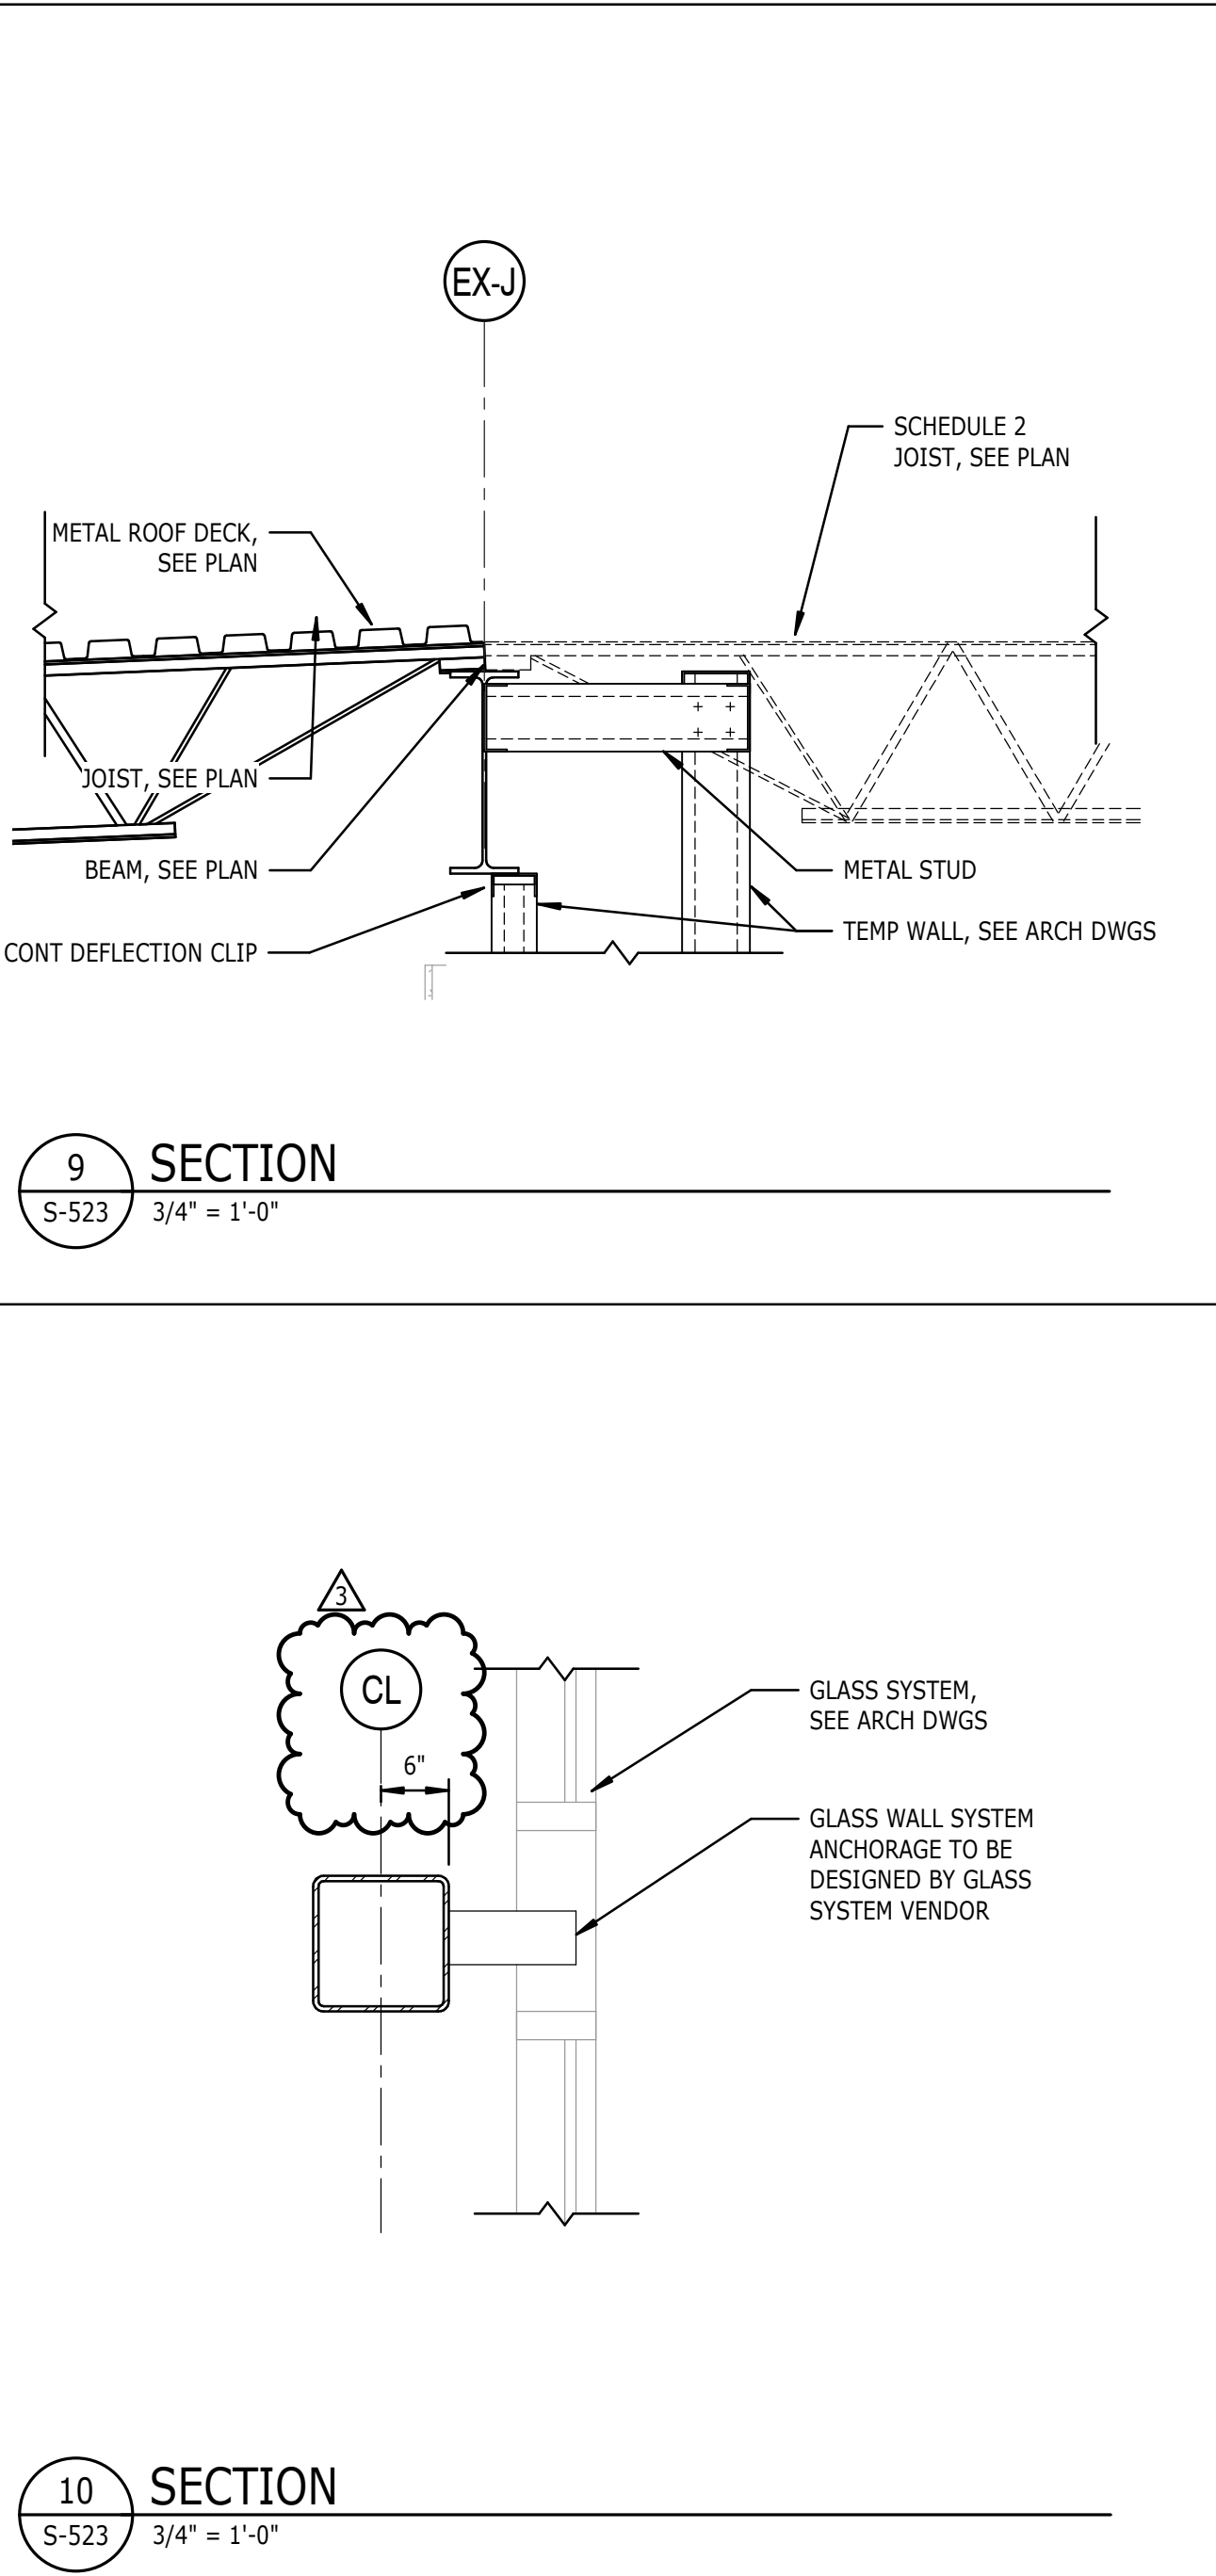


9 SECTION  
S-523 3/4" = 1'-0"

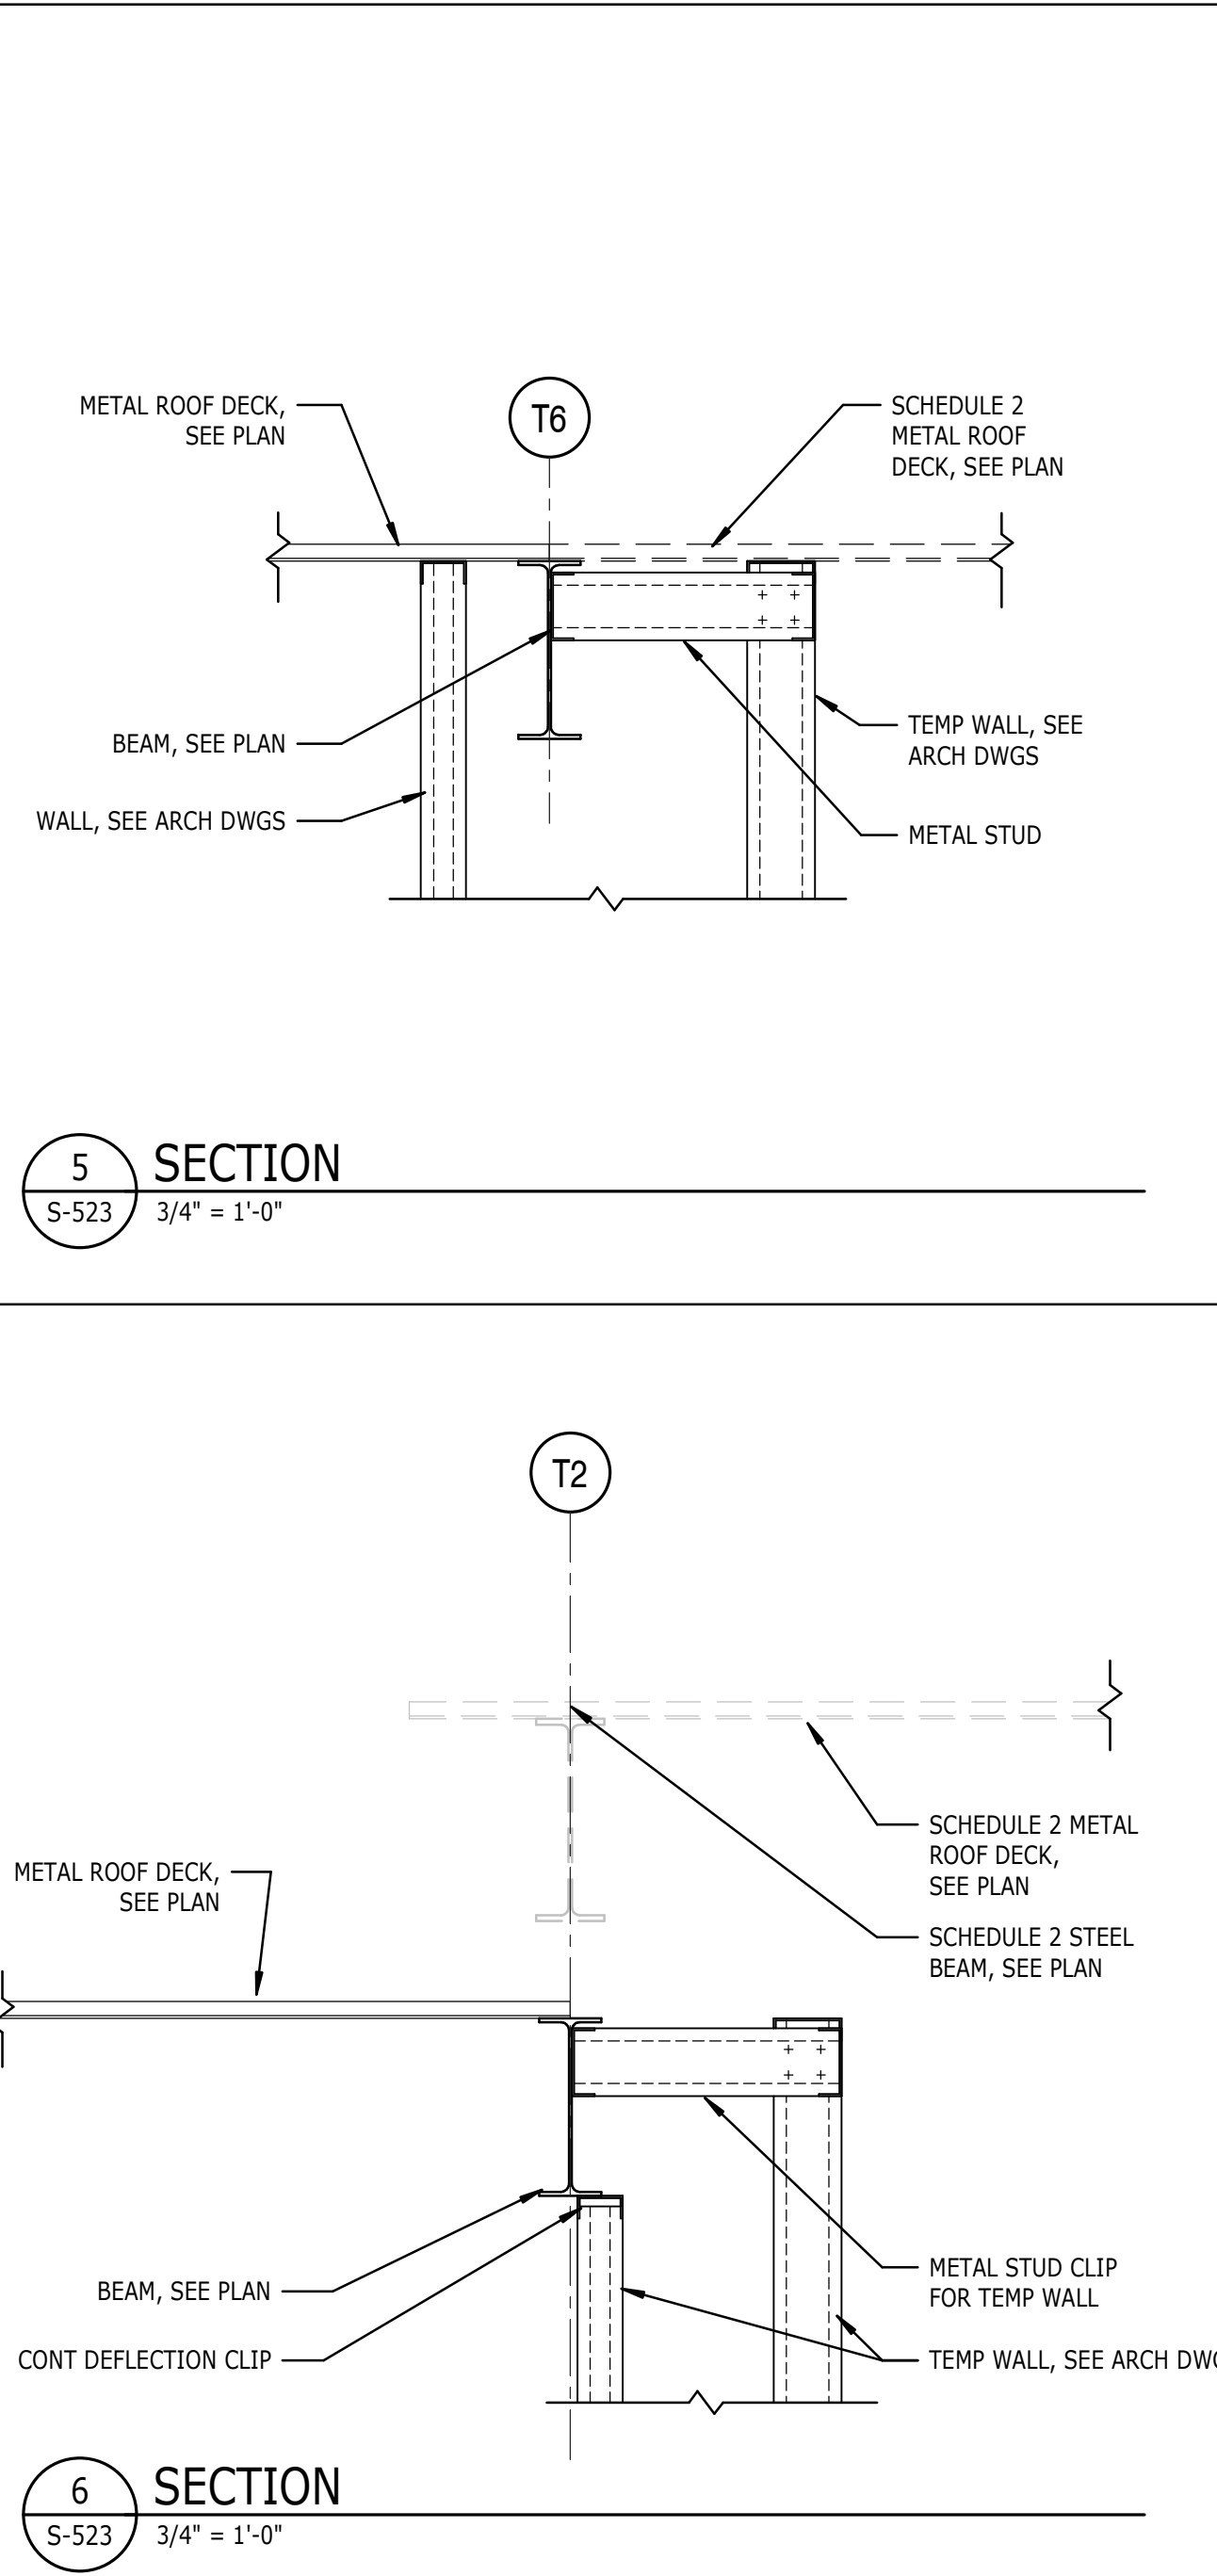


5 SECTION  
S-523 3/4" = 1'-0"

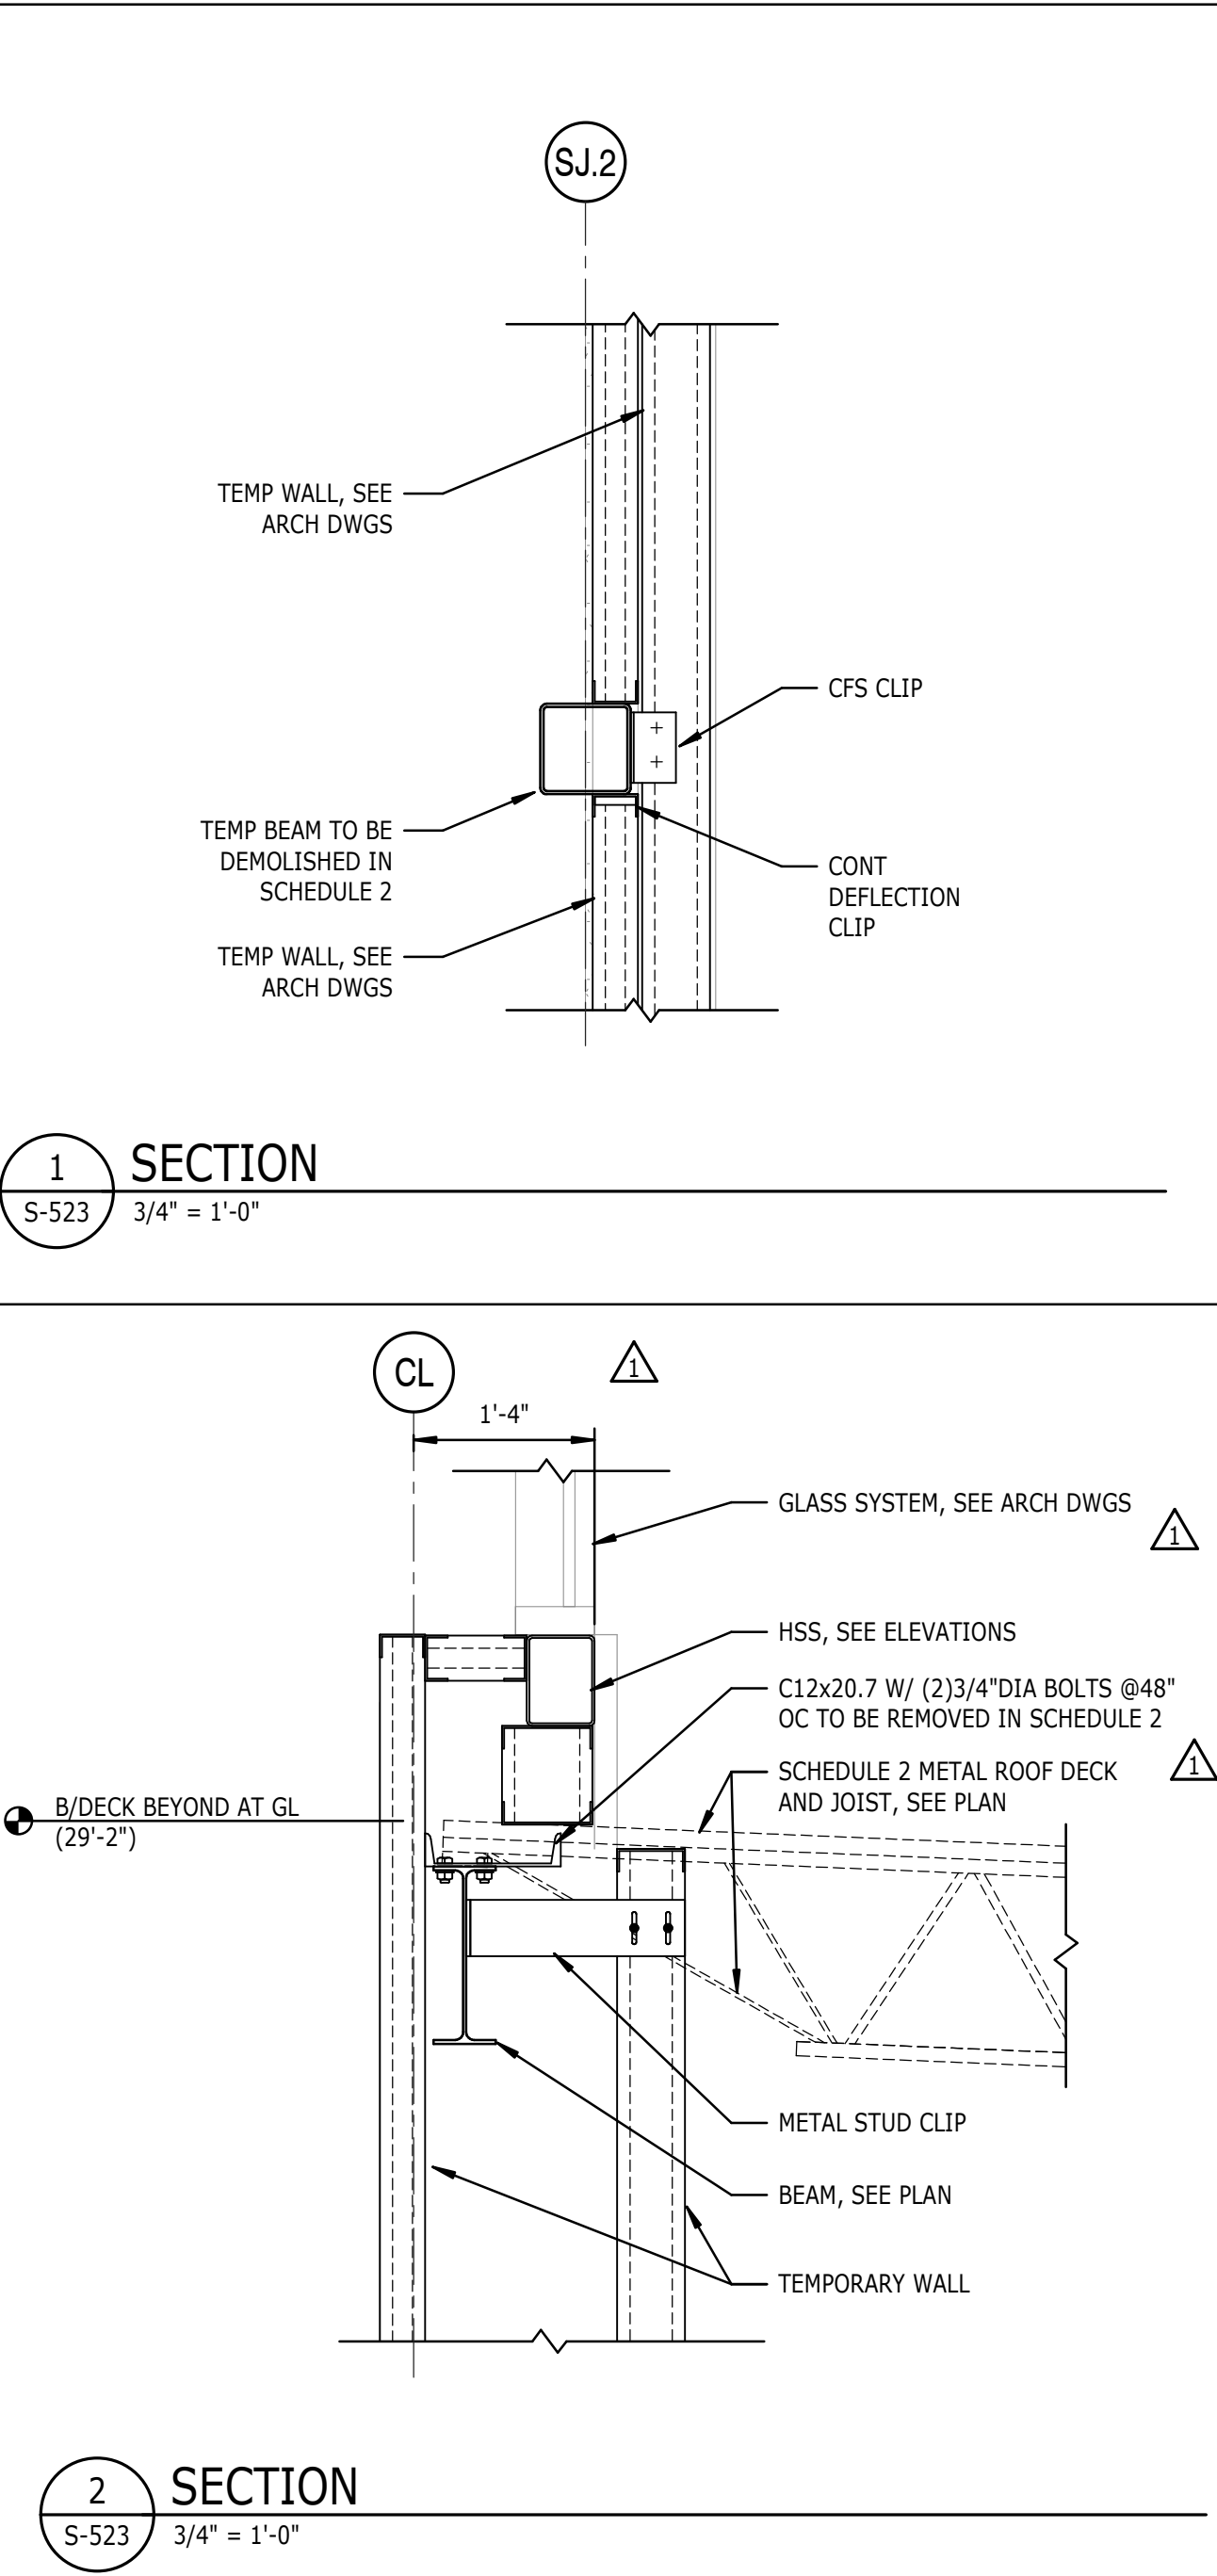


1 SECTION  
S-523 3/4" = 1'-0"

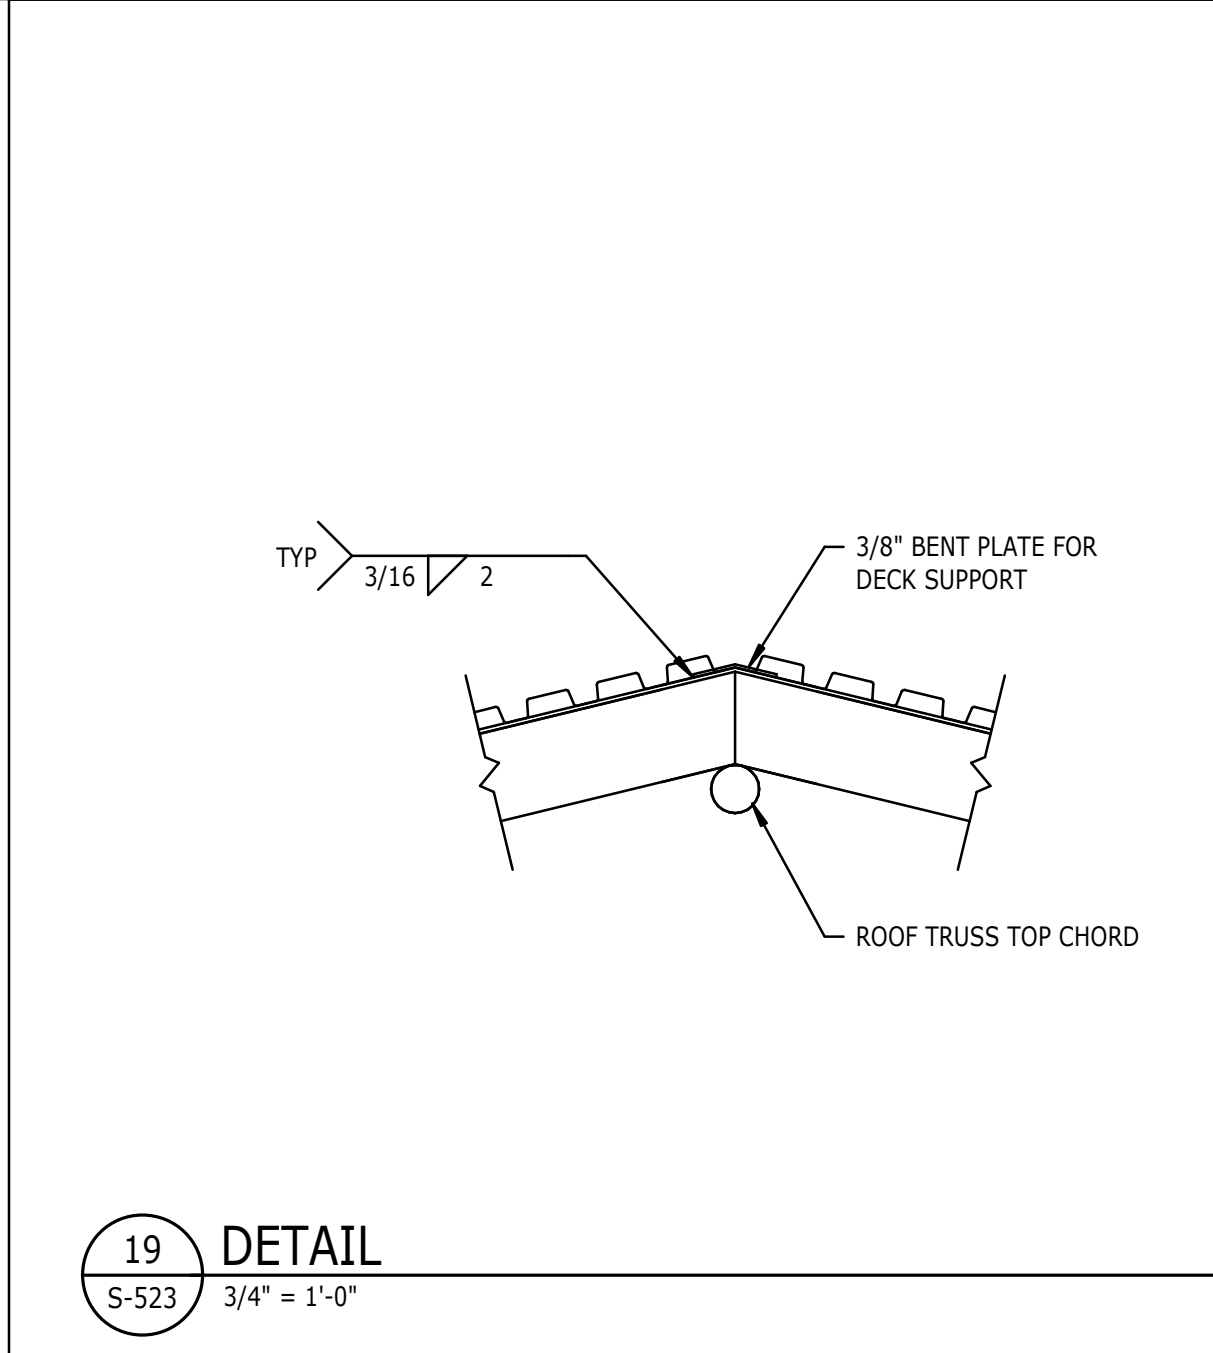


19 DETAIL  
S-523 3/4" = 1'-0"

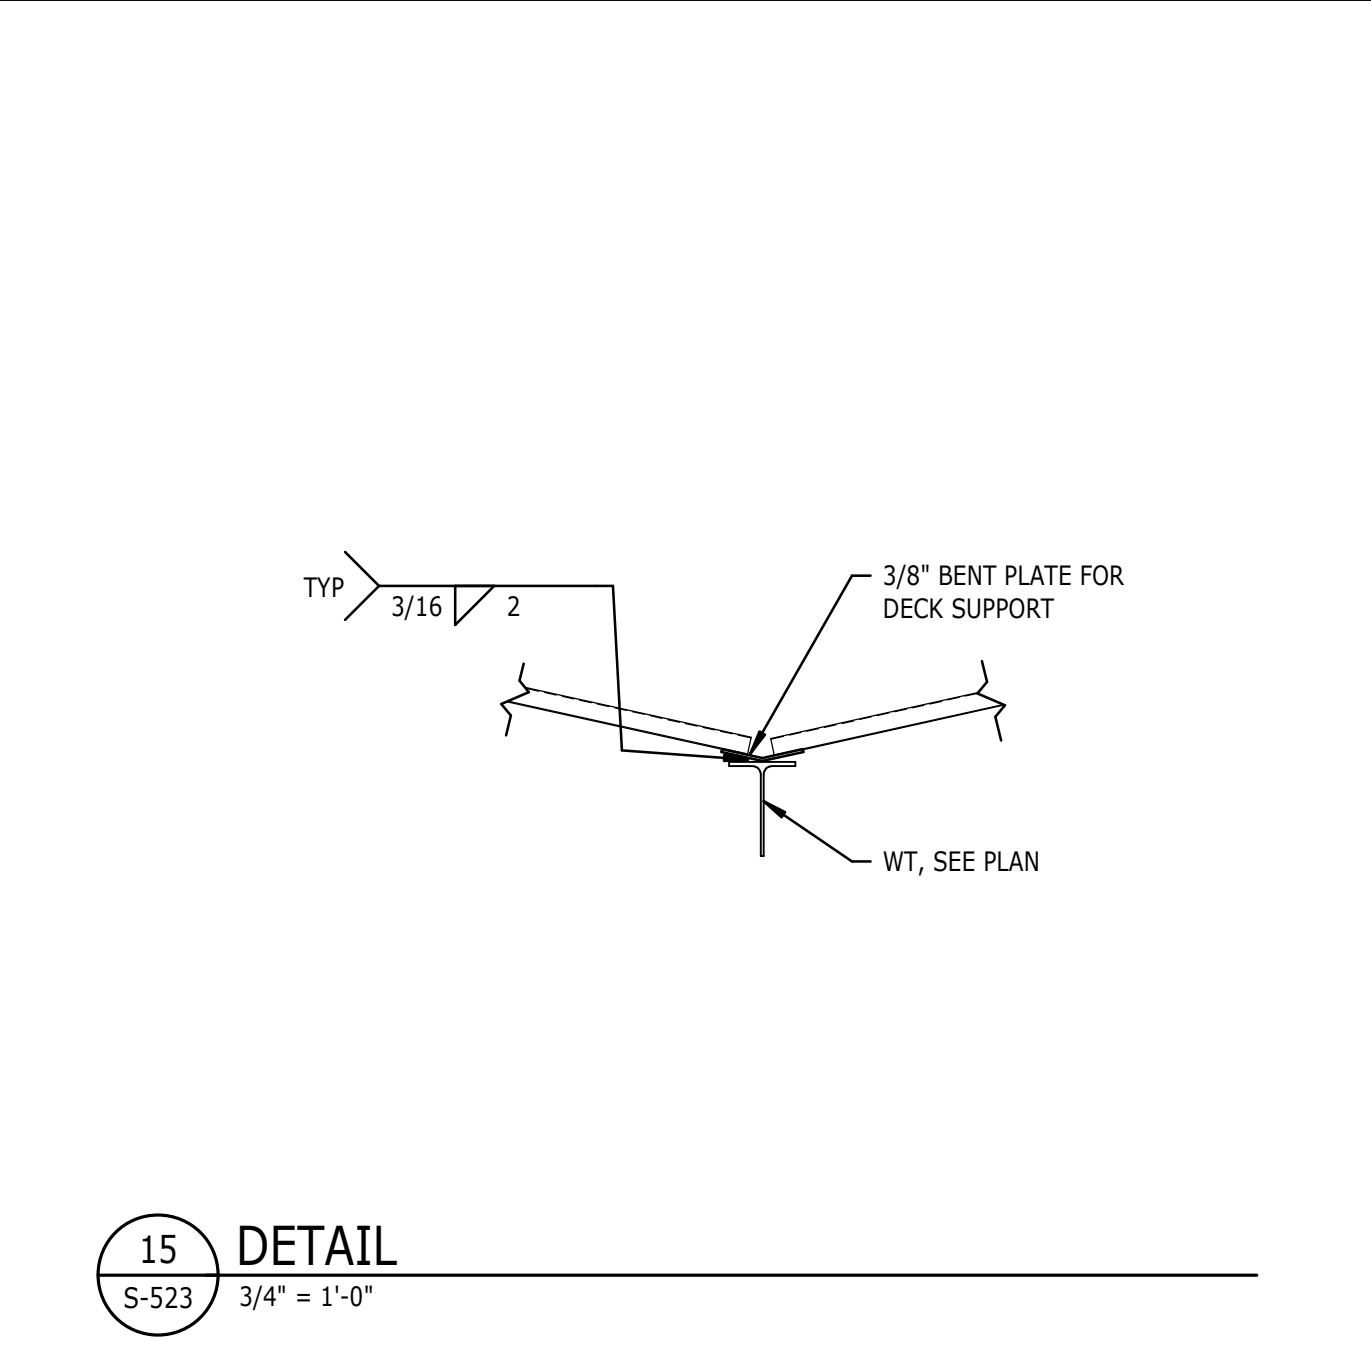


15 DETAIL  
S-523 3/4" = 1'-0"

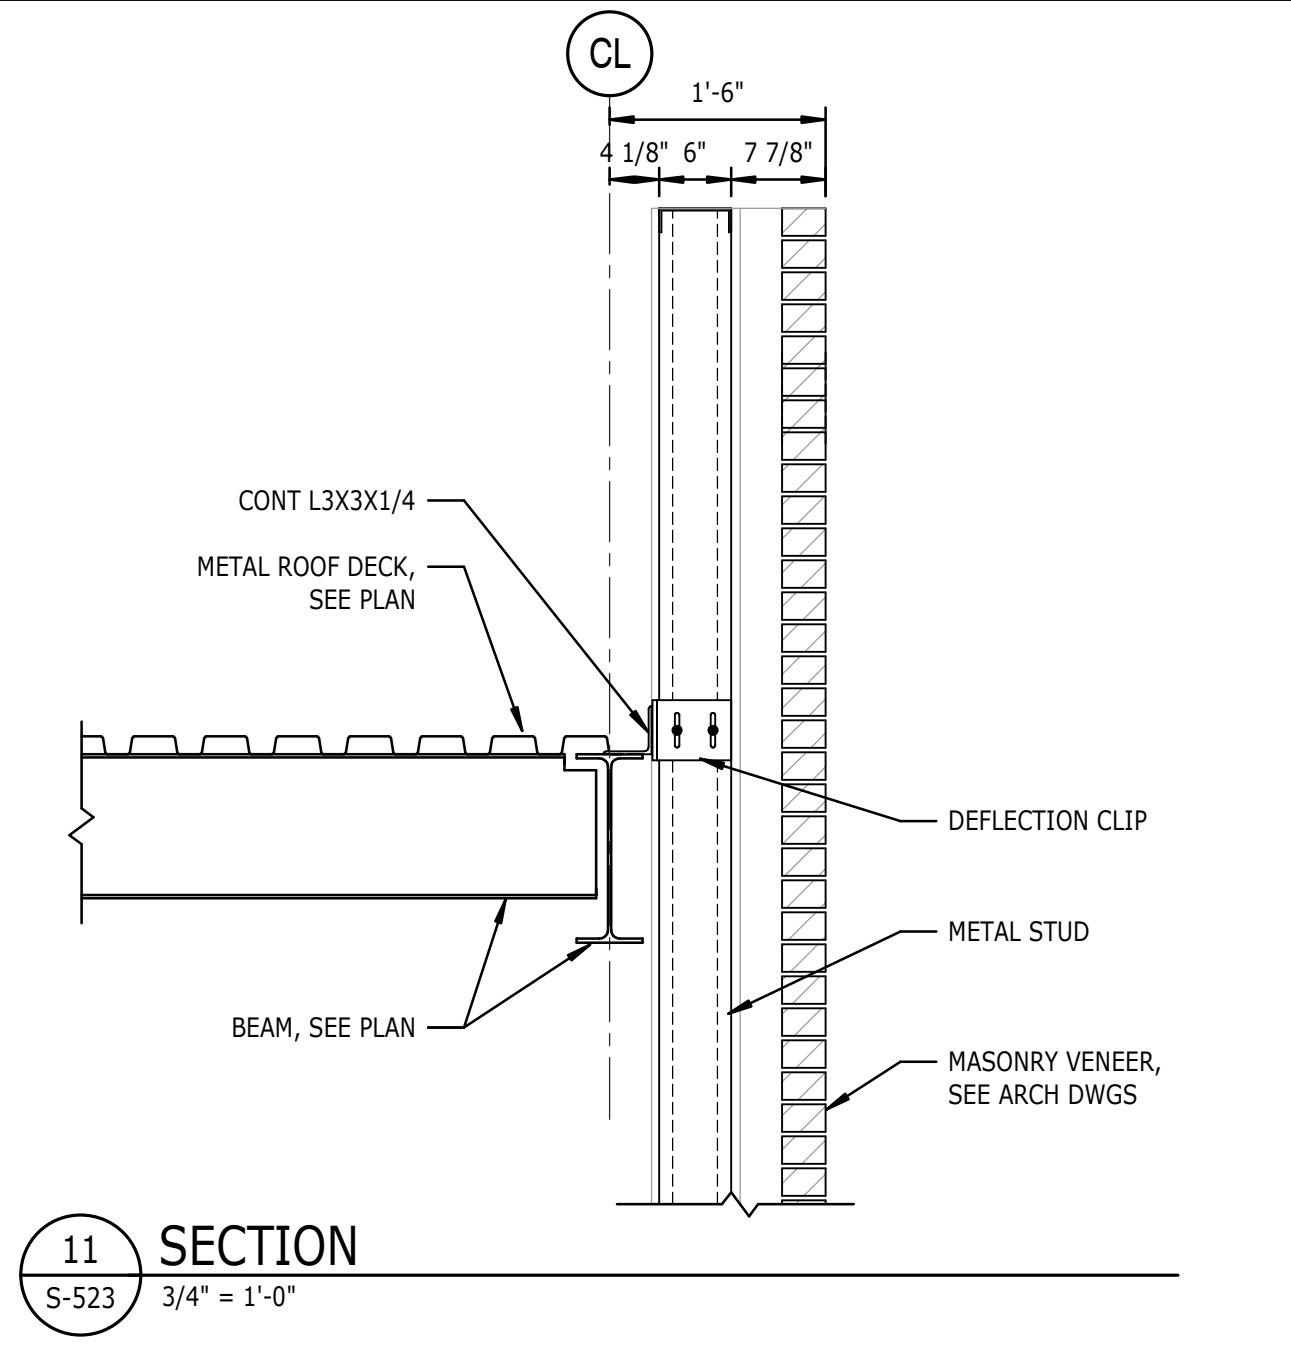


11 SECTION  
S-523 3/4" = 1'-0"

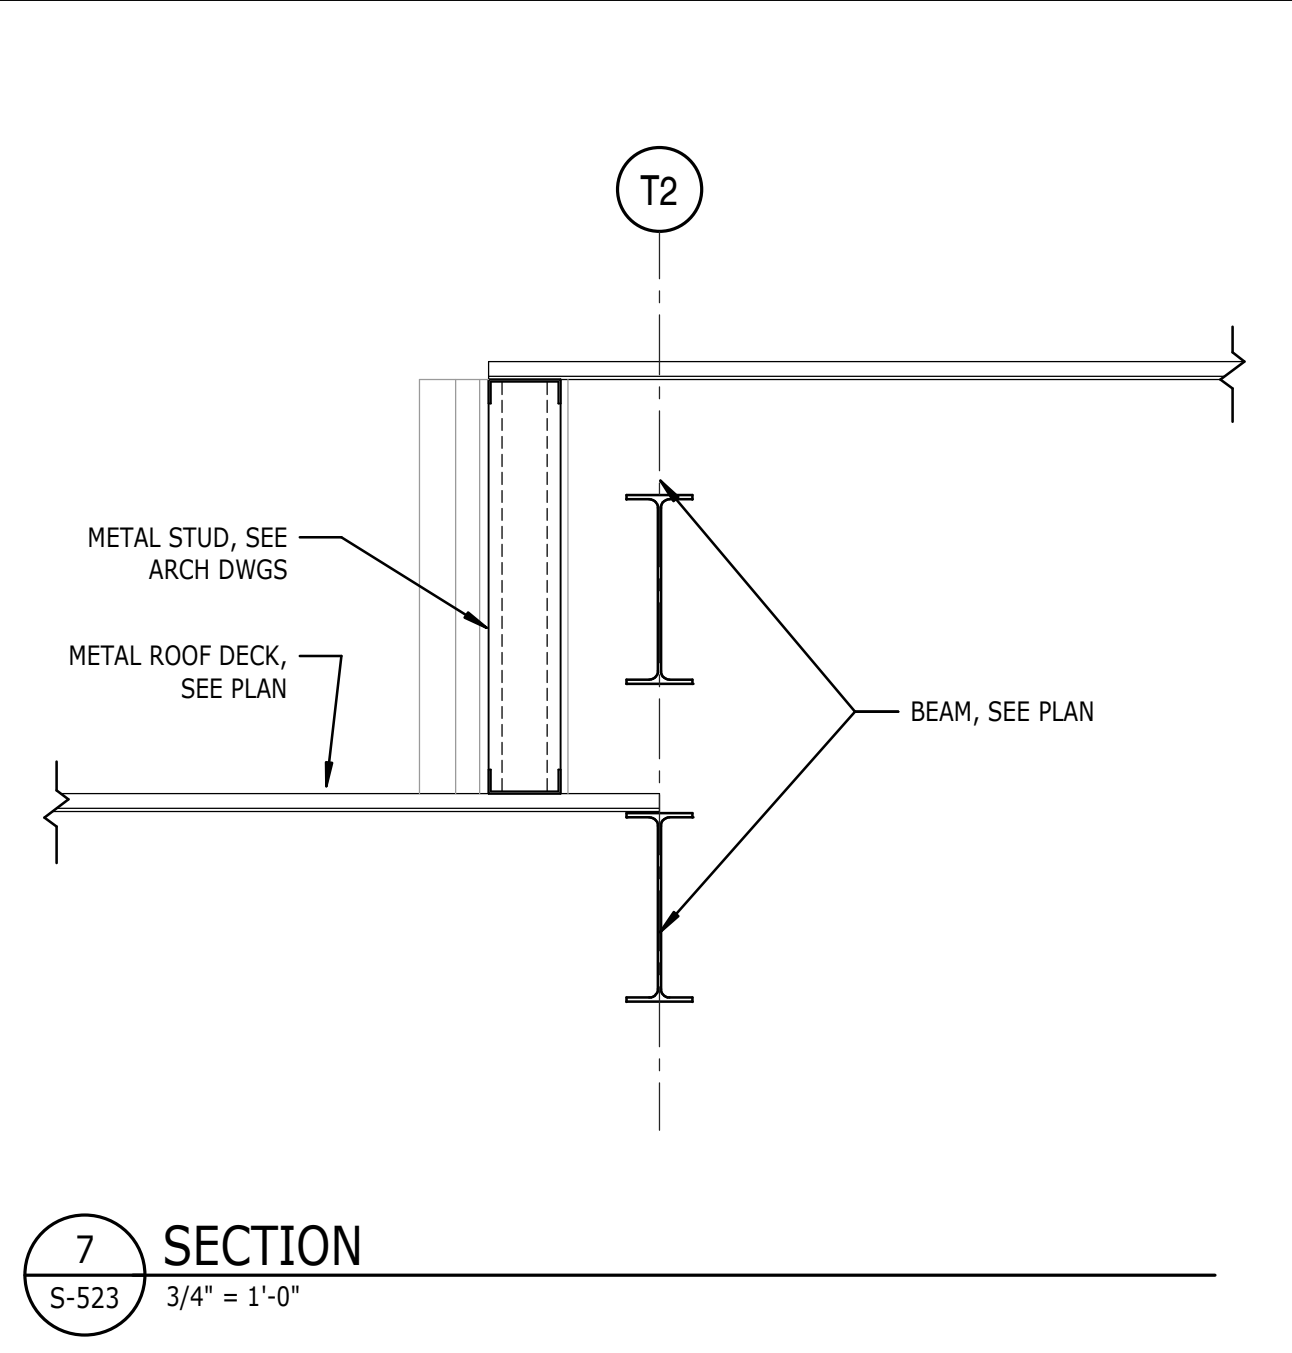


7 SECTION  
S-523 3/4" = 1'-0"

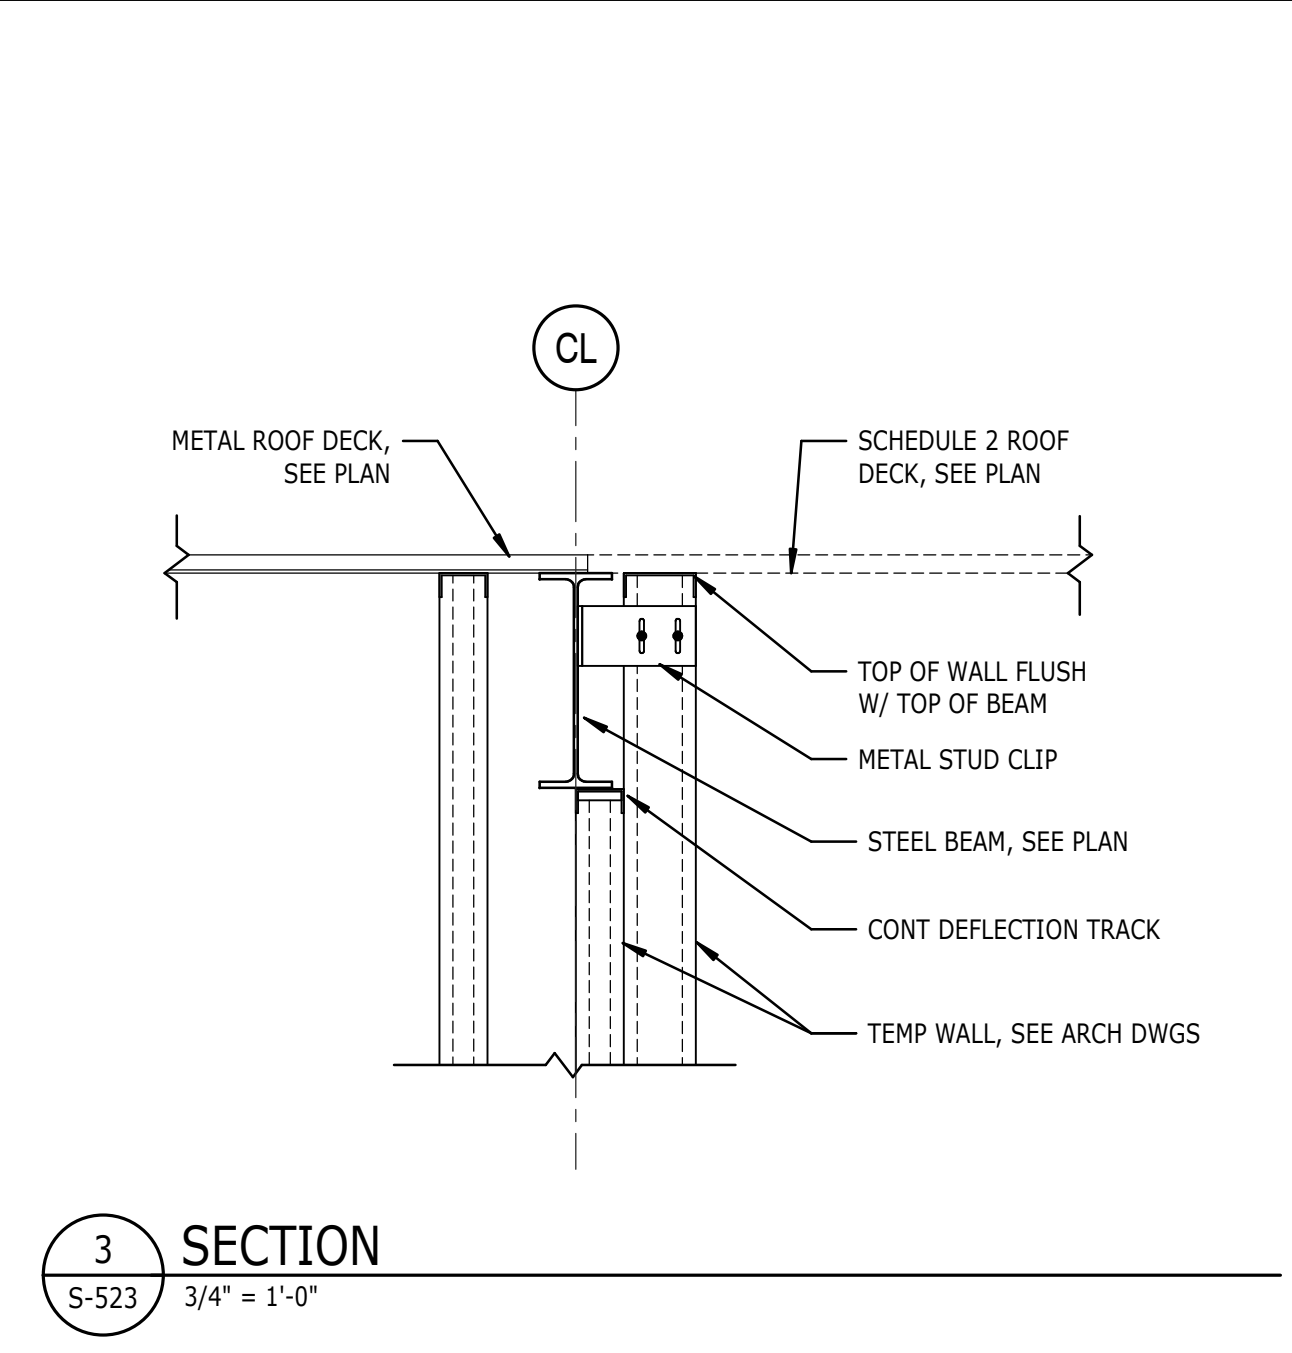


3 SECTION  
S-523 3/4" = 1'-0"

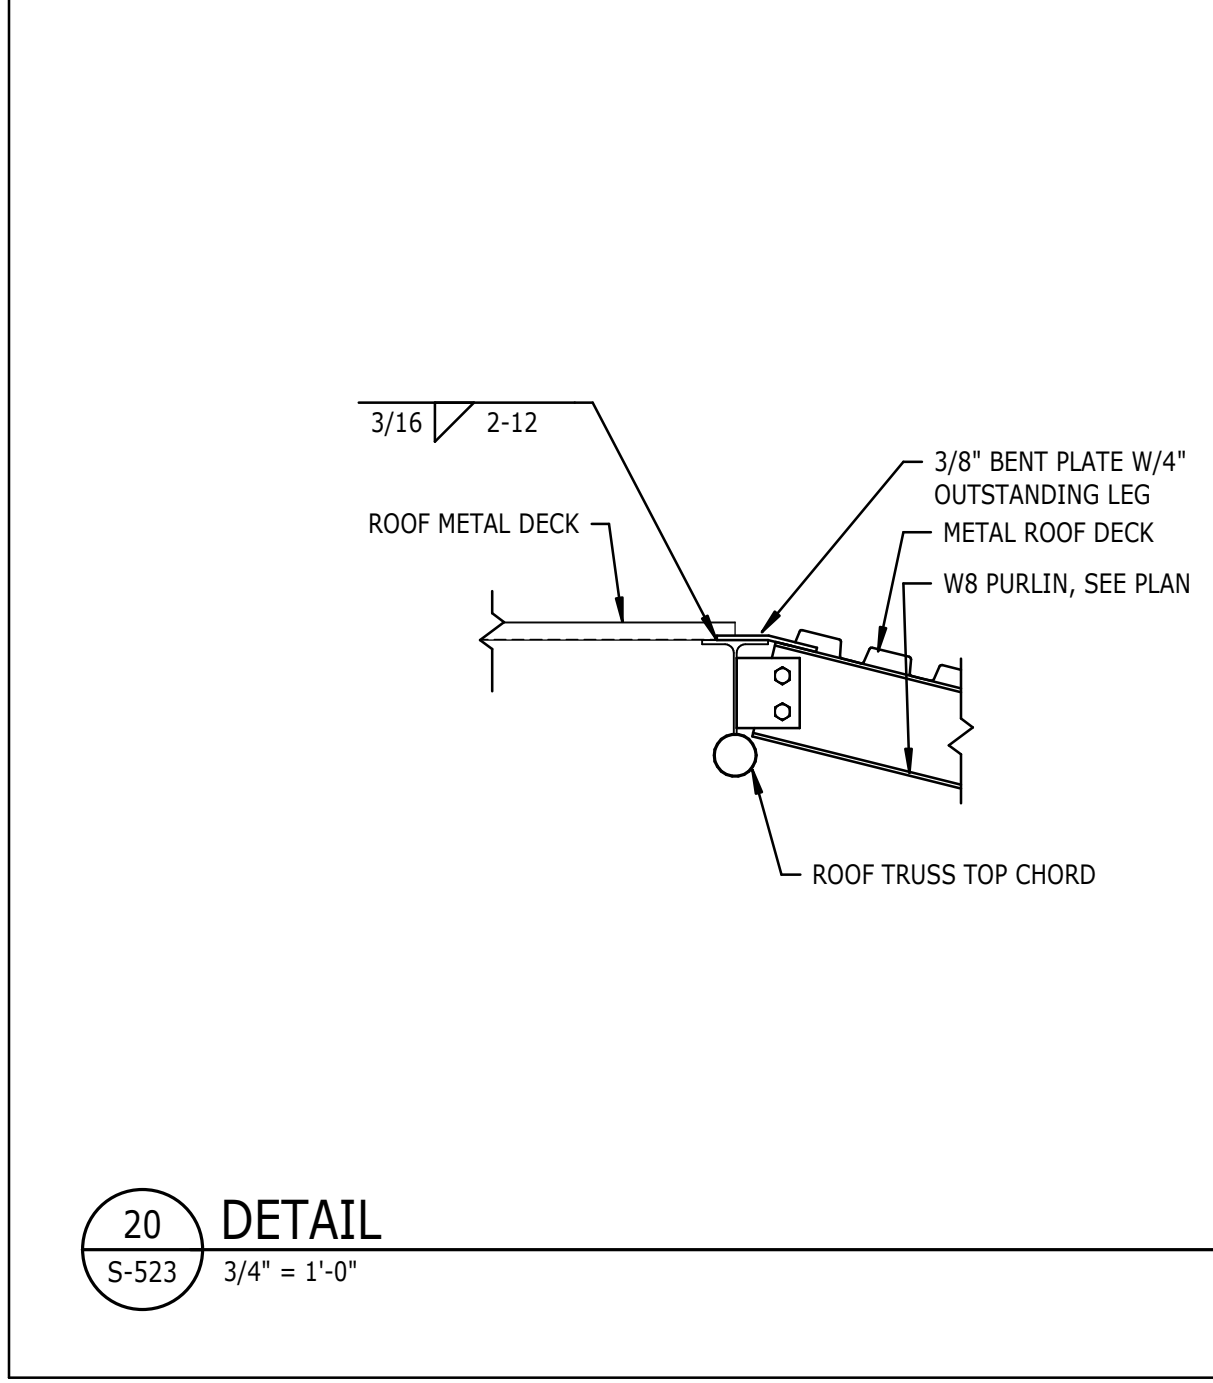


20 DETAIL  
S-523 3/4" = 1'-0"

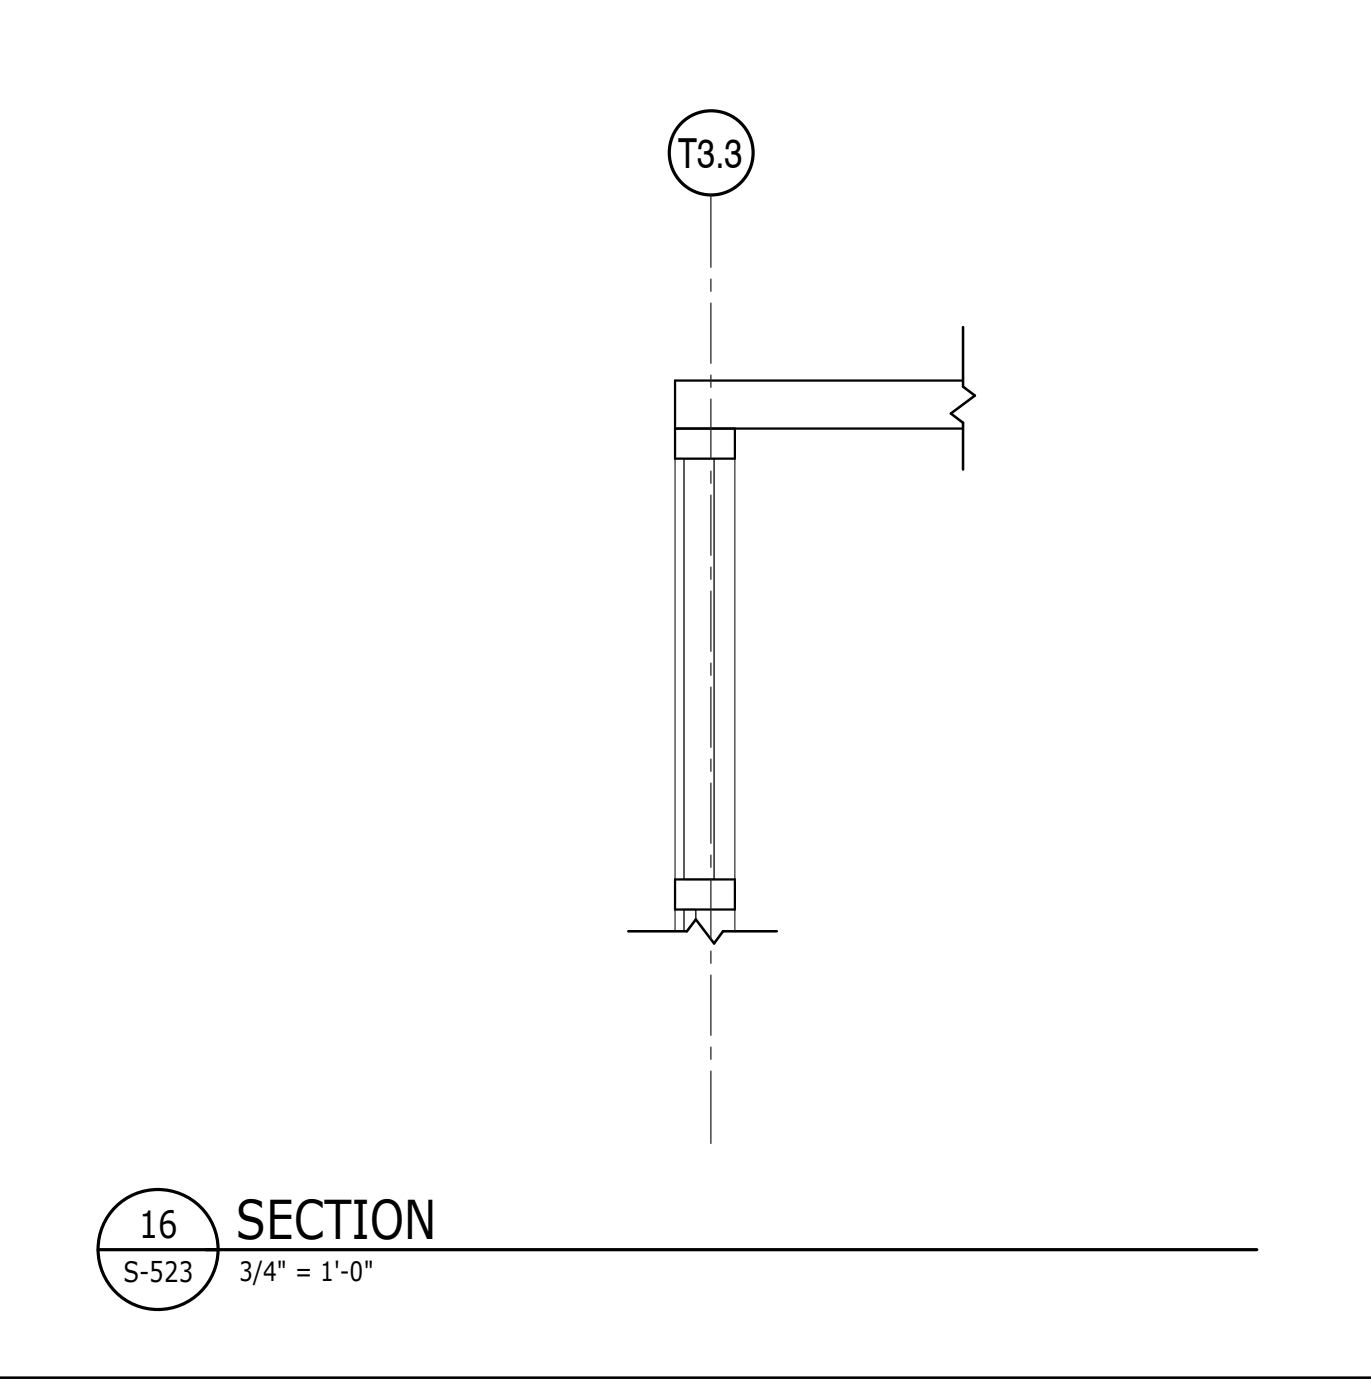


16 SECTION  
S-523 3/4" = 1'-0"

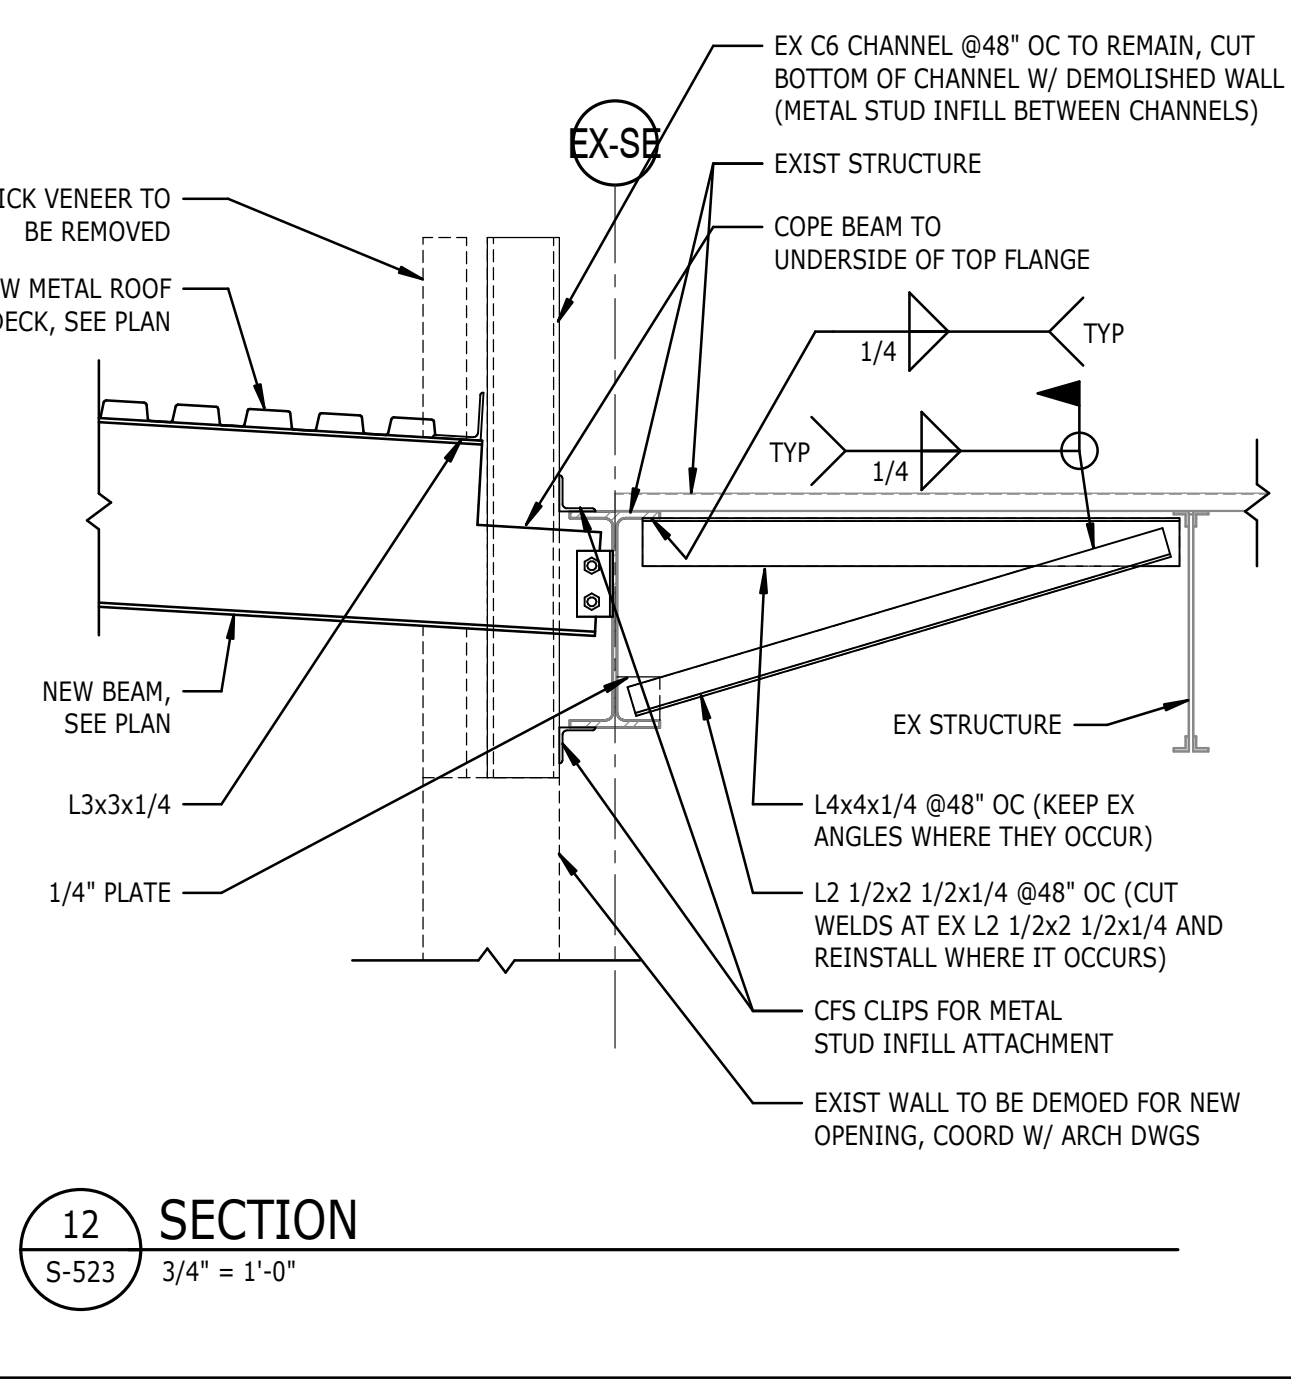

12 SECTION  
S-523 3/4" = 1'-0"

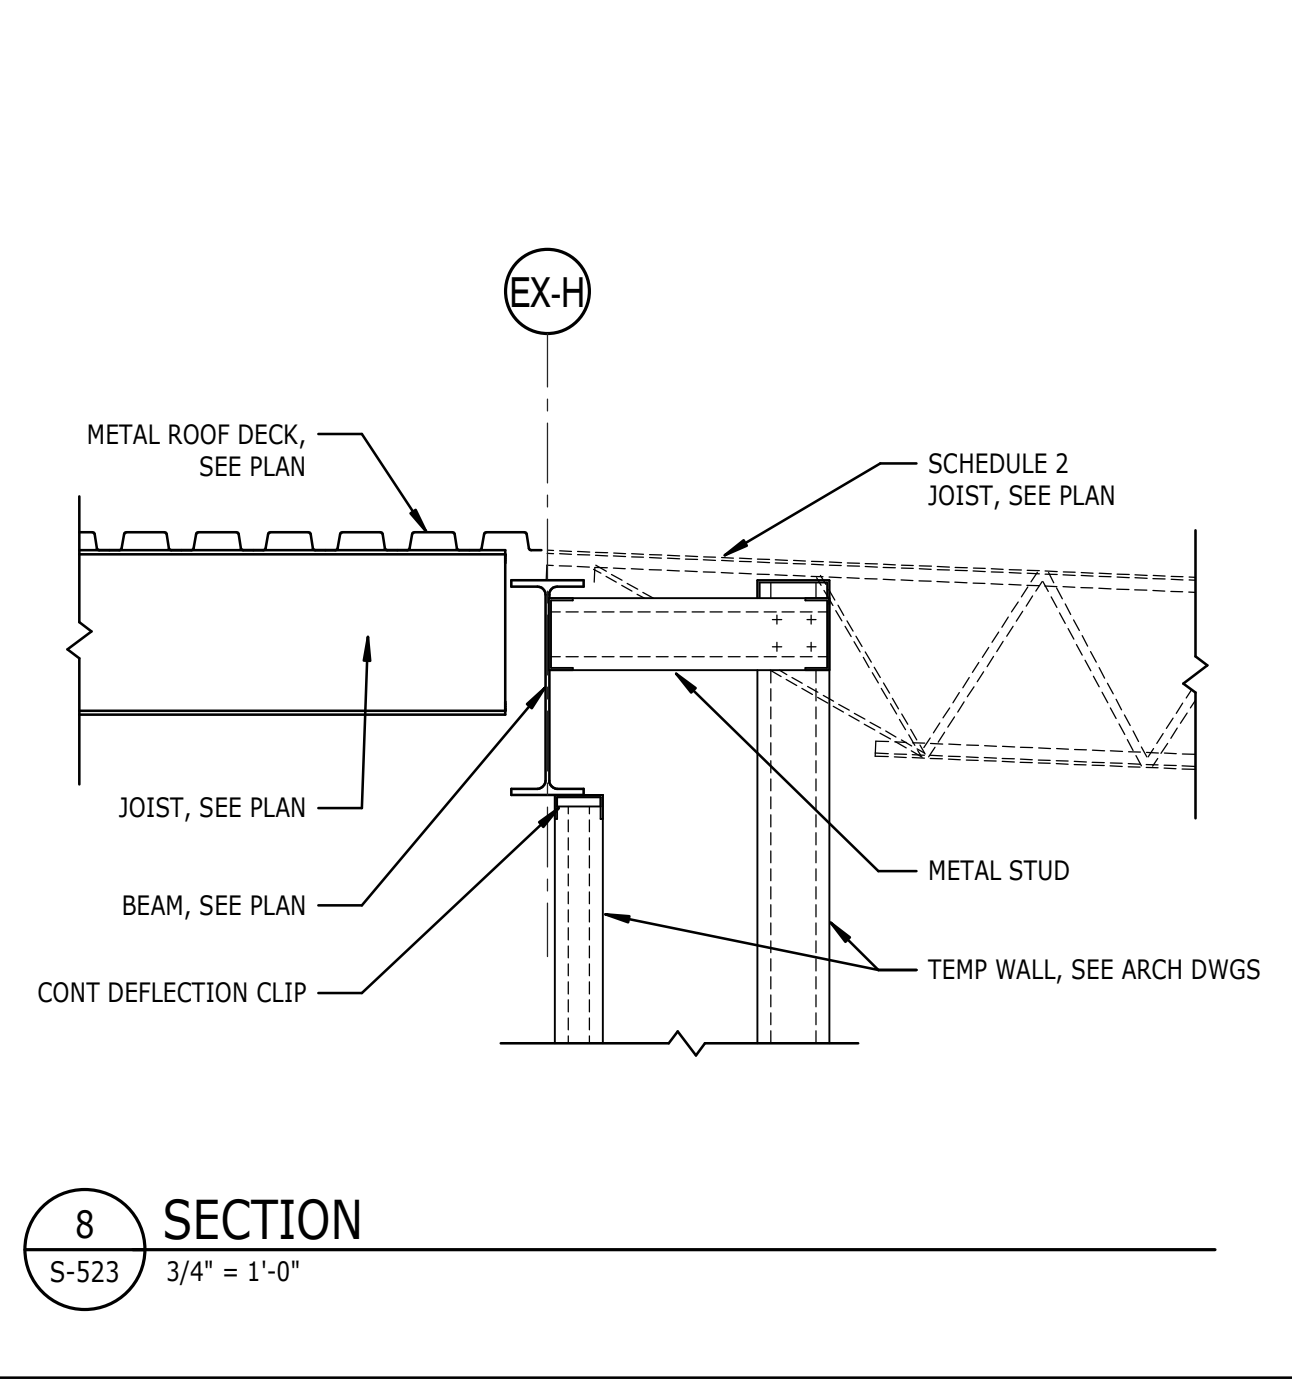

8 SECTION  
S-523 3/4" = 1'-0"


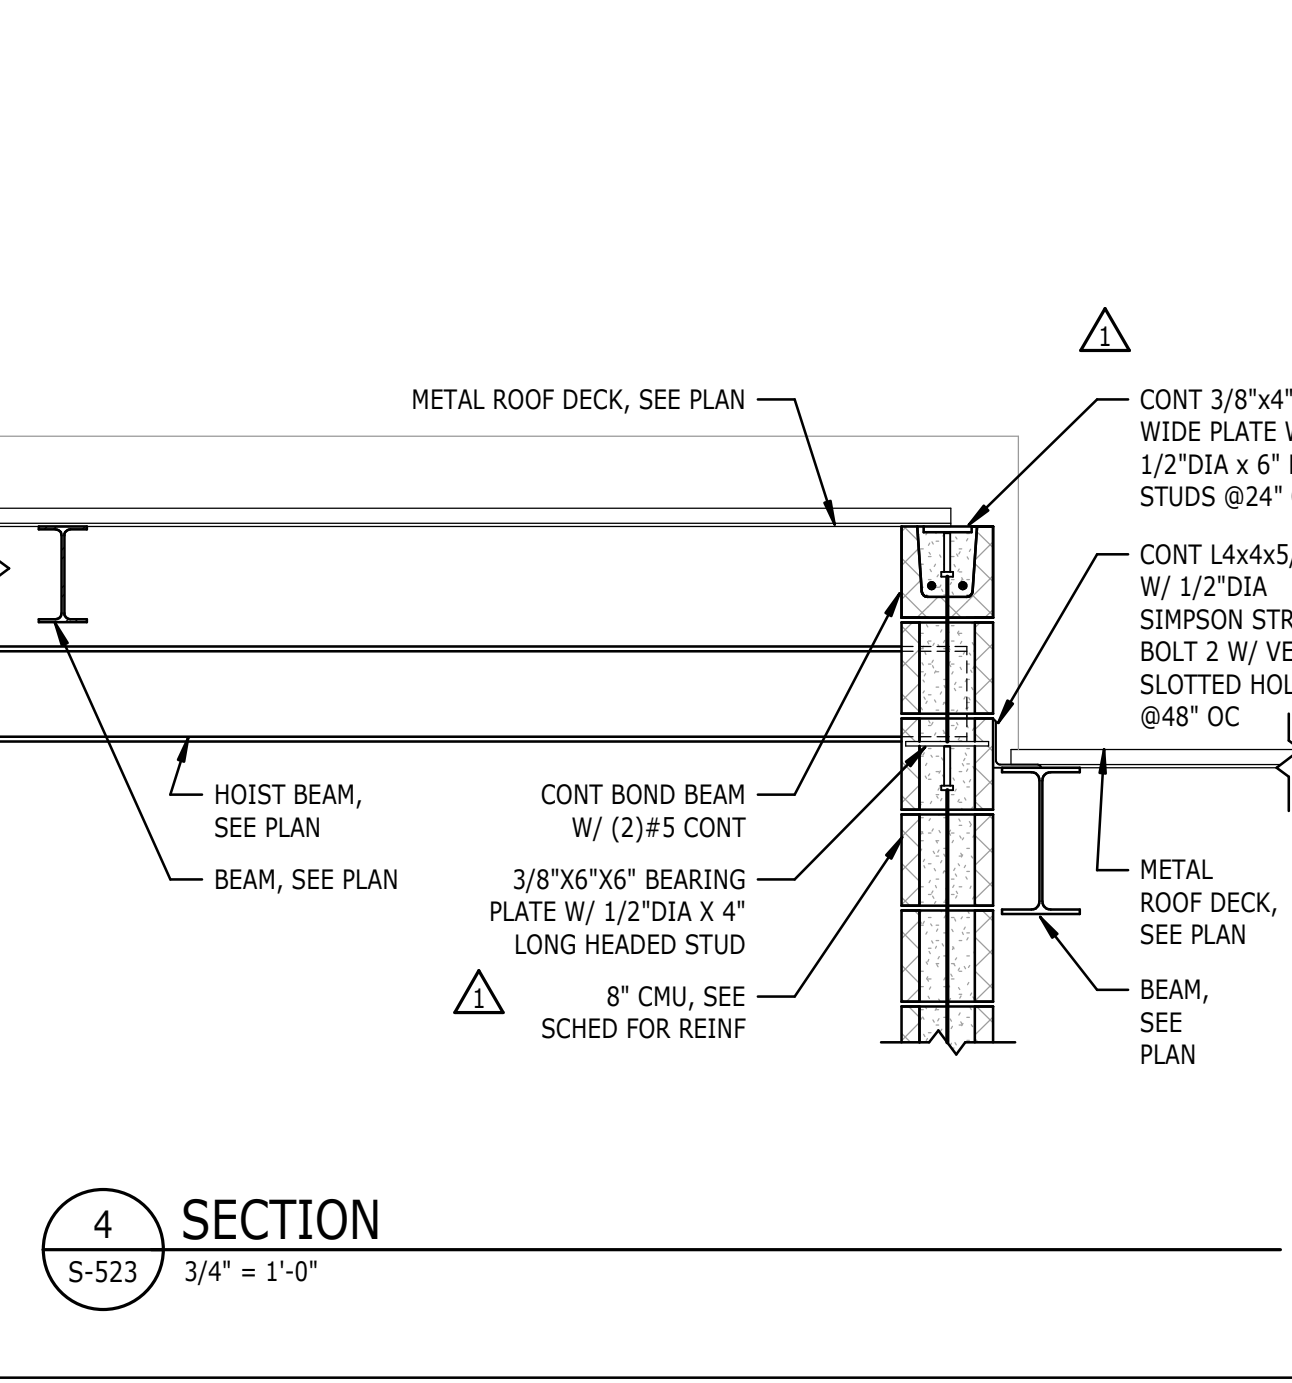


4 SECTION  
S-523 3/4" = 1'-0"


REVISIONS

1	7/12/19	AD-01
3	7/30/19	AD-03




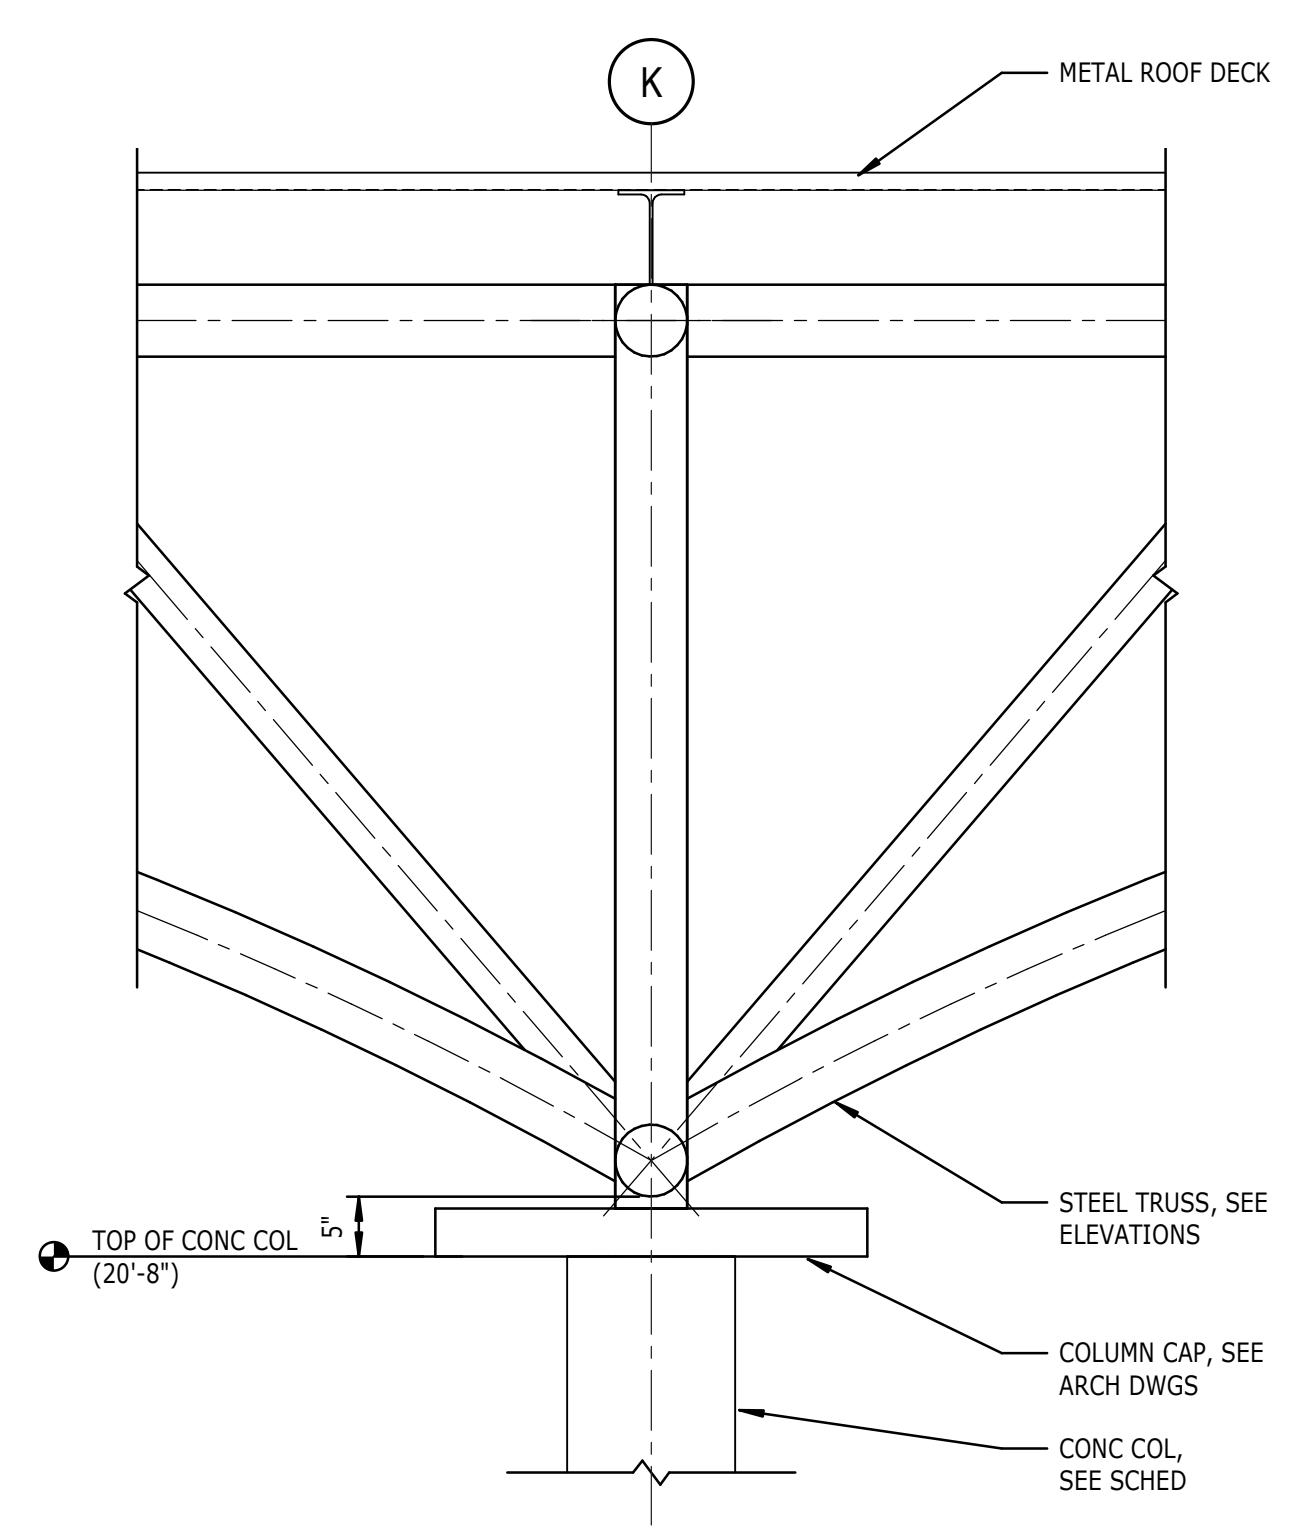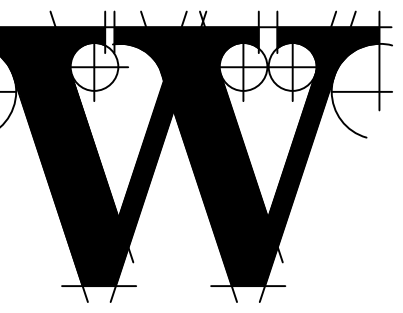


**1 SECTION**  
S-524 3/4" = 1'-0"

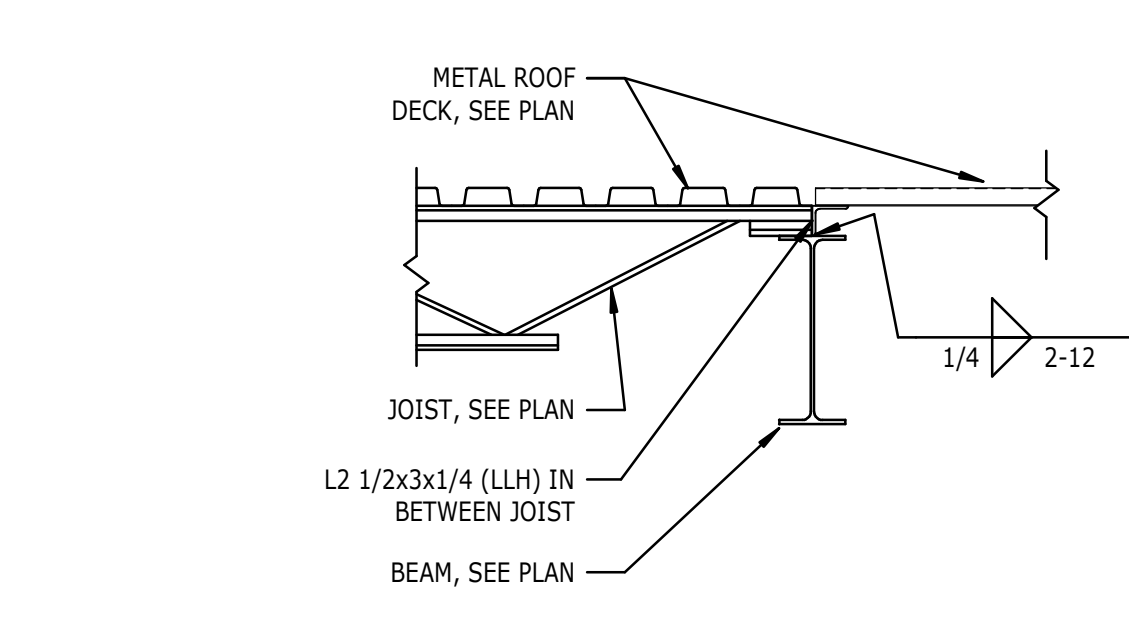


**5 SECTION**  
S-524 3/4" = 1'-0"

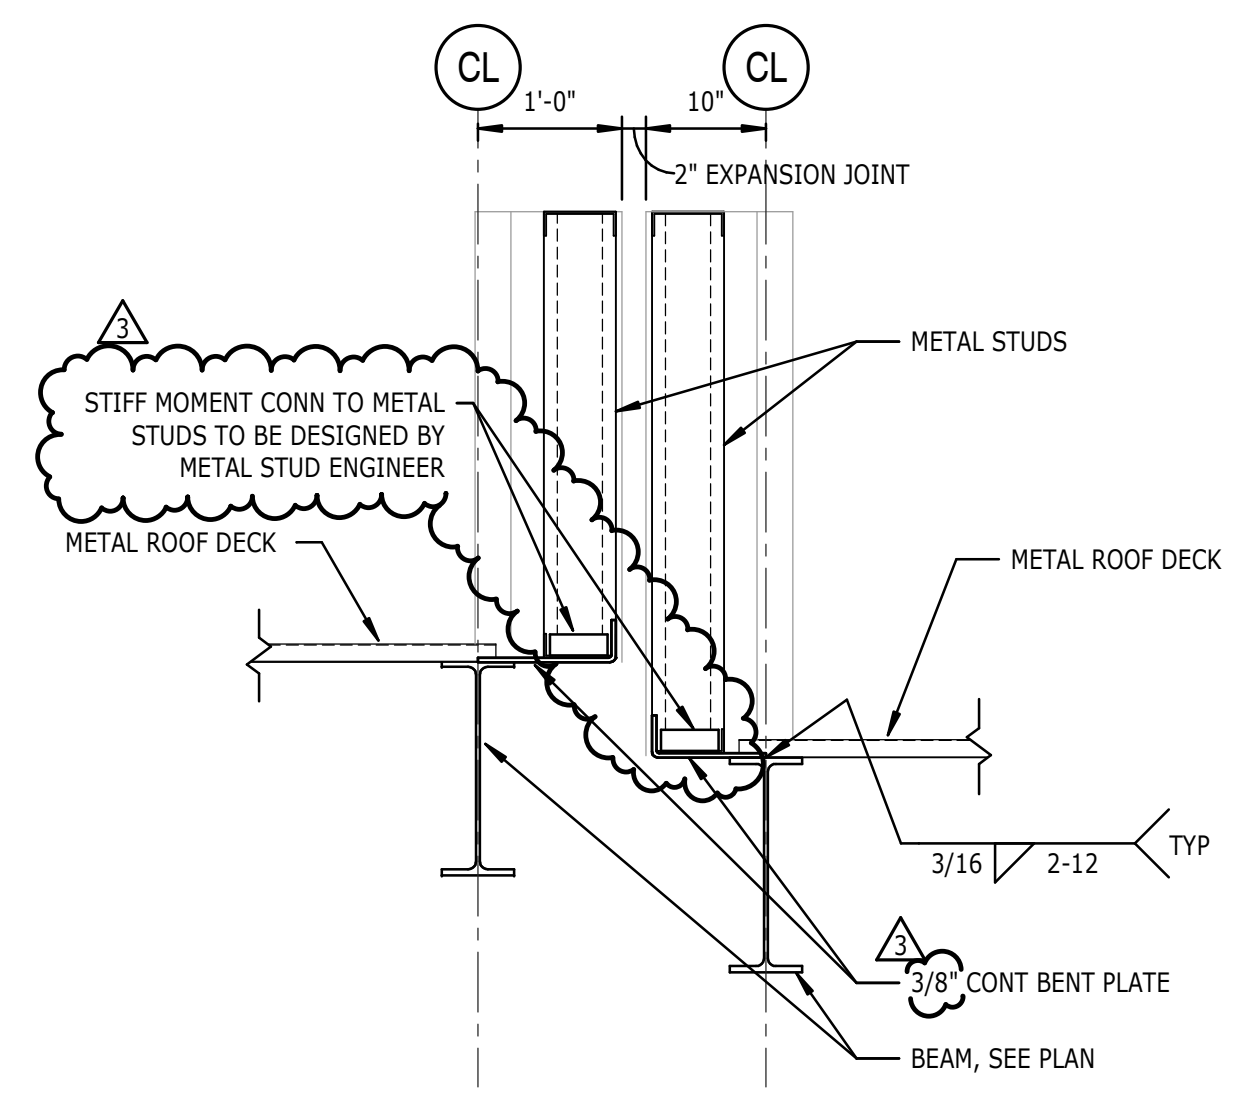


**6 SECTION**  
S-524 3/4" = 1'-0"

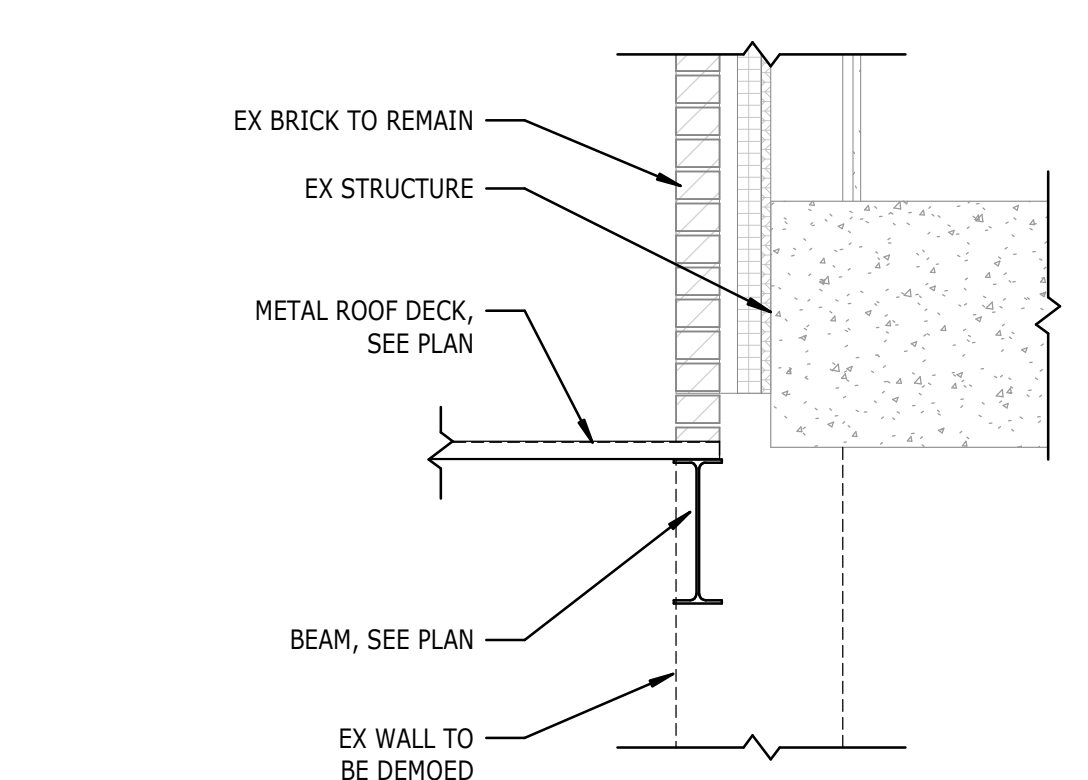


**7 SECTION**  
S-524 3/4" = 1'-0"

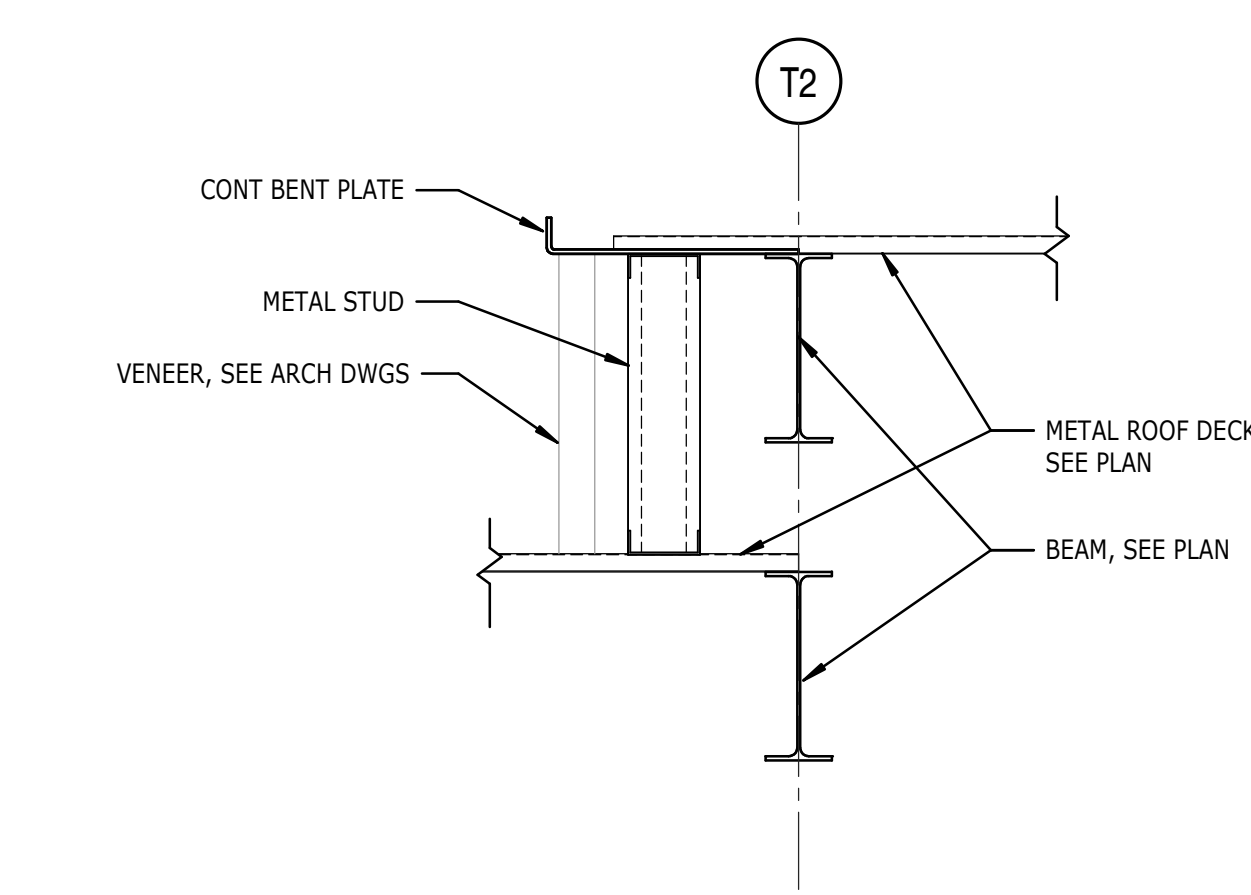


**8 SECTION**  
S-524 3/4" = 1'-0"

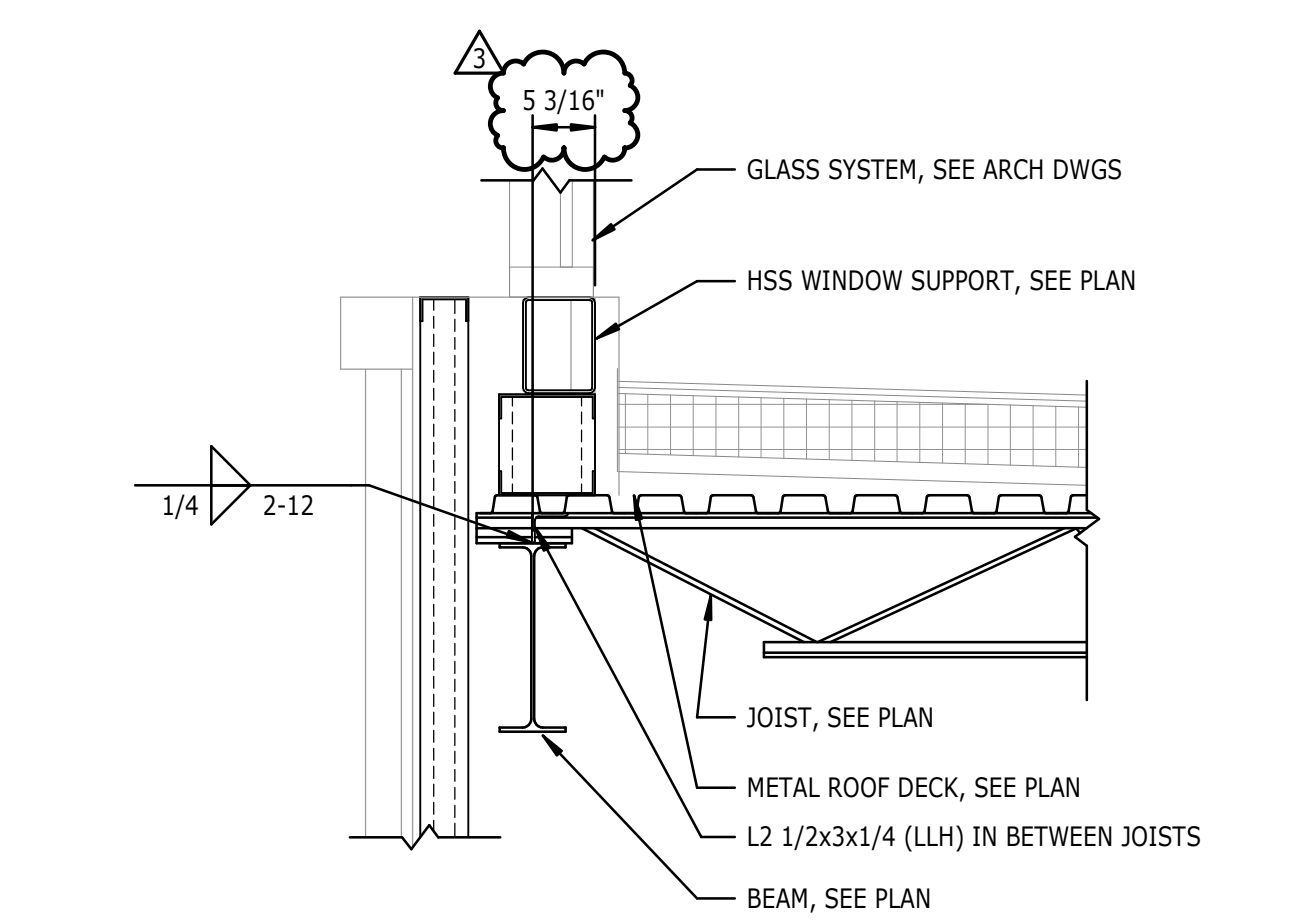


**3 SECTION**  
S-524 3/4" = 1'-0"

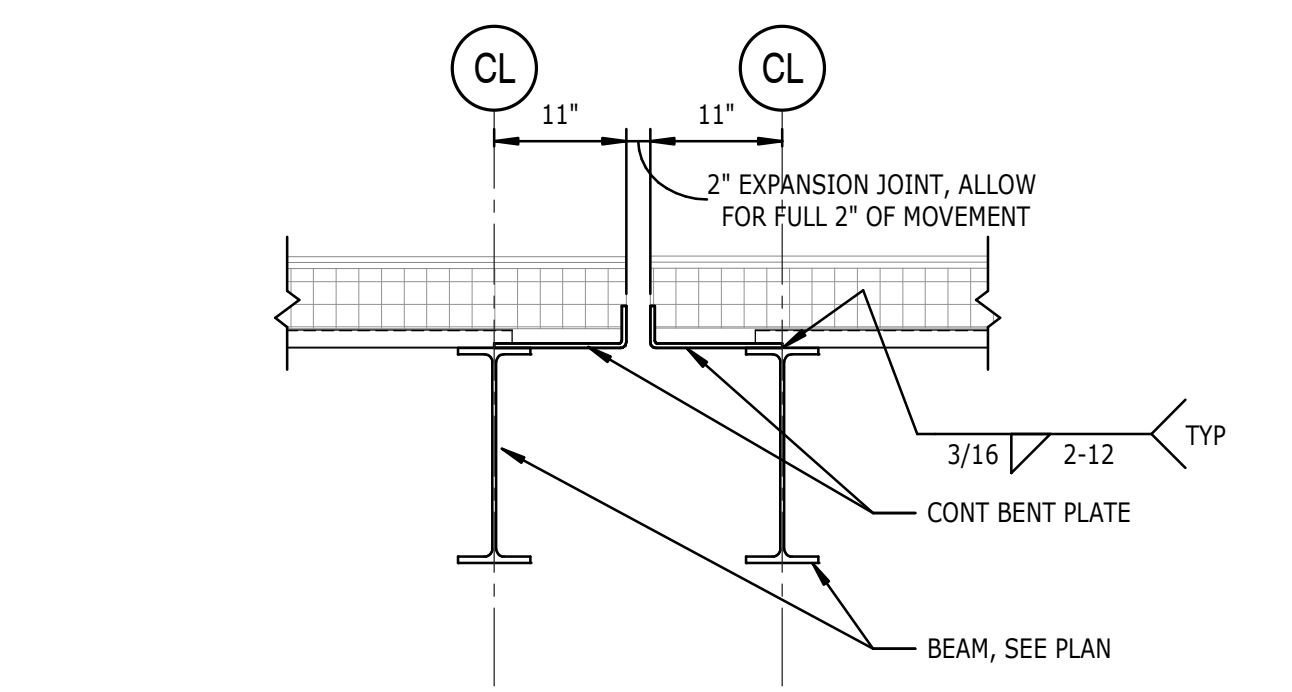


**4 SECTION**  
S-524 3/4" = 1'-0"

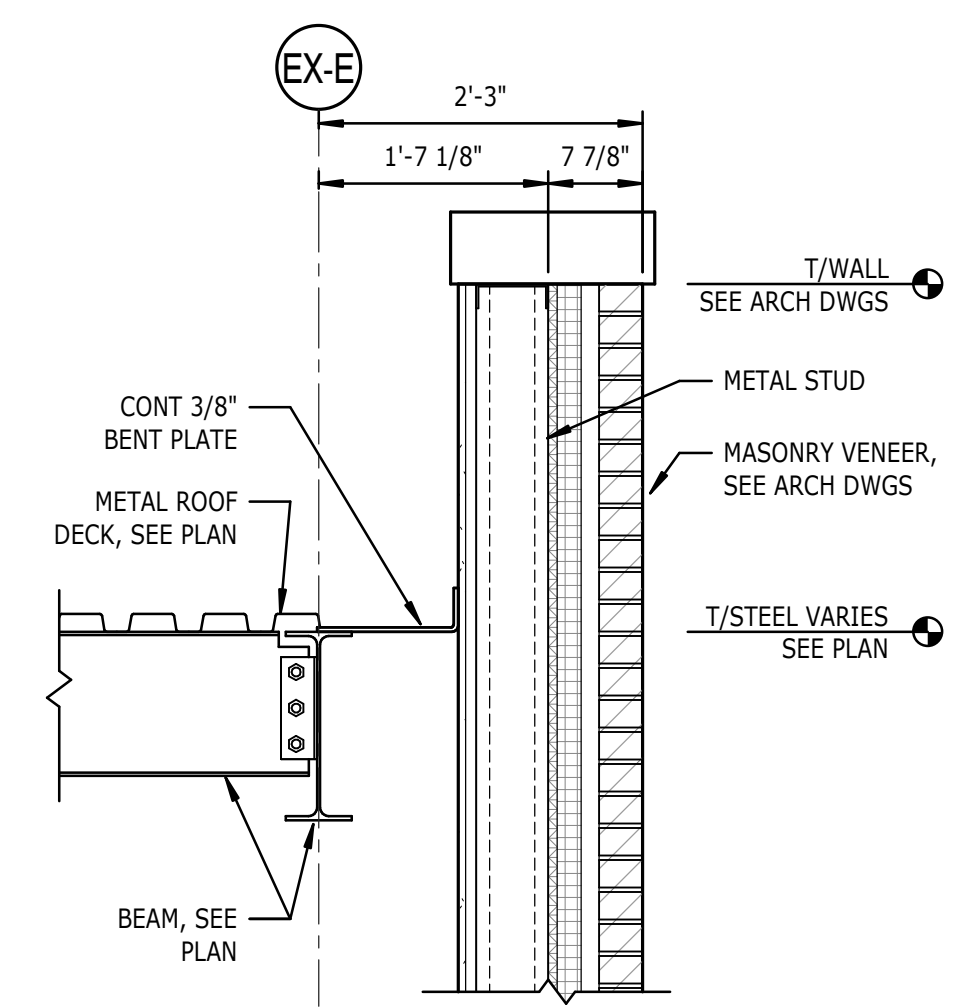


**9 SECTION**  
S-524 3/4" = 1'-0"

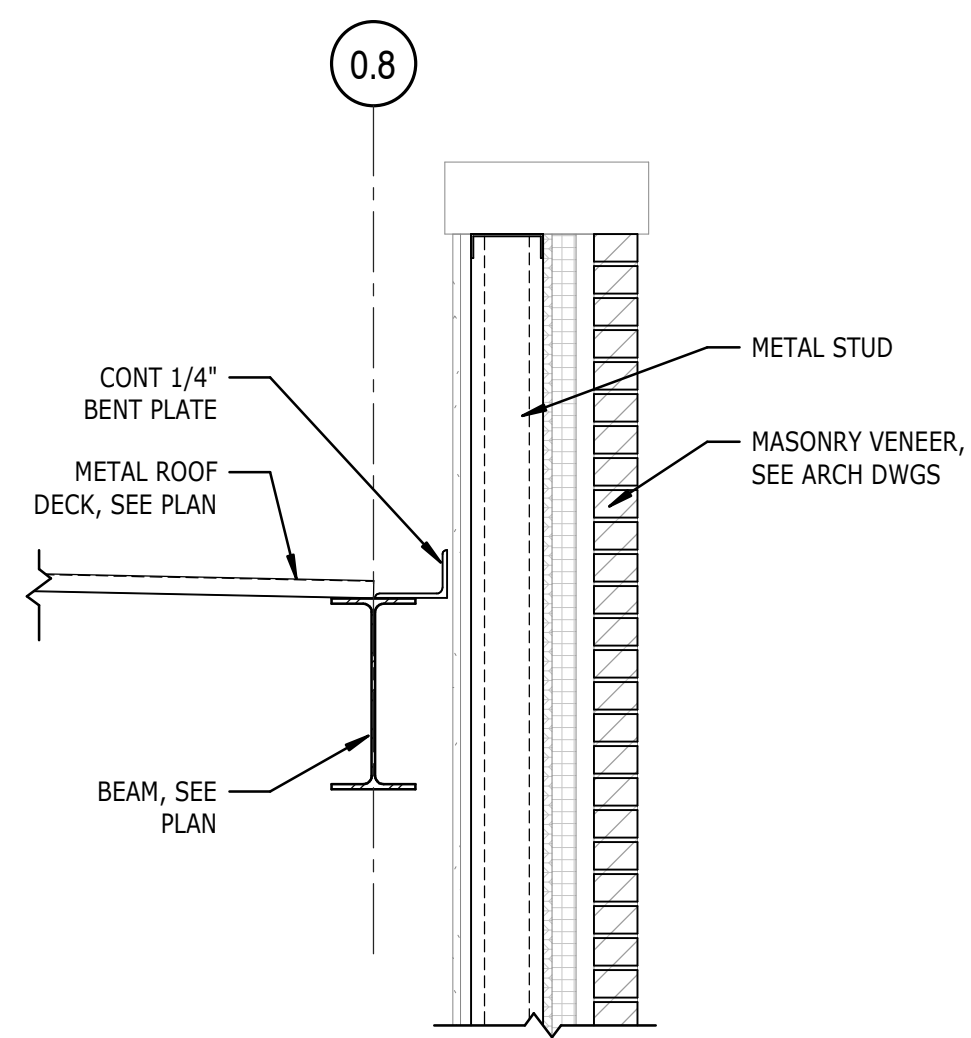


**10 SECTION**  
S-524 3/4" = 1'-0"

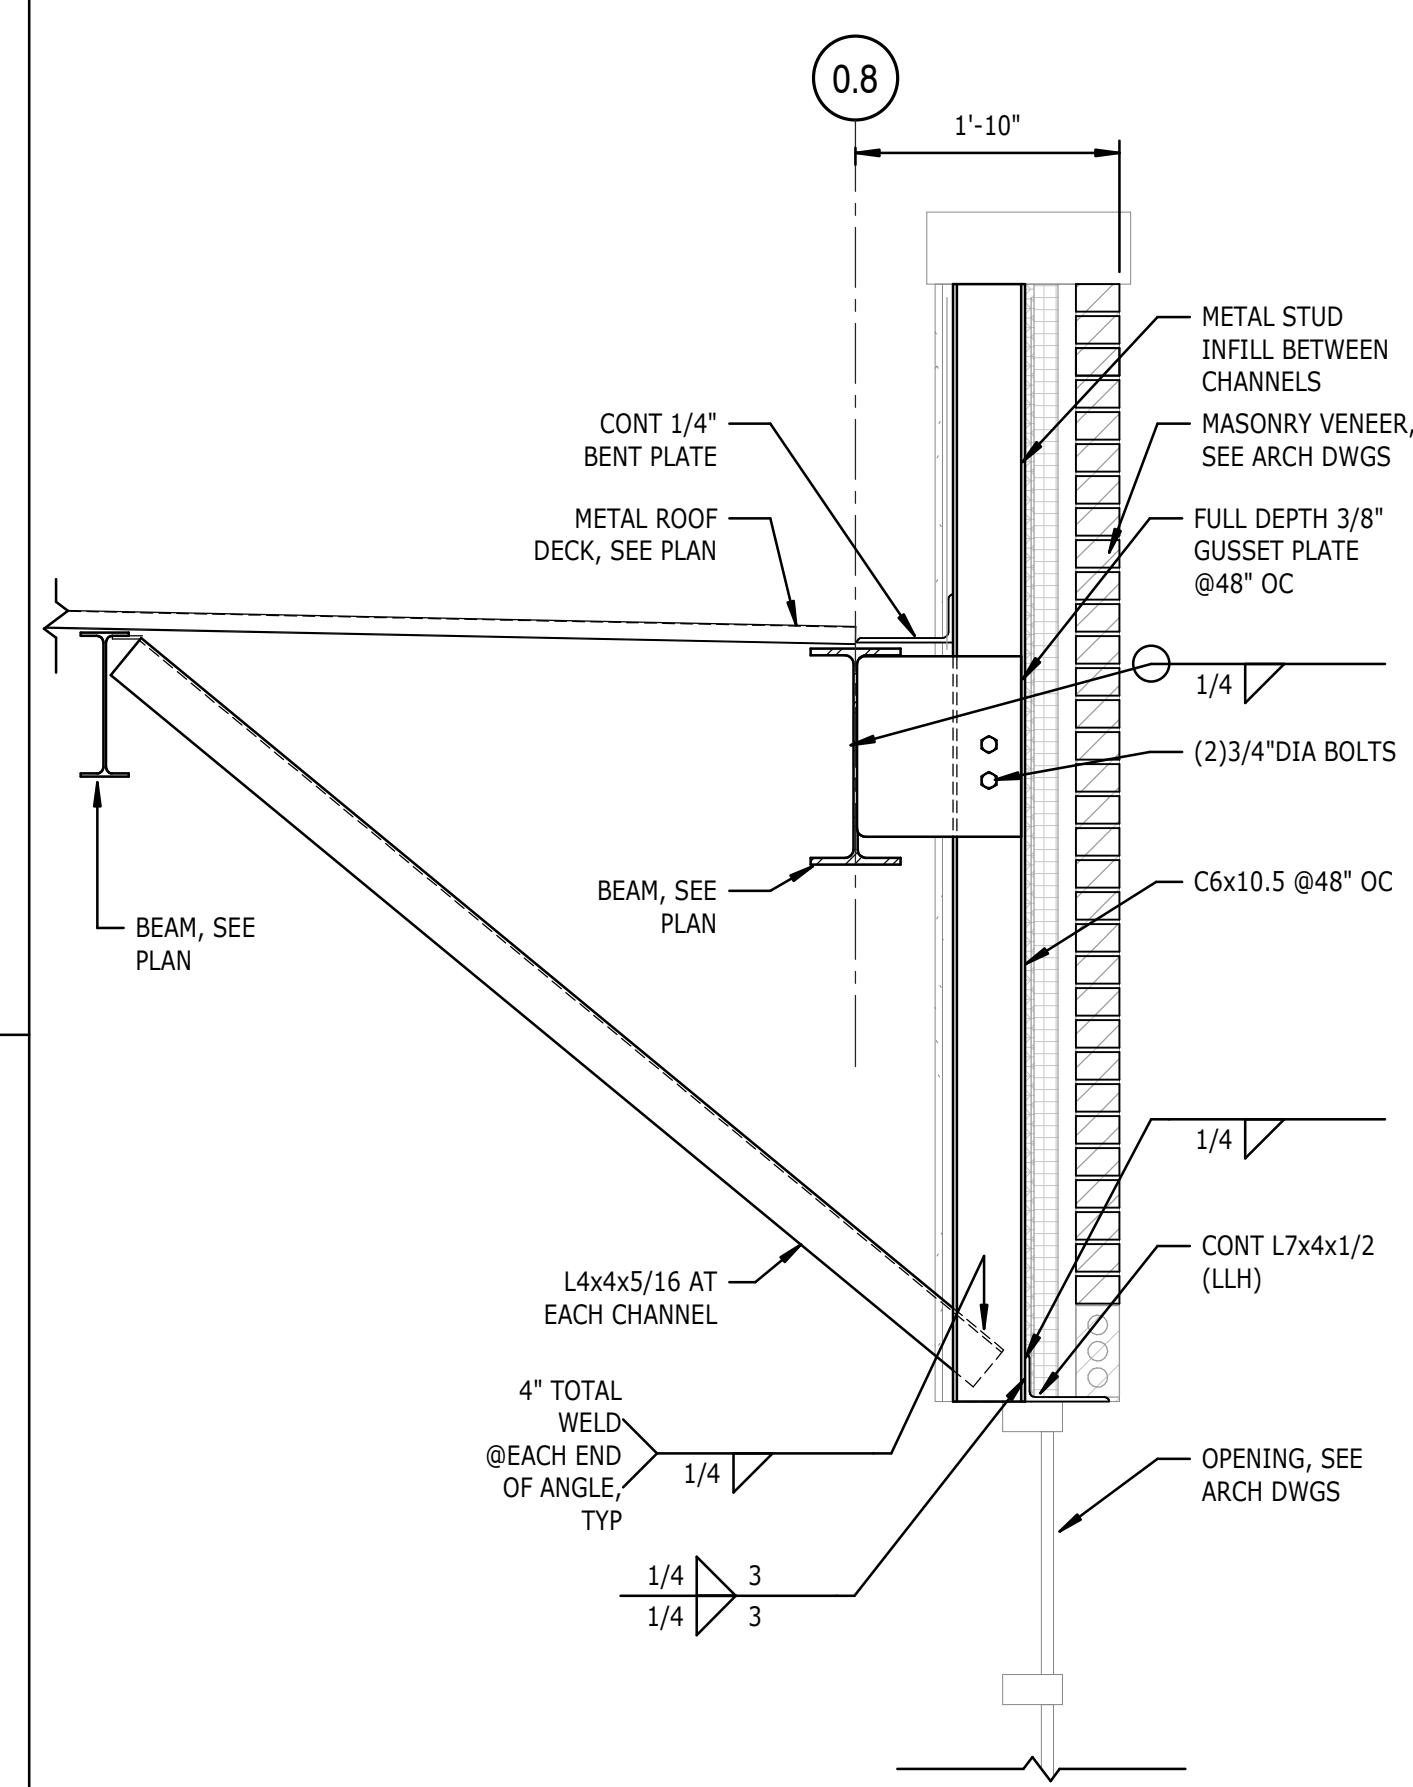


**12 SECTION**  
S-524 3/4" = 1'-0"

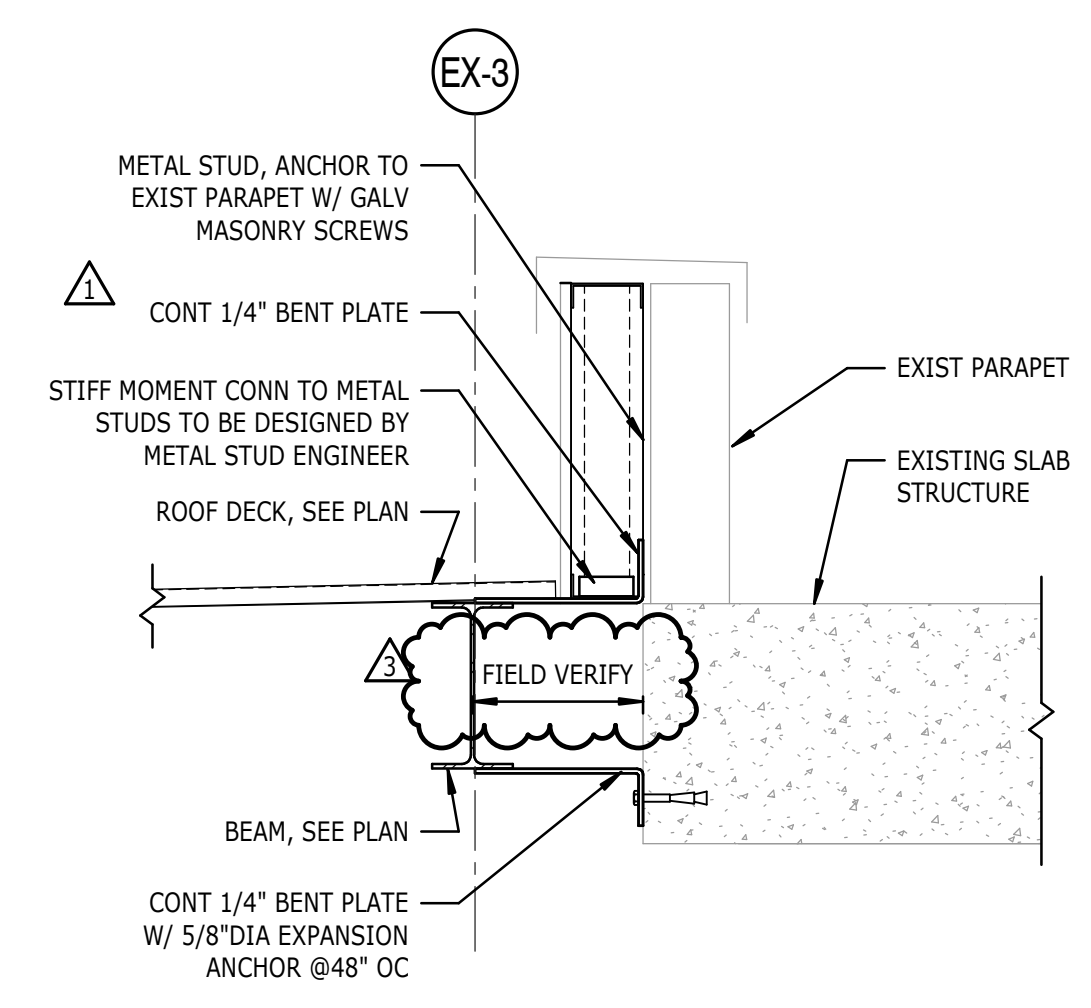


**13 SECTION**  
S-524 3/4" = 1'-0"

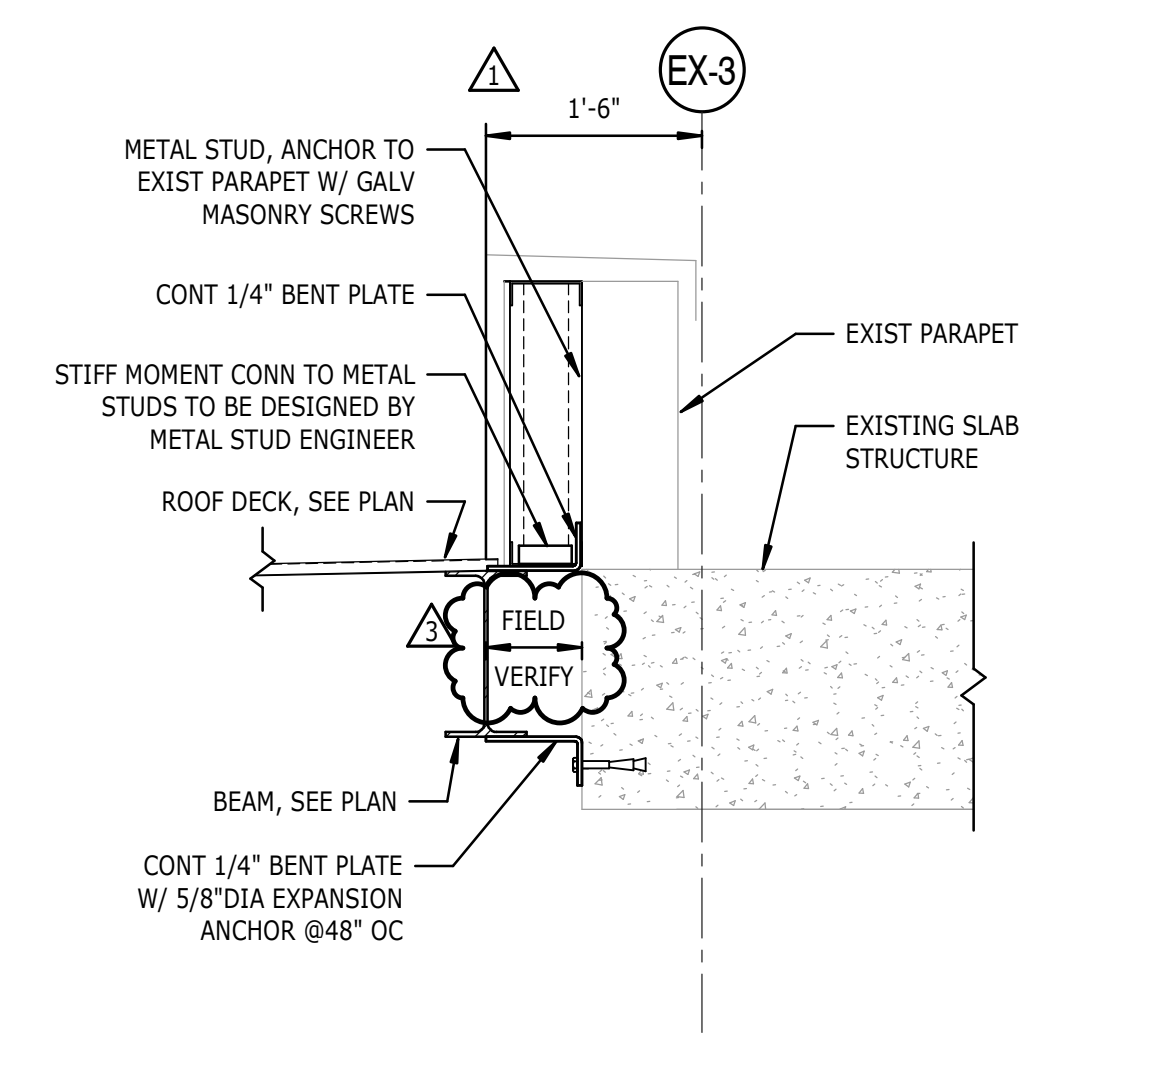


**14 SECTION**  
S-524 3/4" = 1'-0"

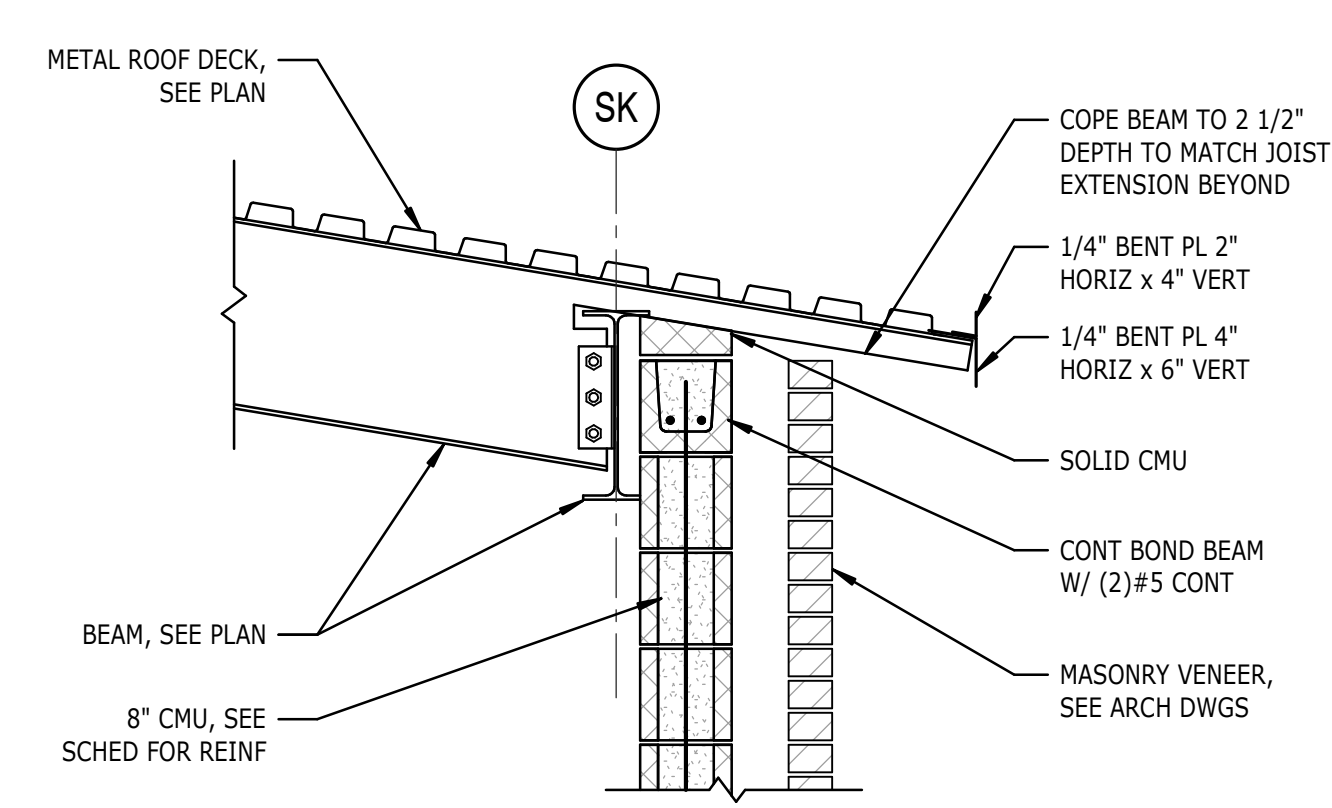


**15 SECTION**  
S-524 3/4" = 1'-0"

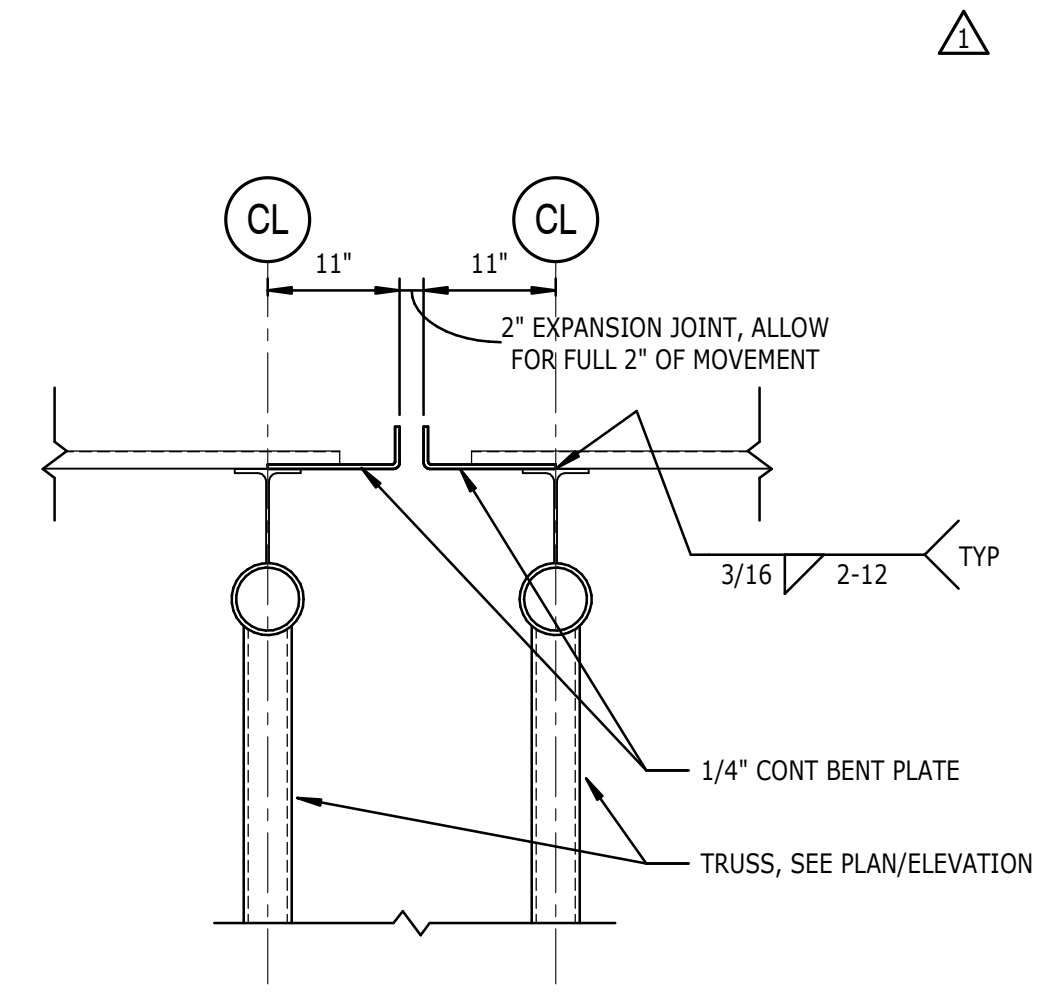


**17 SECTION**  
S-524 3/4" = 1'-0"

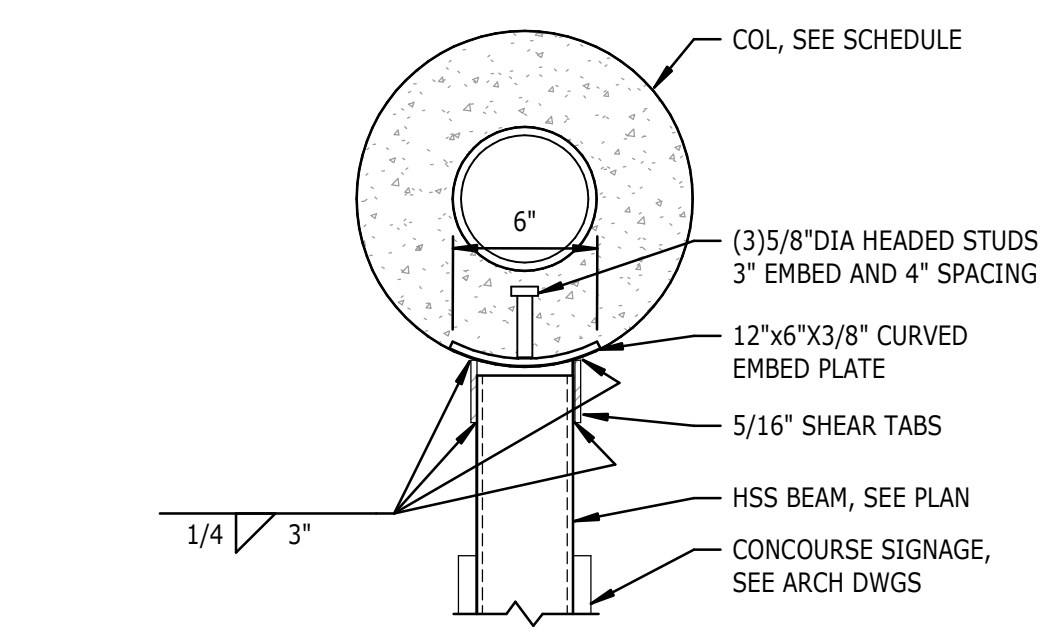

**18 DETAIL**  
S-524 CONTOUR SIGNAGE CONNECTION DETAIL  
NTS

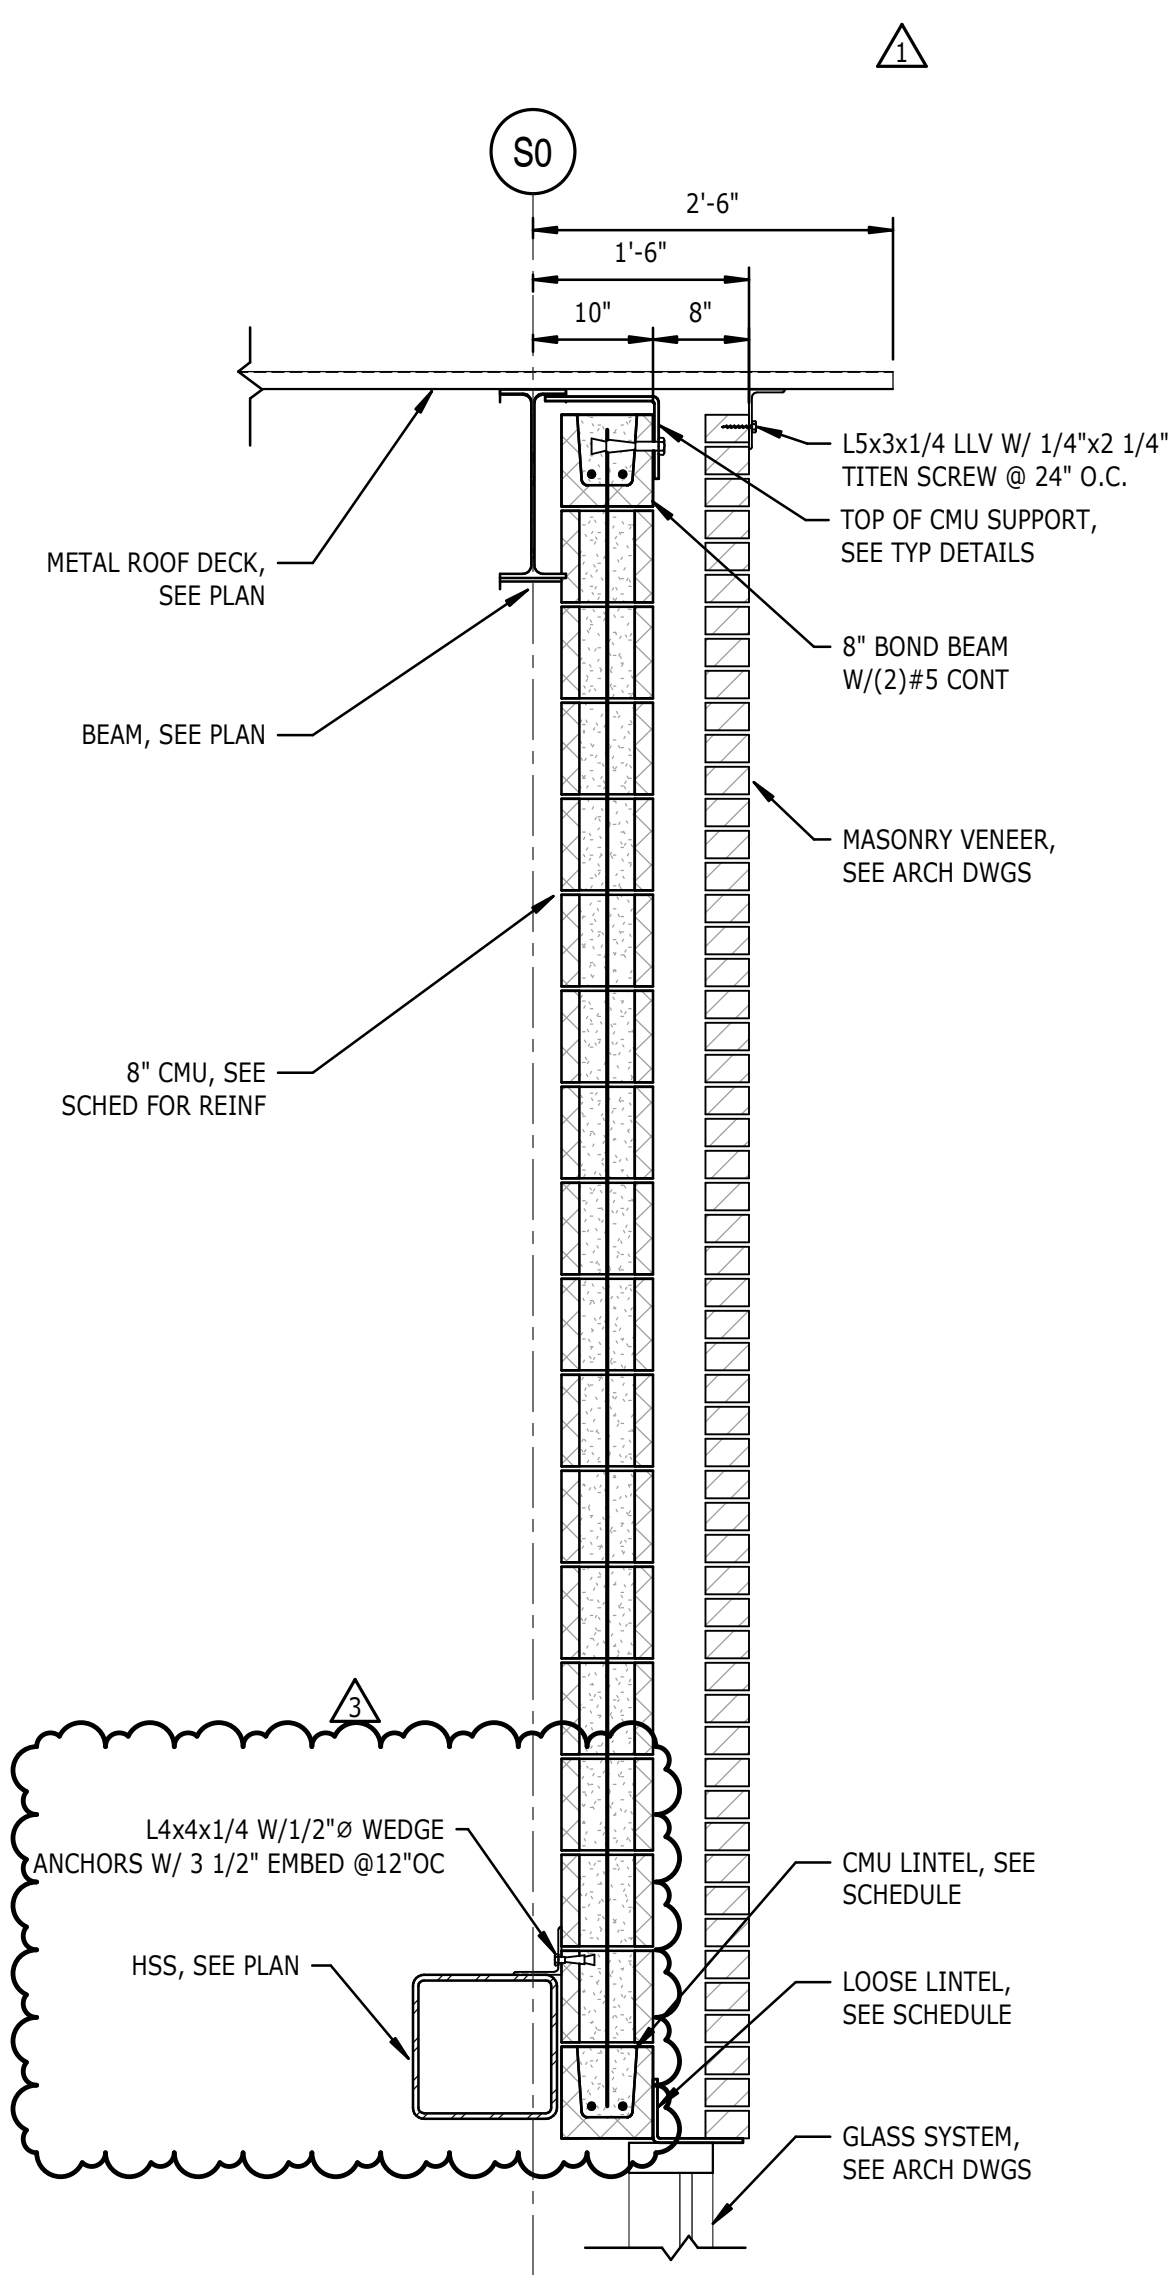


**19 SECTION**  
S-524 3/4" = 1'-0"

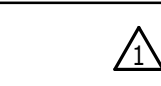



# TERMINAL IMPROVEMENTS CONTRACT 3

Wilmington International Airport  
1740 Airport Boulevard, Suite 12  
Wilmington, NC 28405

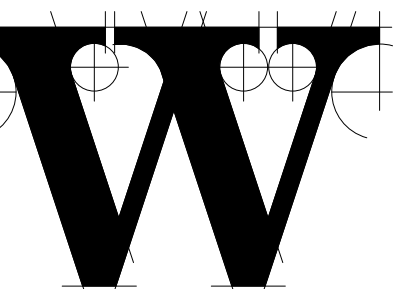

## THE WILSON GROUP ARCHITECTS

PO Box 5510 Charlotte, NC 28299  
704-331-9747 • www.twgarchitects.com

PROJECT MANAGER & CIVIL ENGINEER  
**TALBERT & BRIGHT**  
CONSULTING ARCHITECT  
LS3P

STRUCTURAL ENGINEER  
**STEWART**


FP/IME ENGINEER  
**CHEATHAM & ASSOC.**

BAGGAGE HANDLING CONSULTANTS  
**BNP**

AIRCRAFT SUPPORT SYSTEMS  
**DK CONSULTANTS**

SPECIALTY LIGHTING CONSULTANT  
**HARTRANFT**

SIGNAGE & WAYFINDING  
**TAKEFORM**

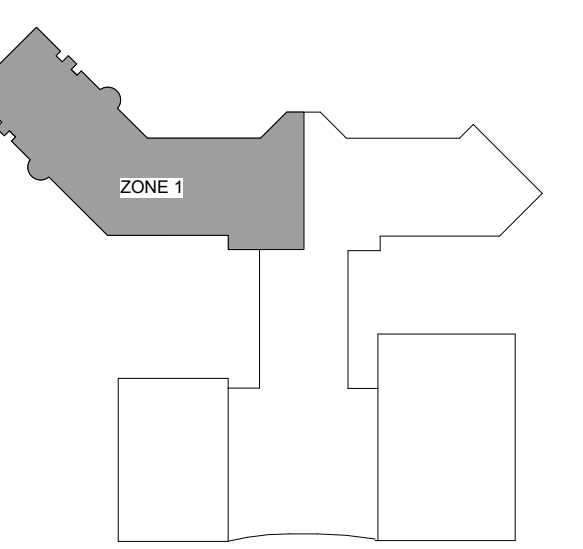

### KEY PLAN

COPYRIGHT © 2019  
THE WILSON GROUP ARCHITECTS  
ALL RIGHTS RESERVED

PRINTED OR ELECTRONIC DRAWINGS AND DOCUMENTATION MAY NOT BE REPRODUCED IN ANY FORM WITHOUT WRITTEN PERMISSION FROM THE WILSON GROUP ARCHITECTS

### REVISIONS

1 7/30/2019 AD-03


DATE 6/28/2019  
PROJECT NUMBER 9202-000  
SHEET TITLE

## SCHEDULE 1 - BOARDING LEVEL RCP ZONE 1


SHEET NUMBER  
**A1-161**

RCP LEGEND	
	2x4' w 6' SLOT LAY-IN CEILING PANEL
	2x2 LAY-IN CEILING PANEL
	GYPSUM BOARD
	EXPOSED STRUCTURE - PAINTED
	EXHAUST AIR GRILLE
	SPEAKER
	SPRINKLER
	SPEAKER/STROBE
	HEIGHT (FEET, INCHES) ABOVE FINISHED FLOOR, 10'-6" U.N.O.
	6" X LED FIXTURE LENGTH VARIES
	2 X 2 LED FIXTURE
	LED FIXTURE
	1 X 1 LED FIXTURE
	2 X 2 LED FIXTURE - EXTERIOR
	SUPPLY AIR DIFFUSER
	RETURN AIR DIFFUSER
	EXHAUST FAN
	6" X MECH SUPPLY AND RETURN DIFFUSER LENGTH VARIES

PLAN LEGEND	
	8" REINFORCED CMU
	8" CAST IN PLACE CONCRETE
	PARTITION AS SCHEDULED
	EIFS & CMU
	EIFS & C.I.P. CONCRETE
	1 HOUR FIRE RATED PARTITION
	BRICK VENEER
	EXISTING COVERED AREA
	EXISTING ENCLOSED AREA
	EXISTING WALLS/COLUMNS
	RD = ROOF DRAIN LOCATION

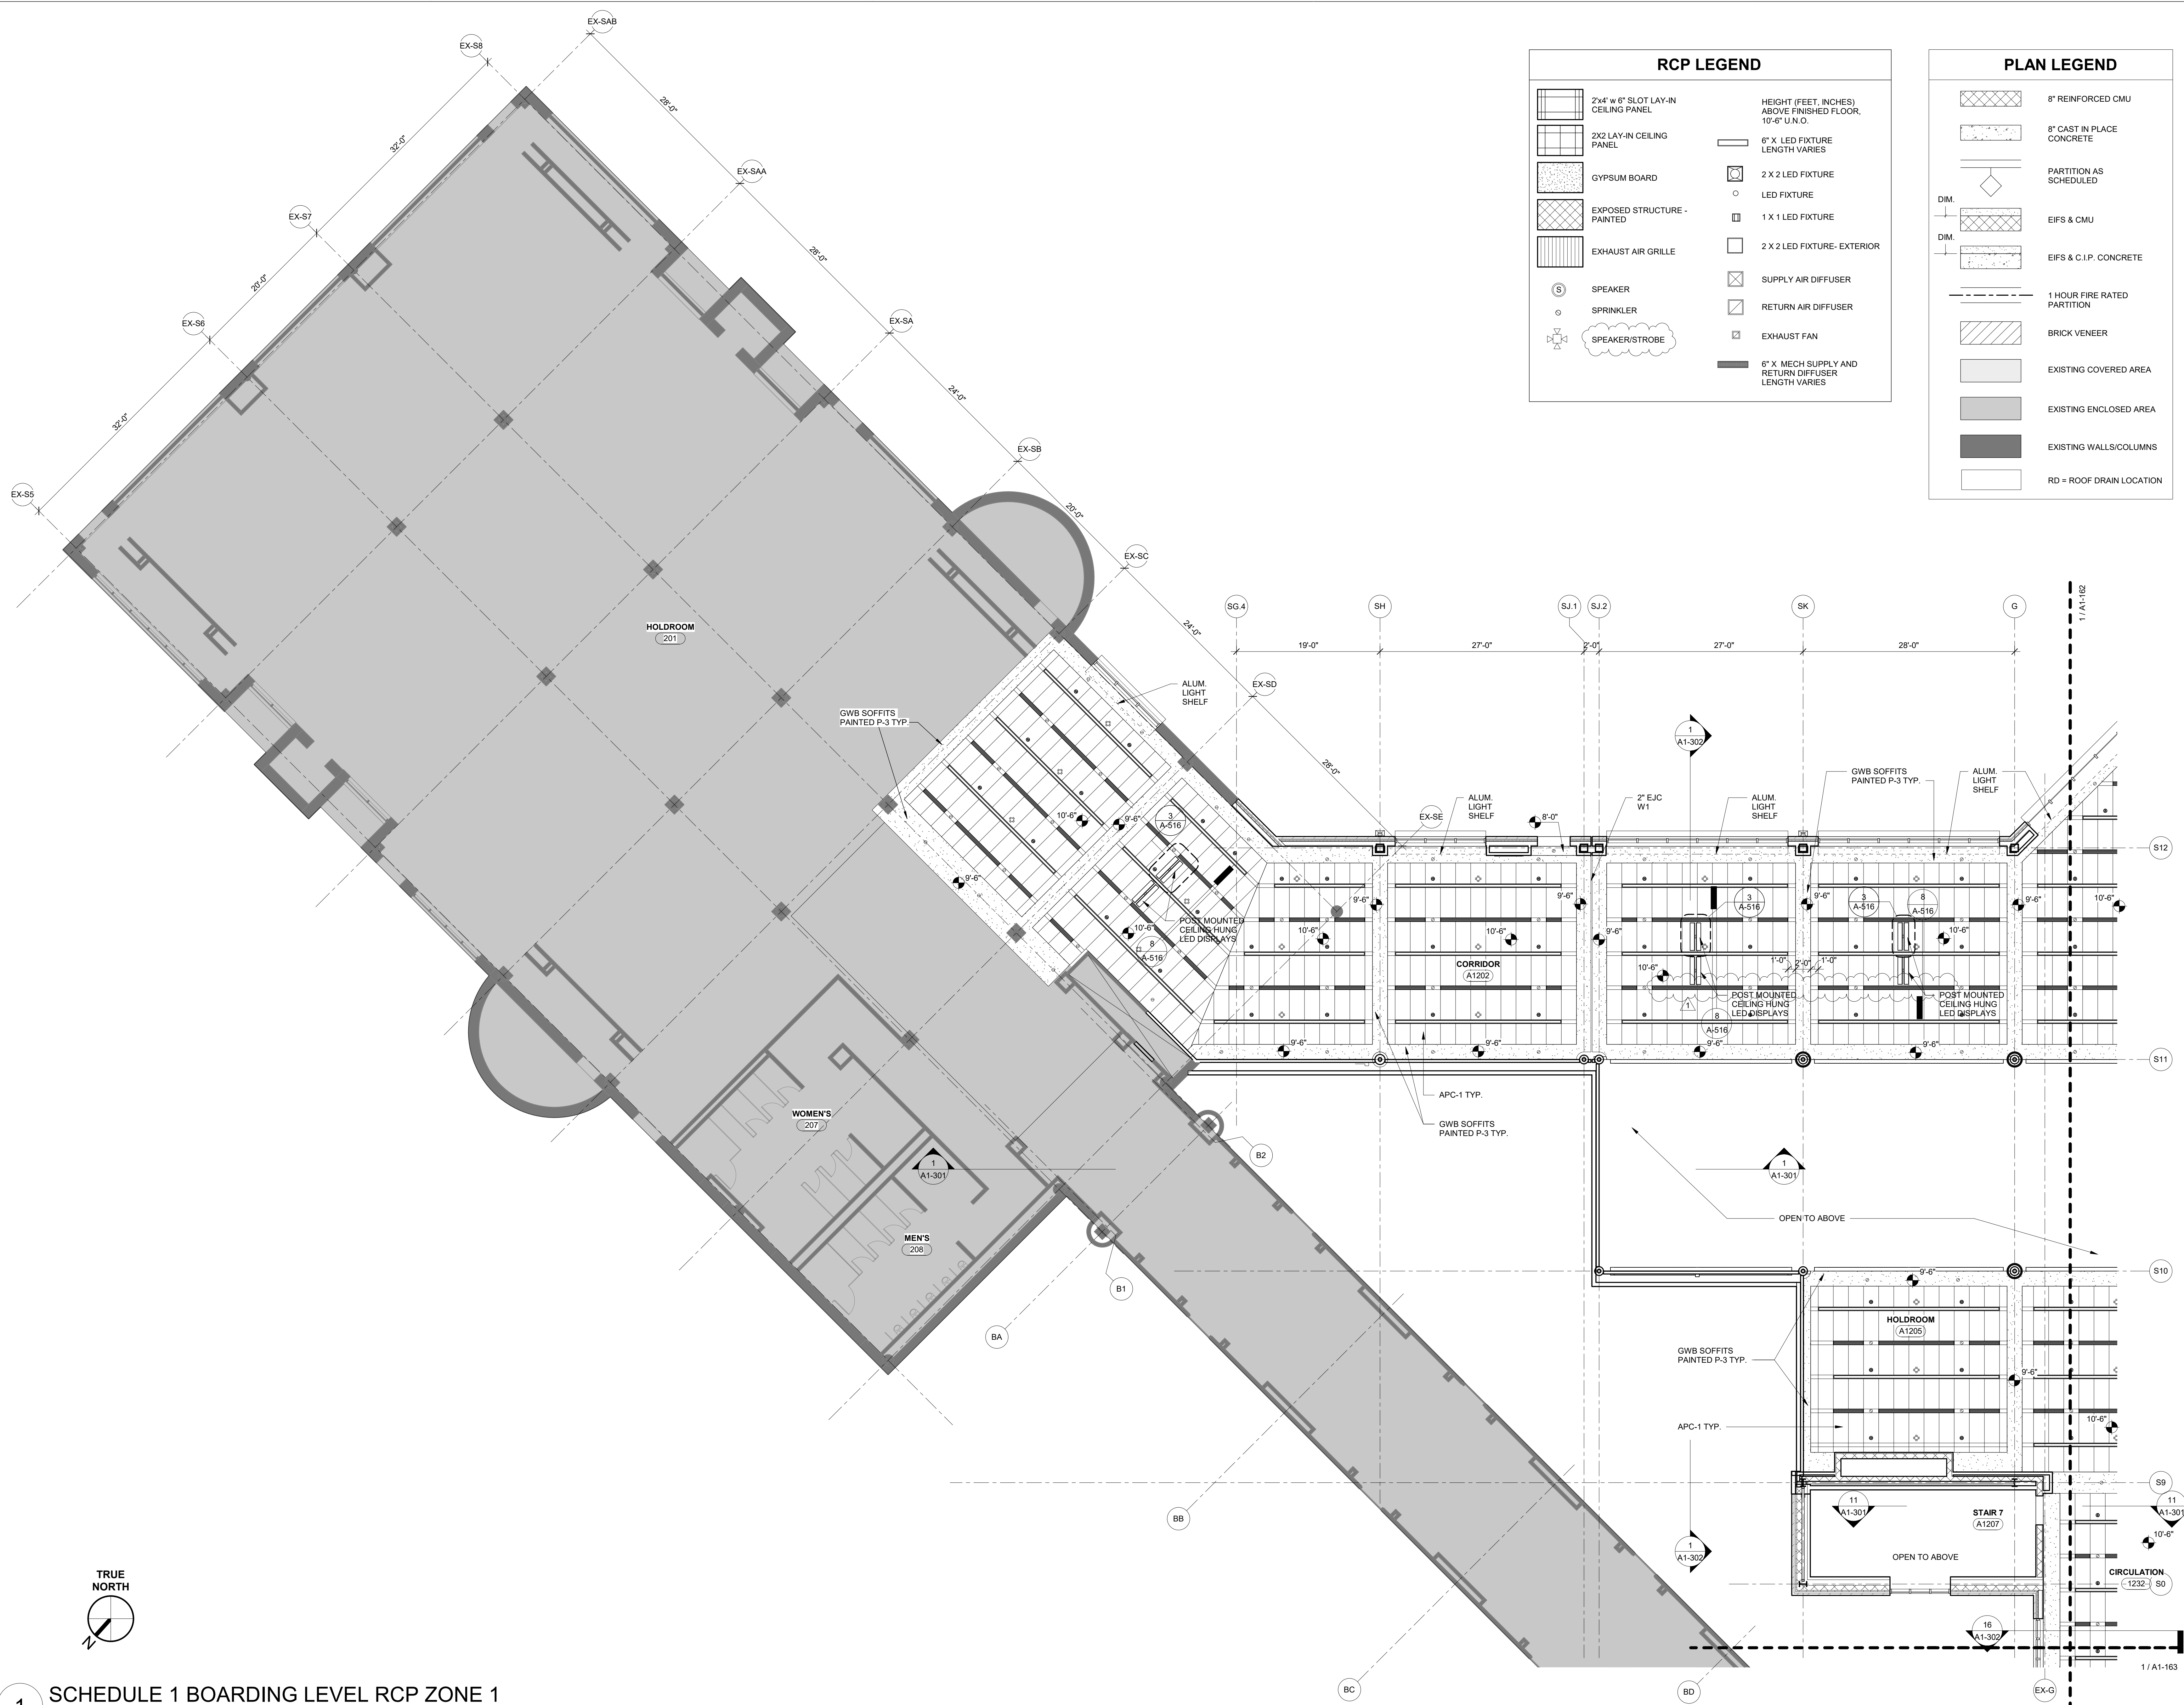


1 SCHEDULE 1 BOARDING LEVEL RCP ZONE 1  
1/8" = 1'-0"

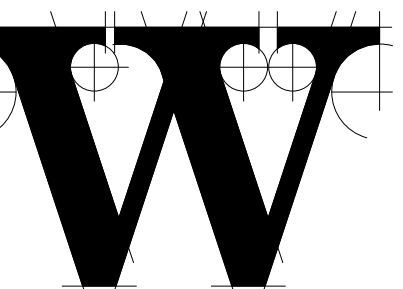


RCP LEGEND	
	2x4" w 6' SLOT LAY-IN CEILING PANEL
	2X2 LAY-IN CEILING PANEL
	GYPSUM BOARD
	EXPOSED STRUCTURE - PAINTED
	EXHAUST AIR GRILLE
	SPEAKER
	SPRINKLER
	SPEAKER/STROBE
	HEIGHT (FEET, INCHES) ABOVE FINISHED FLOOR, 10'-6" U.N.O.
	6' X LED FIXTURE LENGTH VARIES
	2 X 2 LED FIXTURE
	LED FIXTURE
	1 X 1 LED FIXTURE
	2 X 2 LED FIXTURE- EXTERIOR
	SUPPLY AIR DIFFUSER
	RETURN AIR DIFFUSER
	EXHAUST FAN
	8' X MESH SUPPLY AND RETURN DIFFUSER LENGTH VARIES


PLAN LEGEND	
	8' REINFORCED CMU
	8' CAST IN PLACE CONCRETE
	PARTITION AS SCHEDULED
	EIFS & CMU
	EIFS & C.I.P. CONCRETE
	1 HOUR FIRE RATED PARTITION
	BRICK VENEER
	EXISTING COVERED AREA
	EXISTING ENCLOSED AREA
	EXISTING WALLS/COLUMNS
	RD = ROOF DRAIN LOCATION

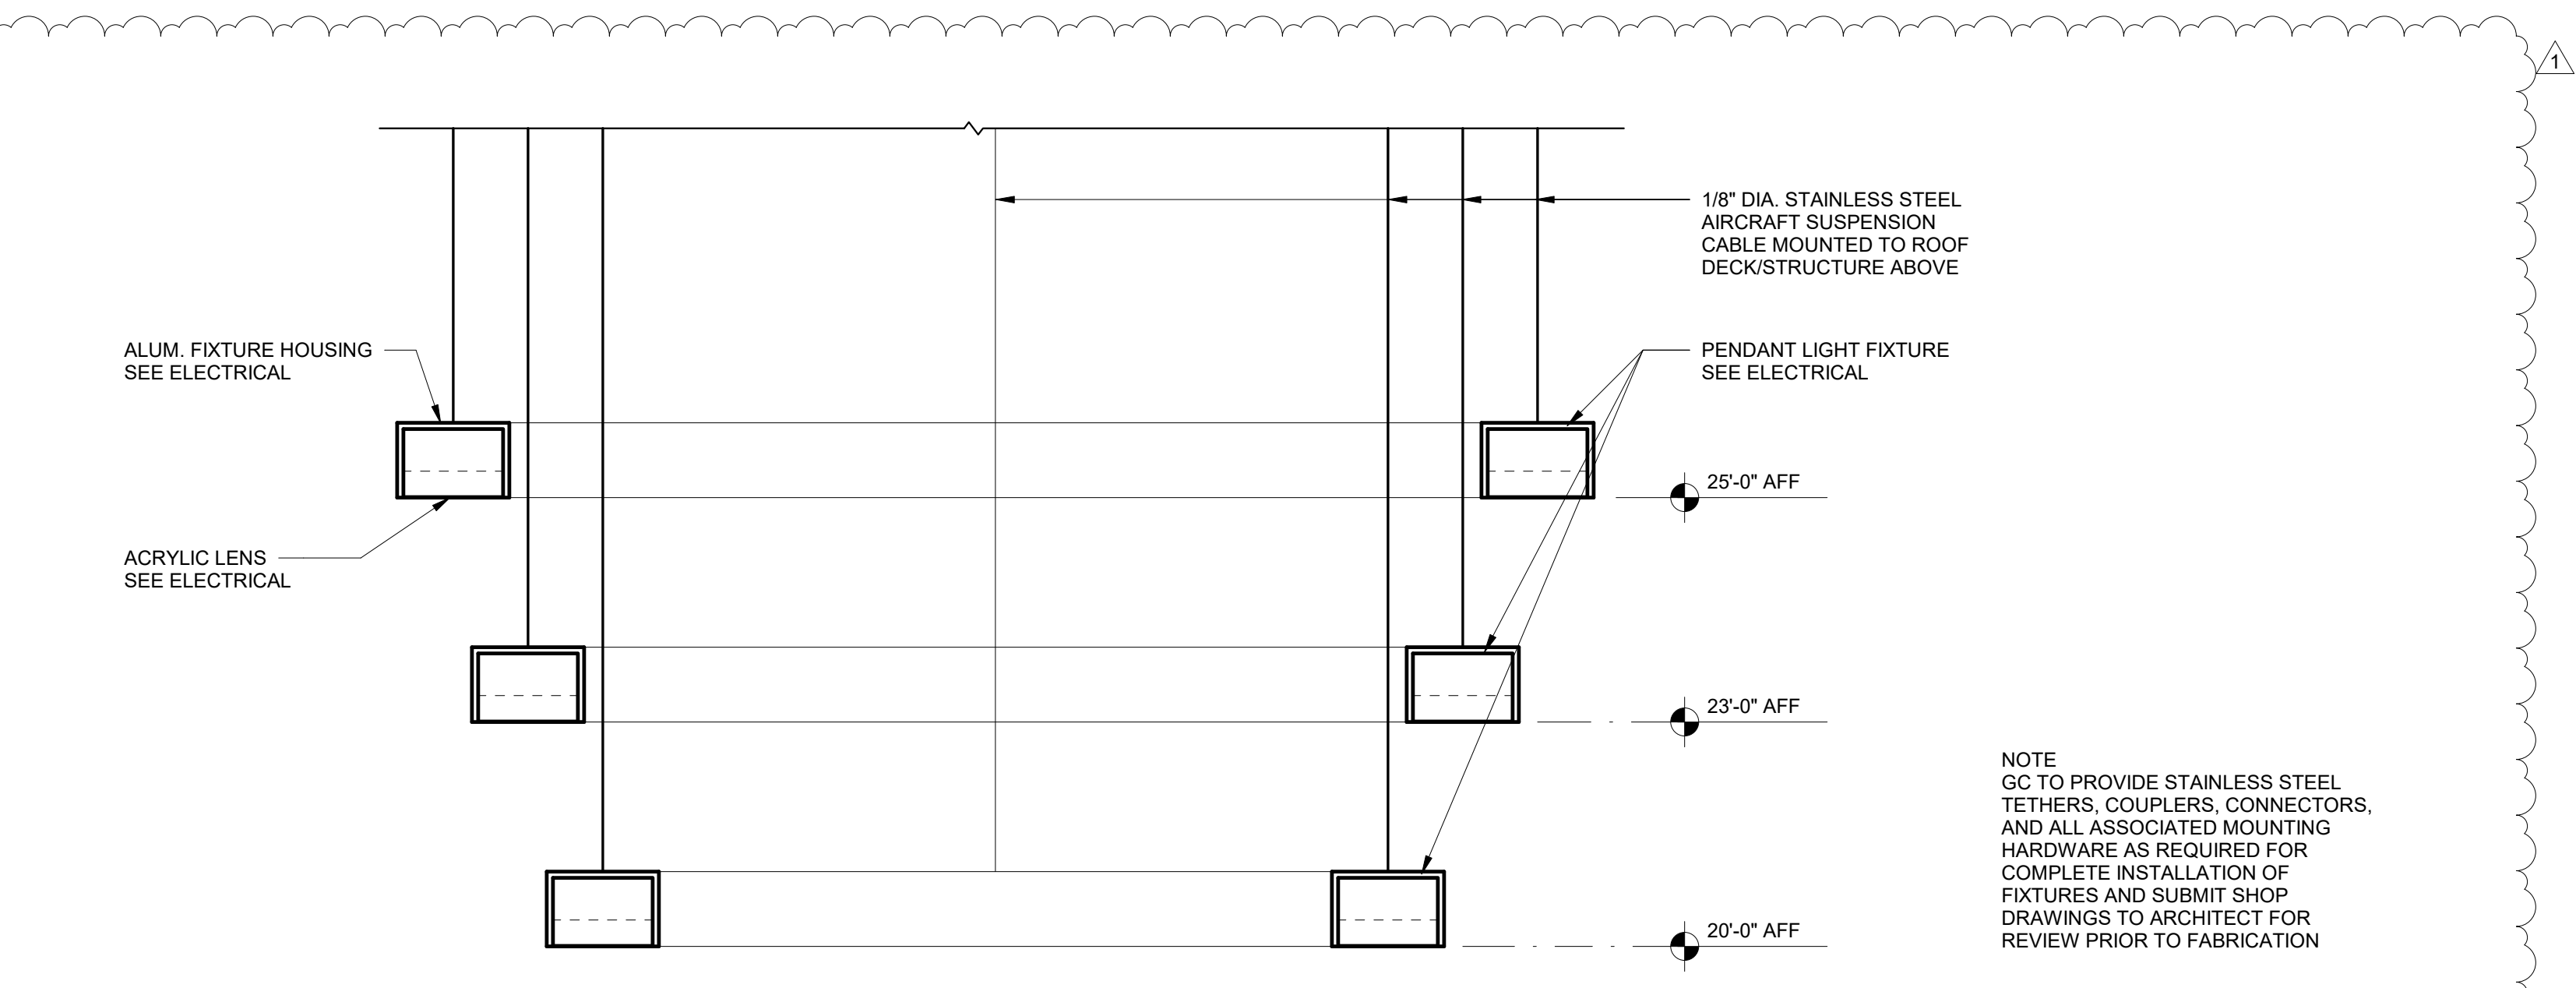

**16 LIGHT FIXTURE SECTION DETAIL**  
1/2" = 1'-0"

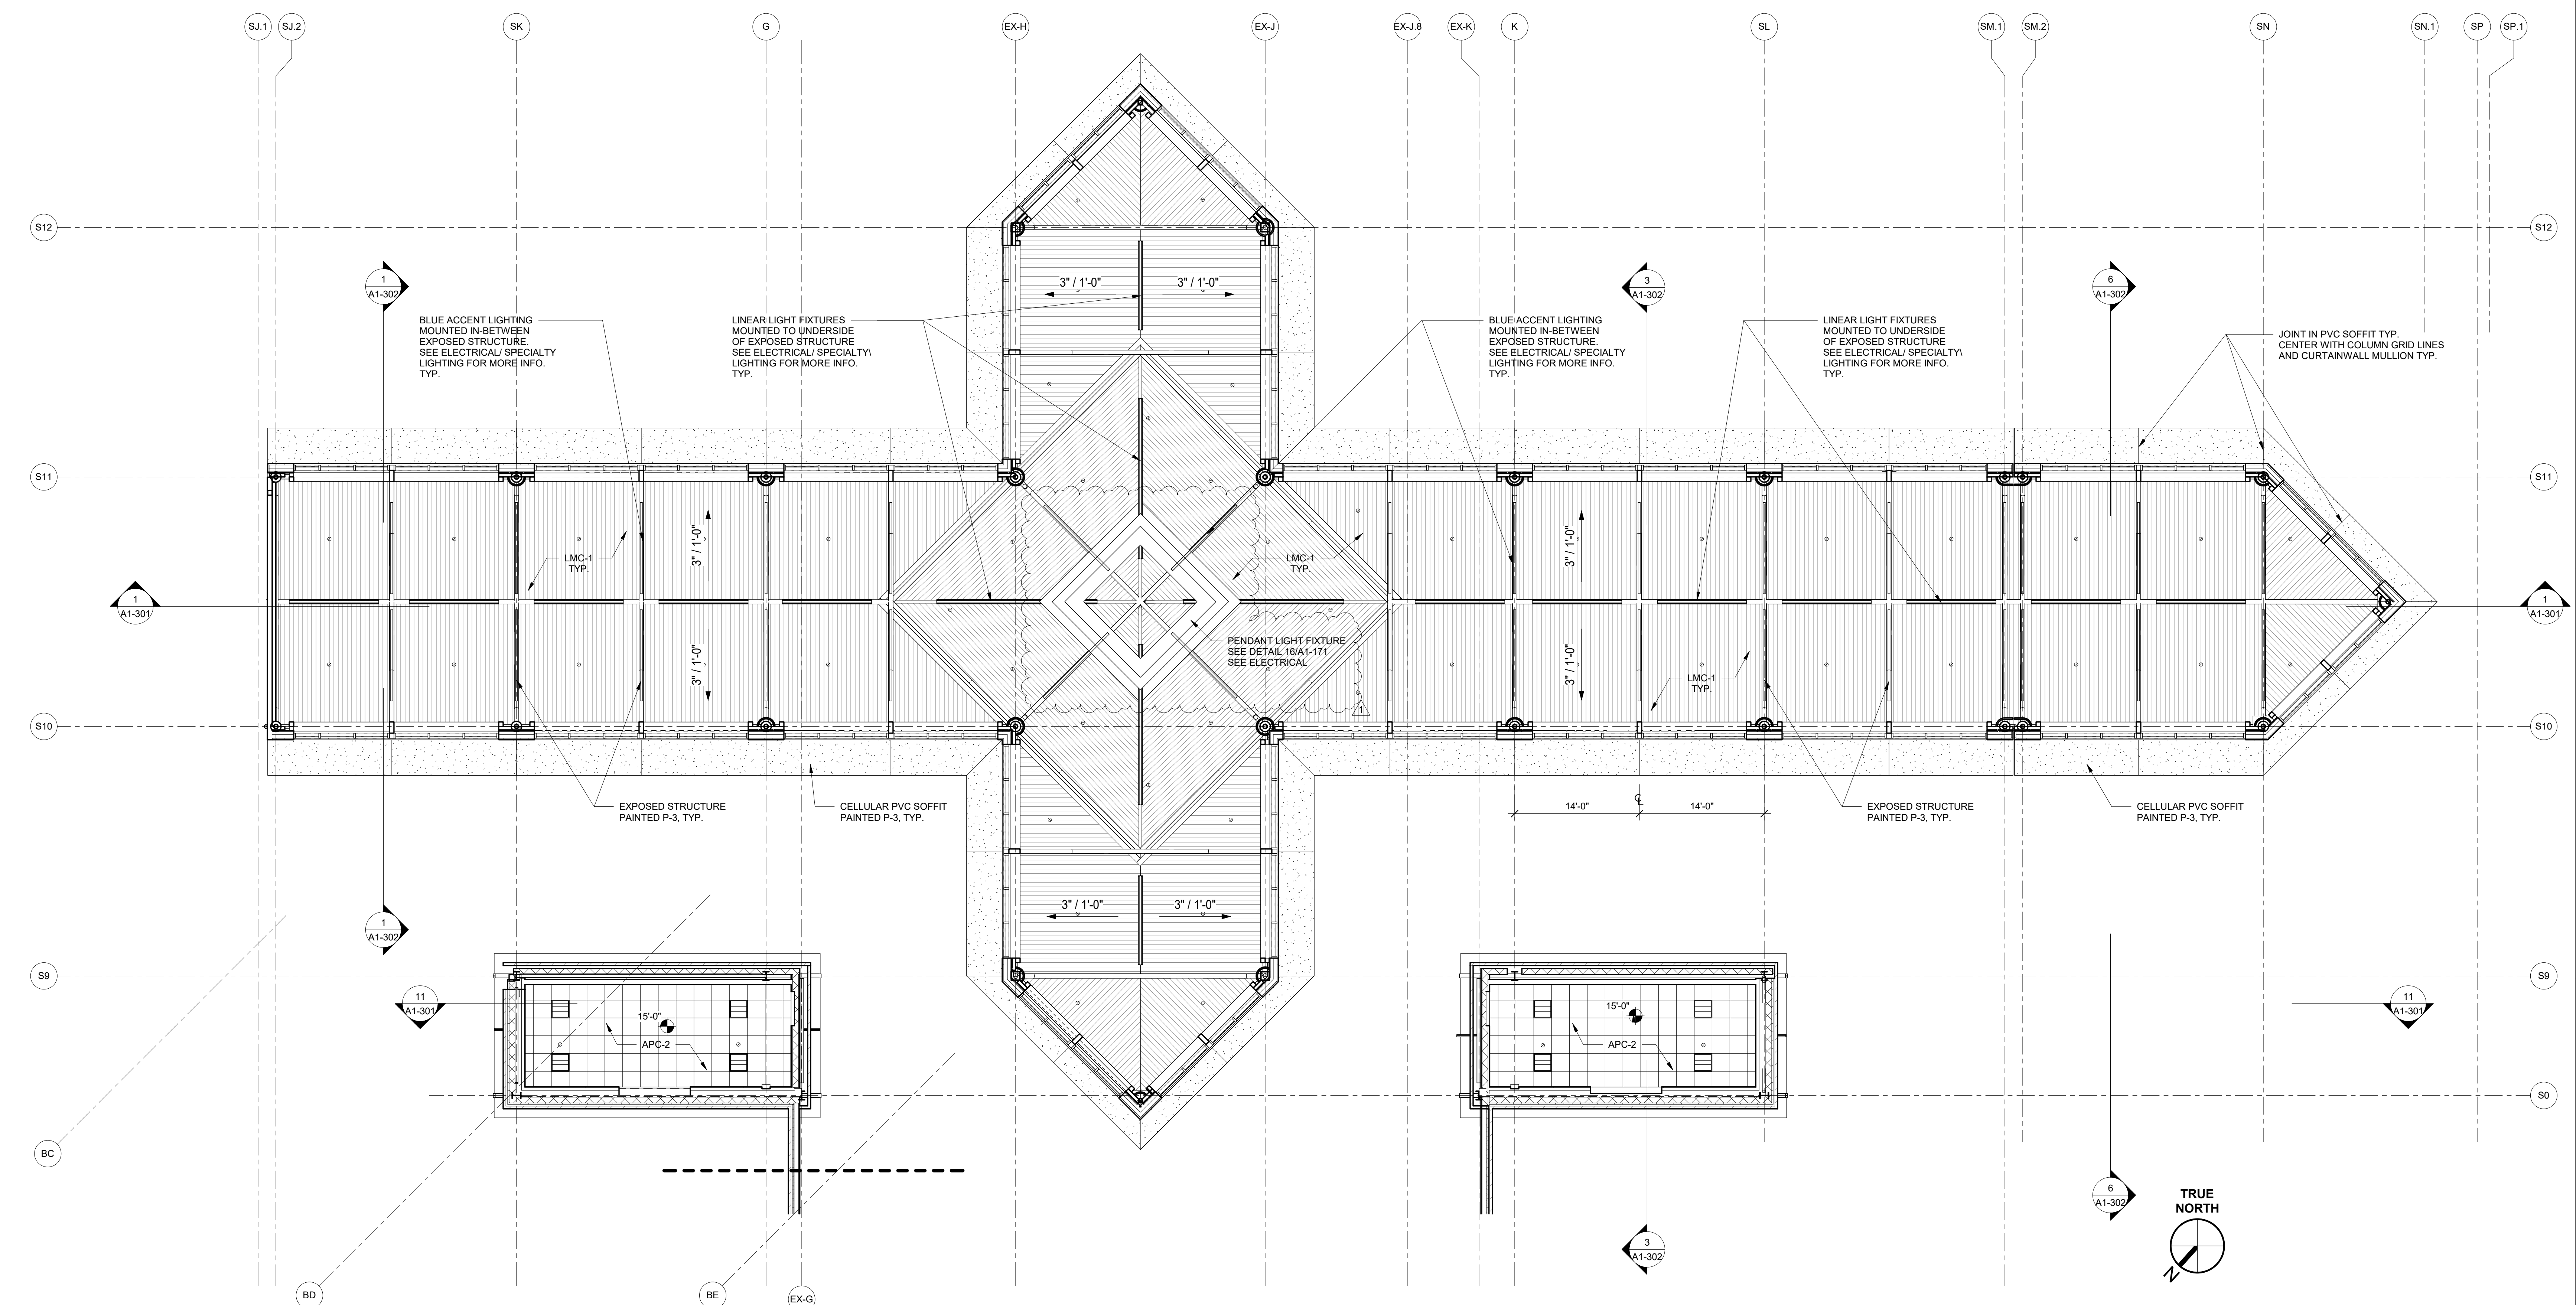


**1 SCHEDULE 1 - CLERESTORY RCP**  
1/8" = 1'-0"

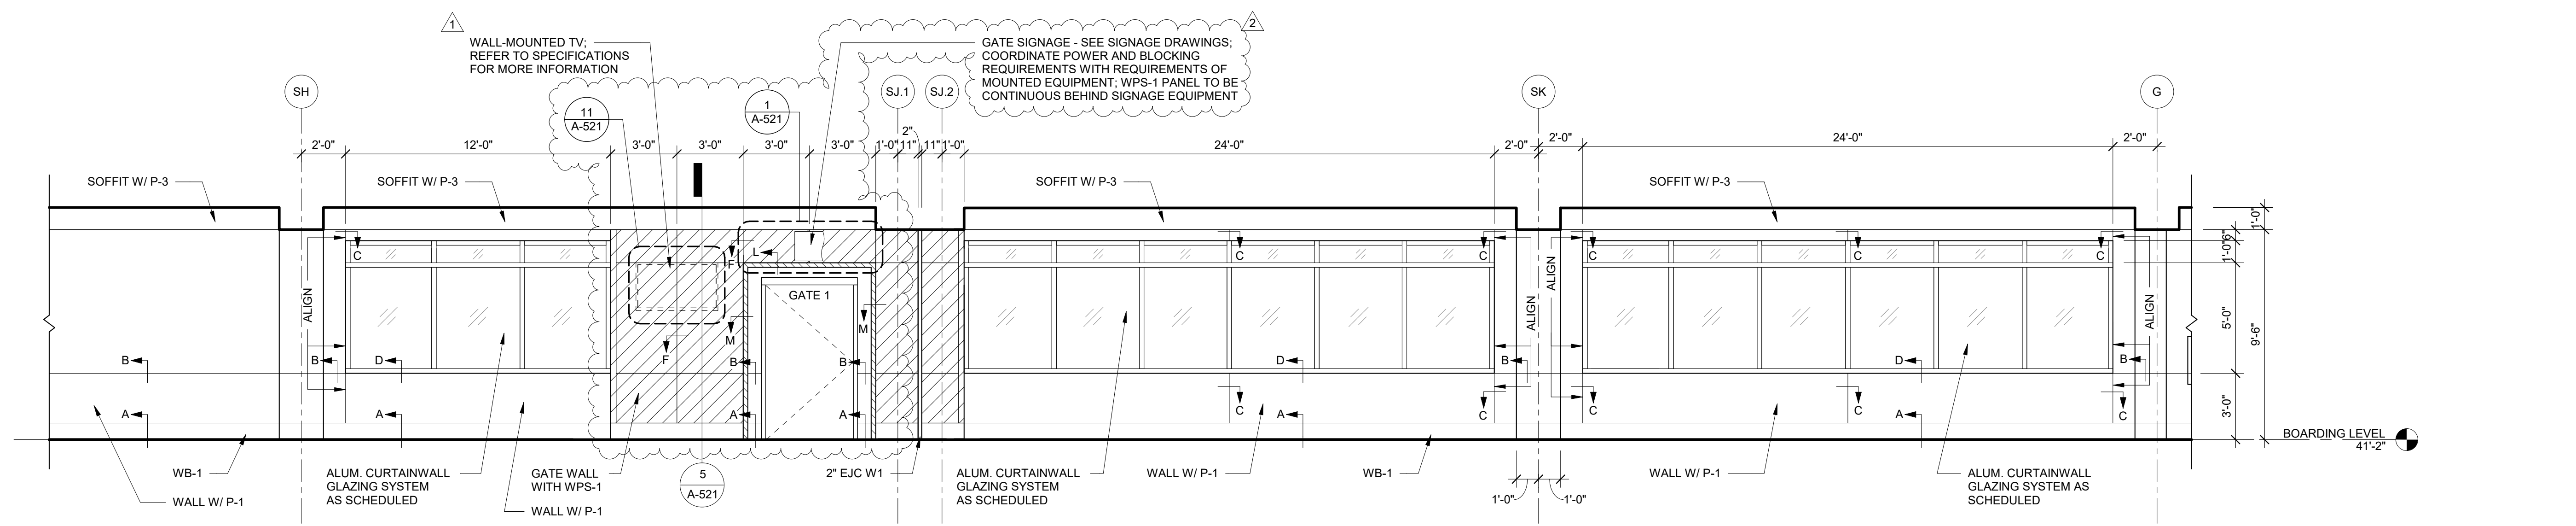


- GENERAL NOTES - INTERIOR ELEVATIONS**
1. REFER TO SHEET A-654 FOR WALL BASE, WALL, AND PANEL REVEAL DETAILS.
  2. ABBREVIATIONS:
    - CLR = CENTERLINE OF REVEAL
    - TOR = TOP OF REVEAL
    - BOR = BOTTOM OF REVEAL
  3. CONTRACTOR TO PROVIDE SHOP DRAWINGS TO ARCHITECT FOR REVIEW AND APPROVAL OF ALL SPECIALTY WALL PANEL SYSTEMS (WPS) PRIOR TO PROCUREMENT, FABRICATION, AND INSTALLATION.
  4. CONTRACTOR TO PROVIDE MOCKUPS OF EACH SPECIALTY WALL PANEL SYSTEM (WPS) FOR REVIEW AND APPROVAL PRIOR TO PROCUREMENT, FABRICATION, AND INSTALLATION.
  5. ALL VERTICAL AND HORIZONTAL REVEALS ARE TO BE CONTINUOUS AND UNINTERRUPTED, U.N.D.
  6. ALL DEAD STOP EXTRUSIONS ARE TO BE CONTINUOUS AND UNINTERRUPTED.


**16** INTERIOR ELEVATION - HOLD ROOM 36 - NORTH  
1/4" = 1'-0"

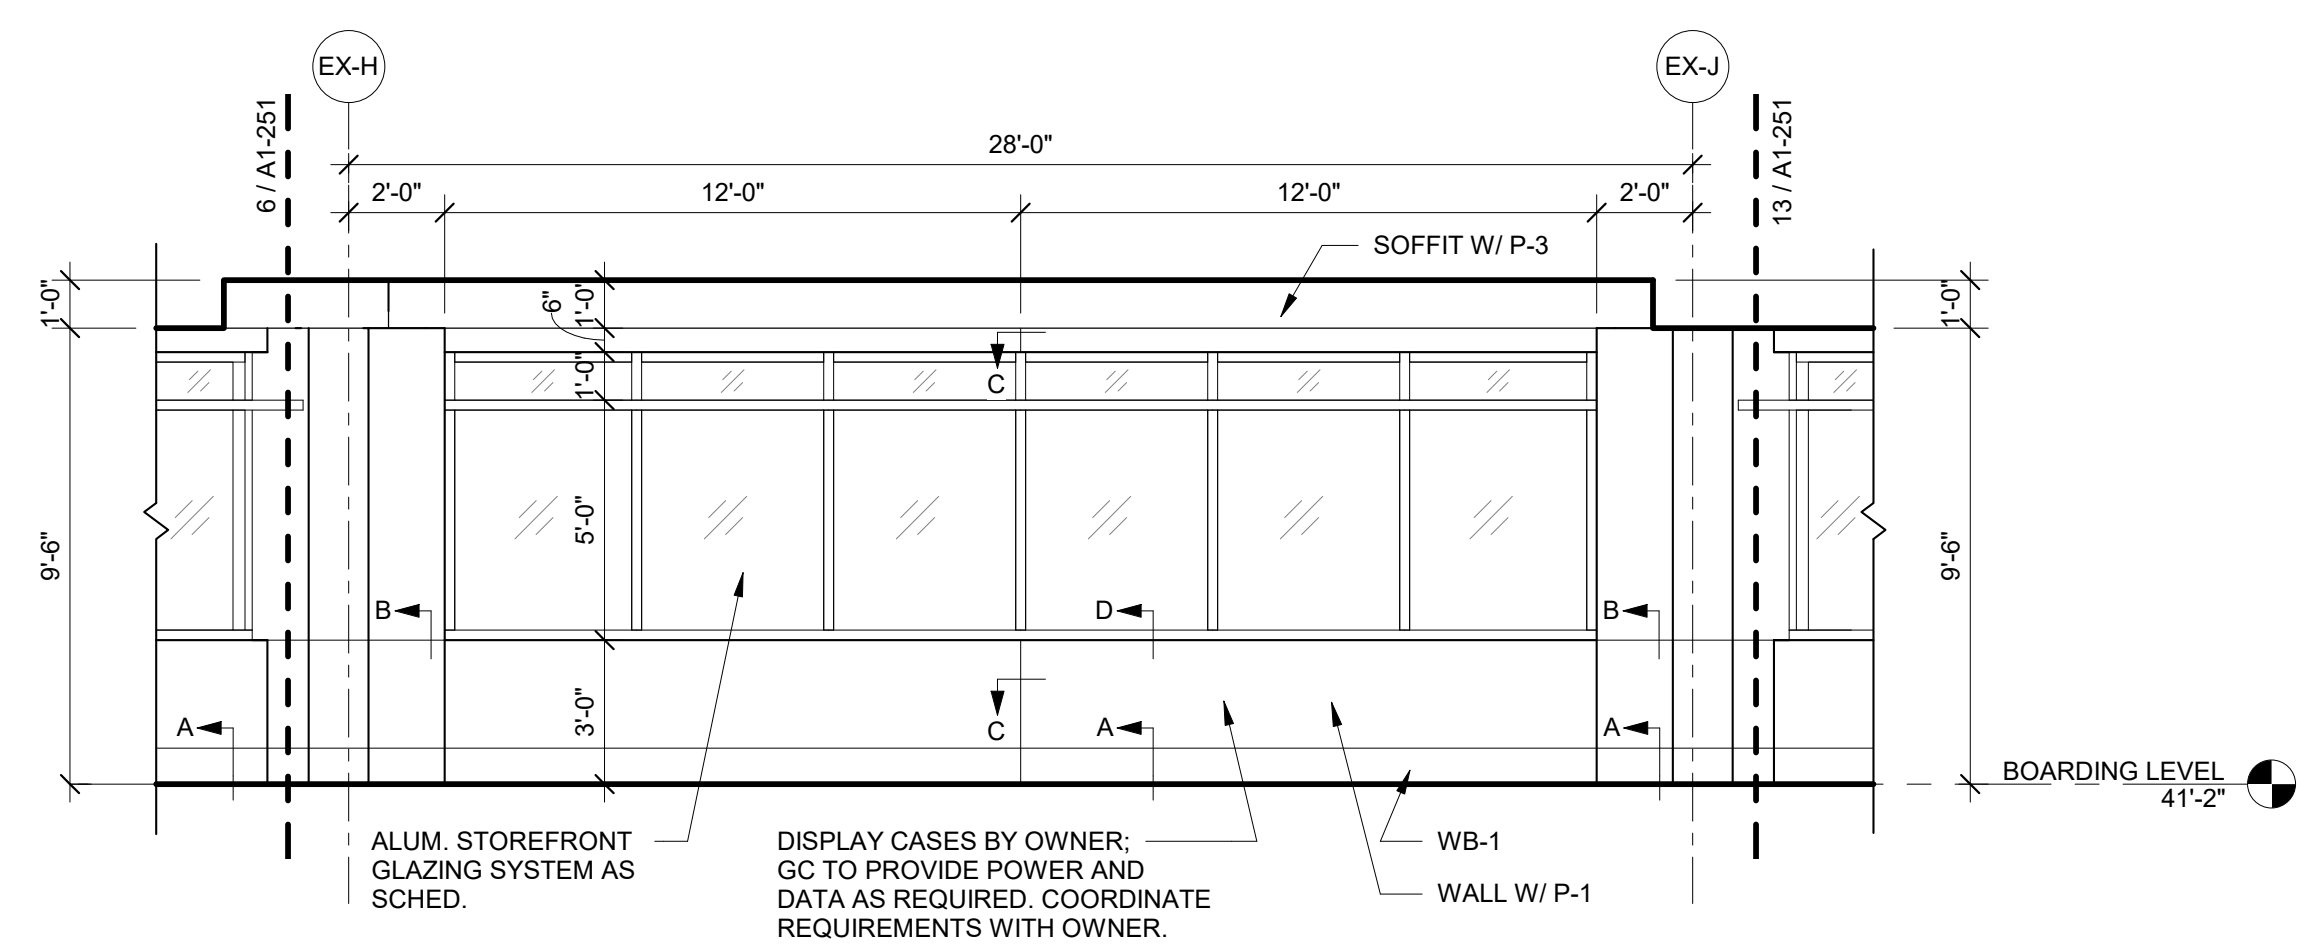


**11** INTERIOR ELEVATION - OBSERVATION NORTH  
1/4" = 1'-0"

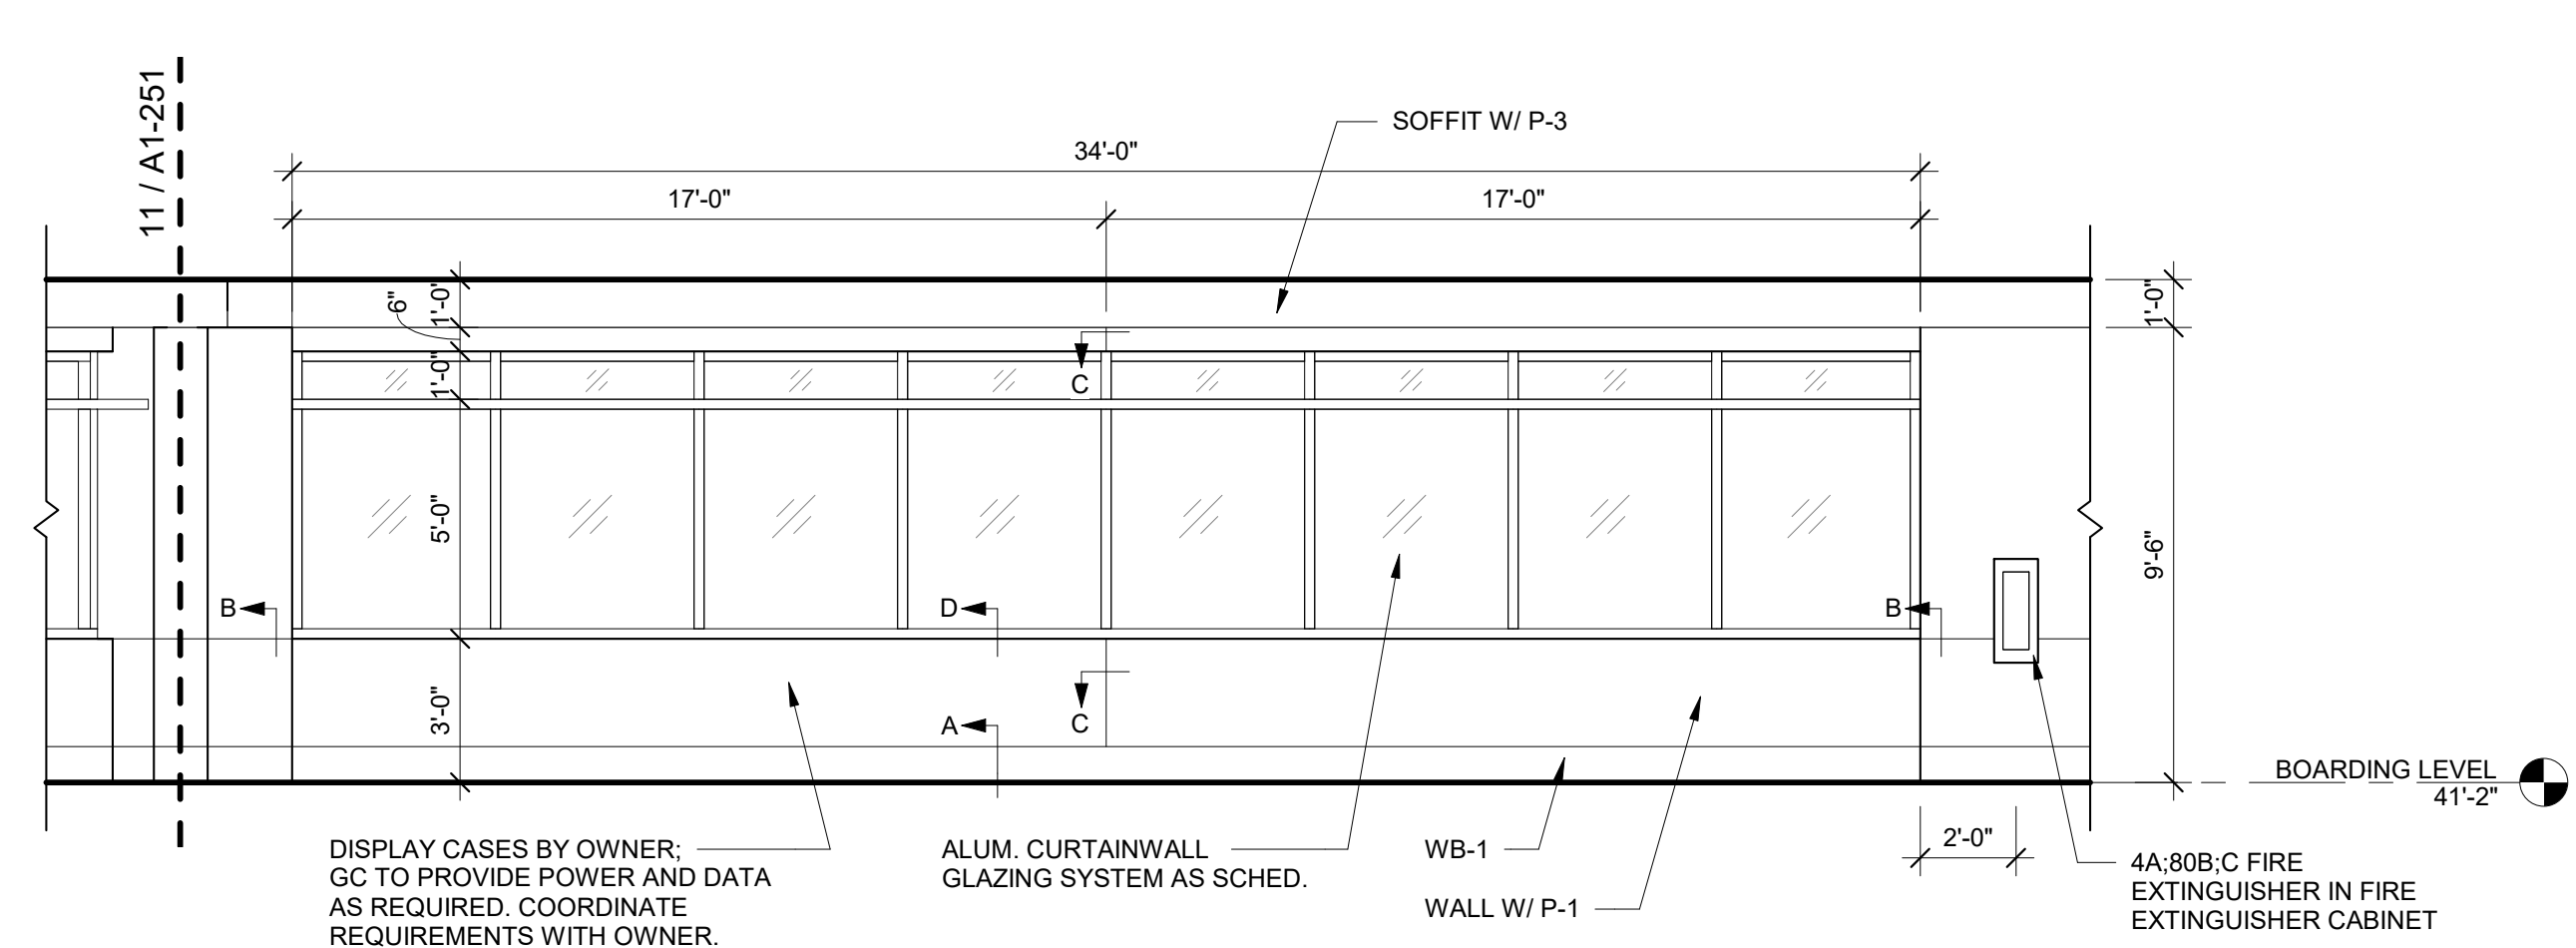


**13** INTERIOR ELEVATION - OBSERVATION NORTH EAST  
1/4" = 1'-0"

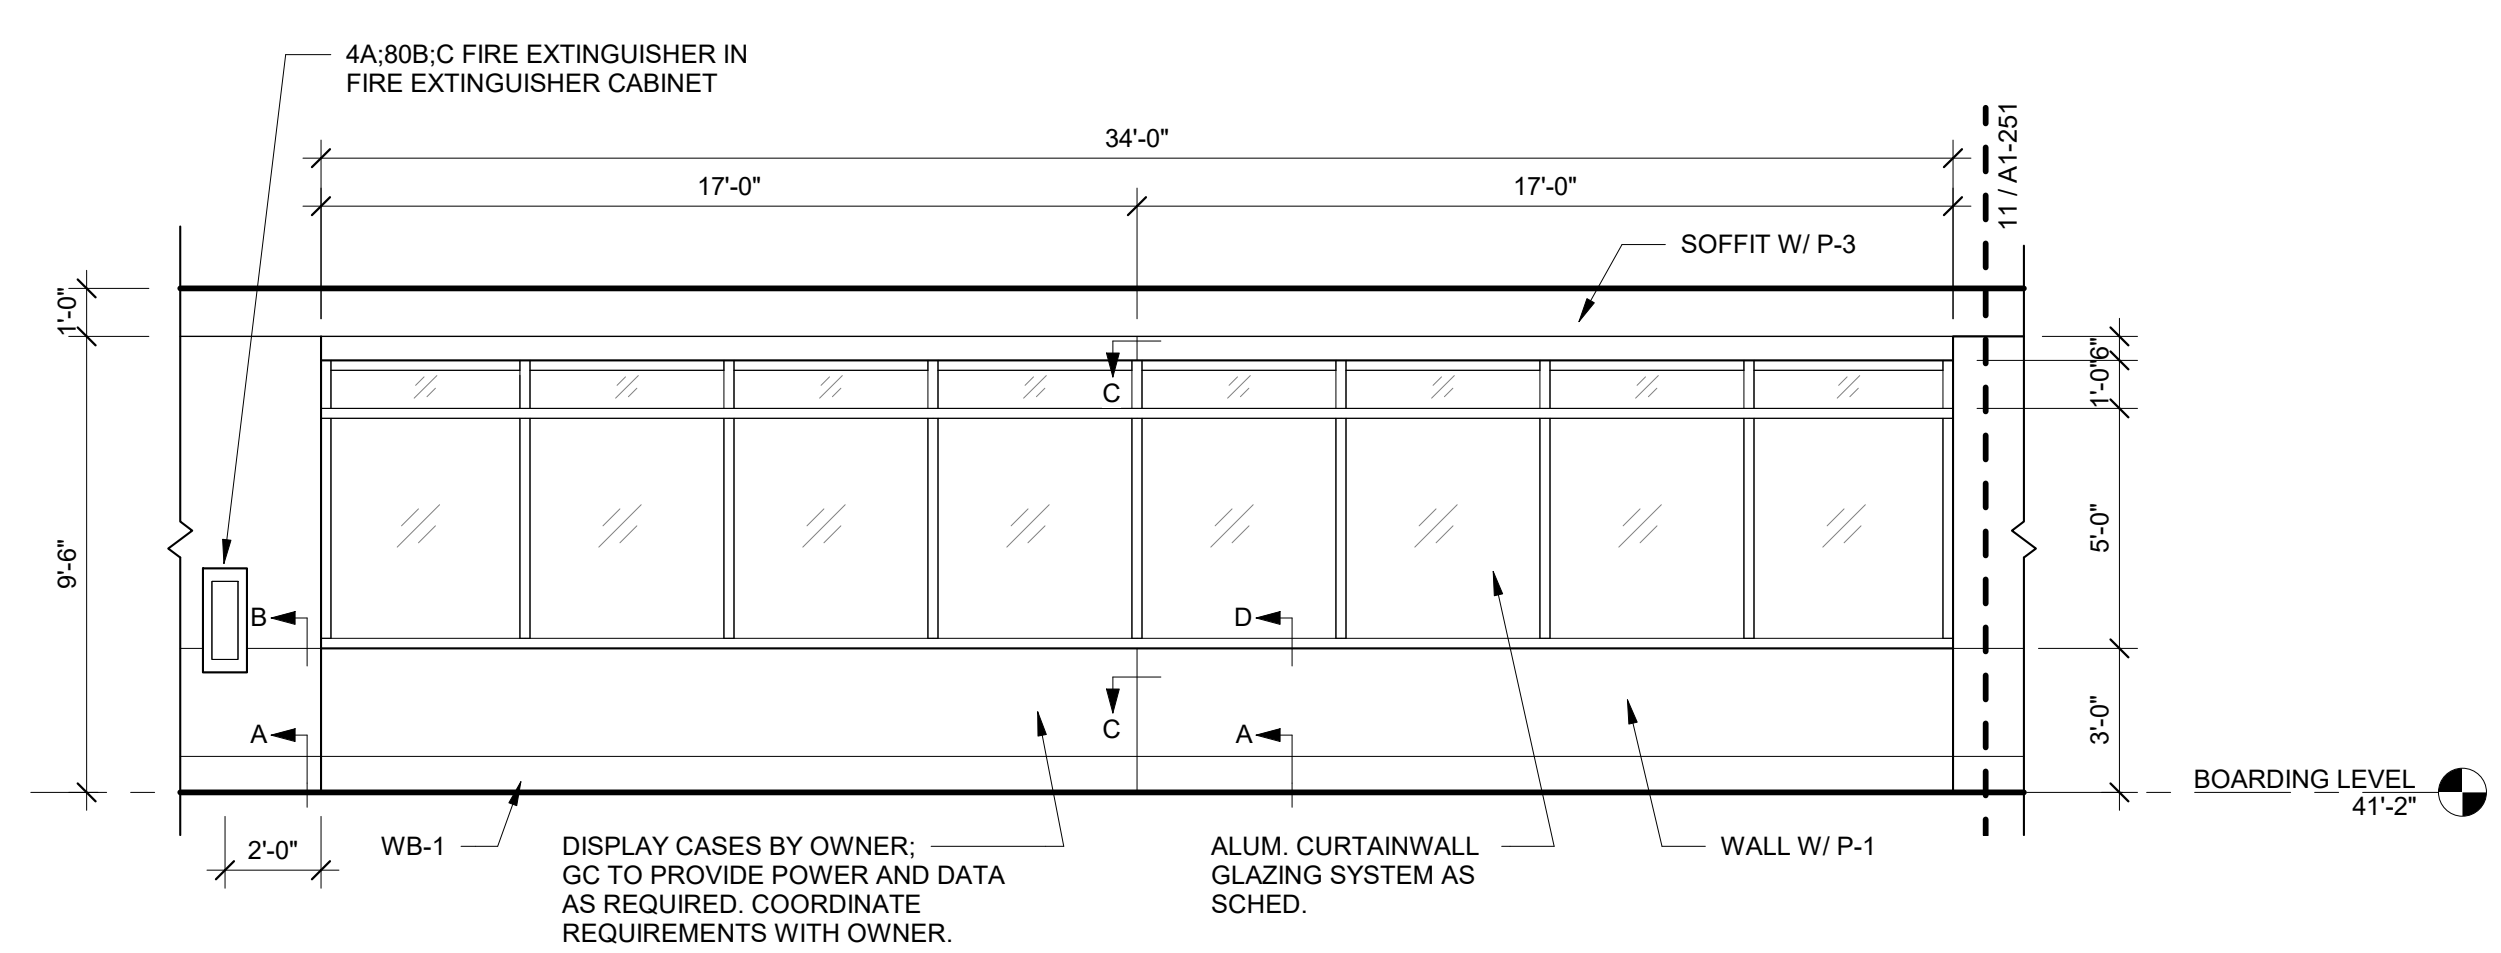

**6** INTERIOR ELEVATION - OBSERVATION NORTHWEST  
1/4" = 1'-0"

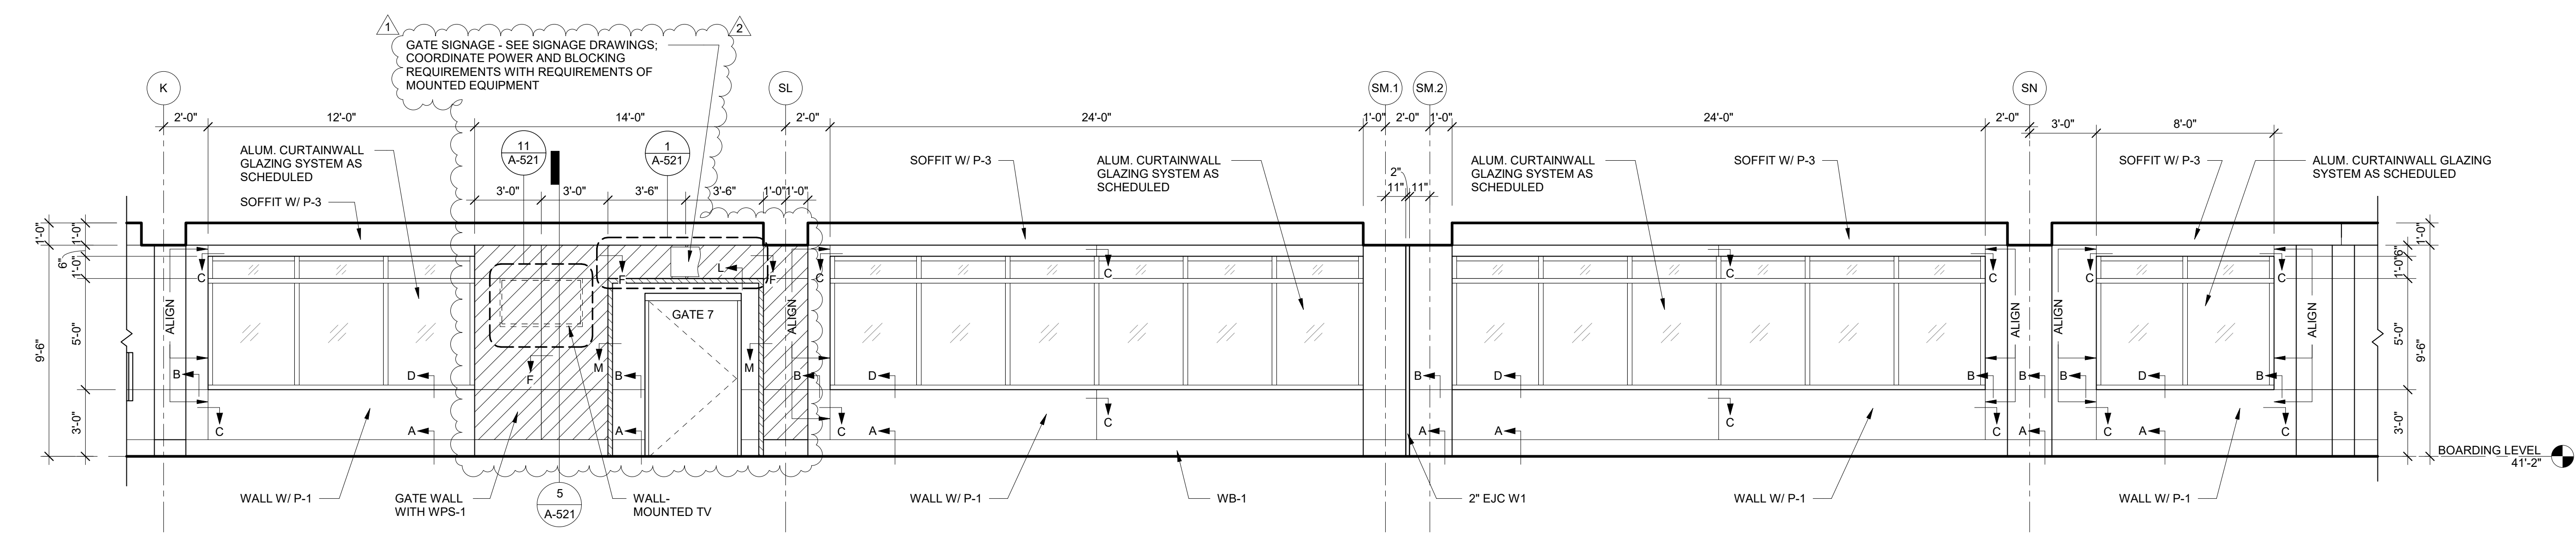

**1** INTERIOR ELEVATION - HOLD ROOM 32 - NORTH  
1/4" = 1'-0"

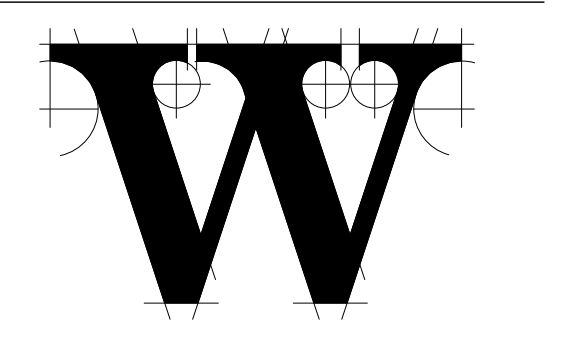

**THE WILSON GROUP**  
- ARCHITECTS -  
PO Box 5510 Charlotte, NC 28299  
704-331-9747 • www.twgarchitects.com

PROJECT MANAGER & CIVIL ENGINEER  
**TALBERT & BRIGHT**  
CONSULTING ARCHITECT  
LS3P

STRUCTURAL ENGINEER  
**STEWART**

FP/PM/E ENGINEER  
**CHEATHAM & ASSOC.**

BAGGAGE HANDLING CONSULTANTS  
**BNP**

AIRCRAFT SUPPORT SYSTEMS  
**DK CONSULTANTS**

SPECIALTY LIGHTING CONSULTANT  
**HARTRANFT**

SIGNAGE & WAYFINDING  
**TAKEFORM**

COPYRIGHT © 2019  
THE WILSON GROUP ARCHITECTS  
ALL RIGHTS RESERVED  
PRINTED OR ELECTRONIC DRAWINGS AND DOCUMENTATION MAY NOT BE REPRODUCED IN ANY FORM WITHOUT WRITTEN PERMISSION FROM THE WILSON GROUP ARCHITECTS

**REVISIONS**

1	7/12/2019	AD-01
2	7/30/2019	AD-03

DATE 6/28/2019  
PROJECT NUMBER 9202-000  
SHEET TITLE

**SCHEDULE 1 - INTERIOR ELEVATIONS**

SHEET NUMBER  
**A1-251**

**REVISIONS**

1	7/12/2019	AD-01
2	7/30/2019	AD-03


DATE 6/28/2019  
PROJECT NUMBER 9202-000  
SHEET TITLE

**SCHEDULE 1 - INTERIOR ELEVATIONS**


SHEET NUMBER  
**A1-252**

**GENERAL NOTES - INTERIOR ELEVATIONS**


1. REFER TO SHEET A-654 FOR WALL BASE, WALL, AND PANEL REVEAL DETAILS.
2. ABBREVIATIONS:
  - CLR = CENTERLINE OF REVEAL
  - TOR = TOP OF REVEAL
  - SOR = BOTTOM OF REVEAL
3. CONTRACTOR TO PROVIDE SHOP DRAWINGS TO ARCHITECT FOR REVIEW AND APPROVAL OF ALL SPECIALTY WALL PANEL SYSTEMS (WPS) PRIOR TO PROCUREMENT, FABRICATION, AND INSTALLATION.
4. CONTRACTOR TO PROVIDE MOCKUPS OF EACH SPECIALTY WALL PANEL SYSTEM (WPS) FOR REVIEW AND APPROVAL PRIOR TO PROCUREMENT, FABRICATION, AND INSTALLATION.
5. ALL VERTICAL AND HORIZONTAL REVEALS ARE TO BE CONTINUOUS AND UNINTERRUPTED, U.N.O.
6. ALL DEAD STOP EXTRUSIONS ARE TO BE CONTINUOUS AND UNINTERRUPTED.

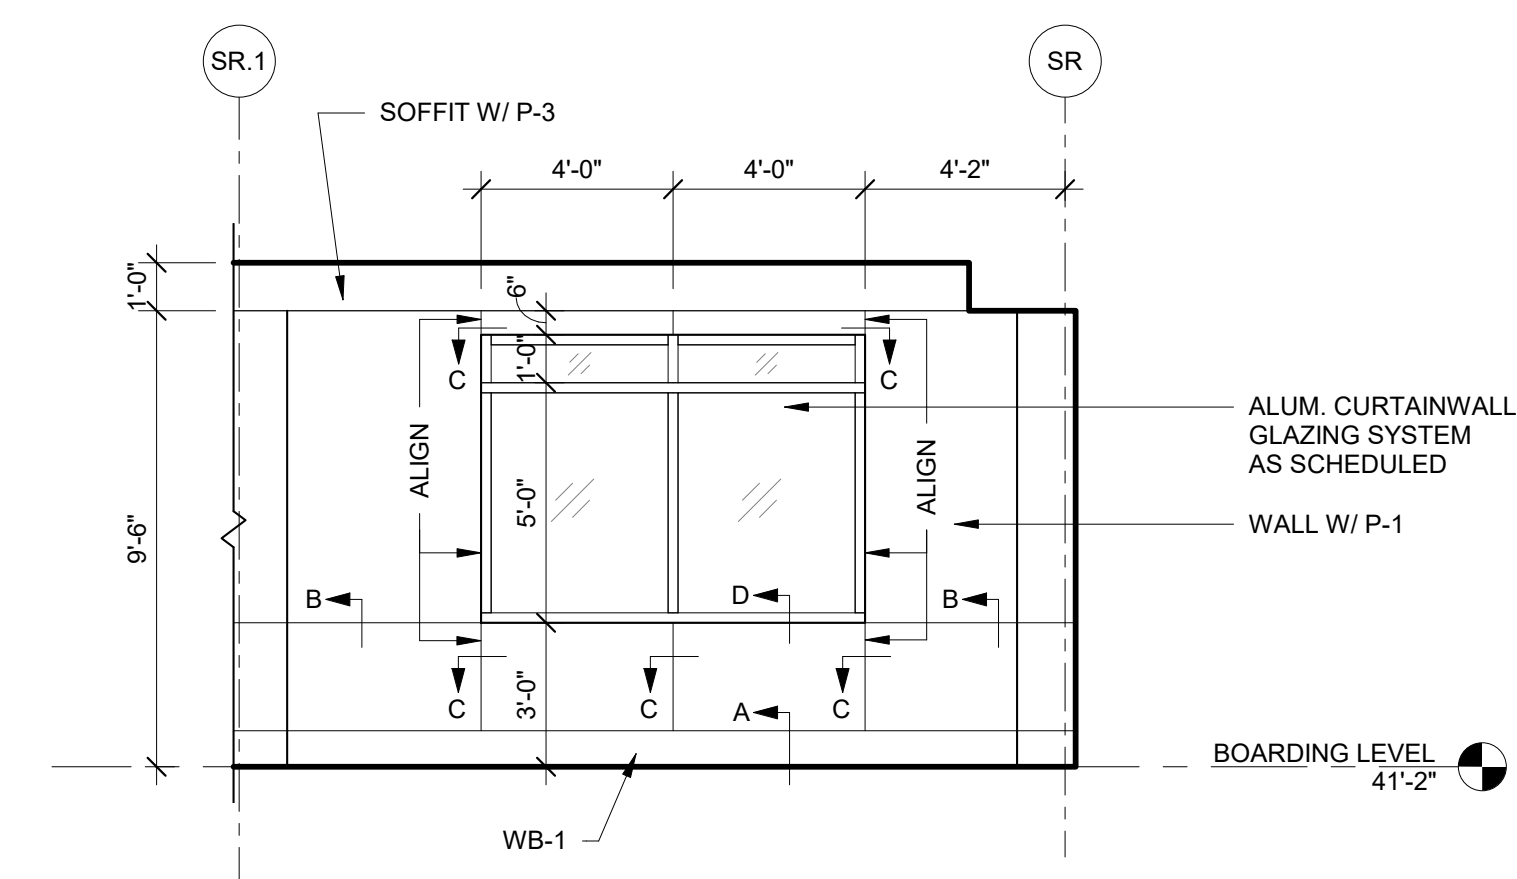


**11 NORTH WEST INTERIOR ELEVATION - ZONE 2**  
1/4" = 1'-0"

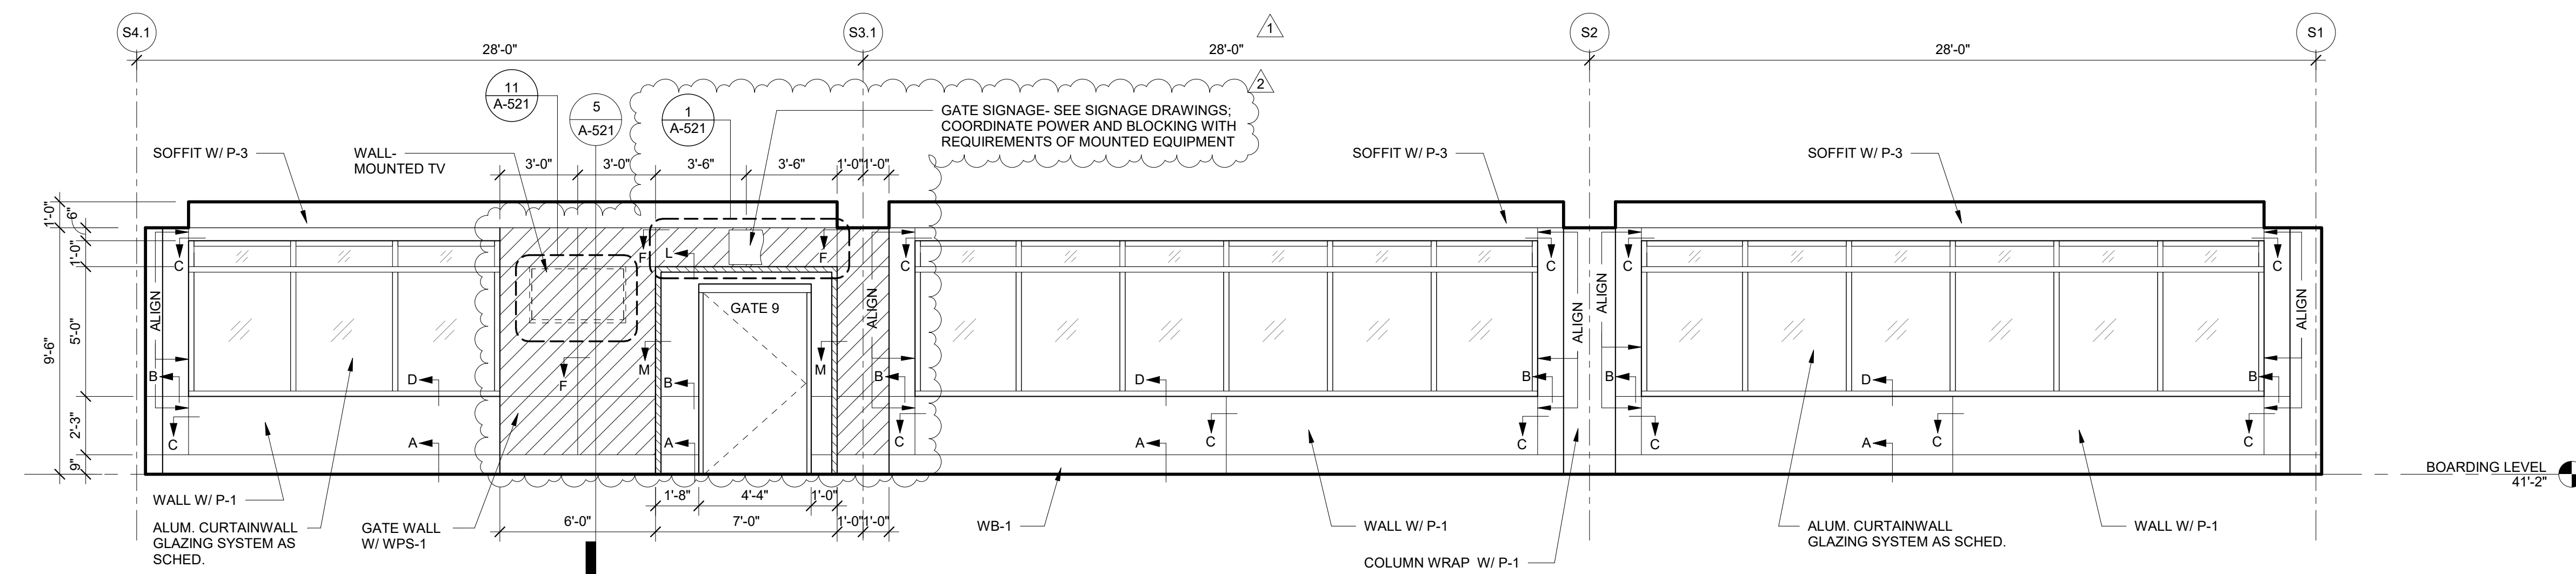

**6 NORTH EAST INTERIOR ELEVATION - ZONE 2**  
1/4" = 1'-0"

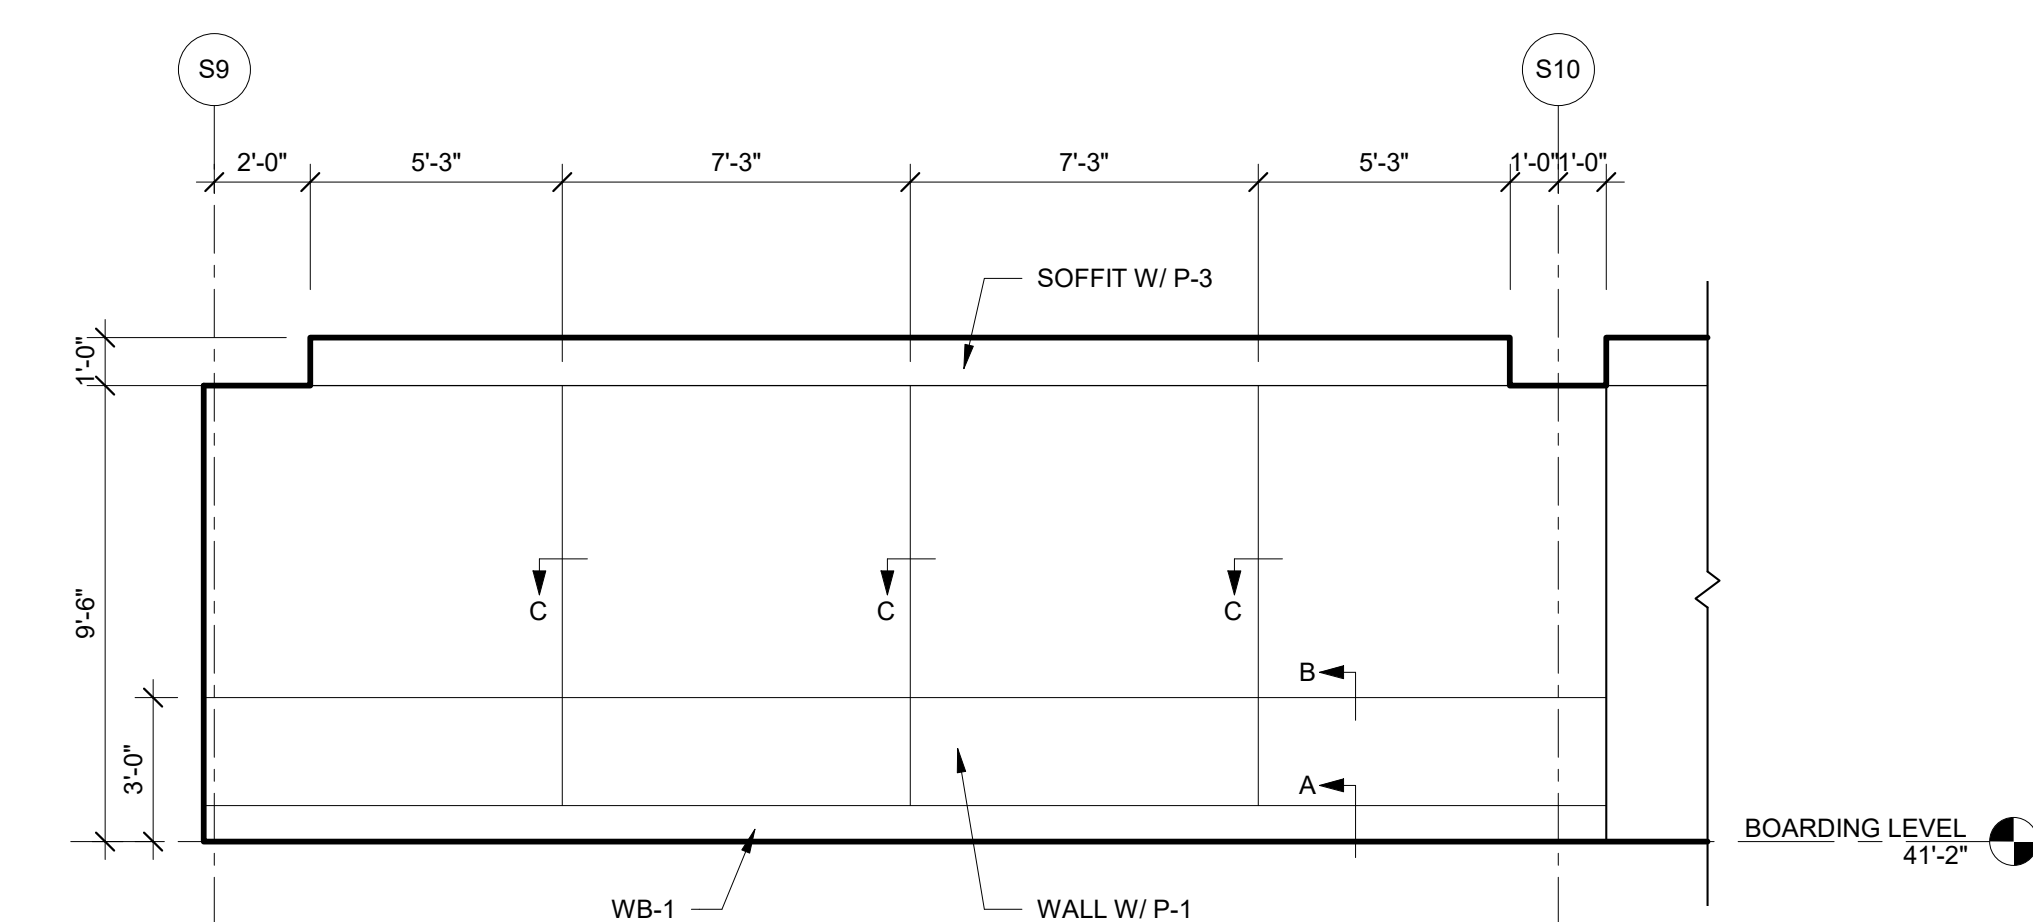

**1 SOUTH WEST INTERIOR ELEVATION - ZONE 2**  
1/4" = 1'-0"

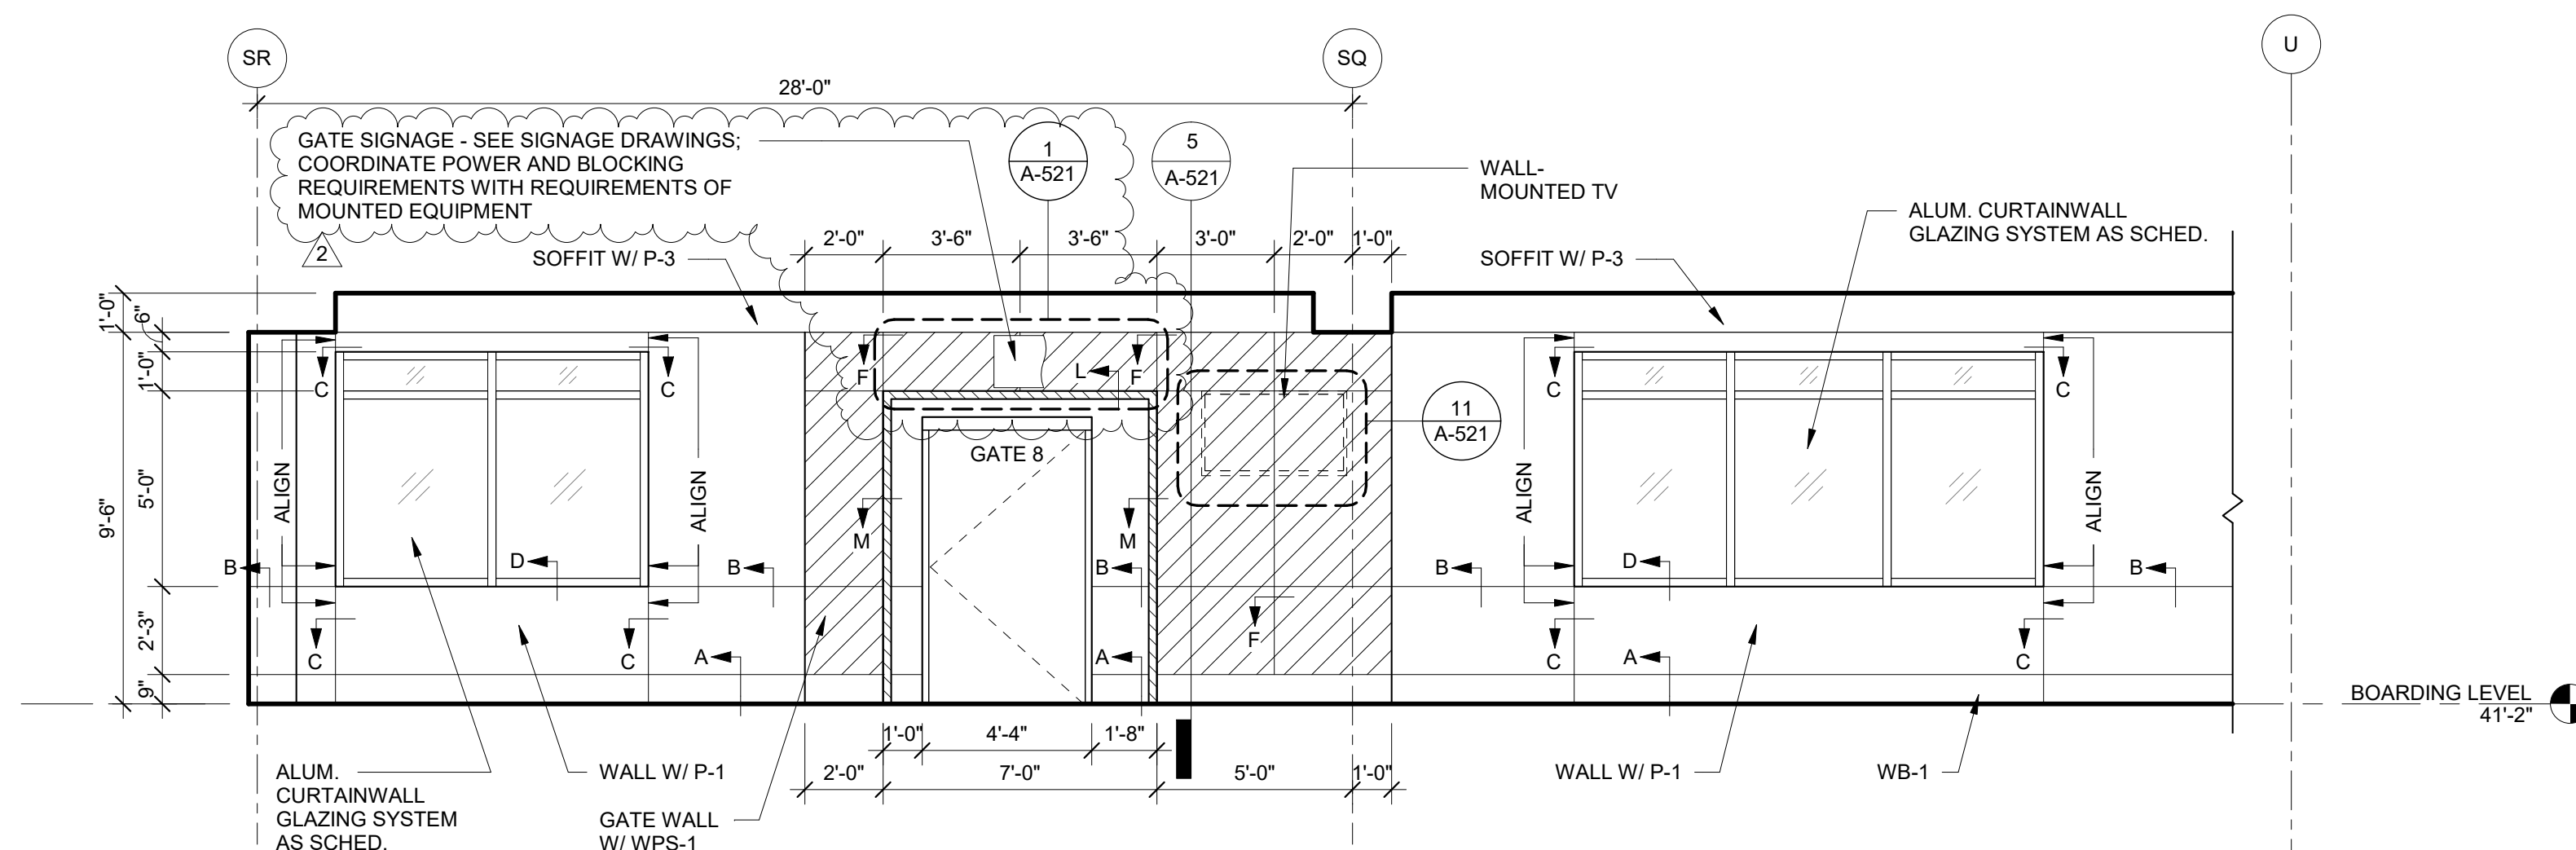

**3 SOUTH EAST INTERIOR ELEVATION - ZONE 2**  
1/4" = 1'-0"



**GENERAL NOTES - INTERIOR ELEVATIONS**

- REFER TO SHEET A-654 FOR WALL BASE, WALL, AND PANEL REVEAL DETAILS.
- ABBREVIATIONS:
  - CLR = CENTERLINE OF REVEAL
  - TOR = TOP OF REVEAL
  - BOR = BOTTOM OF REVEAL
- CONTRACTOR TO PROVIDE SHOP DRAWINGS TO ARCHITECT FOR REVIEW AND APPROVAL OF ALL SPECIALTY WALL PANEL SYSTEMS (WPS) PRIOR TO PROCUREMENT, FABRICATION, AND INSTALLATION.
- CONTRACTOR TO PROVIDE MOCKUPS OF EACH SPECIALTY WALL PANEL SYSTEM (WPS) FOR REVIEW AND APPROVAL PRIOR TO PROCUREMENT, FABRICATION, AND INSTALLATION.
- ALL VERTICAL AND HORIZONTAL REVEALS ARE TO BE CONTINUOUS AND UNINTERRUPTED, U.N.O.
- ALL DEAD STOP EXTRUSIONS ARE TO BE CONTINUOUS AND UNINTERRUPTED.

**ILM**

**TERMINAL IMPROVEMENTS CONTRACT 3**

Wilmington International Airport  
1740 Airport Boulevard, Suite 12  
Wilmington, NC 28405

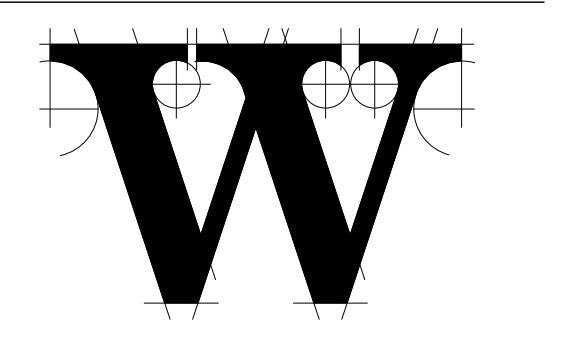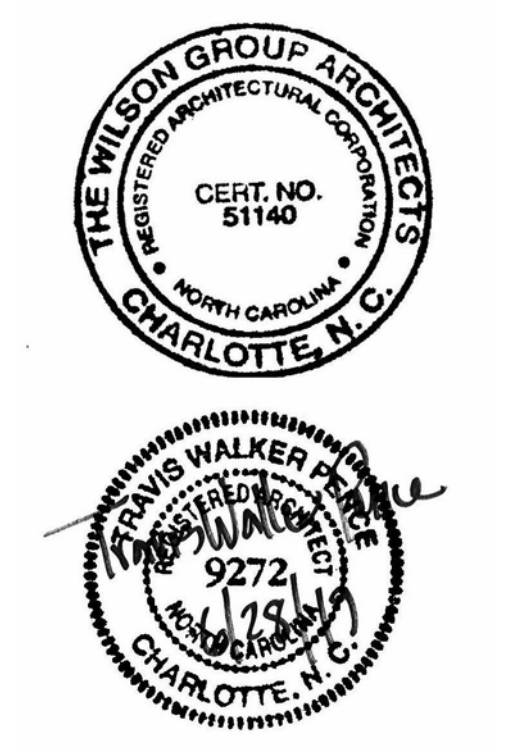

**THE WILSON GROUP**  
- ARCHITECTS -  
PO Box 5510 Charlotte, NC 28299  
704-331-9747 • www.twgarchitects.com

PROJECT MANAGER & CIVIL ENGINEER  
**TALBERT & BRIGHT**  
CONSULTING ARCHITECT  
LS3P

STRUCTURAL ENGINEER  
**STEWART**

FP/IME ENGINEER  
**CHEATHAM & ASSOC.**

BAGGAGE HANDLING CONSULTANTS  
**BNP**

AIRCRAFT SUPPORT SYSTEMS  
**DK CONSULTANTS**

SPECIALTY LIGHTING CONSULTANT  
**HARTRANFT**

SIGNAGE & WAYFINDING  
**TAKEFORM**

COPYRIGHT © 2019  
THE WILSON GROUP ARCHITECTS  
ALL RIGHTS RESERVED

PRINTED OR ELECTRONIC DRAWINGS AND DOCUMENTATION MAY NOT BE REPRODUCED IN ANY FORM WITHOUT WRITTEN PERMISSION FROM THE WILSON GROUP ARCHITECTS


REVISIONS

1 7/30/2019 AD-03


DATE 6/28/2019  
PROJECT NUMBER 9202-000  
SHEET TITLE

**SCHEDULE 1 - INTERIOR ELEVATIONS**


SHEET NUMBER  
**A1-253**

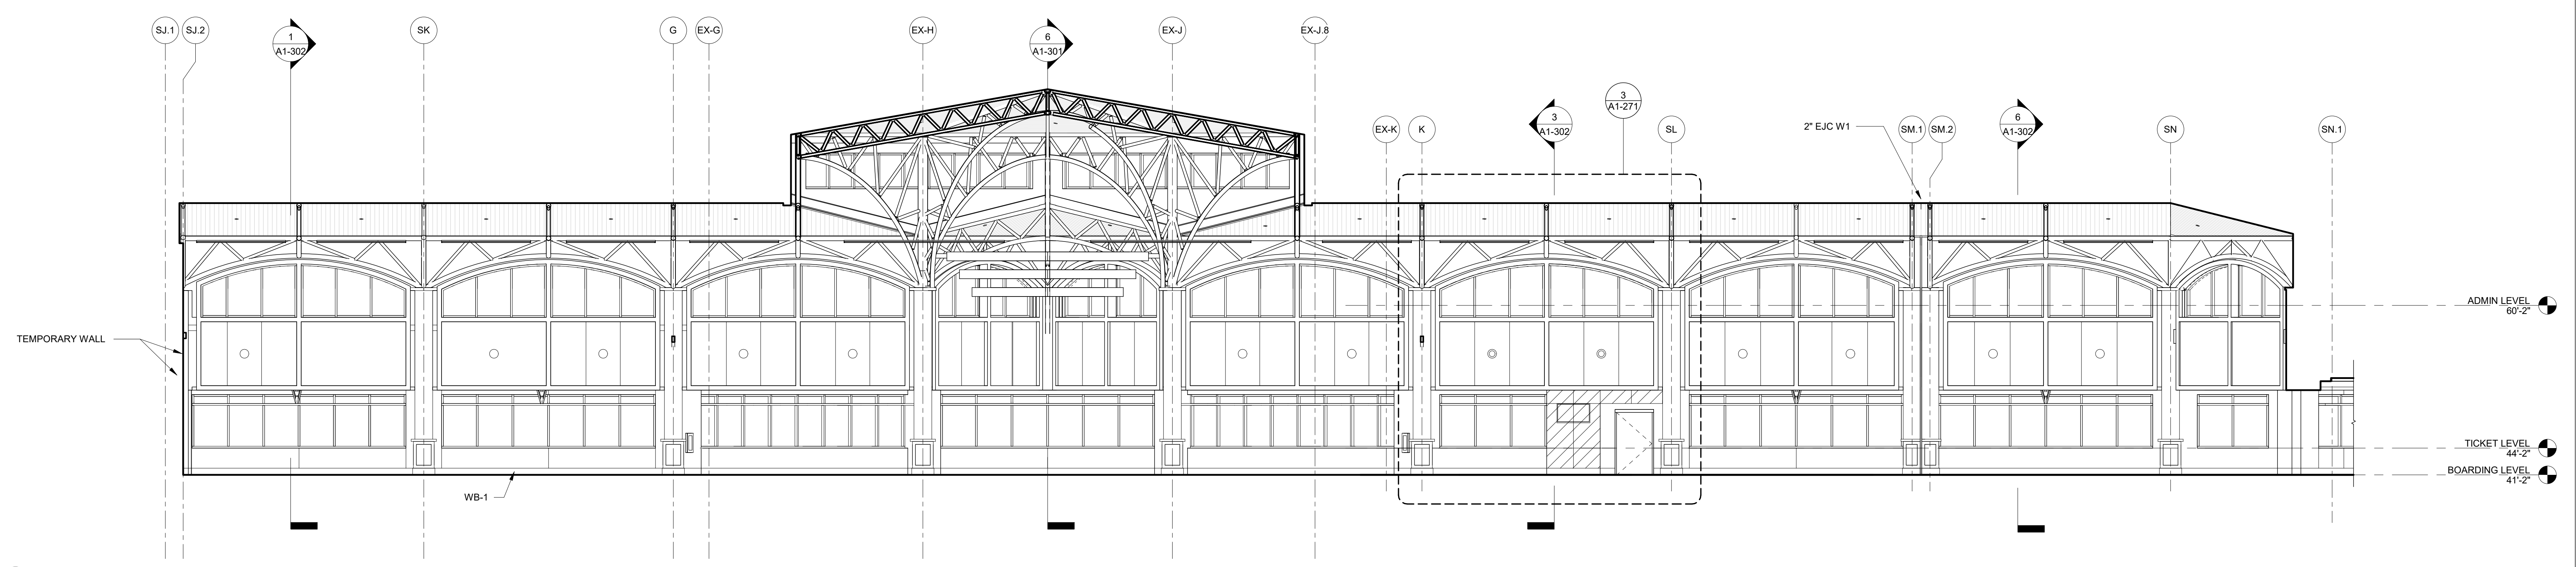

**6** INTERIOR ELEVATION  
1/8" = 1'-0"

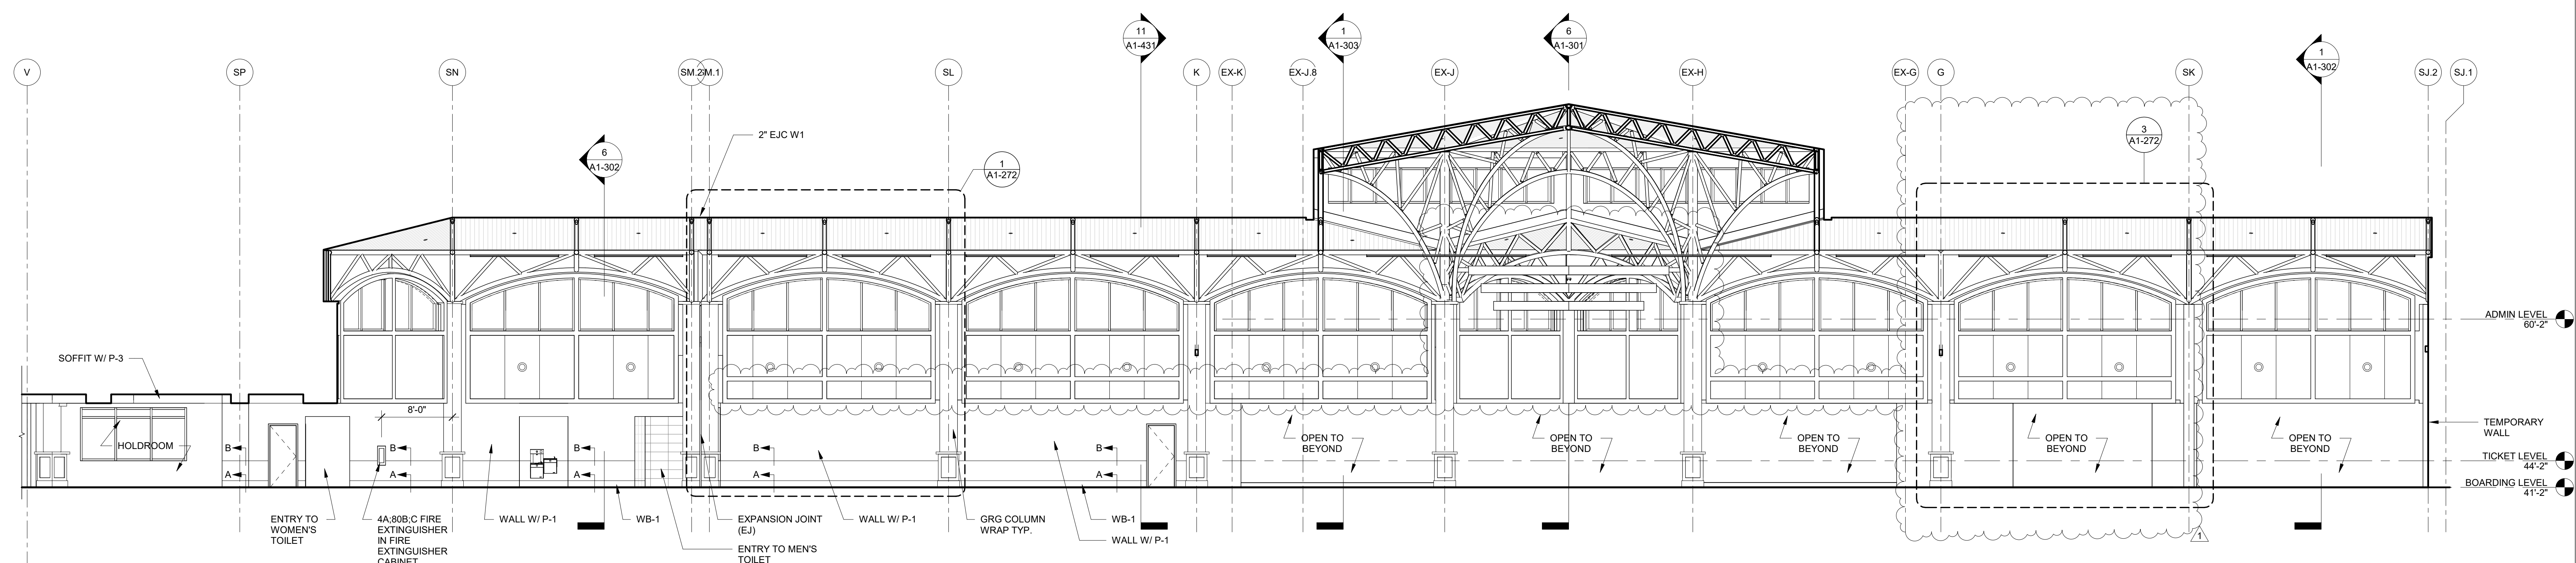

**1** INTERIOR ELEVATION  
1/8" = 1'-0"

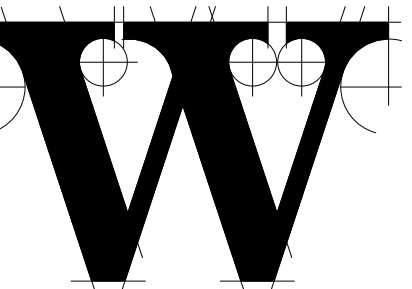

**REVISIONS**

1 7/30/2019 AD-03

DATE 6/28/2019  
PROJECT NUMBER 9202-000  
SHEET TITLE


**SCHEDULE 1 - ENLARGED INTERIOR ELEVATIONS**

SHEET NUMBER


**A1-272**

**GENERAL NOTES - INTERIOR ELEVATIONS**

1. REFER TO SHEET A-654 FOR WALL BASE, WALL, AND PANEL REVEAL DETAILS.
2. ABBREVIATIONS:
  - CLR = CENTERLINE OF REVEAL
  - TOR = TOP OF REVEAL
  - BOT = BOTTOM OF REVEAL
3. CONTRACTOR TO PROVIDE SHOP DRAWINGS TO ARCHITECT FOR REVIEW AND APPROVAL OF ALL SPECIALTY WALL PANEL SYSTEMS (WPS) PRIOR TO PROCUREMENT, FABRICATION, AND INSTALLATION.
4. CONTRACTOR TO PROVIDE MOCKUPS OF EACH SPECIALTY WALL PANEL SYSTEM (WPS) FOR REVIEW AND APPROVAL PRIOR TO PROCUREMENT, FABRICATION, AND INSTALLATION.
5. ALL VERTICAL AND HORIZONTAL REVEALS ARE TO BE CONTINUOUS AND UNINTERRUPTED, U.N.O.
6. ALL DEAD STOP EXTRUSIONS ARE TO BE CONTINUOUS AND UNINTERRUPTED.

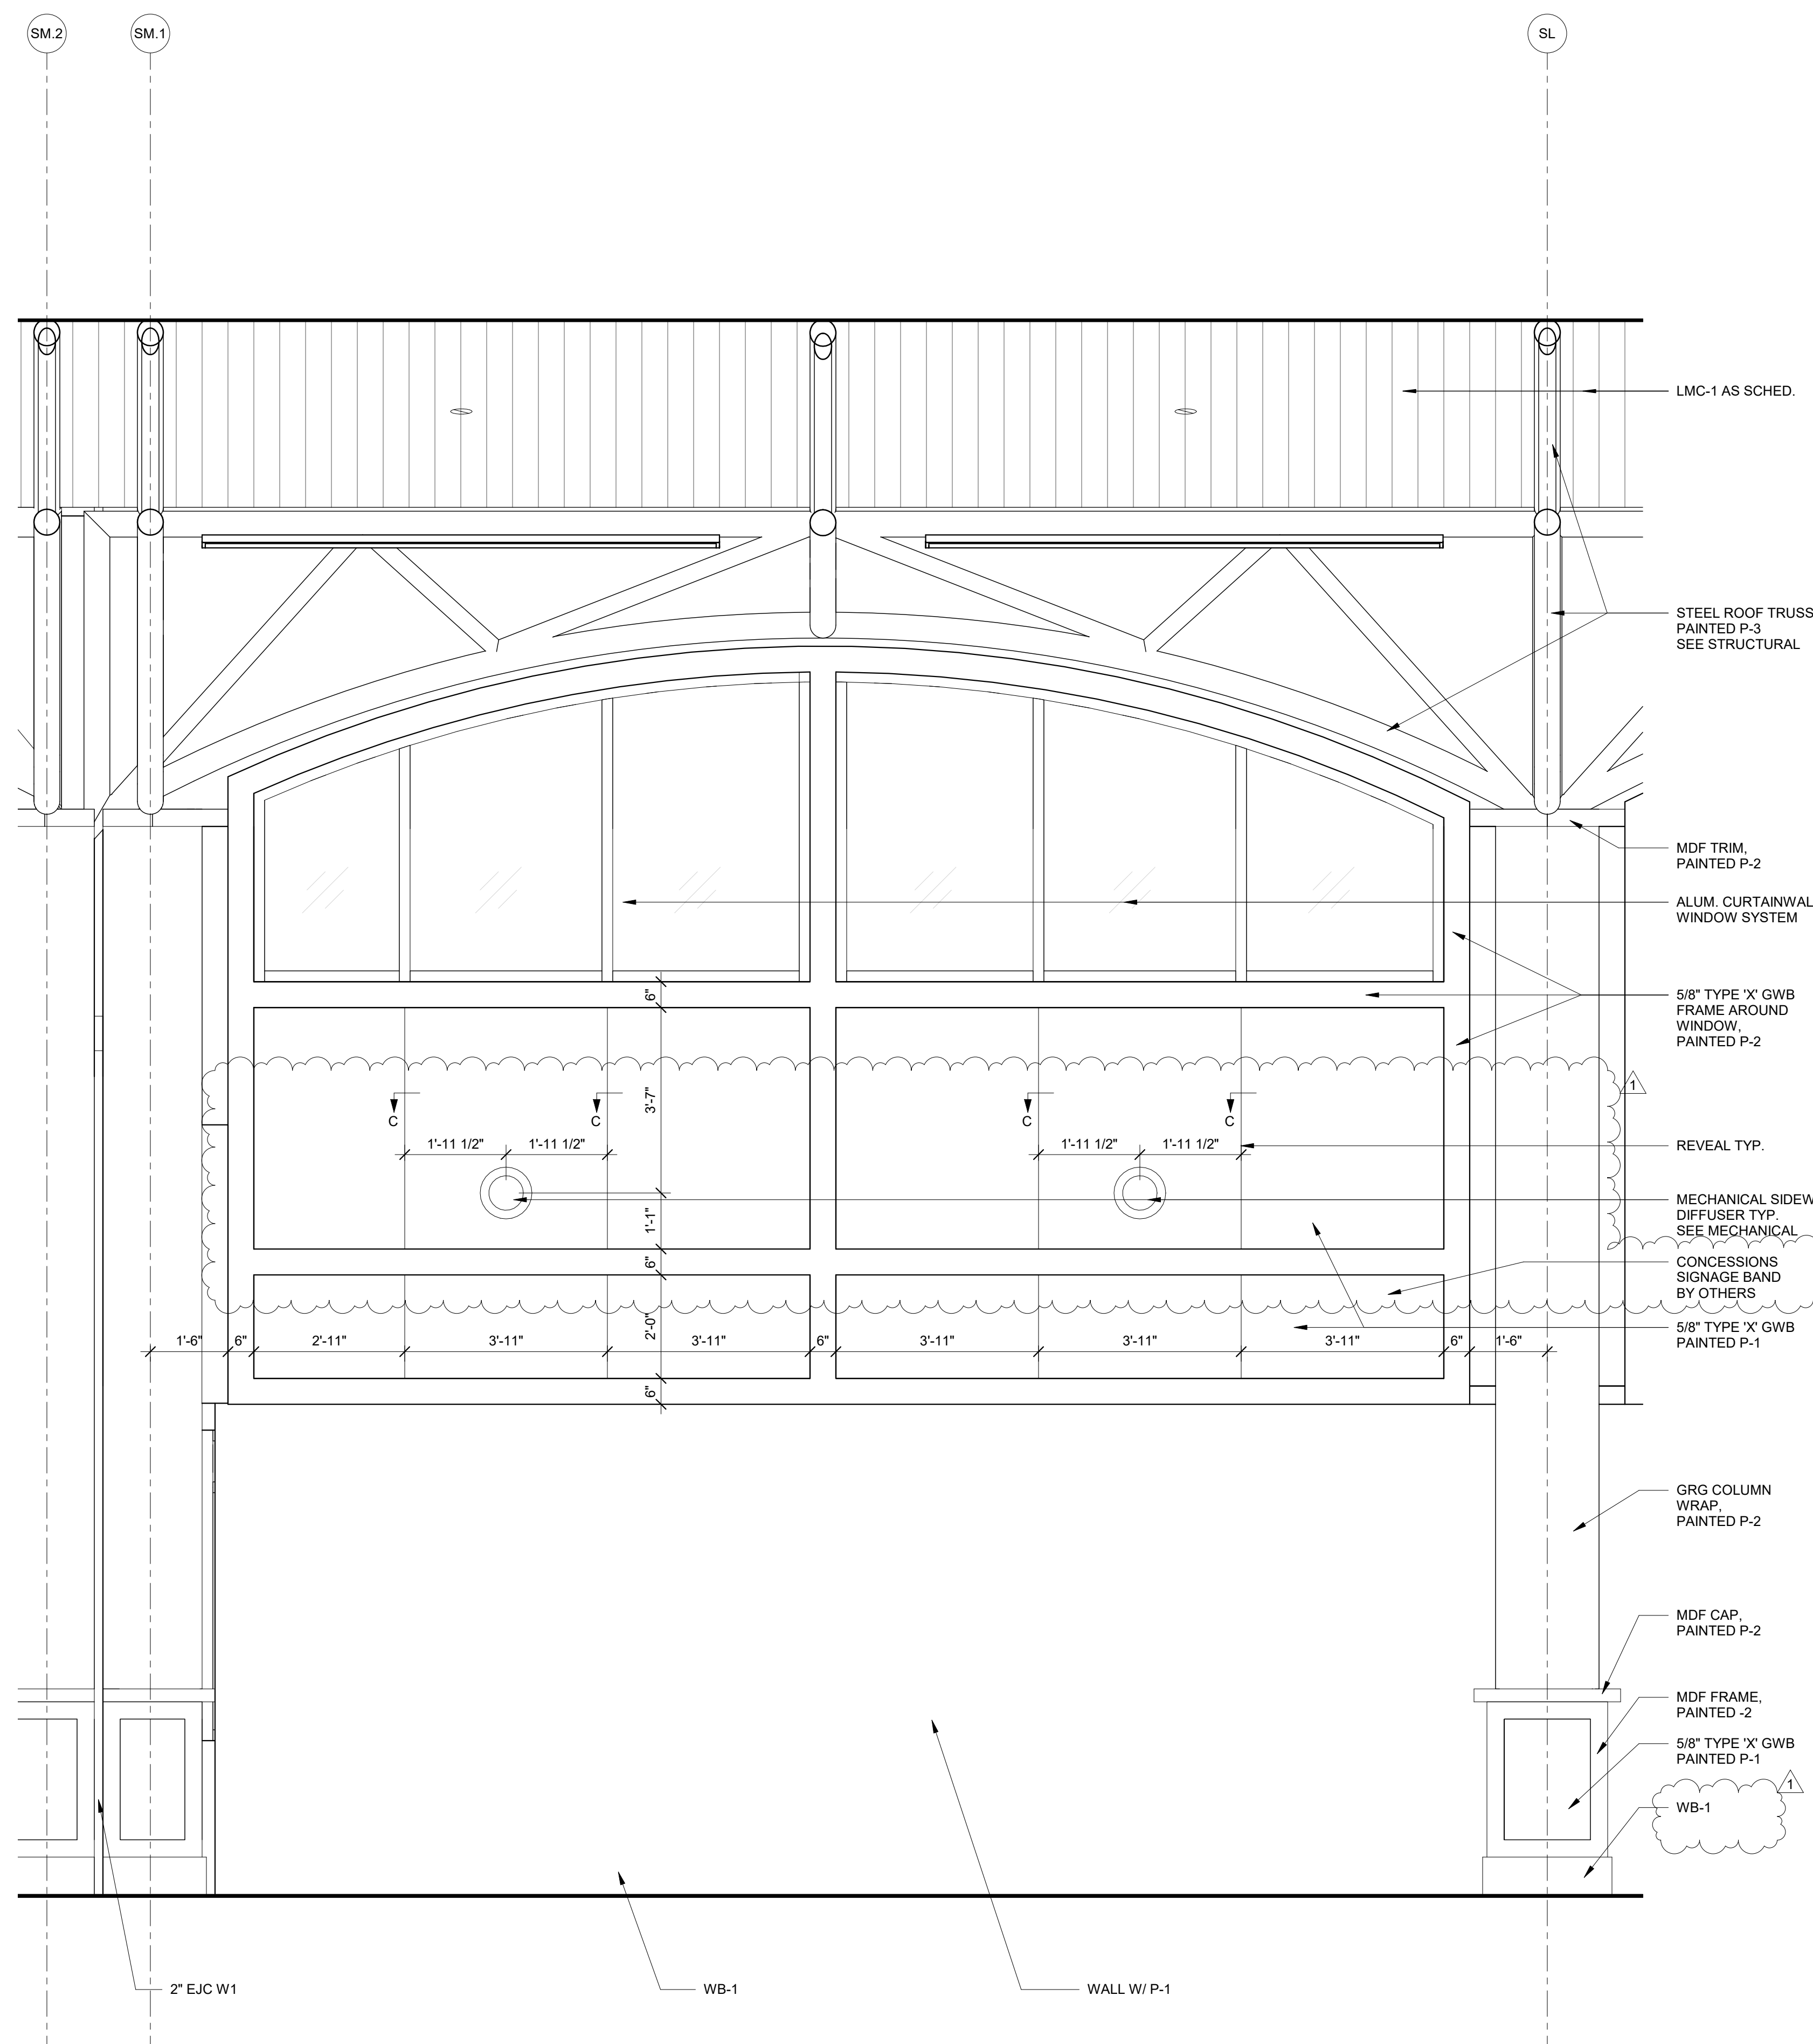

**1 TYPICAL CONCESSION EJ TYP. BAY**  
1/2" = 1'-0"

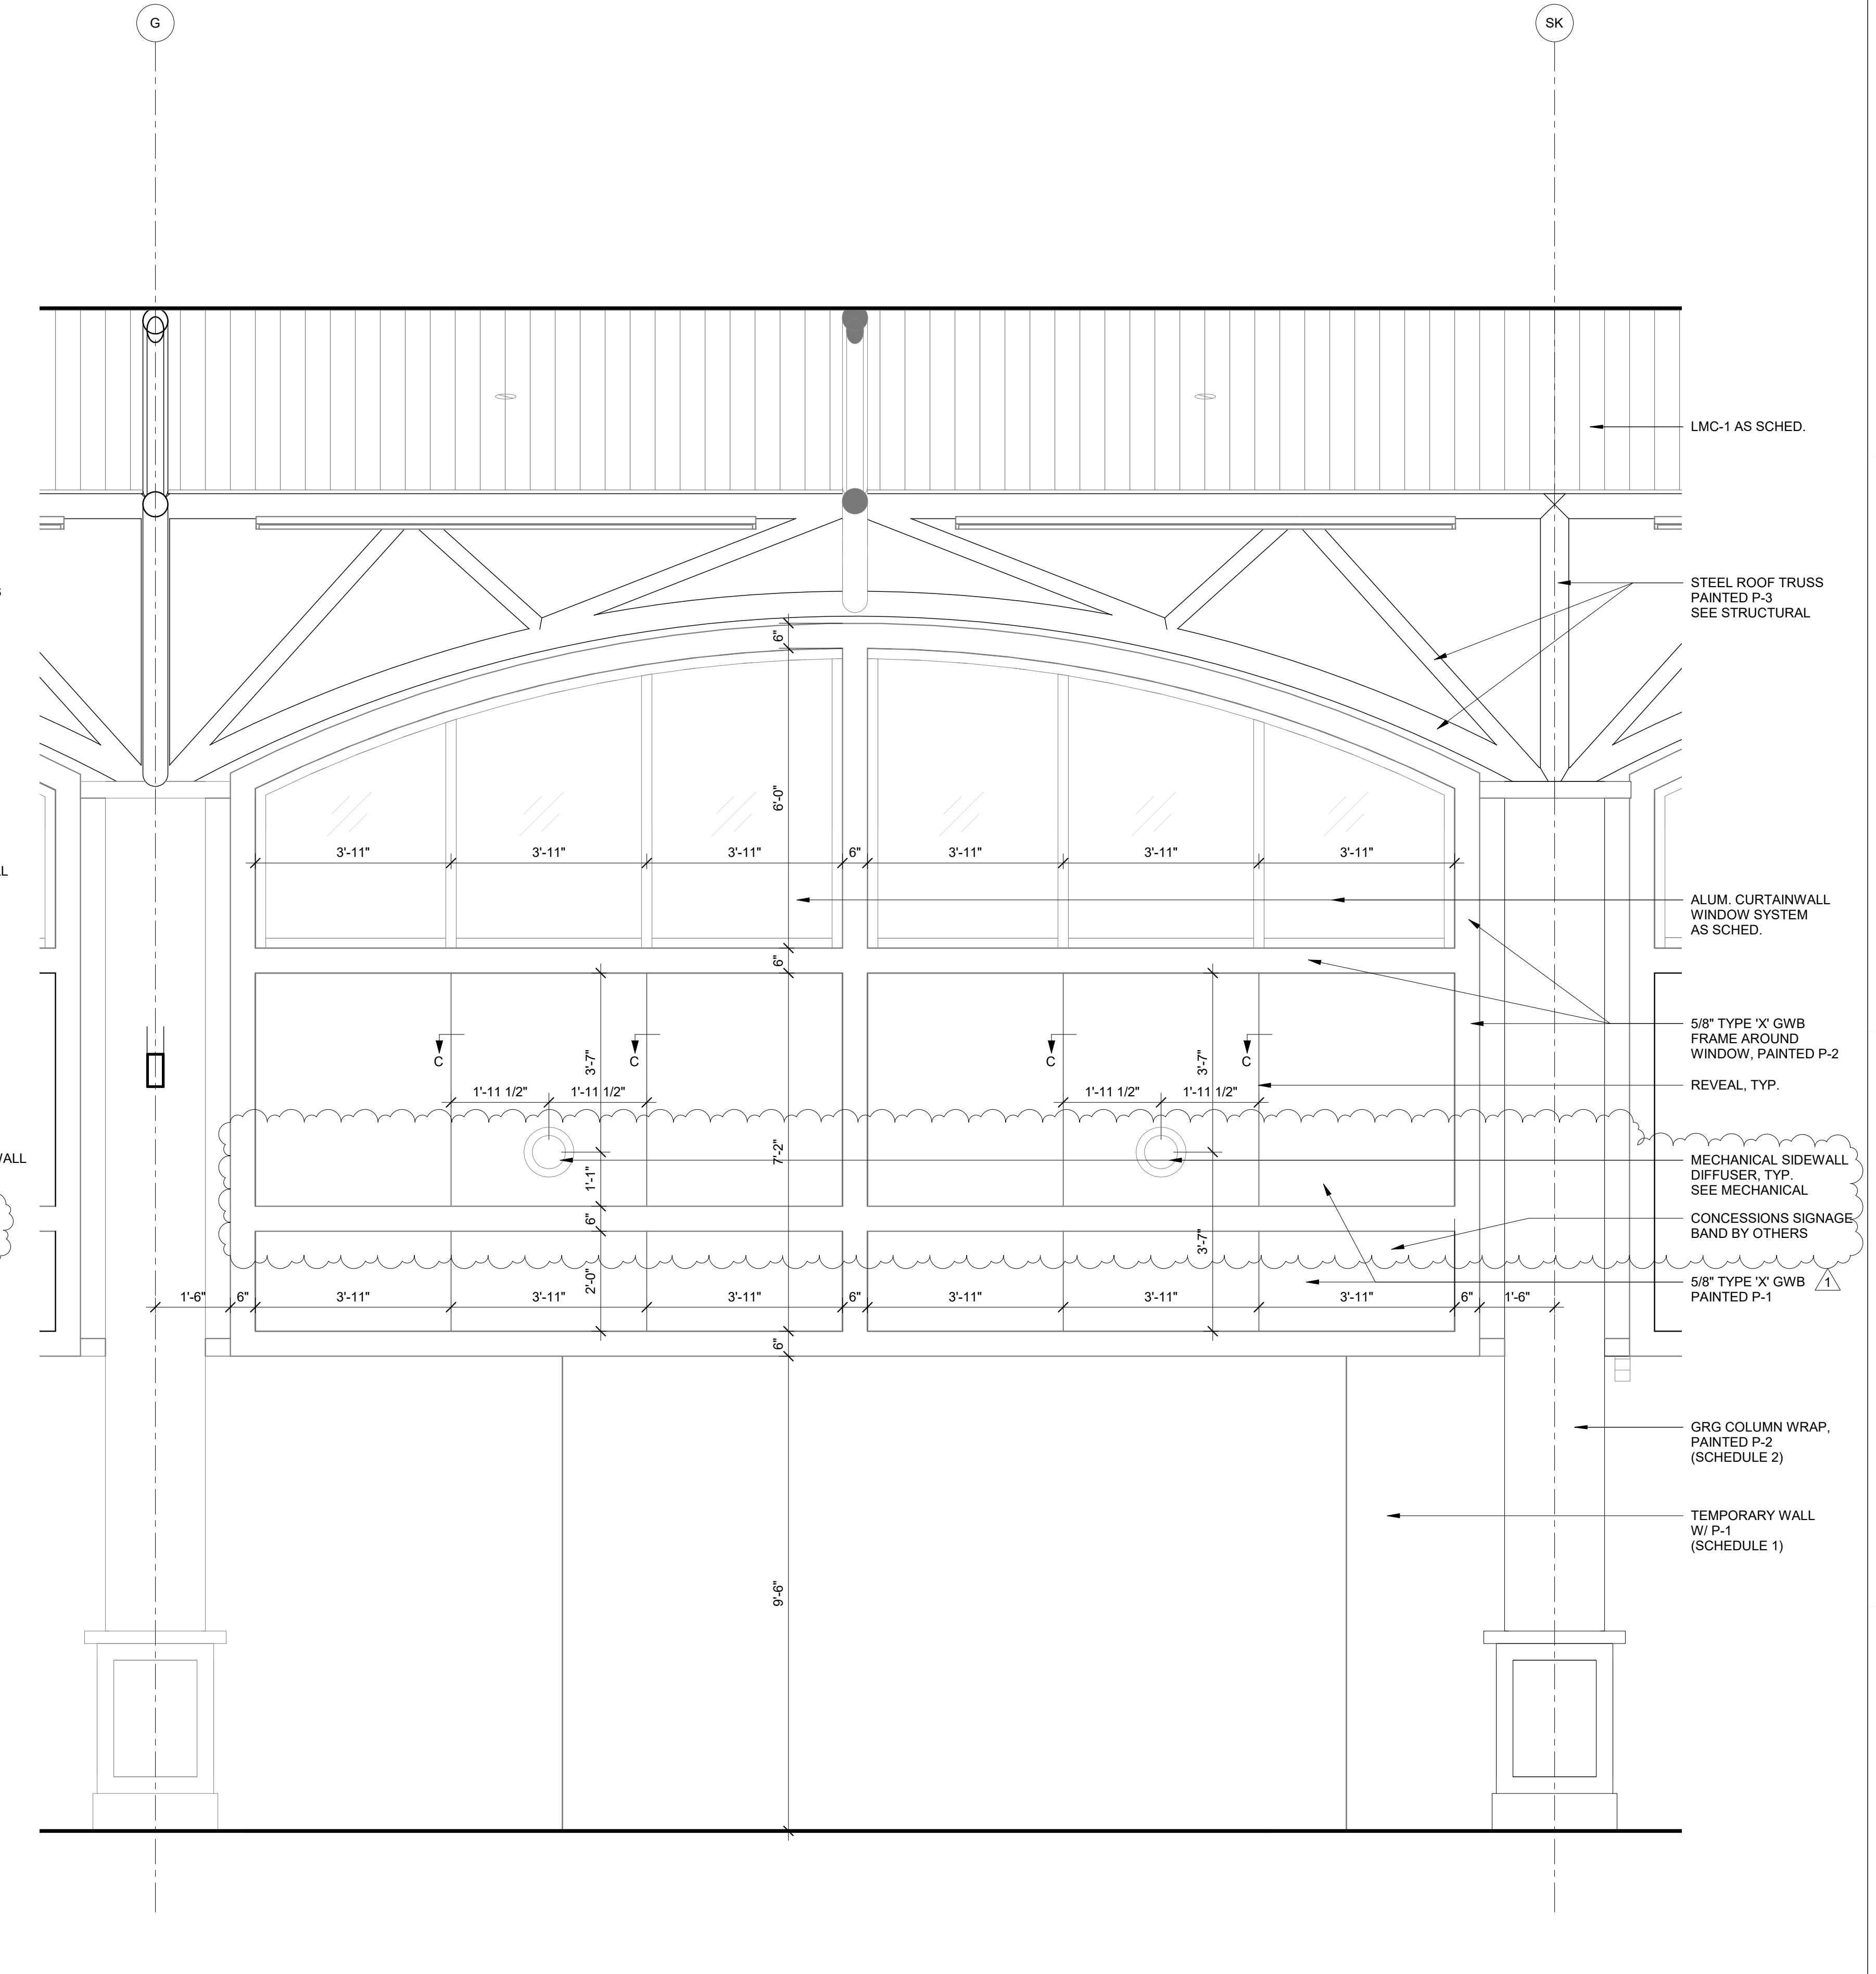


**3 TYPICAL CONCESSION WALL BAY**  
1/2" = 1'-0"



TERMINAL IMPROVEMENTS CONTRACT 3

Wilmington International Airport  
1740 Airport Boulevard, Suite 12  
Wilmington, NC 28405

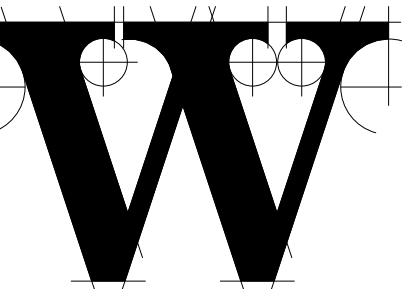

THE WILSON GROUP ARCHITECTS

PO Box 5510 Charlotte, NC 28299  
704-331-9747 • www.twgarchitects.com

PROJECT MANAGER & CIVIL ENGINEER  
**TALBERT & BRIGHT**

CONSULTING ARCHITECT  
**LS3P**

STRUCTURAL ENGINEER  
**STEWART**

FPI/PI/E ENGINEER  
**CHEATHAM & ASSOC.**

BAGGAGE HANDLING CONSULTANTS  
**BNP**

AIRCRAFT SUPPORT SYSTEMS  
**DK CONSULTANTS**

SPECIALTY LIGHTING CONSULTANT  
**HARTRANFT**

SIGNAGE & WAYFINDING  
**TAKEFORM**

COPYRIGHT © 2019  
THE WILSON GROUP ARCHITECTS  
ALL RIGHTS RESERVED

PRINTED OR ELECTRONIC DRAWINGS AND DOCUMENTATION MAY NOT BE REPRODUCED IN ANY FORM WITHOUT WRITTEN PERMISSION FROM THE WILSON GROUP ARCHITECTS

REVISIONS


- 1 7/12/2019 AD-01
- 2 7/30/2019 AD-03

DATE 7/12/2019  
PROJECT NUMBER 9202-000  
SHEET TITLE


SCHEDULE 1 - ENLARGED FLOOR PLANS

SHEET NUMBER


**A1-401**

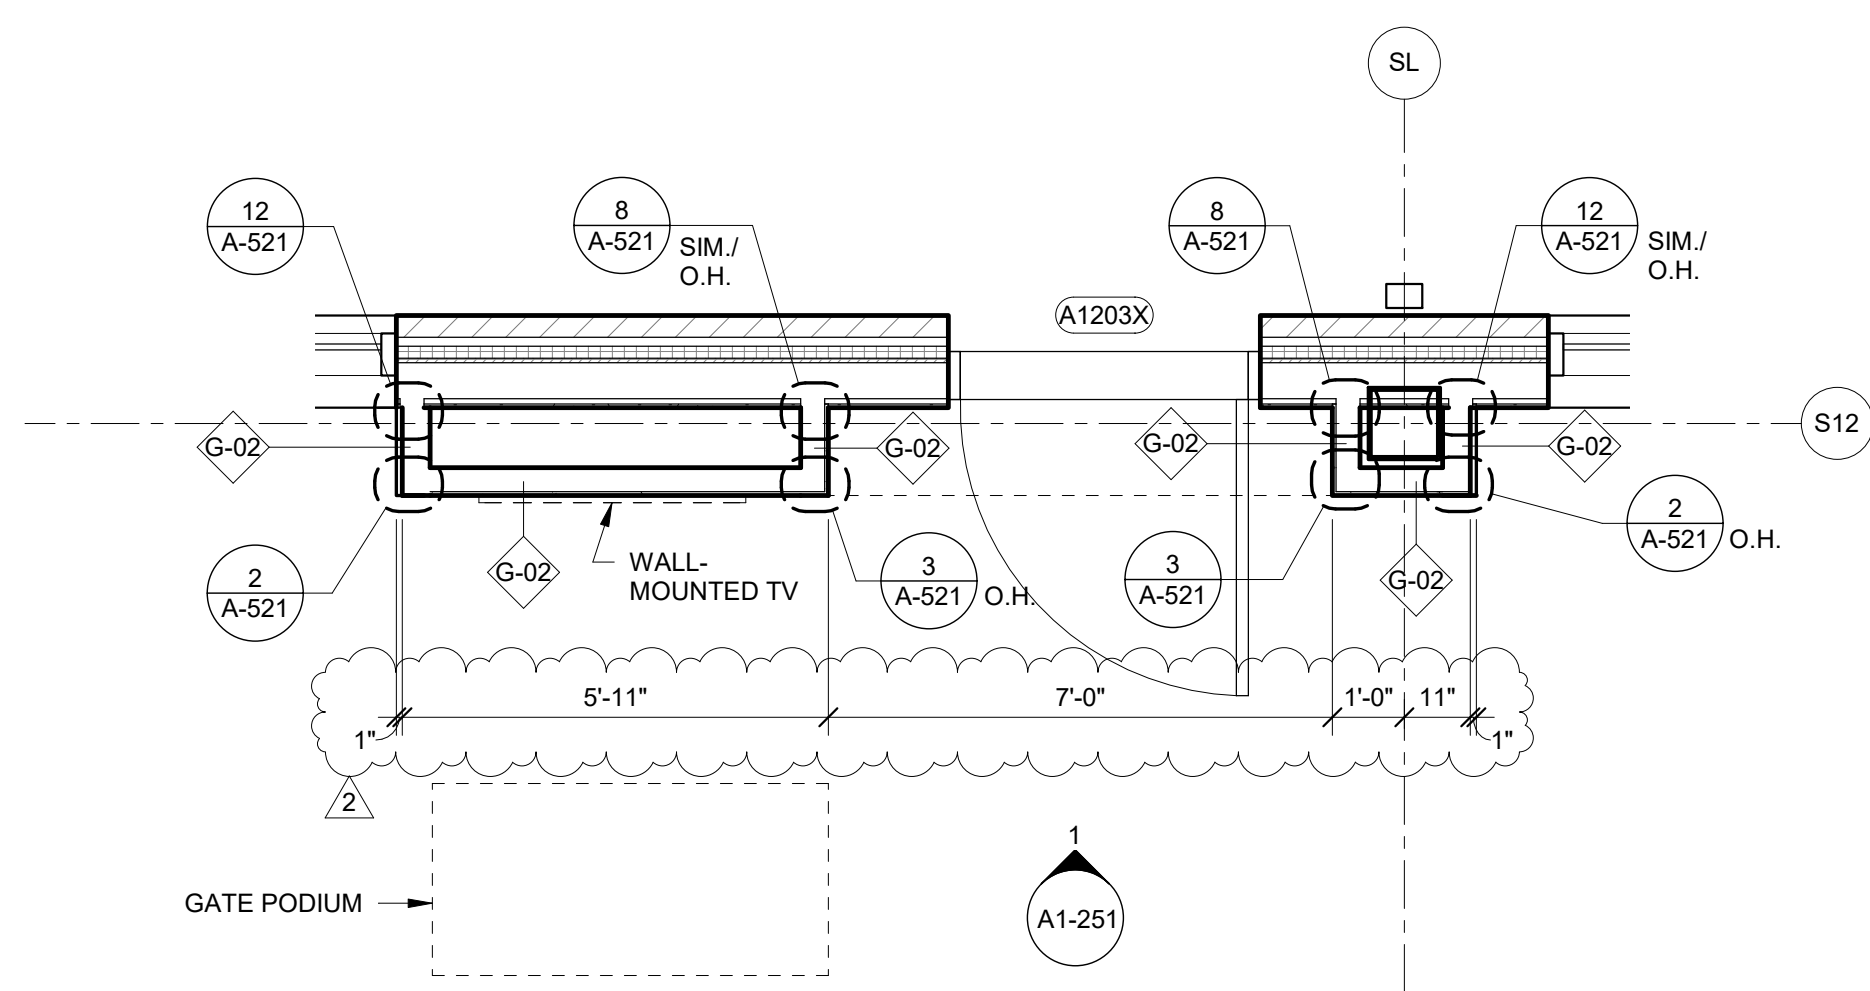

1 ENLARGED FLOOR PLAN AT ZONE 2 (GATE 7)  
3/8" = 1'-0"

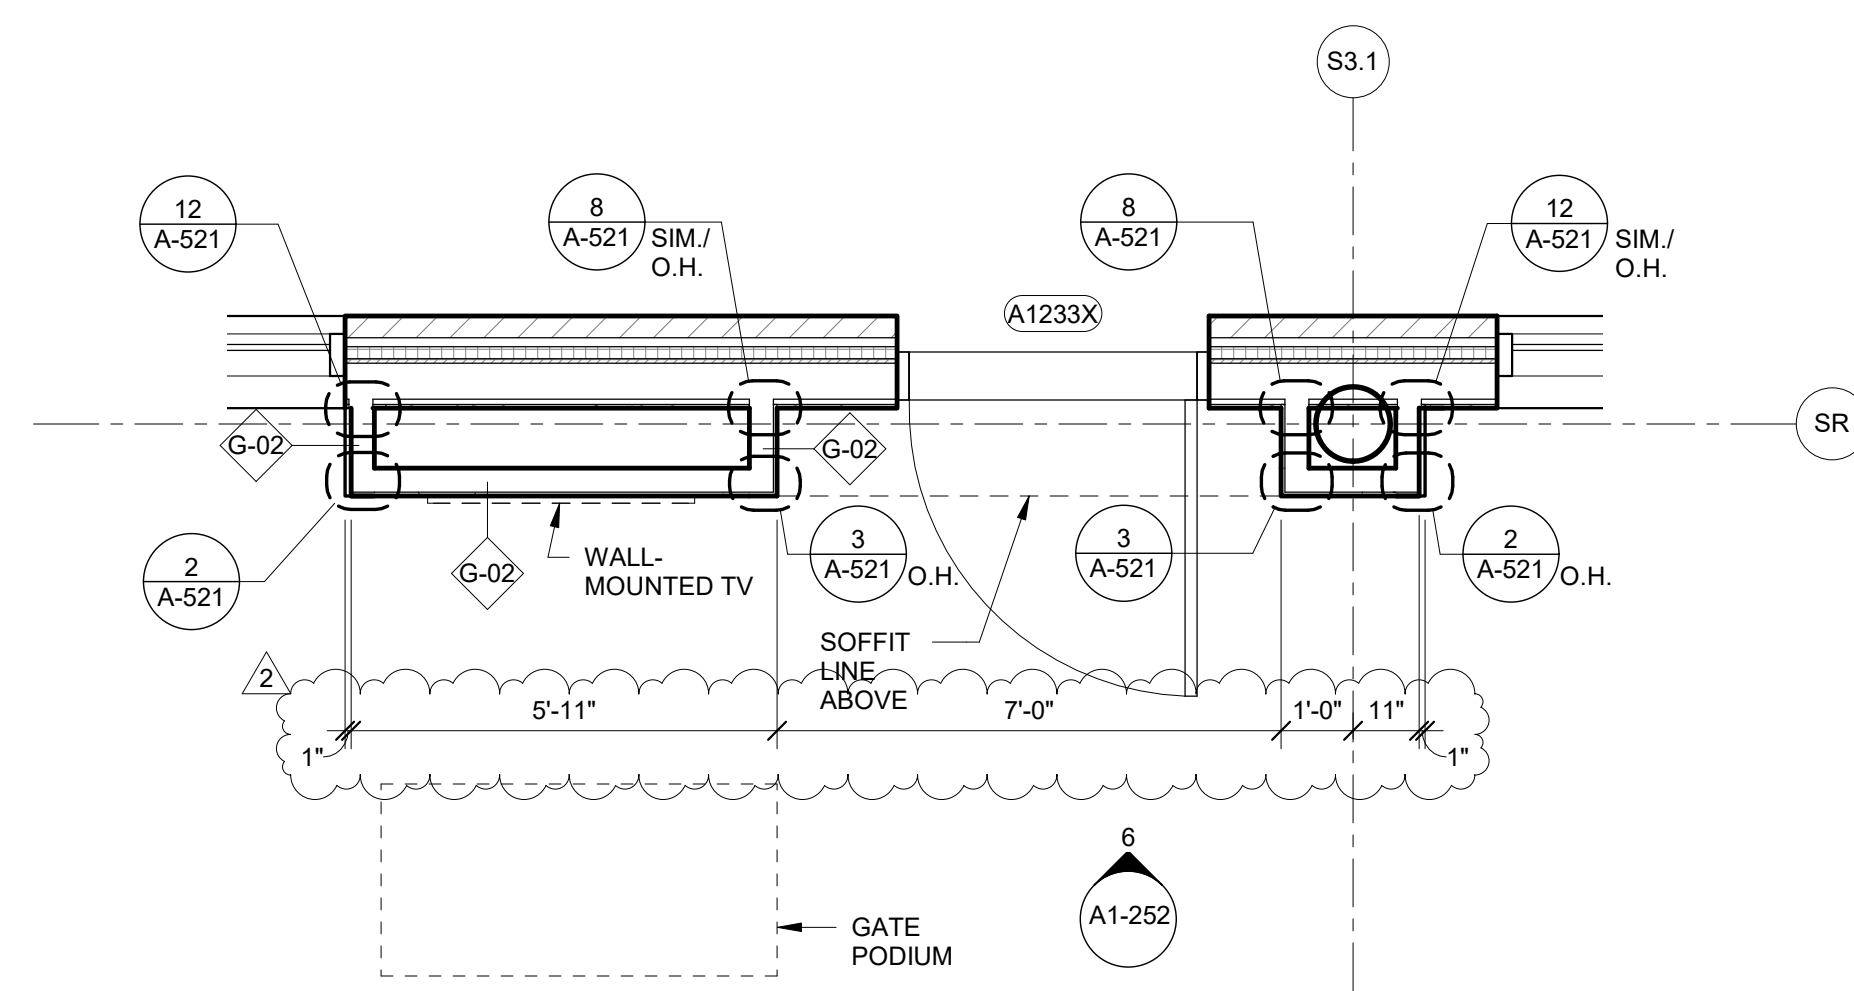

2 ENLARGED FLOOR PLAN AT ZONE 2 (GATE 9)  
3/8" = 1'-0"

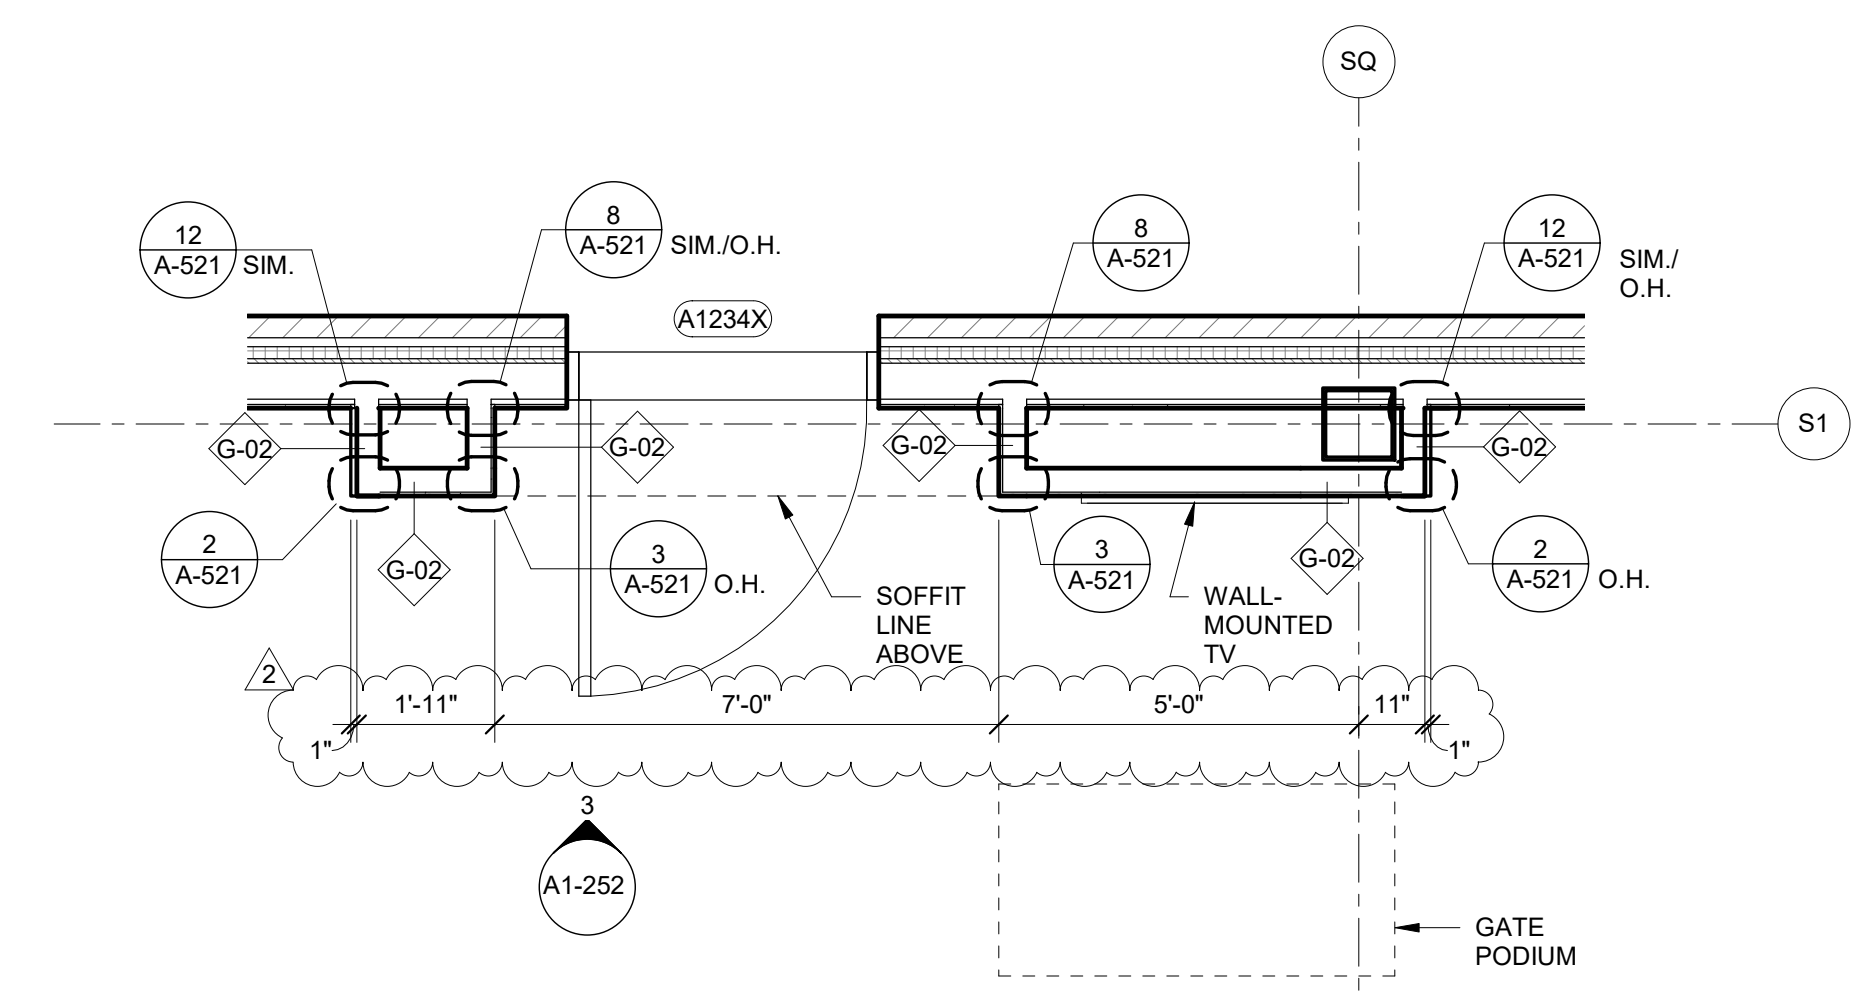


4 ENLARGED FLOOR PLAN AT ZONE 2 (GATE 8)  
3/8" = 1'-0"



GENERAL TOILET ACCESSORY AND BATHROOM FINISH NOTES  
 REFER TO SPECIFICATION SECTION 10 28 00 - TOILET ACCESSORIES FOR TOILET ACCESSORY LEGEND AND INFORMATION.

TOILET ACCESSORIES LEGEND	
SYMBOL	DESCRIPTION
TA-1A	24" X 48" LIGHTED LED MIRROR- SEE ELECTRICAL DRAWINGS
TA-1B	24" X 36" FRAMED MIRROR
TA-2	AUTOMATIC TOP-FILL COUNTER MOUNTED SOAP DISPENSER
TA-3	SURFACE MOUNTED SANITARY NAPKIN DISPENSER- BOBRICK B-270
TA-4	SURFACE MOUNTED SANITARY NAPKIN DISPENSER- BOBRICK B-4354
TA-5	COUNTER WASTE RECEPTACLE GROMMET
TA-6	MULTI-ROLL TOILET TISSUE DISPENSER
TA-7	18" GRAB BAR (VERTICAL)
TA-8	36" GRAB BAR (HORIZONTAL, REAR)
TA-9	42" GRAB BAR (HORIZONTAL, SIDE)
TA-10	SS COAT HOOK (CENTERED ON TOILET SIDE OF DOOR @ 60" A.F.F.)
TA-11	PAPER TOWEL DISPENSER
TA-12	BATTERY OPERATED WALL MOUNTED HAND SOAP DISPENSER
TA-14	BABY CHANGING STATION
TA-15	WASTE RECEPTACLE
TA-16	MOP AND BROOM HOLDER
TA-17	UNDERCOUNTER PULL OUT TRASH RECEPTACLE
TA-18	ADULT CHANGING STATION
TA-19	COMBINATION PAPER TOWEL AND WASTE RECEPTACLE

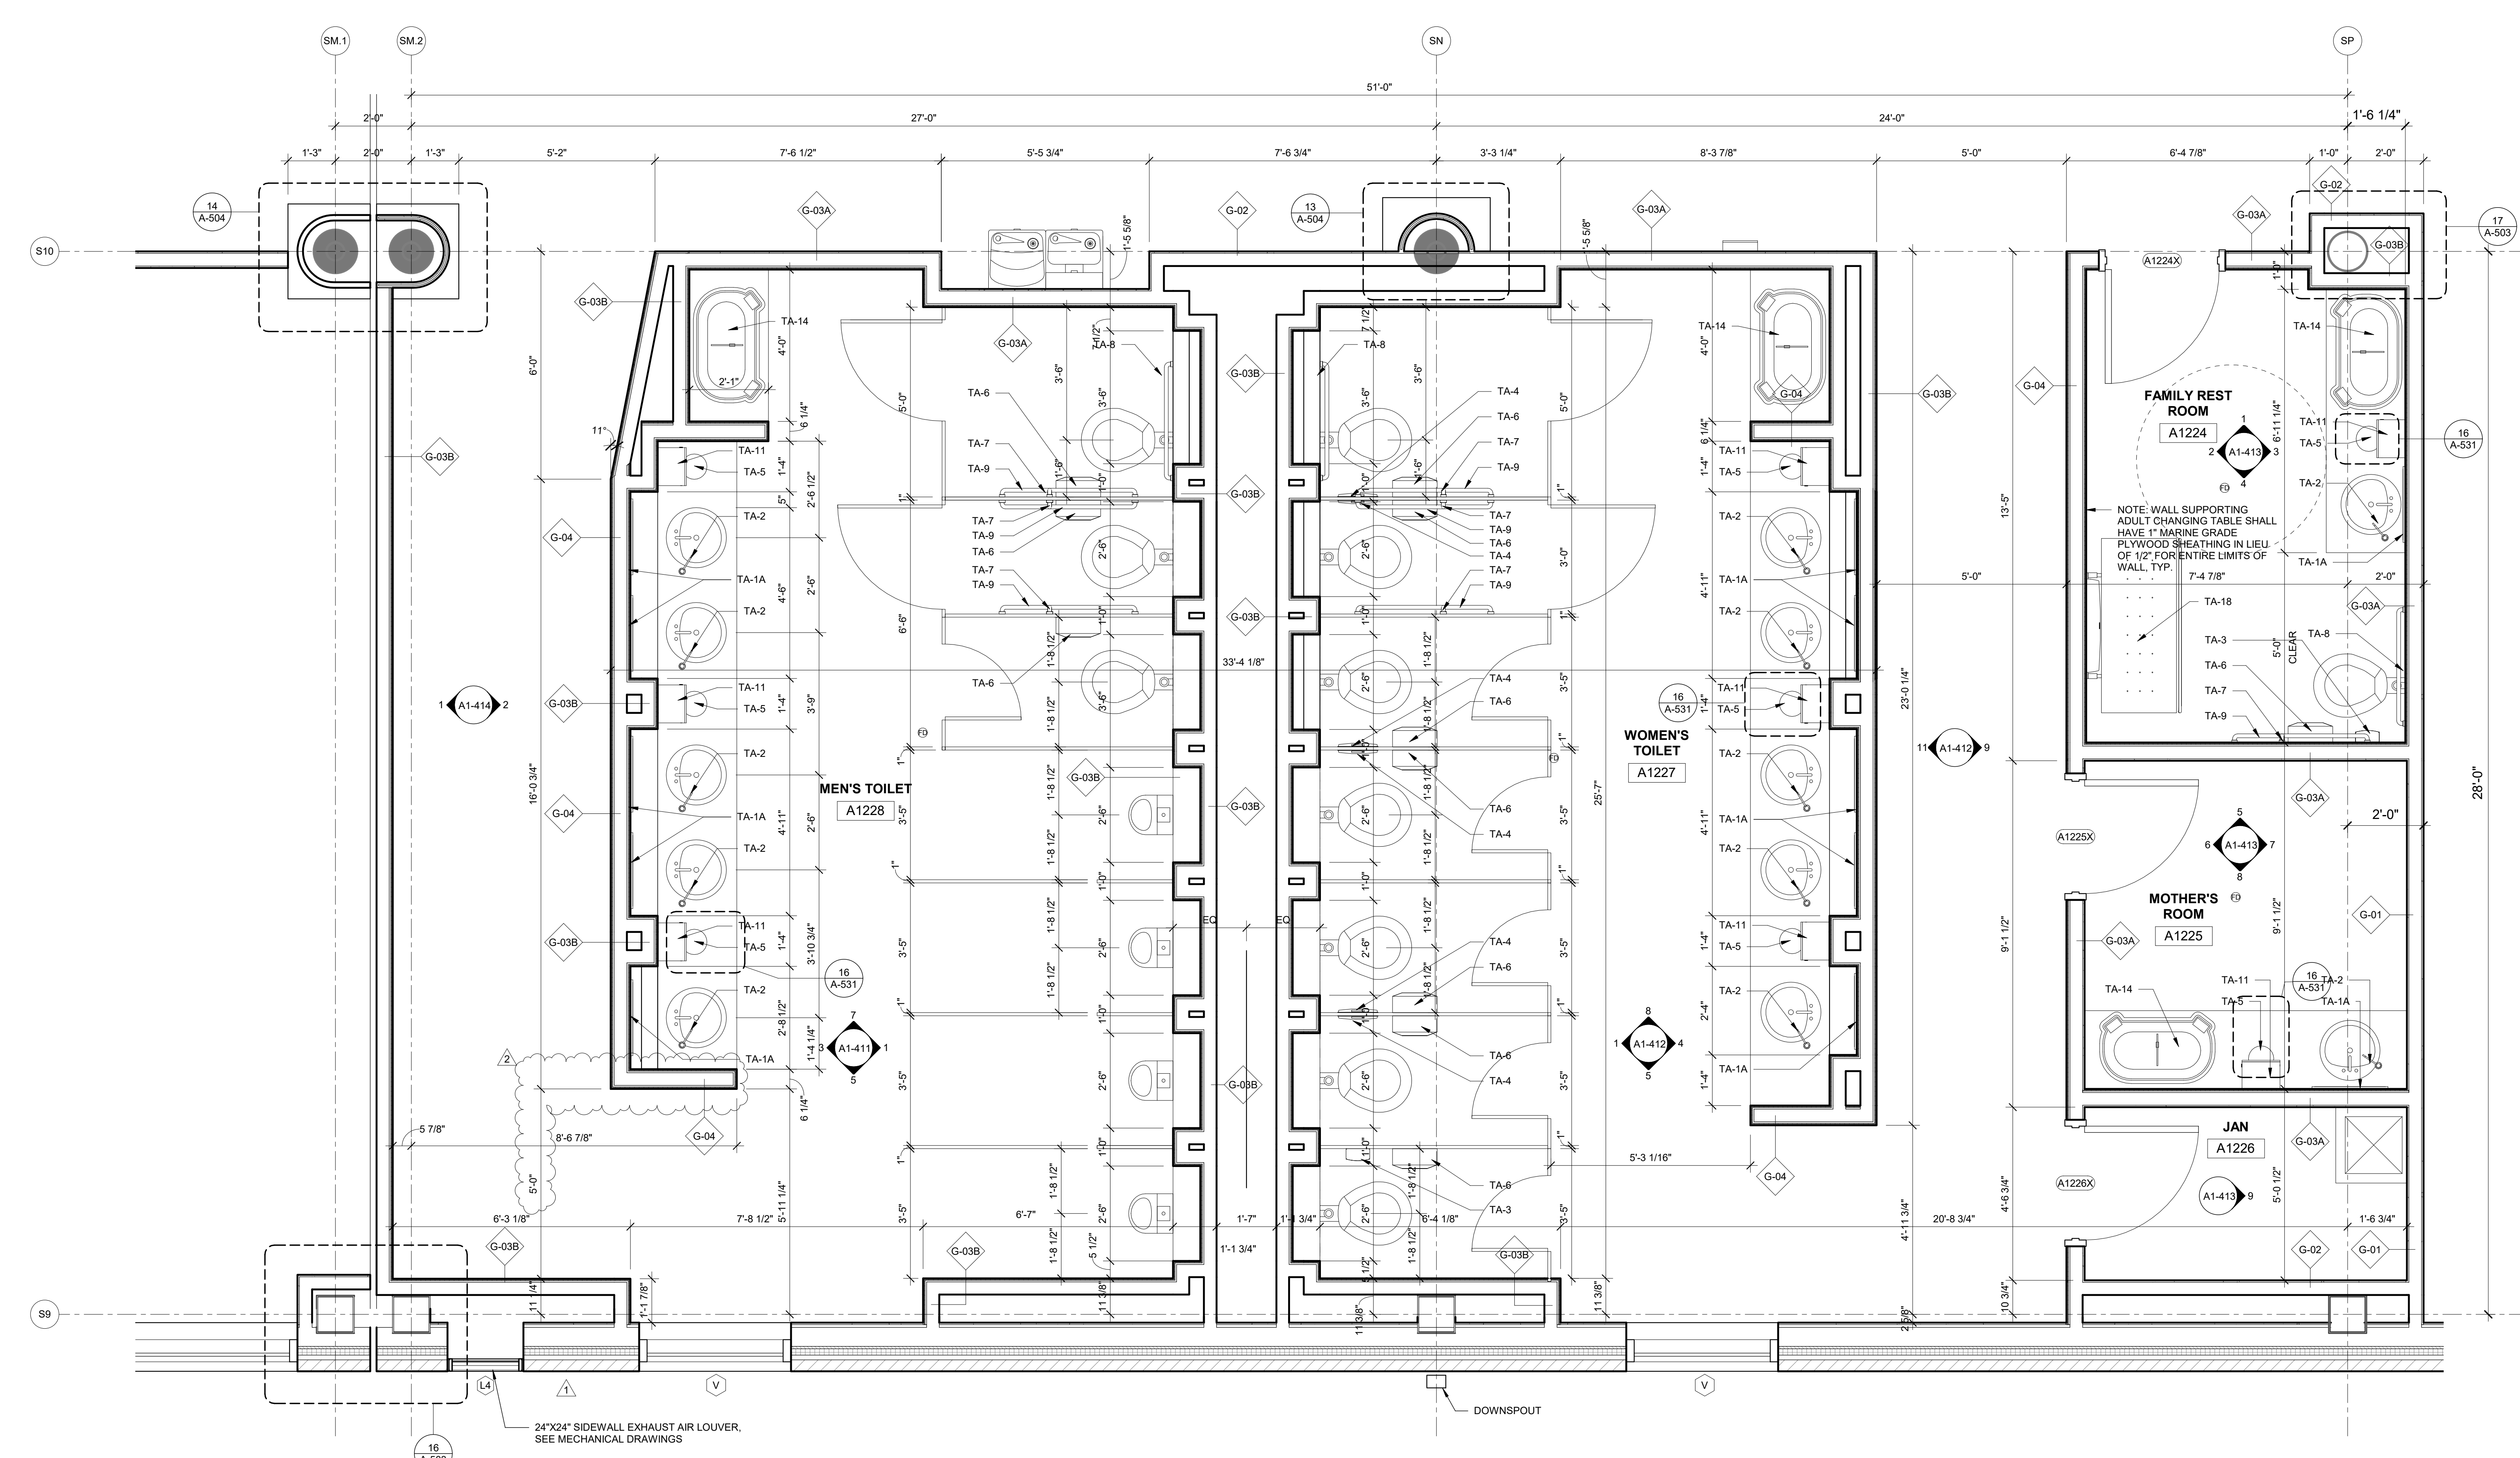


1 ZONE 2 - ENLARGED TOILET ROOM AREA  
 1/2" = 1'-0"



TERMINAL IMPROVEMENTS CONTRACT 3

Wilmington International Airport  
 1740 Airport Boulevard, Suite 12  
 Wilmington, NC 28405

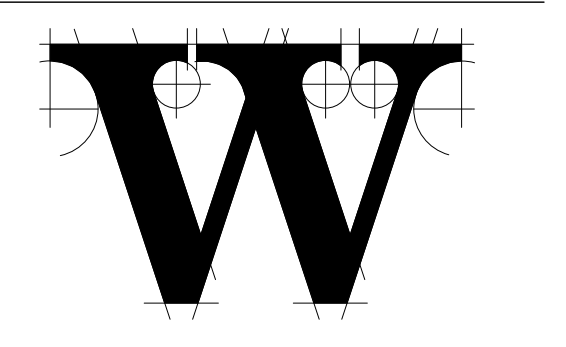

THE WILSON GROUP - ARCHITECTS -

PO Box 5510 Charlotte, NC 28299  
 704-331-9747 • www.twgarchitects.com

PROJECT MANAGER & CIVIL ENGINEER  
**TALBERT & BRIGHT**

CONSULTING ARCHITECT  
**LS3P**

STRUCTURAL ENGINEER  
**STEWART**


FP/PM/E ENGINEER  
**CHEATHAM & ASSOC.**

BAGGAGE HANDLING CONSULTANTS  
**BNP**

AIRCRAFT SUPPORT SYSTEMS  
**DK CONSULTANTS**

SPECIALTY LIGHTING CONSULTANT  
**HARTFRANT**

SIGNAGE & WAYFINDING  
**TAKEFORM**

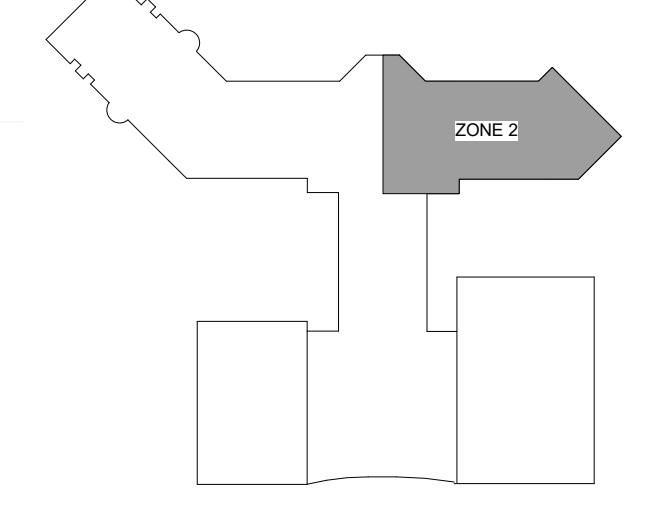

KEY PLAN

COPYRIGHT © 2019  
 THE WILSON GROUP ARCHITECTS  
 ALL RIGHTS RESERVED

PRINTED OR ELECTRONIC DRAWINGS AND DOCUMENTATION MAY NOT BE REPRODUCED IN ANY FORM WITHOUT WRITTEN PERMISSION FROM THE WILSON GROUP ARCHITECTS

REVISIONS

1	7/12/2019	AD-01
2	7/30/2019	AD-03

DATE 6/28/2019  
 PROJECT NUMBER 9202-000  
 SHEET TITLE

SCHEDULE 1 - ENLARGED FLOOR PLANS

SHEET NUMBER  
**A1-402**

**GENERAL TOILET ACCESSORY AND BATHROOM FINISH NOTES**

REFER TO SPECIFICATION SECTION 10 28 00 - TOILET ACCESSORIES FOR TOILET ACCESSORY LEGEND AND INFORMATION.

**GENERAL NOTES - INTERIOR ELEVATIONS**

1. REFER TO SHEET A-654 FOR WALL BASE, WALL, AND PANEL REVEAL DETAILS.
2. ABBREVIATIONS:
  - CLR = CENTERLINE OF REVEAL
  - TOR = TOP OF REVEAL
  - BOR = BOTTOM OF REVEAL
3. CONTRACTOR TO PROVIDE SHOP DRAWINGS TO ARCHITECT FOR REVIEW AND APPROVAL OF ALL SPECIALTY WALL PANEL SYSTEMS (WPS) PRIOR TO PROCUREMENT, FABRICATION, AND INSTALLATION.
4. CONTRACTOR TO PROVIDE MOCKUPS OF EACH SPECIALTY WALL PANEL SYSTEM (WPS) FOR REVIEW AND APPROVAL PRIOR TO PROCUREMENT, FABRICATION, AND INSTALLATION.
5. ALL VERTICAL AND HORIZONTAL REVEALS ARE TO BE CONTINUOUS AND UNINTERRUPTED, U.N.O.
6. ALL DEAD STOP EXTRUSIONS ARE TO BE CONTINUOUS AND UNINTERRUPTED.


**TOILET ACCESSORIES LEGEND**

SYMBOL	DESCRIPTION
TA-1A	24" X 48" LIGHTED LED MIRROR- SEE ELECTRICAL DRAWINGS
TA-1B	24" X 36" FRAMED MIRROR
TA-2	AUTOMATIC TOP-FILL COUNTER MOUNTED SOAP DISPENSER
TA-3	SURFACE MOUNTED SANITARY NAPKIN DISPENSER-BOBRICK B-270
TA-4	SURFACE MOUNTED SANITARY NAPKIN DISPENSER-BOBRICK B-4354
TA-5	COUNTER WASTE RECEPTACLE GROMMET
TA-6	MULTI-ROLL TOILET TISSUE DISPENSER
TA-7	18" GRAB BAR (VERTICAL)
TA-8	36" GRAB BAR (HORIZONTAL, REAR)
TA-9	42" GRAB BAR (HORIZONTAL, SIDE)
TA-10	SS COAT HOOK (CENTERED ON TOILET SIDE OF DOOR @ 60" A.F.F.)
TA-11	PAPER TOWEL DISPENSER
TA-12	BATTERY OPERATED WALL MOUNTED HAND SOAP DISPENSER
TA-14	BABY CHANGING STATION
TA-15	WASTE RECEPTACLE
TA-16	MOP AND BROOM HOLDER
TA-17	UNDERCOUNTER PULL OUT TRASH RECEPTACLE
TA-18	ADULT CHANGING STATION
TA-19	COMBINATION PAPER TOWEL AND WASTE RECEPTACLE



**TERMINAL IMPROVEMENTS CONTRACT 3**

Wilmington International Airport  
1740 Airport Boulevard, Suite 12  
Wilmington, NC 28405

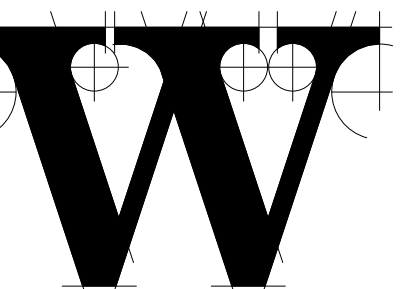

**THE WILSON GROUP ARCHITECTS**

PO Box 5510 Charlotte, NC 28299  
704-331-9747 • www.twgarchitects.com

PROJECT MANAGER & CIVIL ENGINEER  
**TALBERT & BRIGHT**

CONSULTING ARCHITECT  
**LS3P**

STRUCTURAL ENGINEER  
**STEWART**

FP/PM/E ENGINEER  
**CHEATHAM & ASSOC.**

BAGGAGE HANDLING CONSULTANTS  
**BNP**

AIRCRAFT SUPPORT SYSTEMS  
**DK CONSULTANTS**

SPECIALTY LIGHTING CONSULTANT  
**HARTRANFT**

SIGNAGE & WAYFINDING  
**TAKEFORM**

COPYRIGHT © 2019  
THE WILSON GROUP ARCHITECTS  
ALL RIGHTS RESERVED


PRINTED OR ELECTRONIC DRAWINGS AND DOCUMENTATION MAY NOT BE REPRODUCED IN ANY FORM WITHOUT WRITTEN PERMISSION FROM THE WILSON GROUP ARCHITECTS

REVISIONS  
1 7/30/2019 AD-03


DATE 6/28/2019  
PROJECT NUMBER 9202-000  
SHEET TITLE

**SCHEDULE 1 - RESTROOM ELEVATIONS**


SHEET NUMBER  
**A1-411**

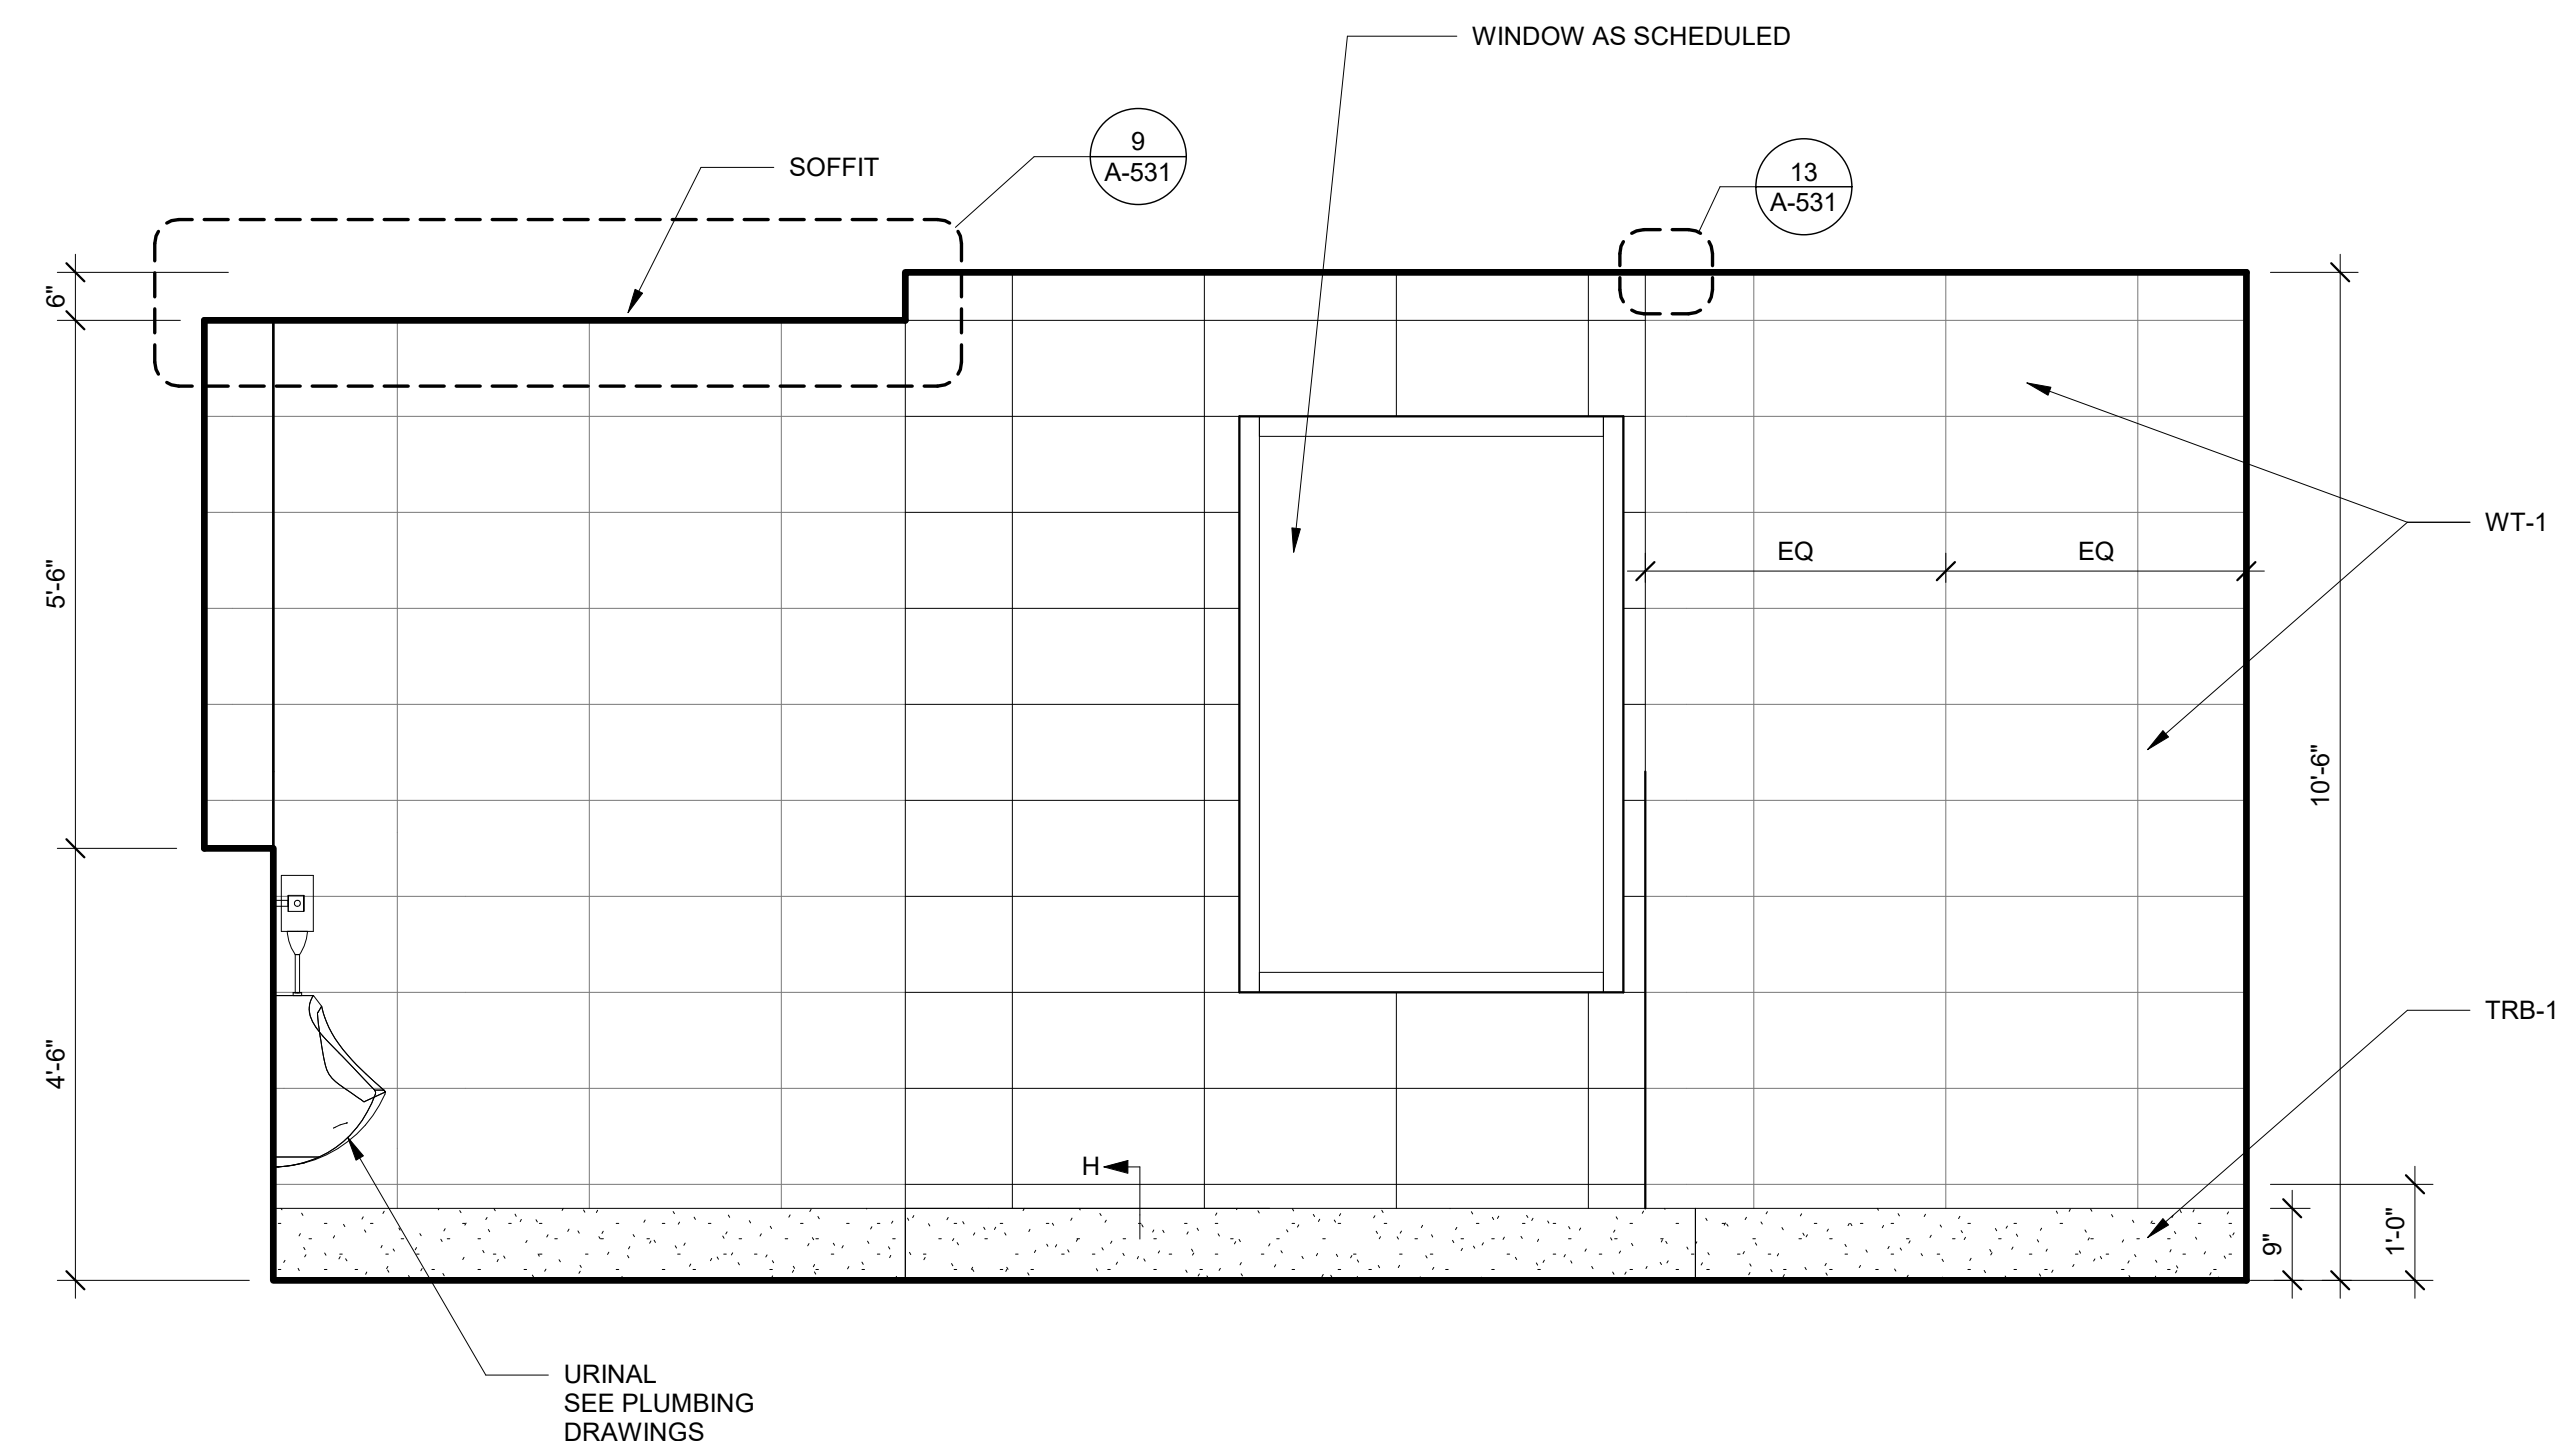


**5 MEN'S ROOM NORTH WALL**  
1/2" = 1'-0"

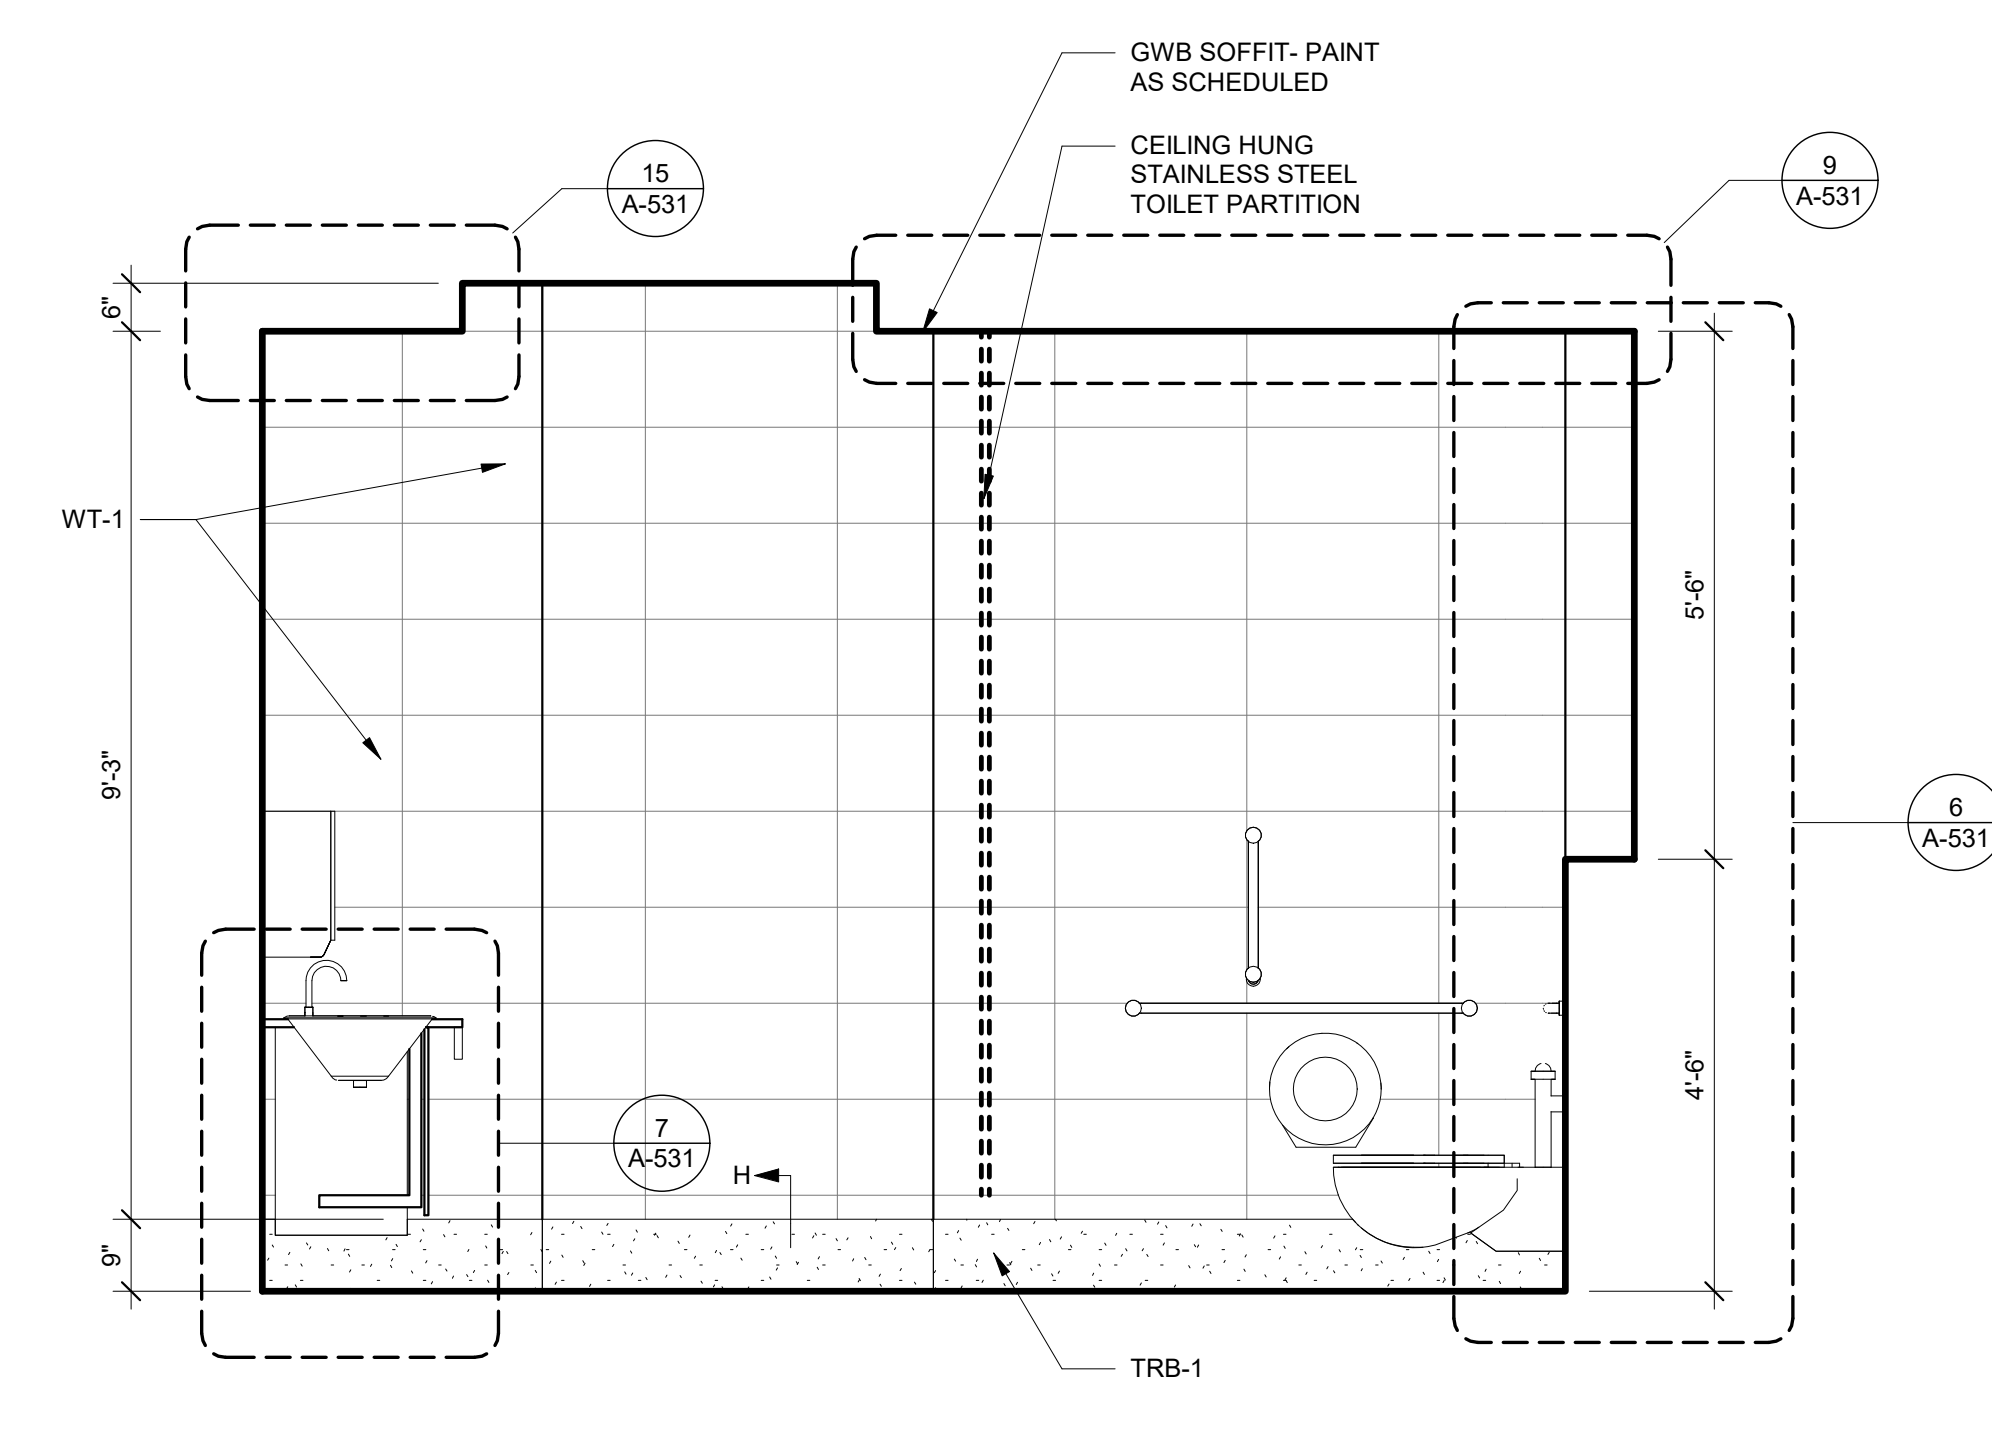


**7 MEN'S ROOM- SOUTH WALL**  
1/2" = 1'-0"

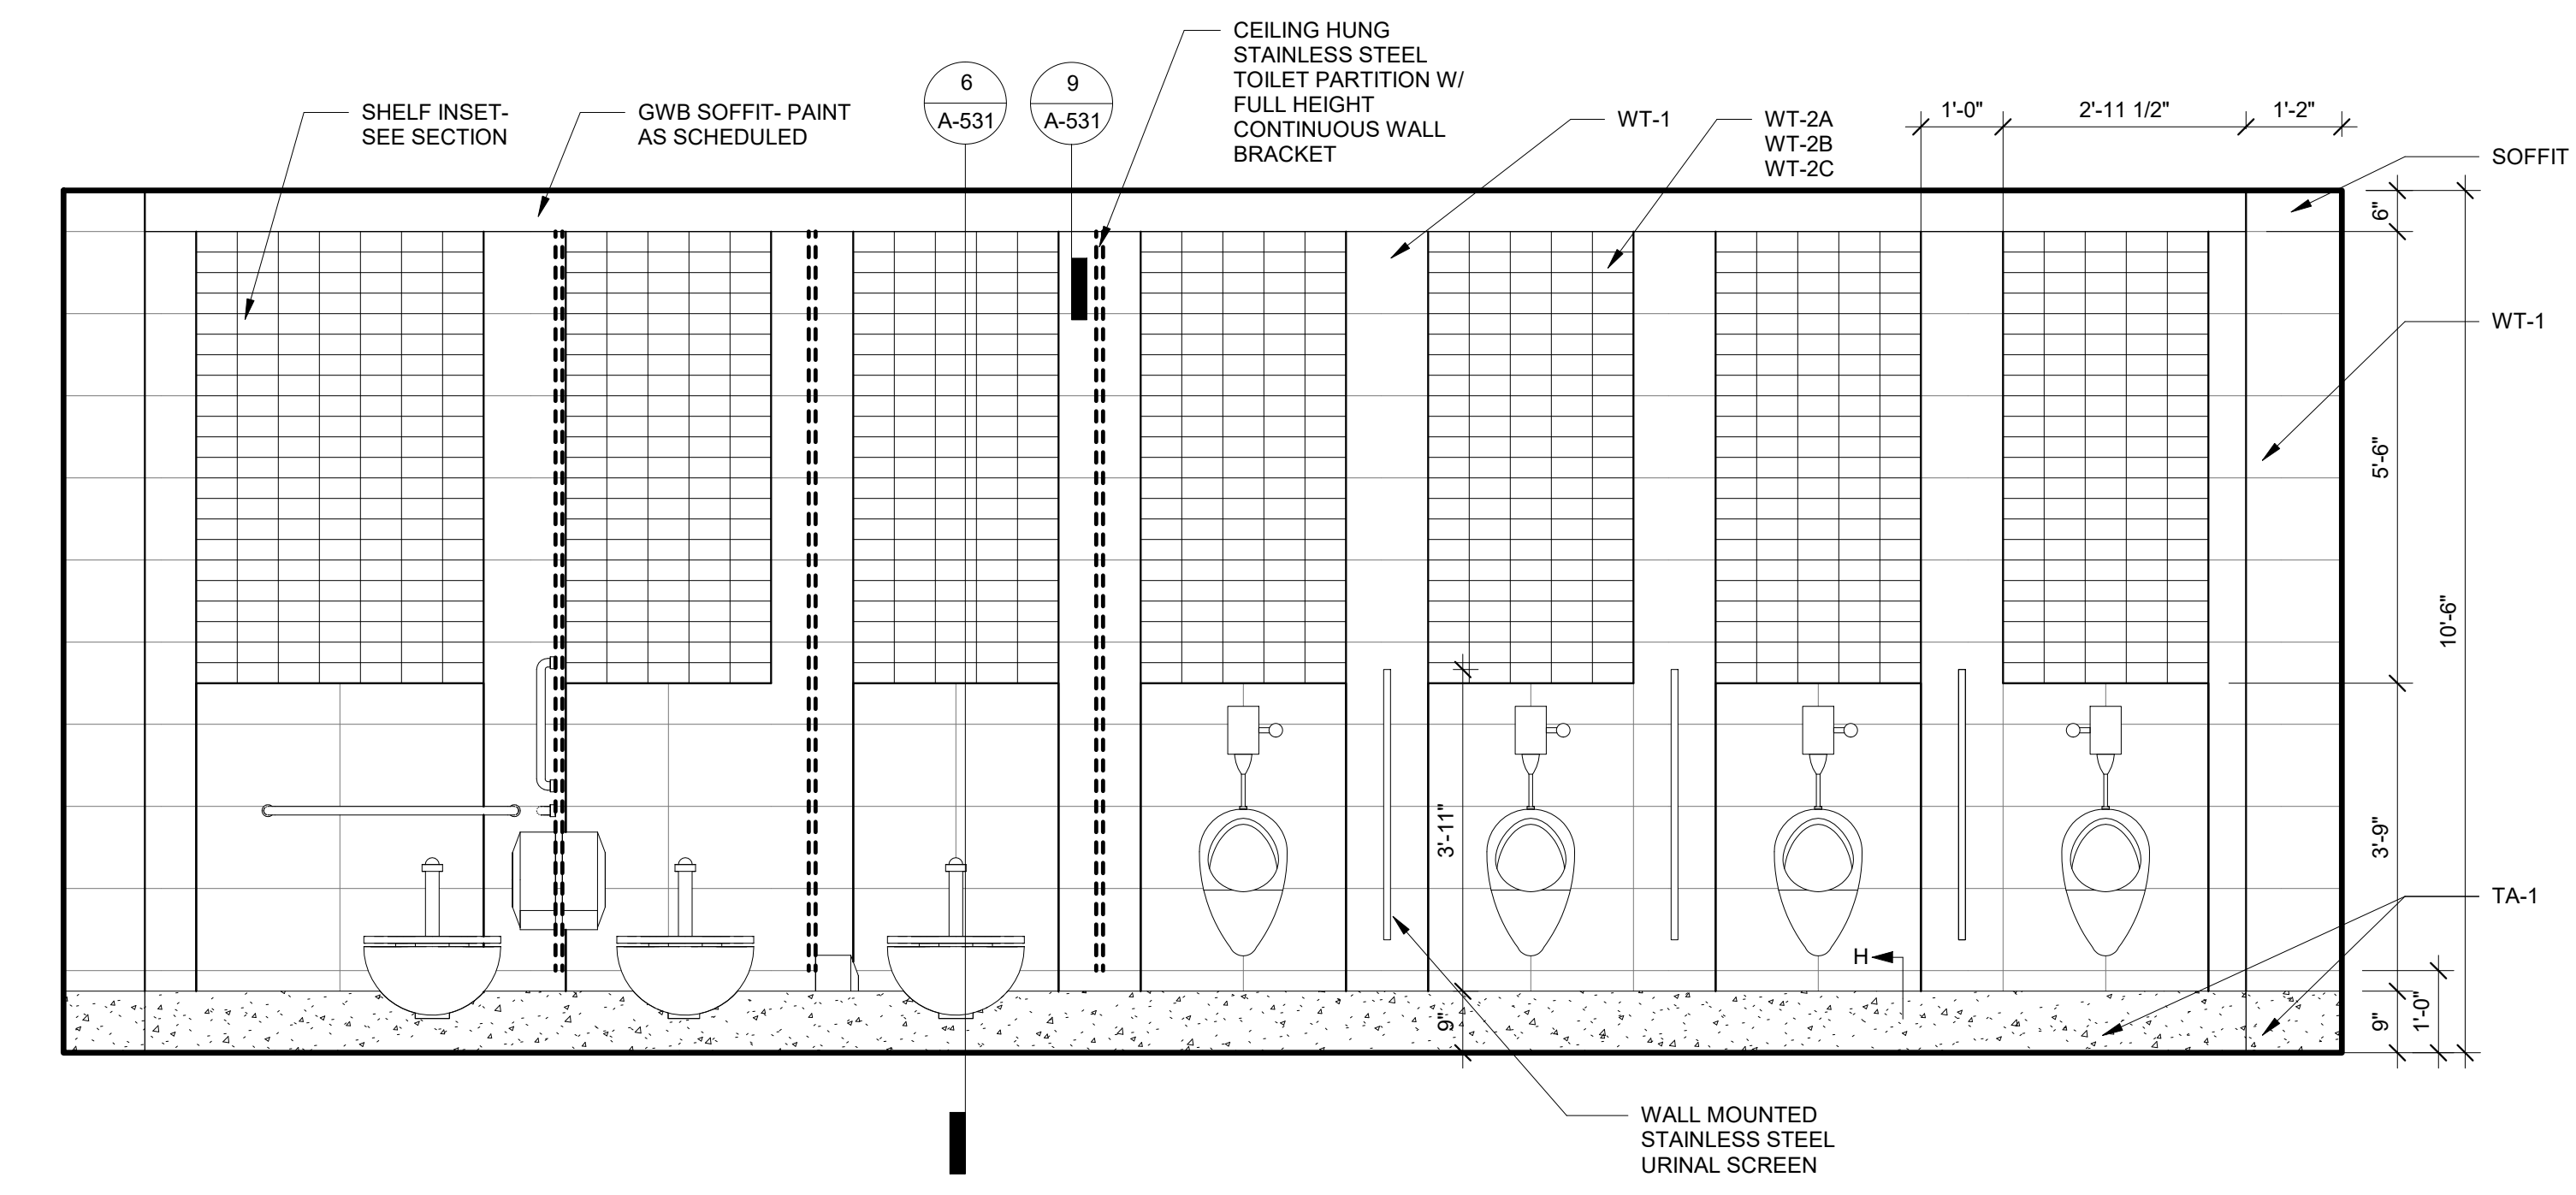

**1 MEN'S ROOM-TOILET WALL**  
1/2" = 1'-0"


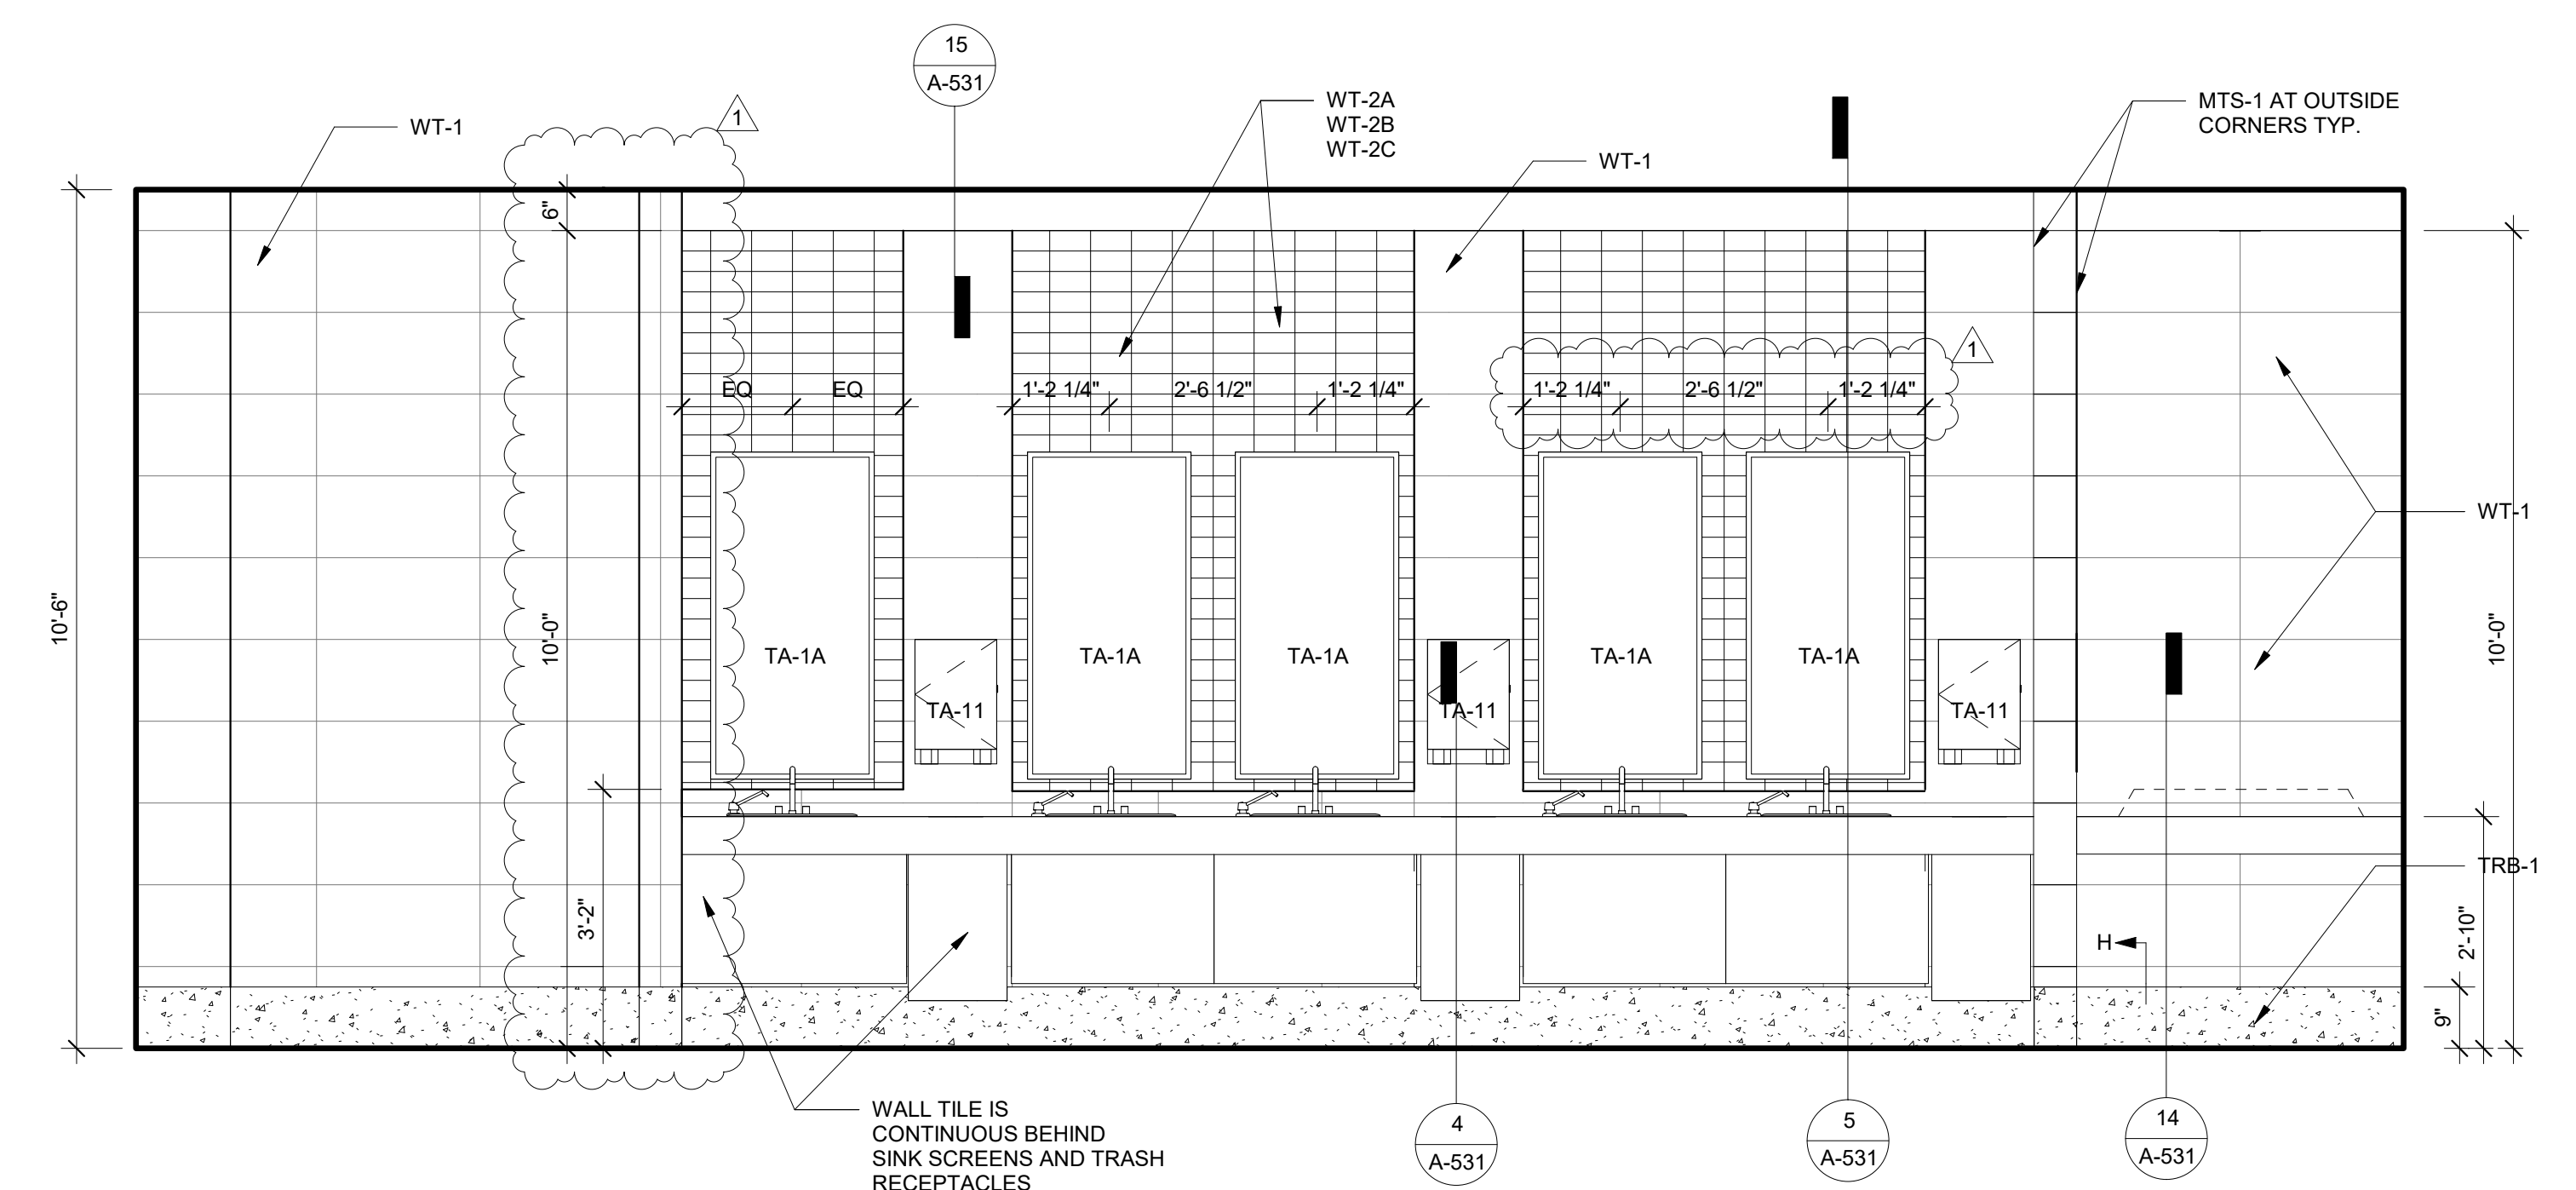


**3 MEN'S ROOM-LAVATORY WALL**  
1/2" = 1'-0"

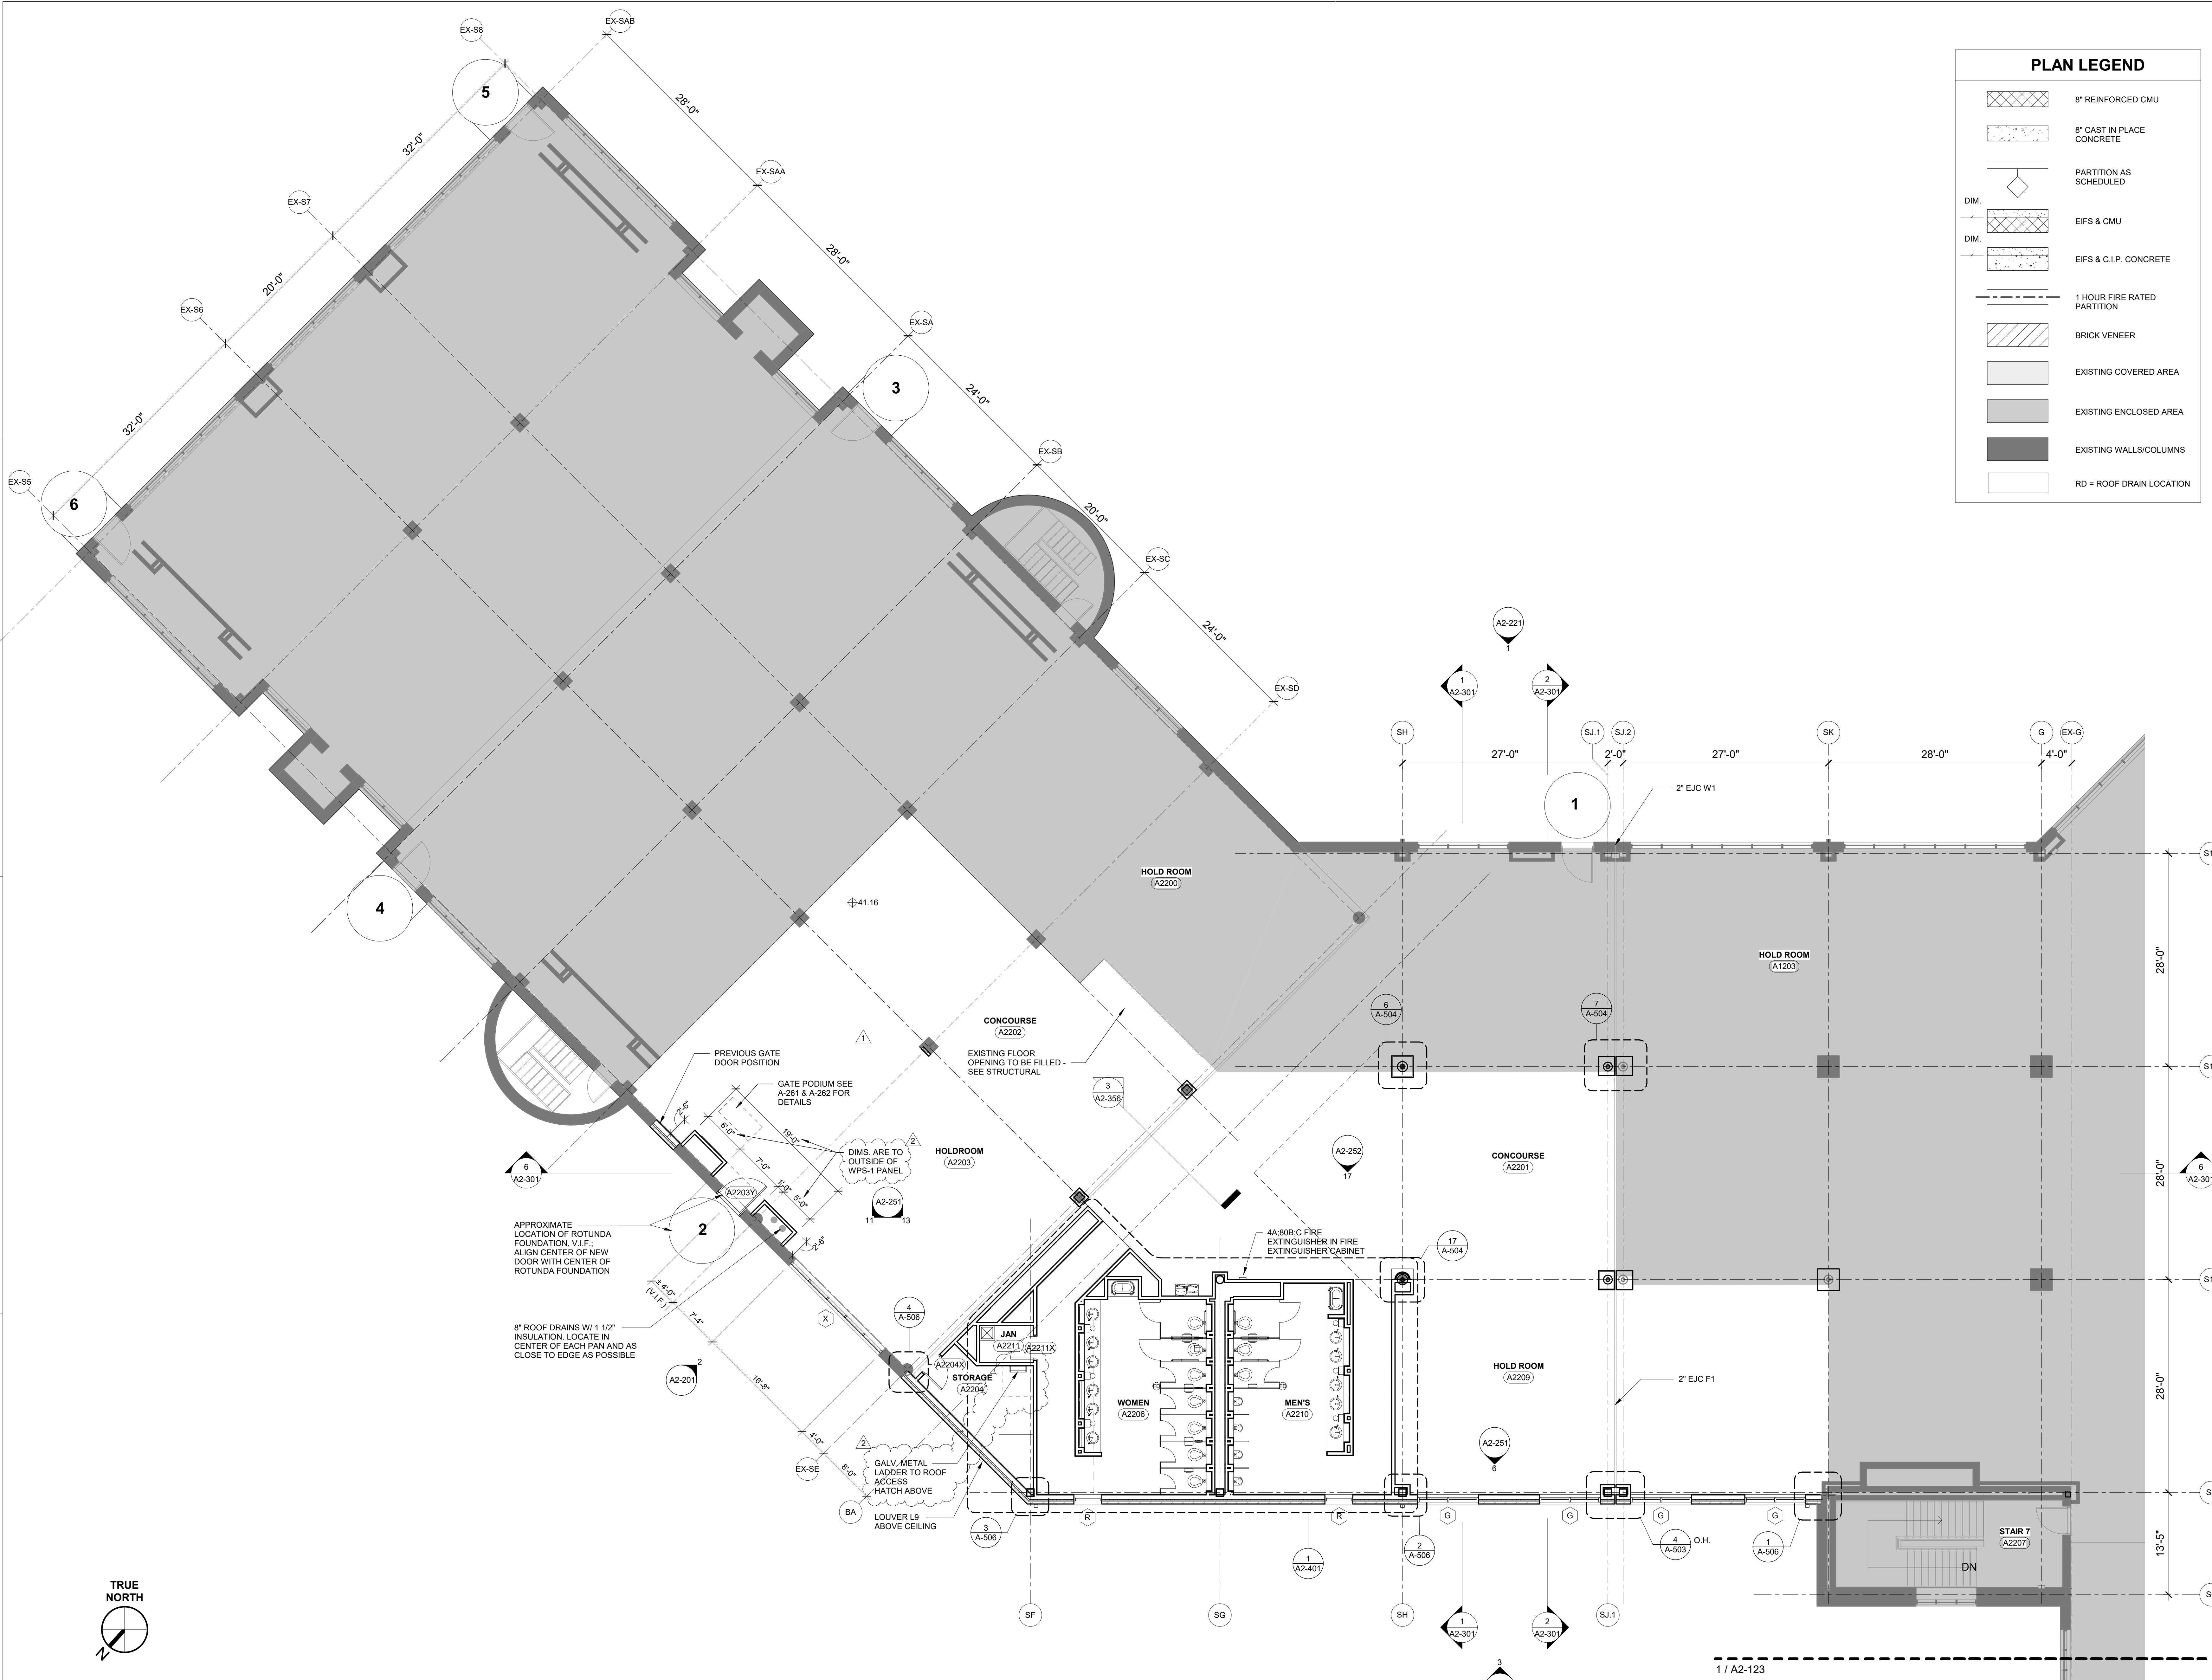


**PLAN LEGEND**

	8" REINFORCED CMU
	8" CAST IN PLACE CONCRETE
	PARTITION AS SCHEDULED
	EFS & CMU
	EFS & C.I.P. CONCRETE
	1 HOUR FIRE RATED PARTITION
	BRICK VENEER
	EXISTING COVERED AREA
	EXISTING ENCLOSED AREA
	EXISTING WALLS/COLUMNS
	RD = ROOF DRAIN LOCATION

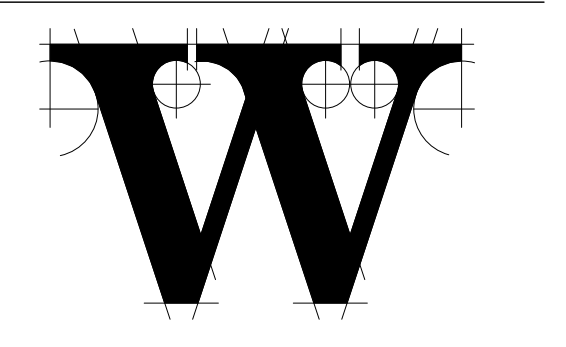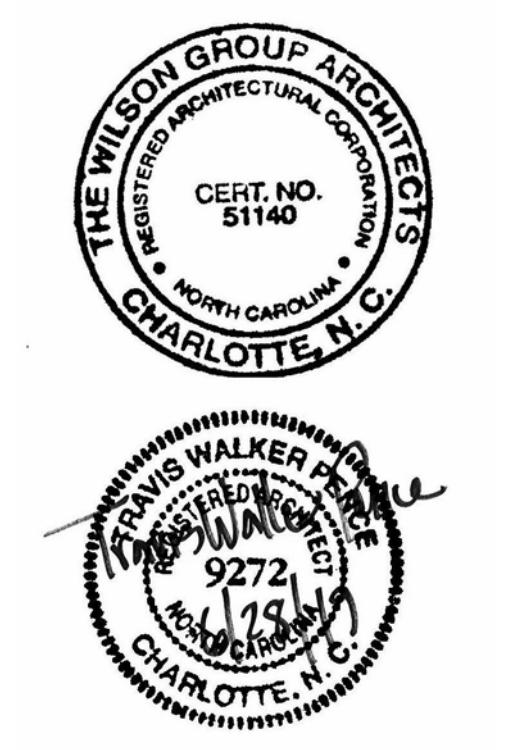

**THE WILSON GROUP**  
 - ARCHITECTS -  
 PO Box 5510 Charlotte, NC 28299  
 704-331-9747 • www.twgarchitects.com

- PROJECT MANAGER & CIVIL ENGINEER  
**TALBERT & BRIGHT**  
 CONSULTING ARCHITECT  
 LS3P
- STRUCTURAL ENGINEER  
**STEWART**
- FP/IME ENGINEER  
**CHEATHAM & ASSOC.**
- BAGGAGE HANDLING CONSULTANTS  
**BNP**
- AIRCRAFT SUPPORT SYSTEMS  
**DK CONSULTANTS**
- SPECIALTY LIGHTING CONSULTANT  
**HARTRANFT**
- SIGNAGE & WAYFINDING  
**TAKEFORM**

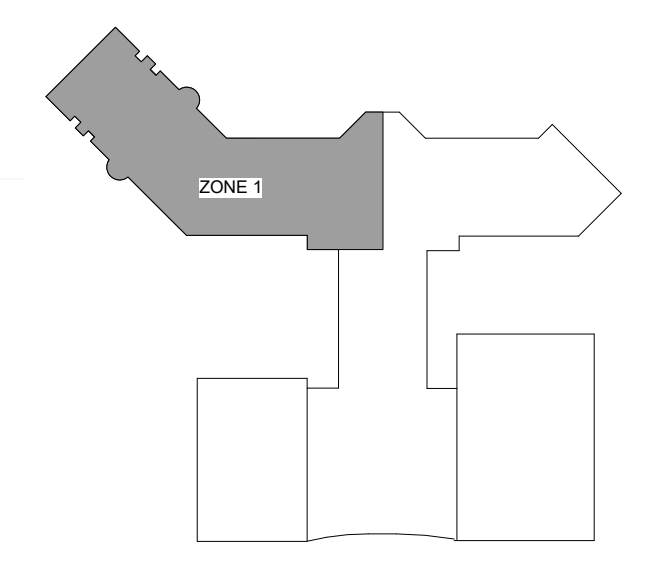

**KEY PLAN**

COPYRIGHT © 2019  
 THE WILSON GROUP ARCHITECTS  
 ALL RIGHTS RESERVED

PRINTED OR ELECTRONIC DRAWINGS AND DOCUMENTATION MAY NOT BE REPRODUCED IN ANY FORM WITHOUT WRITTEN PERMISSION FROM THE WILSON GROUP ARCHITECTS

**REVISIONS**


1	7/12/2019	AD-01
2	7/30/2019	AD-03

DATE 6/28/2019  
 PROJECT NUMBER 9202-000  
 SHEET TITLE

**SCHEDULE 2 - BOARDING LEVEL FLOOR PLAN ZONE 1**

SHEET NUMBER  
**A2-121**


**1 SCHEDULE 2 - OVERALL BOARDING LEVEL FLOOR PLAN - ZONE 1**  
 1/8" = 1'-0"

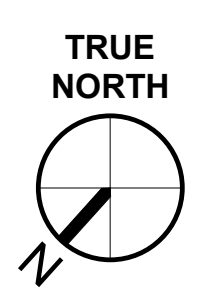



# TERMINAL IMPROVEMENTS CONTRACT 3

Wilmington International Airport  
1740 Airport Boulevard, Suite 12  
Wilmington, NC 28405

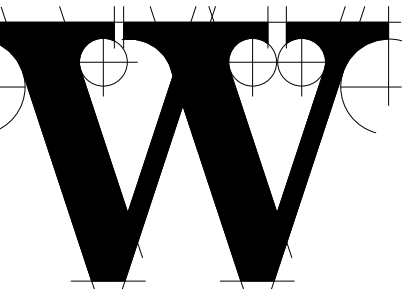

## THE WILSON GROUP ARCHITECTS

PO Box 5510 Charlotte, NC 28299  
704-331-9747 • www.twgarchitects.com

PROJECT MANAGER & CIVIL ENGINEER  
**TALBERT & BRIGHT**

CONSULTING ARCHITECT  
**LS3P**

STRUCTURAL ENGINEER  
**STEWART**


FP/IME ENGINEER  
**CHEATHAM & ASSOC.**

BAGGAGE HANDLING CONSULTANTS  
**BNP**

AIRCRAFT SUPPORT SYSTEMS  
**DK CONSULTANTS**

SPECIALTY LIGHTING CONSULTANT  
**HARTRANFT**

SIGNAGE & WAYFINDING  
**TAKEFORM**

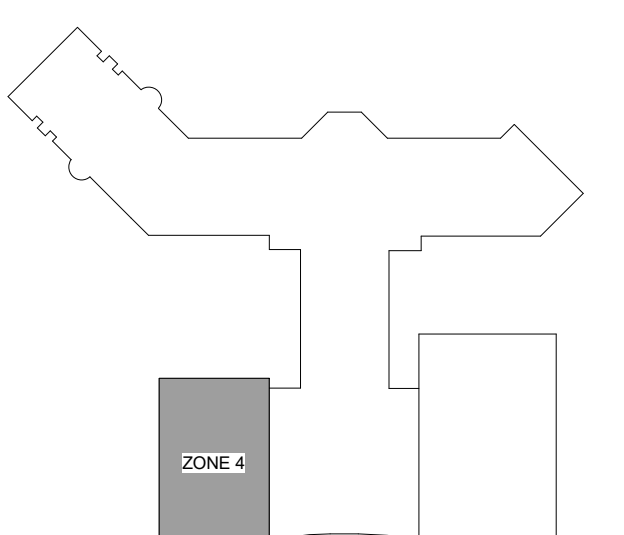

### KEY PLAN

COPYRIGHT © 2019 THE WILSON GROUP ARCHITECTS ALL RIGHTS RESERVED

PRINTED OR ELECTRONIC DRAWINGS AND DOCUMENTATION MAY NOT BE REPRODUCED IN ANY FORM WITHOUT WRITTEN PERMISSION FROM THE WILSON GROUP ARCHITECTS

### REVISIONS

- 1 7/12/2019 AD-01
- 2 7/30/2019 AD-03

DATE 6/28/2019  
PROJECT NUMBER 9202-000  
SHEET TITLE


## SCHEDULE 2 - TICKET LEVEL FLOOR PLAN ZONE 4

SHEET NUMBER

# A2-124

### PLAN LEGEND

- 8' REINFORCED CMU
- 8' CAST IN PLACE CONCRETE
- PARTITION AS SCHEDULED
- EIFS & CMU
- EIFS & C.I.P. CONCRETE
- 1 HOUR FIRE RATED PARTITION
- BRICK VENEER
- EXISTING COVERED AREA
- EXISTING ENCLOSED AREA
- EXISTING WALLS/COLUMNS
- RD = ROOF DRAIN LOCATION

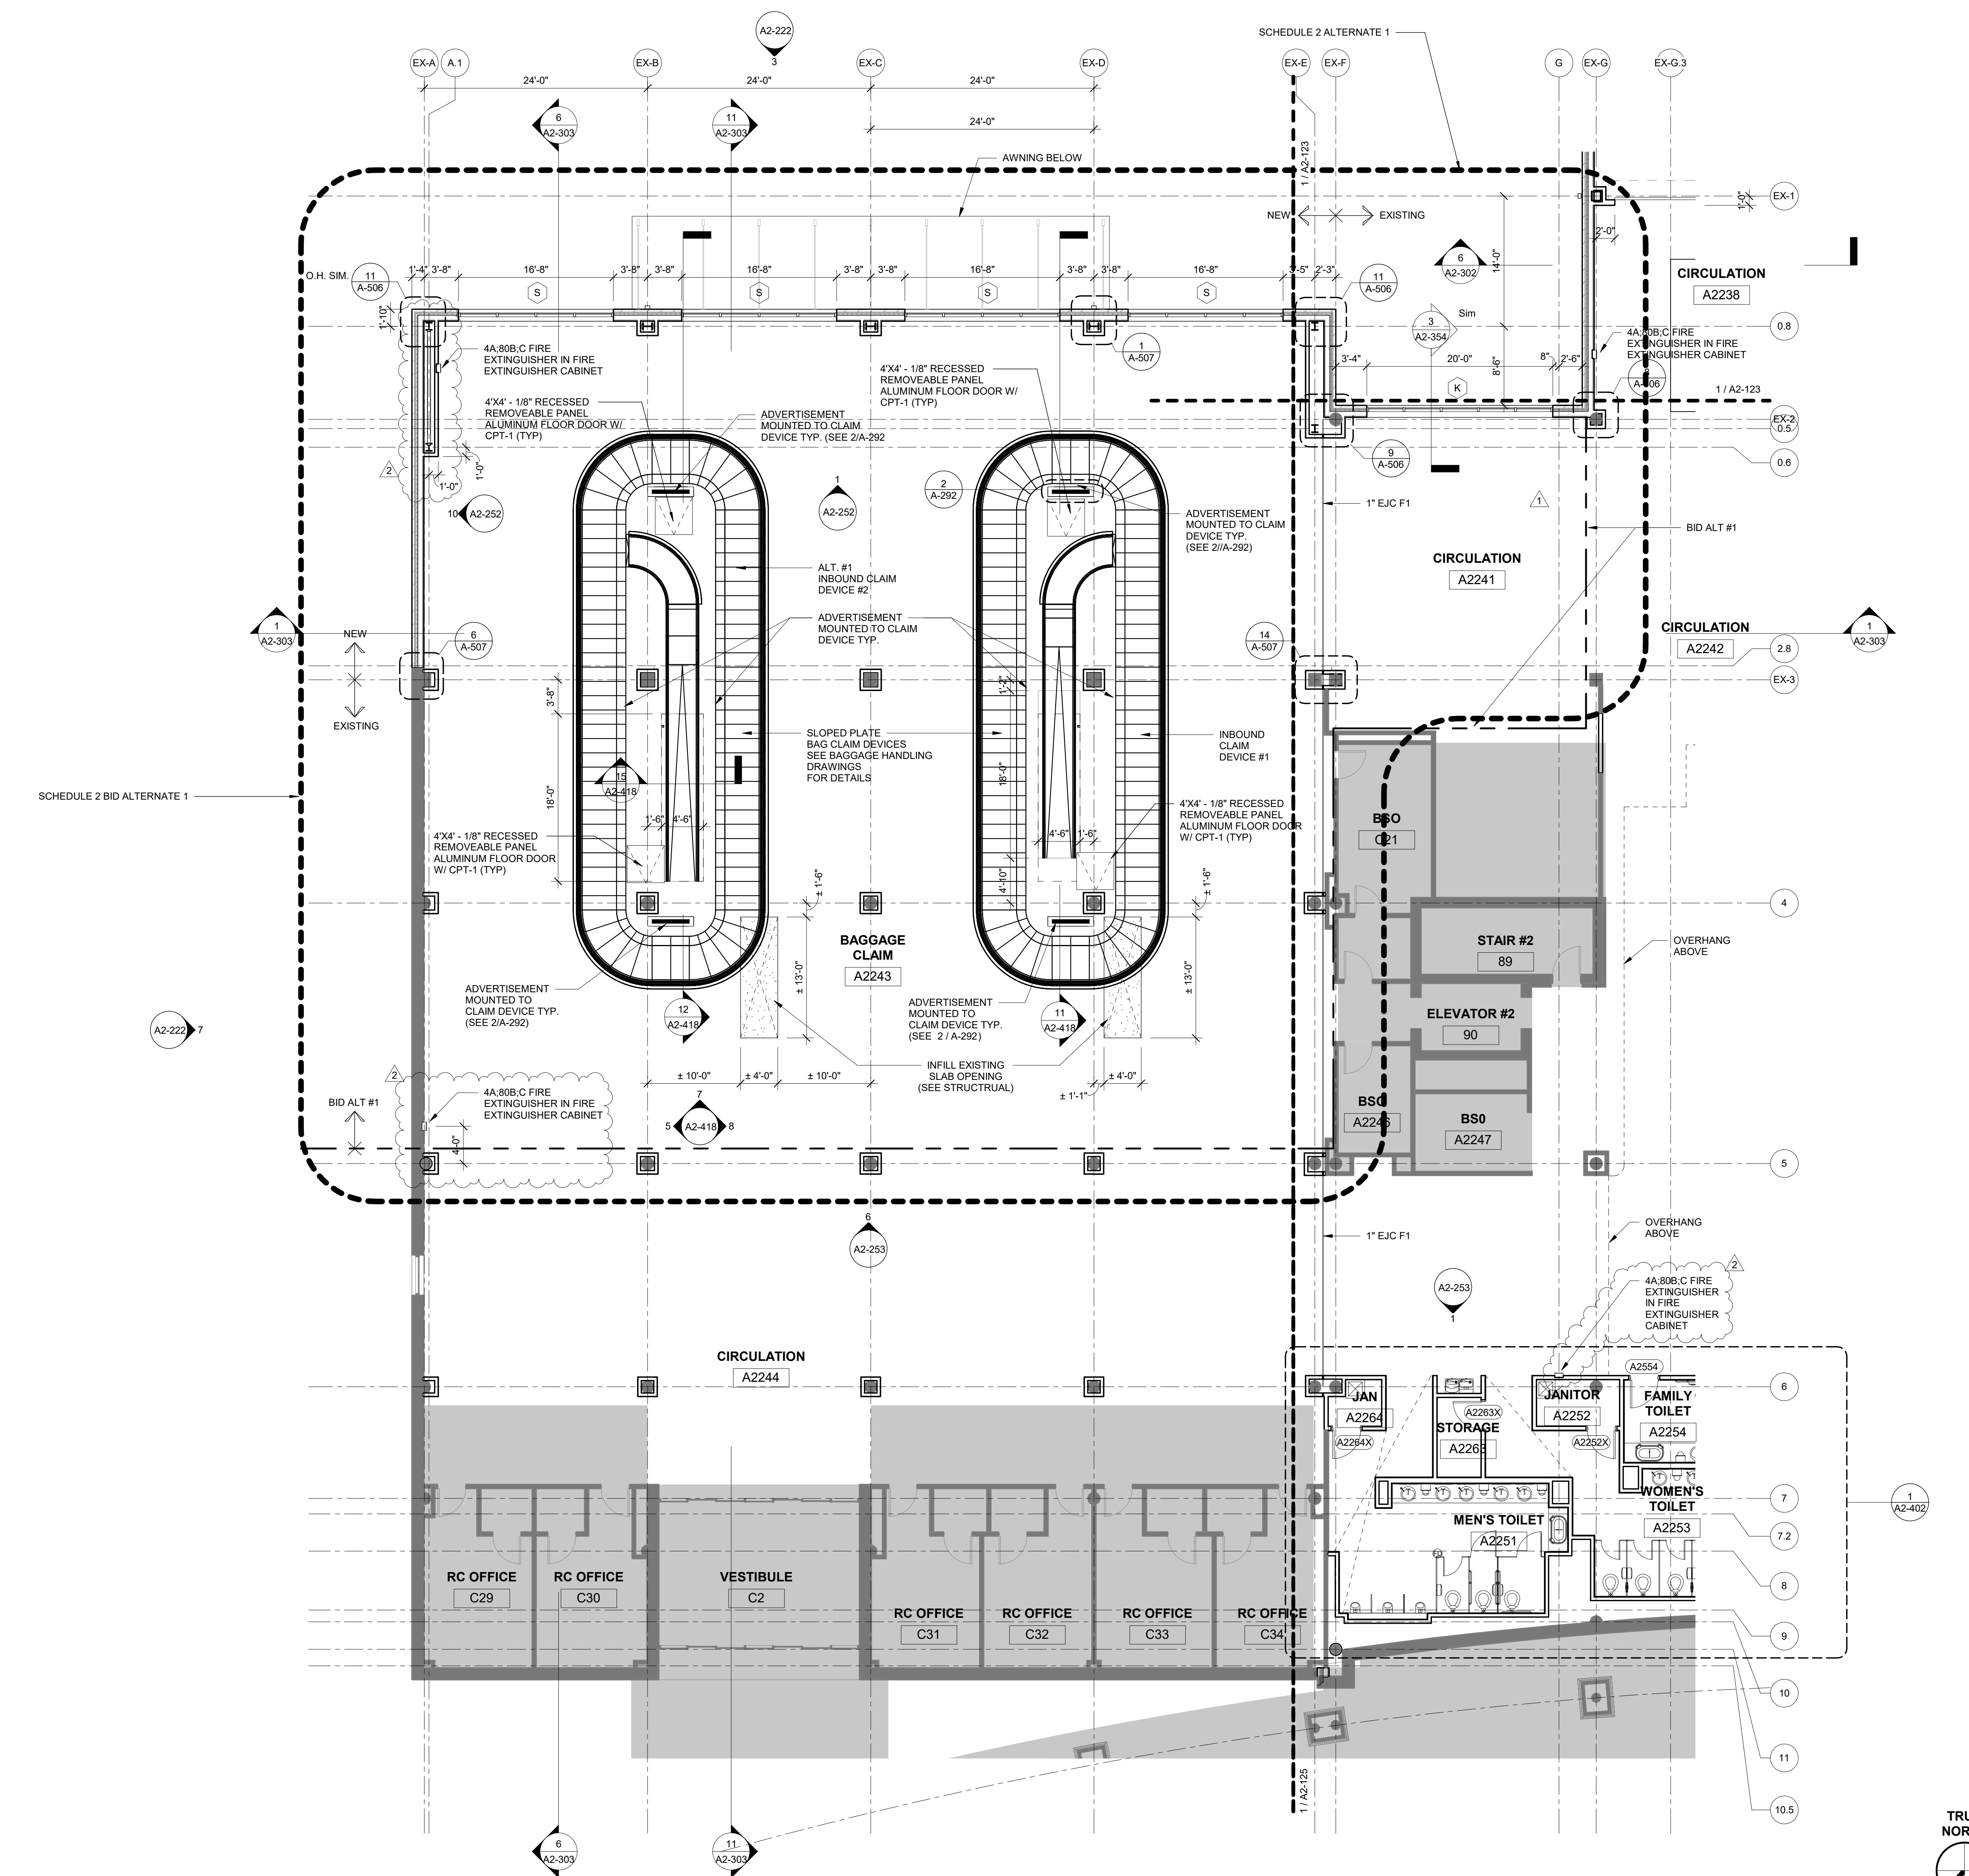


**1** SCHEDULE 2 - TICKET LEVEL FLOOR PLAN - ZONE 4  
1/8" = 1'-0"



# TERMINAL IMPROVEMENTS CONTRACT 3

Wilmington International Airport  
1740 Airport Boulevard, Suite 12  
Wilmington, NC 28405

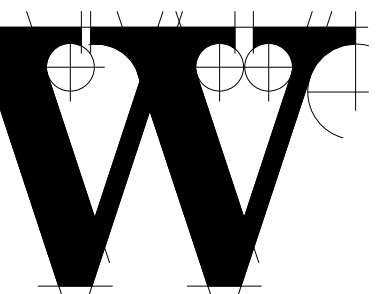

## THE WILSON GROUP ARCHITECTS

PO Box 5510 Charlotte, NC 28299  
704-331-9747 • www.twgarchitects.com

PROJECT MANAGER & CIVIL ENGINEER  
**TALBERT & BRIGHT**  
CONSULTING ARCHITECT  
LS3P

STRUCTURAL ENGINEER  
**STEWART**


FP/PM/E ENGINEER  
**CHEATHAM & ASSOC.**

BAGGAGE HANDLING CONSULTANTS  
**BNP**

AIRCRAFT SUPPORT SYSTEMS  
**DK CONSULTANTS**

SPECIALTY LIGHTING CONSULTANT  
**HARTRANFT**

SIGNAGE & WAYFINDING  
**TAKEFORM**

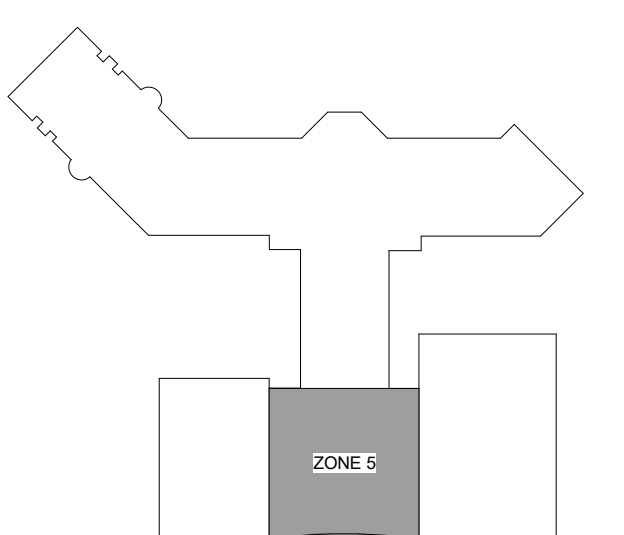

### KEY PLAN

COPYRIGHT © 2019  
THE WILSON GROUP ARCHITECTS  
ALL RIGHTS RESERVED

PRINTED OR ELECTRONIC DRAWINGS AND DOCUMENTATION MAY NOT BE REPRODUCED IN ANY FORM WITHOUT WRITTEN PERMISSION FROM THE WILSON GROUP ARCHITECTS

### REVISIONS

- 1 7/12/2019 AD-01
- 2 7/30/2019 AD-03

DATE 6/28/2019  
PROJECT NUMBER 9202-000  
SHEET TITLE



## SCHEDULE 2 - TICKET LEVEL FLOOR PLAN ZONE 5

SHEET NUMBER

# A2-125

### PLAN LEGEND

- 8" REINFORCED CMU
- 8" CAST IN PLACE CONCRETE
- PARTITION AS SCHEDULED
- EIFS & CMU
- EIFS & C.I.P. CONCRETE
- 1 HOUR FIRE RATED PARTITION
- BRICK VENEER
- EXISTING COVERED AREA
- EXISTING ENCLOSED AREA
- EXISTING WALLS/COLUMNS
- RD = ROOF DRAIN LOCATION

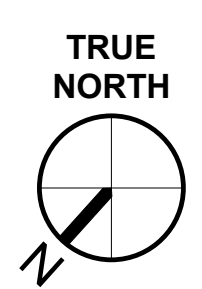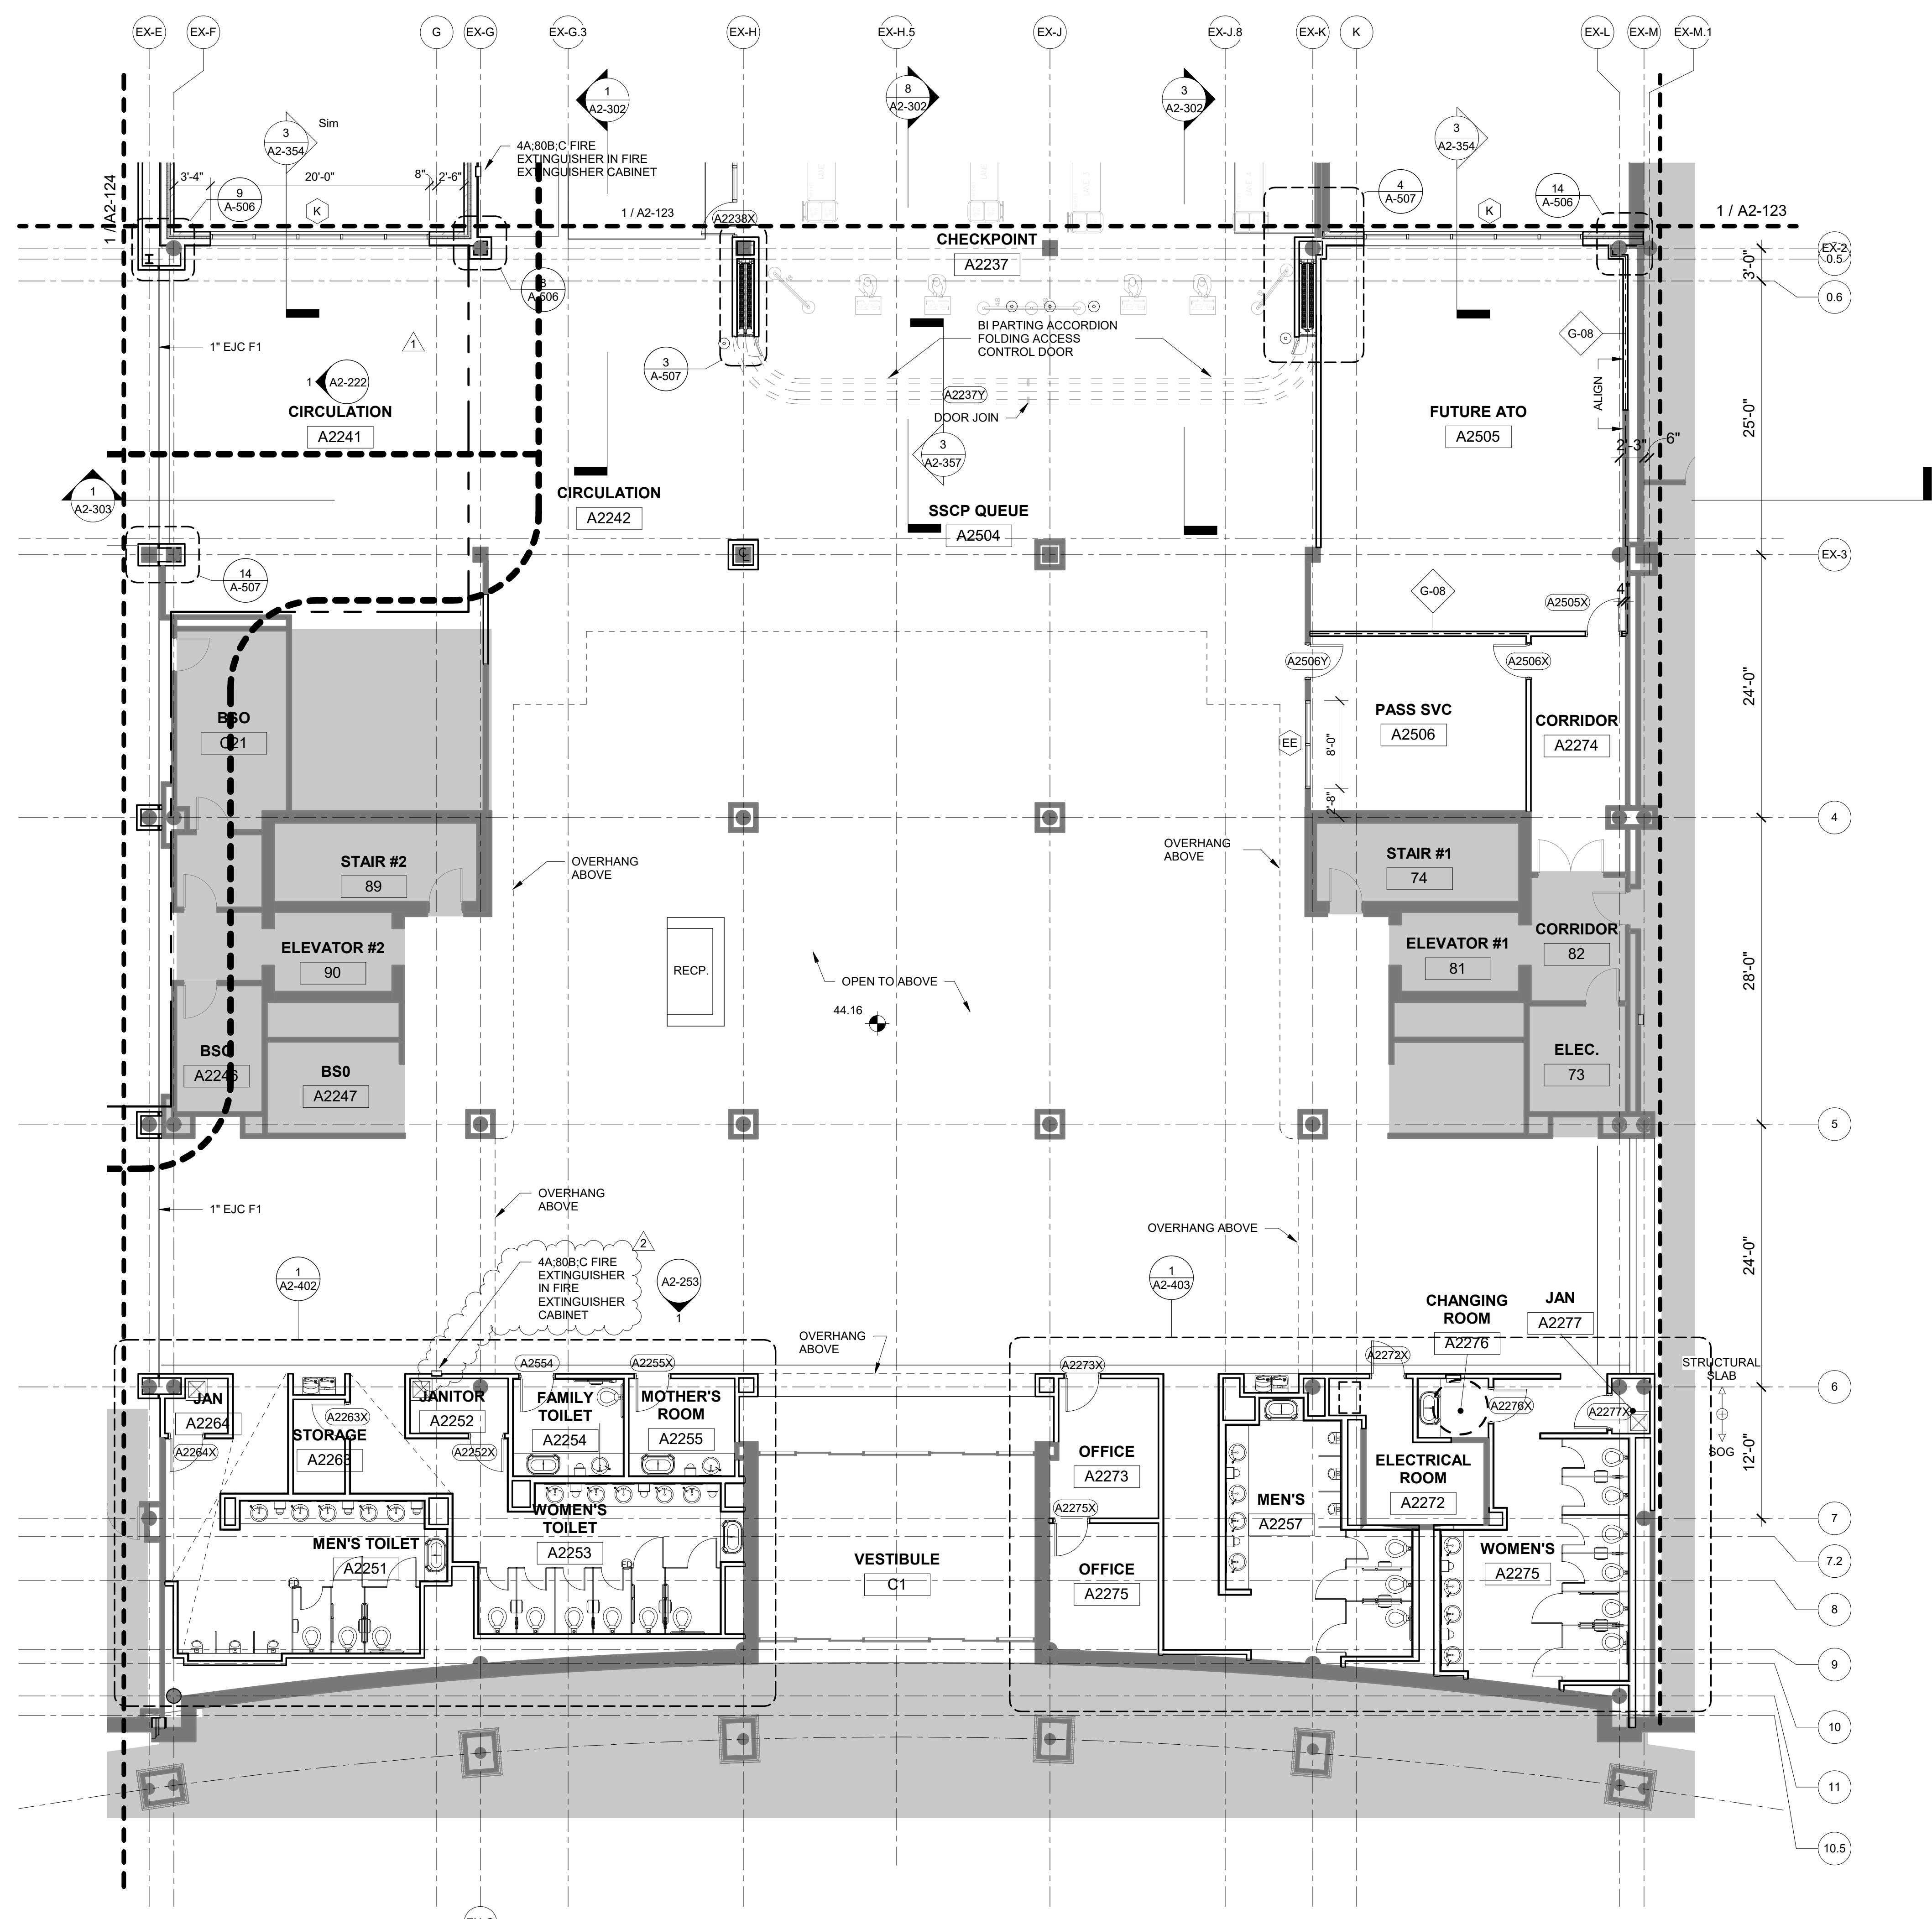


1 SCHEDULE 2 - TICKET LEVEL FLOOR PLAN - ZONE 5  
1/8" = 1'-0"



TERMINAL IMPROVEMENTS CONTRACT 3

Wilmington International Airport 1740 Airport Boulevard, Suite 12 Wilmington, NC 28405

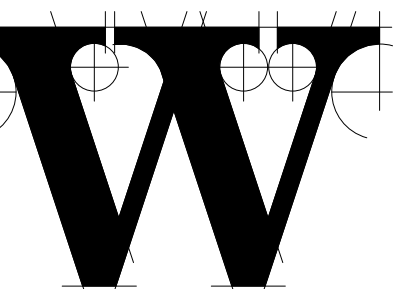

THE WILSON GROUP ARCHITECTS

PO Box 5510 Charlotte, NC 28299 704-331-9747 • www.twgarchitects.com

PROJECT MANAGER & CIVIL ENGINEER TALBERT & BRIGHT CONSULTING ARCHITECT LS3P

STRUCTURAL ENGINEER STEWART


FP/PIPE ENGINEER CHEATHAM & ASSOC.

BAGGAGE HANDLING CONSULTANTS BNP

AIRCRAFT SUPPORT SYSTEMS DK CONSULTANTS

SPECIALTY LIGHTING CONSULTANT HARTRANFT

SIGNAGE & WAYFINDING TAKEFORM

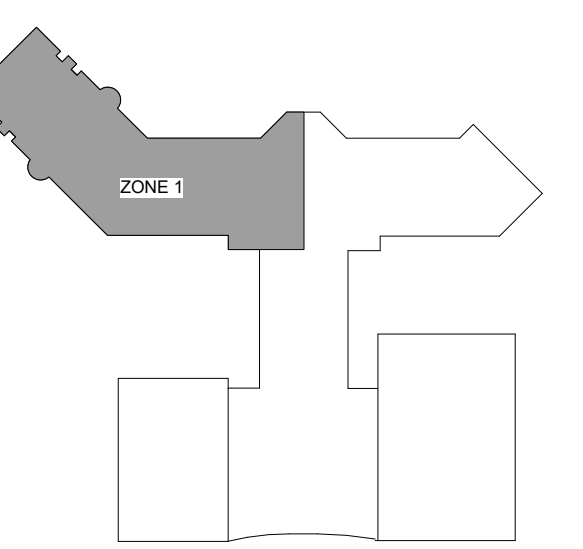

KEY PLAN

COPYRIGHT © 2019 THE WILSON GROUP ARCHITECTS ALL RIGHTS RESERVED

PRINTED OR ELECTRONIC DRAWINGS AND DOCUMENTATION MAY NOT BE REPRODUCED IN ANY FORM WITHOUT WRITTEN PERMISSION FROM THE WILSON GROUP ARCHITECTS

REVISIONS


1 7/30/2019 AD-03

DATE 6/28/2019 PROJECT NUMBER 9202-000 SHEET TITLE

SCHEDULE 2 - ROOF LEVEL PLAN ZONE 1

SHEET NUMBER A2-141

ROOF DRAINAGE LEGEND

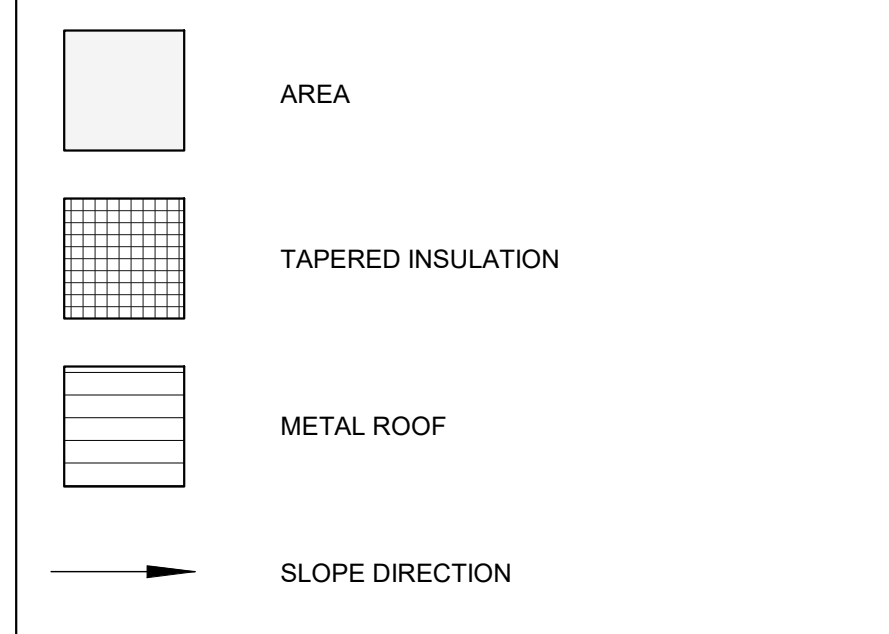


ROOF DRAINAGE CALCULATIONS


Table with columns: DRAINAGE AREA (X), MAX. SF, AREA SF, LEADER SIZE, REMARKS. Contains 24 rows of calculations for various roof areas and leader sizes.

ROOF NOTE

1. SEE DETAILS S-18 & 19 /A-S14 FOR LIGHTNING ARREST MOUNTING DETAILS

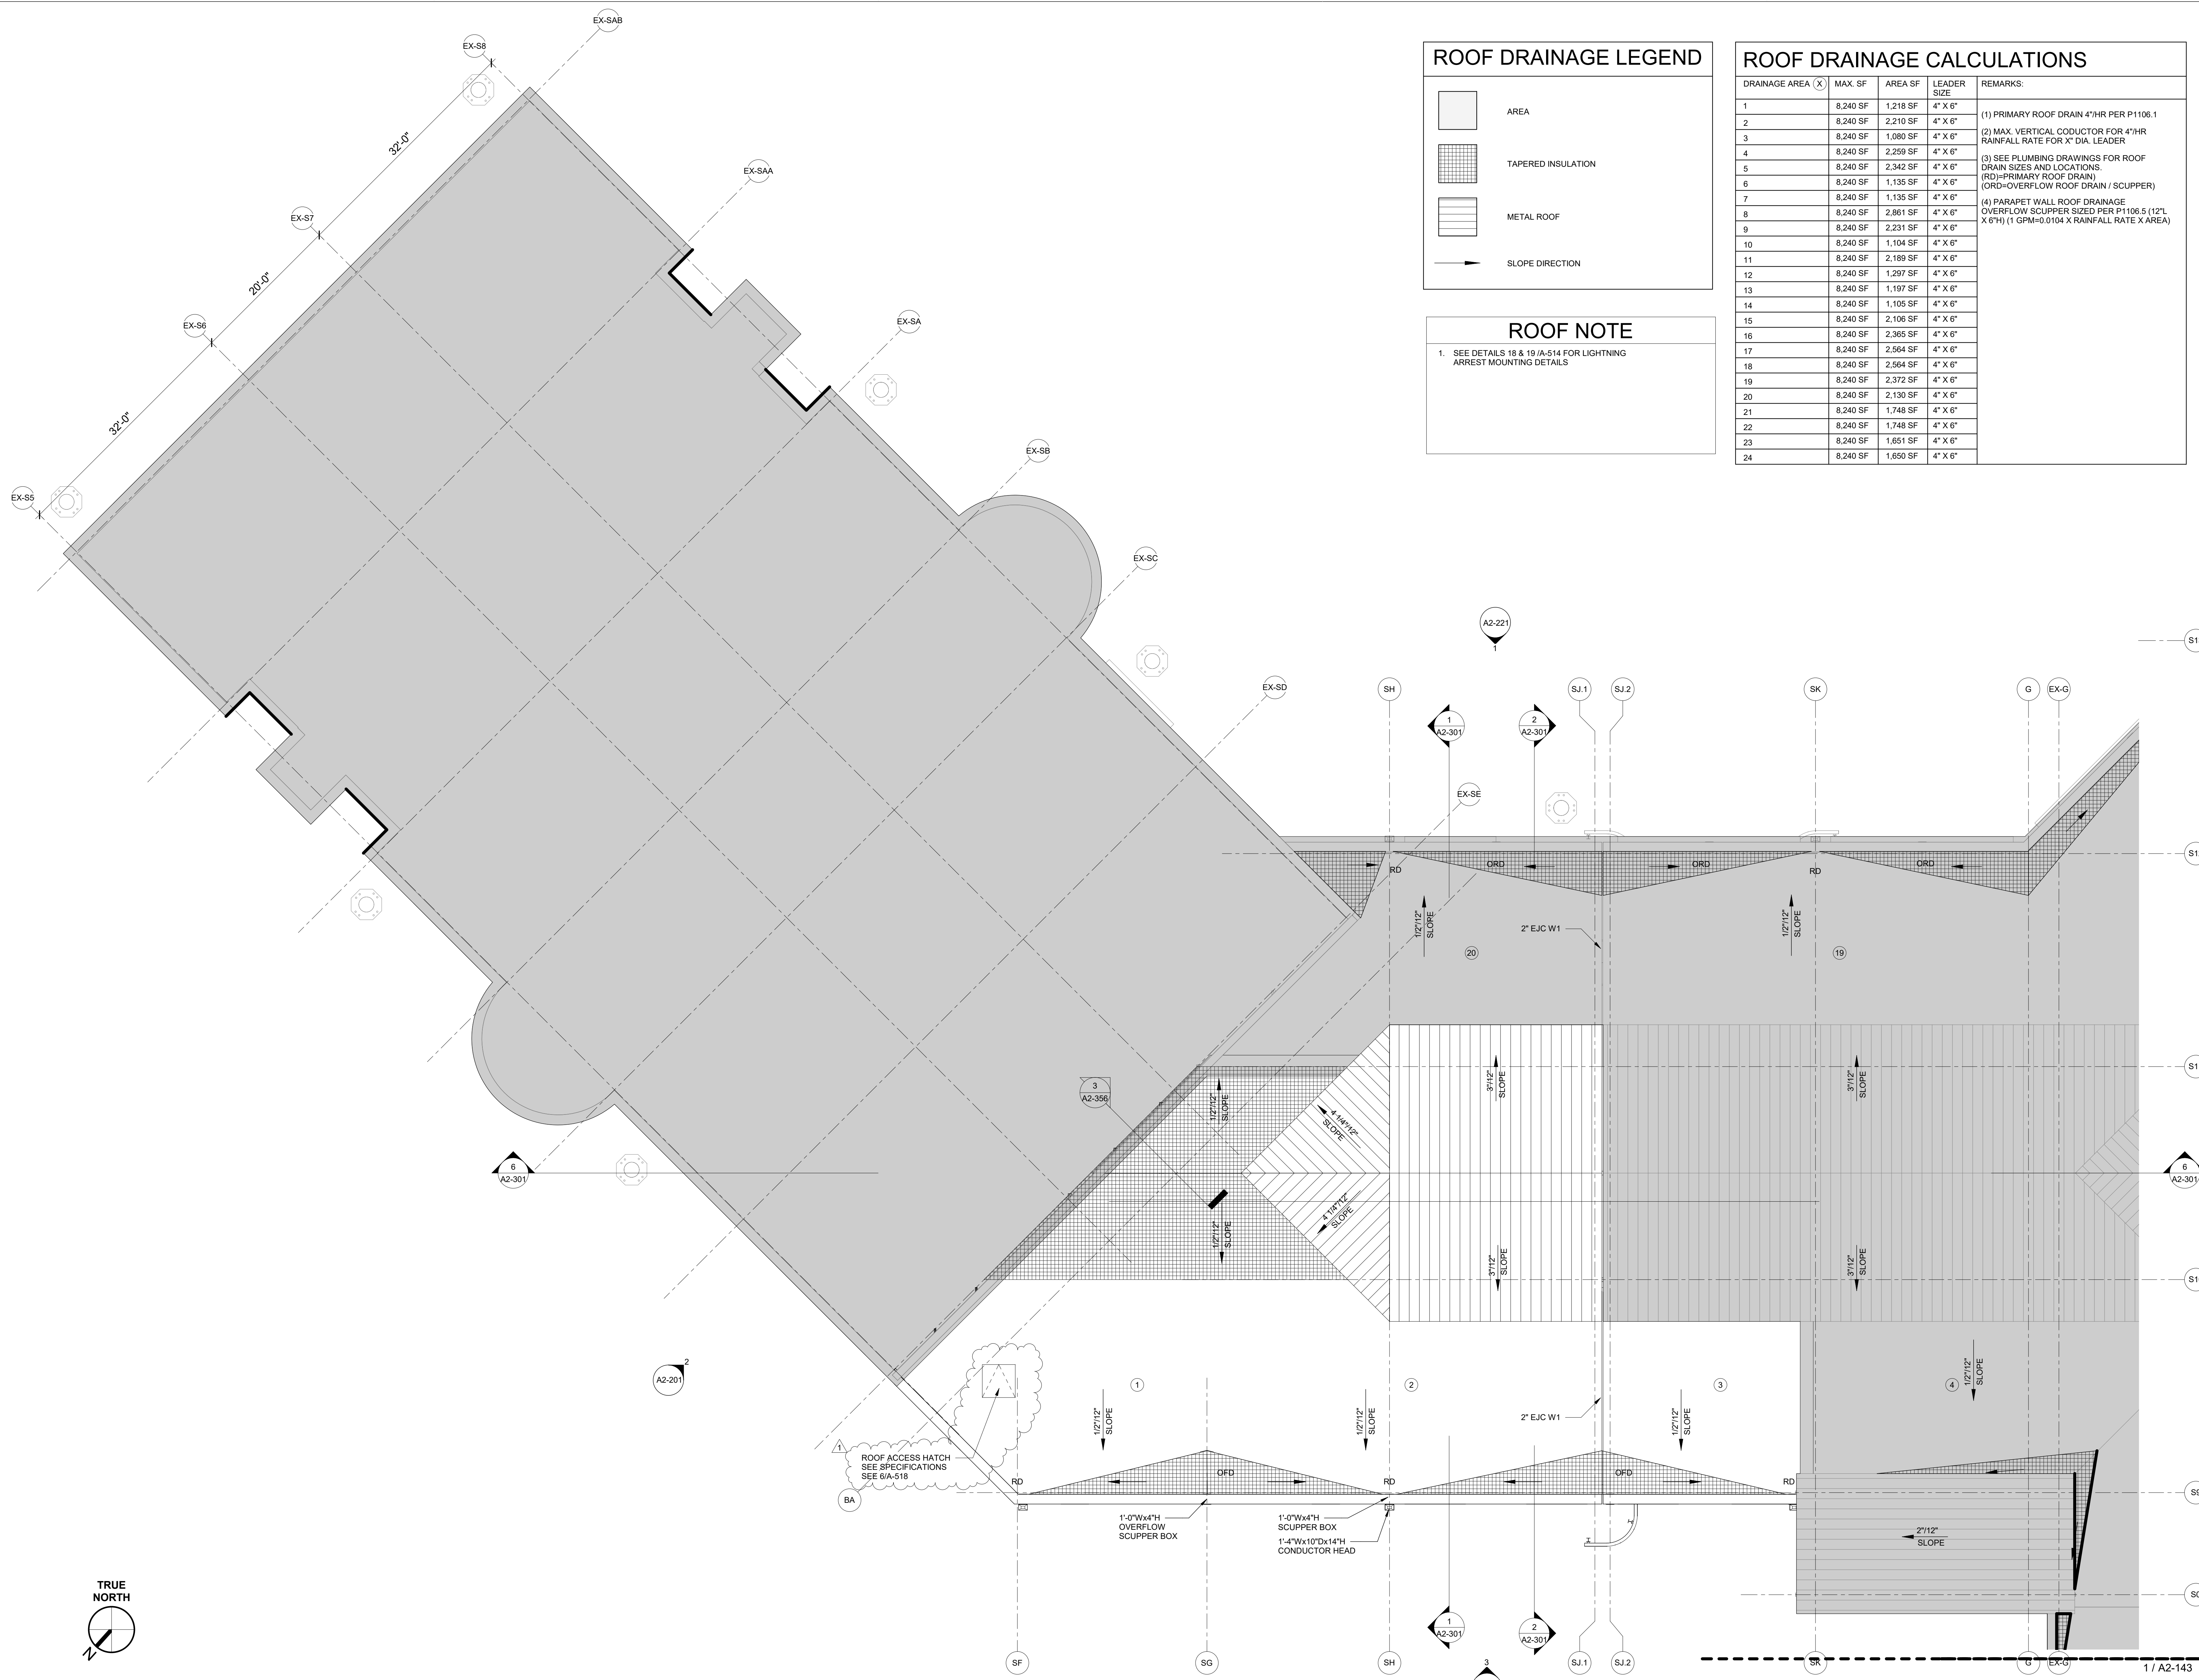


1 SCHEDULE 2 - ROOF PLAN ZONE 1 1/8" = 1'-0"

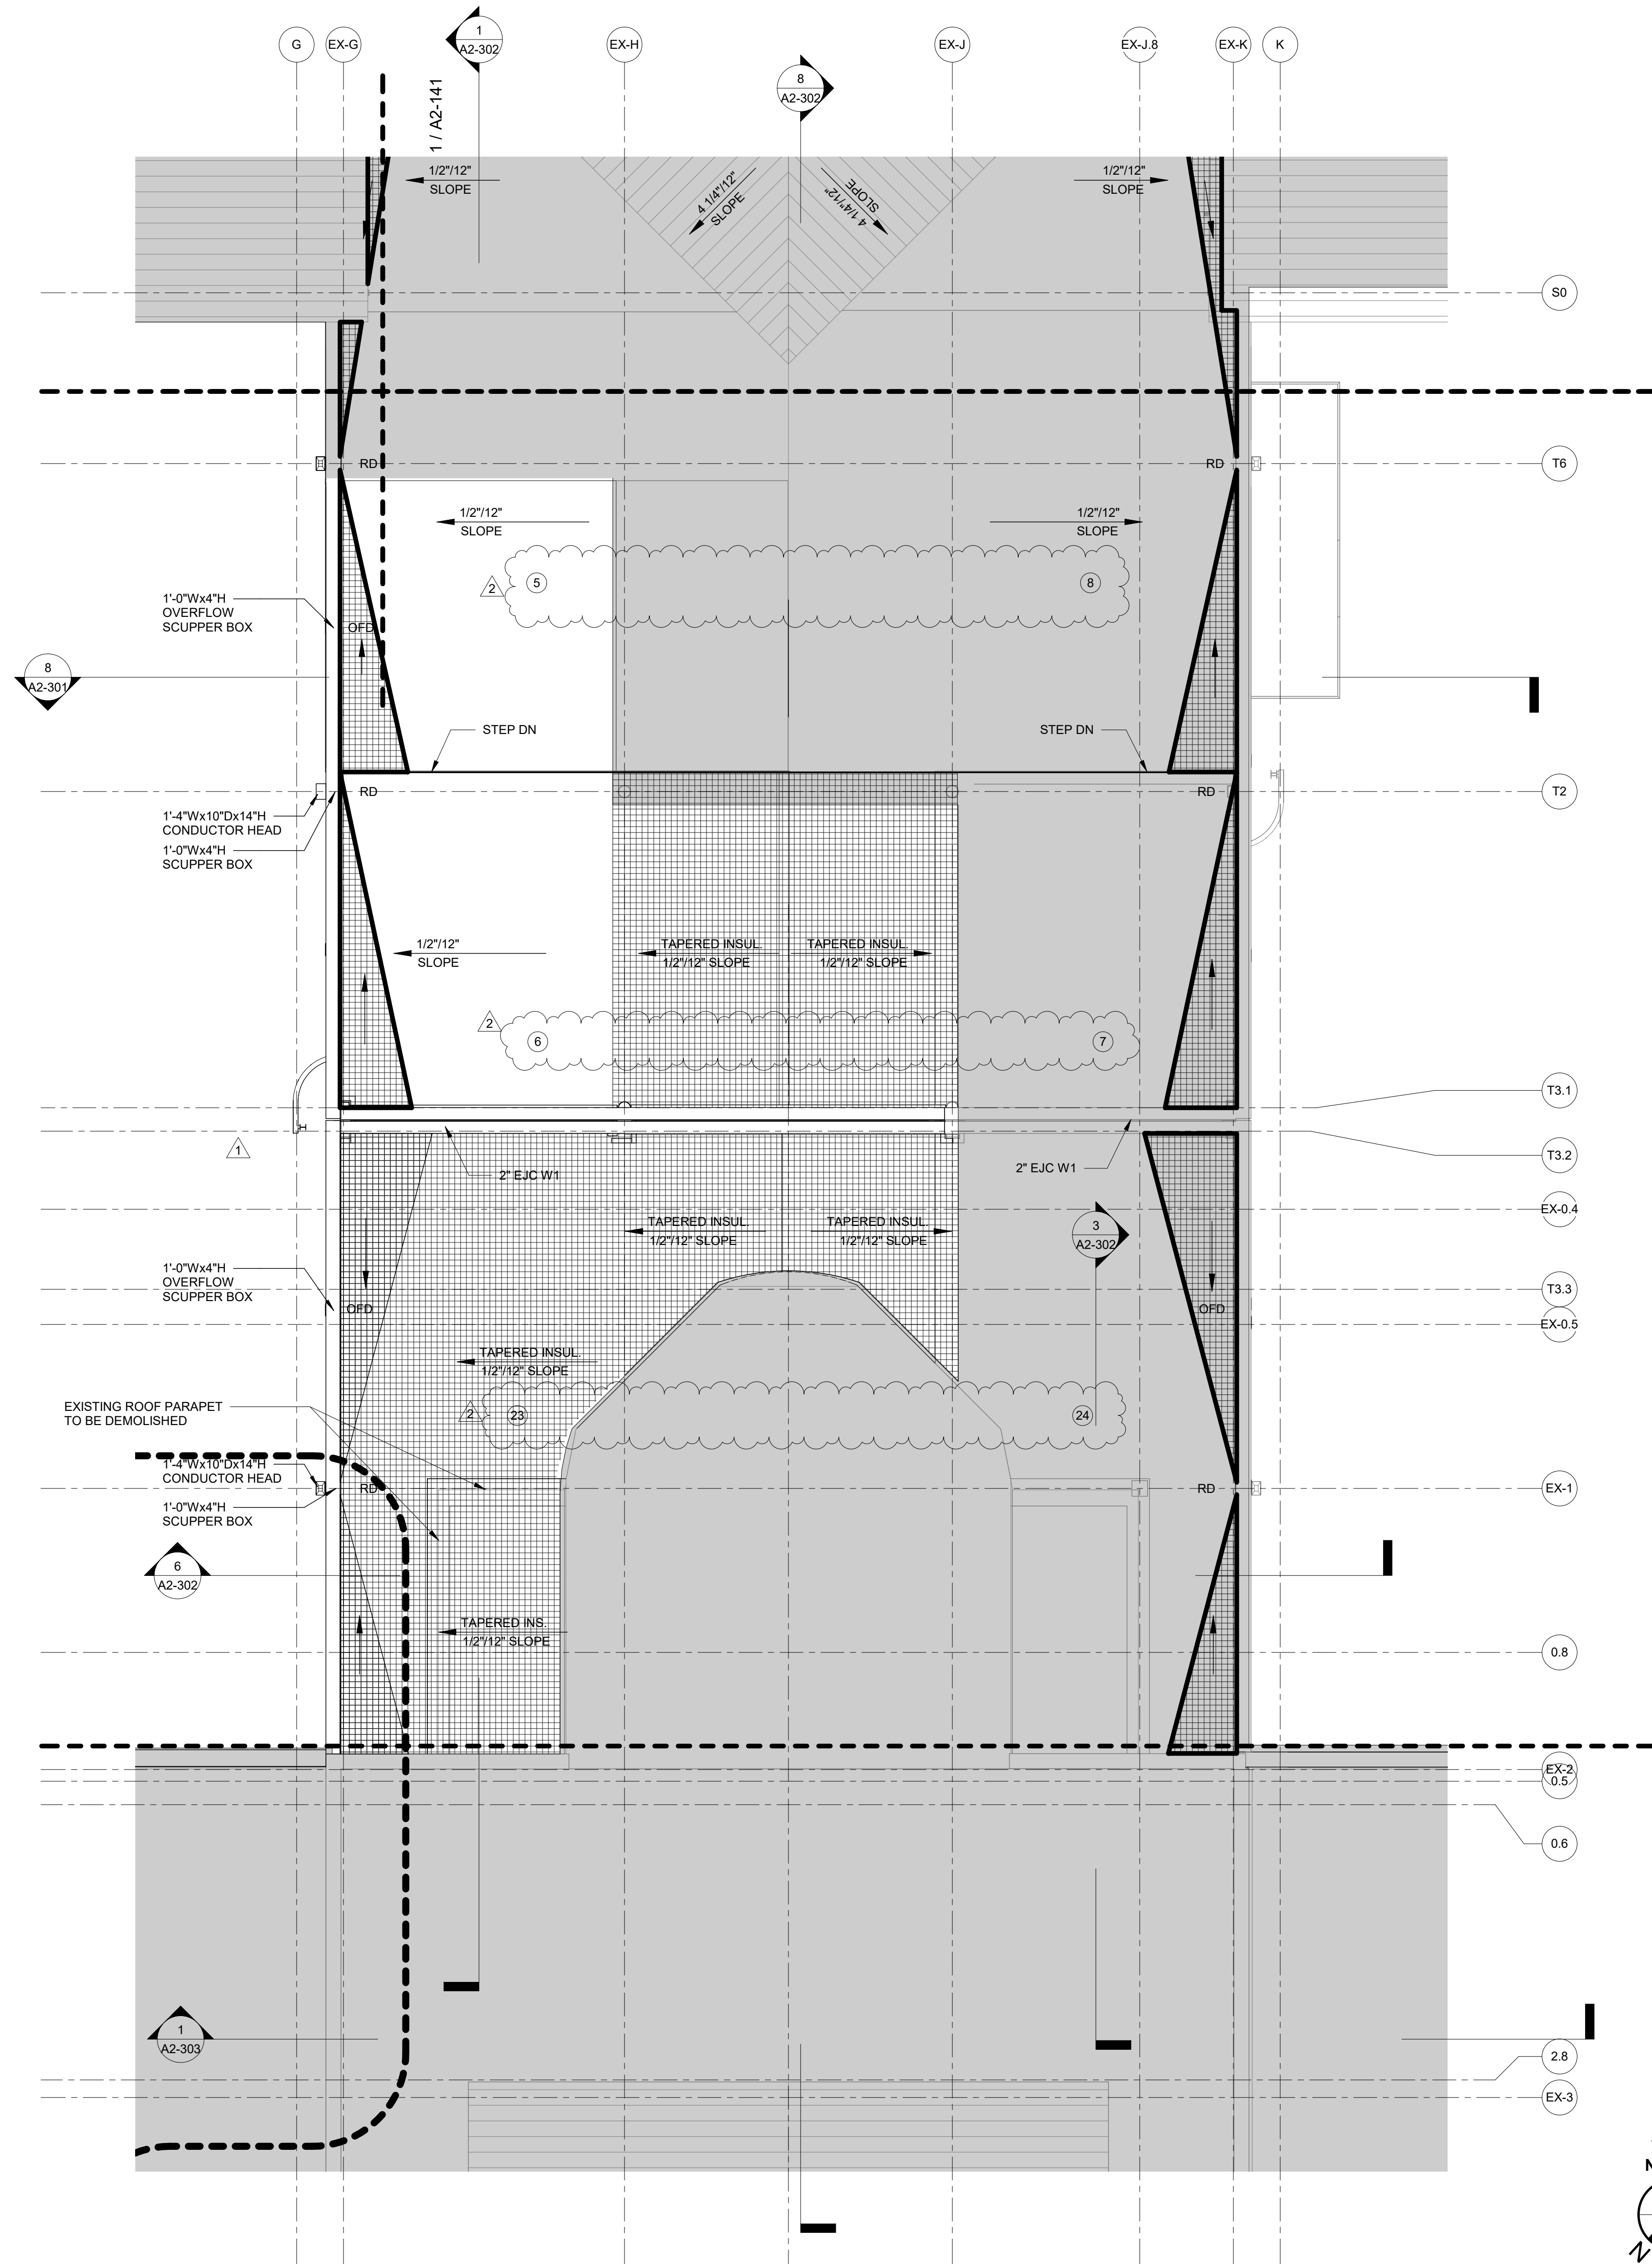


### ROOF DRAINAGE CALCULATIONS

DRAINAGE AREA (X)	MAX. SF	AREA SF	LEADER SIZE	REMARKS:
1	8,240 SF	1,218 SF	4" X 6"	(1) PRIMARY ROOF DRAIN 4"HR PER P1106.1
2	8,240 SF	2,210 SF	4" X 6"	(2) MAX. VERTICAL CONDUCTOR FOR 4"HR RAINFALL RATE FOR X" DIA. LEADER
3	8,240 SF	1,080 SF	4" X 6"	(3) SEE PLUMBING DRAWINGS FOR ROOF DRAIN SIZES AND LOCATIONS.
4	8,240 SF	2,259 SF	4" X 6"	(RD)=PRIMARY ROOF DRAIN (ORD)=OVERFLOW ROOF DRAIN / SCUPPER
5	8,240 SF	2,342 SF	4" X 6"	(4) PARAPET WALL ROOF DRAINAGE OVERFLOW SCUPPER SIZED PER P1106.5 (12" L X 6" H) (1 GPM=0.0104 X RAINFALL RATE X AREA)
6	8,240 SF	1,135 SF	4" X 6"	
7	8,240 SF	1,135 SF	4" X 6"	
8	8,240 SF	2,861 SF	4" X 6"	
9	8,240 SF	2,231 SF	4" X 6"	
10	8,240 SF	1,104 SF	4" X 6"	
11	8,240 SF	2,189 SF	4" X 6"	
12	8,240 SF	1,297 SF	4" X 6"	
13	8,240 SF	1,197 SF	4" X 6"	
14	8,240 SF	1,105 SF	4" X 6"	
15	8,240 SF	2,106 SF	4" X 6"	
16	8,240 SF	2,365 SF	4" X 6"	
17	8,240 SF	2,564 SF	4" X 6"	
18	8,240 SF	2,564 SF	4" X 6"	
19	8,240 SF	2,372 SF	4" X 6"	
20	8,240 SF	2,130 SF	4" X 6"	
21	8,240 SF	1,748 SF	4" X 6"	
22	8,240 SF	1,748 SF	4" X 6"	
23	8,240 SF	1,651 SF	4" X 6"	
24	8,240 SF	1,650 SF	4" X 6"	

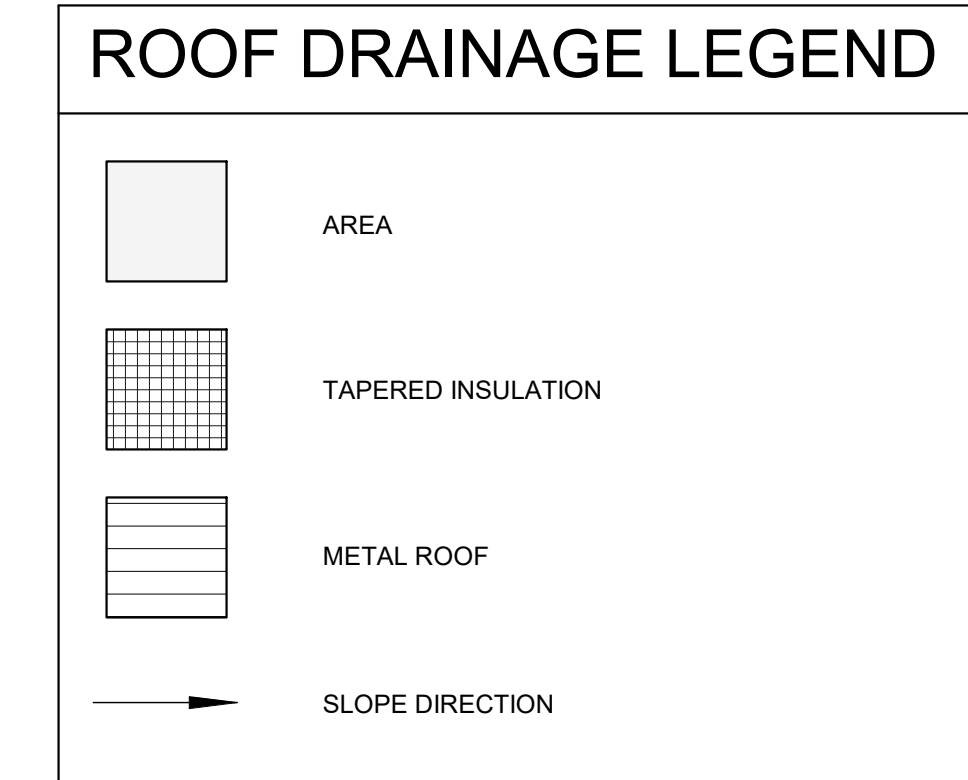

### ROOF NOTE

1. SEE DETAILS 18 & 19 JA-514 FOR LIGHTNING ARREST MOUNTING DETAILS

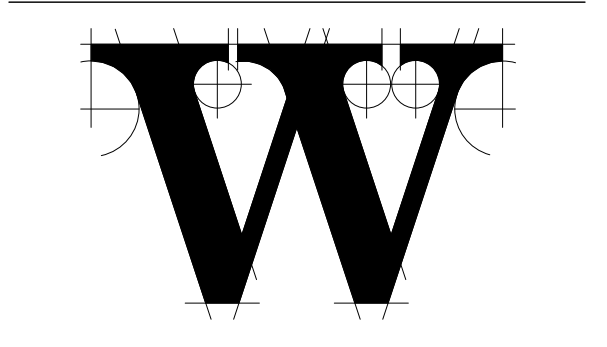

**THE WILSON GROUP**  
- ARCHITECTS -  
PO Box 5510 Charlotte, NC 28299  
704-331-9747 • www.twgarchitects.com

PROJECT MANAGER & CIVIL ENGINEER  
**TALBERT & BRIGHT**  
CONSULTING ARCHITECT  
LS3P


STRUCTURAL ENGINEER  
**STEWART**

FP/PM/E ENGINEER  
**CHEATHAM & ASSOC.**  
BAGGAGE HANDLING CONSULTANTS  
BNP

AIRCRAFT SUPPORT SYSTEMS  
**DK CONSULTANTS**

SPECIALTY LIGHTING CONSULTANT  
**HARTRANFT**

SIGNAGE & WAYFINDING  
**TAKEFORM**

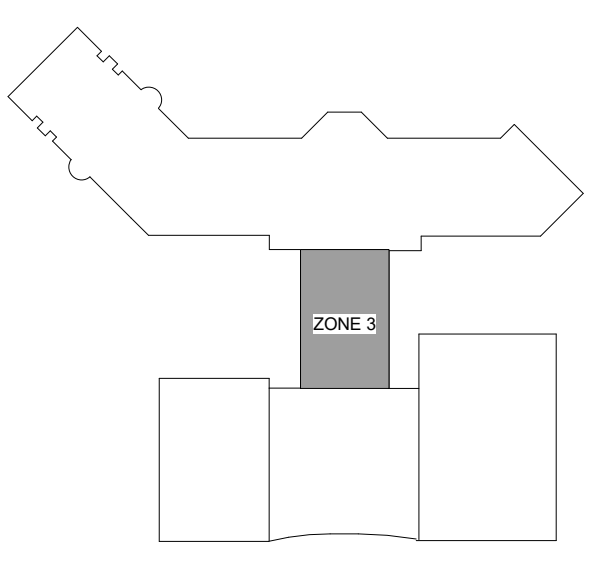

**KEY PLAN**  
COPYRIGHT © 2019  
THE WILSON GROUP ARCHITECTS  
ALL RIGHTS RESERVED

PRINTED OR ELECTRONIC DRAWINGS AND DOCUMENTATION MAY NOT BE REPRODUCED IN ANY FORM WITHOUT WRITTEN PERMISSION FROM THE WILSON GROUP ARCHITECTS

### REVISIONS


1	7/12/2019	AD-01
2	7/30/2019	AD-03


DATE 6/28/2019  
PROJECT NUMBER 9202-000  
SHEET TITLE

**SCHEDULE 2 - ROOF LEVEL PLAN ZONE 3**

SHEET NUMBER  
**A2-143**

1 SCHEDULE 2 - ROOF PLAN ZONE 3  
1/8" = 1'-0"

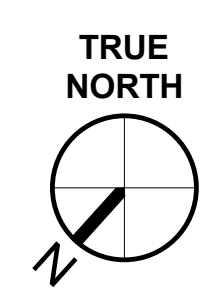

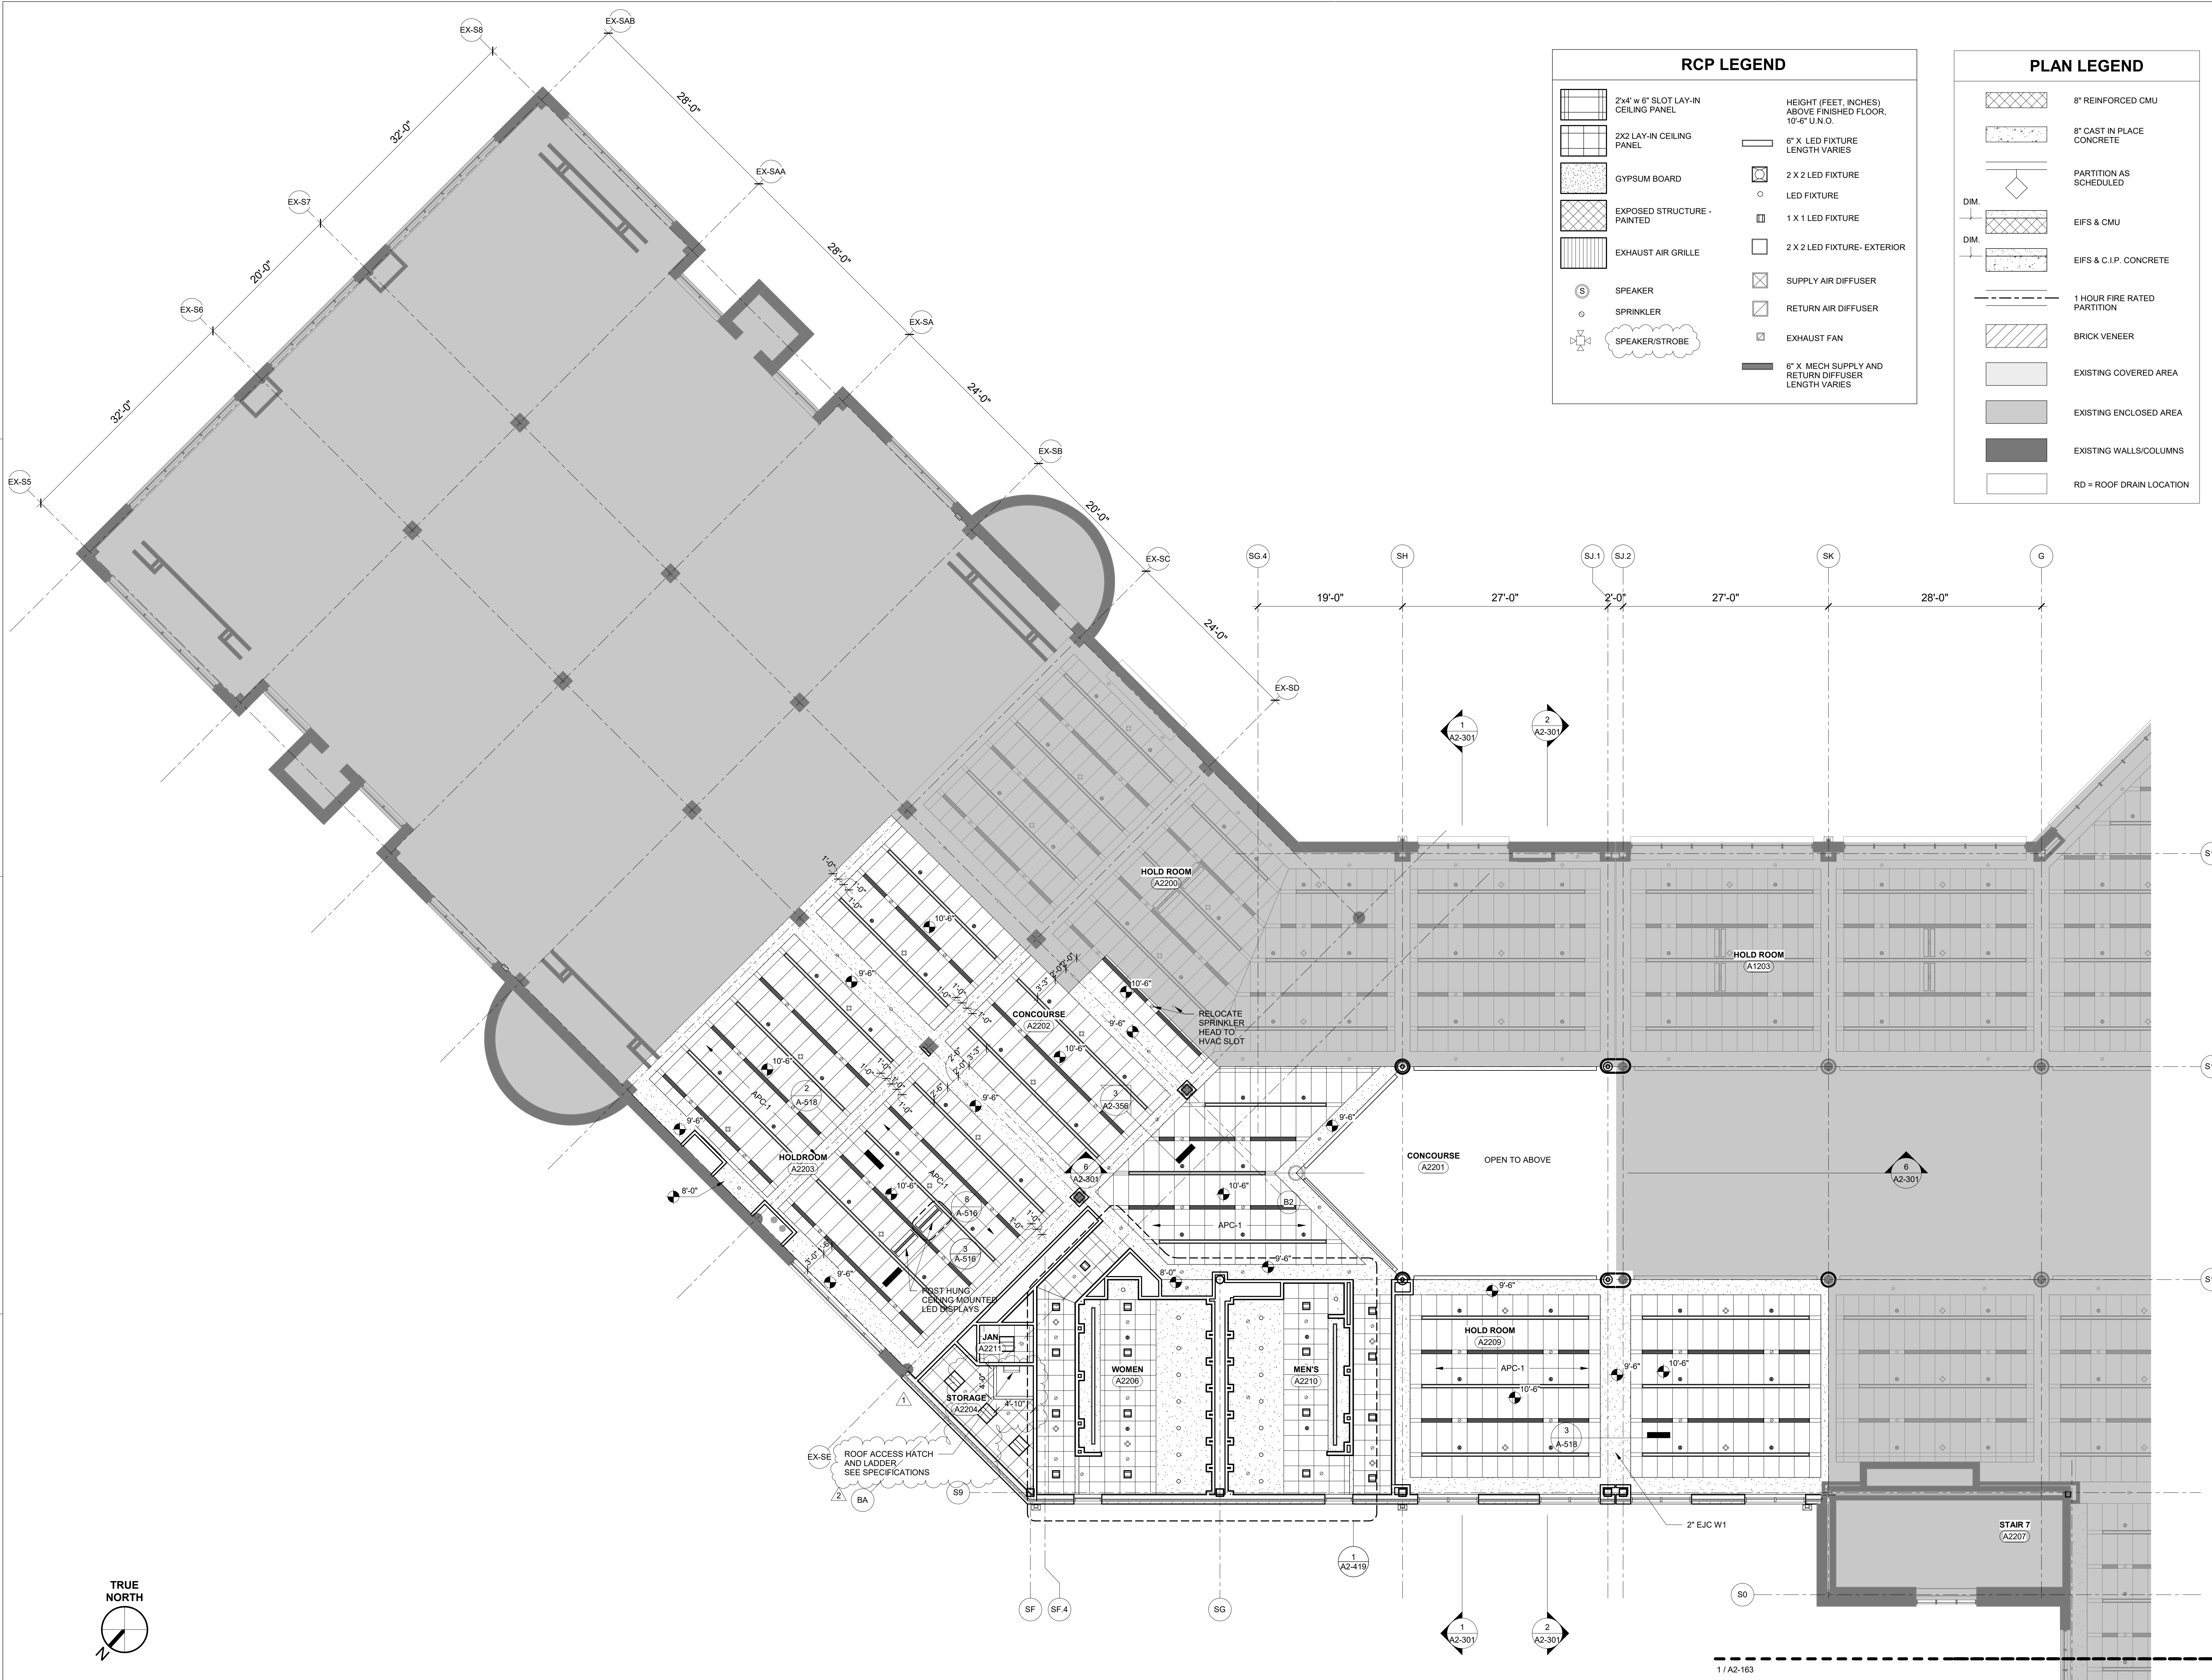

**RCP LEGEND**


	2x4" w 6' SLOT LAY-IN CEILING PANEL		HEIGHT (FEET, INCHES) ABOVE FINISHED FLOOR, 10'-6" U.N.D.
	2X2 LAY-IN CEILING PANEL		6' X LED FIXTURE LENGTH VARIES
	GYPSUM BOARD		2 X 2 LED FIXTURE
	EXPOSED STRUCTURE - PAINTED		LED FIXTURE
	EXHAUST AIR GRILLE		1 X 1 LED FIXTURE
	SPEAKER		2 X 2 LED FIXTURE - EXTERIOR
	SPRINKLER		SUPPLY AIR DIFFUSER
	SPEAKER/STROBE		RETURN AIR DIFFUSER
			EXHAUST FAN
			6' X MECH SUPPLY AND RETURN DIFFUSER LENGTH VARIES

**PLAN LEGEND**

	8' REINFORCED CMU
	8' CAST IN PLACE CONCRETE
	PARTITION AS SCHEDULED
	EIFS & CMU
	EIFS & C.I.P. CONCRETE
	1 HOUR FIRE RATED PARTITION
	BRICK VENEER
	EXISTING COVERED AREA
	EXISTING ENCLOSED AREA
	EXISTING WALLS/COLUMNS
	RD = ROOF DRAIN LOCATION



**TERMINAL IMPROVEMENTS CONTRACT 3**  
 Wilmington International Airport  
 1740 Airport Boulevard, Suite 12  
 Wilmington, NC 28405

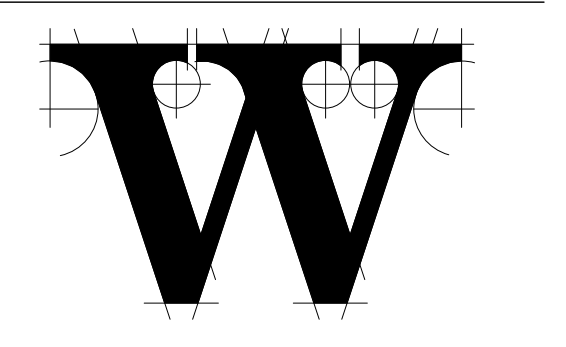

**THE WILSON GROUP**  
 - ARCHITECTS -  
 PO Box 5510 Charlotte, NC 28299  
 704-331-9747 • www.twgarchitects.com

PROJECT MANAGER & CIVIL ENGINEER  
**TALBERT & BRIGHT**  
 CONSULTING ARCHITECT  
 LS3P


STRUCTURAL ENGINEER  
**STEWART**

FP/PM/E ENGINEER  
**CHEATHAM & ASSOC.**  
 BAGGAGE HANDLING CONSULTANTS  
 BNP

AIRCRAFT SUPPORT SYSTEMS  
**DK CONSULTANTS**

SPECIALTY LIGHTING CONSULTANT  
**HARTRANFT**

SIGNAGE & WAYFINDING  
**TAKEFORM**

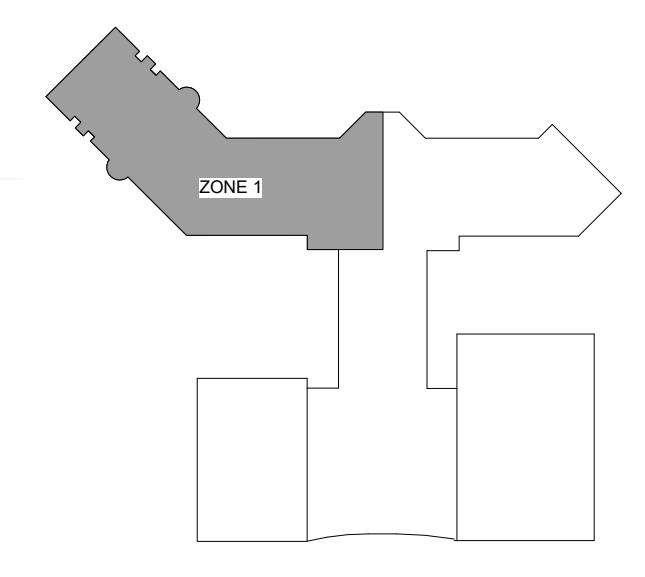

**KEY PLAN**  
 COPYRIGHT © 2019  
 THE WILSON GROUP ARCHITECTS  
 ALL RIGHTS RESERVED

PRINTED OR ELECTRONIC DRAWINGS AND DOCUMENTATION MAY NOT BE REPRODUCED IN ANY FORM WITHOUT WRITTEN PERMISSION FROM THE WILSON GROUP ARCHITECTS

**REVISIONS**


1	7/12/2019	AD-01
2	7/30/2019	AD-03

DATE 6/28/2019  
 PROJECT NUMBER 9202-000  
 SHEET TITLE


**SCHEDULE 2 - BOARDING LEVEL RCP ZONE 1**

SHEET NUMBER  
**A2-161**

**1 SCHEDULE 2 - BOARDING LEVEL RCP ZONE 1**  
 1/8" = 1'-0"

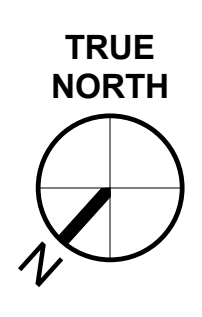



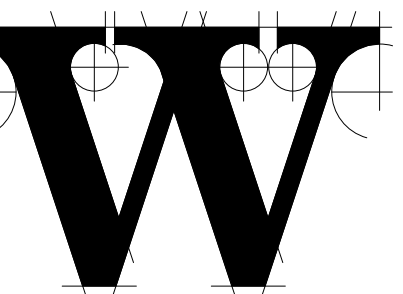

**THE WILSON GROUP**  
- ARCHITECTS -

PO Box 5510 Charlotte, NC 28299  
704-331-9747 • www.twgarchitects.com

PROJECT MANAGER & CIVIL ENGINEER  
**TALBERT & BRIGHT**  
CONSULTING ARCHITECT  
LS3P

STRUCTURAL ENGINEER  
**STEWART**

FP/PM/E ENGINEER  
**CHEATHAM & ASSOC.**

BAGGAGE HANDLING CONSULTANTS  
**BNP**

AIRCRAFT SUPPORT SYSTEMS  
**DK CONSULTANTS**

SPECIALTY LIGHTING CONSULTANT  
**HARTRANFT**

SIGNAGE & WAYFINDING  
**TAKEFORM**

COPYRIGHT © 2019  
THE WILSON GROUP ARCHITECTS  
ALL RIGHTS RESERVED  
PRINTED OR ELECTRONIC DRAWINGS AND DOCUMENTATION MAY NOT BE REPRODUCED IN ANY FORM WITHOUT WRITTEN PERMISSION FROM THE WILSON GROUP ARCHITECTS

**REVISIONS**


- 1 7/12/2019 AD-01
- 2 7/30/2019 AD-03

DATE 6/28/2019  
PROJECT NUMBER 9202-000  
SHEET TITLE


**SCHEDULE 2 - BUILDING ELEVATIONS**

SHEET NUMBER


**A2-222**

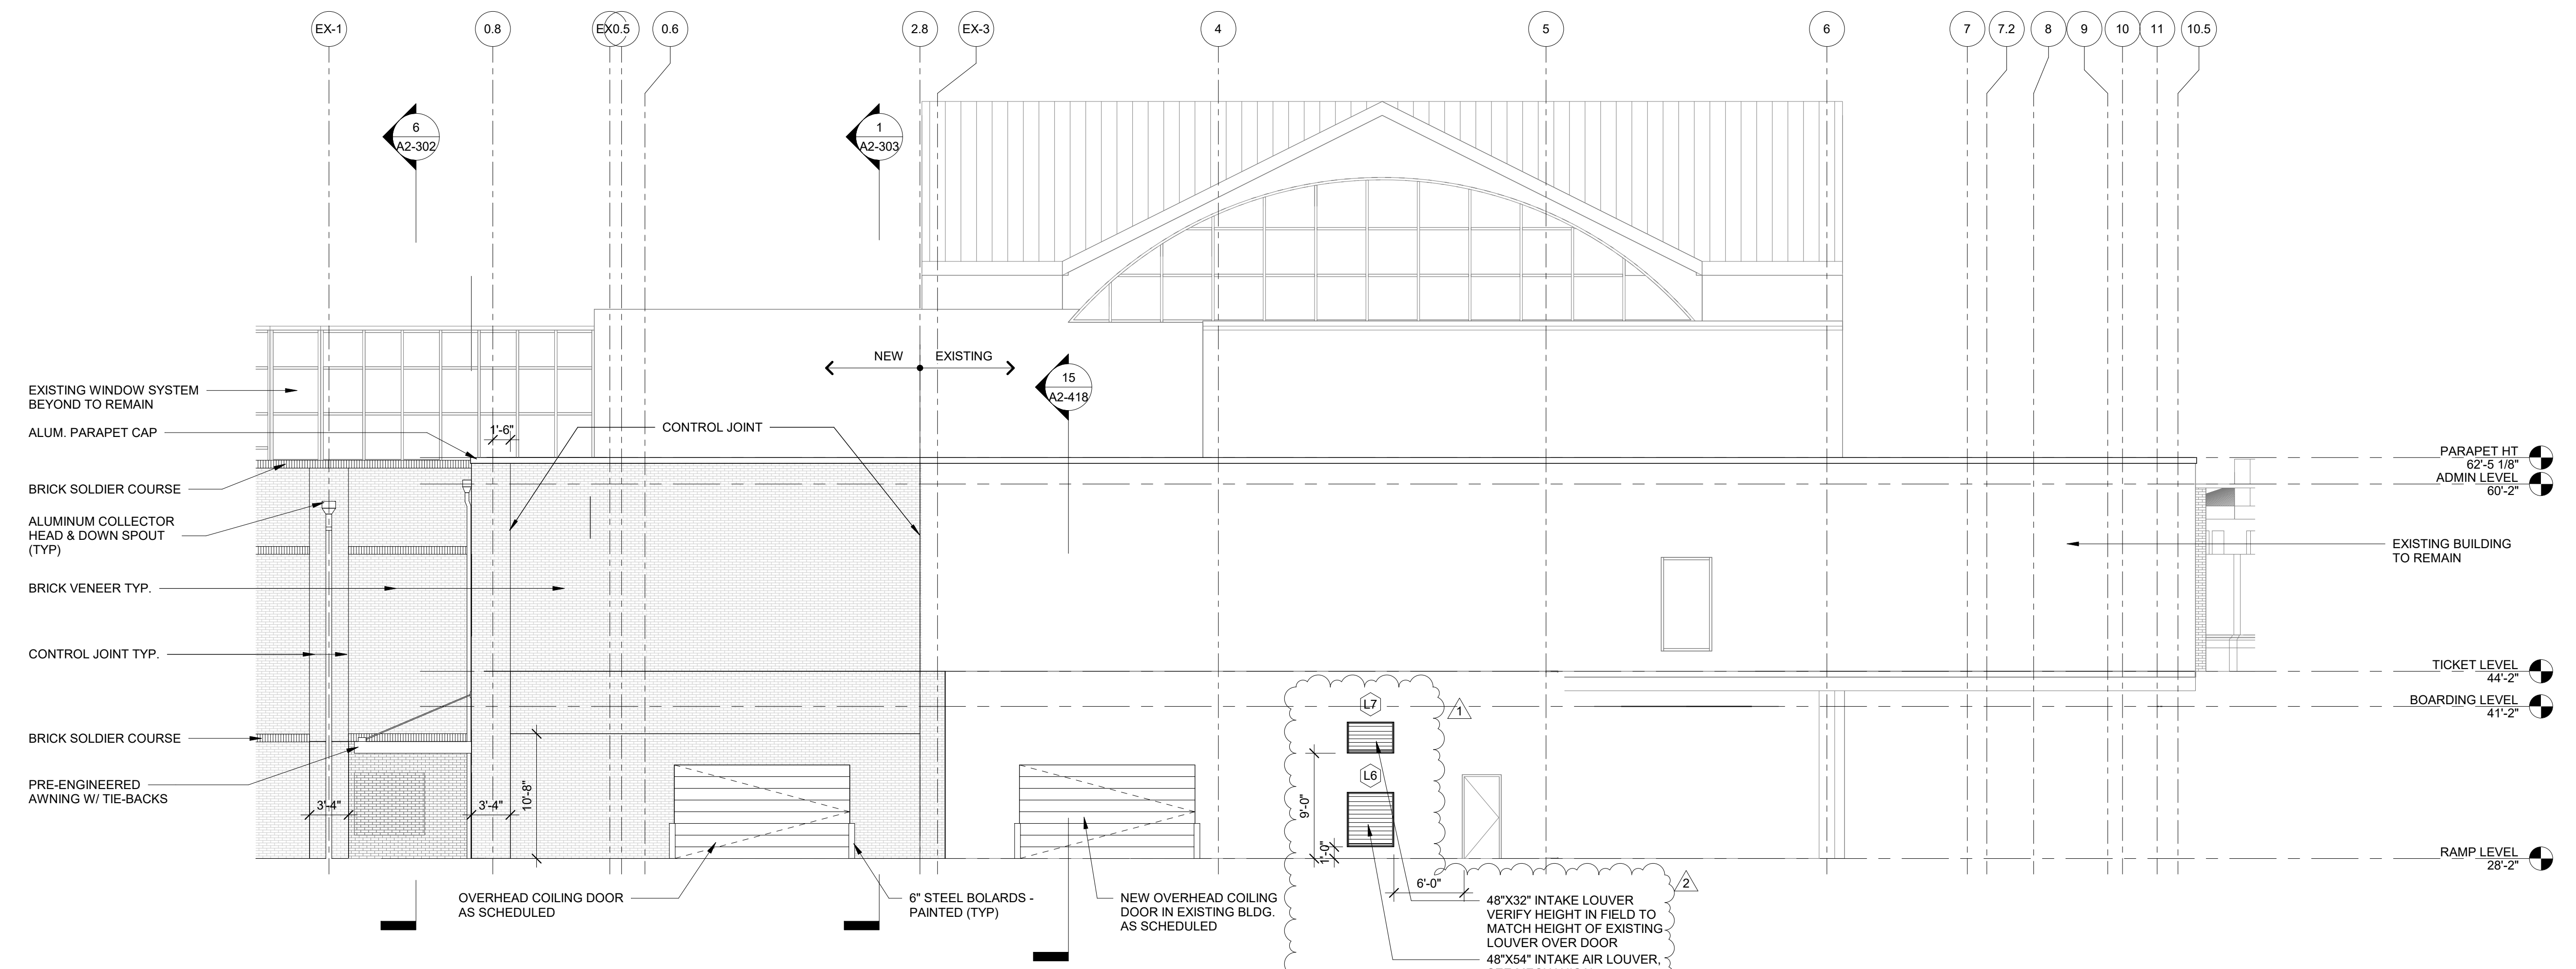


**7 ENLARGED BUILDING ELEVATION - EAST ZONE 4**  
1/8" = 1'-0"

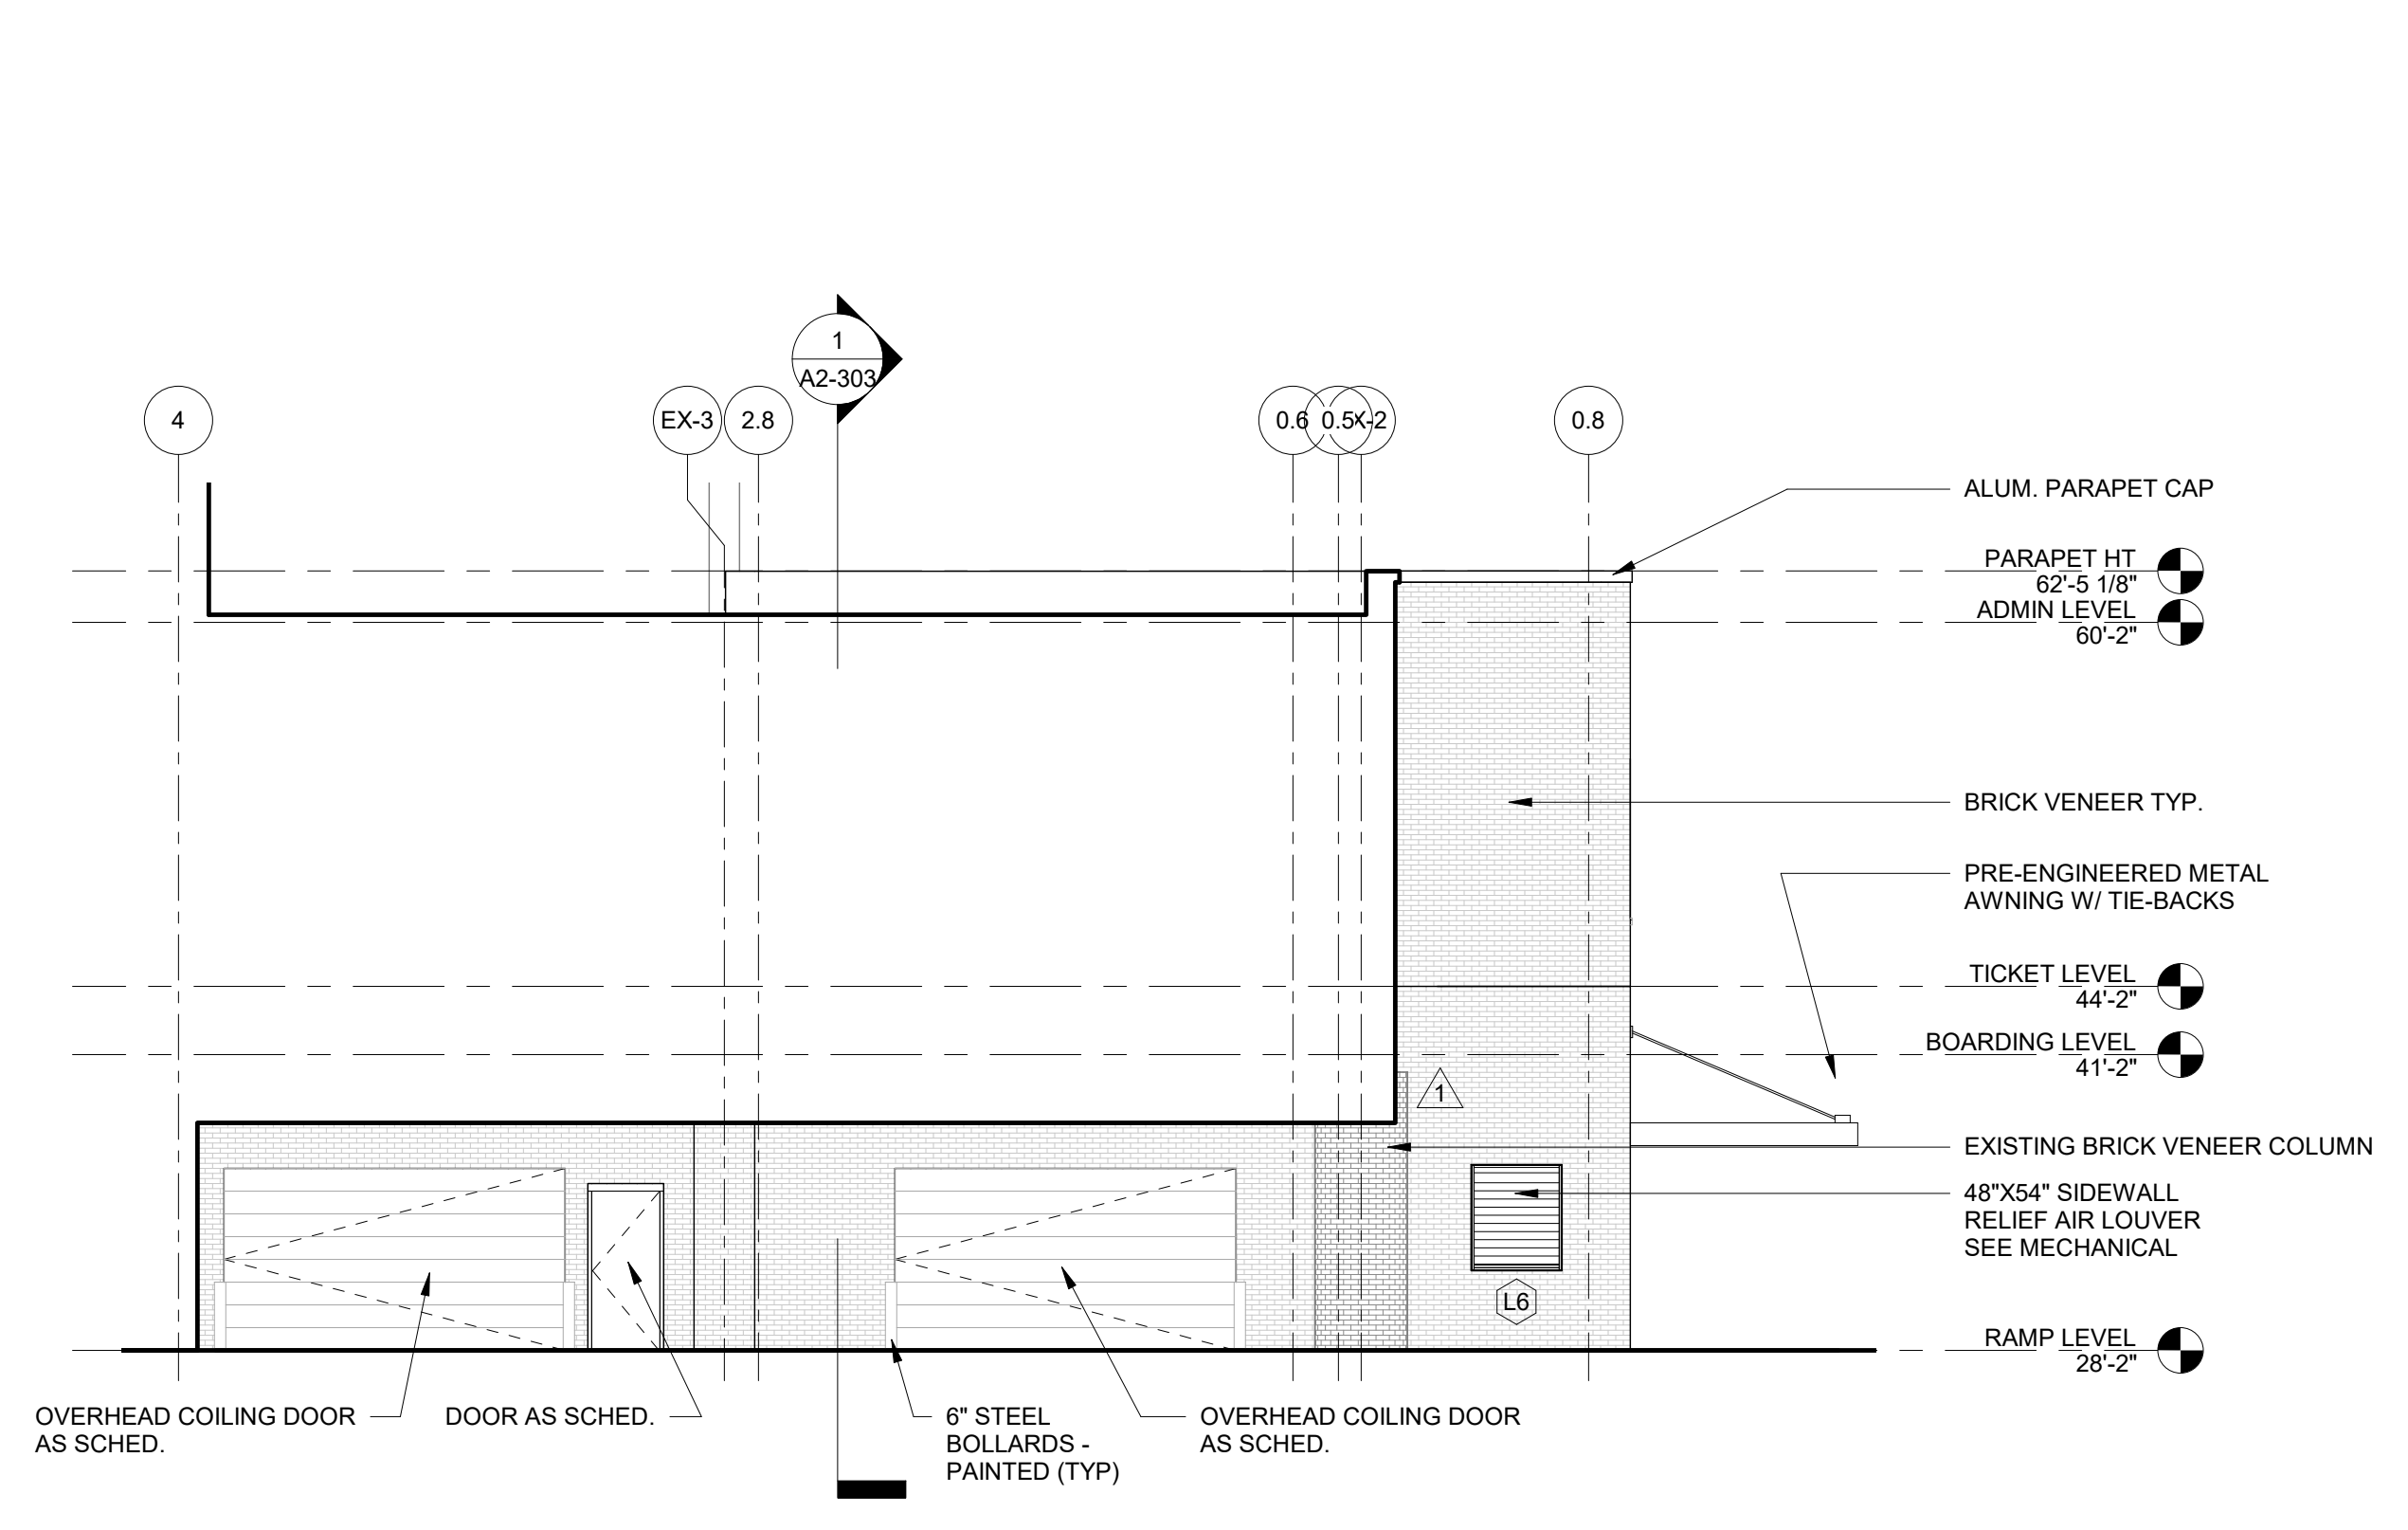

**1 ENLARGED EXTERIOR ELEVATION - WEST ZONE 4**  
1/8" = 1'-0"

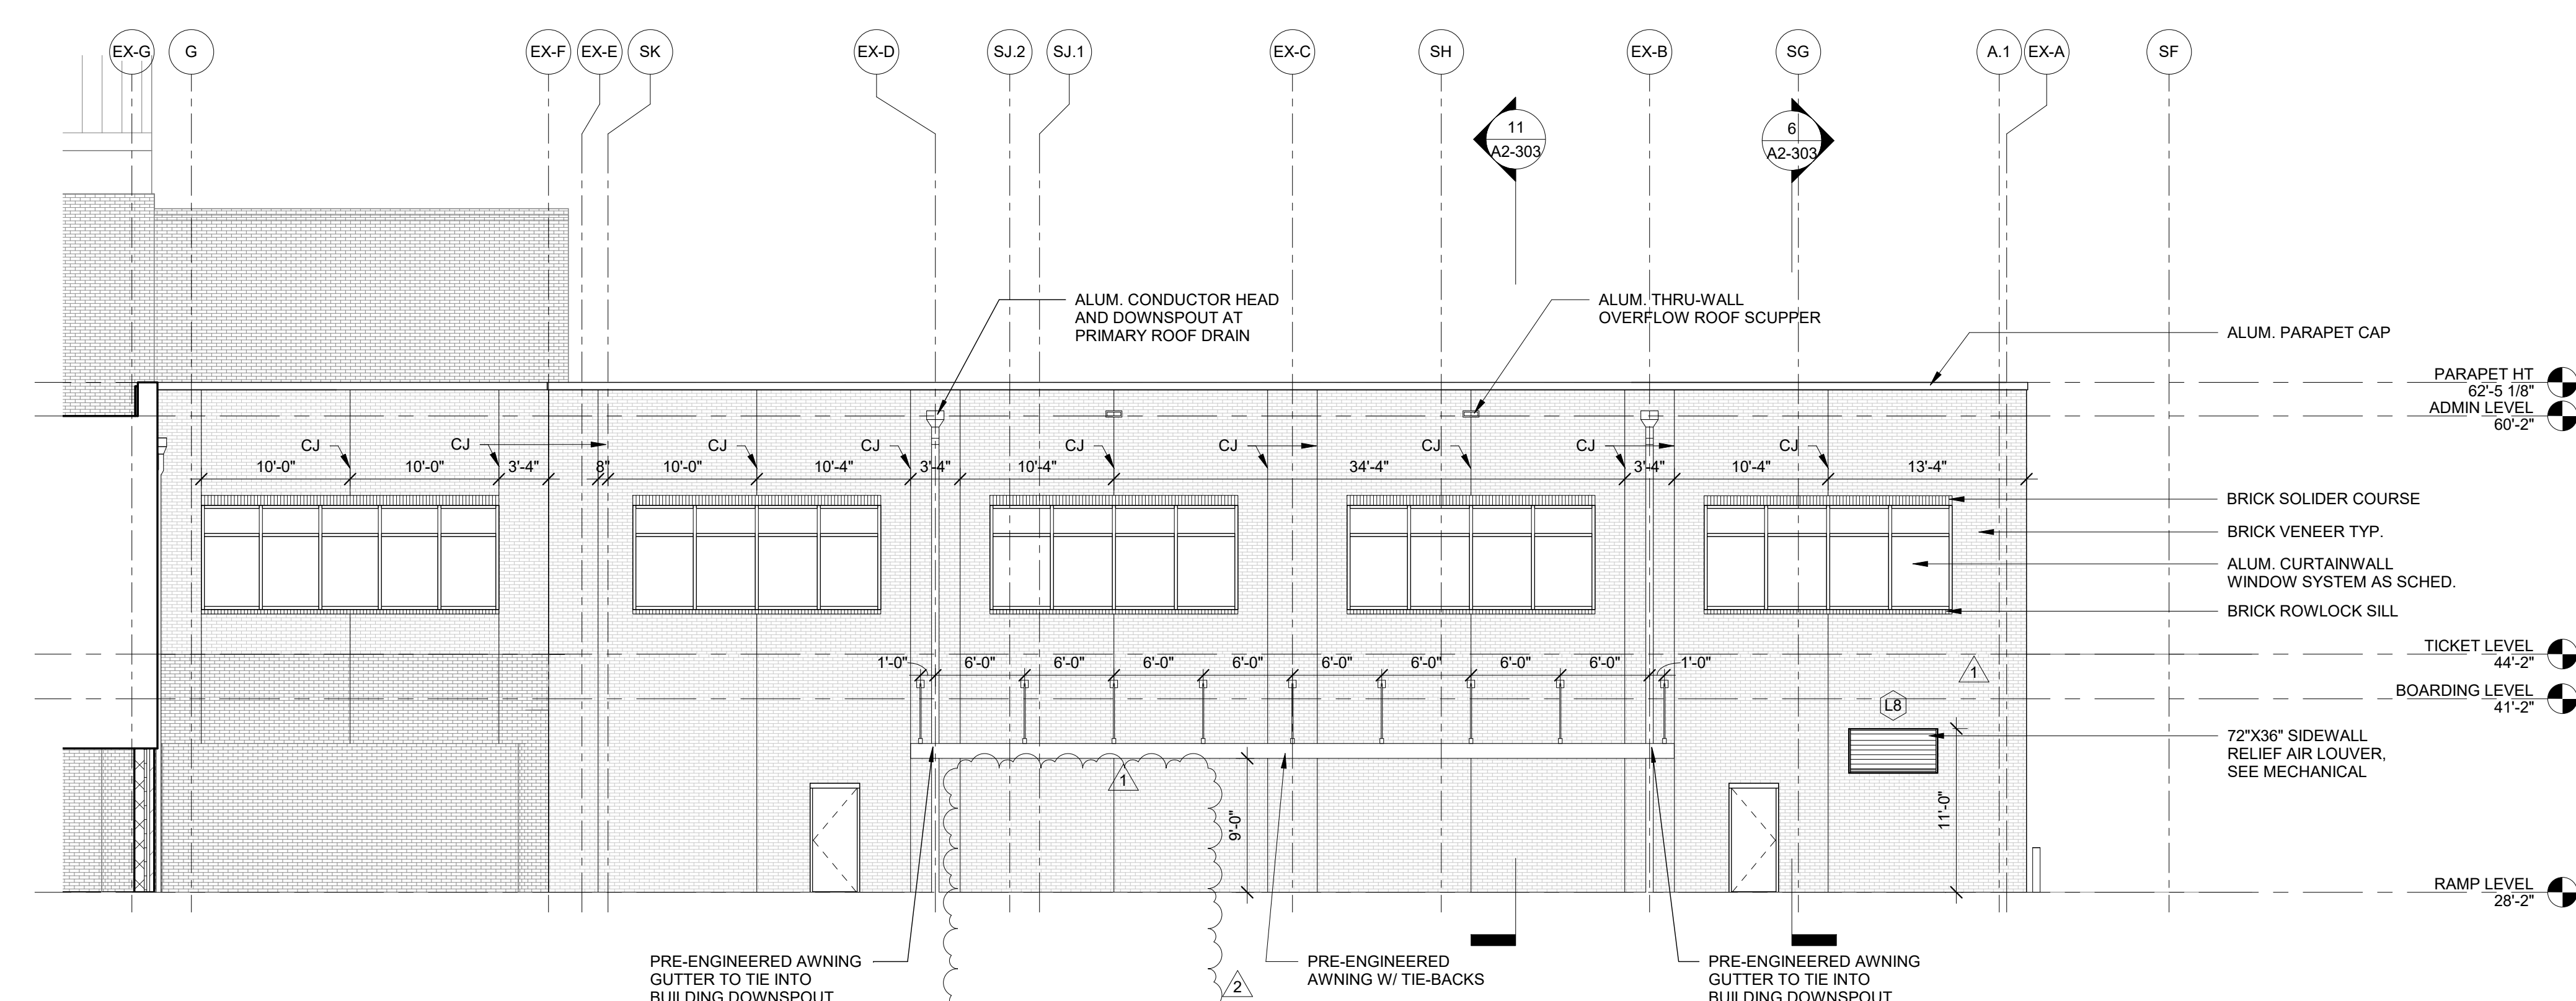


**3 ENLARGED BUILDING ELEVATION - SOUTH ZONE 4**  
1/8" = 1'-0"

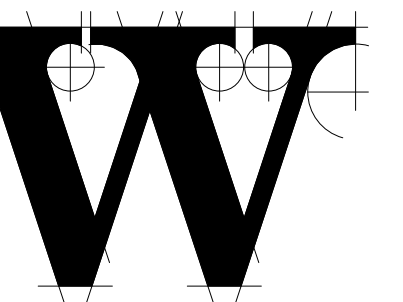


**GENERAL NOTES - INTERIOR ELEVATIONS**


1. REFER TO SHEET A-654 FOR WALL BASE, WALL, AND PANEL REVEAL DETAILS.
2. ABBREVIATIONS:
  - CLR = CENTERLINE OF REVEAL
  - TOR = TOP OF REVEAL
  - BOR = BOTTOM OF REVEAL
3. CONTRACTOR TO PROVIDE SHOP DRAWINGS TO ARCHITECT FOR REVIEW AND APPROVAL OF ALL SPECIALTY WALL PANEL SYSTEMS (WPS) PRIOR TO PROCUREMENT, FABRICATION, AND INSTALLATION.
4. CONTRACTOR TO PROVIDE MOCKUPS OF EACH SPECIALTY WALL PANEL SYSTEM (WPS) FOR REVIEW AND APPROVAL PRIOR TO PROCUREMENT, FABRICATION, AND INSTALLATION.
5. ALL VERTICAL AND HORIZONTAL REVEALS ARE TO BE CONTINUOUS AND UNINTERRUPTED, U.N.O.
6. ALL DEAD STOP EXTRUSIONS ARE TO BE CONTINUOUS AND UNINTERRUPTED.

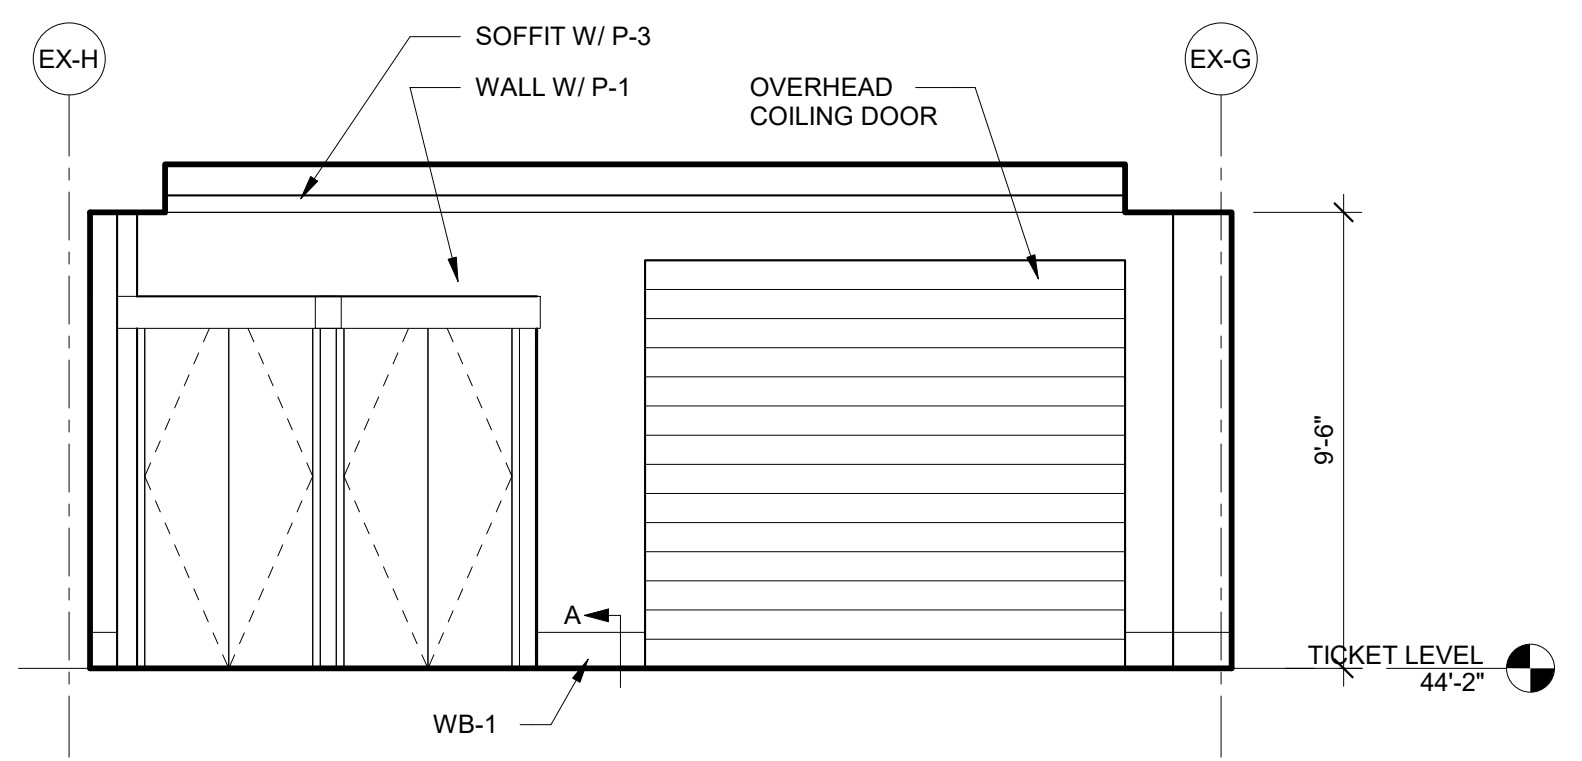


**17 SCH 2 INT ELEV - CIRCULATION SOUTH**  
1/4" = 1'-0"

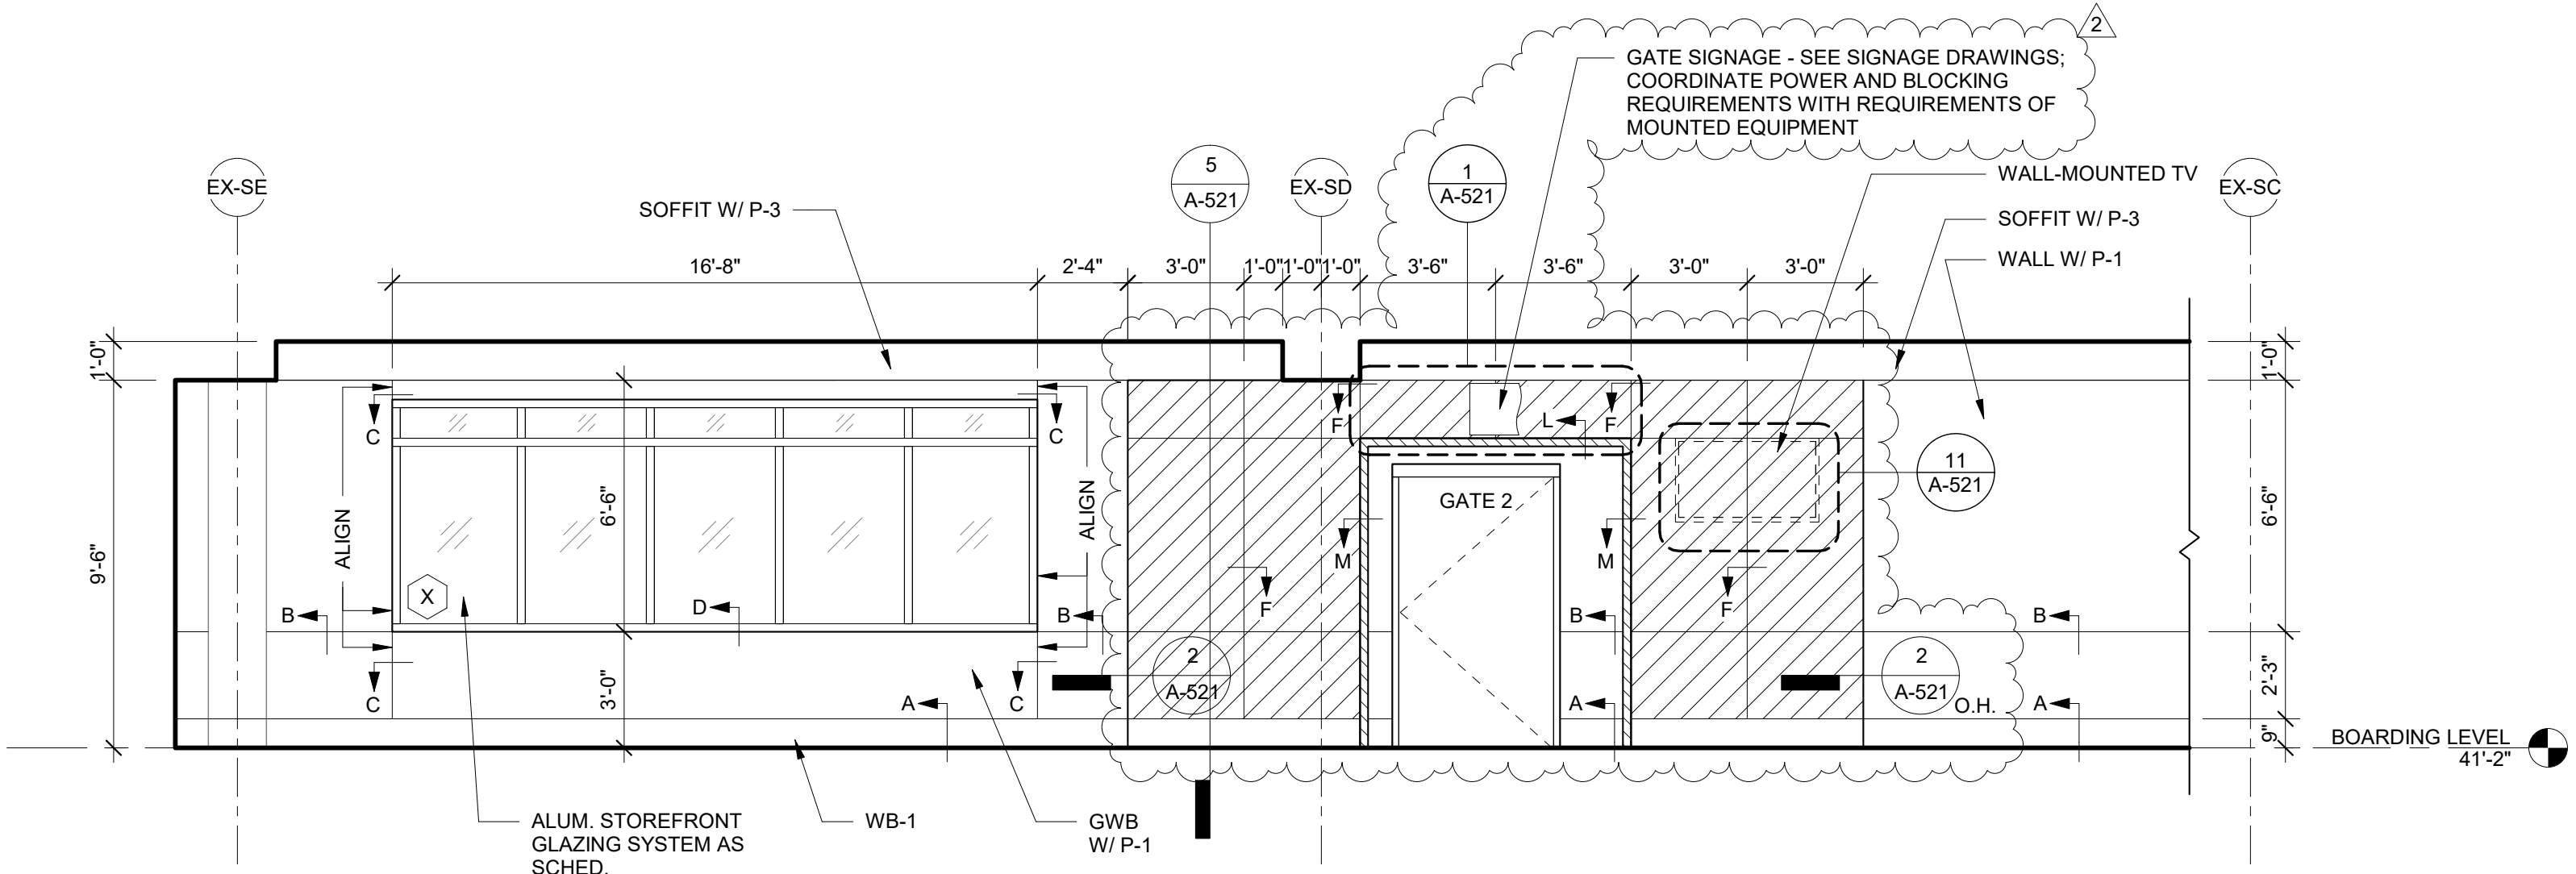


**11 INTERIOR ELEVATION - HOLDROOM A2203**  
1/4" = 1'-0"

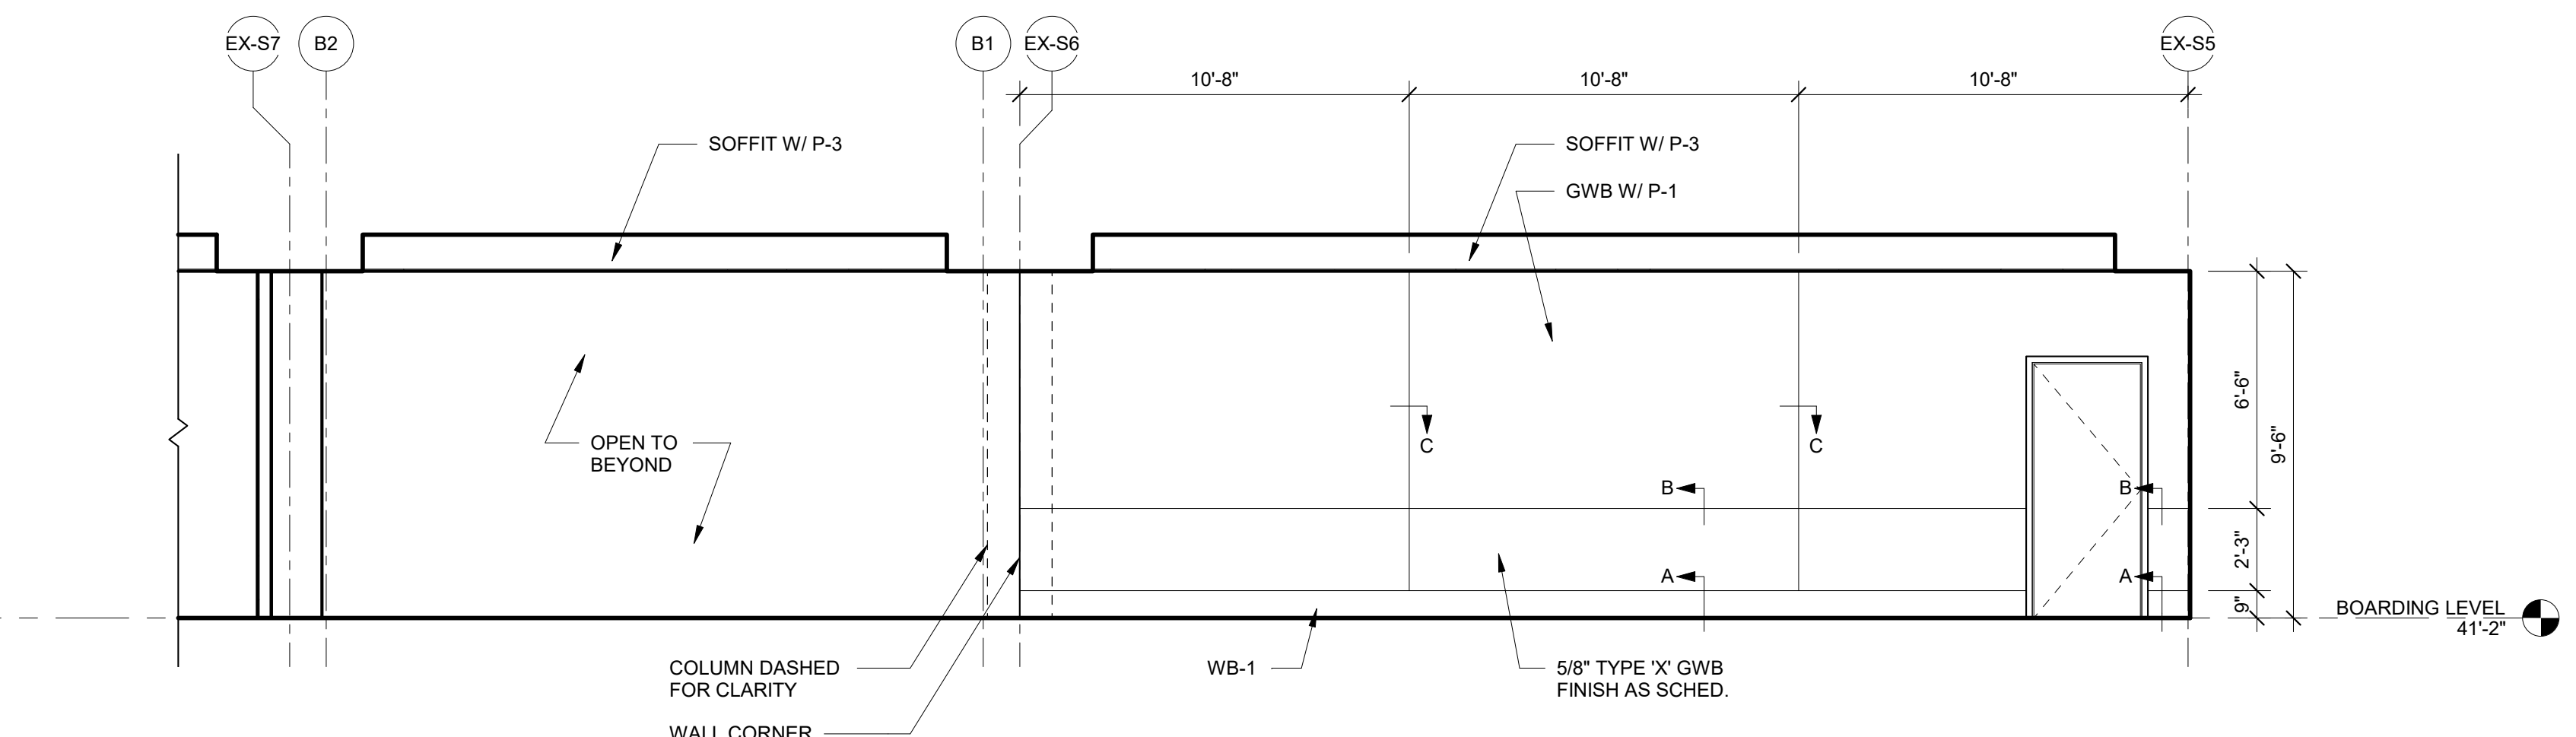


**13 INTERIOR ELEVATION - HOLDROOM A2203**  
1/4" = 1'-0"

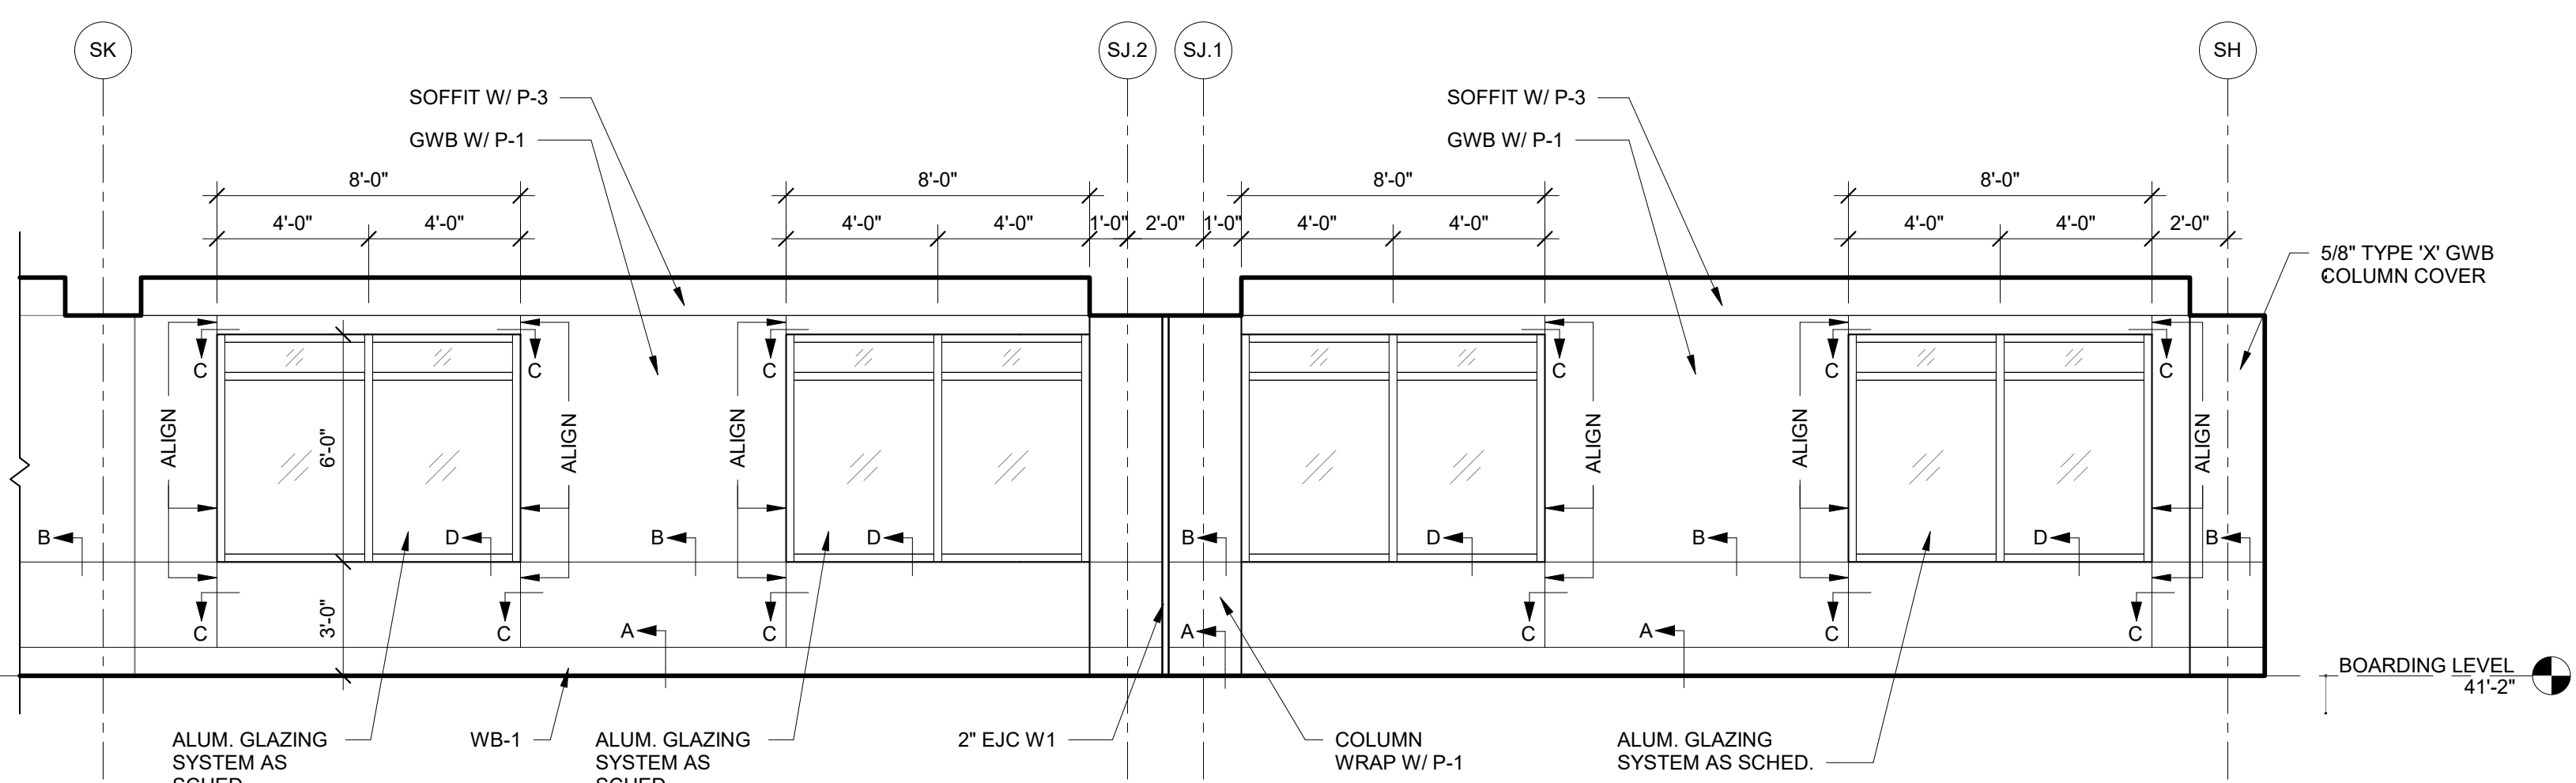


**6 INTERIOR ELEVATION - HOLDROOM A2209**  
1/4" = 1'-0"

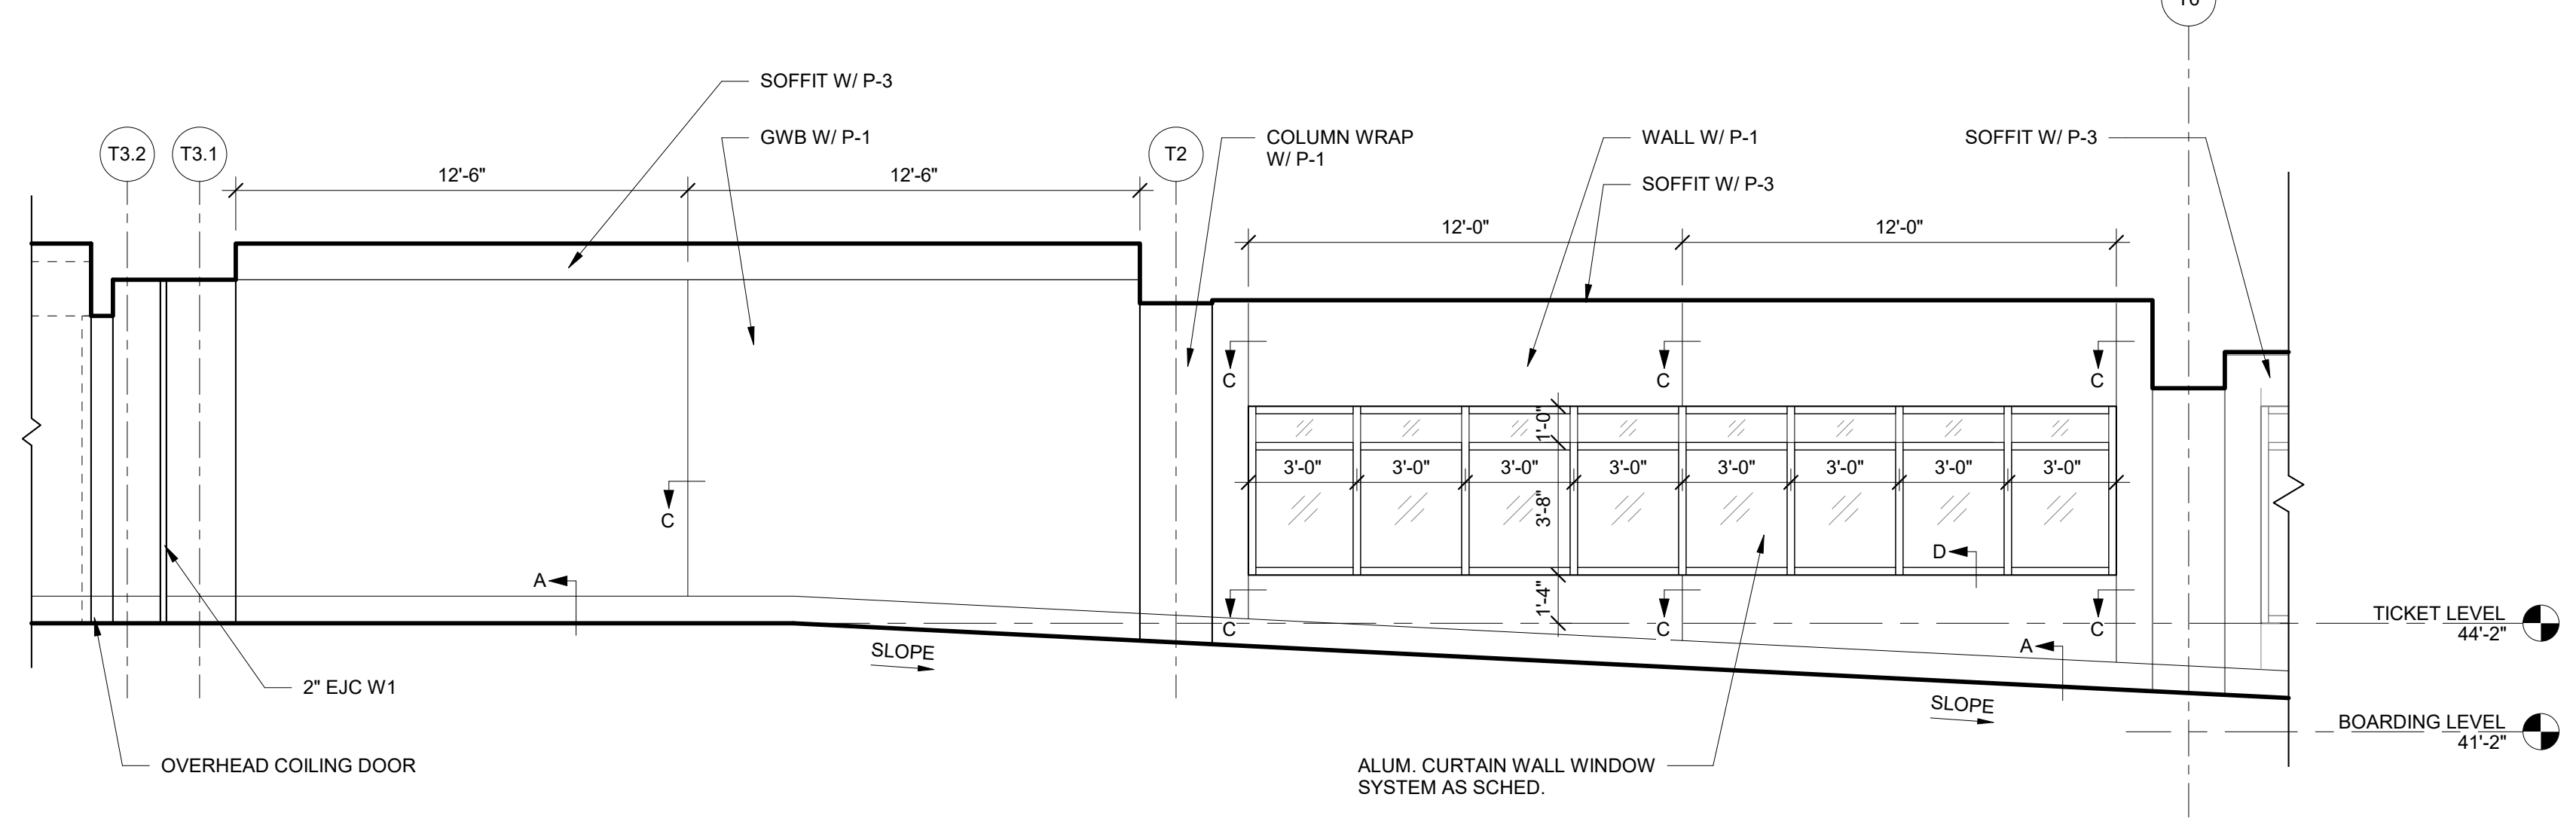


**8 INTERIOR ELEVATION - SLOPE WEST**  
1/4" = 1'-0"

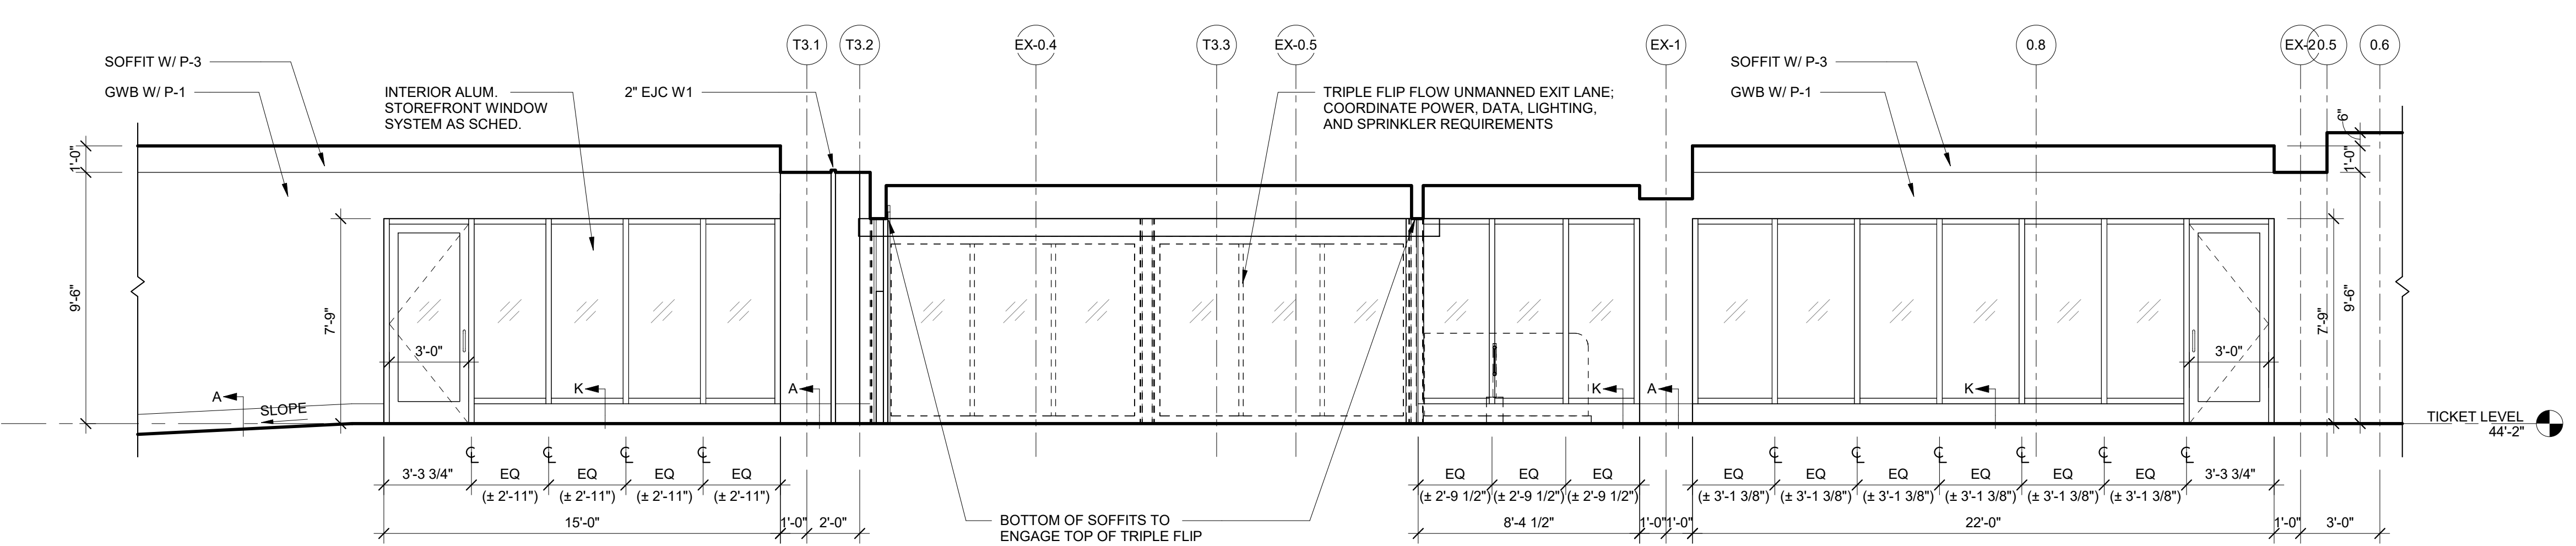

**1 INTERIOR ELEVATION - SLOPE EAST**  
1/4" = 1'-0"

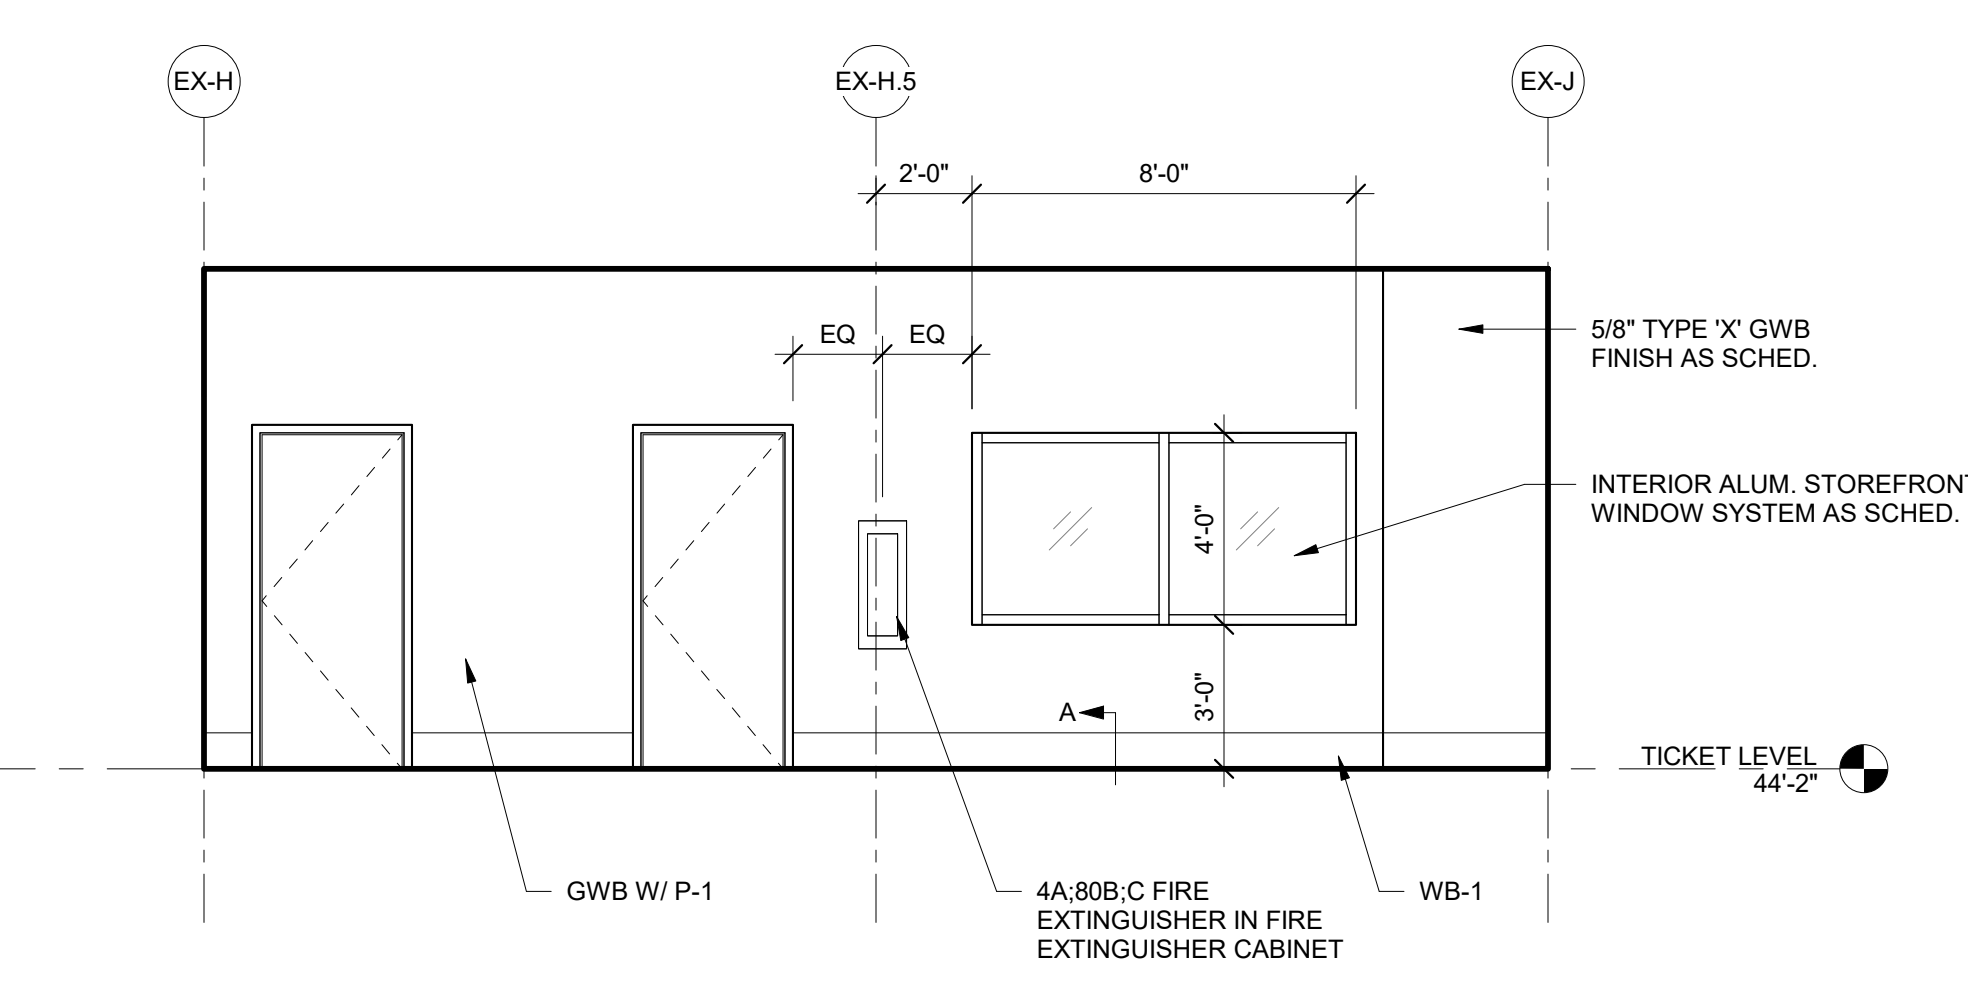

**5 INTERIOR ELEVATION - PSR/OFFICE**  
1/4" = 1'-0"

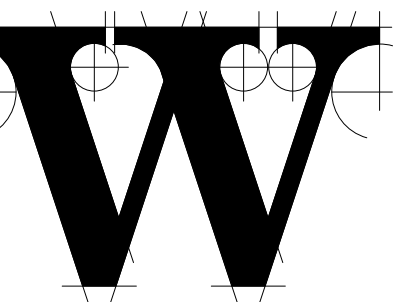

**THE WILSON GROUP**  
- ARCHITECTS -

PO Box 5510 Charlotte, NC 28299  
704-331-9747 • www.twgarchitects.com

PROJECT MANAGER & CIVIL ENGINEER  
**TALBERT & BRIGHT**  
CONSULTING ARCHITECT  
**LS3P**

STRUCTURAL ENGINEER  
**STEWART**

FP/PM/E ENGINEER  
**CHEATHAM & ASSOC.**

BAGGAGE HANDLING CONSULTANTS  
**BNP**

AIRCRAFT SUPPORT SYSTEMS  
**DK CONSULTANTS**

SPECIALTY LIGHTING CONSULTANT  
**HARTRANFT**

SIGNAGE & WAYFINDING  
**TAKEFORM**

COPYRIGHT © 2019  
THE WILSON GROUP ARCHITECTS  
ALL RIGHTS RESERVED  
PRINTED OR ELECTRONIC DRAWINGS AND  
DOCUMENTATION MAY NOT BE REPRODUCED  
IN ANY FORM WITHOUT WRITTEN PERMISSION  
FROM THE WILSON GROUP ARCHITECTS

**REVISIONS**


1	7/12/2019	AD-01
2	7/30/2019	AD-03

DATE: 6/28/2019  
PROJECT NUMBER: 9202-000  
SHEET TITLE:



**SCHEDULE 2 - BOARDING LEVEL FURNITURE PLAN**

SHEET NUMBER  
**A2-731**


SEAT TYPE	QNTY
BEAM SEATING - POWERED (TYP)	539
BEAM SEATING - NOT POWERED - SEE PLAN FOR LOCATIONS	16
LINEAR SOFT SEATING	277 +/-
RADIAL SOFT SEATING	40 +/-
ROCKING CHAIRS	24
FLOOR STANDING TRASH BINS - SEE PLAN FOR LOCATIONS	4

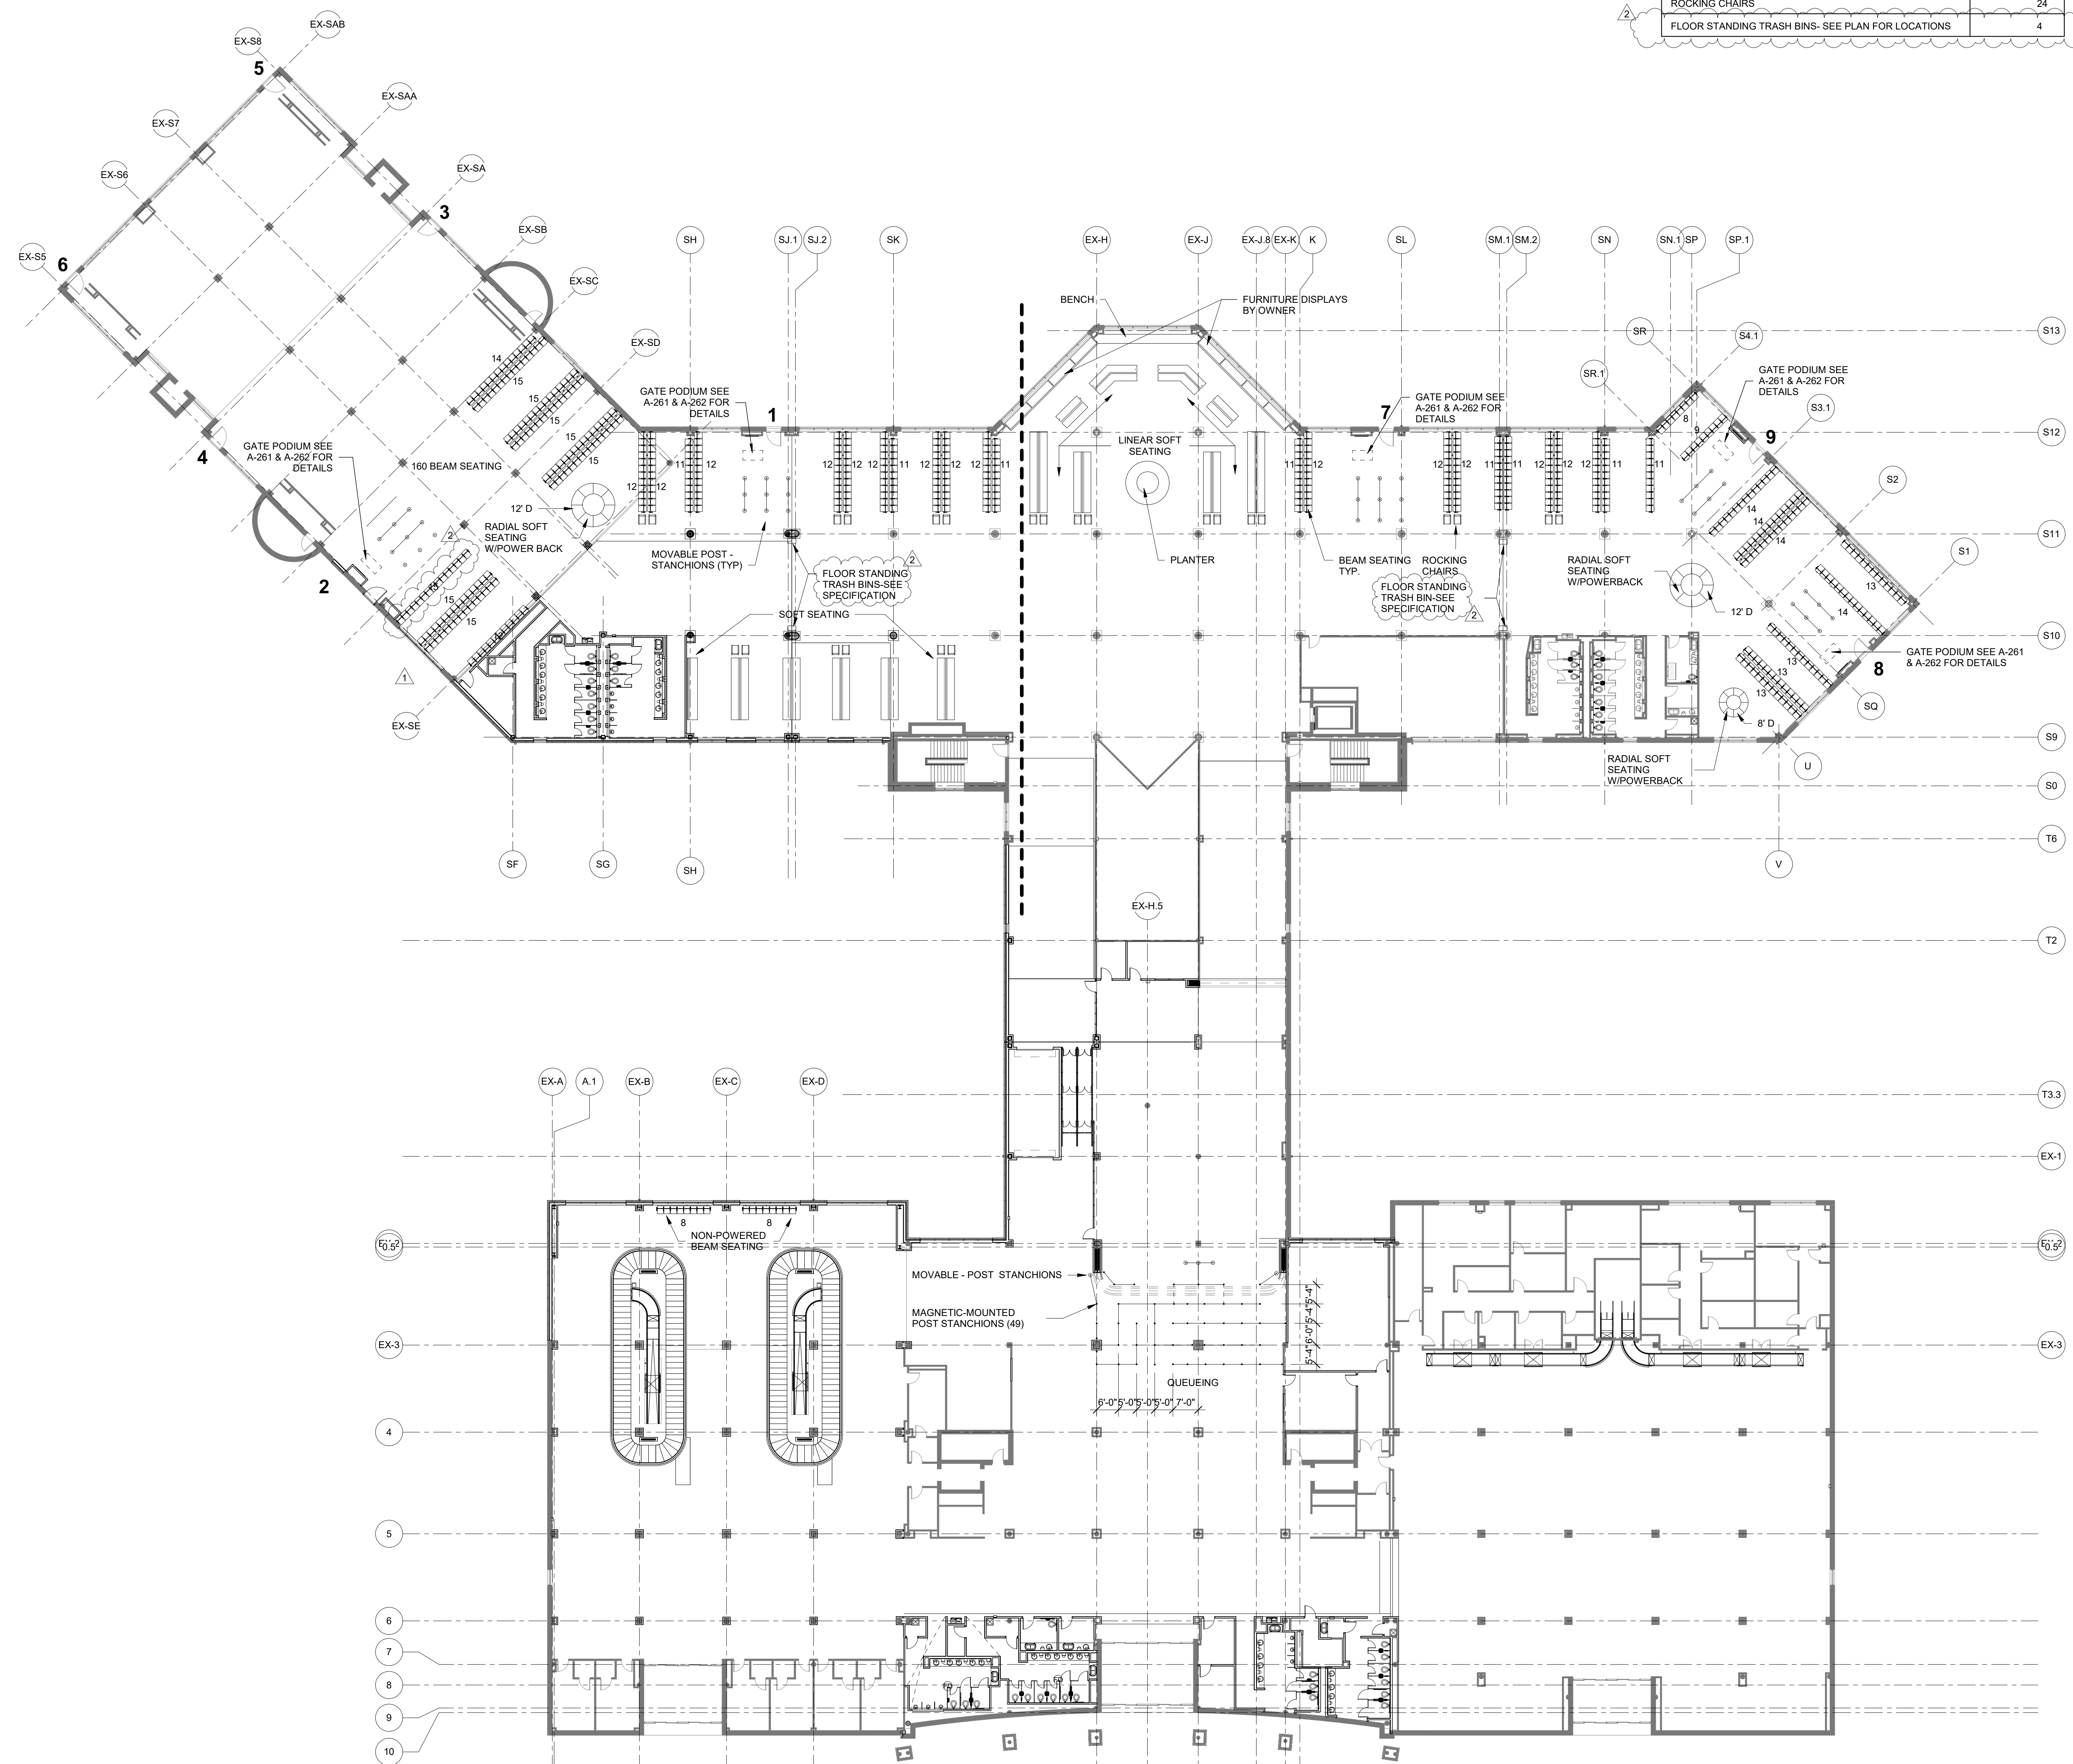


**1** SCHEDULE 2 - TICKET LEVEL OVERALL FURNITURE FLOOR PLAN  
1" = 20'-0"

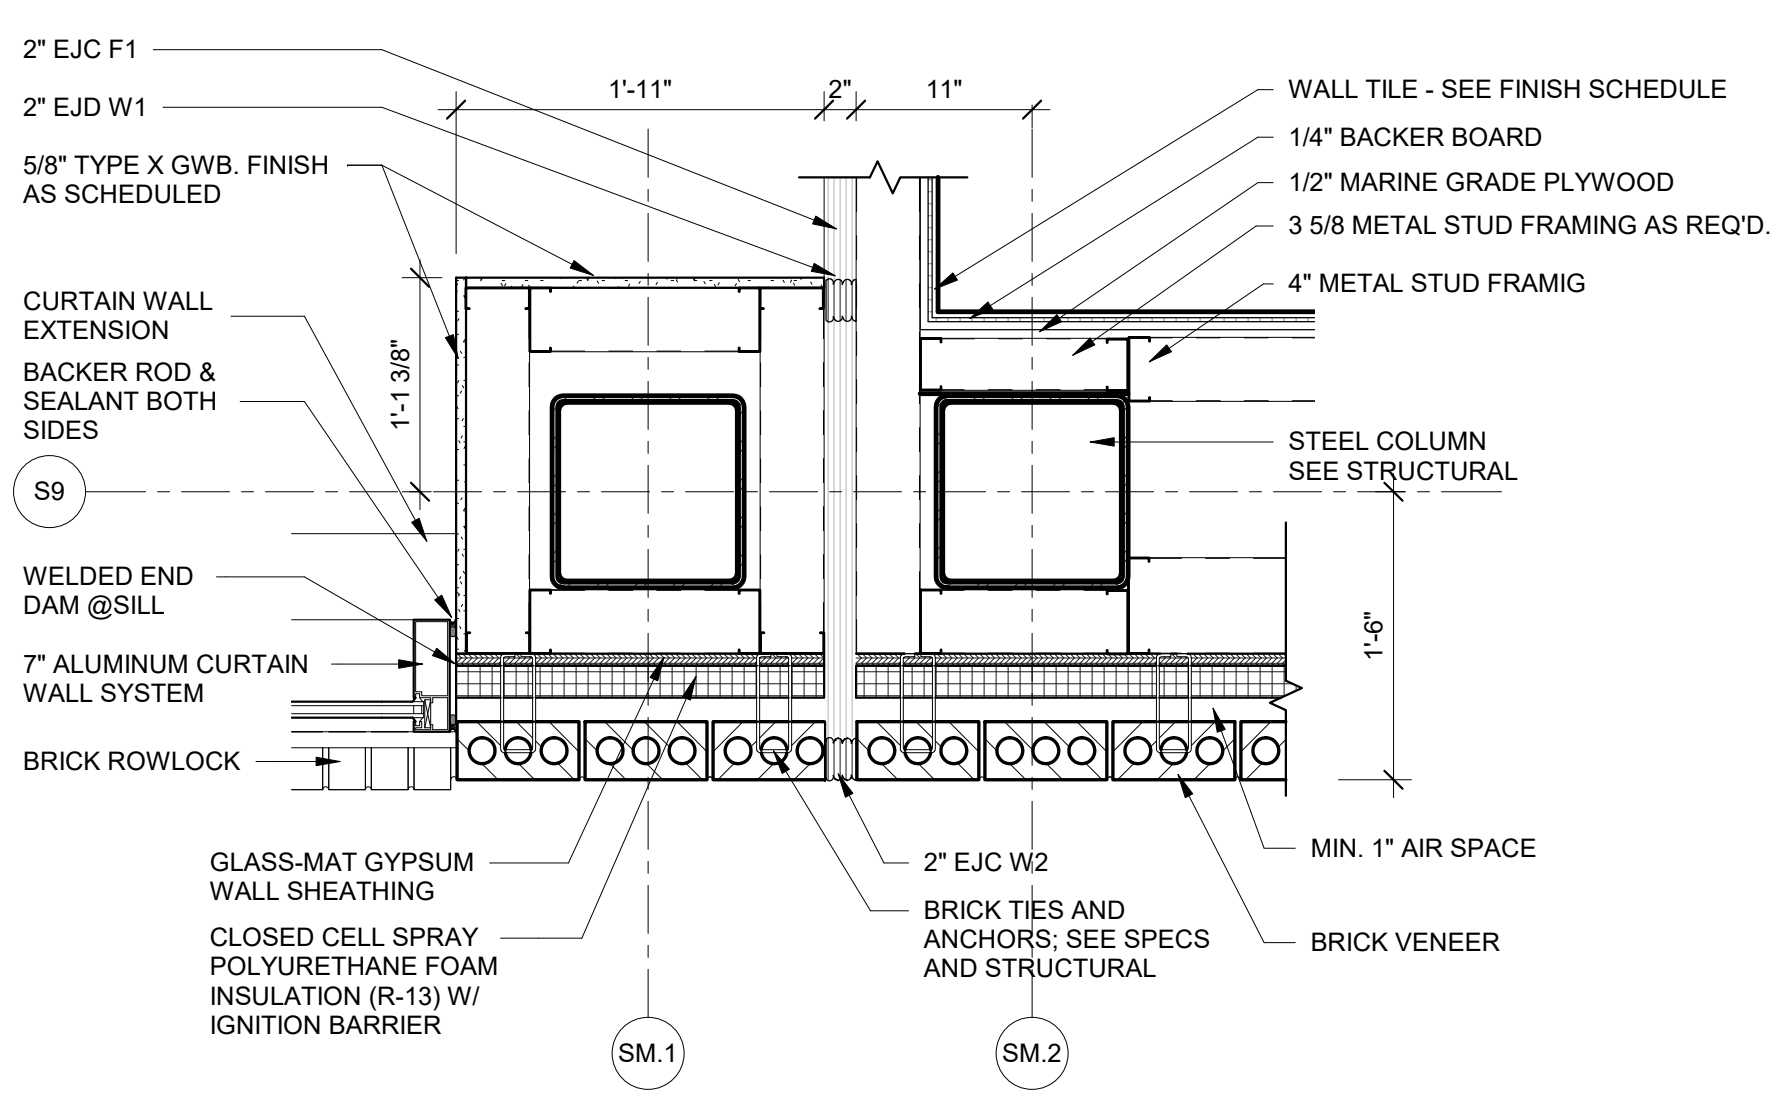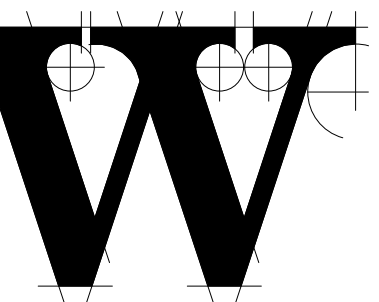


**16 PLAN DETAIL AT BOARDING LEVEL**  
1" = 1'-0"

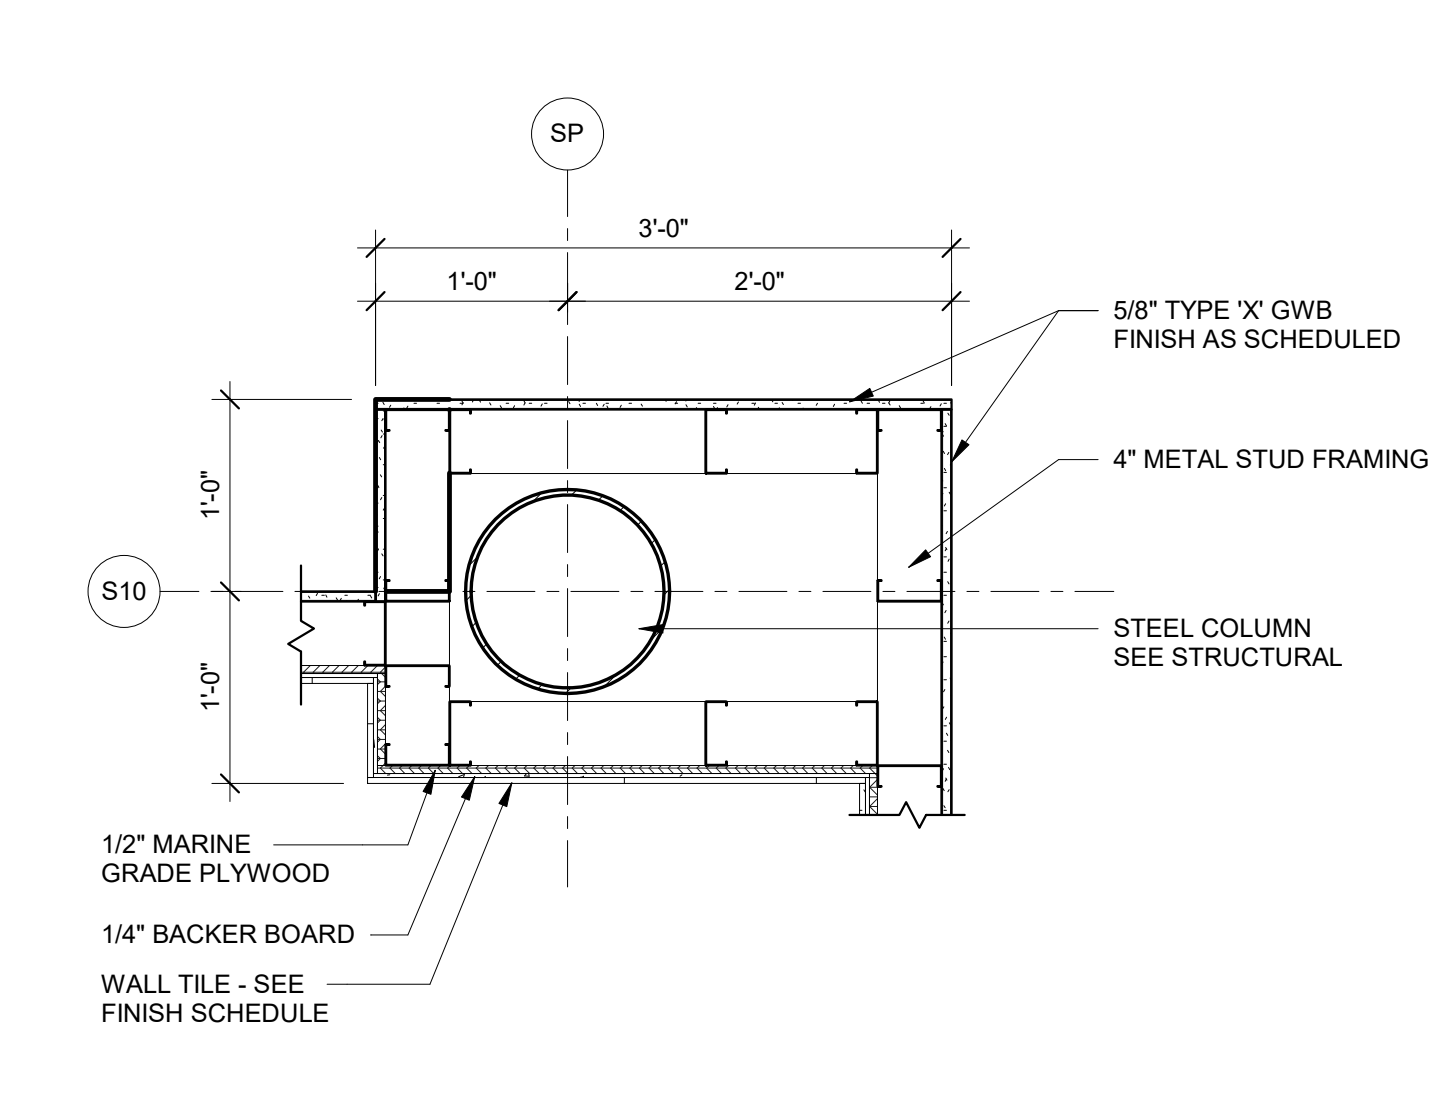


**17 PLAN DETAIL AT BOARDING LEVEL**  
1" = 1'-0"

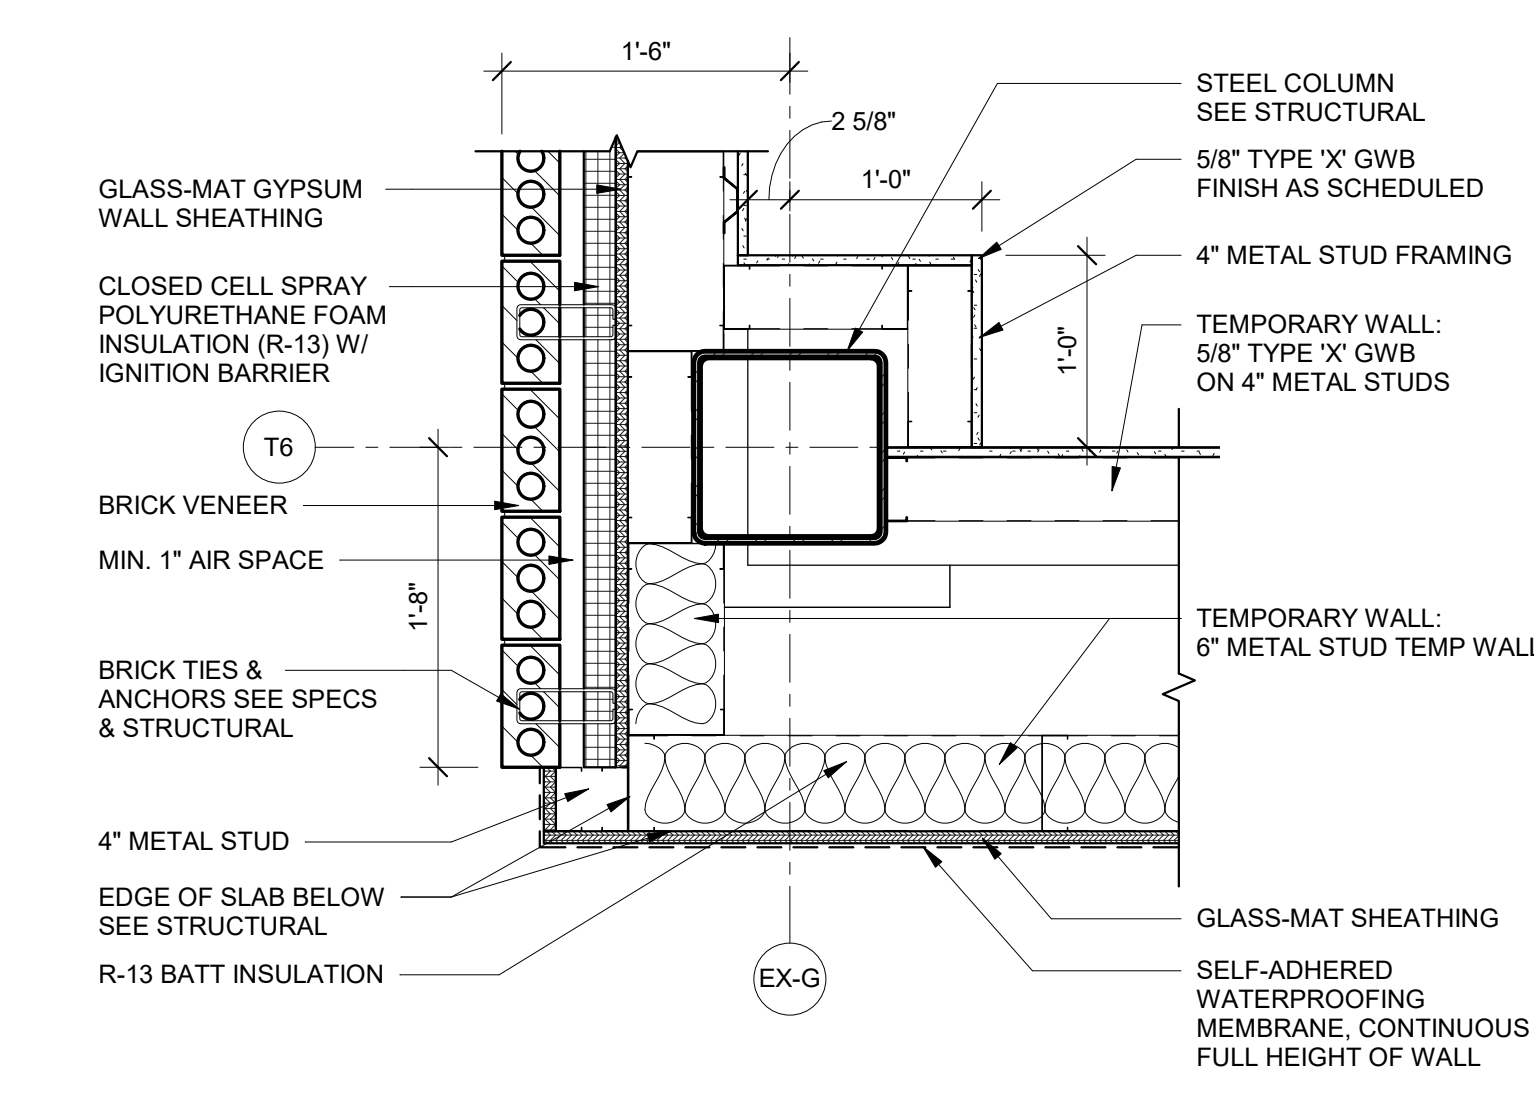


**18 PLAN DETAIL AT BOARDING LEVEL**  
1" = 1'-0"

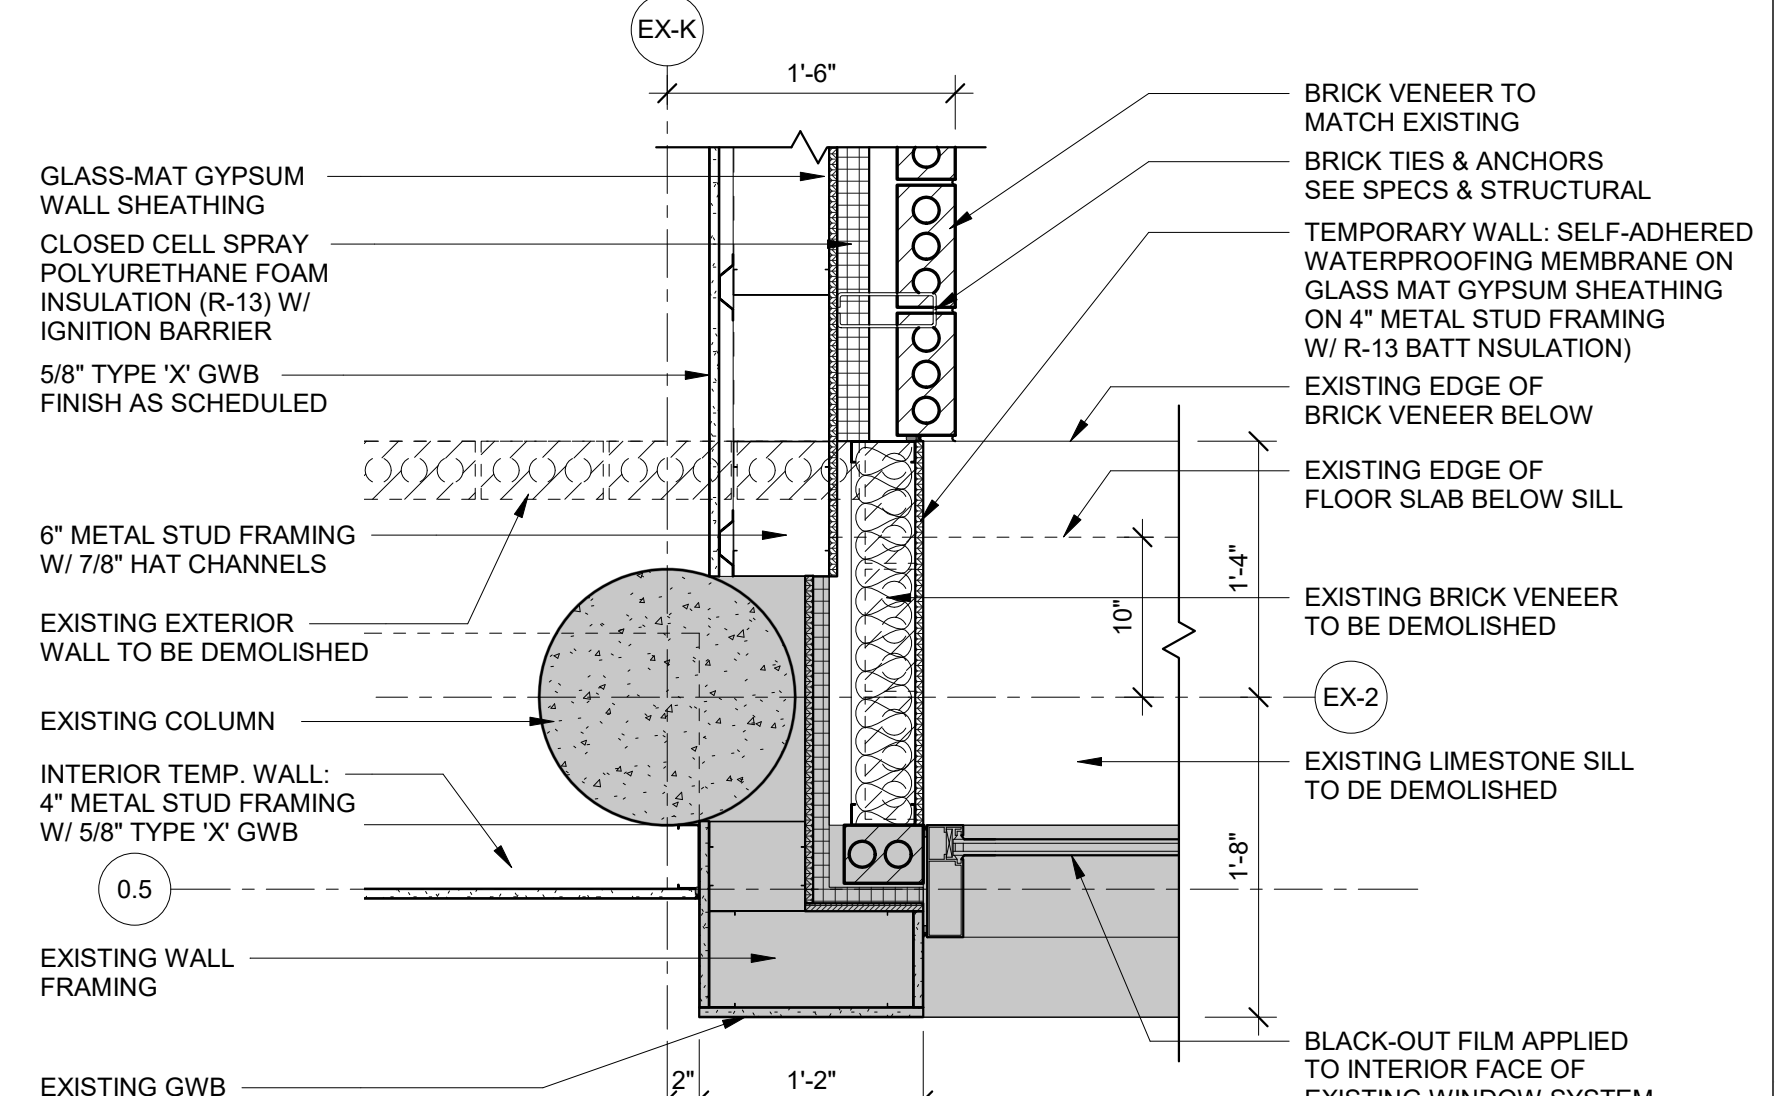


**19 PLAN DETAIL AT BOARDING LEVEL**  
1" = 1'-0"

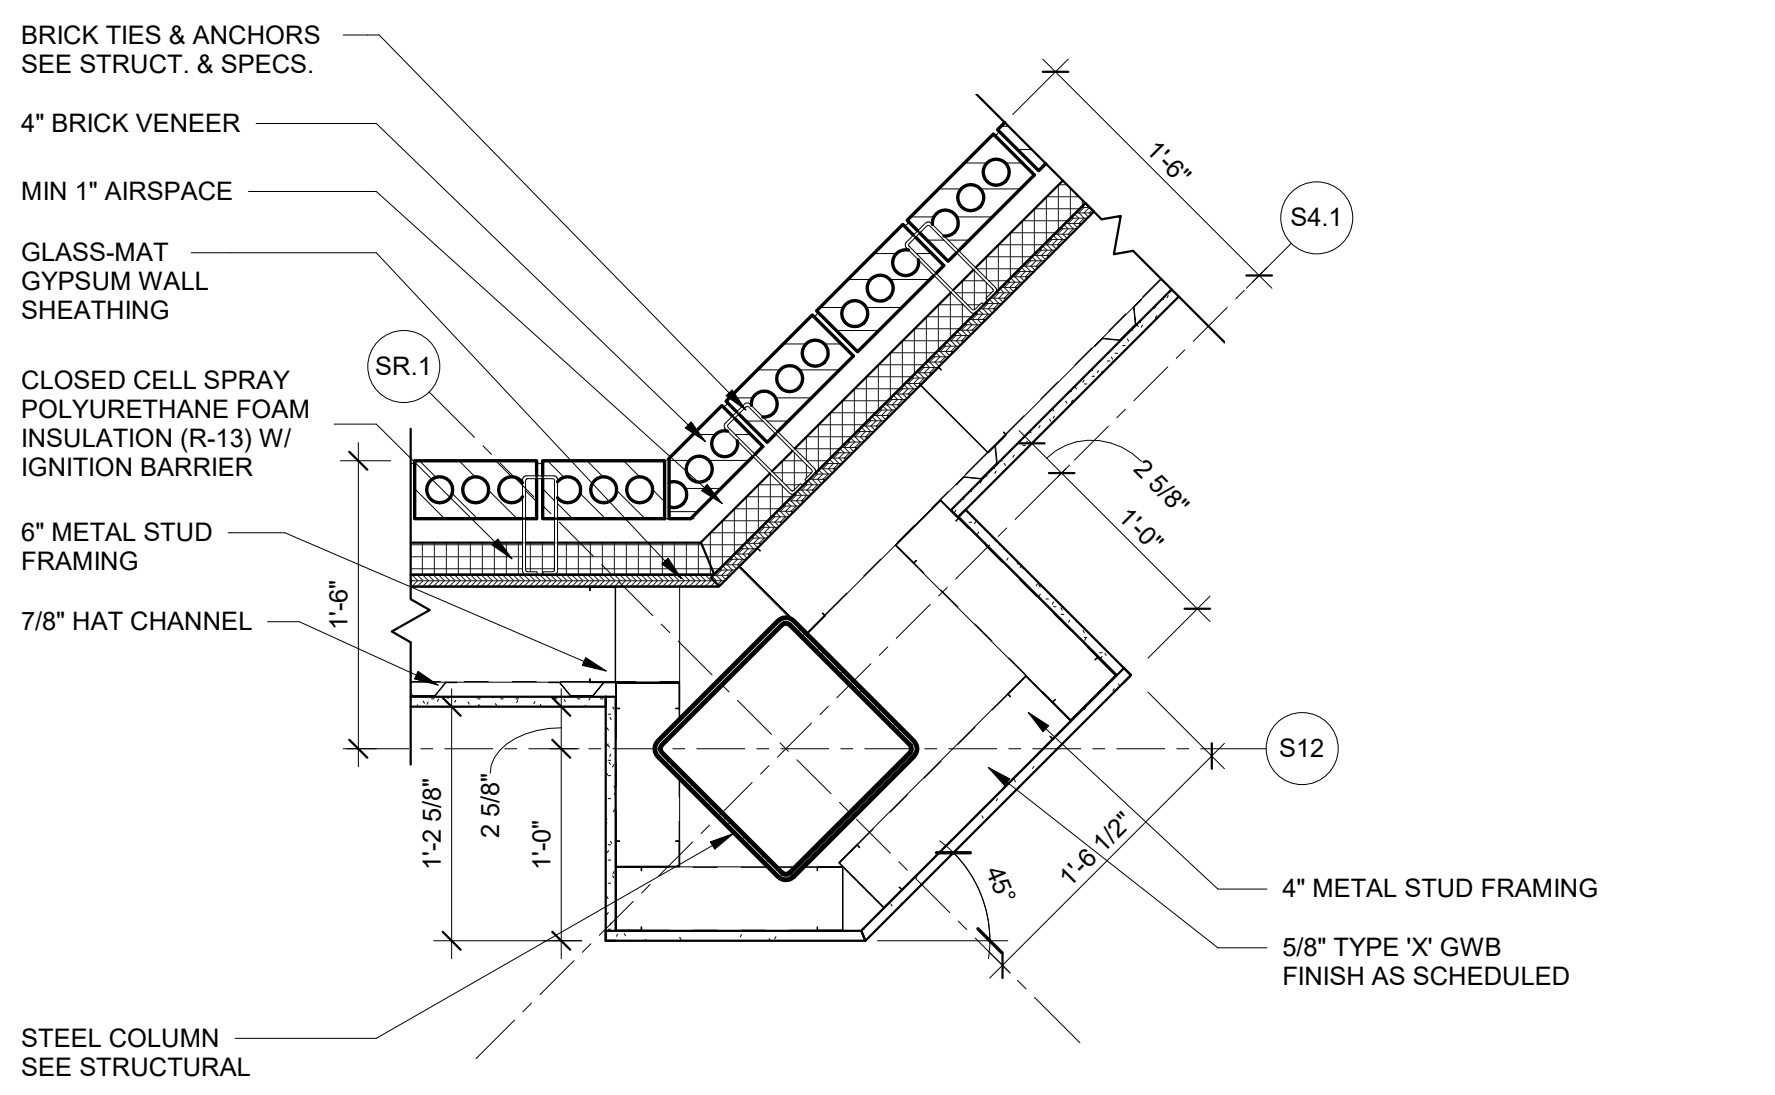


**11 PLAN DETAIL AT BOARDING LEVEL**  
1" = 1'-0"

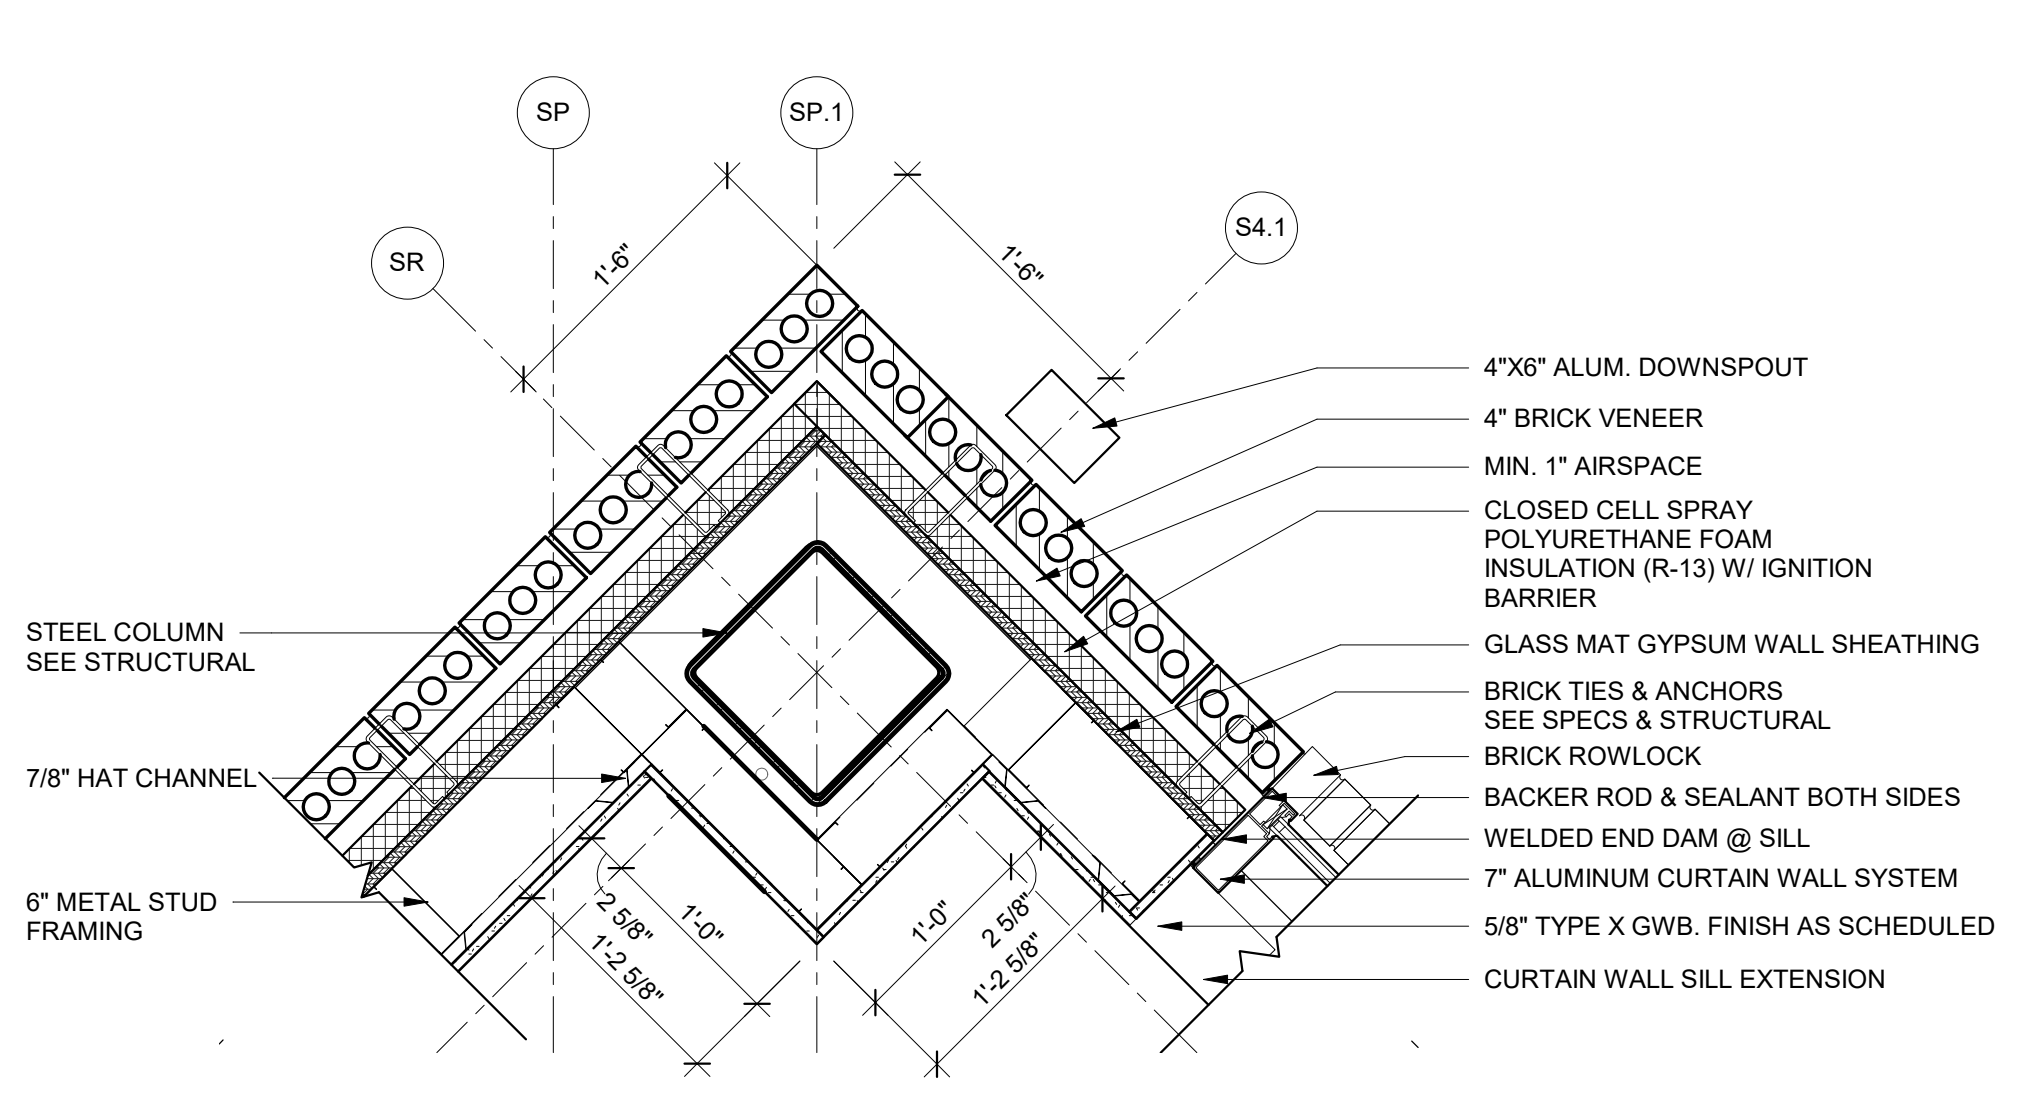


**12 PLAN DETAIL AT BOARDING LEVEL**  
1" = 1'-0"

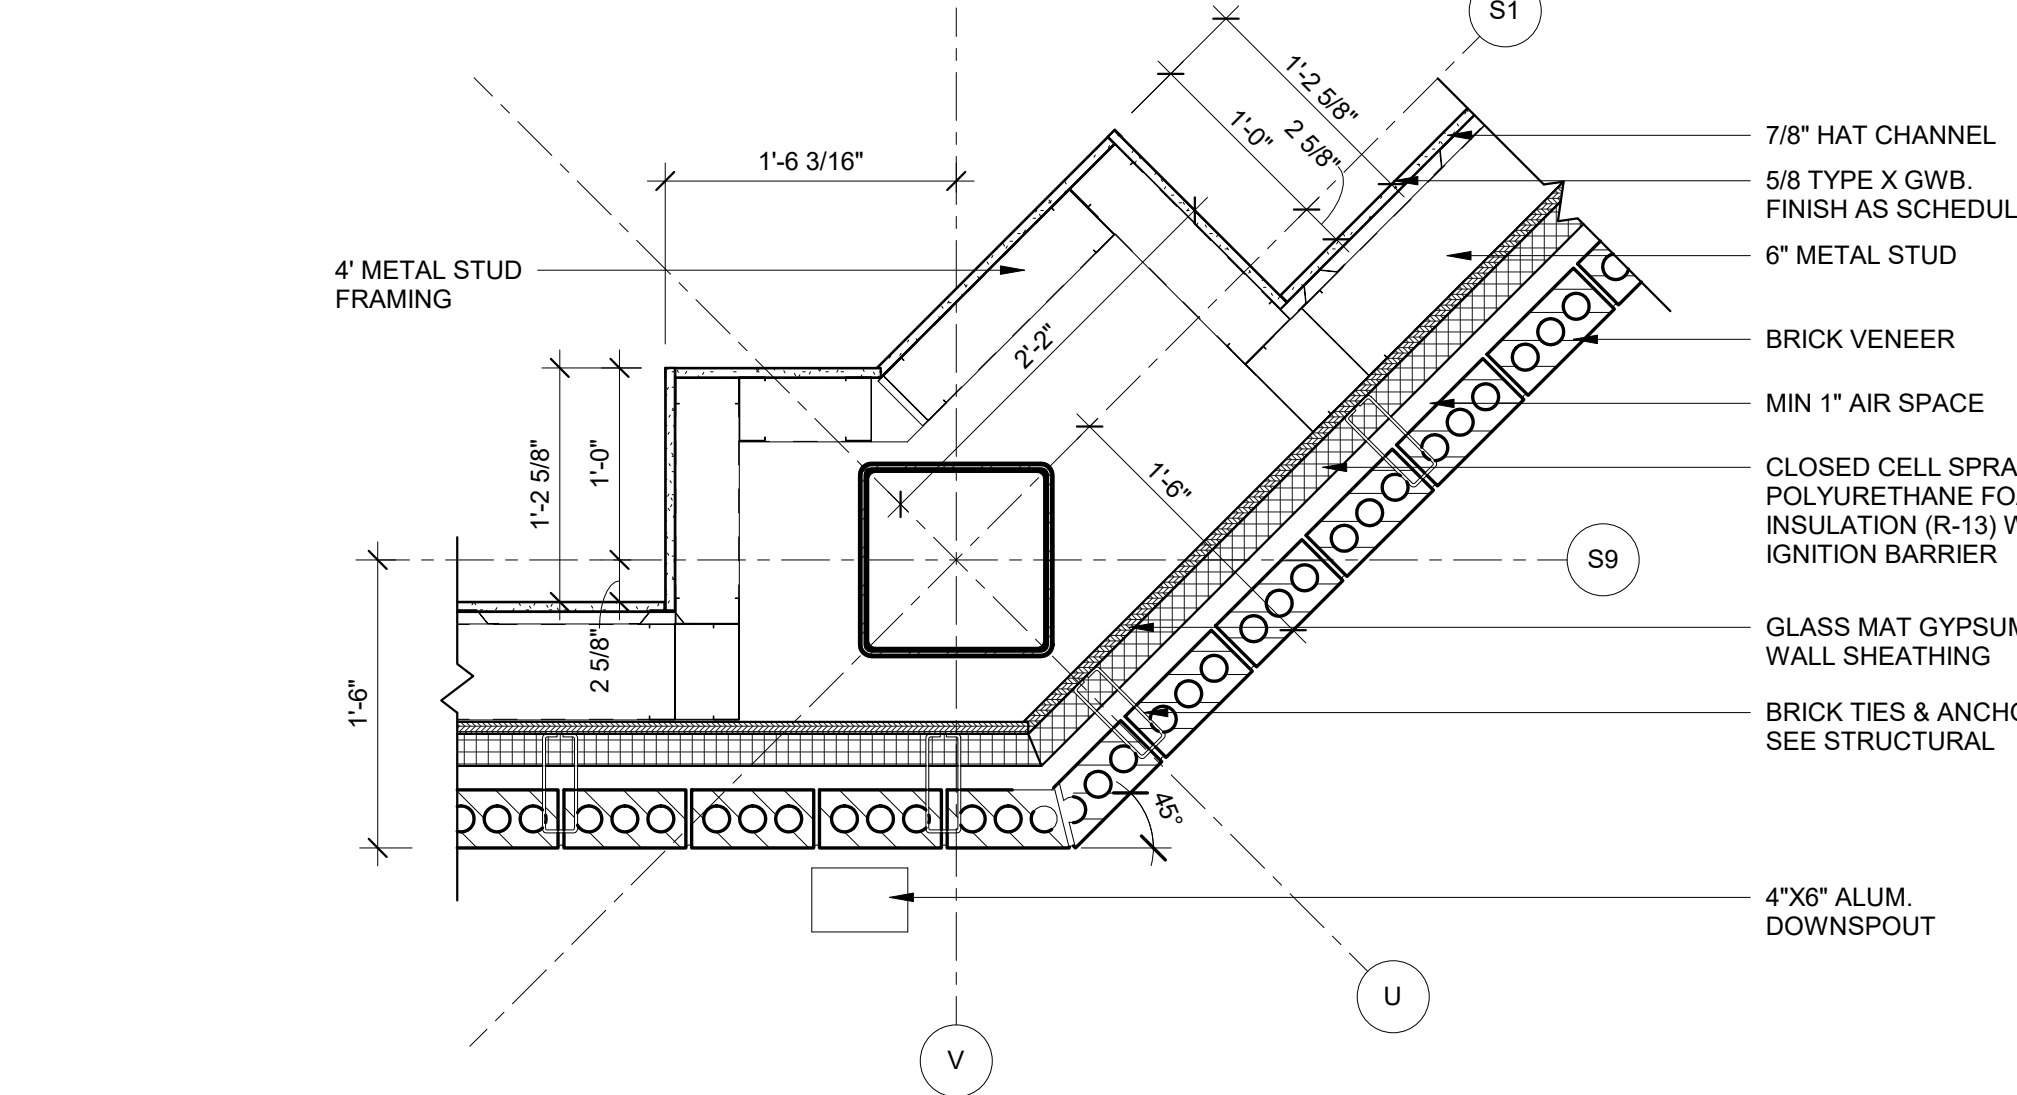


**13 PLAN DETAIL AT BOARDING LEVEL**  
1" = 1'-0"

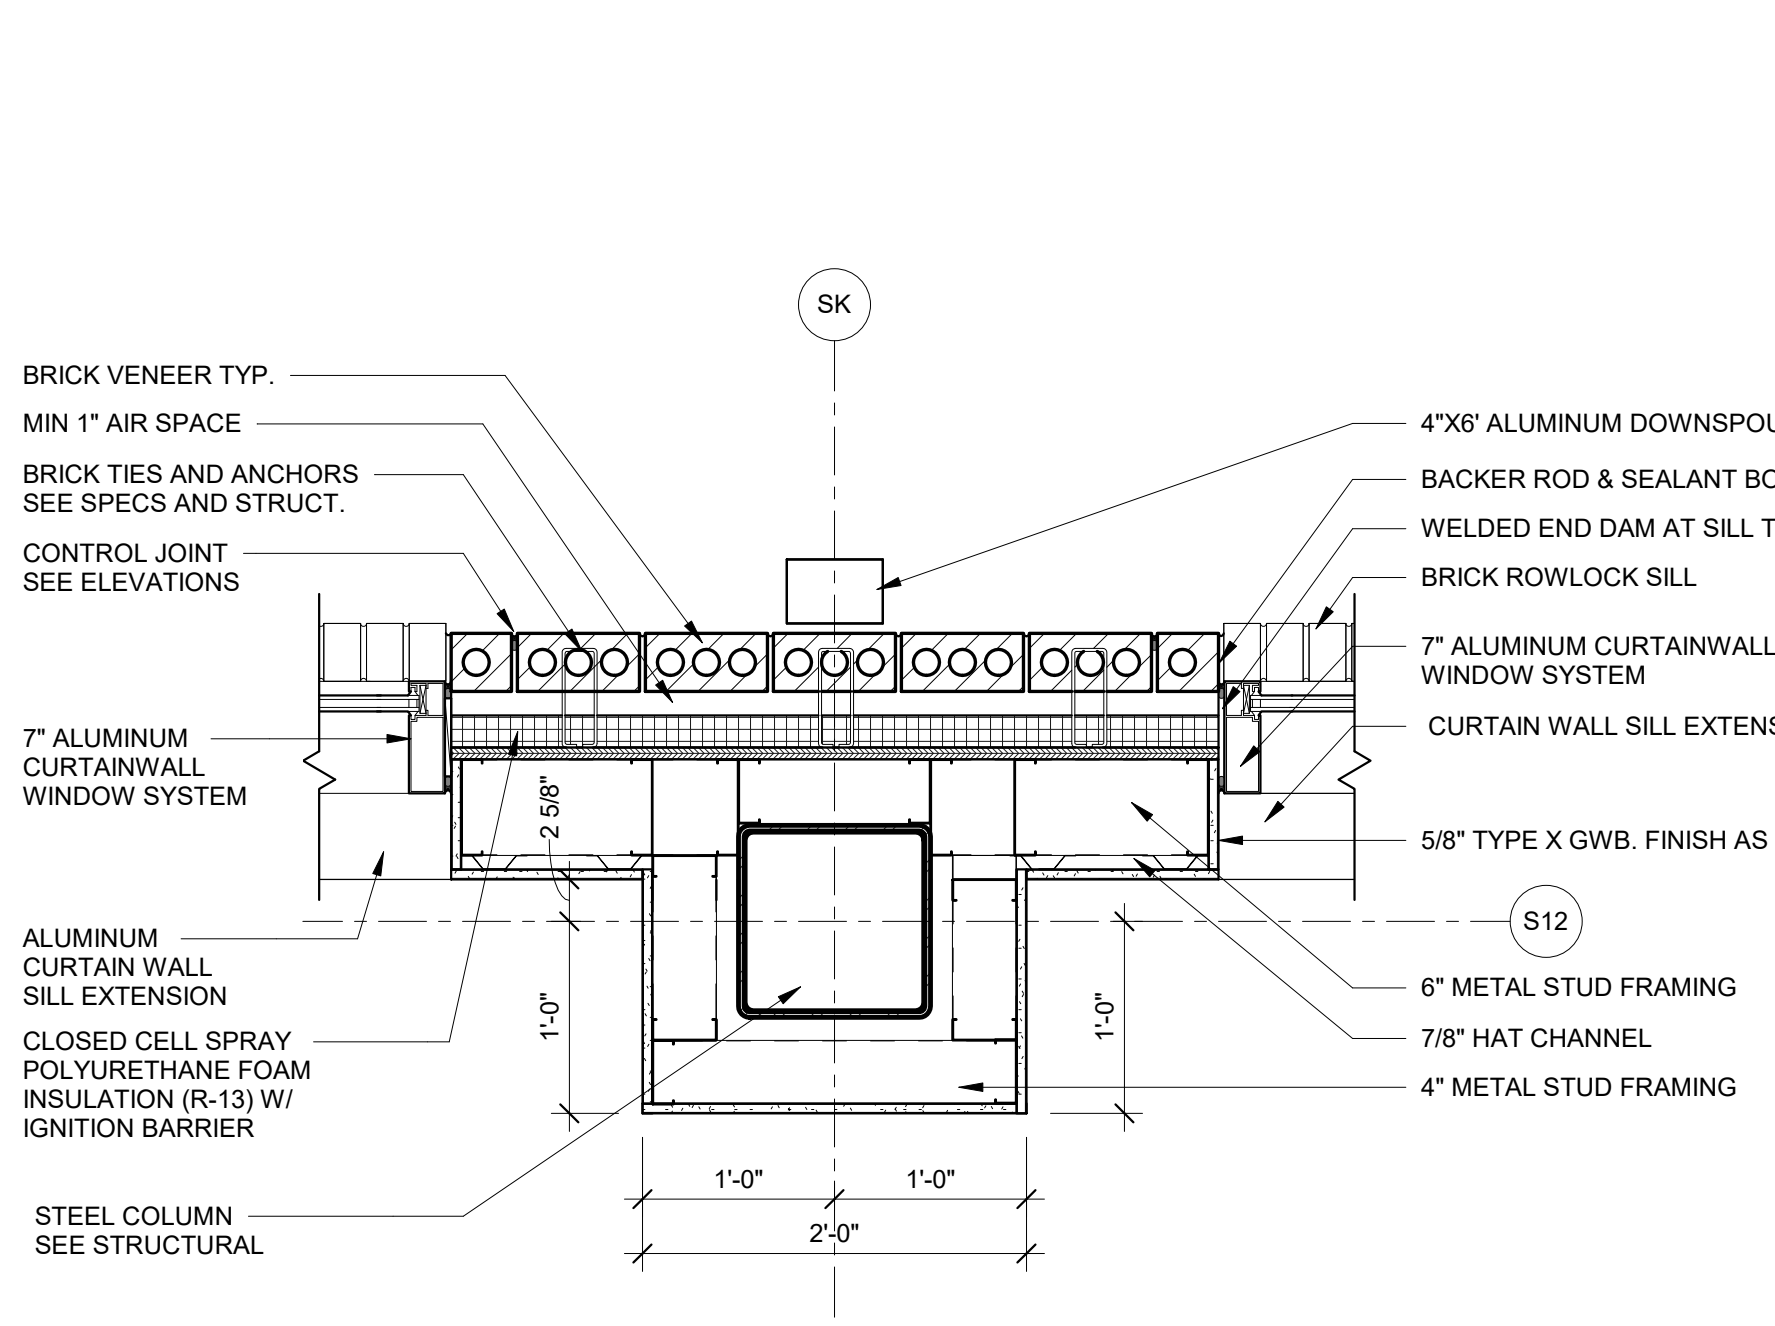


**6 PLAN DETAIL AT BOARDING LEVEL**  
1" = 1'-0"

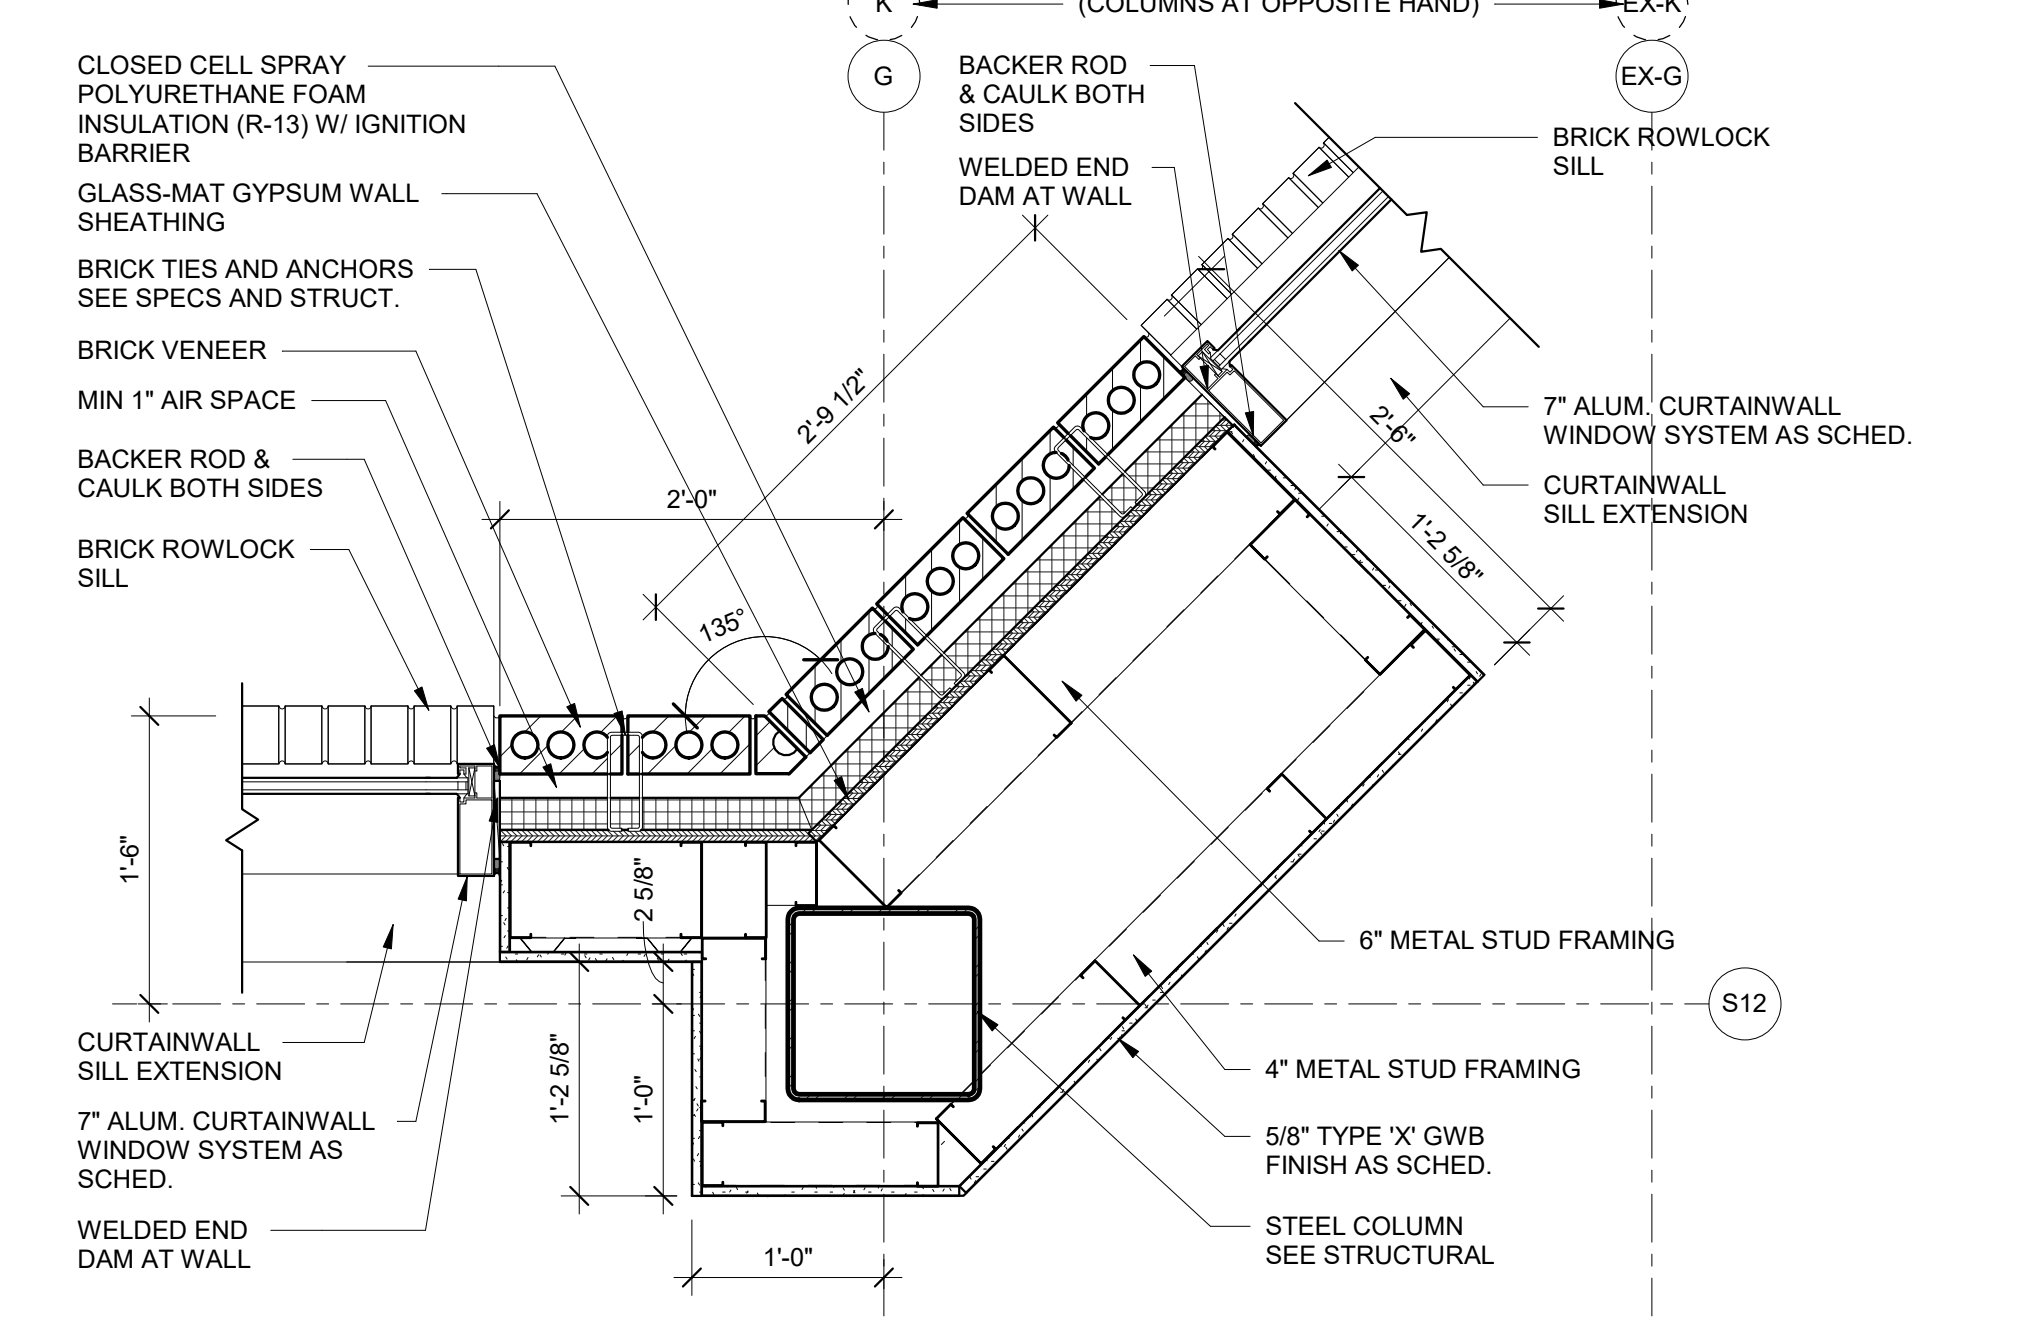


**7 PLAN DETAIL AT BOARDING LEVEL**  
1" = 1'-0"

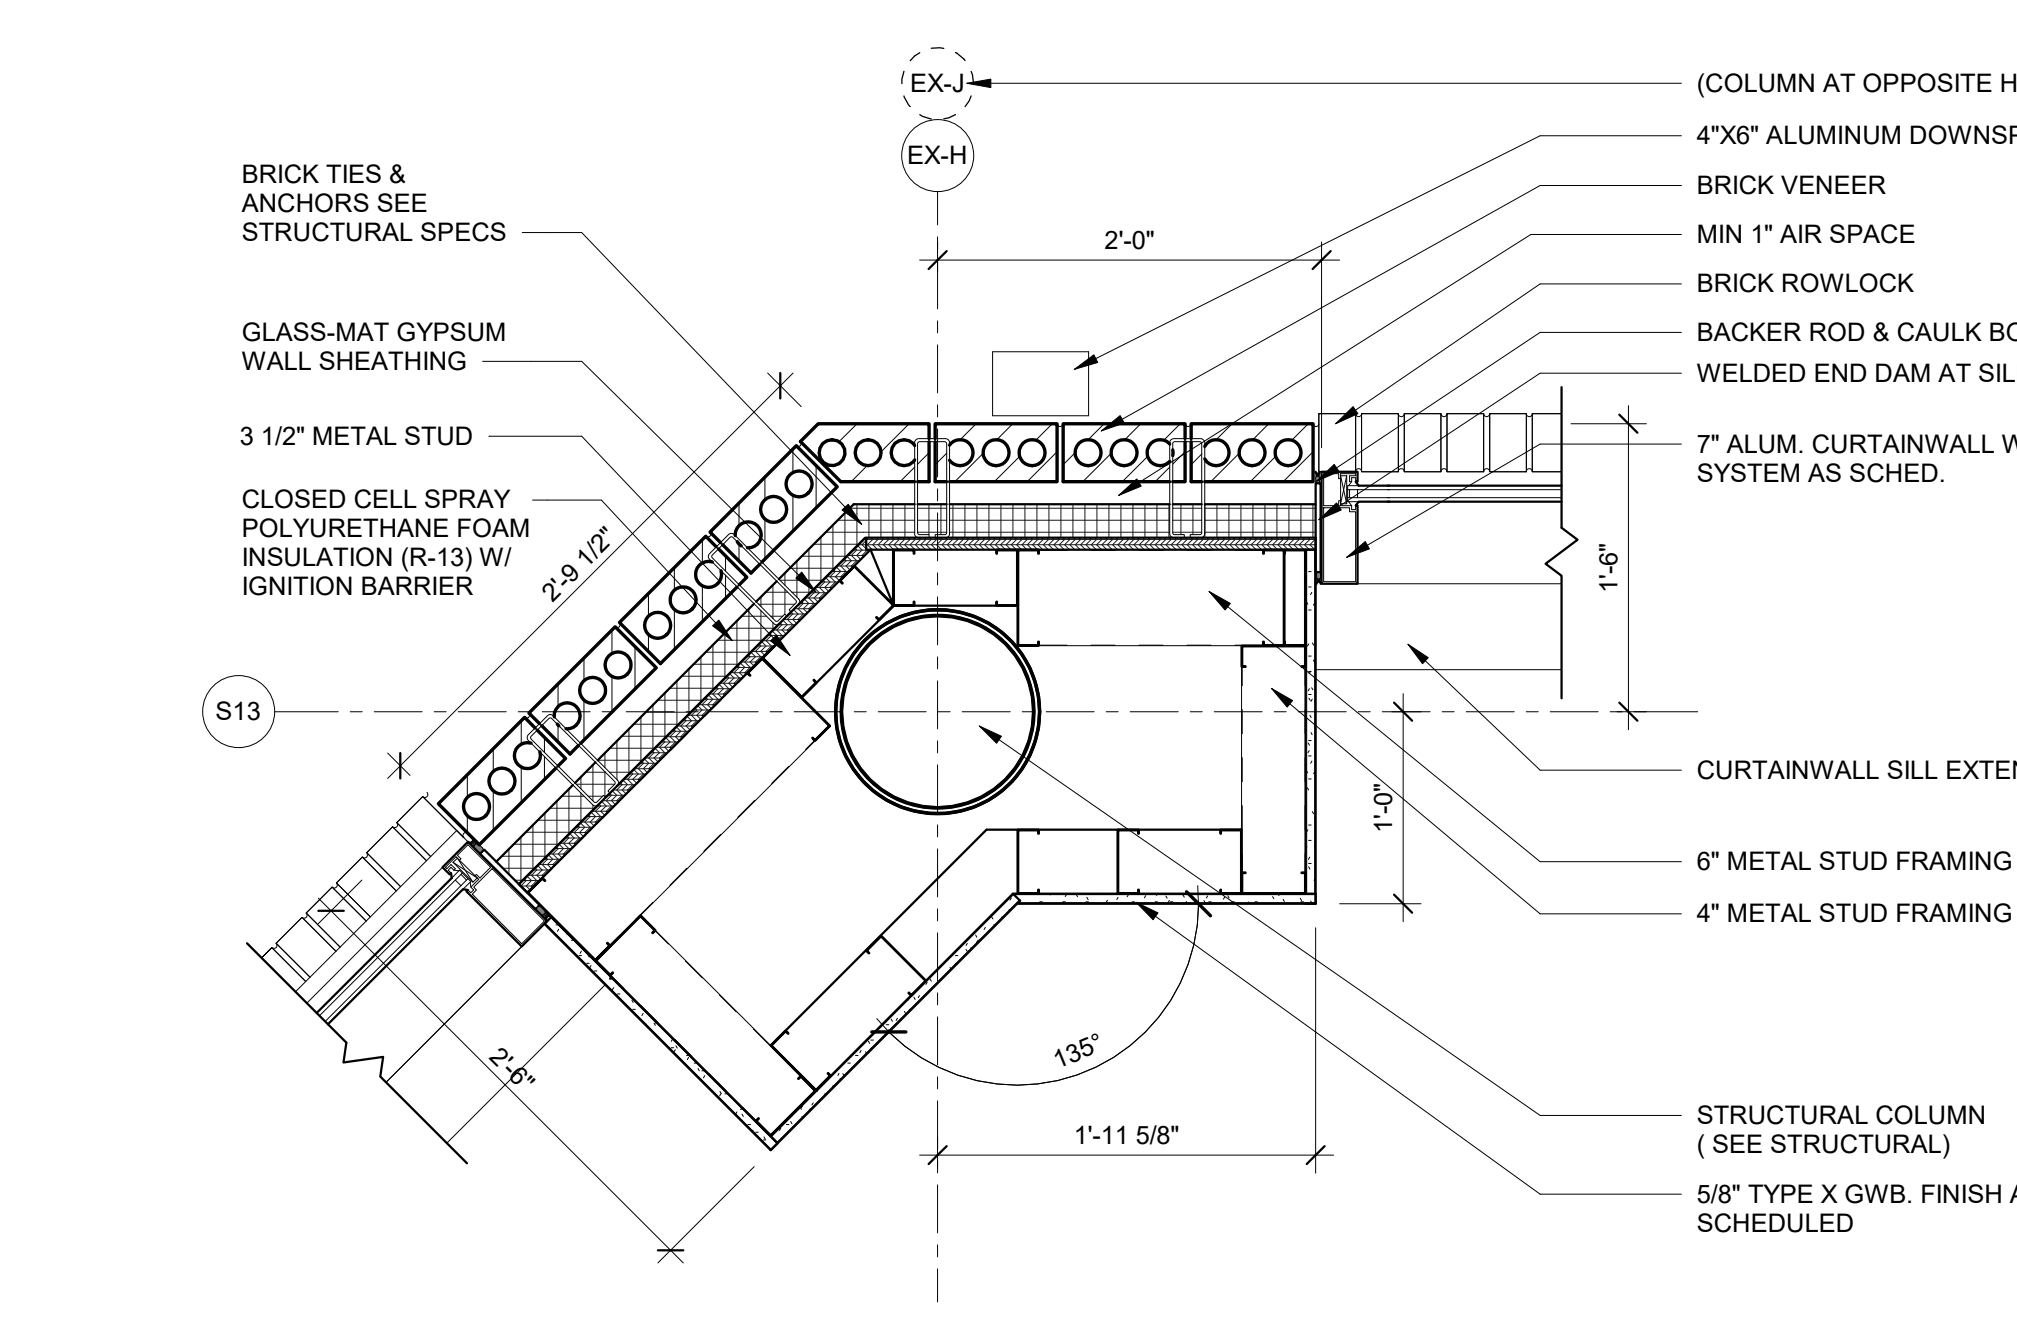


**8 PLAN DETAIL AT BOARDING LEVEL**  
1" = 1'-0"

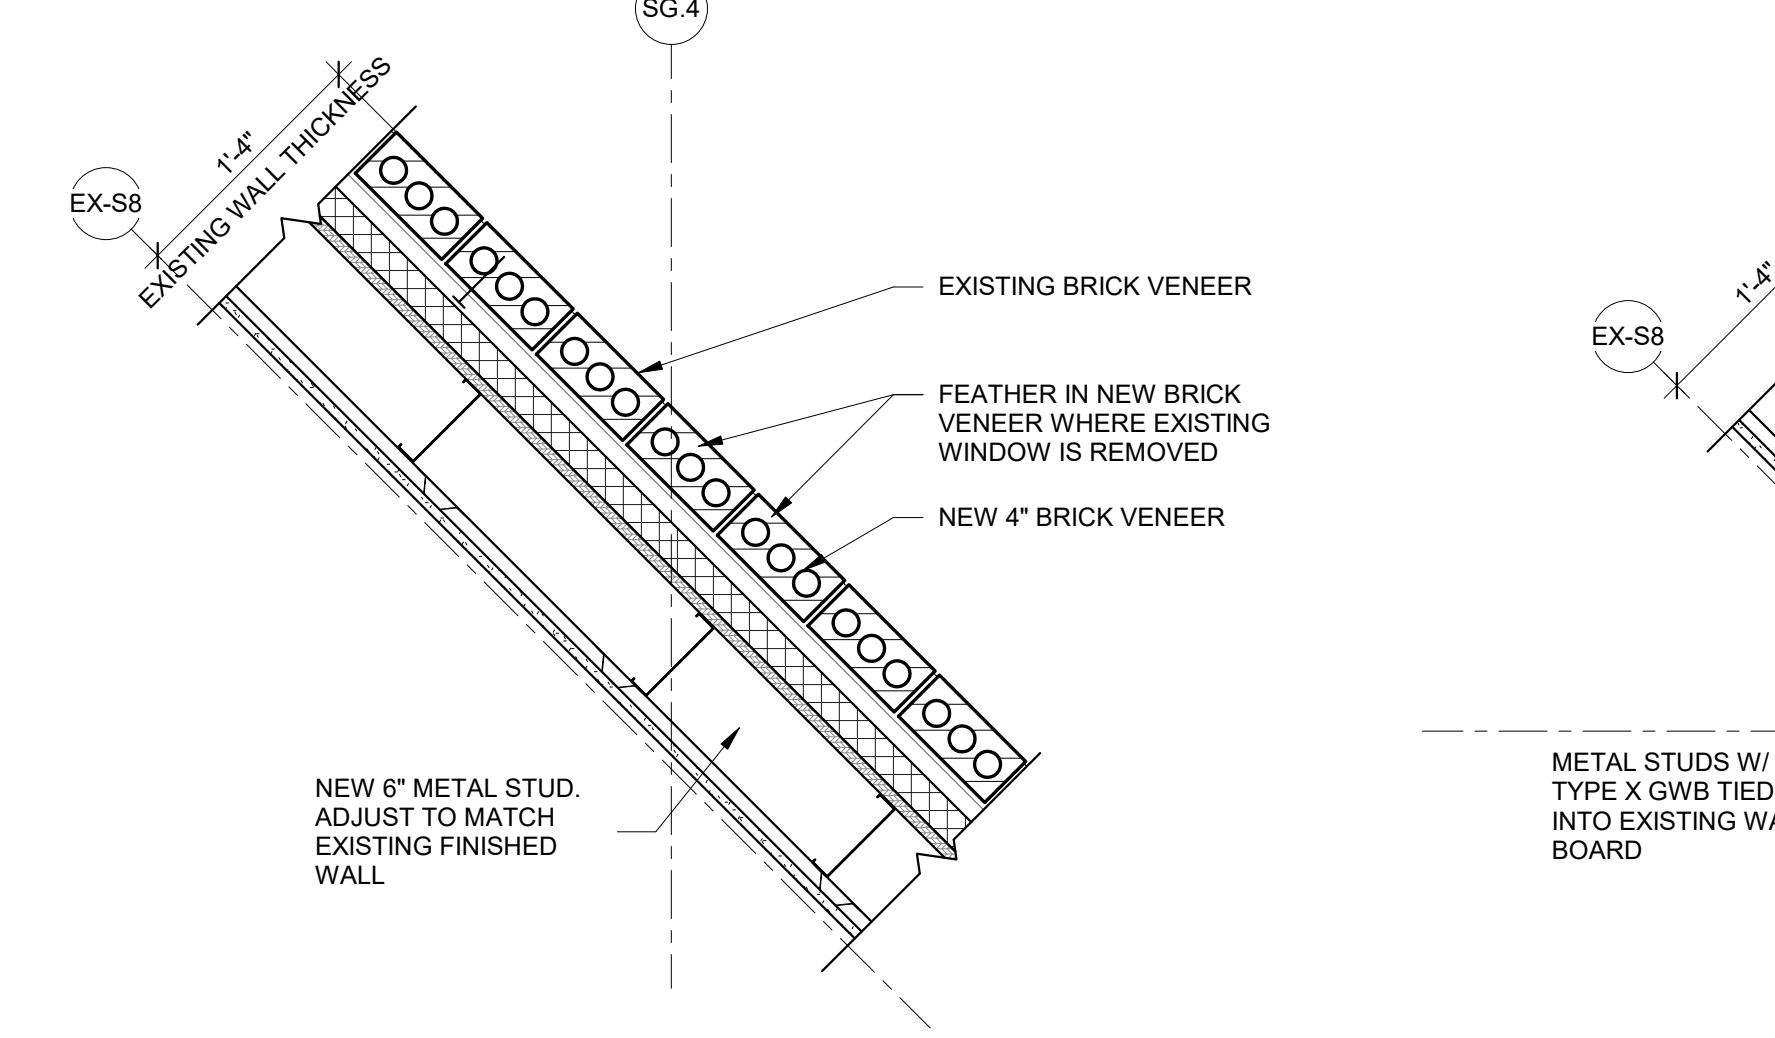

**1 PLAN DETAIL AT BOARDING LEVEL**  
1" = 1'-0"

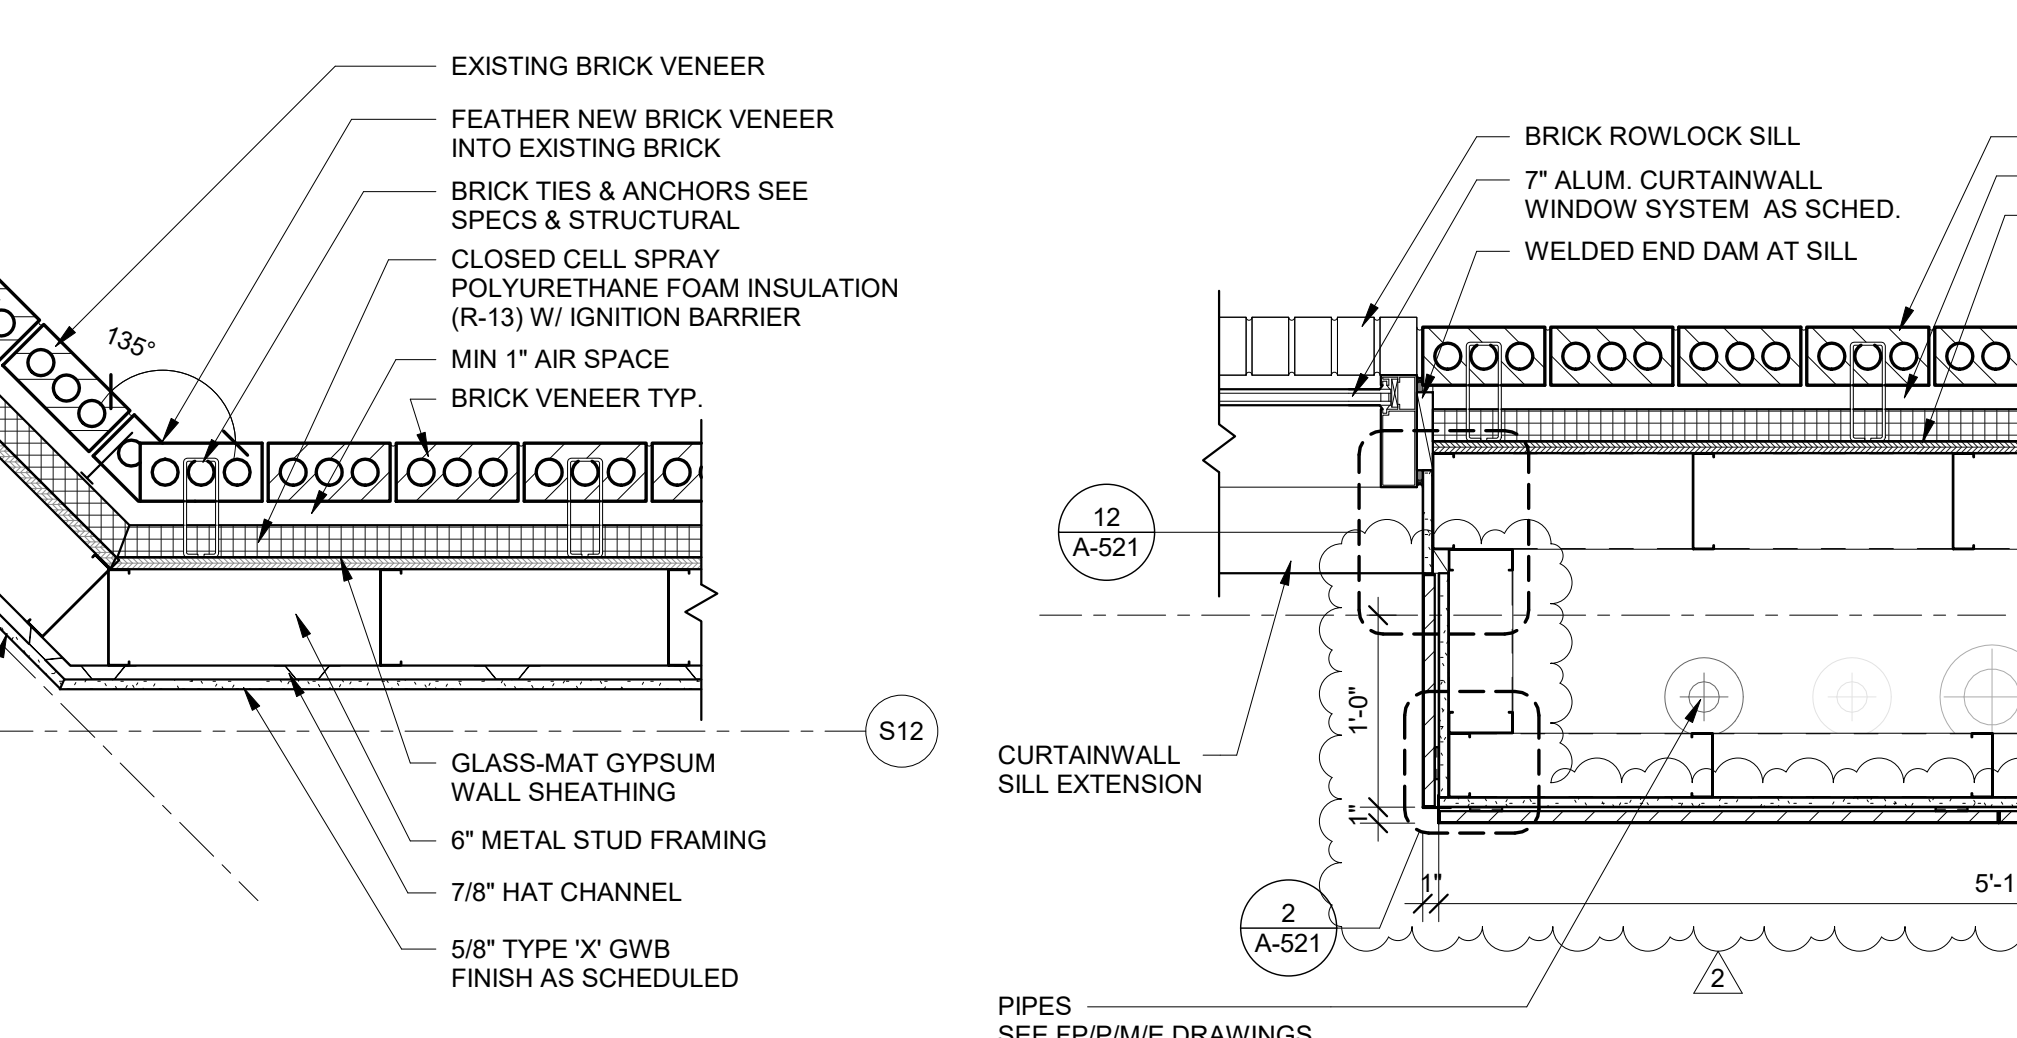


**2 PLAN DETAIL AT BOARDING LEVEL**  
1" = 1'-0"

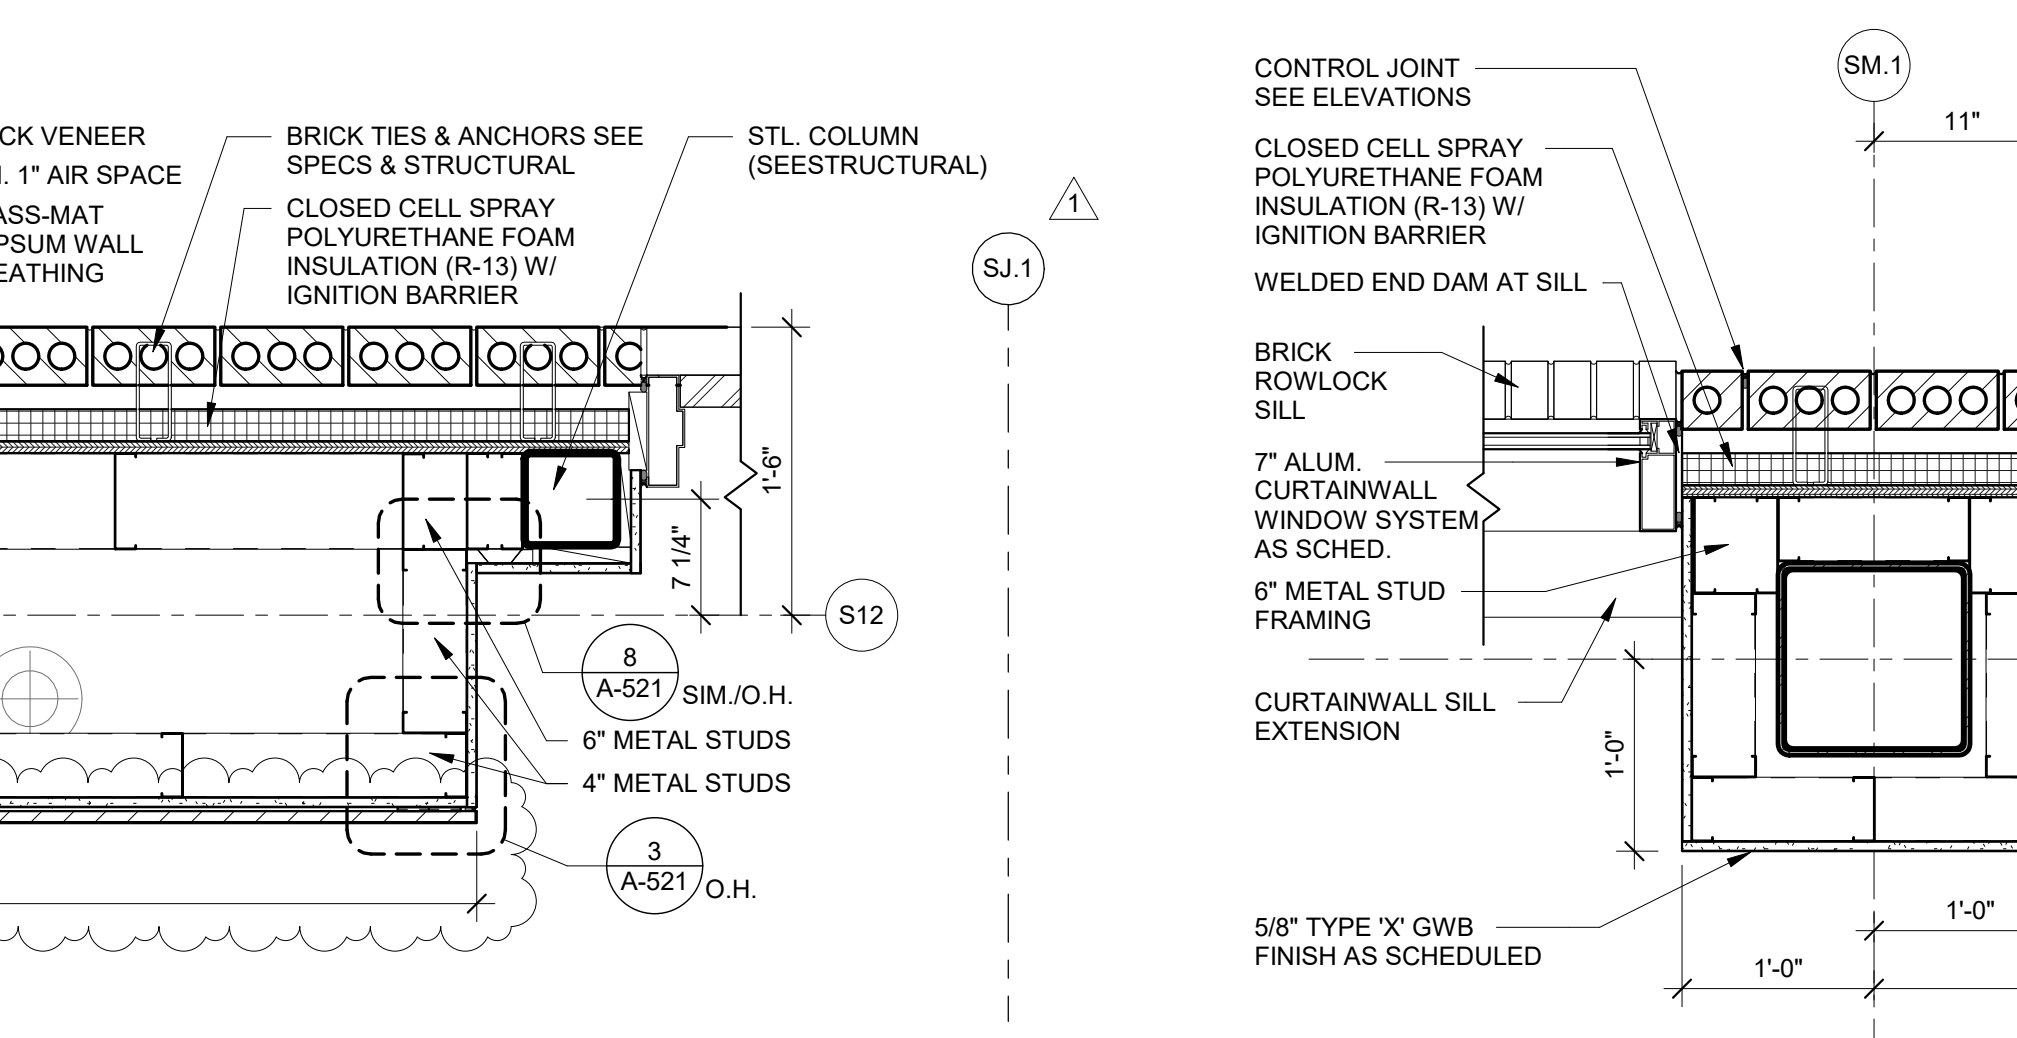


**4 PLAN DETAIL AT BOARDING LEVEL**  
1" = 1'-0"





**1 PLAN DETAIL AT BOARDING LEVEL**  
1" = 1'-0"

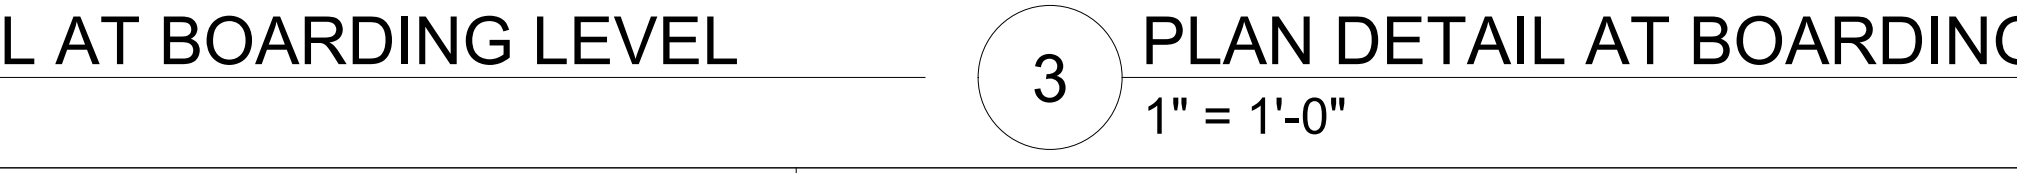


**3 PLAN DETAIL AT BOARDING LEVEL**  
1" = 1'-0"

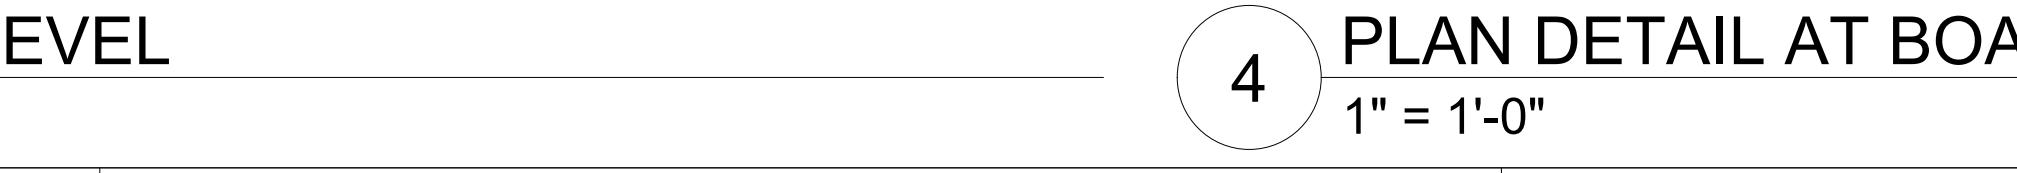


**4 PLAN DETAIL AT BOARDING LEVEL**  
1" = 1'-0"

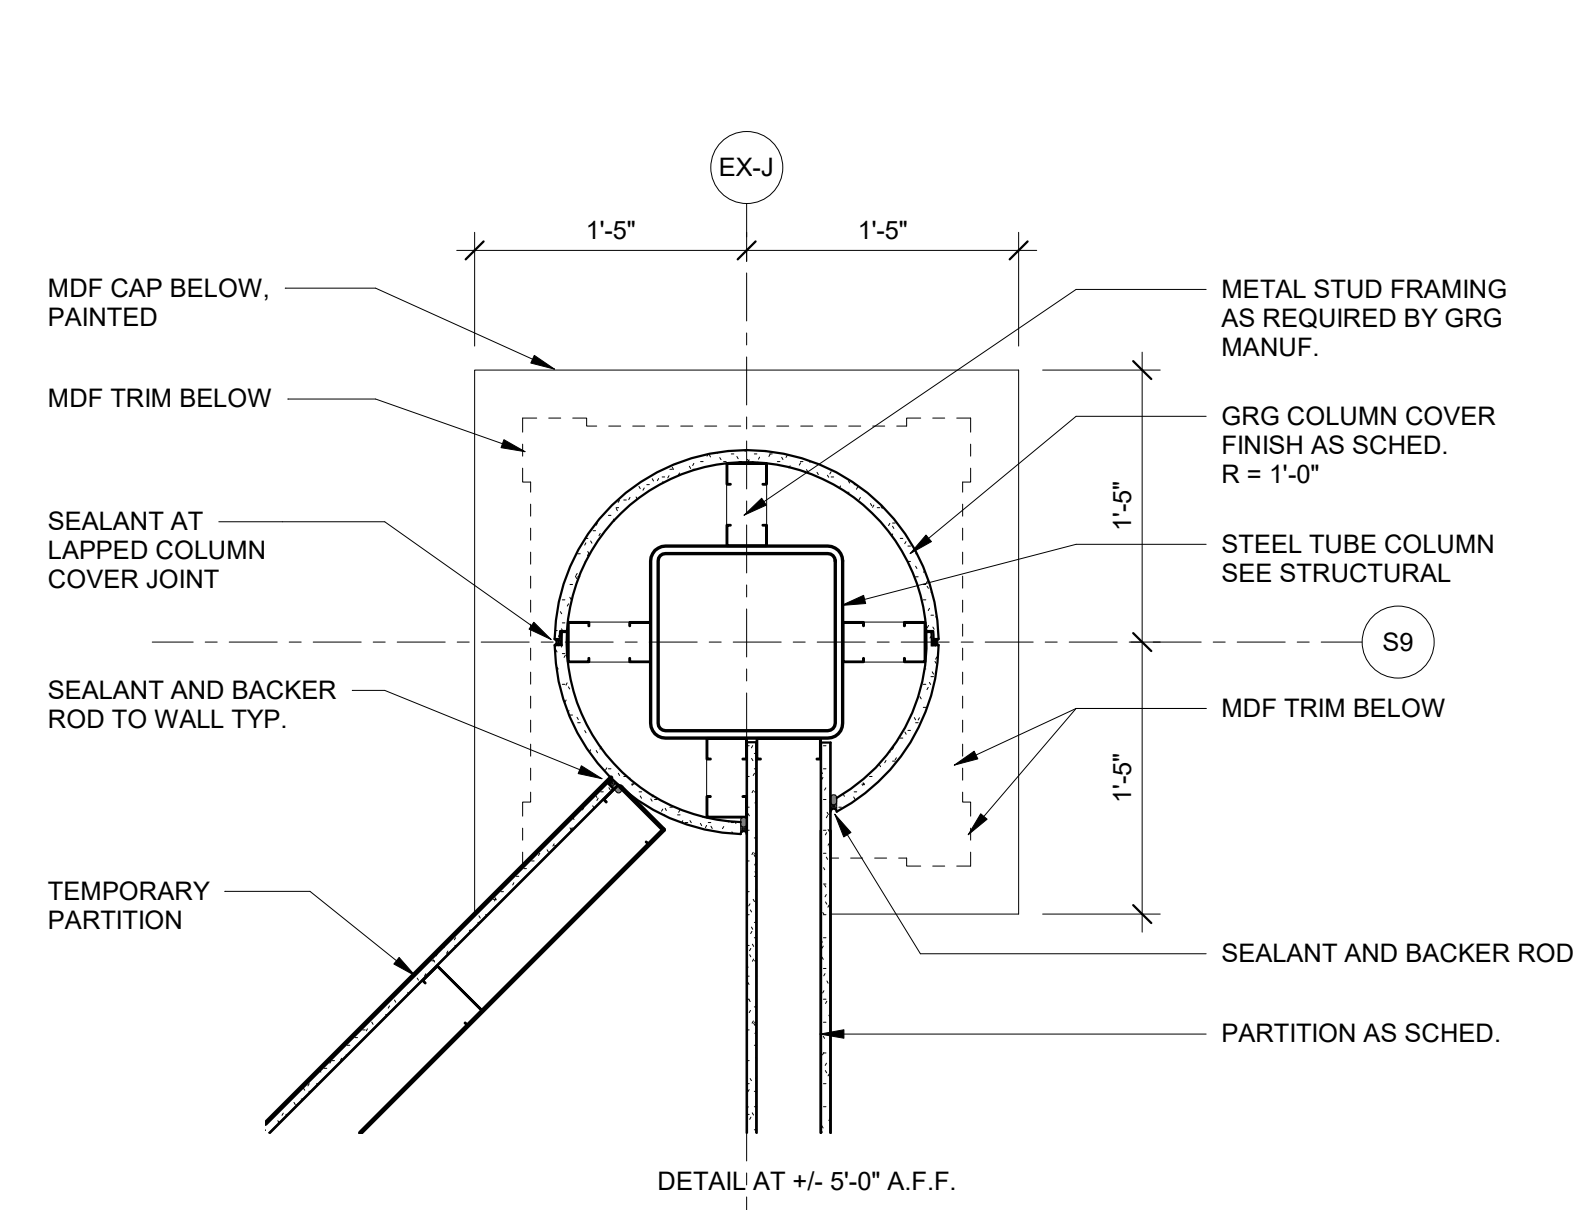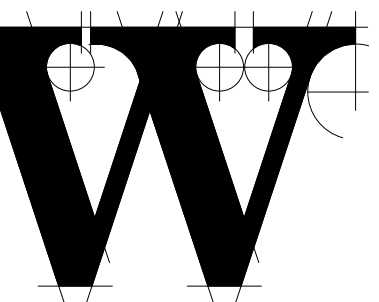


**16 PLAN DETAIL AT COLUMN COVER**  
1" = 1'-0"

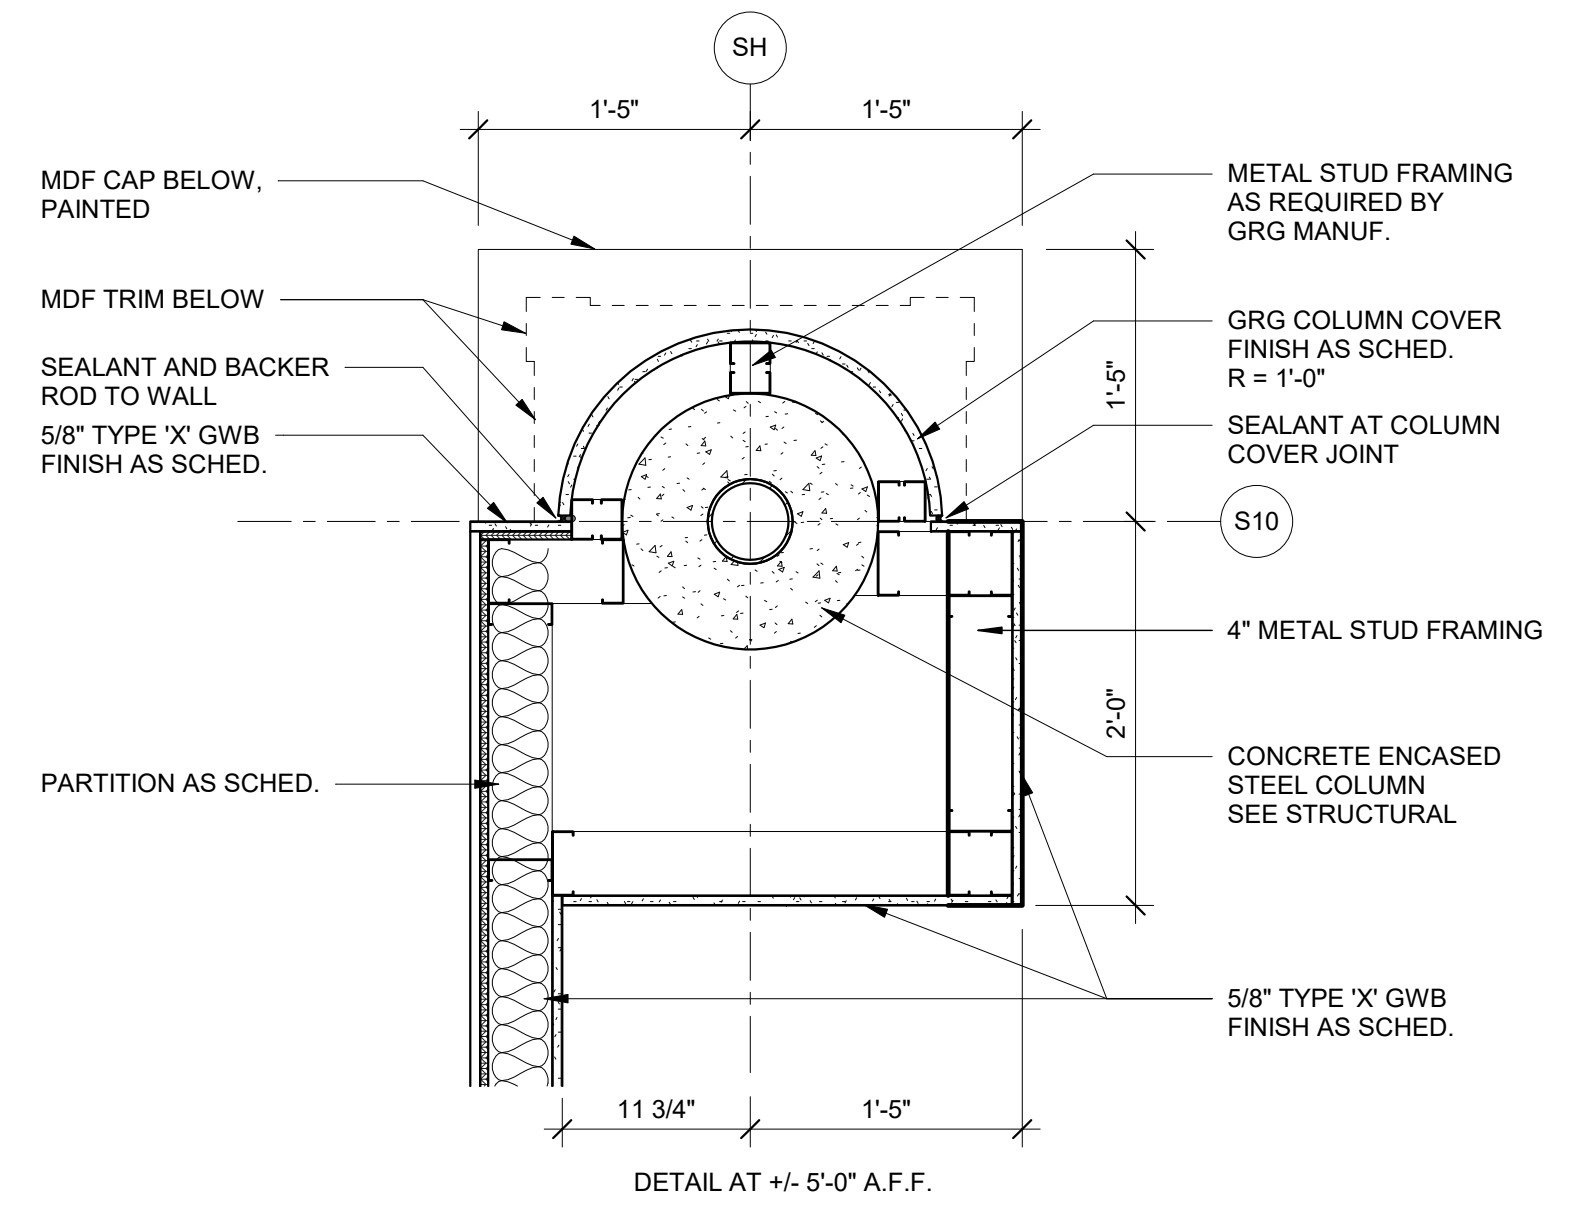


**17 PLAN DETAIL AT COLUMN COVER**  
1" = 1'-0"

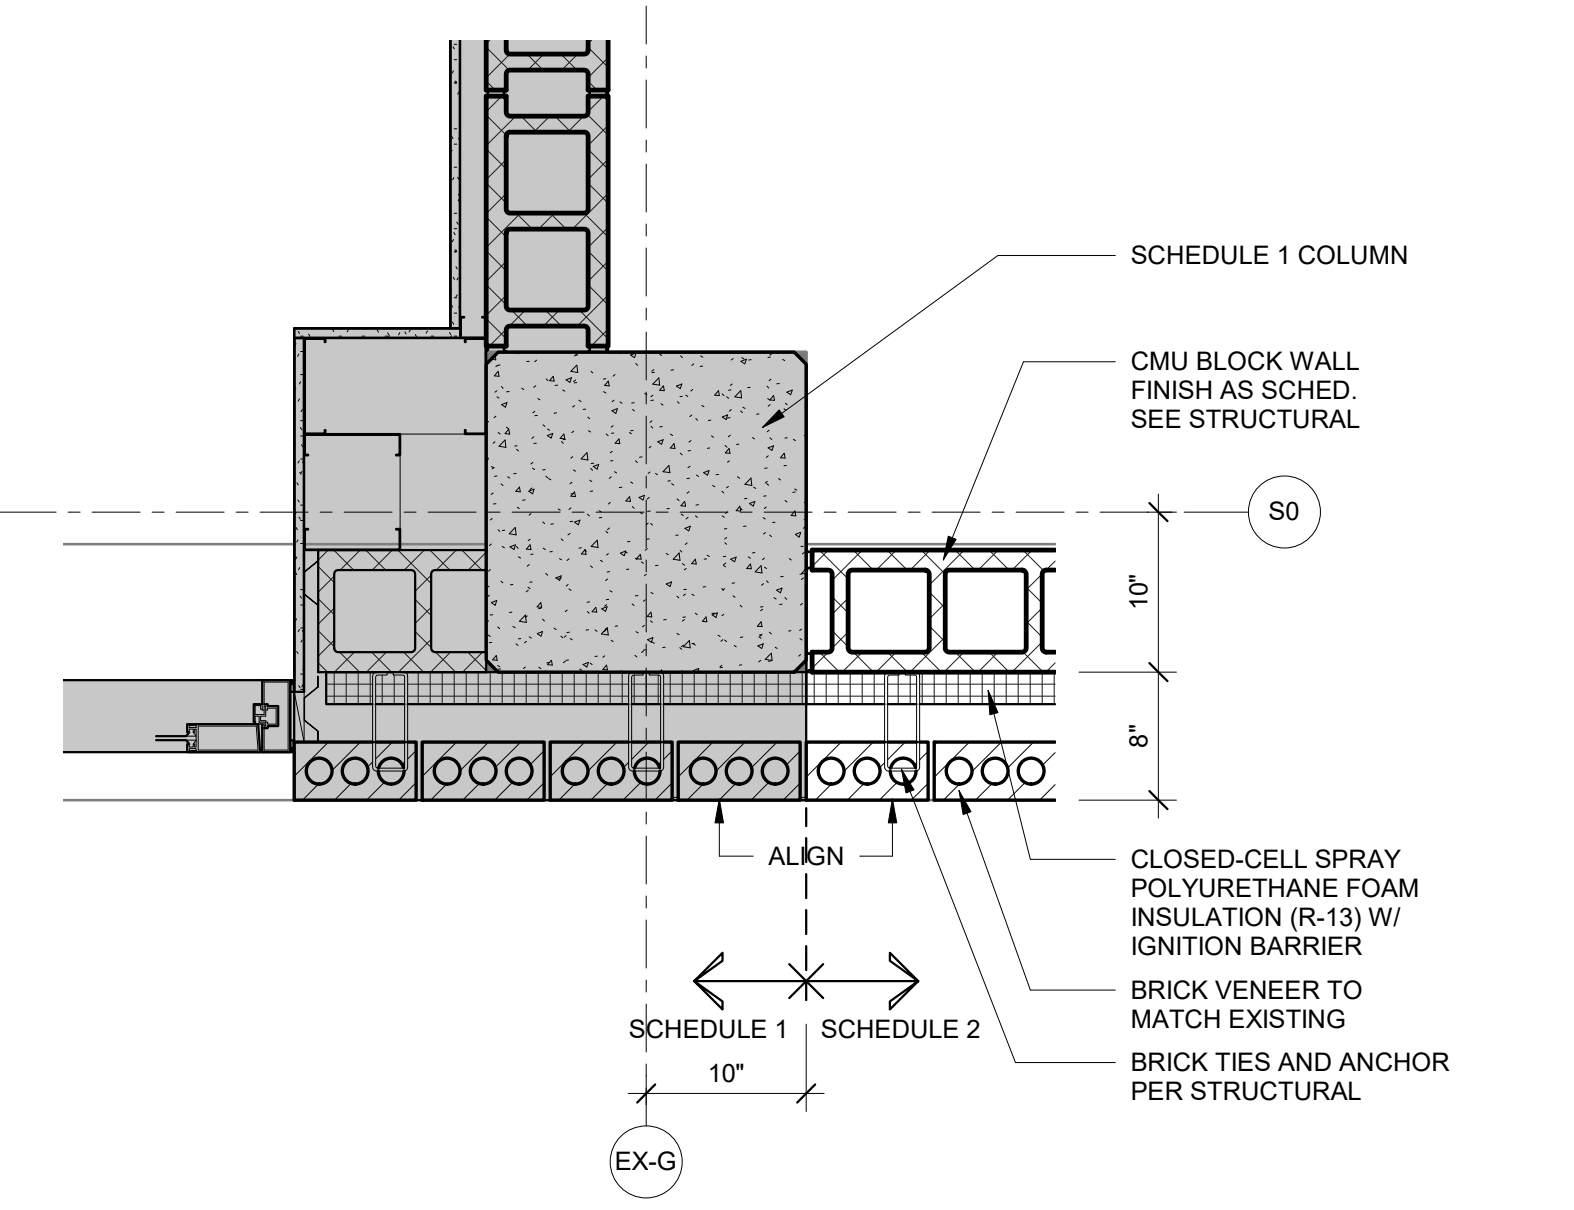


**18 PLAN DETAIL AT RAMP LEVEL**  
1" = 1'-0"

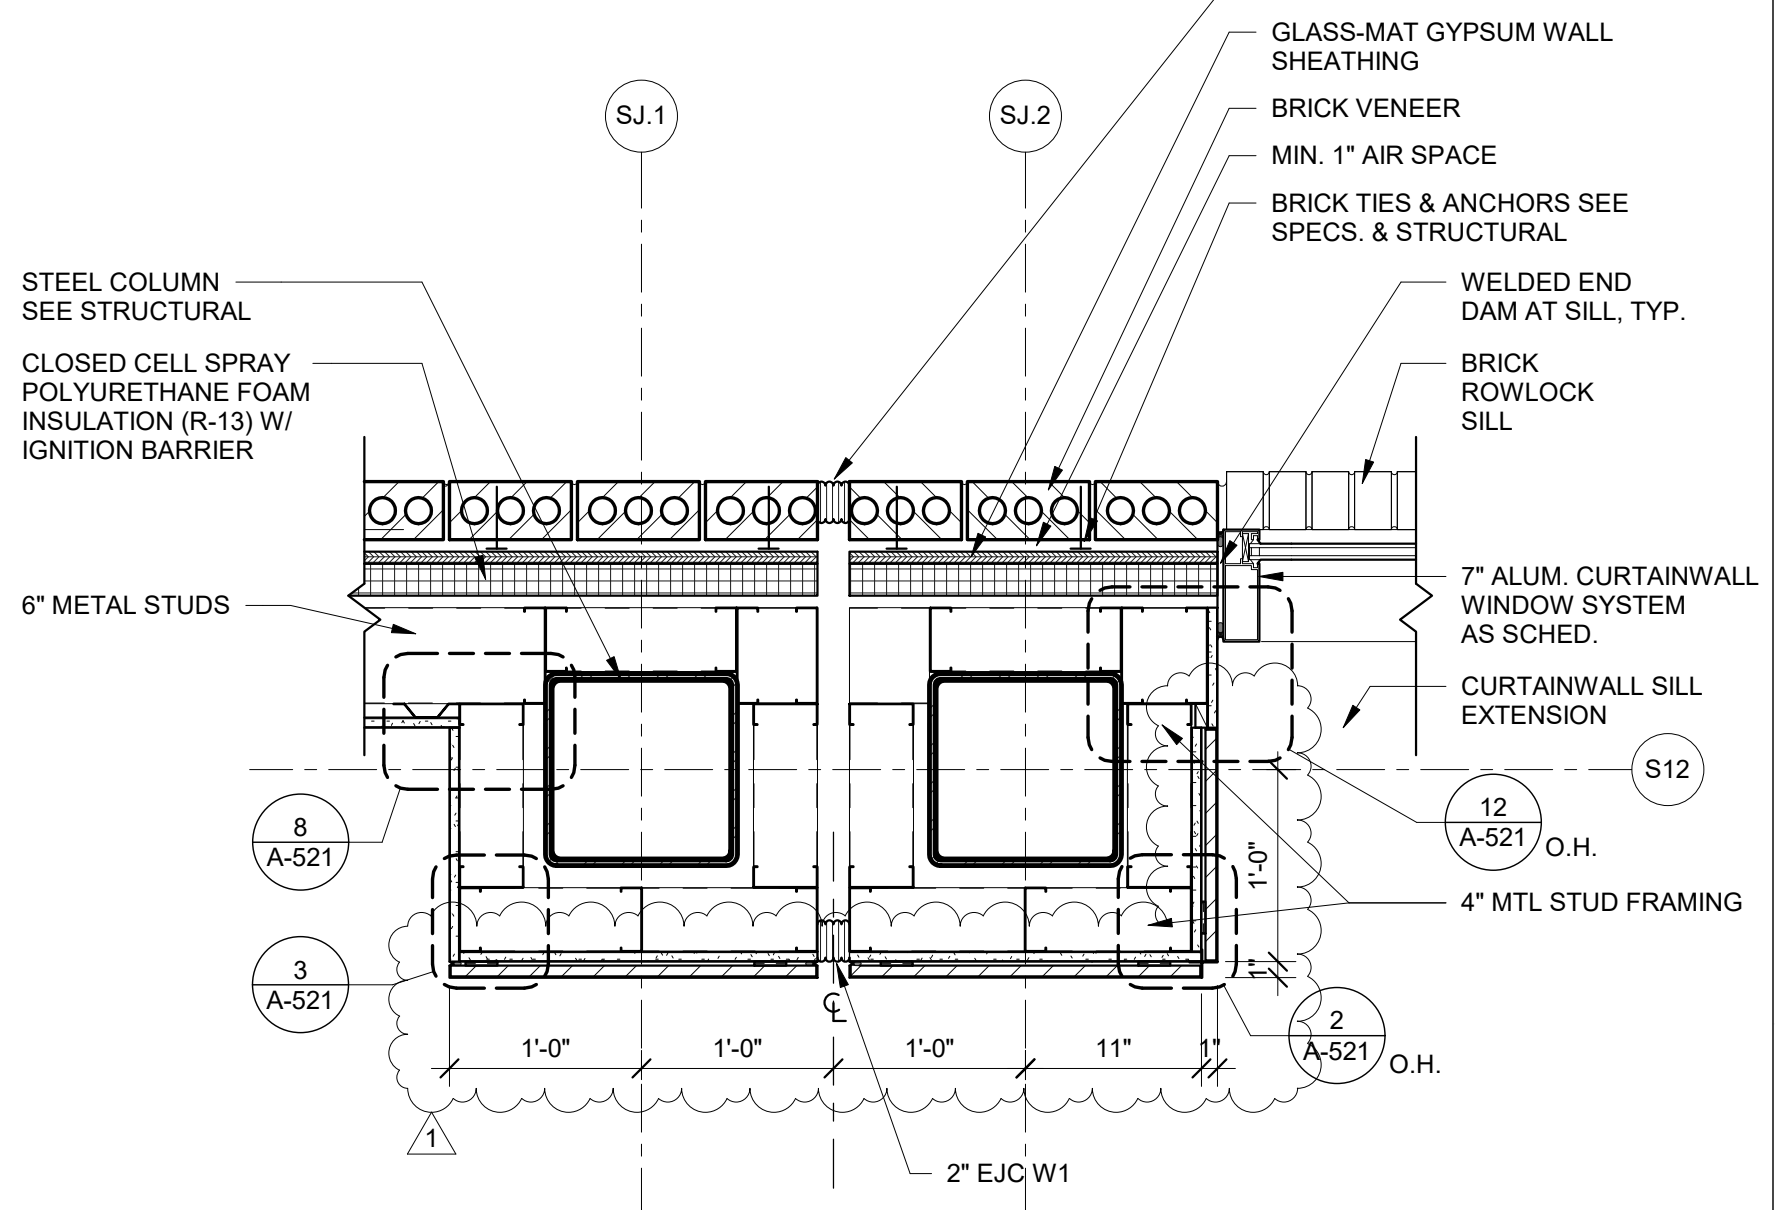


**20 PLAN DETAIL AT BOARDING LEVEL**  
1" = 1'-0"

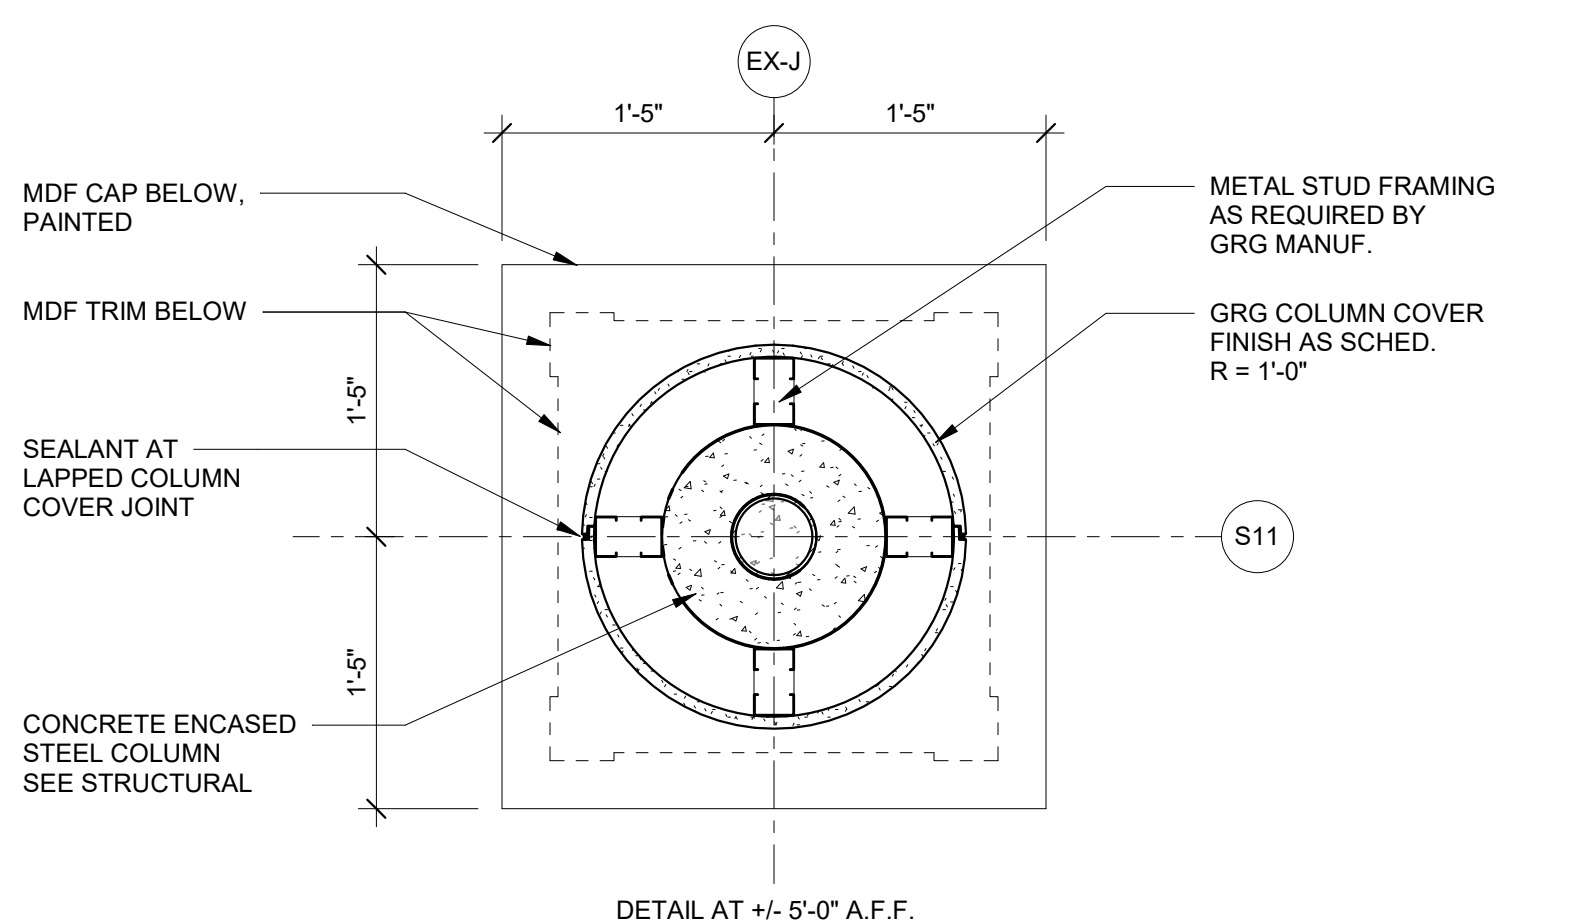


**11 PLAN DETAIL AT COLUMN COVER**  
1" = 1'-0"

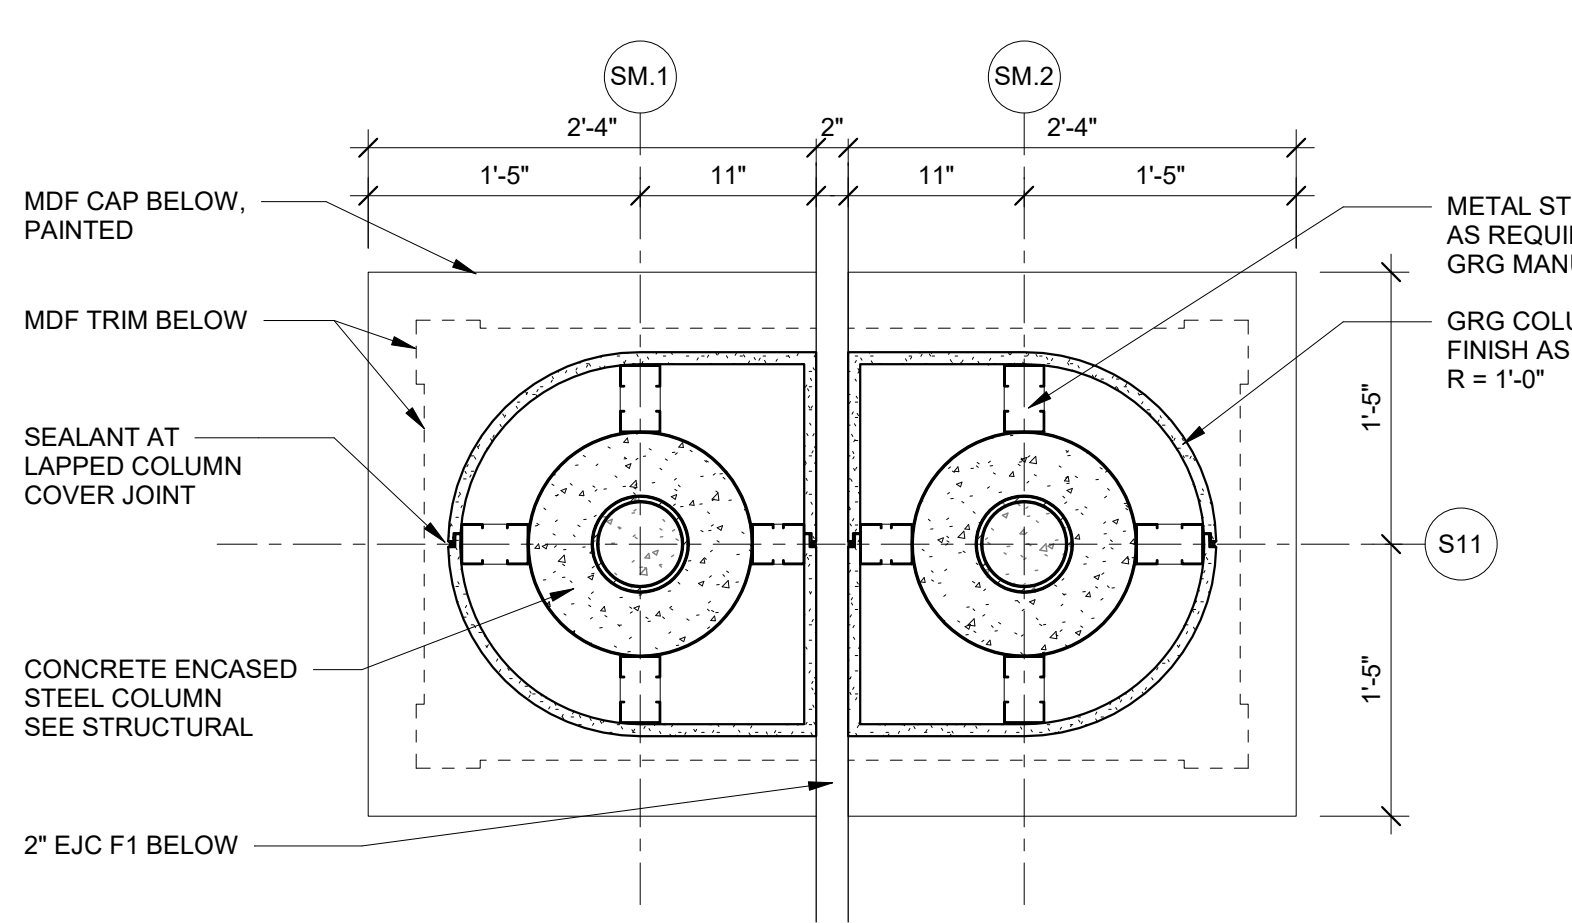


**12 PLAN DETAIL AT COLUMN COVER**  
1" = 1'-0"

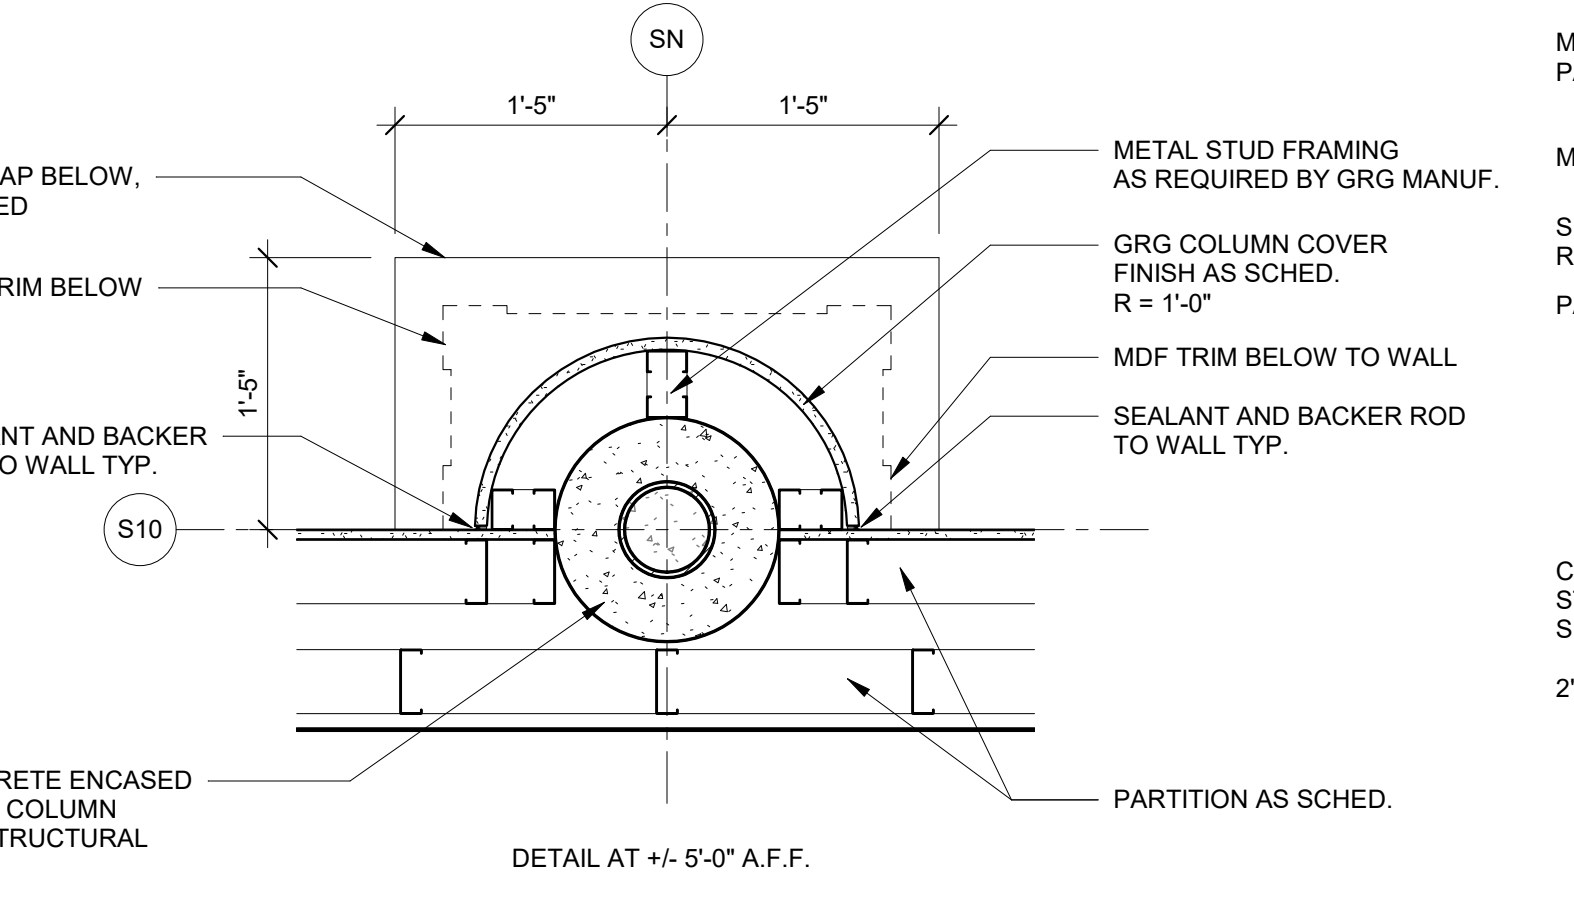


**13 PLAN DETAIL AT COLUMN COVER**  
1" = 1'-0"

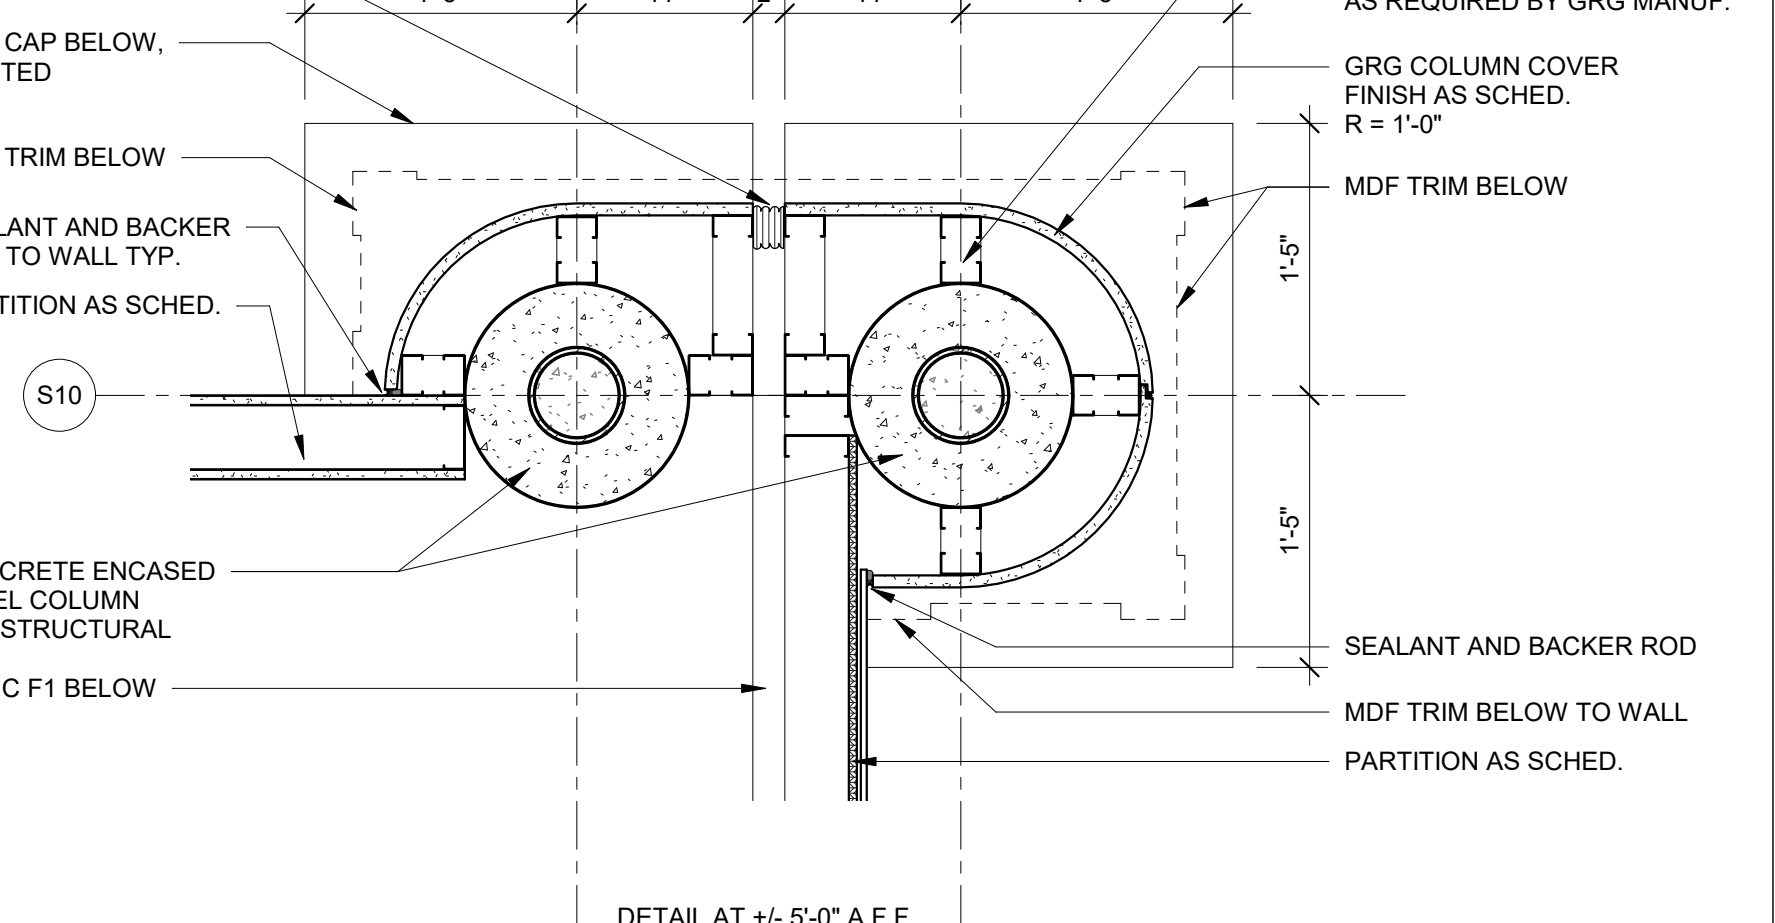


**14 PLAN DETAIL AT COLUMN COVER**  
1" = 1'-0"

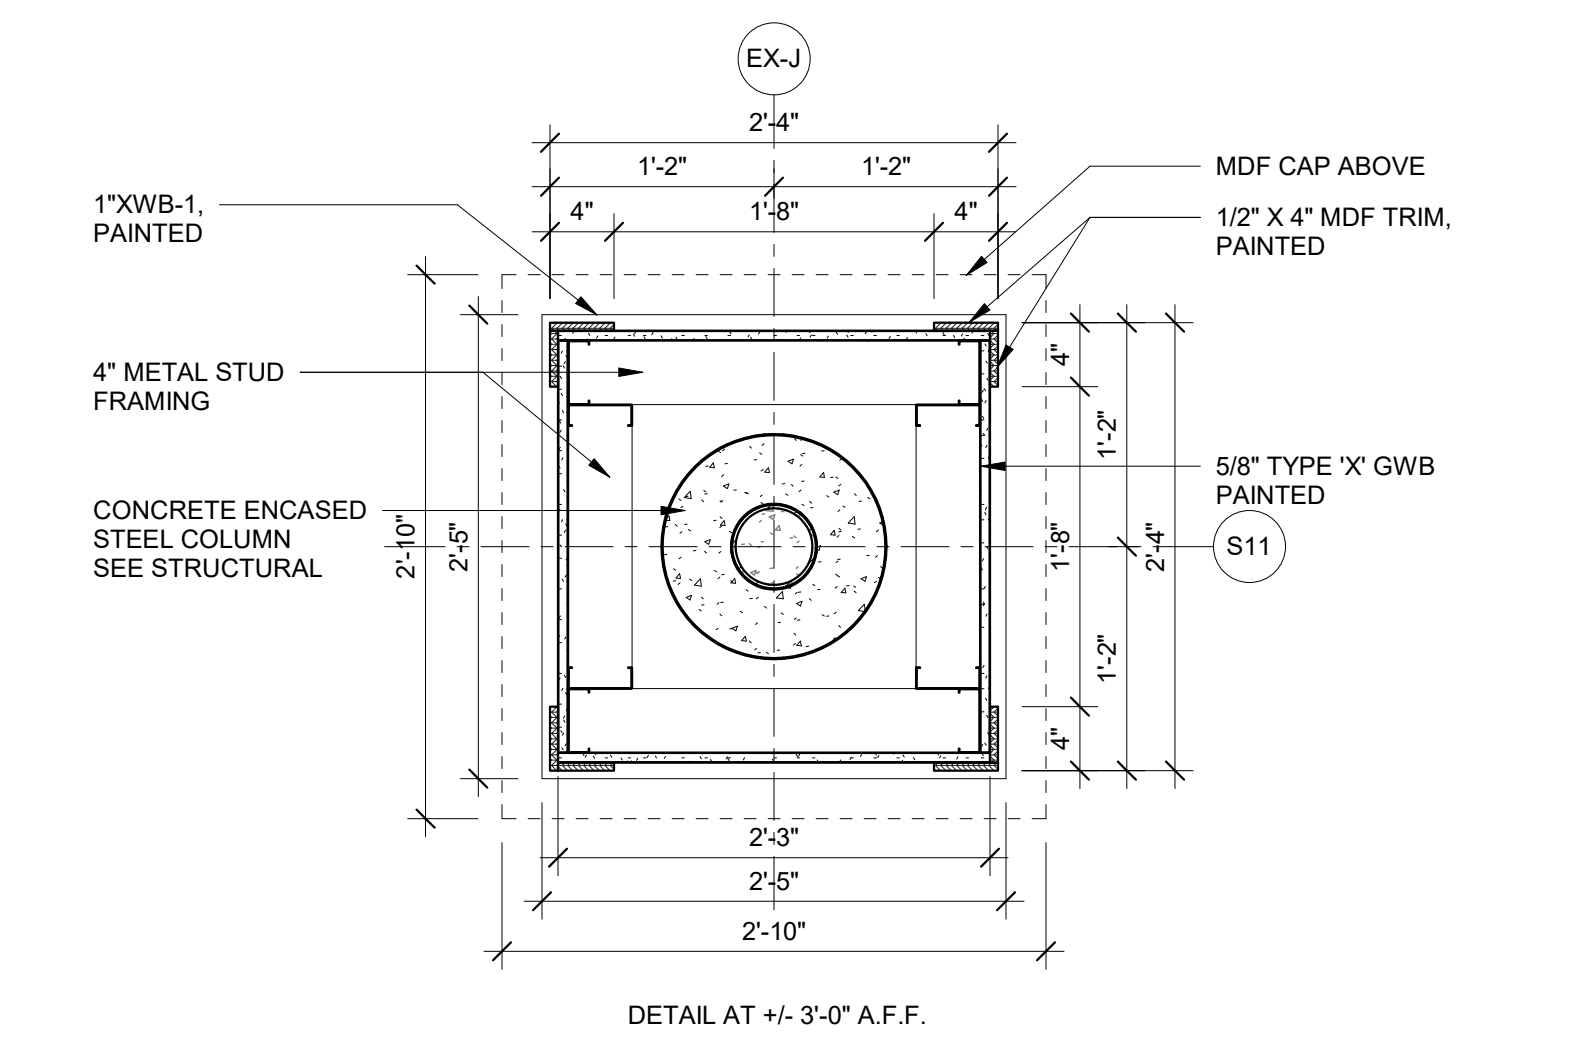


**6 PLAN DETAIL AT BOARDING LEVEL**  
1" = 1'-0"

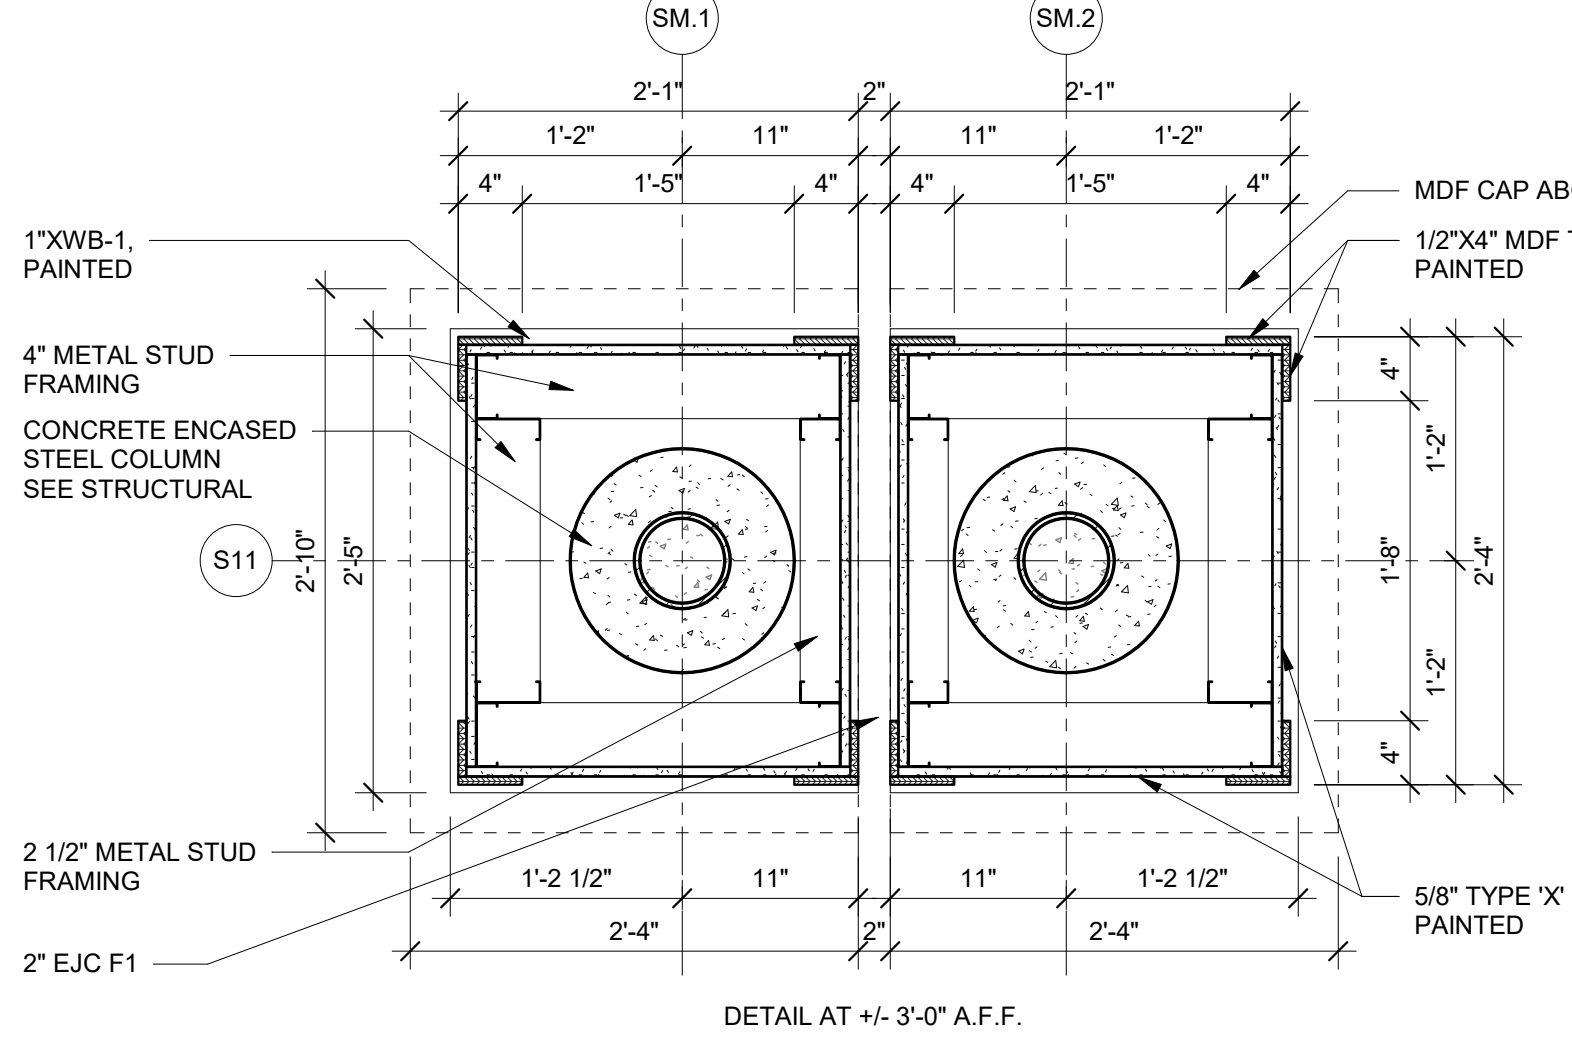


**7 PLAN DETAIL AT BOARDING LEVEL**  
1" = 1'-0"

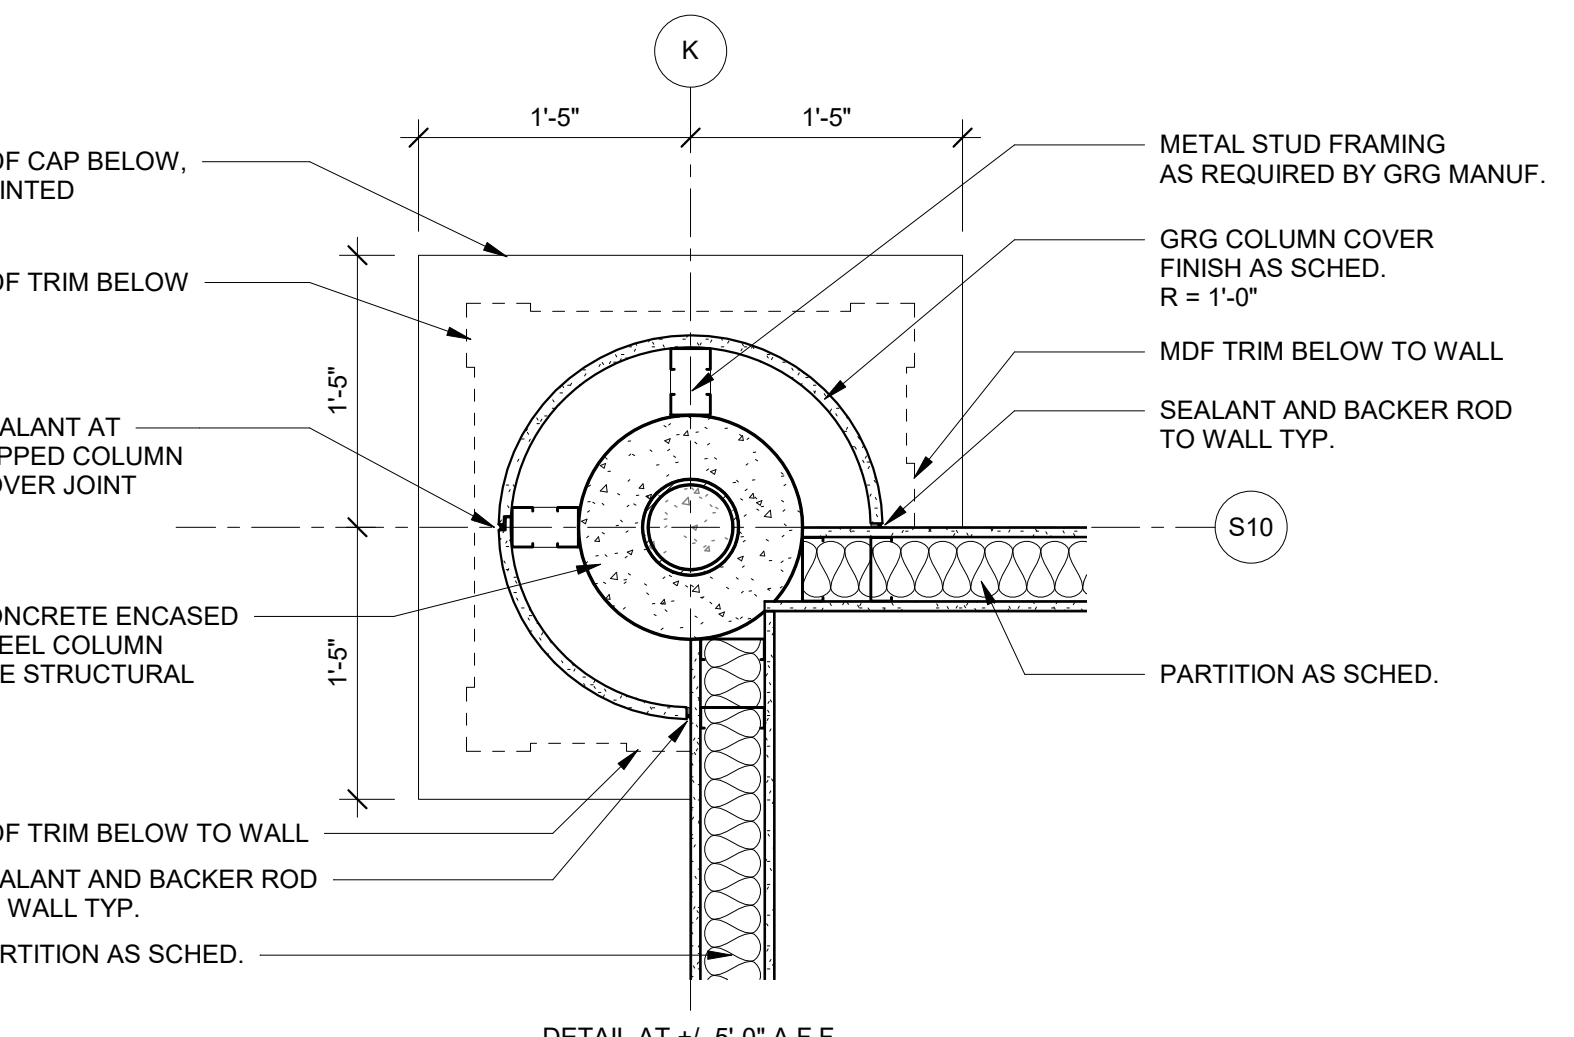


**8 PLAN DETAIL AT BOARDING LEVEL**  
1" = 1'-0"

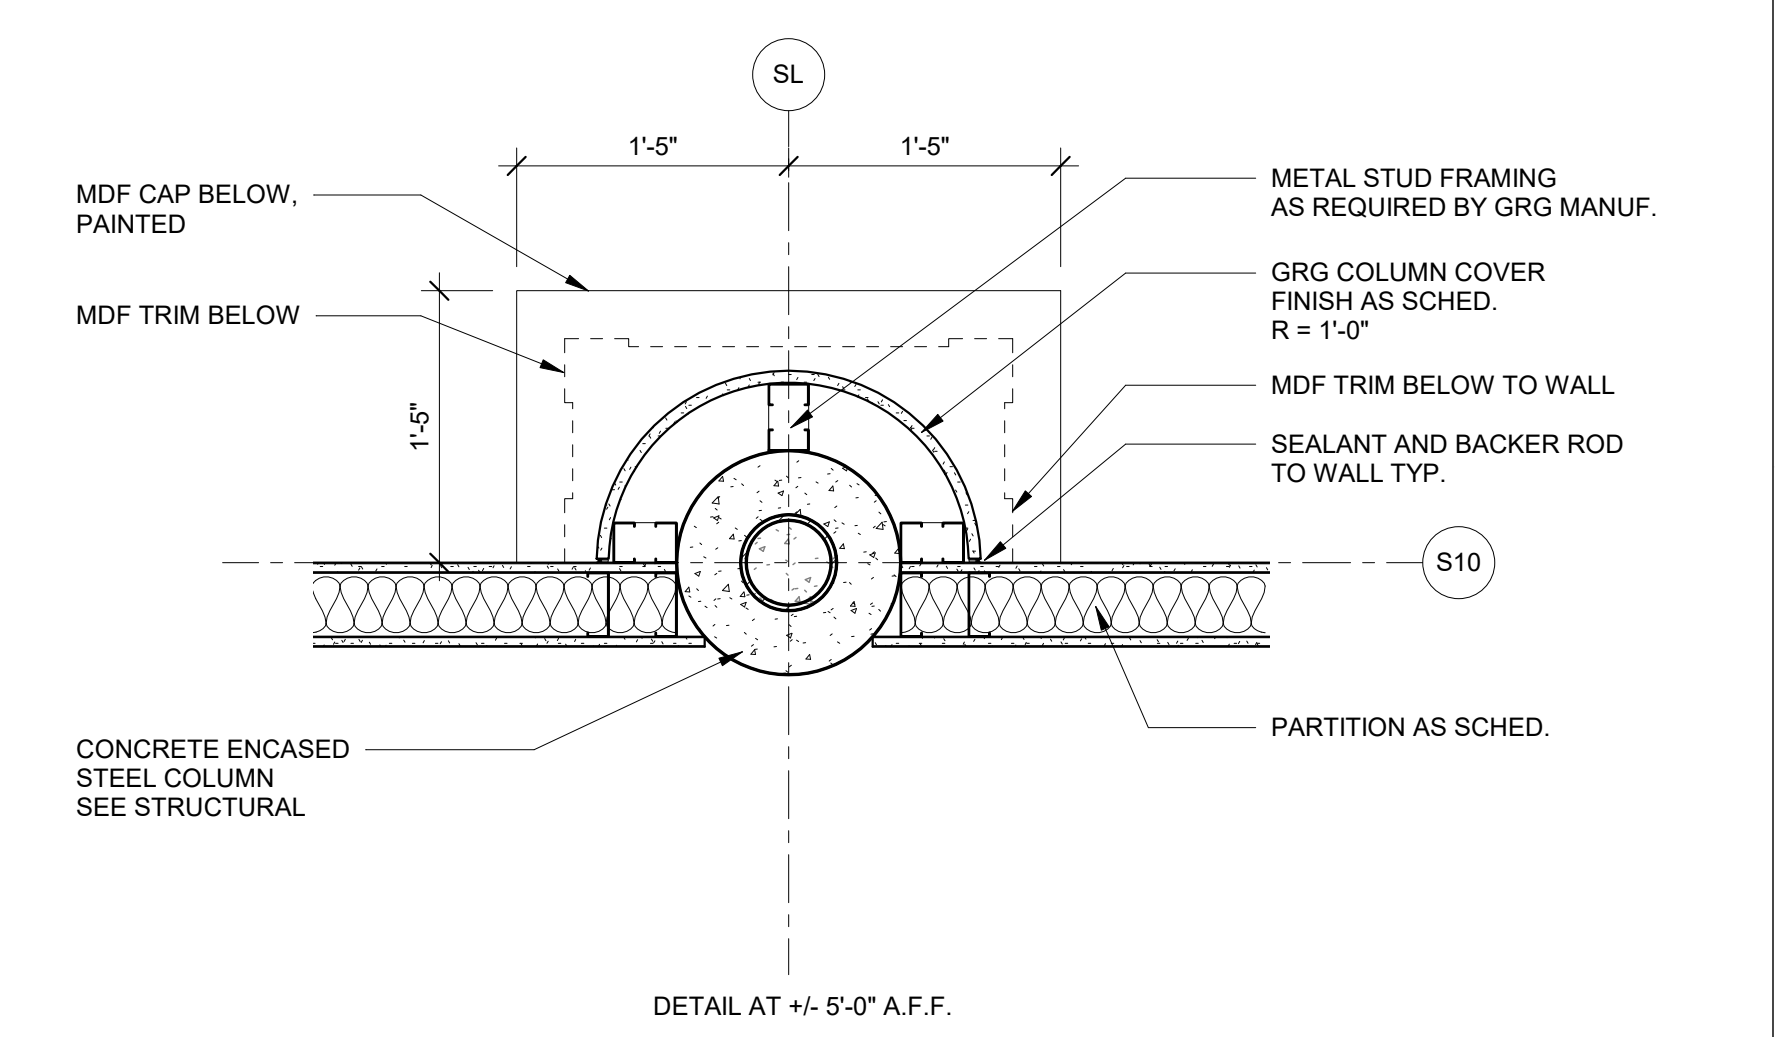


**9 PLAN DETAIL AT BOARDING LEVEL**  
1" = 1'-0"

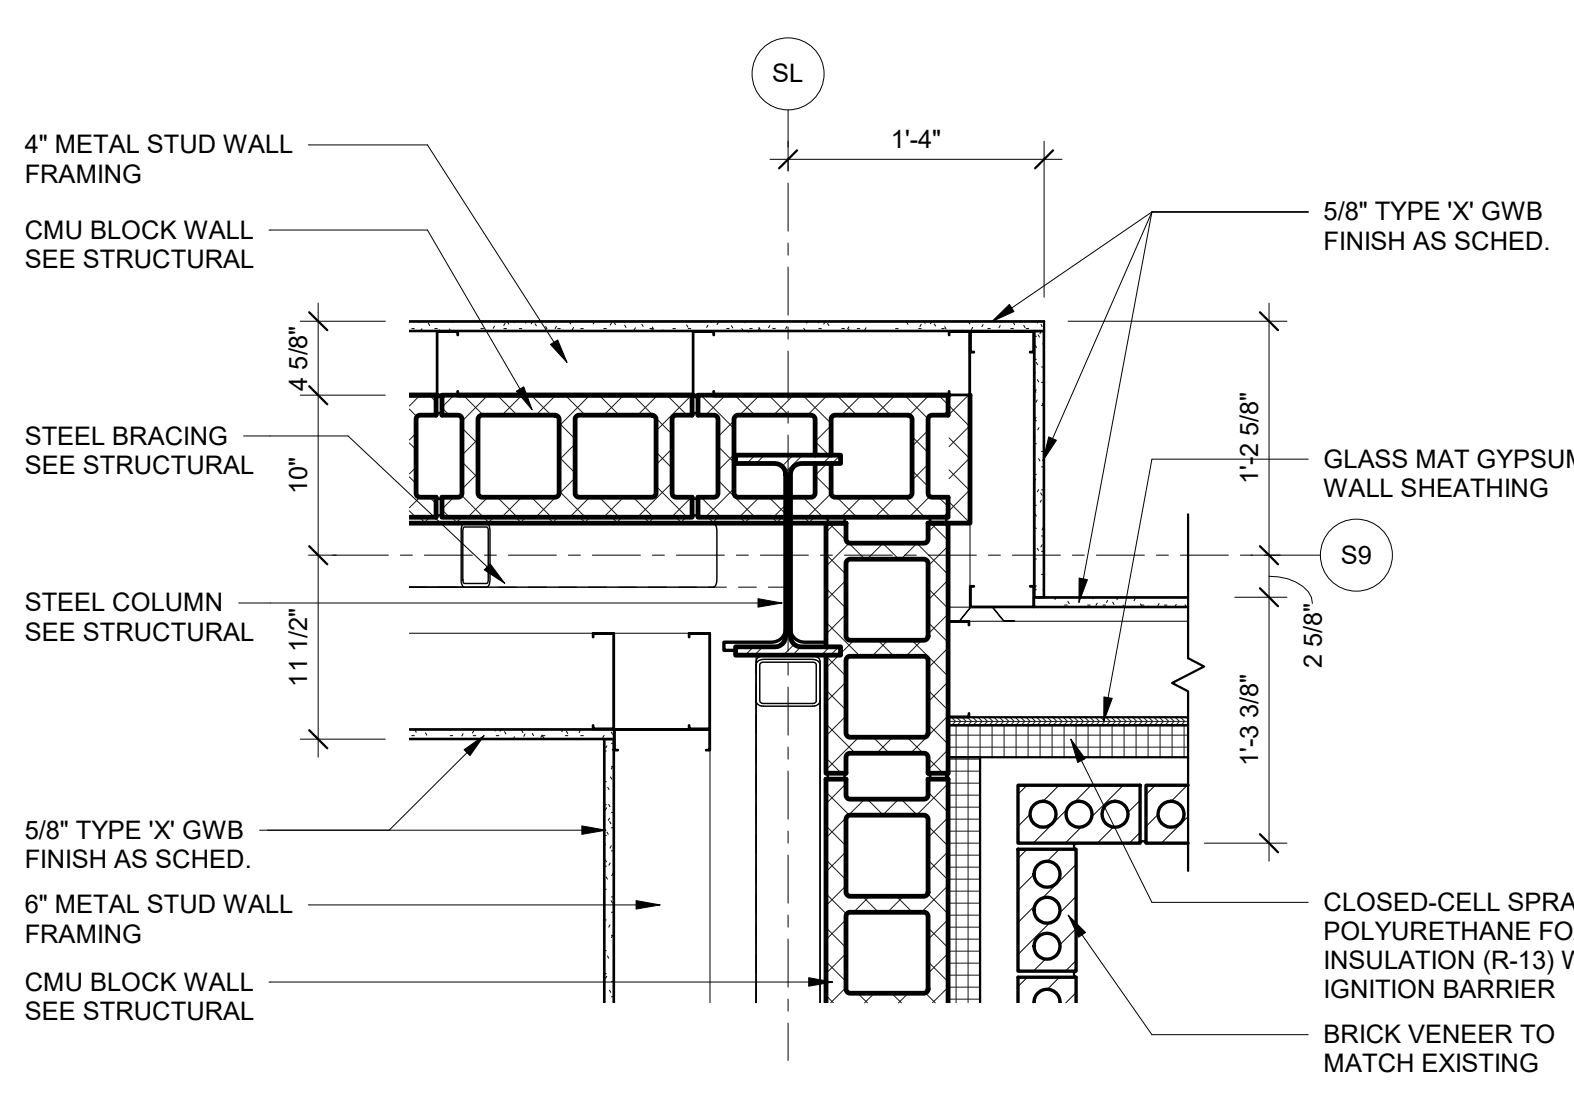


**1 PLAN DETAIL AT BOARDING LEVEL**  
1" = 1'-0"

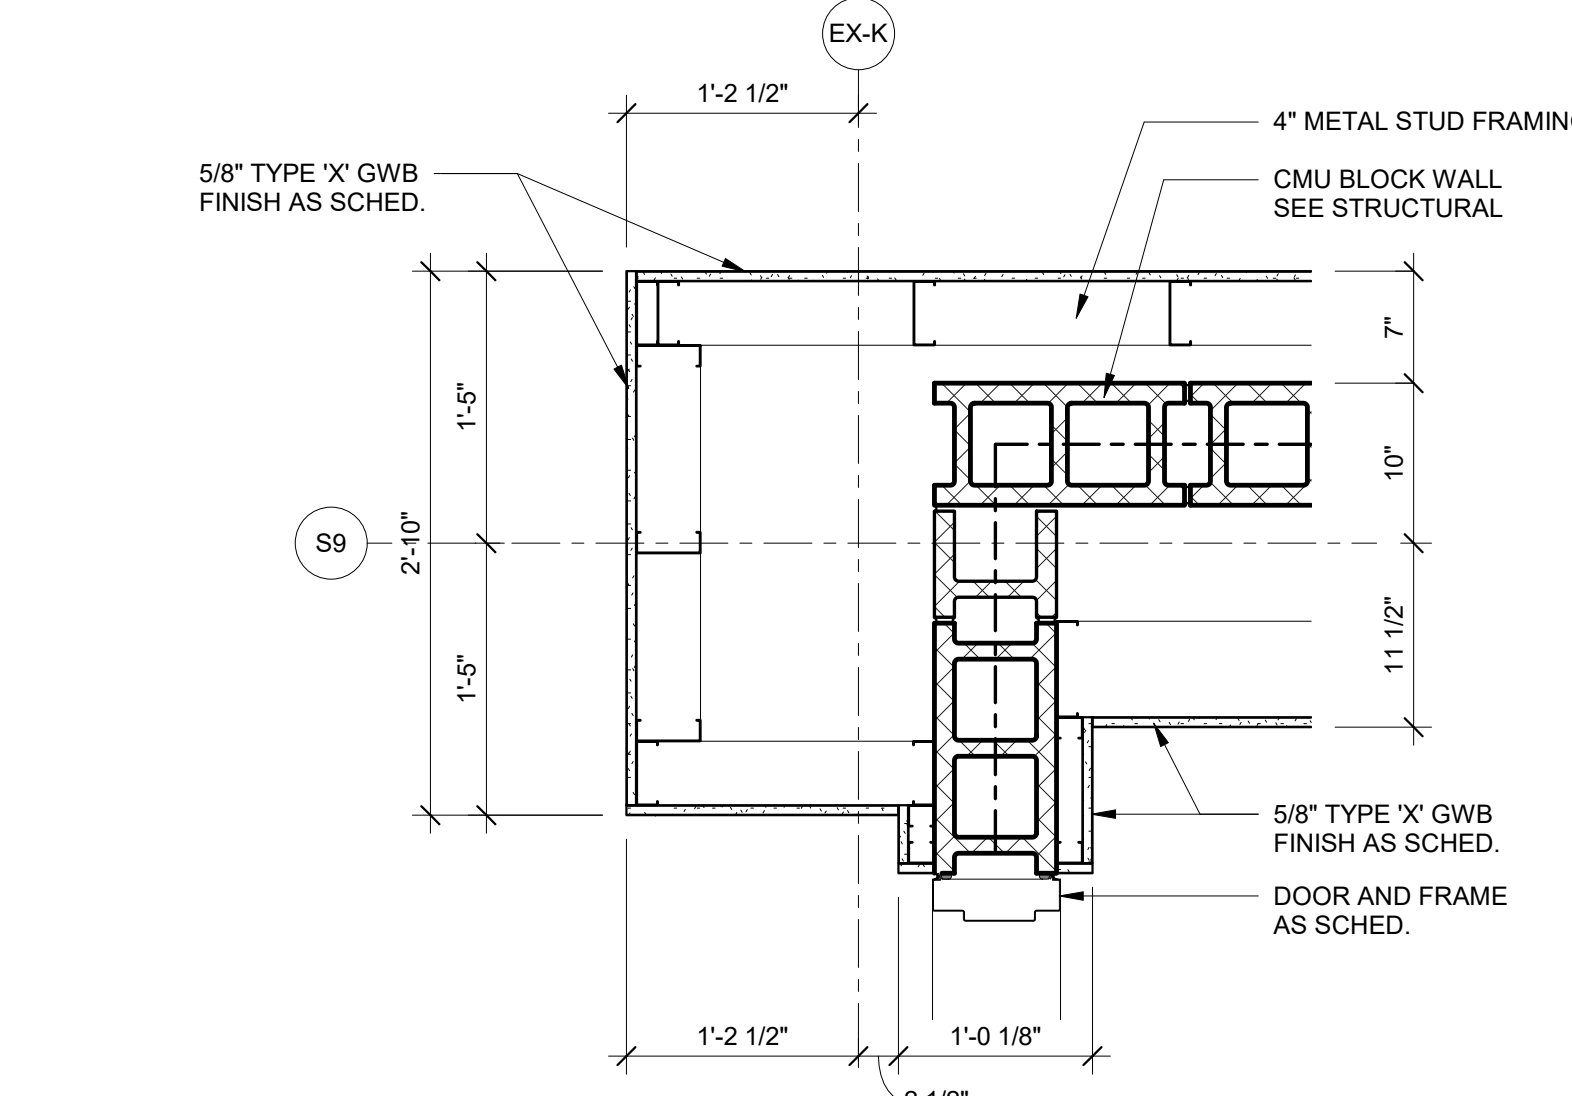



**2 PLAN DETAIL AT BOARDING LEVEL**  
1" = 1'-0"

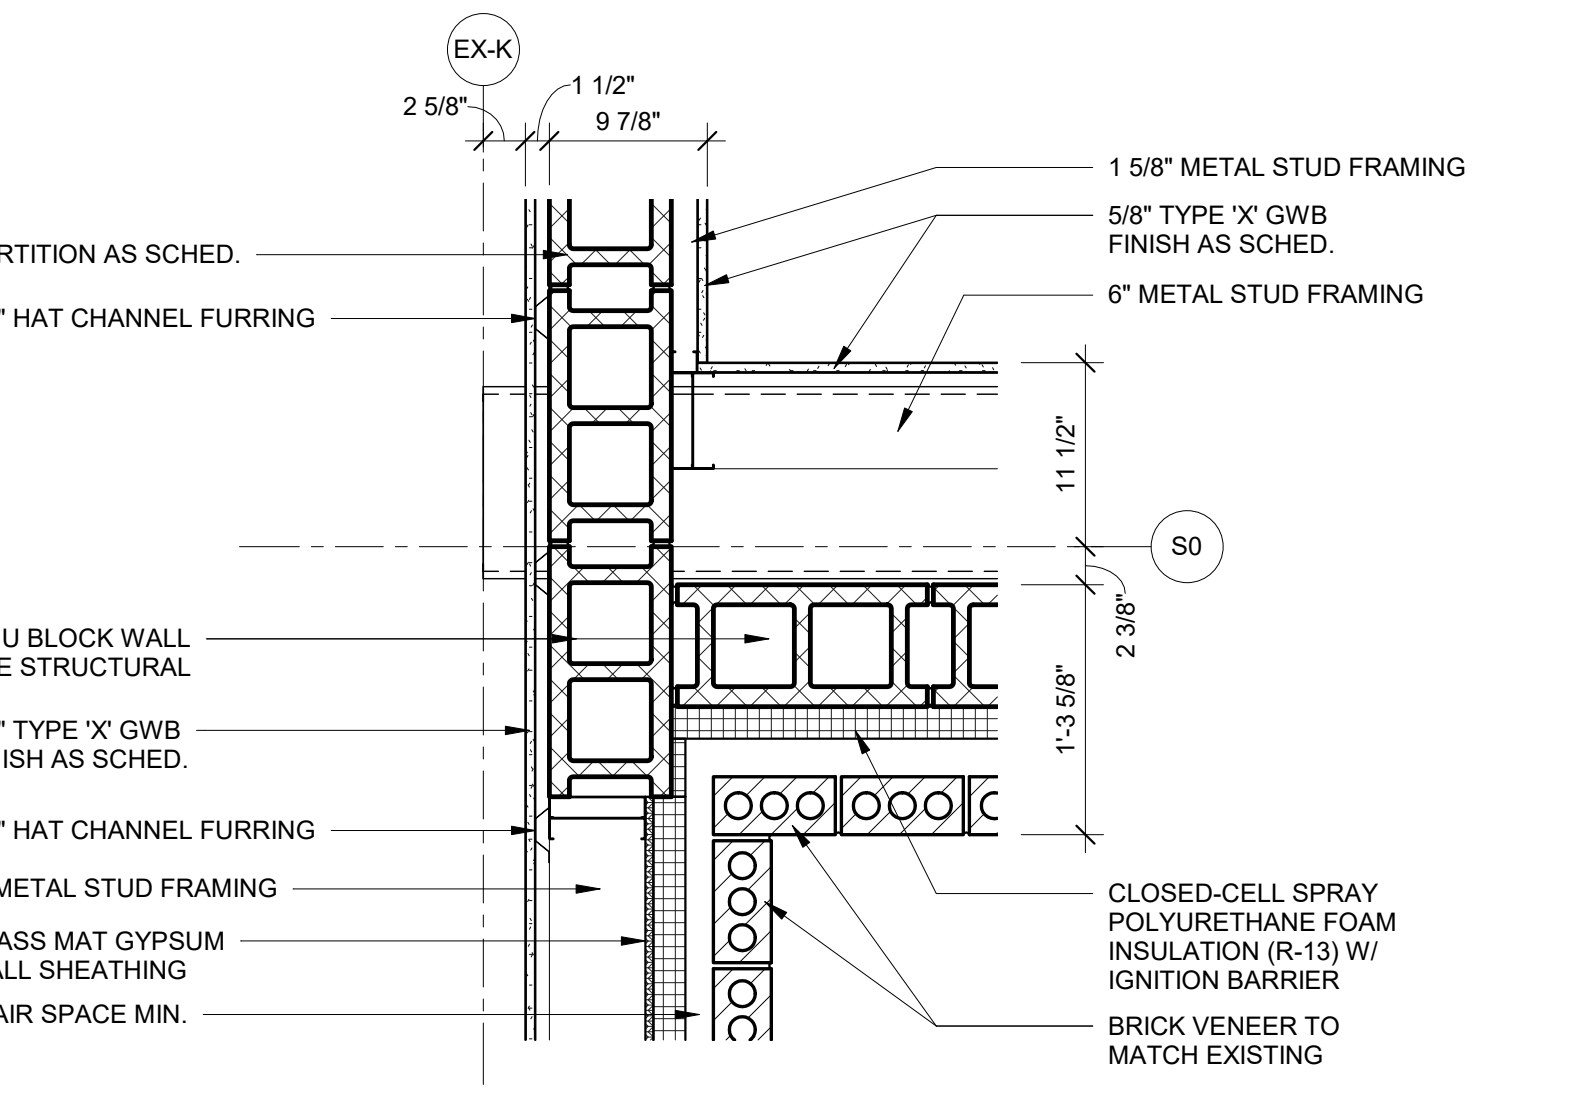


**3 PLAN DETAIL AT BOARDING LEVEL**  
1" = 1'-0"

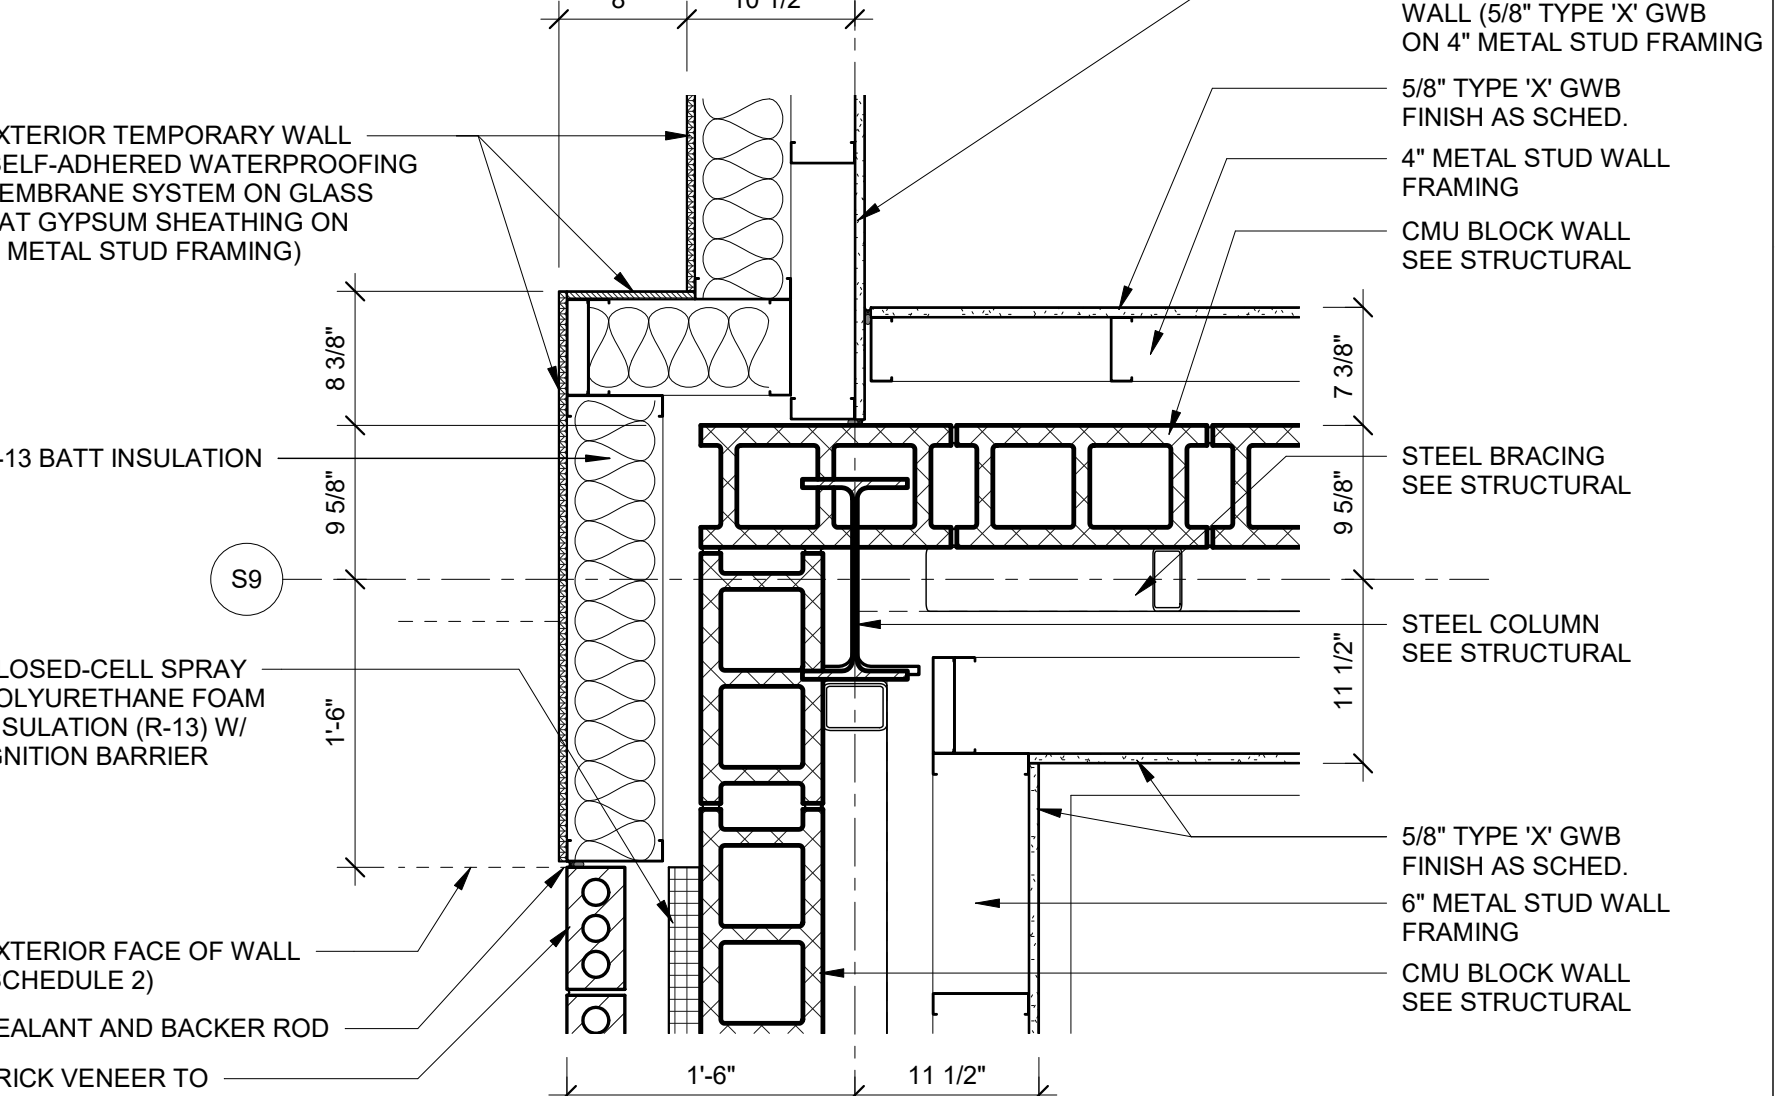


**4 PLAN DETAIL AT BOARDING LEVEL**  
1" = 1'-0"

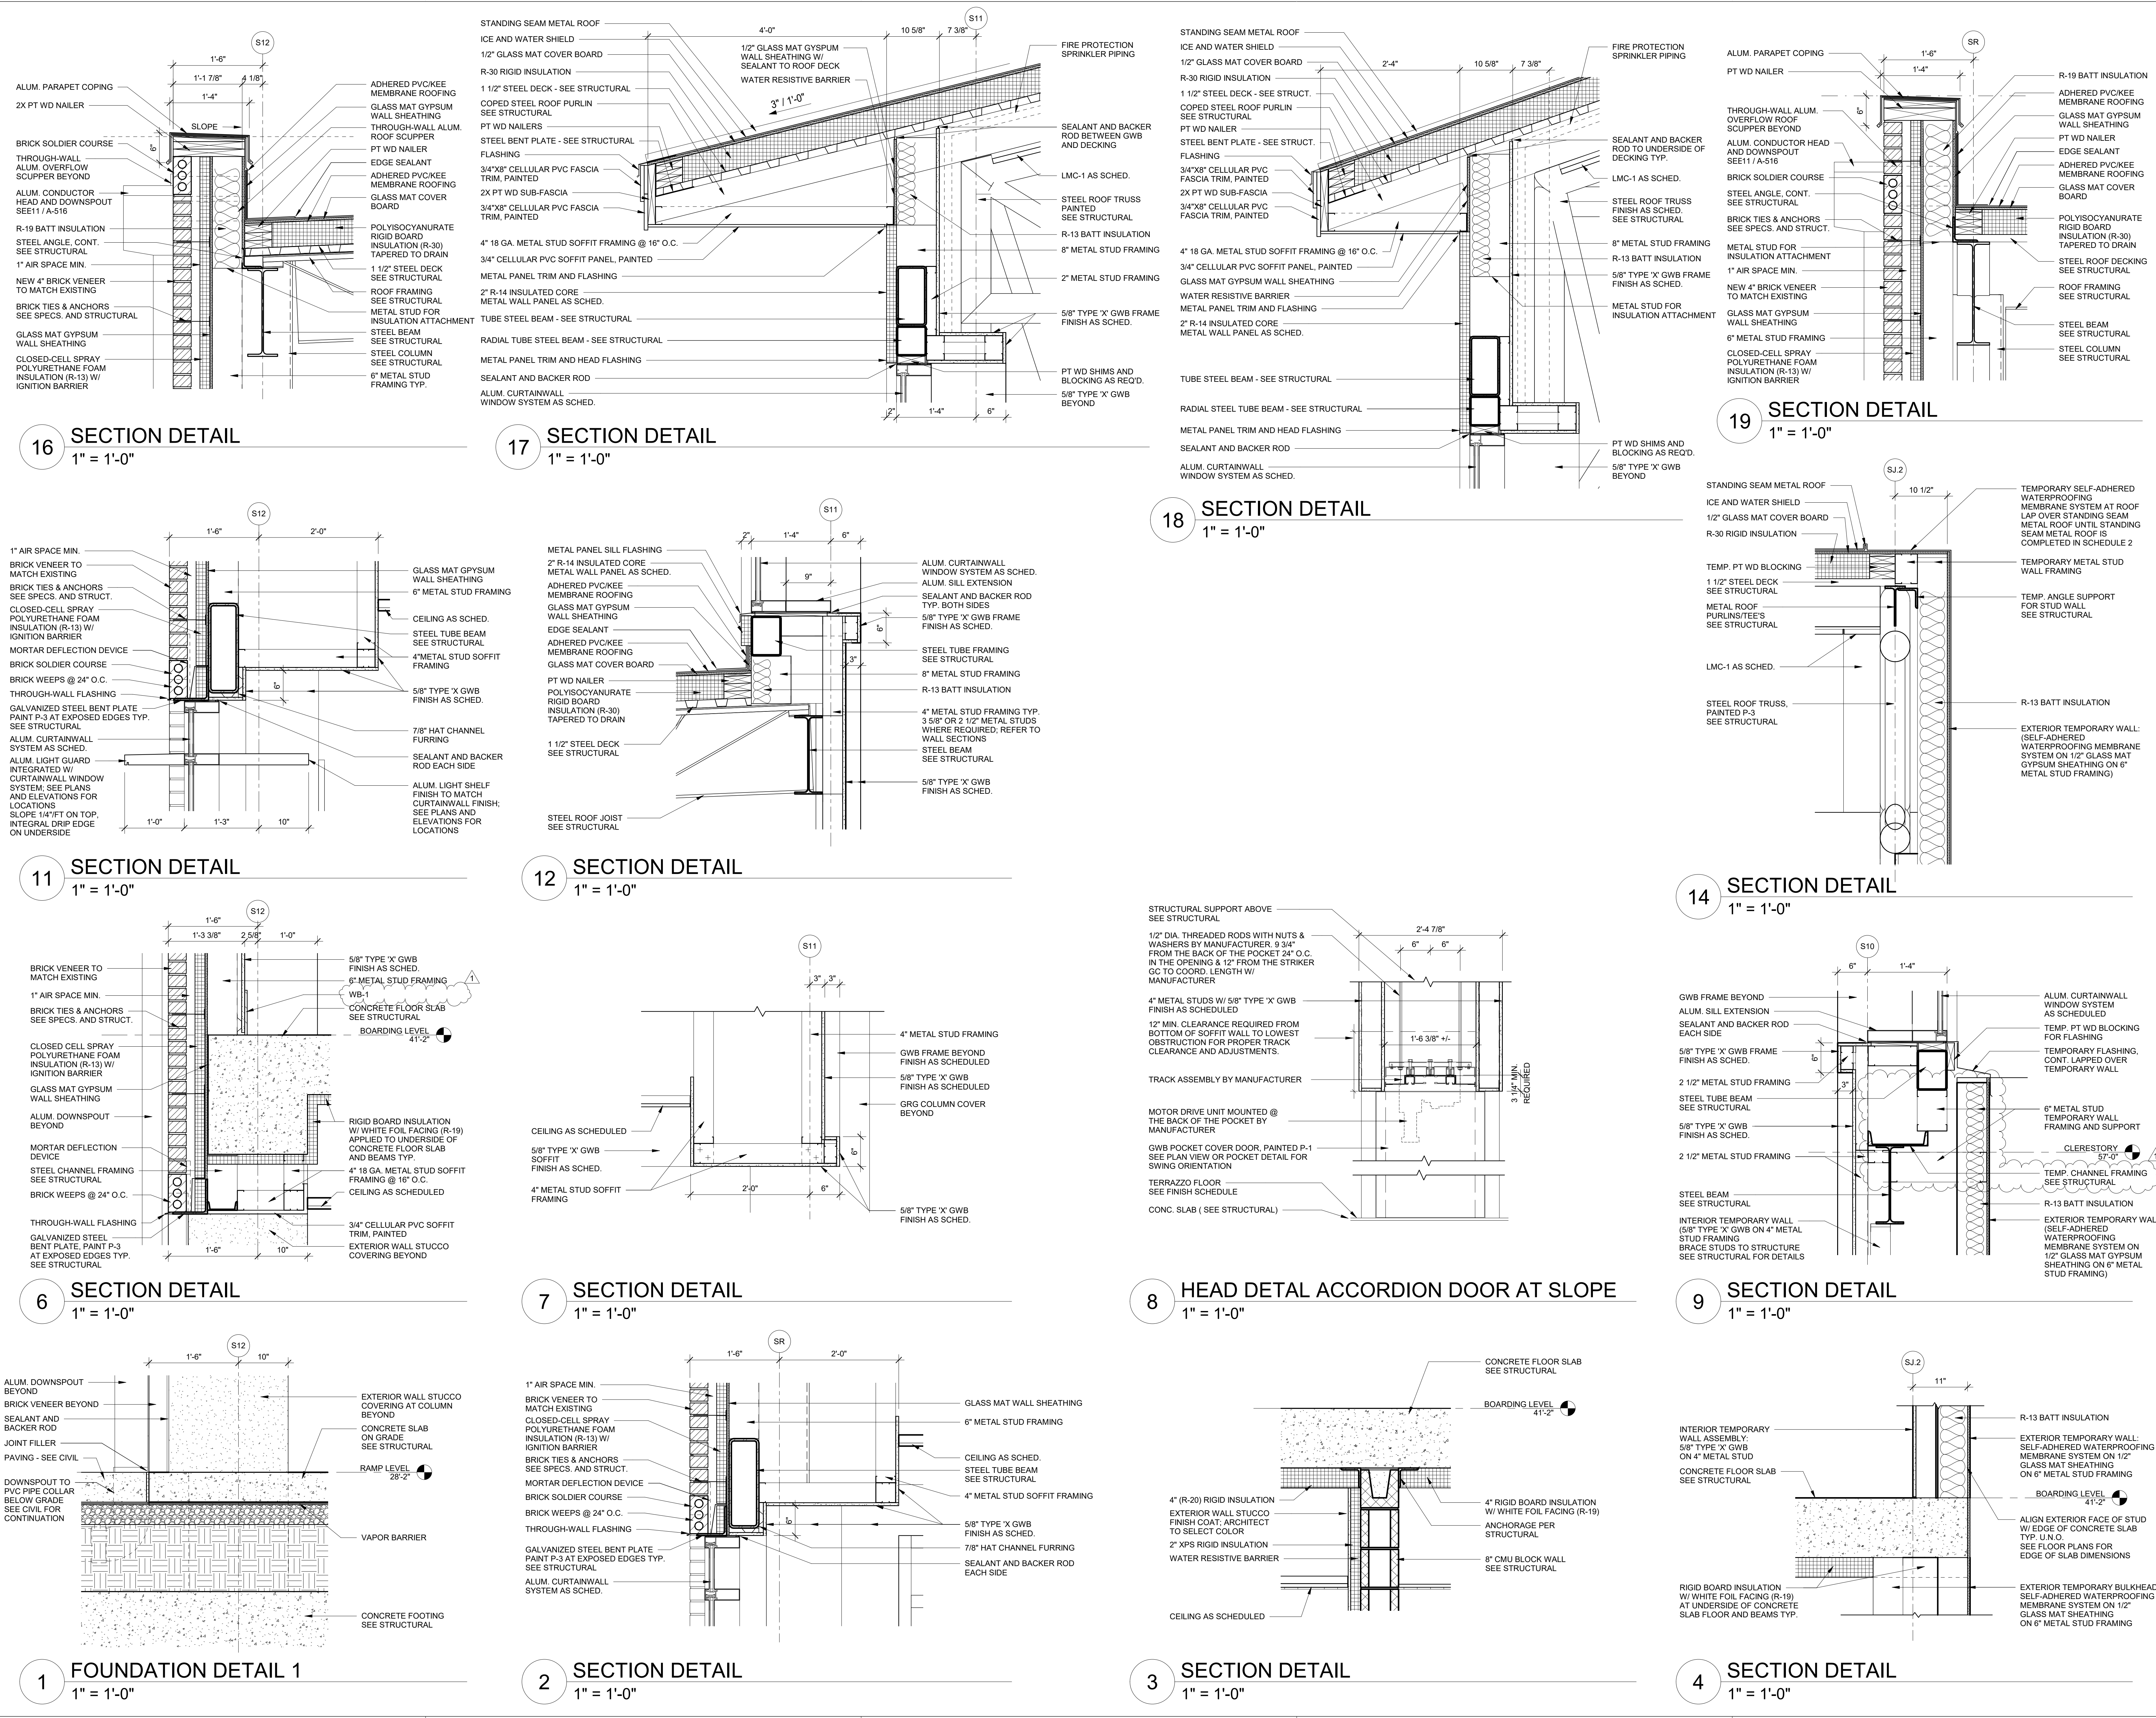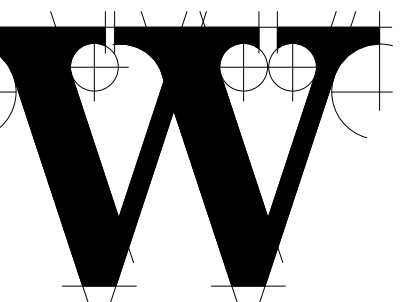


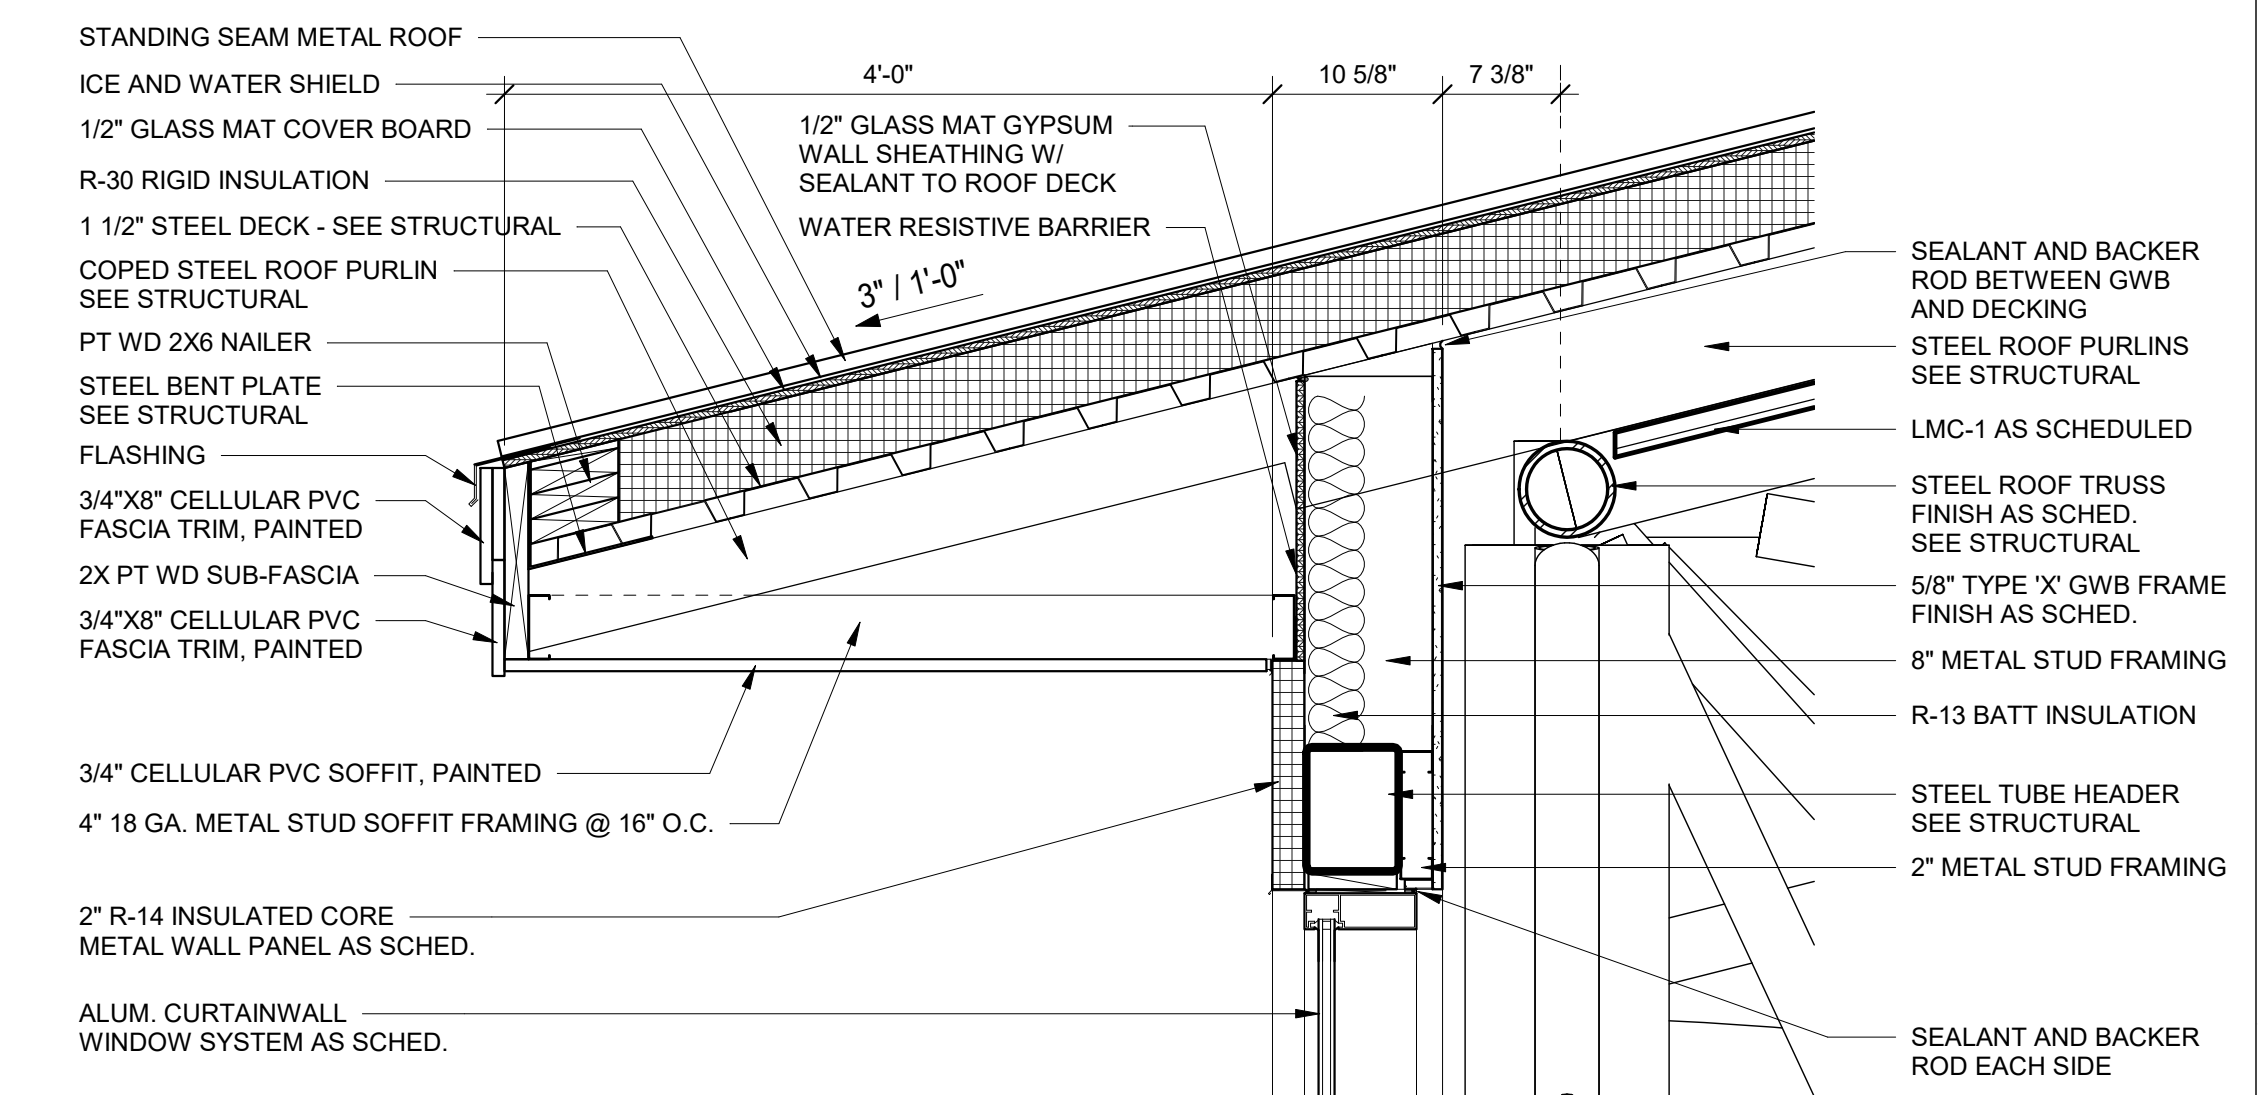


**19 SECTION DETAIL**  
1" = 1'-0"

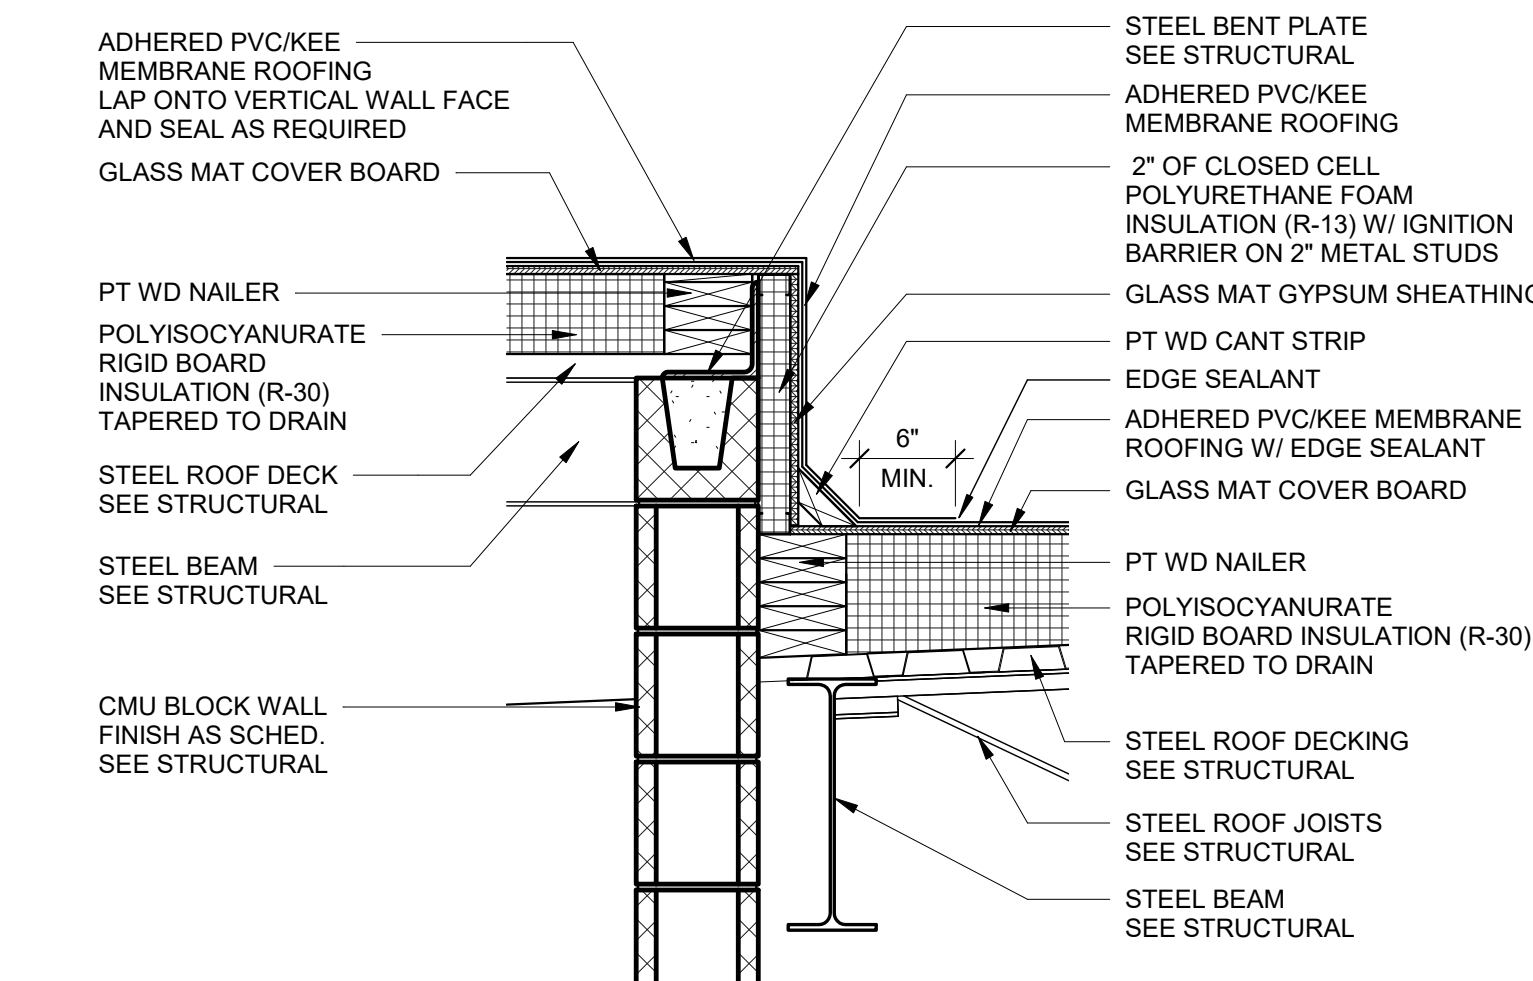


**17 SECTION DETAIL**  
1" = 1'-0"

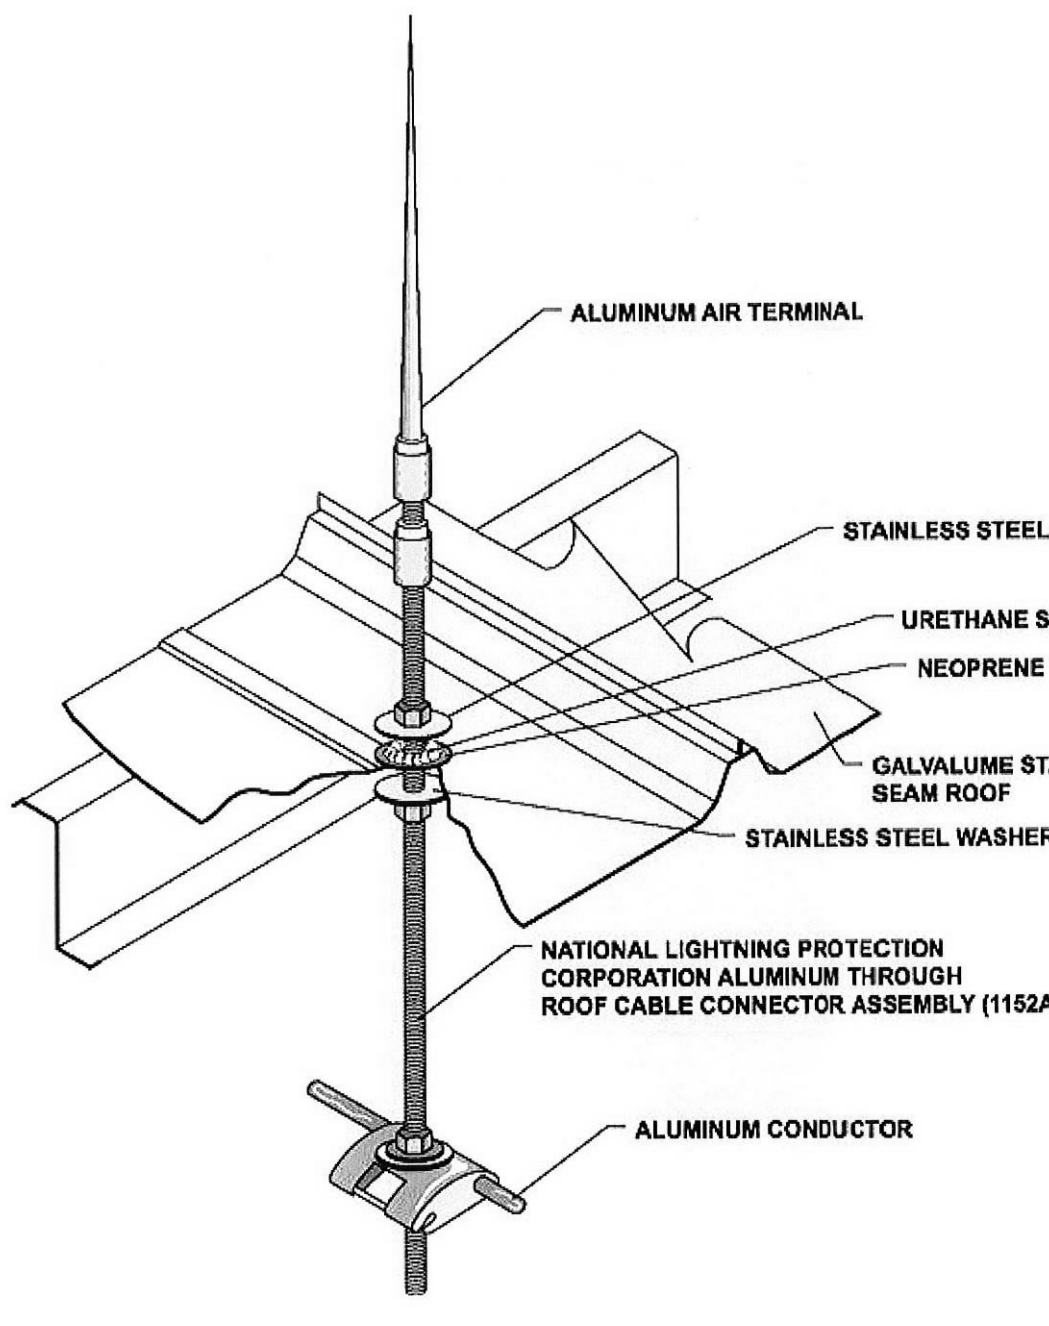


**13 LIGHTNING ARREST DETAIL**  
N.T.S.

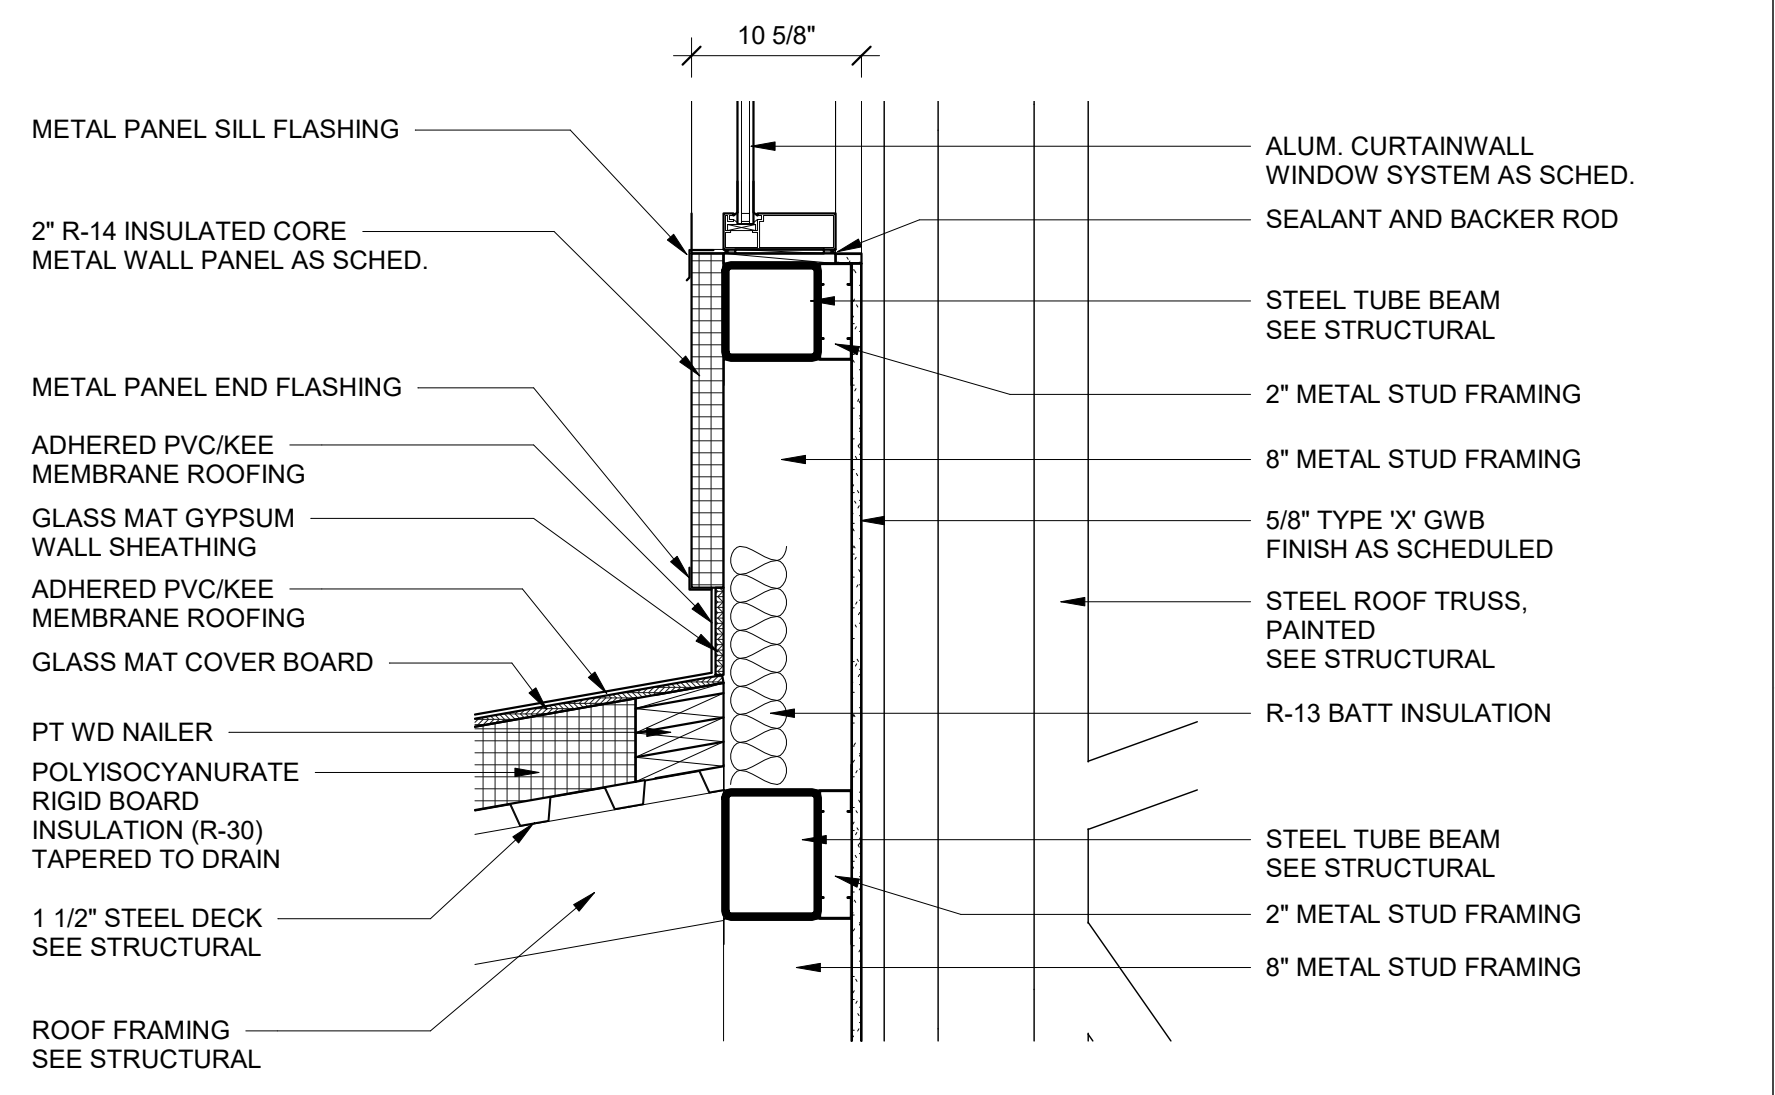


**14 ROOF DETAIL AT CUPOLA 1**  
1" = 1'-0"

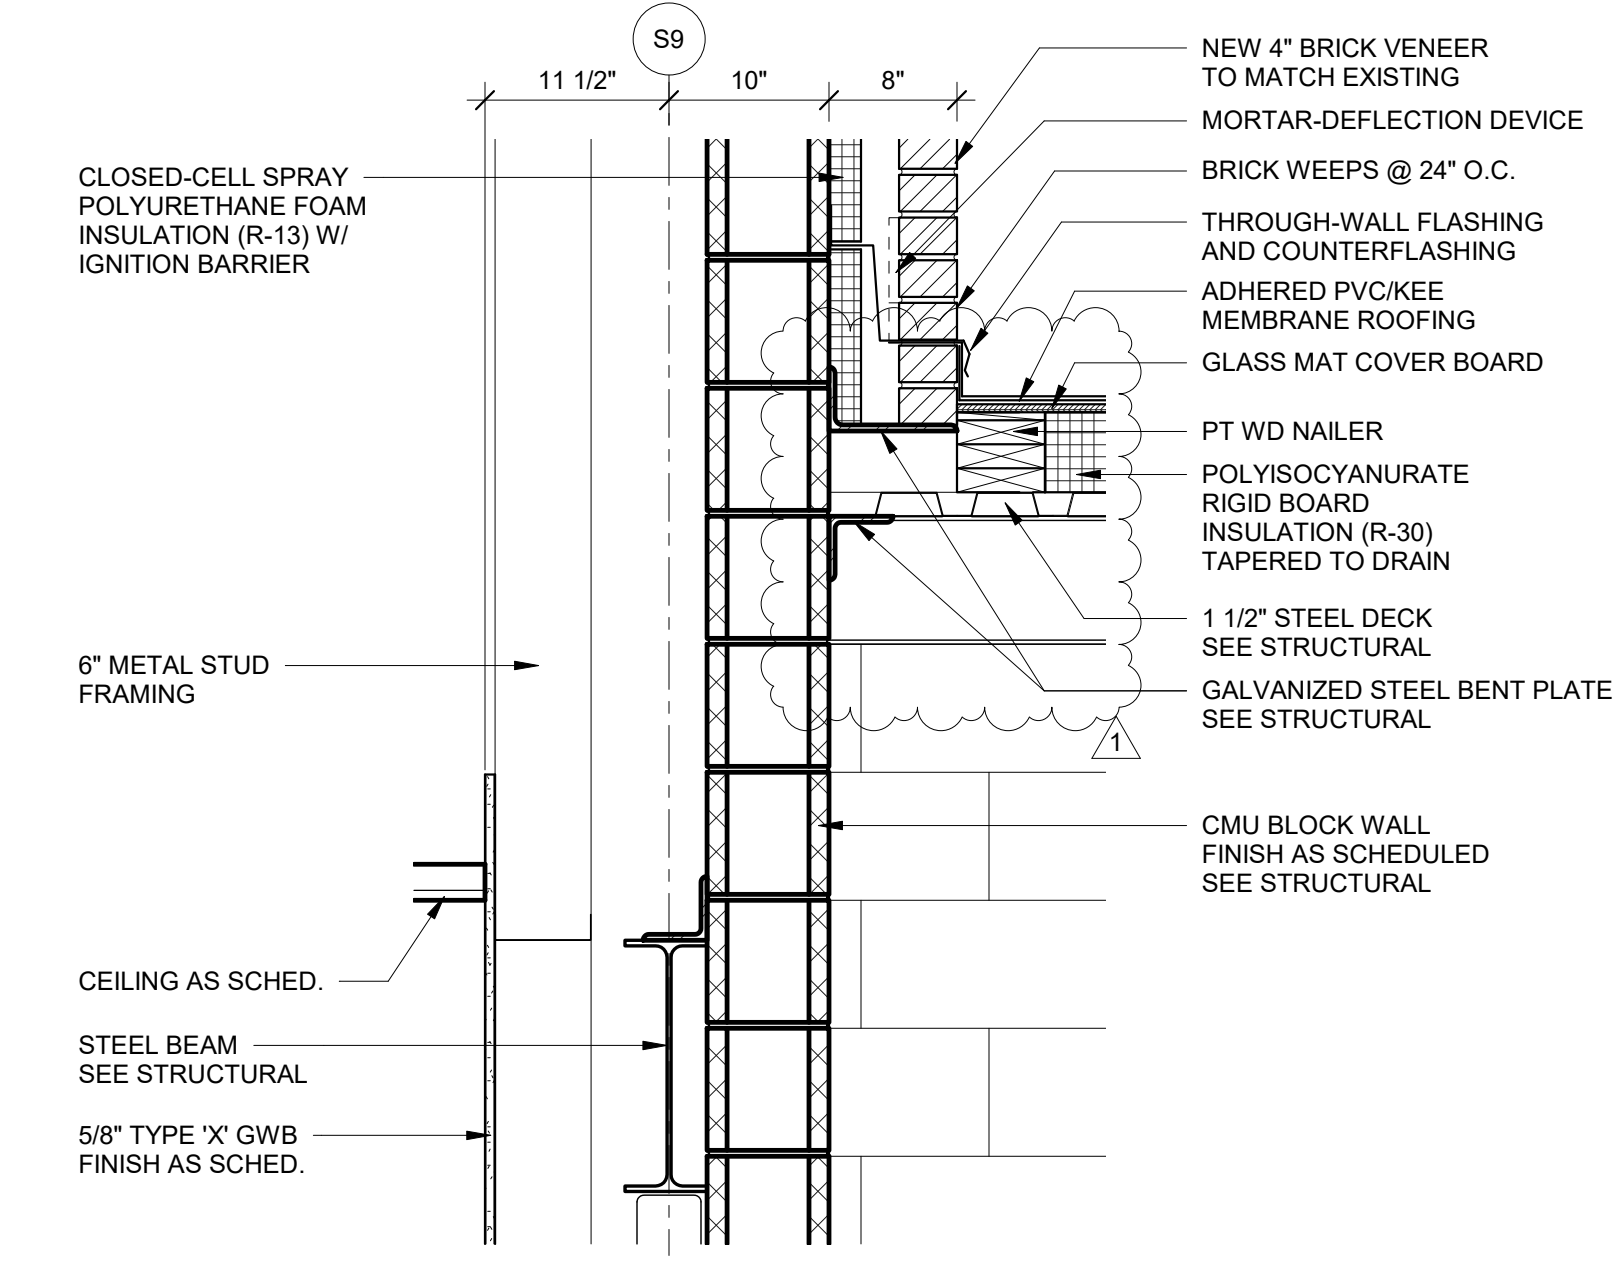


**12 SECTION DETAIL**  
1" = 1'-0"

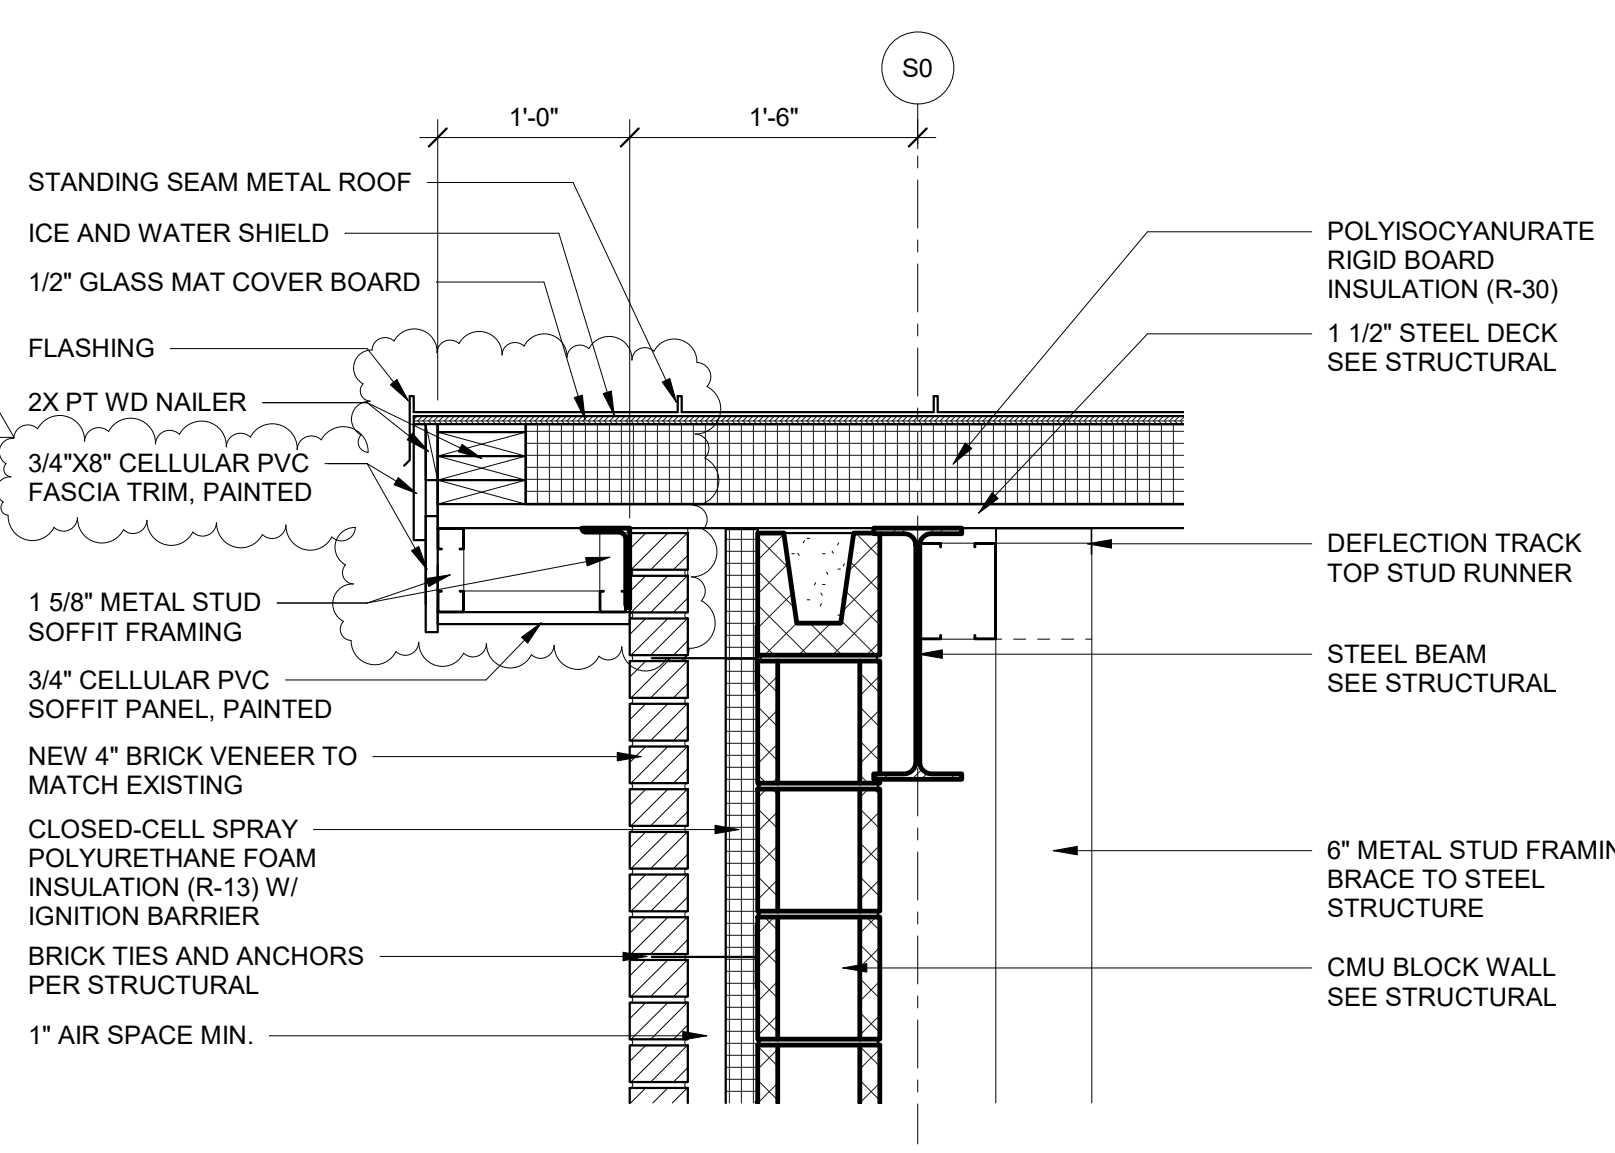


**11 SECTION DETAIL**  
1" = 1'-0"

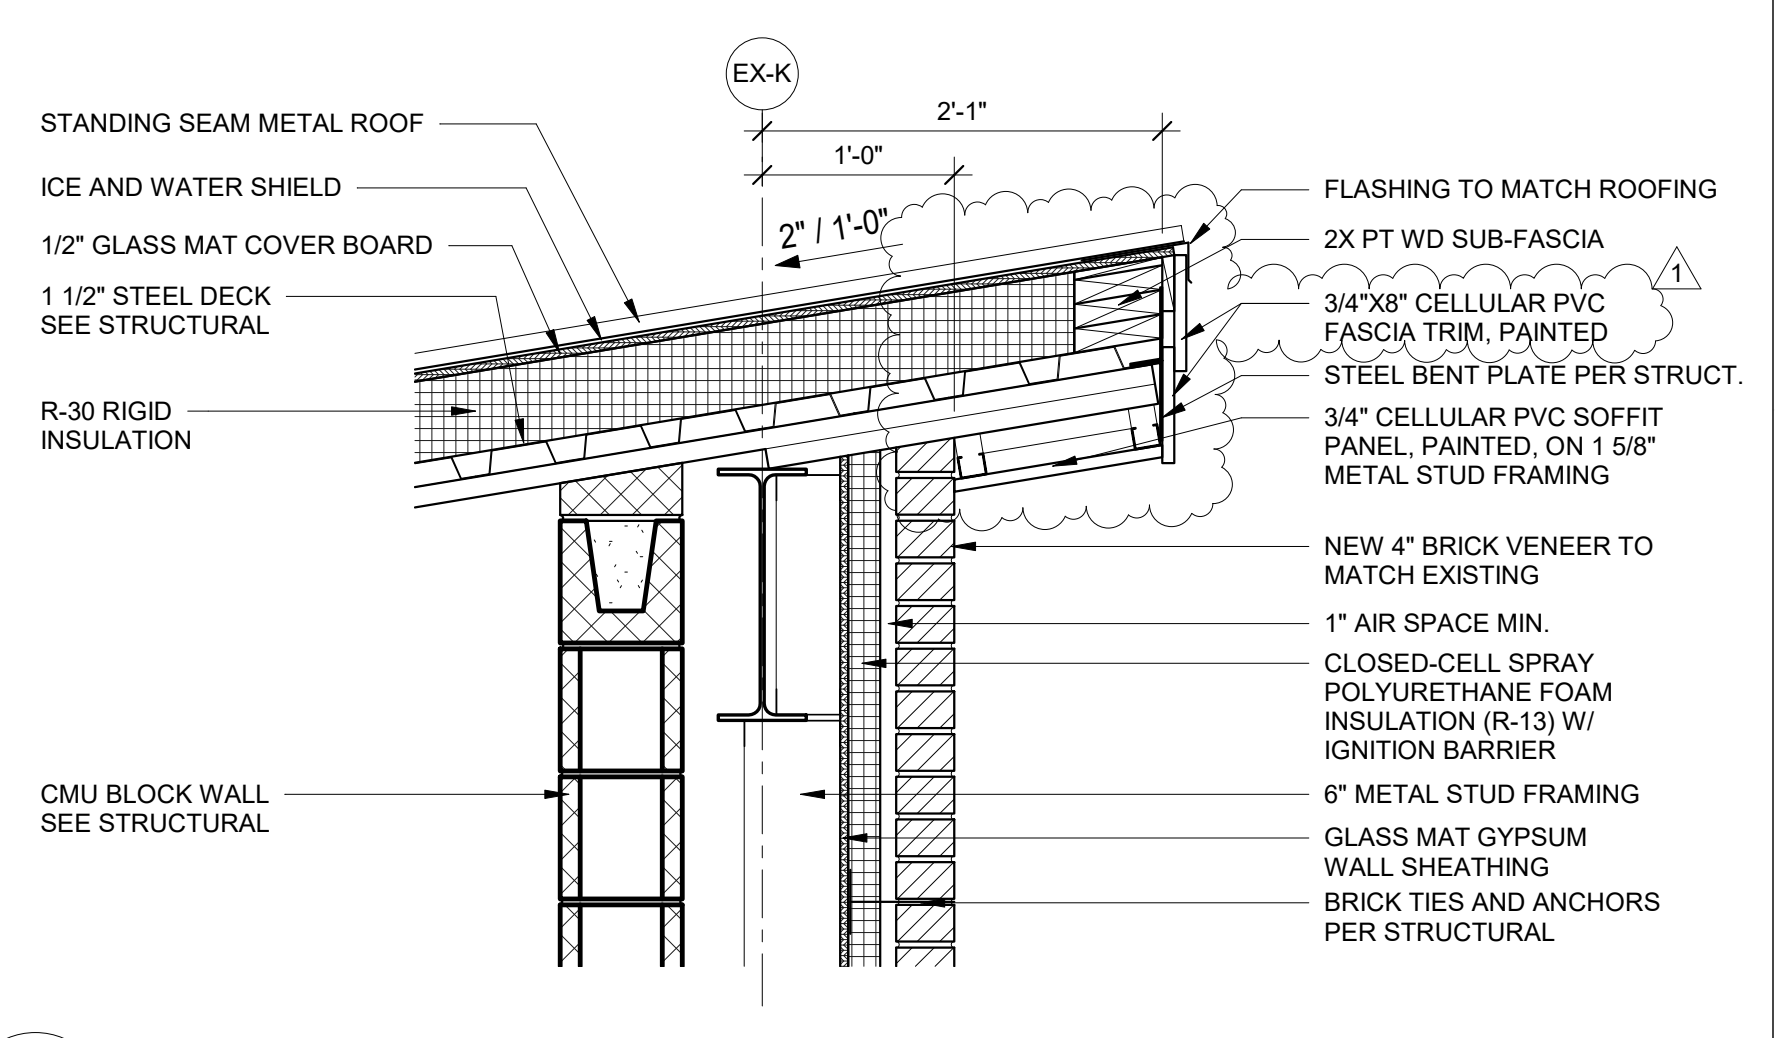


**9 SECTION DETAIL**  
1" = 1'-0"

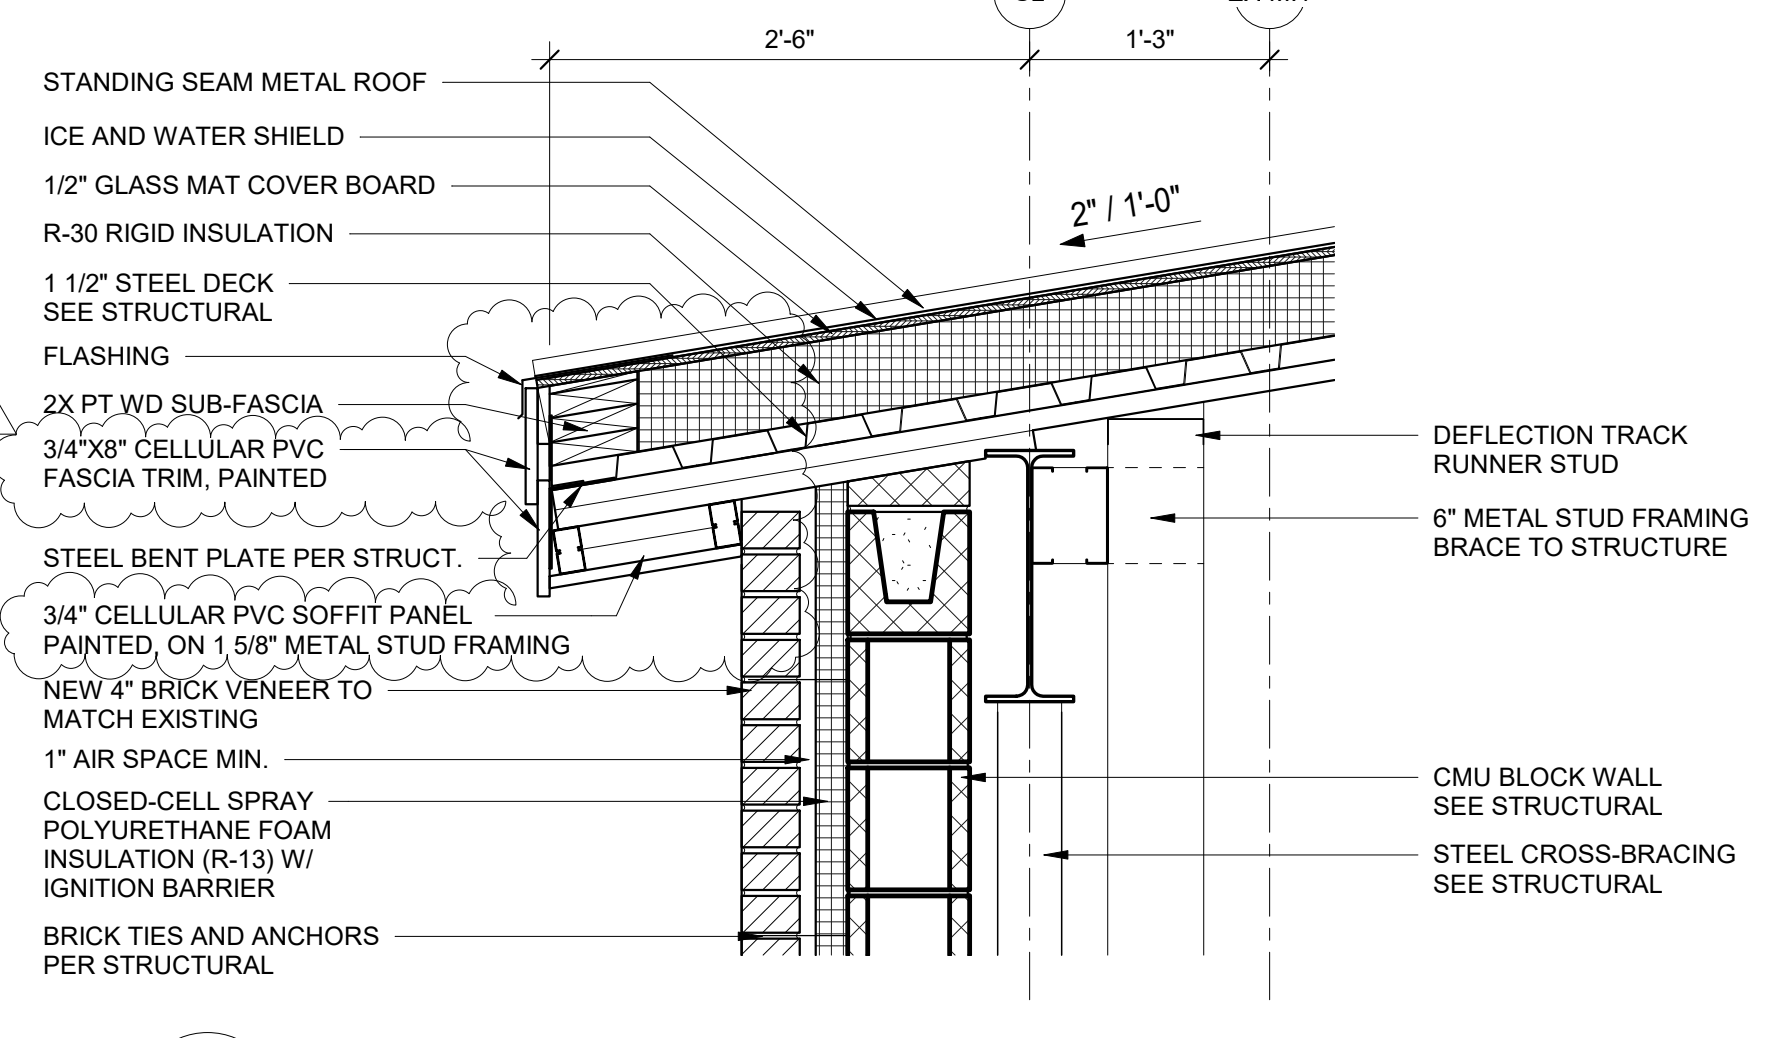


**8 SECTION DETAIL**  
1" = 1'-0"

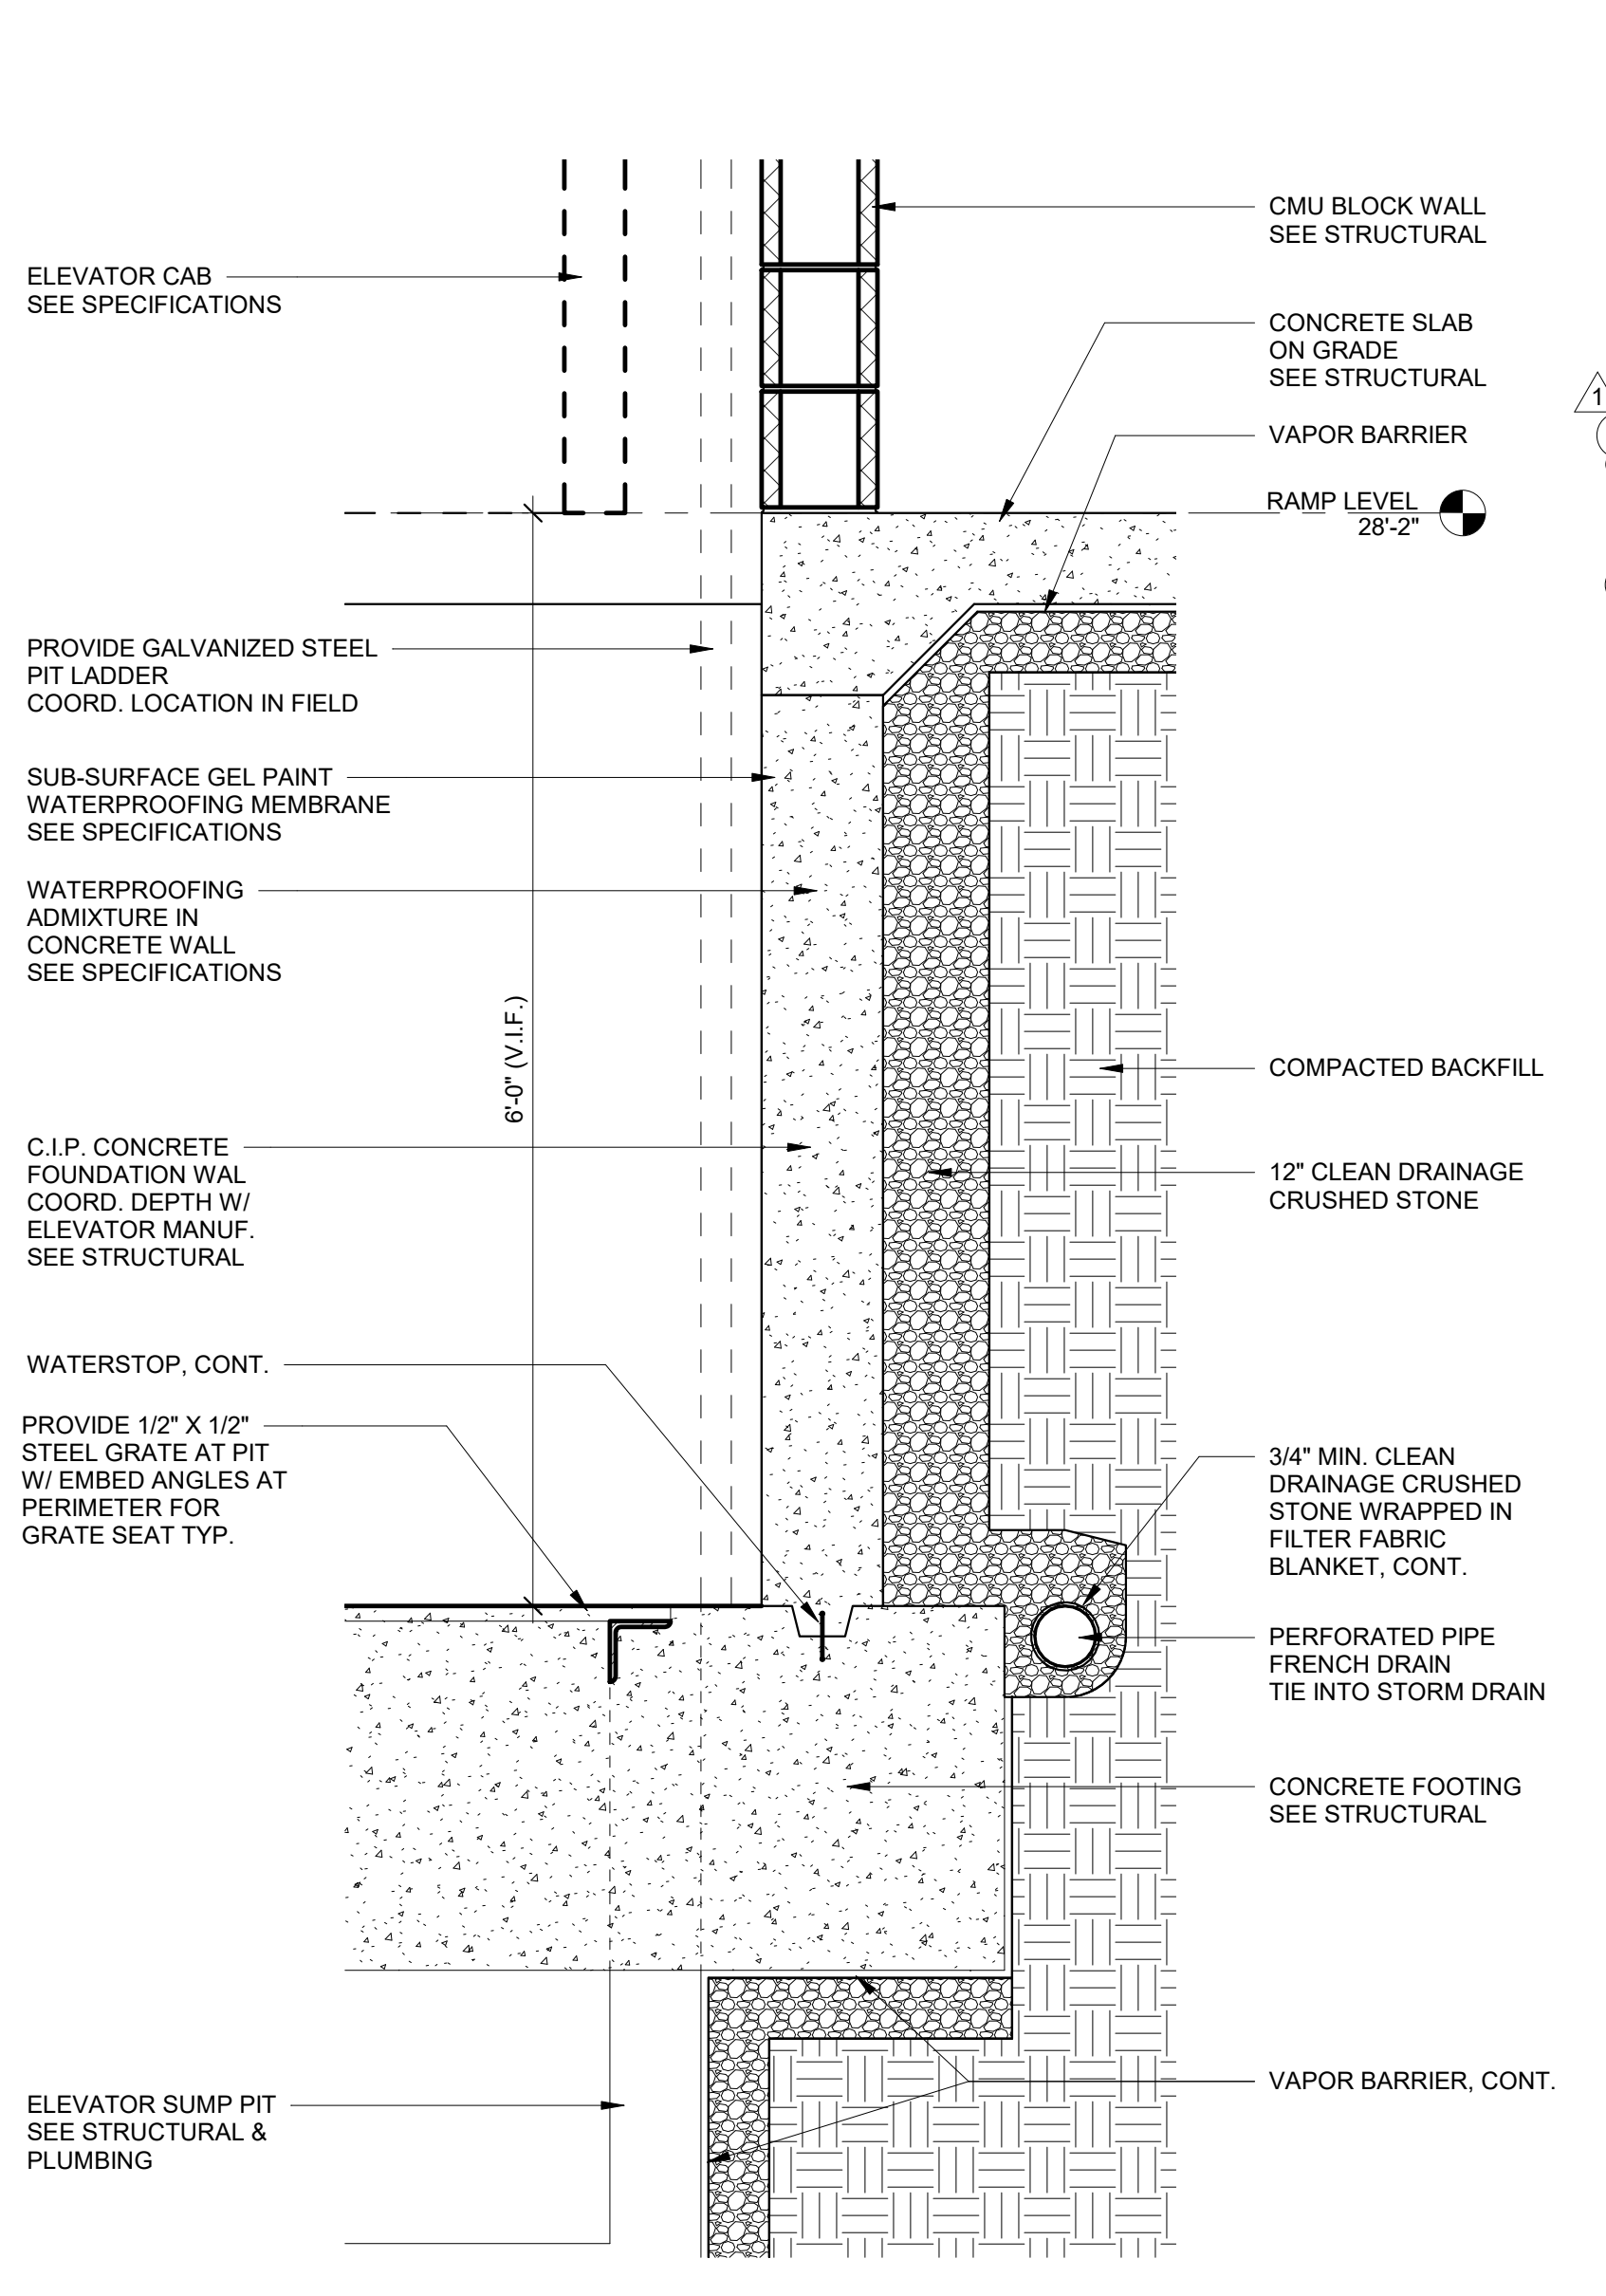


**2 SECTION DETAIL**  
1" = 1'-0"

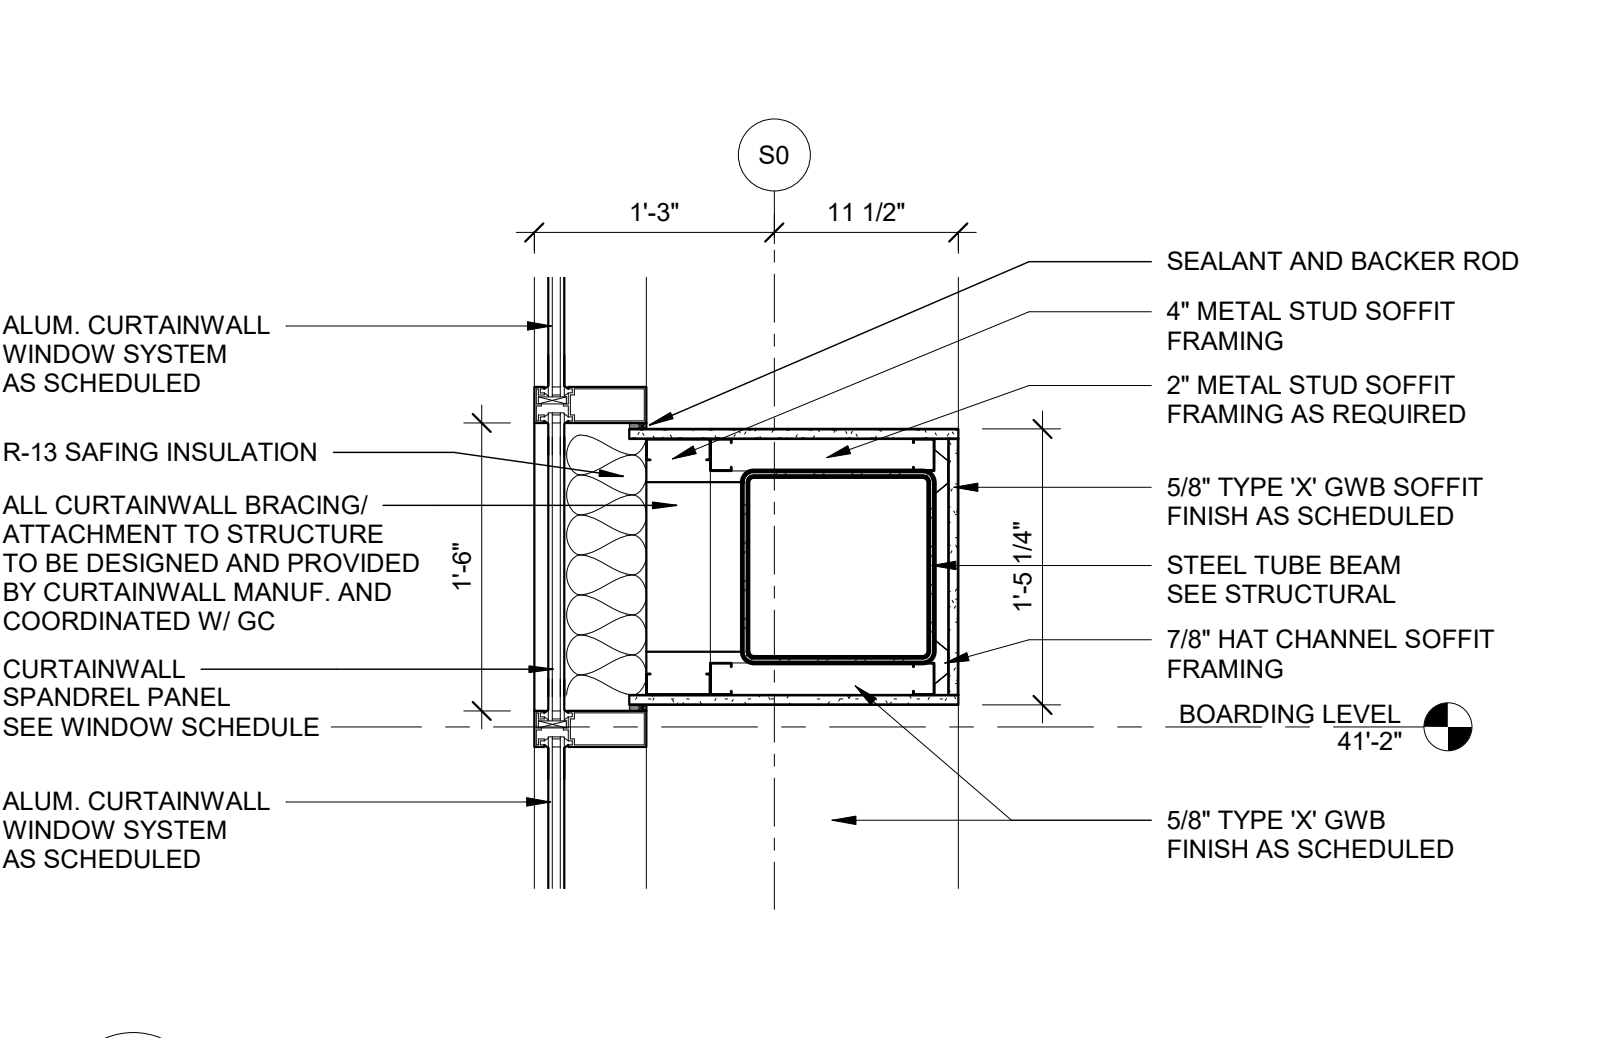


**6 SECTION DETAIL**  
1" = 1'-0"

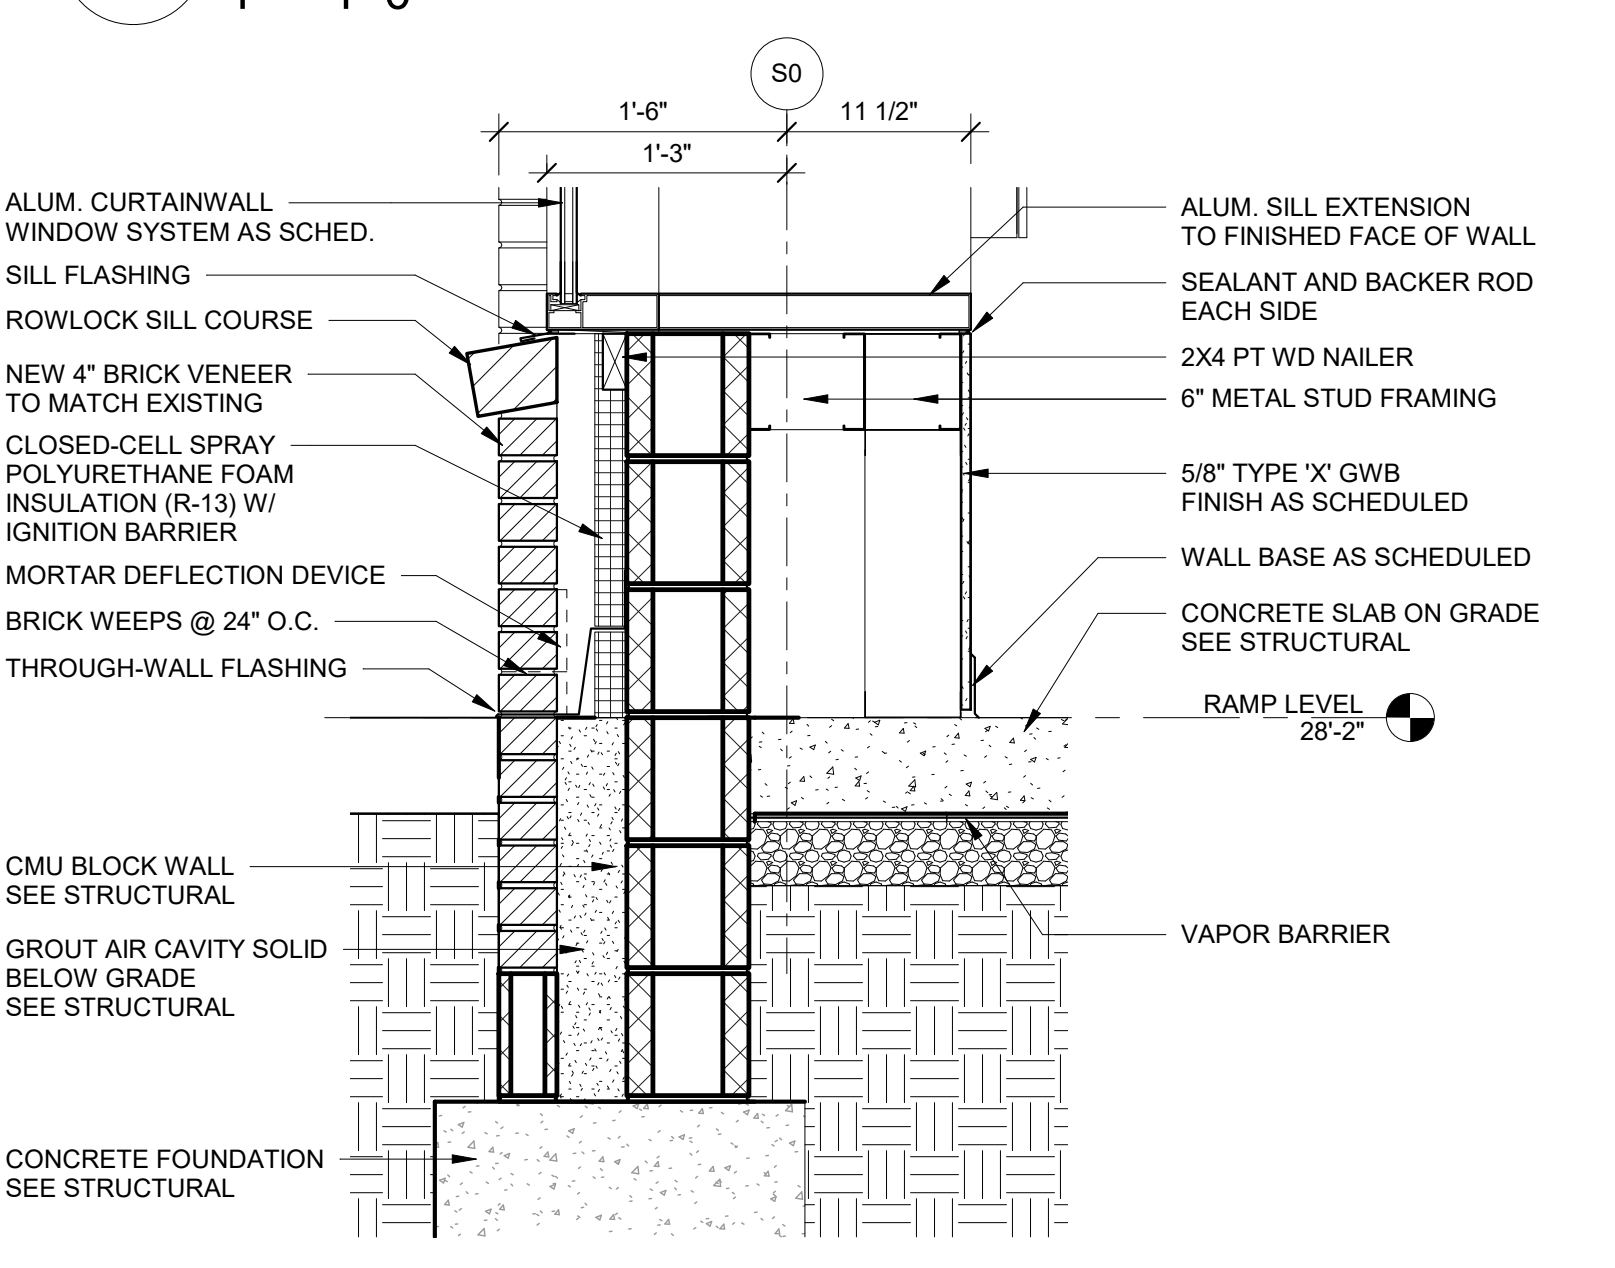


**1 SECTION DETAIL**  
1" = 1'-0"

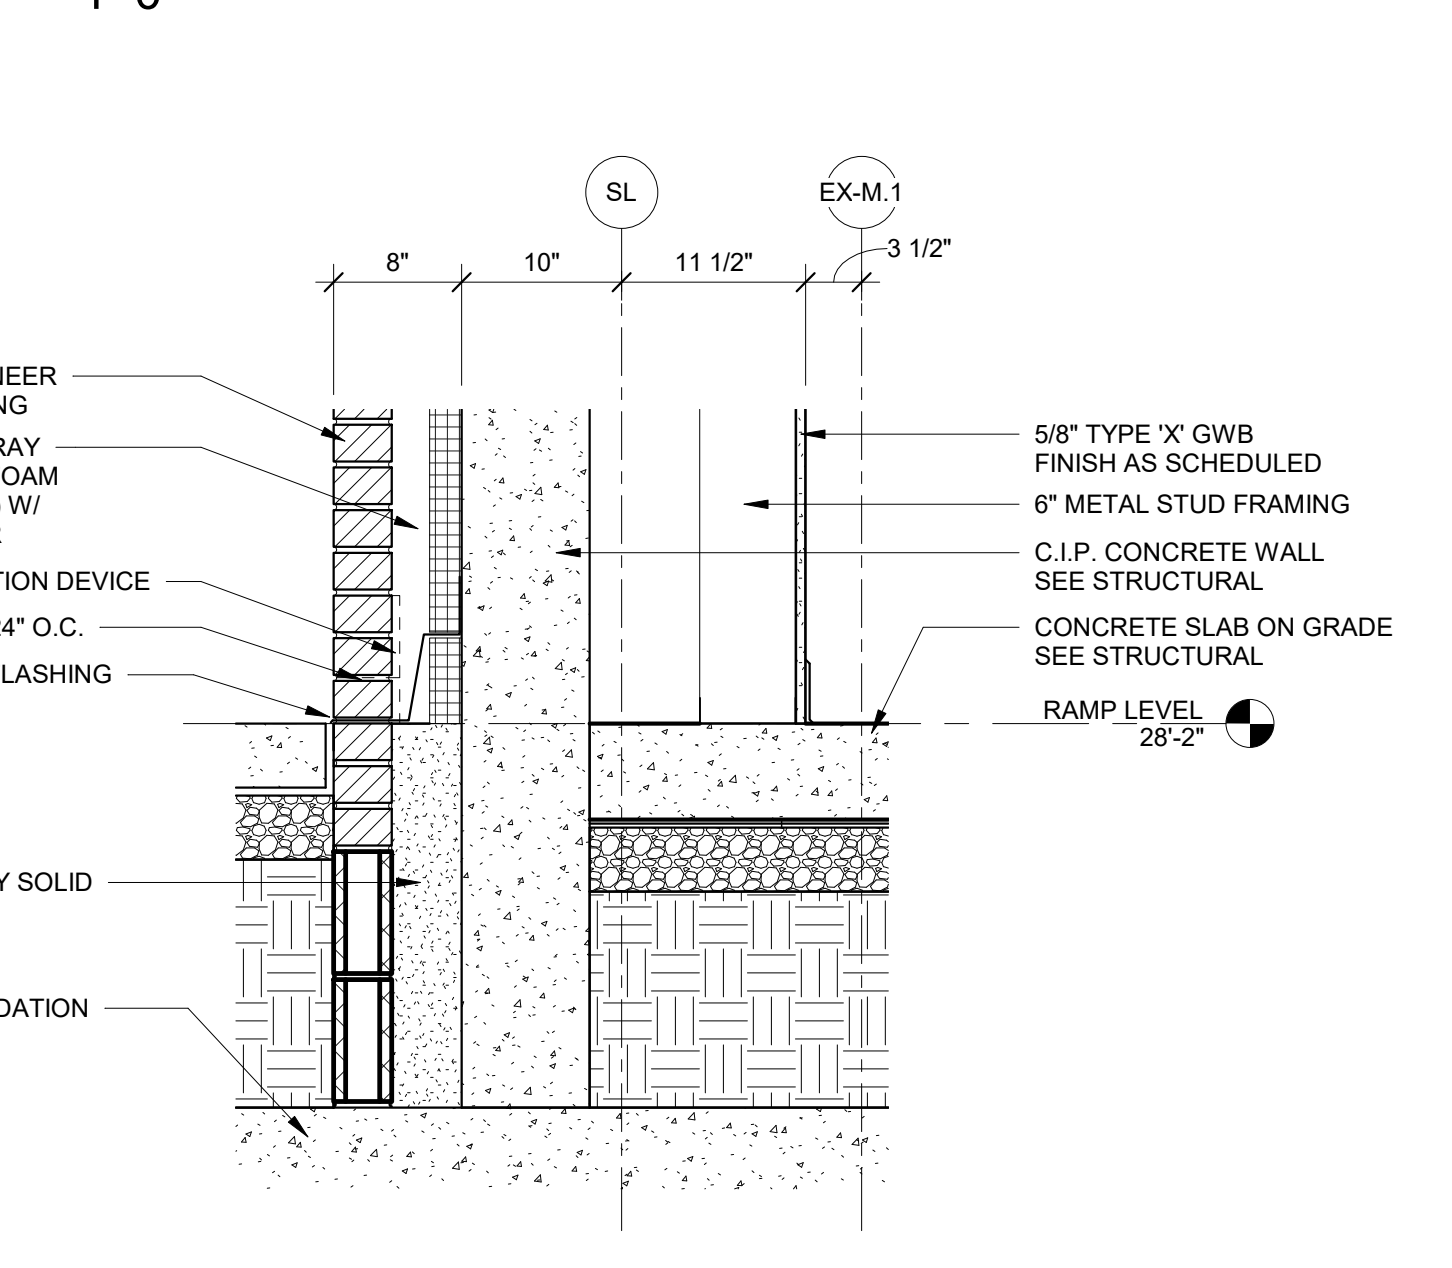

**3 SECTION DETAIL**  
1" = 1'-0"

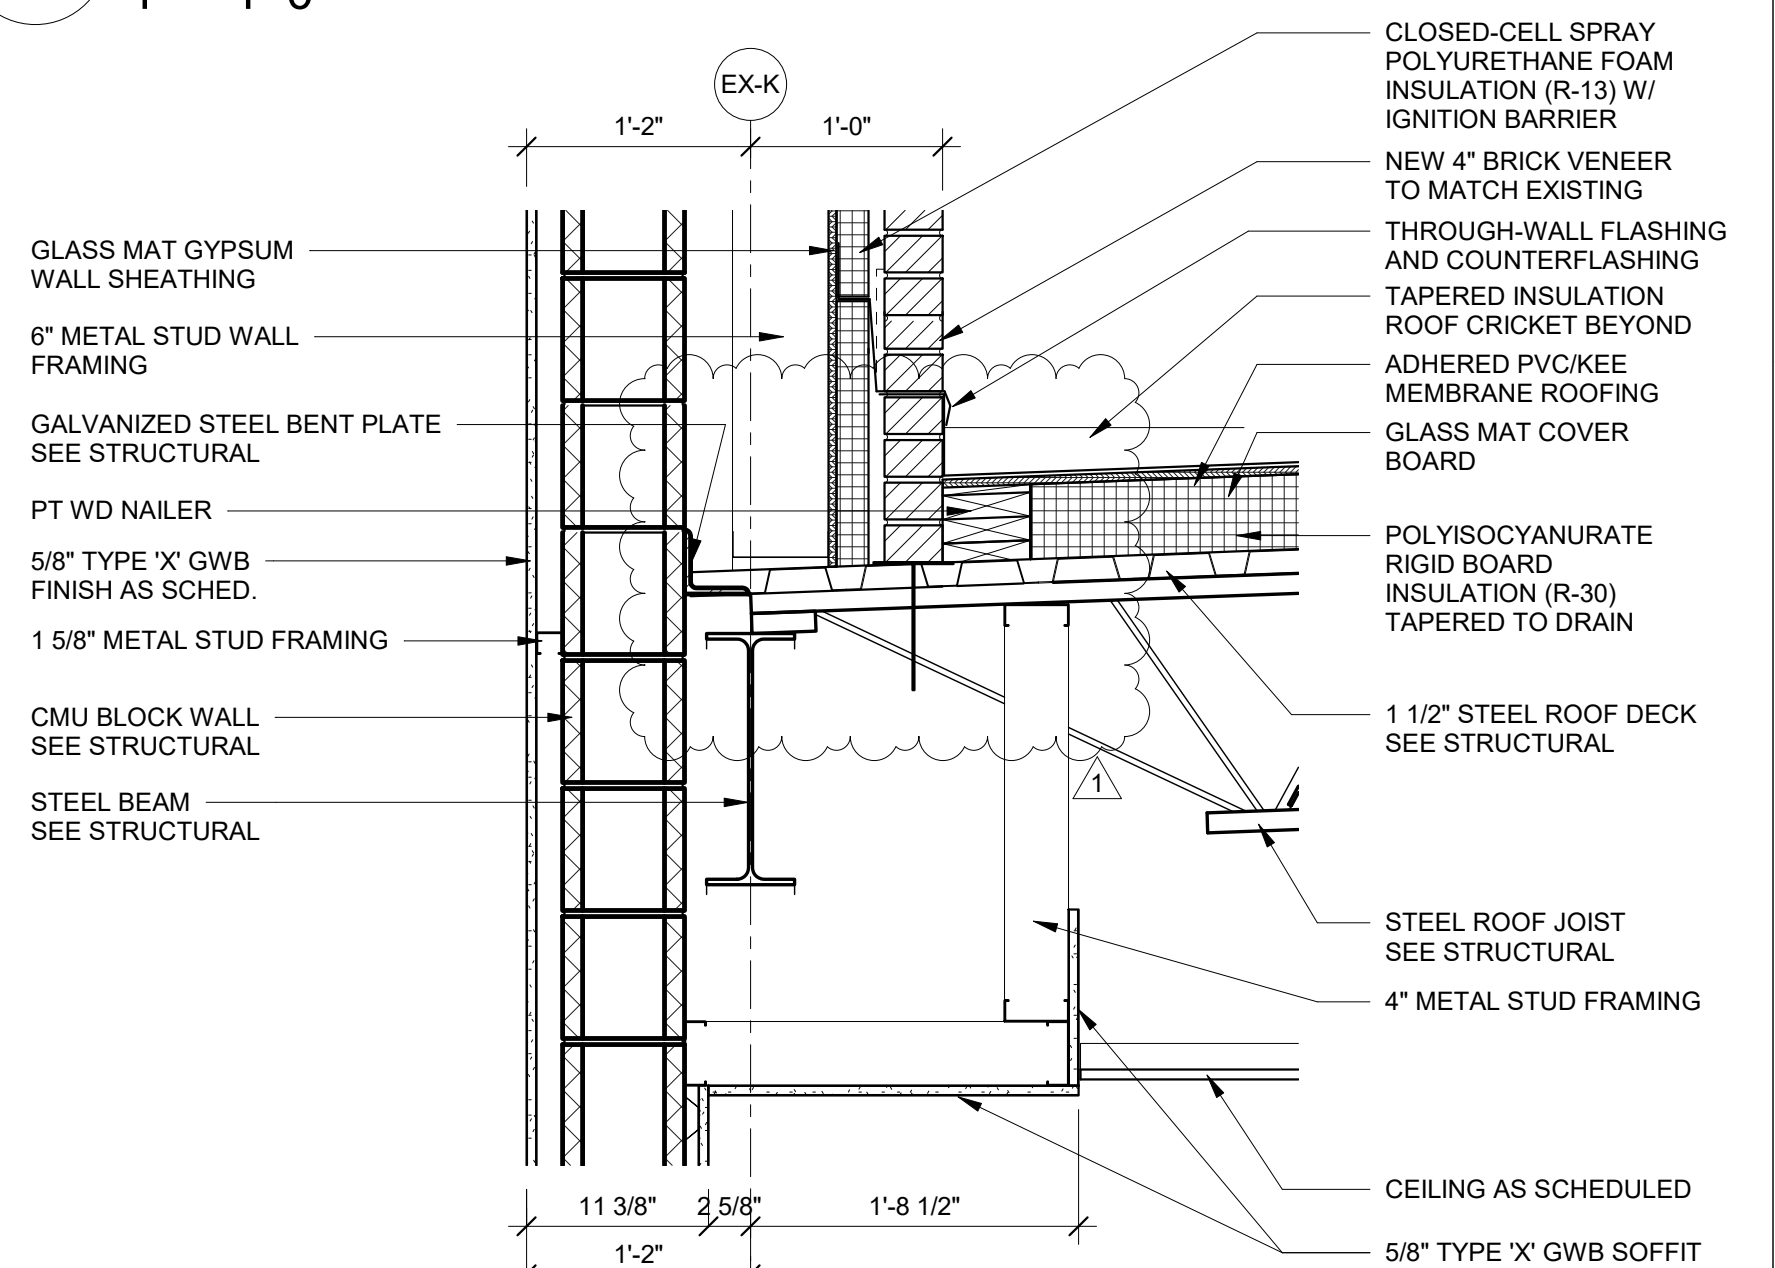

**4 SECTION DETAIL**  
1" = 1'-0"

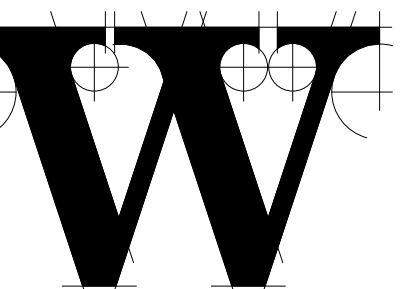

**THE WILSON GROUP**  
- ARCHITECTS -

PO Box 5510 Charlotte, NC 28299  
704-331-9747 • www.twgarchitects.com

PROJECT MANAGER & CIVIL ENGINEER  
**TALBERT & BRIGHT**  
CONSULTING ARCHITECT  
LS3P

STRUCTURAL ENGINEER  
**STEWART**

FP/PM/E ENGINEER  
**CHEATHAM & ASSOC.**

BAGGAGE HANDLING CONSULTANTS  
**BNP**

AIRCRAFT SUPPORT SYSTEMS  
**DK CONSULTANTS**

SPECIALTY LIGHTING CONSULTANT  
**HARTRANFT**

SIGNAGE & WAYFINDING  
**TAKEFORM**








COPYRIGHT © 2019  
THE WILSON GROUP ARCHITECTS  
ALL RIGHTS RESERVED  
PRINTED OR ELECTRONIC DRAWINGS AND DOCUMENTATION MAY NOT BE REPRODUCED IN ANY FORM WITHOUT WRITTEN PERMISSION FROM THE WILSON GROUP ARCHITECTS

REVISIONS  
1 7/30/2019 AD-03


DATE 6/28/2019  
PROJECT NUMBER 9202-000  
SHEET TITLE

**TYPICAL SOFFIT DETAILS**

SHEET NUMBER  
**A-518**

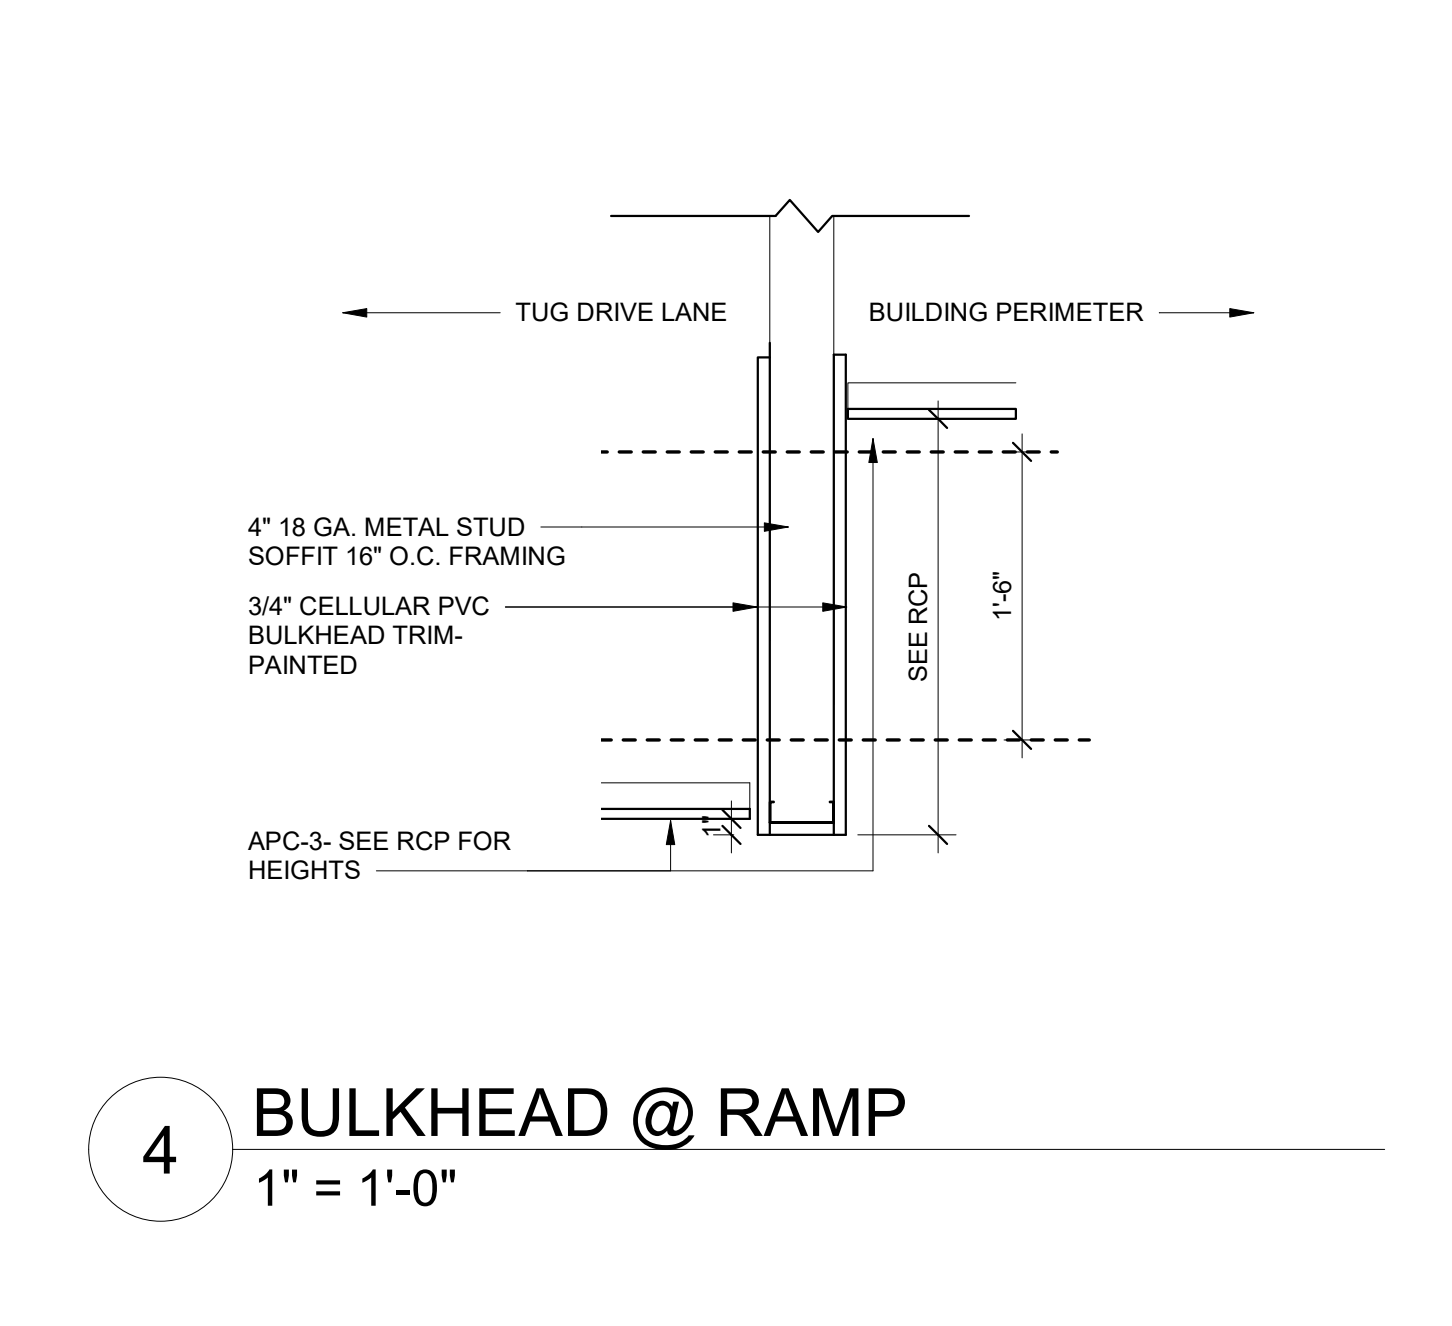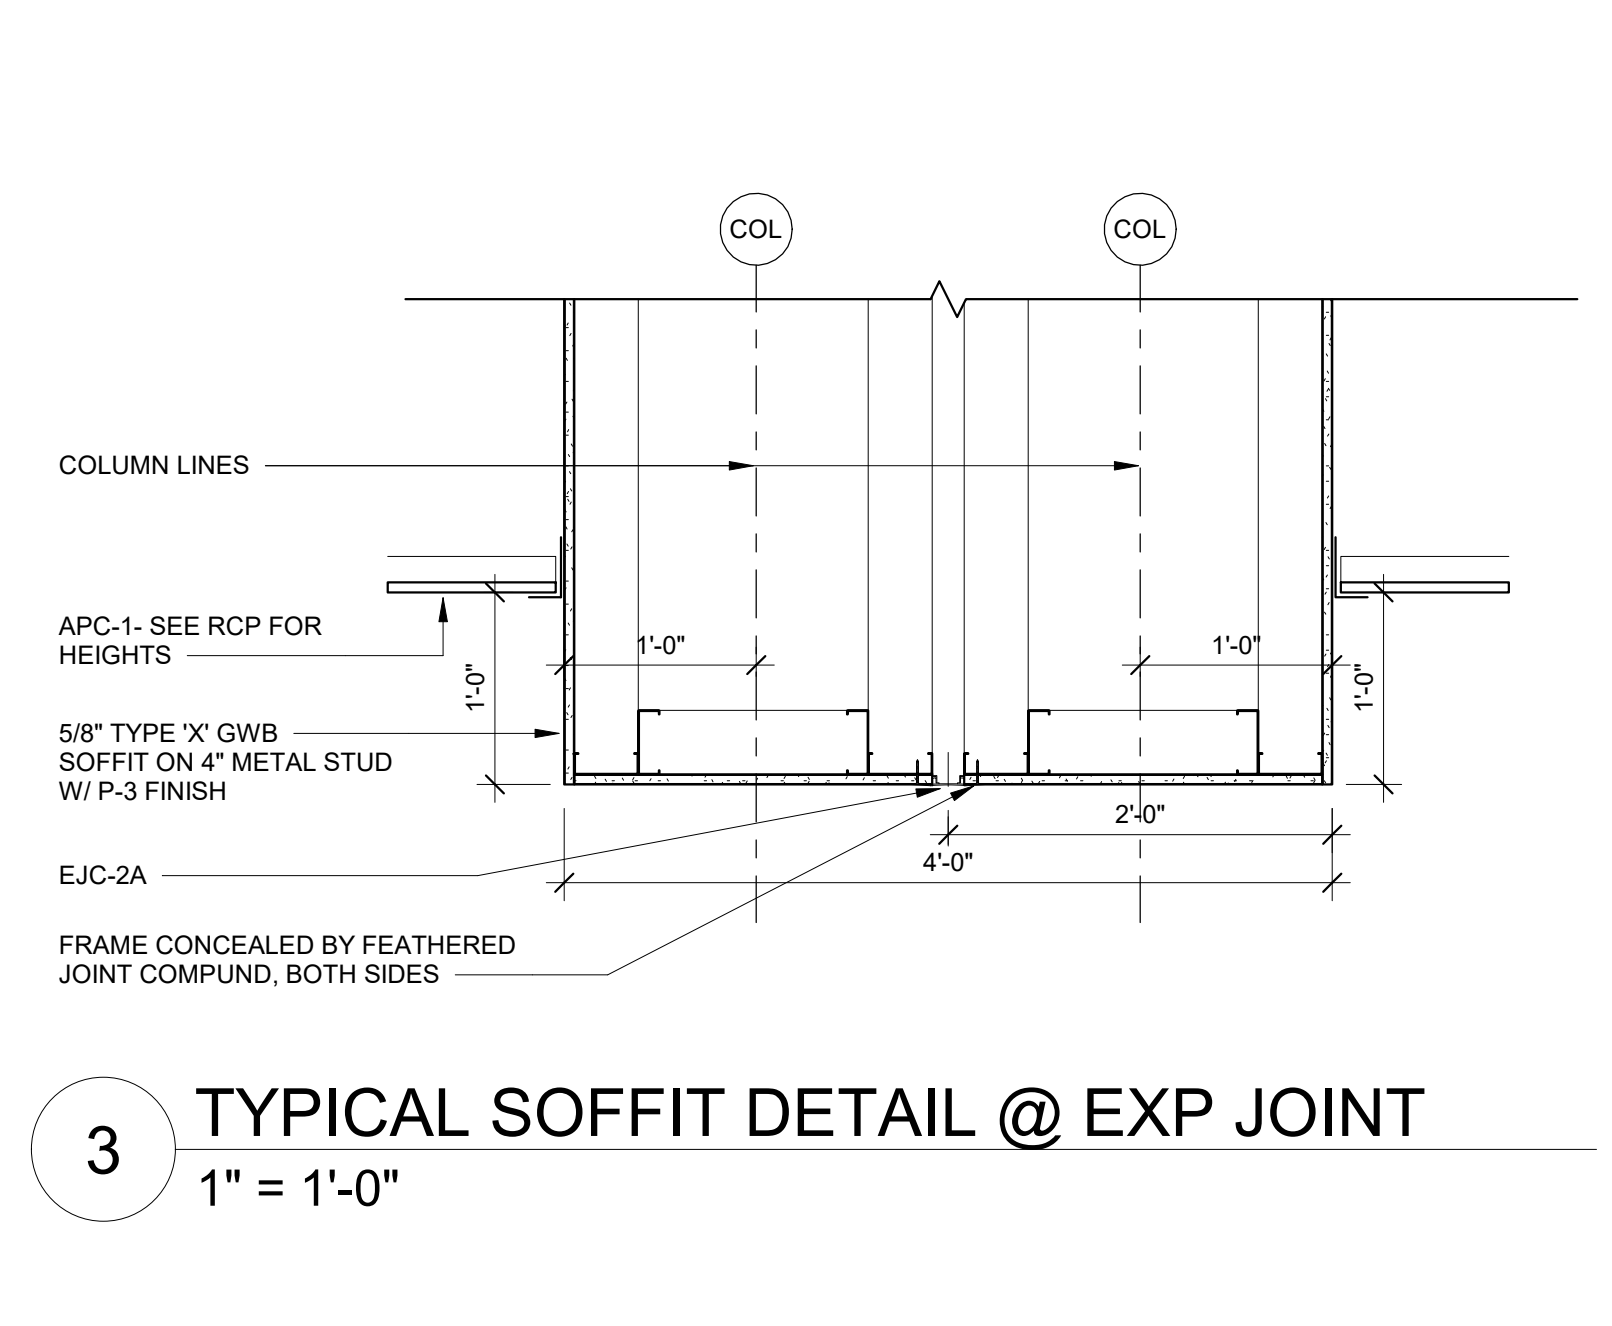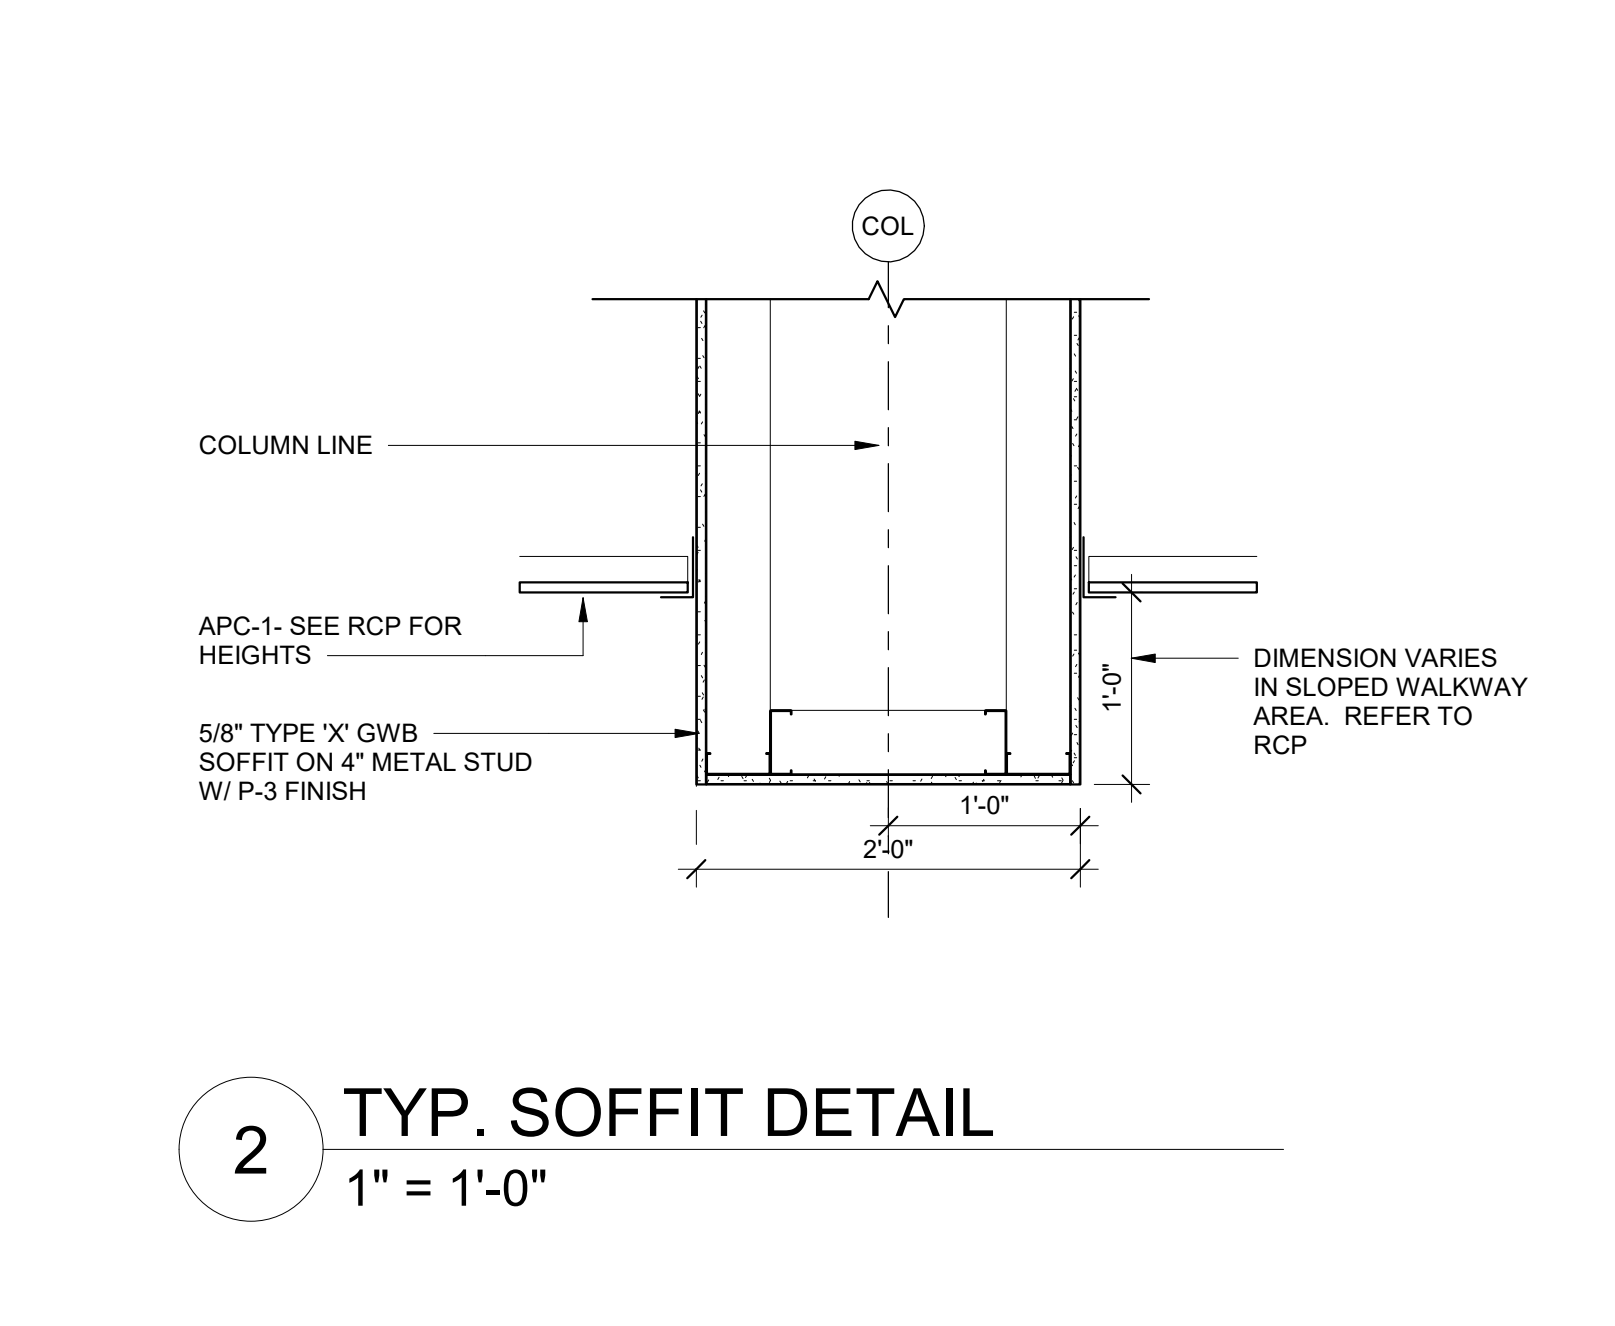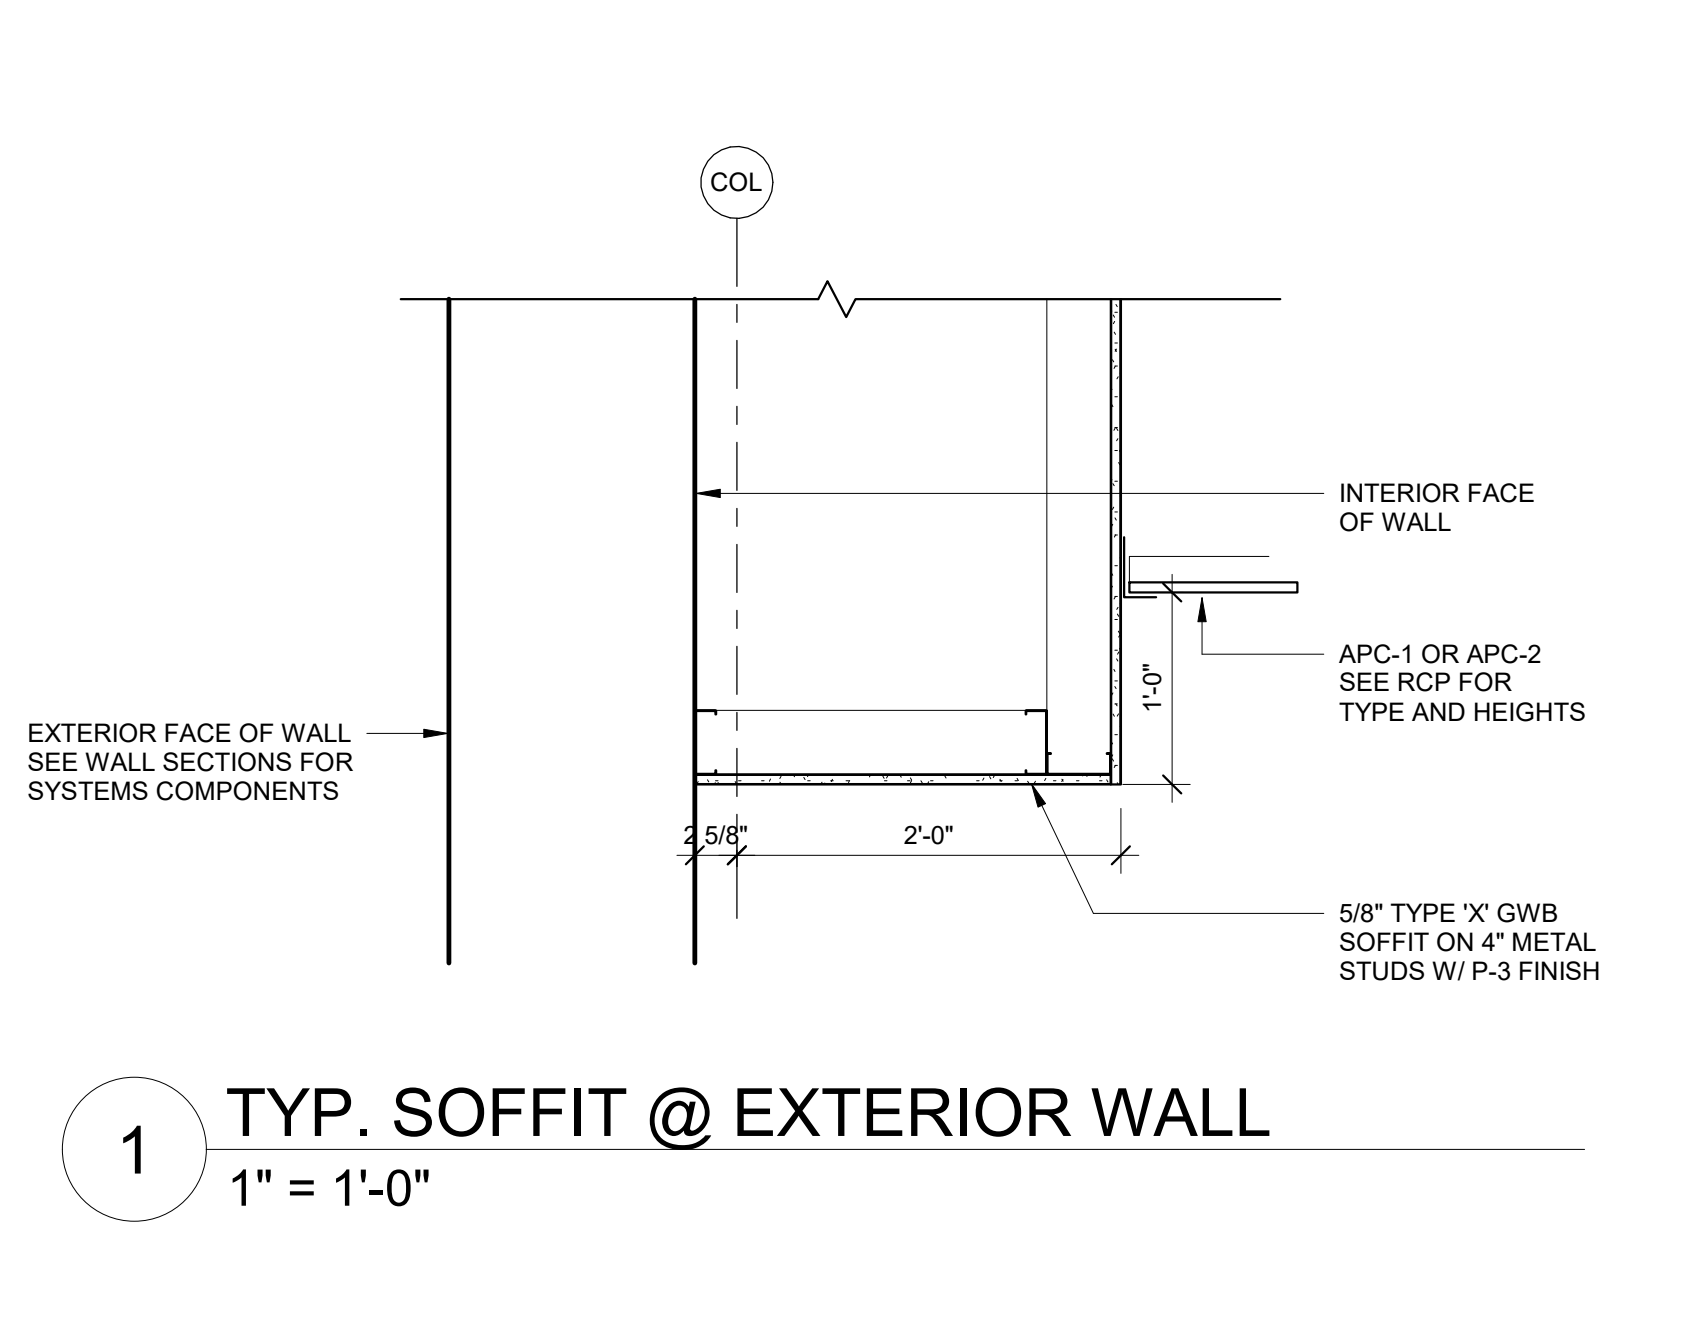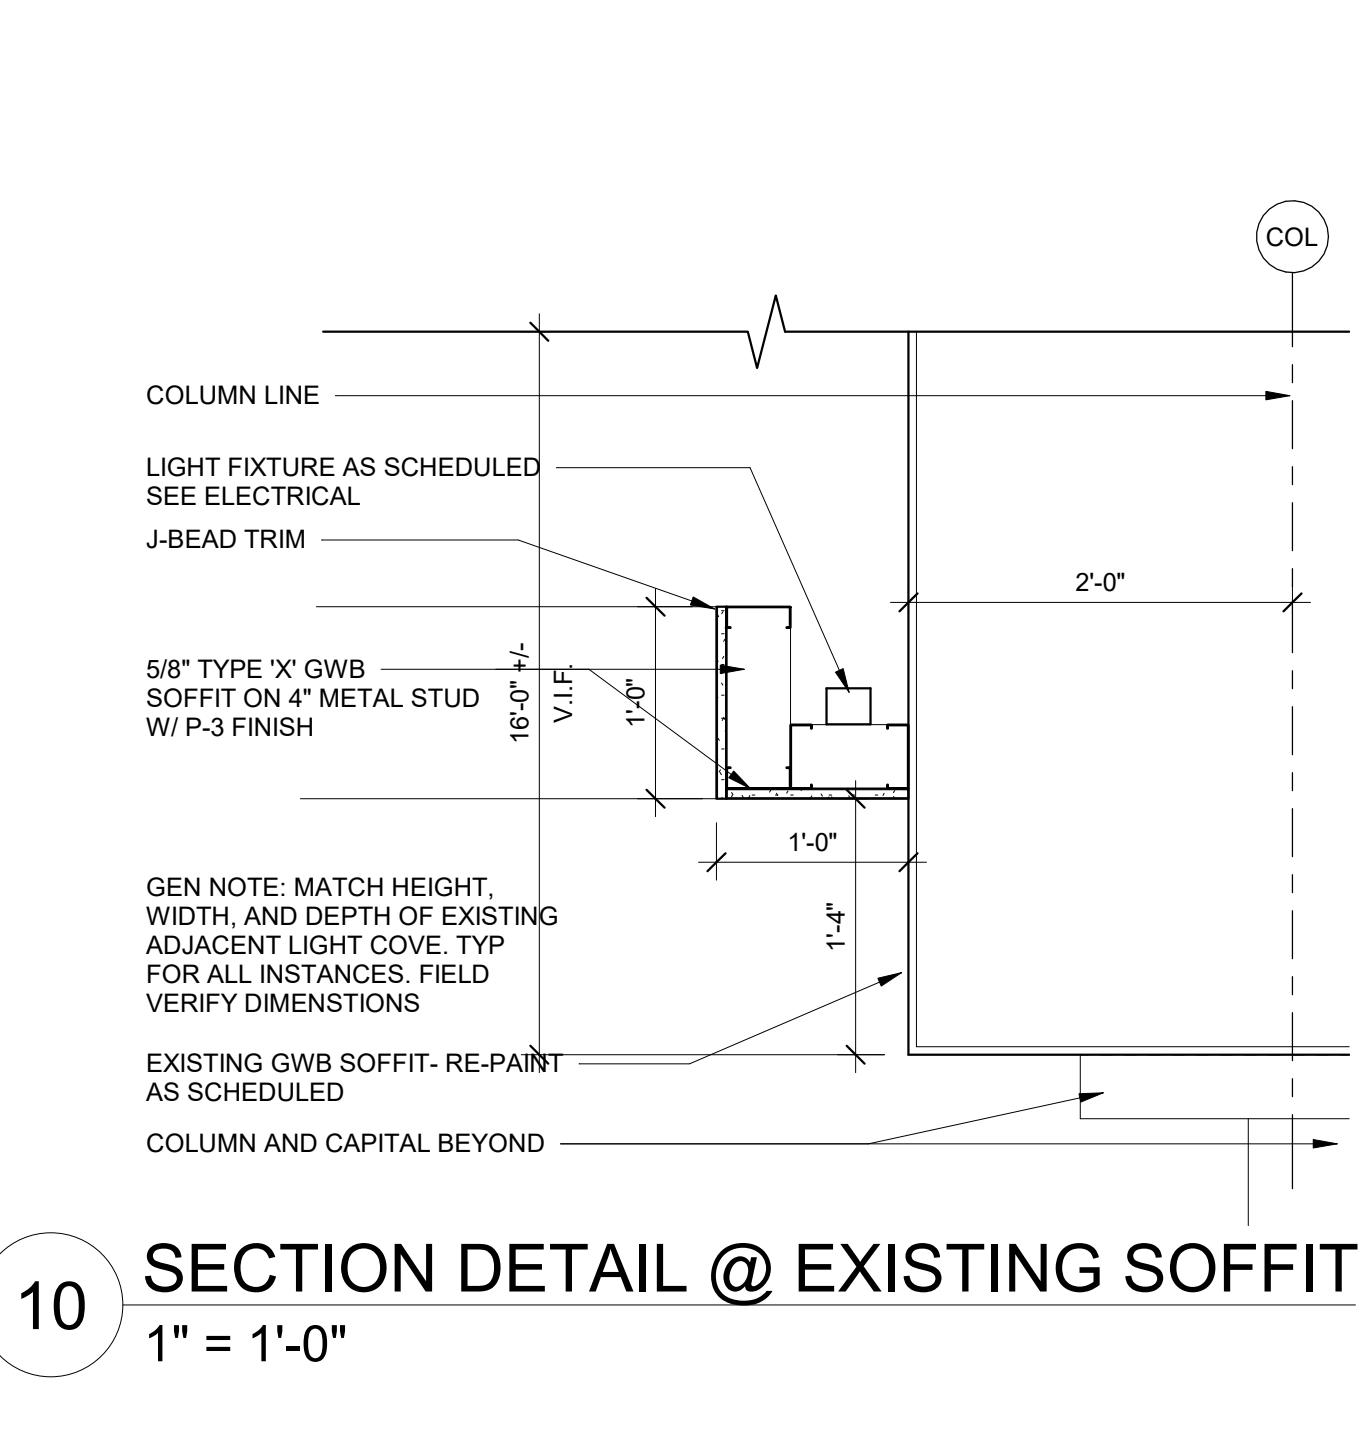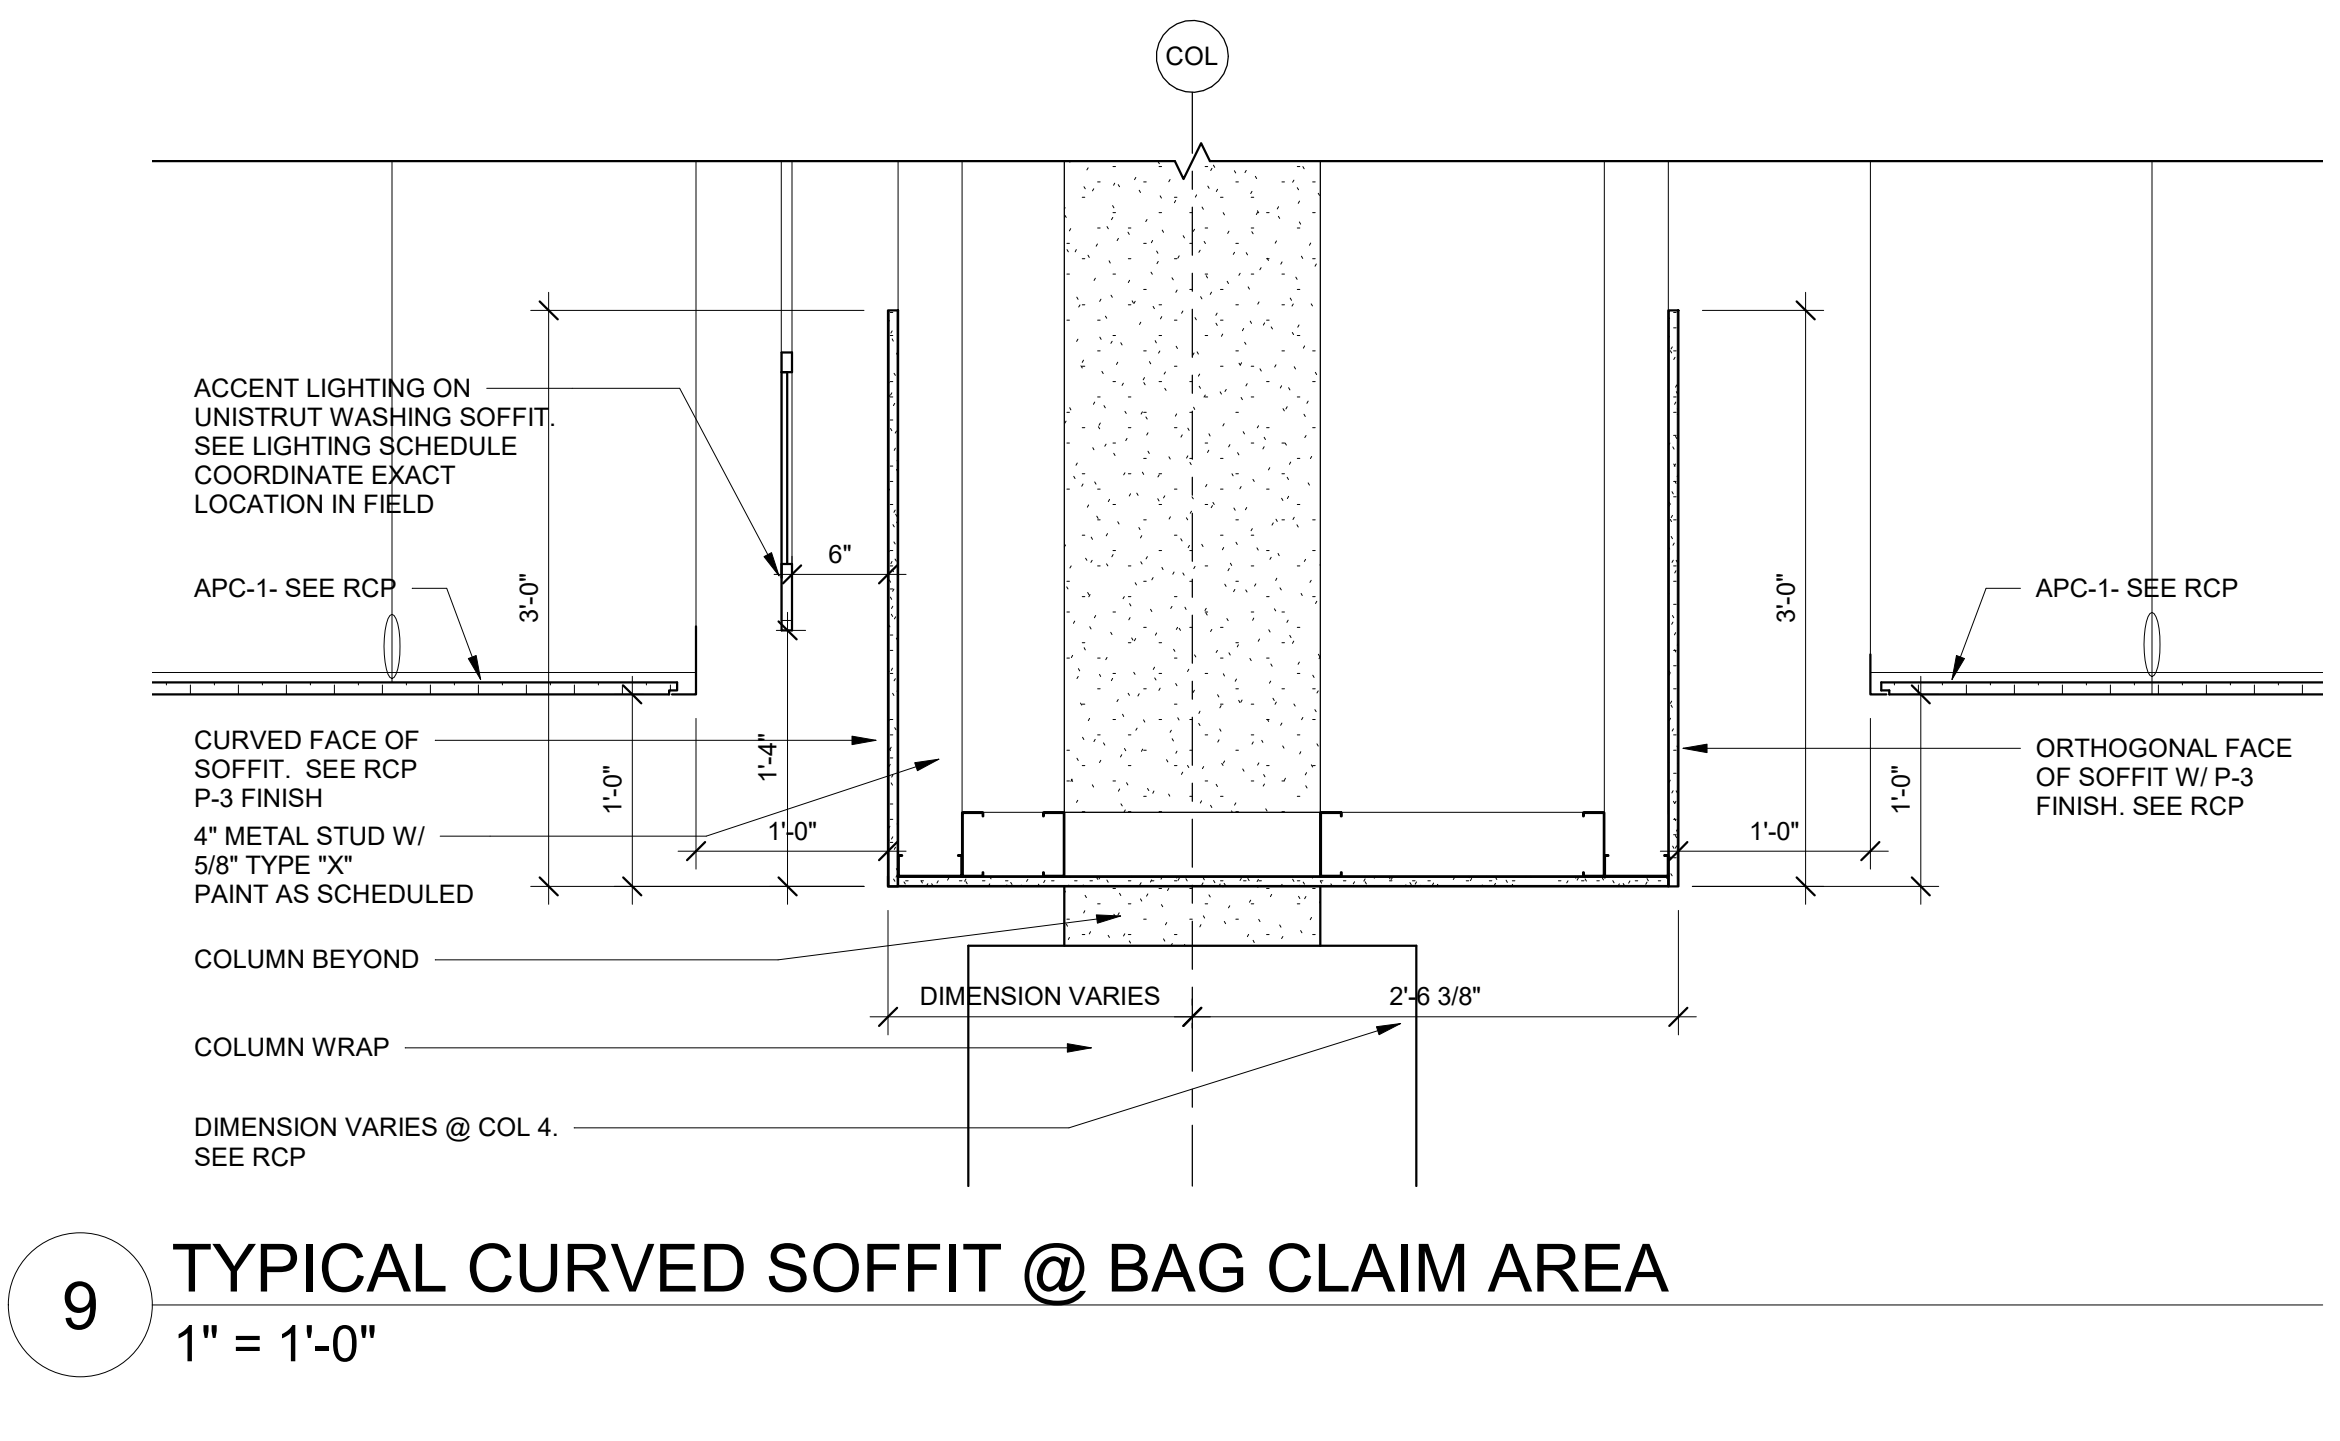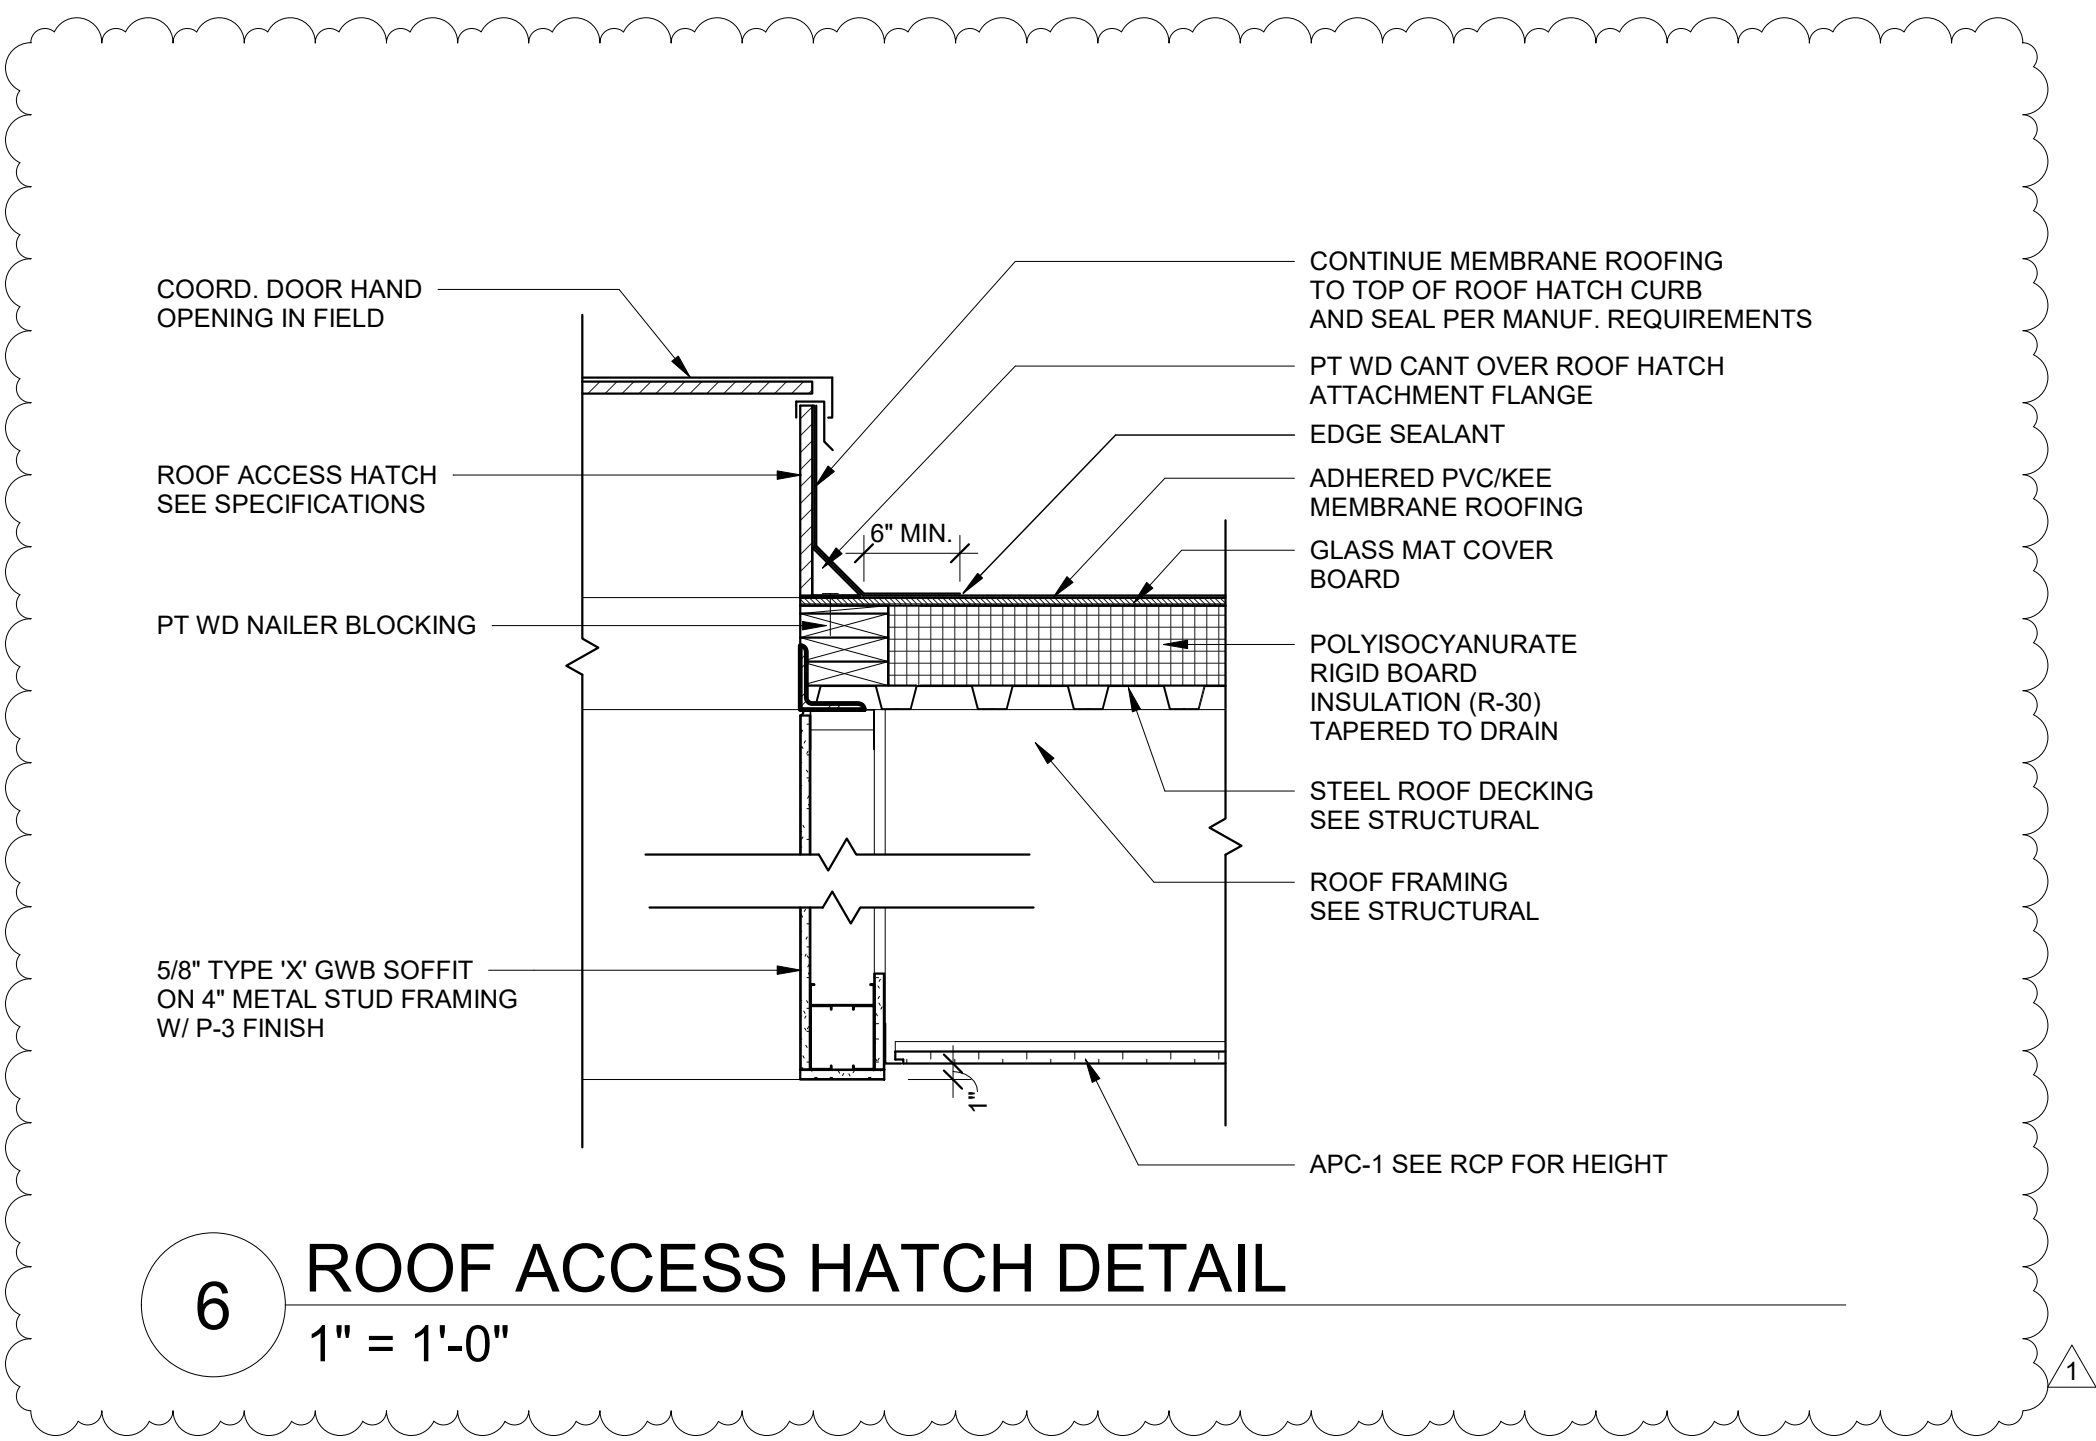



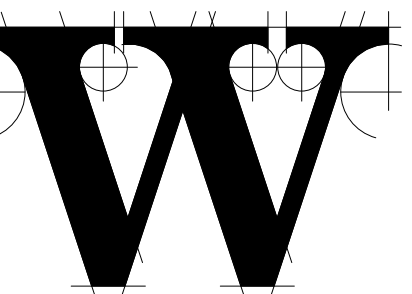

**THE WILSON GROUP**  
- ARCHITECTS -

PO Box 5510 Charlotte, NC 28299  
704-331-9747 • www.twgarchitects.com

PROJECT MANAGER & CIVIL ENGINEER  
**TALBERT & BRIGHT**

CONSULTING ARCHITECT  
**LS3P**

STRUCTURAL ENGINEER  
**STEWART**

FP/PM/E ENGINEER  
**CHEATHAM & ASSOC.**

BAGGAGE HANDLING CONSULTANTS  
**BNP**

AIRCRAFT SUPPORT SYSTEMS  
**DK CONSULTANTS**

SPECIALTY LIGHTING CONSULTANT  
**HARTRANFT**

SIGNAGE & WAYFINDING  
**TAKEFORM**

COPYRIGHT © 2019  
THE WILSON GROUP ARCHITECTS  
ALL RIGHTS RESERVED

PRINTED OR ELECTRONIC DRAWINGS AND DOCUMENTATION MAY NOT BE REPRODUCED IN ANY FORM WITHOUT WRITTEN PERMISSION FROM THE WILSON GROUP ARCHITECTS

**REVISIONS**


1 7/30/2019 AD-03

DATE 6/28/2019  
PROJECT NUMBER 9202-000  
SHEET TITLE


**SPECIALTY WALL PANEL SYSTEM DETAILS**

SHEET NUMBER


**A-521**

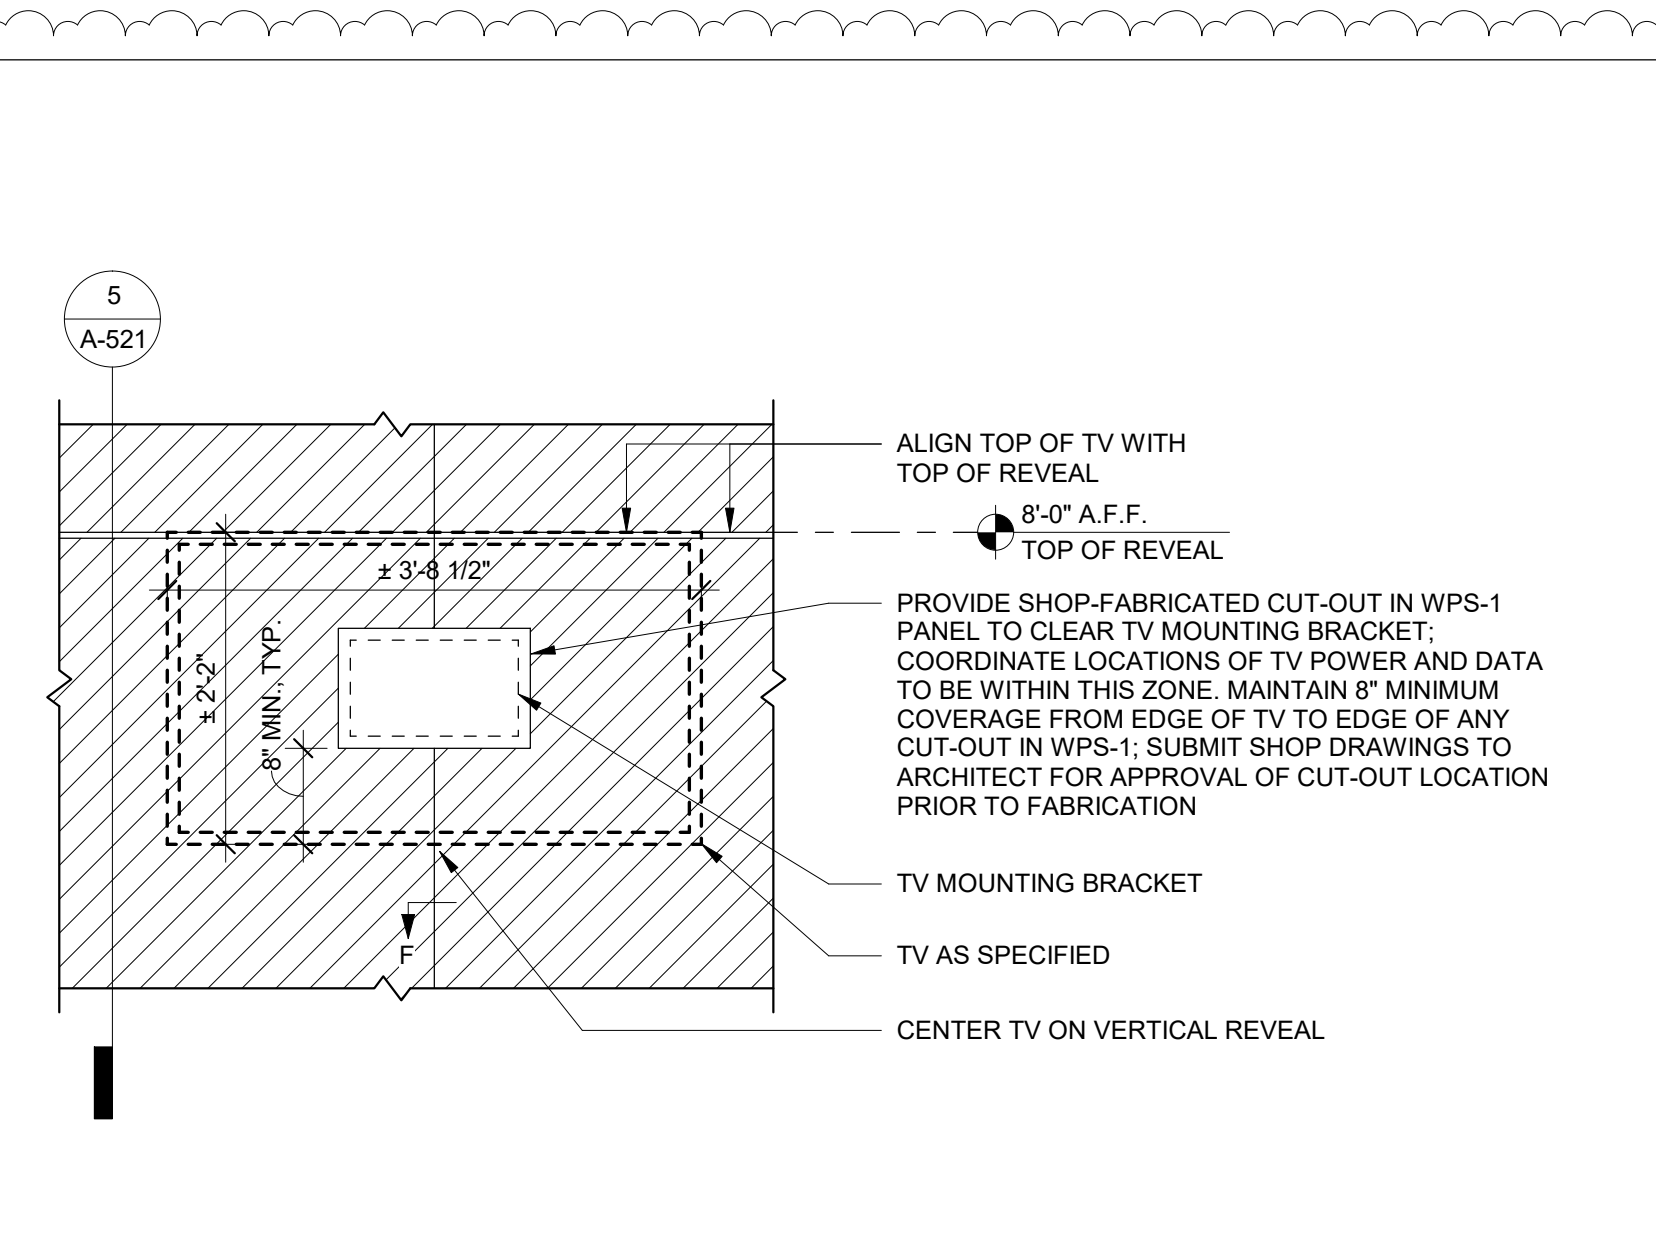


**11 ENLARGED ELEVATION AT GATE WALL TV**  
3/4" = 1'-0"

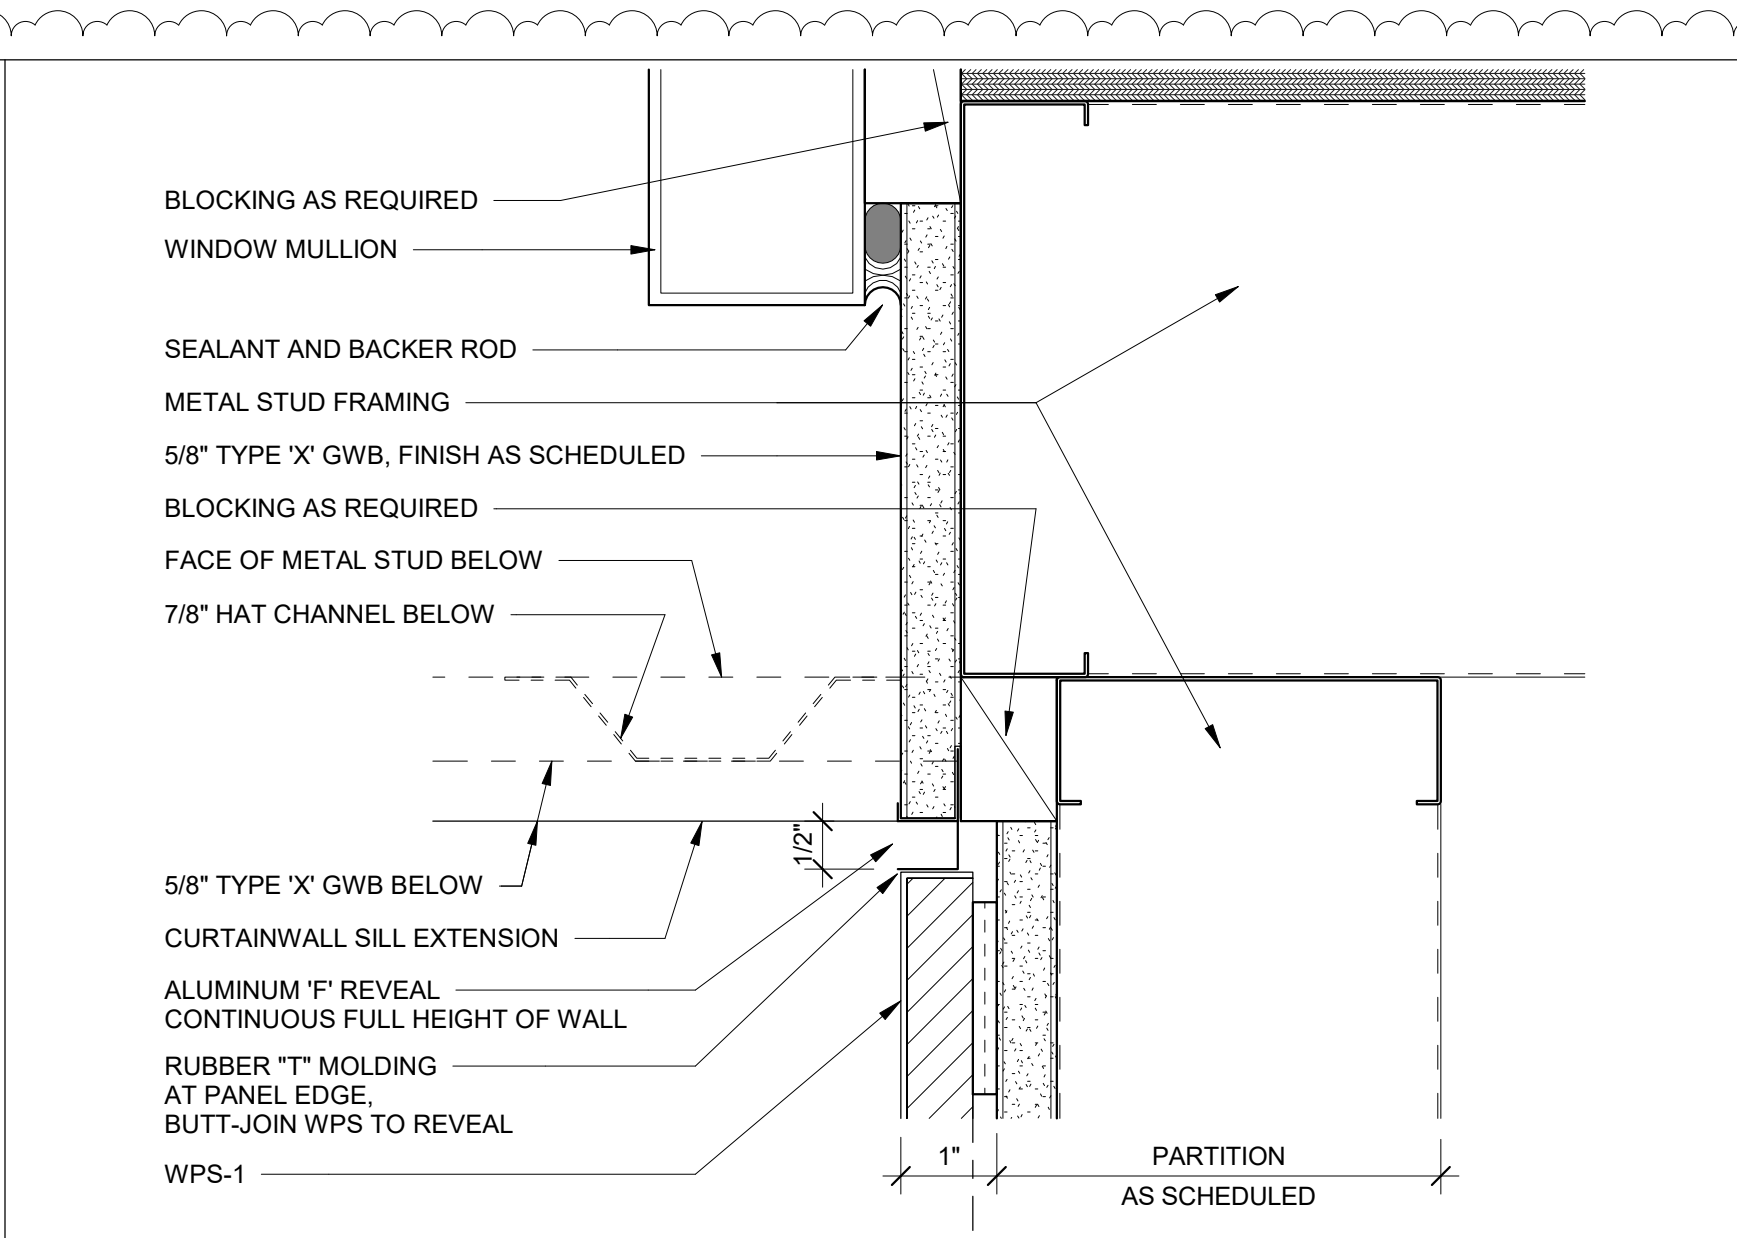


**12 PLAN DETAIL @ GATE WALL**  
6" = 1'-0"

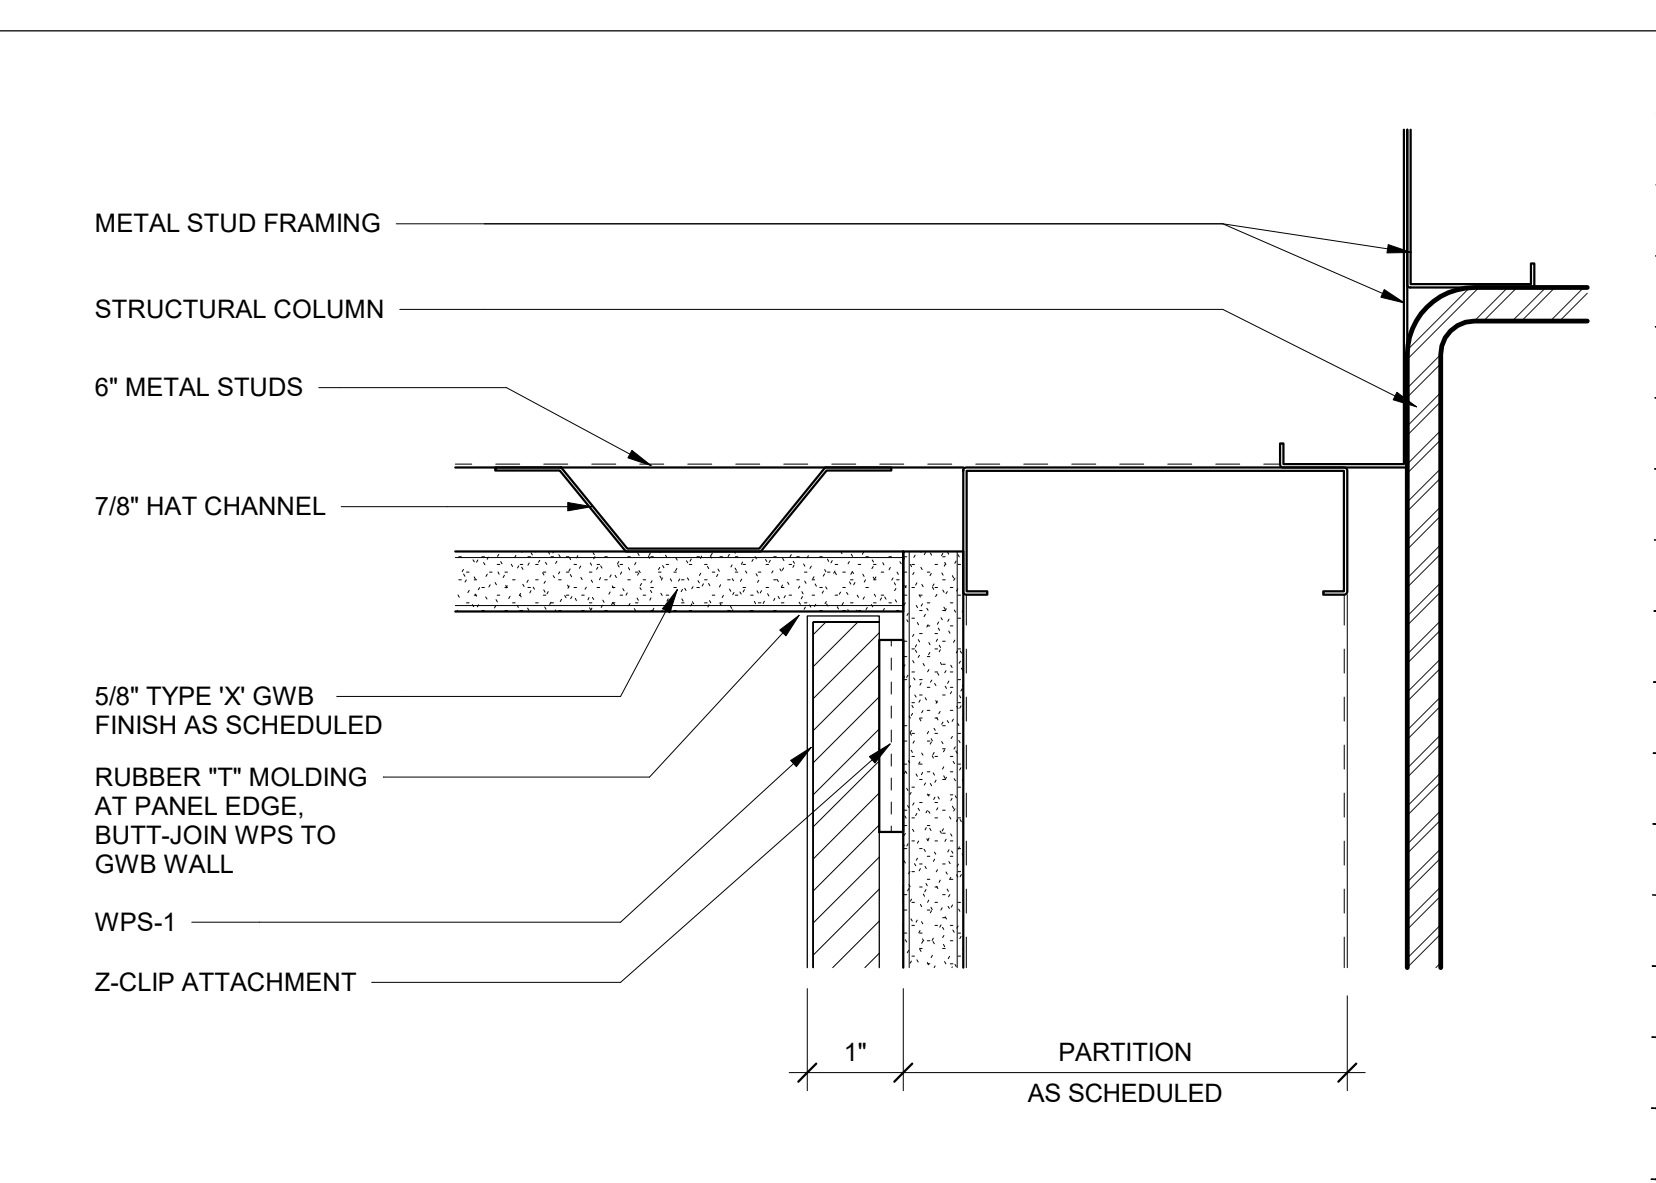


**7 PLAN DETAIL @ GATE WALL**  
6" = 1'-0"

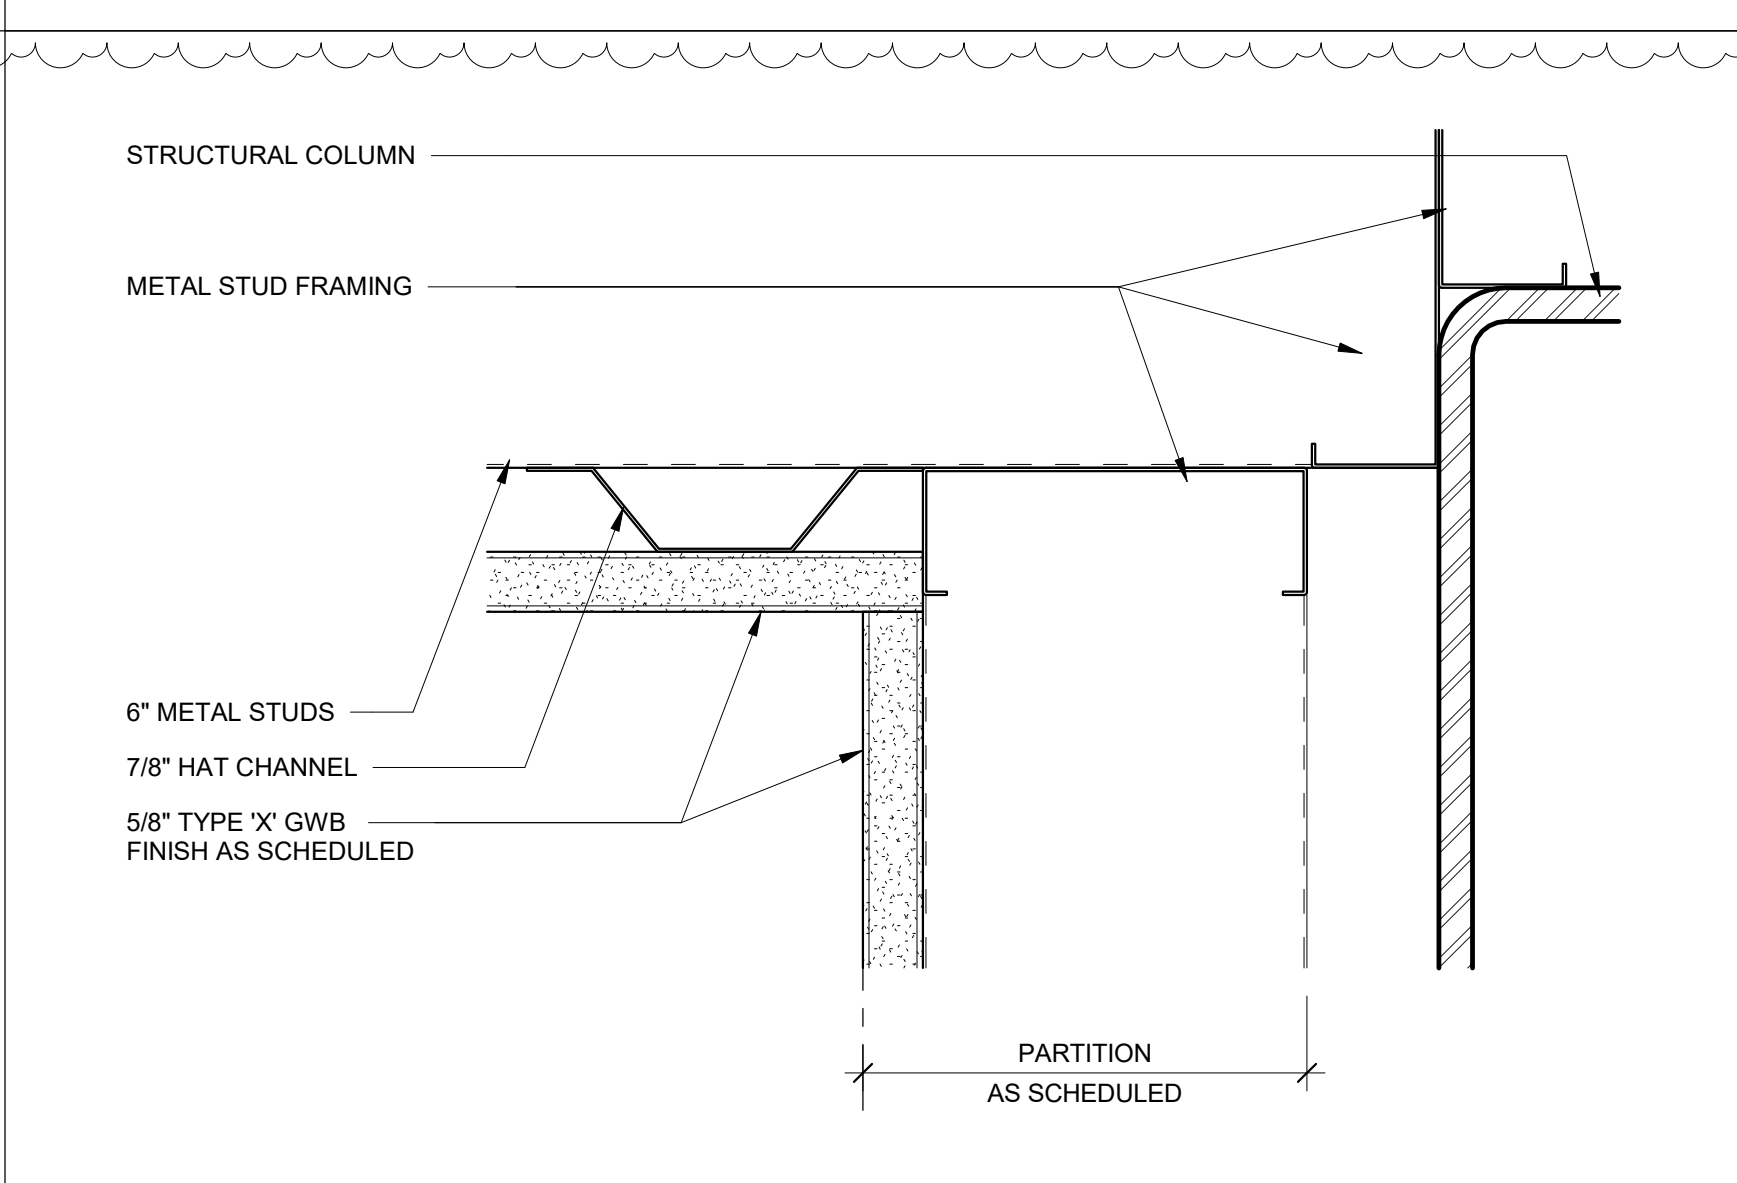


**8 PLAN DETAIL @ GATE WALL**  
6" = 1'-0"

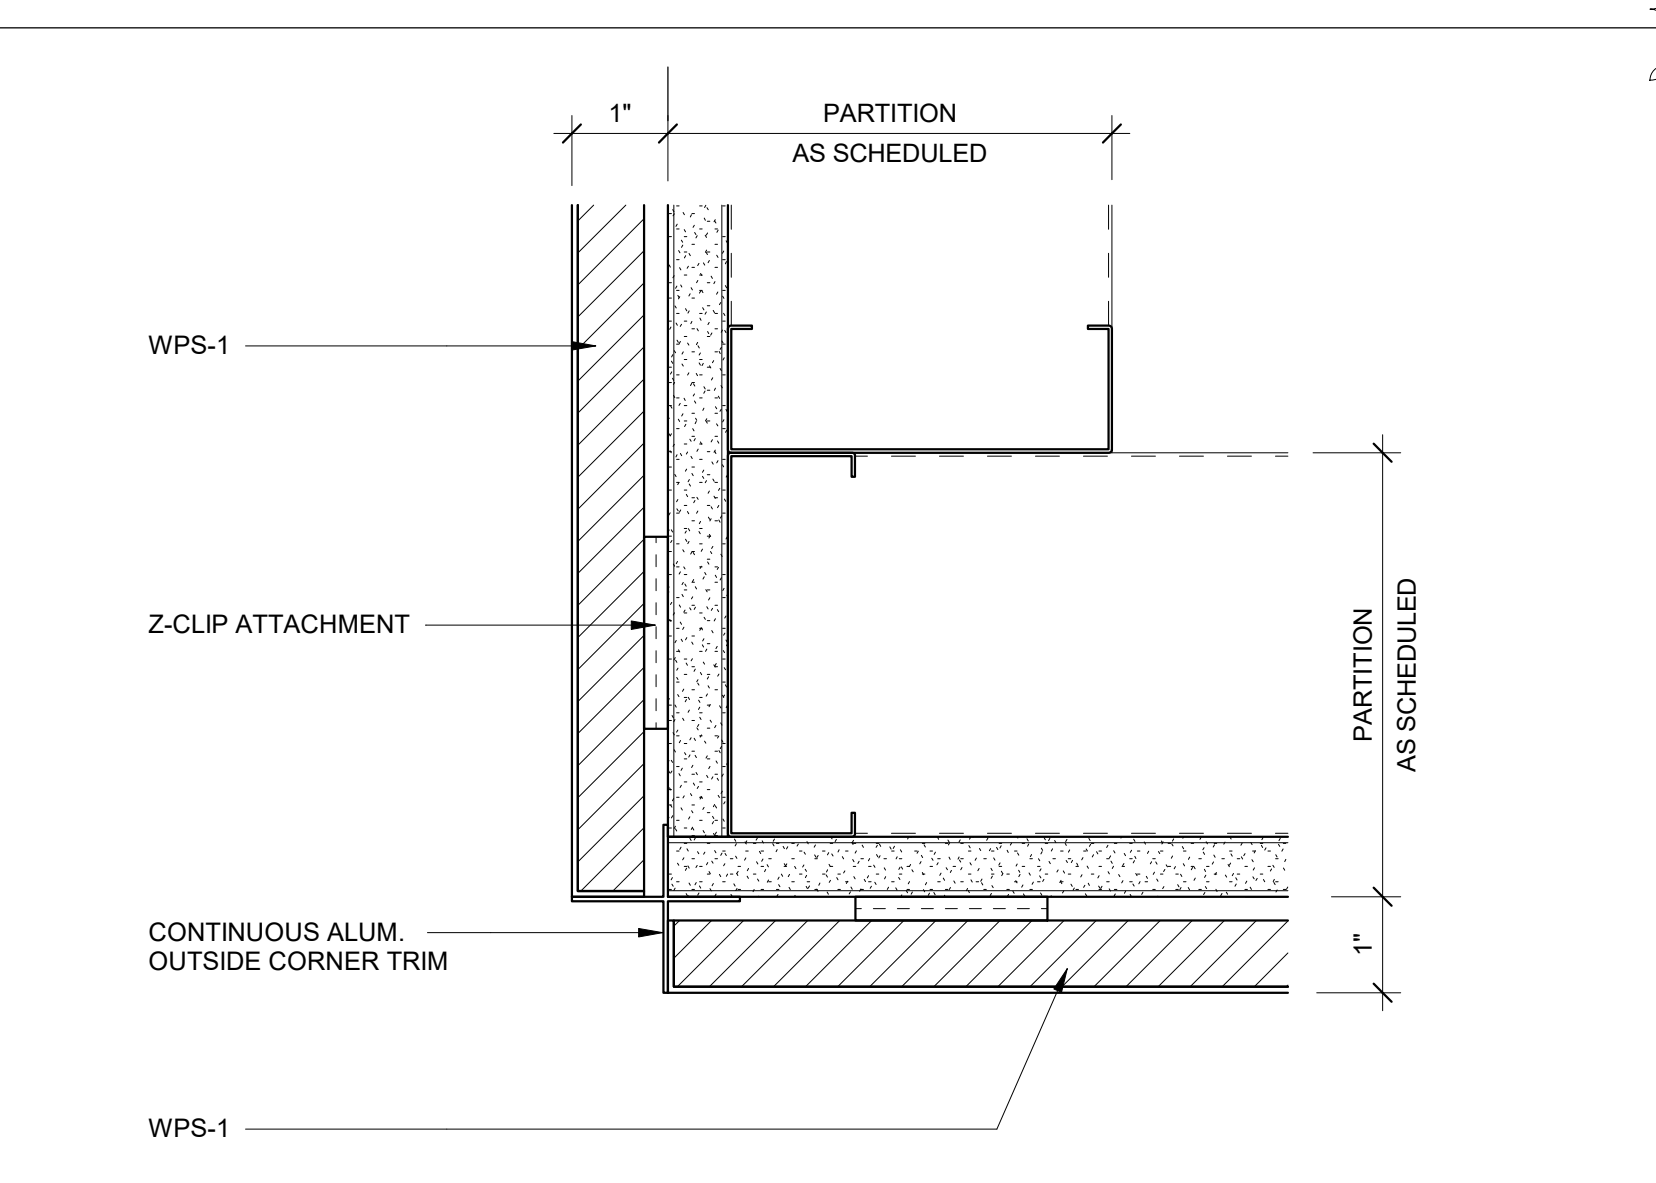


**2 PLAN DETAIL @ GATE WALL**  
6" = 1'-0"

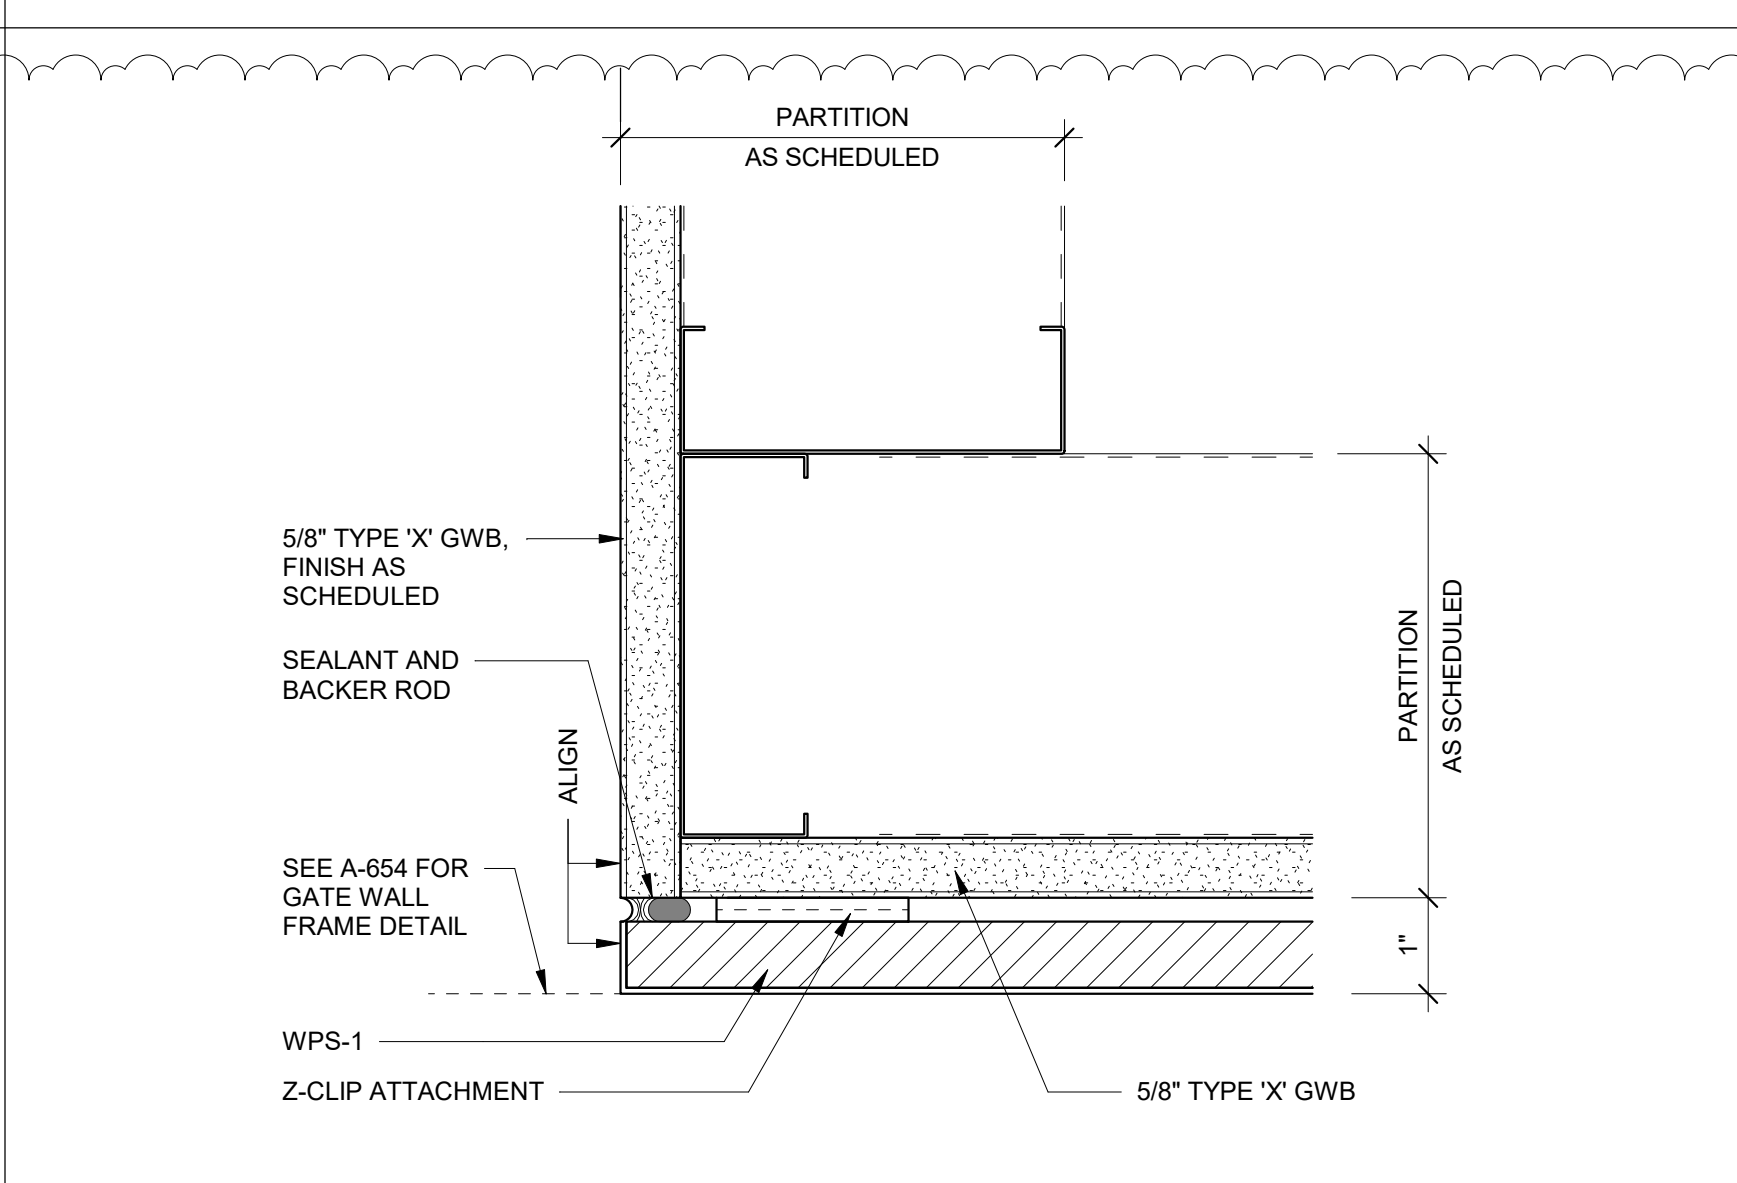

**3 PLAN DETAIL @ GATE WALL**  
6" = 1'-0"

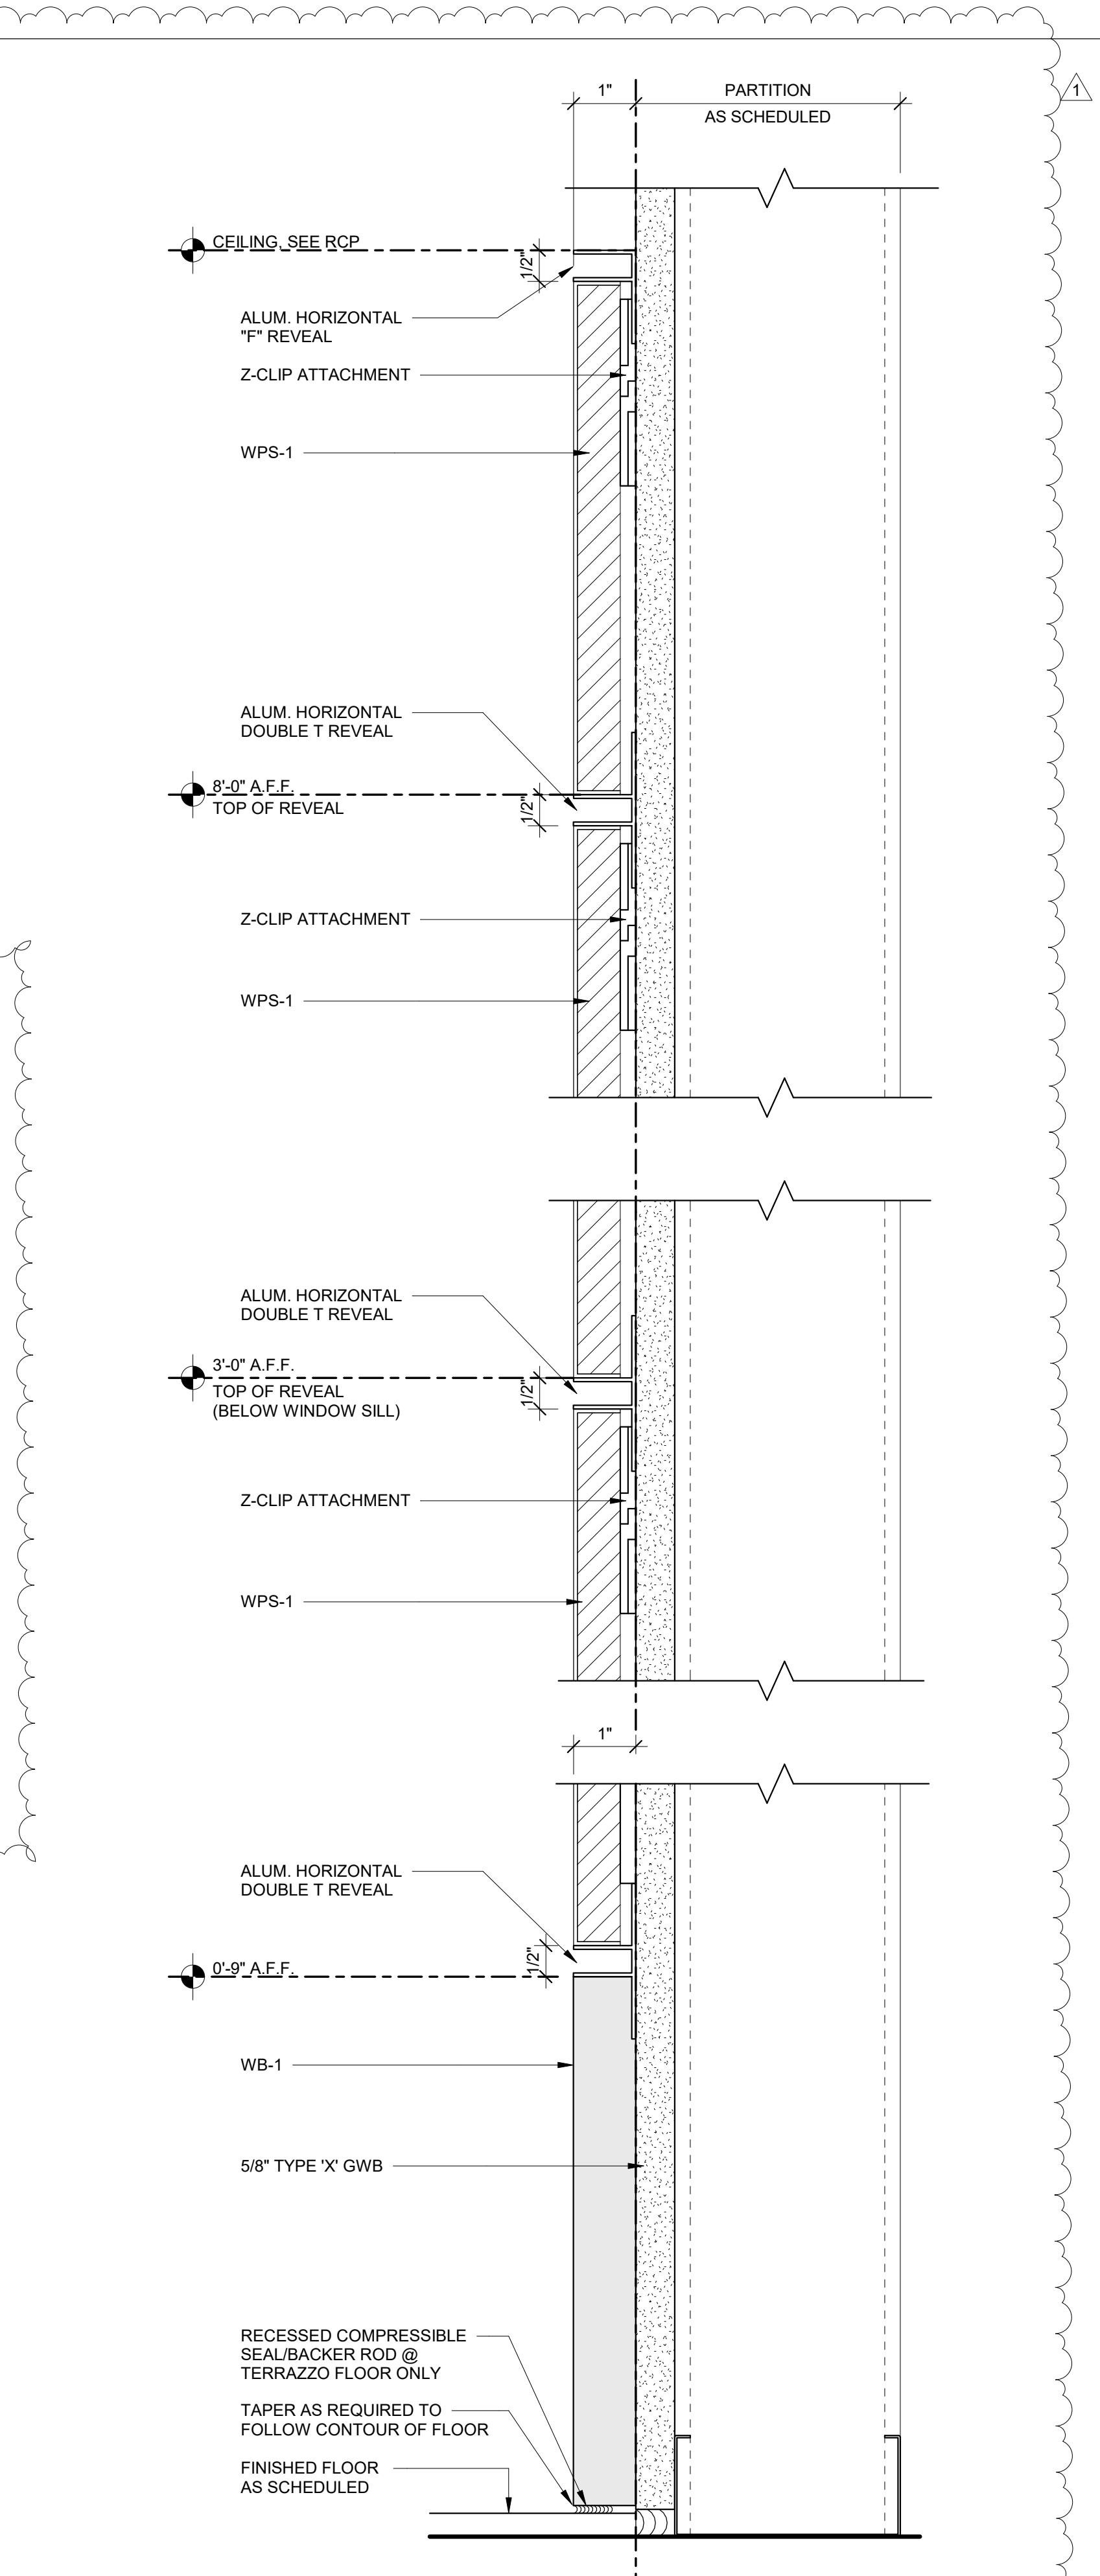

**5 WALL SECTION @ GATE WALL**  
6" = 1'-0"

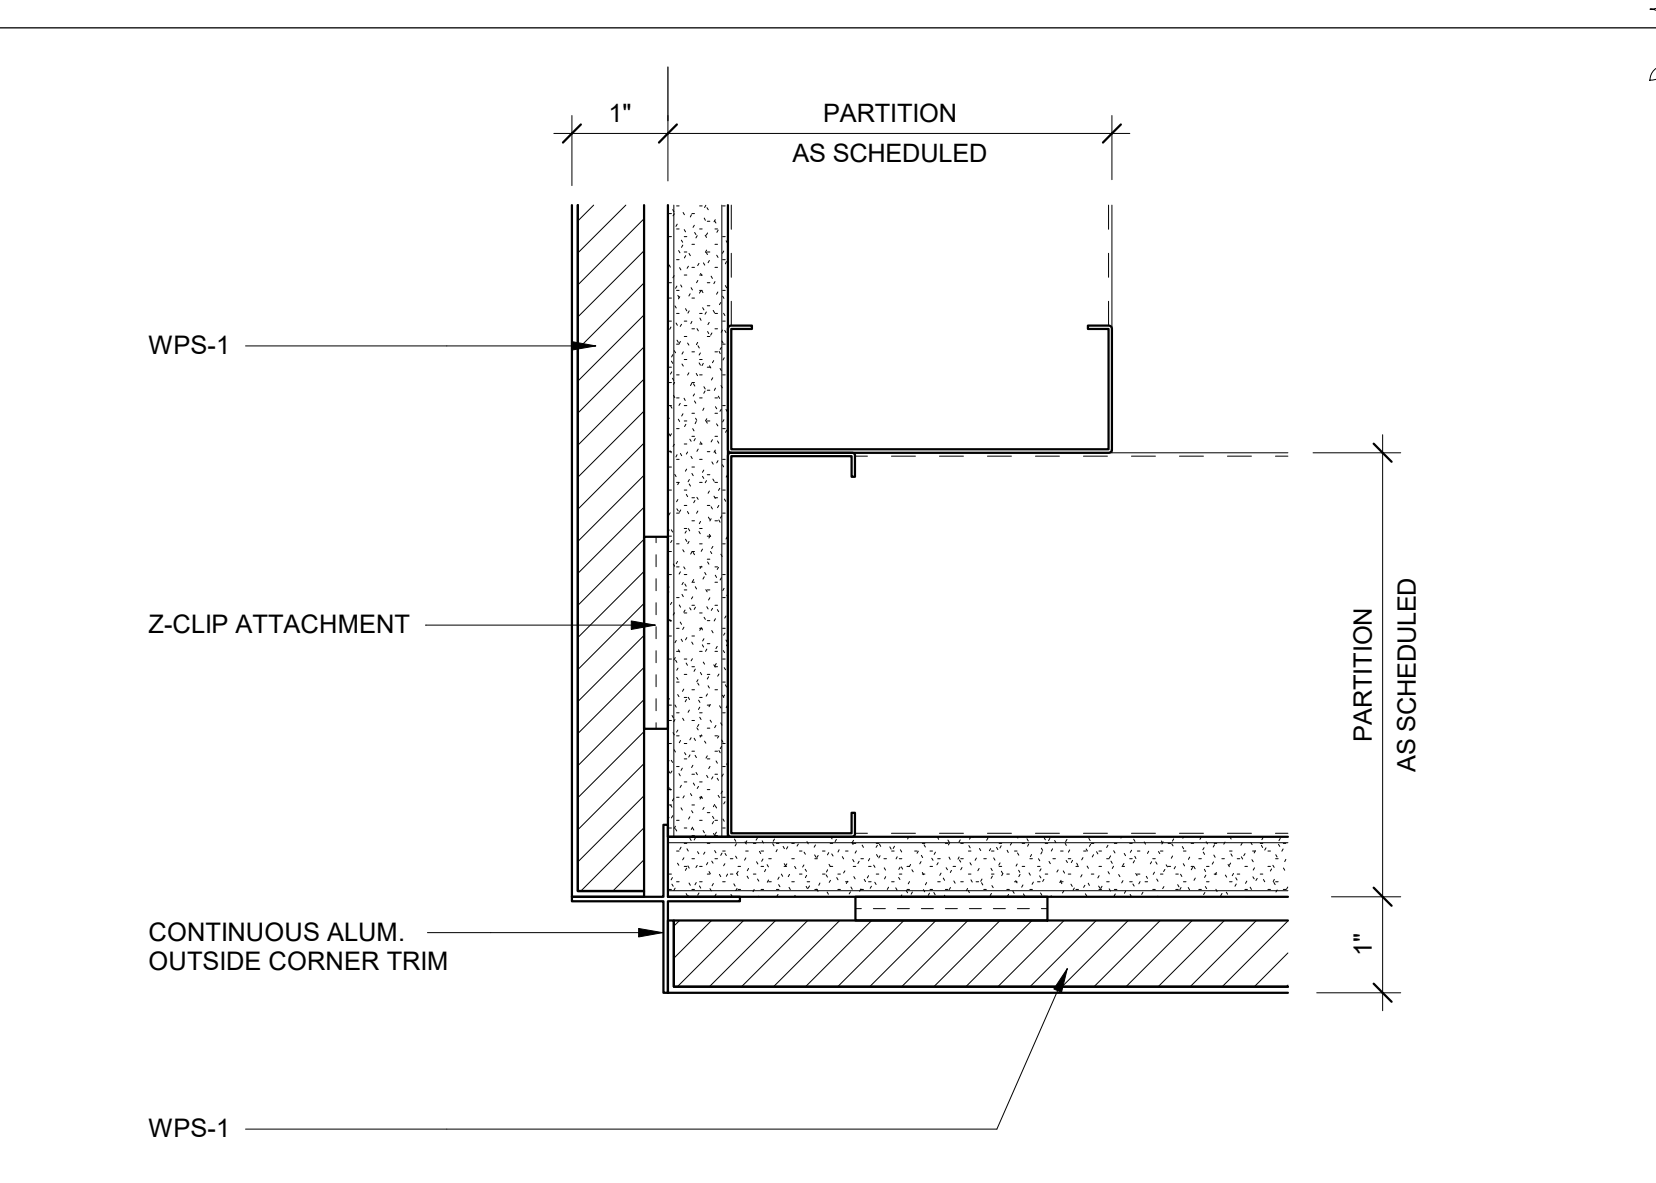

**1 ENLARGED ELEV AT GATE WALL SIGNAGE**  
3/4" = 1'-0"

**4 PLAN DETAIL @ GATE WALL**  
6" = 1'-0"

ROOM FINISH SCHEDULE 1									
ROOM NUMBER	ROOM NAME	BASE	FLOORING	Wall Finish - North Wall	Wall Finish - East Wall	Wall Finish - South Wall	Wall Finish - West Wall	Ceiling Finish	REMARKS
RAMP LEVEL									
A108	ELECTRICAL	N/A	N/A	N/A	N/A	N/A	N/A	N/A	
A1101	FUTURE	N/A	N/A	N/A	N/A	N/A	N/A	N/A	
A1102	U.A. STORAGE	N/A	EXPOSED CONCRETE	N/A	N/A	N/A	N/A	N/A	
A1104	MECHANICAL	N/A	EXPOSED CONCRETE	N/A	N/A	N/A	N/A	N/A	
A1105	MECHANICAL	N/A	EXPOSED CONCRETE	N/A	N/A	N/A	N/A	N/A	
A1106	STAIR 6	RB-1	EXPOSED CONCRETE	P-1	P-1	P-1	P-1	APC-2	
A1107	STAIR 7	RB-1	EXPOSED CONCRETE	P-1	P-1	P-1	P-1	APC-2	
A1108	EMR	N/A	EXPOSED CONCRETE	N/A	N/A	N/A	N/A	N/A	
A1109	CORRIDOR	RB-1	EXPOSED CONCRETE	P-1	P-1	P-1	P-1	APC-2	
A1110	ELECTRICAL	N/A	EXPOSED CONCRETE	N/A	N/A	N/A	N/A	N/A	
A1111	MECHANICAL	N/A	EXPOSED CONCRETE	N/A	N/A	N/A	N/A	N/A	
A1112	IT	N/A	EXPOSED CONCRETE	N/A	N/A	N/A	N/A	N/A	
A1113	MECHANICAL	N/A	N/A	N/A	N/A	N/A	N/A	N/A	
A1115	VESTIBULE	RB-1	N/A	P-1	N/A	P-1	P-1	APC-2	
A1116	ELEV. #6	SEE ELEVATOR	SEE ELEVATOR	SEE ELEVATOR	SEE ELEVATOR	SEE ELEVATOR	SEE ELEVATOR	SEE ELEVATOR	
A1117	CONCESSION ENTRANCE	RB-1	EXPOSED CONCRETE	P-1	P-1	P-1	P-1	APC-2	
A1120	AIRLINE	N/A	N/A	N/A	N/A	N/A	N/A	N/A	
A1130	FUTURE	N/A	N/A	N/A	N/A	N/A	N/A	N/A	
A1131	FUTURE	N/A	N/A	N/A	N/A	N/A	N/A	N/A	
A1132	STORAGE	N/A	EXPOSED CONCRETE	N/A	N/A	N/A	N/A	N/A	
A1135	SARA	N/A	SEE FLOOR PLAN	N/A	N/A	N/A	N/A	N/A	
A2134	FUTURE MECHANICAL	N/A	EXPOSED CONCRETE	N/A	N/A	N/A	N/A	N/A	
BOARDING LEVEL									
A1202	CORRIDOR	WB-1	CPT-1	P-1	P-1	P-1	P-1	APC-1	
A1205	HOLDROOM	WB-1	CPT-1	P-1	P-1	P-1	P-1	APC-1	
A1207	STAIR 7	RB-1	N/A	P-1	P-1	P-1	P-1	APC-2	
A1208	STAIR 6	RB-1	N/A	P-1	P-1	P-1	P-1	APC-2	
A1209	CONCOURSE	WB-1	TR-1,TR-2,TR-3	P-1	P-1	P-1	P-1	SEE RCP	
A1210	FUTURE	N/A	N/A	N/A	N/A	N/A	N/A	N/A	
A1211	CONCOURSE	WB-1	TR-1,TR-2	P-1	P-1	P-1	P-1	SEE RCP	
A1212	HOLD ROOM	WB-1	CPT-1	P-1	P-1	P-1	P-1	APC-1	
A1216	ELEVATOR 6	SEE ELEVATOR	SEE ELEVATOR	SEE ELEVATOR	SEE ELEVATOR	SEE ELEVATOR	SEE ELEVATOR	SEE ELEVATOR	
A1222	HOLD ROOM	WB-1	CPT-1	P-1	P-1	P-1	P-1	APC-1	
A1223	HOLD ROOM	WB-1	CPT-1	P-1	P-1	P-1	P-1	APC-1	
A1224	FAMILY REST ROOM	TRB-1	TR-1	WT-1	WT-1	WT-1	WT-1	APC-2	
A1225	MOTHER'S ROOM	TRB-1	TR-1	WT-1	P-1	P-1	P-1	APC-2	
A1226	JAN	FRB-1	TR-1	FRP-1	FRP-1	FRP-1	FRP-1	APC-2	
A1227	WOMEN'S TOILET	TRB-1	TR-1	SEE ELEVATIONS	SEE ELEVATIONS	SEE ELEVATIONS	SEE ELEVATIONS	ACP-2/P-3	
A1228	MEN'S TOILET	TRB-1	TR-1	SEE ELEVATIONS	SEE ELEVATIONS	SEE ELEVATIONS	SEE ELEVATIONS	ACP-2/P-3	
A1236	HOLD ROOM	WT-1	TR-1,TR-2	P-1	P-1	P-1	P-1	APC-1	
TICKET LEVEL									
A1232	CIRCULATION	WB-1	TR-1,TR-2	P-1	P-1	P-1	P-1	ACP-1	
A1233	CIRCULATION	WB-1	TR-1,TR-2	P-1	P-1	P-1	P-1	ACP-1	

ROOM FINISH SCHEDULE 2									
ROOM NUMBER	ROOM NAME	BASE	FLOORING	Wall Finish - North Wall	Wall Finish - East Wall	Wall Finish - South Wall	Wall Finish - West Wall	Ceiling Finish	REMARKS
RAMP LEVEL									
A1132	STORAGE	N/A	EXPOSED CONCRETE	N/A	N/A	N/A	N/A	N/A	
A2101	FUTURE	N/A	N/A	N/A	N/A	N/A	N/A	N/A	
A2102	MECHANICAL	N/A	N/A	N/A	N/A	N/A	N/A	N/A	
A2106	STAIR 6	RB-1	N/A	P-1	P-1	P-1	P-1	ACP-2	
A2107	STAIR 7	RB-1	N/A	P-1	P-1	P-1	P-1	ACP-2	
A2130	STORAGE	N/A	N/A	N/A	N/A	N/A	N/A	N/A	
A2132	WORK	RB-1	CPT-2	P-1	P-1	P-1	P-1	ACP-2	
A2133	CONFERENCE/ BREAK RM	RB-1	CPT-2	P-1	P-1	P-1	P-1	ACP-2	
A2134	MECHANICAL	N/A	N/A	N/A	N/A	N/A	N/A	N/A	
A2135	HALL	RB-1	CPT-2	P-1	P-1	P-1	P-1	ACP-2	
A2136	UNISEX	TRB-1	TR-1	WT-1	WT-1	P-3	P-3	ACP-2	
A2137	UNISEX	TRB-1	TR-1	WT-1	WT-1	P-3	P-3	ACP-2	
A2138	STORAGE	RB-1	CPT-2	P-1	P-1	P-1	P-1	ACP-2	
A2139	STORAGE	RB-1	CPT-2	P-1	P-1	P-1	P-1	ACP-2	
A2140	OFFICE	RB-1	CPT-2	P-1	P-1	P-1	P-1	ACP-2	
A2141	OFFICE	RB-1	CPT-2	P-1	P-1	P-1	P-1	ACP-2	
A2142	OFFICE	RB-1	CPT-2	P-1	P-1	P-1	P-1	ACP-2	
A2143	OFFICE	RB-1	CPT-2	P-1	P-1	P-1	P-1	ACP-2	
A2144	INBOUND MAKE UP	N/A	N/A	N/A	N/A	N/A	N/A	N/A	
BOARDING LEVEL									
A1203	HOLD ROOM	WB-1	CPT-1	P-1	P-1	P-1	P-1	ACP-1	
A2200	HOLD ROOM	WB-1	CPT-1	P-1	P-1	P-1	P-1	ACP-1	
A2201	CONCOURSE	WB-1	SEE FINISH PLAN	P-1	P-1	P-1	P-1	SEE RCP	
A2202	CONCOURSE	WB-1	SEE FINISH PLAN	P-1	P-1	P-1	P-1	SEE RCP	
A2203	HOLDROOM	WB-1	CPT-1	P-1	P-1	P-1	P-1	ACP-1	
A2204	STORAGE	RB-1	N/A	P-1	P-1	P-1	P-1	ACP-2	
A2206	WOMEN	TRB-1	TR-1	SEE ELEVATIONS	SEE ELEVATIONS	SEE ELEVATIONS	SEE ELEVATIONS	SEE RCP	
A2206	STAIR 6	RB-1	N/A	P-1	P-1	P-1	P-1	ACP-2	
A2207	STAIR 7	RB-1	N/A	P-1	P-1	P-1	P-1	ACP-2	
A2209	HOLD ROOM	WB-1	CPT-1	P-1	P-1	P-1	P-1	ACP-1	
A2210	MEN'S	TRB-1	TR-1	SEE ELEVATIONS	SEE ELEVATIONS	SEE ELEVATIONS	SEE ELEVATIONS	SEE RCP	
A2211	JAN	RB-1	TR-1	FRP-1	FRP-1	FRP-1	FRP-1	ACP-2	
TICKET LEVEL									
A2208	Room	WB-1	SEE FINISH PLAN	P-1	P-1	P-1	P-1	ACP-2	
A2231	CIRCULATION	WB-1	SEE FINISH PLAN	P-1	P-1	P-1	P-1	ACP-2	
A2232	PSR	WB-1	SEE FINISH PLAN	P-1	P-1	P-1	P-1	ACP-2	
A2233	OFFICE	WB-1	SEE FINISH PLAN	P-1	P-1	P-1	P-1	ACP-2	
A2234	BYPASS	N/A	SEE FINISH PLAN	P-1	P-1	P-1	P-1	ACP-2	
A2235	EXIT	N/A	SEE FINISH PLAN	N/A	N/A	N/A	N/A	N/A	
A2236	EXIT	N/A	SEE FINISH PLAN	N/A	N/A	N/A	N/A	N/A	
A2237	CHECKPOINT								
A2238	CIRCULATION	WB-1	SEE FINISH PLAN	P-1	P-1	P-1	P-1	SEE RCP	
A2239	CIRCULATION	WB-1	SEE FINISH PLAN	P-1	P-1	P-1	P-1	SEE RCP	
A2241	CIRCULATION	WB-1	SEE FINISH PLAN	P-1	P-1	P-1	P-1	SEE RCP	
A2242	CIRCULATION	WB-1	SEE FINISH PLAN	P-1	P-1	P-1	P-1	SEE RCP	
A2243	BAGGAGE CLAIM	WB-1	CPT-1	P-1	P-1	P-1	P-1	SEE RCP	
A2244	CIRCULATION	WB-1	SEE FINISH PLAN	P-1	P-1	P-1	P-1	SEE RCP	
A2246	BSO	WB-1	SEE FINISH PLAN	P-1	P-1	P-1	P-1	N/A	
A2247	BSO	WB-1	SEE FINISH PLAN	P-1	P-1	P-1	P-1	N/A	
A2251	MEN'S TOILET	TRB-1	SEE FINISH PLAN	SEE ELEVATIONS	SEE ELEVATIONS	SEE ELEVATIONS	SEE ELEVATIONS	SEE RCP	
A2252	JANITOR	RB-1	SEE FINISH PLAN	FRP-1	FRP-1	FRP-1	FRP-1	ACP-2	
A2253	WOMEN'S TOILET	TRB-1	SEE FINISH PLAN	SEE ELEVATIONS	SEE ELEVATIONS	SEE ELEVATIONS	SEE ELEVATIONS	SEE RCP	
A2254	FAMILY TOILET	TRB-1	SEE FINISH PLAN	SEE ELEVATIONS	SEE ELEVATIONS	SEE ELEVATIONS	SEE ELEVATIONS	SEE RCP	
A2255	MOTHER'S ROOM	TRB-1	SEE FINISH PLAN	SEE ELEVATIONS	SEE ELEVATIONS	SEE ELEVATIONS	SEE ELEVATIONS	SEE RCP	
A2257	MEN'S	TRB-1	SEE FINISH PLAN	SEE ELEVATIONS	SEE ELEVATIONS	SEE ELEVATIONS	SEE ELEVATIONS	SEE RCP	
A2263	STORAGE								
A2264	JAN								
A2272	ELECTRICAL ROOM	N/A	N/A	N/A	N/A	N/A	N/A	N/A	
A2273	OFFICE	RB-1	CPT-2	P-1	P-1	P-1	P-1	ACP-2	
A2274	CORRIDOR	RB-1	CPT-2	P-1	P-1	P-1	P-1	ACP-2	
A2275	WOMEN'S	TRB-1	SEE FINISH PLAN	SEE ELEVATIONS	SEE ELEVATIONS	SEE ELEVATIONS	SEE ELEVATIONS	ACP-2	
A2275	OFFICE	RB-1	CPT-2	P-1	P-1	P-1	P-1	ACP-2	
A2276	CHANGING ROOM	TRB-1	SEE FINISH PLAN	SEE ELEVATIONS	SEE ELEVATIONS	SEE ELEVATIONS	SEE ELEVATIONS	ACP-2	
A2277	JAN	RB-1	SEE FINISH PLAN	FRP-1	FRP-1	FRP-1	FRP-1	ACP-2	
A2504	SSCP QUEUE	TRB-1	SEE FINISH PLAN	P-1	P-1	P-1	P-1	SEE RCP	
A2505	FUTURE ATO	N/A	N/A	N/A	N/A	N/A	N/A	N/A	
A2506	PASS SVC	RB-1	CPT-2	P-1	P-1	P-1	P-1	ACP-2	

**GENERAL FINISH NOTES**


- ALL DIMENSIONS SHALL BE FIELD VERIFIED.
- THE CONTRACTOR SHALL FIELD VERIFY ALL EXISTING BUILDING CONSTRUCTION AND DIMENSIONS PRIOR TO SUBMITTALS AND NEW CONSTRUCTION. THE CONTRACTOR SHALL IMMEDIATELY NOTIFY THE ARCHITECT OF ANY DEVIATIONS.
- INTERIOR CAULKING SHALL BE ARCHITECTURAL GRADE TO MATCH THE COLOR OF ADJACENT SURFACES. SUBMIT SAMPLES TO ARCHITECT FOR VERIFICATION PRIOR TO PROCUREMENT AND INSTALLATION.
- TRANSITION ALL FLOOR FINISHES AT CENTER OF DOOR, U.N.O.
- ALL UNIDENTIFIED COLORS AND FINISHES SHALL BE SELECTED AND APPROVED BY ARCHITECT THROUGH THE SUBMITTAL PROCESS.
- RECESSED WIREWAYS, ACCESS PANELS, GRILLES, ELECTRICAL PANELS, AND ALL OTHER SUCH ARCHITECTURAL, ELECTRICAL, AND MECHANICAL DEVICES SHALL BE FINISHED TO MATCH ADJACENT WALL OR CEILING SURFACE, U.N.O.
- INTERIOR FINISHES SHALL MEET THE REQUIREMENTS OF SECTION 803 OF THE 2018 NCSBC, TABLE 803.3 OF THE 2018 IFC, AND 302 & 303 OF A117.1-2009.
- ALL GWB CEILINGS SHALL BE PAINTED P-2, U.N.O.
- WALL COVER PLATES SHALL BE STAINLESS STEEL, U.N.O.
- ALL WALL MOUNTED SWITCHES AND OUTLETS SHALL BE GRAY IN COLOR, U.N.O.
- ALL EXPOSED DRAIN PIPES SHALL BE PAINTED TO MATCH EXISTING.
- PREPARE FLOOR SURFACES TO RECEIVE NEW FLOOR FINISH PER MANUFACTURER'S SPECIFICATIONS AND RECOMMENDED INSTRUCTIONS.
- EXISTING ROOMS WITH EXISTING PAINT ARE TO BE REPAINTED AS SCHEDULED.
- SAMPLES OF ALL FINISHES ARE TO BE PROVIDED VIA SUBMITTAL PROCESS TO ARCHITECT FOR VERIFICATION PRIOR TO PROCUREMENT AND INSTALLATION.
- EXISTING WALL BASE IN ALL WORK AREAS IS TO BE REMOVED IN ITS ENTIRETY. INSTALL NEW WALL BASE AS SCHEDULED. PATCH AND REPAIR WALL AS REQUIRED TO RECEIVE NEW FINISH.

PER ADDENDUM AD-03, ROOMS LABELED AS "NOT PLACED" HAVE BEEN REMOVED FROM "ROOM FINISH SCHEDULE 2."



**TERMINAL IMPROVEMENTS CONTRACT 3**

Wilmington International Airport  
1740 Airport Boulevard, Suite 12  
Wilmington, NC 28405

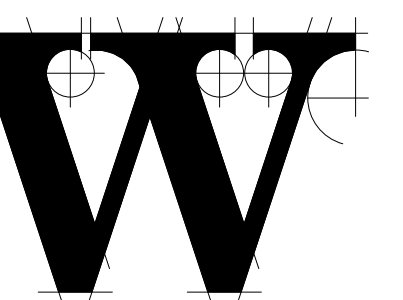

**THE WILSON GROUP ARCHITECTS**

PO Box 5510 Charlotte, NC 28299  
704-331-9747 • www.twgarchitects.com

PROJECT MANAGER & CIVIL ENGINEER  
**TALBERT & BRIGHT**

CONSULTING ARCHITECT  
**LS3P**

STRUCTURAL ENGINEER  
**STEWART**

FP/PI/E ENGINEER  
**CHEATHAM & ASSOC.**

BAGGAGE HANDLING CONSULTANTS  
**BNP**

AIRCRAFT SUPPORT SYSTEMS  
**DK CONSULTANTS**

SPECIALTY LIGHTING CONSULTANT  
**HARTRANFT**

SIGNAGE & WAYFINDING  
**TAKEFORM**

COPYRIGHT © 2019  
THE WILSON GROUP ARCHITECTS  
ALL RIGHTS RESERVED

PRINTED OR ELECTRONIC DRAWINGS AND DOCUMENTATION MAY NOT BE REPRODUCED IN ANY FORM WITHOUT WRITTEN PERMISSION FROM THE WILSON GROUP ARCHITECTS

**REVISIONS**


1 7/30/2019 AD-03

DATE 6/28/2019  
PROJECT NUMBER 9202-000  
SHEET TITLE

**FINISH SCHEDULES**

SHEET NUMBER

**A-651**

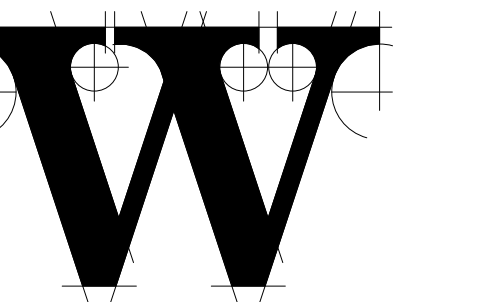

**THE WILSON GROUP**  
- ARCHITECTS -

PO Box 5510 Charlotte, NC 28299  
704-331-9747 • www.twgarchitects.com

PROJECT MANAGER & CIVIL ENGINEER  
**TALBERT & BRIGHT**

CONSULTING ARCHITECT  
**LS3P**

STRUCTURAL ENGINEER  
**STEWART**

FP/IME ENGINEER  
**CHEATHAM & ASSOC.**

BAGGAGE HANDLING CONSULTANTS  
**BNP**

AIRCRAFT SUPPORT SYSTEMS  
**DK CONSULTANTS**

SPECIALTY LIGHTING CONSULTANT  
**HARTRANFT**

SIGNAGE & WAYFINDING  
**TAKEFORM**

COPYRIGHT © 2019  
THE WILSON GROUP ARCHITECTS  
ALL RIGHTS RESERVED  
PRINTED OR ELECTRONIC DRAWINGS AND DOCUMENTATION MAY NOT BE REPRODUCED IN ANY FORM WITHOUT WRITTEN PERMISSION FROM THE WILSON GROUP ARCHITECTS


REVISIONS

1	7/12/2019	AD-01
2	7/30/2019	AD-03


DATE 6/28/2019  
PROJECT NUMBER 9202-000  
SHEET TITLE

**WALL BASE, WALL, AND PANEL REVEAL DETAILS**


SHEET NUMBER  
**A-654**

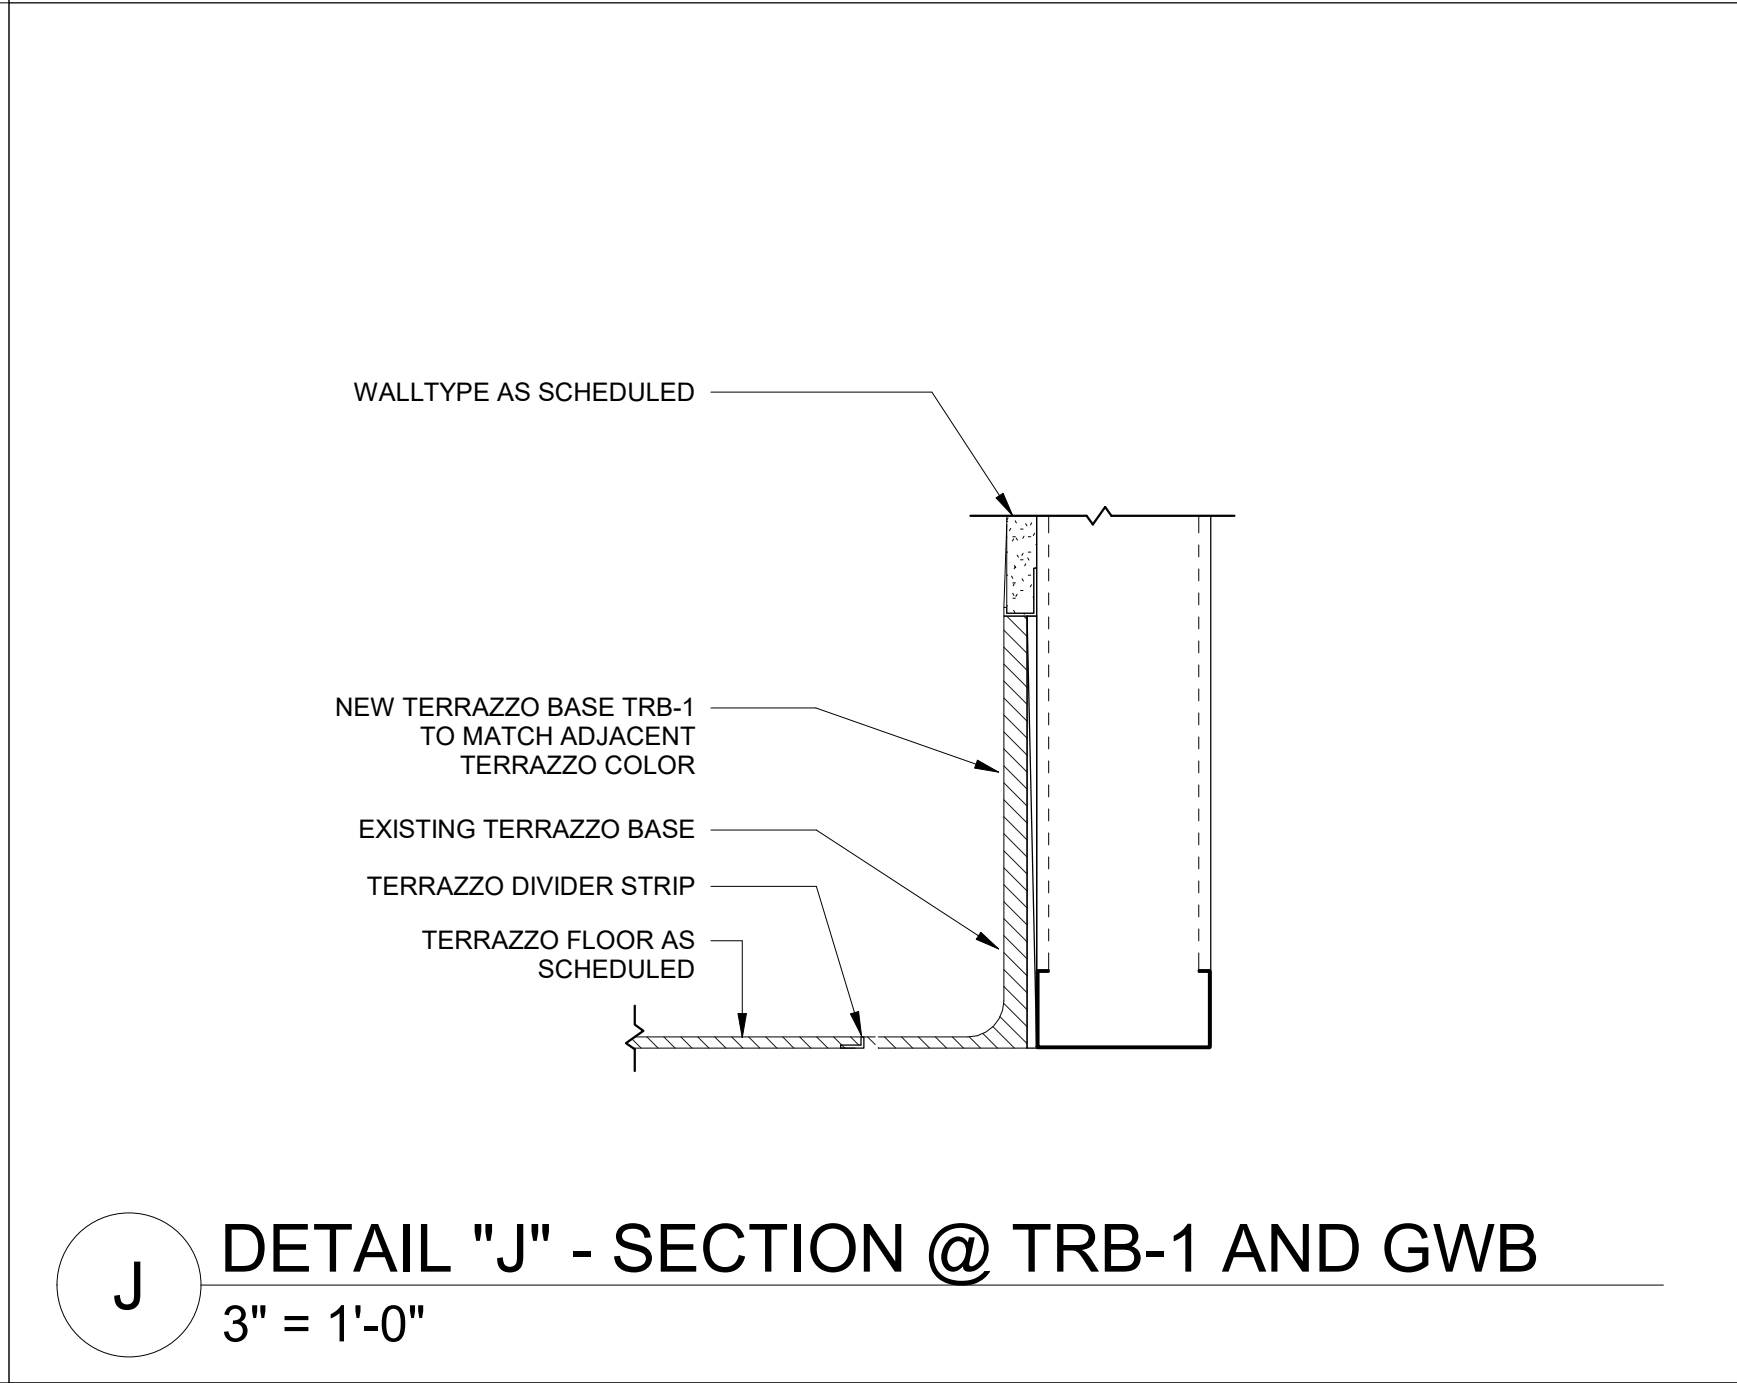


**J** DETAIL "J" - SECTION @ TRB-1 AND GWB  
3" = 1'-0"

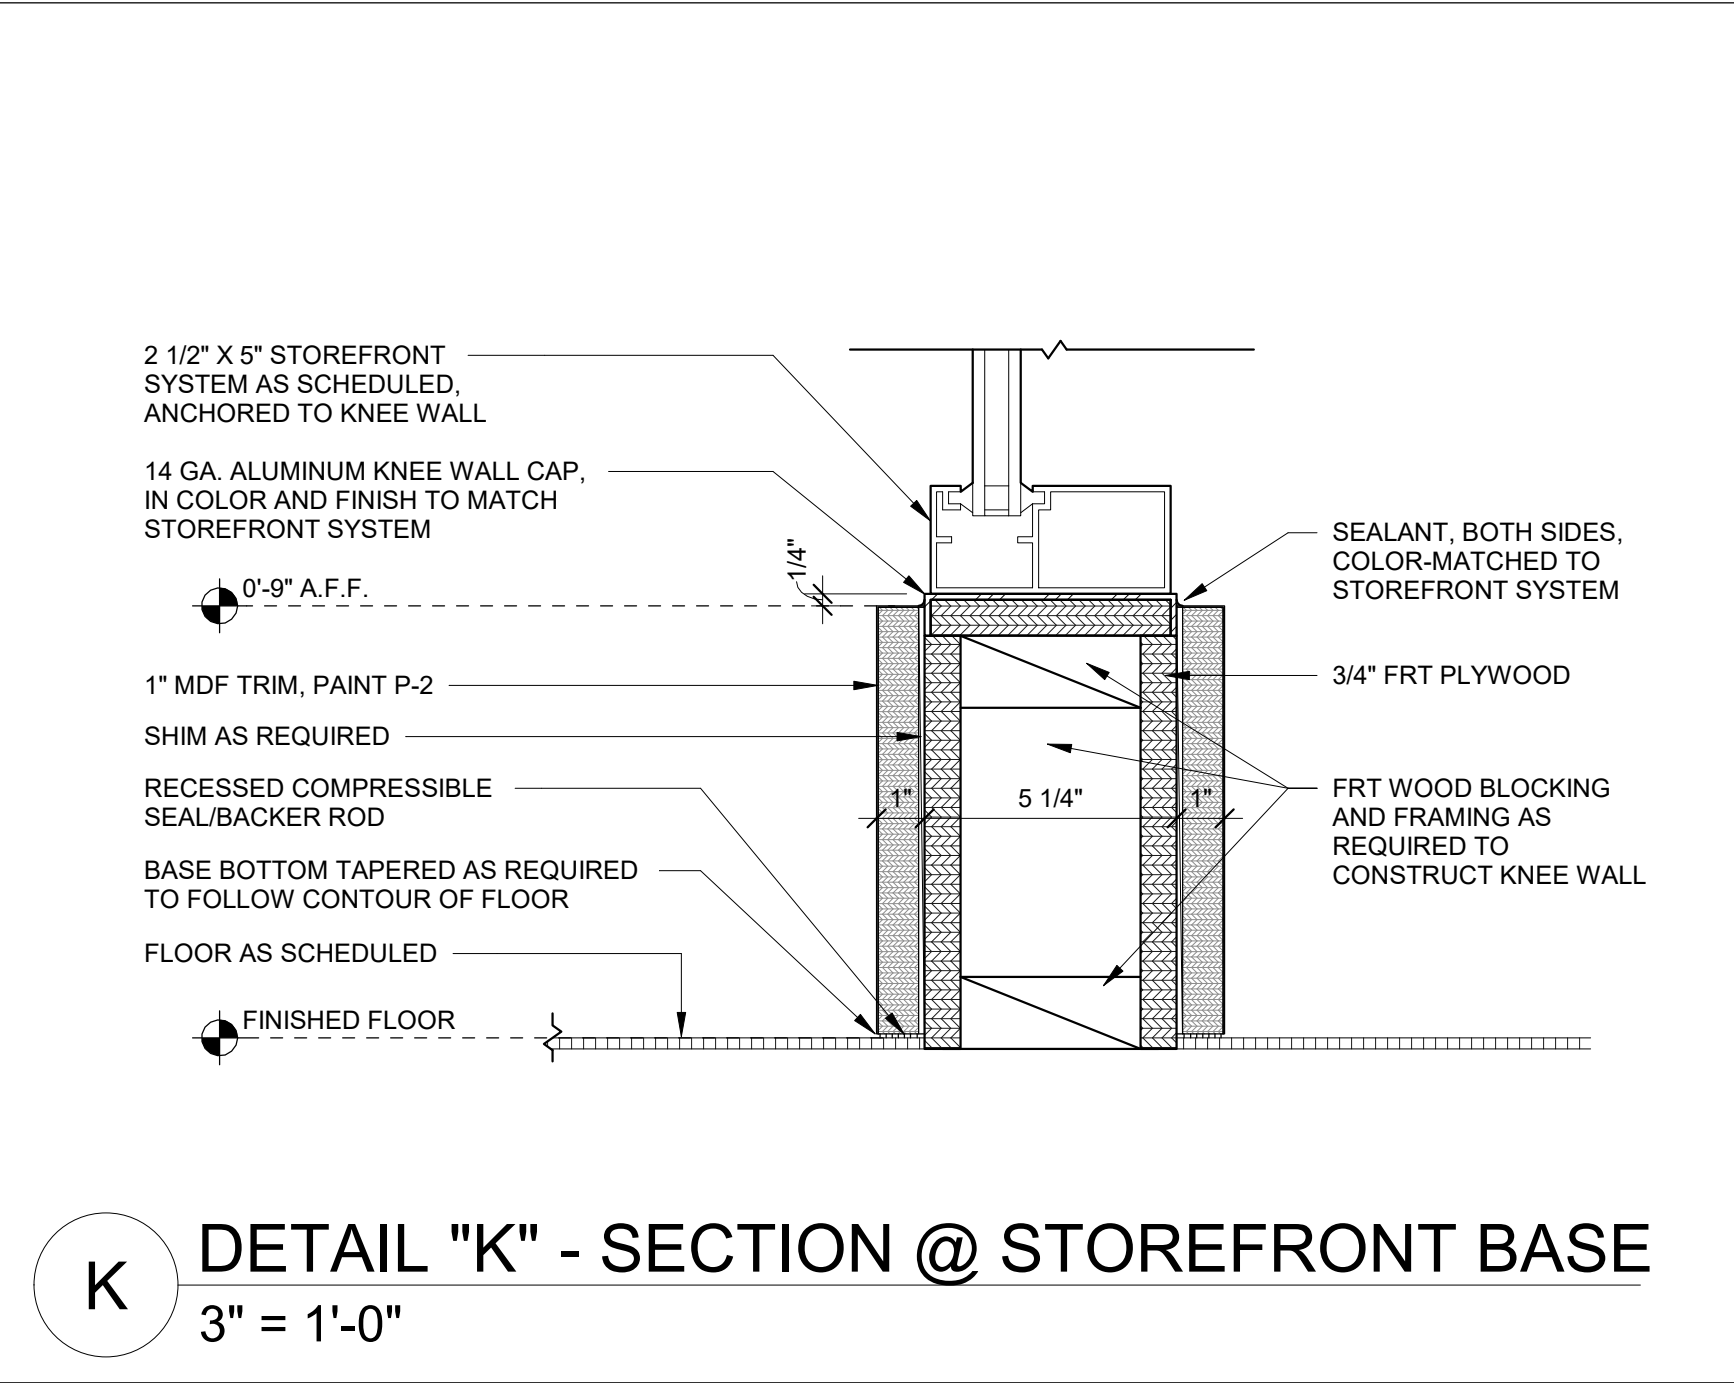


**K** DETAIL "K" - SECTION @ STOREFRONT BASE  
3" = 1'-0"

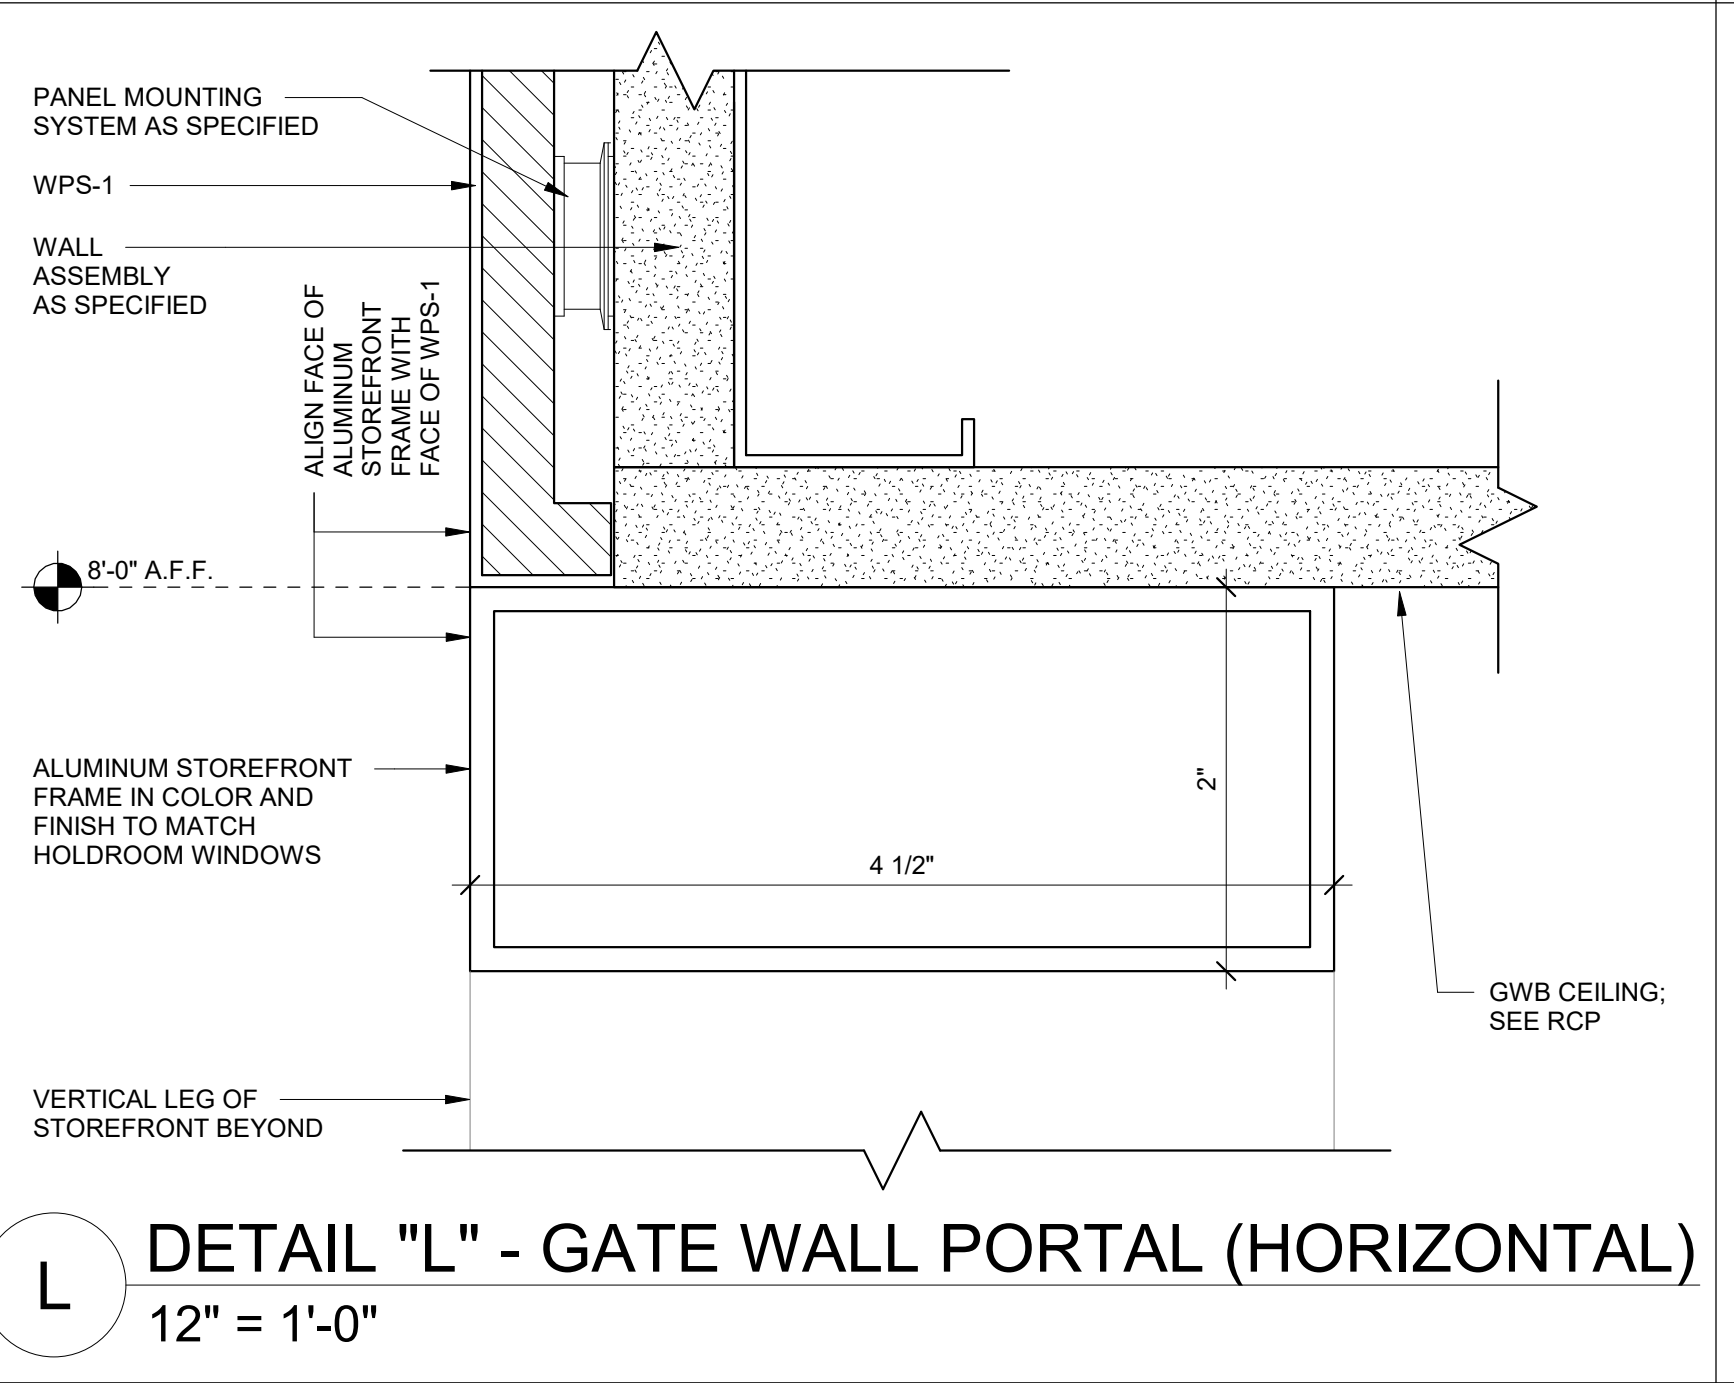


**L** DETAIL "L" - GATE WALL PORTAL (HORIZONTAL)  
12" = 1'-0"

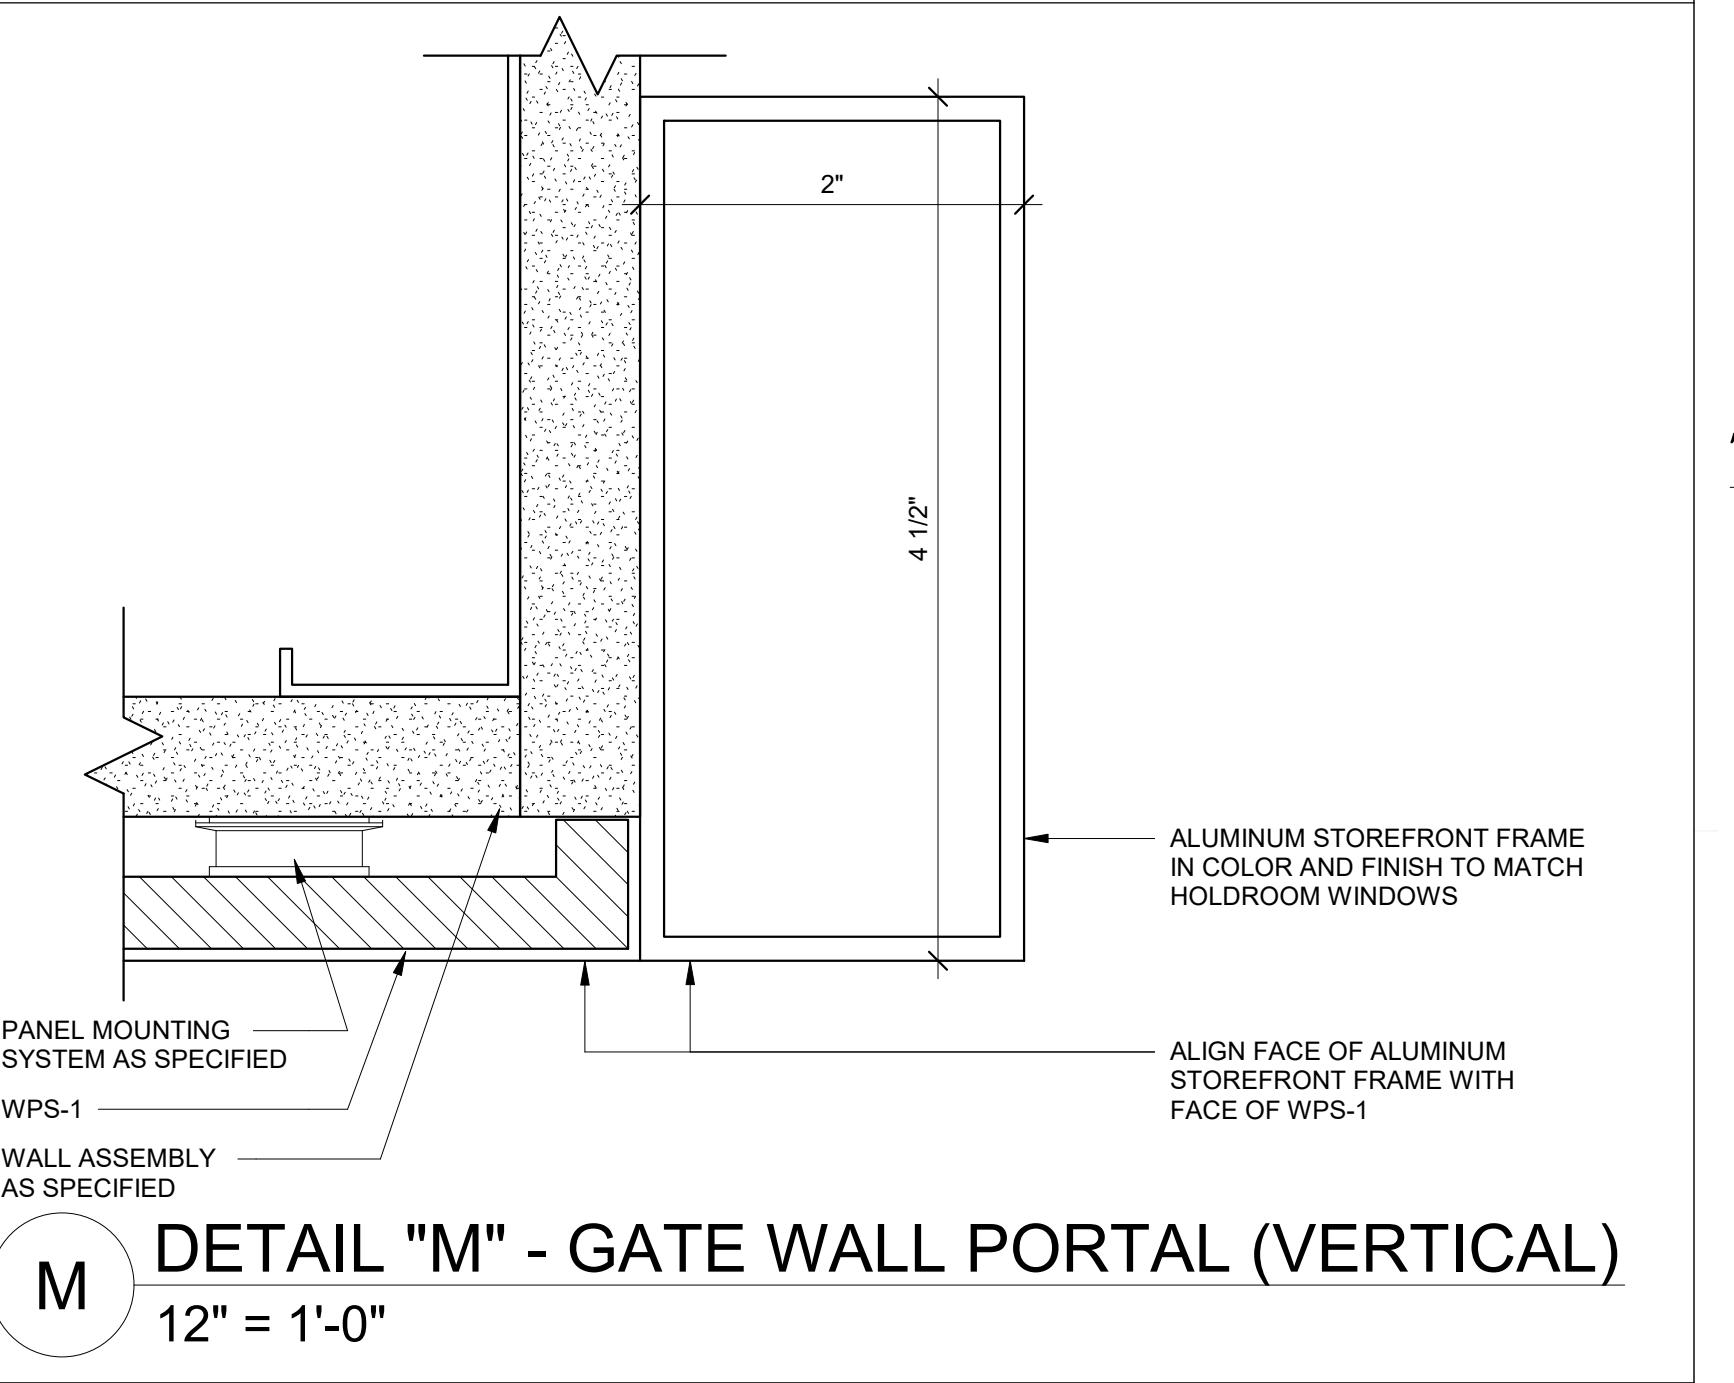


**M** DETAIL "M" - GATE WALL PORTAL (VERTICAL)  
12" = 1'-0"

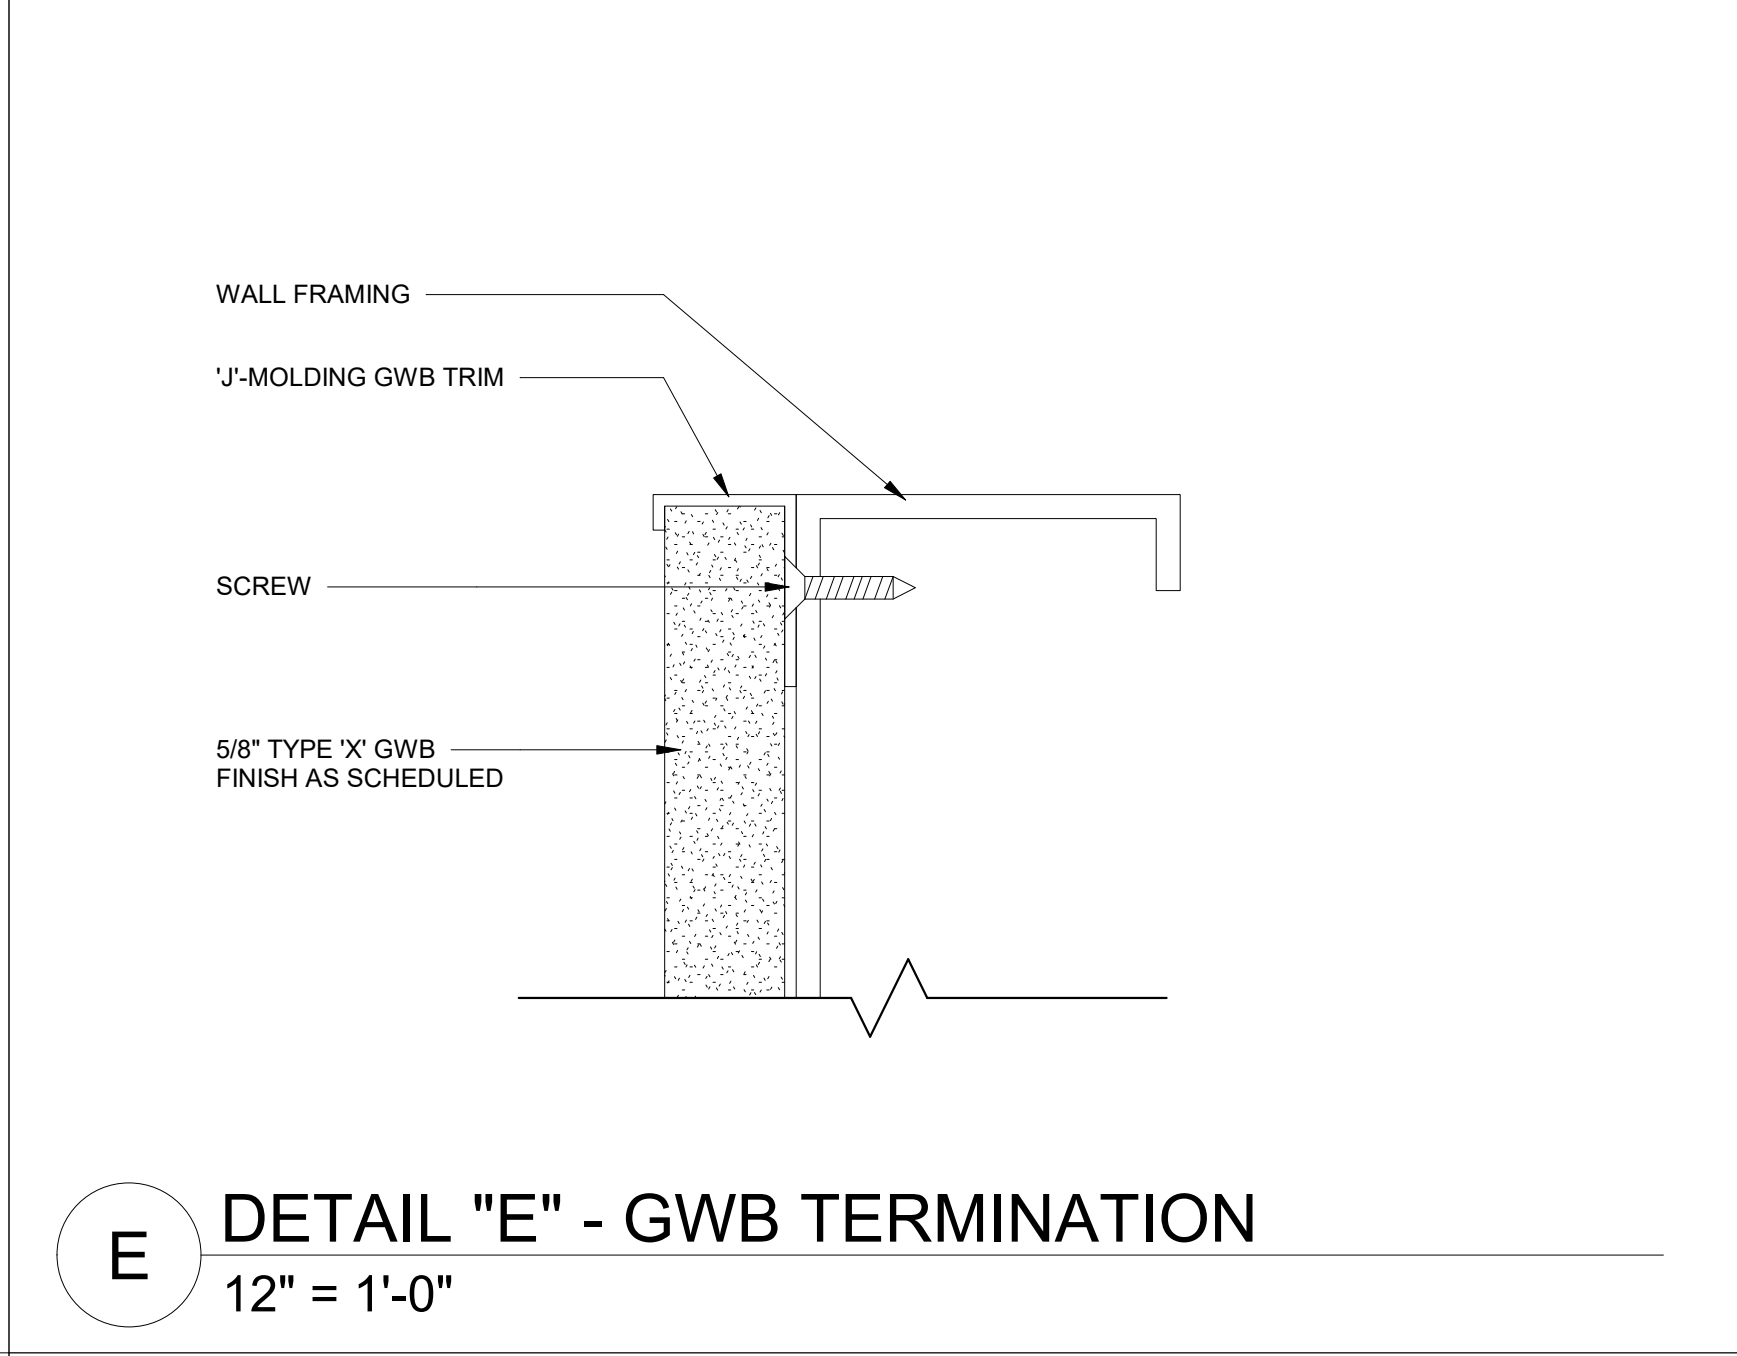


**E** DETAIL "E" - GWB TERMINATION  
12" = 1'-0"

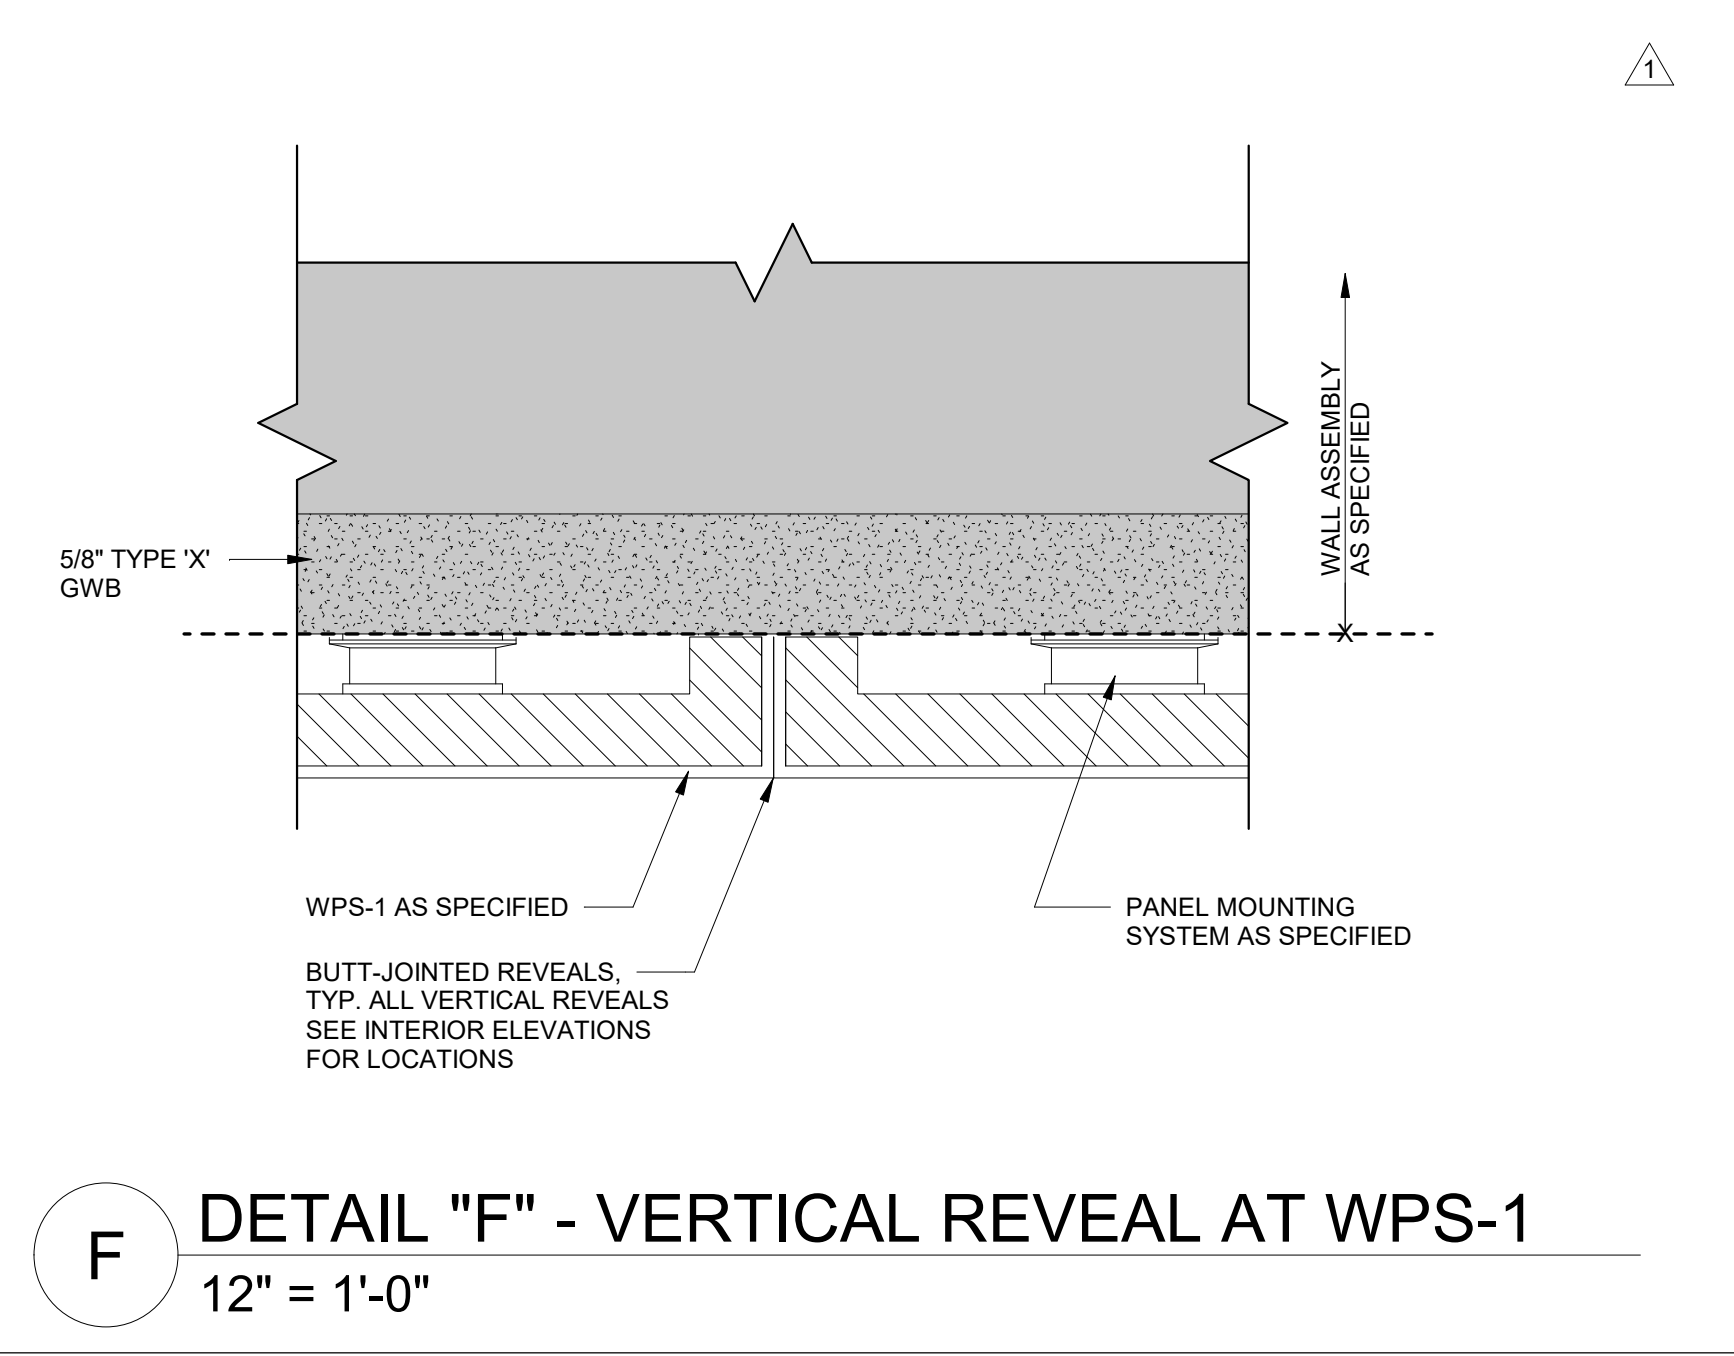


**F** DETAIL "F" - VERTICAL REVEAL AT WPS-1  
12" = 1'-0"

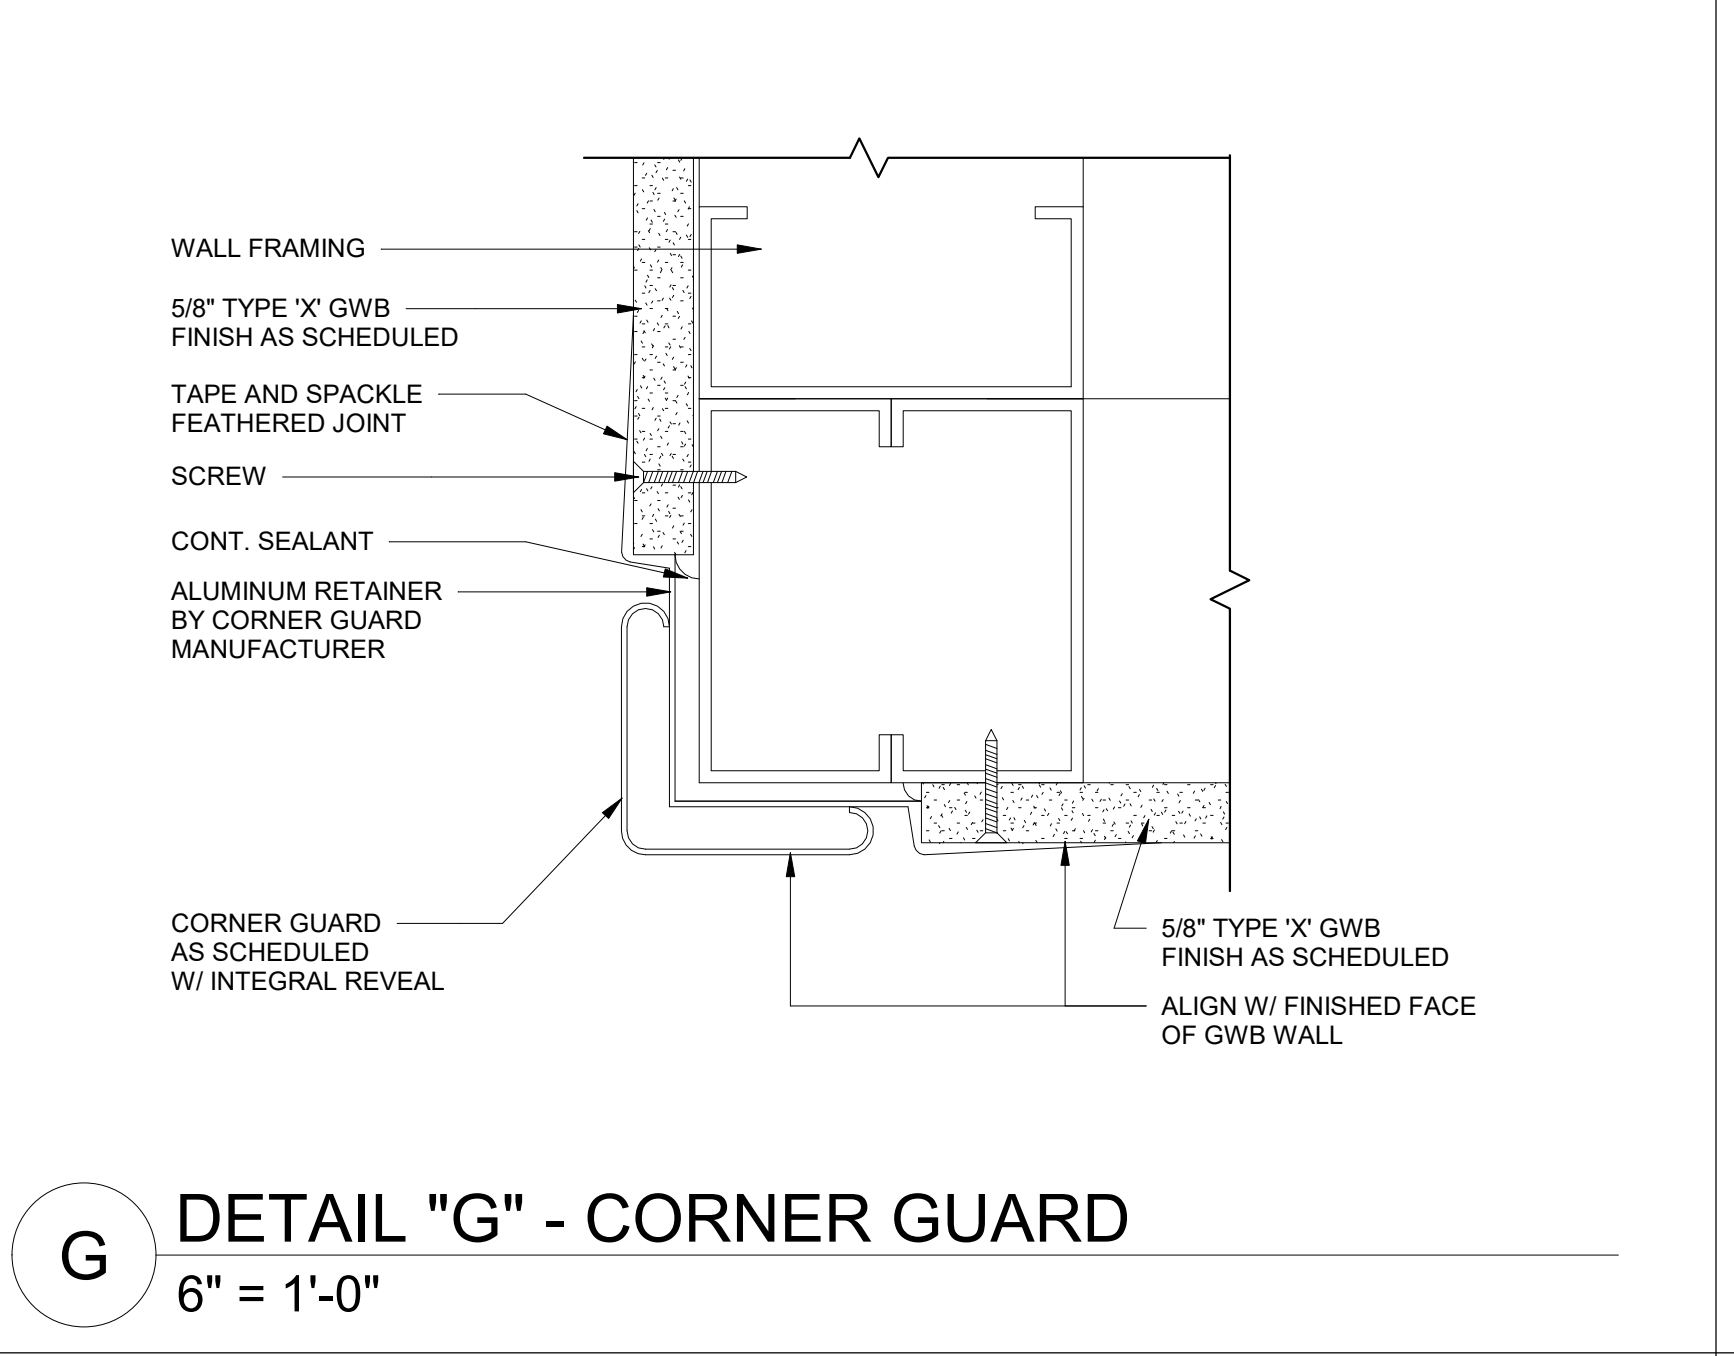


**G** DETAIL "G" - CORNER GUARD  
6" = 1'-0"

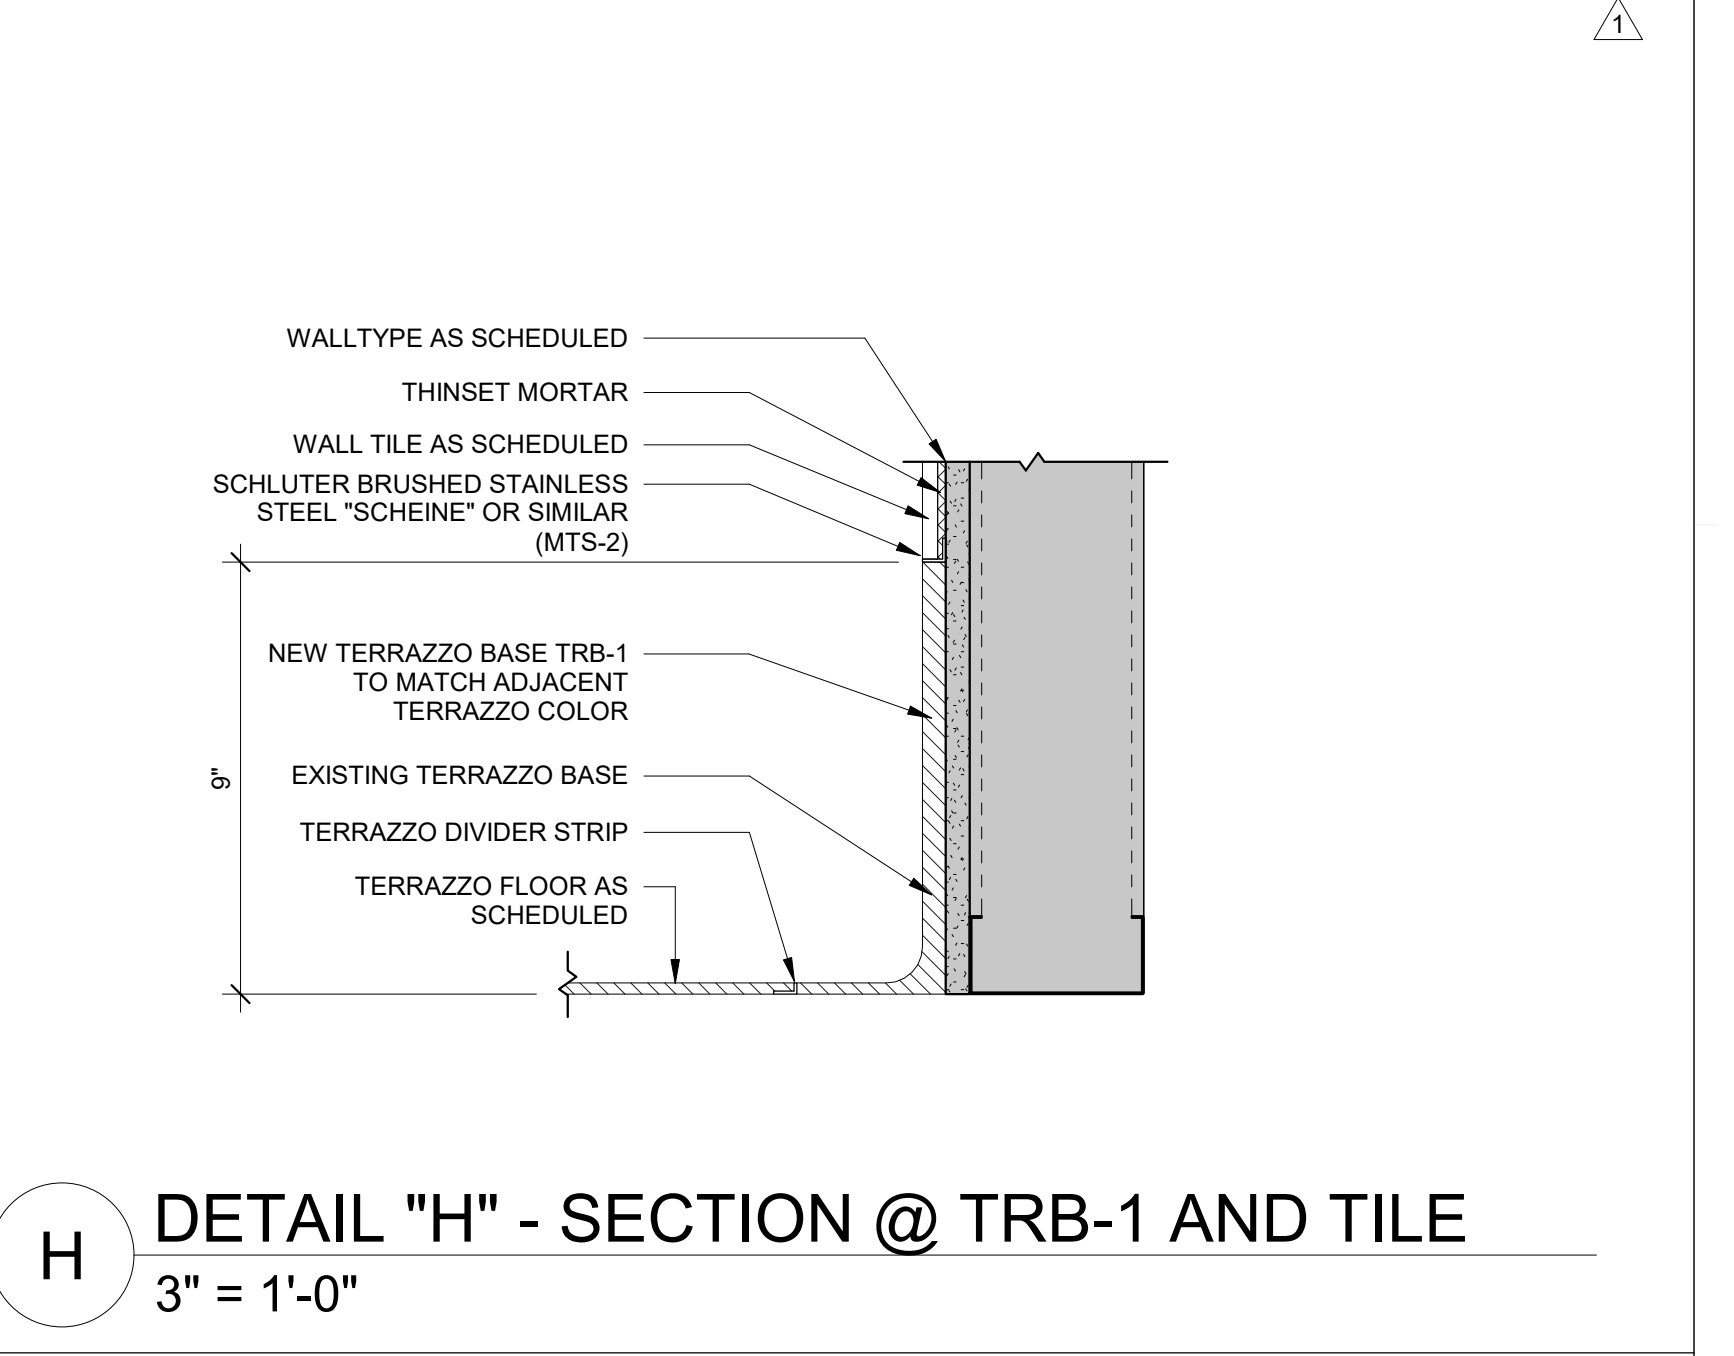


**H** DETAIL "H" - SECTION @ TRB-1 AND TILE  
3" = 1'-0"

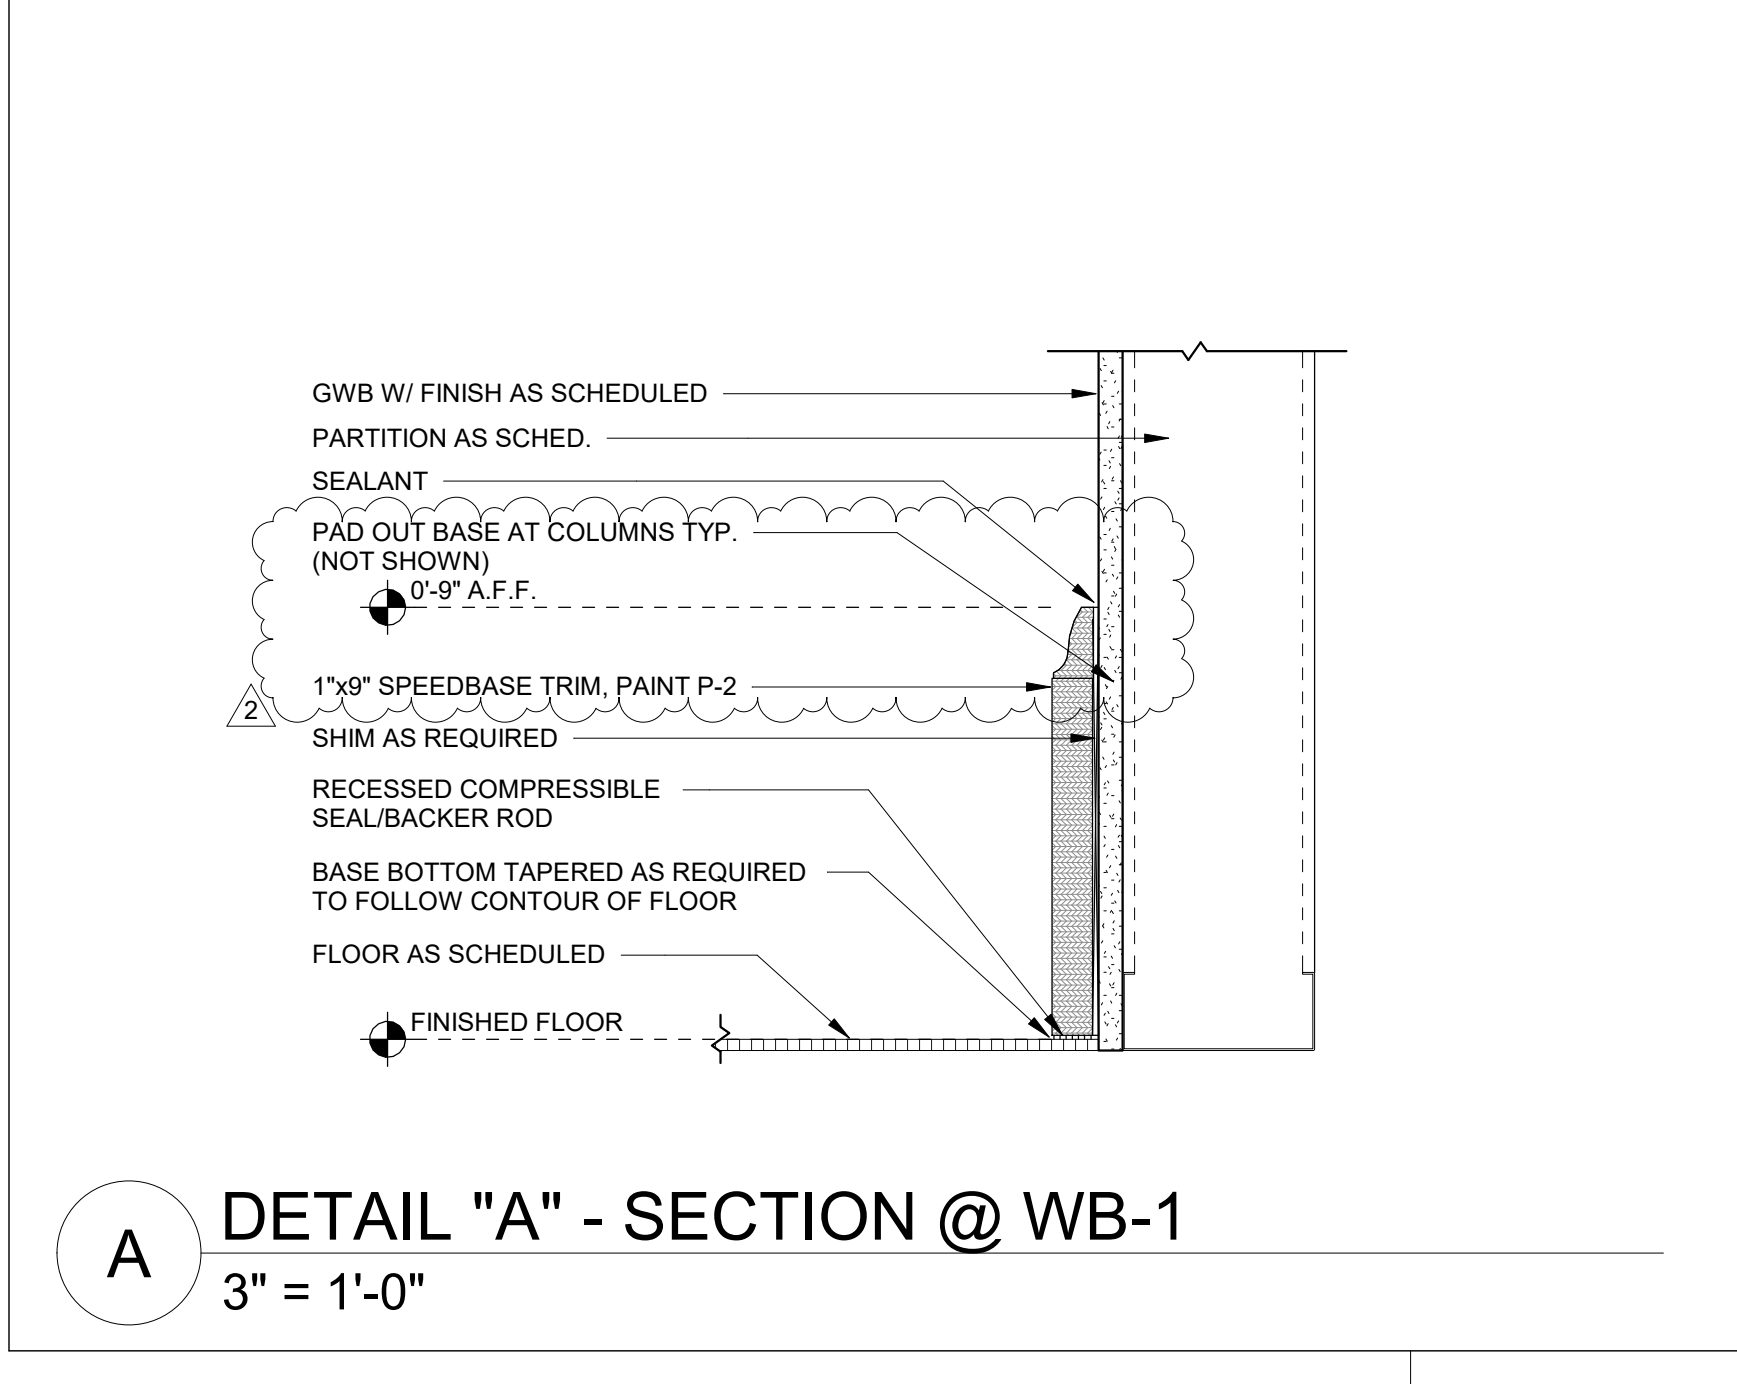


**A** DETAIL "A" - SECTION @ WB-1  
3" = 1'-0"

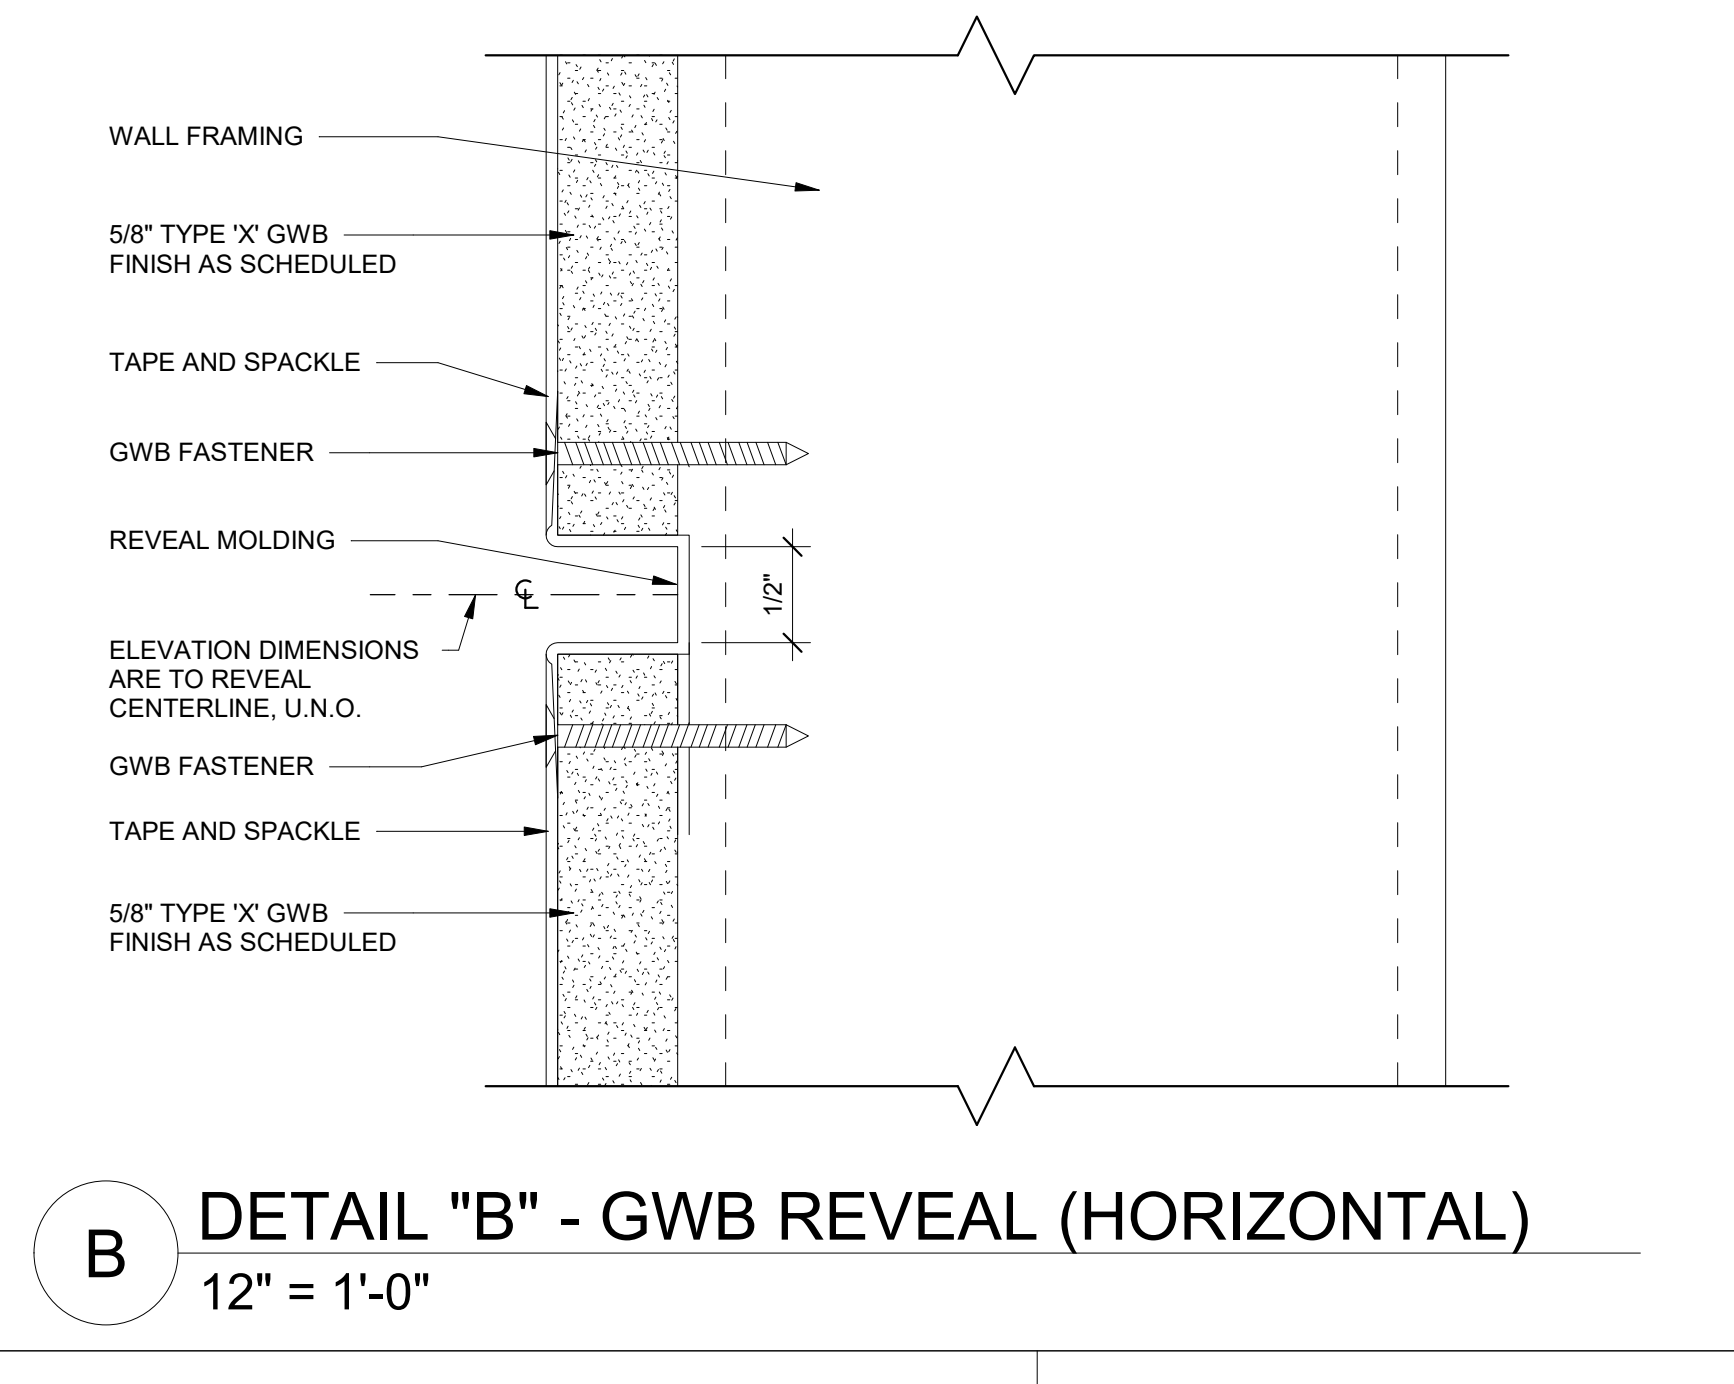


**B** DETAIL "B" - GWB REVEAL (HORIZONTAL)  
12" = 1'-0"

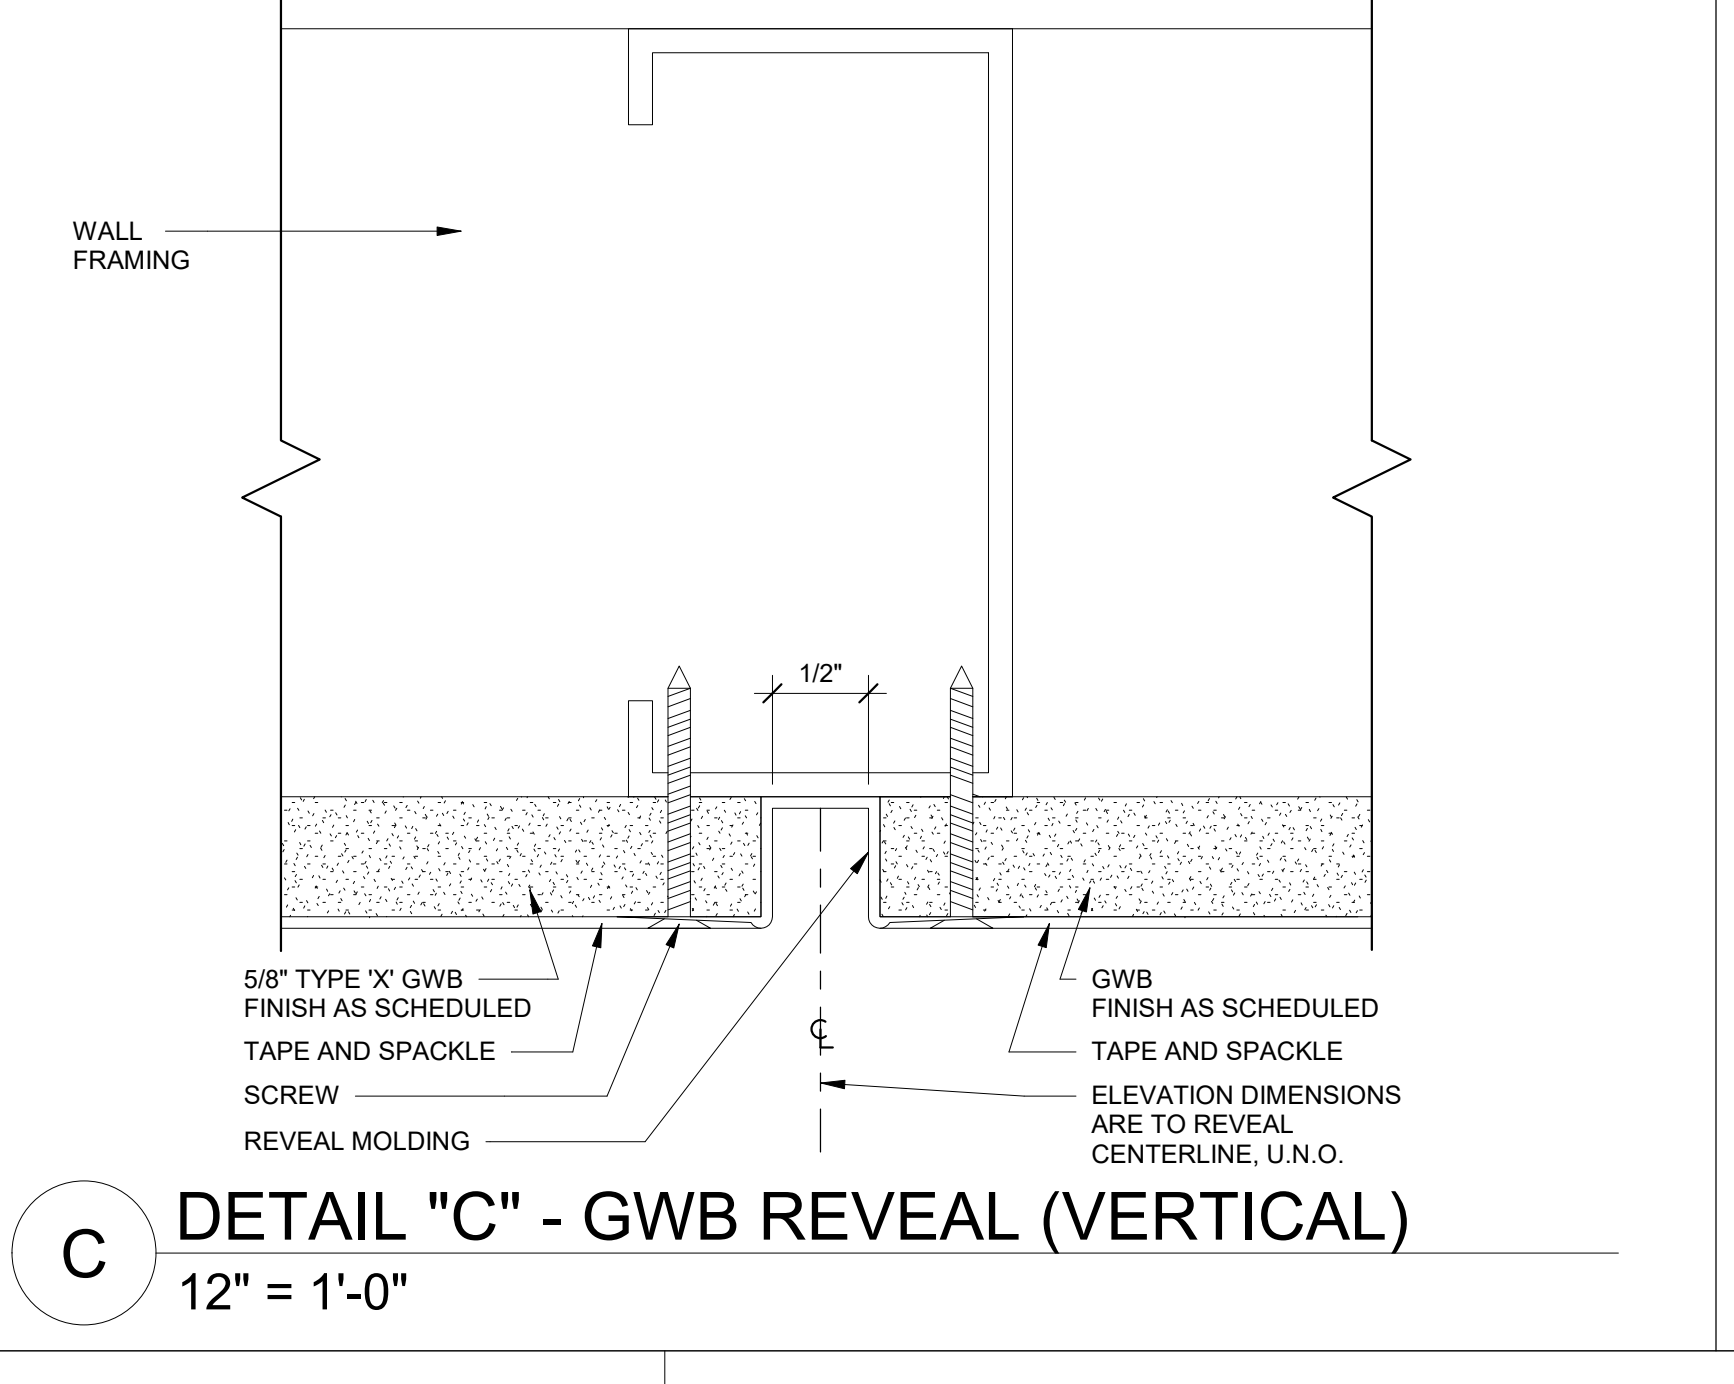

**C** DETAIL "C" - GWB REVEAL (VERTICAL)  
12" = 1'-0"

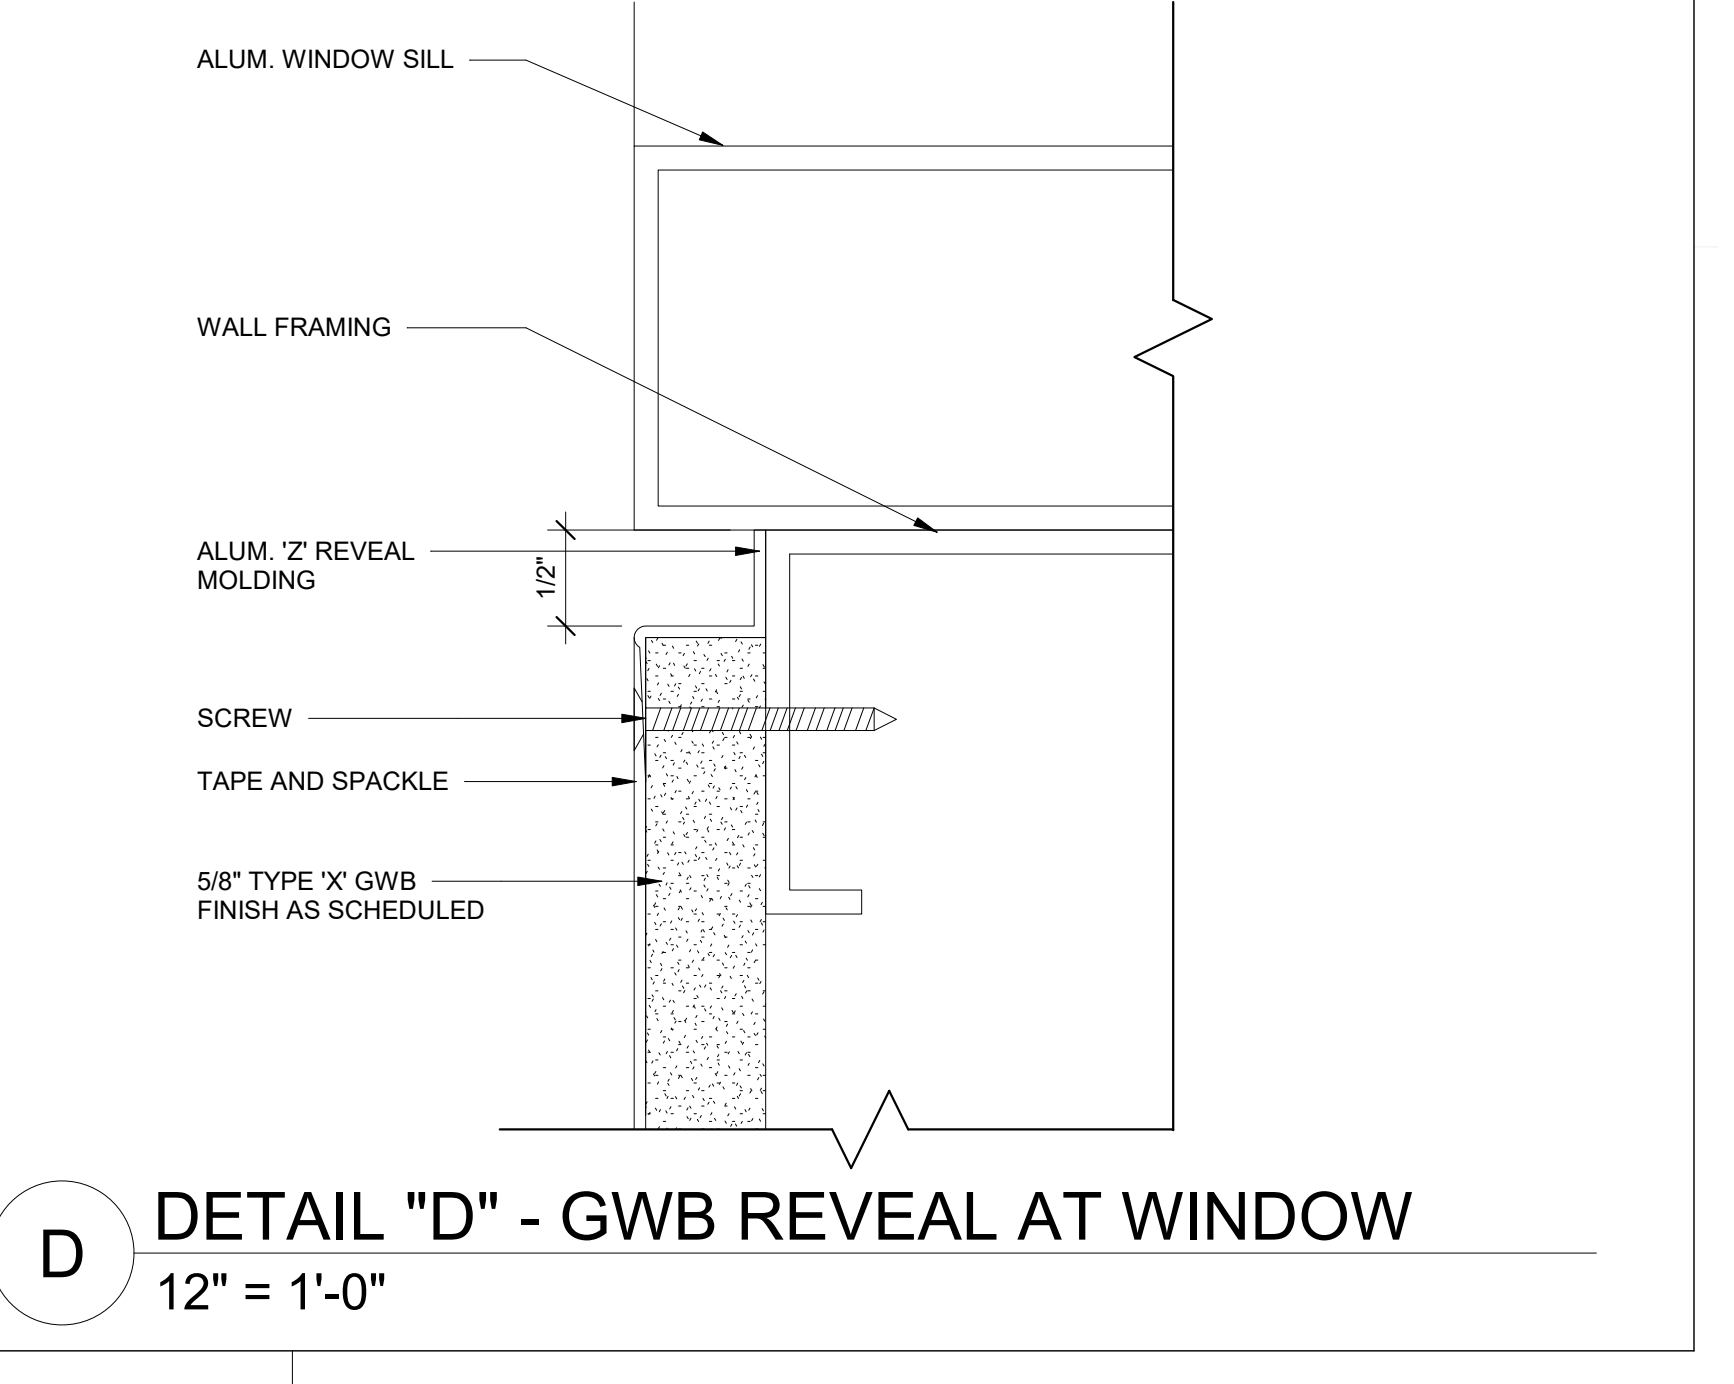

**D** DETAIL "D" - GWB REVEAL AT WINDOW  
12" = 1'-0"

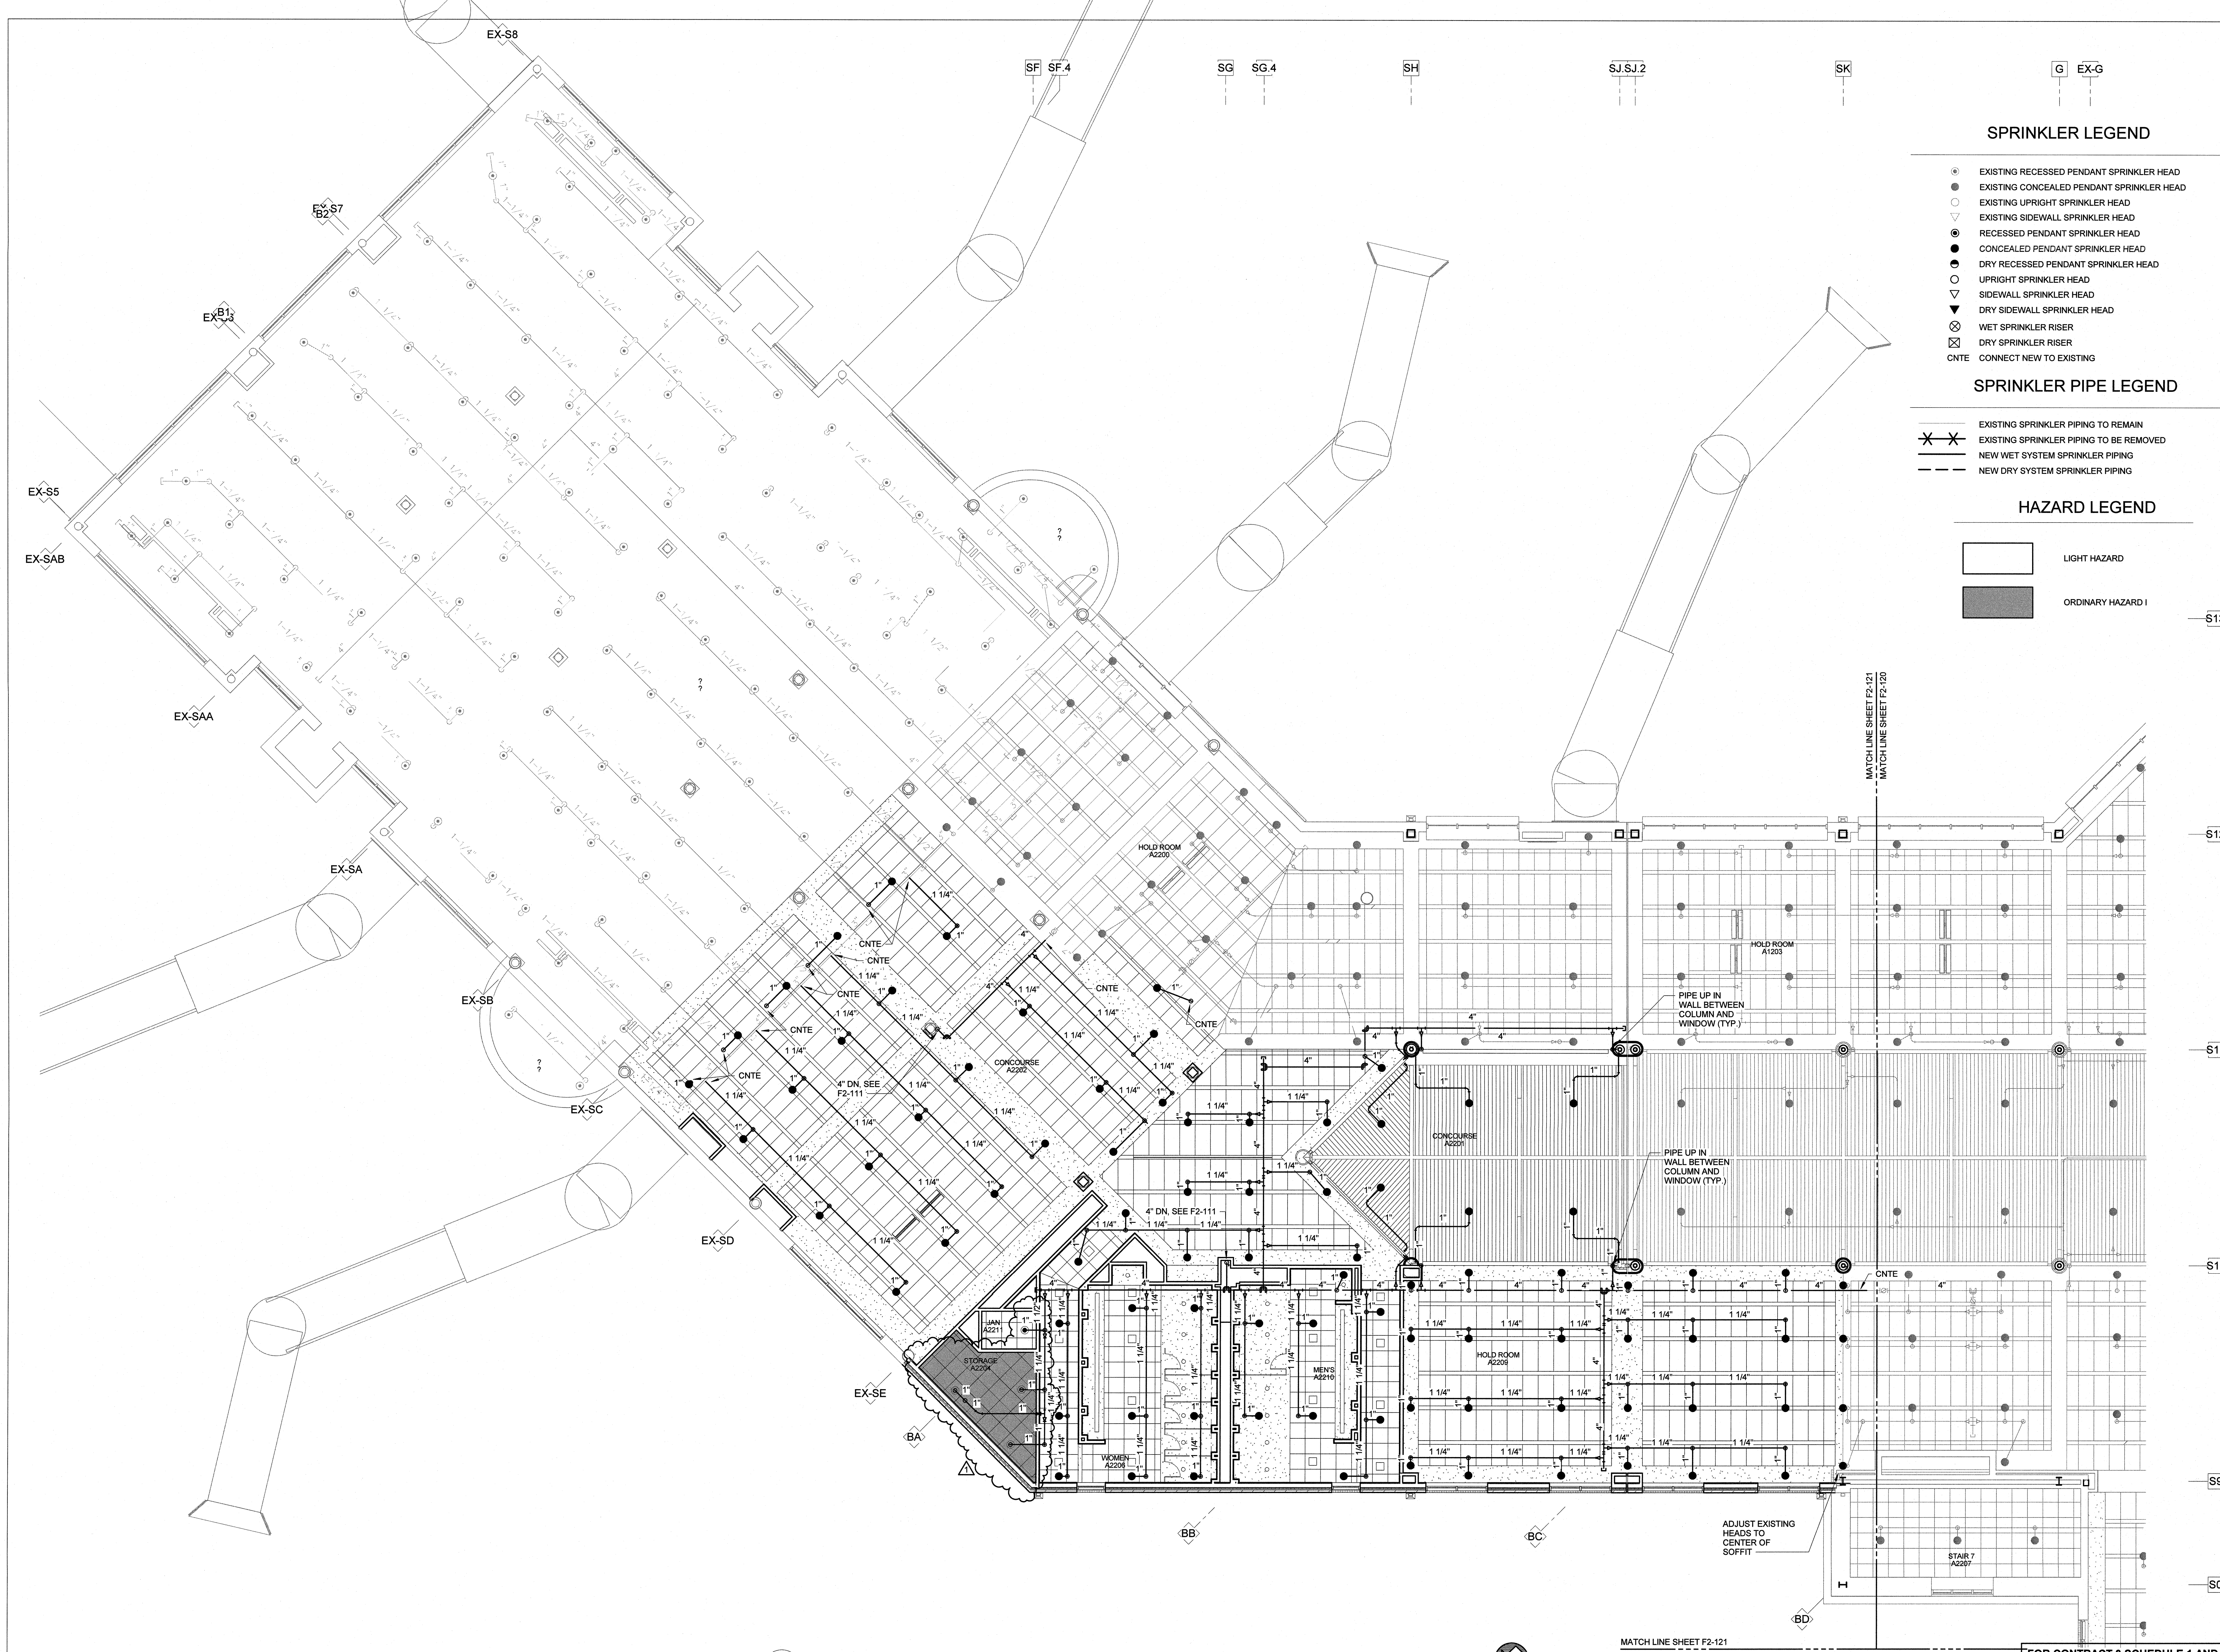

**SPRINKLER LEGEND**

- EXISTING RECESSED PENDANT SPRINKLER HEAD
- EXISTING CONCEALED PENDANT SPRINKLER HEAD
- EXISTING UPRIGHT SPRINKLER HEAD
- ▽ EXISTING SIDEWALL SPRINKLER HEAD
- RECESSED PENDANT SPRINKLER HEAD
- CONCEALED PENDANT SPRINKLER HEAD
- DRY RECESSED PENDANT SPRINKLER HEAD
- UPRIGHT SPRINKLER HEAD
- ▽ SIDEWALL SPRINKLER HEAD
- ▽ DRY SIDEWALL SPRINKLER HEAD
- ⊗ WET SPRINKLER RISER
- ⊗ DRY SPRINKLER RISER
- CNTX — CONNECT NEW TO EXISTING

**SPRINKLER PIPE LEGEND**

- EXISTING SPRINKLER PIPING TO REMAIN
- EXISTING SPRINKLER PIPING TO BE REMOVED
- NEW WET SYSTEM SPRINKLER PIPING
- NEW DRY SYSTEM SPRINKLER PIPING


**HAZARD LEGEND**

- LIGHT HAZARD
- ORDINARY HAZARD I


**1** F2-121 SCHEDULE 2 - BOARDING LEVEL CEILING PLAN - ZONE 1 - FIRE PROTECTION  
 SCALE: 1/8" = 1'-0"

MATCH LINE SHEET F2-121  
 MATCH LINE SHEET F2-123

FOR CONTRACT 3 SCHEDULE 1 AND SCHEDULE 2 WORK PHASES:  
 • SEE ARCHITECTURAL PLANS A-01\* SERIES FOR ADDITIONAL AND DETAILED PHASING INFORMATION.  
 • SEE BAGGAGE HANDLING SYSTEM PLANS B-\* SERIES FOR ADDITIONAL AND DETAILED PHASING INFORMATION.  
 • COORDINATE ACTUAL PHASED WORK REQUIREMENTS WITH THE GENERAL CONTRACTOR'S SCHEDULE.

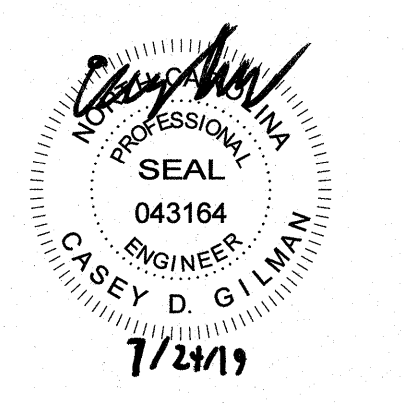

- PROJECT MANAGER & CIVIL ENGINEER  
**TALBERT & BRIGHT**  
CONSULTING ARCHITECT  
LS3P
- STRUCTURAL ENGINEER  
**STEWART**
- FFP/ME ENGINEER  
**CHEATHAM & ASSOC.**
- BAGGAGE HANDLING CONSULTANTS  
**BNP**
- AIRCRAFT SUPPORT SYSTEMS  
**DK CONSULTANTS**
- SPECIALTY LIGHTING CONSULTANT  
**HARTRANFT**
- SIGNAGE & WAYFINDING  
**TAKEFORM**

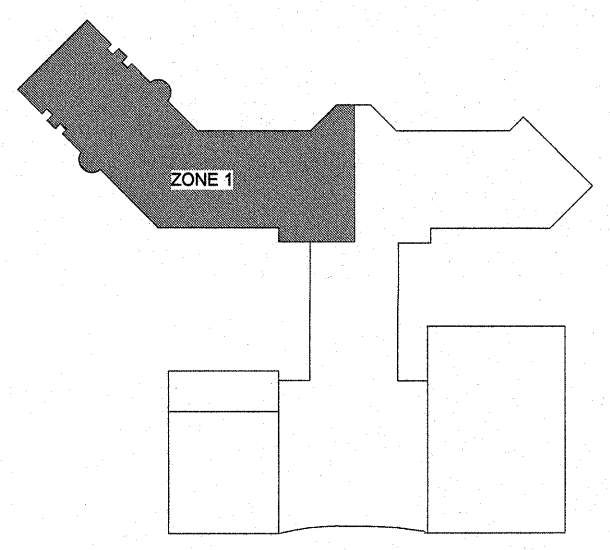

**KEY PLAN**  
 COPYRIGHT © 2019  
 THE WILSON GROUP ARCHITECTS  
 ALL RIGHTS RESERVED

PRINTED OR ELECTRONIC DRAWINGS AND DOCUMENTATION MAY NOT BE REPRODUCED IN ANY FORM WITHOUT WRITTEN PERMISSION FROM THE WILSON GROUP ARCHITECTS

**REVISIONS**

1	7/26/19	AD-03
---	---------	-------

DATE 06/28/19  
 PROJECT NUMBER 9202-000  
 SHEET TITLE

**SCHEDULE 2 - BOARDING LEVEL PLAN ZONE 1 FIRE PROTECTION**

SHEET NUMBER  
**F2-121**





**TERMINAL IMPROVEMENTS CONTRACT 3**

Wilmington International Airport  
1740 Airport Boulevard, Suite 12  
Wilmington, NC 28405

**CHEATHAM & ASSOCIATES, P.A.**  
CONSULTING ENGINEERS  
3412 ENTERPRISE DRIVE  
WILMINGTON, NORTH CAROLINA 28405  
PHONE: (910) 452-4210  
FAX: (910) 452-4211  
OFFICE@CHEATHAMPA.COM  
NC LICENSE# C-1073


JOB # 19005

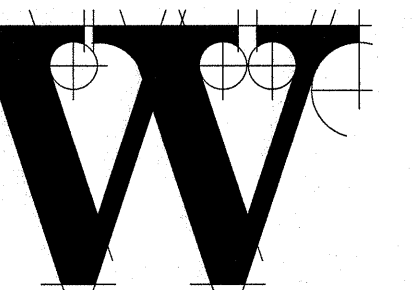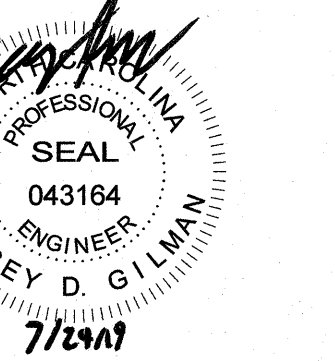

**THE WILSON GROUP**

- ARCHITECTS -  
PO Box 5510 Charlotte, NC 28299  
704-331-9747 • www.twgarchitects.com

- PROJECT MANAGER & CIVIL ENGINEER  
**TALBERT & BRIGHT**
- CONSULTING ARCHITECT  
**LS3P**
- STRUCTURAL ENGINEER  
**STEWART**
- FP/PAE ENGINEER  
**CHEATHAM & ASSOC.**
- BAGGAGE HANDLING CONSULTANTS  
**BNP**
- AIRCRAFT SUPPORT SYSTEMS  
**DK CONSULTANTS**
- SPECIALTY LIGHTING CONSULTANT  
**HARTRANFT**
- SIGNAGE & WAYFINDING  
**TAKEFORM**

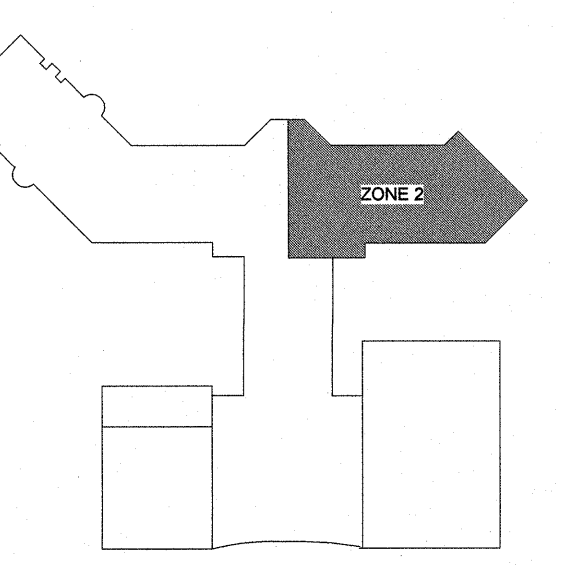

**KEY PLAN**

COPYRIGHT © 2019  
THE WILSON GROUP ARCHITECTS  
ALL RIGHTS RESERVED.  
PRINTED OR ELECTRONIC DRAWINGS AND DOCUMENTATION MAY NOT BE REPRODUCED IN ANY FORM WITHOUT WRITTEN PERMISSION FROM THE WILSON GROUP ARCHITECTS

**REVISIONS**


- 7/12/19 AD-01
- 7/26/19 AD-03

DATE 06/28/19  
PROJECT NUMBER 9202-000  
SHEET TITLE

**SCHEDULE 1 - RAMP LEVEL PLAN ZONE 2 PLUMBING**

SHEET NUMBER

**P1-112**

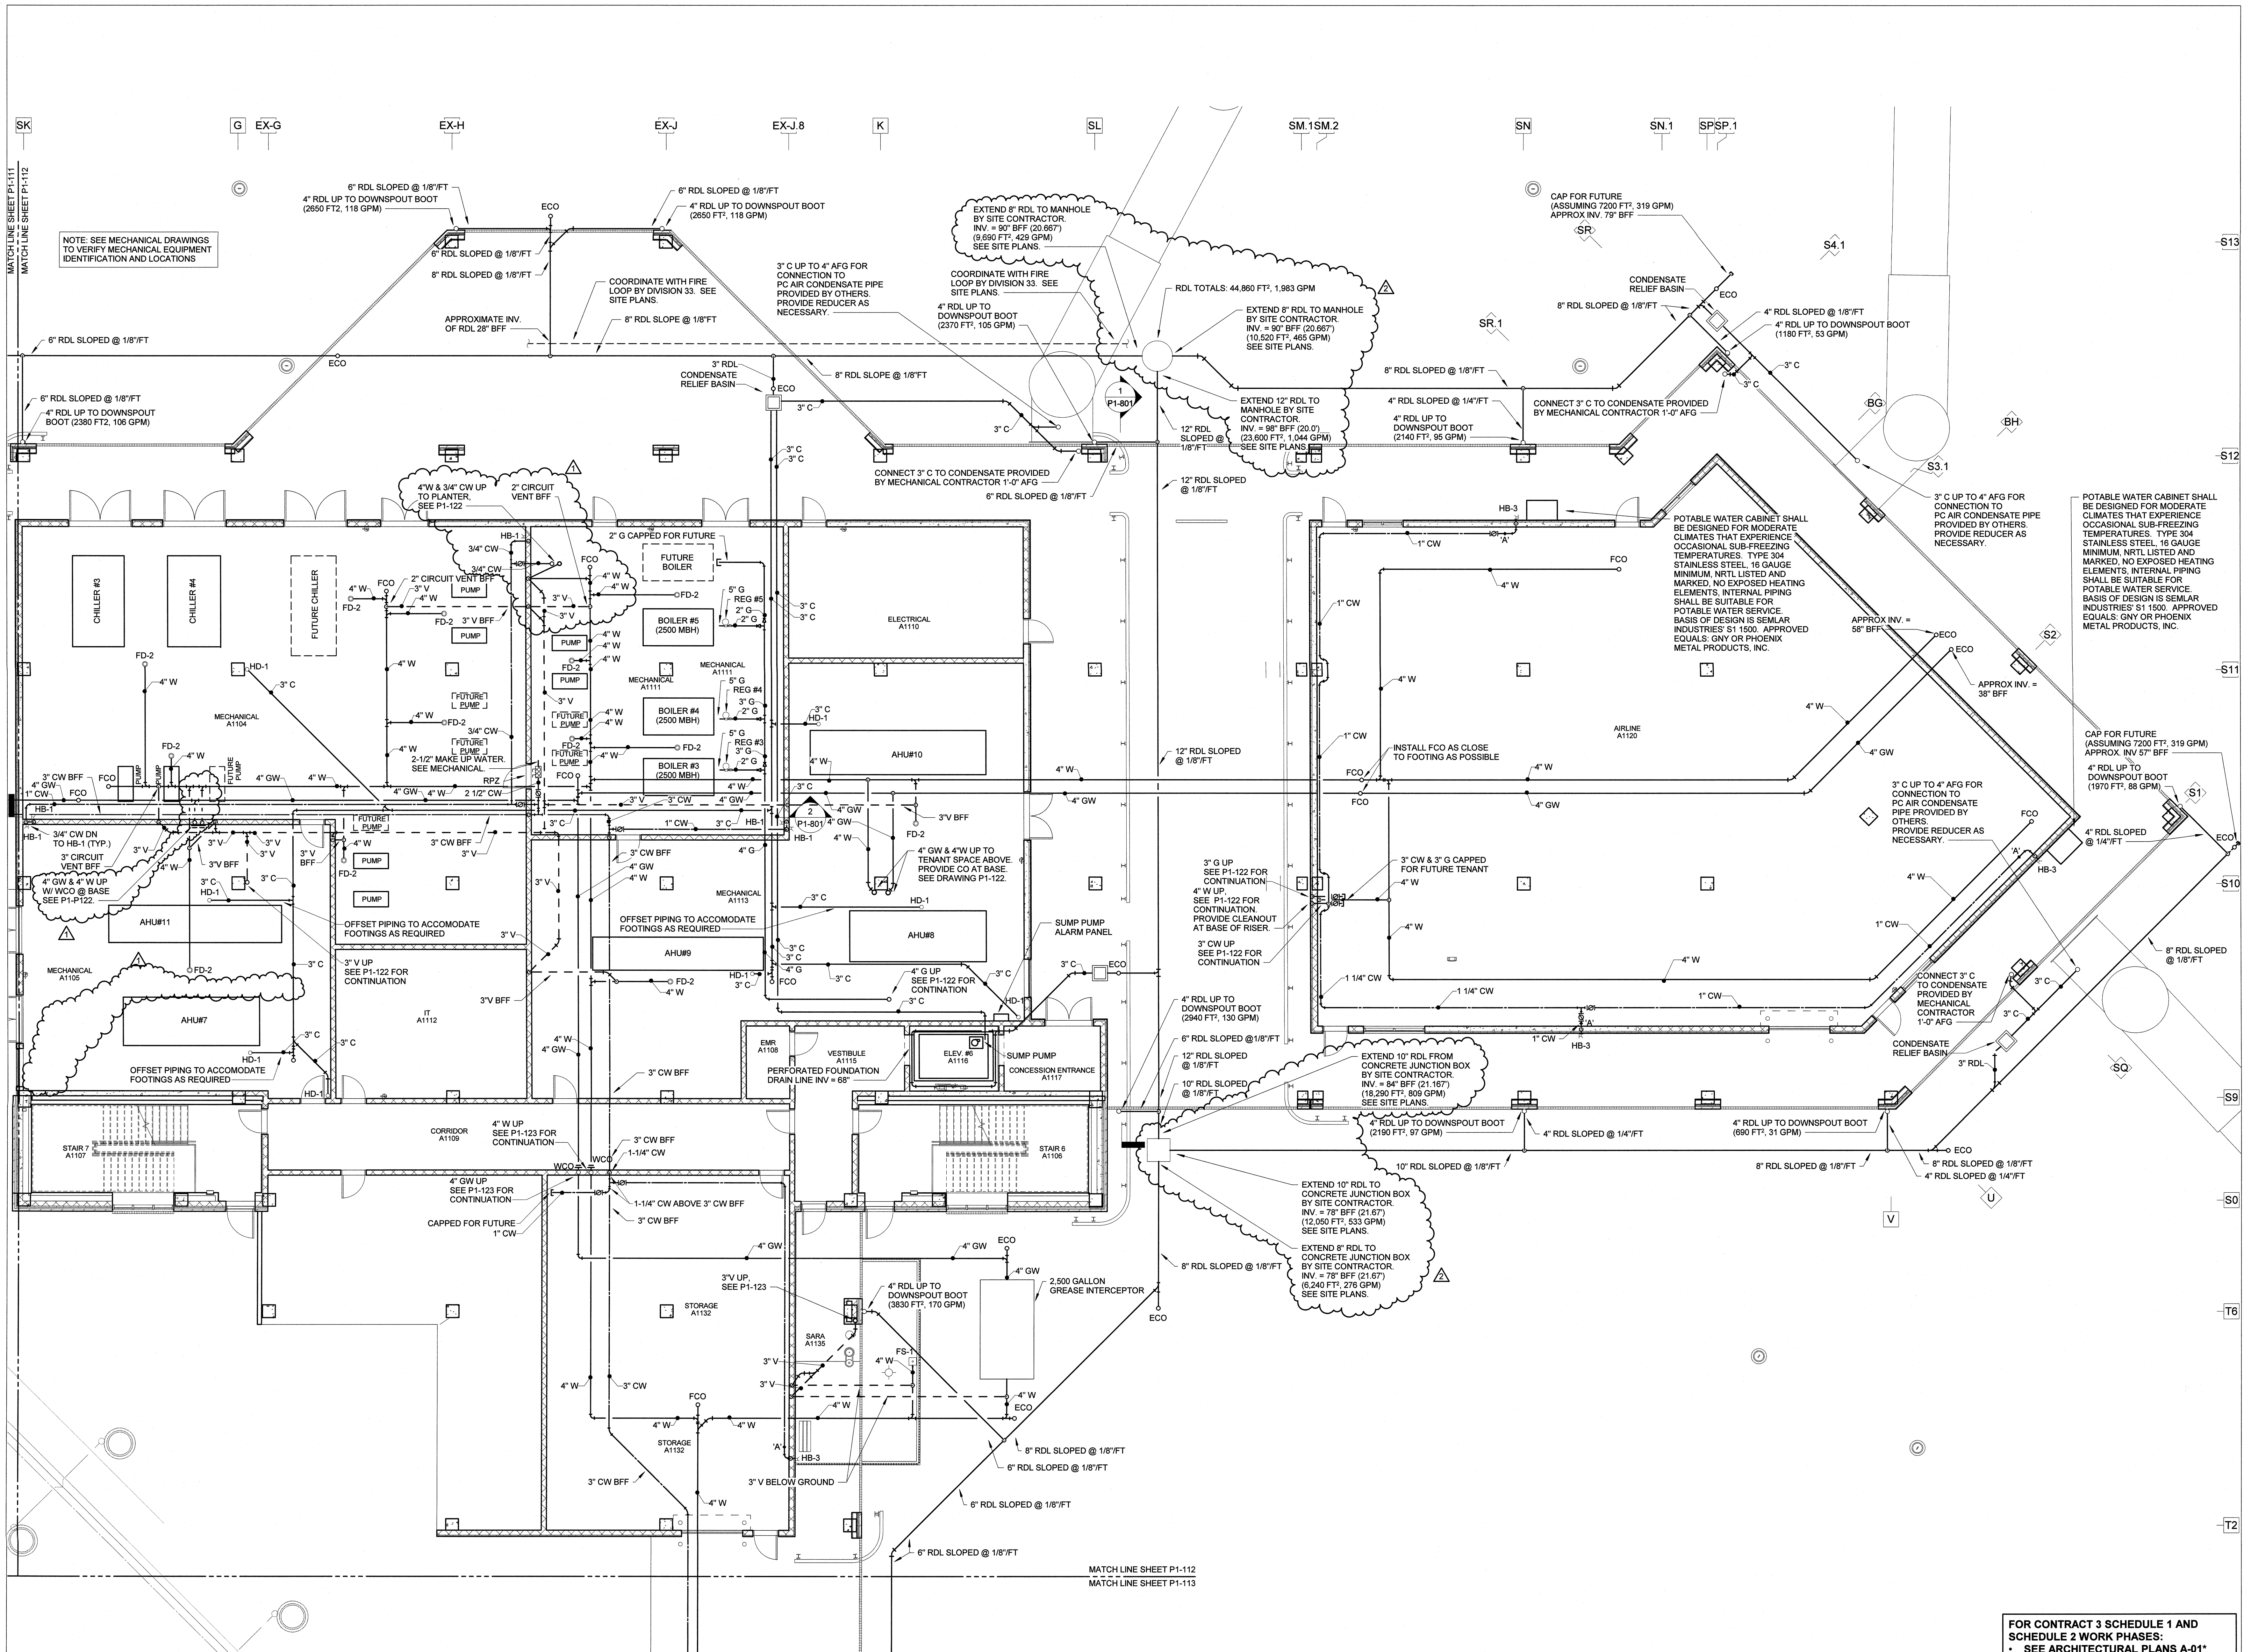

NOTE: SEE MECHANICAL DRAWINGS TO VERIFY MECHANICAL EQUIPMENT IDENTIFICATION AND LOCATIONS

FOR CONTRACT 3 SCHEDULE 1 AND SCHEDULE 2 WORK PHASES:  
• SEE ARCHITECTURAL PLANS A-01\* SERIES FOR ADDITIONAL AND DETAILED PHASING INFORMATION.  
• SEE BAGGAGE HANDLING SYSTEM PLANS B-\* SERIES FOR ADDITIONAL AND DETAILED PHASING INFORMATION.  
• COORDINATE ACTUAL PHASED WORK REQUIREMENTS WITH THE GENERAL CONTRACTOR'S SCHEDULE.

**1 SCHEDULE 1 - RAMP LEVEL FLOOR PLAN - ZONE 2 - PLUMBING**  
SCALE: 1/8" = 1'-0"

MATCH LINE SHEET P1-112  
MATCH LINE SHEET P1-113





**TERMINAL IMPROVEMENTS CONTRACT 3**

Wilmington International Airport  
1740 Airport Boulevard, Suite 12  
Wilmington, NC 28405

**CHEATHAM & ASSOCIATES, P.A.**  
CONSULTING ENGINEERS  
3412 ENTERPRISE DRIVE  
WILMINGTON, NORTH CAROLINA 28405  
PHONE: (910) 452-4210  
FAX: (910) 452-4211  
OFFICE@CHEATHAMPA.COM  
NC LICENSE# C-1073

JOB # 19005

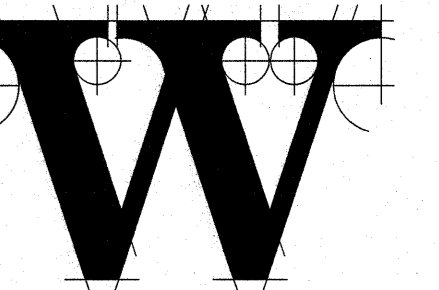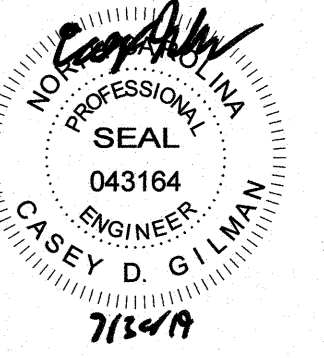

**THE WILSON GROUP ARCHITECTS**

PO Box 5510 Charlotte, NC 28299  
704-331-9747 • www.twgarchitects.com

PROJECT MANAGER & CIVIL ENGINEER  
**TALBERT & BRIGHT**  
CONSULTING ARCHITECT  
LS3P

STRUCTURAL ENGINEER  
**STEWART**


FP/PM/E ENGINEER  
**CHEATHAM & ASSOC.**

BAGGAGE HANDLING CONSULTANTS  
**BNP**

AIRCRAFT SUPPORT SYSTEMS  
**DK CONSULTANTS**

SPECIALTY LIGHTING CONSULTANT  
**HARTRANFT**

SIGNAGE & WAYFINDING  
**TAKEFORM**

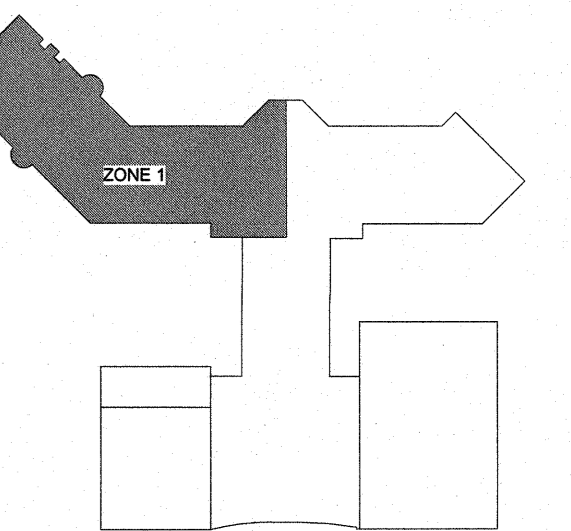

**KEY PLAN**

COPYRIGHT © 2019  
THE WILSON GROUP ARCHITECTS  
ALL RIGHTS RESERVED

PRINTED OR ELECTRONIC DRAWINGS AND DOCUMENTATION MAY NOT BE REPRODUCED IN ANY FORM WITHOUT WRITTEN PERMISSION FROM THE WILSON GROUP ARCHITECTS

**REVISIONS**


1 7/26/19 AD-03

DATE 06/28/19  
PROJECT NUMBER 9202-000  
SHEET TITLE

**SCHEDULE 2 - BOARDING LEVEL FLOOR PLAN ZONE 1 PLUMBING**

SHEET NUMBER





**P2-121**

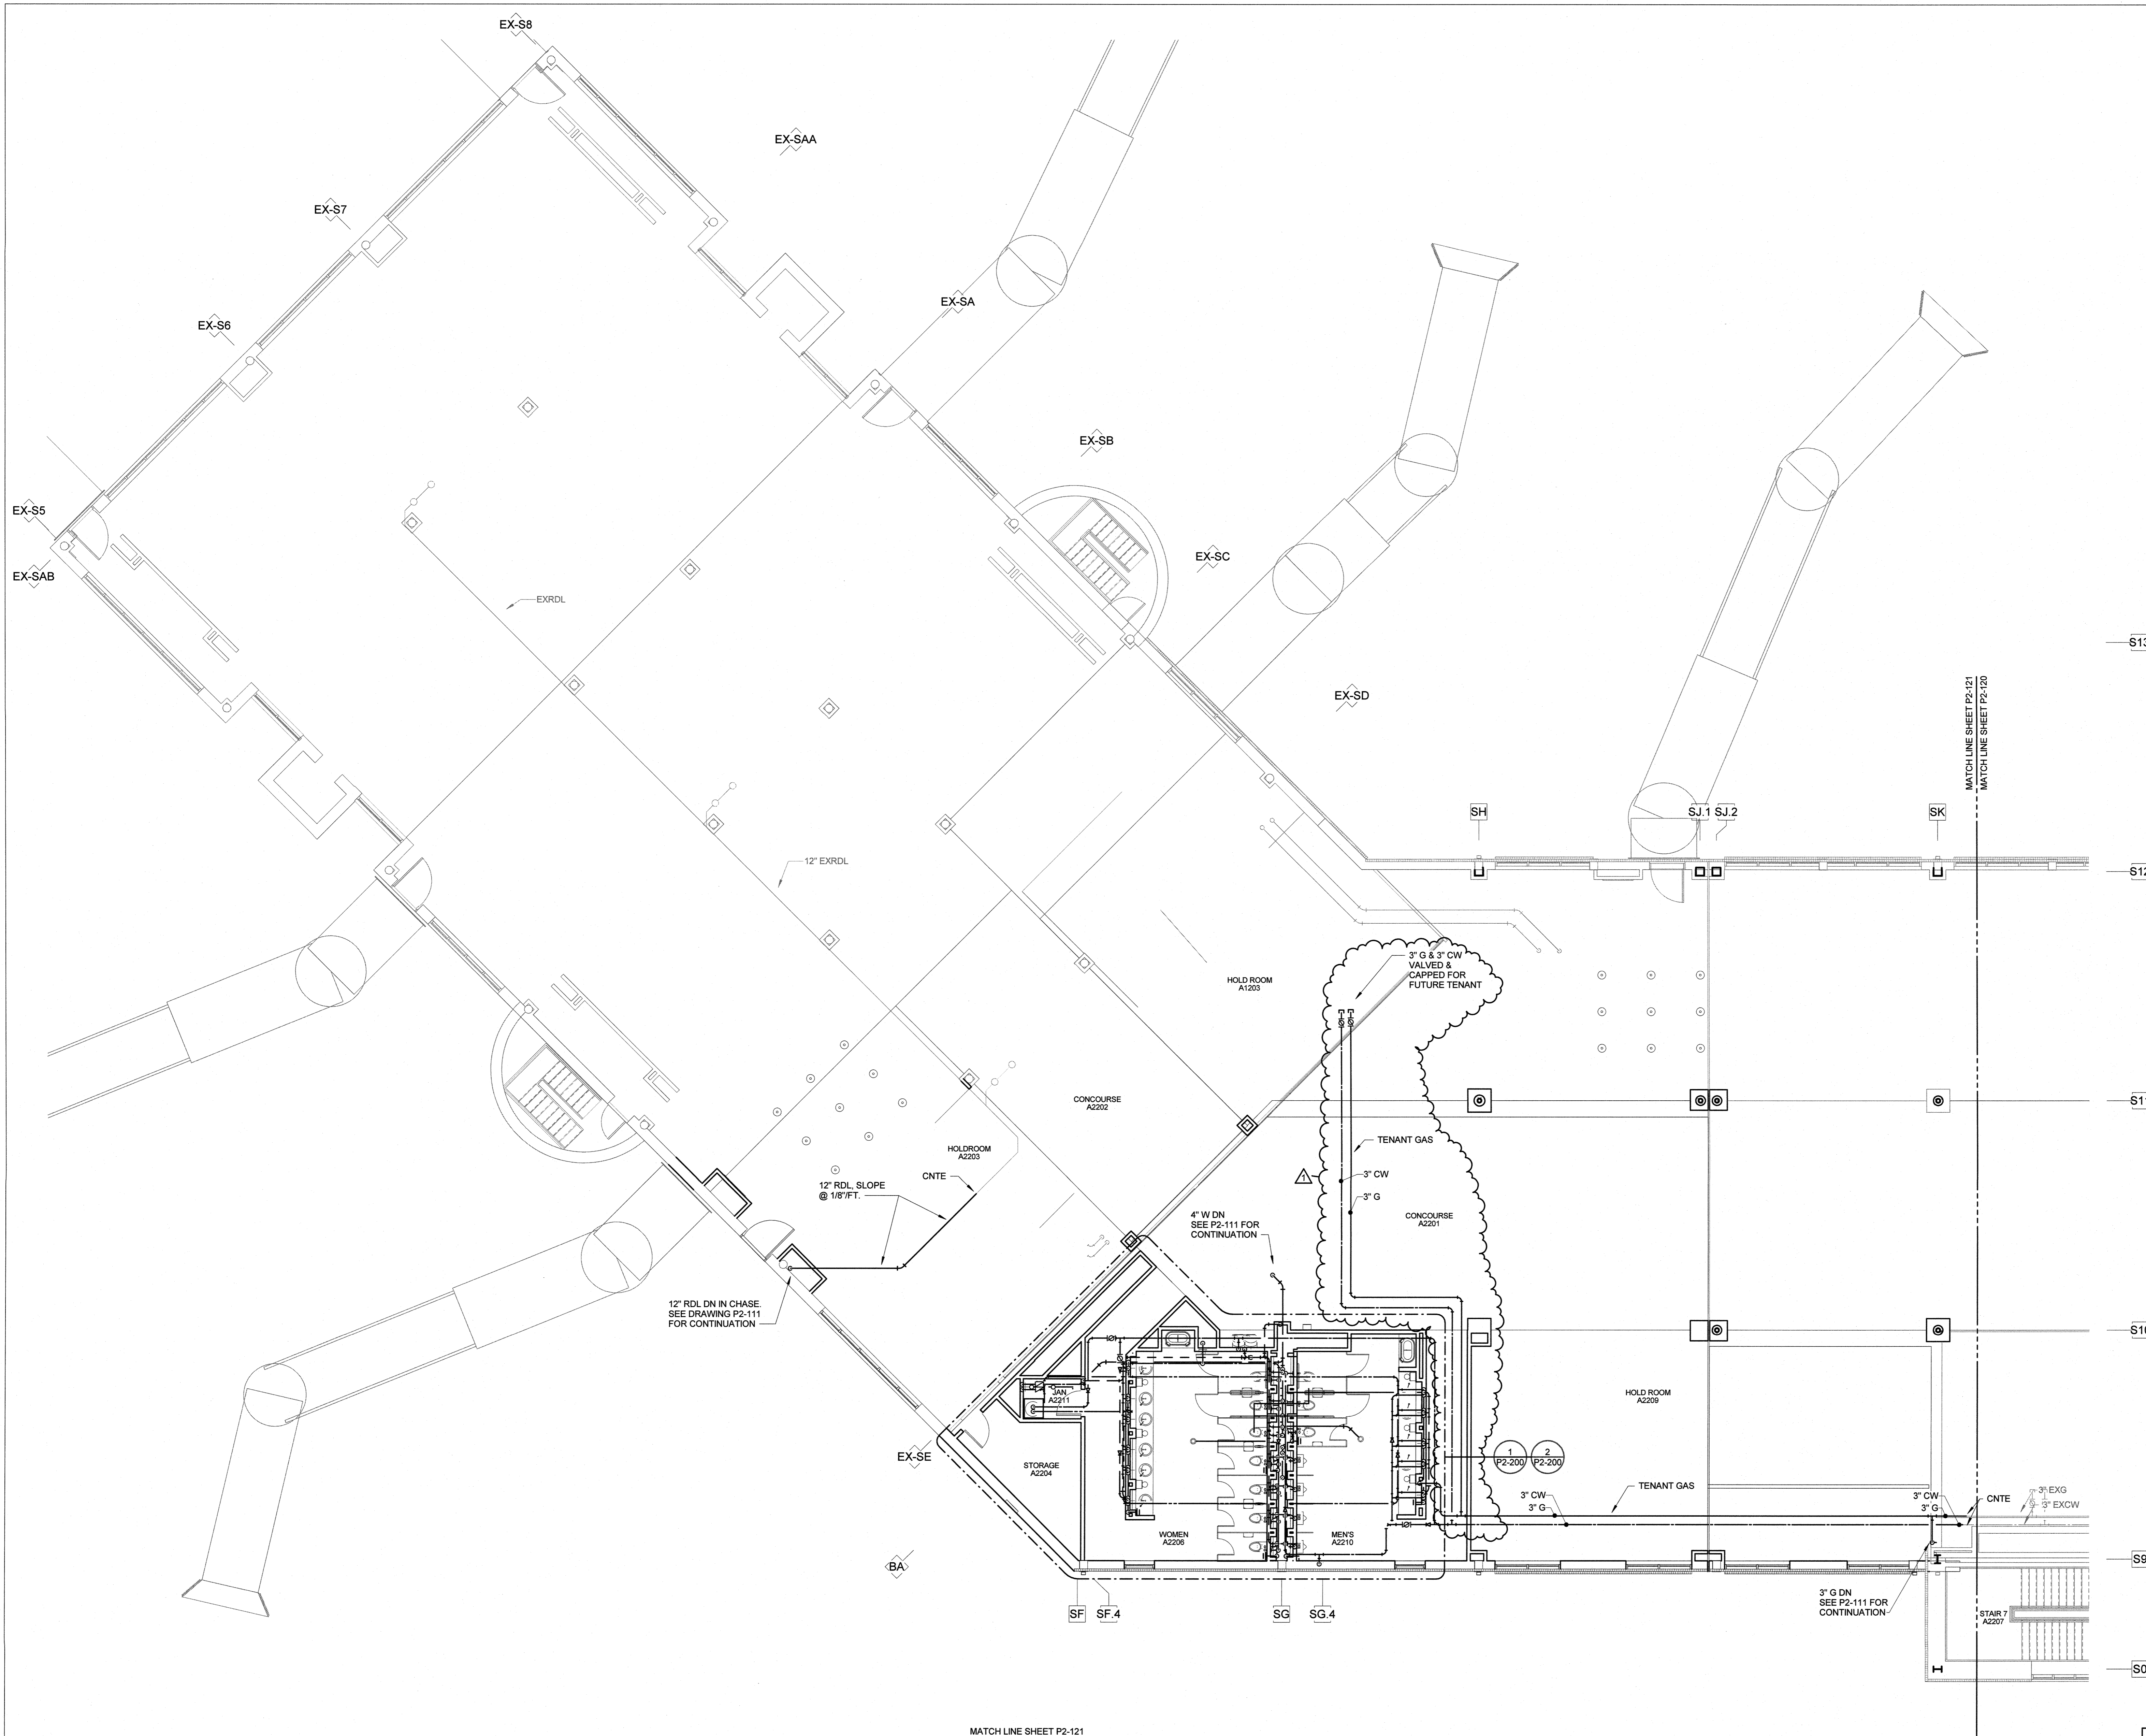

MATCH LINE SHEET P2-121  
MATCH LINE SHEET P2-120

**1 SCHEDULE 2 - BOARDING LEVEL FLOOR PLAN - ZONE 1 - PLUMBING**  
P2-121 SCALE: 1/8" = 1'-0"

FOR CONTRACT 3 SCHEDULE 1 AND SCHEDULE 2 WORK PHASES:  
• SEE ARCHITECTURAL PLANS A-01\* SERIES FOR ADDITIONAL AND DETAILED PHASING INFORMATION.  
• SEE BAGGAGE HANDLING SYSTEM PLANS B-\* SERIES FOR ADDITIONAL AND DETAILED PHASING INFORMATION.  
• COORDINATE ACTUAL PHASED WORK REQUIREMENTS WITH THE GENERAL CONTRACTOR'S SCHEDULE.

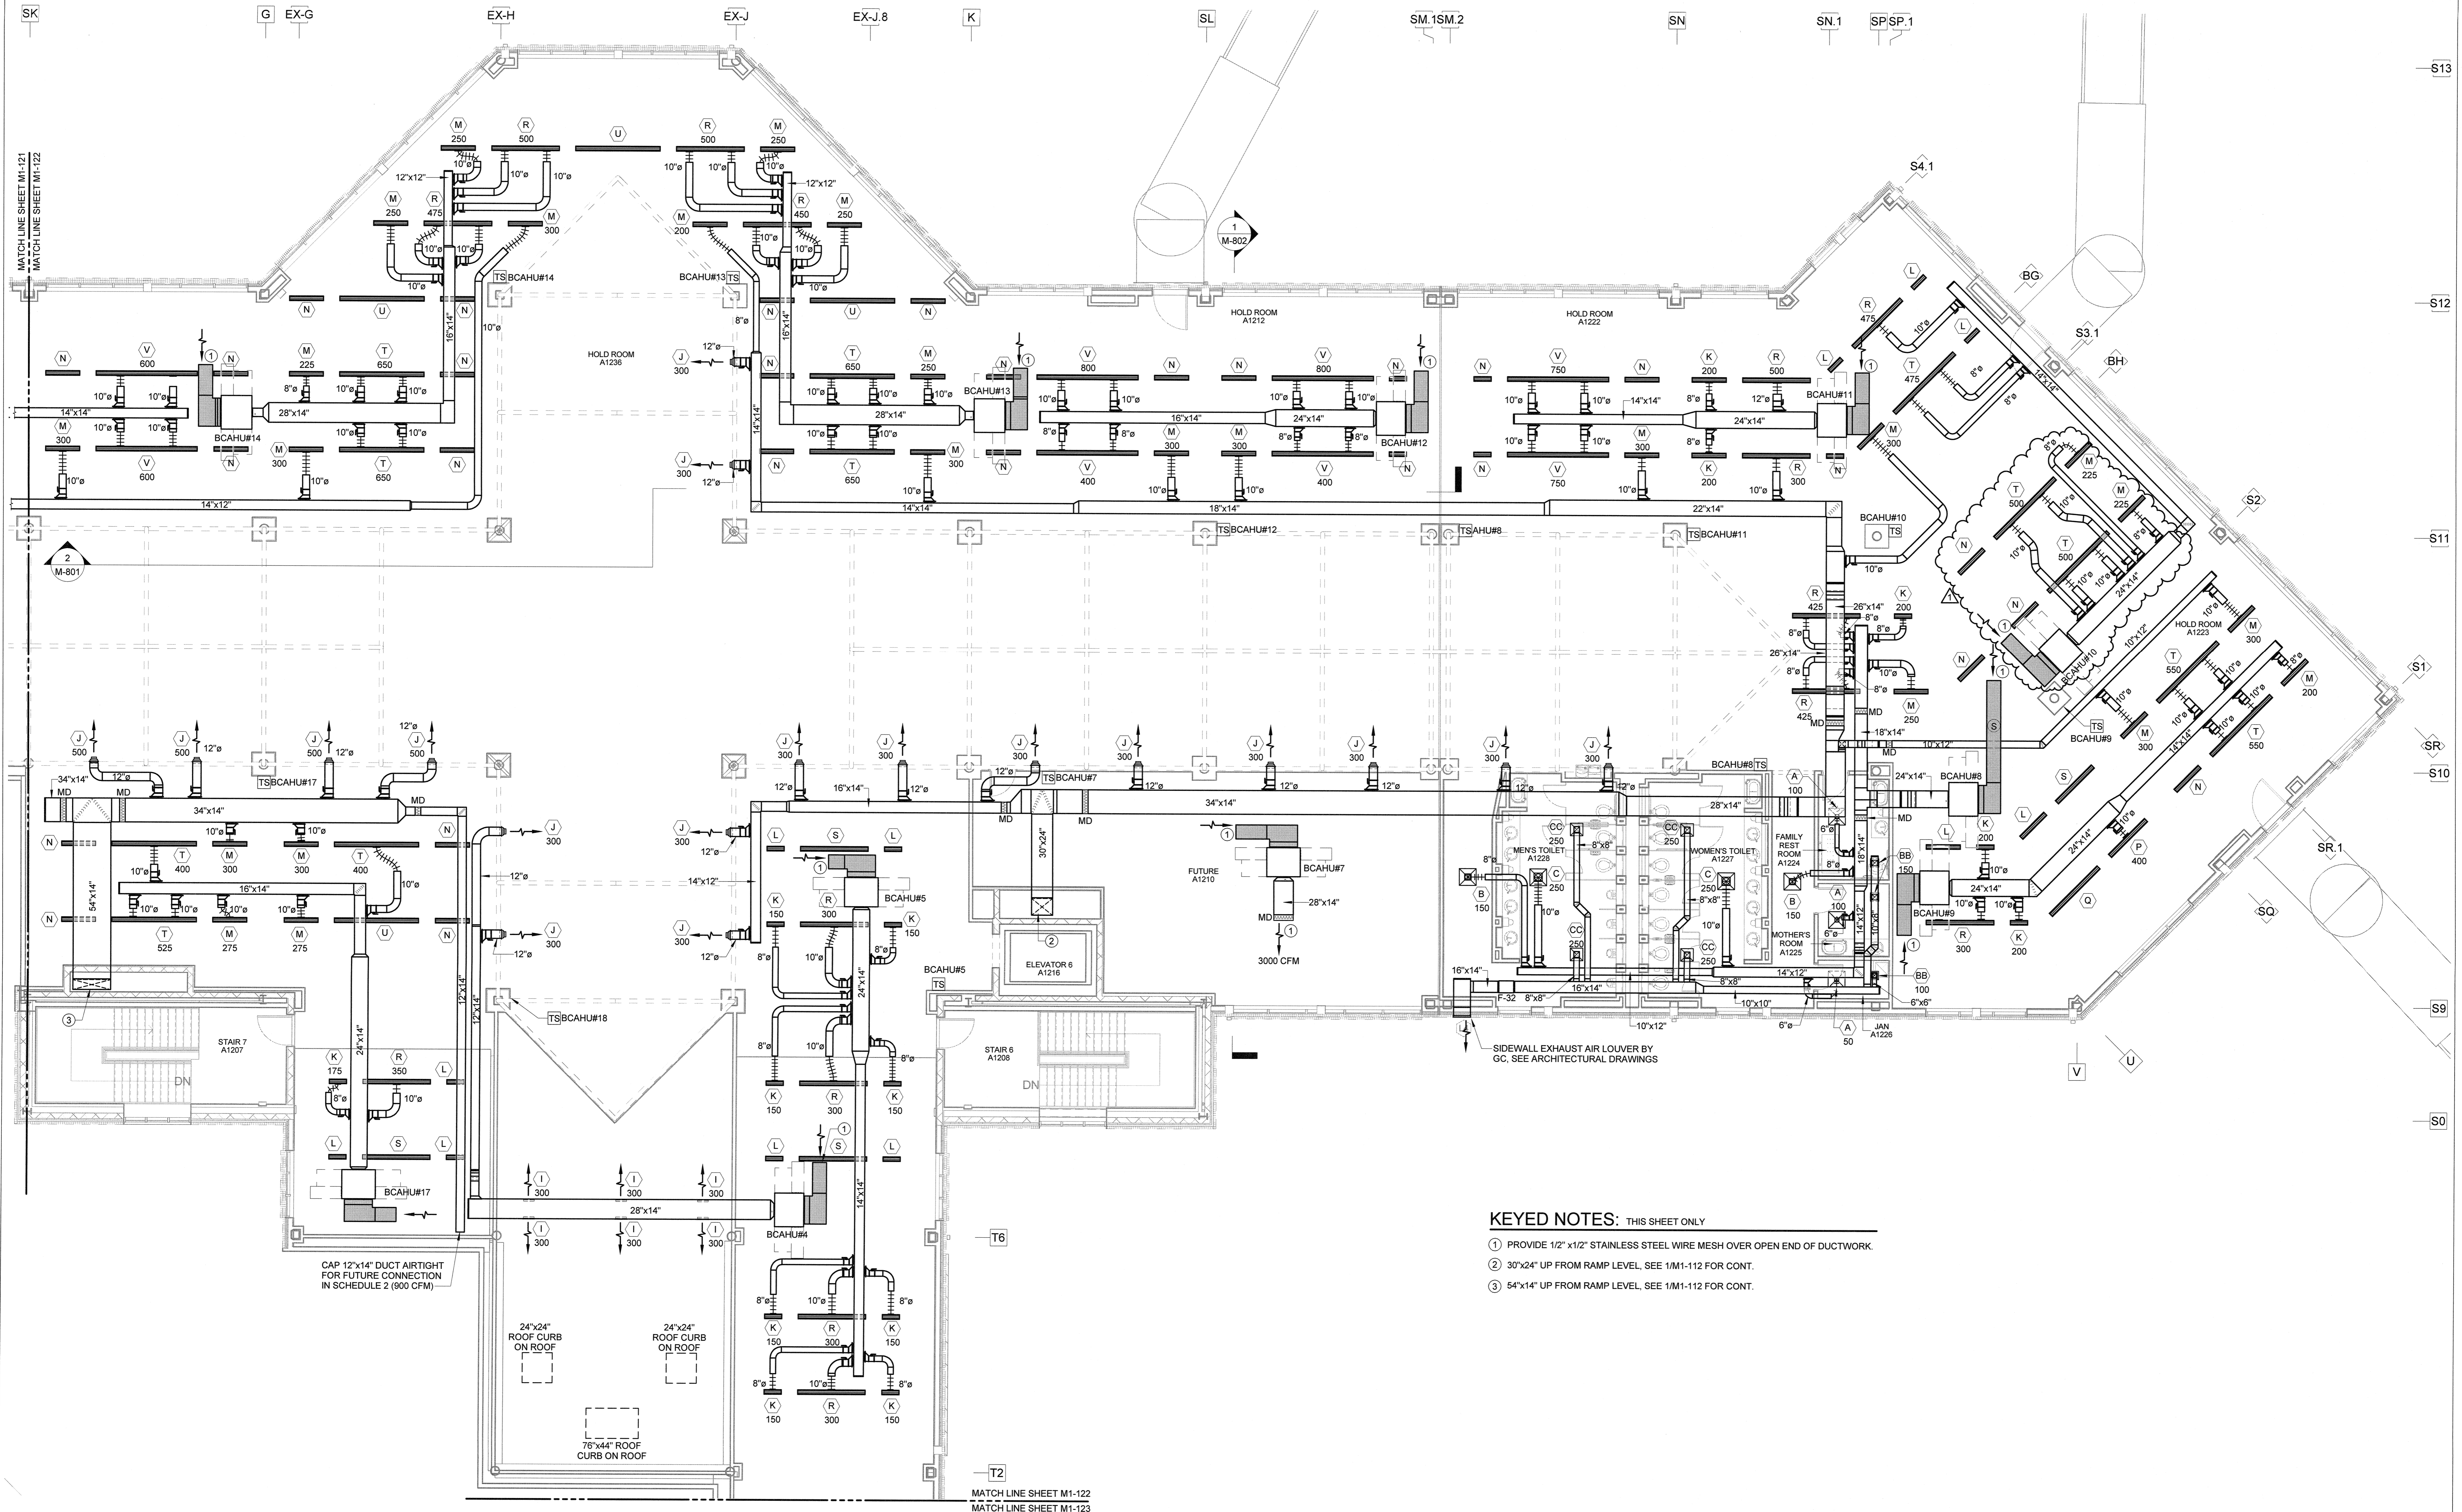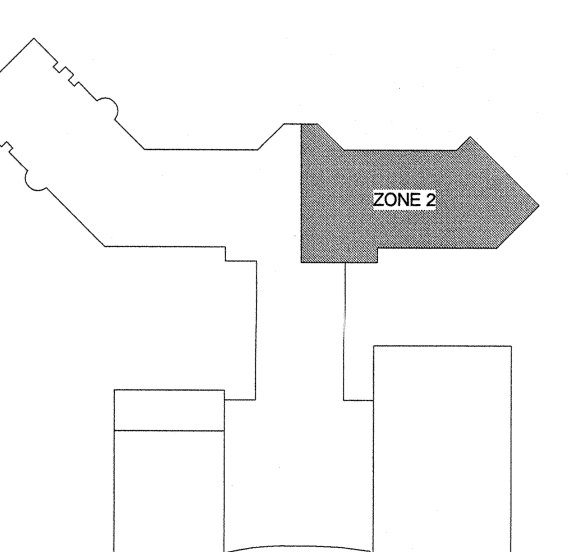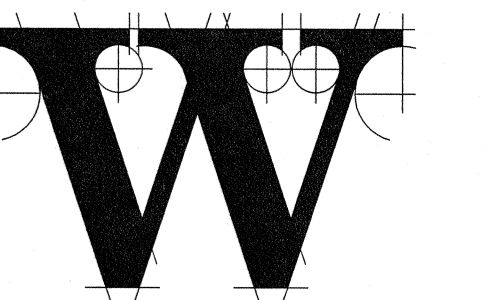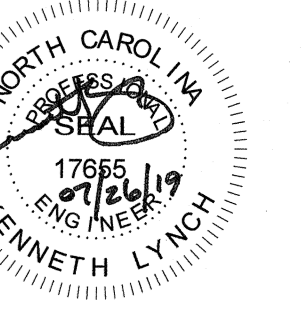

- KEYED NOTES: THIS SHEET ONLY**
- ① PROVIDE 1/2" x 1/2" STAINLESS STEEL WIRE MESH OVER OPEN END OF DUCTWORK.
  - ② 30"x24" UP FROM RAMP LEVEL, SEE 1/M1-112 FOR CONT.
  - ③ 54"x14" UP FROM RAMP LEVEL, SEE 1/M1-112 FOR CONT.

**1** SCHEDULE 1 - BOARDING LEVEL MECHANICAL PLAN - ZONE 2  
SCALE: 1/8" = 1'-0"

FOR CONTRACT 3 SCHEDULE 1 AND SCHEDULE 2 WORK PHASES:  
• SEE ARCHITECTURAL PLANS A-01\* SERIES FOR ADDITIONAL AND DETAILED PHASING INFORMATION.  
• SEE BAGGAGE HANDLING SYSTEM PLANS B-\* SERIES FOR ADDITIONAL AND DETAILED PHASING INFORMATION.  
• COORDINATE ACTUAL PHASED WORK REQUIREMENTS WITH THE GENERAL CONTRACTOR'S SCHEDULE.




TERMINAL IMPROVEMENTS CONTRACT 3

Wilmington International Airport  
1740 Airport Boulevard, Suite 12  
Wilmington, NC 28405

CHEATHAM & ASSOCIATES, P.A.  
CONSULTING ENGINEERS  
3412 ENTERPRISE DRIVE  
WILMINGTON, NORTH CAROLINA 28405  
PHONE: (910) 452-4210  
FAX: (910) 452-4211  
OFFICE@CHEATHAMPA.COM  
NC LICENSE# C-1073

JOB # 19005

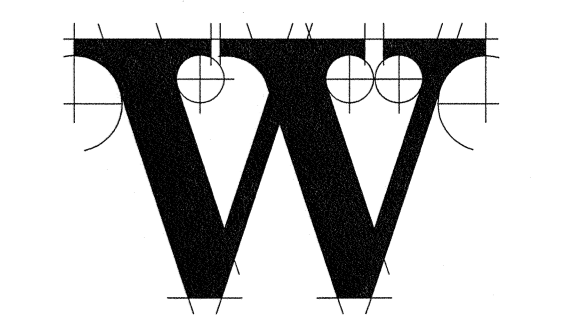

THE WILSON GROUP - ARCHITECTS -

PO Box 5510 Charlotte, NC 28259  
704-331-9747 • www.twgarchitects.com

PROJECT MANAGER & CIVIL ENGINEER  
TALBERT & BRIGHT  
CONSULTING ARCHITECT  
LS3P

STRUCTURAL ENGINEER  
STEWART


FP/PIPE ENGINEER  
CHEATHAM & ASSOC.

BAGGAGE HANDLING CONSULTANTS  
BNP

AIRCRAFT SUPPORT SYSTEMS  
DK CONSULTANTS

SPECIALTY LIGHTING CONSULTANT  
HARTRANFT

SIGNAGE & WAYFINDING  
TAKEFORM

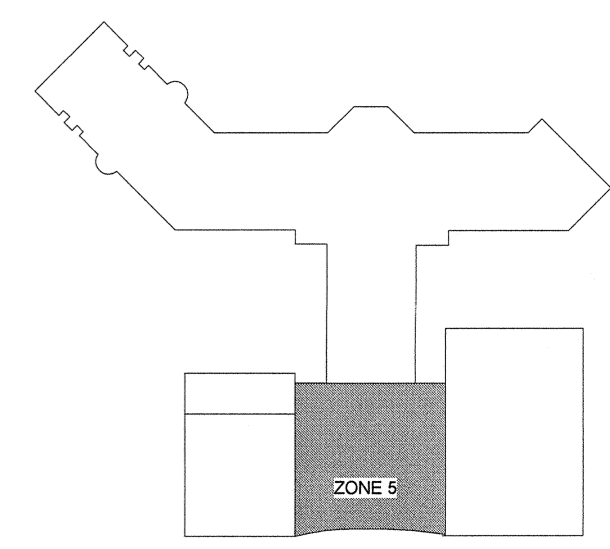

KEY PLAN

COPYRIGHT © 2019  
THE WILSON GROUP ARCHITECTS  
ALL RIGHTS RESERVED


PRINTED OR ELECTRONIC DRAWINGS AND DOCUMENTATION MAY NOT BE REPRODUCED IN ANY FORM WITHOUT WRITTEN PERMISSION FROM THE WILSON GROUP ARCHITECTS

REVISIONS  
1 7/26/19 AD-03

DATE 06/28/19  
PROJECT NUMBER 9202-000  
SHEET TITLE

SCHEDULE 1 - RAMP LEVEL MECHANICAL PIPING PLAN - ZONE 5  
SHEET NUMBER

M1-215




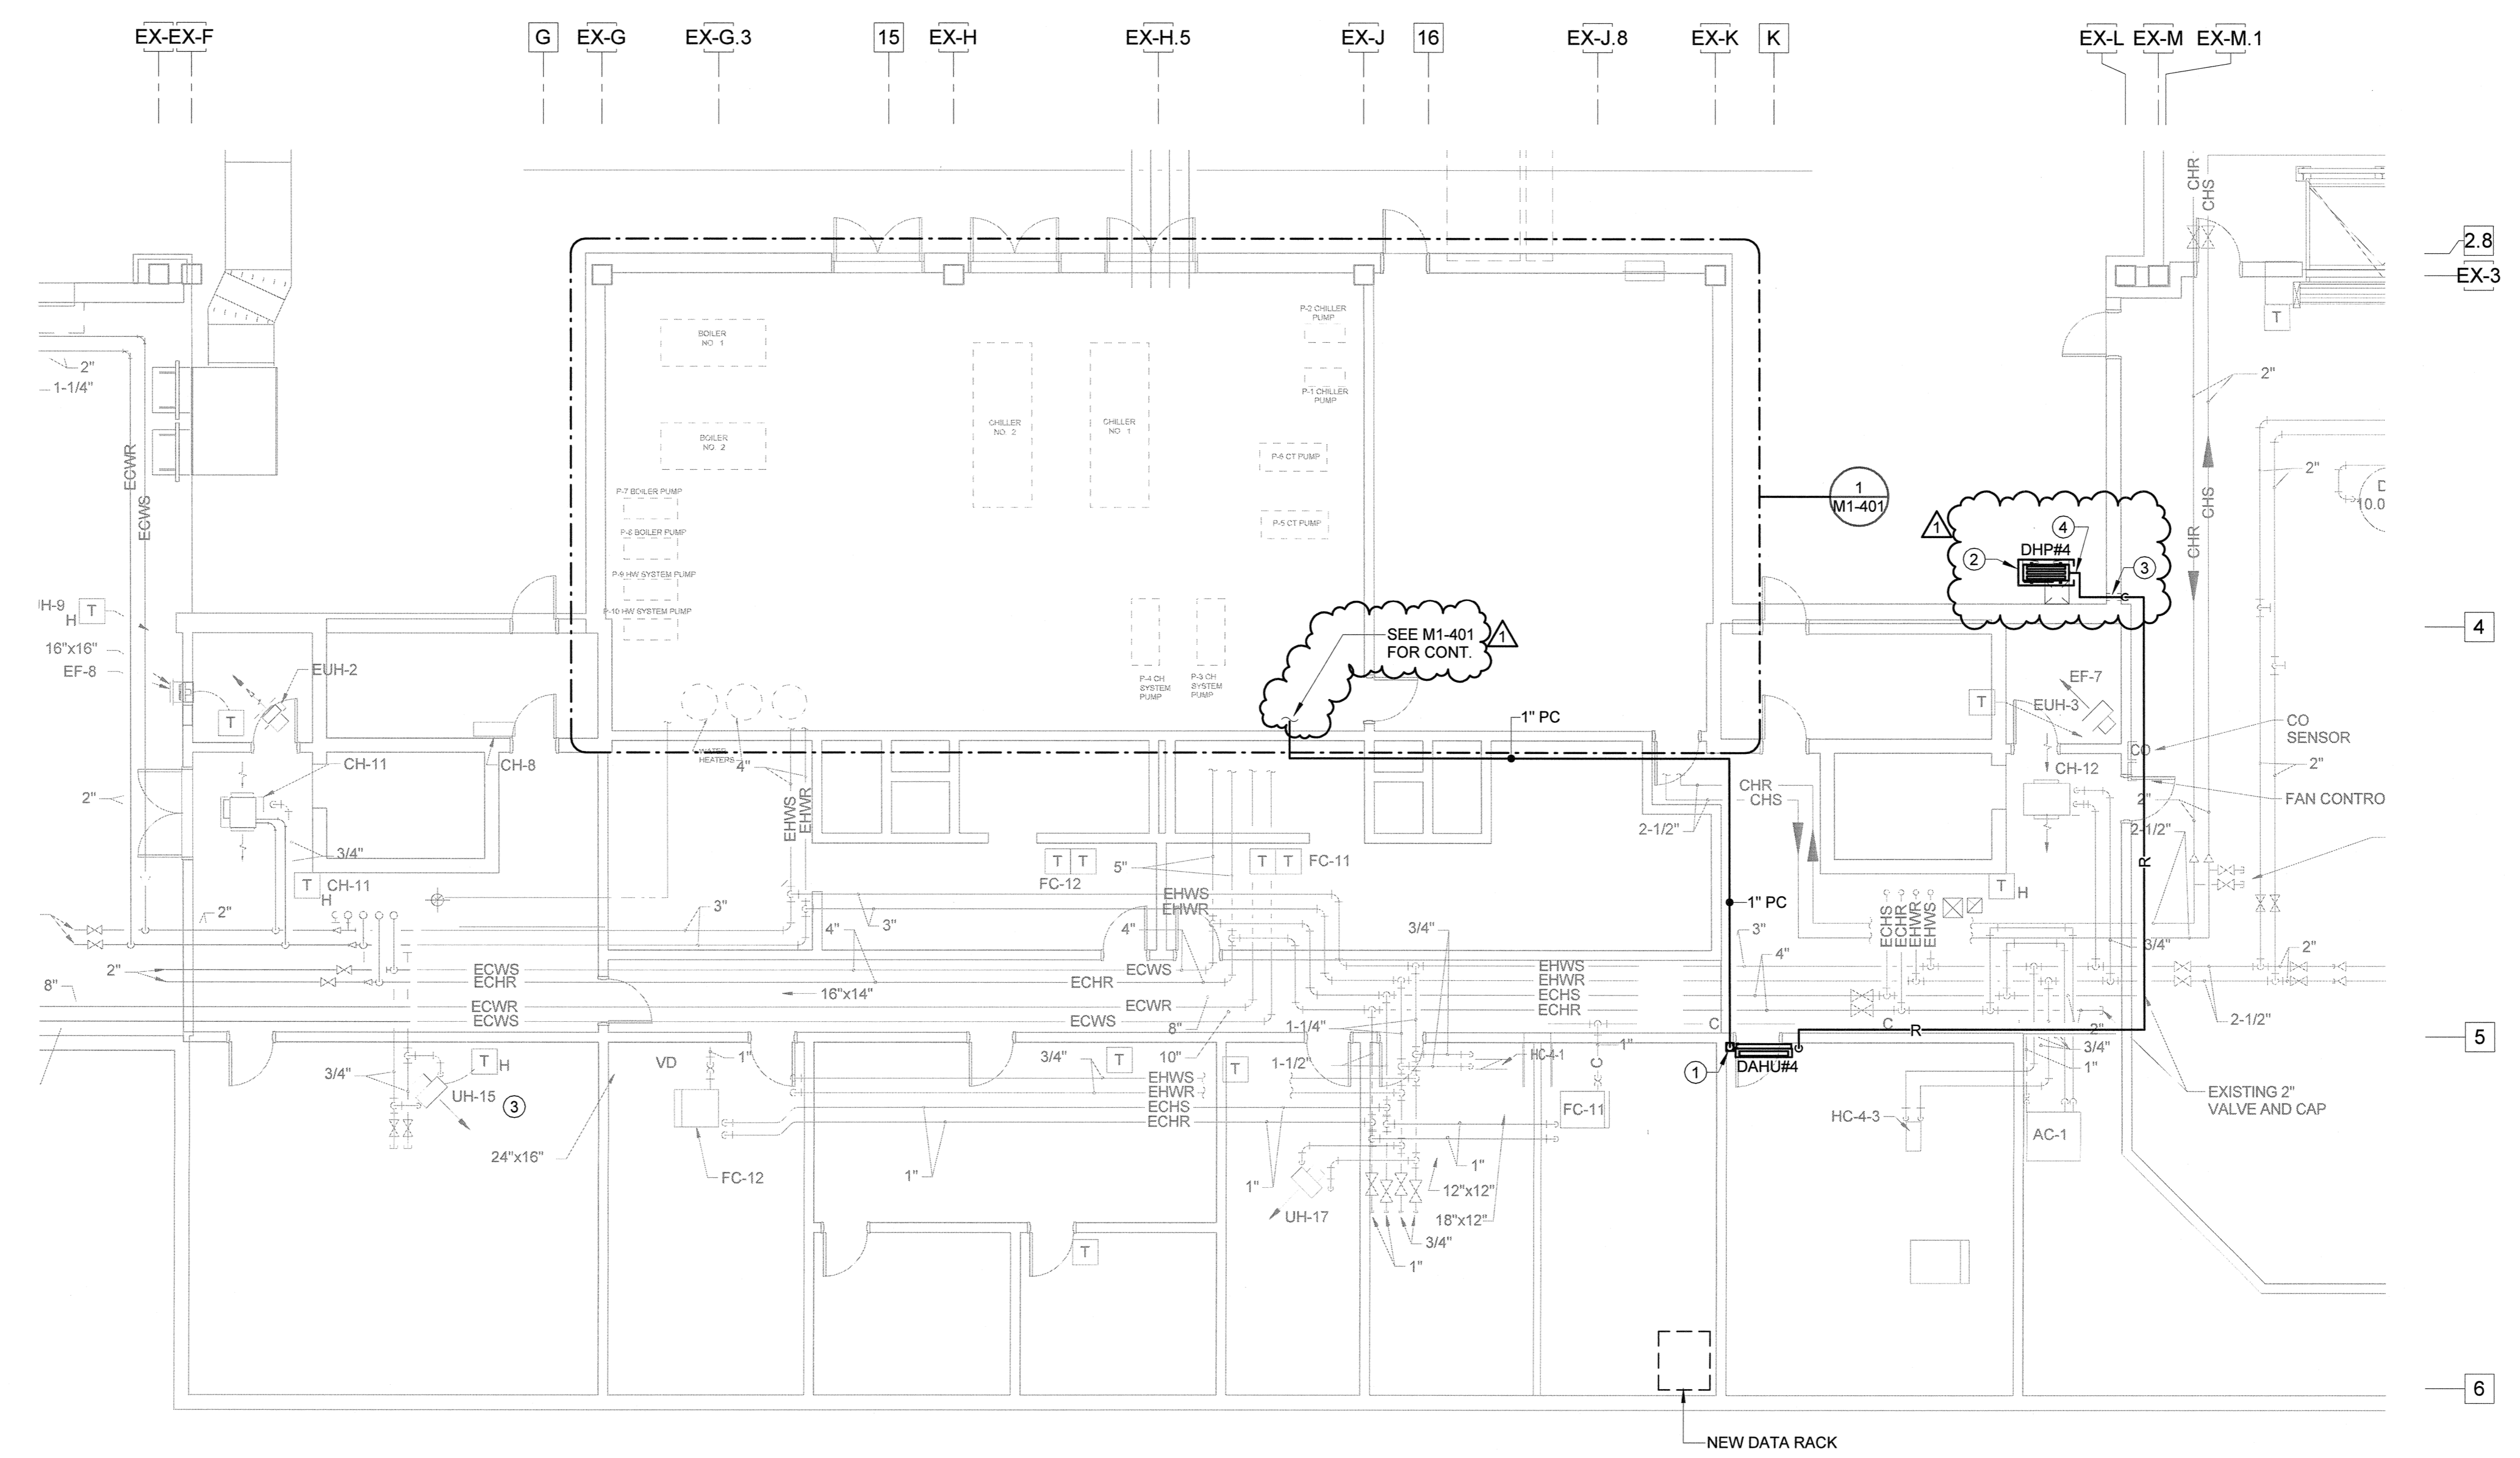


1 M1-215 SCHEDULE 1 - RAMP LEVEL MECHANICAL PIPING PLAN - ZONE 5  
SCALE: 1/8" = 1'-0"

- KEYED NOTES: THIS SHEET ONLY
- 1 PROVIDE CONDENSATE PUMP FOR DAHU#4.
  - 2 4" THICK CONC. PAD, PAINT PAD OSHA APPROVED YELLOW.
  - 3 SEAL WALL PENETRATION WEATHERTIGHT.
  - 4 SUPPORT REFRIGERANT PIPING AT EDGE OF CONCRETE PAD.

FOR CONTRACT 3 SCHEDULE 1 AND SCHEDULE 2 WORK PHASES:  
• SEE ARCHITECTURAL PLANS A-01\* SERIES FOR ADDITIONAL AND DETAILED PHASING INFORMATION.  
• SEE BAGGAGE HANDLING SYSTEM PLANS B-\* SERIES FOR ADDITIONAL AND DETAILED PHASING INFORMATION.  
• COORDINATE ACTUAL PHASED WORK REQUIREMENTS WITH THE GENERAL CONTRACTOR'S SCHEDULE.



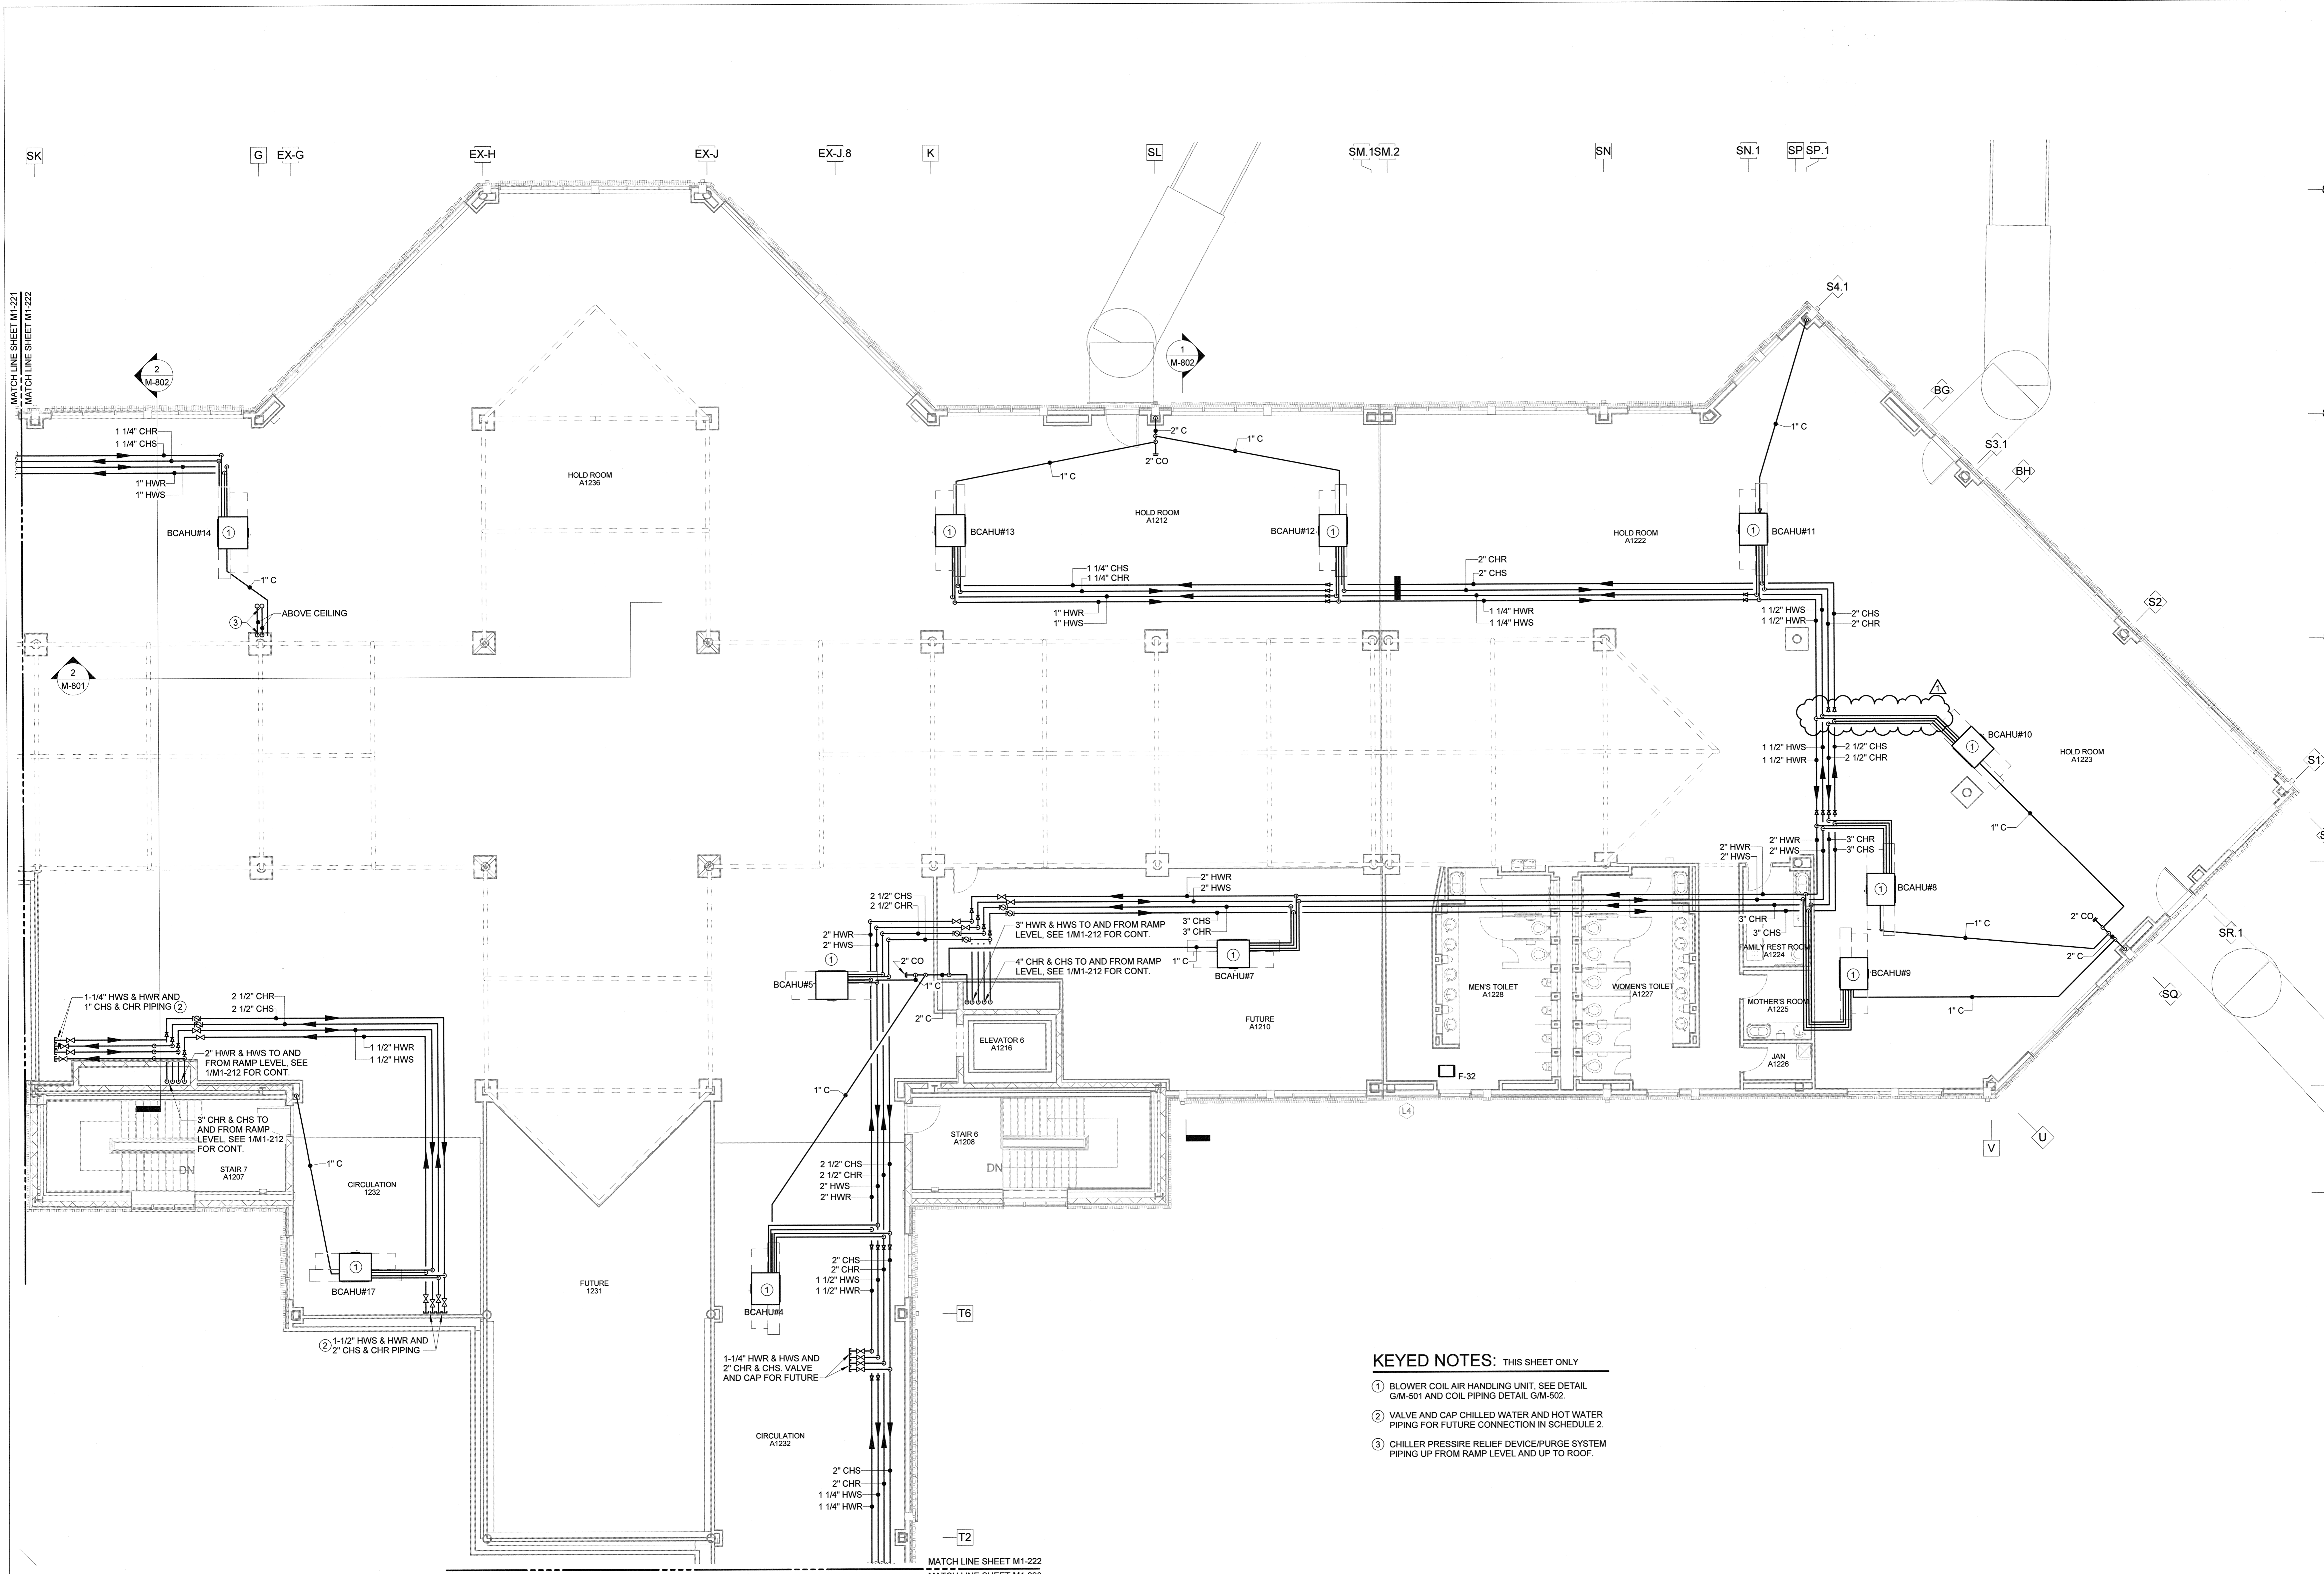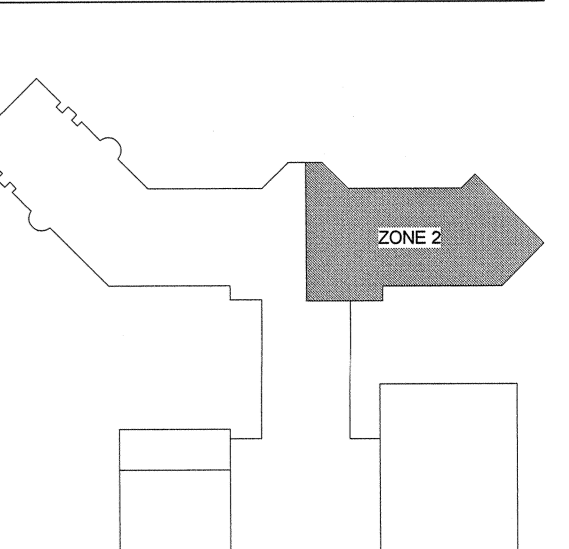
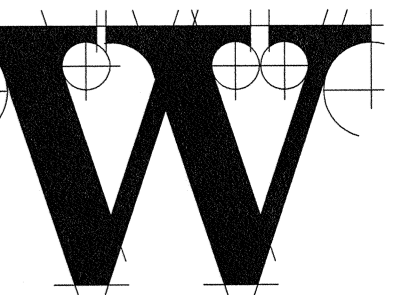
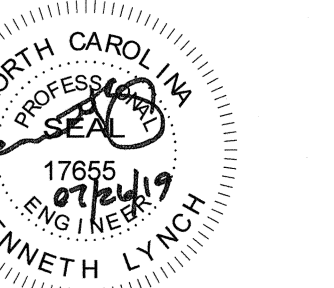


**KEYED NOTES: THIS SHEET ONLY**


- ① BLOWER COIL AIR HANDLING UNIT. SEE DETAIL GM-501 AND COIL PIPING DETAIL GM-502.
- ② VALVE AND CAP CHILLED WATER AND HOT WATER PIPING FOR FUTURE CONNECTION IN SCHEDULE 2.
- ③ CHILLER PRESSURE RELIEF DEVICE/PURGE SYSTEM PIPING UP FROM RAMP LEVEL AND UP TO ROOF.

**1** SCHEDULE 1 - BOARDING LEVEL MECHANICAL PIPING PLAN - ZONE 2  
SCALE: 1/8" = 1'-0"


FOR CONTRACT 3 SCHEDULE 1 AND SCHEDULE 2 WORK PHASES:  
• SEE ARCHITECTURAL PLANS A-01\* SERIES FOR ADDITIONAL AND DETAILED PHASING INFORMATION.  
• SEE BAGGAGE HANDLING SYSTEM PLANS B-\* SERIES FOR ADDITIONAL AND DETAILED PHASING INFORMATION.  
• COORDINATE ACTUAL PHASED WORK REQUIREMENTS WITH THE GENERAL CONTRACTOR'S SCHEDULE.

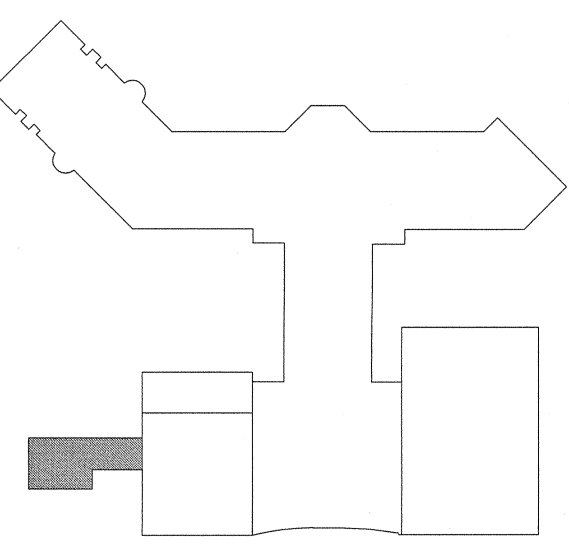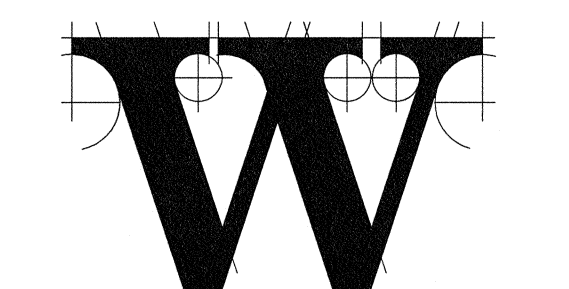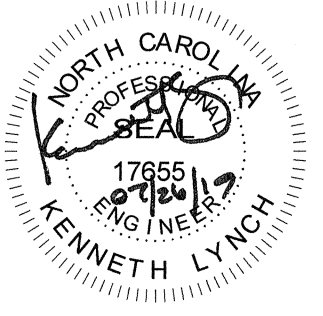

- SCHEDULE 1**
1. MAKE TEMPORARY CONDENSER WATER SUPPLY AND RETURN CONNECTIONS IN INBOUND MAKE UP A2144.
  2. CONNECT TEMPORARY COOLING TOWER TO PROVIDE CONDENSER WATER (1100 GPM, 95°F EWT, 85°F LWT, @ 80°F WB) FOR EXISTING CHILLED WATER PLANT - MECHANICAL A1104.
  3. DEMOLITION EXISTING COOLING TOWER, STRUCTURE, CONDENSER WATER PIPING, ETC. COMPLETE TO POINTS INDICATED ON DRAWINGS.
  4. COORDINATE SHUTDOWN OF EXISTING CHILLED WATER PLANT WITH OWNER SO AS TO MINIMIZE NO COOLING IN THE EXISTING BUILDING.
  5. INSTALL NEW COOLING TOWERS CT-1 AND CT-2 AND CONDENSER WATER PIPING. ONCE INSTALLATION AND TESTING OF CT-1 AND CT-2 ARE COMPLETE, DISCONNECT AND REMOVE TEMPORARY COOLING TOWER AND TEMPORARY CONDENSER WATER PIPING.

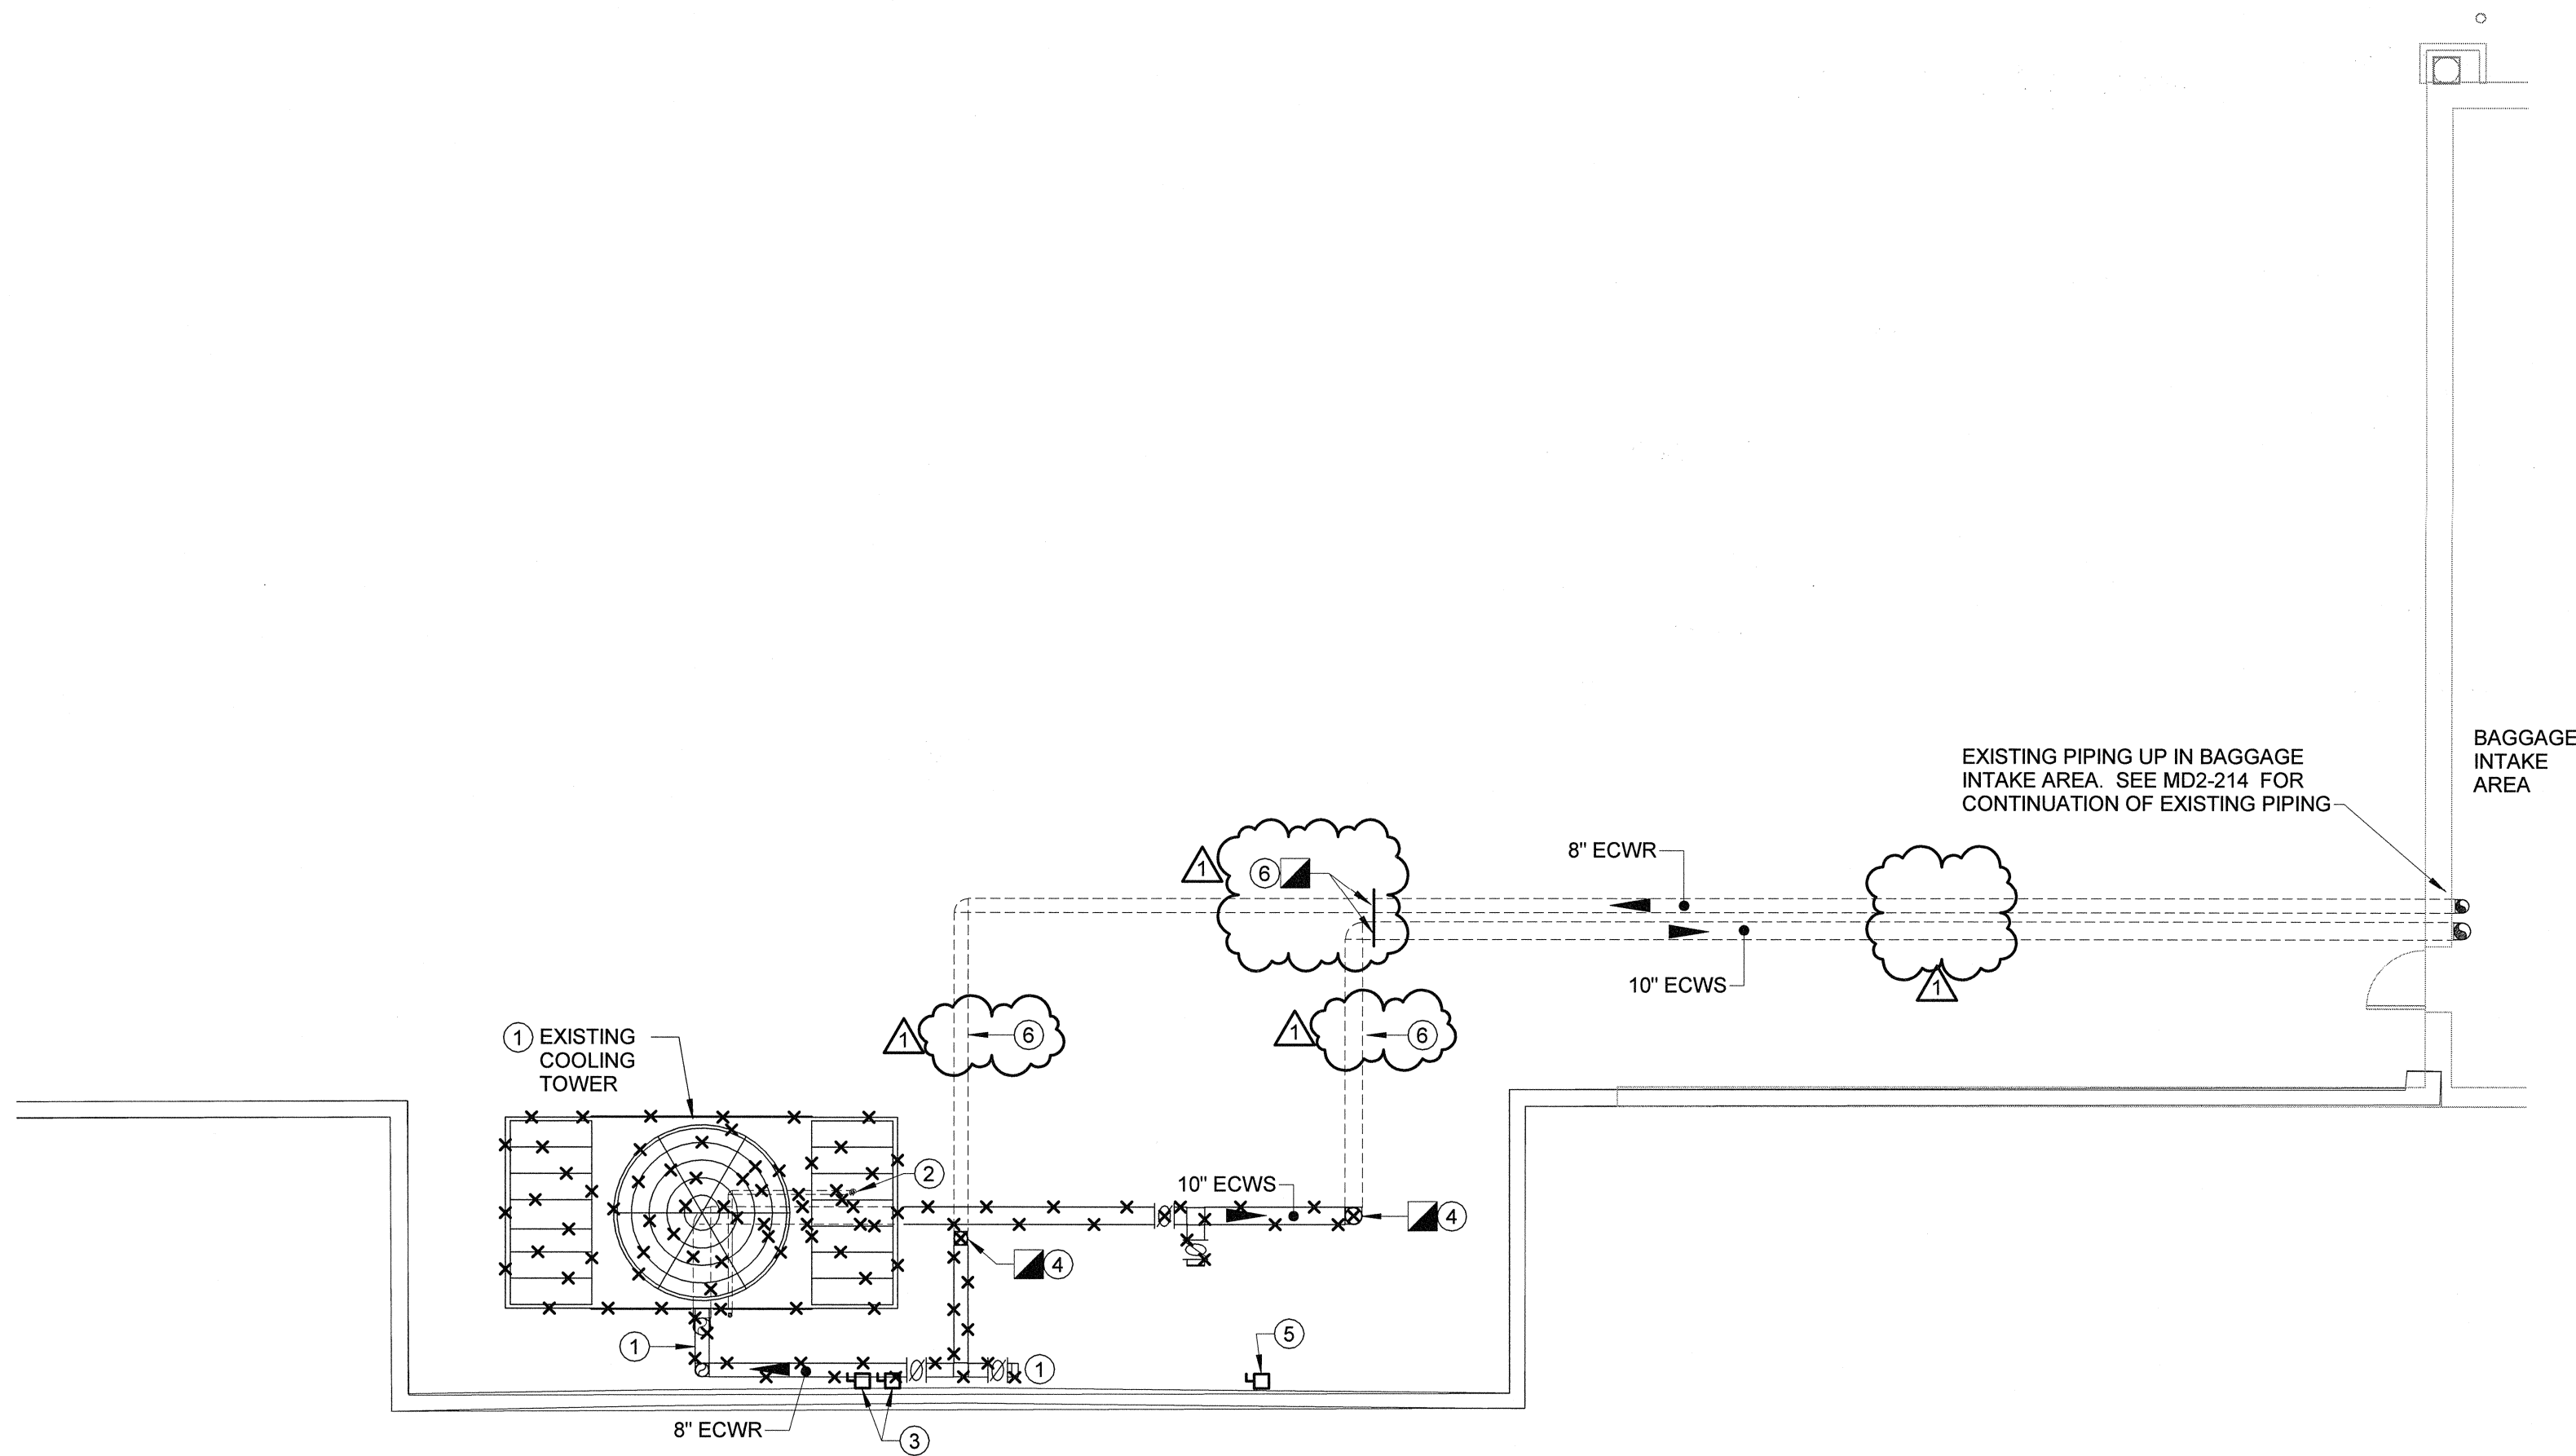

**1 SCHEDULE 1 - EXISTING COOLING TOWER**  
SCALE: 1/8" = 1'-0"

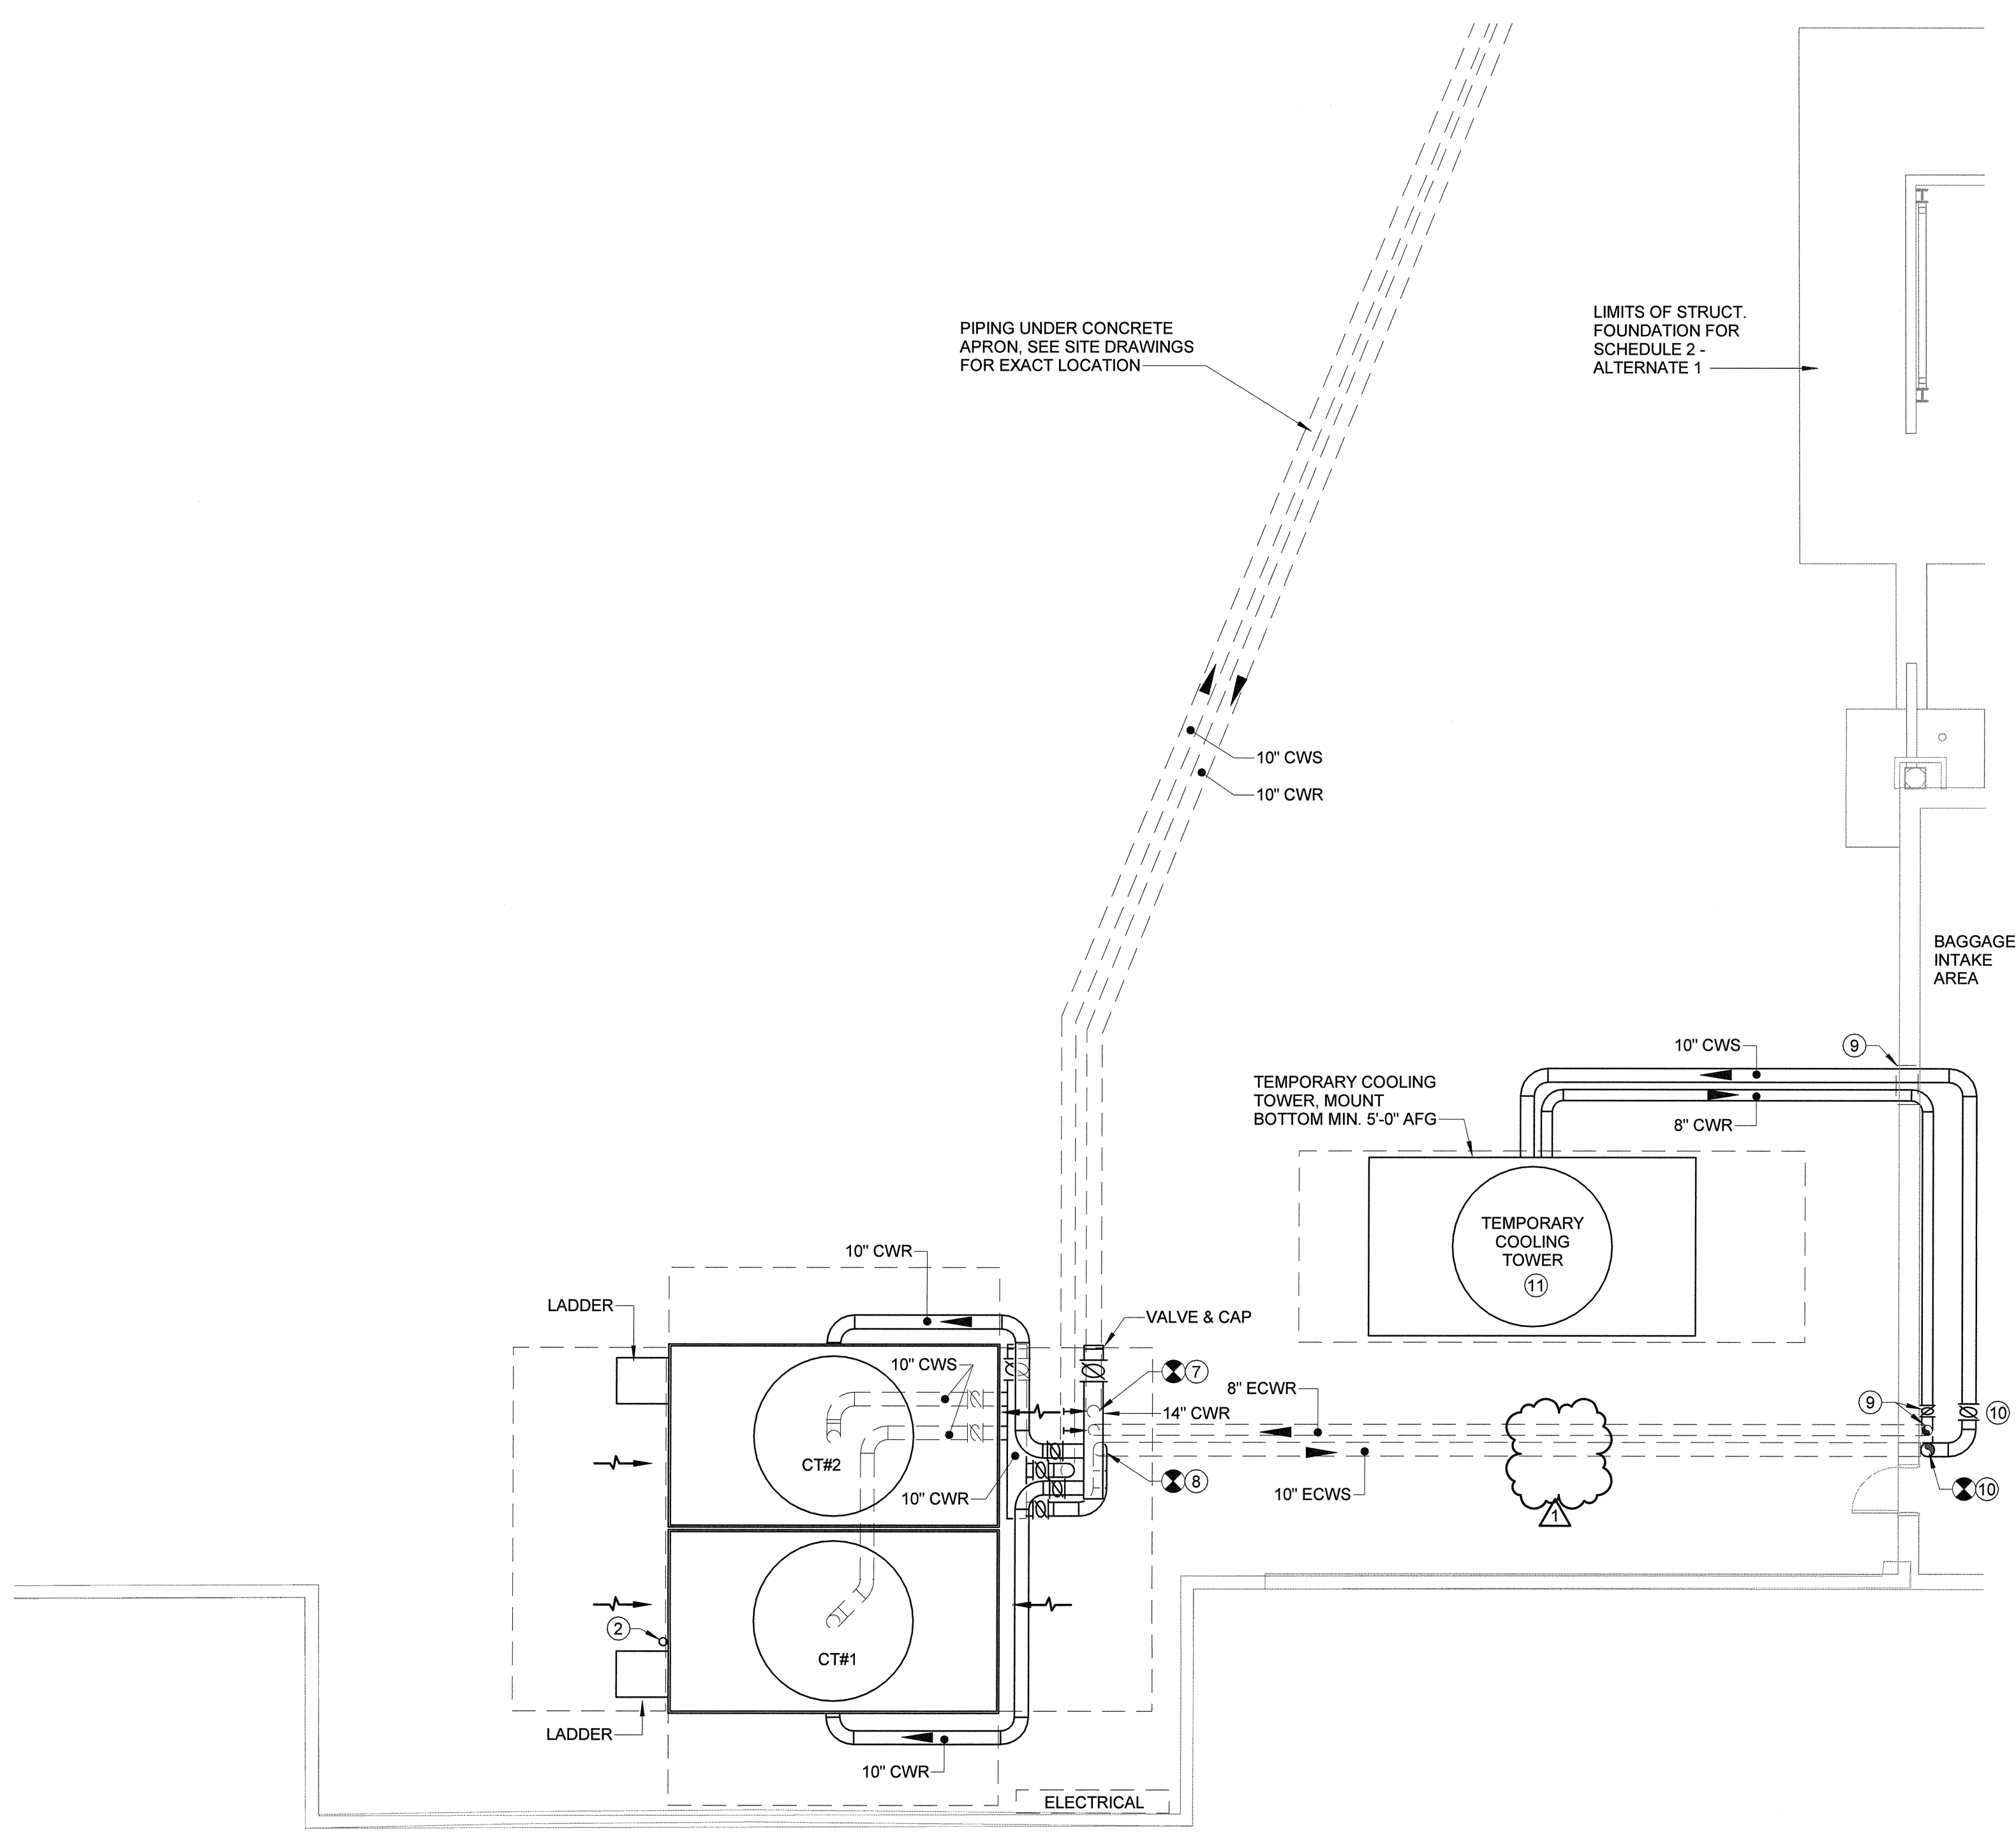

**2 SCHEDULE 1 - NEW COOLING TOWERS**  
SCALE: 1/8" = 1'-0"

**KEYED NOTES: THIS SHEET ONLY**

1. REMOVE COOLING TOWER, SUPPORTS, PIPING, ELECTRICAL BACK TO SOURCE AFTER TEMPORARY COOLING TOWER IS FUNCTIONAL AND CONNECTED TO EXISTING CONDENSER WATER PIPING.
2. HUB DRAIN TO REMAIN AND BE REUSED.
3. REMOVE EXISTING COOLING TOWER ELECTRICAL DISCONNECTS BACK TO SOURCE.
4. CAP EXISTING PIPING ABOVE GRADE.
5. REMOVE EXISTING ABANDONED ELECTRICAL DISCONNECT AND ELECTRICAL BACK TO SOURCE.
6. EXISTING CONDENSER WATER PIPING TO BE ABANDONED IN PLACE BELOW GRADE.
7. INTERCEPT EXISTING 8" ECWR PIPE BELOW GRADE AND CONNECT NEW 8" CWR TO EXISTING. FIELD VERIFY EXACT SIZE AND LOCATION.
8. INTERCEPT EXISTING 10" ECWS PIPE BELOW GRADE AND CONNECT NEW 10" CWS TO EXISTING. FIELD VERIFY EXACT SIZE AND LOCATION.
9. TEMPORARY LOCATION OF PIPING THROUGH WALL AT LOCATION OF NEW DOOR. TEMPORARY CONNECT 10" CWS BELOW EXISTING BUTTERFLY VALVE. REMOVE CHECK VALVE AND INSTALL IN TEMPORARY PIPING. AFTER CT-1 AND CT-2 ARE INSTALLED AND READY FOR OPERATION, DISCONNECT TEMPORARY TOWER AND REINSTALL CHECK VALVE.
10. TEMPORARY CONNECT 8" CWS TO EXISTING, INTERCEPT EXISTING PIPING AND ADD NEW BUTTERFLY VALVE IN RISE AND ON TEMPORARY PIPING SIDE. AFTER CT-1 AND CT-2 ARE INSTALLED AND READY FOR OPERATION, DISCONNECT TEMPORARY TOWER AND TEMPORARY PIPING BACK TO BUTTERFLY VALVE. CAP VALVE TO REMAIN.
11. TEMPORARY COOLING TOWER TO PROVIDE CONDENSER WATER (1100 GPM, 95°F EWT, 85°F LWT, @ 80°F WB) FOR EXISTING CHILLED WATER PLANT - MECHANICAL A1104.

FOR CONTRACT 3 SCHEDULE 1 AND SCHEDULE 2 WORK PHASES:  
• SEE ARCHITECTURAL PLANS A-01\* SERIES FOR ADDITIONAL AND DETAILED PHASING INFORMATION.  
• SEE BAGGAGE HANDLING SYSTEM PLANS B-\* SERIES FOR ADDITIONAL AND DETAILED PHASING INFORMATION.  
• COORDINATE ACTUAL PHASED WORK REQUIREMENTS WITH THE GENERAL CONTRACTOR'S SCHEDULE.





**TERMINAL IMPROVEMENTS CONTRACT 3**

Wilmington International Airport  
1740 Airport Boulevard, Suite 12  
Wilmington, NC 28405

**CHEATHAM & ASSOCIATES, P.A.**  
CONSULTING ENGINEERS  
3412 ENTERPRISE DRIVE  
WILMINGTON, NORTH CAROLINA 28405  
PHONE: (910) 452-4210  
FAX: (910) 452-4211  
OFFICE@CHEATHAMPA.COM  
NC LICENSE# C-1073

JOB # 19005

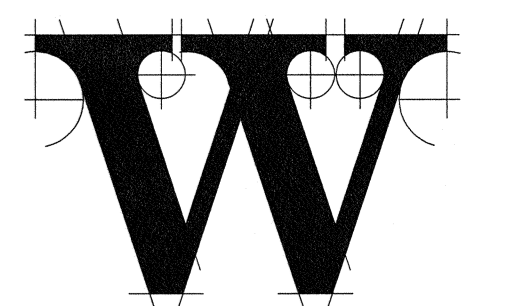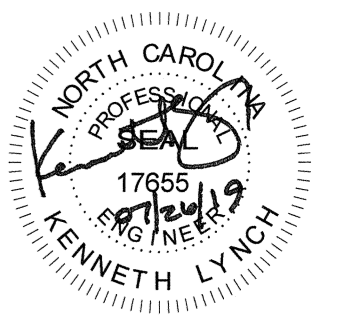

**THE WILSON GROUP**

- ARCHITECTS -

PO Box 5510 Charlotte, NC 28259  
704-331-9747 • www.twgarchitects.com

PROJECT MANAGER & CIVIL ENGINEER  
**TALBERT & BRIGHT**

CONSULTING ARCHITECT  
**LS3P**

STRUCTURAL ENGINEER  
**STEWART**


FP/PM ENGINEER  
**CHEATHAM & ASSOC.**

BAGGAGE HANDLING CONSULTANTS  
**BNP**

AIRCRAFT SUPPORT SYSTEMS  
**DK CONSULTANTS**

SPECIALTY LIGHTING CONSULTANT  
**HARTRANFT**

SIGNAGE & WAYFINDING  
**TAKEFORM**

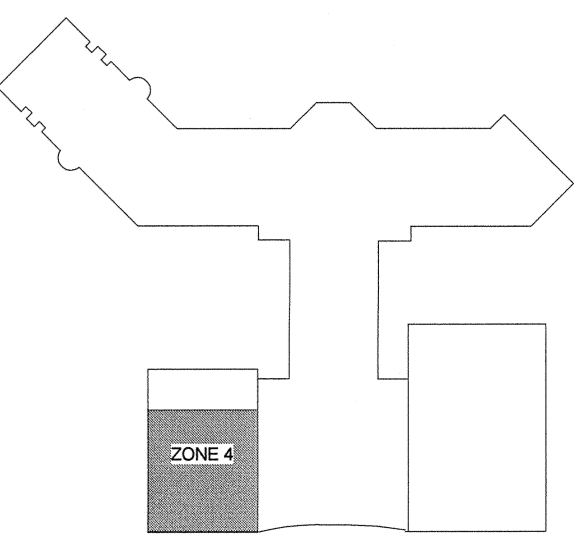

**KEY PLAN**

COPYRIGHT © 2019  
THE WILSON GROUP ARCHITECTS  
ALL RIGHTS RESERVED

PRINTED OR ELECTRONIC DRAWINGS AND  
DOCUMENTATION MAY NOT BE REPRODUCED  
IN ANY FORM WITHOUT WRITTEN PERMISSION  
FROM THE WILSON GROUP ARCHITECTS

**REVISIONS**


1 7/26/19 AD-03

DATE 06/28/19  
PROJECT NUMBER 9202-000  
SHEET TITLE

**SCHEDULE 2 - RAMP LEVEL MECHANICAL PLAN - ZONE 4 - ALTERNATE 1**

SHEET NUMBER

**M2-114**

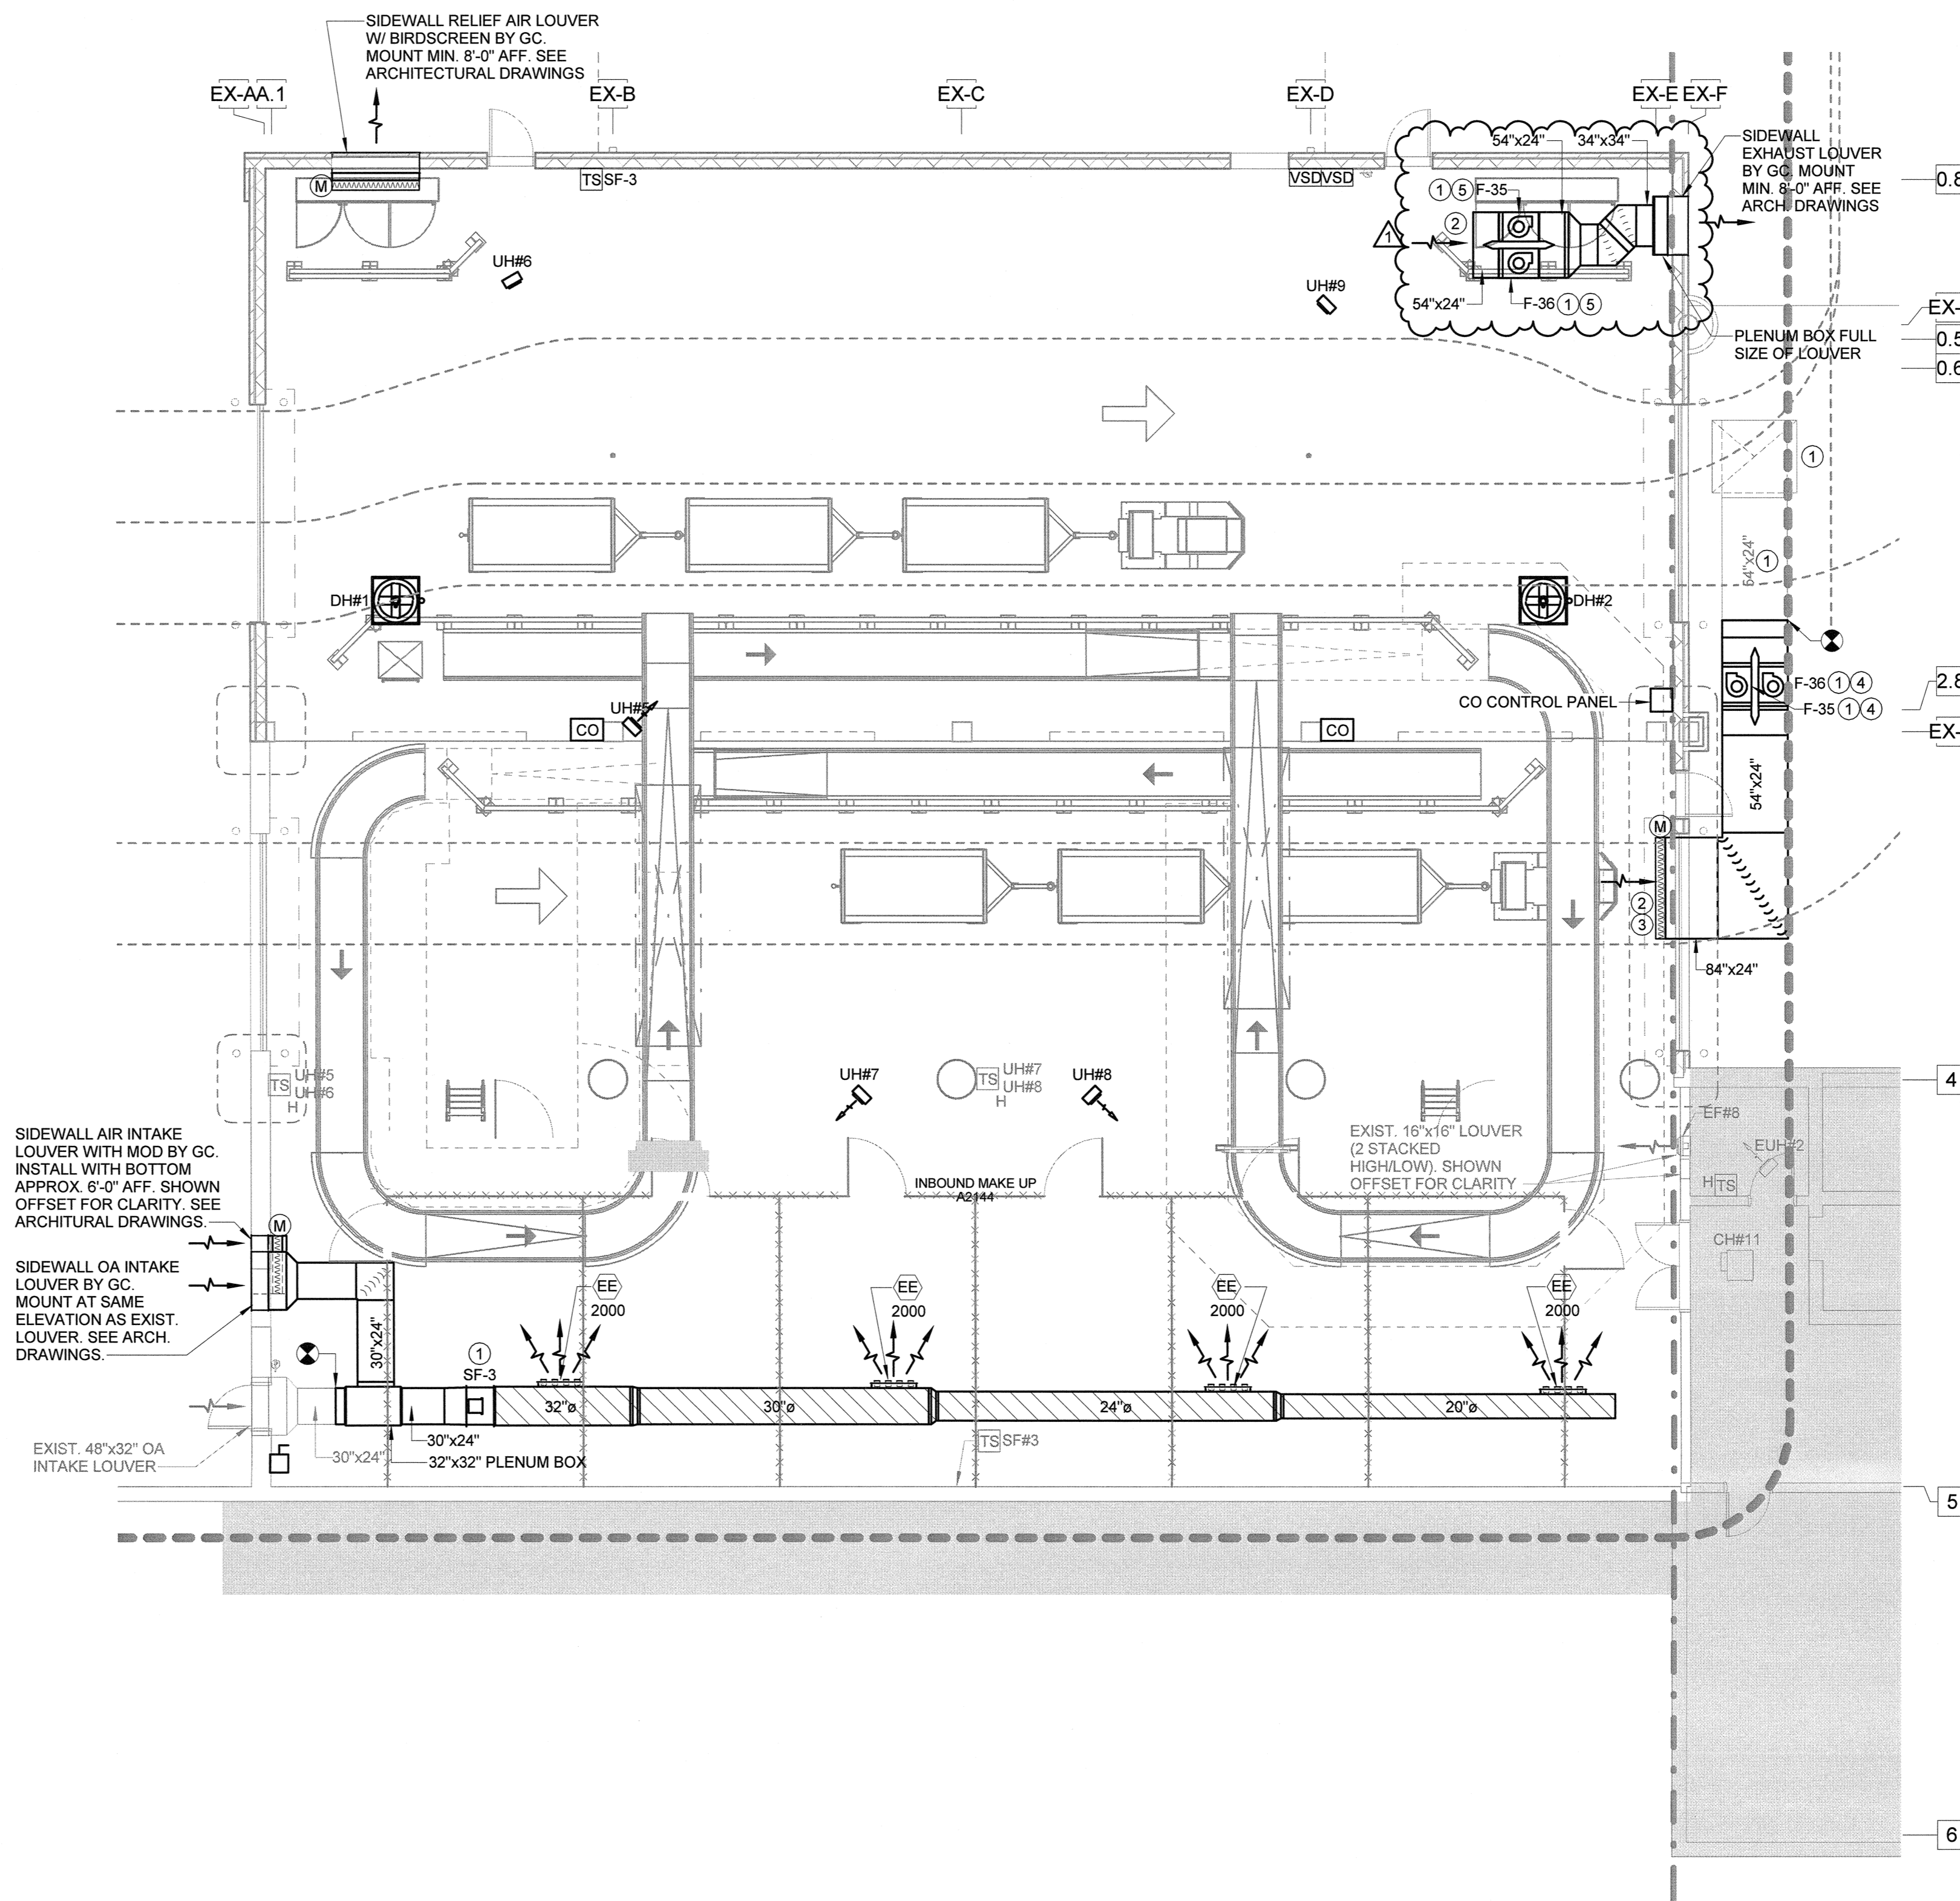

**1** SCHEDULE 2 - RAMP LEVEL MECHANICAL PLAN - ZONE 4 - ALTERNATE 1  
SCALE: 1/8" = 1'-0"

**KEYED NOTES:** THIS SHEET ONLY

- ① PROVIDE NEOPRENE VIBRATION ISOLATION ON ALL FAN SUPPORT HANGERS.
- ② PROVIDE 1/2"x1/2" WIRE MESH OVER OPEN END OF DUCTWORK.
- ③ INSTALL DUCTWORK IN EXISTING OPENING. TOP OF DUCTWORK SHALL BE INSTALLED AT THE TOP OF EXISTING OPENING. GENERAL CONTRACTOR TO FILL IN OPENING BELOW DUCTWORK TO MATCH EXISTING.
- ④ FOR ENABLING PHASE - MECHANICAL CONTRACTOR SHALL TEMPORARILY INSTALL FANS F-35 & F-36 IN LOCATION INDICATED DURING SCHEDULE 2 ALTERNATE BID 1 WORK. ONCE WORK HAS BEEN COMPLETED, MECHANICAL CONTRACTOR SHALL RELOCATE FANS TO FINAL POSITION INDICATED AND NOTED IN KEYED NOTE 5. SUPPORT FANS FROM STRUCTURE SIMILAR TO FAN INSTALLATION IN CONTRACT 1.
- ⑤ FINAL LOCATION OF FANS F-35 & F-36.

FOR CONTRACT 3 SCHEDULE 1 AND SCHEDULE 2 WORK PHASES:  
• SEE ARCHITECTURAL PLANS A-01\* SERIES FOR ADDITIONAL AND DETAILED PHASING INFORMATION.  
• SEE BAGGAGE HANDLING SYSTEM PLANS B-\* SERIES FOR ADDITIONAL AND DETAILED PHASING INFORMATION.  
• COORDINATE ACTUAL PHASED WORK REQUIREMENTS WITH THE GENERAL CONTRACTOR'S SCHEDULE.





# TERMINAL IMPROVEMENTS CONTRACT 3

Wilmington International Airport  
1740 Airport Boulevard, Suite 12  
Wilmington, NC 28405

**CHEATHAM & ASSOCIATES, P.A.**  
CONSULTING ENGINEERS  
3412 ENTERPRISE DRIVE  
WILMINGTON, NORTH CAROLINA 28405  
PHONE: (910) 452-4210  
FAX: (910) 452-4211  
OFFICE@CHEATHAMPA.COM  
NC LICENSE# C-1073

JOB # 19005

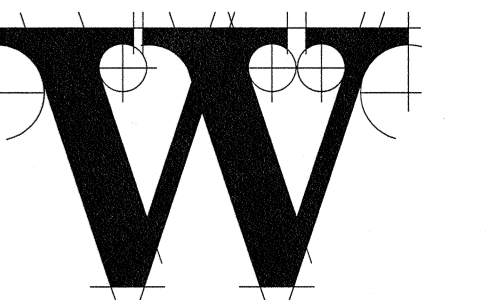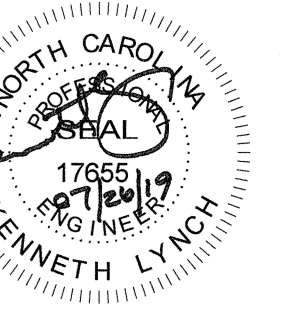

## THE WILSON GROUP - ARCHITECTS -

PO Box 5510 Charlotte, NC 28299  
704-331-9747 • www.twgarchitects.com

PROJECT MANAGER & CIVIL ENGINEER  
**TALBERT & BRIGHT**  
CONSULTING ARCHITECT  
LS3P

STRUCTURAL ENGINEER  
**STEWART**


FP/PRIME ENGINEER  
**CHEATHAM & ASSOC.**

BAGGAGE HANDLING CONSULTANTS  
**BNP**

AIRCRAFT SUPPORT SYSTEMS  
**DK CONSULTANTS**

SPECIALTY LIGHTING CONSULTANT  
**HARTRANFT**

SIGNAGE & WAYFINDING  
**TAKEFORM**

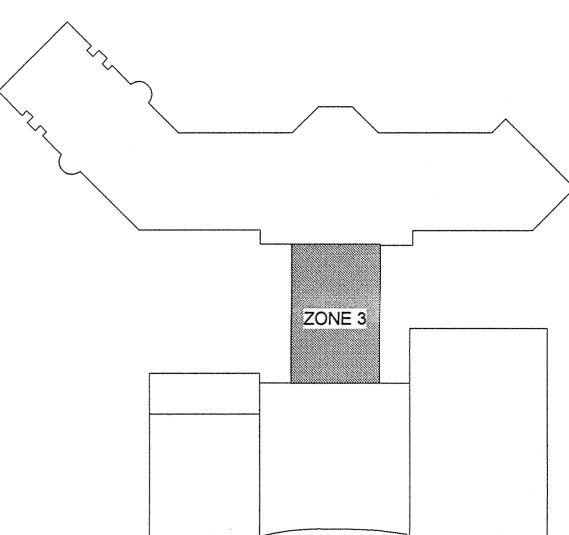

### KEY PLAN

COPYRIGHT © 2019  
THE WILSON GROUP ARCHITECTS  
ALL RIGHTS RESERVED

PRINTED OR ELECTRONIC DRAWINGS AND DOCUMENTATION MAY NOT BE REPRODUCED IN ANY FORM WITHOUT WRITTEN PERMISSION FROM THE WILSON GROUP ARCHITECTS

### REVISIONS


1 7/26/19 AD-03

DATE 06/28/19  
PROJECT NUMBER 9202-000  
SHEET TITLE

## SCHEDULE 2 - TICKET LEVEL MECHANICAL PLAN - ZONE 3

SHEET NUMBER

# M2-123

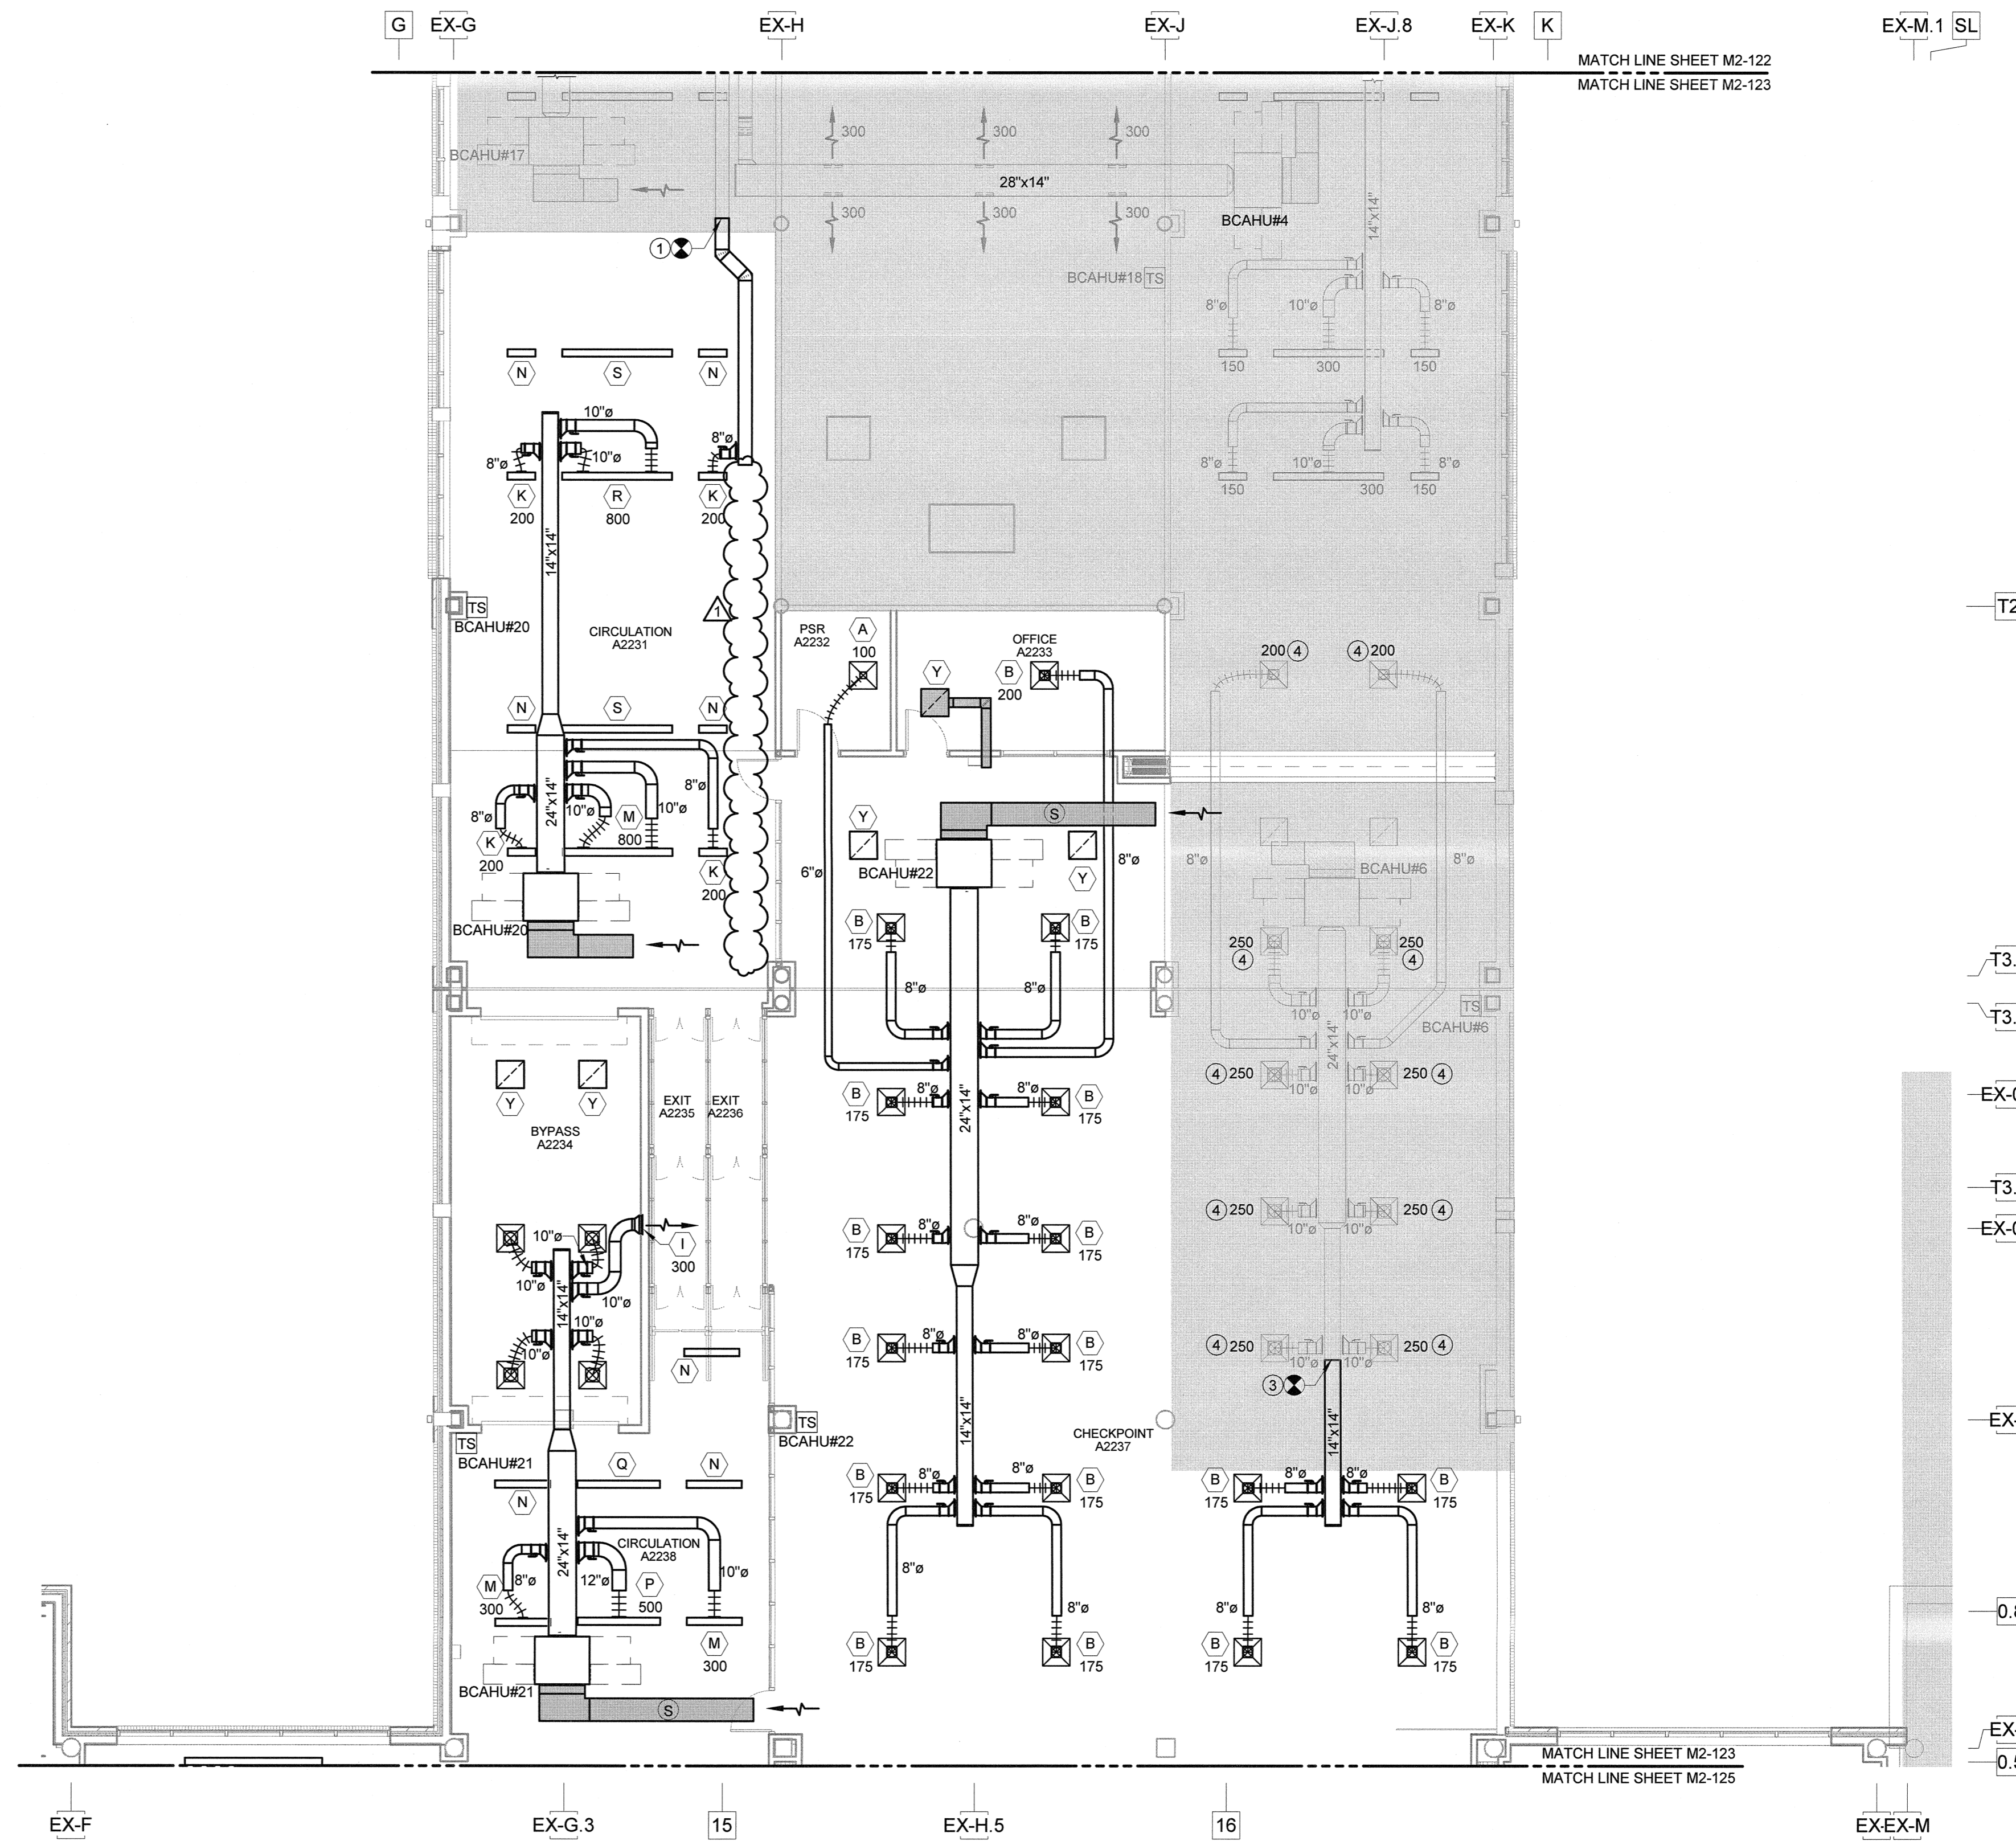

**1** SCHEDULE 2 - TICKET LEVEL MECHANICAL PLAN - ZONE 3  
SCALE: 1/8" = 1'-0"

### KEYED NOTES: THIS SHEET ONLY

- CONNECT NEW OUTSIDE AIR DUCTWORK TO EXISTING DUCTWORK AT POINT INDICATED.
- CAP UNUSED SUPPLY AIR RUNOUT AIRTRIGHT AND INSULATE AS SPECIFIED.
- CONNECT AND EXTEND DUCTWORK AS SHOWN.
- RETAB AIRFLOWS FOR EXISTING DIFFUSERS FOR BCAHU#6.

FOR CONTRACT 3 SCHEDULE 1 AND SCHEDULE 2 WORK PHASES:  
• SEE ARCHITECTURAL PLANS A-01\* SERIES FOR ADDITIONAL AND DETAILED PHASING INFORMATION.  
• SEE BAGGAGE HANDLING SYSTEM PLANS B-\* SERIES FOR ADDITIONAL AND DETAILED PHASING INFORMATION.  
• COORDINATE ACTUAL PHASED WORK REQUIREMENTS WITH THE GENERAL CONTRACTOR'S SCHEDULE.





**TERMINAL IMPROVEMENTS CONTRACT 3**

Wilmington International Airport  
1740 Airport Boulevard, Suite 12  
Wilmington, NC 28405

**CHEATHAM & ASSOCIATES, P.A.**  
CONSULTING ENGINEERS  
3412 ENTERPRISE DRIVE  
WILMINGTON, NORTH CAROLINA 28405  
PHONE: (910) 452-4210  
FAX: (910) 452-4211  
OFFICE@CHEATHAMPA.COM  
NC LICENSE# C-1073

**JOB # 19005**

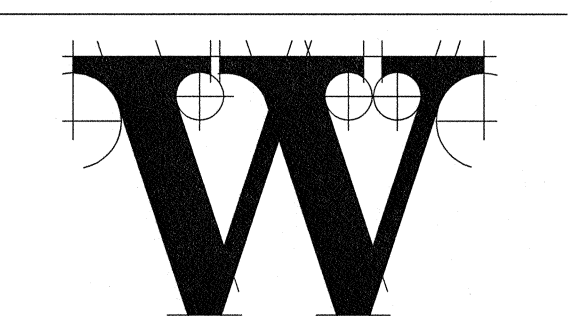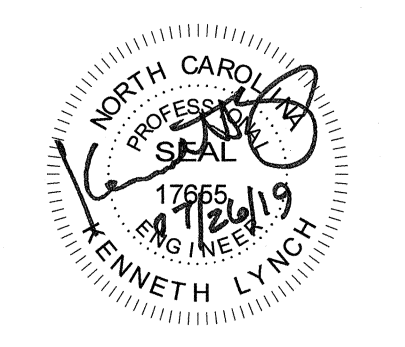

**THE WILSON GROUP**  
- ARCHITECTS -

PO Box 5510 Charlotte, NC 28299  
704-331-9747 • www.twgarchitects.com

PROJECT MANAGER & CIVIL ENGINEER  
**TALBERT & BRIGHT**

CONSULTING ARCHITECT  
**LS3P**

STRUCTURAL ENGINEER  
**STEWART**

FP/PM/E ENGINEER  
**CHEATHAM & ASSOC.**

BAGGAGE HANDLING CONSULTANTS  
**BNP**

AIRCRAFT SUPPORT SYSTEMS  
**DK CONSULTANTS**

SPECIALTY LIGHTING CONSULTANT  
**HARTRANFT**

SIGNAGE & WAYFINDING  
**TAKEFORM**

COPYRIGHT © 2019  
THE WILSON GROUP ARCHITECTS  
ALL RIGHTS RESERVED  
PRINTED OR ELECTRONIC DRAWINGS AND DOCUMENTATION MAY NOT BE REPRODUCED IN ANY FORM WITHOUT WRITTEN PERMISSION FROM THE WILSON GROUP ARCHITECTS

REVISIONS

1 7/26/19 AD-03

DATE 06/28/19  
PROJECT NUMBER 9202-000  
SHEET TITLE

**MECHANICAL SCHEDULES**

SHEET NUMBER

**M-601**

SYMBOL	UNIT TYPE	AIR QUANTITY			EXT SP *H2O		ELECTRICAL (3)			PREHEAT POSITION COIL (4)				COOLING COIL (6)					REHEAT POSITION COIL (4)			BASIS OF DESIGN	REMARKS					
		SUPPLY CFM	OUTSIDE AIR CFM	RELIEF CFM	SUPPLY (2)	RELIEF (2)	SUPPLY FAN HP	VOLTAGE & PHASE	RELIEF FAN HP	VOLTAGE & PHASE	EAT °F	GTH-MBH	GPM	PIPE SIZE	EDB °F	EWB °F	LDB °F	LWB °F	GTH-MBH	GPM (5)	PIPE SIZE			EAT °F	GTH-MBH	GPM	PIPE SIZE	CONTROL VALVES
AHU#1	CVMZ	31,650	4800 (1)	(12)	1.25	(12)	30	460V-3Ø	N/A	N/A	N/A	N/A	N/A	N/A	81.0	66.5	56.0	54.2	1182.3	235 (5A)	3"	61.0	678.9	67.5 (4A)(11)	2"	3-WAY	EXISTING - CARRIER 39EB57 (1986)	(7) CH ONLY
	Zone 1 (DD)	4256																										TICKETING COUNTER AREA
	Zone 2	NOT USED																										UPPER LOBBY
	Zone 3	4147																										TICKETING WAITING
	Zone 4	5770																										TICKETING ENTRY AND LOBBY
	Zone 5	10212																										ATRIUM LOBBY
AHU#2	CVMZ	25,500	4250 (1)	(12)	1.25	(12)	30	460V-3Ø	N/A	N/A	N/A	N/A	N/A	N/A	81.0	66.5	56.0	54.2	951.7	190 (5A)	3"	61.0	486.9	48.5 (4A)(11)	2"	3-WAY	EXISTING - CARRIER 39EB57 (1986)	(7) CH ONLY
	Zone 1 (DD)	1270																										EXISTING GIFT SHOP AREA
	Zone 2	3000																										SCREENING AREA
	Zone 3	2550																										BAGGAGE CLAIM EXTERIOR
	Zone 4	5250																										BAGGAGE CLAIM INTERIOR
	Zone 5	5000																										BAGGAGE CLAIM ENTRY AND LOBBY
	Zone 6 (DD)	4875																										2ND FLOOR ADMIN AREA
	Zone 7	1200																										CAR RENTAL AND OFFICES
	Zone 8	3550																										MAIAN ENTRY AND RESTROOMS
AHU#3	CVMZ	9800	3500 (1)	(15)(16)	1.65	(15)	[2] 7-1/2	460V-3Ø	N/A	N/A	N/A	N/A	N/A	N/A	81.4	68.9	53.0	52.9	500	83.5	3"	-	-	-	-	2-WAY (CH)		(7)(17)(18) CH ONLY
	Zone 1	2500																										NE HOLDING ROOM
	Zone 2	2100																										SW HOLDING ROOM
	Zone 3 (DD)	2200																										RAMP LEVEL OFFICE AREA
	Zone 4	3000																										MIDDLE HOLDING ROOM
AHU#4	VTCV	2700	450 (1)	N/A	1.00	N/A	3	460V-3Ø	N/A	N/A	N/A	N/A	N/A	N/A	78.0	65.9	53.0	52.9	107.5	18	1-1/2"	62.3	100.0	7.0	1"	3-WAY		(17) FINANCE OFFICES - RAMP LEVEL
AHU#5	VTCV	4000	375 (1)	N/A	1.80	N/A	7-1/2	460V-3Ø	N/A	N/A	N/A	N/A	N/A	N/A	80.5	64.5	52.8	52.5	141.4	28.0 (5A)	2"	60.0	167.0	17.0 (4A)	1-1/2"	3-WAY	EXISTING - YORK AP-80 (2000)	HOLDING ROOM
AHU#6	VTCV	4000	375 (1)	N/A	1.80	N/A	7-1/2	460V-3Ø	N/A	N/A	N/A	N/A	N/A	N/A	80.5	64.5	52.8	52.5	141.4	28.0 (5A)	2"	60.0	167.0	17.0 (4A)	1-1/2"	2-WAY	EXISTING - YORK AP-80 (2000)	HOLDING ROOM
AHU#7	DOAS	6500	6500	N/A	1.25	N/A	[2] 7-1/2	460V-3Ø	N/A	N/A	24.0	220.0	15.0	1-1/4"	93.0	78.0	52.0	51.9	530	88.5	3"	50.0	317.5	21.5	1-1/2"	2-WAY	TRANE CSAA014	(7)(17)(18)
AHU#8	DOAS	6500	6500	N/A	1.25	N/A	[2] 7-1/2	460V-3Ø	N/A	N/A	24.0	220.0	15.0	1-1/4"	93.0	78.0	52.0	51.9	530	88.5	3"	50.0	317.5	21.5	1-1/2"	2-WAY	TRANE CSAA014	(17)(18)
AHU#9	VAV	2600	275 (1)	(16)	1.80	0.50	3	460V-3Ø	1-1/2	460V-3Ø	24.0	100.0	6.75	1"	76.9	64.8	52.0	51.9	95	16	1-1/2"	50.0	125.0	8.5	1-1/4"	2-WAY	TRANE CSAA006	(17)(18)
AHU#10	VAV	4300	450 (1)	(16)	2.0	0.50	[2] 3	460V-3Ø	[2] 1-1/2	460V-3Ø	24.0	162.5	11.0	1-1/4"	76.9	64.8	52.0	51.9	160	27	2"	50.0	210.0	14.0	1-1/4"	3-WAY	TRANE CSAA008	(17)(18)
AHU#11	VAV	3300	350 (1)	(16)	1.8	0.50	5	460V-3Ø	1-1/2	460V-3Ø	24.0	125.0	8.5	1-1/4"	76.9	64.9	52.0	51.9	120	20	1-1/2"	50.0	160.0	11.0	1-1/4"	3-WAY	TRANE CSAA008	(17)(18)

- MINIMUM OUTSIDE AIR CFMS INDICATED WITH 0-100% OA ECONOMIZER, WITH RELIEF FAN WHERE INDICATED.
- EXT. S.P. INCLUDES DUCTWORK & GRILLES. COMPONENTS INTERNAL TO THE AHU SUCH AS FILTERS, COILS AND DAMPERS ARE NOT INCLUDED IN THIS FIGURE.
- UNIT SHALL HAVE SEPARATE POWER CONNECTION FOR EACH FAN.
- BASED ON 150°F EWT & 30°F DROP. MAXIMUM WATER PRESSURE DROP OF 10 FT FOR COIL PLUS CONTROL VALVE. COIL SHALL HAVE A MAXIMUM OF 120 FINS PER FOOT.
- BASED ON 180°F EWT & 20°F DROP.
- BASED ON 44°F EWT & 12°F RISE. MAXIMUM WATER PRESSURE DROP OF 20 FT. FOR COIL PLUS CONTROL VALVE.
- BASED ON 45°F EWT & 10°F RISE.
- BASED ON MAXIMUM COIL FACE VELOCITY OF 500 FPM AND MAXIMUM AIRSIDE PRESSURE DROP OF 2.0" WATER COLUMN. COIL SHALL HAVE A MINIMUM OF 6 ROWS AND A MAXIMUM OF 132 FINS PER FOOT.
- PROVIDE VARIABLE SPEED PUMPING SYSTEM DIFFERENTIAL PRESSURE TRANSMITTER ACROSS CHS & CHR PIPING AND ACROSS HWS & HWR PIPING TO COILS WITH INSTALLATION PER MANUFACTURER'S INSTRUCTIONS.
- MINIMUM AND MAXIMUM OUTSIDE AIR AND RETURN AIR CFMS INDICATED. SIGNAL FROM DEMAND CONTROL VENTILATION CO2 SENSOR CONTROLS OA CFM, RETURN AIR CFM AND RELIEF FAN TRACK ACCORDINGLY.
- TBD
- UNIT'S FILTERS SHALL HAVE A MAXIMUM FACE VELOCITY OF 500 FPM.
- SUM OF MULTIZONE UNITS DUCT MOUNTED HEATING COILS.
- EXISTING SVF FANS.
- HEATING IN ZONE'S DUAL DUCT BOXES.
- IN DUCT MOUNTED ZONE HEATING COILS WITH MAXIMUM COIL FACE VELOCITY 525 FPM AND A MAXIMUM AIR PRESSURE DROP OF 0.35" WATER COLUMN.
- OA ECONOMIZER RELIEF IS VIA DAMPER(S) TO LOUVERED PENTHOUSES IN HOLDROOM CEILING PLENUM.
- TRACKING OUTSIDE AIR AND SPACE STATIC PRESSURE, SEE SEQUENCES OF OPERATION.
- WITH HIGH EFFICIENCY FILTRATION SECTION
- WITH ACTIVATED CARBON FILTER SECTION

SYMBOL	AIRFLOW		EXT SP *H2O (1)	ELECTRICAL	COOLING COIL (3)(4)					REHEAT POSITION COIL (2)				CONTROL VALVES	BASIS OF DESIGN	REMARKS			
	SUPPLY AIR	OUTSIDE AIR			SUPPLY FAN HP	VOLTAGE & PHASE	EDB °F	EWB °F	LDB °F	LWB °F	GTH-MBH	GPM	PIPE SIZE				EAT °F	GTH-MBH	GPM
BCAHU#1	2075	210	0.60"	1.0	460V-3Ø	76.8	64.6	54.9	54.4	65.0	13 (3A)	1-1/4"	65.3	60.0	6 (2A)	1"	3-WAY	TRANE BCVD072	AIRLINE OFFICES ATO - EXISTING FOR REFERENCE ONLY
BCAHU#2	1050	120	0.50"	1.0	460V-3Ø	77.0	64.8	54.5	54.3	35.0	7 (3A)	1"	64.7	30.0	3 (2A)	3/4"	3-WAY	TRANE BCVD036	AIRLINE OFFICES ATO - EXISTING FOR REFERENCE ONLY
BCAHU#3	925	100	0.60"	1.0	460V-3Ø	76.9	64.7	54.5	54.0	30.0	6 (3A)	1"	65.0	27.5	2.75 (2A)	3/4"	3-WAY	TRANE BCVD036	AIRLINE OFFICES ATO - EXISTING FOR REFERENCE ONLY
BCAHU#4	3000	(5)	0.60"	3.0	460V-3Ø	75.0	63.0	54.5	54.3	90.0	15.00	1-1/4"	70.0	90.0	6.00	1"	2-WAY	TRANE BCHD090	BOARDING LEVEL - SCHEDULE 1 RESTAURANT AREA
BCAHU#5	2400	(5)	0.50"	3.0	460V-3Ø	75.0	63.0	55.0	54.9	80.0	13.50	1-1/4"	70.0	70.0	5.00	1"	2-WAY	TRANE BCHD072	BOARDING LEVEL - SCHEDULE 1 CONNECTOR
BCAHU#6	2400	(5)	0.50"	3.0	460V-3Ø	75.0	63.0	55.0	54.9	80.0	13.50	1-1/4"	70.0	70.0	5.00	1"	3-WAY	TRANE BCHD072	BOARDING LEVEL - SCHEDULE 1 CONNECTOR
BCAHU#7	3000	(5)	0.50"	3.0	460V-3Ø	75.0	63.0	54.5	54.3	90.0	15.00	1-1/4"	70.0	90.0	6.00	1"	2-WAY	TRANE BCHD090	BOARDING LEVEL - SCHEDULE 1 TENANT FIT-UP AREA
BCAHU#8	2400	(5)	0.60"	3.0	460V-3Ø	75.0	63.0	55.0	54.9	80.0	13.50	1-1/4"	70.0	70.0	5.00	1"	2-WAY	TRANE BCHD072	BOARDING LEVEL - SCHEDULE 1
BCAHU#9	2400	(5)	0.60"	3.0	460V-3Ø	75.0	63.0	55.0	54.9	80.0	13.50	1-1/4"	70.0	70.0	5.00	1"	2-WAY	TRANE BCHD072	BOARDING LEVEL - SCHEDULE 1
BCAHU#10	2400	(5)	0.60"	3.0	460V-3Ø	75.0	63.0	55.0	54.9	80.0	13.50	1-1/4"	70.0	70.0	5.00	1"	2-WAY	TRANE BCHD072	BOARDING LEVEL - SCHEDULE 1
BCAHU#11	2400	(5)	0.50"	3.0	460V-3Ø	75.0	63.0	55.0	54.9	80.0	13.50	1-1/4"	70.0	70.0	5.00	1"	2-WAY	TRANE BCHD072	BOARDING LEVEL - SCHEDULE 1
BCAHU#12	2400	(5)	0.50"	3.0	460V-3Ø	75.0	63.0	55.0	54.9	80.0	13.50	1-1/4"	70.0	70.0	5.00	1"	2-WAY	TRANE BCHD072	BOARDING LEVEL - SCHEDULE 1 (6)
BCAHU#13	3000	(5)	0.60"	3.0	460V-3Ø	75.0	63.0	54.5	54.3	90.0	15.00	1-1/4"	70.0	90.0	6.00	1"	3-WAY	TRANE BCHD090	BOARDING LEVEL - SCHEDULE 1
BCAHU#14	3000	(5)	0.60"	3.0	460V-3Ø	75.0	63.0	54.5	54.3	90.0	15.00	1-1/4"	70.0	90.0	6.00	1"	3-WAY	TRANE BCHD090	BOARDING LEVEL - SCHEDULE 1
BCAHU#15	2400	(5)	0.50"	3.0	460V-3Ø	75.0	63.0	55.0	54.9	80.0	13.50	1-1/4"	70.0	70.0	5.00	1"	2-WAY	TRANE BCHD072	BOARDING LEVEL - SCHEDULE 1
BCAHU#16	3000	(5)	0.50"	3.0	460V-3Ø	75.0	63.0	54.5	54.3	90.0	15.00	1-1/4"	70.0	90.0	6.00	1"	2-WAY	TRANE BCHD090	BOARDING LEVEL - SCHEDULE 1
BCAHU#17	2400	(5)	0.5																

**ELECTRICAL NOTES**

- ELECTRICAL WORK SHALL BE PERFORMED IN ACCORDANCE WITH THE NATIONAL ELECTRICAL CODE AND REQUIREMENTS OF THE LOCAL AUTHORITY HAVING JURISDICTION.
- PERMITS FOR ELECTRICAL WORK SHALL BE OBTAINED BY AND PAID BY THE ELECTRICAL CONTRACTOR. THE ELECTRICAL CONTRACTOR SHALL PAY FOR ANY ADDITIONAL FEES FOR INSPECTIONS, TESTS, AND OTHER SERVICES AS REQUIRED FOR THE COMPLETION OF THE WORK.
- THE ELECTRICAL CONTRACTOR AND ANY OF HIS SUBCONTRACTORS SHALL VISIT THE PROJECT SITE TO WITNESS EXISTING CONDITIONS AND BECOME FAMILIAR WITH THE SCOPE OF THE WORK REQUIRED PRIOR TO SUBMITTING PROPOSALS. WORK REQUIRED BY EXISTING JOB CONDITIONS NOT INDICATED ON DRAWINGS SHALL BE INCLUDED IN EACH PROPOSAL.
- THE DRAWINGS AND SPECIFICATIONS ARE INTENDED TO RESULT IN THE PRODUCTION OF A COMPLETE AND FUNCTIONAL ELECTRICAL SYSTEM. THE ELECTRICAL CONTRACTOR SHALL PROVIDE ALL MATERIAL, LABOR, EQUIPMENT, AND OTHER SERVICES AS NECESSARY TO COMPLETE THE WORK.
- DISCREPANCIES IN THE DRAWINGS AND SPECIFICATIONS THAT WILL AFFECT THE WORK SHALL BE BROUGHT TO THE ATTENTION OF THE ARCHITECT AND ENGINEER PRIOR TO SUBMITTING PROPOSALS.
- UNLESS NOTED OTHERWISE, ALL MATERIALS AND EQUIPMENT SHALL BE NEW AND INCLUDE A 3RD PARTY LABEL (I.E.: UL, CSA, ETC.) LISTING APPROVAL FOR ITS INSTALLED APPLICATION.
- REVIEW PLANS OF OTHER TRADES FOR COORDINATION OF WORK AND FOR RELATED AND ADJOINING WORK.
- REVIEW COMPLETE PLAN SET FOR CONSTRUCTION TYPE, FINISHES, HEADROOM, ROOF FINISHES, CEILING, ETC. REVIEW COMPLETE PLAN SET FOR PROJECT PHASING AND STAGING. REVIEW COMPLETE PLAN SET FOR WORK COVERED BY ALTERNATE BID ITEMS.
- COORDINATE DEVICE AND EQUIPMENT MOUNTING HEIGHTS WITH OTHER DISCIPLINE DRAWINGS, CASEWORK DETAILS & SUBMITTALS, EQUIPMENT DETAILS & SUBMITTALS, ETC.
- PENETRATIONS OF FIRE-RATED WALLS, FLOORS, CEILING, AND PARTITIONS SHALL BE FIRE STOPPED IN ACCORDANCE WITH REQUIREMENTS OF THE STATE BUILDING CODE. COORDINATE WORK TO INSURE THAT FIRE STOPPING IS COMPLETED.
- PENETRATIONS OF SMOKE PARTITIONS SHALL BE SEALED IN ACCORDANCE WITH REQUIREMENTS OF THE STATE BUILDING CODE. COORDINATE WORK TO INSURE THAT SMOKE PARTITION SEALING IS COMPLETED.
- PENETRATIONS OF EXTERIOR BUILDING WALLS, FLOORS, OR ROOFS SHALL BE SEALED WATER-TIGHT. INTERIORS OF RACEWAY PENETRATIONS THROUGH EXTERIOR WALLS SHALL BE SEALED WITH NON-HARDENING ELECTRICAL PUTTY.
- CUTTING AND PATCHING TO INSTALL DEVICES AND EQUIPMENT SHALL BE PERFORMED WITH FINISHES RESTORED TO THEIR ORIGINAL CONDITION. SUCH WORK SHALL BE COMPLETED TO A DEGREE THAT IS ACCEPTABLE TO THE ARCHITECT, ENGINEER, AND/OR OWNER.
- COORDINATE PRECISE LOCATION OF HVAC EQUIPMENT WITH THE MECHANICAL CONTRACTOR.
- FOR HVAC EQUIPMENT, VERIFY CIRCUIT BREAKER RATINGS, FUSE RATINGS, AND WIRE SIZES. IF RATINGS DIFFER FROM THOSE INDICATED ON THE DRAWINGS, NOTIFY THE ARCHITECT, ENGINEER, AND OWNER FOR DIRECTION. PROVIDE OVERCURRENT PROTECTION IN ACCORDANCE WITH EQUIPMENT MANUFACTURER NAMEPLATE DATA. IF THE EQUIPMENT LISTING LABEL REQUIRES FUSED PROTECTION, ENSURE THAT FUSES IN A FUSED DISCONNECT SWITCH AT THE EQUIPMENT ARE SIZED AS INDICATED ON THE EQUIPMENT LABEL.
- VERIFY PROPER SIZING OF OVERLOAD DEVICES IN STARTERS BASED ON EQUIPMENT NAMEPLATE DATA.
- IF HORSEPOWER OR LOAD RATINGS OF EQUIPMENT DIFFER FROM THOSE INDICATED ON THE DRAWINGS, NOTIFY THE ARCHITECT, ENGINEER, AND OWNER FOR DIRECTION.
- PROVIDE NATIONAL ELECTRICAL CODE REQUIRED CLEARANCES FOR ALL ELECTRICAL EQUIPMENT. COORDINATE RESOLUTION OF CONFLICTS WITH OTHER TRADES.
- RECEPTACLE, SWITCH, DATA/TELEPHONE OUTLETS SHALL BE FLUSH MOUNTED IN FINISHED SPACES UNLESS OTHERWISE NOTED.
- WHERE INSTALLED IN PLENUM SPACES, CABLES SHALL BE PLENUM-RATED OR INSTALLED IN METAL RACEWAY.
- PRIOR TO ORDERING LIGHT FIXTURES, CONTRACTOR SHALL VERIFY TYPE OF CEILING OR WALL BY REVIEW OF ARCHITECTURAL FINISH SCHEDULES AND PROVIDE SUITABLE TRIM AND APPURTENANCES TO MOUNT FIXTURES IN TYPE OF CEILING OR WALL INDICATED.
- RECESSED LIGHT FIXTURES INSTALLED IN CEILING HAVING INSULATION INSTALLED OVER CEILING AND FIXTURES (AS INDICATED IN ARCHITECTURAL PLANS, OR FOUND AS EXISTING CONDITIONS) SHALL BE U.L. RATED FOR DIRECT CONTACT WITH INSULATION.
- RECESSED LIGHT FIXTURES INSTALLED IN FIRE RATED CEILING SHALL BE U.L. RATED FOR USE IN FIRE RATED CEILING OR SHALL BE INSTALLED WITH "TENTING" IN ACCORDANCE WITH RATING REQUIREMENTS OF THE CEILING ASSEMBLY.
- EXIT AND EMERGENCY LIGHTS SHALL BE CONNECTED TO THE NEAREST UNSWITCHED CIRCUIT THAT SERVES LIGHT FIXTURES WITHIN THE SAME SPACE.
- NO MOUNTING HARDWARE SHALL BE ATTACHED TO ROOF DECKS. ATTACHMENTS SHALL BE MADE TO THE ROOF SUPPORTING STRUCTURE.
- WHERE WORKING IN EXISTING BUILDINGS, FACILITIES, OR STRUCTURES; PROTECT AND MAINTAIN IN OPERATION EXISTING LIFE SAFETY SYSTEMS, PUBLIC ADDRESS SYSTEMS, ELECTRICAL SYSTEMS, ETC. IF SHUTDOWNS ARE REQUIRED, NOTIFY THE ARCHITECT, ENGINEER, AND OWNER FOR COORDINATION WELL IN ADVANCE OF ANY SYSTEM SHUTDOWN. WHERE AN OUTAGE OF EXTENDED DURATION IS NOT ACCEPTABLE TO THE OWNER, PROVIDE TEMPORARY CONNECTIONS AS REQUIRED TO MAINTAIN SERVICE.
- WHERE WORKING IN EXISTING BUILDINGS, FACILITIES, OR STRUCTURES; WORK MAY BE REQUIRED TO BE PERFORMED WHILE REMAINING OCCUPIED BY OWNER STAFF. WORK SHALL BE COORDINATED WITH THE OWNER TO MINIMIZE DISRUPTION TO THE OWNER.
- WHERE WORKING IN EXISTING BUILDINGS, FACILITIES, OR STRUCTURES; EXISTING ABANDONED CIRCUITS USED TO CONNECT NEW LOADS IN THE SAME AREA SHALL BE CLEARLY IDENTIFIED ON AS-BUILT MARK-UP DRAWINGS WITH REGARD TO PANEL-CIRCUIT AND CIRCUIT ROUTING CONFIGURATION.
- ABANDONED CIRCUITRY (RACEWAY & CONDUCTORS) SHALL BE REMOVED IN ITS ENTIRETY FROM ITS SOURCE. ABANDONED LOW VOLTAGE CABLING SHALL BE REMOVED IN ITS ENTIRETY UNLESS OTHERWISE NOTED.
- PANEL BUS MATERIAL: COPPER.
- SHARED NEUTRAL CONDUCTORS SHALL NOT BE USED UNLESS SPECIFICALLY INDICATED SO ON HOMERUN CIRCUITRY DESIGNATIONS.
- PANEL BREAKER CONFIGURATIONS SHALL BE INSTALLED AS INDICATED ON THE PANEL SCHEDULES OR AS NOTED. BREAKER POSITION REVISIONS WILL NOT BE ACCEPTED UNLESS APPROVED IN WRITING BY THE ENGINEER.
- LOAD CIRCUITS SHALL BE INSTALLED AS INDICATED ON THE DRAWINGS. CIRCUITRY REVISIONS WILL NOT BE ACCEPTED UNLESS APPROVED IN WRITING BY THE ENGINEER.

**ABBREVIATIONS**

ADA	AMERICAN DISABILITIES ACT
AFF	ABOVE FINISHED FLOOR
AFS	ABOVE FINISHED GRADE
AHU	AIR HANDLER UNIT
AIC	AMP'S INTERRUPTING CAPABILITY
AV	AUDIO VIDEO
BAS	BUILDING AUTOMATION SYSTEM
BCAHU	BLOWER COIL AIR HANDLER UNIT
BKR	BREAKER
COND	CONDUIT
C/B	CIRCUIT BREAKER
CCTV	CLOSED CIRCUIT TELEVISION
CLD	CEILING
CKT	CIRCUIT
COMB	COMBINATION
COMM	COMMUNICATIONS
COMP	COMPRESSOR
CJ	COPPER
DDC	DIRECT DIGITAL CONTROL
DIA	DIAMETER
DWG	DRAWING
EMT	ELECTRICAL METALLIC TUBING
ENCL	ENCLOSED
EXSTG	EXISTING
FACP	FIRE ALARM CONTROL PANEL
FACU	FIRE ALARM CONTROL UNIT
FMC	FLEXIBLE METALLIC CONDUIT
G	EQUIPMENT GROUND
GEC	GROUNDING ELECTRODE CONDUCTOR
GFCI	GROUND FAULT CIRCUIT INTERRUPTER
GEP	GROUND FAULT EQUIPMENT PROTECTED
GFI	GROUND FAULT INTERRUPTER
GPI	GROUND POWER UNIT
HPF	HIGH POWER FACTOR
HP	HEAT PUMP
HP	HORSEPOWER
IMC	INTERMEDIATE METAL CONDUIT
K	KILO (THOUSAND)
LED	LIGHT EMITTING DIODE
LFMC	LIQUIDTIGHT FLEXIBLE METALLIC CONDUIT
LIT	LIGHTING
LTS	LIGHTS
MC	MECHANICAL CONTRACTOR
MCB	MAIN CIRCUIT BREAKER
MCP	MOTOR CONTROL PANEL
MDF	MAIN DISTRIBUTION PANEL
MFR	MANUFACTURER
MLO	MAIN LUG ONLY
MS	MOTOR STARTER
MSB	MAIN SWITCHBOARD
N/A	NOT APPLICABLE
NEC	NATIONAL ELECTRICAL CODE
NEMA	NATIONAL ELECTRICAL MANUFACTURERS ASSOC.
NTS	NOT TO SCALE
P	PHASE OR POLE
PBB	PASSENGER BOARDING BRIDGE
PC	PLUMBING CONTRACTOR
PH	PHASE
PLC	PROGRAMMABLE LOGIC CONTROLLER
PNL	PANEL
PVC	POLYVINYL CHLORIDE
REC	RECEPTACLE
RECP	RECEPTACLE
REQ.	REQUIRED
RGC	RIGID GALVANIZED CONDUIT
RGS	RIGID GALVANIZED STEEL
S.S.	STAINLESS STEEL
SYS	SYSTEM
S/N	SOLID NEUTRAL
TEL	TELEPHONE
TSP	TWISTED SHIELDED PAIR
TYP	TYPICAL
UL	UNDERWRITERS LABORATORY
UH	UNIT HEATER
UNO	UNLESS NOTED OTHERWISE
UNO	UNLESS OTHERWISE NOTED
V	VOLTS
VA	VOLT-AMPS
VFD	VARIABLE FREQUENCY DRIVE
W	WATTS
W	WIRE
W/	WITH
WSP	WEATHERPROOF
XFMR	TRANSFORMER

**SHEET LIST**

E-001	ELECTRICAL NOTES, SHEET LIST, & APPENDIX B SUMMARY
E-002	ELECTRICAL LEGENDS
ED1-111	SCHEDULE 1 - ELECTRICAL RAMP LEVEL DEMO PLAN ZONE 1
ED1-113	SCHEDULE 1 - ELECTRICAL RAMP LEVEL DEMO PLAN ZONE 3
ED1-114	SCHEDULE 1 - ELECTRICAL RAMP LEVEL DEMO PLAN ZONE 4
ED1-115	SCHEDULE 1 - ELECTRICAL RAMP LEVEL DEMO PLAN ZONE 5
ED1-121	SCHEDULE 1 - ELECTRICAL BOARDING LEVEL DEMO PLAN ZONE 1
ED1-123	SCHEDULE 1 - ELECTRICAL BOARDING LEVEL DEMO PLAN ZONE 3
ED1-125	SCHEDULE 1 - ELECTRICAL BOARDING LEVEL DEMO PLAN ZONE 5
E1-109	SCHEDULE 1 - ELECTRICAL SITE PLAN
E1-110	SCHEDULE 1 - ELECTRICAL RAMP LEVEL OVERALL PLAN
E1-111	SCHEDULE 1 - ELECTRICAL RAMP LEVEL POWER PLAN ZONE 1
E1-112	SCHEDULE 1 - ELECTRICAL RAMP LEVEL POWER PLAN ZONE 2
E1-113	SCHEDULE 1 - ELECTRICAL RAMP LEVEL POWER PLAN ZONE 3
E1-114	SCHEDULE 1 - ELECTRICAL RAMP LEVEL POWER PLAN ZONE 4
E1-115	SCHEDULE 1 - ELECTRICAL RAMP LEVEL POWER PLAN ZONE 5
E1-116	SCHEDULE 1 - ELECTRICAL RAMP LEVEL POWER PLAN ZONE 6
E1-121	SCHEDULE 1 - ELECTRICAL RAMP LEVEL LIGHTING PLAN ZONE 1
E1-122	SCHEDULE 1 - ELECTRICAL RAMP LEVEL LIGHTING PLAN ZONE 2
E1-123	SCHEDULE 1 - ELECTRICAL RAMP LEVEL LIGHTING PLAN ZONE 3
E1-124	SCHEDULE 1 - ELECTRICAL RAMP LEVEL LIGHTING PLAN ZONE 4
E1-131	SCHEDULE 1 - ELECTRICAL RAMP LEVEL AUXILIARY SYSTEMS ZONE 1
E1-132	SCHEDULE 1 - ELECTRICAL RAMP LEVEL AUXILIARY SYSTEMS ZONE 2
E1-133	SCHEDULE 1 - ELECTRICAL RAMP LEVEL AUXILIARY SYSTEMS ZONE 3
E1-135	SCHEDULE 1 - ELECTRICAL RAMP LEVEL AUXILIARY SYSTEMS ZONE 5
E1-136	SCHEDULE 1 - ELECTRICAL RAMP LEVEL AUXILIARY SYSTEMS ZONE 6
E1-140	SCHEDULE 1 - ELECTRICAL BOARDING LEVEL OVERALL PLAN
E1-141	SCHEDULE 1 - ELECTRICAL BOARDING LEVEL POWER PLAN ZONE 1
E1-142	SCHEDULE 1 - ELECTRICAL BOARDING LEVEL POWER PLAN ZONE 2
E1-143	SCHEDULE 1 - ELECTRICAL BOARDING LEVEL POWER PLAN ZONE 3
E1-151	SCHEDULE 1 - ELECTRICAL BOARDING LEVEL LIGHTING PLAN ZONE 1
E1-152	SCHEDULE 1 - ELECTRICAL BOARDING LEVEL LIGHTING PLAN ZONE 2
E1-153	SCHEDULE 1 - ELECTRICAL BOARDING LEVEL LIGHTING PLAN ZONE 3
E1-157	SCHEDULE 1 - ELECTRICAL CLERESTORY LEVEL LIGHTING PLAN
E1-161	SCHEDULE 1 - ELECTRICAL BOARDING LEVEL AUXILIARY SYSTEMS ZONE 1
E1-162	SCHEDULE 1 - ELECTRICAL BOARDING LEVEL AUXILIARY SYSTEMS ZONE 2
E1-163	SCHEDULE 1 - ELECTRICAL BOARDING LEVEL AUXILIARY SYSTEMS ZONE 3
E1-171	SCHEDULE 1 - ELECTRICAL ROOF PLAN ZONE 1
E1-172	SCHEDULE 1 - ELECTRICAL ROOF PLAN ZONE 2
E1-173	SCHEDULE 1 - ELECTRICAL ROOF PLAN ZONE 3
E1-401	SCHEDULE 1 - ELECTRICAL ENLARGED ELECTRICAL ROOM PLANS
E1-402	SCHEDULE 1 - ELECTRICAL GENERATOR & UTILITY XFMR PLANS
E2-111	SCHEDULE 2 - ELECTRICAL ENLARGED PLANS - MECHANICAL A4
ED2-111	SCHEDULE 2 - ELECTRICAL RAMP LEVEL DEMO PLAN ZONE 1
ED2-112	SCHEDULE 2 - ELECTRICAL RAMP LEVEL DEMO PLAN ZONE 2
ED2-113	SCHEDULE 2 - ELECTRICAL RAMP LEVEL DEMO PLAN ZONE 3
ED2-114	SCHEDULE 2 - ELECTRICAL RAMP LEVEL DEMO PLAN ZONE 4
ED2-115	SCHEDULE 2 - ELECTRICAL RAMP LEVEL DEMO PLAN ZONE 5
ED2-121	SCHEDULE 2 - ELECTRICAL BOARDING LEVEL DEMO PLAN ZONE 1
ED2-123	SCHEDULE 2 - ELECTRICAL BOARDING LEVEL DEMO PLAN ZONE 3
ED2-124	SCHEDULE 2 - ELECTRICAL BOARDING LEVEL DEMO PLAN ZONE 4
ED2-125	SCHEDULE 2 - ELECTRICAL BOARDING LEVEL DEMO PLAN ZONE 5
E2-110	SCHEDULE 2 - ELECTRICAL RAMP LEVEL OVERALL PLAN
E2-111	SCHEDULE 2 - ELECTRICAL RAMP LEVEL POWER PLAN ZONE 1
E2-113	SCHEDULE 2 - ELECTRICAL RAMP LEVEL POWER PLAN ZONE 3
E2-114	SCHEDULE 2 - ELECTRICAL RAMP LEVEL POWER PLAN ZONE 4
E2-115	SCHEDULE 2 - ELECTRICAL RAMP LEVEL POWER PLAN ZONE 5
E2-121	SCHEDULE 2 - ELECTRICAL RAMP LEVEL LIGHTING PLAN ZONE 1
E2-123	SCHEDULE 2 - ELECTRICAL RAMP LEVEL LIGHTING PLAN ZONE 3
E2-124	SCHEDULE 2 - ELECTRICAL RAMP LEVEL LIGHTING PLAN ZONE 4
E2-125	SCHEDULE 2 - ELECTRICAL RAMP LEVEL LIGHTING PLAN ZONE 5
E2-131	SCHEDULE 2 - ELECTRICAL RAMP LEVEL AUXILIARY SYSTEMS ZONE 1
E2-133	SCHEDULE 2 - ELECTRICAL RAMP LEVEL AUXILIARY SYSTEMS ZONE 3
E2-134	SCHEDULE 2 - ELECTRICAL RAMP LEVEL AUXILIARY SYSTEMS ZONE 4
E2-135	SCHEDULE 2 - ELECTRICAL RAMP LEVEL AUXILIARY SYSTEMS ZONE 5
E2-140	SCHEDULE 2 - ELECTRICAL BOARDING LEVEL OVERALL PLAN
E2-141	SCHEDULE 2 - ELECTRICAL BOARDING LEVEL POWER PLAN ZONE 1
E2-142	SCHEDULE 2 - ELECTRICAL BOARDING LEVEL POWER PLAN ZONE 2
E2-143	SCHEDULE 2 - ELECTRICAL BOARDING LEVEL POWER PLAN ZONE 3
E2-144	SCHEDULE 2 - ELECTRICAL BOARDING LEVEL POWER PLAN ZONE 4
E2-145	SCHEDULE 2 - ELECTRICAL BOARDING LEVEL POWER PLAN ZONE 5
<del>E2-146</del>	<del>SCHEDULE 2 - ELECTRICAL BOARDING LEVEL POWER PLAN ZONE 6</del>
E2-151	SCHEDULE 2 - ELECTRICAL BOARDING LEVEL LIGHTING PLAN ZONE 1
E2-153	SCHEDULE 2 - ELECTRICAL BOARDING LEVEL LIGHTING PLAN ZONE 3
E2-154	SCHEDULE 2 - ELECTRICAL BOARDING LEVEL LIGHTING PLAN ZONE 4
E2-155	SCHEDULE 2 - ELECTRICAL BOARDING LEVEL LIGHTING PLAN ZONE 5
E2-156	SCHEDULE 2 - ELECTRICAL BOARDING LEVEL LIGHTING PLAN ZONE 6
E2-161	SCHEDULE 2 - ELECTRICAL BOARDING LEVEL AUXILIARY SYSTEMS ZONE 1
E2-163	SCHEDULE 2 - ELECTRICAL BOARDING LEVEL AUXILIARY SYSTEMS ZONE 3
E2-164	SCHEDULE 2 - ELECTRICAL BOARDING LEVEL AUXILIARY SYSTEMS ZONE 4
E2-165	SCHEDULE 2 - ELECTRICAL BOARDING LEVEL AUXILIARY SYSTEMS ZONE 5
E2-171	SCHEDULE 1 - ELECTRICAL ROOF PLAN ZONE 1
E2-173	SCHEDULE 1 - ELECTRICAL ROOF PLAN ZONE 3
E2-174	SCHEDULE 1 - ELECTRICAL ROOF PLAN ZONE 4
E-501	ELECTRICAL DETAILS
E-502	ELECTRICAL DETAILS
E-503	ELECTRICAL DETAILS
E-504	ELECTRICAL DETAILS
E-601	ELECTRICAL LUMINAIRE AND DIMMER SCHEDULE
E-602	ELECTRICAL EQUIPMENT CIRCUITRY SCHEDULES
E-603	ELECTRICAL PANEL SCHEDULES
E-604	ELECTRICAL PANEL SCHEDULES
E-605	ELECTRICAL PANEL SCHEDULES
E-606	ELECTRICAL PANEL SCHEDULES
E-701	ELECTRICAL POWER RISER DIAGRAM
E-702	ELECTRICAL POWER RISER DIAGRAM
E-703	ELECTRICAL MISCELLANEOUS RISER DIAGRAMS
E-801	ELECTRICAL PA ZONE COVERAGE PLAN



**APPENDIX B, BUILDING CODE SUMMARY**  
**ELECTRICAL SUMMARY FOR BUILDING ADDITION**

**METHOD OF COMPLIANCE**  
 -ENERGY CODE:  PREScriptive  PERFORMANCE  
 -ASHRAE 90.1:  PREScriptive  PERFORMANCE

**LIGHTING SCHEDULE**  
 Lamp Type Required in Fixtures \_\_\_\_\_  
 Number of Lamps in Fixtures \_\_\_\_\_ SEE LIGHT FIXTURE /  
 Ballast Types Used in Fixtures \_\_\_\_\_ LUMINAIRE SCHEDULE  
 Number of Ballasts Used in Fixtures \_\_\_\_\_  
 Total Wattage per Fixture \_\_\_\_\_

**TOTAL WATTAGE SPECIFIED VERSUS ALLOWED**  
 Interior Specified: 55,336 Watts Exterior Specified: 7,467 Watts  
 Interior Allowed: 74,294 Watts Exterior Allowed: 17,335 Watts

**ADDITIONAL METHOD OF COMPLIANCE**  
 506.2.1 More Efficient Mechanical Equipment  
 506.2.2 Reduced Lighting Power Density  
 506.2.3 Energy Recovery Ventilation System  
 506.2.4 Higher Efficiency Service Water Heating  
 506.2.5 On-Site Supply of Renewable Energy  
 506.2.6 Automatic Daylighting Control Systems

**DESIGNER STATEMENT**  
 To the best of my knowledge and belief, the design of this building complies with the electrical systems and equipment requirements of the North Carolina State Building Code, Section 505 of the North Carolina Energy Conservation Code.

SIGNED: Mark A. Clarraco  
 NAME: Mark A. Clarraco, P.E.  
 TITLE: Engineer

**WARNING**  
 Maximum Available Fault Current:  
 30,377 Symmetrical RMS Amperes  
 Date: 06/28/2019  
 Based on:  
 Utility Transformer: 1500 kVA (Maximum)  
 Utility Transformer: 5.32% Impedance (Minimum)  
 Service Feeder: #600KCMIL (6 SETS)(Maximum) Copper  
 Service Feeder Length: 390 (Minimum)  
 Motor Load: 600 kVA (Maximum)

NOTE:  
 THE CONTRACTOR SHALL OBTAIN INSTALLED SERVICE TRANSFORMER DATA AND AVAILABLE FAULT CURRENT DATA FROM THE UTILITY COMPANY. FORWARD INFORMATION TO THE ENGINEER FOR ASSESSMENT OF REVISIONS TO THE LABEL DATA.

**FAULT CURRENT LABEL FOR SERVICE EQUIPMENT**  
 NO SCALE

**MISC. ELECTRICAL SYMBOL LEGEND**

	ENCLOSED CIRCUIT BREAKER, NEMA 1 (UNO), AMPERAGE AS INDICATED OR BASED ON SUPPLY CIRCUIT RATING.
	EQUIPMENT CONNECTION
	SAFETY SWITCH DISCONNECT, HEAVY-DUTY, NON-FUSED, NEMA 1 INSIDE, NEMA 4X OUTSIDE (UNO), AMPERAGE AS INDICATED OR BASED ON SUPPLY CIRCUIT BREAKER RATING.
	SAFETY SWITCH DISCONNECT, HEAVY-DUTY, FUSED AT NAMEPLATE RATING OF EQUIPMENT SERVED, NEMA 1 INSIDE, NEMA 4X OUTSIDE (UNO), AMPERAGE AS INDICATED OR BASED ON SUPPLY CIRCUIT BREAKER RATING.
	MANUAL MOTOR STARTER, SIZED IN ACCORDANCE WITH NAMEPLATE RATING OF EQUIPMENT SERVED
	PANELBOARD, SEE PANEL SCHEDULE
	TRANSFORMER, DRY TYPE, RATINGS INDICATED. PROVIDE 4" CONCRETE HOUSE KEEPING PAD IF A FLOOR MOUNTED UNIT IS PROVIDED.
	GROUND ROD, 3/4" X 10' COPPER CLAD. WHERE TWO RODS ARE INDICATED, SPACE A MINIMUM OF 20' APART.
	DOOR OPERATOR PUSHBUTTON STATION.
<p>HOMERUN DESIGNATION, #12 CONDUCTORS UNLESS NOTED OTHERWISE.</p> <p>BY EC PROVIDED BY EC, INSTALLED BY EC</p> <p>CONDUCTOR TERMINATIONS IN EQUIPMENT BY MC &amp; PC</p> <p>BY EC</p> <p>— EQUIPMENT GROUND CONDUCTOR — PHASE CONDUCTOR — NEUTRAL CONDUCTOR</p> <p>LETTER INDICATES ELEVATION OR DETAIL: NUMBER INDICATES PLAN OR SECTION SHEET NUMBER WHERE PLAN, SECTION, ELEVATION OR DETAIL IS DRAWN</p>	

**RECEPTACLE LEGEND**

SYMBOL	NEMA	VOLTS	DESCRIPTION
	5-20R	120V 1P 2W	DUPLEX, MTD 18" AFF UNO
	5-20R	120V 1P 2W	DUPLEX, MTD TO CEILING STRUCTURE FOR CATWALK MAINTENANCE.
	5-20R	120V 1P 2W	DUPLEX FOR CONDENSATE PUMP; COORDINATE LOCATION W/ MECH CONTRACTOR
	5-20R	120V 1P 2W	DUPLEX GFCI, MTD 6" ABOVE COUNTER HEIGHT UNO
	5-20R	120V 1P 2W	DUPLEX ELECTRIC WATER COOLER OUTLET; SUPPLY FROM GFCI TYPE C/B; COORDINATE MTG LOCATION TO CONCEAL OUTLET WHEN COOLER IS INSTALLED.
	5-20R	120V 1P 2W	DUPLEX GFCI, MTD 18" AFF UNO; LISTED WEATHER-RESISTANT TYPE; PROVIDE CAST ALUMINUM WEATHERPROOF IN-USE COVER WITH CAST ALUMINUM FD WEATHERPROOF BOX.
	5-20R	120V 1P 2W	DUPLEX GFCI FOR HEAT TRACE; LISTED WEATHER-RESISTANT TYPE; PROVIDE CAST ALUMINUM WEATHERPROOF IN-USE COVER WITH CAST ALUMINUM FD WEATHERPROOF BOX.
	5-20R	120V 1P 2W	DUPLEX FOR HOT BOX HEATER; SUPPLY FROM GFCI TYPE C/B (30mA); LISTED WEATHER-RESISTANT TYPE; PROVIDE CAST ALUMINUM WEATHERPROOF IN-USE COVER WITH CAST ALUMINUM FD WEATHERPROOF BOX. COORDINATE MTG HEIGHT WITH ENCLOSURE PROVIDED.
	5-20R	120V 1P 2W	DUPLEX FOR FLIGHT INFORMATION DISPLAY. LOCATED BEHIND TV MOUNT IN RECESSED LCD OUTLET BOX (COORDINATE SPECIFIC LOCATION AND HEIGHT WITH OWNER/ARCHITECT). SEE AUXILIARY SYSTEMS PLANS FOR SHARED BOX WITH DATA OUTLET. DESIGN BASIS ARLINGTON #TVB5613 WITH COVER. SEE DETAIL J/E-501.
	5-20R	120V 1P 2W	DUPLEX GFCI, MTD 18" AFF UNO
	5-20R	120V 1P 2W	DUPLEX GFCI FOR HEAT TRACE; LISTED WEATHER-RESISTANT TYPE; PROVIDE CAST ALUMINUM WEATHERPROOF IN-USE COVER WITH CAST ALUMINUM FD WEATHERPROOF BOX.
	5-20R	120V 1P 2W	DUPLEX FOR HOT BOX HEATER; SUPPLY FROM GFCI TYPE C/B (30mA); LISTED WEATHER-RESISTANT TYPE; PROVIDE CAST ALUMINUM WEATHERPROOF IN-USE COVER WITH CAST ALUMINUM FD WEATHERPROOF BOX. COORDINATE MTG HEIGHT WITH ENCLOSURE PROVIDED.
	5-20R	120V 1P 2W	DUPLEX FOR REFRIGERATOR; MOUNT 48" AFF UNO. SUPPLY FROM GFCI TYPE C/B.
	5-20R	120V 1P 2W	DUPLEX POWER FOR SUMP PUMP ALARM PANEL. COORDINATE EXACT LOCATION WITH OWNER.
	5-20R	120V 1P 2W	TSA TDC/CAT OUTLET (G); 5-20R DUPLEX; MTD IN 8" POKE-THRU ASSEMBLY; SEE AUX SYS PLANS FOR SHARED ASSEMBLY; COVER FINISH SELECTION BY ARCHITECT. SEE TSA OUTLETS DETAIL A-503.
	5-20R	120V 1P 2W	TSA STSO OUTLET (P); 5-20R DUPLEX MTD IN 8" POKE-THRU ASSEMBLY; SEE AUX SYS PLANS FOR SHARED ASSEMBLY; COVER FINISH SELECTION BY ARCHITECT. SEE TSA OUTLETS DETAIL A-503.
	5-20R	120V 1P 2W	DUPLEX, UNO MTD AT CEILING FOR TV.
	120V 1P 2W		J-BOX ABOVE CLG LEVEL FOR DDC OR MECHANICAL CONTROL POWER SOURCE
	120V 1P 2W		POWER FOR FUTURE DECORATIVE PENDANT, MOUNTED AT TOP OF CUPOLA.
	120V 1P 2W		POWER FOR EXIT LANE. COORDINATE EXACT LOCATION WITH EQUIPMENT VENDOR.
	120V 1P 2W		POWER FOR FIRE ALARM COMPONENTS
	120V 1P 2W		POWER FOR ILLUMINATED GATE SIGN. MOUNT ABOVE GATE DOOR, COORDINATE EXACT LOCATION AND MOUNTING HEIGHT WITH SIGN VENDOR.
	120V 1P 2W		POWER FOR ILLUMINATED SIGN. COORDINATE EXACT LOCATION AND MOUNTING HEIGHT WITH SIGN VENDOR.
	120V 1P 2W		POWER FOR LED LIGHTED MIRROR. COORDINATE WITH ARCHITECT FOR EXACT HEIGHT AND LOCATION.
	5-20R	120V 1P 2W	QUAD, MTD 18" AFF UNO
	5-20R	120V 1P 2W	QUAD FOR BACK DISPLAY. LOCATED IN RECESSED OUTLET BOX (COORDINATE SPECIFIC LOCATION WITH OWNER/ARCHITECT). SEE AUXILIARY SYSTEMS PLANS FOR SHARED BOX WITH DATA OUTLET. DESIGN BASIS ARLINGTON #TVB5613 WITH COVER. SEE DETAIL S/E-502.
	5-20R	120V 1P 2W	QUAD, MTD IN FLUSH FLOOR BOX; SEE AUX SYS PLANS FOR SHARED BOX; PROVIDE DIVIDER FOR POWER SEPARATION FROM VOICE/DATA
	5-20R	120V 1P 2W	QUAD; MTD IN POKE-THRU ASSEMBLY; SEE AUX SYS PLANS FOR SHARED ASSEMBLY; 8" POKE-THRU WITH 4-GANG CAPACITY; COVER FINISH SELECTION BY ARCHITECT.
	5-20R	120V 1P 2W	TSA DURESS OUTLET (F); QUAD; MTD 18" AFF UNO. SEE TSA OUTLETS DETAIL A-503.
	5-20R	120V 1P 2W	SIMPLEX OUTLET FOR SUMP PUMP; SUPPLIED FROM GFCI C/B; MOUNT 24" AFF/AFG.
	L5-30R	120V 1P 2W	DATA ROOM RECEPTACLE. MOUNT TO TOP OF RACK.
	120V 1P 2W		TSA FRONT XRAY OUTLET (A). 5-20R DUPLEX & L5-15R TWISTLOCK MTD IN 8" POKE-THRU ASSEMBLY; SEE AUX SYS PLANS FOR SHARED ASSEMBLY; COVER FINISH SELECTION BY ARCHITECT. SEE TSA OUTLETS DETAIL A-503.
	120V 1P 2W		TSA REAR XRAY OUTLET (B). (3) 5-20R DUPLEX, (1) 5-20R SIMPLEX, & (1) L5-30R TWISTLOCK MOUNTED IN 10" POKE-THRU ASSEMBLY; VERIFY SPACING REQUIREMENTS WITH MANUFACTURER FOR MINIMUM DISTANCE FROM ADJACENT DATA POKE-THRU; COVER FINISH SELECTION BY ARCHITECT. SEE TSA OUTLETS DETAIL A-503.
	120V 1P 2W		TSA AVS/BSL/ETD OUTLET (C). 5-20R DUPLEX MTD IN 8" POKE-THRU ASSEMBLY; SEE AUX SYS PLANS FOR SHARED ASSEMBLY; COVER FINISH SELECTION BY ARCHITECT. SEE TSA OUTLETS DETAIL A-503.
	L6-30R	208V 2P 2W	POWER FOR TSA IT CABINET
	120V 1P 2W		EXHAUST FAN; SEE MECHANICAL SCHEDULE. PROVIDE POWER PACK FOR SWITCHING WITH LIGHTING CEILING OCCUPANCY SENSOR.

**SWITCH LEGEND**

SYMBOL	DESCRIPTION	NOTES
	DIMMER SWITCH	RATED FOR VOLTAGE WHERE APPLIED, 20A; MTD 42" AFF UNO
	DIMMER SWITCH FOR 3-WAY CONTROL	RATED FOR VOLTAGE WHERE APPLIED, 20A; MTD 42" AFF UNO
	4-WAY SWITCH	RATED FOR VOLTAGE WHERE APPLIED, 20A; MTD 42" AFF UNO; WHERE SHOWN PAIRED, PROVIDE DUAL LEVEL SWITCHING.
	LOW VOLTAGE SWITCH; MTD 42" AFF UNO	CONNECT VIA LOW VOLTAGE BUS TO LIGHTING CONTROL SYSTEM; VERIFY CABLE REQUIREMENTS WITH VENDOR; SEE PLAN NOTES FOR CONTROL INFO.
	OCCUPANCY SENSOR WALL SWITCH, DIMMER; DUAL TECHNOLOGY	RATED FOR VOLTAGE WHERE APPLIED, 20A; MTD 42" AFF UNO
	OCCUPANCY SENSOR WALL SWITCH, SINGLE OKT, DUAL TECHNOLOGY	RATED FOR VOLTAGE WHERE APPLIED, 20A; MTD 42" AFF UNO
	OCCUPANCY SENSOR, DUAL TECHNOLOGY, WALL MTD @ 10' AFF UNO	INCORPORATE POWER PACK FOR CIRCUITRY SWITCHING, SEE WIRING DIAGRAMS
	OCCUPANCY SENSOR, DUAL TECHNOLOGY; CEILING MTD	INCORPORATE POWER PACK FOR CIRCUITRY SWITCHING, SEE WIRING DIAGRAMS
	PHOTOCELL, EXTERIOR; MOUNT ON NORTH FACE OF BLDG, FAGING NORTH	
	FAA PHOTOCELL, EXTERIOR; MOUNT ON NORTH FACE OF BLDG, FAGING NORTH	
	TOGGLE SWITCH, SINGLE POLE	RATED FOR VOLTAGE WHERE APPLIED, 20A; MTD 42" AFF UNO
	3-WAY SWITCH	RATED FOR VOLTAGE WHERE APPLIED, 20A; MTD 42" AFF UNO

**FIRE ALARM LEGEND**

SYMBOL	DESCRIPTION	MOUNTING
	AMPLIFIER	WALL
	CONTROL / RELAY MODULE	
	RELAY MODULE FOR DOOR RELEASE ON FIRE ALARM	ACCESS CONTROL EQUIPMENT
	CONTROL / RELAY MODULE FOR FIRE DOOR ACTIVATION	EQUIPMENT
	DUCT DETECTOR -- PROVIDED BY FIRE ALARM VENDOR	BY MECH CONTRACTOR
	FIELD CHARGING POWER SUPPLY	WALL
	FLOW SWITCH	BY SPRINKLER CONTRACTOR
	HEAT DETECTOR	CEILING
	HEAT DETECTOR- ELEVATOR PIT, COORDINATE LOCATION WITH SPRINKLER HEAD	WALL
	HORN/STROBE, 15 CANDELA	WALL
	LOCAL OPERATOR CONSOLE	WALL
	MONITOR MODULE FOR TAMPER SWITCH	
	MONITOR MODULE FOR MONITORING A DRY CONTACT CLOSURE DEVICE	
	PULL STATION	WALL
	REMOTE INDICATOR WITH TEST SWITCH FOR DUCT DETECTOR	CEILING / WALL
	SMOKE DETECTOR	CEILING
	SMOKE DETECTOR	WALL
	TAMPER SWITCH	BY SPRINKLER CONTRACTOR

**FIRE ALARM AV LEGEND**

SYMBOL	DESCRIPTION	MOUNTING
	SPEAKER 1/4 WATT - 8 WATT MULTI TAP SPEAKER	CEILING MTD
	SPEAKER STROBE 1/2 WATT, 15 CANDELA	CEILING MTD
	SPEAKER STROBE 1/2 WATT, 30 CANDELA	CEILING MTD
	SPEAKER STROBE 1/2 WATT, 75 CANDELA	CEILING MTD
	SPEAKER STROBE 1/4 WATT, 15 CANDELA	CEILING MTD
	SPEAKER STROBE 1 WATT, 30 CANDELA	CEILING MTD
	SPEAKER STROBE 1 WATT, 75 CANDELA	CEILING MTD
	SPEAKER STROBE 2 WATT, 75 CANDELA	CEILING MTD
	SPEAKER STROBE 2 WATT, 95 CANDELA	CEILING MTD
	SPEAKER STROBE 2 WATT, 115 CANDELA	CEILING MTD
	SPEAKER STROBE 2 WATT, 177 CANDELA	CEILING MTD
	SPEAKER STROBE 1/2 WATT, 15 CANDELA	WALL MTD
	SPEAKER STROBE 1/2 WATT, 30 CANDELA	WALL MTD
	SPEAKER STROBE 1 WATT, 30 CANDELA	WALL MTD
	SPEAKER STROBE 1 WATT, 95 CANDELA	WALL MTD
	SPEAKER STROBE 2 WATT, 75 CANDELA	WALL MTD
	SPEAKER STROBE 2 WATT, 95 CANDELA	WALL MTD
	SPEAKER STROBE 2 WATT, 115 CANDELA	WALL MTD
	SPEAKER STROBE 2 WATT, 177 CANDELA	WALL MTD
	STROBE 15 CANDELA	WALL MTD

**PA AND SECURITY LEGEND**

SYMBOL	DESCRIPTION	MOUNTING	NOTES
	DEMO PA SPEAKER	CEILING	
	CARD READER, BIOMETRIC	4" SQUARE BOX RECESSED	INSTALL 3/4" C AND CABLE TO ROOM BUILDING MANAGEMENT A111
	CARD READER, NON-BIOMETRIC	4" SQUARE BOX RECESSED	INSTALL 3/4" C AND CABLE TO ROOM BUILDING MANAGEMENT A111
	SECURITY CAMERA, 3-SENSOR	CEILING; 4" SQUARE BOX, RECESSED	STUB 3/4" C TO INDICATED LOCATION OR NEAREST ACCESSIBLE CEILING SPACE; INSTALL CAT6 CABLE TO NEAREST ILM IT SPACE
	SECURITY CAMERA, 3-SENSOR	WALL; 4" SQUARE BOX, RECESSED; COORDINATE HEIGHT W/ ARCHITECT	STUB 3/4" C TO INDICATED LOCATION OR NEAREST ACCESSIBLE CEILING SPACE; INSTALL CAT6 CABLE TO NEAREST ILM IT SPACE
	SECURITY CAMERA, 4-SENSOR	CEILING; 4" SQUARE BOX, RECESSED	STUB 3/4" C TO INDICATED LOCATION OR NEAREST ACCESSIBLE CEILING SPACE; INSTALL CAT6 CABLE TO NEAREST ILM IT SPACE
	SECURITY CAMERA, 4-SENSOR	WALL; 4" SQUARE BOX, RECESSED; COORDINATE HEIGHT W/ ARCHITECT	STUB 3/4" C TO INDICATED LOCATION OR NEAREST ACCESSIBLE CEILING SPACE; INSTALL CAT6 CABLE TO NEAREST ILM IT SPACE
	SECURITY CAMERA, FIXED FOCUS	CEILING; 4" SQUARE BOX, RECESSED	STUB 3/4" C TO INDICATED LOCATION OR NEAREST ACCESSIBLE CEILING SPACE; INSTALL CAT6 CABLE TO NEAREST ILM IT SPACE
	SECURITY CAMERA, FIXED FOCUS	WALL; 4" SQUARE BOX, RECESSED; COORDINATE HEIGHT W/ ARCHITECT	STUB 3/4" C TO INDICATED LOCATION OR NEAREST ACCESSIBLE CEILING SPACE; INSTALL CAT6 CABLE TO NEAREST ILM IT SPACE
	CARD READER FOR BHS	COORDINATE EXACT LOCATION WITH BHS VENDOR	4" SQUARE BOX RECESSED. COORDINATE MOUNTING WHERE INDICATED AT BHS MCPS. INSTALL 3/4" C AND CABLE TO ROOM BUILDING MANAGEMENT A111.
	DOOR SWITCH / CONTACT	RECESSED	1/2" FLEXIBLE METALLIC CONDUIT CONCEALED IN DOOR FRAME HEADER TO JUNCTION BOX MTD ABOVE DOOR. INSTALL 3/4" C AND CABLE TO ROOM BUILDING MANAGEMENT A111.
	DRY CONTACTS		CONVEYOR FIRE DOOR POSITION MONITORING (OPEN & CLOSED) THROUGH BHS CONTROL PANEL. 3/4" C AND CABLE (4#14#14G) BACK TO ROOM BUILDING MANAGEMENT A111.
	ELECTRIC HINGE		1/2" FLEXIBLE METALLIC CONDUIT CONCEALED IN DOOR FRAME TO JUNCTION BOX MTD ABOVE CEILING. PROVIDE PATHWAY THROUGH DOOR TO ACCOMMODATE CONNECTION TO ASSOCIATED ELECTRIC STRIKE.
	ELECTRIC STRIKE		FOR SINGLE DOOR, PROVIDE 1/2" FLEXIBLE METALLIC CONDUIT CONCEALED IN DOOR FRAME TO JUNCTION BOX MTD ABOVE CEILING. SEE NOTES AT ELECTRIC HINGE FOR DOUBLE DOOR CONFIGURATION.
	PA SPEAKER	CEILING/ RECESSED	

**DATA & TELEPHONE OUTLET LEGEND**

SYMBOL	DESCRIPTION	PROVIDED BY: CONTRACTOR
	DATA / TELEPHONE OUTLET FOR BACK LINER DISPLAY INFORMATION	WALL, LOCATED BEHIND BACK DISPLAY IN RECESSED LCD OUTLET BOX (COORDINATE SPECIFIC LOCATION AND MOUNTING HEIGHT WITH OWNER/ARCHITECT). SEE POWER PLANS FOR SHARED BOX WITH POWER OUTLET. DESIGN BASIS ARLINGTON #TVB5613 WITH COVER. ROUTE (4) 1" C TO IT A1112 INSTALL (5) CAT 6 CABLES TO IT ROOM A1112 AS FOLLOWS: (1) CAT 6 CABLE FOR AMERICAN AIRLINES (1) CAT 6 CABLE FOR DELTA AIRLINES (1) CAT 6 CABLE TO UNITED AIRLINES (1) CAT 6 CABLE TO ILM DATA RACK (1) CAT 6 CABLE FOR FUTURE
	DATA / TELEPHONE OUTLET FOR EXIT LANE	ABOVE CEILING, 4" SQUARE, DEEP BOX. COORDINATE EXACT LOCATION WITH EXIT LANE VENDOR. INSTALL (2) CAT 6 CABLES TO IT A1112 OR TO ROOM BUILDING MANAGEMENT A11
	DATA / TELEPHONE OUTLET FOR FLIGHT INFORMATION DISPLAY	WALL, LOCATED BEHIND FLIGHT INFORMATION DISPLAY IN RECESSED LCD OUTLET BOX (COORDINATE SPECIFIC LOCATION AND MOUNTING HEIGHT WITH OWNER/ARCHITECT). SEE POWER PLANS FOR SHARED BOX WITH POWER OUTLET. DESIGN BASIS ARLINGTON #TVB5613 WITH COVER. ROUTE 1" C TO IT A1112 (1) CAT 6 CABLE TO ILM DATA RACK (1) CAT 6 CABLE FOR FUTURE
	DATA / TELEPHONE OUTLET	WALL, 18" AFF UNO; 4" SQUARE, DEEP BOX; STUB 1" C TO 6" ABOVE CEILING INSTALL (2) CAT 6 CABLES TO IT A1112 OR TO ROOM BUILDING MANAGEMENT A11
	FUTURE DATA DROP	DATA DROP ABOVE CEILING FOR FUTURE ILM USE. INSTALL (1) CAT 6 CABLES TO IT A1112 OR TO ROOM BUILDING MANAGEMENT A11. PROVIDE 25' CABLE COIL ABOVE ACCESSIBLE CEILING. TERMINATE ENDS & LABEL AS "FUTURE ILM USE"
	DATA / TELEPHONE OUTLET	ABOVE CEILING, 4" SQUARE, DEEP BOX INSTALL (2) CAT 6 CABLES TO IT A1112 OR TO ROOM BUILDING MANAGEMENT A11
	TSA DATA / TELEPHONE OUTLET	WALL, 18" AFF UNO; 4" SQUARE, DEEP BOX; STUB 1" C TO 6" ABOVE CEILING OR DOWN THROUGH SLAB AS REQUIRED. INSTALL (2) CAT 6 CABLES TO TSA IT RACK IN RAMP LEVEL ROOM 125.
	TSA DATA OUTLET (A)	TSA FRONT XRAY OUTLET (A), 8" POKE-THROUGH ASSEMBLY WITH SHARED POWER OUTLETS. STUB 1" C DOWN THROUGH SLAB; EXTEND TO CONCEALED LOCATION AS REQUIRED. INSTALL (2) CAT 6 CABLES TO TSA IT RACK IN RAMP LEVEL TSA TRAINING ROOM 125. SEE TSA OUTLETS DETAIL A-503.
	TSA DATA OUTLET (B)	TSA REAR XRAY OUTLET (B), 8" POKE-THROUGH ASSEMBLY WITH SHARED POWER OUTLETS. STUB 1 1/2" C DOWN THROUGH SLAB; EXTEND TO CONCEALED LOCATION AS REQUIRED. INSTALL (6) CAT 6 CABLES TO TSA IT RACK IN RAMP LEVEL TSA TRAINING ROOM 125. STUB 1" C DOWN THROUGH SLAB, OVER, AND UP THROUGH SLAB AT TSA AVS/BSL/ETD FLOOR OUTLET (C). INSTALL (2) CAT 6 CABLES TO TSA AVS/BSL/ETD FLOOR OUTLET (C).
	TSA DATA OUTLET (C)	TSA AVS/BSL/ETD OUTLET (C), 8" POKE-THROUGH ASSEMBLY WITH SHARED POWER OUTLETS. SEE TSA OUTLETS DETAIL A-503. STUB 1 1/4" C DOWN THROUGH SLAB; EXTEND TO CONCEALED LOCATION AS REQUIRED. INSTALL (4) CAT 6 CABLES TO TSA IT RACK IN RAMP LEVEL TSA TRAINING ROOM 125. STUB 1" C DOWN THROUGH SLAB, OVER, AND UP THROUGH SLAB AT TSA REAR XRAY FLOOR OUTLET (B). INSTALL (2) CAT 6 CABLES TO TSA REAR XRAY FLOOR OUTLET (B).
	TSA DATA OUTLET (F)	TSA DURESS & CHRONOS CLOCK OUTLETS (F). ONE POTS PHONE LINE OUTLET (DURESS) & TWO CHRONOS CLOCK DATA OUTLETS; MTD 18" AFF UNO. STUB 1 1/4" C DOWN THROUGH SLAB; EXTEND TO CONCEALED LOCATION AS REQUIRED. INSTALL (3) CAT 6 CABLES TO TSA IT RACK IN RAMP LEVEL TSA TRAINING ROOM 125. SEE TSA OUTLETS DETAIL A-503.
	TSA DATA OUTLET (G)	TSA TDC/CAT OUTLET (G), MTD IN 8" POKE-THRU ASSEMBLY; SEE POWER PLANS FOR SHARED ASSEMBLY. INSTALL 1" C FROM POKE-THRU TO CONCEALED SPACE AS REQUIRED. INSTALL (2) CAT6 CABLES TO TSA IT RACK IN RAMP LEVEL TSA TRAINING ROOM 125. SEE TSA OUTLETS DETAIL A-503.
	TSA DATA OUTLET (P)	TSA STSO OUTLET (P); MTD IN 8" POKE-THRU ASSEMBLY; SEE POWER PLANS FOR SHARED ASSEMBLY. INSTALL 1" C FROM POKE-THRU TO CONCEALED SPACE AS REQUIRED. INSTALL (2) CAT6 CABLES TO TSA IT RACK IN RAMP LEVEL TSA TRAINING ROOM 125. SEE TSA OUTLETS DETAIL A-503.
	DATA DROP FOR ACCESS POINT	PROVIDE 20' COIL AT TERMINATED DATA DROP LOCATION FOR CONNECTION TO FUTURE OWNER PROVIDED EQUIPMENT. INSTALL (1) CAT 6A CABLE TO IT A1112, ILM RACK
	DATA / TELEPHONE OUTLET	FLOOR AT COUNTER; MTD IN POKE-THRU ASSEMBLY; INTEGRAL TO POWER FLOOR BOX WITH DIVIDER SEPARATING POWER & COMMUNICATIONS COORDINATE EXACT LOCATION WITH ARCHITECT ROUTE (1) 2" C UNDERGROUND TO IT A1112 INSTALL (5) CAT 6 CABLES TO IT A1112 (1) CAT 6 CABLE FOR AMERICAN AIRLINES (1) CAT 6 CABLE FOR DELTA AIRLINES (1) CAT 6 CABLE TO UNITED AIRLINES (1) CAT 6 CABLE FOR FUTURE (1) CAT 6 CABLE TO PA SYSTEM
	DATA / TELEPHONE OUTLET	FLOOR, INTEGRAL TO POWER FLOOR BOX WITH DIVIDER SEPARATING POWER & COMMUNICATIONS ROUTE (2) 1" C UNDERGROUND, TURN UP INTO WALL CAVITY, & STUB UP TO 6" ABOVE CEILING INSTALL (2) CAT 6 CABLES TO ROOM BUILDING MANAGEMENT A11.
	TELEPHONE OUTLET FOR ELEVATOR COMMUNICATION	COORDINATE INSTALLATION LOCATION WITH ELEVATOR VENDOR/INSTALLER




**TERMINAL IMPROVEMENTS CONTRACT 3**

Wilmington International Airport  
1740 Airport Boulevard, Suite 12  
Wilmington, NC 28405

**CHEATHAM & ASSOCIATES, P.A.**  
CONSULTING ENGINEERS  
3412 ENTERPRISE DRIVE  
WILMINGTON, NORTH CAROLINA 28405  
PHONE: (910) 452-4210  
FAX: (910) 452-4211  
OFFICE@CHEATHAMPA.COM  
NC LICENSE# C-1673

JOB # 19005

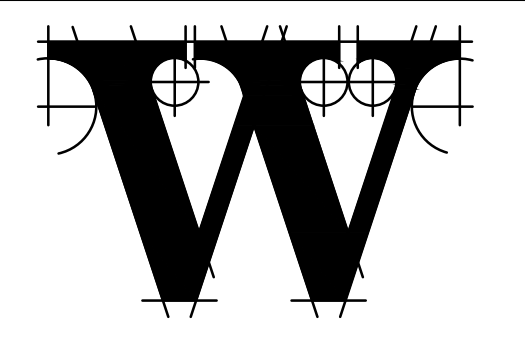

PO Box 5510 Charlotte, NC 28289  
704-331-9747 • www.twgarchitects.com

PROJECT MANAGER & CIVIL ENGINEER  
**TALBERT & BRIGHT**  
CONSULTING ARCHITECT  
LS3P

STRUCTURAL ENGINEER  
**STEWART**

FPP/PM/E ENGINEER  
**CHEATHAM & ASSOC.**

BAGGAGE HANDLING CONSULTANTS  
**BNP**

AIRCRAFT SUPPORT SYSTEMS  
**DK CONSULTANTS**

SPECIALTY LIGHTING CONSULTANT  
**HARTRANFT**

SIGNAGE & WAYFINDING  
**TAKEFORM**

COPYRIGHT © 2019  
THE WILSON GROUP ARCHITECTS  
ALL RIGHTS RESERVED

PRINTED OR ELECTRON

FOR CONTRACT 3 SCHEDULE 1 AND SCHEDULE 2 WORK PHASES:  
 • SEE ARCHITECTURAL PLANS A-01\* SERIES FOR ADDITIONAL AND DETAILED PHASING INFORMATION.  
 • SEE BAGGAGE HANDLING SYSTEM PLANS B-\* SERIES FOR ADDITIONAL AND DETAILED PHASING INFORMATION.  
 • COORDINATE ACTUAL PHASED WORK REQUIREMENTS WITH THE GENERAL CONTRACTOR'S SCHEDULE.





**TERMINAL IMPROVEMENTS CONTRACT 3**

Wilmington International Airport  
 1740 Airport Boulevard, Suite 12  
 Wilmington, NC 28405

**CHEATHAM & ASSOCIATES, P.A.**  
 CONSULTING ENGINEERS  
 3412 ENTERPRISE DRIVE  
 WILMINGTON, NORTH CAROLINA 28405  
 PHONE: (919) 452-4210  
 FAX: (919) 452-4211  
 OFFICE@CHEATHAM.PA.COM  
 NC LICENSE# C-1073

JOB # 19005

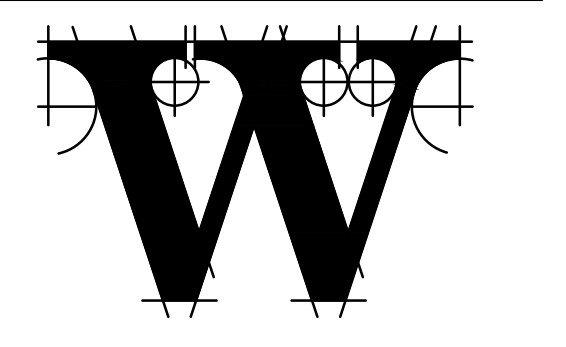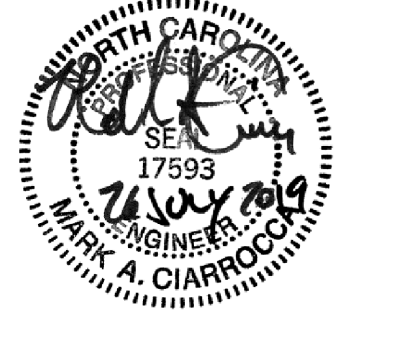

**THE WILSON GROUP**  
 ARCHITECTS  
 PO Box 5510 Charlotte, NC 28299  
 704-331-9747 • www.twgarchitects.com

PROJECT MANAGER & CIVIL ENGINEER  
**TALBERT & BRIGHT**  
 CONSULTING ARCHITECT  
 LS3P

STRUCTURAL ENGINEER  
**STEWART**

FPP/PM ENGINEER  
**CHEATHAM & ASSOC.**

BAGGAGE HANDLING CONSULTANTS  
**BNP**

AIRCRAFT SUPPORT SYSTEMS  
**DK CONSULTANTS**

SPECIALTY LIGHTING CONSULTANT  
**HARTRANFT**

SIGNAGE & WAYFINDING  
**TAKEFORM**



COPYRIGHT © 2019  
 THE WILSON GROUP ARCHITECTS  
 ALL RIGHTS RESERVED  
 PRINTED OR ELECTRONIC DRAWINGS AND DOCUMENTATION MAY NOT BE REPRODUCED IN ANY FORM WITHOUT WRITTEN PERMISSION FROM THE WILSON GROUP ARCHITECTS

REVISIONS  
 AD-03 07/26/2019

DATE 06/28/19  
 PROJECT NUMBER 9202-000  
 SHEET TITLE

**SCHEDULE 1 - ELECTRICAL SITE PLAN**

SHEET NUMBER  
**E1-109**

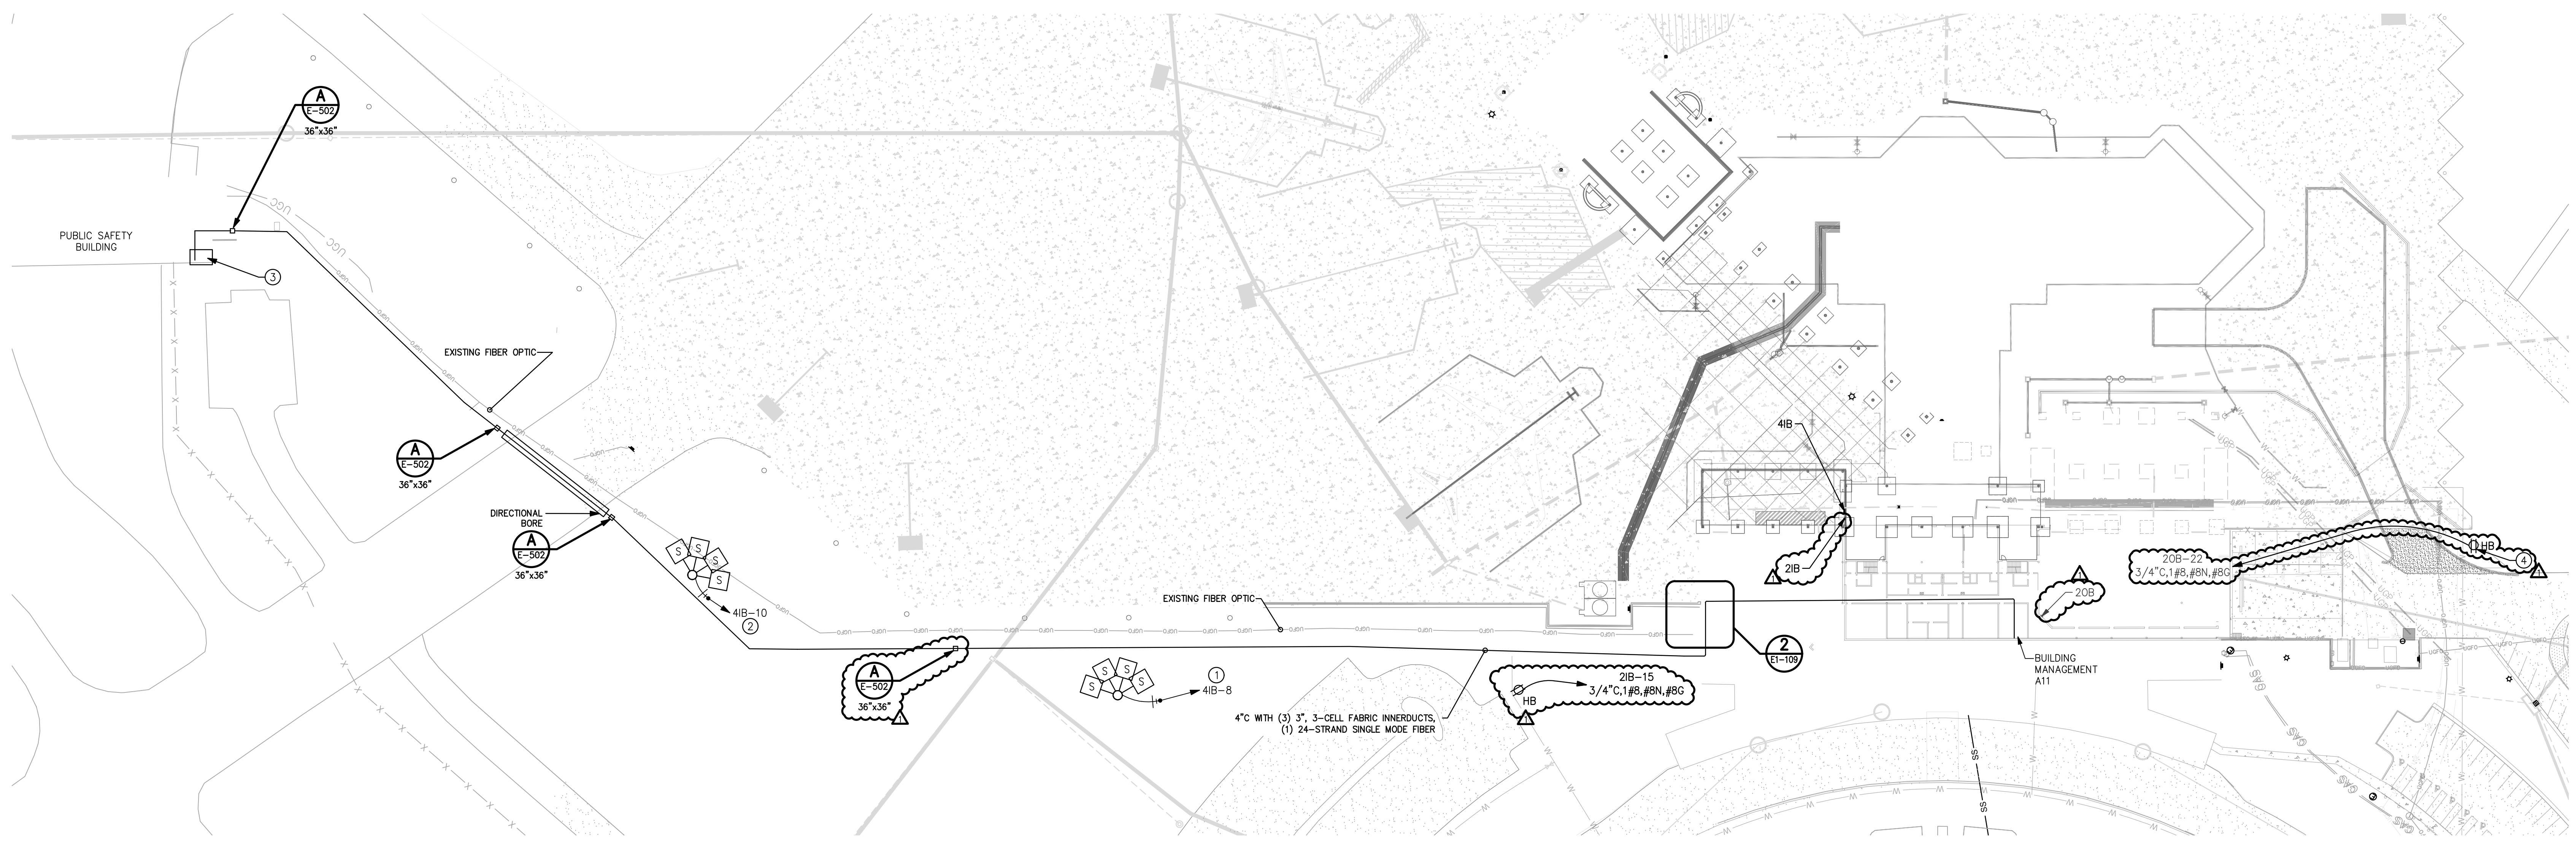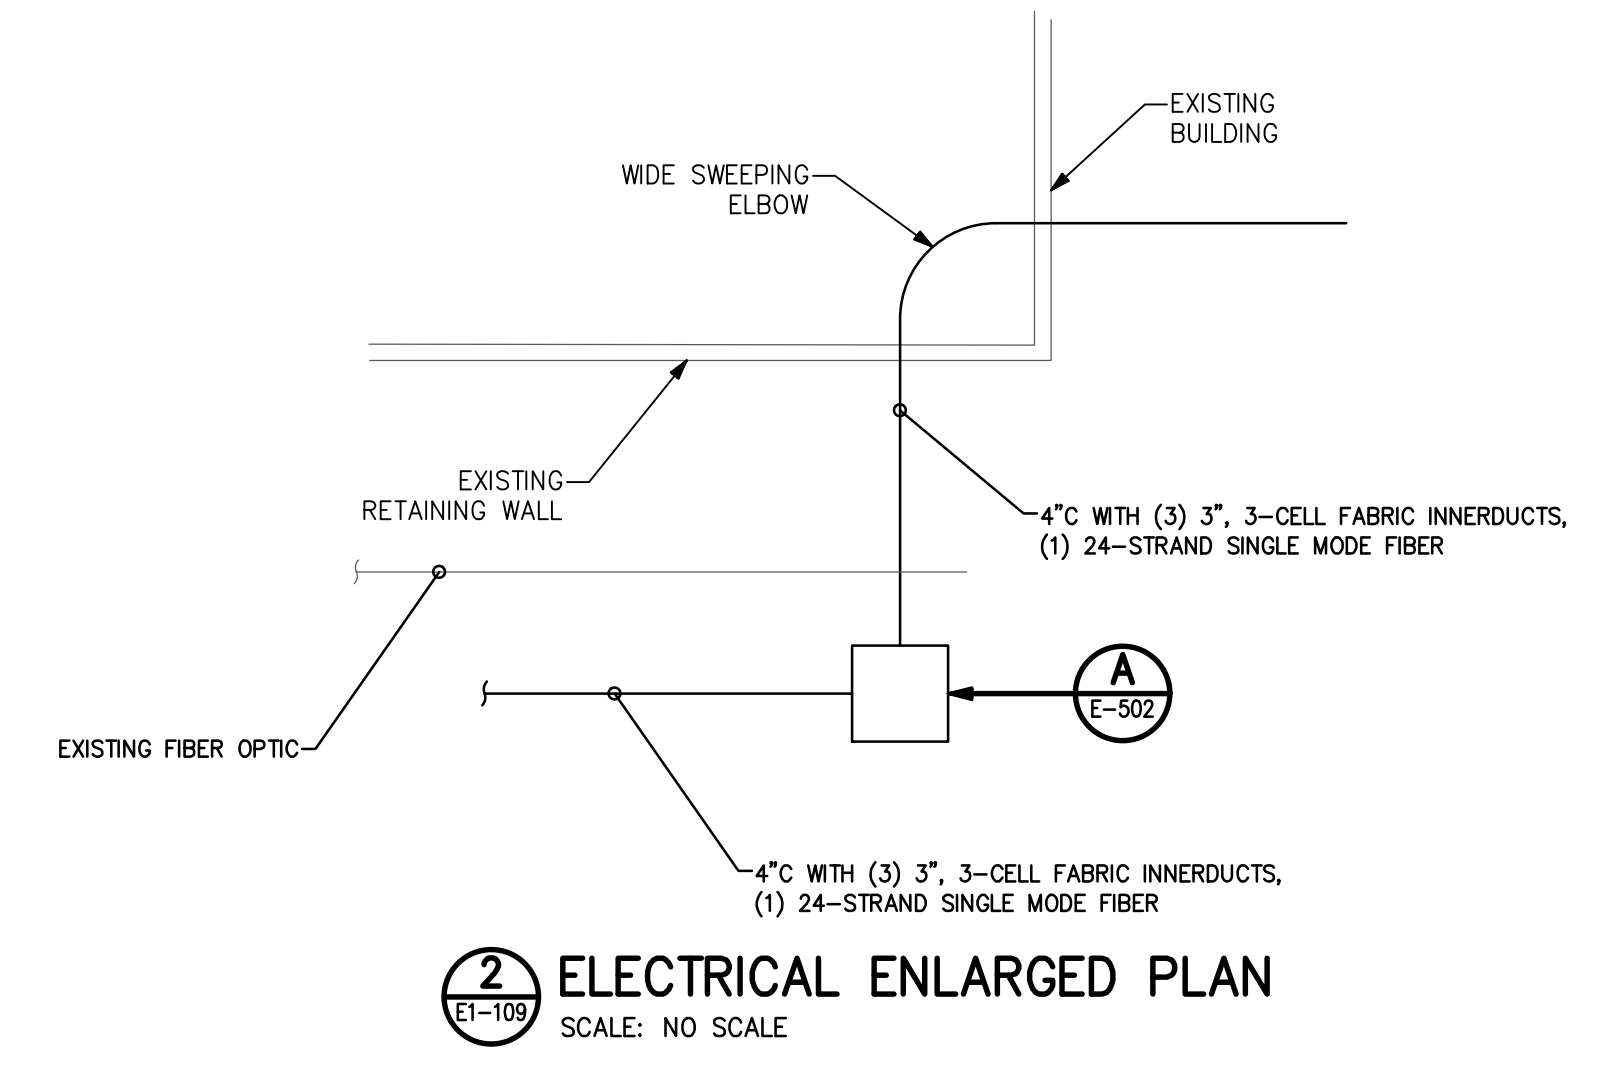

**1 ELECTRICAL SITE PLAN**  
 SCALE: 1" = 50'

GRAPHIC SCALE: 1" = 50'  
 0 12 25 50 100  
 TRUE NORTH

- KEYED NOTES:**
- LIGHTING CIRCUIT TO BE CONTROLLED THROUGH EXISTING GE LIGHTING CONTROL PANEL (CATALOG #RC0V48SHL) LOCATED IN ELECTRICAL ROOM AS. SEE E2-125 FOR PANEL LOCATION. CONTRACTOR TO PROVIDE NEW RELAY. PROVIDE #10,#10N,#10G FOR OBSTRUCTION LIGHTS. OBSTRUCTION LIGHTS TO BE CIRCUITED FROM 2IB-14 AND SWITCHED THROUGH FAA PHOTOCELL. SEE E1-124 FOR LOCATION OF FAA PHOTOCELL.
  - LIGHTING CIRCUIT TO BE CONTROLLED THROUGH EXISTING GE LIGHTING CONTROL PANEL (CATALOG #RC0V48SHL) LOCATED IN ELECTRICAL ROOM AS. SEE E2-125 FOR PANEL LOCATION. CONTRACTOR TO PROVIDE NEW RELAY. PROVIDE #10,#10N,#10G FOR OBSTRUCTION LIGHTS. OBSTRUCTION LIGHTS TO BE CIRCUITED FROM 2IB-16 AND SWITCHED THROUGH FAA PHOTOCELL. SEE E1-124 FOR LOCATION OF FAA PHOTOCELL.
  - 4" C WITH (3) 3", 3-CELL FABRIC INNERDUCTS, (1) 24-STRAND SINGLE MODE FIBER UP TO SECOND FLOOR EQUIPMENT RACK.
  - EXISTING SIEMENS PANELBOARD 20B, P1 TYPE. USE EXISTING (1) 20A/1P CIRCUIT BREAKER IN POSITION 22.




**FOR CONTRACT 3 SCHEDULE 1 AND SCHEDULE 2 WORK PHASES:**

- SEE ARCHITECTURAL PLANS A-01\* SERIES FOR ADDITIONAL AND DETAILED PHASING INFORMATION.
- SEE BAGGAGE HANDLING SYSTEM PLANS B-\* SERIES FOR ADDITIONAL AND DETAILED PHASING INFORMATION.
- COORDINATE ACTUAL PHASED WORK REQUIREMENTS WITH THE GENERAL CONTRACTOR'S SCHEDULE.

- KEYED NOTES:**
- TEMPORARY GENERATOR CIRCUITRY TO FEED ATS-2. CONDUITS SHALL BE SURFACE MOUNTED TO RAMP LEVEL CEILING.  
(3) 3" PVC, 3#350KCMIL, #350KCMIL, #3/0G  
(1) 3/4" PVC, 2#12, #12G (START/STOP)
  - REUSE EXISTING CIRCUIT BREAKERS IN PANEL ELP2 FOR BLOCK HEATER AND BATTERY CHARGER CIRCUITS. CONDUITS SHALL BE SURFACE MOUNTED TO RAMP LEVEL CEILING.  
3/4" PVC, 2#12, #12G (BLOCK HEATER) (ELP2-8,10)  
3/4" PVC, #12, #12N, #12G (BATTERY CHARGER) (ELP2-3)
  - TEMPORARY GENERATOR CIRCUITRY TO FEED ATS-1. CONDUITS SHALL BE SURFACE MOUNTED TO RAMP LEVEL CEILING.  
(1) 1-1/4" PVC, 3#2, #2 N, #8G  
(1) 3/4" PVC, 2#12, #12G (START/STOP)
  - PROVIDE (1) 3P/20A CIRCUIT BREAKER (SQ-D TYPE KAB) FOR WATER HEATER SHOWN ON SHEET #E1-141. EXISTING PANEL IS MANUFACTURED BY SQ-D (I-LINE TYPE HCW).

NOTE: SEE SHEET #E-602 FOR EQUIPMENT FEEDER SCHEDULES.

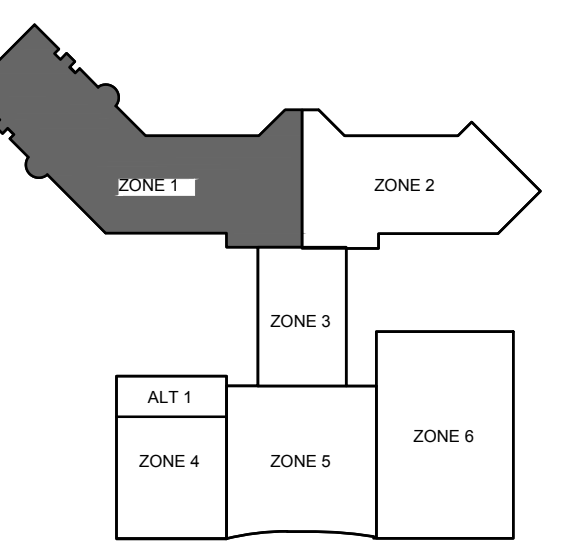

**KEY PLAN**

COPYRIGHT © 2019  
 THE WILSON GROUP ARCHITECTS  
 ALL RIGHTS RESERVED

PRINTED OR ELECTRONIC DRAWINGS AND DOCUMENTATION MAY NOT BE REPRODUCED IN ANY FORM WITHOUT WRITTEN PERMISSION FROM THE WILSON GROUP ARCHITECTS


**REVISIONS**

AD-03 07/26/2019

DATE 06/28/19  
 PROJECT NUMBER 9202-000  
 SHEET TITLE

**SCHEDULE 1 - ELECTRICAL RAMP LEVEL POWER PLAN ZONE 1**  
 SHEET NUMBER

**E1-111**


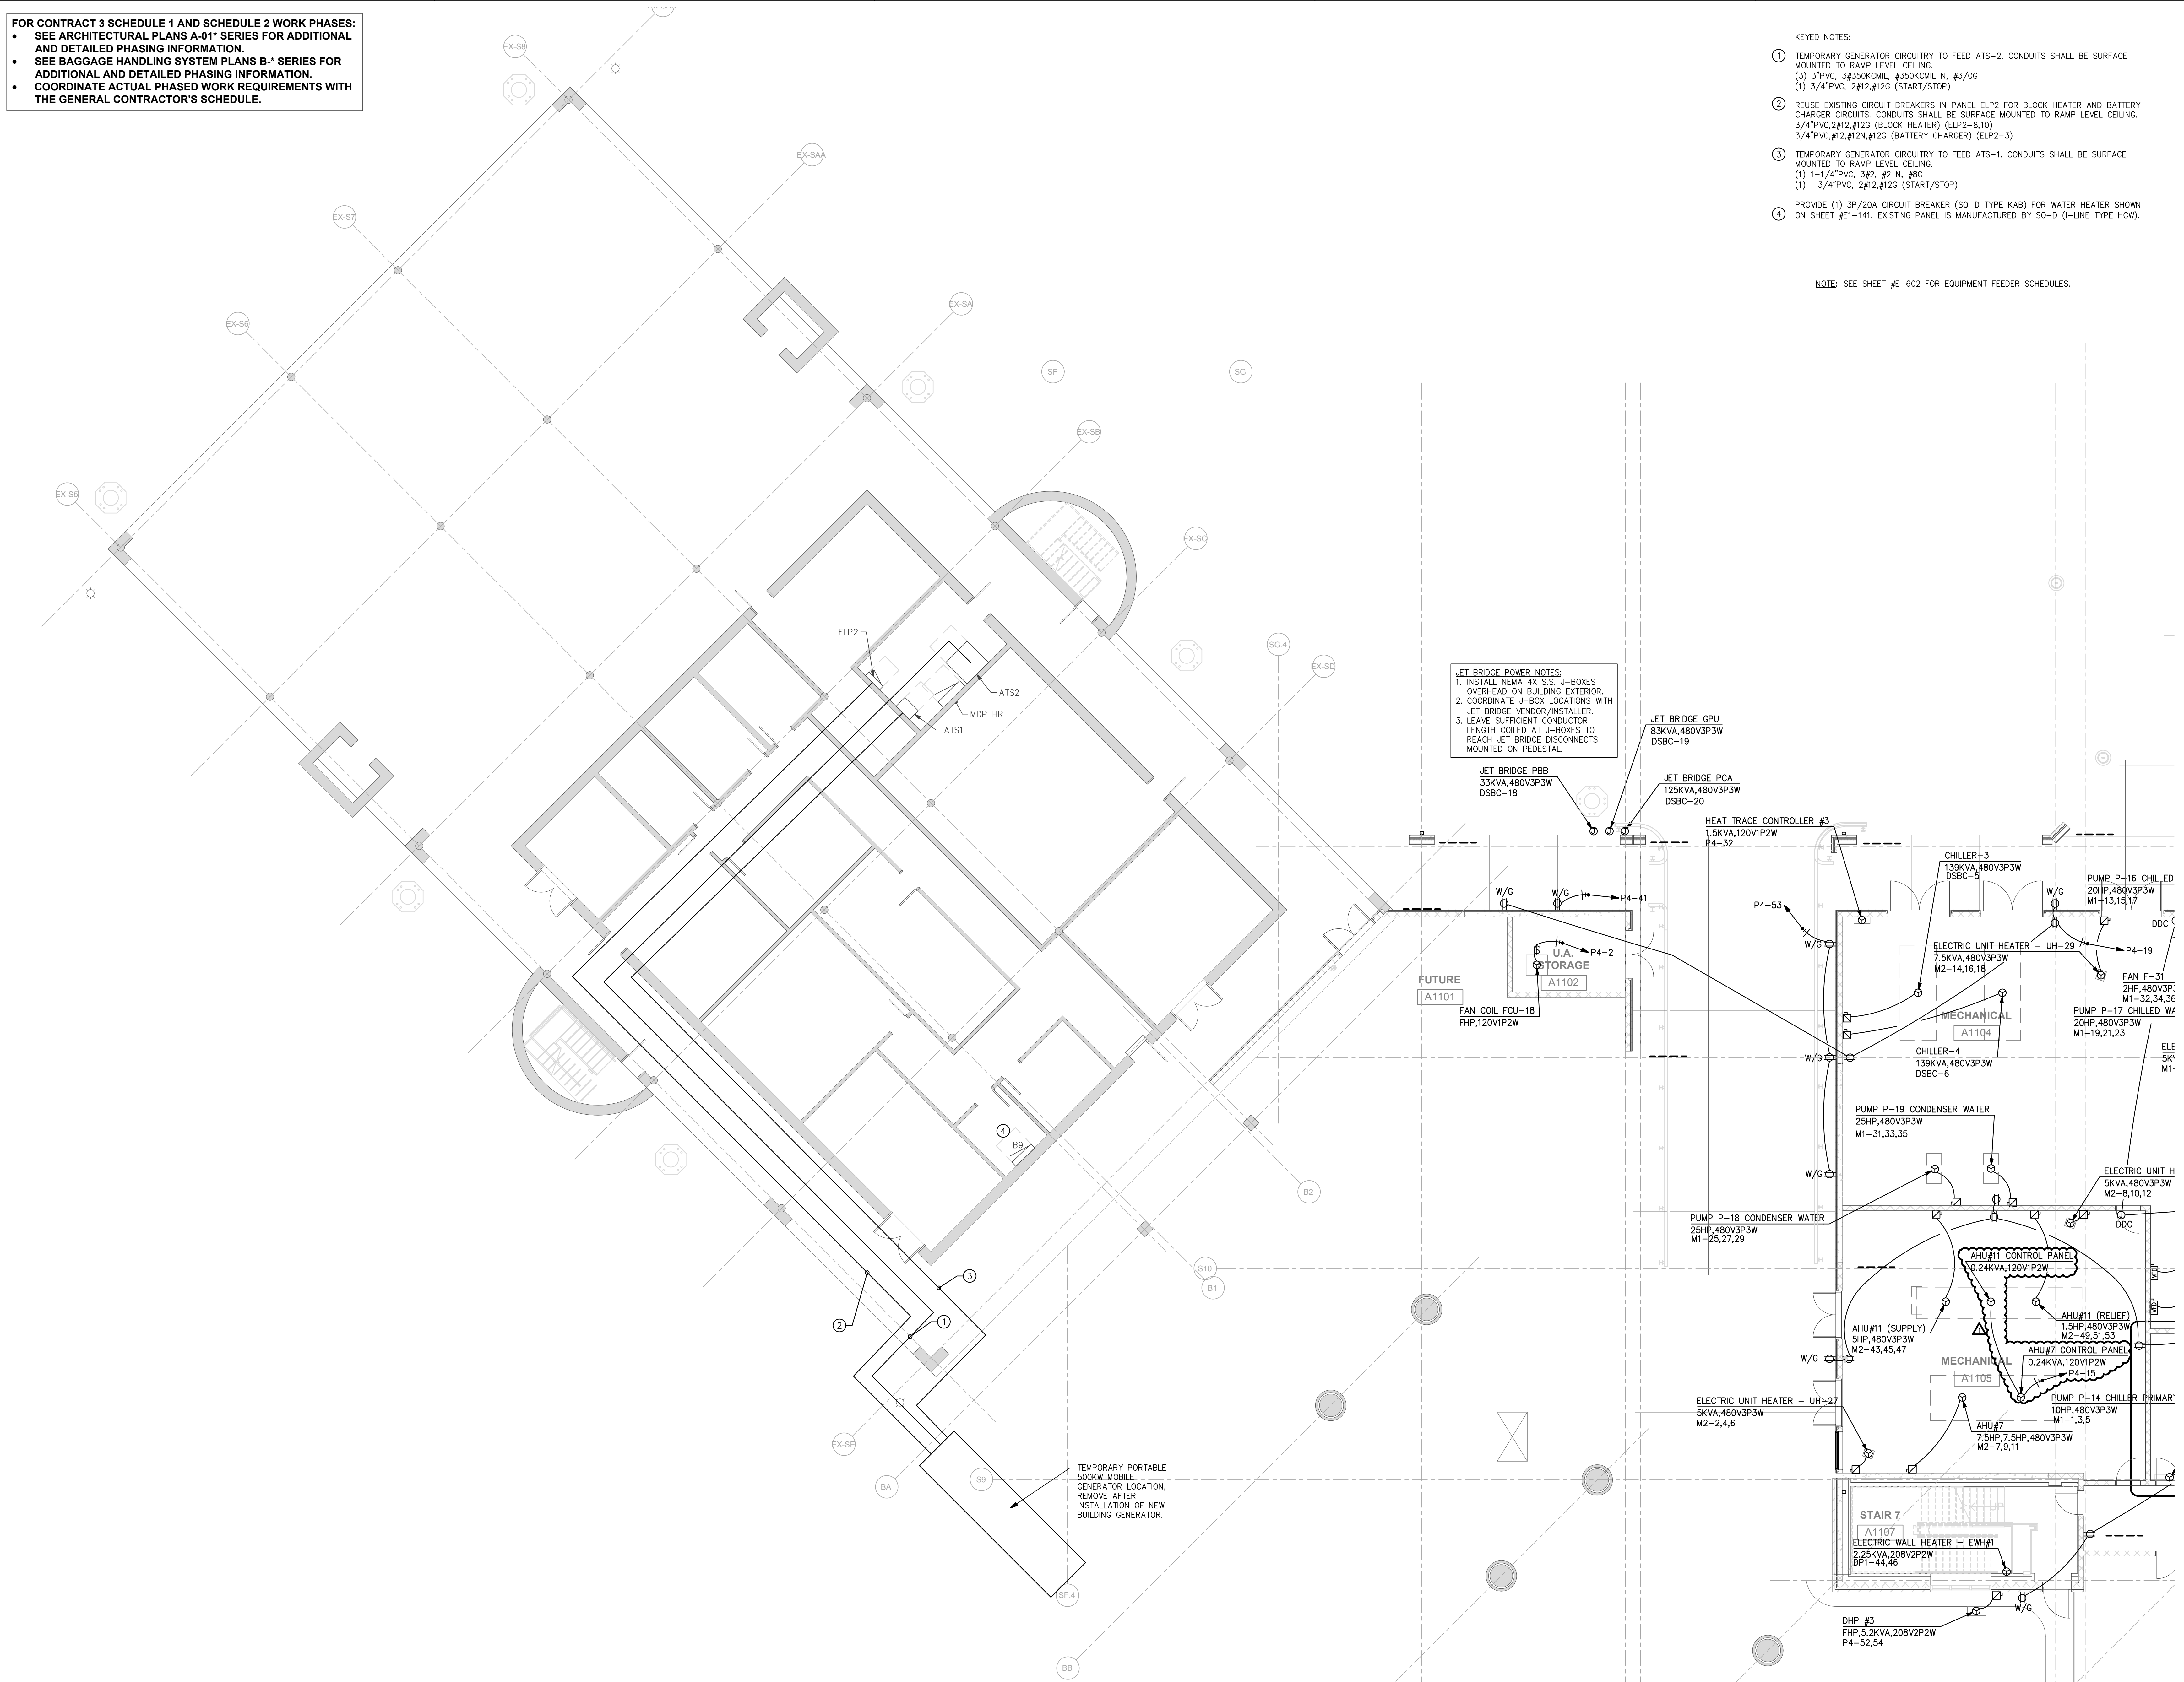


**JET BRIDGE POWER NOTES:**

- INSTALL NEMA 4X S.S. J-BOXES OVERHEAD ON BUILDING EXTERIOR.
- COORDINATE J-BOX LOCATIONS WITH JET BRIDGE VENDOR/INSTALLER.
- LEAVE SUFFICIENT CONDUCTOR LENGTH COILED AT J-BOXES TO REACH JET BRIDGE DISCONNECTS MOUNTED ON PEDESTAL.

TEMPORARY PORTABLE 500KW MOBILE GENERATOR LOCATION. REMOVE AFTER INSTALLATION OF NEW BUILDING GENERATOR.

**SCHEDULE 1 - ELECTRICAL RAMP LEVEL - POWER PLAN - ZONE 1**  
 SCALE: 1/8" = 1'-0"

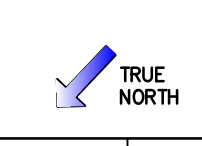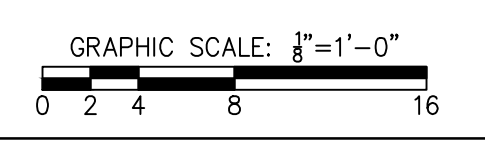

**FOR CONTRACT 3 SCHEDULE 1 AND SCHEDULE 2 WORK PHASES:**

- SEE ARCHITECTURAL PLANS A-01\* SERIES FOR ADDITIONAL AND DETAILED PHASING INFORMATION.
- SEE BAGGAGE HANDLING SYSTEM PLANS B-\* SERIES FOR ADDITIONAL AND DETAILED PHASING INFORMATION.
- COORDINATE ACTUAL PHASED WORK REQUIREMENTS WITH THE GENERAL CONTRACTOR'S SCHEDULE.




**TERMINAL IMPROVEMENTS CONTRACT 3**

Wilmington International Airport  
1740 Airport Boulevard, Suite 12  
Wilmington, NC 28405

**CHEATHAM & ASSOCIATES, P.A.**  
CONSULTING ENGINEERS  
3412 ENTERPRISE DRIVE  
WILMINGTON, NORTH CAROLINA 28405  
PHONE: (910) 452-4210  
FAX: (910) 452-4211  
OFFICE@CHEATHAMPA.COM  
NC LICENSE# C-1073

JOB # 19005

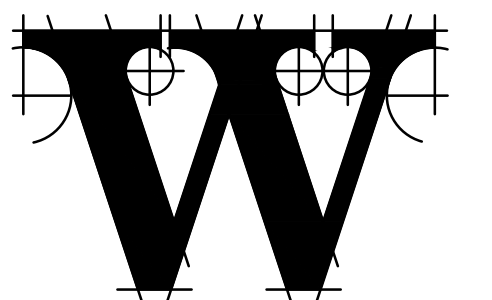

**THE WILSON GROUP**  
- ARCHITECTS -

PO Box 5510 Charlotte, NC 28299  
704-331-9747 • www.twgarchitects.com

PROJECT MANAGER & CIVIL ENGINEER  
**TALBERT & BRIGHT**

CONSULTING ARCHITECT  
**LS3P**

STRUCTURAL ENGINEER  
**STEWART**


FPP/PM/E ENGINEER  
**CHEATHAM & ASSOC.**

BAGGAGE HANDLING CONSULTANTS  
**BNP**

AIRCRAFT SUPPORT SYSTEMS  
**DK CONSULTANTS**

SPECIALTY LIGHTING CONSULTANT  
**HARTRANFT**

SIGNAGE & WAYFINDING  
**TAKEFORM**

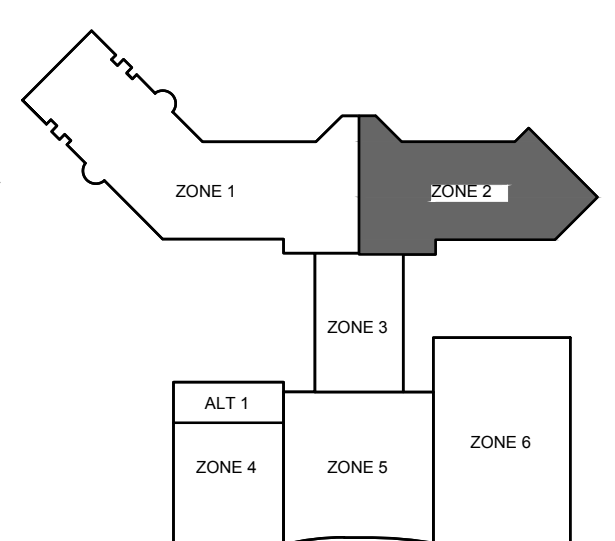

**KEY PLAN**

COPYRIGHT © 2019  
THE WILSON GROUP ARCHITECTS  
ALL RIGHTS RESERVED

PRINTED OR ELECTRONIC DRAWINGS AND DOCUMENTATION MAY NOT BE REPRODUCED IN ANY FORM WITHOUT WRITTEN PERMISSION FROM THE WILSON GROUP ARCHITECTS


**REVISIONS**

AD-03 07/26/2019

DATE 06/28/19  
PROJECT NUMBER 9202-000  
SHEET TITLE

**SCHEDULE 1 - ELECTRICAL RAMP LEVEL POWER PLAN ZONE 2**  
SHEET NUMBER

**E1-112**

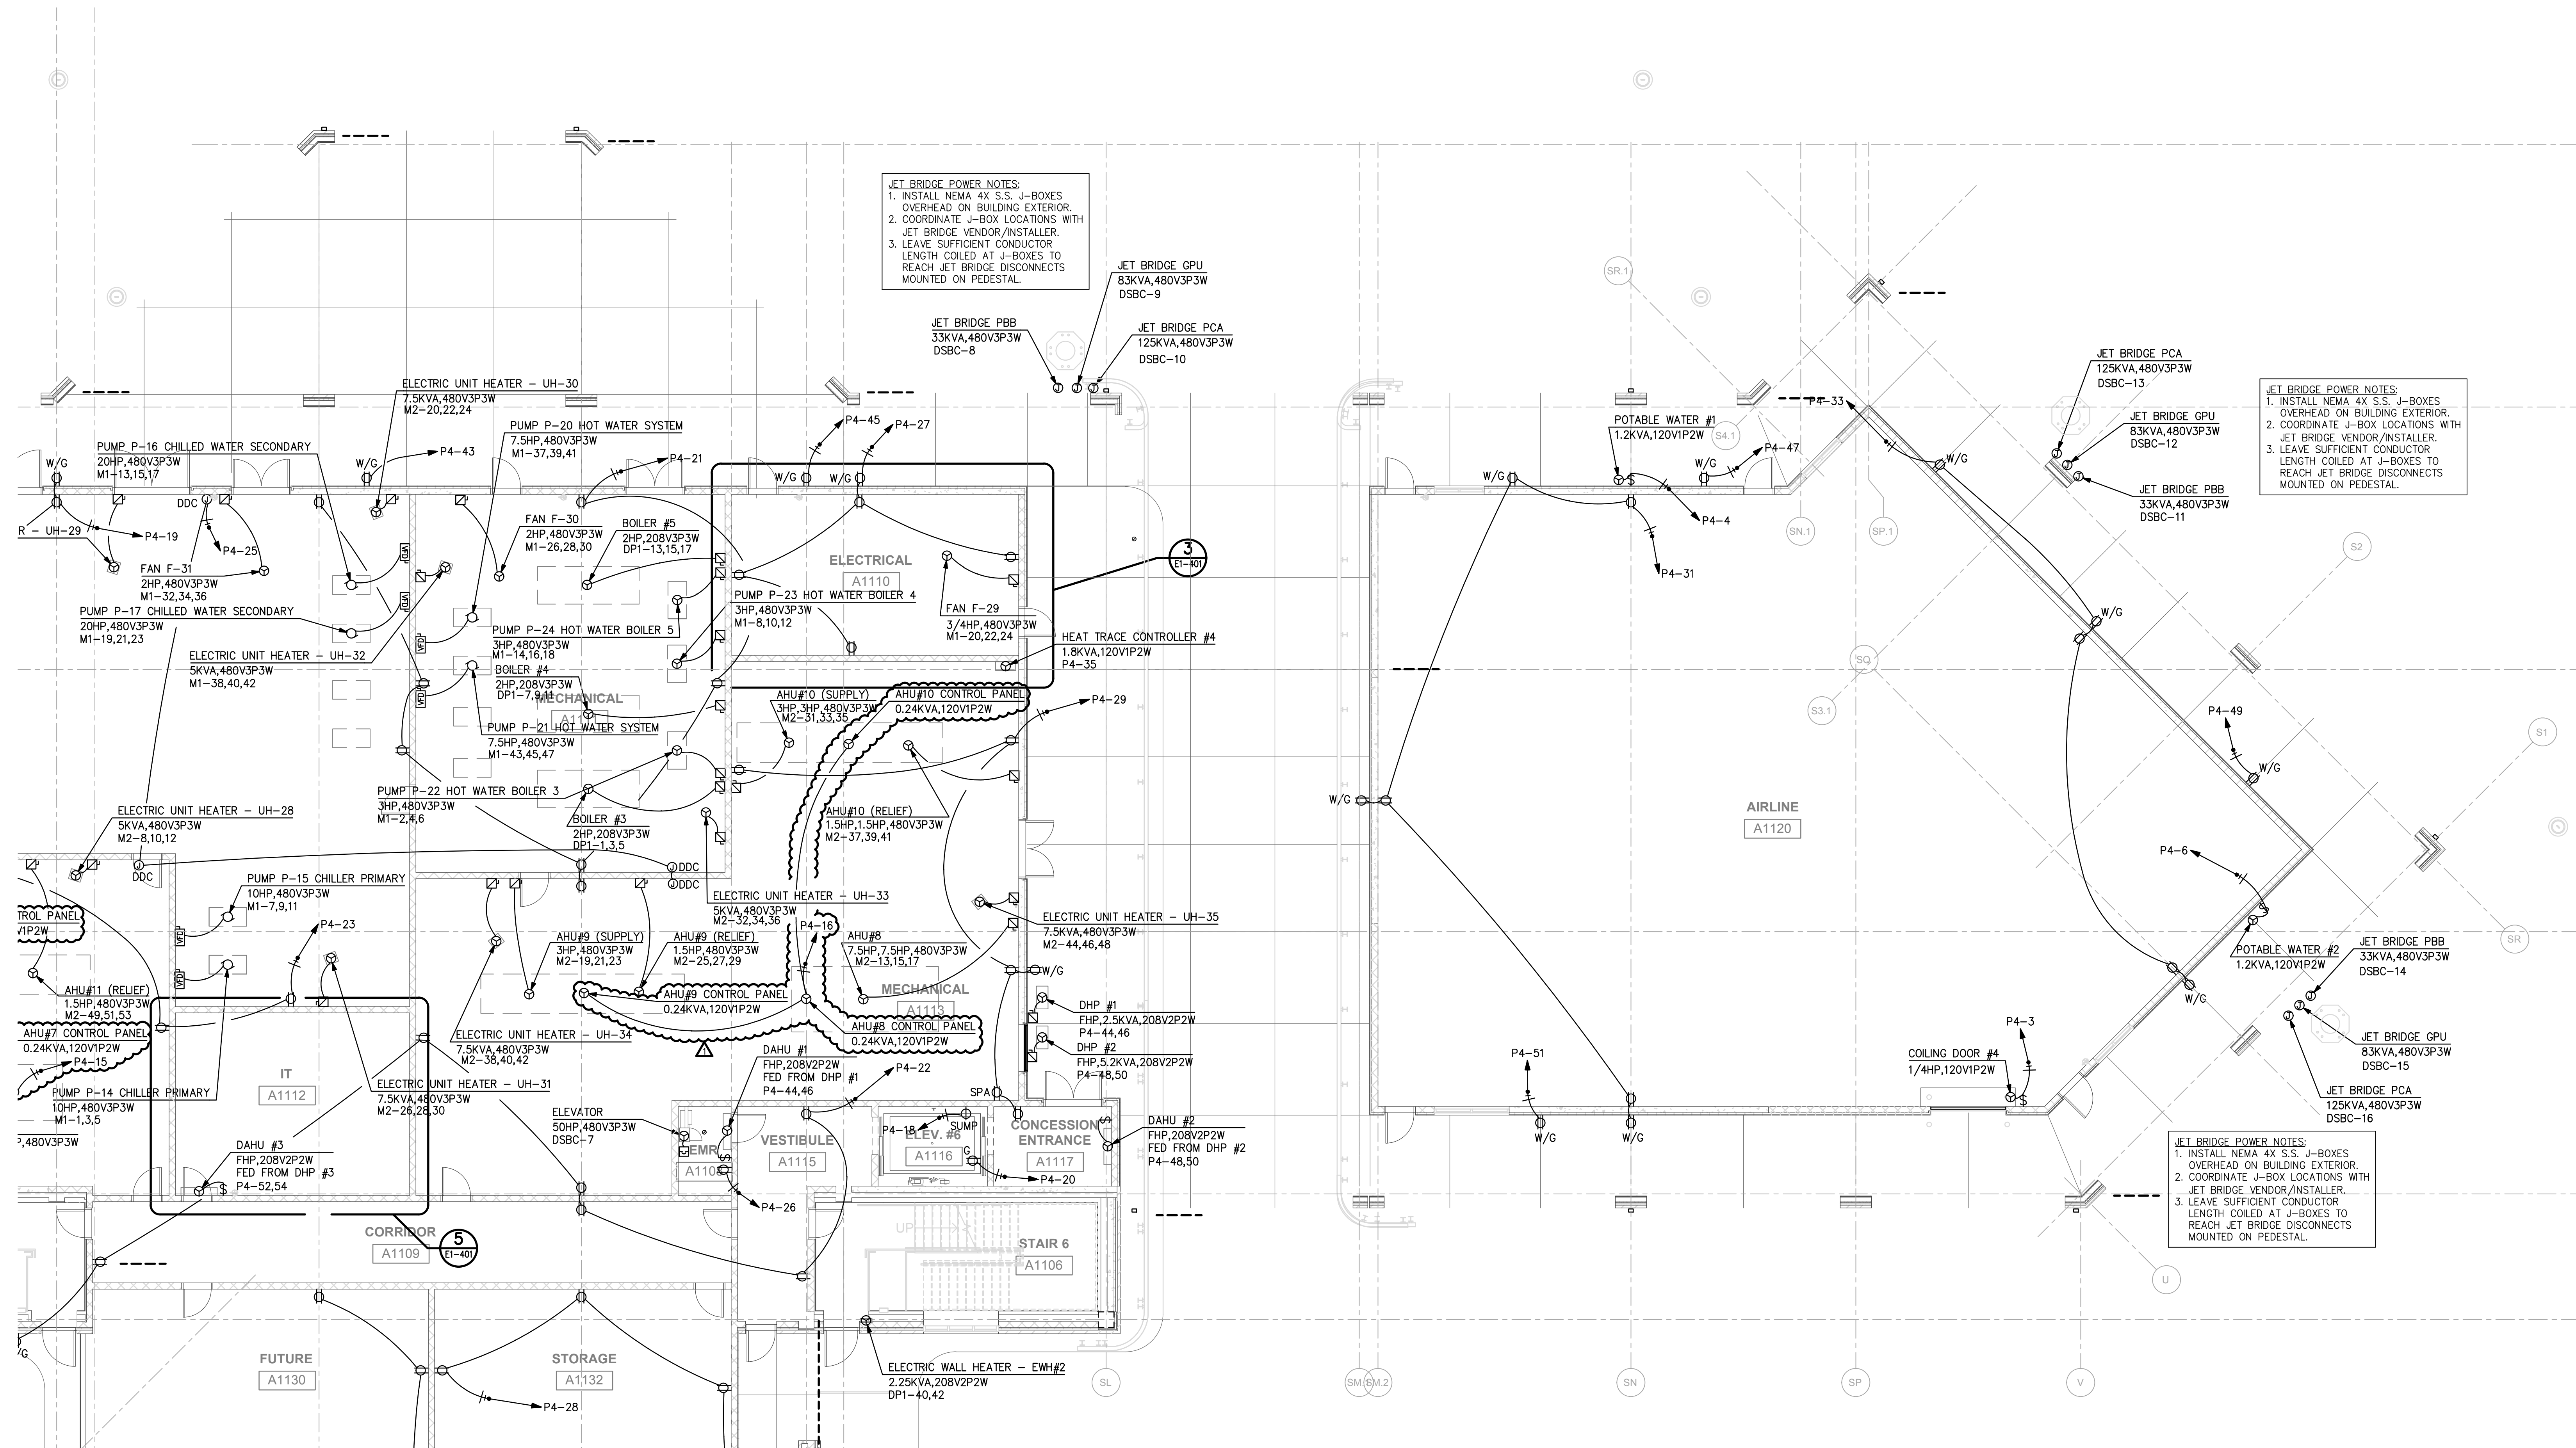


**JET BRIDGE POWER NOTES:**  
1. INSTALL NEMA 4X S.S. J-BOXES OVERHEAD ON BUILDING EXTERIOR.  
2. COORDINATE J-BOX LOCATIONS WITH JET BRIDGE VENDOR/INSTALLER.  
3. LEAVE SUFFICIENT CONDUCTOR LENGTH COILED AT J-BOXES TO REACH JET BRIDGE DISCONNECTS MOUNTED ON PEDESTAL.

**SCHEDULE 1 - ELECTRICAL RAMP LEVEL - POWER PLAN - ZONE 2**  
SCALE: 1/8" = 1'-0"

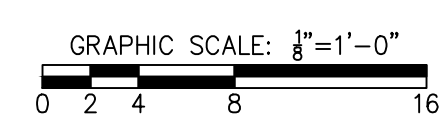

**FOR CONTRACT 3 SCHEDULE 1 AND SCHEDULE 2 WORK PHASES:**



- SEE ARCHITECTURAL PLANS A-01\* SERIES FOR ADDITIONAL AND DETAILED PHASING INFORMATION.
- SEE BAGGAGE HANDLING SYSTEM PLANS B-\* SERIES FOR ADDITIONAL AND DETAILED PHASING INFORMATION.
- COORDINATE ACTUAL PHASED WORK REQUIREMENTS WITH THE GENERAL CONTRACTOR'S SCHEDULE.

- KEYED NOTES:**
- 1 AMERICAN AIRLINES FIBER OPTIC CABLE IN CONDUIT FROM COMM. 180 LOCATED ON TICKET LEVEL TO NEW DATA ROOM LOCATED ON RAMP LEVEL E1-132.
  - 2 DELTA AIRLINES FIBER OPTIC CABLE IN CONDUIT FROM TEL/COMM. 188 LOCATED ON TICKET LEVEL TO NEW DATA ROOM LOCATED ON RAMP LEVEL E1-132.
  - 3 UNITED AIRLINES FIBER OPTIC CABLE IN CONDUIT FROM STORAGE/IT 196 LOCATED ON TICKET LEVEL TO NEW DATA ROOM LOCATED ON RAMP LEVEL E1-132.
  - 4 ILM FIBER OPTIC CABLE IN CONDUIT FROM EXISTING IT EQUIPMENT IN RAMP LEVEL BUILDING MANAGEMENT ROOM TO NEW DATA ROOM LOCATED ON RAMP LEVEL E1-132.
  - 5 AMERICAN AIRLINES FIBER OPTIC CABLE IN CONDUIT FROM NEW DATA ROOM LOCATED TO EXISTING IT RACK LOCATED ON E1-131.
  - 6 DELTA AIRLINES FIBER OPTIC CABLE IN CONDUIT FROM NEW DATA ROOM TO EXISTING IT RACK LOCATED ON E1-131.
  - 7 UNITED AIRLINES FIBER OPTIC CABLE IN CONDUIT FROM NEW DATA ROOM TO EXISTING IT RACK LOCATED ON E1-131.
  - 8 ILM CAMERA FIBER OPTIC CABLE IN CONDUIT AND (2) 100-PAIR COPPER FROM NEW DATA ROOM TO EXISTING IT RACK LOCATED ON E1-131.
  - 9 INTERFACE ACCESS CONTROL SYSTEM WITH ELEVATOR DOOR CONTROL.

**ILM**  
**TERMINAL IMPROVEMENTS CONTRACT 3**  
 Wilmington International Airport  
 1740 Airport Boulevard, Suite 12  
 Wilmington, NC 28405

**CHEATHAM & ASSOCIATES, P.A.**  
 CONSULTING ENGINEERS  
 3412 ENTERPRISE DRIVE  
 WILMINGTON, NORTH CAROLINA 28405  
 PHONE: (919) 452-4210  
 FAX: (919) 452-4211  
 OFFICE@CHEATHAMPA.COM  
 NC LICENSE# C-1673

**JOB # 19005**

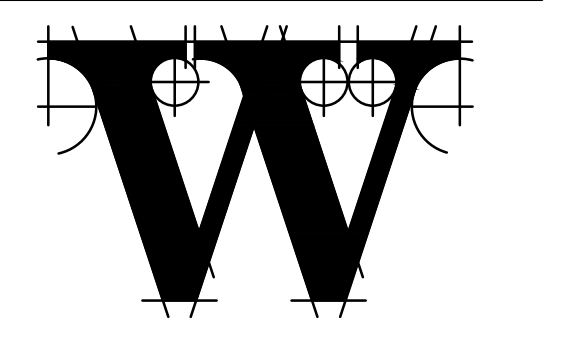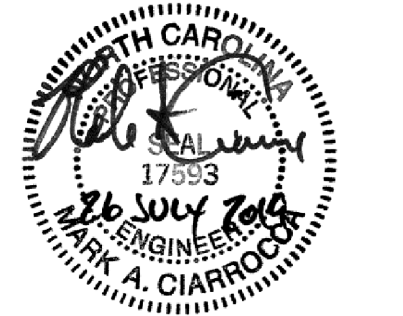

**THE WILSON GROUP**  
 - ARCHITECTS -  
 PO Box 5510 Charlotte, NC 28299  
 704-331-9747 • www.twgarchitects.com

PROJECT MANAGER & CIVIL ENGINEER  
**TALBERT & BRIGHT**  
 CONSULTING ARCHITECT  
 LS3P

STRUCTURAL ENGINEER  
**STEWART**


FP/PM/E ENGINEER  
**CHEATHAM & ASSOC.**

BAGGAGE HANDLING CONSULTANTS  
**BNP**

AIRCRAFT SUPPORT SYSTEMS  
**DK CONSULTANTS**

SPECIALTY LIGHTING CONSULTANT  
**HARTRANFT**

SIGNAGE & WAYFINDING  
**TAKEFORM**

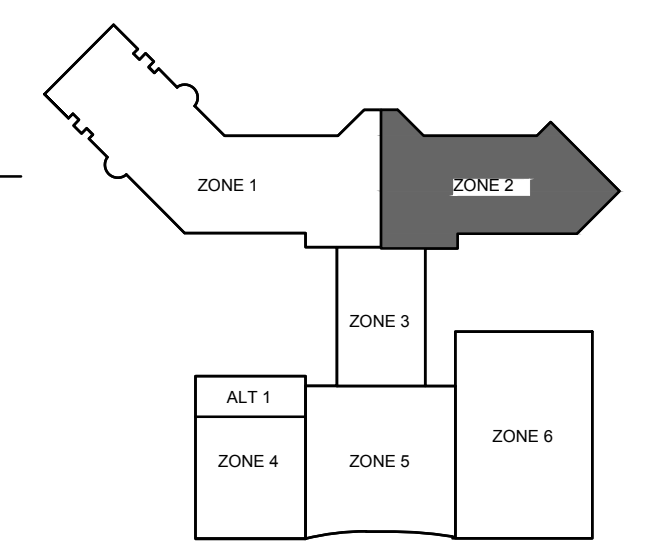

**KEY PLAN**  
 COPYRIGHT © 2019  
 THE WILSON GROUP ARCHITECTS  
 ALL RIGHTS RESERVED


PRINTED OR ELECTRONIC DRAWINGS AND DOCUMENTATION MAY NOT BE REPRODUCED IN ANY FORM WITHOUT WRITTEN PERMISSION FROM THE WILSON GROUP ARCHITECTS

**REVISIONS**  
 AD-03 07/26/2019

DATE 06/28/19  
 PROJECT NUMBER 9202-000  
 SHEET TITLE

**SCHEDULE 1 - ELECTRICAL RAMP LEVEL AUXILIARY SYSTEMS PLAN ZONE 2**  
 SHEET NUMBER

**E1-132**

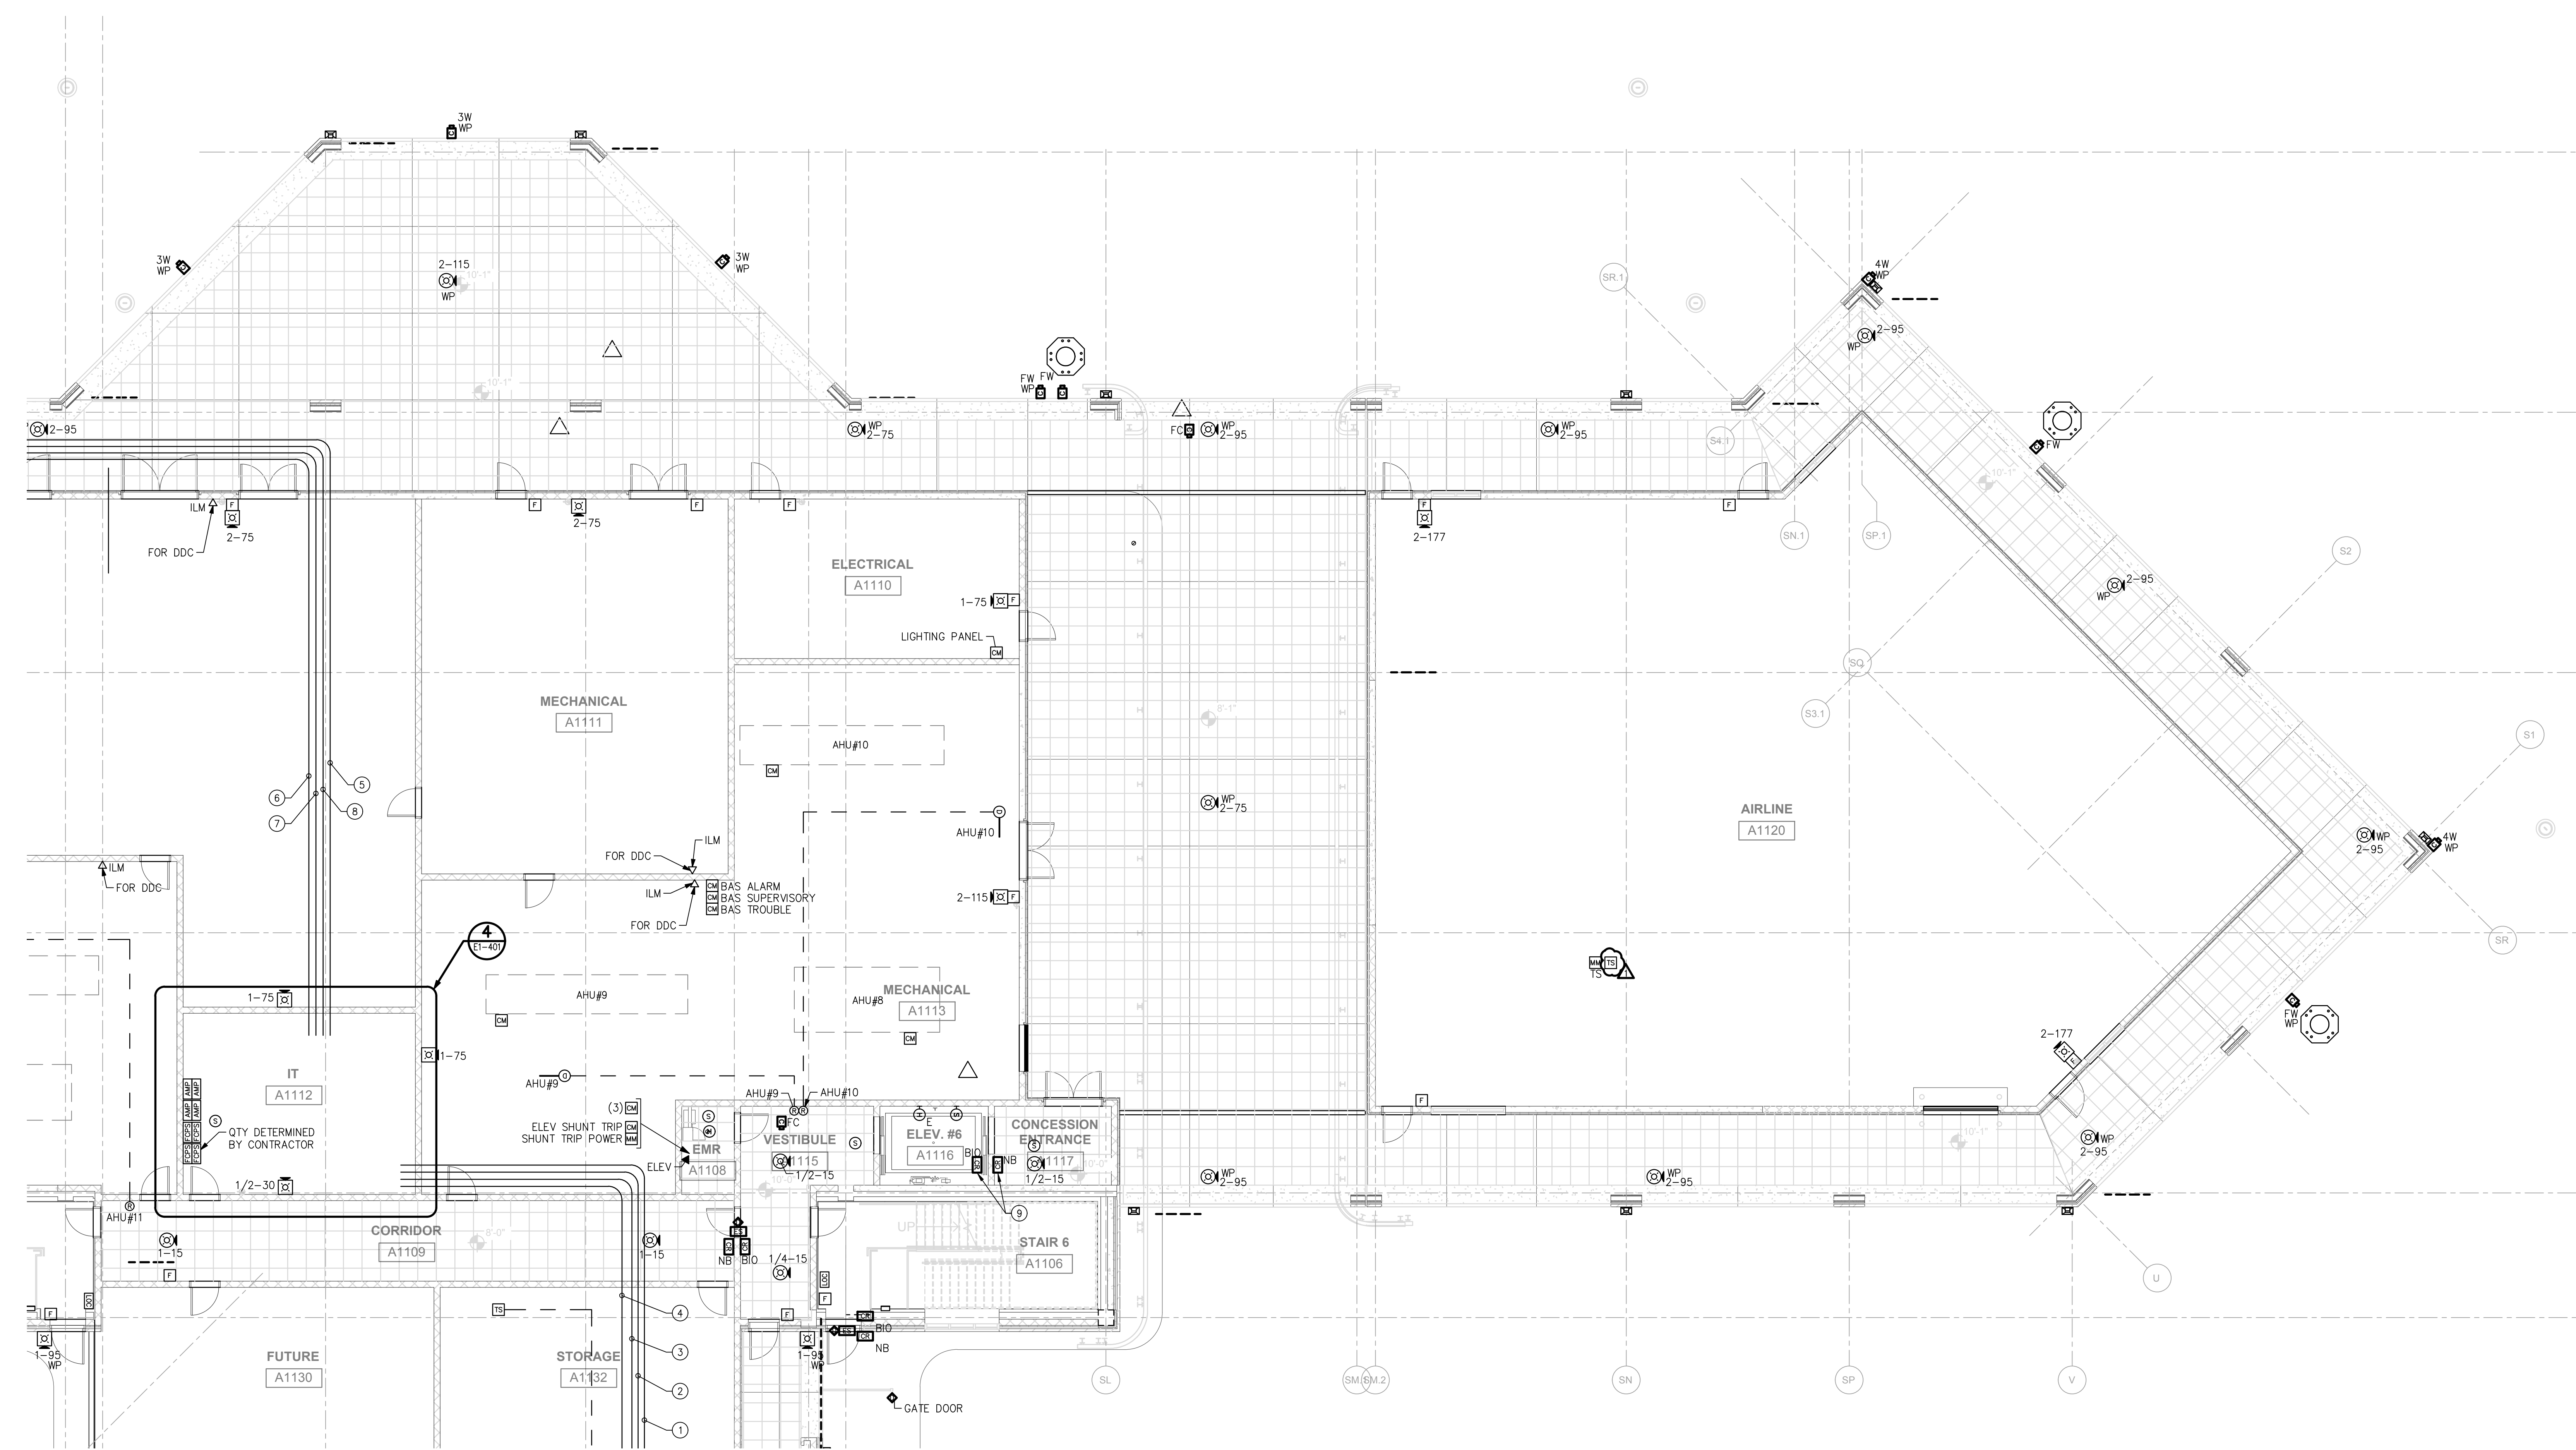

**SCHEDULE 1 - ELECTRICAL RAMP LEVEL - AUXILIARY SYSTEMS PLAN - ZONE 2**  
 SCALE: 1/8" = 1'-0" GRAPHIC SCALE: 1/8" = 1'-0" TRUE NORTH

FOR CONTRACT 3 SCHEDULE 1 AND SCHEDULE 2 WORK PHASES:  
 • SEE ARCHITECTURAL PLANS A-01\* SERIES FOR ADDITIONAL AND DETAILED PHASING INFORMATION.  
 • SEE BAGGAGE HANDLING SYSTEM PLANS B-\* SERIES FOR ADDITIONAL AND DETAILED PHASING INFORMATION.  
 • COORDINATE ACTUAL PHASED WORK REQUIREMENTS WITH THE GENERAL CONTRACTOR'S SCHEDULE.




**TERMINAL IMPROVEMENTS CONTRACT 3**

Wilmington International Airport  
 1740 Airport Boulevard, Suite 12  
 Wilmington, NC 28405

**CHEATHAM & ASSOCIATES, P.A.**  
 CONSULTING ENGINEERS  
 3412 ENTERPRISE DRIVE  
 WILMINGTON, NORTH CAROLINA 28405  
 PHONE: (919) 452-4210  
 FAX: (919) 452-4211  
 OFFICE@CHEATHAMPA.COM  
 NC LICENSE# C-1073

JOB # 19005

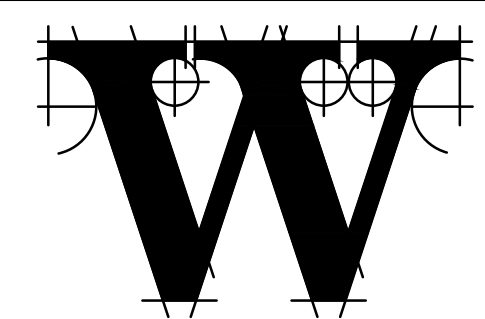

**THE WILSON GROUP**  
 ARCHITECTS

PO Box 5510 Charlotte, NC 28299  
 704-331-9747 • www.twgarchitects.com

PROJECT MANAGER & CIVIL ENGINEER  
**TALBERT & BRIGHT**  
 CONSULTING ARCHITECT  
 LS3P

STRUCTURAL ENGINEER  
**STEWART**


FP/PM/E ENGINEER  
**CHEATHAM & ASSOC.**

BAGGAGE HANDLING CONSULTANTS  
**BNP**

AIRCRAFT SUPPORT SYSTEMS  
**DK CONSULTANTS**

SPECIALTY LIGHTING CONSULTANT  
**HARTRANFT**

SIGNAGE & WAYFINDING  
**TAKEFORM**

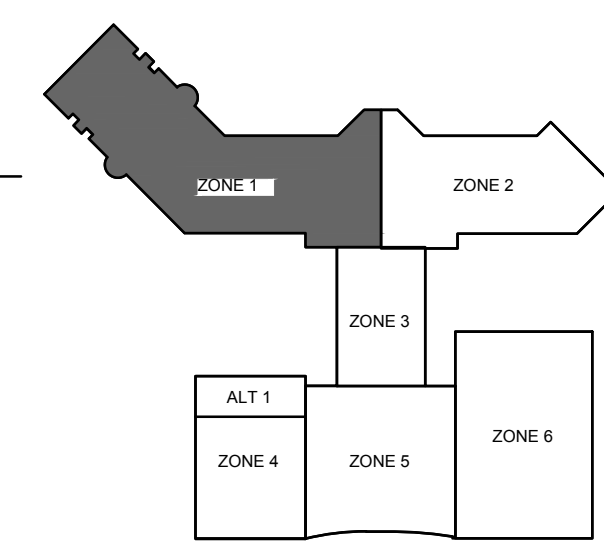

**KEY PLAN**

COPYRIGHT © 2019  
 THE WILSON GROUP ARCHITECTS  
 ALL RIGHTS RESERVED

PRINTED OR ELECTRONIC DRAWINGS AND DOCUMENTATION MAY NOT BE REPRODUCED IN ANY FORM WITHOUT WRITTEN PERMISSION FROM THE WILSON GROUP ARCHITECTS


REVISIONS

AD-03	07/26/2019
-------	------------

DATE 06/28/19  
 PROJECT NUMBER 9202-000  
 SHEET TITLE

**SCHEDULE 1 - ELECTRICAL BOARDING LEVEL POWER PLAN ZONE 1**  
 SHEET NUMBER

**E1-141**


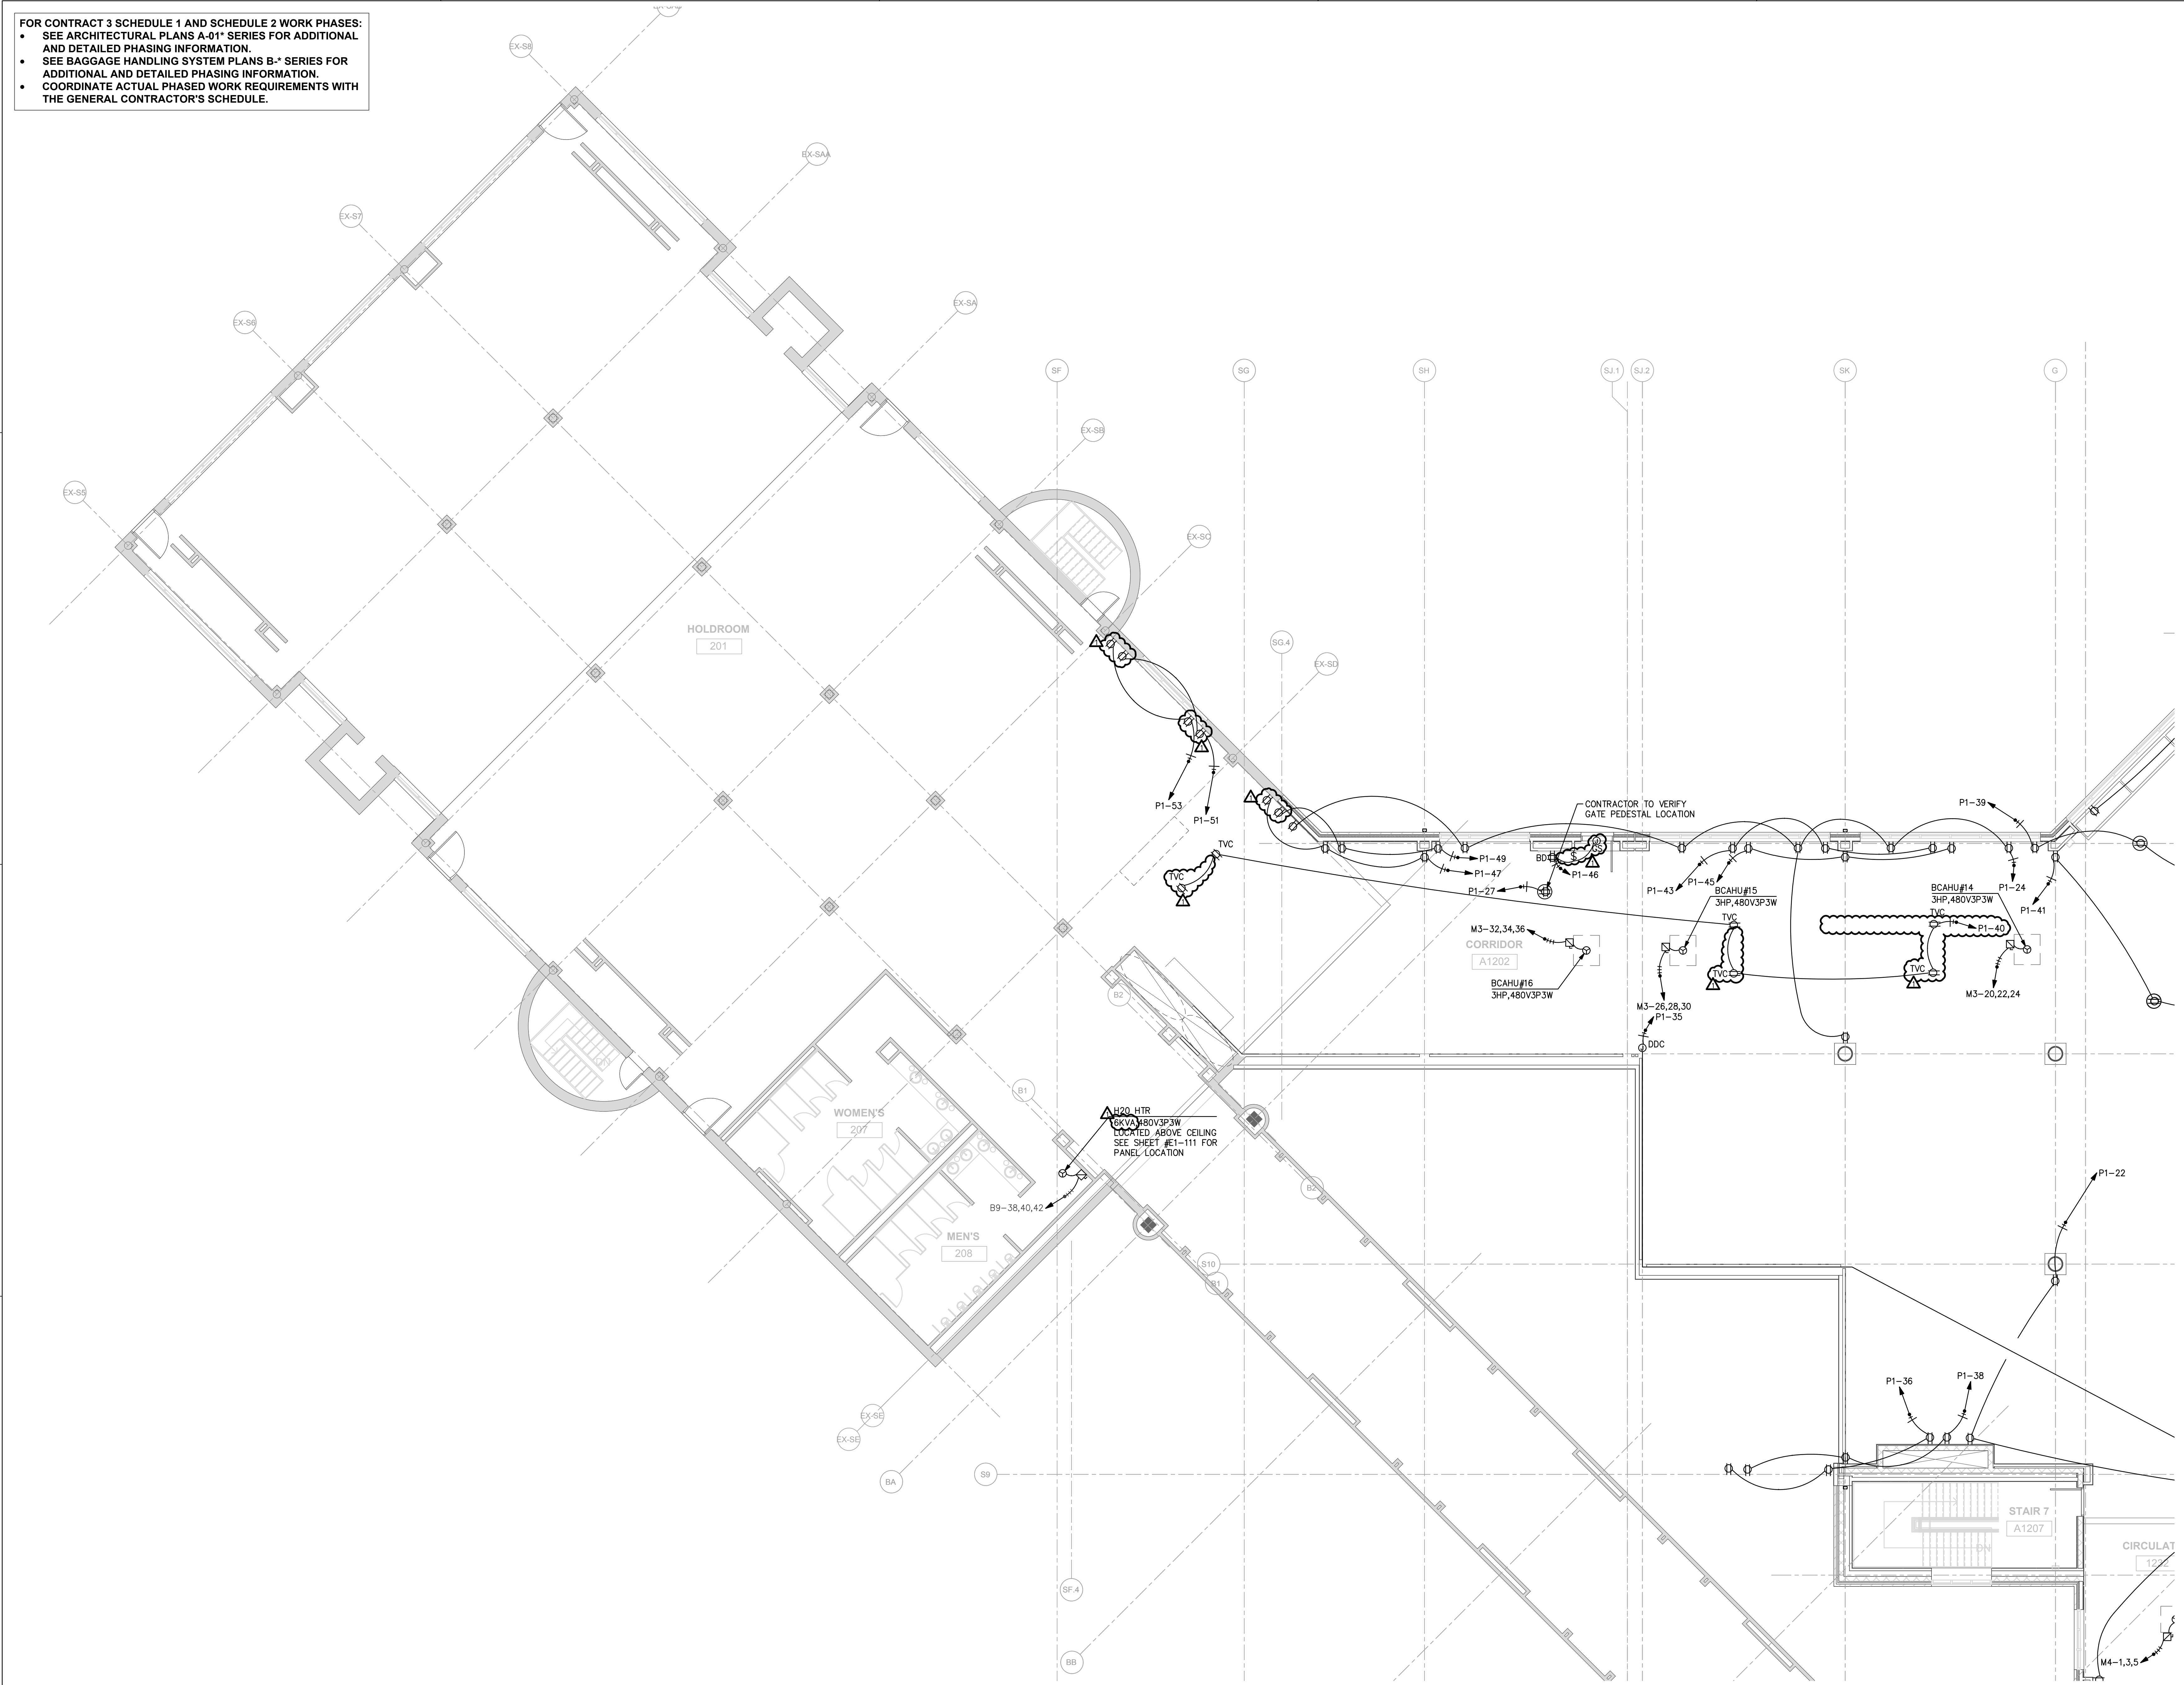


**SCHEDULE 1 - ELECTRICAL BOARDING LEVEL - POWER PLAN - ZONE 1**  
 SCALE: 1/8" = 1'-0"  
 GRAPHIC SCALE: 1" = 1'-0"  
 TRUE NORTH

FOR CONTRACT 3 SCHEDULE 1 AND SCHEDULE 2 WORK PHASES:  
 • SEE ARCHITECTURAL PLANS A-01\* SERIES FOR ADDITIONAL AND DETAILED PHASING INFORMATION.  
 • SEE BAGGAGE HANDLING SYSTEM PLANS B-\* SERIES FOR ADDITIONAL AND DETAILED PHASING INFORMATION.  
 • COORDINATE ACTUAL PHASED WORK REQUIREMENTS WITH THE GENERAL CONTRACTOR'S SCHEDULE.


KEYED NOTES:  
 ① OUTLET FOR ADULT CHANGING TABLE. MOUNTING HEIGHT IS 5'-1/8" TO TOP OF OUTLET AFF. COORDINATE EXACT LOCATION WITH EQUIPMENT VENDOR.

**CHEATHAM & ASSOCIATES, P.A.**  
 CONSULTING ENGINEERS  
 3412 ENTERPRISE DRIVE  
 WILMINGTON, NORTH CAROLINA 28405  
 PHONE: (910) 452-4210  
 FAX: (910) 452-4211  
 OFFICE@CHEATHAM.PA.COM  
 NC LICENSE# C-1073  
**JOB # 19005**

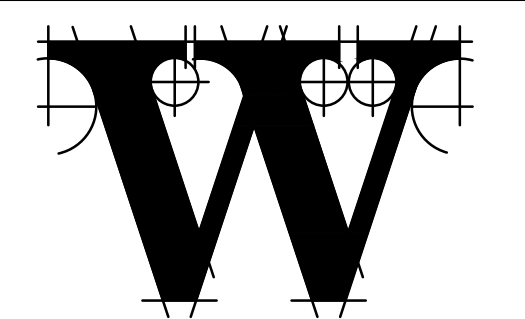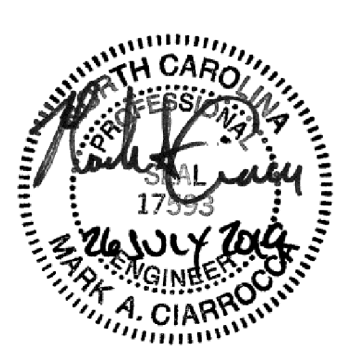

**THE WILSON GROUP - ARCHITECTS -**  
 PO Box 5510 Charlotte, NC 28299  
 704-331-9747 • www.twgarchitects.com

PROJECT MANAGER & CIVIL ENGINEER  
**TALBERT & BRIGHT**  
 CONSULTING ARCHITECT  
**LS3P**  
 STRUCTURAL ENGINEER  
**STEWART**  
 FPP/PM/E ENGINEER  
**CHEATHAM & ASSOC.**  
 BAGGAGE HANDLING CONSULTANTS  
**BNP**  
 AIRCRAFT SUPPORT SYSTEMS  
**DK CONSULTANTS**  
 SPECIALTY LIGHTING CONSULTANT  
**HARTRANFT**  
 SIGNAGE & WAYFINDING  
**TAKEFORM**

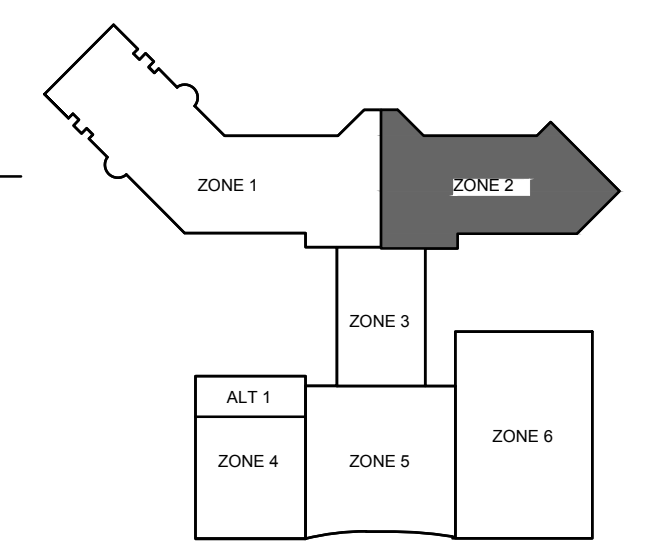

**KEY PLAN**


COPYRIGHT © 2019  
 THE WILSON GROUP ARCHITECTS  
 ALL RIGHTS RESERVED  
 PRINTED OR ELECTRONIC DRAWINGS AND DOCUMENTATION MAY NOT BE REPRODUCED IN ANY FORM WITHOUT WRITTEN PERMISSION FROM THE WILSON GROUP ARCHITECTS

REVISIONS  
 AD-03 07/26/2019


DATE 06/28/19  
 PROJECT NUMBER 9202-000  
 SHEET TITLE

**SCHEDULE 1 - ELECTRICAL BOARDING LEVEL POWER PLAN ZONE 2**  
 SHEET NUMBER

**E1-142**

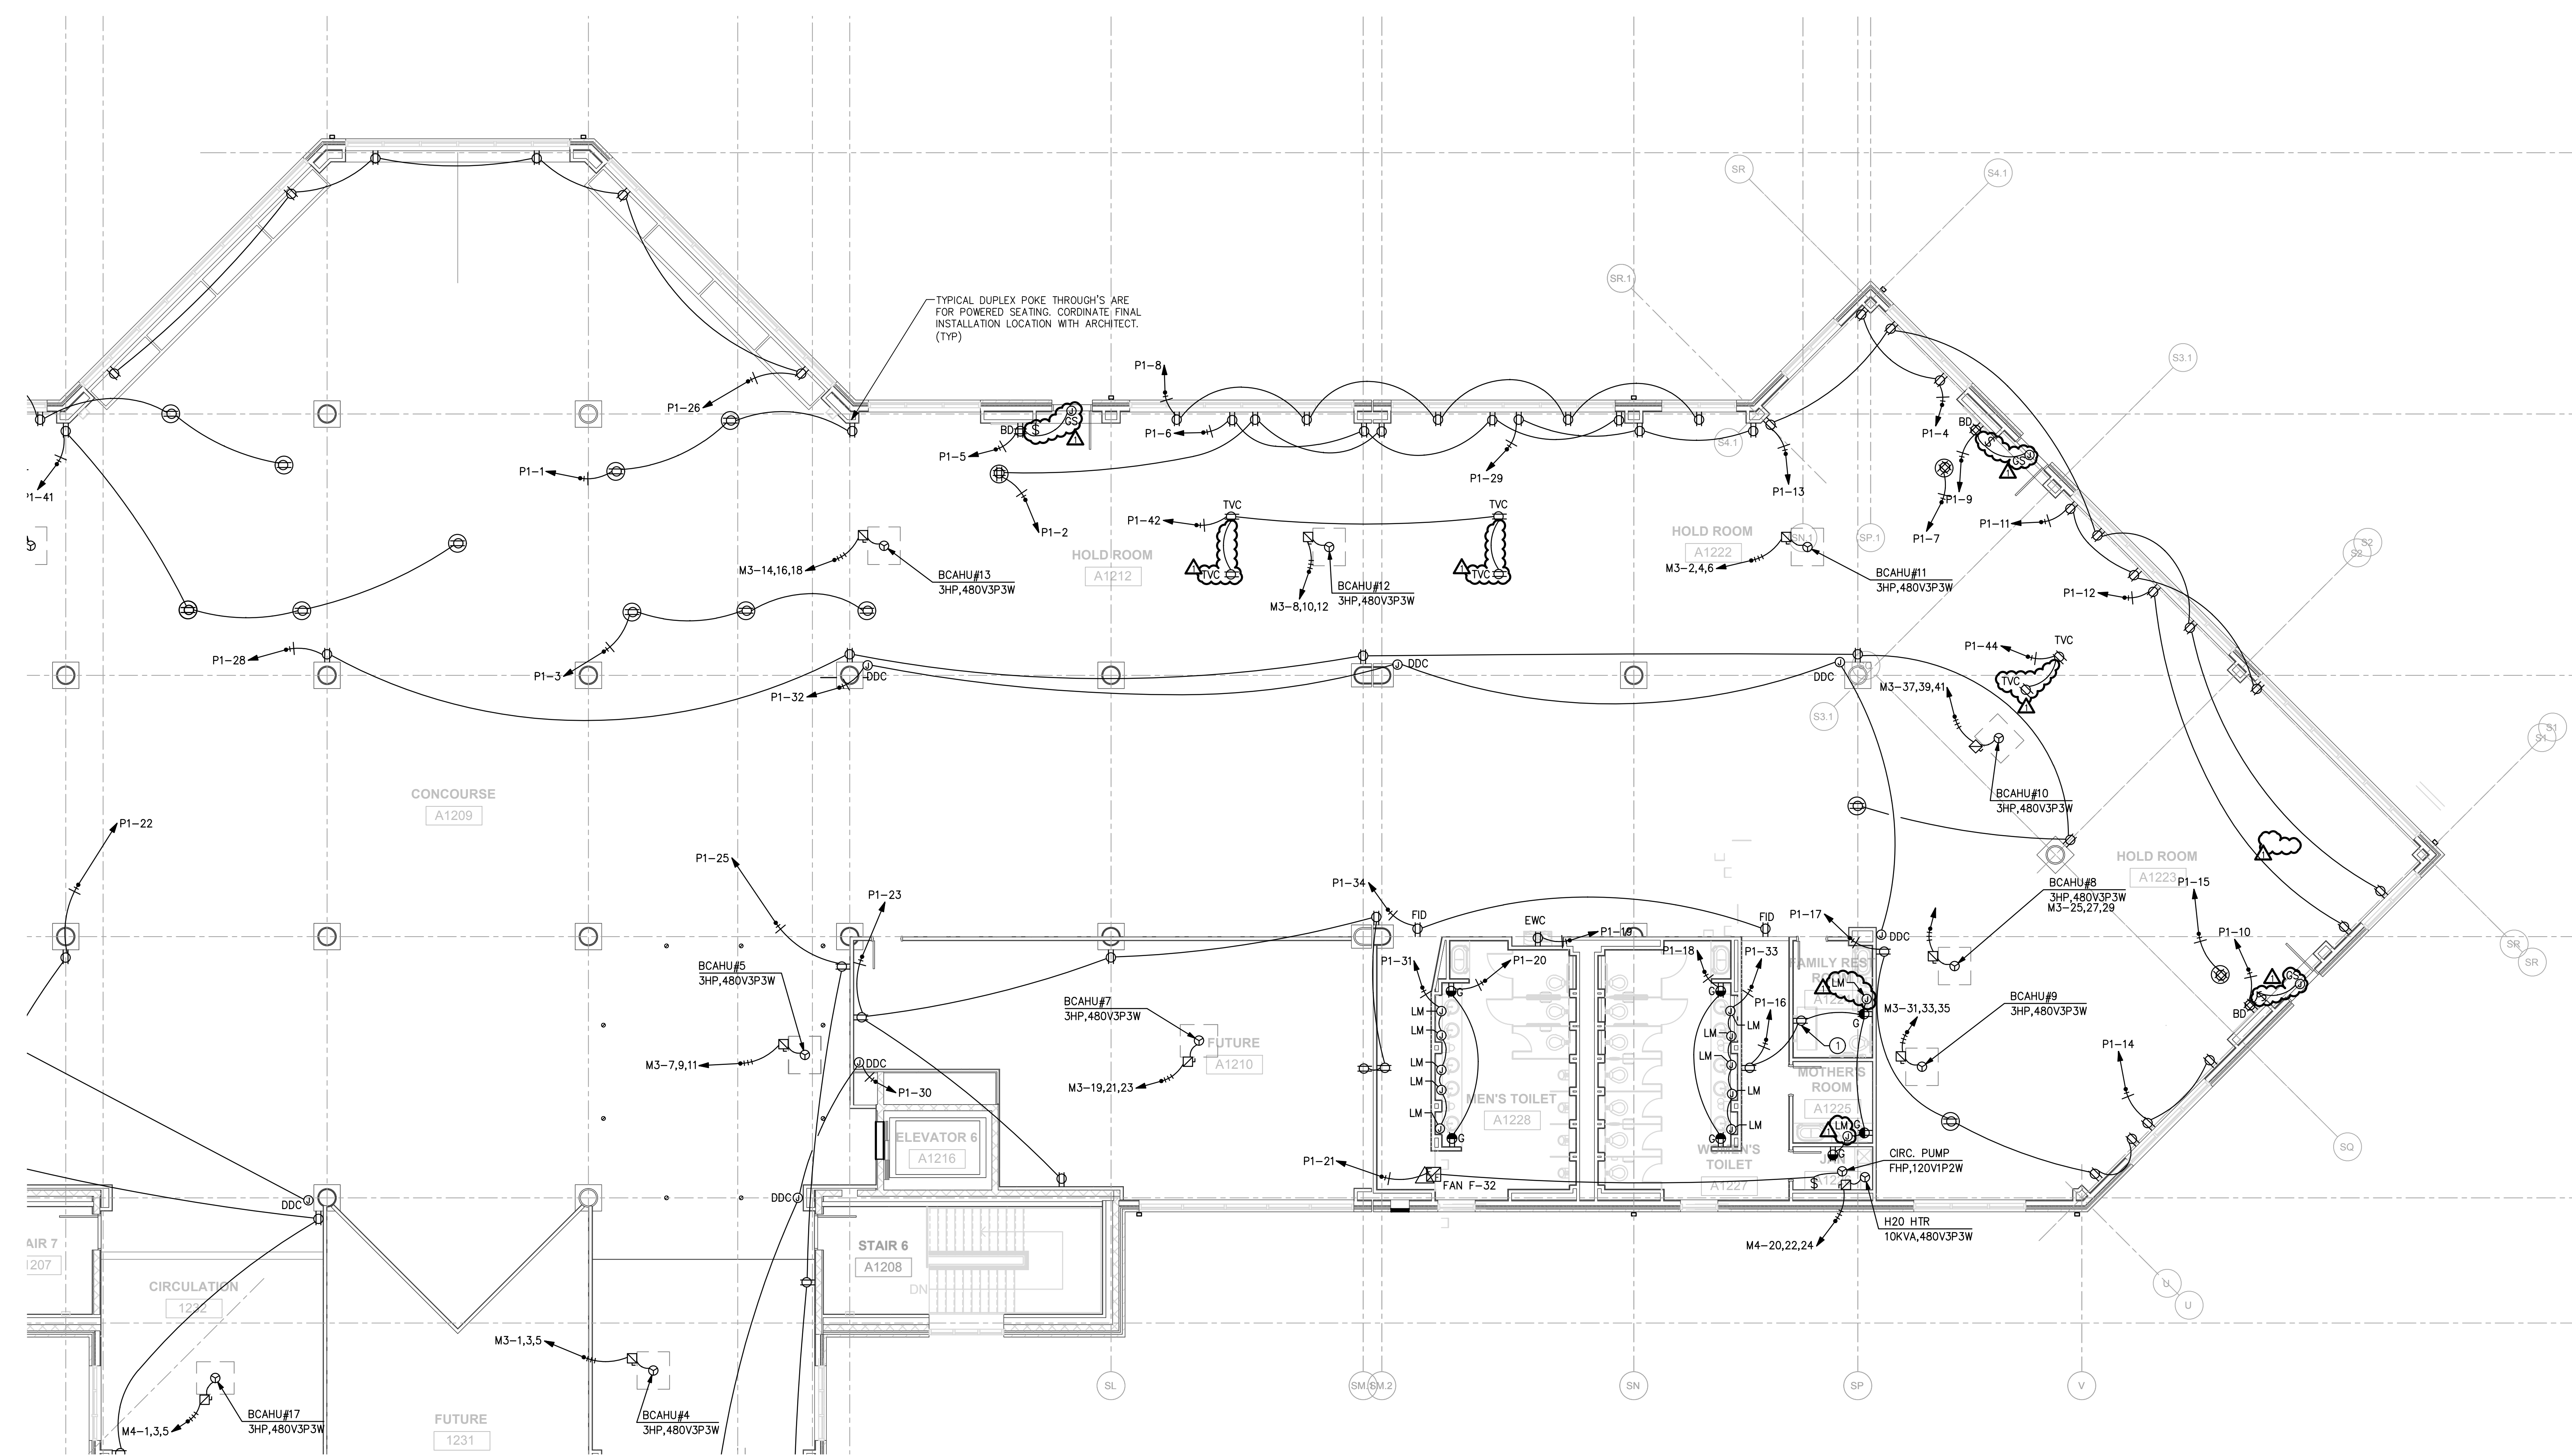


① SCHEDULE 1 - ELECTRICAL BOARDING LEVEL - POWER PLAN - ZONE 2  
 SCALE: 1/8" = 1'-0"

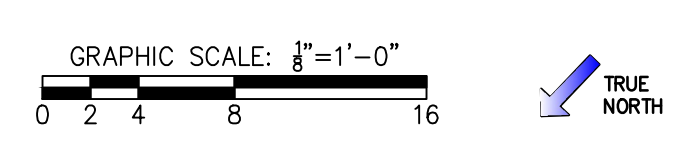

FOR CONTRACT 3 SCHEDULE 1 AND SCHEDULE 2 WORK PHASES:  
 • SEE ARCHITECTURAL PLANS A-01\* SERIES FOR ADDITIONAL AND DETAILED PHASING INFORMATION.  
 • SEE BAGGAGE HANDLING SYSTEM PLANS B-\* SERIES FOR ADDITIONAL AND DETAILED PHASING INFORMATION.  
 • COORDINATE ACTUAL PHASED WORK REQUIREMENTS WITH THE GENERAL CONTRACTOR'S SCHEDULE.

KEYED NOTES:  
 ① JUNCTION BOX FOR FUTURE RESTAURANT POWER. 1 1/2" C, 3#1, 1 N, #6G TO LOCATED IN EXISTING ELECTRICAL ROOM A5 (DSBA-5) LOCATED ON RAMP LEVEL. SEE E1-401 FOR LOCATION.

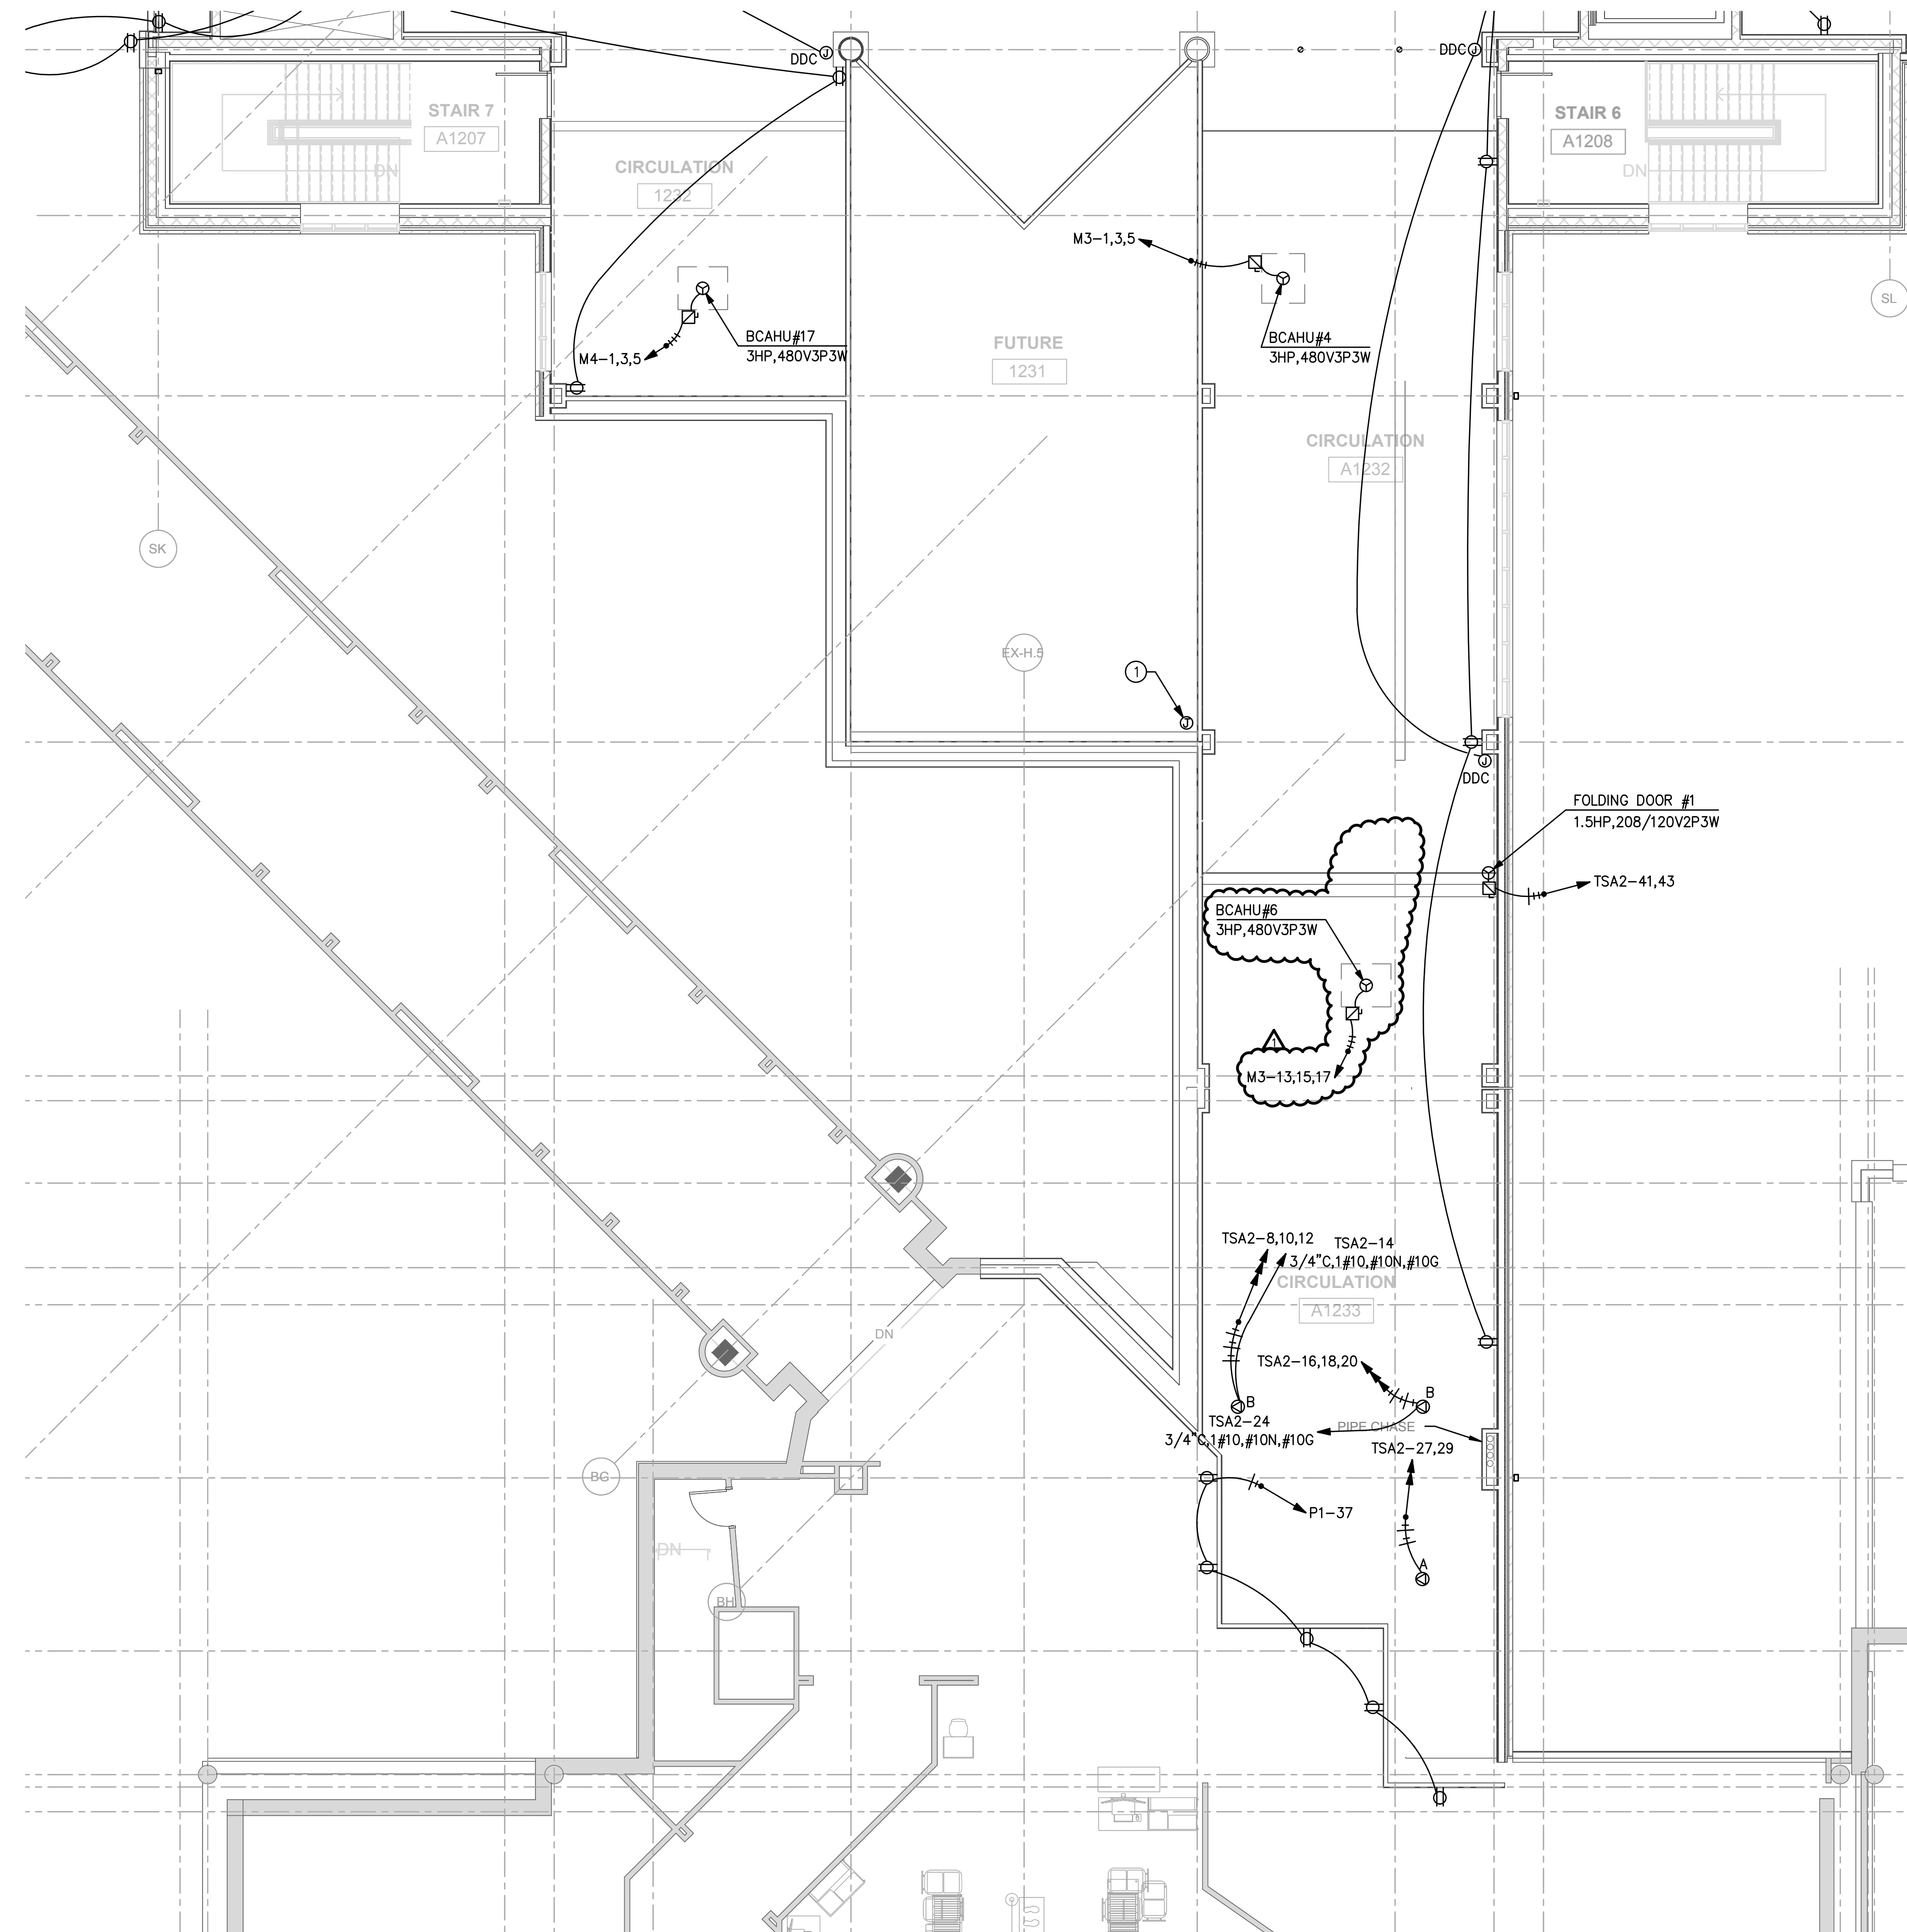

① SCHEDULE 1 - ELECTRICAL BOARDING LEVEL - POWER PLAN - ZONE 3  
 SCALE: 1/8" = 1'-0"

GRAPHIC SCALE: 1/8" = 1'-0"  
 0 2 4 8 16

TRUE NORTH




**TERMINAL IMPROVEMENTS CONTRACT 3**

Wilmington International Airport  
 1740 Airport Boulevard, Suite 12  
 Wilmington, NC 28405

**CHEATHAM & ASSOCIATES, P.A.**  
 CONSULTING ENGINEERS  
 3412 ENTERPRISE DRIVE  
 WILMINGTON, NORTH CAROLINA 28405  
 PHONE: (919) 452-4210  
 FAX: (919) 452-4211  
 OFFICE@CHEATHAMPA.COM  
 NC LICENSE# C-1073

JOB # 19005

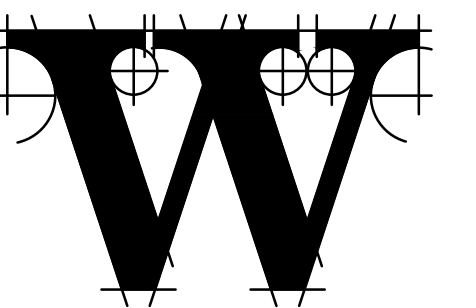

**THE WILSON GROUP**

ARCHITECTS  
 PO Box 5510 Charlotte, NC 28299  
 704-331-9747 • www.twgarchitects.com

PROJECT MANAGER & CIVIL ENGINEER  
**TALBERT & BRIGHT**  
 CONSULTING ARCHITECT  
 LS3P

STRUCTURAL ENGINEER  
**STEWART**


FPP/PM/E ENGINEER  
**CHEATHAM & ASSOC.**

BAGGAGE HANDLING CONSULTANTS  
**BNP**

AIRCRAFT SUPPORT SYSTEMS  
**DK CONSULTANTS**

SPECIALTY LIGHTING CONSULTANT  
**HARTRANFT**

SIGNAGE & WAYFINDING  
**TAKEFORM**

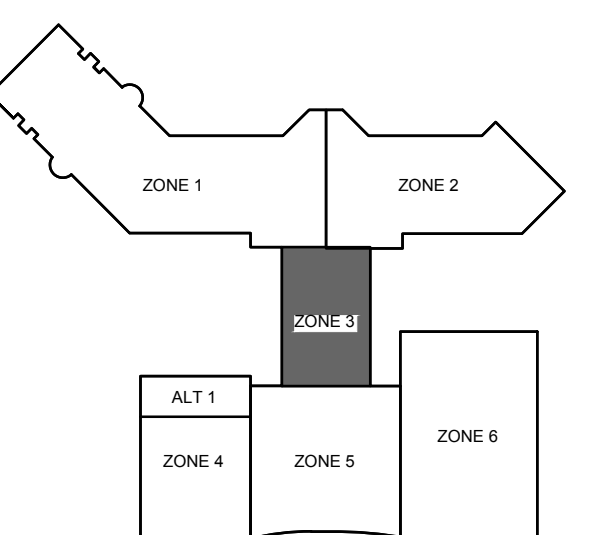

**KEY PLAN**

COPYRIGHT © 2019  
 THE WILSON GROUP ARCHITECTS  
 ALL RIGHTS RESERVED

PRINTED OR ELECTRONIC DRAWINGS AND DOCUMENTATION MAY NOT BE REPRODUCED IN ANY FORM WITHOUT WRITTEN PERMISSION FROM THE WILSON GROUP ARCHITECTS

**REVISIONS**

AD-03 07/26/2019

DATE 06/28/19  
 PROJECT NUMBER 9202-000  
 SHEET TITLE

**SCHEDULE 1 - ELECTRICAL BOARDING LEVEL POWER PLAN ZONE 3**  
 SHEET NUMBER


**E1-143**

**FOR CONTRACT 3 SCHEDULE 1 AND SCHEDULE 2 WORK PHASES:**


- SEE ARCHITECTURAL PLANS A-01\* SERIES FOR ADDITIONAL AND DETAILED PHASING INFORMATION.
- SEE BAGGAGE HANDLING SYSTEM PLANS B-\* SERIES FOR ADDITIONAL AND DETAILED PHASING INFORMATION.
- COORDINATE ACTUAL PHASED WORK REQUIREMENTS WITH THE GENERAL CONTRACTOR'S SCHEDULE.

**NOTES:**

1. LIGHTING FIXTURE SELECTION AND LAYOUT WERE PERFORMED BY HARTRANFT LIGHTING DESIGN. INCLUSION HERE IS NOT INTENDED TO REPRESENT THAT THE FIXTURE SELECTION AND LAYOUT ARE A WORK PRODUCT OF CHEATHAM & ASSOCIATES, P.A. SEE LUMINAIRE SCHEDULE NOTE 1 FOR WHICH LIGHT FIXTURE TYPES THIS NOTE APPLIES TO.
2. NUMBER NEXT TO LIGHT FIXTURE INDICATES DIMMER SCHEDULED ZONE. GENERATOR POWERED LIGHT FIXTURES ARE CONTROLLED ON SAME DIMMER ZONE AS CORRESPONDING ROW.

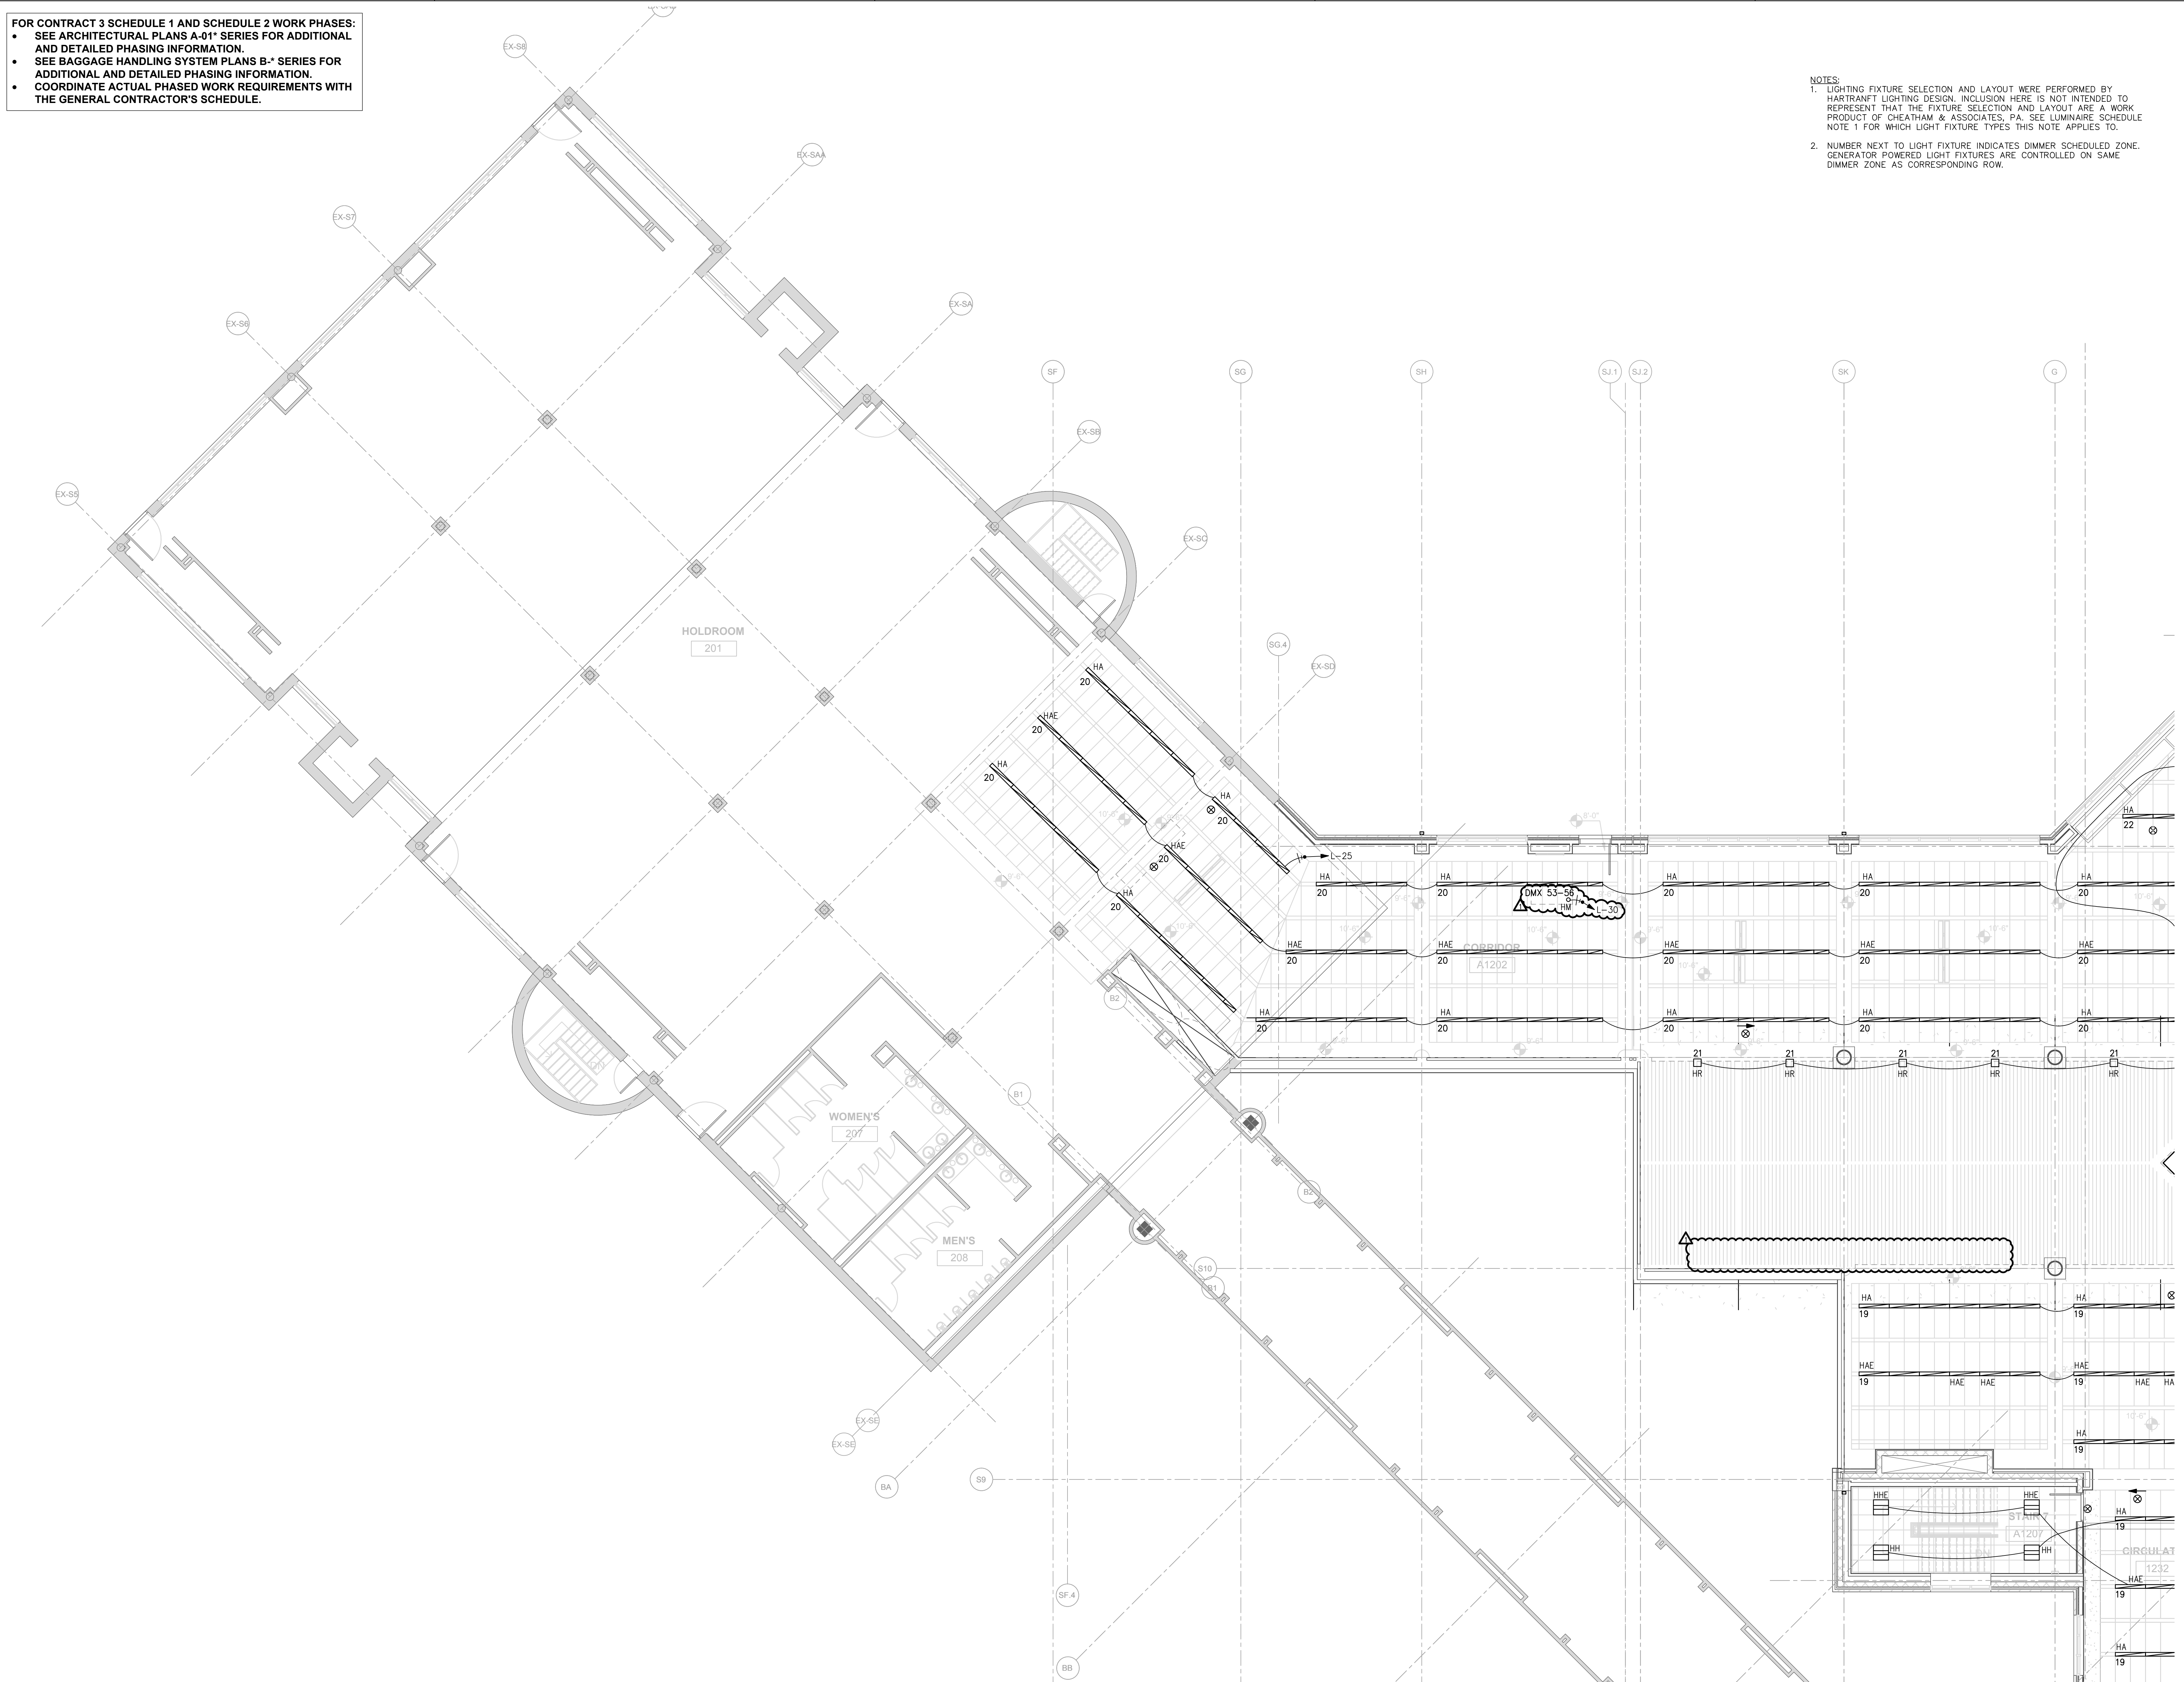

**1** SCHEDULE 1 - ELECTRICAL BOARDING LEVEL - LIGHTING PLAN - ZONE 1  
SCALE: 1/8" = 1'-0"

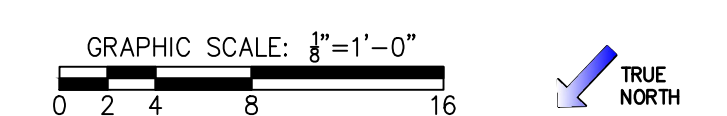


**ILM**  
**TERMINAL IMPROVEMENTS CONTRACT 3**  
Wilmington International Airport  
1740 Airport Boulevard, Suite 12  
Wilmington, NC 28405

**CHEATHAM & ASSOCIATES, P.A.**  
CONSULTING ENGINEERS  
3412 ENTERPRISE DRIVE  
WILMINGTON, NORTH CAROLINA 28405  
PHONE: (919) 452-4210 FAX: (919) 452-4211  
OFFICE@CHEATHAMPA.COM  
NC LICENSE# C-1073  
**JOB # 19005**



**THE WILSON GROUP**  
- ARCHITECTS -  
PO Box 5510 Charlotte, NC 28299  
704-331-9747 • www.twgarchitects.com

- PROJECT MANAGER & CIVIL ENGINEER  
**TALBERT & BRIGHT**  
CONSULTING ARCHITECT  
LS3P
- STRUCTURAL ENGINEER  
**STEWART**
- FPP/IME ENGINEER  
**CHEATHAM & ASSOC.**
- BAGGAGE HANDLING CONSULTANTS  
**BNP**
- AIRCRAFT SUPPORT SYSTEMS  
**DK CONSULTANTS**
- SPECIALTY LIGHTING CONSULTANT  
**HARTRANFT**
- SIGNAGE & WAYFINDING  
**TAKEFORM**

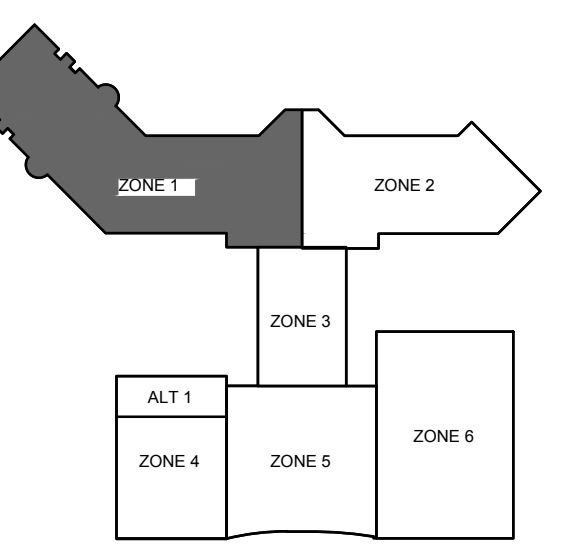

**KEY PLAN**  
COPYRIGHT © 2019  
THE WILSON GROUP ARCHITECTS  
ALL RIGHTS RESERVED  
PRINTED OR ELECTRONIC DRAWINGS AND DOCUMENTATION MAY NOT BE REPRODUCED IN ANY FORM WITHOUT WRITTEN PERMISSION FROM THE WILSON GROUP ARCHITECTS




**REVISIONS**

AD-03	07/26/2019
-------	------------

DATE 06/28/19  
PROJECT NUMBER 9202-000  
SHEET TITLE  
**SCHEDULE 1 - ELECTRICAL BOARDING LEVEL LIGHTING PLAN ZONE 1**  
SHEET NUMBER  
**E1-151**

- FOR CONTRACT 3 SCHEDULE 1 AND SCHEDULE 2 WORK PHASES:**
- SEE ARCHITECTURAL PLANS A-01\* SERIES FOR ADDITIONAL AND DETAILED PHASING INFORMATION.
  - SEE BAGGAGE HANDLING SYSTEM PLANS B-\* SERIES FOR ADDITIONAL AND DETAILED PHASING INFORMATION.
  - COORDINATE ACTUAL PHASED WORK REQUIREMENTS WITH THE GENERAL CONTRACTOR'S SCHEDULE.


**CUPOLA LUMINAIRE SCHEDULE**

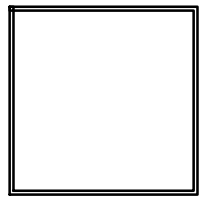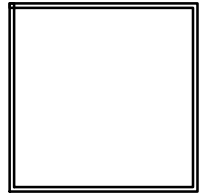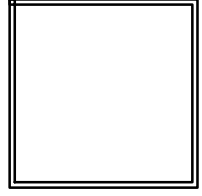CALLOUT	SYMBOL	DESCRIPTION	LAMP	BALLAST	VOLTS	MOUNTING	MANUFACTURER / MODEL	NOTES
H01		16' SQUARE PENDANT	(1) 640W LED	LED DIMMABLE DRIVER	277V 1P 2W	CUPOLA	IVICTUS LIGHTING #CCSD-B3516-1680 MANNING PRE-APPROVED EQUIVALENT 80-MAR INDUSTRIES PRE-APPROVED EQUIVALENT	1000 LUMENS/FT. 3000K COLOR TEMPERATURE. 80 CRI. BRUSHED METAL FINISH. REMOTE LED DRIVER. CONTRACTOR TO INDICATE ON AS-BUILTS MARKUPS LOCATION OF LED REMOVE LED DRIVER. COORDINATE MOUNTING HEIGHT AND ORIENTATION WITH ARCHITECT. SEE NOTE 1.
H02		14' SQUARE PENDANT	(1) 560W LED	LED DIMMABLE DRIVER	277V 1P 2W	CUPOLA	IVICTUS LIGHTING #CCSD-B3516-1680 MANNING PRE-APPROVED EQUIVALENT 80-MAR INDUSTRIES PRE-APPROVED EQUIVALENT	1000 LUMENS/FT. 3000K COLOR TEMPERATURE. 80 CRI. BRUSHED METAL FINISH. REMOTE LED DRIVER. CONTRACTOR TO INDICATE ON AS-BUILTS MARKUPS LOCATION OF LED REMOVE LED DRIVER. COORDINATE MOUNTING HEIGHT AND ORIENTATION WITH ARCHITECT. SEE NOTE 1.
H03		12' SQUARE PENDANT	(1) 480W LED	LED DIMMABLE DRIVER	277V 1P 2W	CUPOLA	IVICTUS LIGHTING #CCSD-B3516-1680 MANNING PRE-APPROVED EQUIVALENT 80-MAR INDUSTRIES PRE-APPROVED EQUIVALENT	1000 LUMENS/FT. 3000K COLOR TEMPERATURE. 80 CRI. BRUSHED METAL FINISH. REMOTE LED DRIVER. CONTRACTOR TO INDICATE ON AS-BUILTS MARKUPS LOCATION OF LED REMOVE LED DRIVER. COORDINATE MOUNTING HEIGHT AND ORIENTATION WITH ARCHITECT. SEE NOTE 1.

NOTES:  
1. LIGHT FIXTURE SELECTION WAS DESIGNED BY HARTRANFT LIGHTING DESIGN. INCLUSION HERE IS NOT INTENDED TO REPRESENT THAT THE FIXTURE SELECTION IS THE WORK PRODUCT OF CHEATHAM & ASSOCIATES, P.A.

NOTES:  
1. LIGHTING FIXTURE SELECTION AND LAYOUT WERE PERFORMED BY HARTRANFT LIGHTING DESIGN. INCLUSION HERE IS NOT INTENDED TO REPRESENT THAT THE FIXTURE SELECTION AND LAYOUT ARE A WORK PRODUCT OF CHEATHAM & ASSOCIATES, P.A. SEE LUMINAIRE SCHEDULE NOTE 1 FOR WHICH LIGHT FIXTURE TYPES THIS NOTE APPLIES TO.  
2. NUMBER NEXT TO LIGHT FIXTURE INDICATES DIMMER SCHEDULED ZONE. GENERATOR POWERED LIGHT FIXTURES ARE CONTROLLED ON SAME DIMMER ZONE AS CORRESPONDING ROW.

KEYED NOTES:  
① THERE SHALL BE NO VISIBLE CONDUIT RUN THROUGH THIS AREA.

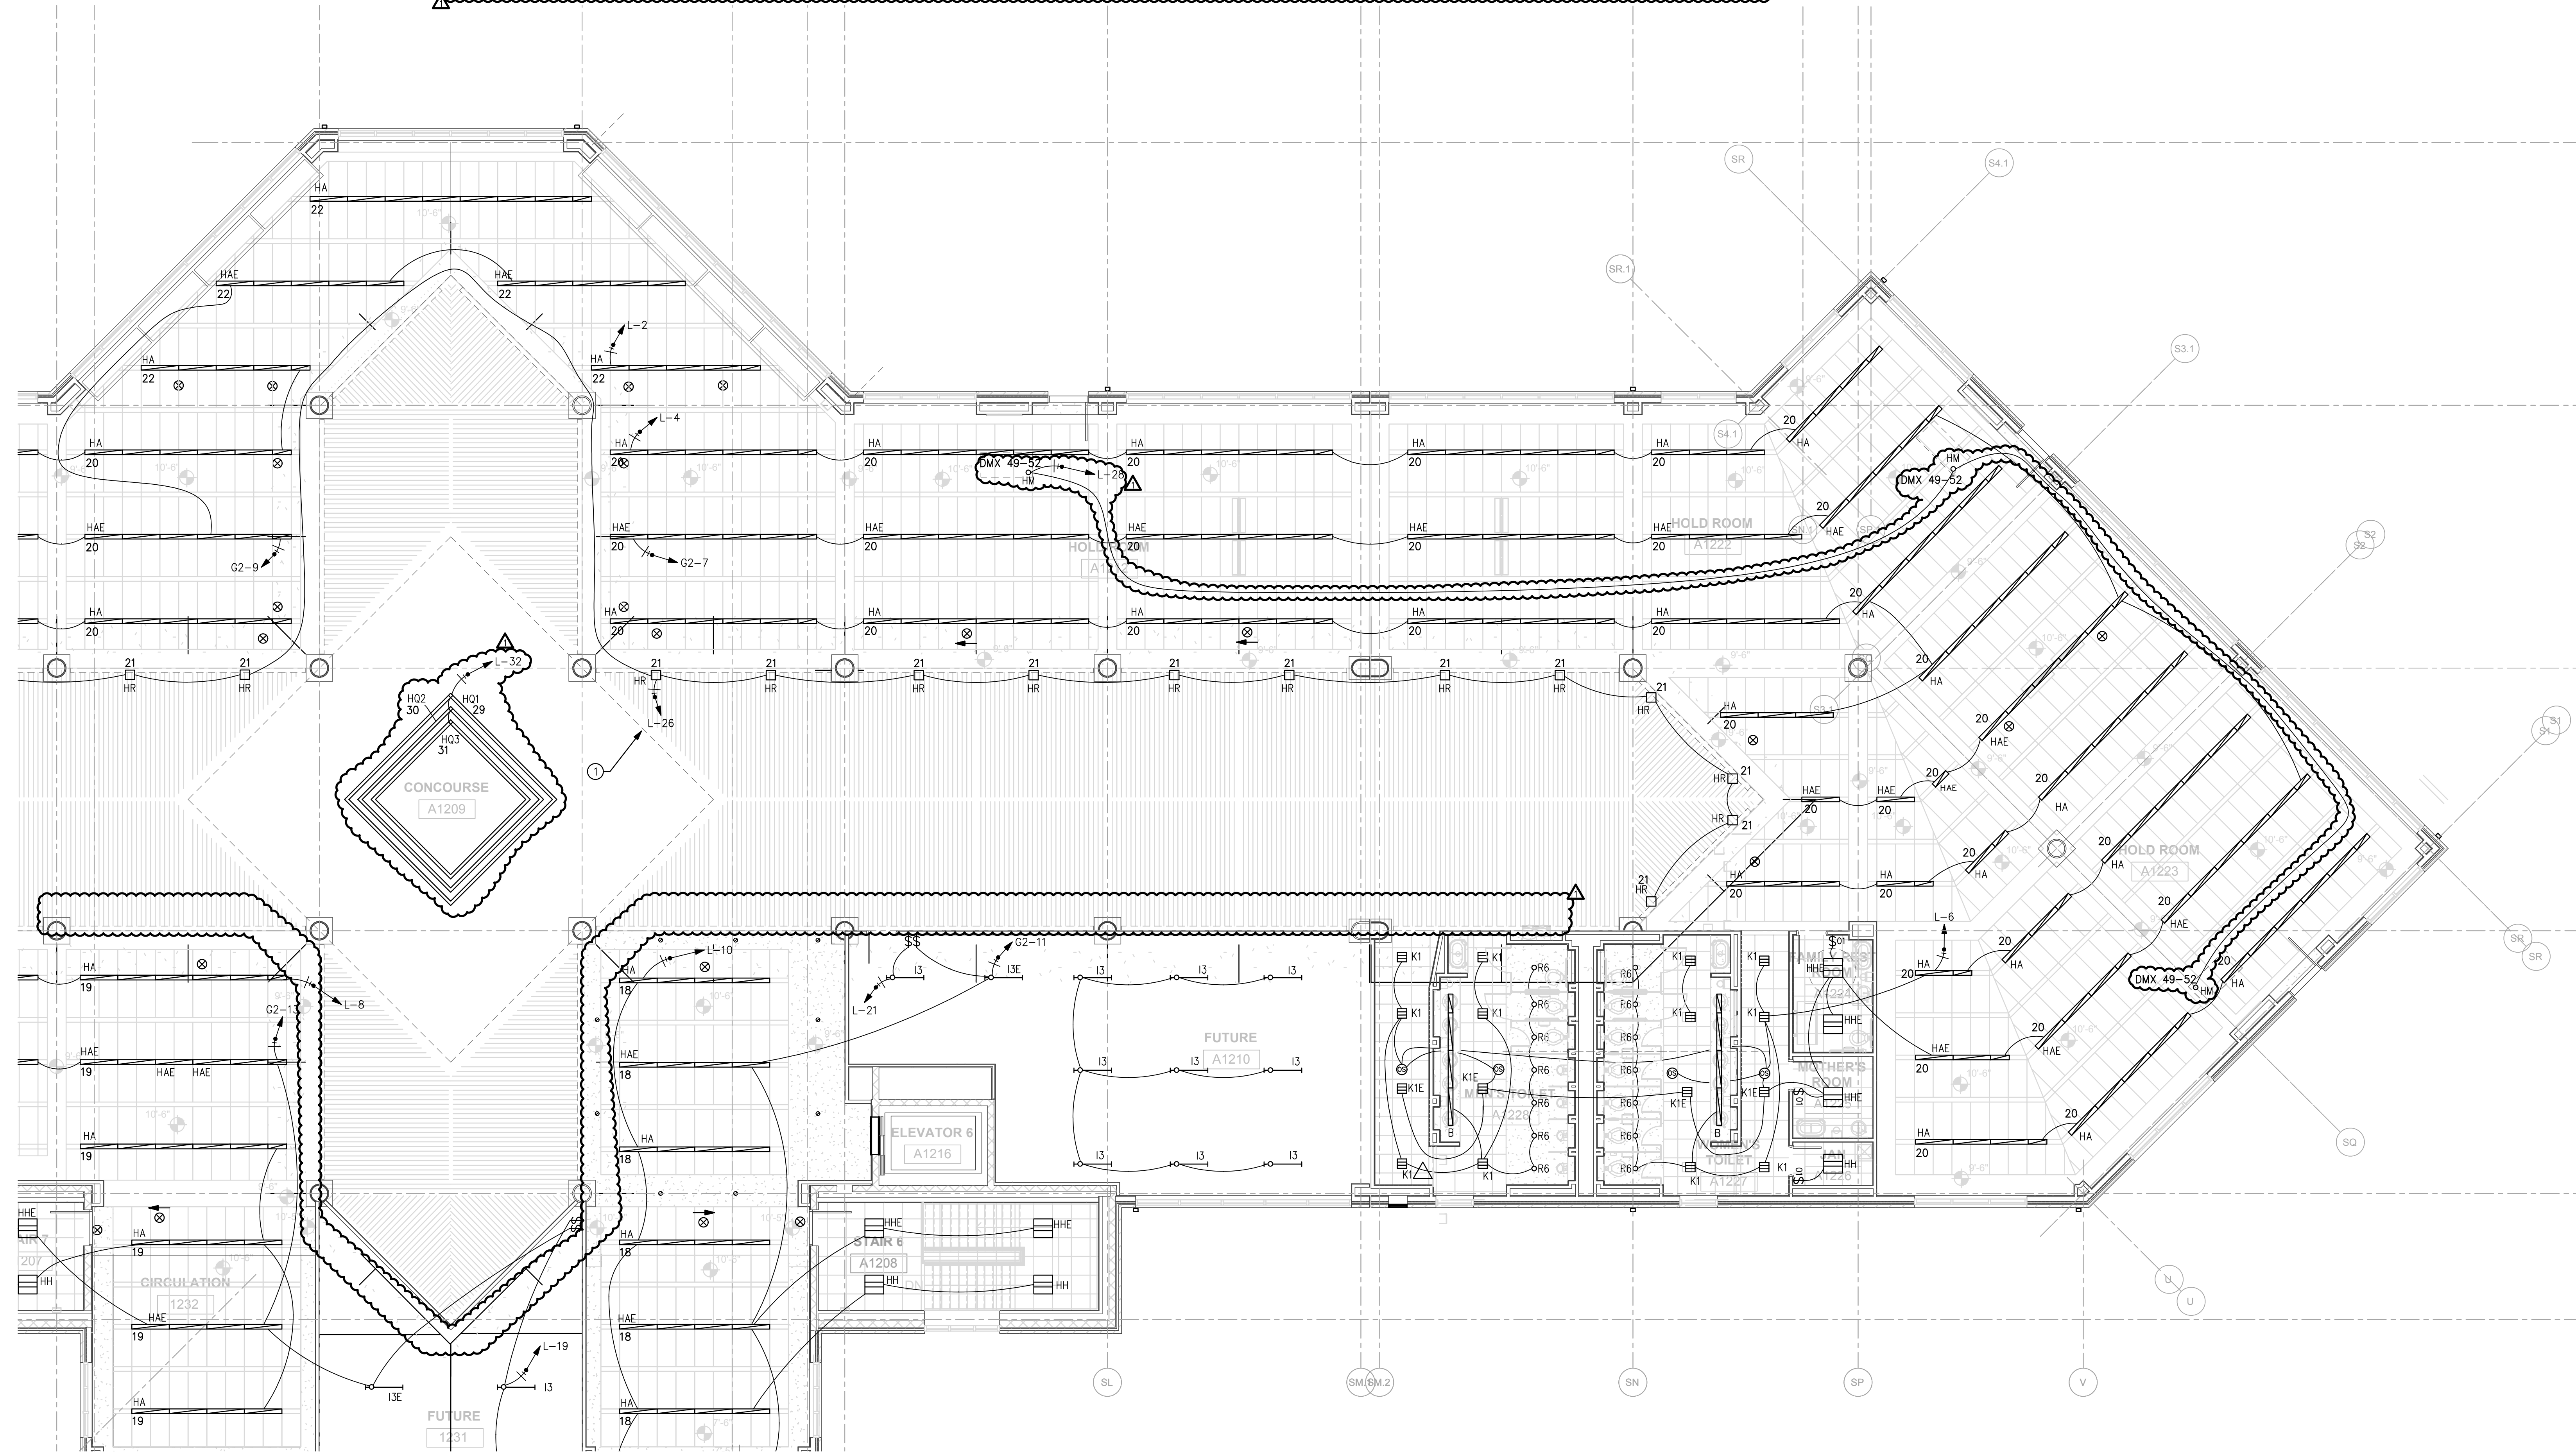

① SCHEDULE 1 - ELECTRICAL BOARDING LEVEL - LIGHTING PLAN - ZONE 2  
SCALE: 1/8" = 1'-0"

GRAPHIC SCALE: 1/8" = 1'-0"  
0 2 4 8 16  
TRUE NORTH


**ILM**  
**TERMINAL IMPROVEMENTS CONTRACT 3**  
Wilmington International Airport  
1740 Airport Boulevard, Suite 12  
Wilmington, NC 28405

**CHEATHAM & ASSOCIATES, P.A.**  
CONSULTING ENGINEERS  
3412 ENTERPRISE DRIVE  
WILMINGTON, NORTH CAROLINA 28405  
PHONE: (910) 452-4210  
FAX: (910) 452-4211  
OFFICE@CHEATHAMPA.COM  
NC LICENSE# C-1073  
JOB # 19005



**THE WILSON GROUP**  
- ARCHITECTS -  
PO Box 5510 Charlotte, NC 28299  
704-331-9747 • www.twgarchitects.com

- PROJECT MANAGER & CIVIL ENGINEER  
**TALBERT & BRIGHT**  
CONSULTING ARCHITECT  
LS3P
- STRUCTURAL ENGINEER  
**STEWART**
- FP/PM/E ENGINEER  
**CHEATHAM & ASSOC.**
- BAGGAGE HANDLING CONSULTANTS  
**BNP**
- AIRCRAFT SUPPORT SYSTEMS  
**DK CONSULTANTS**
- SPECIALTY LIGHTING CONSULTANT  
**HARTRANFT**
- SIGNAGE & WAYFINDING  
**TAKEFORM**

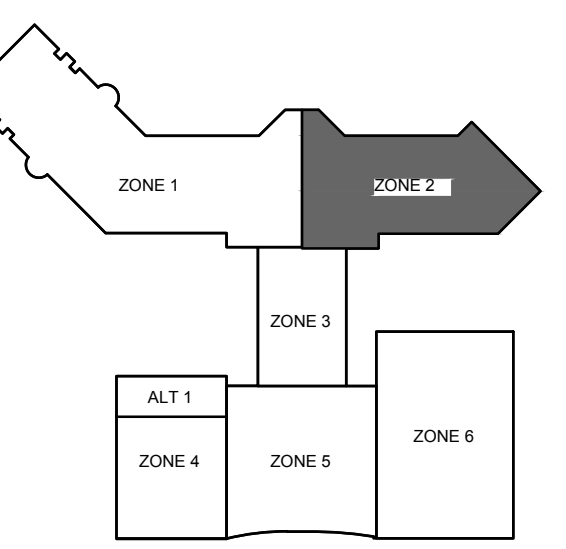

KEY PLAN  
COPYRIGHT © 2019  
THE WILSON GROUP ARCHITECTS  
ALL RIGHTS RESERVED  
PRINTED OR ELECTRONIC DRAWINGS AND DOCUMENTATION MAY NOT BE REPRODUCED IN ANY FORM WITHOUT WRITTEN PERMISSION FROM THE WILSON GROUP ARCHITECTS

REVISIONS  
AD-03 07/26/2019

DATE 06/28/19  
PROJECT NUMBER 9202-000  
SHEET TITLE  
**SCHEDULE 1 - ELECTRICAL BOARDING LEVEL LIGHTING PLAN ZONE 2**  
SHEET NUMBER  
**E1-152**



FOR CONTRACT 3 SCHEDULE 1 AND SCHEDULE 2 WORK PHASES:  
 • SEE ARCHITECTURAL PLANS A-01\* SERIES FOR ADDITIONAL AND DETAILED PHASING INFORMATION.  
 • SEE BAGGAGE HANDLING SYSTEM PLANS B-\* SERIES FOR ADDITIONAL AND DETAILED PHASING INFORMATION.  
 • COORDINATE ACTUAL PHASED WORK REQUIREMENTS WITH THE GENERAL CONTRACTOR'S SCHEDULE.





**TERMINAL IMPROVEMENTS CONTRACT 3**

Wilmington International Airport  
 1740 Airport Boulevard, Suite 12  
 Wilmington, NC 28405

**CHEATHAM & ASSOCIATES, P.A.**  
 CONSULTING ENGINEERS  
 3412 ENTERPRISE DRIVE  
 WILMINGTON, NORTH CAROLINA 28405  
 PHONE: (910) 452-4210  
 FAX: (910) 452-4211  
 OFFICE@CHEATHAMPA.COM  
 NC LICENSE# C-1073

JOB # 19005

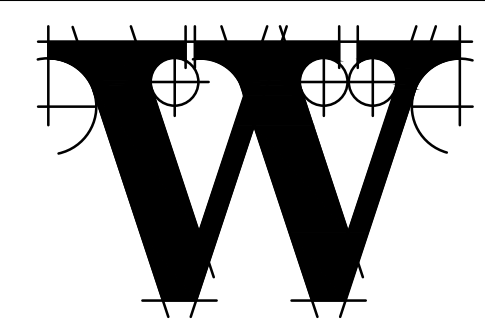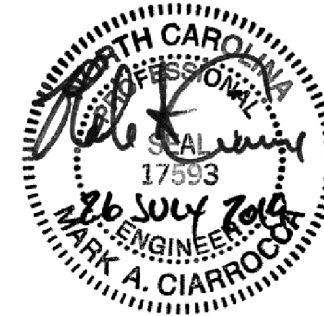

**THE WILSON GROUP ARCHITECTS**

PO Box 5510 Charlotte, NC 28299  
 704-331-9747 • www.twgarchitects.com

PROJECT MANAGER & CIVIL ENGINEER  
**TALBERT & BRIGHT**  
 CONSULTING ARCHITECT  
 LS3P

STRUCTURAL ENGINEER  
**STEWART**


FPP/PM/E ENGINEER  
**CHEATHAM & ASSOC.**

BAGGAGE HANDLING CONSULTANTS  
**BNP**

AIRCRAFT SUPPORT SYSTEMS  
**DK CONSULTANTS**

SPECIALTY LIGHTING CONSULTANT  
**HARTRANFT**

SIGNAGE & WAYFINDING  
**TAKEFORM**

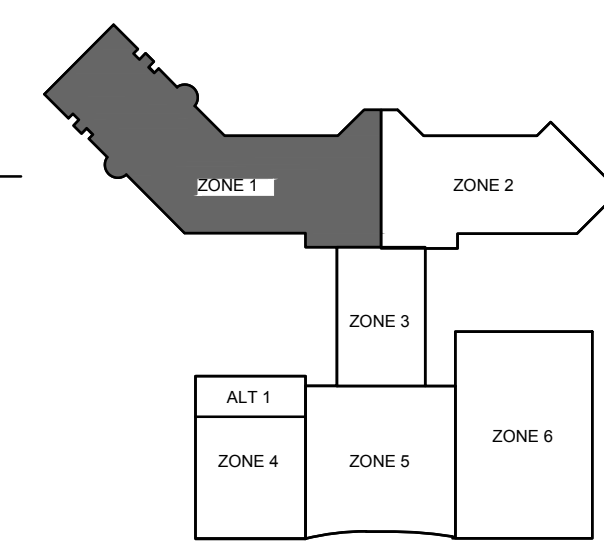

**KEY PLAN**

COPYRIGHT © 2019  
 THE WILSON GROUP ARCHITECTS  
 ALL RIGHTS RESERVED

PRINTED OR ELECTRONIC DRAWINGS AND DOCUMENTATION MAY NOT BE REPRODUCED IN ANY FORM WITHOUT WRITTEN PERMISSION FROM THE WILSON GROUP ARCHITECTS


**REVISIONS**

AD-03 07/26/2019

DATE 06/28/19  
 PROJECT NUMBER 9202-000  
 SHEET TITLE

**SCHEDULE 1 - ELECTRICAL BOARDING LEVEL AUXILIARY SYSTEMS PLAN ZONE 1**  
 SHEET NUMBER

**E1-161**

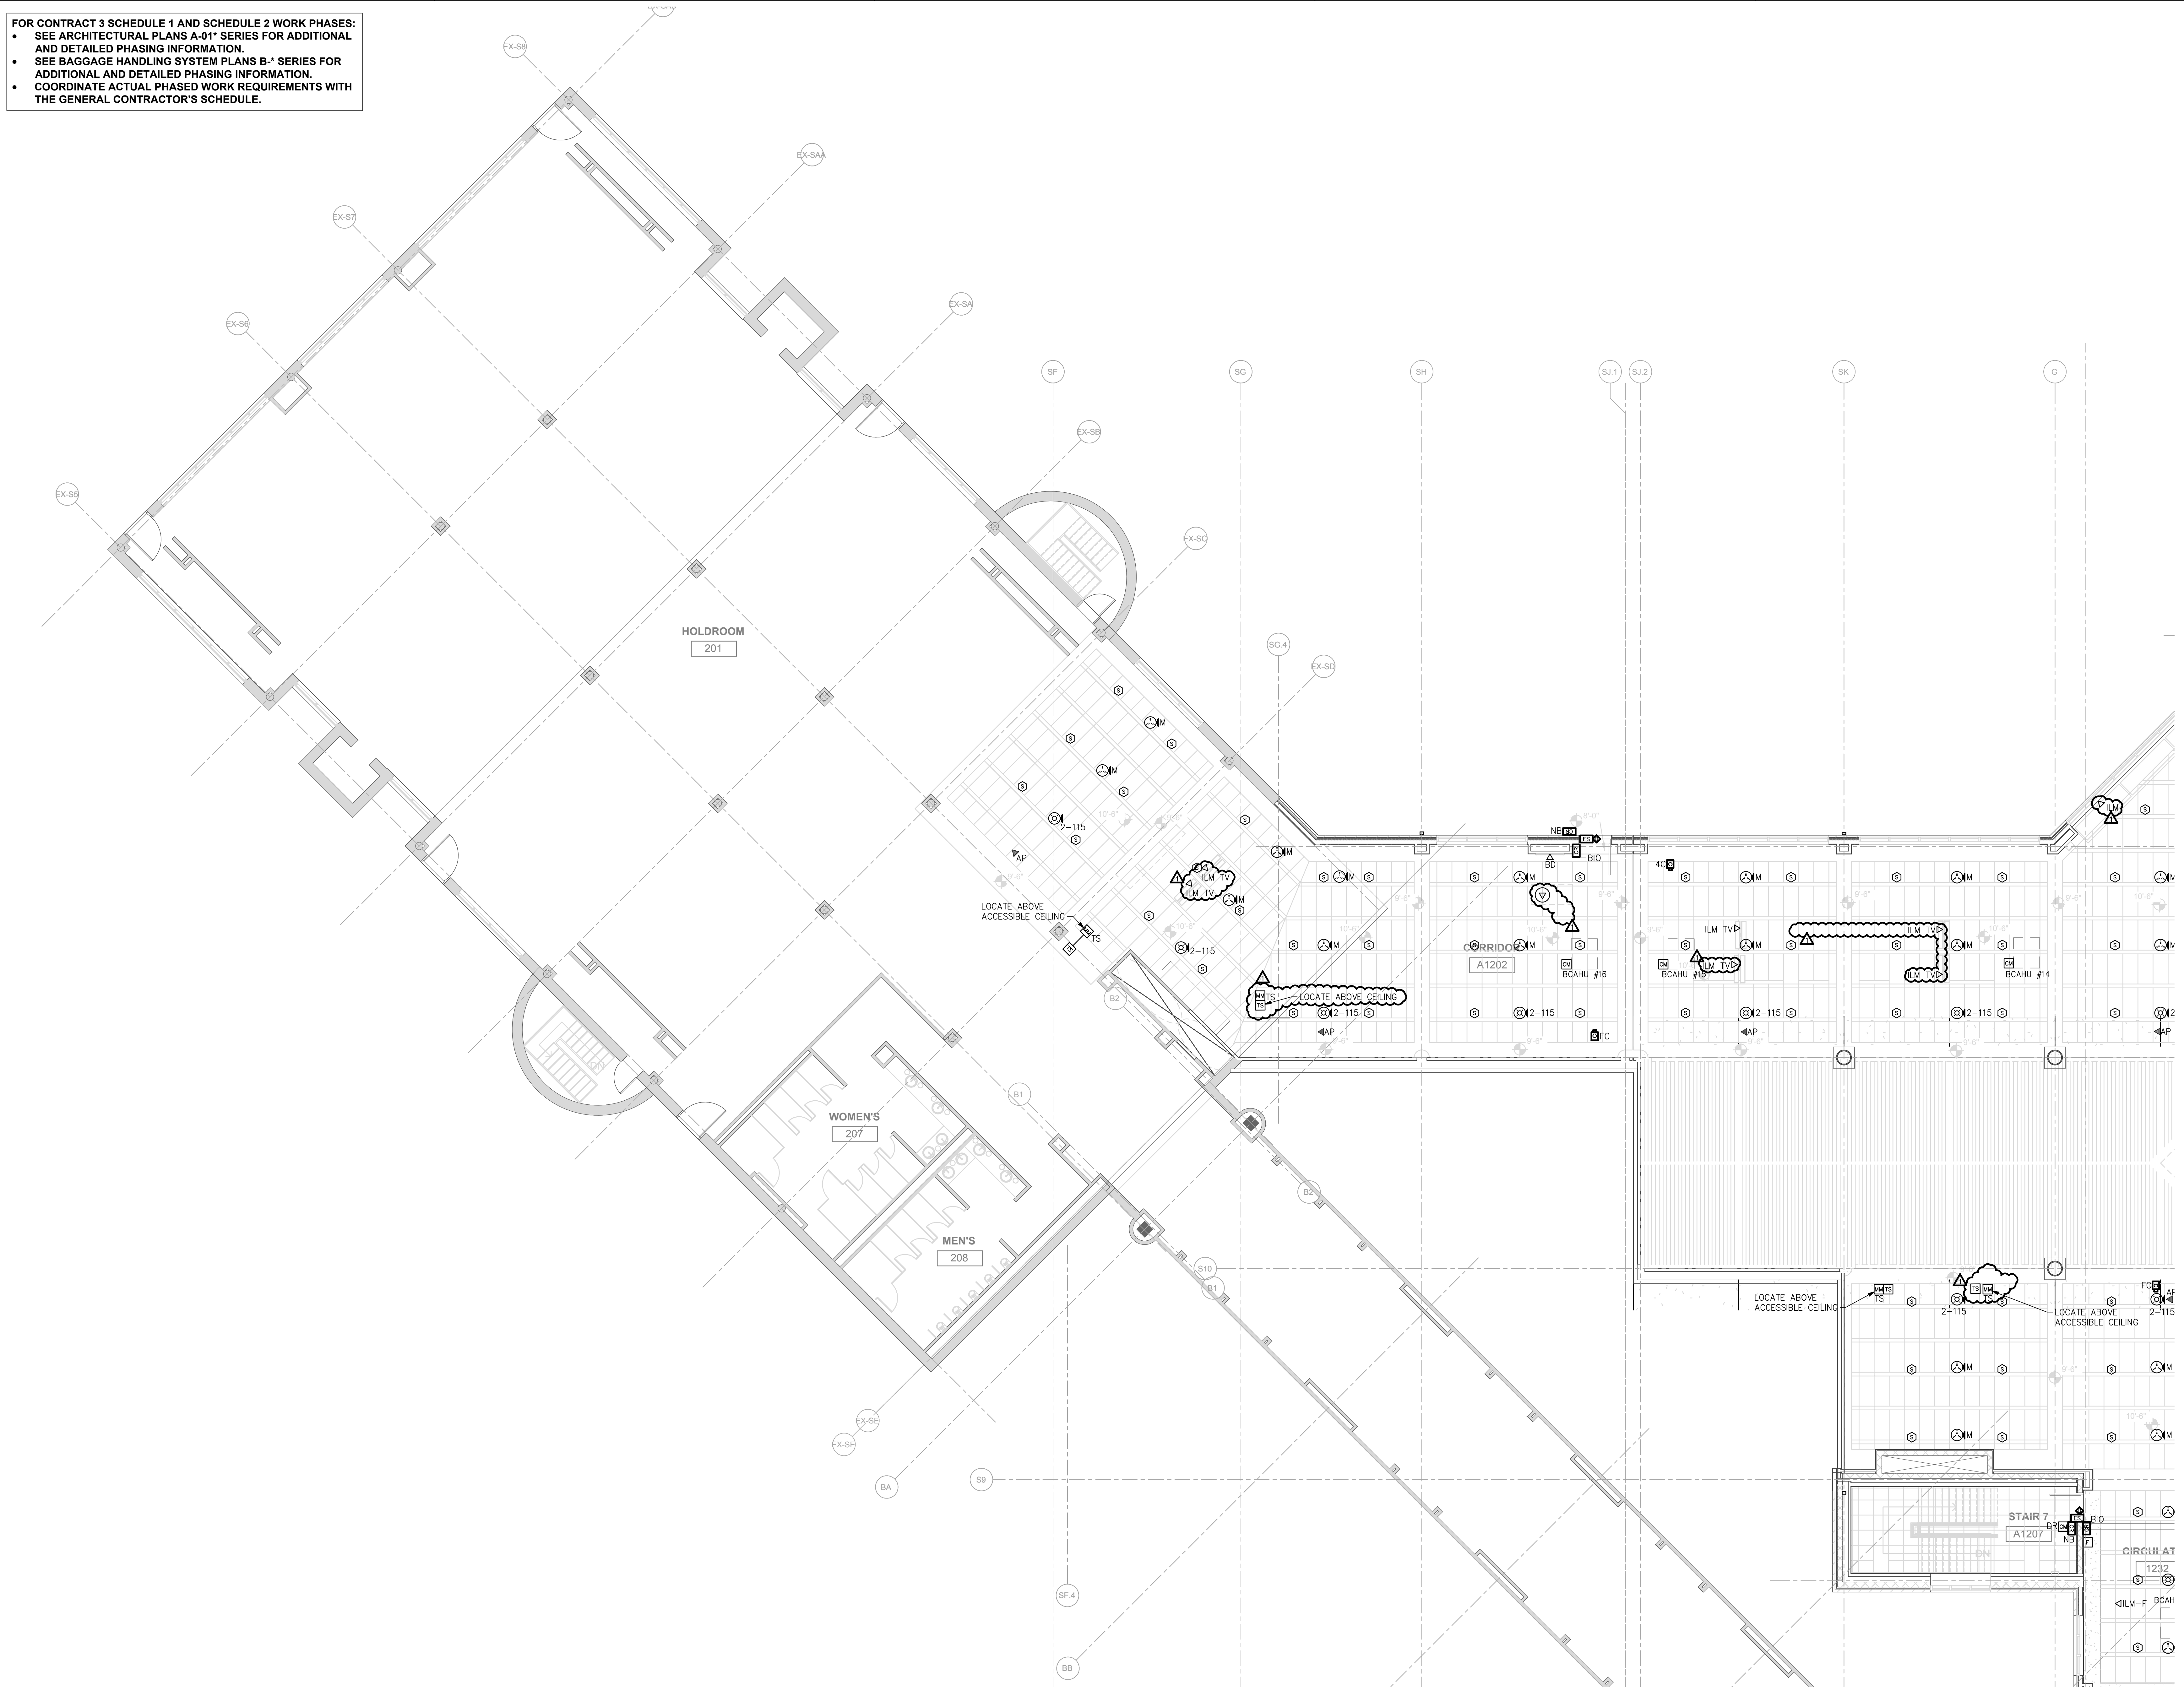

**SCHEDULE 1 - ELECTRICAL BOARDING LEVEL - AUXILIARY SYSTEMS PLAN - ZONE 1**  
 SCALE: 1/8" = 1'-0" GRAPHIC SCALE: 1"=1'-0" TRUE NORTH

FOR CONTRACT 3 SCHEDULE 1 AND SCHEDULE 2 WORK PHASES:

- SEE ARCHITECTURAL PLANS A-01\* SERIES FOR ADDITIONAL AND DETAILED PHASING INFORMATION.
- SEE BAGGAGE HANDLING SYSTEM PLANS B-\* SERIES FOR ADDITIONAL AND DETAILED PHASING INFORMATION.
- COORDINATE ACTUAL PHASED WORK REQUIREMENTS WITH THE GENERAL CONTRACTOR'S SCHEDULE.





**TERMINAL IMPROVEMENTS CONTRACT 3**

Wilmington International Airport  
1740 Airport Boulevard, Suite 12  
Wilmington, NC 28405

**CHEATHAM & ASSOCIATES, P.A.**  
CONSULTING ENGINEERS  
3412 ENTERPRISE DRIVE  
WILMINGTON, NORTH CAROLINA 28405  
PHONE: (919) 452-4210  
FAX: (919) 452-4211  
OFFICE@CHEATHAM.PA.COM  
NC LICENSE# C-1673

JOB # 19005

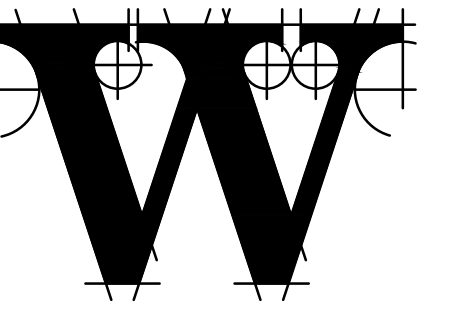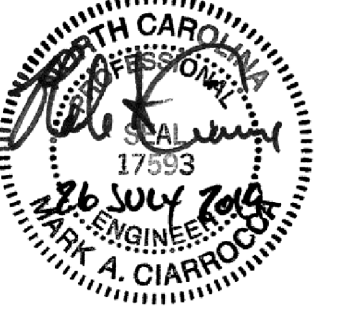

**THE WILSON GROUP - ARCHITECTS -**

PO Box 5510 Charlotte, NC 28289  
704-331-9747 • www.twgarchitects.com

PROJECT MANAGER & CIVIL ENGINEER  
**TALBERT & BRIGHT**  
CONSULTING ARCHITECT  
LS3P

STRUCTURAL ENGINEER  
**STEWART**


FP/PM/E ENGINEER  
**CHEATHAM & ASSOC.**

BAGGAGE HANDLING CONSULTANTS  
**BNP**

AIRCRAFT SUPPORT SYSTEMS  
**DK CONSULTANTS**

SPECIALTY LIGHTING CONSULTANT  
**HARTRANFT**

SIGNAGE & WAYFINDING  
**TAKEFORM**

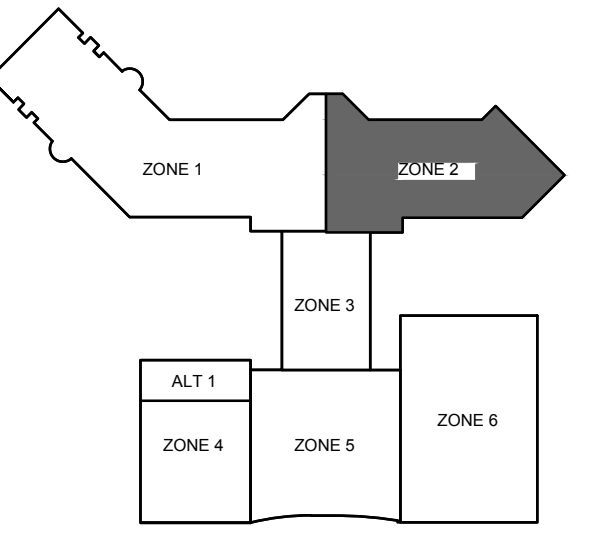

**KEY PLAN**

COPYRIGHT © 2019  
THE WILSON GROUP ARCHITECTS  
ALL RIGHTS RESERVED

PRINTED OR ELECTRONIC DRAWINGS AND DOCUMENTATION MAY NOT BE REPRODUCED IN ANY FORM WITHOUT WRITTEN PERMISSION FROM THE WILSON GROUP ARCHITECTS


**REVISIONS**

AD-03 07/26/2019

DATE 06/28/19  
PROJECT NUMBER 9202-000  
SHEET TITLE

**SCHEDULE 1 - ELECTRICAL BOARDING LEVEL - AUXILIARY SYSTEMS PLAN ZONE 2**  
SHEET NUMBER

**E1-162**

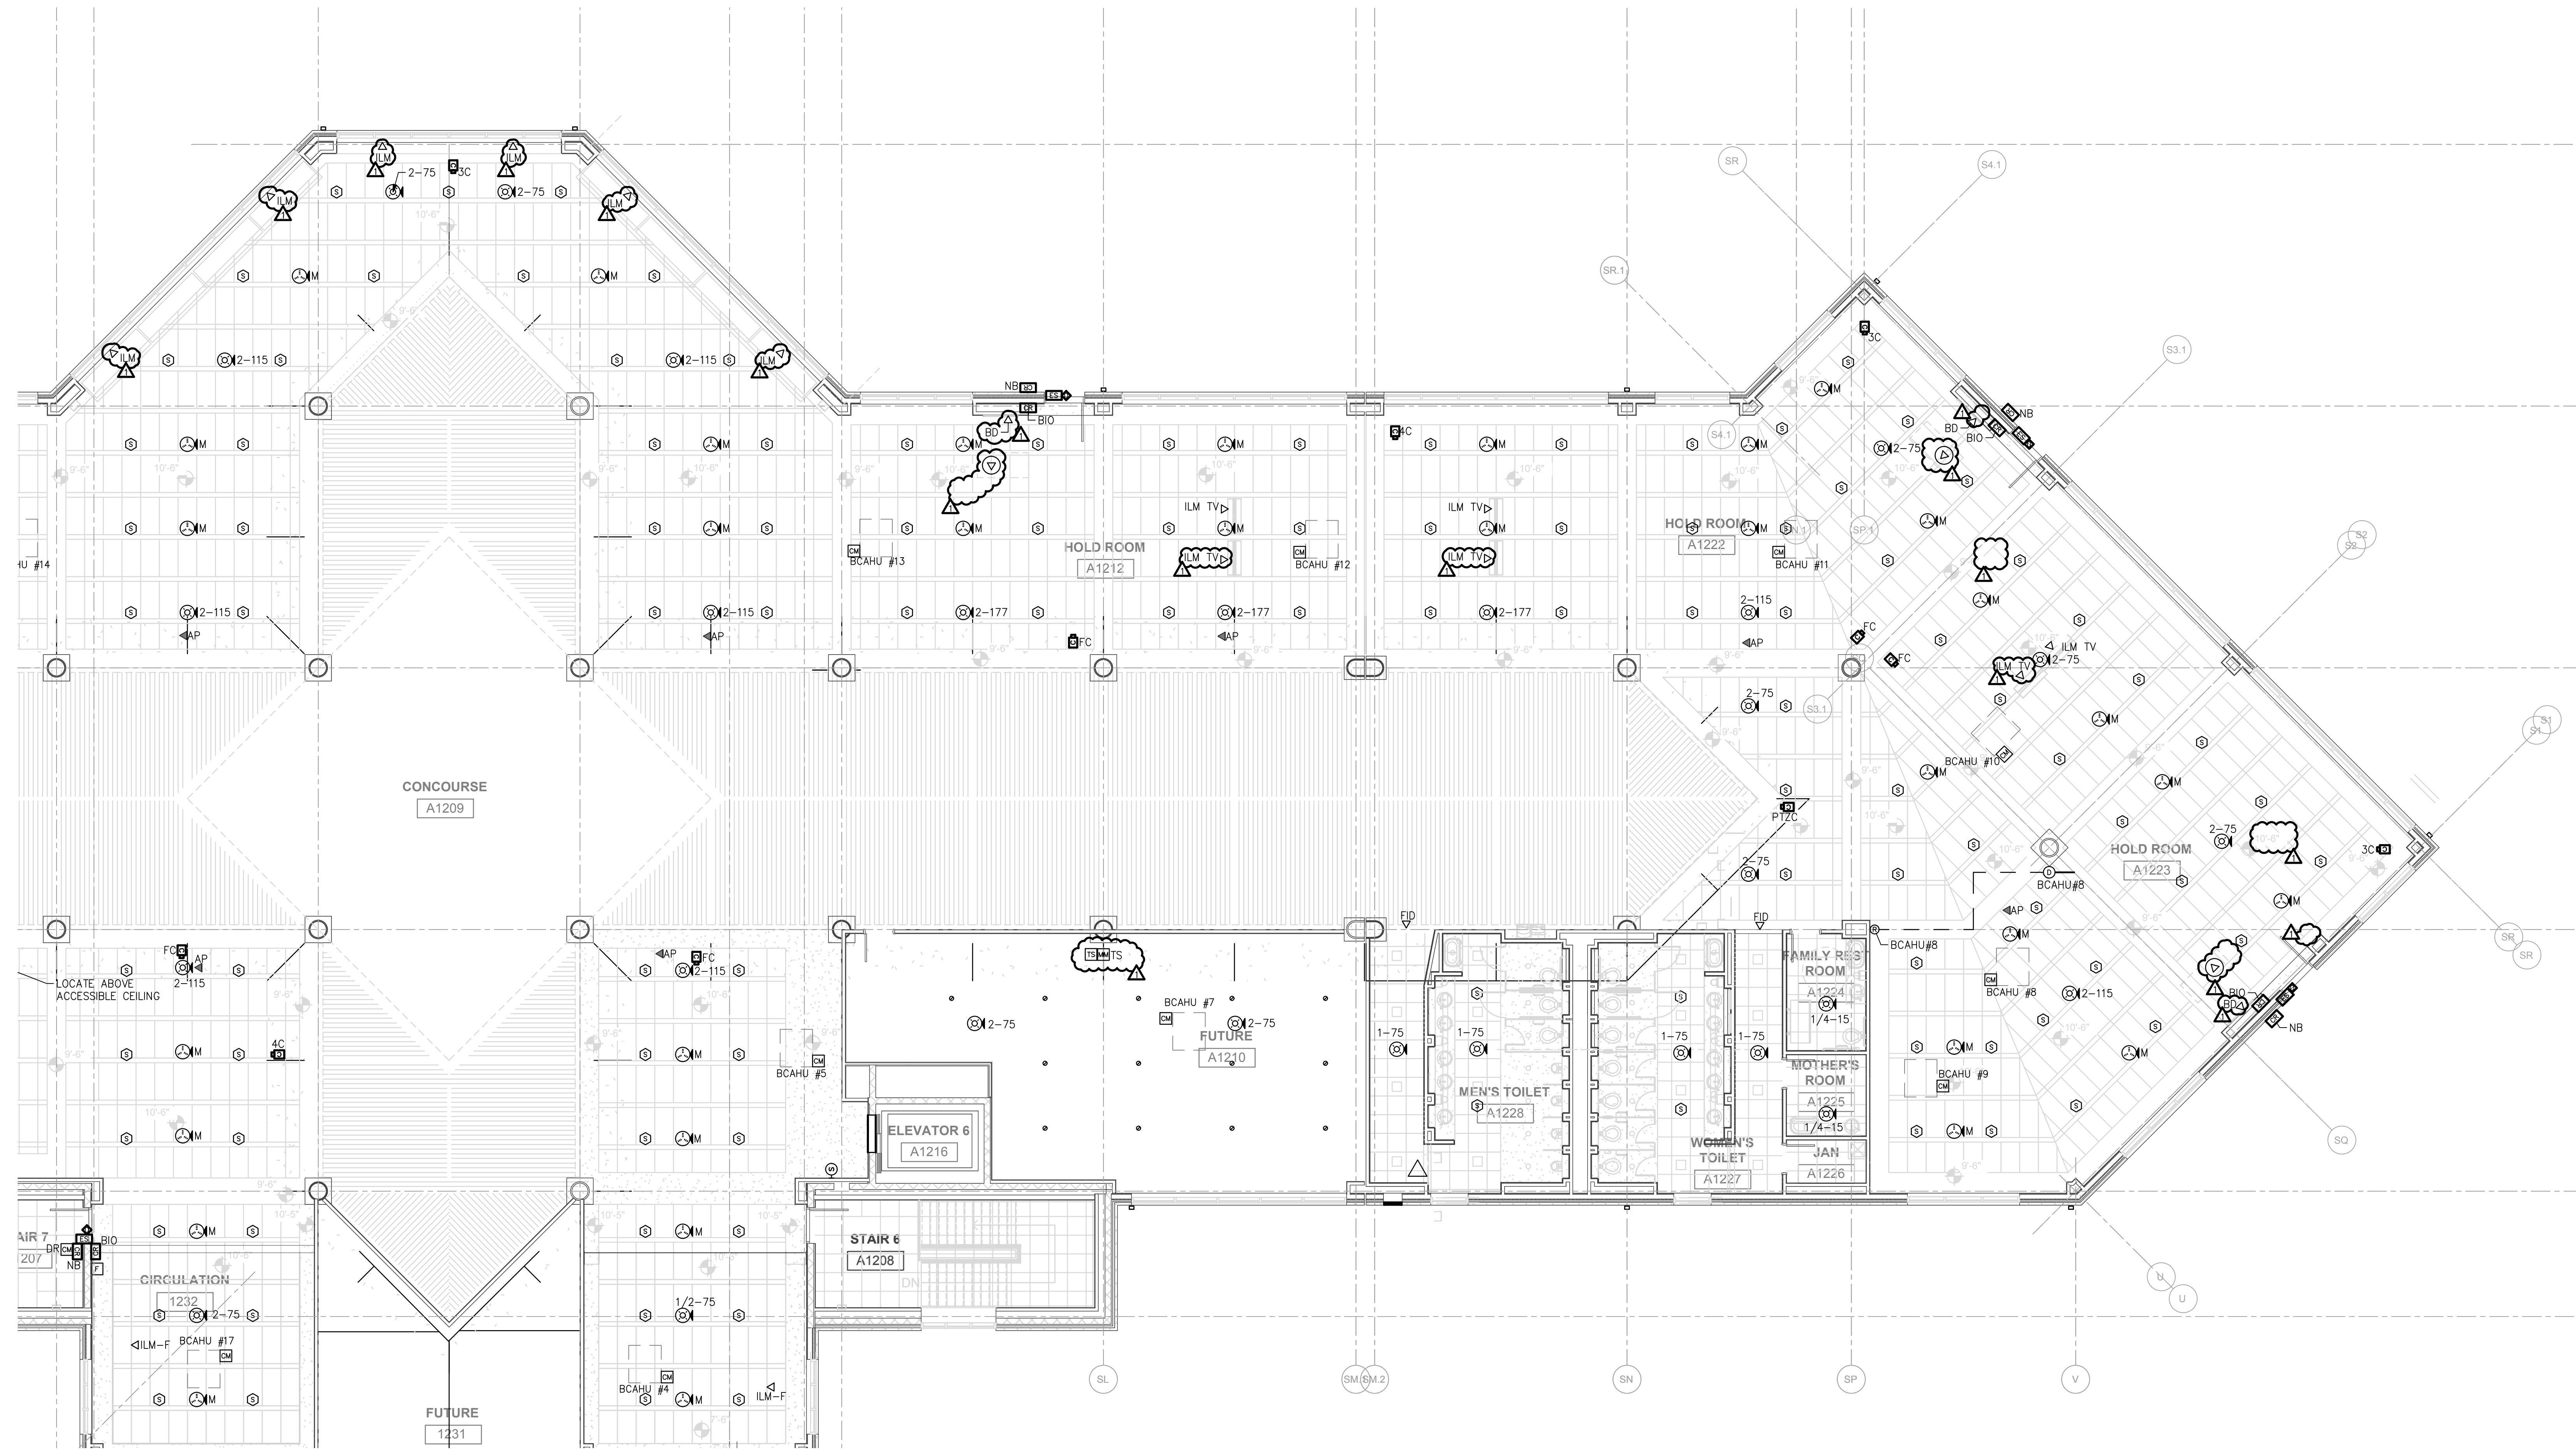

**SCHEDULE 1 - ELECTRICAL BOARDING LEVEL - AUXILIARY SYSTEMS PLAN - ZONE 2**  
SCALE: 1/8" = 1'-0"  
GRAPHIC SCALE: 1" = 1'-0"



FOR CONTRACT 3 SCHEDULE 1 AND SCHEDULE 2 WORK PHASES:  
 • SEE ARCHITECTURAL PLANS A-01\* SERIES FOR ADDITIONAL AND DETAILED PHASING INFORMATION.  
 • SEE BAGGAGE HANDLING SYSTEM PLANS B-\* SERIES FOR ADDITIONAL AND DETAILED PHASING INFORMATION.  
 • COORDINATE ACTUAL PHASED WORK REQUIREMENTS WITH THE GENERAL CONTRACTOR'S SCHEDULE.





**TERMINAL IMPROVEMENTS CONTRACT 3**

Wilmington International Airport  
 1740 Airport Boulevard, Suite 12  
 Wilmington, NC 28405

**CHEATHAM & ASSOCIATES, P.A.**  
 CONSULTING ENGINEERS  
 3412 ENTERPRISE DRIVE  
 WILMINGTON, NORTH CAROLINA 28405  
 PHONE: (910) 452-4210  
 FAX: (910) 452-4211  
 OFFICE@CHEATHAMPA.COM  
 NC LICENSE# C-1073

JOB # 19005

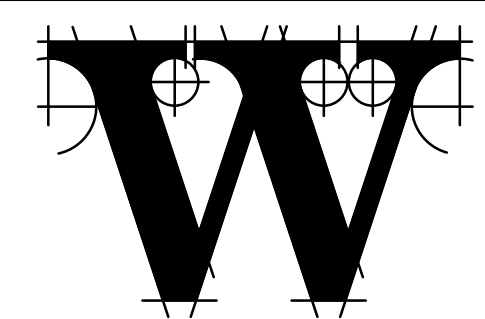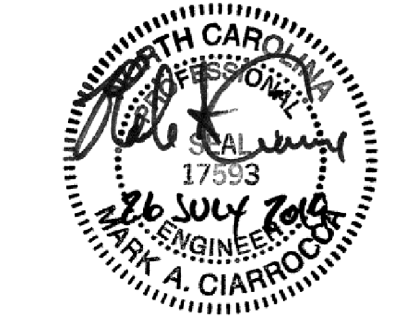

**THE WILSON GROUP ARCHITECTS**

PO Box 5510 Charlotte, NC 28299  
 704-331-9747 • www.twgarchitects.com

PROJECT MANAGER & CIVIL ENGINEER  
**TALBERT & BRIGHT**

CONSULTING ARCHITECT  
 LS3P

STRUCTURAL ENGINEER  
 STEWART


FP/PM/E ENGINEER  
**CHEATHAM & ASSOC.**

BAGGAGE HANDLING CONSULTANTS  
 BNP

AIRCRAFT SUPPORT SYSTEMS  
 DK CONSULTANTS

SPECIALTY LIGHTING CONSULTANT  
 HARTRANFT

SIGNAGE & WAYFINDING  
 TAKEFORM

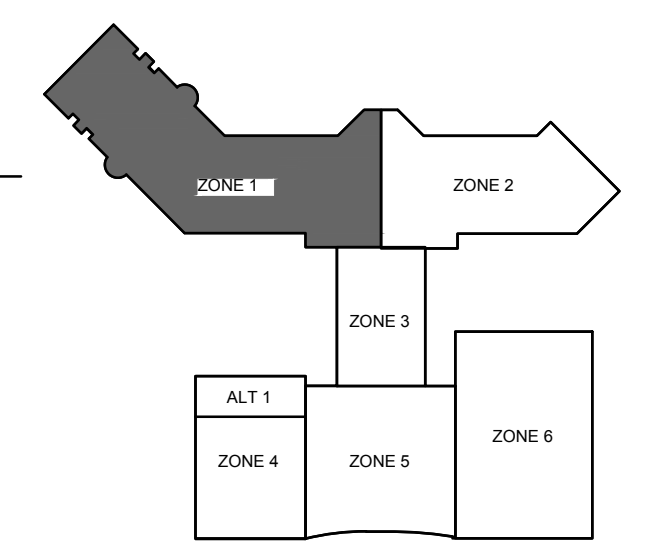

**KEY PLAN**

COPYRIGHT © 2019  
 THE WILSON GROUP ARCHITECTS  
 ALL RIGHTS RESERVED

PRINTED OR ELECTRONIC DRAWINGS AND DOCUMENTATION MAY NOT BE REPRODUCED IN ANY FORM WITHOUT WRITTEN PERMISSION FROM THE WILSON GROUP ARCHITECTS


**REVISIONS**

AD-03 07/26/2019

DATE 06/28/19  
 PROJECT NUMBER 9202-000  
 SHEET TITLE



**SCHEDULE 2 - ELECTRICAL RAMP LEVEL POWER PLAN ZONE 1**  
 SHEET NUMBER

**E2-111**

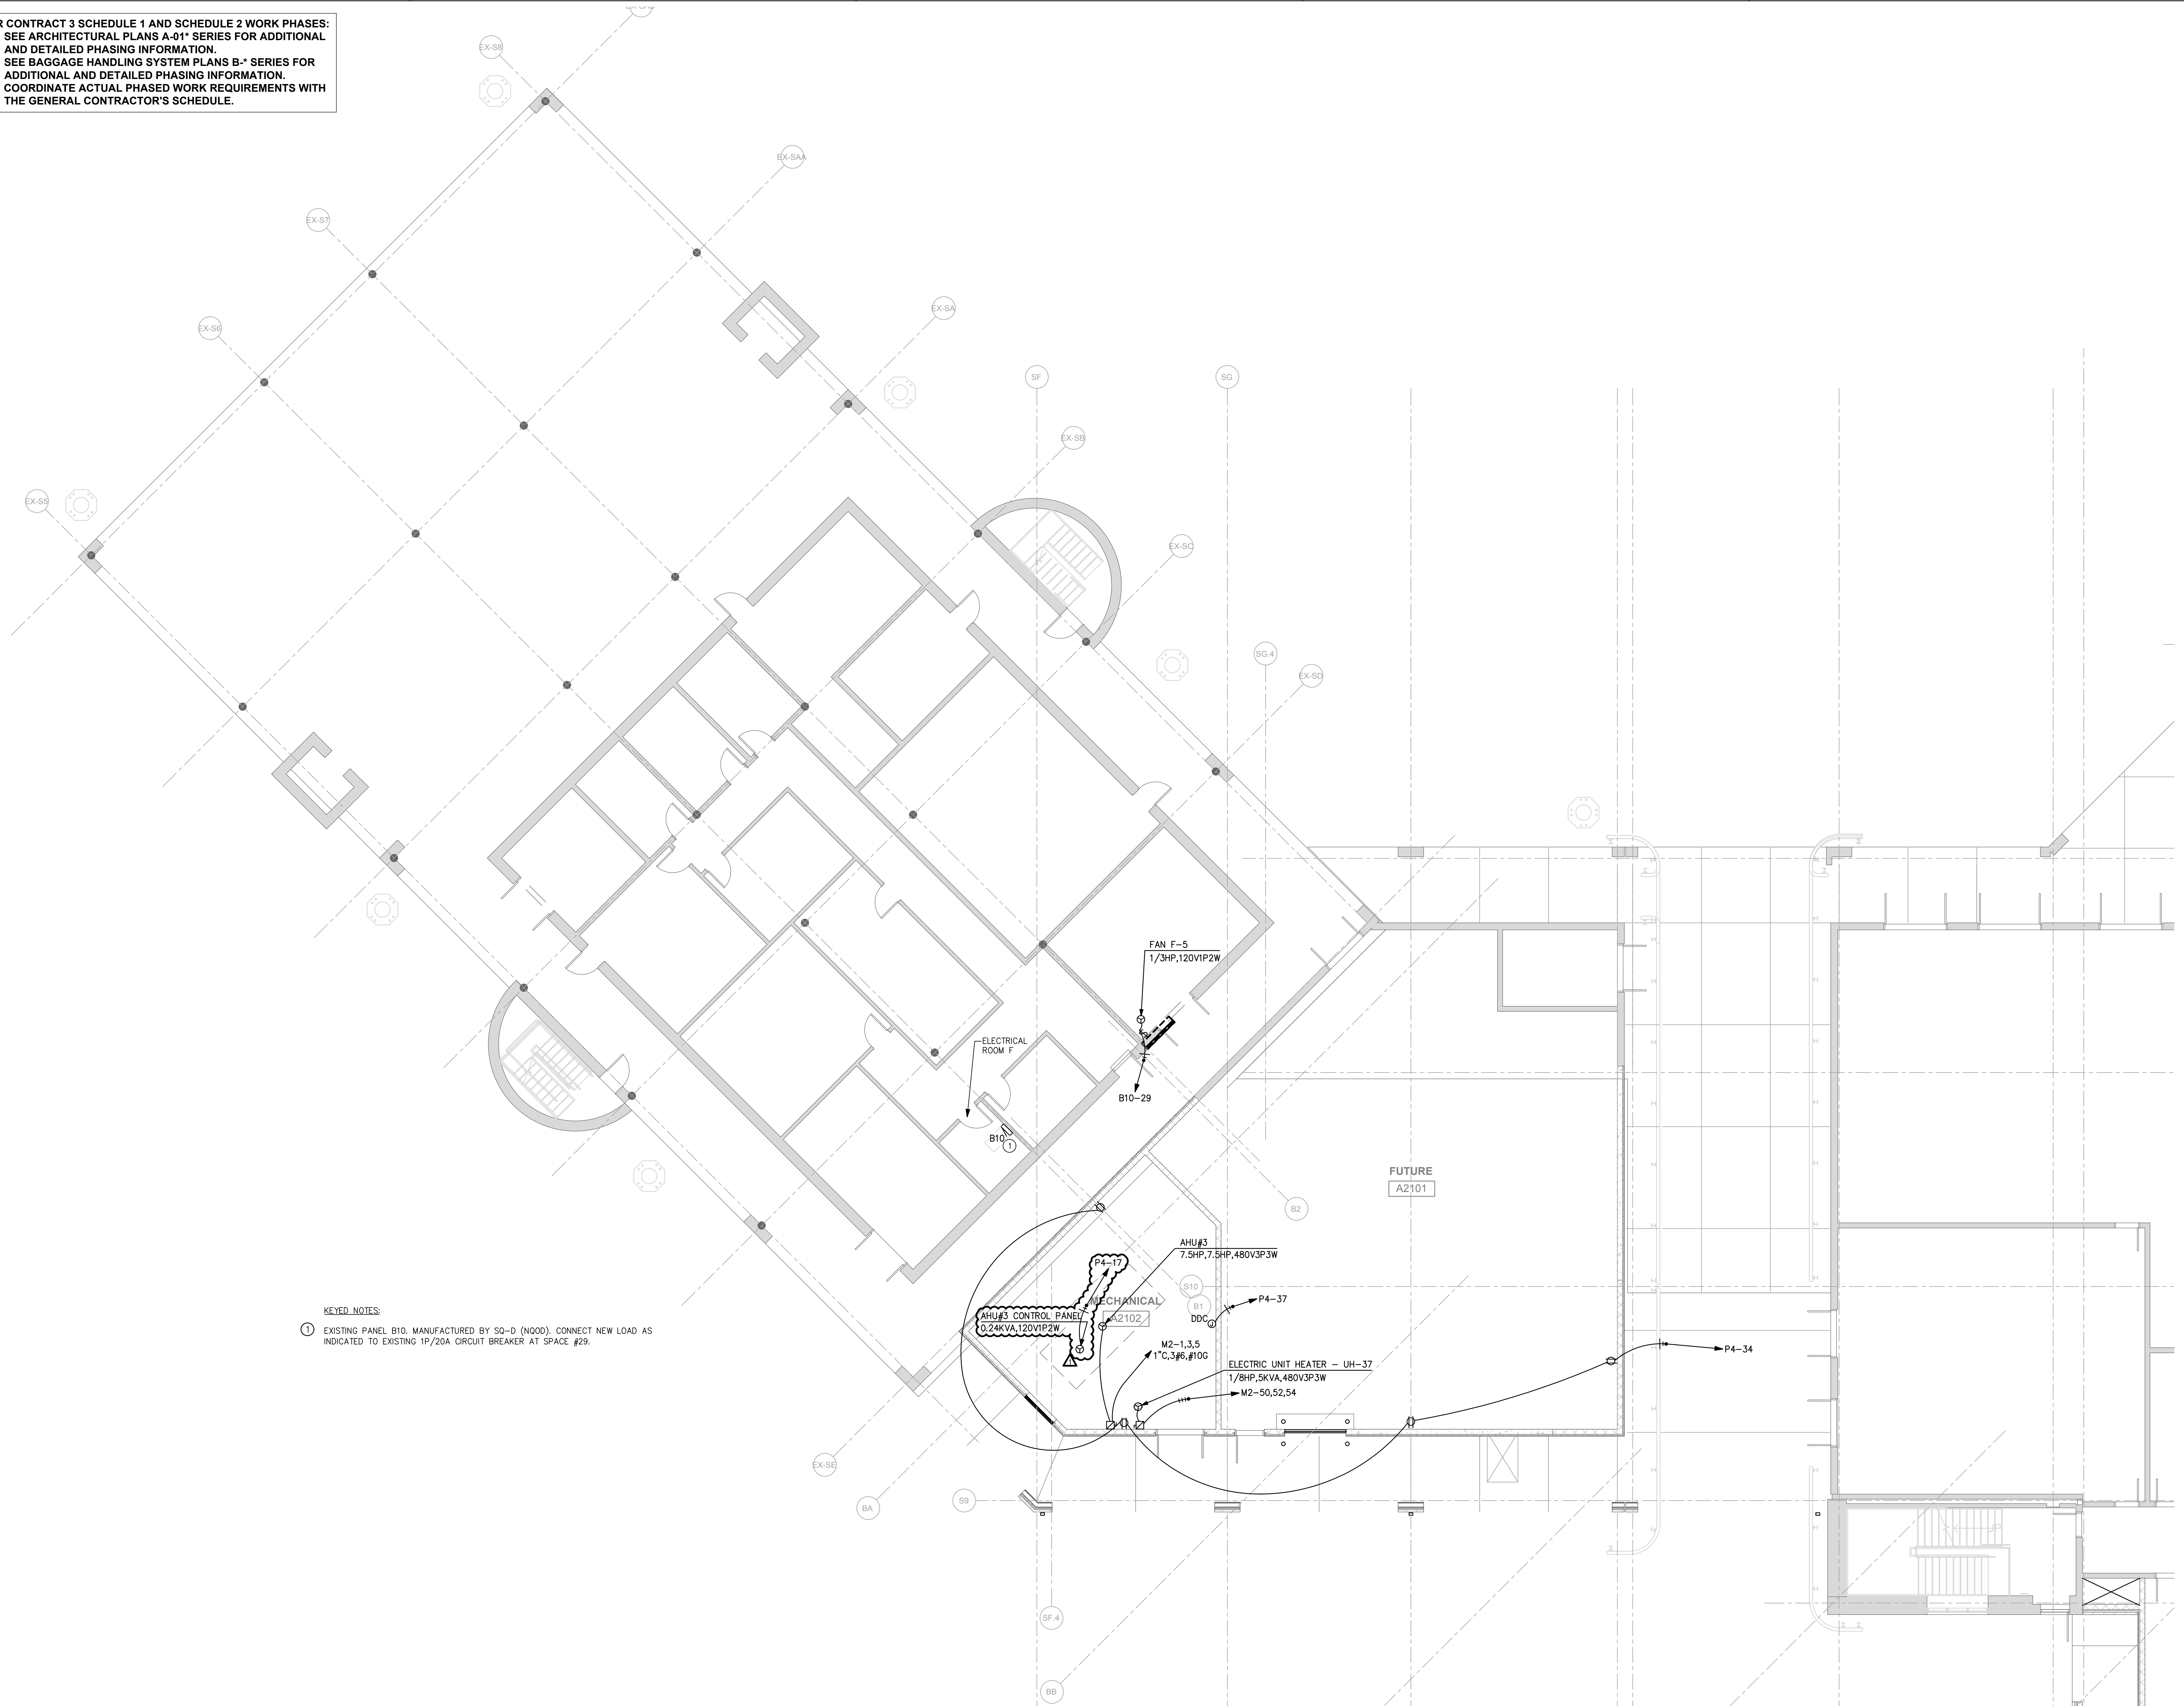

**KEYED NOTES:**  
 ① EXISTING PANEL B10, MANUFACTURED BY SQ-D (NOOD), CONNECT NEW LOAD AS INDICATED TO EXISTING 1P/20A CIRCUIT BREAKER AT SPACE #29.

**SCHEDULE 2 - ELECTRICAL RAMP LEVEL - POWER PLAN - ZONE 1**  
 SCALE: 1/8" = 1'-0"

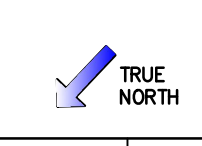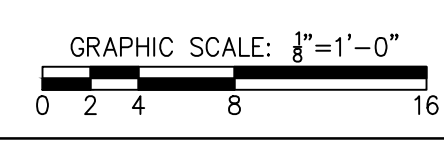

FOR CONTRACT 3 SCHEDULE 1 AND SCHEDULE 2 WORK PHASES:

- SEE ARCHITECTURAL PLANS A-01\* SERIES FOR ADDITIONAL AND DETAILED PHASING INFORMATION.
- SEE BAGGAGE HANDLING SYSTEM PLANS B-\* SERIES FOR ADDITIONAL AND DETAILED PHASING INFORMATION.
- COORDINATE ACTUAL PHASED WORK REQUIREMENTS WITH THE GENERAL CONTRACTOR'S SCHEDULE.





**TERMINAL IMPROVEMENTS CONTRACT 3**

Wilmington International Airport  
1740 Airport Boulevard, Suite 12  
Wilmington, NC 28405

**CHEATHAM & ASSOCIATES, P.A.**  
CONSULTING ENGINEERS  
3412 ENTERPRISE DRIVE  
WILMINGTON, NORTH CAROLINA 28405  
PHONE: (919) 452-4210  
FAX: (919) 452-4211  
OFFICE@CHEATHAMPA.COM  
NC LICENSE# C-1073

JOB # 19005

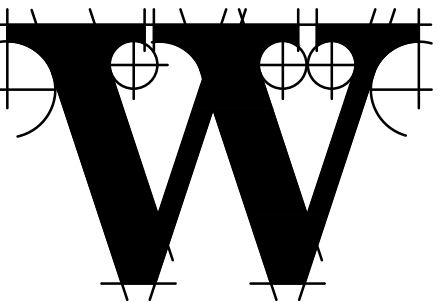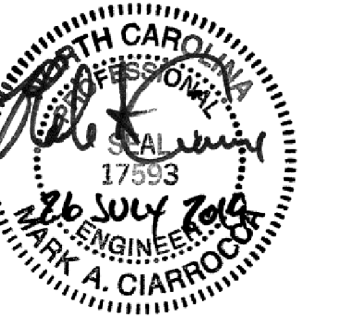

**THE WILSON GROUP**  
- ARCHITECTS -

PO Box 5510 Charlotte, NC 28299  
704-331-9747 • www.twgarchitects.com

PROJECT MANAGER & CIVIL ENGINEER  
**TALBERT & BRIGHT**  
CONSULTING ARCHITECT  
LS3P

STRUCTURAL ENGINEER  
**STEWART**


FPP/ME ENGINEER  
**CHEATHAM & ASSOC.**

BAGGAGE HANDLING CONSULTANTS  
**BNP**

AIRCRAFT SUPPORT SYSTEMS  
**DK CONSULTANTS**

SPECIALTY LIGHTING CONSULTANT  
**HARTRANFT**

SIGNAGE & WAYFINDING  
**TAKEFORM**

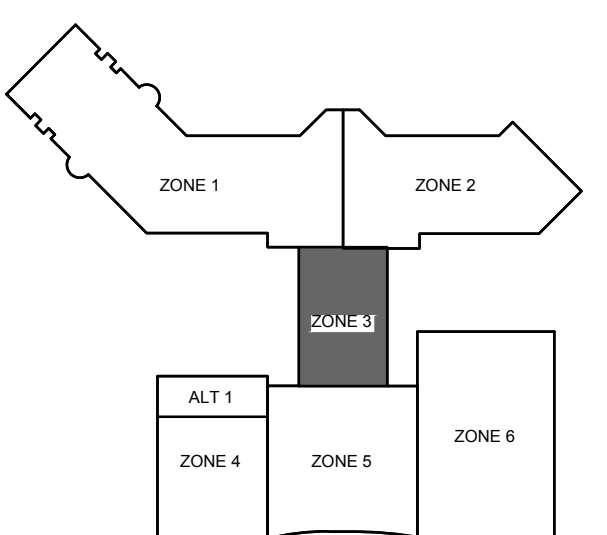



**KEY PLAN**

COPYRIGHT © 2019  
THE WILSON GROUP ARCHITECTS  
ALL RIGHTS RESERVED

PRINTED OR ELECTRONIC DRAWINGS AND DOCUMENTATION MAY NOT BE REPRODUCED IN ANY FORM WITHOUT WRITTEN PERMISSION FROM THE WILSON GROUP ARCHITECTS

**REVISIONS**

AD-03 07/26/2019

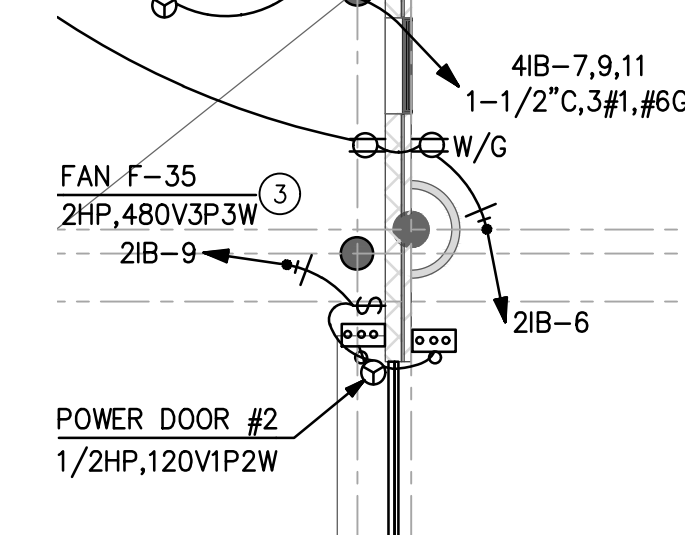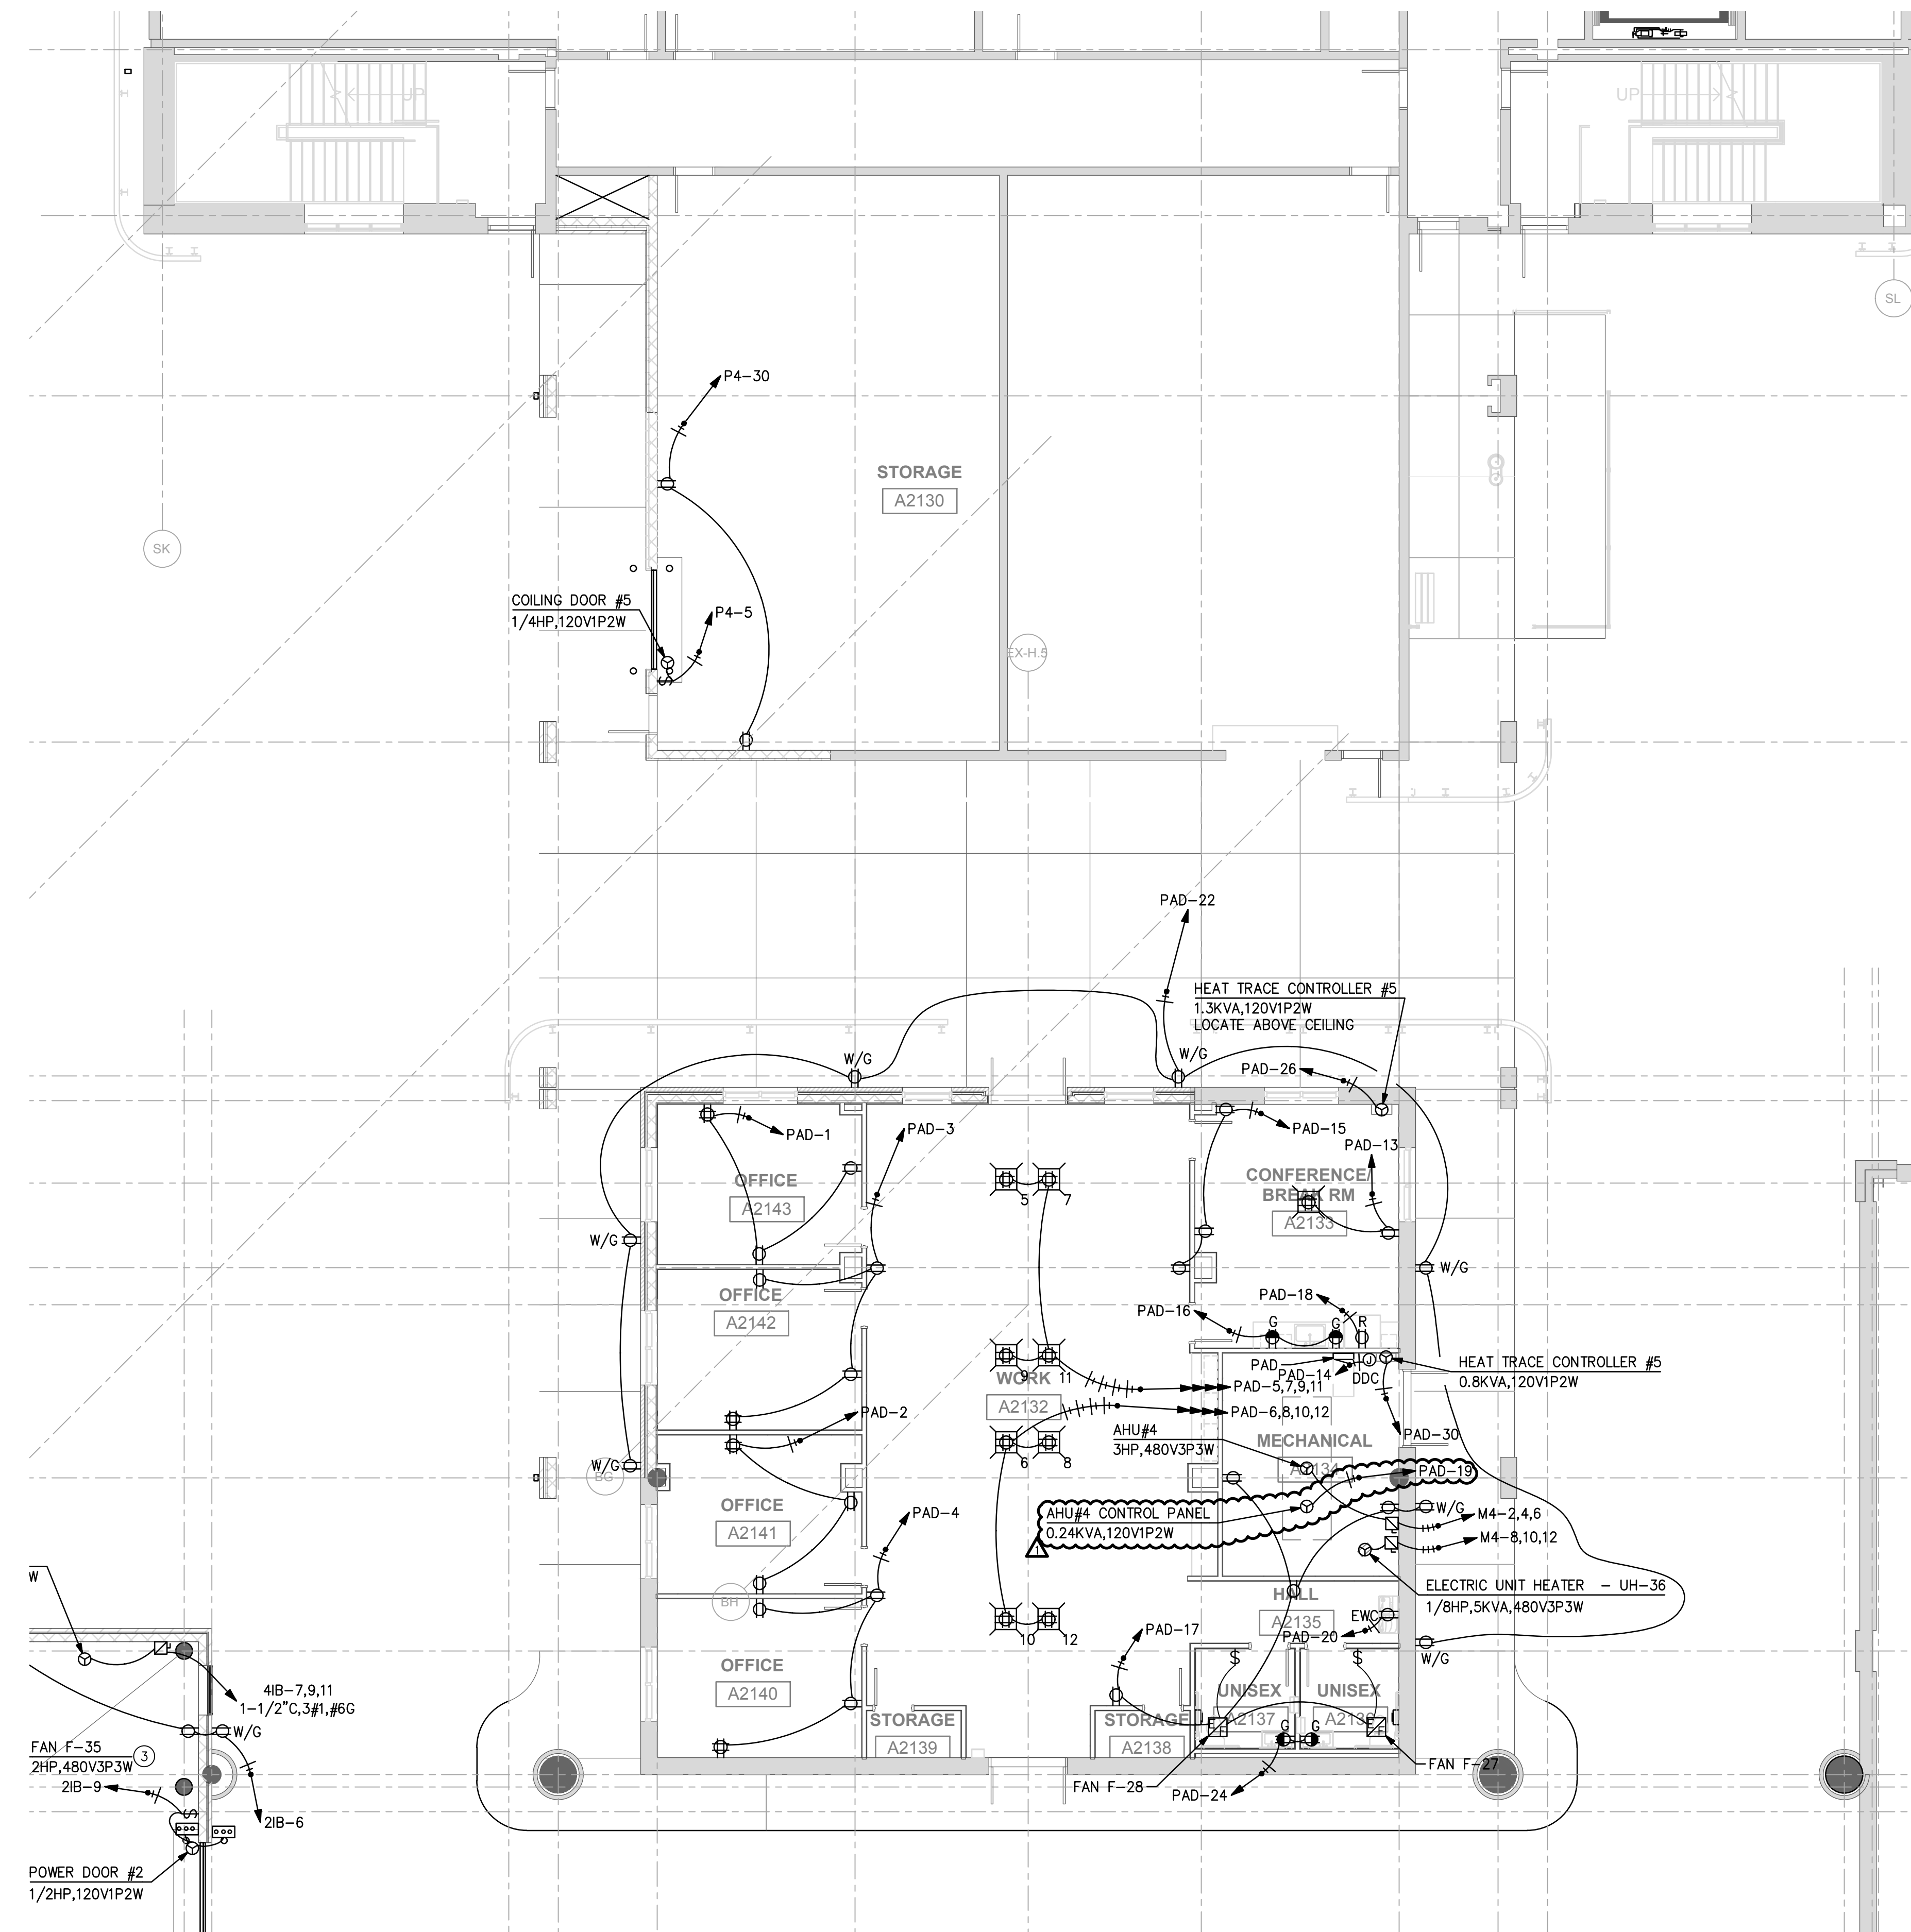

**SCHEDULE 2 - ELECTRICAL RAMP LEVEL - POWER PLAN - ZONE 3**  
SCALE: 1/8" = 1'-0"

GRAPHIC SCALE: 1/8" = 1'-0"  
0 2 4 8 16



DATE 06/28/19  
PROJECT NUMBER 9202-000  
SHEET TITLE

**SCHEDULE 2 - ELECTRICAL RAMP LEVEL POWER PLAN ZONE 3**  
SHEET NUMBER

**E2-113**

FOR CONTRACT 3 SCHEDULE 1 AND SCHEDULE 2 WORK PHASES:  
 • SEE ARCHITECTURAL PLANS A-01\* SERIES FOR ADDITIONAL AND DETAILED PHASING INFORMATION.  
 • SEE BAGGAGE HANDLING SYSTEM PLANS B\* SERIES FOR ADDITIONAL AND DETAILED PHASING INFORMATION.  
 • COORDINATE ACTUAL PHASED WORK REQUIREMENTS WITH THE GENERAL CONTRACTOR'S SCHEDULE.




**TERMINAL IMPROVEMENTS CONTRACT 3**

Wilmington International Airport  
 1740 Airport Boulevard, Suite 12  
 Wilmington, NC 28405

**CHEATHAM & ASSOCIATES, P.A.**  
 CONSULTING ENGINEERS  
 3412 ENTERPRISE DRIVE  
 WILMINGTON, NORTH CAROLINA 28405  
 PHONE: (910) 452-4210  
 FAX: (910) 452-4211  
 OFFICE@CHEATHAMPA.COM  
 NC LICENSE# C-1073

JOB # 19005

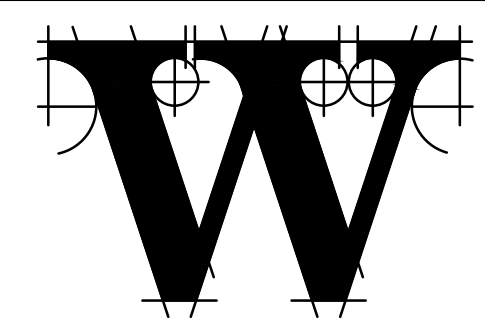

**THE WILSON GROUP ARCHITECTS**

PO Box 5510 Charlotte, NC 28299  
 704-331-9747 • www.twgarchitects.com

PROJECT MANAGER & CIVIL ENGINEER  
**TALBERT & BRIGHT**

CONSULTING ARCHITECT  
**LS3P**

STRUCTURAL ENGINEER  
**STEWART**


FP/PM/E ENGINEER  
**CHEATHAM & ASSOC.**

BAGGAGE HANDLING CONSULTANTS  
**BNP**

AIRCRAFT SUPPORT SYSTEMS  
**DK CONSULTANTS**

SPECIALTY LIGHTING CONSULTANT  
**HARTRANFT**

SIGNAGE & WAYFINDING  
**TAKEFORM**

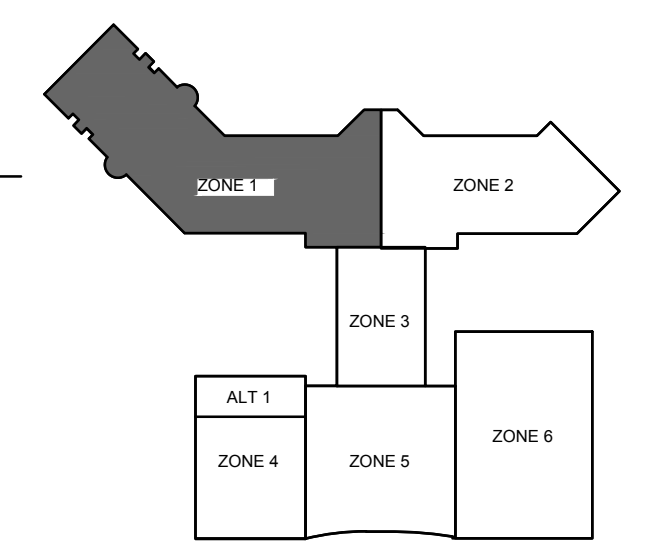

**KEY PLAN**

COPYRIGHT © 2019  
 THE WILSON GROUP ARCHITECTS  
 ALL RIGHTS RESERVED

PRINTED OR ELECTRONIC DRAWINGS AND DOCUMENTATION MAY NOT BE REPRODUCED IN ANY FORM WITHOUT WRITTEN PERMISSION FROM THE WILSON GROUP ARCHITECTS


**REVISIONS**

AD-03 07/26/2019

DATE 06/28/19  
 PROJECT NUMBER 9202-000  
 SHEET TITLE


**SCHEDULE 2 - ELECTRICAL RAMP LEVEL AUXILIARY SYSTEMS PLAN ZONE 1**  
 SHEET NUMBER

**E2-131**


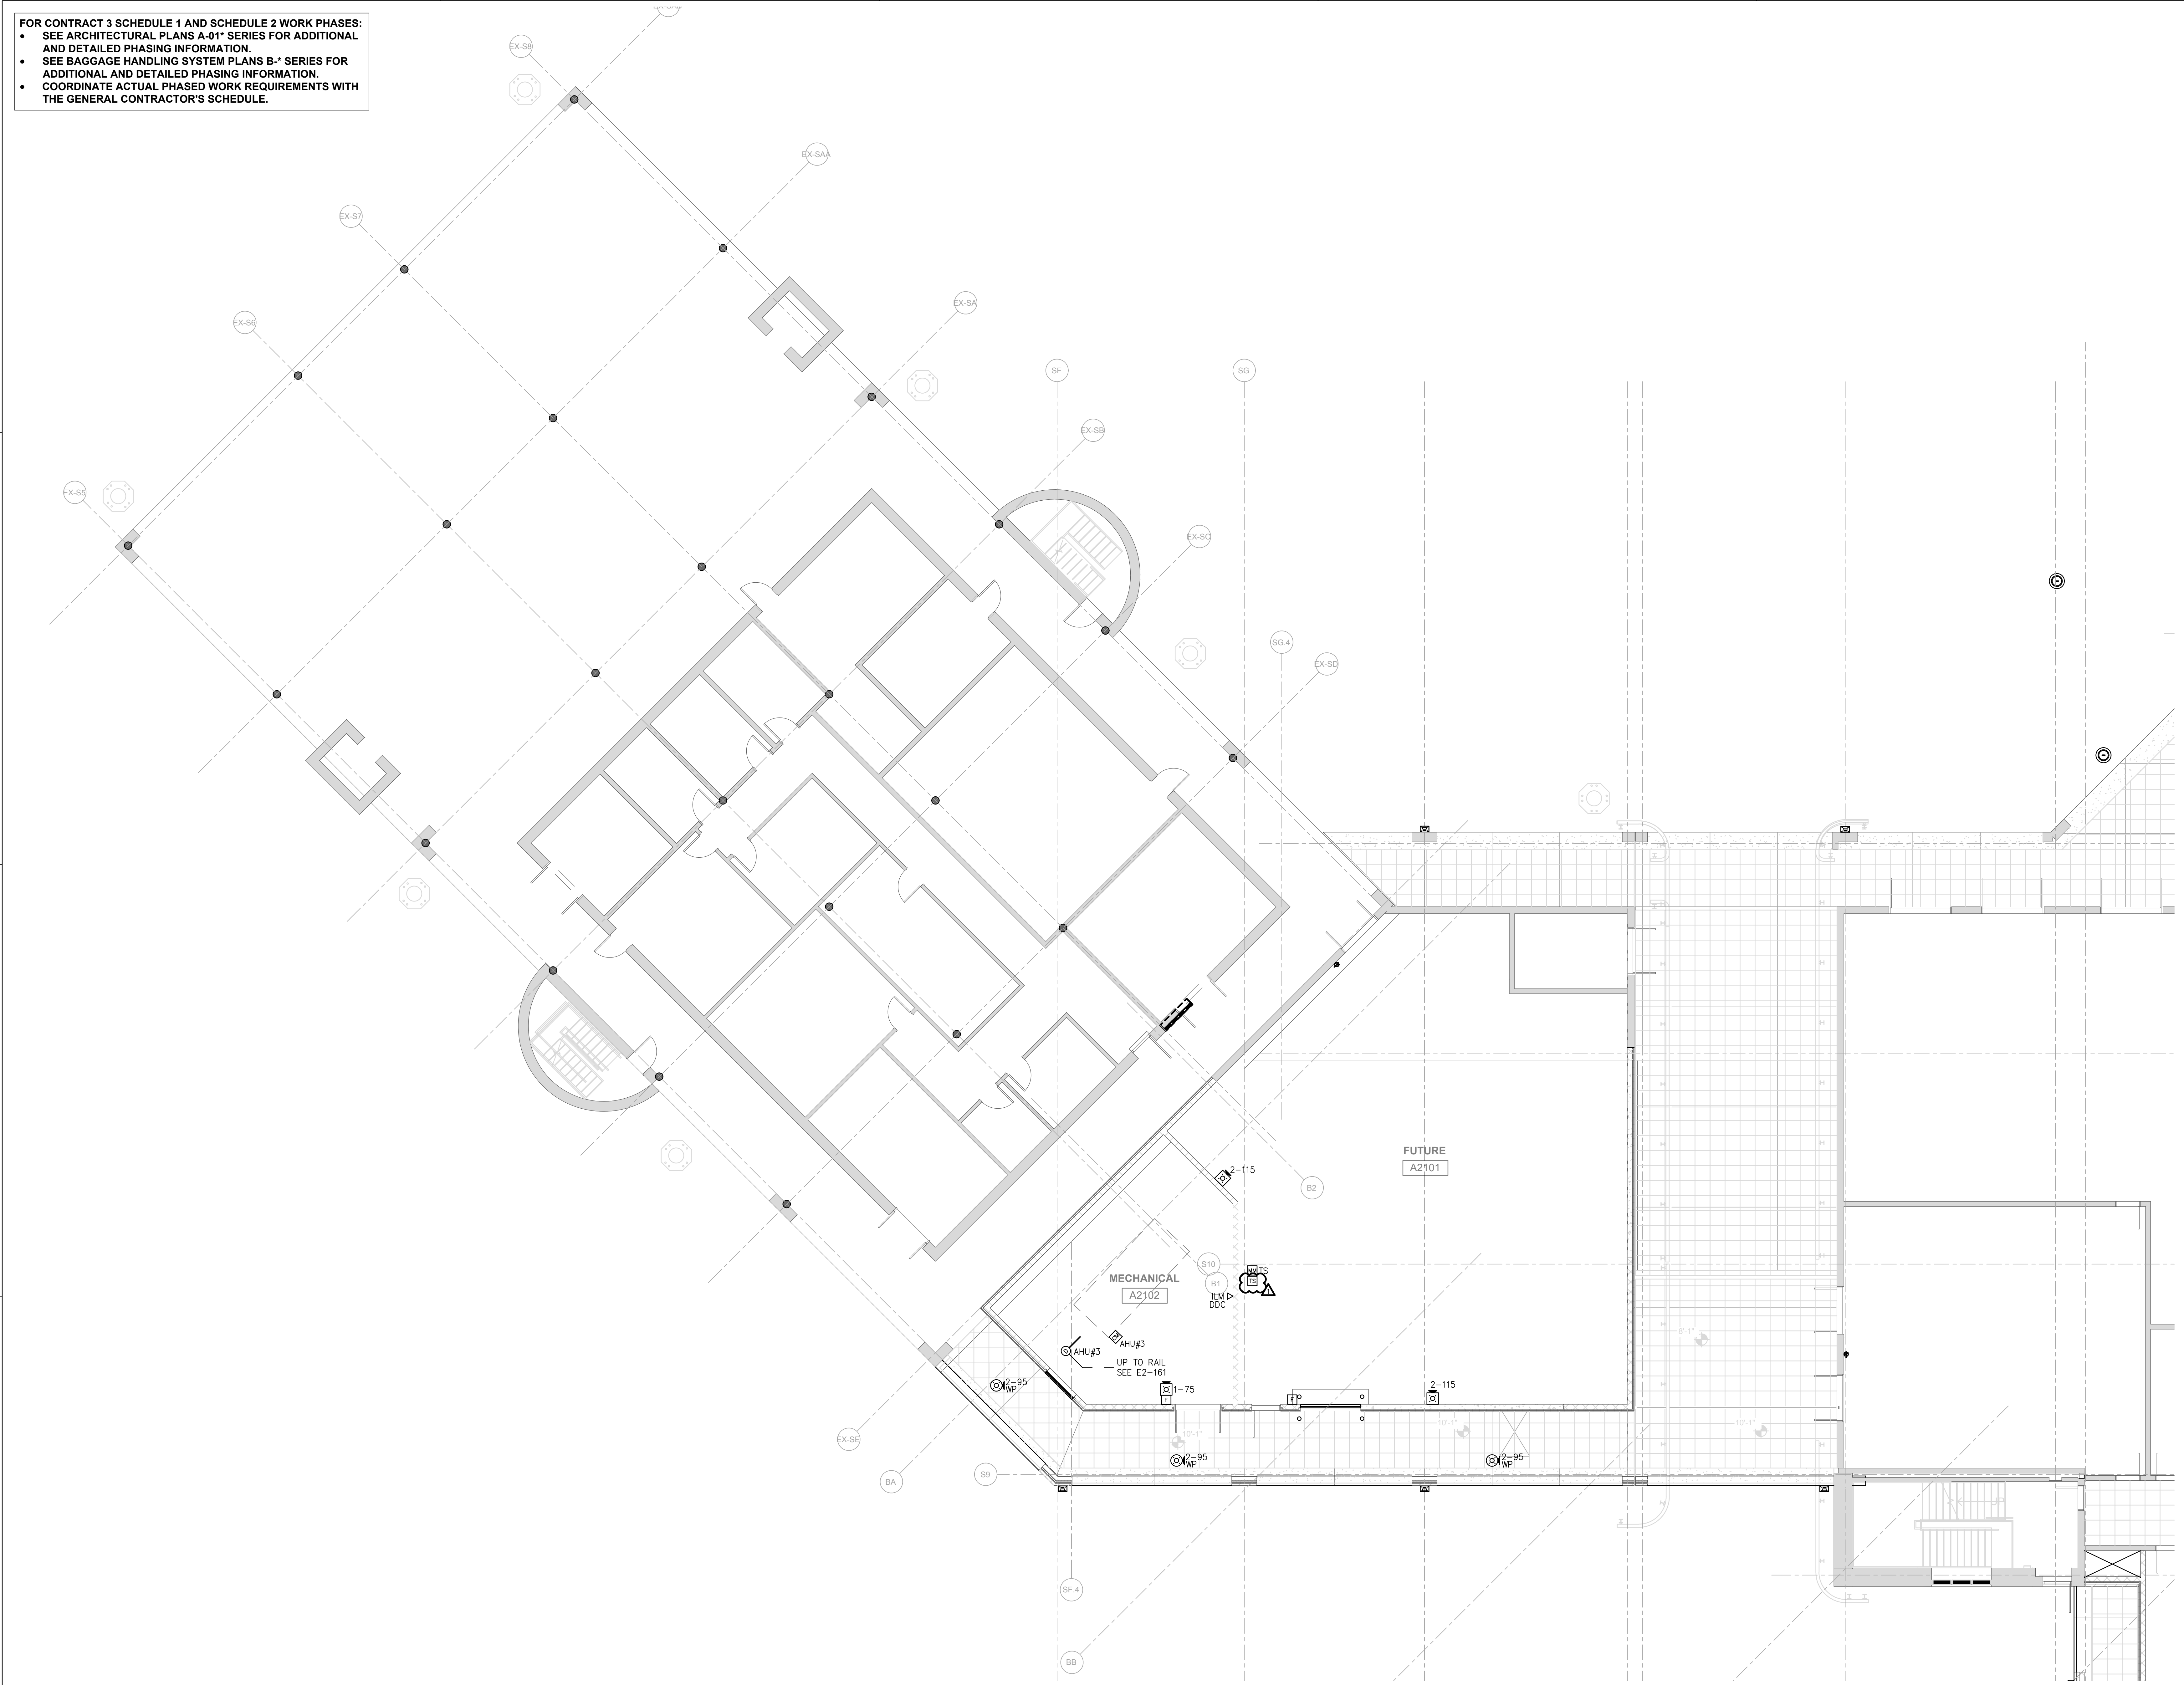


**SCHEDULE 2 - ELECTRICAL RAMP LEVEL - AUXILIARY SYSTEMS PLAN - ZONE 1**  
 SCALE: 1/8" = 1'-0" GRAPHIC SCALE: 1/8" = 1'-0"

FOR CONTRACT 3 SCHEDULE 1 AND SCHEDULE 2 WORK PHASES:  
 • SEE ARCHITECTURAL PLANS A-01\* SERIES FOR ADDITIONAL AND DETAILED PHASING INFORMATION.  
 • SEE BAGGAGE HANDLING SYSTEM PLANS B\* SERIES FOR ADDITIONAL AND DETAILED PHASING INFORMATION.  
 • COORDINATE ACTUAL PHASED WORK REQUIREMENTS WITH THE GENERAL CONTRACTOR'S SCHEDULE.

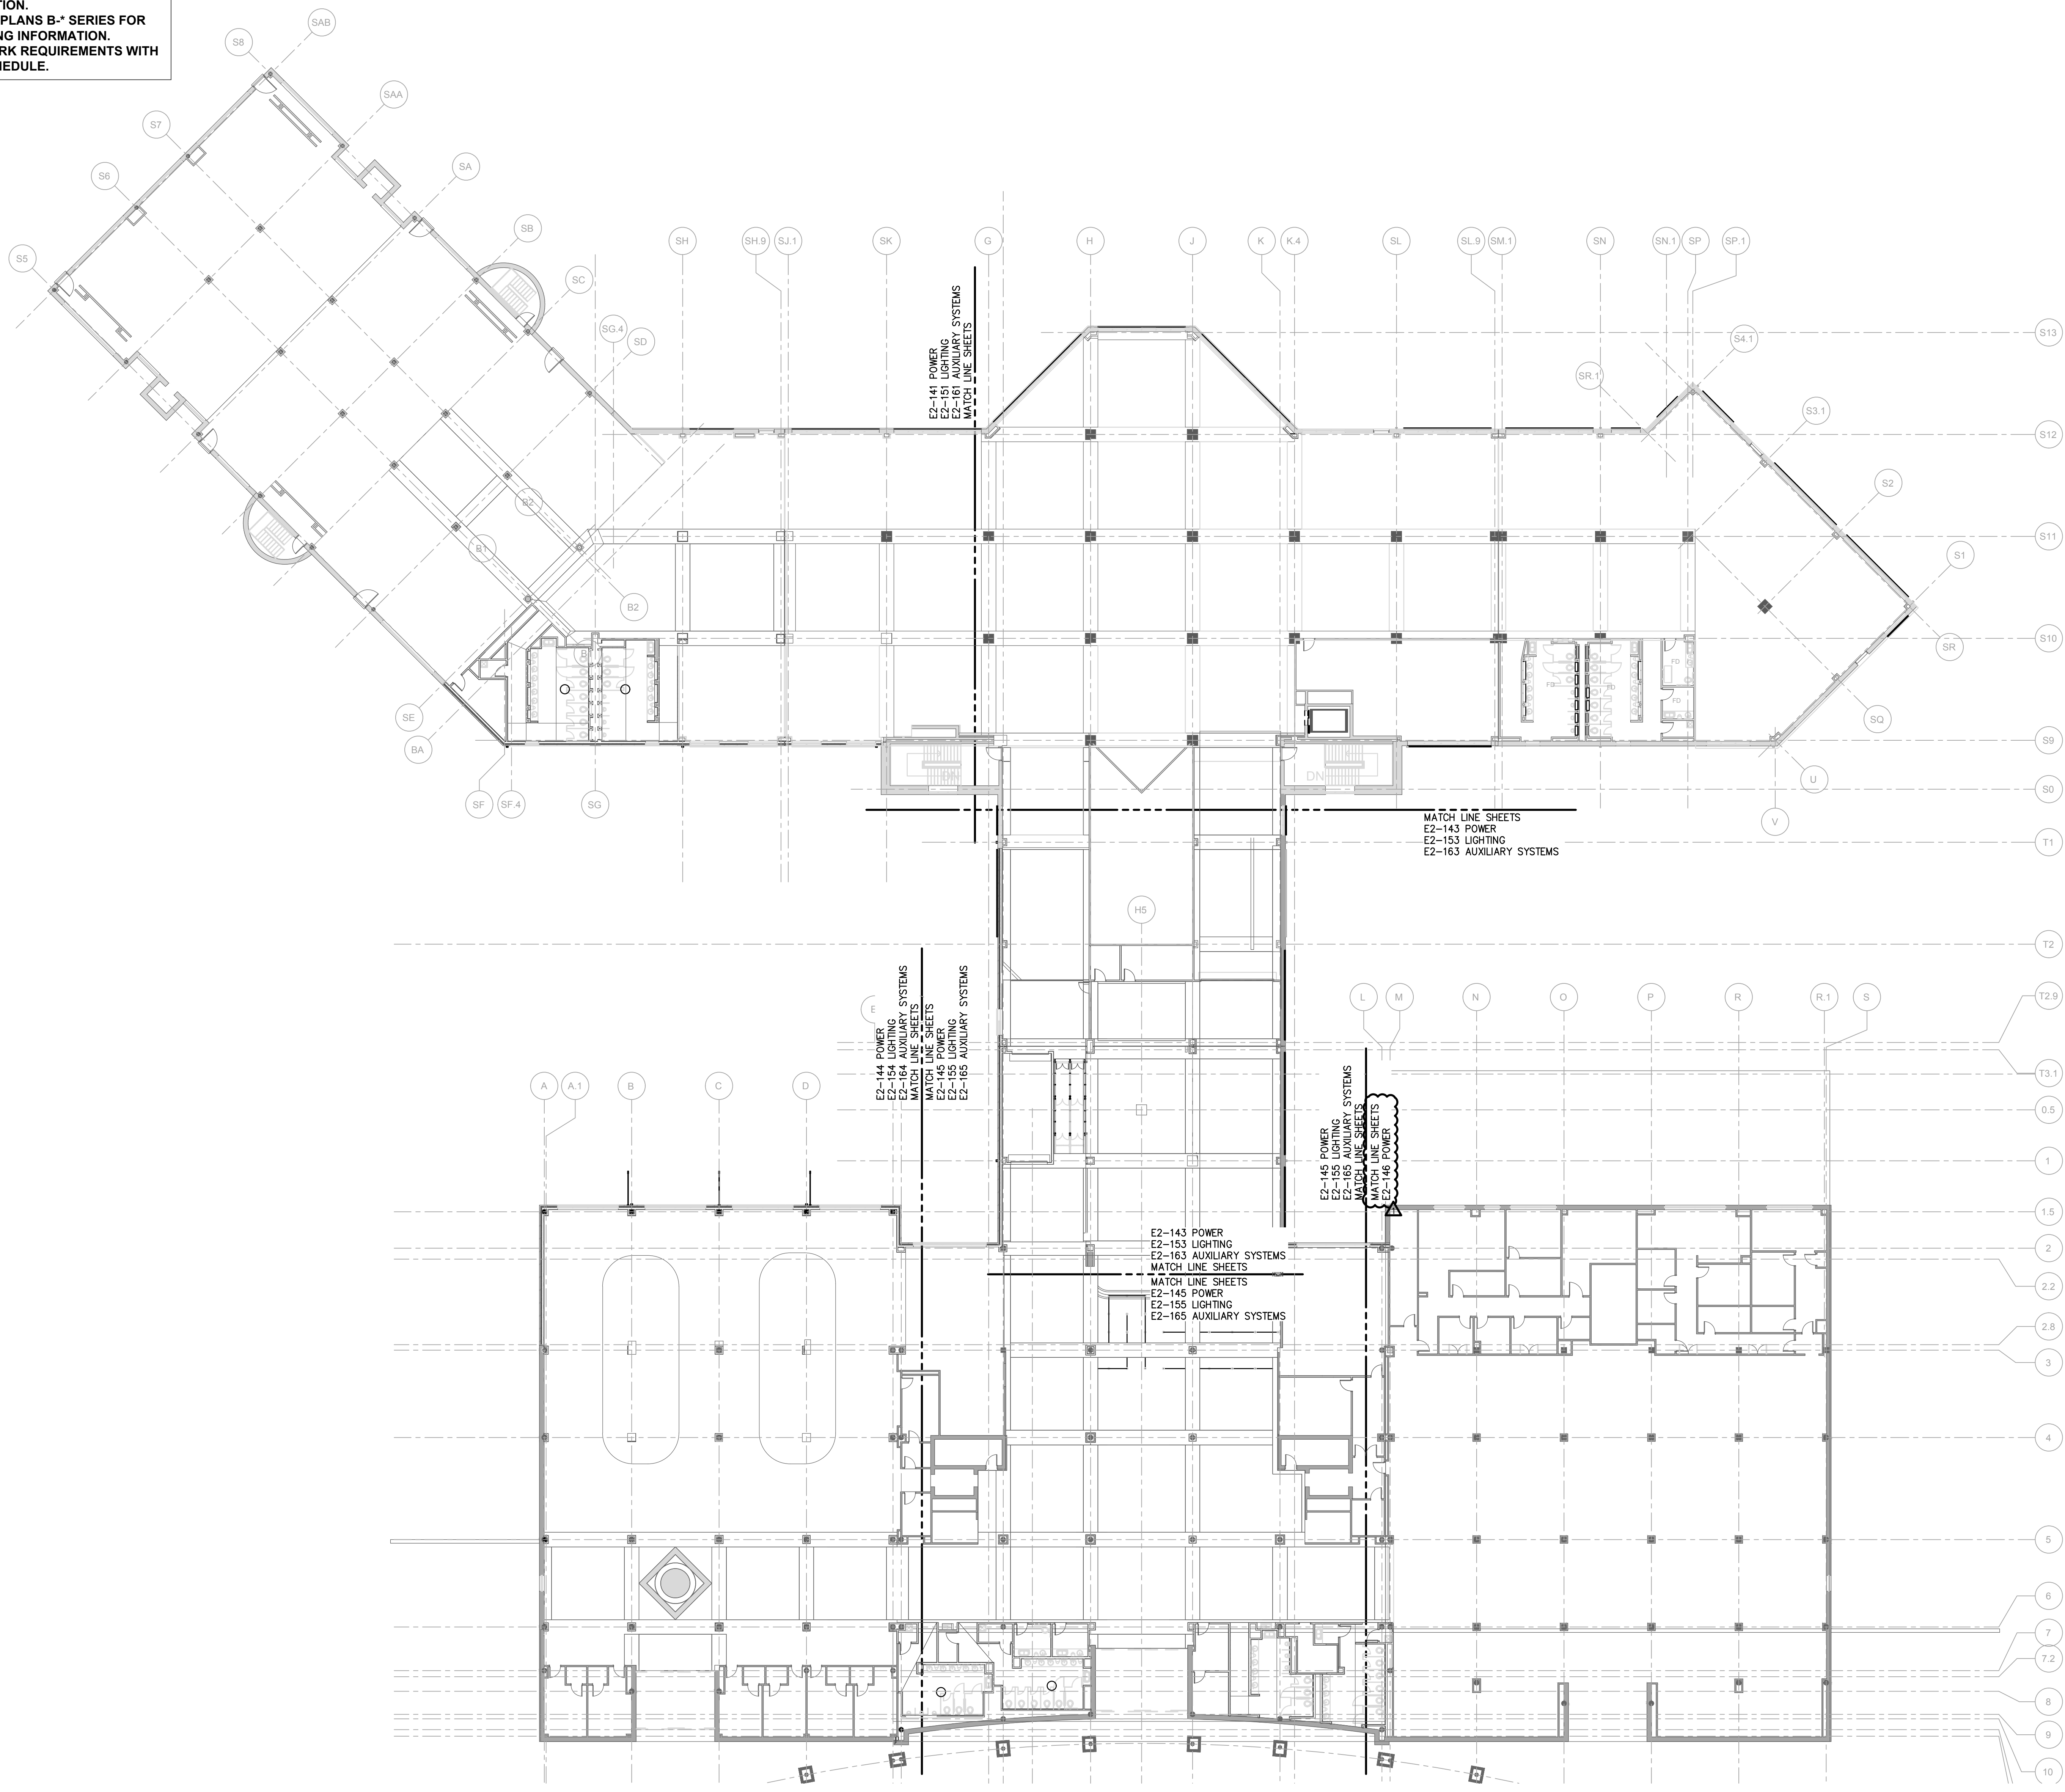

**1** SCHEDULE 2 - ELECTRICAL BOARDING/TICKET LEVEL - OVERALL PLAN  
 SCALE: 1" = 20'  
 GRAPHIC SCALE: 1"=20'  
 TRUE NORTH

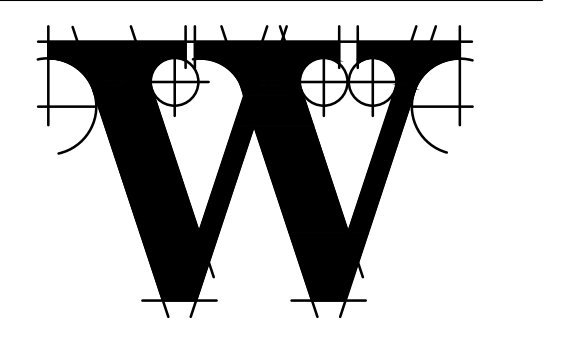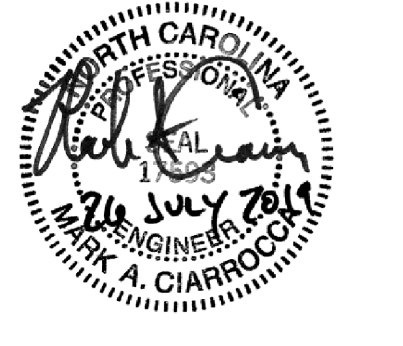

**THE WILSON GROUP**  
 - ARCHITECTS -  
 PO Box 5510 Charlotte, NC 28299  
 704-331-9747 • www.twgarchitects.com

PROJECT MANAGER & CIVIL ENGINEER  
**TALBERT & BRIGHT**  
 CONSULTING ARCHITECT  
 LS3P

STRUCTURAL ENGINEER  
**STEWART**


FPP/PM/E ENGINEER  
**CHEATHAM & ASSOC.**

BAGGAGE HANDLING CONSULTANTS  
**BNP**

AIRCRAFT SUPPORT SYSTEMS  
**DK CONSULTANTS**

SPECIALTY LIGHTING CONSULTANT  
**HARTRANFT**

SIGNAGE & WAYFINDING  
**TAKEFORM**

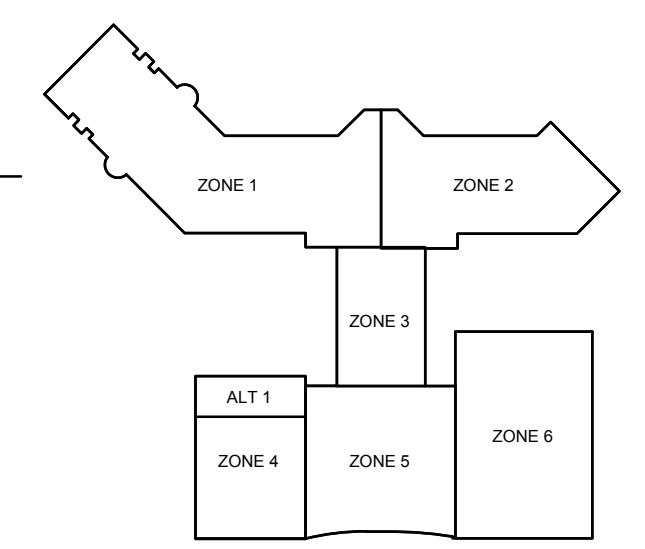

**KEY PLAN**  
 COPYRIGHT © 2019  
 THE WILSON GROUP ARCHITECTS  
 ALL RIGHTS RESERVED


PRINTED OR ELECTRONIC DRAWINGS AND DOCUMENTATION MAY NOT BE REPRODUCED IN ANY FORM WITHOUT WRITTEN PERMISSION FROM THE WILSON GROUP ARCHITECTS

REVISIONS  
 AD-03 07/26/2019


DATE 06/28/19  
 PROJECT NUMBER 9202-000  
 SHEET TITLE

**SCHEDULE 2 - ELECTRICAL BOARDING/TICKET LEVEL OVERALL PLAN**  
 SHEET NUMBER  
**E2-140**

FOR CONTRACT 3 SCHEDULE 1 AND SCHEDULE 2 WORK PHASES:  
 • SEE ARCHITECTURAL PLANS A-01\* SERIES FOR ADDITIONAL AND DETAILED PHASING INFORMATION.  
 • SEE BAGGAGE HANDLING SYSTEM PLANS B\* SERIES FOR ADDITIONAL AND DETAILED PHASING INFORMATION.  
 • COORDINATE ACTUAL PHASED WORK REQUIREMENTS WITH THE GENERAL CONTRACTOR'S SCHEDULE.

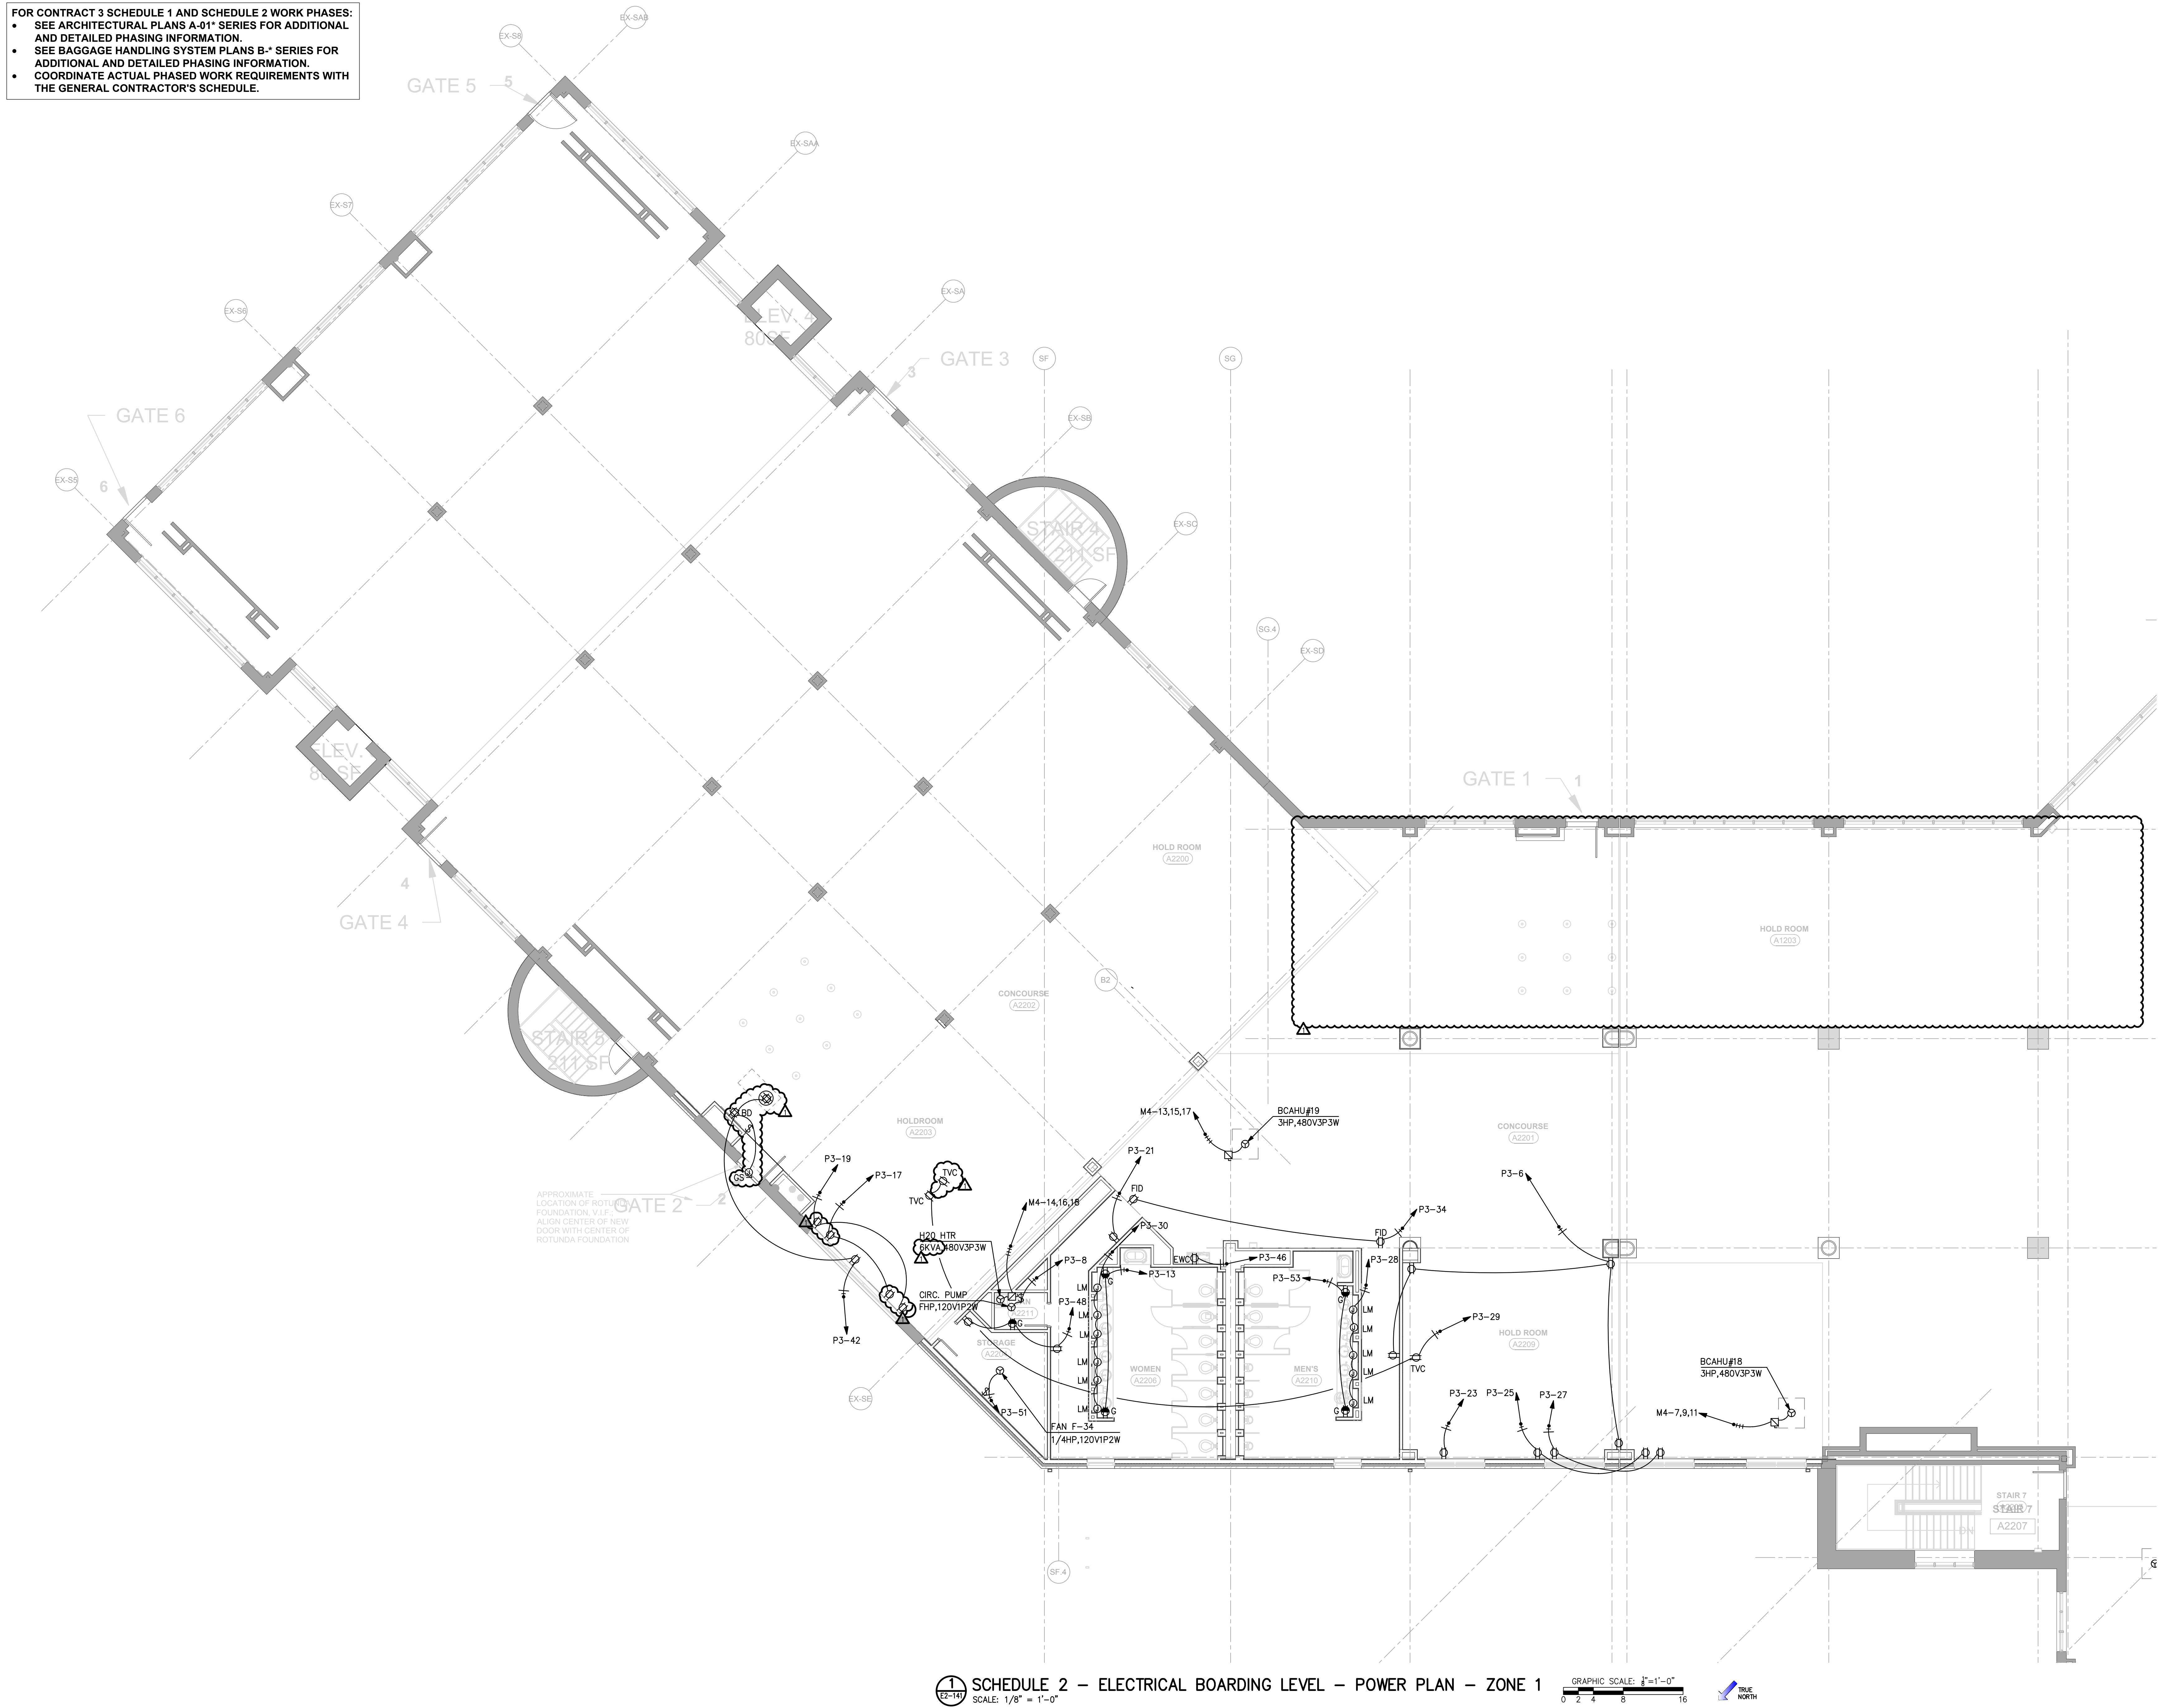

**1** SCHEDULE 2 - ELECTRICAL BOARDING LEVEL - POWER PLAN - ZONE 1  
 SCALE: 1/8" = 1'-0"

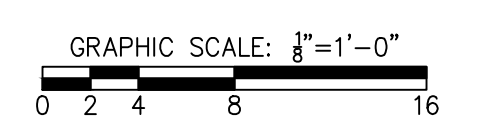


**TERMINAL IMPROVEMENTS CONTRACT 3**

Wilmington International Airport  
 1740 Airport Boulevard, Suite 12  
 Wilmington, NC 28405

**CHEATHAM & ASSOCIATES, P.A.**  
 CONSULTING ENGINEERS  
 3412 ENTERPRISE DRIVE  
 WILMINGTON, NORTH CAROLINA 28405  
 PHONE: (919) 452-4210 FAX: (919) 452-4211  
 OFFICE@CHEATHAMPA.COM  
 NC LICENSE# C-1073

JOB # 19005

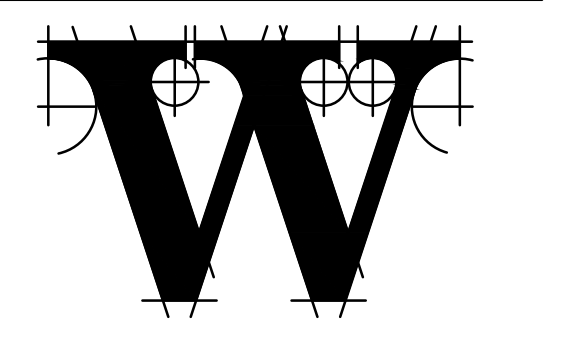

**THE WILSON GROUP**  
 - ARCHITECTS -  
 PO Box 5510 Charlotte, NC 28299  
 704-331-9747 • www.twgarchitects.com

PROJECT MANAGER & CIVIL ENGINEER  
**TALBERT & BRIGHT**  
 CONSULTING ARCHITECT  
 LS3P

STRUCTURAL ENGINEER  
**STEWART**


FP/PM/E ENGINEER  
**CHEATHAM & ASSOC.**

BAGGAGE HANDLING CONSULTANTS  
**BNP**

AIRCRAFT SUPPORT SYSTEMS  
**DK CONSULTANTS**

SPECIALTY LIGHTING CONSULTANT  
**HARTRANFT**

SIGNAGE & WAYFINDING  
**TAKEFORM**

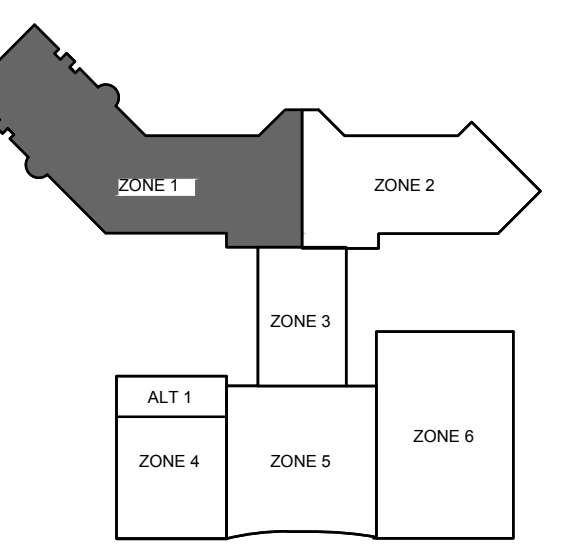

**KEY PLAN**

COPYRIGHT © 2019  
 THE WILSON GROUP ARCHITECTS  
 ALL RIGHTS RESERVED

PRINTED OR ELECTRONIC DRAWINGS AND DOCUMENTATION MAY NOT BE REPRODUCED IN ANY FORM WITHOUT WRITTEN PERMISSION FROM THE WILSON GROUP ARCHITECTS

**REVISIONS**

AD-03 07/26/2019

DATE 06/28/19  
 PROJECT NUMBER 9202-000  
 SHEET TITLE

**SCHEDULE 2 - ELECTRICAL BOARDING LEVEL POWER PLAN ZONE 1**  
 SHEET NUMBER

**E2-141**

FOR CONTRACT 3 SCHEDULE 1 AND SCHEDULE 2 WORK PHASES:  
 • SEE ARCHITECTURAL PLANS A-01\* SERIES FOR ADDITIONAL AND DETAILED PHASING INFORMATION.  
 • SEE BAGGAGE HANDLING SYSTEM PLANS B-\* SERIES FOR ADDITIONAL AND DETAILED PHASING INFORMATION.  
 • COORDINATE ACTUAL PHASED WORK REQUIREMENTS WITH THE GENERAL CONTRACTOR'S SCHEDULE.




**TERMINAL IMPROVEMENTS CONTRACT 3**

Wilmington International Airport  
 1740 Airport Boulevard, Suite 12  
 Wilmington, NC 28405

**CHEATHAM & ASSOCIATES, P.A.**  
 CONSULTING ENGINEERS  
 3412 ENTERPRISE DRIVE  
 WILMINGTON, NORTH CAROLINA 28405  
 PHONE: (919) 452-4210  
 FAX: (919) 452-4211  
 OFFICE@CHEATHAMPA.COM  
 NC LICENSE# C-1073

JOB # 19005

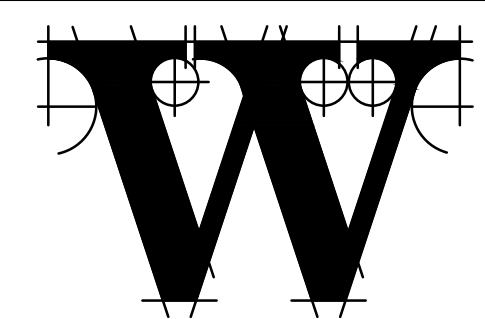

**THE WILSON GROUP ARCHITECTS**

PO Box 5510 Charlotte, NC 28299  
 704-331-9747 • www.twgarchitects.com

PROJECT MANAGER & CIVIL ENGINEER  
**TALBERT & BRIGHT**  
 CONSULTING ARCHITECT  
 LS3P

STRUCTURAL ENGINEER  
**STEWART**


FP/PM/E ENGINEER  
**CHEATHAM & ASSOC.**

BAGGAGE HANDLING CONSULTANTS  
**BNP**

AIRCRAFT SUPPORT SYSTEMS  
**DK CONSULTANTS**

SPECIALTY LIGHTING CONSULTANT  
**HARTRANFT**

SIGNAGE & WAYFINDING  
**TAKEFORM**

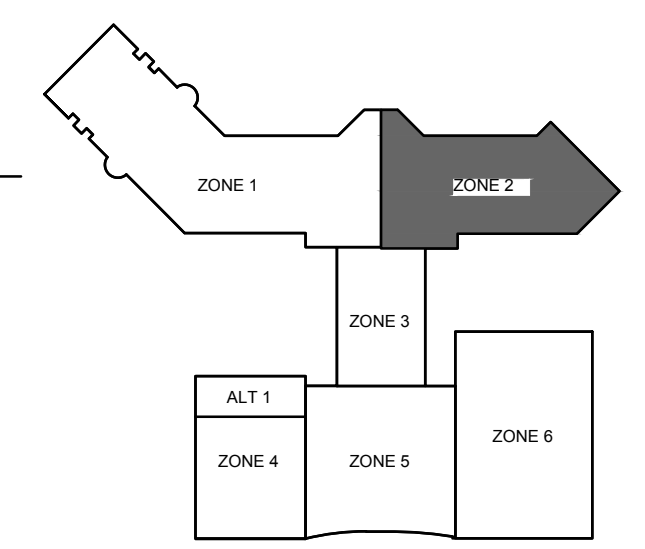

**KEY PLAN**

COPYRIGHT © 2019  
 THE WILSON GROUP ARCHITECTS  
 ALL RIGHTS RESERVED

PRINTED OR ELECTRONIC DRAWINGS AND DOCUMENTATION MAY NOT BE REPRODUCED IN ANY FORM WITHOUT WRITTEN PERMISSION FROM THE WILSON GROUP ARCHITECTS


**REVISIONS**

AD-03 07/26/2019

DATE 06/28/19  
 PROJECT NUMBER 9202-000  
 SHEET TITLE

**SCHEDULE 2 - ELECTRICAL BOARDING LEVEL POWER PLAN ZONE 2**  
 SHEET NUMBER

**E2-142**

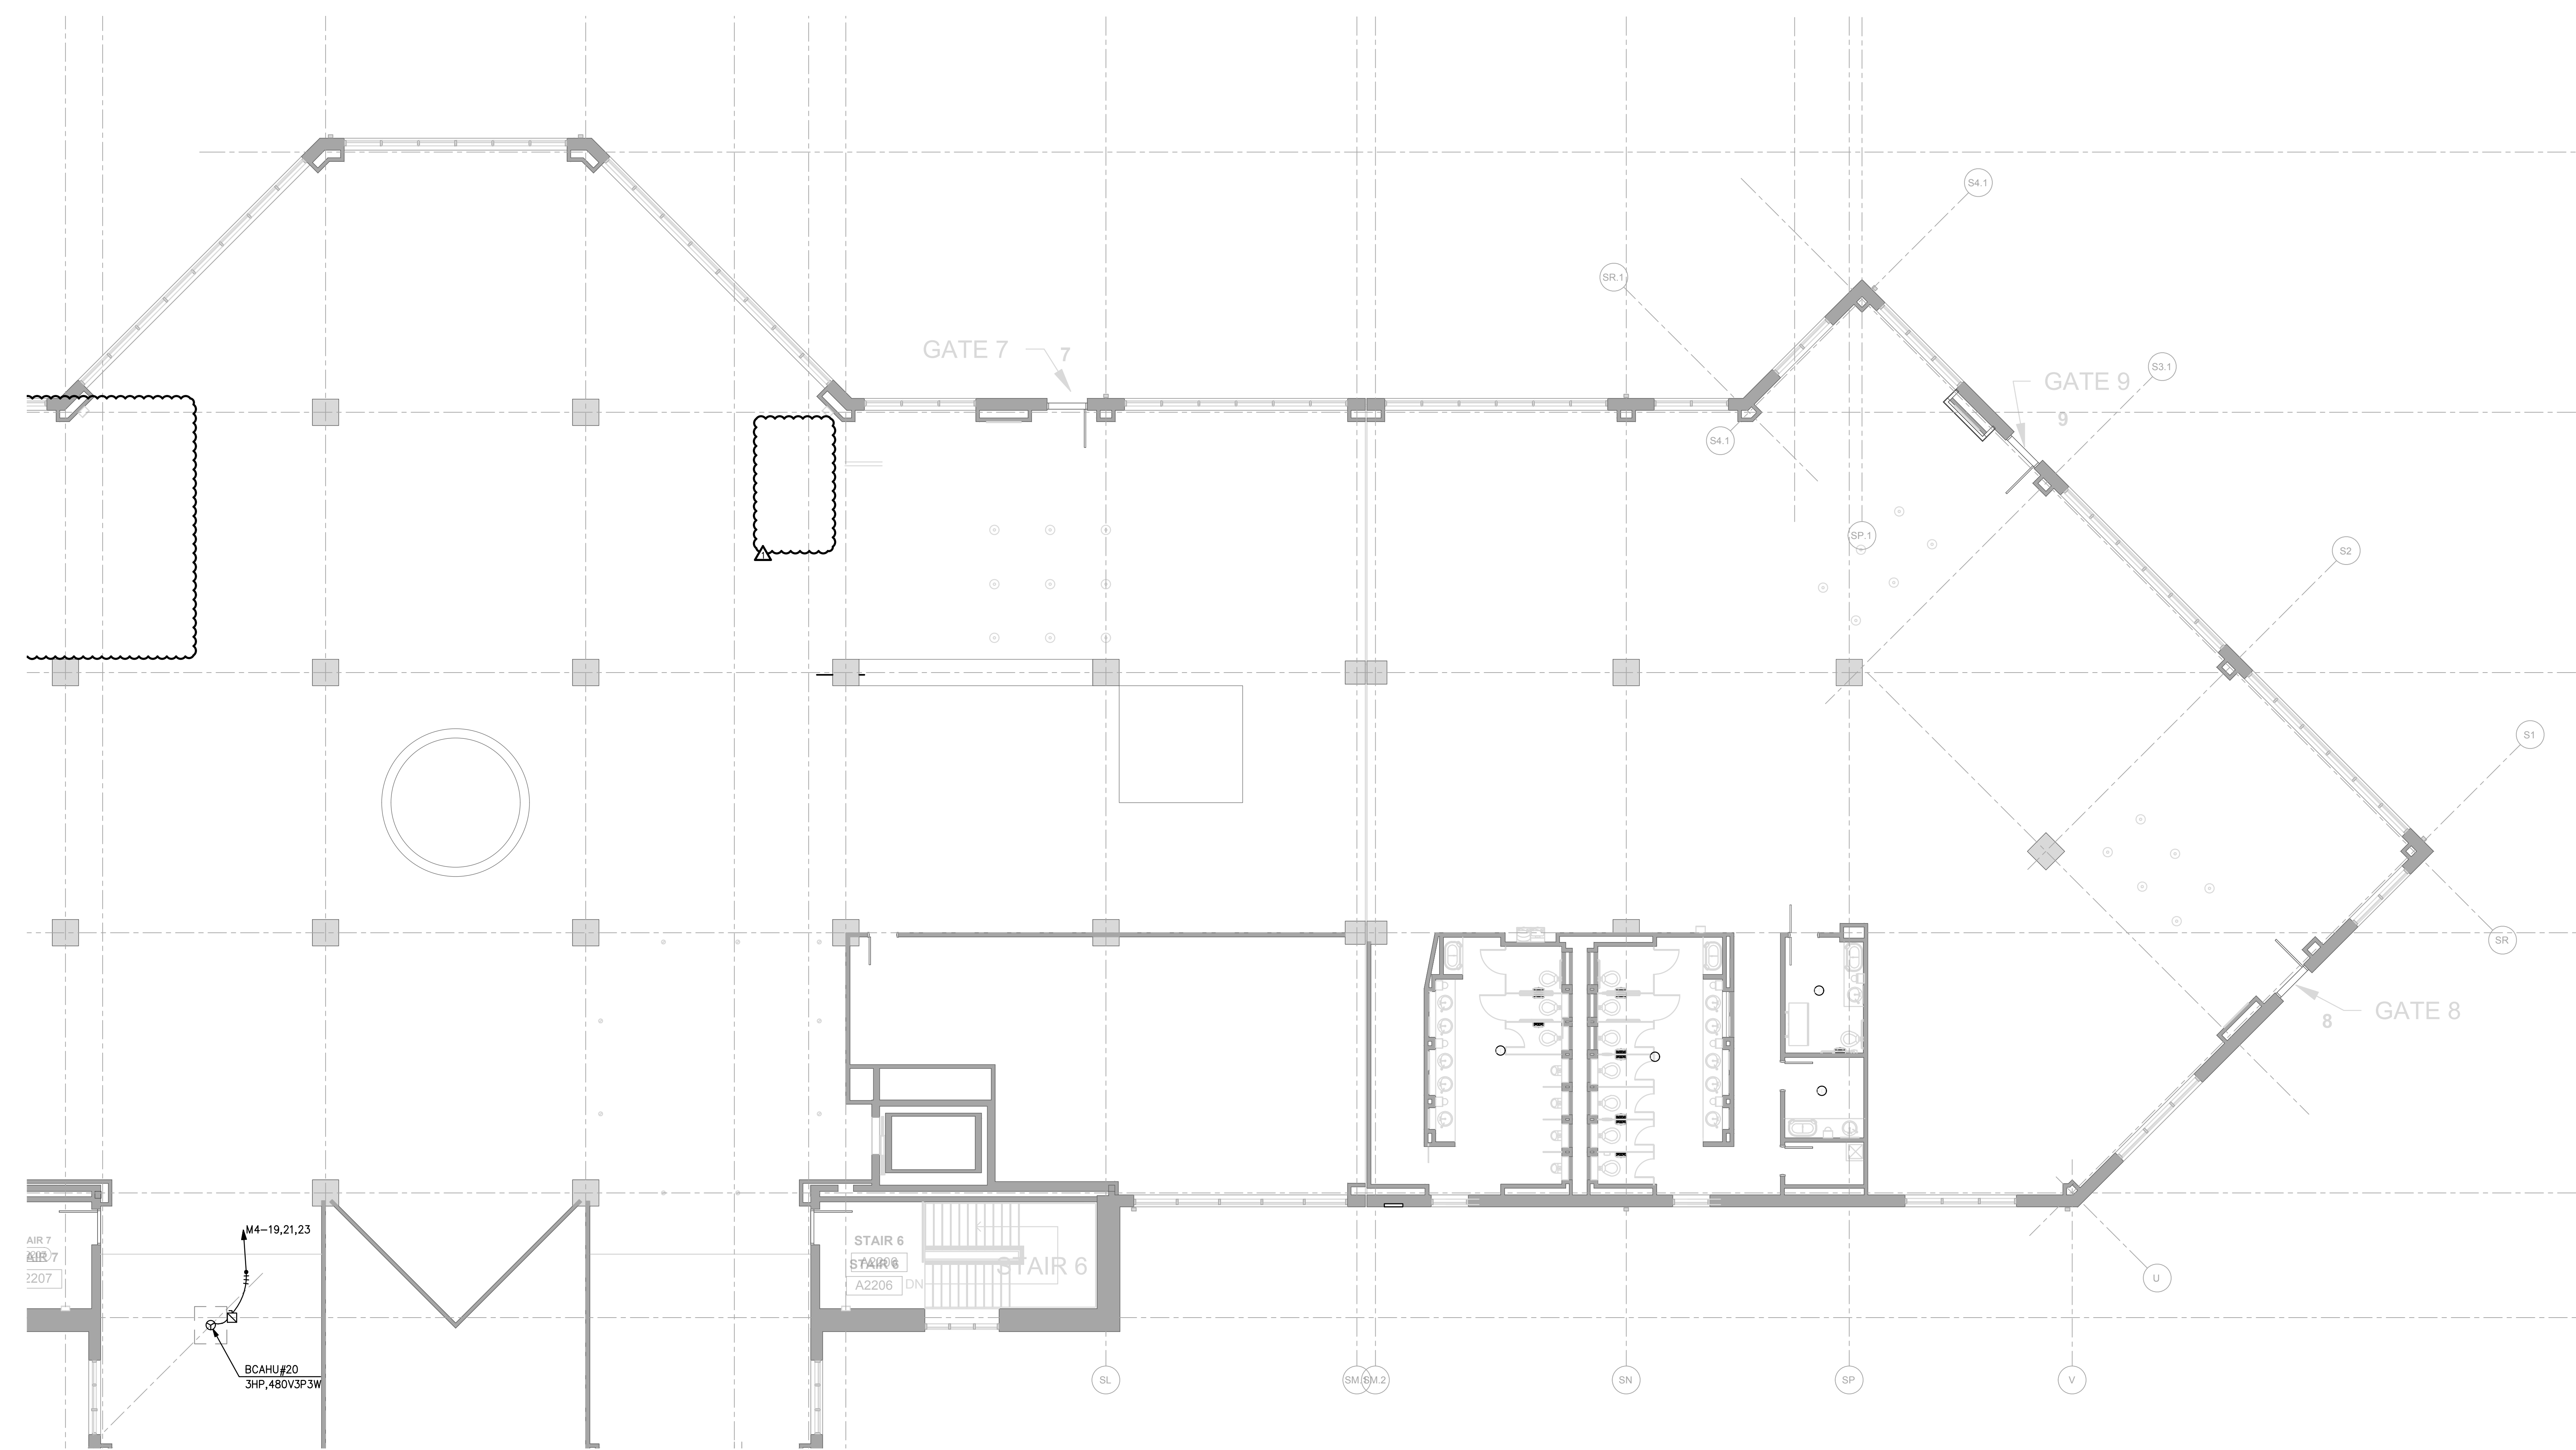

**SCHEDULE 2 - ELECTRICAL BOARDING LEVEL - POWER PLAN - ZONE 2**  
 SCALE: 1/8" = 1'-0" GRAPHIC SCALE: 1"=1'-0" TRUE NORTH



FOR CONTRACT 3 SCHEDULE 1 AND SCHEDULE 2 WORK PHASES:  
 • SEE ARCHITECTURAL PLANS A-01\* SERIES FOR ADDITIONAL AND DETAILED PHASING INFORMATION.  
 • SEE BAGGAGE HANDLING SYSTEM PLANS B-\* SERIES FOR ADDITIONAL AND DETAILED PHASING INFORMATION.  
 • COORDINATE ACTUAL PHASED WORK REQUIREMENTS WITH THE GENERAL CONTRACTOR'S SCHEDULE.




**TERMINAL IMPROVEMENTS CONTRACT 3**

Wilmington International Airport  
 1740 Airport Boulevard, Suite 12  
 Wilmington, NC 28405

**CHEATHAM & ASSOCIATES, P.A.**  
 CONSULTING ENGINEERS  
 3412 ENTERPRISE DRIVE  
 WILMINGTON, NORTH CAROLINA 28405  
 PHONE: (919) 452-4210  
 FAX: (919) 452-4211  
 OFFICE@CHEATHAMPA.COM  
 NC LICENSE# C-1073

JOB # 19005

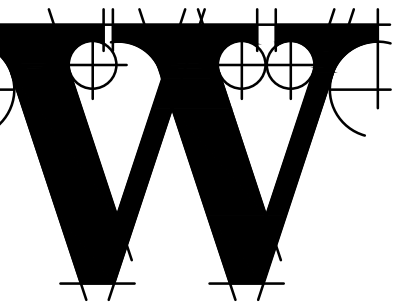

**THE WILSON GROUP - ARCHITECTS -**

PO Box 5510 Charlotte, NC 28299  
 704-331-9747 • www.twgarchitects.com

PROJECT MANAGER & CIVIL ENGINEER  
**TALBERT & BRIGHT**  
 CONSULTING ARCHITECT  
 LS3P

STRUCTURAL ENGINEER  
**STEWART**


FP/PM/E ENGINEER  
**CHEATHAM & ASSOC.**

BAGGAGE HANDLING CONSULTANTS  
**BNP**

AIRCRAFT SUPPORT SYSTEMS  
**DK CONSULTANTS**

SPECIALTY LIGHTING CONSULTANT  
**HARTRANFT**

SIGNAGE & WAYFINDING  
**TAKEFORM**

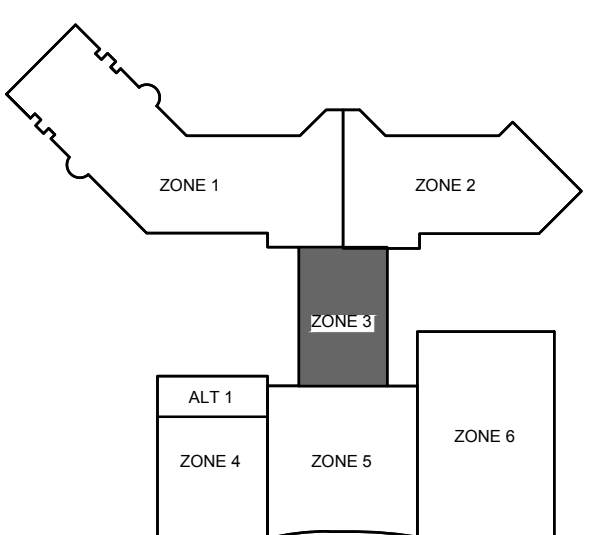

**KEY PLAN**


COPYRIGHT © 2019  
 THE WILSON GROUP ARCHITECTS  
 ALL RIGHTS RESERVED

PRINTED OR ELECTRONIC DRAWINGS AND DOCUMENTATION MAY NOT BE REPRODUCED IN ANY FORM WITHOUT WRITTEN PERMISSION FROM THE WILSON GROUP ARCHITECTS


**REVISIONS**

AD-03 07/26/2019

GENERAL NOTE:  
 PANEL TSA2 IS LOCATED ON LOWER RAMP LEVEL. SEE SHEET #E1-115.

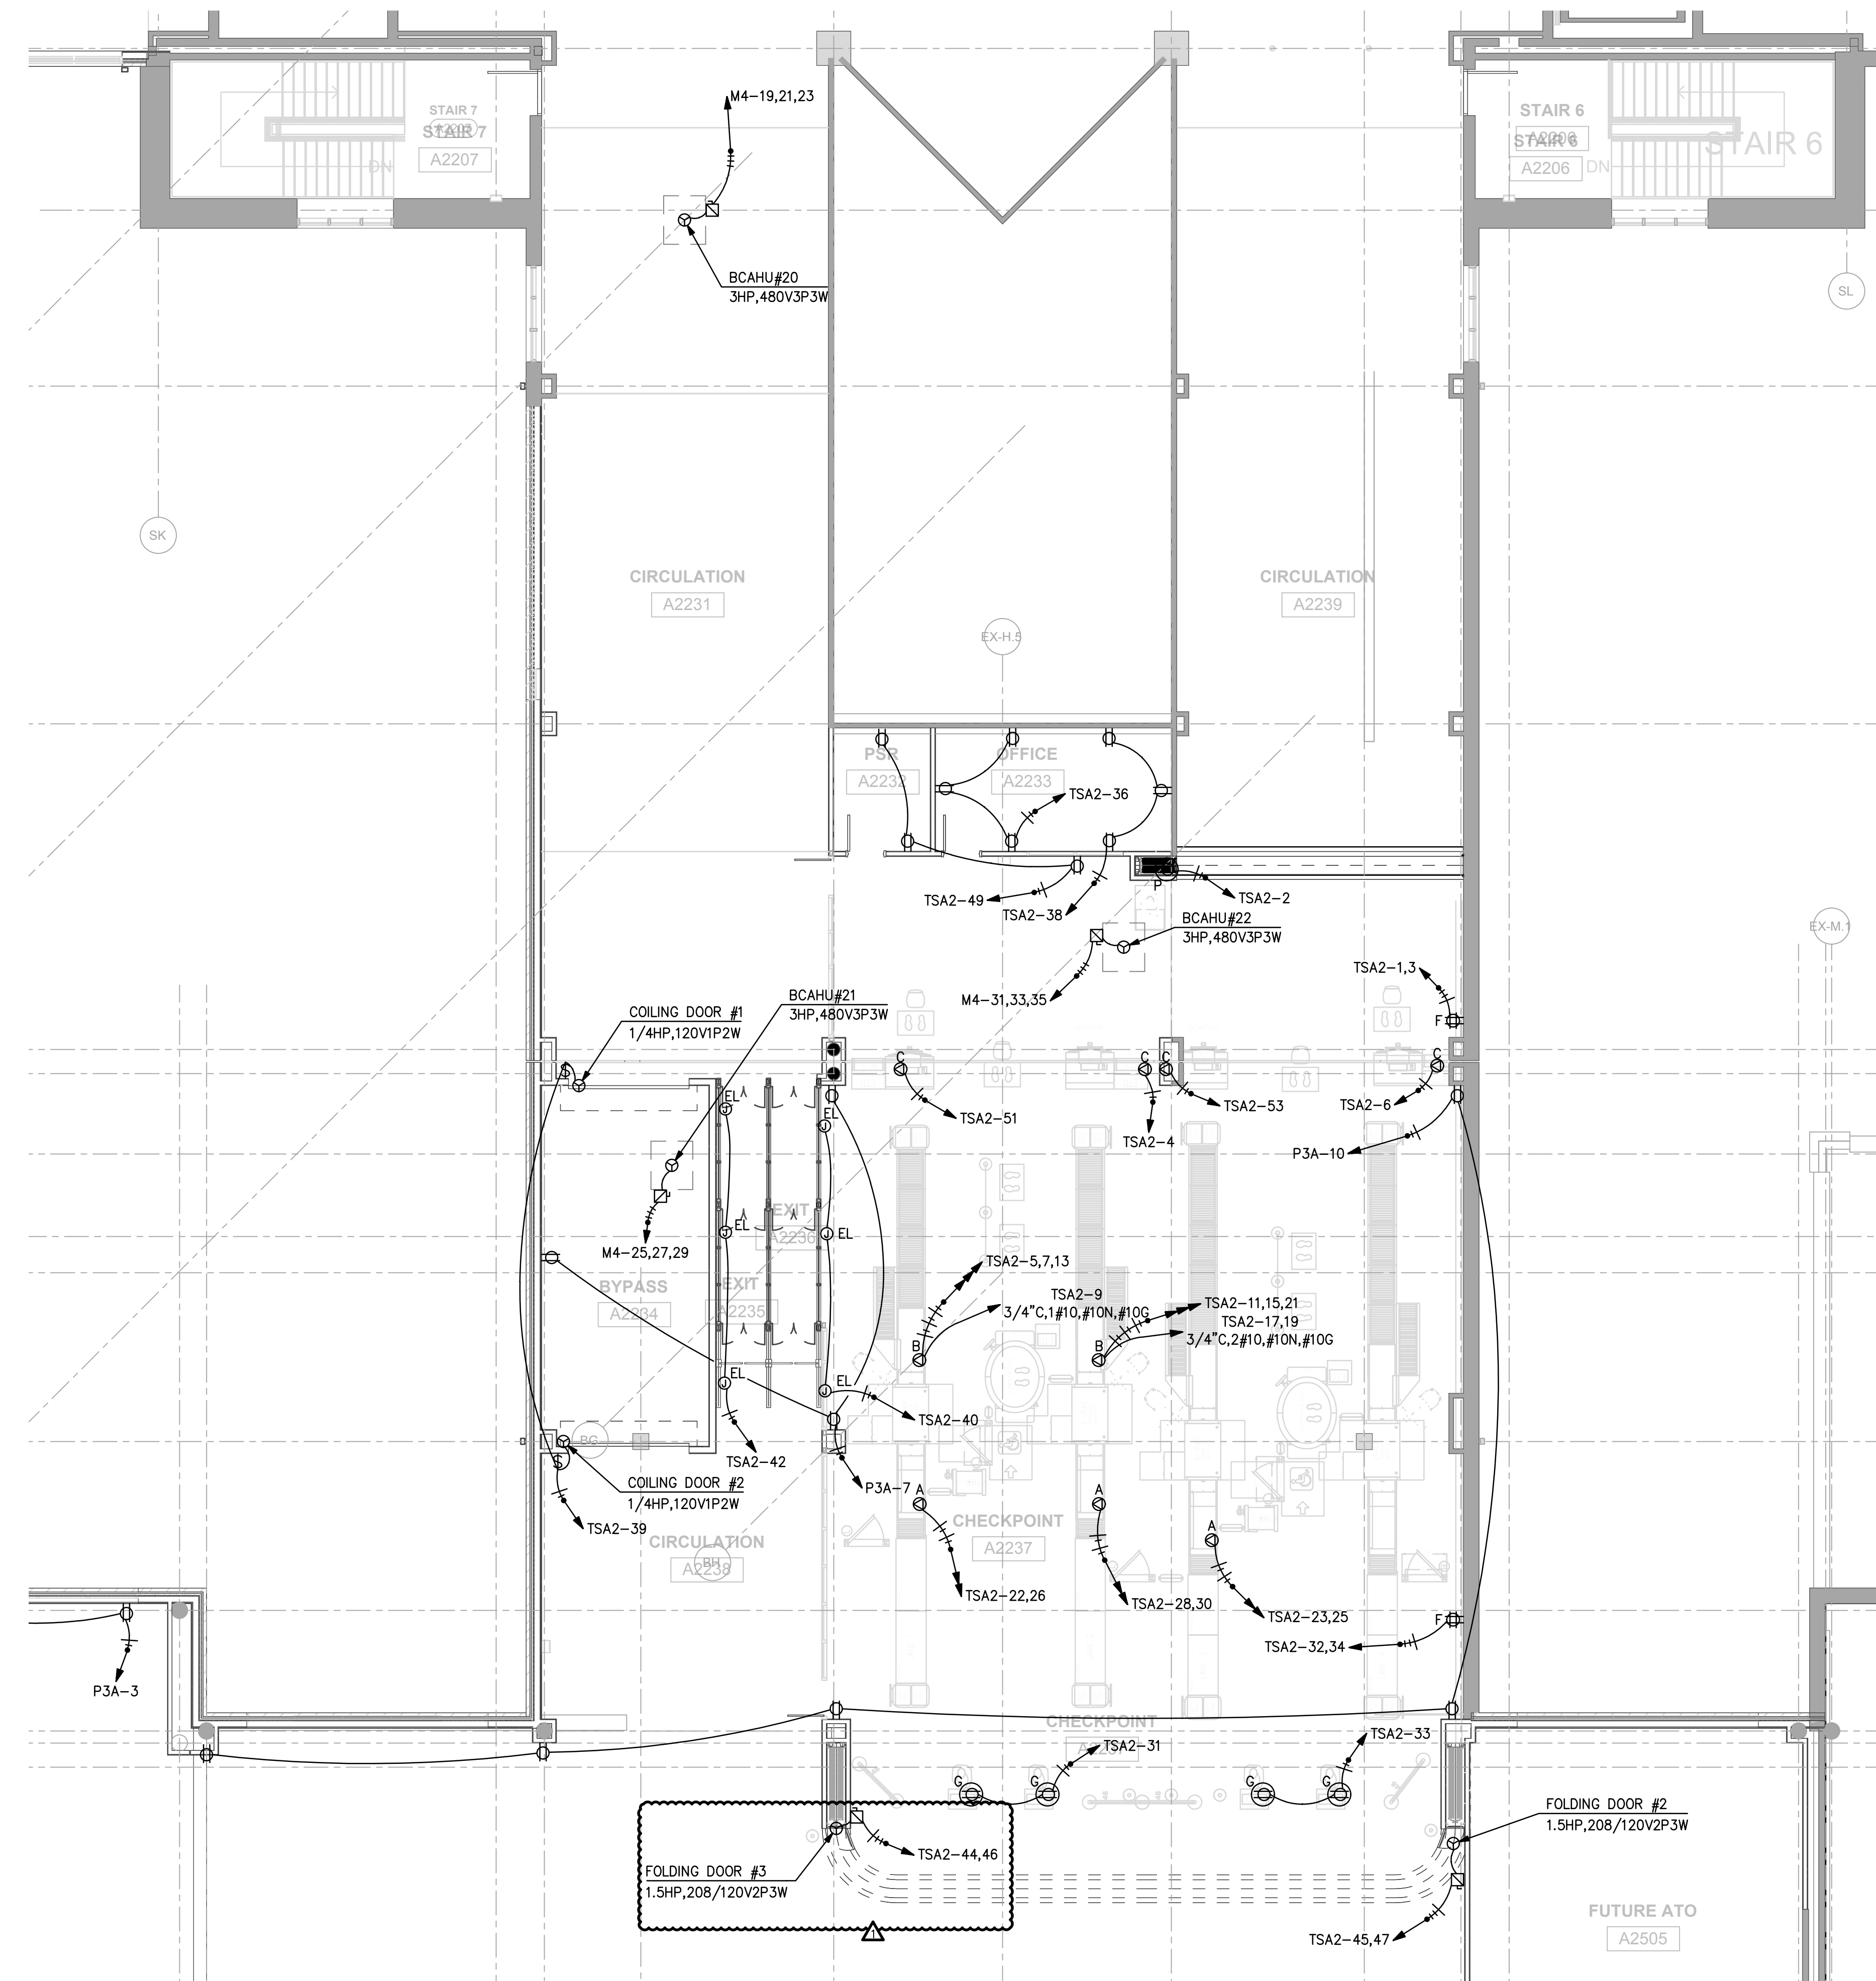

**SCHEDULE 2 - ELECTRICAL BOARDING LEVEL - POWER PLAN - ZONE 3**  
 SCALE: 1/8" = 1'-0"

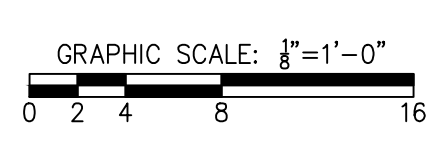


DATE 06/28/19  
 PROJECT NUMBER 9202-000  
 SHEET TITLE

**SCHEDULE 2 - ELECTRICAL BOARDING LEVEL POWER PLAN ZONE 3**  
 SHEET NUMBER

**E2-143**

FOR CONTRACT 3 SCHEDULE 1 AND SCHEDULE 2 WORK PHASES:  
 • SEE ARCHITECTURAL PLANS A-01\* SERIES FOR ADDITIONAL AND DETAILED PHASING INFORMATION.  
 • SEE BAGGAGE HANDLING SYSTEM PLANS B-\* SERIES FOR ADDITIONAL AND DETAILED PHASING INFORMATION.  
 • COORDINATE ACTUAL PHASED WORK REQUIREMENTS WITH THE GENERAL CONTRACTOR'S SCHEDULE.

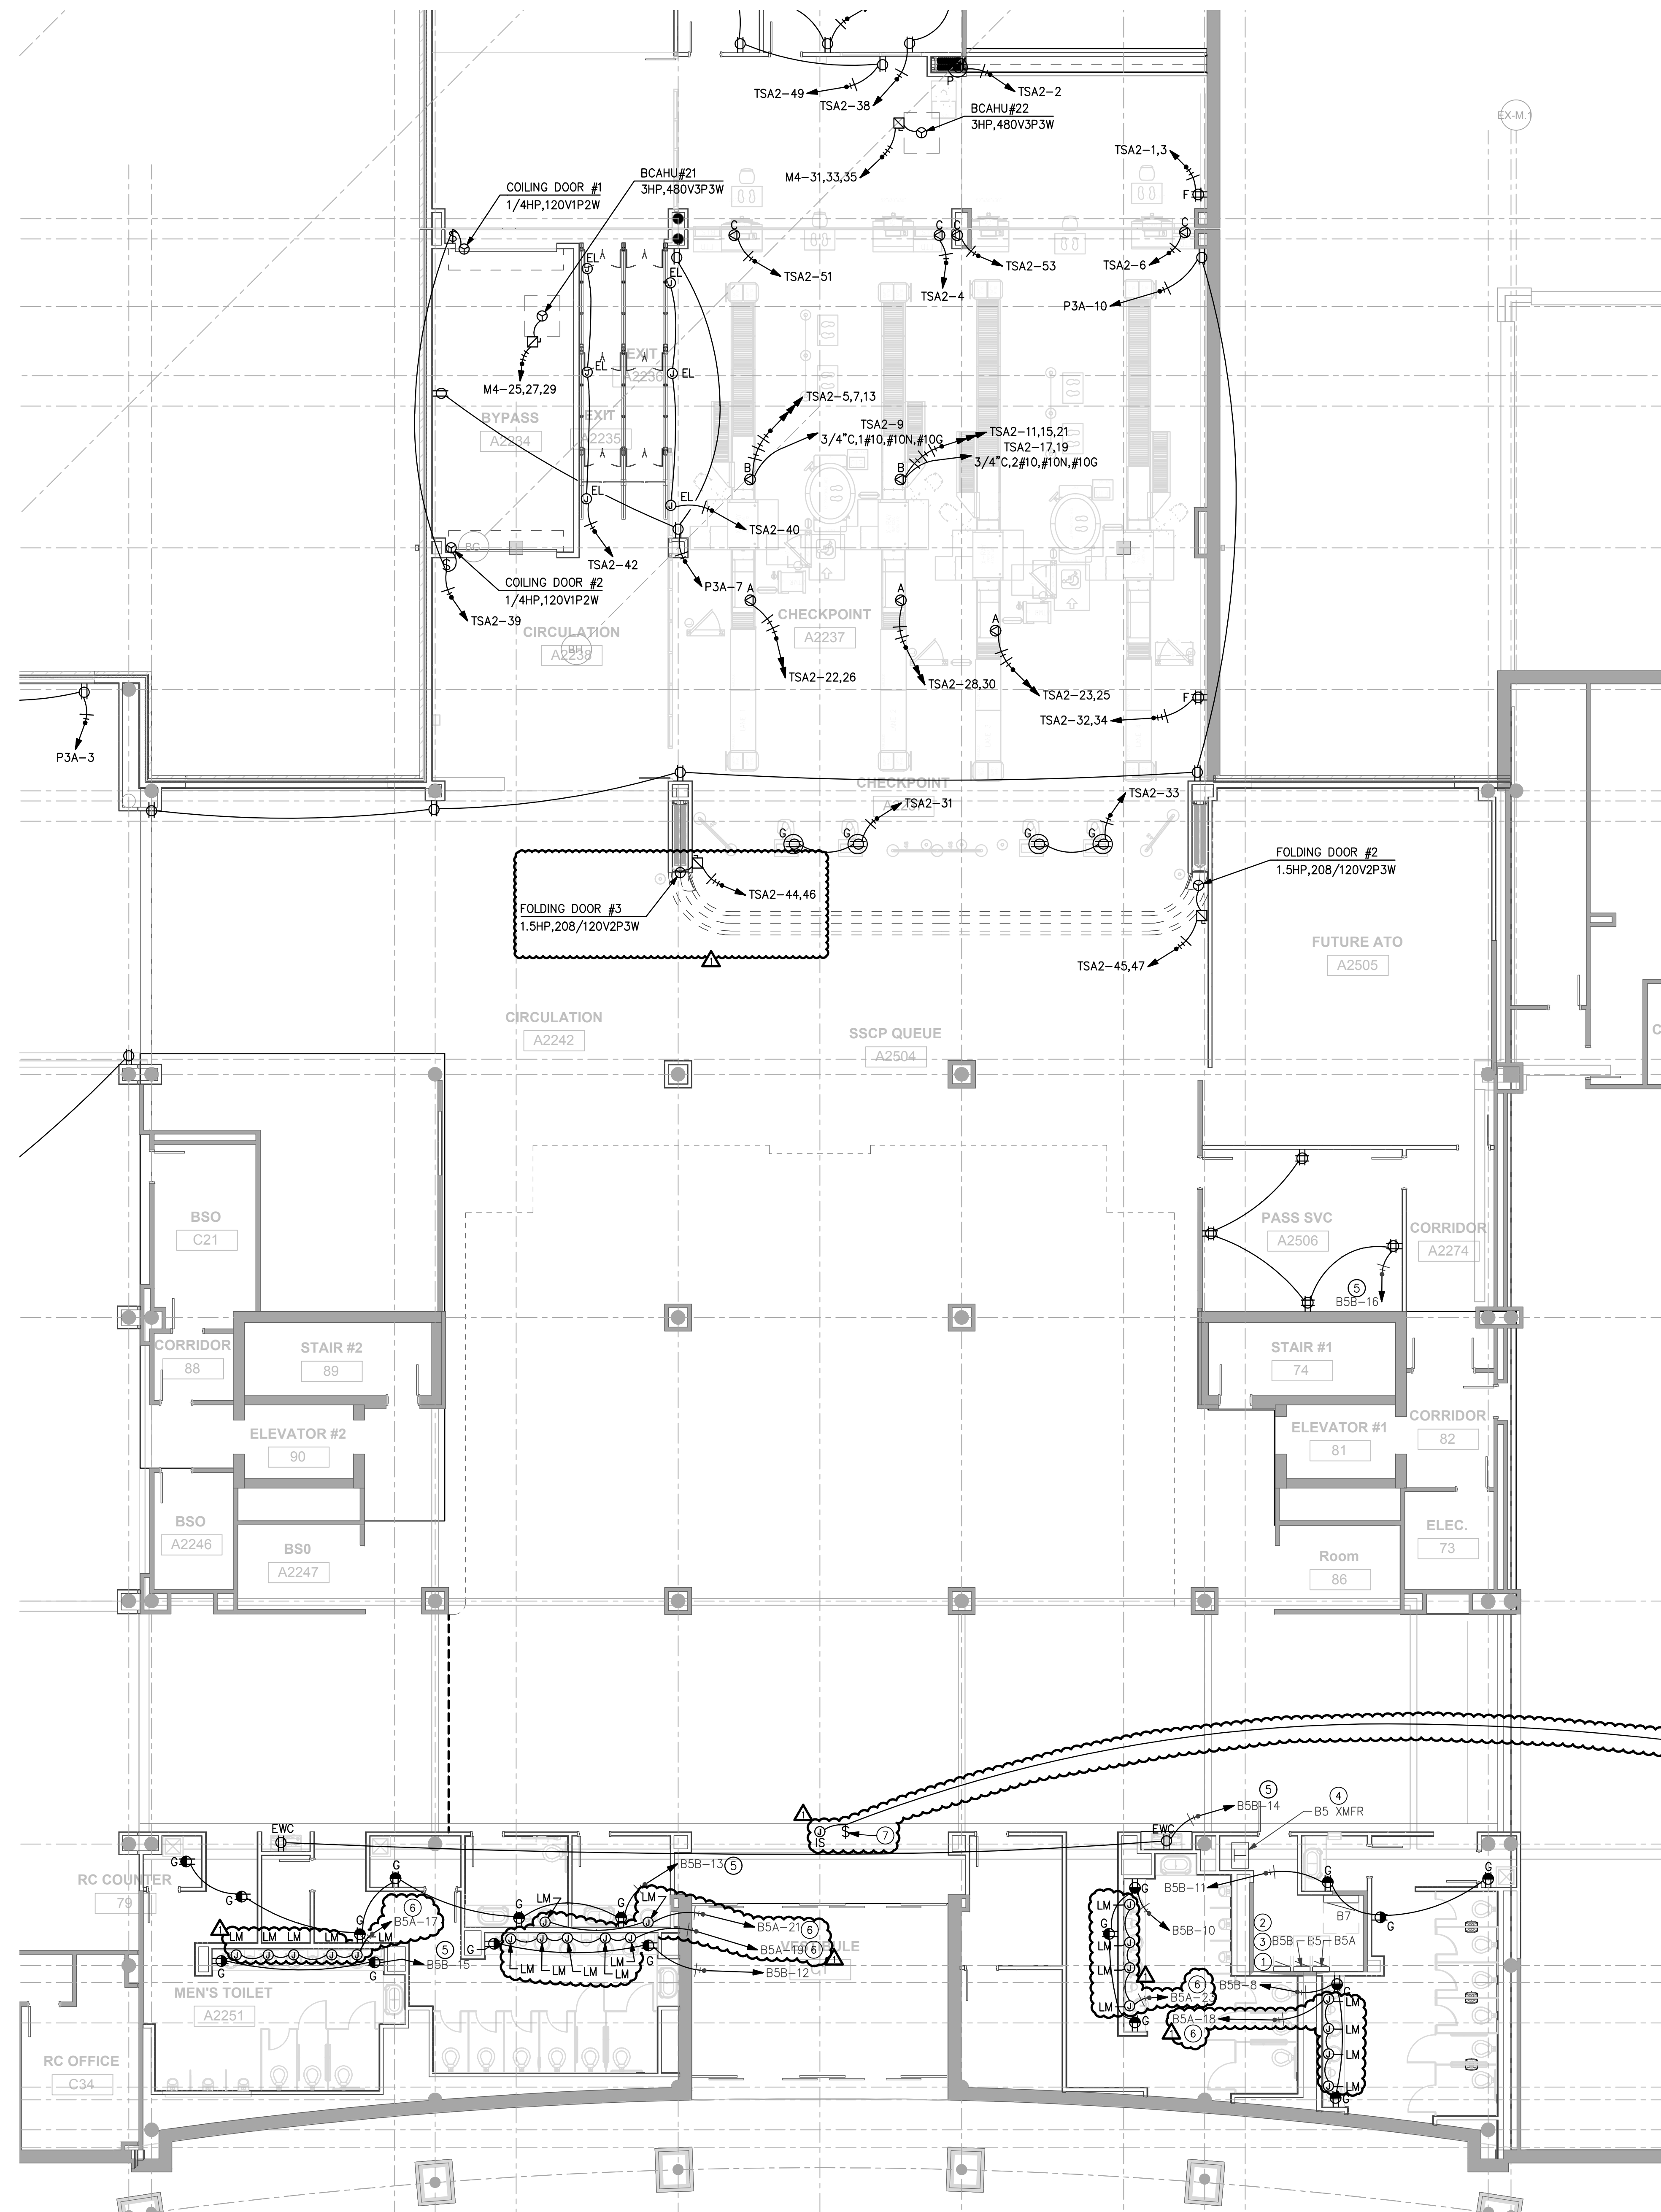


- KEYED NOTES:
- ① EXISTING PANEL B5B, MANUFACTURED BY GE (A SERIES TYPE).
  - ② EXISTING CIRCUIT BREAKERS AVAILABLE IN PANEL B5B.
  - ③ PROVIDE (1) 20A/1P CIRCUIT BREAKER (GFCI TYPE) FOR LOAD INDICATED (CIRCUIT #14).
  - ④ RELOCATED TRANSFORMER B5, INSTALL NEW CIRCUITRY TO PRIMARY AND SECONDARY SIDE OF TRANSFORMER. SEE RISER FOR CIRCUITRY INFORMATION.
  - ⑤ PROVIDE 20A/1P CIRCUIT BREAKER FOR PANEL INDICATED.
  - ⑥ UTILIZE SPARE CIRCUIT BREAKER IN PANEL INDICATED. IF SPARE CIRCUIT BREAKER USED IS DIFFERENT THAN INDICATED, CONTRACTOR SHALL UPDATE MARKUP AS-BUILTS WITH THE CORRECT CIRCUIT NUMBERS.
  - ⑦ CONCEAL SWITCH AROUND ILLUMINATED SIGN.

① SCHEDULE 2 - ELECTRICAL BOARDING LEVEL - POWER PLAN - ZONE 5  
 SCALE: 1/8" = 1'-0"  
 GRAPHIC SCALE: 1" = 1'-0"  
 TRUE NORTH



- PROJECT MANAGER & CIVIL ENGINEER  
**TALBERT & BRIGHT**  
 CONSULTING ARCHITECT  
 LS3P
- STRUCTURAL ENGINEER  
**STEWART**
- FP/PM/E ENGINEER  
**CHEATHAM & ASSOC.**
- BAGGAGE HANDLING CONSULTANTS  
**BNP**
- AIRCRAFT SUPPORT SYSTEMS  
**DK CONSULTANTS**
- SPECIALTY LIGHTING CONSULTANT  
**HARTRANFT**
- SIGNAGE & WAYFINDING  
**TAKEFORM**

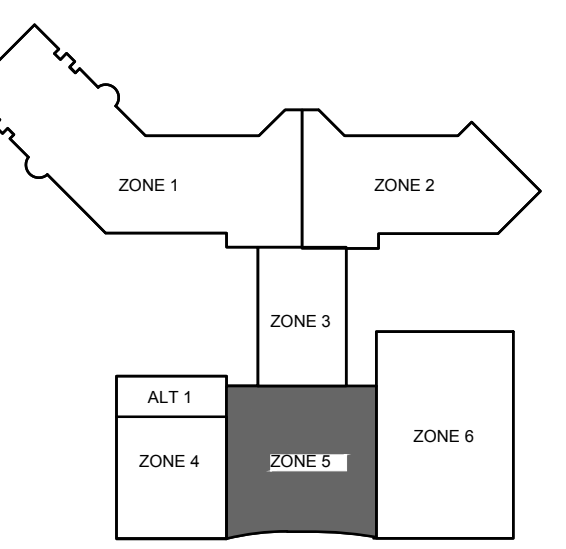

**KEY PLAN**  
 COPYRIGHT © 2019  
 THE WILSON GROUP ARCHITECTS  
 ALL RIGHTS RESERVED

PRINTED OR ELECTRONIC DRAWINGS AND DOCUMENTATION MAY NOT BE REPRODUCED IN ANY FORM WITHOUT WRITTEN PERMISSION FROM THE WILSON GROUP ARCHITECTS

REVISIONS

AD-03	07/26/2019
-------	------------

FOR CONTRACT 3 SCHEDULE 1 AND SCHEDULE 2 WORK PHASES:  
 • SEE ARCHITECTURAL PLANS A-01\* SERIES FOR ADDITIONAL AND DETAILED PHASING INFORMATION.  
 • SEE BAGGAGE HANDLING SYSTEM PLANS B-\* SERIES FOR ADDITIONAL AND DETAILED PHASING INFORMATION.  
 • COORDINATE ACTUAL PHASED WORK REQUIREMENTS WITH THE GENERAL CONTRACTOR'S SCHEDULE.

KEYED NOTES:  
 ① CONCEAL SWITCH AROUND ILLUMINATED SIGN.



① SCHEDULE 2 - ELECTRICAL BOARDING LEVEL - POWER PLAN - ZONE 6  
 SCALE: 1/8" = 1'-0"

GRAPHIC SCALE: 1/8" = 1'-0"  
 0 2 4 8 16




**TERMINAL IMPROVEMENTS CONTRACT 3**

Wilmington International Airport  
 1740 Airport Boulevard, Suite 12  
 Wilmington, NC 28405

**CHEATHAM & ASSOCIATES, P.A.**  
 CONSULTING ENGINEERS  
 3412 ENTERPRISE DRIVE  
 WILMINGTON, NORTH CAROLINA 28405  
 PHONE: (919) 452-4210  
 FAX: (919) 452-4211  
 OFFICE@CHEATHAMPA.COM  
 NC LICENSE# C-1073

JOB # 19005

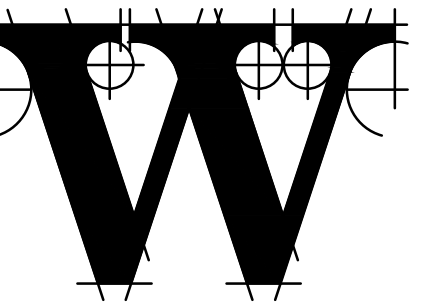

**THE WILSON GROUP**  
 - ARCHITECTS -

PO Box 5510 Charlotte, NC 28299  
 704-331-9747 • www.twgarchitects.com

PROJECT MANAGER & CIVIL ENGINEER  
**TALBERT & BRIGHT**  
 CONSULTING ARCHITECT  
 LS3P

STRUCTURAL ENGINEER  
**STEWART**


FP/PM/E ENGINEER  
**CHEATHAM & ASSOC.**

BAGGAGE HANDLING CONSULTANTS  
**BNP**

AIRCRAFT SUPPORT SYSTEMS  
**DK CONSULTANTS**

SPECIALTY LIGHTING CONSULTANT  
**HARTRANFT**

SIGNAGE & WAYFINDING  
**TAKEFORM**

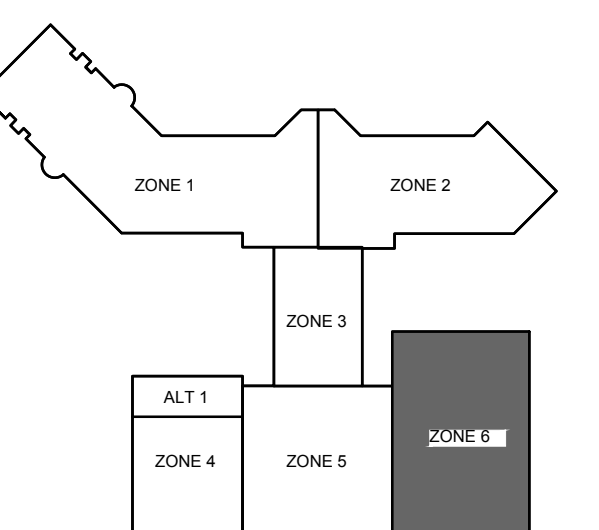

**KEY PLAN**

COPYRIGHT © 2019  
 THE WILSON GROUP ARCHITECTS  
 ALL RIGHTS RESERVED

PRINTED OR ELECTRONIC DRAWINGS AND DOCUMENTATION MAY NOT BE REPRODUCED IN ANY FORM WITHOUT WRITTEN PERMISSION FROM THE WILSON GROUP ARCHITECTS

**REVISIONS**

AD-03 07/26/2019

DATE 06/28/19  
 PROJECT NUMBER 9202-000  
 SHEET TITLE

**SCHEDULE 2 - ELECTRICAL BOARDING LEVEL POWER PLAN ZONE 6**  
 SHEET NUMBER

**E2-146**

FOR CONTRACT 3 SCHEDULE 1 AND SCHEDULE 2 WORK PHASES:  
 • SEE ARCHITECTURAL PLANS A-01\* SERIES FOR ADDITIONAL AND DETAILED PHASING INFORMATION.  
 • SEE BAGGAGE HANDLING SYSTEM PLANS B\* SERIES FOR ADDITIONAL AND DETAILED PHASING INFORMATION.  
 • COORDINATE ACTUAL PHASED WORK REQUIREMENTS WITH THE GENERAL CONTRACTOR'S SCHEDULE.




**TERMINAL IMPROVEMENTS CONTRACT 3**

Wilmington International Airport  
 1740 Airport Boulevard, Suite 12  
 Wilmington, NC 28405

**CHEATHAM & ASSOCIATES, P.A.**  
 CONSULTING ENGINEERS  
 3412 ENTERPRISE DRIVE  
 WILMINGTON, NORTH CAROLINA 28405  
 PHONE: (910) 452-4210  
 FAX: (910) 452-4211  
 OFFICE@CHEATHAM.PA.COM  
 NC LICENSE# C-1673

JOB # 19005

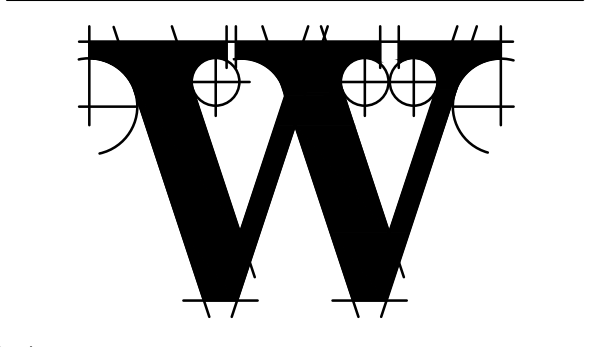

**THE WILSON GROUP**  
 - ARCHITECTS -  
 PO Box 5510 Charlotte, NC 28299  
 704-331-9747 • www.twgarchitects.com

PROJECT MANAGER & CIVIL ENGINEER  
**TALBERT & BRIGHT**  
 CONSULTING ARCHITECT  
 LS3P

STRUCTURAL ENGINEER  
**STEWART**


FPP/PM/E ENGINEER  
**CHEATHAM & ASSOC.**

BAGGAGE HANDLING CONSULTANTS  
**BNP**

AIRCRAFT SUPPORT SYSTEMS  
**DK CONSULTANTS**

SPECIALTY LIGHTING CONSULTANT  
**HARTRANFT**

SIGNAGE & WAYFINDING  
**TAKEFORM**

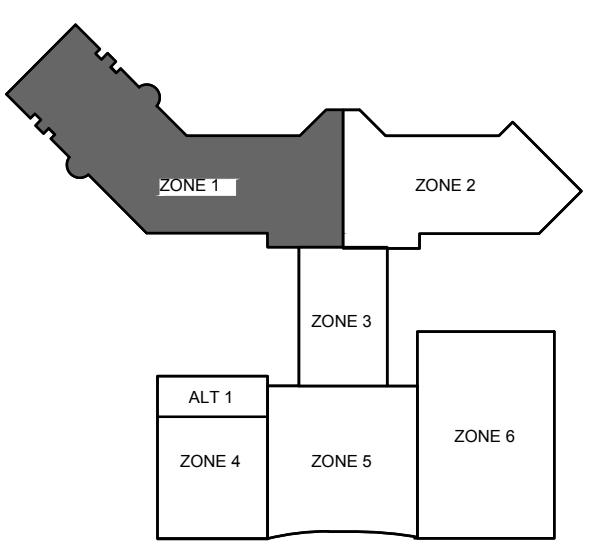

**KEY PLAN**

COPYRIGHT © 2019  
 THE WILSON GROUP ARCHITECTS  
 ALL RIGHTS RESERVED

PRINTED OR ELECTRONIC DRAWINGS AND DOCUMENTATION MAY NOT BE REPRODUCED IN ANY FORM WITHOUT WRITTEN PERMISSION FROM THE WILSON GROUP ARCHITECTS

**REVISIONS**

AD-03 07/26/2019

DATE 06/28/19  
 PROJECT NUMBER 9202-000  
 SHEET TITLE

**SCHEDULE 2 - ELECTRICAL BOARDING LEVEL LIGHTING PLAN ZONE 1**  
 SHEET NUMBER

**E2-151**


**NOTES:**  
 1. LIGHTING FIXTURE SELECTION AND LAYOUT WERE DESIGNED BY HARTRANFT LIGHTING DESIGN. INCLUSION HERE IS NOT INTENDED TO REPRESENT THAT THE FIXTURE SELECTION AND LAYOUT ARE A WORK PRODUCT OF CHEATHAM & ASSOCIATES, P.A. SEE LUMINAIRE SCHEDULE NOTE 1 FOR WHICH LIGHT FIXTURE TYPES THIS NOTE APPLIES TO.  
 2. NUMBER NEXT TO LIGHT FIXTURE INDICATES DIMMER SCHEDULED ZONE.

**KEYED NOTES:**

- ① CONNECT TO EXISTING NORMAL CIRCUIT SERVING SPACE.
- ② CONNECT TO EXISTING GENERATOR CIRCUIT SERVING SPACE.
- ③ CONNECT TO EXISTING MILLWORK LED CIRCUIT.


**SCHEDULE 2 - ELECTRICAL CLERESTORY LEVEL - LIGHTING PLAN**

SCALE: 1/8" = 1'-0"

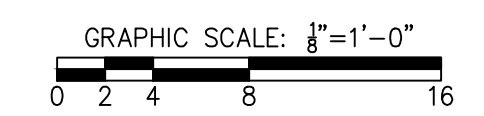

**SCHEDULE 2 - ELECTRICAL BOARDING LEVEL - LIGHTING PLAN - ZONE 1**

SCALE: 1/8" = 1'-0"

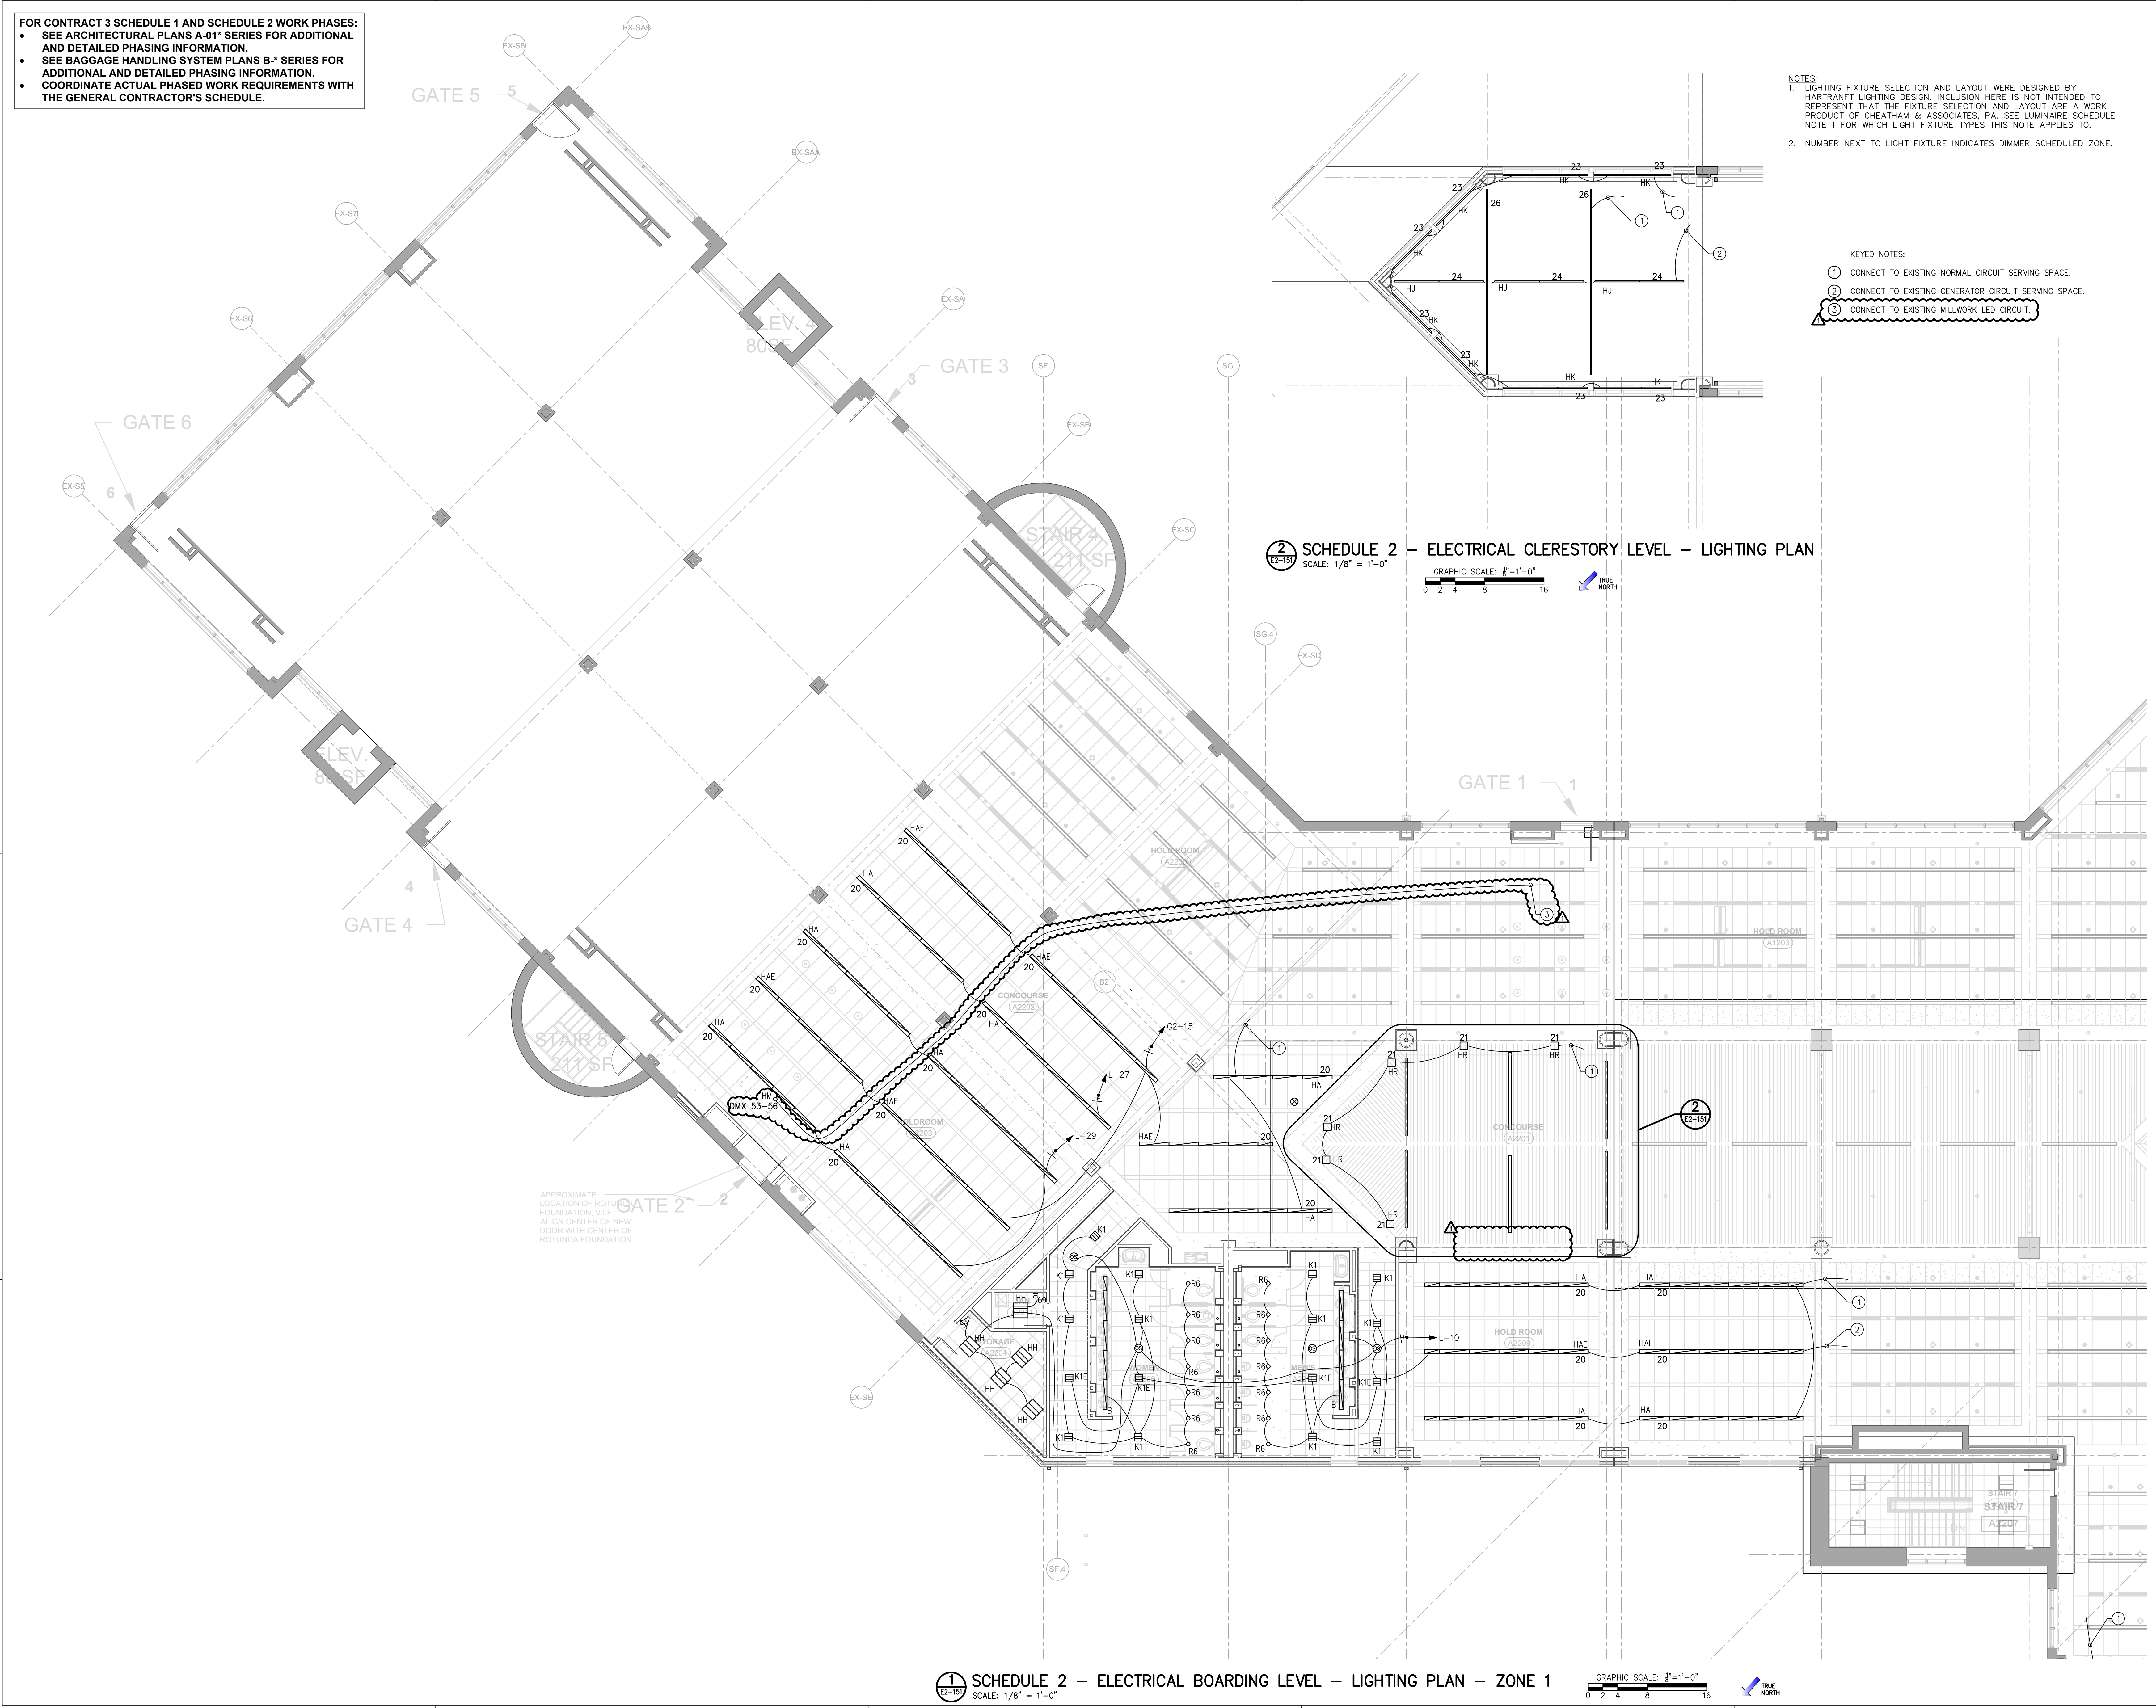


APPROXIMATE LOCATION OF ROTUNDA FOUNDATION, V.I.F. ALIGN CENTER OF NEW DOOR WITH CENTER OF ROTUNDA FOUNDATION

FOR CONTRACT 3 SCHEDULE 1 AND SCHEDULE 2 WORK PHASES:  
 • SEE ARCHITECTURAL PLANS A-01\* SERIES FOR ADDITIONAL AND DETAILED PHASING INFORMATION.  
 • SEE BAGGAGE HANDLING SYSTEM PLANS B-\* SERIES FOR ADDITIONAL AND DETAILED PHASING INFORMATION.  
 • COORDINATE ACTUAL PHASED WORK REQUIREMENTS WITH THE GENERAL CONTRACTOR'S SCHEDULE.


NOTES:  
 1. LIGHTING FIXTURE SELECTION AND LAYOUT WERE DESIGNED BY HARTRANFT LIGHTING DESIGN. INCLUSION HERE IS NOT INTENDED TO REPRESENT THAT THE FIXTURE SELECTION AND LAYOUT ARE A WORK PRODUCT OF CHEATHAM & ASSOCIATES, P.A. SEE LUMINAIRE SCHEDULE NOTE 1 FOR WHICH LIGHT FIXTURE TYPES THIS NOTE APPLIES TO.  
 2. NUMBER NEXT TO LIGHT FIXTURE INDICATES DIMMER SCHEDULED ZONE. SEE E2-156.

KEYED NOTES:  
 ① #10 CONDUCTORS USED FOR BRANCH CIRCUIT INDICATED.  
 ② PROPOSED LOCATION OF LIGHTING CIRCUIT HOMERUNS TO TRANSITION FROM ABOVE CEILING TO BELOW SLAB FOR CONTINUATION OF HOMERUNS IN RAMP LEVEL CEILING CAVITY TO PANEL LTG LOCATED IN EXISTING TICKETING AREA MECHANICAL ROOM 34. SEE E2-155 FOR LOCATION OF PANEL LTG.

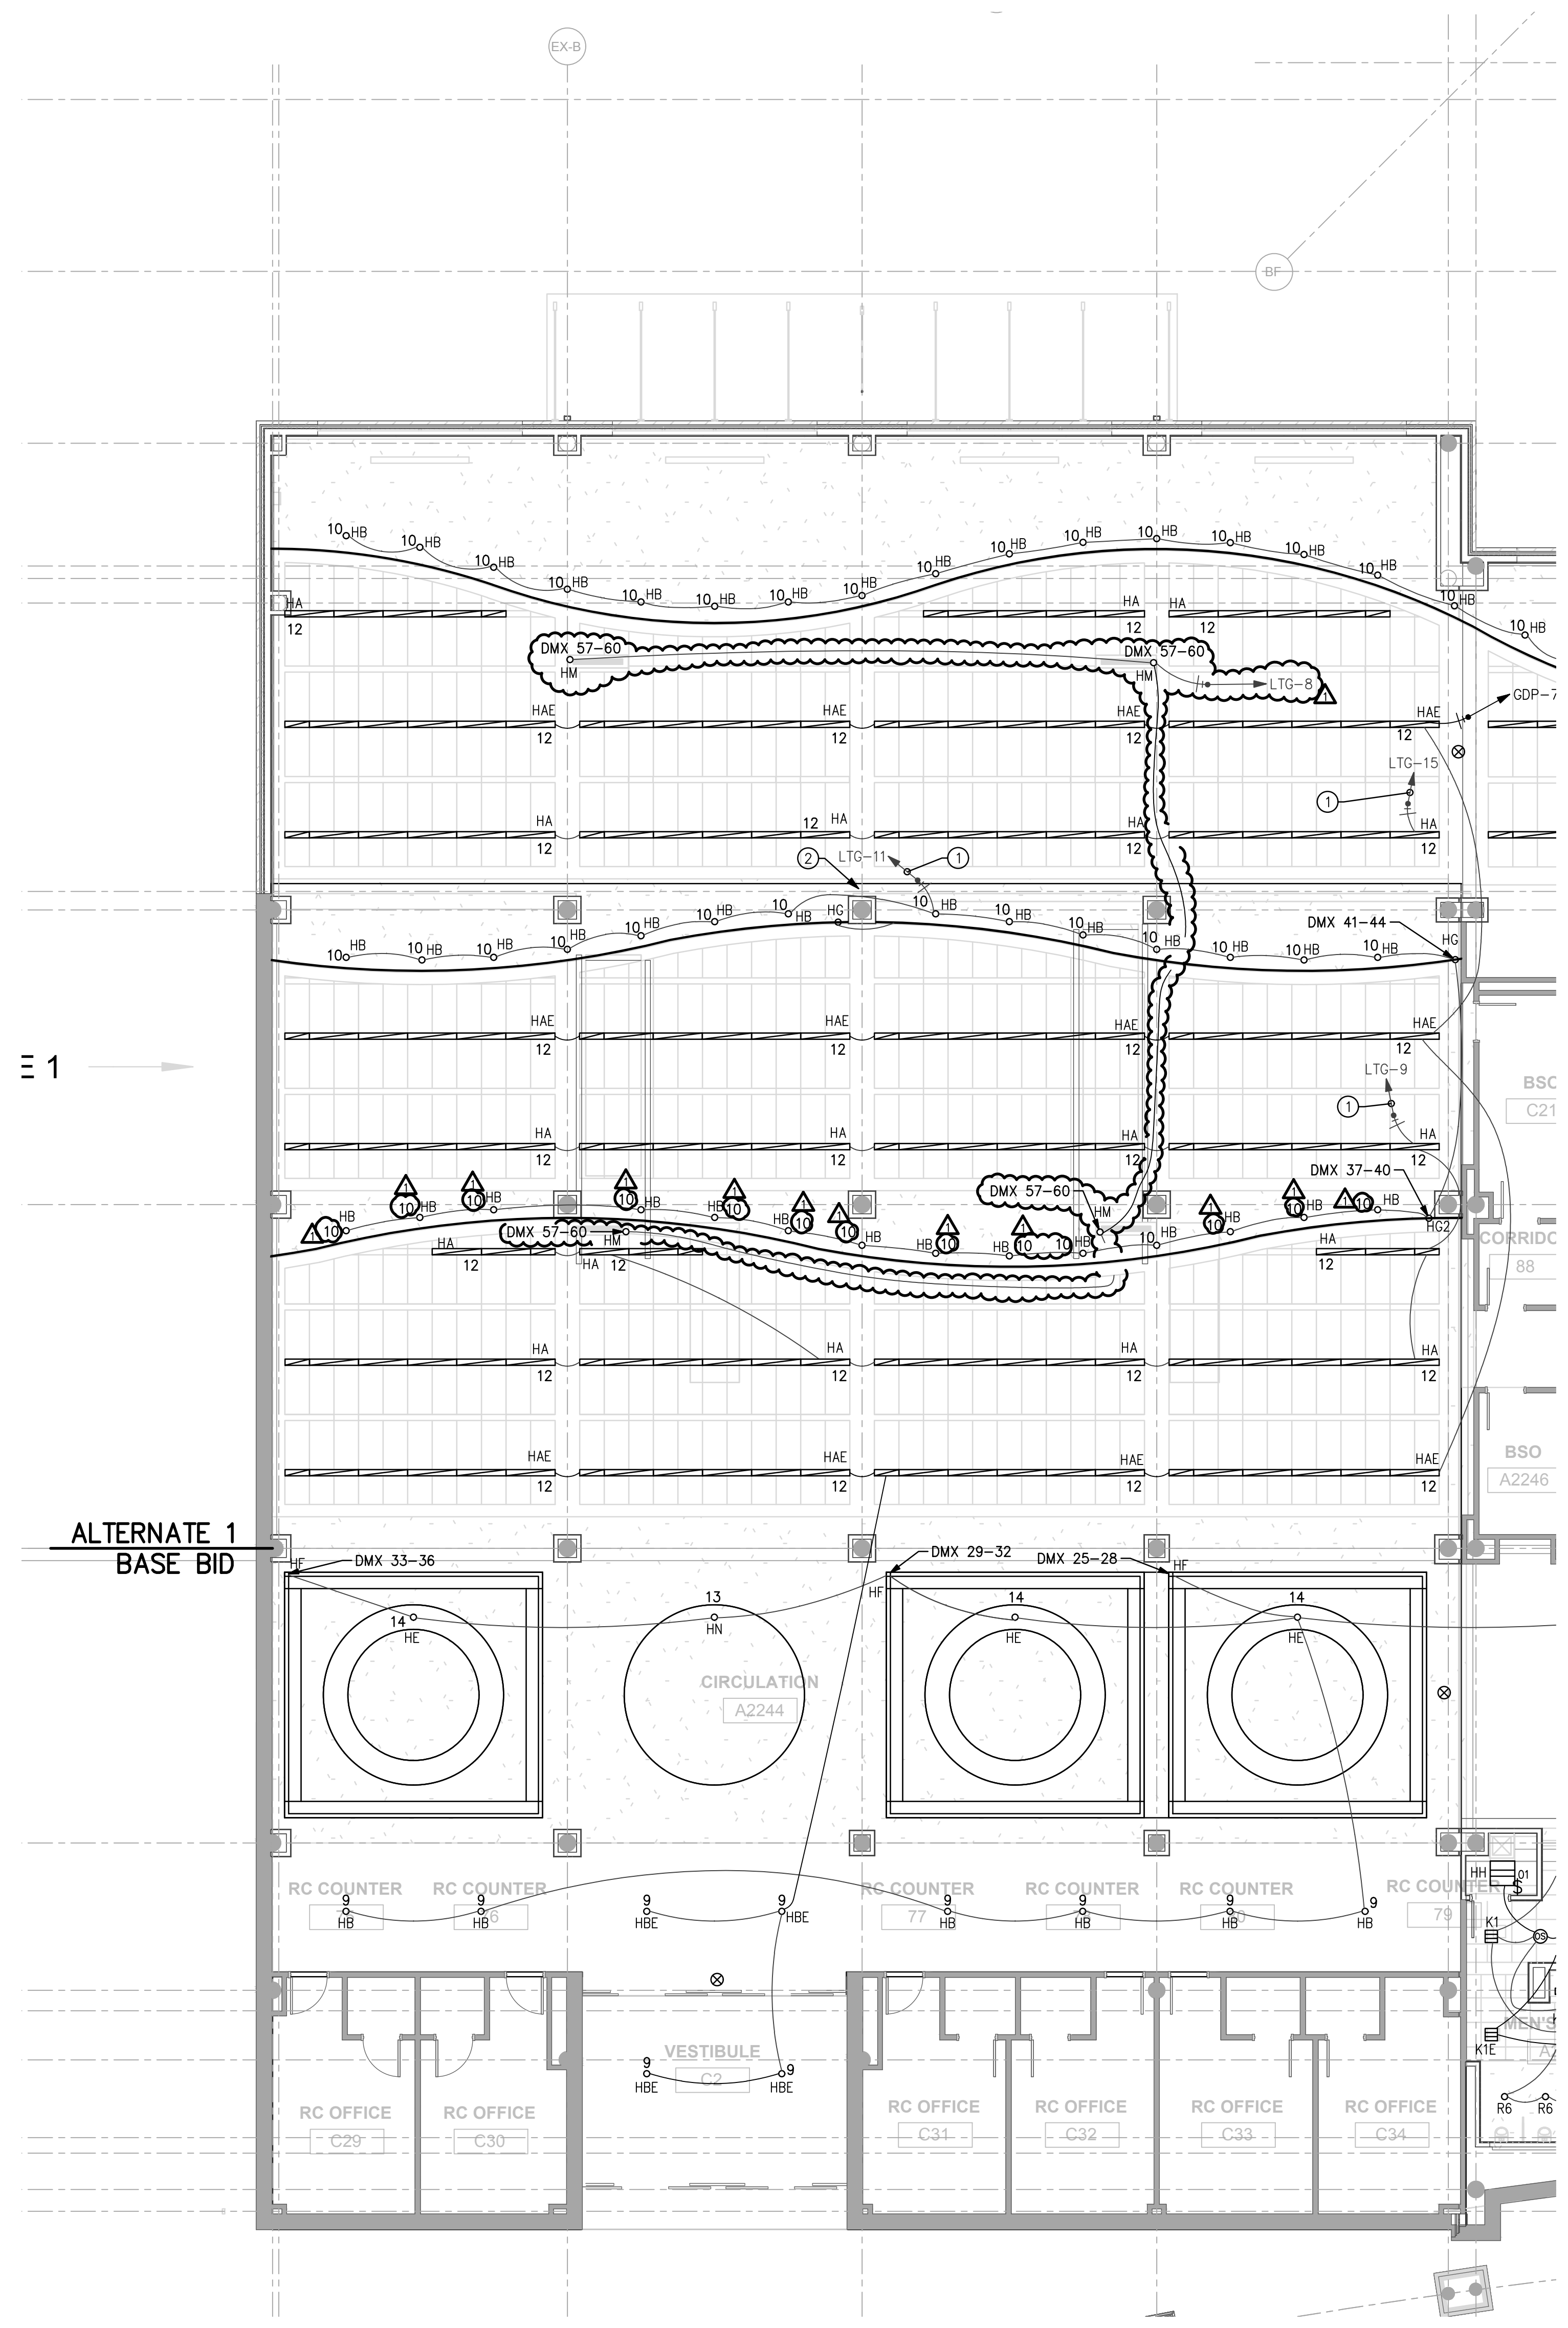


ALTERNATE 1  
 BASE BID

① SCHEDULE 2 - ELECTRICAL BOARDING LEVEL - LIGHTING PLAN - ZONE 4  
 SCALE: 1/8" = 1'-0"

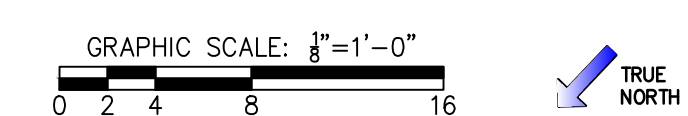


**ILM**  
**TERMINAL IMPROVEMENTS CONTRACT 3**  
 Wilmington International Airport  
 1740 Airport Boulevard, Suite 12  
 Wilmington, NC 28405

**CHEATHAM & ASSOCIATES, P.A.**  
 CONSULTING ENGINEERS  
 3412 ENTERPRISE DRIVE  
 WILMINGTON, NORTH CAROLINA 28405  
 PHONE: (910) 452-4210  
 FAX: (910) 452-4211  
 OFFICE@CHEATHAMPA.COM  
 NC LICENSE# C-1673  
**JOB # 19005**

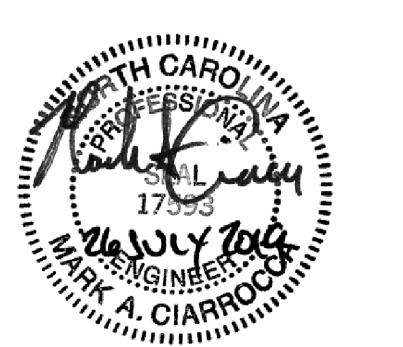

**THE WILSON GROUP**  
 - ARCHITECTS -  
 PO Box 5510 Charlotte, NC 28299  
 704-331-9747 • www.twgarchitects.com

PROJECT MANAGER & CIVIL ENGINEER  
**TALBERT & BRIGHT**  
 CONSULTING ARCHITECT  
 LS3P  
 STRUCTURAL ENGINEER  
 STEWART  
 FPP/PM/E ENGINEER  
**CHEATHAM & ASSOC.**  
 BAGGAGE HANDLING CONSULTANTS  
 BNP  
 AIRCRAFT SUPPORT SYSTEMS  
**DK CONSULTANTS**  
 SPECIALTY LIGHTING CONSULTANT  
**HARTRANFT**  
 SIGNAGE & WAYFINDING  
**TAKEFORM**

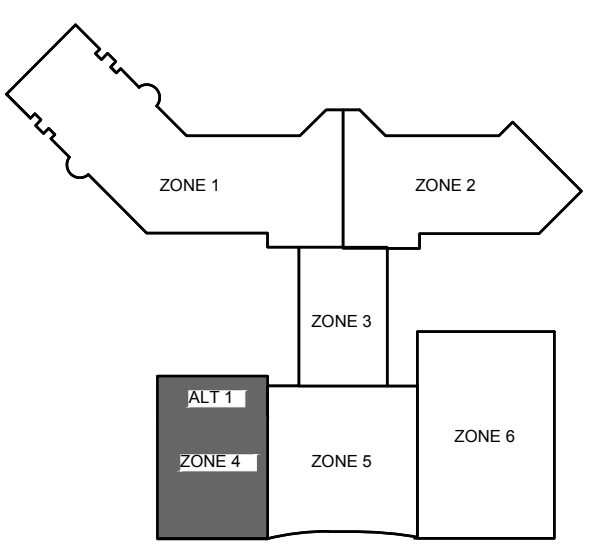

**KEY PLAN**  
 COPYRIGHT © 2019  
 THE WILSON GROUP ARCHITECTS  
 ALL RIGHTS RESERVED  
 PRINTED OR ELECTRONIC DRAWINGS AND DOCUMENTATION MAY NOT BE REPRODUCED IN ANY FORM WITHOUT WRITTEN PERMISSION FROM THE WILSON GROUP ARCHITECTS


REVISIONS  
 Δ AD-03 07/26/2019

DATE 06/28/19  
 PROJECT NUMBER 9202-000  
 SHEET TITLE  
**SCHEDULE 2 - ELECTRICAL BOARDING LEVEL LIGHTING PLAN ZONE 4**  
 SHEET NUMBER

**E2-154**

FOR CONTRACT 3 SCHEDULE 1 AND SCHEDULE 2 WORK PHASES:

- SEE ARCHITECTURAL PLANS A-01\* SERIES FOR ADDITIONAL AND DETAILED PHASING INFORMATION.
- SEE BAGGAGE HANDLING SYSTEM PLANS B-\* SERIES FOR ADDITIONAL AND DETAILED PHASING INFORMATION.
- COORDINATE ACTUAL PHASED WORK REQUIREMENTS WITH THE GENERAL CONTRACTOR'S SCHEDULE.

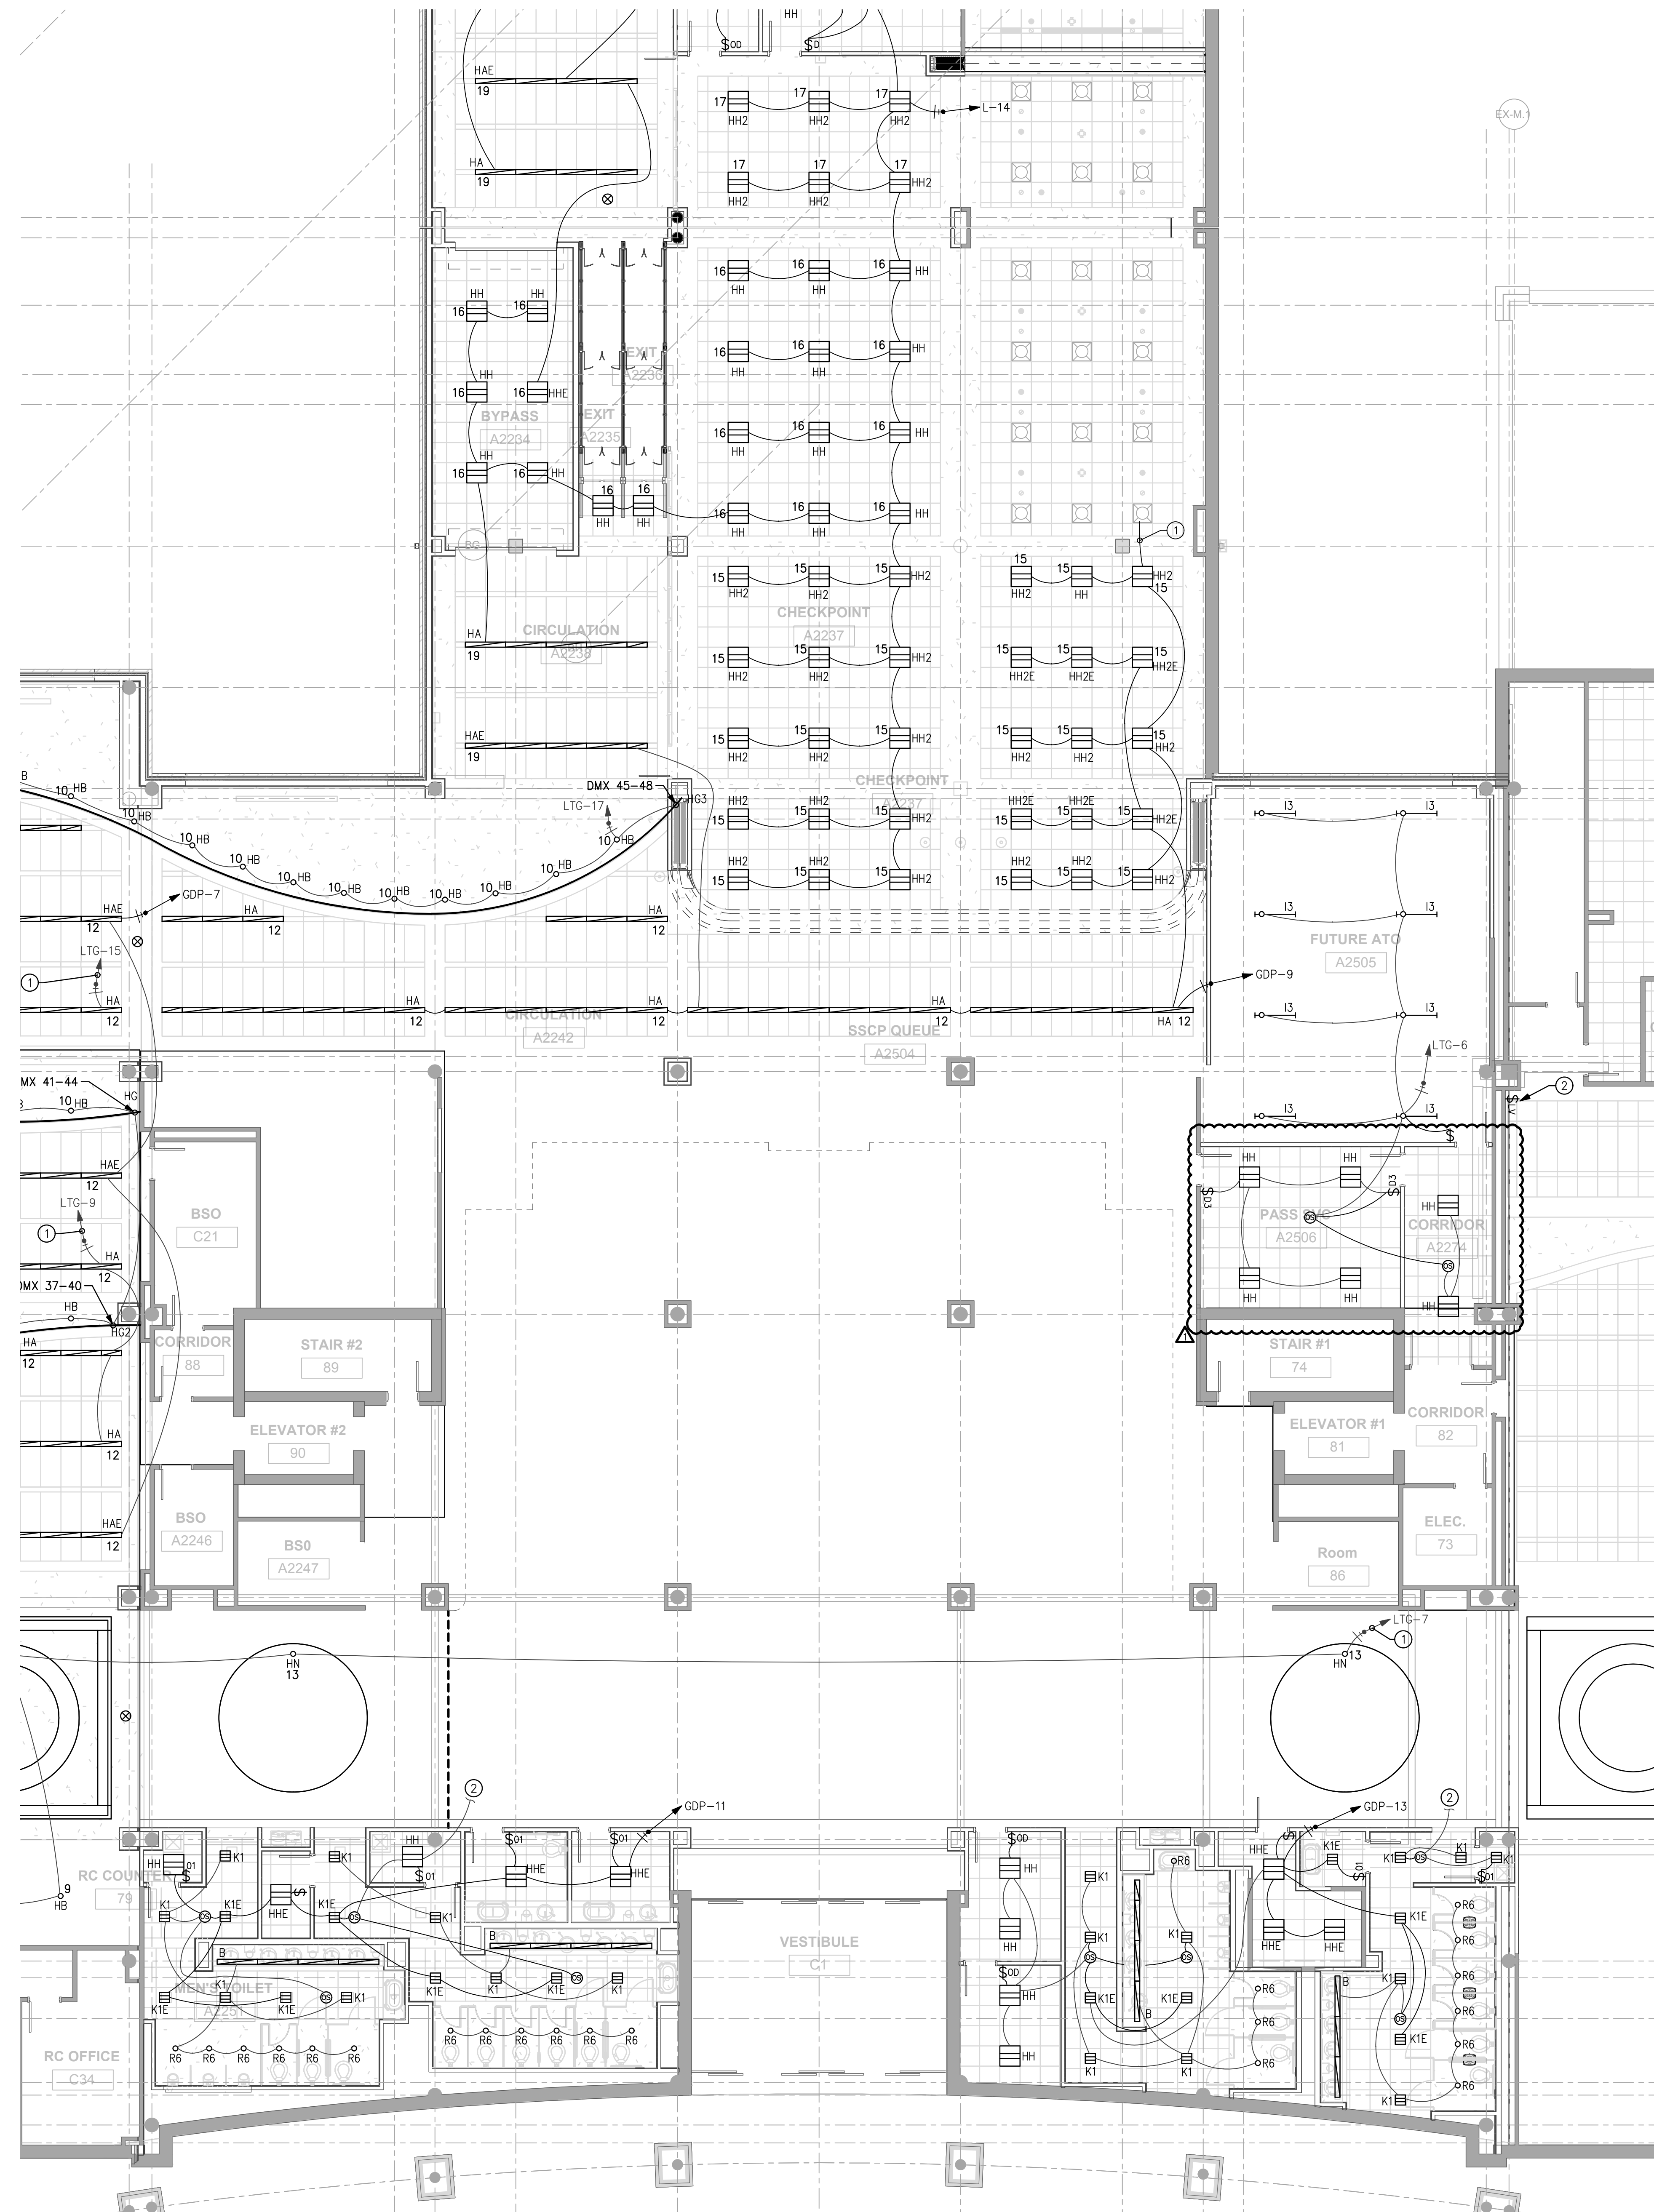


NOTES:

1. LIGHTING FIXTURE SELECTION AND LAYOUT WERE DESIGNED BY HARTRANFT LIGHTING DESIGN. INCLUSION HERE IS NOT INTENDED TO REPRESENT THAT THE FIXTURE SELECTION AND LAYOUT ARE A WORK PRODUCT OF CHEATHAM & ASSOCIATES, P.A. SEE LUMINAIRE SCHEDULE NOTE 1 FOR WHICH LIGHT FIXTURE TYPES THIS NOTE APPLIES TO.
2. NUMBER NEXT TO LIGHT FIXTURE INDICATES DIMMER SCHEDULED ZONE.

KEYED NOTES:

- ① #10 CONDUCTORS USED FOR BRANCH CIRCUIT INDICATED.
- ② CONNECT TO EXISTING CIRCUITS PREVIOUSLY SERVING SPACE.

1 SCHEDULE 2 - ELECTRICAL BOARDING LEVEL - LIGHTING PLAN - ZONE 5  
 SCALE: 1/8" = 1'-0"  
 GRAPHIC SCALE: 1" = 1'-0"  
 0 2 4 6 8 10 12 14 16  
 TRUE NORTH

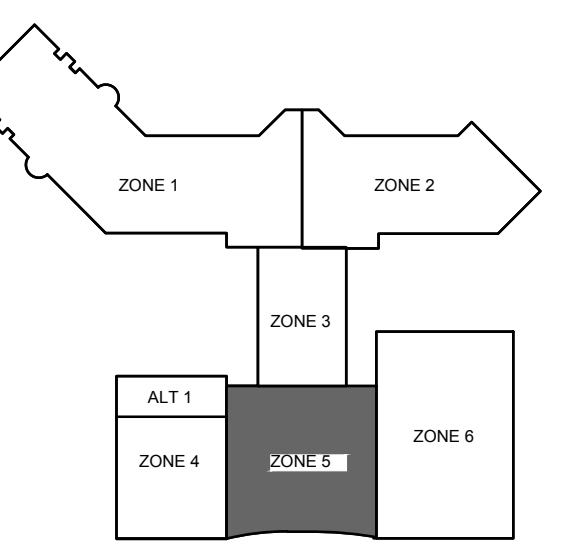

**KEY PLAN**  
 COPYRIGHT © 2019  
 THE WILSON GROUP ARCHITECTS  
 ALL RIGHTS RESERVED

PRINTED OR ELECTRONIC DRAWINGS AND DOCUMENTATION MAY NOT BE REPRODUCED IN ANY FORM WITHOUT WRITTEN PERMISSION FROM THE WILSON GROUP ARCHITECTS

REVISIONS  
 Δ AD-03 07/26/2019

DATE 06/28/19  
 PROJECT NUMBER 9202-000  
 SHEET TITLE  
**SCHEDULE 2 - ELECTRICAL BOARDING LEVEL LIGHTING PLAN ZONE 5**  
 SHEET NUMBER

**E2-155**

FOR CONTRACT 3 SCHEDULE 1 AND SCHEDULE 2 WORK PHASES:  
 • SEE ARCHITECTURAL PLANS A-01\* SERIES FOR ADDITIONAL AND DETAILED PHASING INFORMATION.  
 • SEE BAGGAGE HANDLING SYSTEM PLANS B-\* SERIES FOR ADDITIONAL AND DETAILED PHASING INFORMATION.  
 • COORDINATE ACTUAL PHASED WORK REQUIREMENTS WITH THE GENERAL CONTRACTOR'S SCHEDULE.





**TERMINAL IMPROVEMENTS CONTRACT 3**

Wilmington International Airport  
 1740 Airport Boulevard, Suite 12  
 Wilmington, NC 28405

**CHEATHAM & ASSOCIATES, P.A.**  
 CONSULTING ENGINEERS  
 3412 ENTERPRISE DRIVE  
 WILMINGTON, NORTH CAROLINA 28405  
 PHONE: (919) 452-4210  
 FAX: (919) 452-4211  
 OFFICE@CHEATHAMPA.COM  
 NC LICENSE# C-1073

JOB # 19005

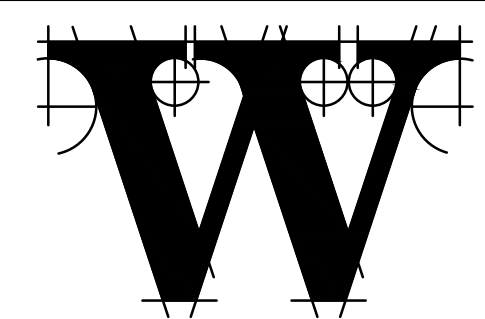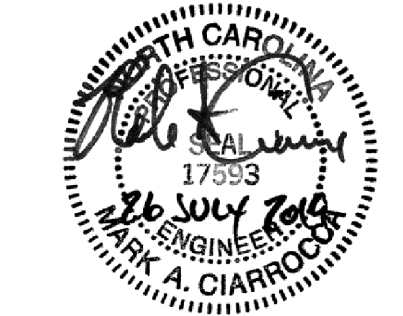

**THE WILSON GROUP - ARCHITECTS -**

PO Box 5510 Charlotte, NC 28289  
 704-331-9747 • www.twgarchitects.com

PROJECT MANAGER & CIVIL ENGINEER  
**TALBERT & BRIGHT**  
 CONSULTING ARCHITECT  
 LS3P

STRUCTURAL ENGINEER  
**STEWART**


FP/PM/E ENGINEER  
**CHEATHAM & ASSOC.**

BAGGAGE HANDLING CONSULTANTS  
**BNP**

AIRCRAFT SUPPORT SYSTEMS  
**DK CONSULTANTS**

SPECIALTY LIGHTING CONSULTANT  
**HARTRANFT**

SIGNAGE & WAYFINDING  
**TAKEFORM**

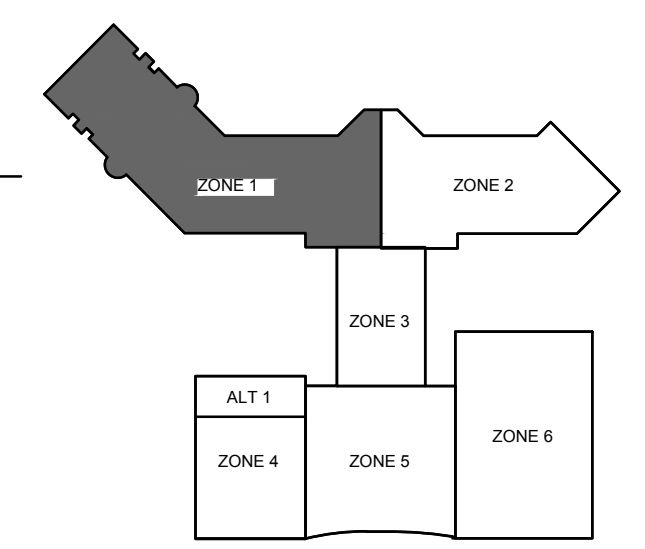

**KEY PLAN**

COPYRIGHT © 2019  
 THE WILSON GROUP ARCHITECTS  
 ALL RIGHTS RESERVED

PRINTED OR ELECTRONIC DRAWINGS AND DOCUMENTATION MAY NOT BE REPRODUCED IN ANY FORM WITHOUT WRITTEN PERMISSION FROM THE WILSON GROUP ARCHITECTS


**REVISIONS**

AD-03 07/26/2019


DATE 06/28/19  
 PROJECT NUMBER 9202-000  
 SHEET TITLE

**SCHEDULE 2 - ELECTRICAL BOARDING LEVEL AUXILIARY SYSTEMS PLAN ZONE 1**  
 SHEET NUMBER


**E2-161**

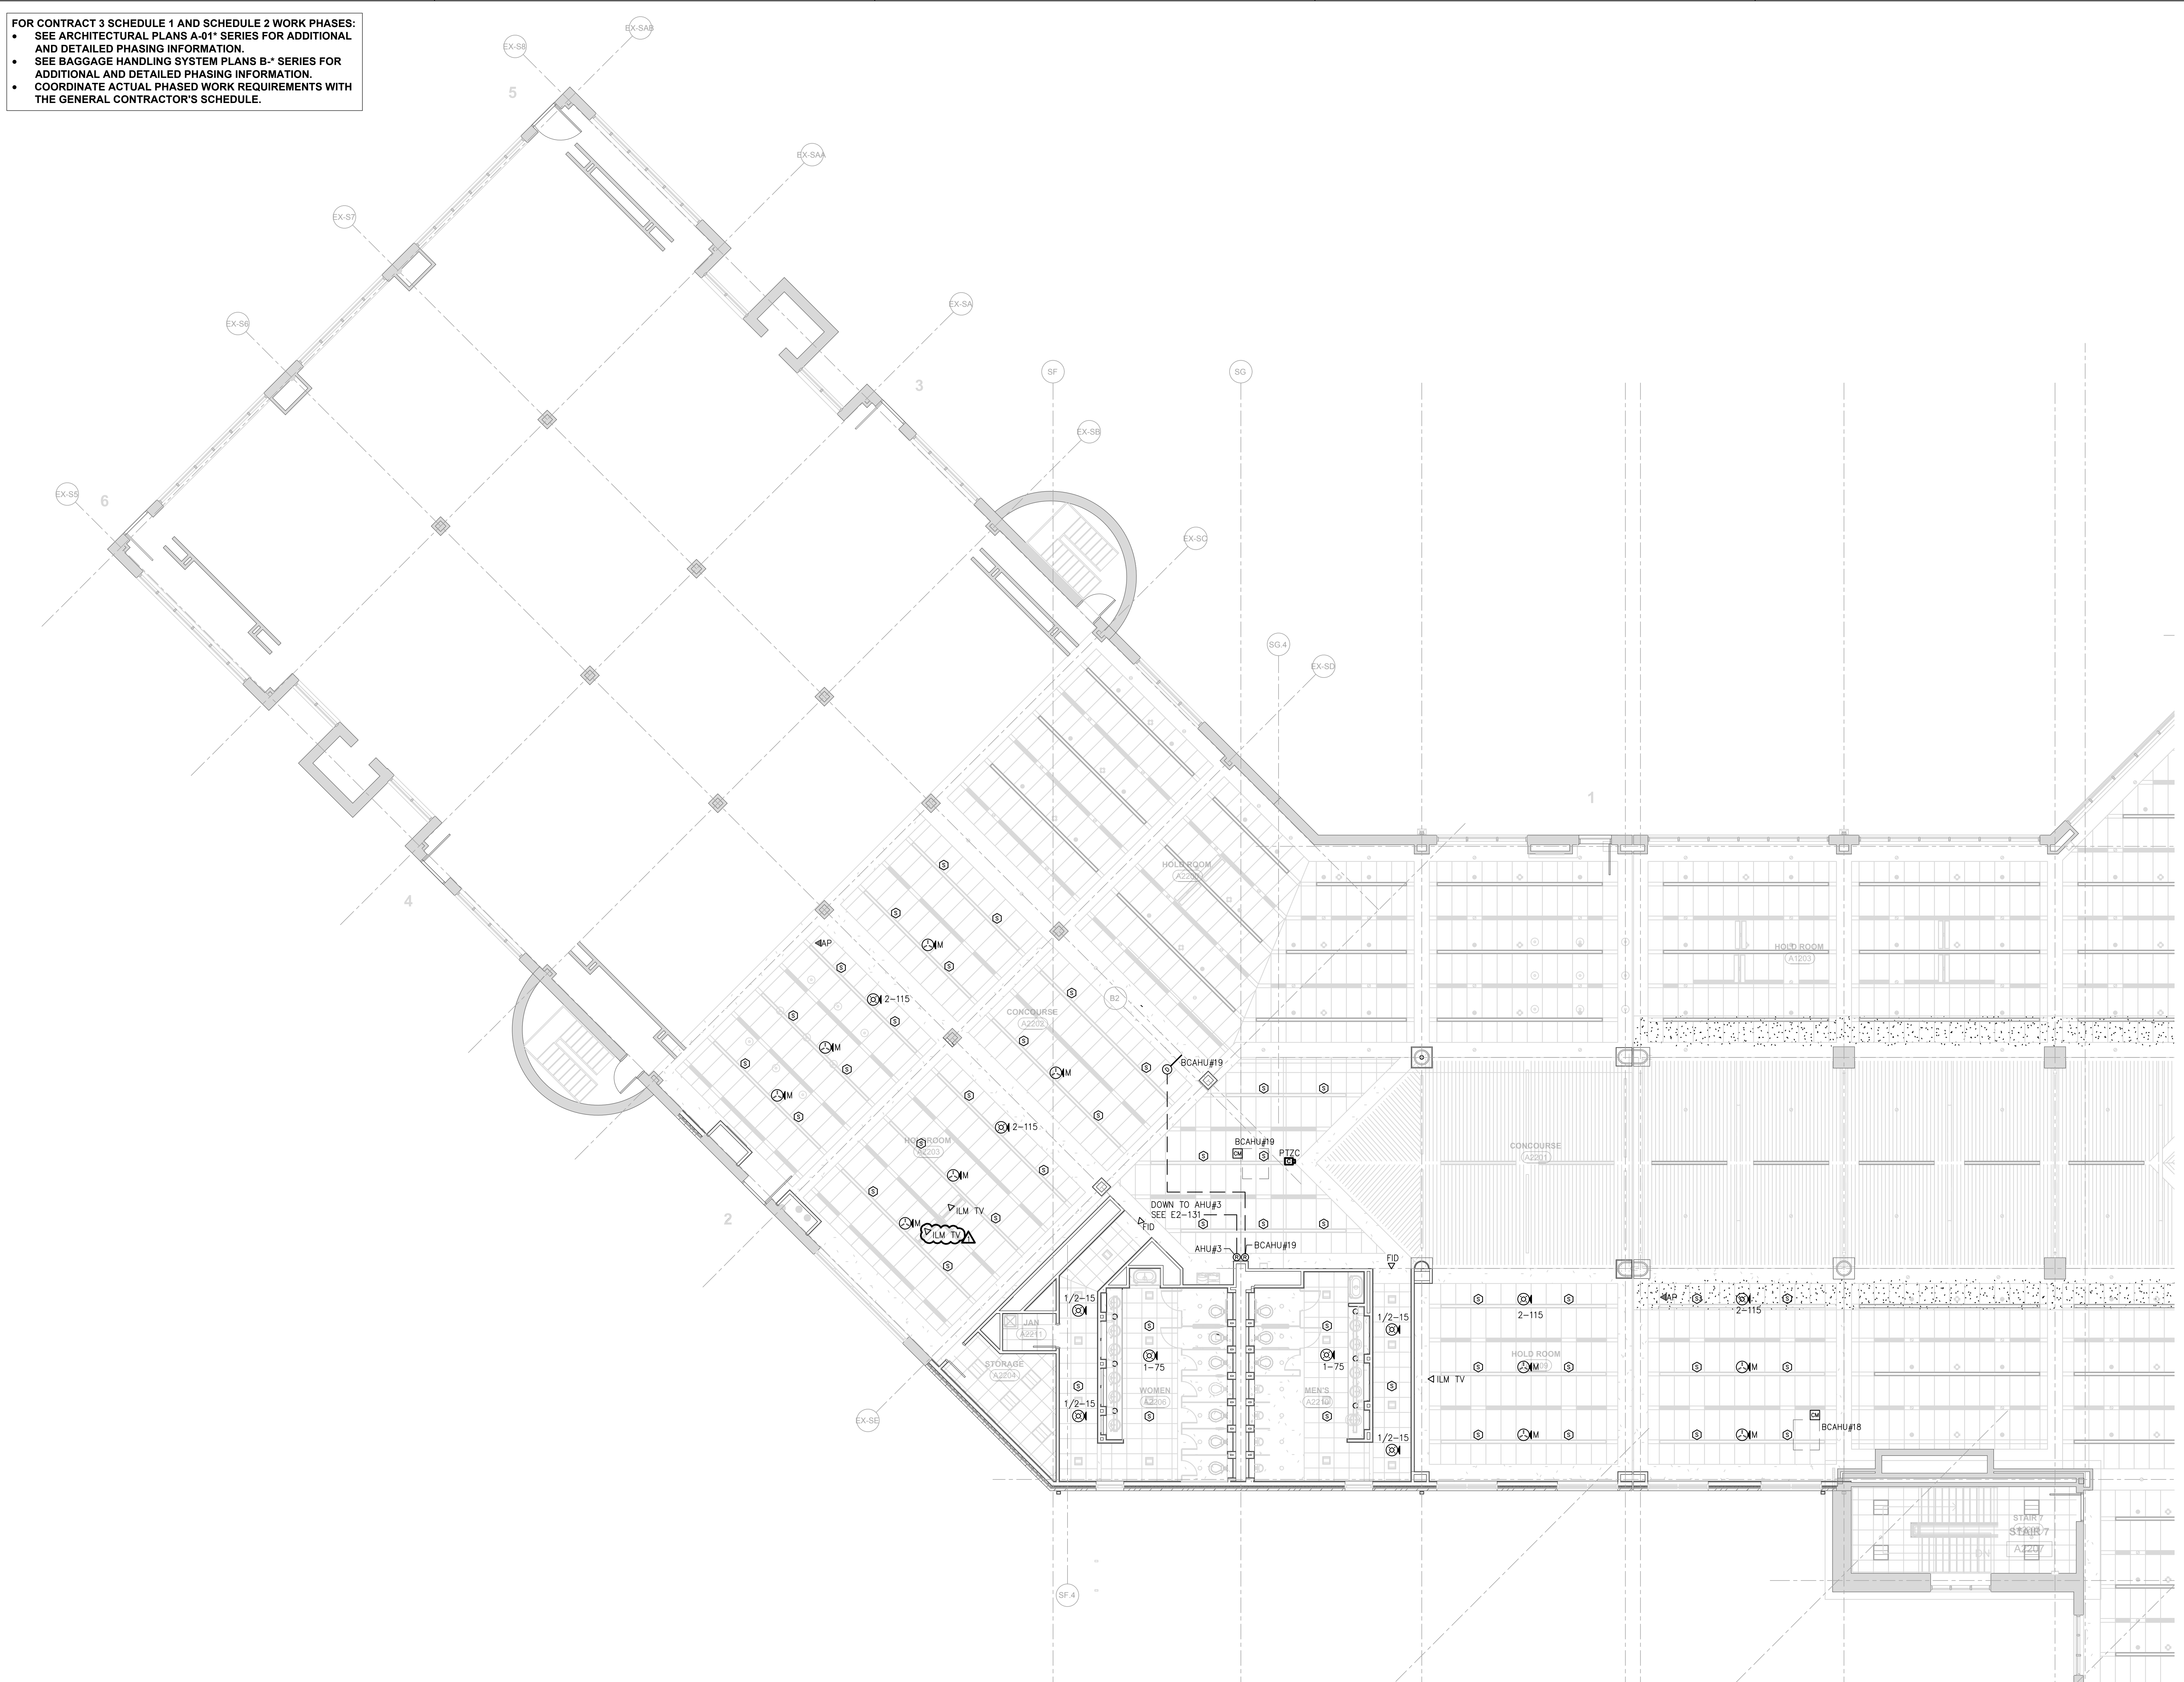

**SCHEDULE 2 - ELECTRICAL BOARDING LEVEL - AUXILIARY SYSTEMS PLAN - ZONE 1**  
 SCALE: 1/8" = 1'-0" GRAPHIC SCALE: 1"=1'-0"

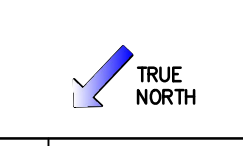

FOR CONTRACT 3 SCHEDULE 1 AND SCHEDULE 2 WORK PHASES:  
 • SEE ARCHITECTURAL PLANS A-01\* SERIES FOR ADDITIONAL AND DETAILED PHASING INFORMATION.  
 • SEE BAGGAGE HANDLING SYSTEM PLANS B-\* SERIES FOR ADDITIONAL AND DETAILED PHASING INFORMATION.  
 • COORDINATE ACTUAL PHASED WORK REQUIREMENTS WITH THE GENERAL CONTRACTOR'S SCHEDULE.

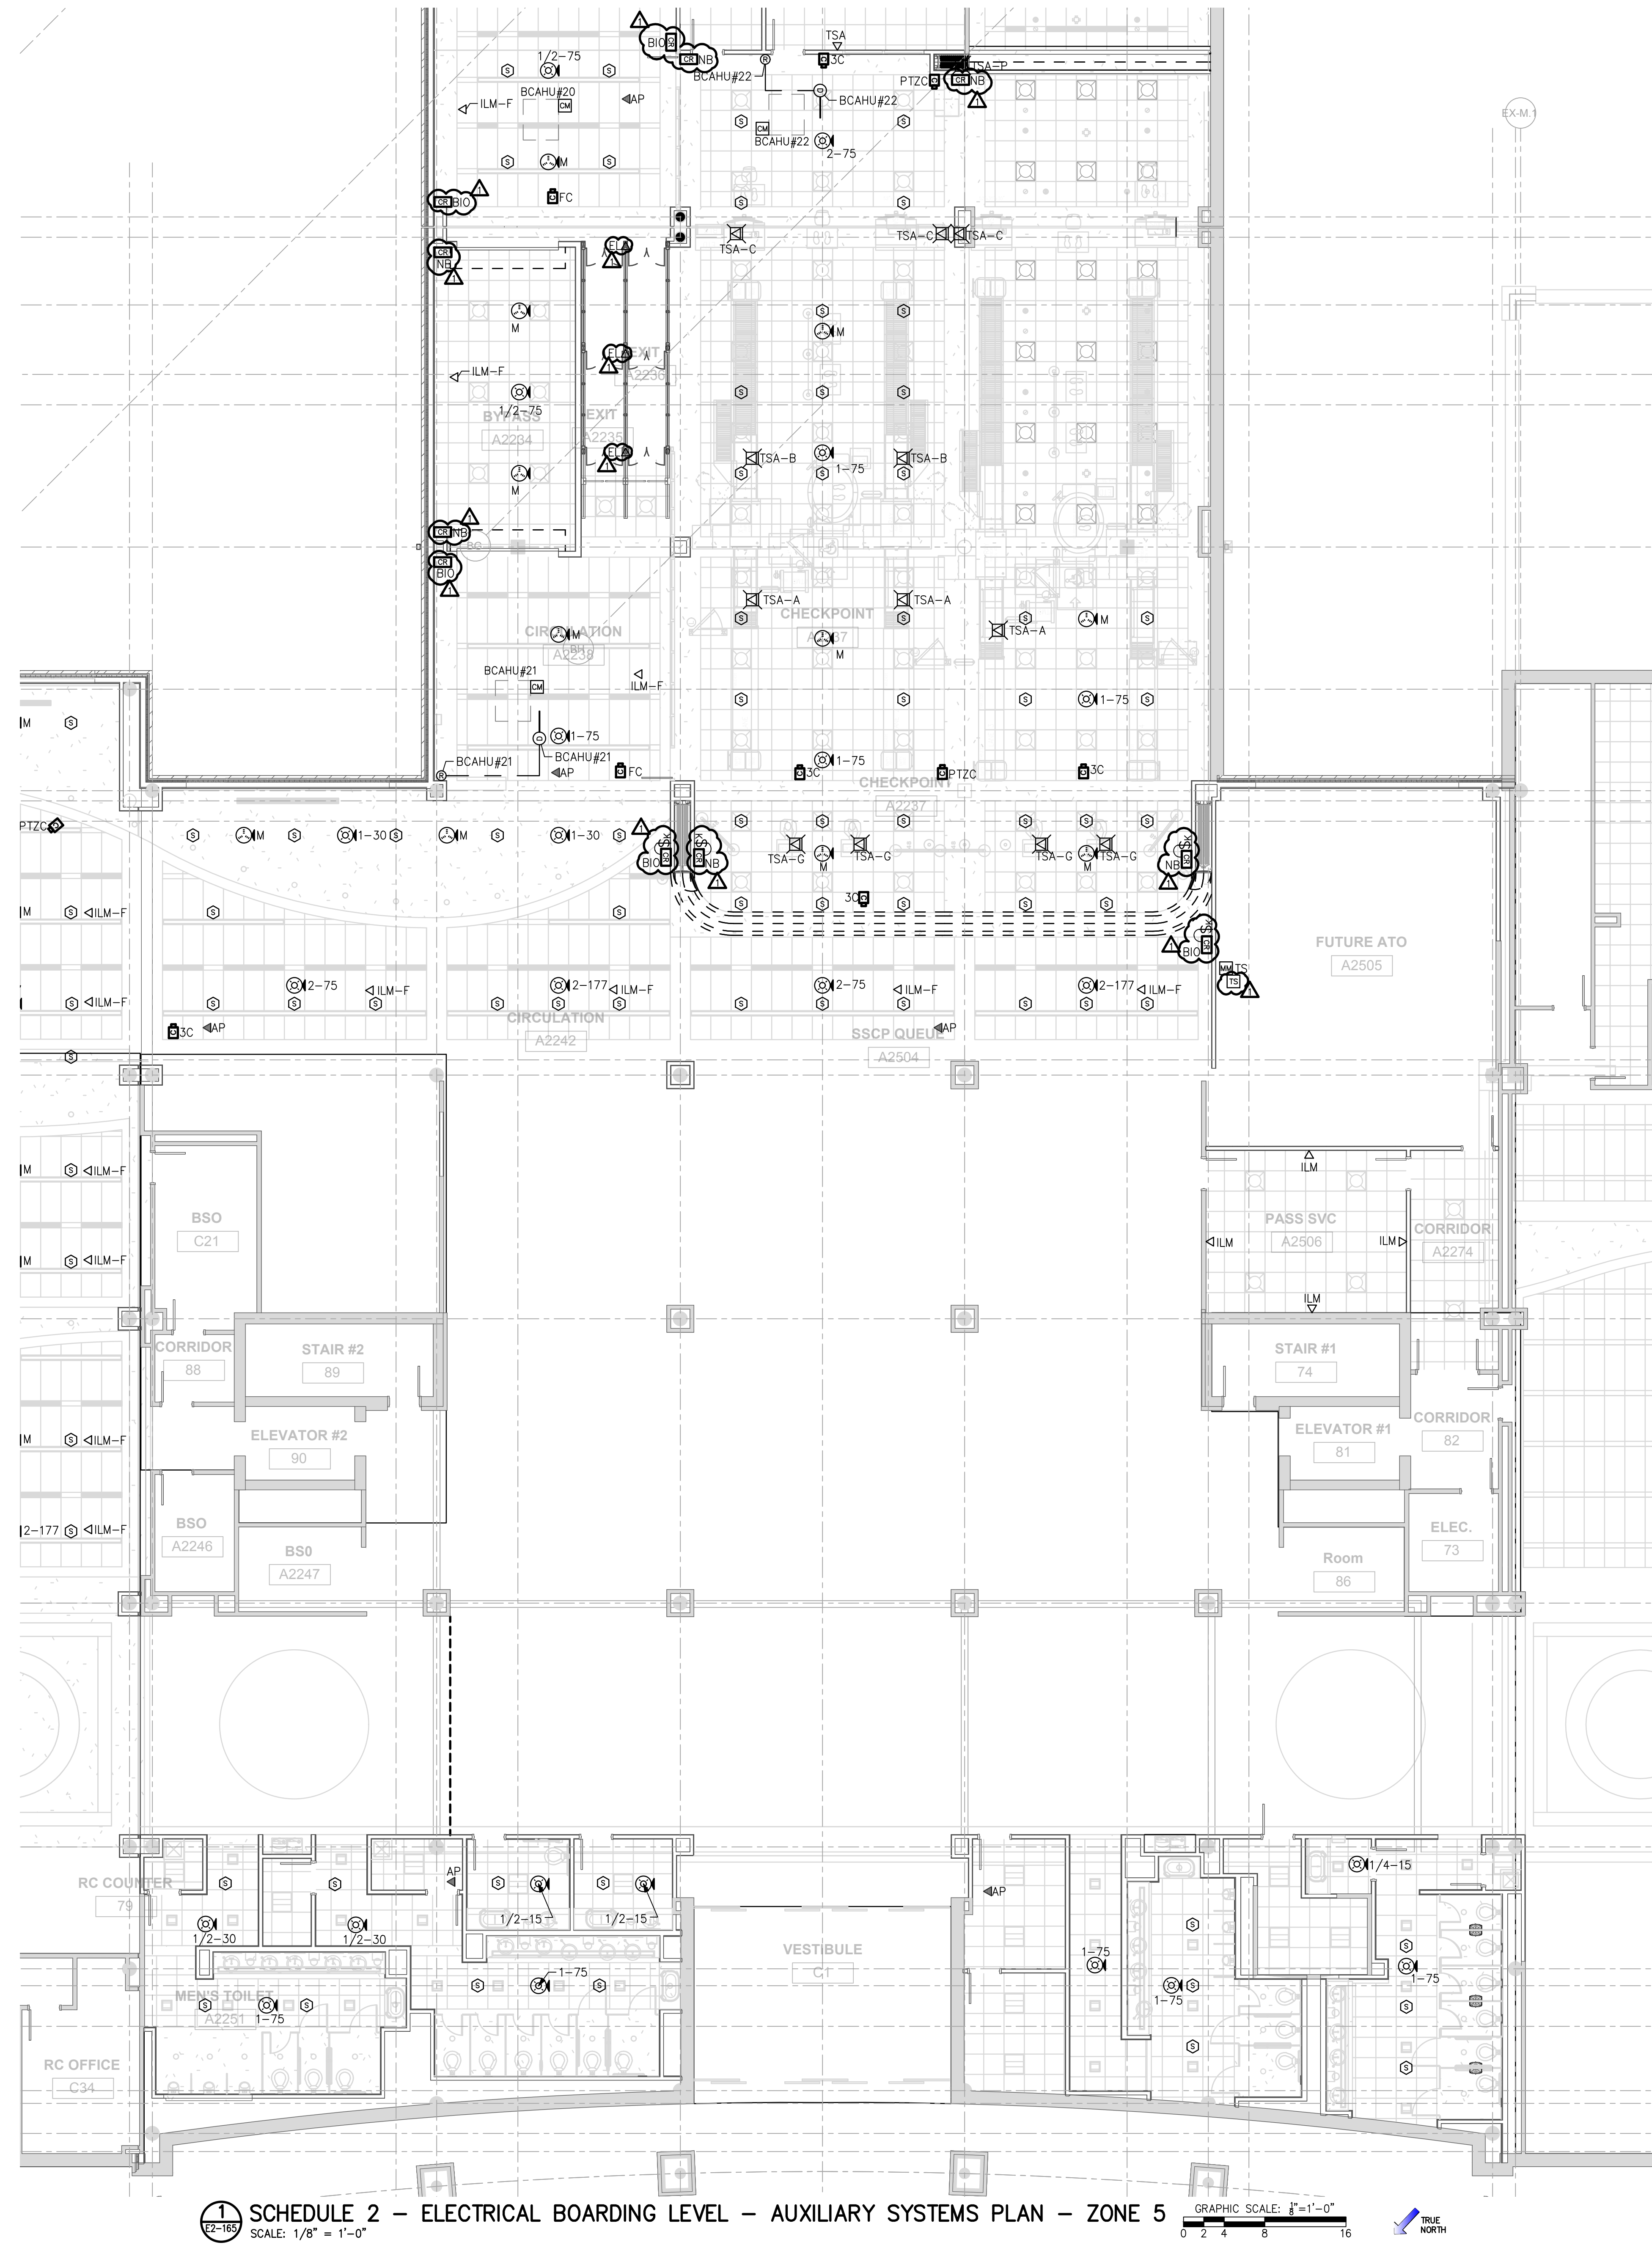

**SCHEDULE 2 - ELECTRICAL BOARDING LEVEL - AUXILIARY SYSTEMS PLAN - ZONE 5**  
 SCALE: 1/8" = 1'-0"  
 GRAPHIC SCALE: 1" = 1'-0"  
 TRUE NORTH





**TERMINAL IMPROVEMENTS CONTRACT 3**

Wilmington International Airport  
 1740 Airport Boulevard, Suite 12  
 Wilmington, NC 28405

**CHEATHAM & ASSOCIATES, P.A.**  
 CONSULTING ENGINEERS  
 3412 ENTERPRISE DRIVE  
 WILMINGTON, NORTH CAROLINA 28405  
 PHONE: (919) 452-4210  
 FAX: (919) 452-4211  
 OFFICE@CHEATHAM.PA.COM  
 NC LICENSE# C-1073

JOB # 19005

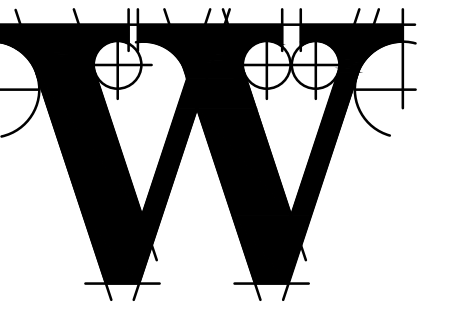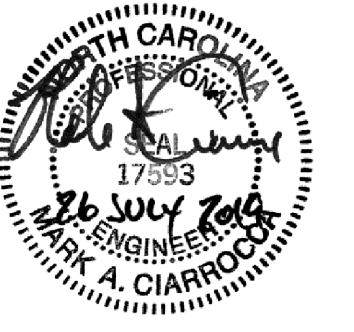

**THE WILSON GROUP**  
 - ARCHITECTS -

PO Box 5510 Charlotte, NC 28299  
 704-331-9747 • www.twgarchitects.com

PROJECT MANAGER & CIVIL ENGINEER  
**TALBERT & BRIGHT**  
 CONSULTING ARCHITECT  
 LS3P

STRUCTURAL ENGINEER  
 STEWART


FP/PM/E ENGINEER  
**CHEATHAM & ASSOC.**

BAGGAGE HANDLING CONSULTANTS  
 BNP

AIRCRAFT SUPPORT SYSTEMS  
 DK CONSULTANTS

SPECIALTY LIGHTING CONSULTANT  
 HARTRANFT

SIGNAGE & WAYFINDING  
 TAKEFORM

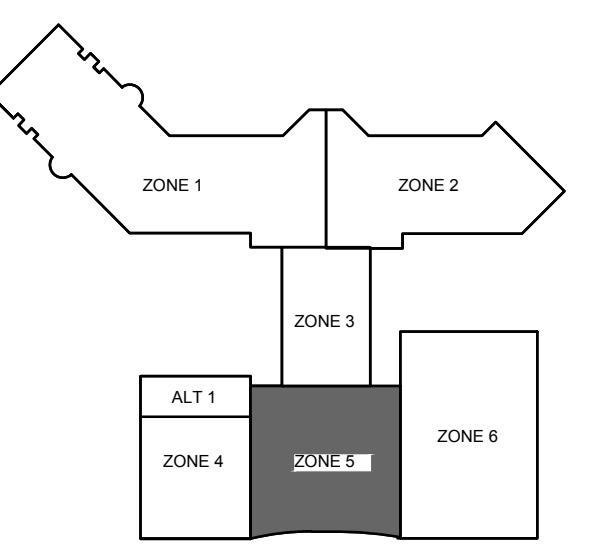

**KEY PLAN**

COPYRIGHT © 2019  
 THE WILSON GROUP ARCHITECTS  
 ALL RIGHTS RESERVED

PRINTED OR ELECTRONIC DRAWINGS AND DOCUMENTATION MAY NOT BE REPRODUCED IN ANY FORM WITHOUT WRITTEN PERMISSION FROM THE WILSON GROUP ARCHITECTS

**REVISIONS**

AD-03 07/26/2019

DATE 06/28/19  
 PROJECT NUMBER 9202-000  
 SHEET TITLE

**SCHEDULE 2 - ELECTRICAL BOARDING LEVEL AUXILIARY SYSTEMS PLAN ZONE 5**  
 SHEET NUMBER

**E2-165**



LUMINAIRE SCHEDULE

CALLOUT	SYMBOL	DESCRIPTION	LAMP	BALLAST	VOLTS	MOUNTING	MANUFACTURER / MODEL	NOTES	CALLOUT
A2M		2x2 RECESSED, PRISMATIC LENS	(1) 37W LED	LED DRIVER	277V 1P 2W	RECESSED	COLUMBIA #LJT SERIES DAYBRITE #27 LED SERIES METALUX #26R LED SERIES	3000 NOMINAL LUMENS, 4000K COLOR TEMPERATURE, 0.156" NOMINAL LENS. DAMP LOCATION LISTED. IC-RATED.	A2M
A2ME		2x2 RECESSED, PRISMATIC LENS, BACKED UP BY EMERGENCY GENERATOR	(1) 37W LED	LED DRIVER	277V 1P 2W	RECESSED	COLUMBIA #LJT SERIES DAYBRITE #27 LED SERIES METALUX #26R LED SERIES	3000 NOMINAL LUMENS, 4000K COLOR TEMPERATURE, 0.156" NOMINAL LENS. DAMP LOCATION LISTED. IC-RATED.	A2ME
B		RECESSED LINEAR WITH LENS	(1) 20W LED	LED DIMMABLE DRIVER	277V 1P 2W	RECESSED	PRUDENTIAL LIGHTING #P33 SERIES FLOXWERK EQUIVALENT PEERLESS EQUIVALENT	1600 NOMINAL LUMENS PER 4 FT. 3000K COLOR TEMPERATURE. FINISH SELECTION BY ARCHITECT; FLANGE KIT. SEE PLAN FOR OVERALL LENGTH. SEE NOTE 1.	B
G		4" GASKETED LED, VERTICALLY MOUNTED	(1) 40W LED	LED DRIVER	120V 1P 2W	WALL; 6"-0" AFF	PARAMOUNT #J2 SERIES PHILIPS EQUIVALENT FAILSAFE #FVSL2 SERIES	4000 NOMINAL LUMENS, 4000K COLOR TEMPERATURE, STAINLESS STEEL MOUNTING HARDWARE & LENS CLAMPS. VERTICALLY MOUNTED. COORDINATE LOCATION WITH ELEVATOR INSTALLER / VENDOR.	G
GS		4" GASKETED INDUSTRIAL	(1) 47W LED	LED DRIVER	277V 1P 2W	PENDANT, BOTTOM OF CATHWALK	COLUMBIA #LXEM SERIES DAYBRITE #DWA6 SERIES METALUX #4VT SERIES	5500 NOMINAL LUMENS, 5000K COLOR TEMPERATURE, FROSTED LENS, STAINLESS STEEL LATCHES.	GS
GT		8" GASKETED INDUSTRIAL	(1) 135W LED	LED DRIVER	277V 1P 2W	PENDANT, 12' AFG UNO	COLUMBIA #LXES SERIES DAYBRITE #DWA6 SERIES METALUX #4VT SERIES	14000 NOMINAL LUMENS, 5000K COLOR TEMPERATURE, FROSTED LENS, STAINLESS STEEL LATCHES.	GT
GTE		8" GASKETED INDUSTRIAL, BACKED UP BY EMERGENCY GENERATOR	(1) 135W LED	LED DRIVER	277V 1P 2W	PENDANT, 12' AFG UNO	COLUMBIA #LXES SERIES DAYBRITE #DWA6 SERIES METALUX #4VT SERIES	14000 NOMINAL LUMENS, 5000K COLOR TEMPERATURE, FROSTED LENS, STAINLESS STEEL LATCHES.	GTE
HA		RECESSED LINEAR	(1) 24W LED	LED DIMMABLE DRIVER	277V 1P 2W	RECESSED	PRUDENTIAL LIGHTING #STR-LED3-LO-R-XX-D1-SC-UNV-XX-DM01 FLOXWERK EQUIVALENT PEERLESS EQUIVALENT	SEE PLAN FOR OVERALL LENGTH. SEE NOTE 1.	HA
HAE		RECESSED LINEAR, BACKED UP BY EMERGENCY GENERATOR	(1) 24W LED	LED DIMMABLE DRIVER	277V 1P 2W	RECESSED	PRUDENTIAL LIGHTING #STR-LED3-LO-R-XX-D1-SC-UNV-XX-DM01 FLOXWERK EQUIVALENT PEERLESS EQUIVALENT	SEE PLAN FOR OVERALL LENGTH. SEE NOTE 1.	HAE
HB		TRIMLESS 3" RECESSED CAN	(1) 18W LED	LED DIMMABLE DRIVER	277V 1P 2W	CEILING	USGA LIGHTING #23RD-C-18CS1-602ZK5-50-S-XX-NC1-UNV-D2 EDISON PRICE EQUIVALENT FOCAL POINT EQUIVALENT	SEE NOTE 1.	HB
HBE		TRIMLESS 3" RECESSED CAN, BACKED UP BY EMERGENCY GENERATOR	(1) 18W LED	LED DIMMABLE DRIVER	277V 1P 2W	CEILING	USGA LIGHTING #23RD-C-18CS1-602ZK5-50-S-XX-NC1-UNV-D2 EDISON PRICE EQUIVALENT FOCAL POINT EQUIVALENT	SEE NOTE 1.	HBE
HE		14" ROUND PENDANT	(1) 456W LED	LED DIMMABLE DRIVER	277V 1P 2W	PENDANT	MIGUS LIGHTING #CCO-B3714-0450 DAYO LITE PRE-APPROVED EQUIVALENT HUBBELL PRE-APPROVED EQUIVALENT	1150 NOMINAL LUMENS/FT. 3000K COLOR TEMPERATURE. SUSPENDED FLUSH WITH BOTTOM OF COVE OPENING. CONTRACTOR TO LOCATE REMOTE DRIVER IN ADJACENT ACCESSIBLE CEILING SPACE. INDICATE REMOTE DRIVER LOCATION ON AS-BUILT MARKUPS. SEE NOTE 1.	HE
HF		COVE LIGHT	(1) 360W	ELECTRONIC	277V 1P 2W	COVE	VODE #707-21-SL-C-0-RP-DMX-0-Z-MOD-FOR-RGBW-A2-0-AL LED LINEAR PRE-APPROVED EQUIVALENT SYLVANIA PRE-APPROVED EQUIVALENT	SEE PLAN FOR OVERALL LENGTH. PROVIDE CORNER CONNECTORS AS REQUIRED. SEE NOTE 1.	HF
HG		CURVABLE COVE LIGHT	(1) 384W LED	LED DRIVER	277V 1P 2W	COVE	VODE #707-21-SL-24-C-0-RP-DMX-0-Z-MOD-FOR-RGBW-A2-0-AL LED LINEAR PRE-APPROVED EQUIVALENT SYLVANIA PRE-APPROVED EQUIVALENT	SEE PLAN FOR OVERALL LENGTH. SEE NOTE 1.	HG
HG2		CURVABLE COVE LIGHT	(1) 782W LED	LED DRIVER	277V 1P 2W	COVE	VODE #707-21-SL-24-C-0-RP-DMX-0-Z-MOD-FOR-RGBW-A2-0-AL LED LINEAR PRE-APPROVED EQUIVALENT SYLVANIA PRE-APPROVED EQUIVALENT	SEE PLAN FOR OVERALL LENGTH. SEE NOTE 1.	HG2
HG3		CURVABLE COVE LIGHT	(1) 1260W LED	LED DRIVER	277V 1P 2W	COVE	VODE #707-21-SL-24-C-0-RP-DMX-0-Z-MOD-FOR-RGBW-A2-0-AL LED LINEAR PRE-APPROVED EQUIVALENT SYLVANIA PRE-APPROVED EQUIVALENT	SEE PLAN FOR OVERALL LENGTH. SEE NOTE 1.	HG3
HH		2x2, ARCHITECTURAL LENS	(1) 20W LED	LED DIMMABLE DRIVER	277V 1P 2W	RECESSED	METALUX #22N-LD2-25-UNV-L830-CD1-U DAYO LITE PRE-APPROVED EQUIVALENT HUBBELL PRE-APPROVED EQUIVALENT	SEE NOTE 1.	HH
HH2		2x2, ARCHITECTURAL LENS, HIGH OUTPUT	(1) 80W LED	LED DIMMABLE DRIVER	277V 1P 2W	RECESSED	FOCAL POINT #FEZ-22-AC-7000UH-30K-1C-UNV-LD1-ST-XX DAYO LITE PRE-APPROVED EQUIVALENT HUBBELL PRE-APPROVED EQUIVALENT	SEE NOTE 1.	HH2
HH2E		2x2, ARCHITECTURAL LENS, HIGH OUTPUT, BACKED UP BY EMERGENCY GENERATOR	(1) 80W LED	LED DIMMABLE DRIVER	277V 1P 2W	RECESSED	FOCAL POINT #FEZ-22-AC-7000UH-30K-1C-UNV-LD1-ST-XX DAYO LITE PRE-APPROVED EQUIVALENT HUBBELL PRE-APPROVED EQUIVALENT	SEE NOTE 1.	HH2E
HHE		2x2, ARCHITECTURAL LENS, BACKED UP BY EMERGENCY GENERATOR	(1) 20W LED	LED DIMMABLE DRIVER	277V 1P 2W	RECESSED	METALUX #22N-LD2-25-UNV-L830-CD1-U DAYO LITE PRE-APPROVED EQUIVALENT HUBBELL PRE-APPROVED EQUIVALENT	SEE NOTE 1.	HHE
HJ		LINEAR SURFACE, BACKED UP BY EMERGENCY GENERATOR	(1) 75W LED	LED DIMMABLE DRIVER	277V 1P 2W	BOTTOM OF TRUSS	VODE LIGHTING #I07-BX-01-XX-72-CC-ZZ-XX-2-0-Z-H0-30-1	SEE PLAN FOR OVERALL LENGTH. SEE NOTE 1.	HJ
HK		LINEAR UPLIGHT GRAZE ON CLERESTORY	(1) 108W LED	LED DRIVER	277V 1P 2W	CEILING	JUNO #10414-20X450-5T-3000K-80CR-DLDPS-40W PRE-APPROVED EQUIVALENT	REMOVE LED DRIVER. CONTRACTOR TO INDICATE ON AS-BUILTS MARKUPS LOCATION OF LED REMOVE LED DRIVER. SEE PLAN FOR OVERALL LENGTH. SEE NOTE 1.	HK
HL		LINEAR BLUE UPLIGHT ON TRUSSES	(1) 75W LED	LED DIMMABLE DRIVER	277V 1P 2W	TOP SIDE OF BOTTOM COVD OF TRUSS	PROLUMLED #P30-50-BLE-270-DM-300-30 PRE-APPROVED EQUIVALENT	REMOVE LED DRIVER. CONTRACTOR TO INDICATE ON AS-BUILTS MARKUPS LOCATION OF LED REMOVE LED DRIVER. SEE PLAN FOR OVERALL LENGTH. SEE NOTE 1.	HL
HM		COUNTER MILLWORK LED STRIP	(1) 50W LED	LED DRIVER	277V 1P 2W	MILLWORK	VODE #707-21-SL-C-0-RP-DMX-0-Z-MOD-FOR-RGBW-SS-WI-0 LED LINEAR PRE-APPROVED EQUIVALENT SYLVANIA PRE-APPROVED EQUIVALENT	REFER TO ARCHITECTURAL MILLWORK DRAWINGS FOR DETAILS.	HM
HN		COVE LIGHT	(1) 203W	LED DIMMABLE DRIVER	277V 1P 2W	CEILING	VODE #707-21-SL-24-C-0-RP-DMX-0-Z-MOD-FOR-RGBW-A2-0-AL LED LINEAR PRE-APPROVED EQUIVALENT SYLVANIA PRE-APPROVED EQUIVALENT	SEE PLAN FOR OVERALL LENGTH. SEE NOTE 1.	HN
HP		TRACK HEAD	(1) 19W LED	LED DRIVER	120V 1P 2W	TRACK	JUNO #T20L-Y-62-30K-80CR-PDM-NFL-XX CON-TECH LIGHTING EQUIVALENT WAC LIGHTING EQUIVALENT	FINISH SELECTION BY ARCHITECT. DISTRIBUTION AND OUTPUT TO BE CONFIRMED WHEN ART WORK IS SELECTED. SEE NOTE 1.	HP
HPT		TRACK	(1) 500W LED	DIMMING	120V 1P 2W	CEILING	JUNO #TEK4/ATEK4 CON-TECH LIGHTING EQUIVALENT WAC LIGHTING EQUIVALENT	PROVIDE 3A CURRENT LIMITER. SEE NOTE 1.	HPT
HR		WALL SCONCE	(1) 10W LED	LED DIMMABLE DRIVER	277V 1P 2W	WALL; COORDINATE MTD HEIGHT WITH ARCHITECT	LOUIS POULSEN #AJ EKLPTA SERIES PRE-APPROVED EQUIVALENT	3000K COLOR TEMPERATURE. SEE NOTE 1.	HR
I2		4" INDUSTRIAL	(1) 30W LED	LED DRIVER	277V 1P 2W	PENDANT/SURFACE	COLUMBIA #LCL SERIES DAYBRITE #FSS SERIES METALUX #SNLED SERIES	3700 NOMINAL LUMENS, 4000K COLOR TEMPERATURE. WIRE GUARD.	I2
I2E		4" INDUSTRIAL, BACKED UP BY EMERGENCY GENERATOR	(1) 30W LED	LED DRIVER	277V 1P 2W	PENDANT/SURFACE	COLUMBIA #LCL SERIES DAYBRITE #FSS SERIES METALUX #SNLED SERIES	3700 NOMINAL LUMENS, 4000K COLOR TEMPERATURE. WIRE GUARD.	I2E
I3		4" INDUSTRIAL	(1) 40W LED	LED DRIVER	277V 1P 2W	PENDANT/SURFACE	COLUMBIA #LCL SERIES DAYBRITE #FSS SERIES METALUX #SNLED SERIES	5300 NOMINAL LUMENS, 4000K COLOR TEMPERATURE. WIRE GUARD.	I3
I3E		4" INDUSTRIAL, BACKED UP BY EMERGENCY GENERATOR	(1) 40W LED	LED DRIVER	277V 1P 2W	PENDANT/SURFACE	COLUMBIA #LCL SERIES DAYBRITE #FSS SERIES METALUX #SNLED SERIES	5300 NOMINAL LUMENS, 4000K COLOR TEMPERATURE. WIRE GUARD.	I3E
JEL		JELLY JAR	(1) 18W LED	LED DRIVER	120V 1P 2W	MTD UNDER BHS EQUIPMENT TRACK	HUBBELL #WH1 SERIES BOOK #WBL0215 SERIES CROUSE-HINDS #EVL2 SERIES	3/4" CONDUIT HUB; SILVER GRAY FINISH; CLEAR GLASS GLOBE; DIE CAST GUARD. COORDINATE EXACT LOCATION WITH BUS EQUIPMENT VENDOR. INTENDED LOCATION IS NEAR BHS MAINTENANCE HATCH.	JEL
K1		1x1, ARCHITECTURAL LENS	(1) 22W LED	LED DIMMABLE DRIVER	277V 1P 2W	RECESSED	PINNACLE LIGHTING #CJ11-A SERIES PRE-APPROVED EQUIVALENT AXIS LIGHTING #BVALED SERIES	1600 NOMINAL LUMENS, 3000K COLOR TEMPERATURE.	K1
K1E		1x1, ARCHITECTURAL LENS, BACKED UP BY EMERGENCY GENERATOR	(1) 22W LED	LED DIMMABLE DRIVER	277V 1P 2W	RECESSED	PINNACLE LIGHTING #CJ11-A SERIES PRE-APPROVED EQUIVALENT AXIS LIGHTING #BVALED SERIES	1600 NOMINAL LUMENS, 3000K COLOR TEMPERATURE.	K1E
R6		6" RECESSED CAN	(1) 18W LED	LED DIMMABLE DRIVER	277V 1P 2W	RECESSED	PRESCOLITE #LFLED SERIES LIGHTOLIER #LBR SERIES PORTFOLIO #LDR SERIES	1500 NOMINAL LUMENS, 3000K COLOR TEMPERATURE. SELF-FLANGED LENSED REFLECTOR TRIM; LOW IRIDESCENT CLEAR FINISH.	R6
S		APRON LIGHT	(1) 558W LED	LED DRIVER	277V 1P 2W	POLE; 60"; 5' CONCRETE BASE	MORAW-EDISON #ELEDN-AF-10-LED-E1-TAFT BEACON #BA7A-96-505-AK-4 PRE-APPROVED EQUIVALENT	65,000 NOMINAL LUMENS, 4000K COLOR TEMPERATURE. TYPE IV FORWARD THROW OPTICS. FINISH SELECTION BY ARCHITECT. SLIPTRIP MOUNT ON BULLHORN BRACKET. BIRD GUARD MESH TOP. TOOL-LESS HARDWARE. APRON LIGHTING LOCATED AT TOP OF BULLHORN BRACKET.	S
W		HALF CYLINDER WALL PACK	(1) 40W LED	LED DRIVER	277V 1P 2W	WALL	DECO LIGHTING #D440 SERIES GARDCO #F04L SERIES RAYON #F50L SERIES	3800 NOMINAL LUMENS, 4000K COLOR TEMPERATURE. TYPE IV DISTRIBUTION. DOWNLIGHT ONLY. FINISH SELECTION BY ARCHITECT.	W
WE		HALF CYLINDER WALL PACK, BACKED UP BY EMERGENCY GENERATOR	(1) 20W LED	LED DRIVER	277V 1P 2W	WALL; MTD 9"-0" AFG	DECO LIGHTING #D440 SERIES GARDCO #F04L SERIES RAYON #F50L SERIES	3800 NOMINAL LUMENS, 4000K COLOR TEMPERATURE. TYPE IV DISTRIBUTION. DUAL LED DRIVERS AND DUAL LED ARRAYS FOR EGRESS REQUIREMENTS. DOWNLIGHT ONLY. FINISH SELECTION BY ARCHITECT.	WE
X		EXIT SIGN	(2) 1W LED	ELECTRONIC	277V 1P 2W	UNIVERSAL	DUAL-LITE #EVE SERIES LIGHTALARM5 #RAN SERIES PATHWAY #XR SERIES	CONNECT TO NEAREST UNSWITCHED GENERATOR LIGHT CIRCUIT IN SAME SPACE. THESE FIXTURES ARE NOT TAGGED WITH "X" ON THE DRAWINGS; ONLY THE SYMBOL IS USED.	X

NOTES:  
1. LIGHT FIXTURE SELECTION WAS DESIGNED BY HARTRANFT LIGHTING DESIGN. INCLUSION HERE IS NOT INTENDED TO REPRESENT THAT THE FIXTURE SELECTION IS THE WORK PRODUCT OF CHEATHAM & ASSOCIATES, P.A.  
2. REFER TO E1-192 FOR LUMINAIRE SCHEDULE FOR LIGHT FIXTURE TYPES 101, 102, 103.

NOTES:  
1. LIGHTING FIXTURE SELECTION, LAYOUT, AND DIMMER SCHEDULE WERE DESIGNED BY HARTRANFT LIGHTING DESIGN. INCLUSION HERE IS NOT INTENDED TO REPRESENT THAT THE FIXTURE SELECTION, LAYOUT, AND DIMMER SCHEDULE IS THE WORK PRODUCT OF CHEATHAM & ASSOCIATES, P.A.

HARTRANFT LIGHTING DESIGN				DIMMER SCHEDULE			REVISIONS		
PROJECT: WILMINGTON TERMINAL EXPANSION CONTRACT 3 (NOTE: CONTINUED FROM "TR" CONTROL SYSTEM FOR CONTRACT 2 BY SYSTEM TO BE INSTALLED)				PROJECT #			7/25/2019		
ZONE				REVISION:					
ZONE NO.	FIXTURE	DESCRIPTION	WATTS	UNITS	QTY.	CONTROL & LOAD TYPE	CONTROL TYPE	TOTAL	
<b>FRONT OF HOUSE (BAGGAGE CLAIM)</b>									
9A, 9B	HB	TUNABLE WHITE DOWNLIGHT	18	EACH	8	0-10V, 2 Channel per zone	TMECLOCK AND PHOTOSENSOR	144.0	
10A, 10B	HB	TUNABLE WHITE DOWNLIGHT	18	EACH	52	0-10V, 2 Channel per zone	TMECLOCK	936.0	
11	HC	ACCENT DOWNLIGHTS ON SLOPED CEILING	20	EACH	8	0-10V	TMECLOCK	160.0	
12A, 12B	HA	LO SLOT FIXTURE	6	LFT	742	0-10V	TMECLOCK	4452.0	
13	HN	CURVABLE FOR EXISTING COVE	6.6	LFT	138	0-10V	TMECLOCK	910.8	
14	HE	CUSTOM RING FIXTURES	456	EACH	3	0-10V	TMECLOCK	1368.0	
<b>SECURITY CHECKPOINT</b>									
15	HF2	LED HO 2X2	79	EACH	12	0-10V	TMECLOCK	948.0	
16	HH	LED LO 2X2	20	EACH	18	0-10V	TMECLOCK	360.0	
17	HH2	LED HO 2X2	79	EACH	15	0-10V	TMECLOCK	1185.0	
18	HA	LO SLOT FIXTURE	6	LFT	162	0-10V	TMECLOCK	972.0	
<b>CONCOURSE EXIT</b>									
19A, 19B	HA	LO SLOT FIXTURE	6	LFT	314	0-10V	TMECLOCK	1884.0	
<b>GATE AREA</b>									
20A, 20B, 20C, 20D	HA	LO SLOT FIXTURE	6	LFT	1110	0-10V	TMECLOCK	6660.0	
21	HR	SCONCE IN CONCOURSE AREA	10	EACH	40	0-10V	TMECLOCK	400.0	
22	HI	4" SQUARE DOWNLIGHT	24	EACH	18	0-10V	TMECLOCK	432.0	
<b>CLERESTORY</b>									
23A, 23B	HK	LINEAR UPLIGHT GRAZE ON CLERESTORY	4.8	LFT	420	0-10V	TMECLOCK	2016.0	
24A, 24B	HJ	SURFACE MOUNTED LINEAR	12.5	LFT	156	0-10V	TMECLOCK	1950.0	
25	HP	TRACK LIGHTING FOR ARTWORK	19	EACH	20	0-10V	TMECLOCK	380.0	
26A, 26B, 26C	HL	BLUE LINEAR UPLIGHT ON TRUSSES	10	LFT	496	0-10V	TMECLOCK	4960.0	
<b>CUPOLA</b>									
27	HL	BLUE LINEAR UPLIGHT ON TRUSSES	10	LFT	88	0-10V	TMECLOCK	880.0	
28	HJ	SURFACE MOUNTED LINEAR	12.5	LFT	104	0-10V	TMECLOCK	1300.0	
29	HQ1	16 FT SQUARE PENDANT	1	EACH	500		TMECLOCK	500.0	
30	HQ2	14 FT SQUARE PENDANT	1	EACH	500		TMECLOCK	500.0	
31	HQ3	12 FT SQUARE PENDANT	1	EACH	500		TMECLOCK	500.0	
<b>DMX</b>									
CHANNELS 25-36	HF	RGBW EXTRUSION IN RECTANGULAR COVE	8	LFT	214.0	DMX	PLAYER LINKED WITH TIME CLOCK	1712.0	
CHANNELS 37-40	HG	RGW CURVED COVE	8	LFT	95.0	DMX	PLAYER LINKED WITH TIME CLOCK	760.0	
CHANNELS 41-44	HG	RGW CURVED COVE	8	LFT	95.5	DMX	PLAYER LINKED WITH TIME CLOCK	764.0	
CHANNELS 45-48	HG	RGW CURVED COVE	8	LFT	157.8	DMX	PLAYER LINKED WITH TIME CLOCK	1262.0	
CHANNELS 49-52	HM	RGBW EXTRUSION IN MILLWORK DETAIL OF GATE PODIA	88	LFT	50 confirm length	DMX	PLAYER LINKED WITH TIME CLOCK	400	
CHANNELS 53-58	HM	RGBW EXTRUSION IN MILLWORK DETAIL OF GATE PODIA	8	LFT	50 confirm length	DMX	PLAYER LINKED WITH TIME CLOCK	400	
CHANNELS 57-60	HM	RGBW EXTRUSION IN MILLWORK DETAIL OF BAGGAGE CLAIM KIOSK	8	LFT	50 confirm length	DMX	PLAYER LINKED WITH TIME CLOCK	400	
<b>LIGHTING CONTROL PANEL/KEYPAD - CRESTON, ETC. OR EQUAL AND COLOR KINETICS IPLAYERS. DIMMING CONTROLS SHALL LINK TO BUILDING MANAGEMENT SYSTEM AND SHALL BE BACNET COMPATIBLE IF NECESSARY.</b>									
FINAL DIMMER LOADS MUST BE CONFIRMED BY ELECTRICAL ENGINEER									

LIGHTING RELAY / SWITCHING SCHEDULE						
CIRCUIT	SWITCHED ZONE	PANEL	LC	AREA / DESCRIPTION	SWITCHED OUTPUTS	NOTES
L-1	1			RAMP LEVEL	YES	PHOTOCELL CONTROL
L-5	2			STAIR 7 A 1107, CORRIDOR A 1108, VEST A 1115, STOR A 1132	YES	SCHEDULED ON/OFF
L-8	3			STAIR 7 A 1107	YES	SCHEDULED ON/OFF
L-9	4			APRON LIGHTING	YES	PHOTOCELL CONTROL
L-11	5			APRON LIGHTING	YES	PHOTOCELL CONTROL
L-12	6			STAIR A 1208	YES	SCHEDULED ON/OFF
L-13	7			APRON LIGHTING	YES	PHOTOCELL CONTROL
L-15	8			RAMP LEVEL	YES	PHOTOCELL CONTROL
L-19	9			FUTURE 1231	YES	SCHEDULED ON/OFF
L-21	10			FUTURE A 1210	YES	SCHEDULED ON/OFF
L-23	11			STOR A 1211	YES	SCHEDULED ON/OFF
L-31	12			ARLINE A 1120	YES	SCHEDULED ON/OFF
G2-1	13			RAMP LEVEL	YES	PHOTOCELL CONTROL
G2-5	14			RAMP LEVEL	YES	PHOTOCELL CONTROL
	15			SPARE RELAY		
	16			SPARE RELAY		
	17			SPARE RELAY		

AIR HANDLING UNIT EQUIPMENT SCHEDULE				
CALLOUT	VOLTS	CIRCUIT	BREAKER	WIRE CALLOUT
AHU#3	480V 3P 3W	M2-1,3,5	50/3	1" C,3#6,#10G
AHU#3 CONTROL PANEL	120V 1P 2W	P4-17	20/1	3/4" C,1#12,#12N,#12G
AHU#4	480V 3P 3W	M4-2,4,6	15/3	3/4" C,3#12,#12G
AHU#4 CONTROL PANEL	120V 1P 2W	PAD-19	20/1	3/4" C,1#12,#12N,#12G
AHU#7	480V 3P 3W	M2-7,9,11	50/3	1" C,3#6,#10G
AHU#7 CONTROL PANEL	120V 1P 2W	P4-15	20/1	3/4" C,1#12,#12N,#12G
AHU#8	480V 3P 3W	M2-13,15,17	50/3	1" C,3#6,#10G
AHU#8 CONTROL PANEL	120V 1P 2W	P4-16	20/1	3/4" C,1#12,#12N,#12G
AHU#9 CONTROL PANEL	120V 1P 2W	P4-16	20/1	3/4" C,1#12,#12N,#12G
AHU#9 (RELIEF)	480V 3P 3W	M2-25,27,29	15/3	3/4" C,3#12,#12G
AHU#9 (SUPPLY)	480V 3P 3W	M2-19,21,23	15/3	3/4" C,3#12,#12G
AHU#10 CONTROL PANEL	120V 1P 2W	P4-16	20/1	3/4" C,1#12,#12N,#12G
AHU#10 (RELIEF)	480V 3P 3W	M2-37,39,41	15/3	3/4" C,3#12,#12G
AHU#10 (SUPPLY)	480V 3P 3W	M2-31,33,35	25/3	3/4" C,3#10,#10G
AHU#11 CONTROL PANEL	120V 1P 2W	P4-15	20/1	3/4" C,1#12,#12N,#12G
AHU#11 (RELIEF)	480V 3P 3W	M2-49,51,53	15/3	3/4" C,3#12,#12G
AHU#11 (SUPPLY)	480V 3P 3W	M2-43,45,47	20/3	3/4" C,3#12,#12G

BLOWER COIL AIR HANDING UNIT EQUIPMENT SCHEDULE				
CALLOUT	VOLTS	CIRCUIT	BREAKER	WIRE CALLOUT
BCAHU#1	480V 3P 3W	4B8-8,10,12	15/3	3/4" C,3#12,#12G
BCAHU#2	480V 3P 3W	4B8-14,16,18	15/3	3/4" C,3#12,#12G
BCAHU#3	480V 3P 3W	4B8-20,22,24	15/3	3/4" C,3#12,#12G
BCAHU#4	480V 3P 3W	M3-1,3,5	15/3	3/4" C,3#12,#12G
BCAHU#5	480V 3P 3W	M3-7,9,11	15/3	3/4" C,3#12,#12G
BCAHU#6	480V 3P 3W	M3-13,15,17	15/3	3/4" C,3#12,#12G
BCAHU#7	480V 3P 3W	M3-19,21,23	15/3	3/4" C,3#12,#12G
BCAHU#8	480V 3P 3W	M3-25,27,29	15/3	3/4" C,3#12,#12G
BCAHU#9	480V 3P 3W	M3-31,33,35	15/3	3/4" C,3#12,#12G
BCAHU#10	480V 3P 3W	M3-37,39,41	15/3	3/4" C,3#12,#12G
BCAHU#11	480V 3P 3W	M3-2,4,6	15/3	3/4" C,3#12,#12G
BCAHU#12	480V 3P 3W	M3-8,10,12	15/3	3/4" C,3#12,#12G
BCAHU#13	480V 3P 3W	M3-14,16,18	15/3	3/4" C,3#12,#12G
BCAHU#14	480V 3P 3W	M3-20,22,24	15/3	3/4" C,3#12,#12G
BCAHU#15	480V 3P 3W	M3-26,28,30	15/3	3/4" C,3#12,#12G
BCAHU#16	480V 3P 3W	M3-32,34,36	15/3	3/4" C,3#12,#12G
BCAHU#17	480V 3P 3W	M4-1,3,5	15/3	3/4" C,3#12,#12G
BCAHU#18	480V 3P 3W	M4-7,9,11	15/3	3/4" C,3#12,#12G
BCAHU#19	480V 3P 3W	M4-13,15,17	15/3	3/4" C,3#12,#12G
BCAHU#20	480V 3P 3W	M4-19,21,23	15/3	3/4" C,3#12,#12G
BCAHU#21	480V 3P 3W	M4-25,27,29	15/3	3/4" C,3#12,#12G
BCAHU#22	480V 3P 3W	M4-31,33,35	15/3	3/4" C,3#12,#12G

BOILER EQUIPMENT SCHEDULE				
CALLOUT	VOLTS	CIRCUIT	BREAKER	WIRE CALLOUT
BOILER #3	208V 3P 3W	DP1-1,3,5	15/3	3/4" C,3#12,#12G
BOILER #4	208V 3P 3W	DP1-7,9,11	15/3	3/4" C,3#12,#12G
BOILER #5	208V 3P 3W	DP1-13,15,17	15/3	3/4" C,3#12,#12G

CHILLER EQUIPMENT SCHEDULE				
CALLOUT	VOLTS	CIRCUIT	BREAKER	WIRE CALLOUT
CHILLER-3	480V 3P 3W	DSBC-5	350/3	3" C,3#350kcmil,#3G
CHILLER-4	480V 3P 3W	DSBC-6	350/3	3" C,3#350kcmil,#3G

FAN COIL UNIT EQUIPMENT SCHEDULE				
CALLOUT	VOLTS	CIRCUIT	BREAKER	WIRE CALLOUT
FAN COIL FCU-18	120V 1P 2W	P4-2	20/1	3/4" C,1#12,#12N,#12G

COOLING TOWER EQUIPMENT SCHEDULE				
CALLOUT	VOLTS	CIRCUIT	BREAKER	WIRE CALLOUT
COOLING TOWER #CT-1	480V 3P 3W	4I8-13,15,17	70/3	1-1/4" C,3#4,#8G
COOLING TOWER #CT-1 SUMP HEATER	480V 3P 3W	4I8-19,21,23	40/3	3/4" C,3#6,#10G
COOLING TOWER #CT-2	480V 3P 3W	4I8-25,27,29	70/3	1-1/4" C,3#4,#8G
COOLING TOWER #CT-2 SUMP HEATER	480V 3P 3W	4I8-31,33,35	40/3	3/4" C,3#6,#10G

DUCTLESS SPLIT SYSTEM HEAT PUMP EQUIPMENT SCHEDULE				
CALLOUT	VOLTS	CIRCUIT	BREAKER	WIRE CALLOUT
DAHU #1	208V 2P 2W	P4-44,46	15/2	3/4" C,2#12,#12G
DAHU #2	208V 2P 2W	P4-48,50	25/2	3/4" C,2#10,#10G
DAHU #3	208V 2P 2W	P4-52,54	25/2	3/4" C,2#10,#10G
DAHU #4	208V 2P 2W	TSA-28,30	25/2	3/4" C,2#6,#10G
DHP #1	208V 2P 2W	P4-44,46	15/2	3/4" C,2#12,#12G
DHP #2	208V 2P 2W	P4-48,50	25/2	3/4" C,2#10,#10G
DHP #3	208V 2P 2W	P4-52,54	25/2	3/4" C,2#10,#10G
DHP #4	208V 2P 2W	TSA-28,30	25/2	3/4" C,2#6,#10G

ELECTRIC UNIT HEAT EQUIPMENT SCHEDULE				
CALLOUT	VOLTS	CIRCUIT	BREAKER	WIRE CALLOUT
ELECTRIC UNIT HEATER - UH-27	480V 3P 3W	M2-2,4,6	15/3	3/4" C,3#12,#12G
ELECTRIC UNIT HEATER - UH-28	480V 3P 3W	M2-8,10,12	15/3	3/4" C,3#12,#12G
ELECTRIC UNIT HEATER - UH-29	480V 3P 3W	M2-14,16,18	15/3	3/4" C,3#12,#12G
ELECTRIC UNIT HEATER - UH-30	480V 3P 3W	M2-20,22,24	20/3	3/4" C,3#12,#12G
ELECTRIC UNIT HEATER - UH-31	480V 3P 3W	M2-26,28,30	15/3	3/4" C,3#12,#12G
ELECTRIC UNIT HEATER - UH-32	480V 3P 3W	M1-38,40,42	15/3	3/4" C,3#12,#12G
ELECTRIC UNIT HEATER - UH-33	480V 3P 3W	M2-32,34,36	15/3	3/4" C,3#12,#12G
ELECTRIC UNIT HEATER - UH-34	480V 3P 3W	M2-38,40,42	15/3	3/4" C,3#12,#12G
ELECTRIC UNIT HEATER - UH-35	480V 3P 3W	M2-44,46,48	15/3	3/4" C,3#12,#12G
ELECTRIC UNIT HEATER - UH-36	480V 3P 3W	M4-8,10,12	15/3	3/4" C,3#12,#12G
ELECTRIC UNIT HEATER - UH-37	480V 3P 3W	M2-50,52,54	15/3	3/4" C,3#12,#12G

ELECTRIC WALL HEATER EQUIPMENT SCHEDULE				
CALLOUT	VOLTS	CIRCUIT	BREAKER	WIRE CALLOUT
ELECTRIC WALL HEATER - EWH#1	208V 2P 2W	DP1-44,46	20/2	3/4" C,2#12,#12G
ELECTRIC WALL HEATER - EWH#2	208V 2P 2W	DP1-40,42	20/2	3/4" C,2#12,#12G

PLUMBING EQUIPMENT SCHEDULE				
CALLOUT	VOLTS	CIRCUIT	BREAKER	WIRE CALLOUT
CIRC. PUMP	120V 1P 2W	P3-8	15/1	3/4" C,1#12,#12N,#12G
CIRC. PUMP	120V 1P 2W	P1-21	20/1	3/4" C,1#12,#12N,#12G
H2O HTR	480V 3P 3W	M4-20,22,24	20/3	3/4" C,3#12,#12G
H2O HTR	480V 3P 3W	M4-14,16,18	20/3	3/4" C,3#12,#12G
H2O HTR	480V 3P 3W	B9-38,40,42	20/3	3/4" C,3#12,#12G
POTABLE WATER #1	120V 1P 2W	P4-4	20/1	3/4" C,1#12,#12N,#12G
POTABLE WATER #2	120V 1P 2W	P4-6	20/1	3/4" C,1#12,#12N,#12G

POWER VENTILATOR EQUIPMENT SCHEDULE				
CALLOUT	VOLTS	CIRCUIT	BREAKER	WIRE CALLOUT
FAN F-5	120V 1P 2W	B10-29	20/1	3/4" C,1#12,#12N,#12G
FAN F-29	480V 3P 3W	M1-20,22,24	15/3	3/4" C,3#12,#12G
FAN F-30	480V 3P 3W	M1-26,28,30	15/3	3/4" C,3#12,#12G
FAN F-31	480V 3P 3W	M1-32,34,36	15/3	3/4" C,3#12,#12G
FAN F-34	120V 1P 2W	P3-51	15/1	3/4" C,1#12,#12N,#12G
FAN F-35	480V 3P 3W	4I8-38,40,42	15/3	3/4" C,3#12,#12G
FAN F-36	480V 3P 3W	4I8-38,40,42	15/3	3/4" C,3#12,#12G
FAN SF-1	480V 3P 3W	MC-26,28,30	15/3	3/4" C,3#12,#12G
FAN SF-3	480V 3P 3W	4I8-37,39,41	15/3	3/4" C,3#12,#12G

PUMP EQUIPMENT SCHEDULE				
CALLOUT	VOLTS	CIRCUIT	BREAKER	WIRE CALLOUT
PUMP P-14 CHILLER PRIMARY	480V 3P 3W	M1-1,3,5	30/3	3/4" C,3#10,#10G
PUMP P-15 CHILLER PRIMARY	480V 3P 3W	M1-7,9,11	30/3	3/4" C,3#10,#10G
PUMP P-16 CHILLED WATER SECONDARY	480V 3P 3W	M1-13,15,17	50/3	1" C,3#6,#10G
PUMP P-17 CHILLED WATER SECONDARY	480V 3P 3W	M1-19,21,23	50/3	1" C,3#6,#10G
PUMP P-18 CONDENSER WATER	480V 3P 3W	M1-25,27,29	70/3	1-1/4" C,3#4,#8G
PUMP P-19 CONDENSER WATER	480V 3P 3W	M1-31,33,35	70/3	1-1/4" C,3#4,#8G
PUMP P-20 HOT WATER SYSTEM	480V 3P 3W	M1-37,39,41	30/3	3/4" C,3#10,#10G
PUMP P-21 HOT WATER SYSTEM	480V 3P 3W	M1-43,45,47	30/3	3/4" C,3#10,#10G
PUMP P-22 HOT WATER BOILER 3	480V 3P 3W	M1-2,4,6	15/3	3/4" C,3#12,#12G
PUMP P-23 HOT WATER BOILER 4	480V 3P 3W	M1-8,10,12	15/3	3/4" C,3#12,#12G
PUMP P-24 HOT WATER BOILER 5	480V 3P 3W	M1-14,16,18	15/3	3/4" C,3#12,#12G

MISCELLANEOUS EQUIPMENT SCHEDULE				
CALLOUT	VOLTS	CIRCUIT	BREAKER	WIRE CALLOUT
AIR COMPRESSOR	480V 3P 3W	MC-20,22,24	20/3	3/4" C,3#12,#12G
COILING DOOR #1	120V 1P 2W	TSA2-39	20/1	3/4" C,1#12,#12N,#12G
COILING DOOR #2	120V 1P 2W	TSA2-39	20/1	3/4" C,1#12,#12N,#12G
COILING DOOR #3	120V 1P 2W	P4-1	20/1	3/4" C,1#12,#12N,#12G
COILING DOOR #4	120V 1P 2W	P4-3	20/1	3/4" C,1#12,#12N,#12G
COILING DOOR #5	120V 1P 2W	P4-5	20/1	3/4" C,1#12,#12N,#12G
ELEV. CAB LITS	120V 1P 2W	P3-15	20/1	3/4" C,1#12,#12N,#12G
ELEVATOR	480V 3P 3W	DSBC-7	125/3	1-1/2" C,3#1,#6G
FOLDING DOOR #1	208/120V 2P 3W	TSA2-41,43	20/2	3/4" C,2#12,#12N,#12G
FOLDING DOOR #2	208/120V 2P 3W	TSA2-45,47	20/2	3/4" C,2#12,#12N,#12G
FOLDING DOOR #3	208/120V 2P 3W	TSA2-44,46	20/2	3/4" C,2#12,#12N,#12G
HEAT TRACE CONTROLLER #1	120V 1P 2W	B4B-14	15/1	3/4" C,1#12,#12N,#12G
HEAT TRACE CONTROLLER #2	120V 1P 2W	B4B-14	15/1	3/4" C,1#12,#12N,#12G
HEAT TRACE CONTROLLER #3	120V 1P 2W	P4-32	15/1	3/4" C,1#12,#12N,#12G
HEAT TRACE CONTROLLER #4	120V 1P 2W	P4-35	15/1	3/4" C,1#12,#12N,#12G
HEAT TRACE CONTROLLER #5	120V 1P 2W	PAD-26	15/1	3/4" C,1#12,#12N,#12G
HEAT TRACE CONTROLLER #5	120V 1P 2W	PAD-30	15/1	3/4" C,1#12,#12N,#12G
JET BRIDGE GPU	480V 3P 3W	DSBC-12	150/3	1-1/2" C,3#1/0,#6G
JET BRIDGE GPU	480V 3P 3W	DSBC-15	150/3	1-1/2" C,3#1/0,#6G
JET BRIDGE GPU	480V 3P 3W	DSBC-19	150/3	1-1/2" C,3#1/0,#6G
JET BRIDGE GPU	480V 3P 3W	DSBC-9	150/3	1-1/2" C,3#1/0,#6G
JET BRIDGE PBB	480V 3P 3W	DSBC-11	60/3	1" C,3#6,#10G
JET BRIDGE PBB	480V 3P 3W	DSBC-14	60/3	1" C,3#6,#10G
JET BRIDGE PBB	480V 3P 3W	DSBC-18	60/3	1" C,3#6,#10G
JET BRIDGE PBB	480V 3P 3W	DSBC-8	60/3	1" C,3#6,#10G
JET BRIDGE PCA	480V 3P 3W	DSBC-13	250/3	2-1/2" C,3#250kcmil,#4G
JET BRIDGE PCA	480V 3P 3W	DSBC-20	250/3	2-1/2" C,3#250kcmil,#4G
JET BRIDGE PCA	480V 3P 3W	DSBC-10	250/3	2-1/2" C,3#250kcmil,#4G
JET BRIDGE PCA	480V 3P 3W	DSBC-16	250/3	2-1/2" C,3#250kcmil,#4G
MCP-IB1	480V 3P 3W	4I8-1,3,5	125/3	1-1/2" C,3#1,#6G
MCP-IB2	480V 3P 3W	4I8-7,9,11	125/3	1-1/2" C,3#1,#6G
POWER DOOR #1	120V 1P 2W	2I8-7	20/1	3/4" C,1#12,#12N,#12G
POWER DOOR #2	120V 1P 2W	2I8-9	20/1	3/4" C,1#12,#12N,#12G
POWER DOOR #3	120V 1P 2W	2I8-11	20/1	3/4" C,1#12,#12N,#12G
POWER DOOR #4	120V 1P 2W	2I8-13	20/1	3/4" C,1#12,#12N,#12G

**ILM**  
**TERMINAL IMPROVEMENTS CONTRACT 3**  
 Wilmington International Airport  
 1740 Airport Boulevard, Suite 12  
 Wilmington, NC 28405

**CHEATHAM & ASSOCIATES, P.A.**  
 CONSULTING ENGINEERS  
 3412 ENTERPRISE DRIVE





**TERMINAL IMPROVEMENTS CONTRACT 3**

Wilmington International Airport  
1740 Airport Boulevard, Suite 12  
Wilmington, NC 28405

**CHEATHAM & ASSOCIATES, P.A.**  
CONSULTING ENGINEERS  
3412 ENTERPRISE DRIVE  
WILMINGTON, NORTH CAROLINA 28405  
PHONE: (910) 452-4210  
FAX: (910) 452-4211  
OFFICE@CHEATHAMPA.COM  
NC LICENSE# C-1073

JOB # 19005

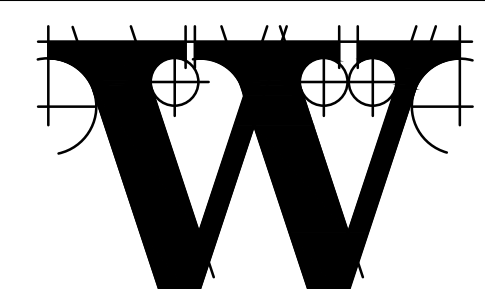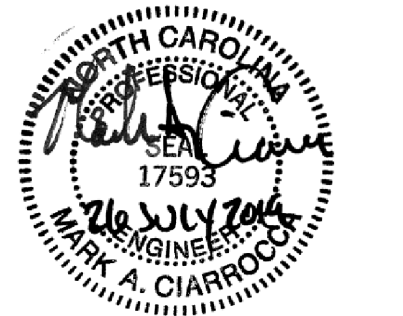

**THE WILSON GROUP**  
- ARCHITECTS -

PO Box 5510 Charlotte, NC 28299  
704-331-9747 • www.twgarchitects.com

PROJECT MANAGER & CIVIL ENGINEER  
**TALBERT & BRIGHT**

CONSULTING ARCHITECT  
**LS3P**

STRUCTURAL ENGINEER  
**STEWART**

FPP/PM/E ENGINEER  
**CHEATHAM & ASSOC.**

BAGGAGE HANDLING CONSULTANTS  
**BNP**

AIRCRAFT SUPPORT SYSTEMS  
**DK CONSULTANTS**

SPECIALTY LIGHTING CONSULTANT  
**HARTRANFT**

SIGNAGE & WAYFINDING  
**TAKEFORM**

COPYRIGHT © 2019  
THE WILSON GROUP ARCHITECTS  
ALL RIGHTS RESERVED

PRINTED OR ELECTRONIC DRAWINGS AND  
DOCUMENTATION MAY NOT BE REPRODUCED  
IN ANY FORM WITHOUT WRITTEN PERMISSION  
FROM THE WILSON GROUP ARCHITECTS


REVISIONS

AD-03 07/26/2019


DATE 06/28/19  
PROJECT NUMBER 9202-000  
SHEET TITLE

**ELECTRICAL MISCELLANEOUS RISER DIAGRAMS**

SHEET NUMBER  
**E-703**

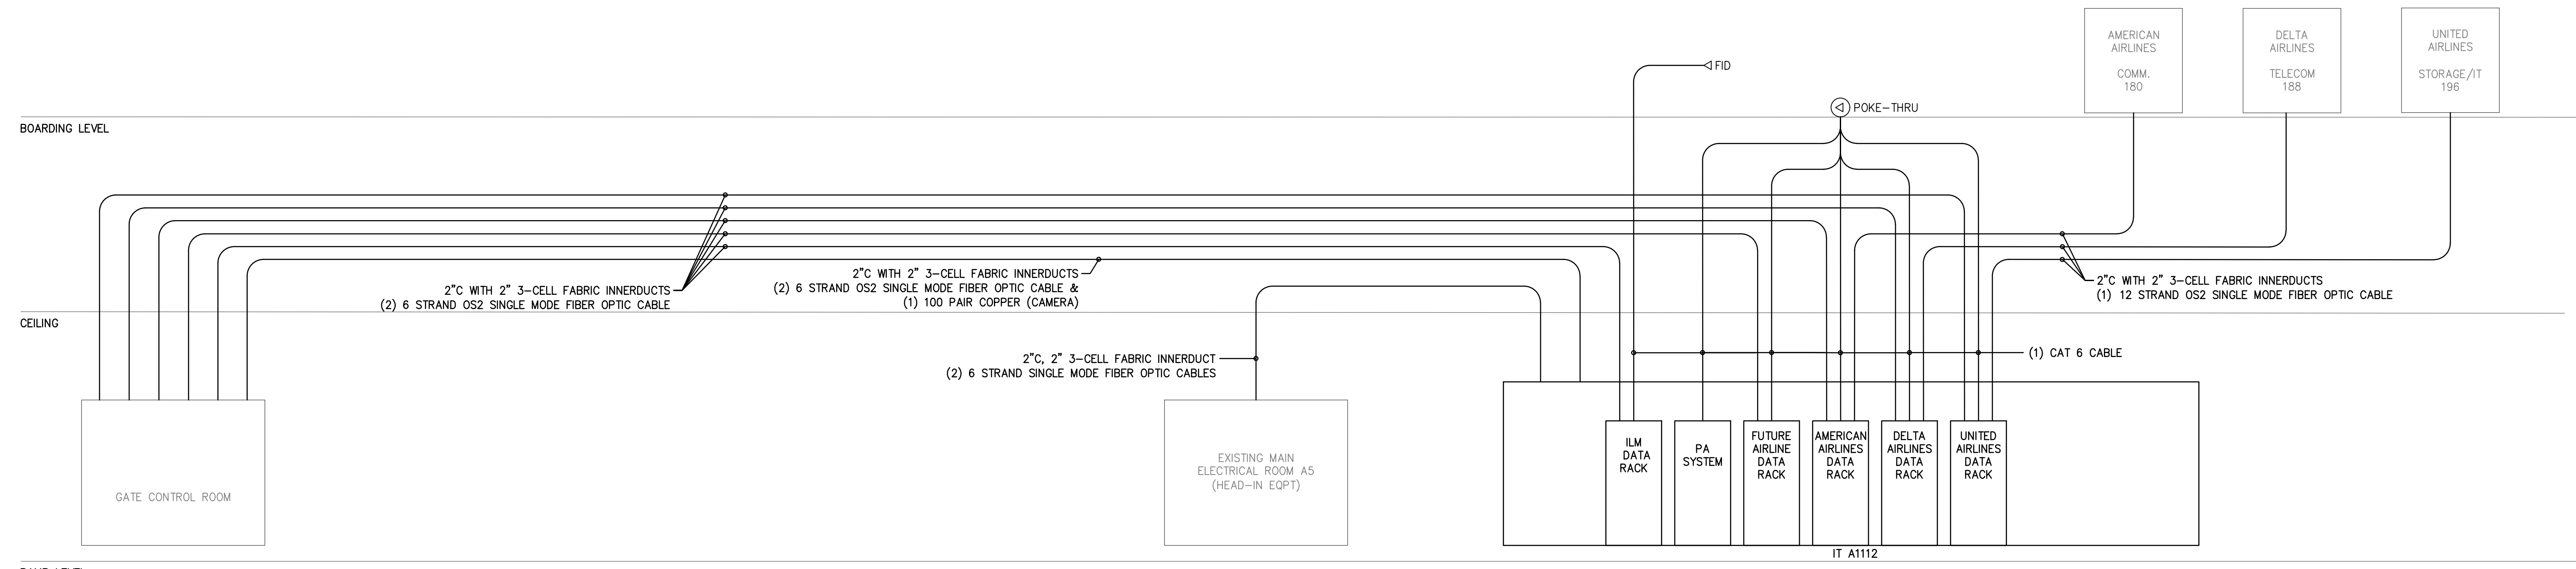


**D TELEPHONE/DATA SYSTEMS RISER DIAGRAM**  
NO SCALE

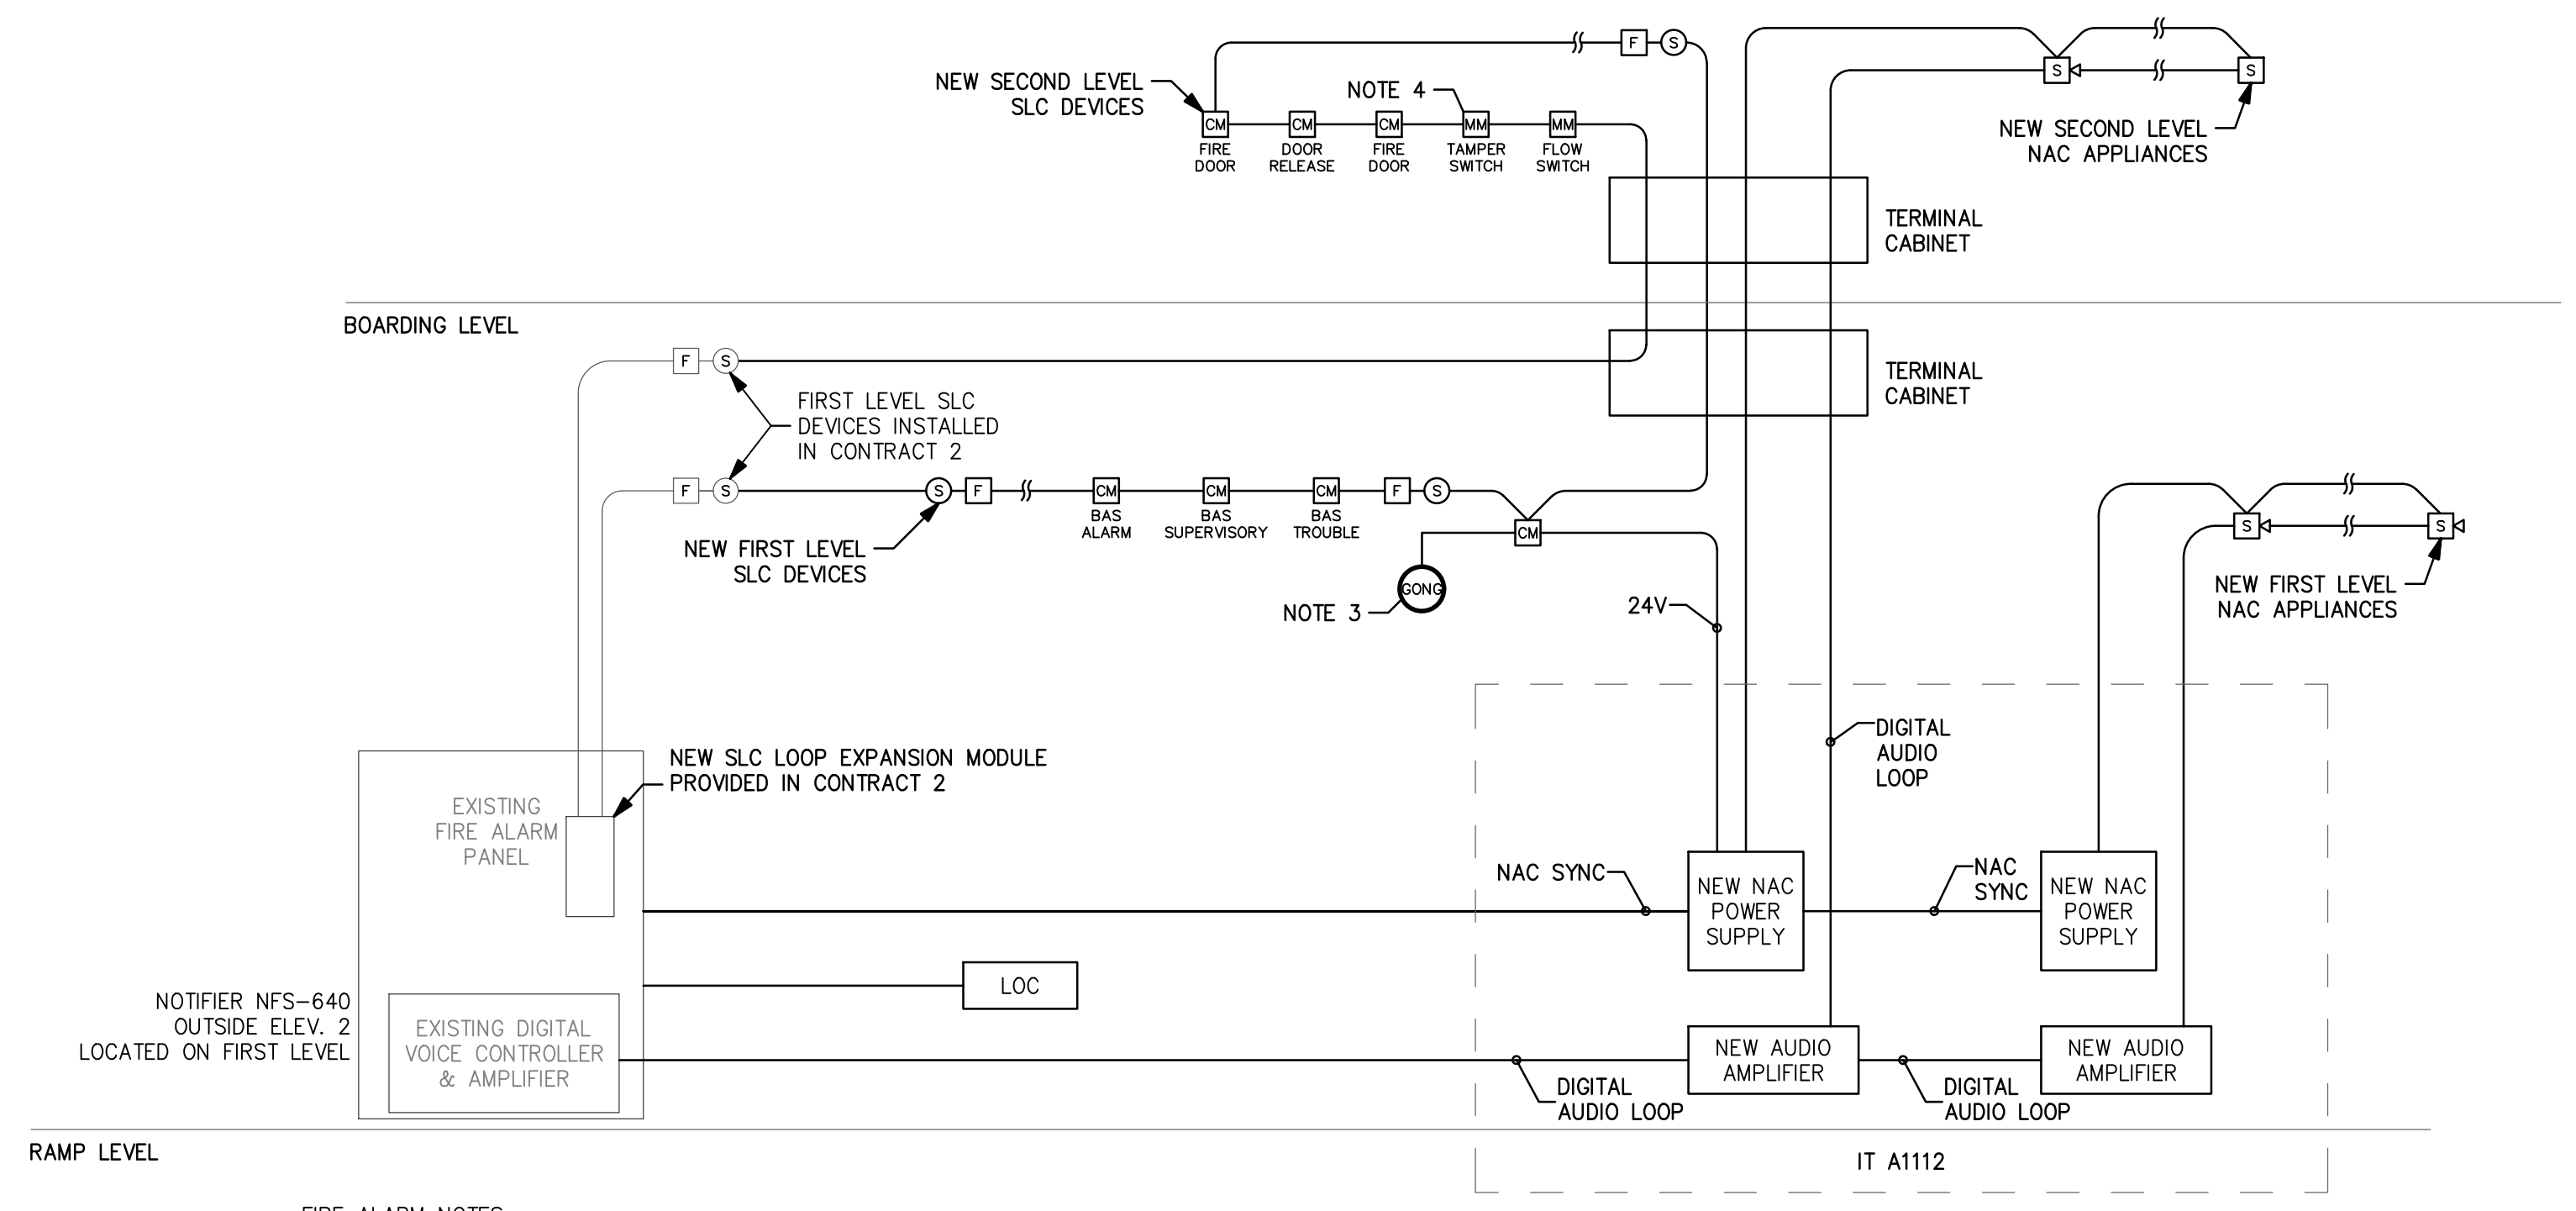


- FIRE ALARM NOTES**
1. NEW ADDRESSABLE DEVICES SHALL BE CONNECTED TO THE SLC PROVIDED IN CONTRACT 2.
  2. EXTENSION OF THE EXISTING BUILDING SLC TO CONNECT NEW DEVICES SHALL BE PERMITTED ONLY ON A CASE BY CASE BASIS. CONNECTION OF NEW DEVICES TO THE EXISTING SLC SHALL NOT BE ACCEPTED UNLESS APPROVED IN WRITING BY THE ENGINEER.
  3. ELECTRICALLY ACTIVATED SPRINKLER WATERFLOW BELL(S) OR GONG(S) SHALL BE FURNISHED AND INSTALLED BY THE MECHANICAL/SPRINKLER CONTRACTOR. THE ELECTRICAL/FIRE ALARM CONTRACTOR SHALL MAKE ELECTRICAL CONNECTIONS. ELECTRIC SPRINKLER WATERFLOW BELL(S) OR GONG(S) SHALL BE POWERED BY THE FIRE ALARM SYSTEM & SHALL OPERATE AT 24-V DC.
  4. MODULES INSTALLED IN NON-CONDITIONED SPACES SHALL BE TESTED, LISTED, AND MARKED FOR CONTINUOUS DUTY ACROSS THE RANGE OF TEMPERATURES AND HUMIDITY EXPECTED AT THEIR INSTALLED LOCATIONS.

**C FIRE ALARM SYSTEM RISER DIAGRAM**  
NO SCALE

	ACTIVATE COMMON ALARM SIGNAL INDICATOR	ACTIVATE COMMON AUDIBLE ALARM SIGNAL	ACTIVATE COMMON SUPERVISORY SIGNAL INDICATOR	ACTIVATE COMMON SUPERVISORY SIGNAL	ACTIVATE COMMON TROUBLE SIGNAL INDICATOR	ACTIVATE COMMON TROUBLE SIGNAL	ACTIVATE EVACUATION SIGNALS	TRANSMIT FIRE ALARM SIGNAL TO SUPERVISING STA.	TRANSMIT SUPERVISORY SIGNAL TO SUPERVISING STA.	TRANSMIT TROUBLE SIGNAL TO SUPERVISING STA.	SEND GENERAL FIRE ALARM SIGNAL TO BAS	SEND GENERAL TROUBLE SIGNAL TO BAS	ACTIVATE SPRINKLER GONG	RELEASE MANUALLY RELEASABLE FIRE DOORS	ACTIVATE ELEVATOR PRIMARY FLOOR RECALL	ACTIVATE ELEVATOR ALTERNATE FLOOR RECALL	ACTIVATE ELEVATOR VISUAL WARNING SIGNAL	ACTIVATE ELEVATOR POWER BRUNT	ACTIVATE FIRE SHUTTERS & FIRE DOORS	SHUT DOWN AIR HANDLERS	RELEASE ACCESS CONTROLLED DOORS IN EGRESS PATH
1. MANUAL PULL STATIONS	X	X	X	X	X	X	X	X	X	X	X	X	X	X	X	X	X	X	X	X	X
2. SMOKE/HEAT DETECTORS	X	X	X	X	X	X	X	X	X	X	X	X	X	X	X	X	X	X	X	X	X
3. SMOKE DETECTOR - ELEV. MECH. ROOM	X	X	X	X	X	X	X	X	X	X	X	X	X	X	X	X	X	X	X	X	X
4. HEAT DETECTOR - ELEV. MECH. ROOM	X	X	X	X	X	X	X	X	X	X	X	X	X	X	X	X	X	X	X	X	X
5. SMOKE DETECTOR - 1ST FLR. ELEV. LOBBY	X	X	X	X	X	X	X	X	X	X	X	X	X	X	X	X	X	X	X	X	X
6. SMOKE DETECTOR - 2ND FLR. ELEV. LOBBY	X	X	X	X	X	X	X	X	X	X	X	X	X	X	X	X	X	X	X	X	X
7. HEAT DETECTOR - ELEV. RT	X	X	X	X	X	X	X	X	X	X	X	X	X	X	X	X	X	X	X	X	X
8. HVAC DUCT SMOKE DETECTOR	X	X	X	X	X	X	X	X	X	X	X	X	X	X	X	X	X	X	X	X	X
9. SPRINKLER WATERFLOW	X	X	X	X	X	X	X	X	X	X	X	X	X	X	X	X	X	X	X	X	X
10. SPRINKLER CONTROL VALVE	X	X	X	X	X	X	X	X	X	X	X	X	X	X	X	X	X	X	X	X	X
11. SHUNT TRIP BREAKER PWR. SUPERVISORY	X	X	X	X	X	X	X	X	X	X	X	X	X	X	X	X	X	X	X	X	X
12. FIRE ALARM SYSTEM POWER FAILURE			X	X				X	X	X	X	X	X	X	X	X	X	X	X	X	X
13. FIRE ALARM SYSTEM LOW BATTERY			X	X				X	X	X	X	X	X	X	X	X	X	X	X	X	X
14. SPD CIRCUIT			X	X				X	X	X	X	X	X	X	X	X	X	X	X	X	X
15. GROUND FAULT			X	X				X	X	X	X	X	X	X	X	X	X	X	X	X	X
16. NOTIFICATION APPLIANCE CIRCUIT SHORT			X	X				X	X	X	X	X	X	X	X	X	X	X	X	X	X
17. AHU SHUTDOWN DEFEAT SWITCH			X	X				X	X	X	X	X	X	X	X	X	X	X	X	X	X

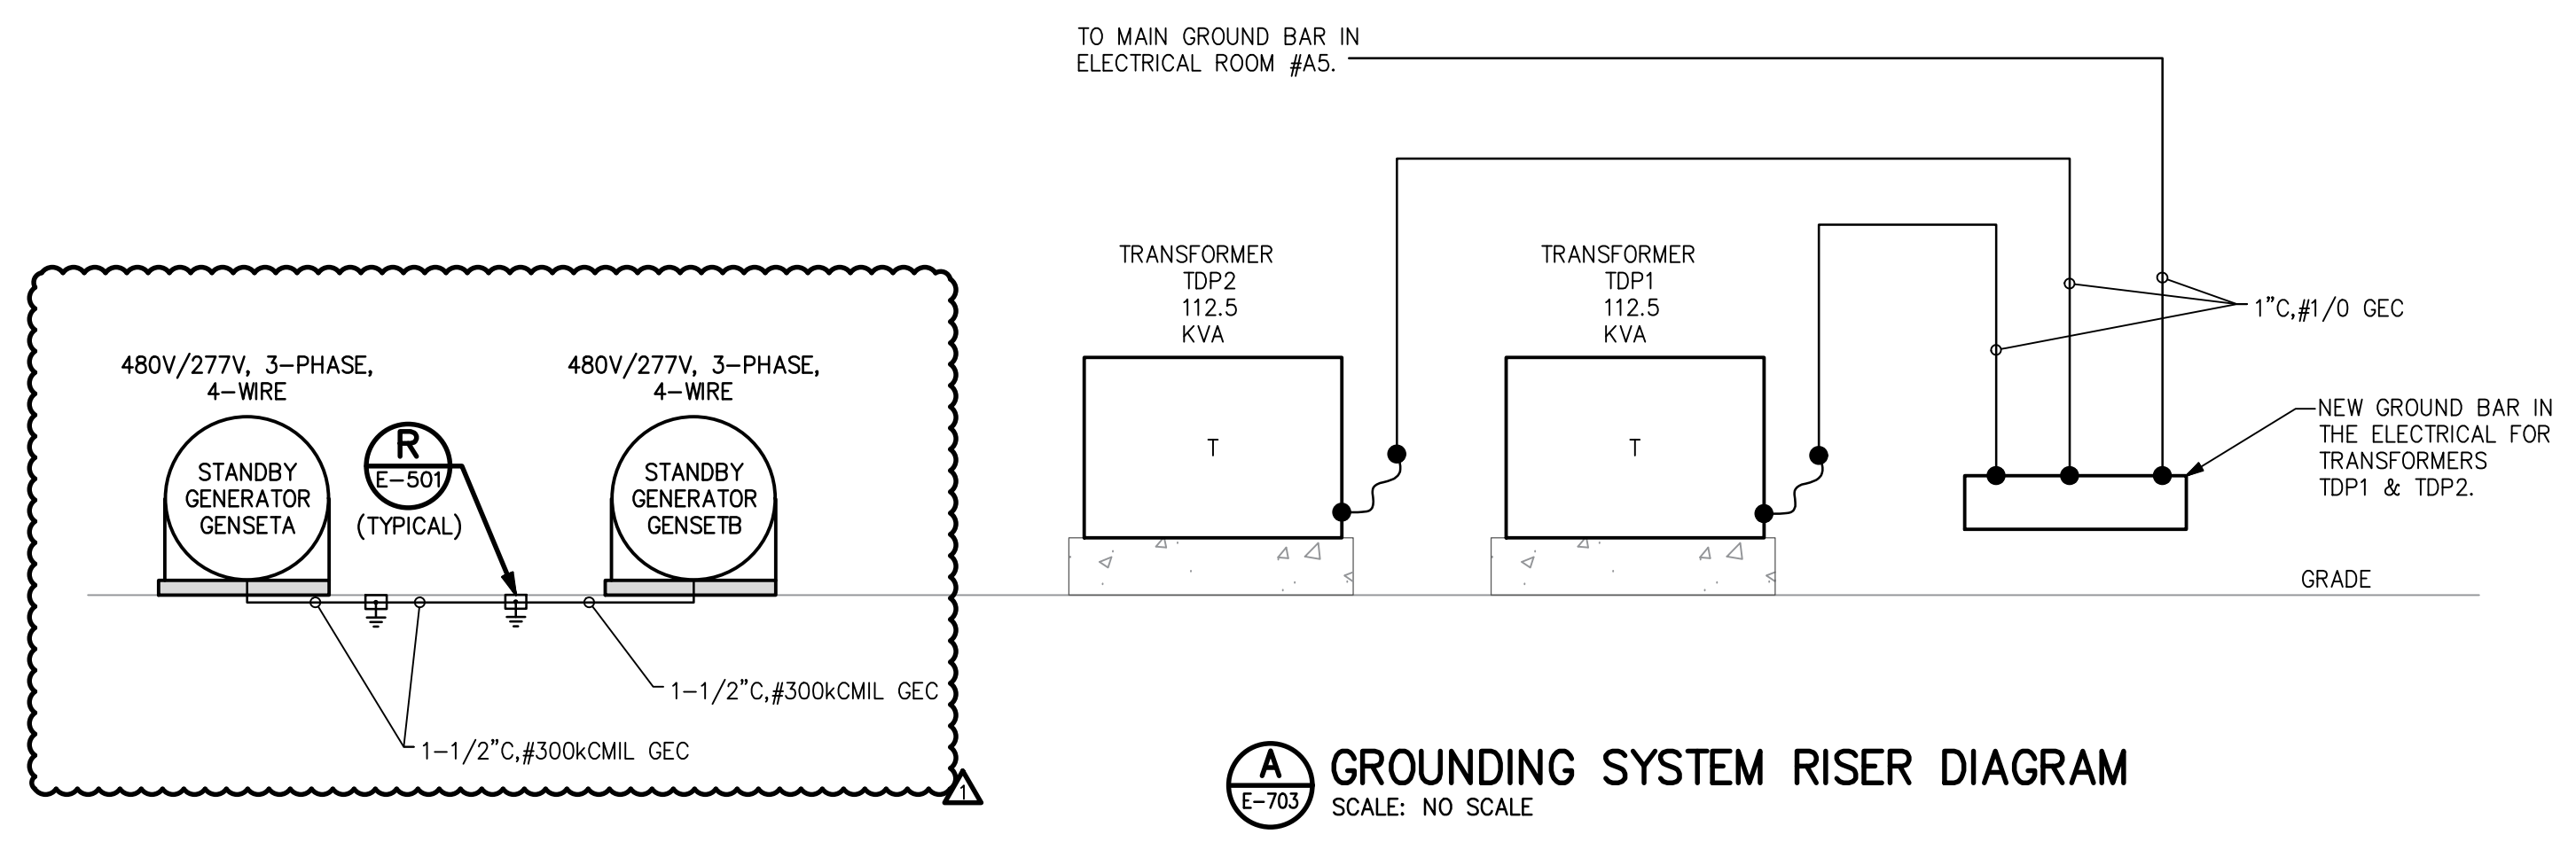

**A GROUNDING SYSTEM RISER DIAGRAM**  
SCALE: NO SCALE

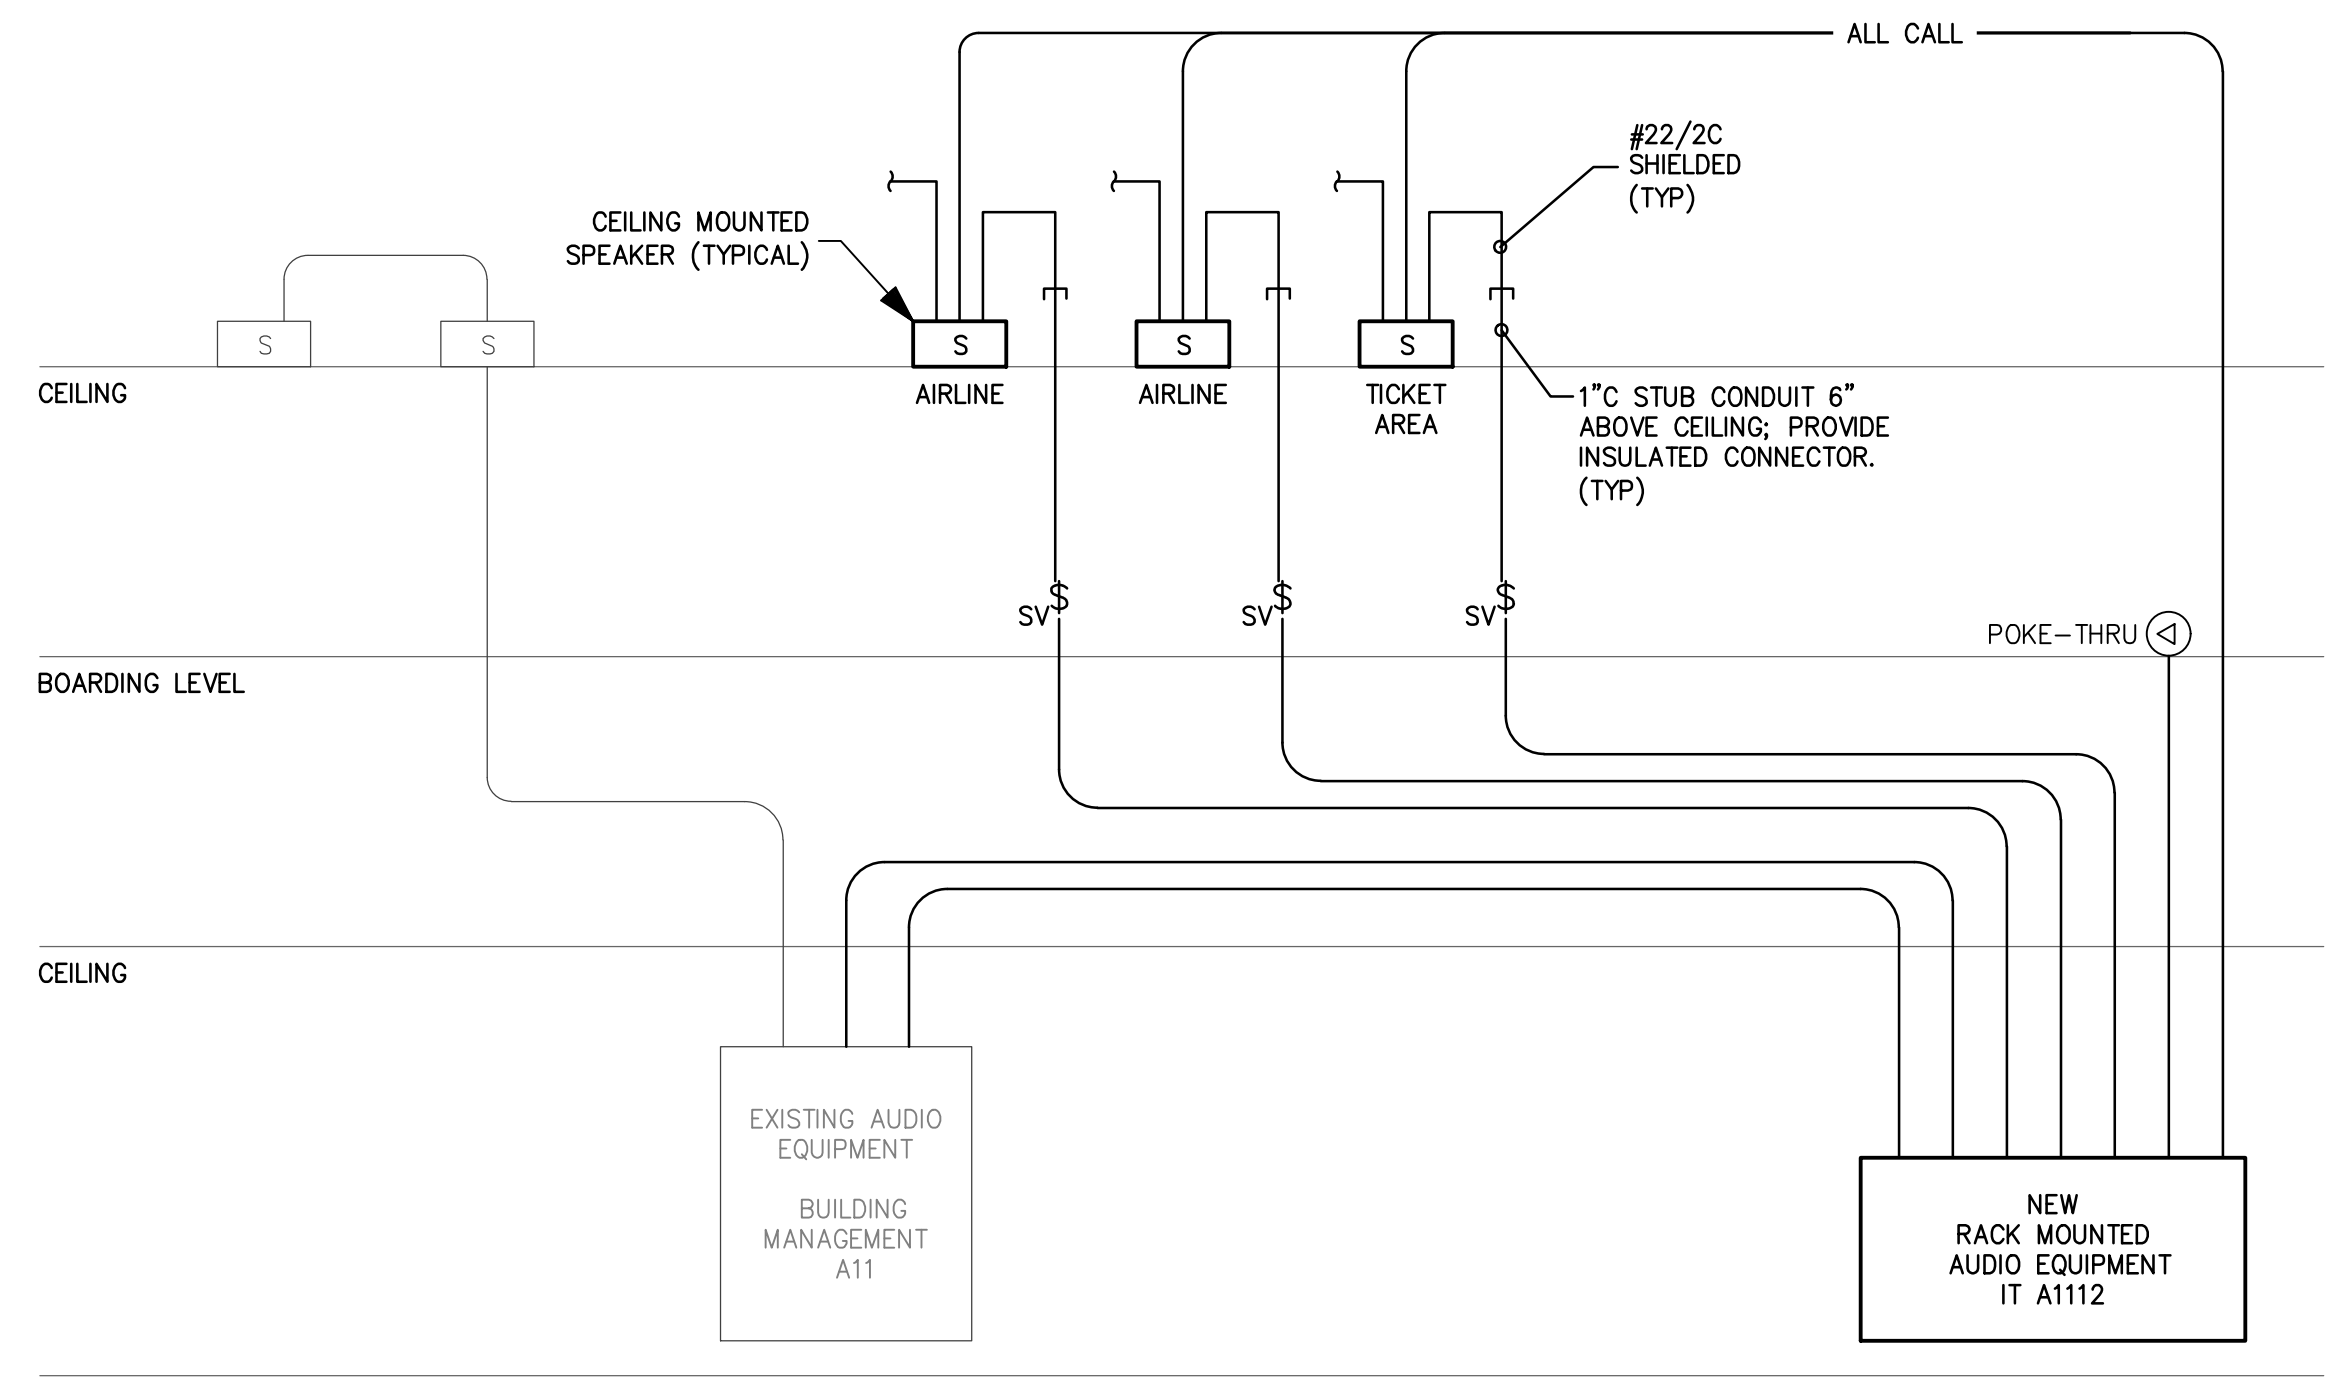


**B PA SYSTEM RISER DIAGRAM**  
SCALE: N/A


FOR CONTRACT 3 SCHEDULE 1 AND SCHEDULE 2 WORK PHASES:

- SEE ARCHITECTURAL PLANS A-01\* SERIES FOR ADDITIONAL AND DETAILED PHASING INFORMATION.
- SEE BAGGAGE HANDLING SYSTEM PLANS B-\* SERIES FOR ADDITIONAL AND DETAILED PHASING INFORMATION.
- COORDINATE ACTUAL PHASED WORK REQUIREMENTS WITH THE GENERAL CONTRACTOR'S SCHEDULE.

KEYED NOTES:  
 ① EXISTING DEVICES TO REMAIN.

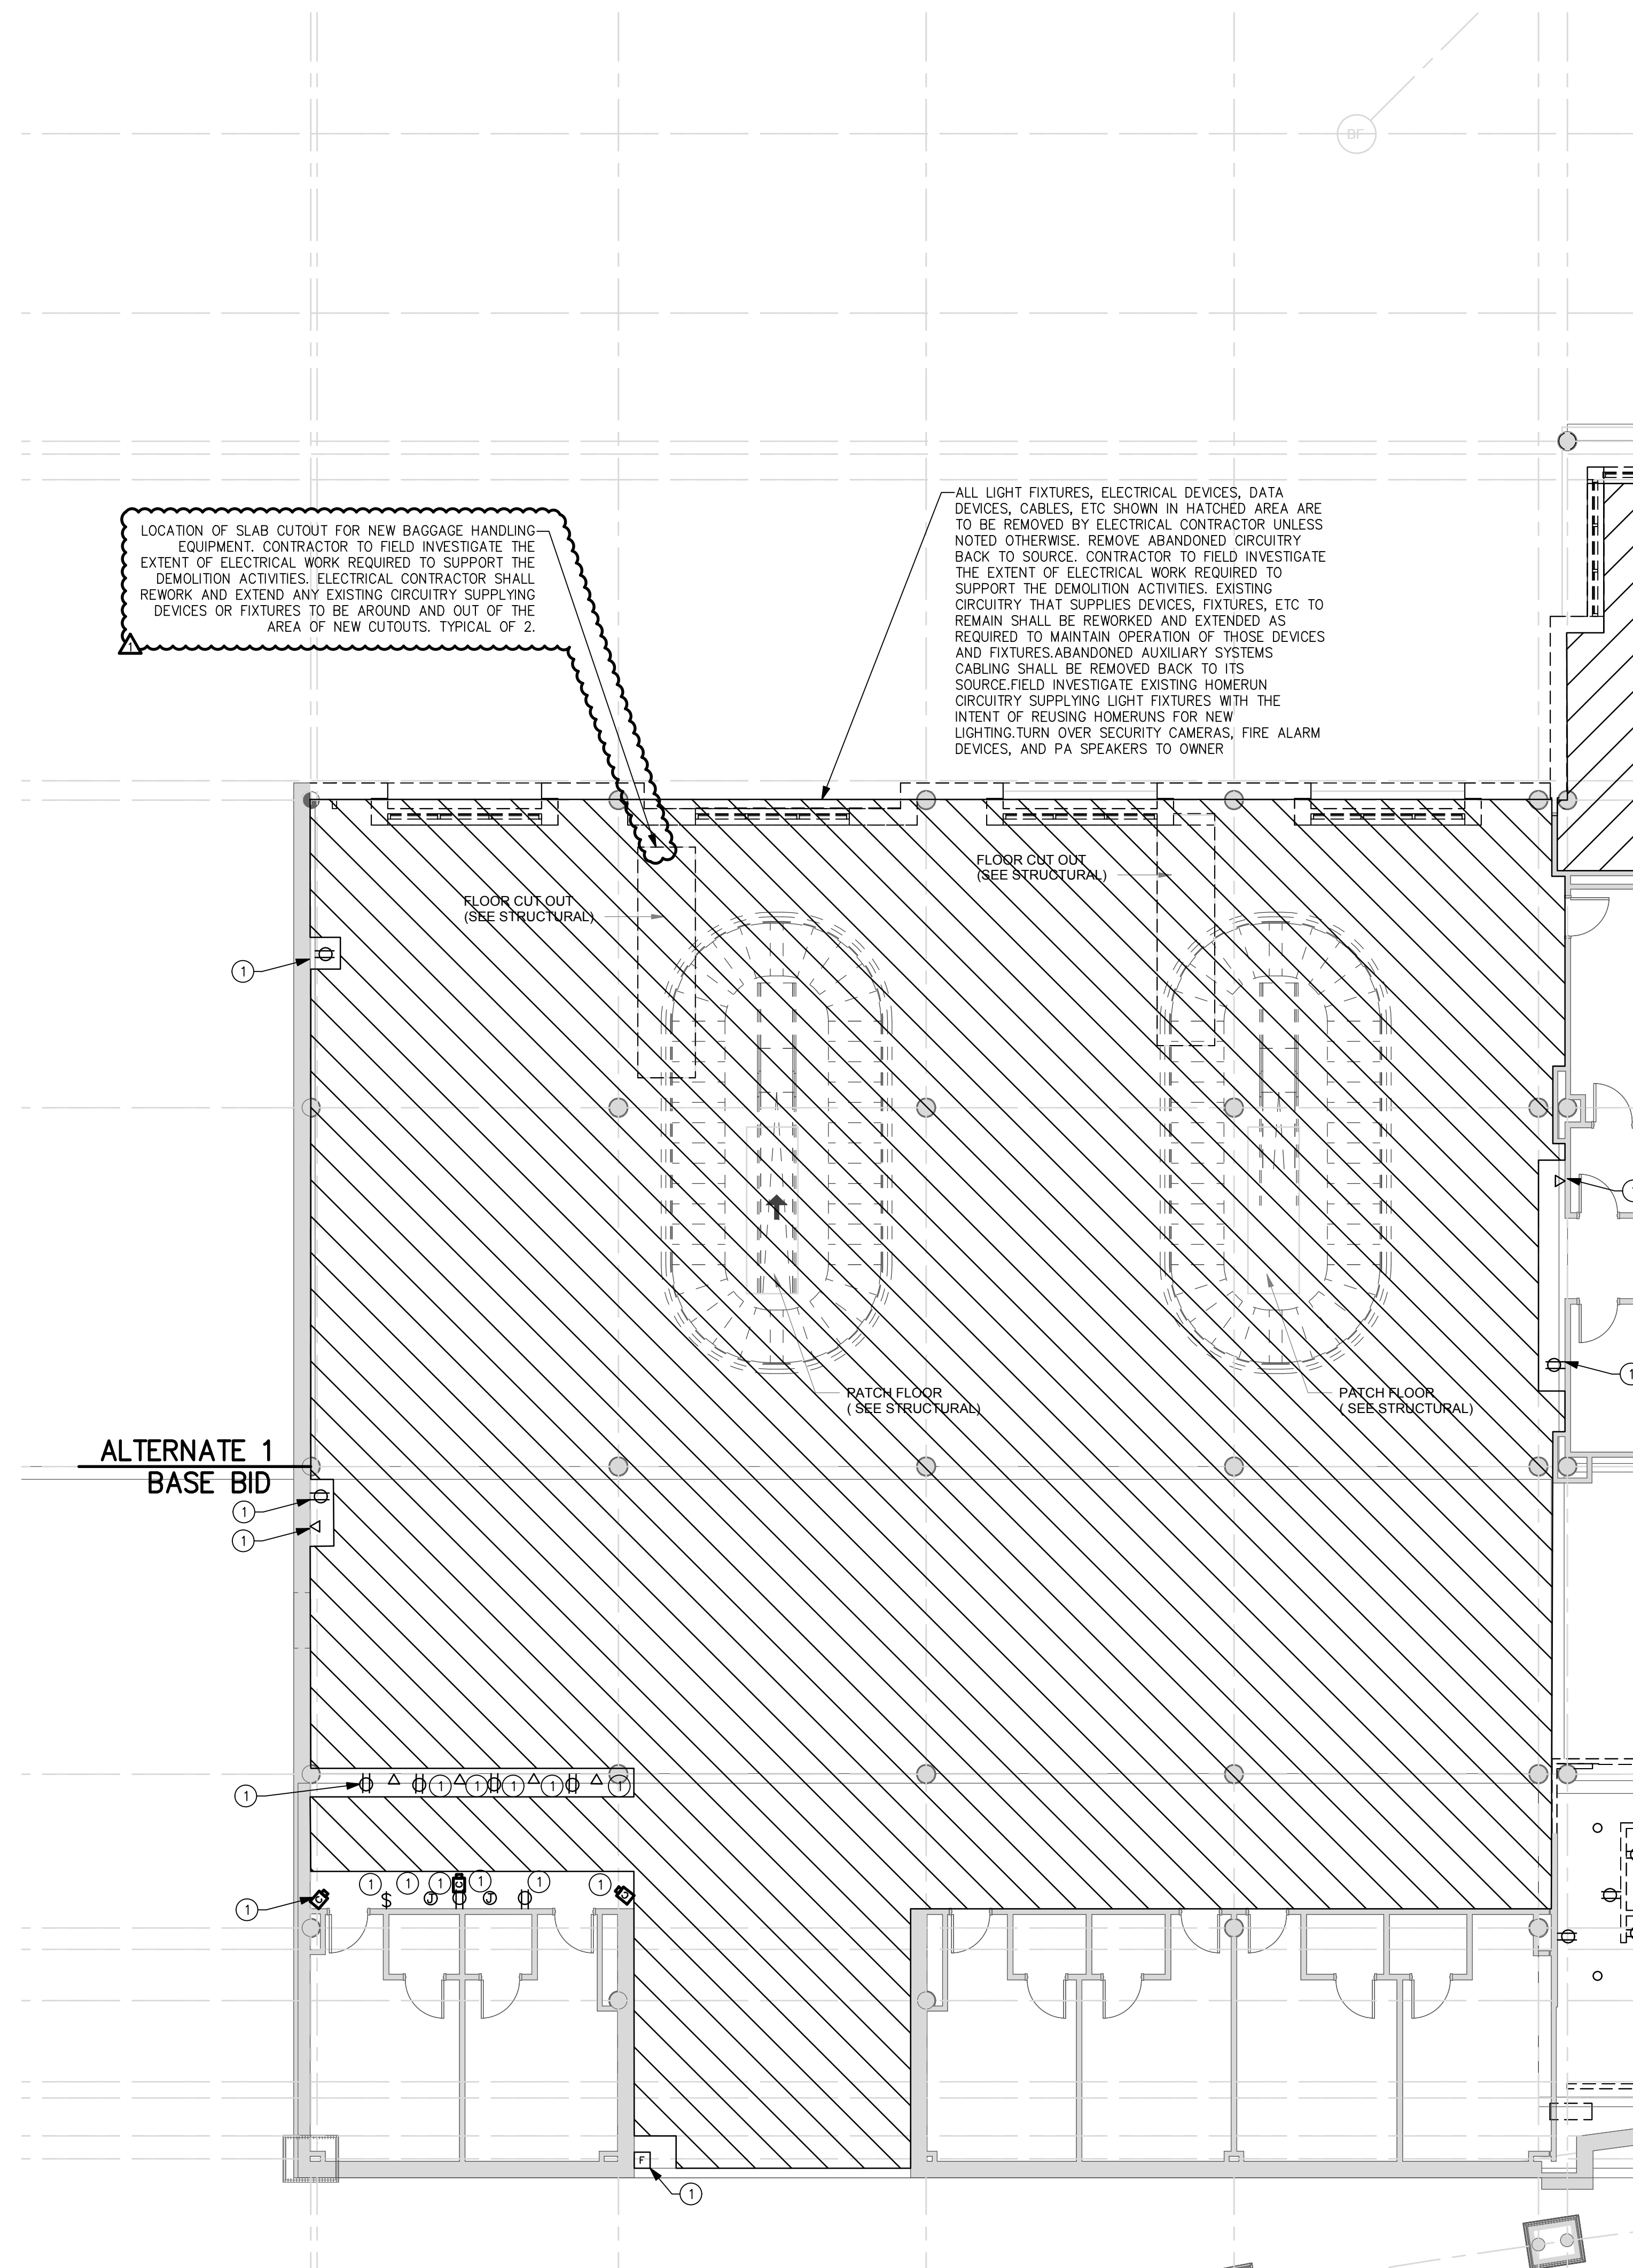

① SCHEDULE 2 - ELECTRICAL BOARDING LEVEL - DEMOLITION PLAN - ZONE 4  
 SCALE: 1/8" = 1'-0"


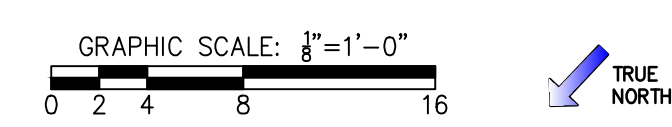


**TERMINAL IMPROVEMENTS CONTRACT 3**

Wilmington International Airport  
 1740 Airport Boulevard, Suite 12  
 Wilmington, NC 28405

**CHEATHAM & ASSOCIATES, P.A.**  
 CONSULTING ENGINEERS  
 3412 ENTERPRISE DRIVE  
 WILMINGTON, NORTH CAROLINA 28405  
 PHONE: (919) 452-4210  
 FAX: (919) 452-4211  
 OFFICE@CHEATHAMPA.COM  
 NC LICENSE# C-1073

JOB # 19005

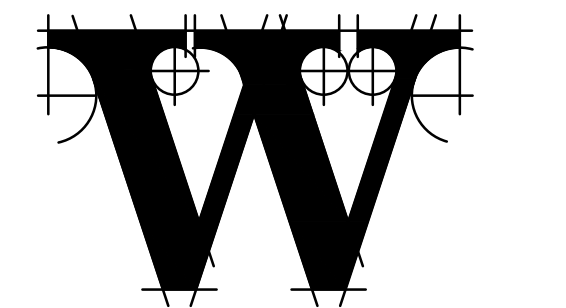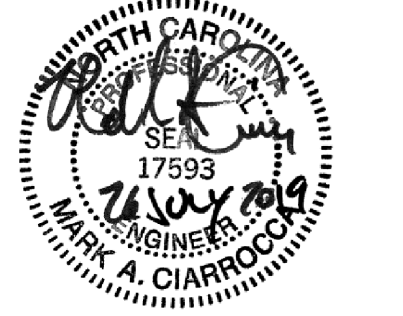

**THE WILSON GROUP**  
 - ARCHITECTS -

PO Box 5510 Charlotte, NC 28299  
 704-331-9747 • www.twgarchitects.com

PROJECT MANAGER & CIVIL ENGINEER  
**TALBERT & BRIGHT**  
 CONSULTING ARCHITECT  
 LS3P

STRUCTURAL ENGINEER  
 STEWART


FP/PM/E ENGINEER  
**CHEATHAM & ASSOC.**

BAGGAGE HANDLING CONSULTANTS  
 BNP

AIRCRAFT SUPPORT SYSTEMS  
 DK CONSULTANTS

SPECIALTY LIGHTING CONSULTANT  
 HARTRANFT

SIGNAGE & WAYFINDING  
 TAKEFORM

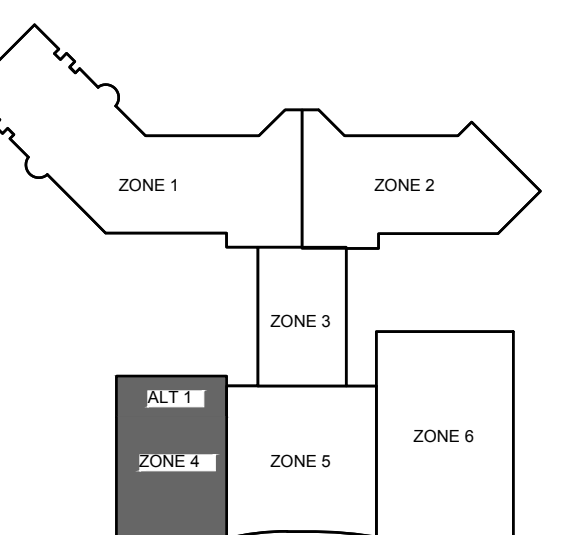

**KEY PLAN**

COPYRIGHT © 2019  
 THE WILSON GROUP ARCHITECTS  
 ALL RIGHTS RESERVED

PRINTED OR ELECTRONIC DRAWINGS AND DOCUMENTATION MAY NOT BE REPRODUCED IN ANY FORM WITHOUT WRITTEN PERMISSION FROM THE WILSON GROUP ARCHITECTS

**REVISIONS**

AD-03 07/26/2019



DATE 06/28/19  
 PROJECT NUMBER 9202-000  
 SHEET TITLE

**SCHEDULE 2 - ELECTRICAL BOARDING LEVEL DEMOLITION PLAN ZONE 4**


SHEET NUMBER

**ED2-124**

gray background to show illumination

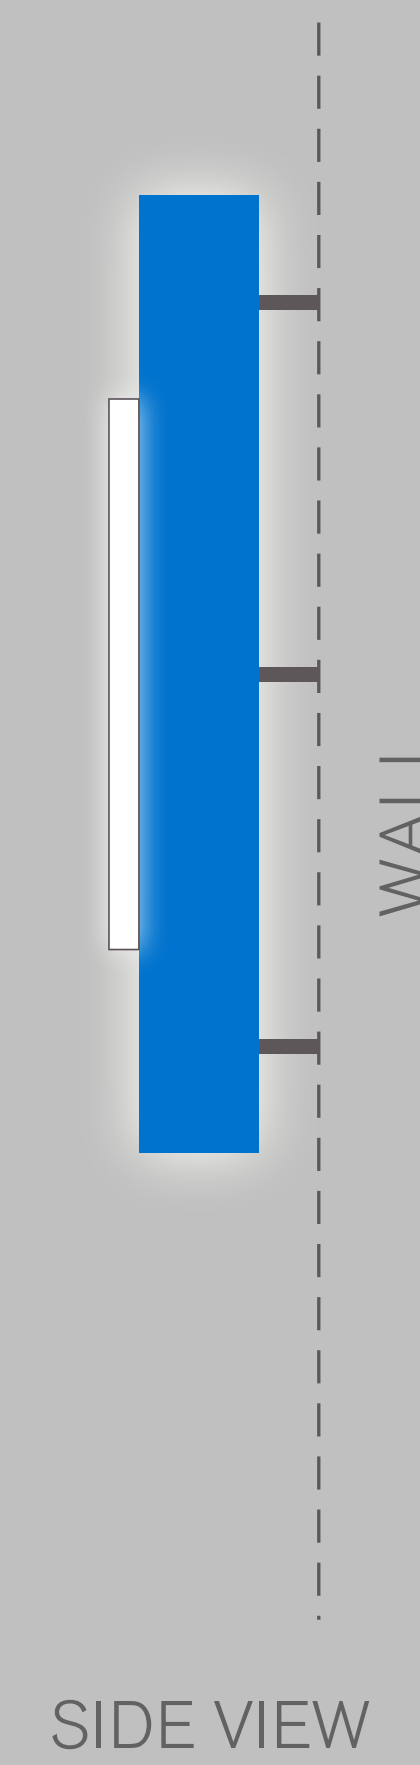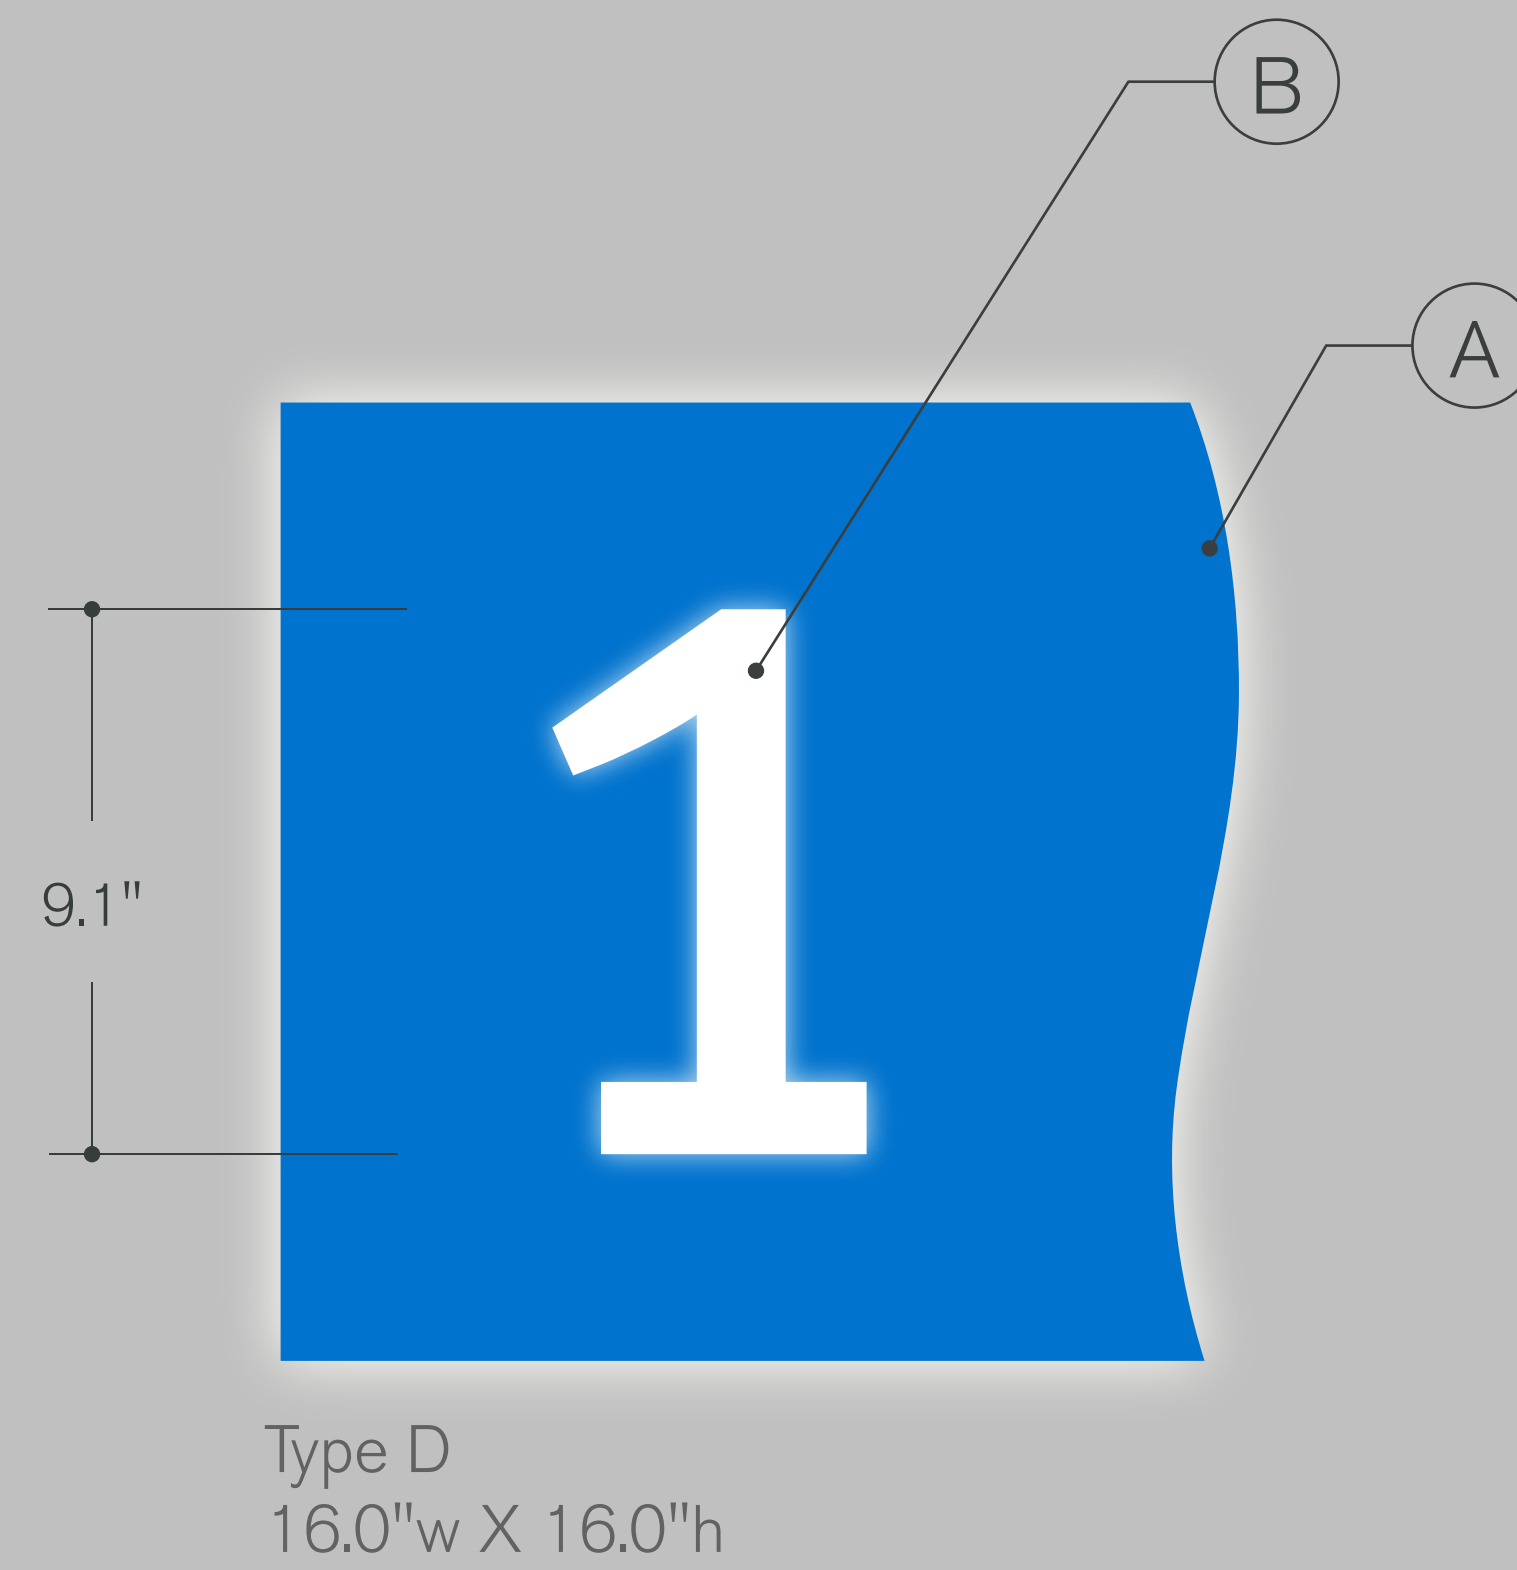

ELEVATION VIEW

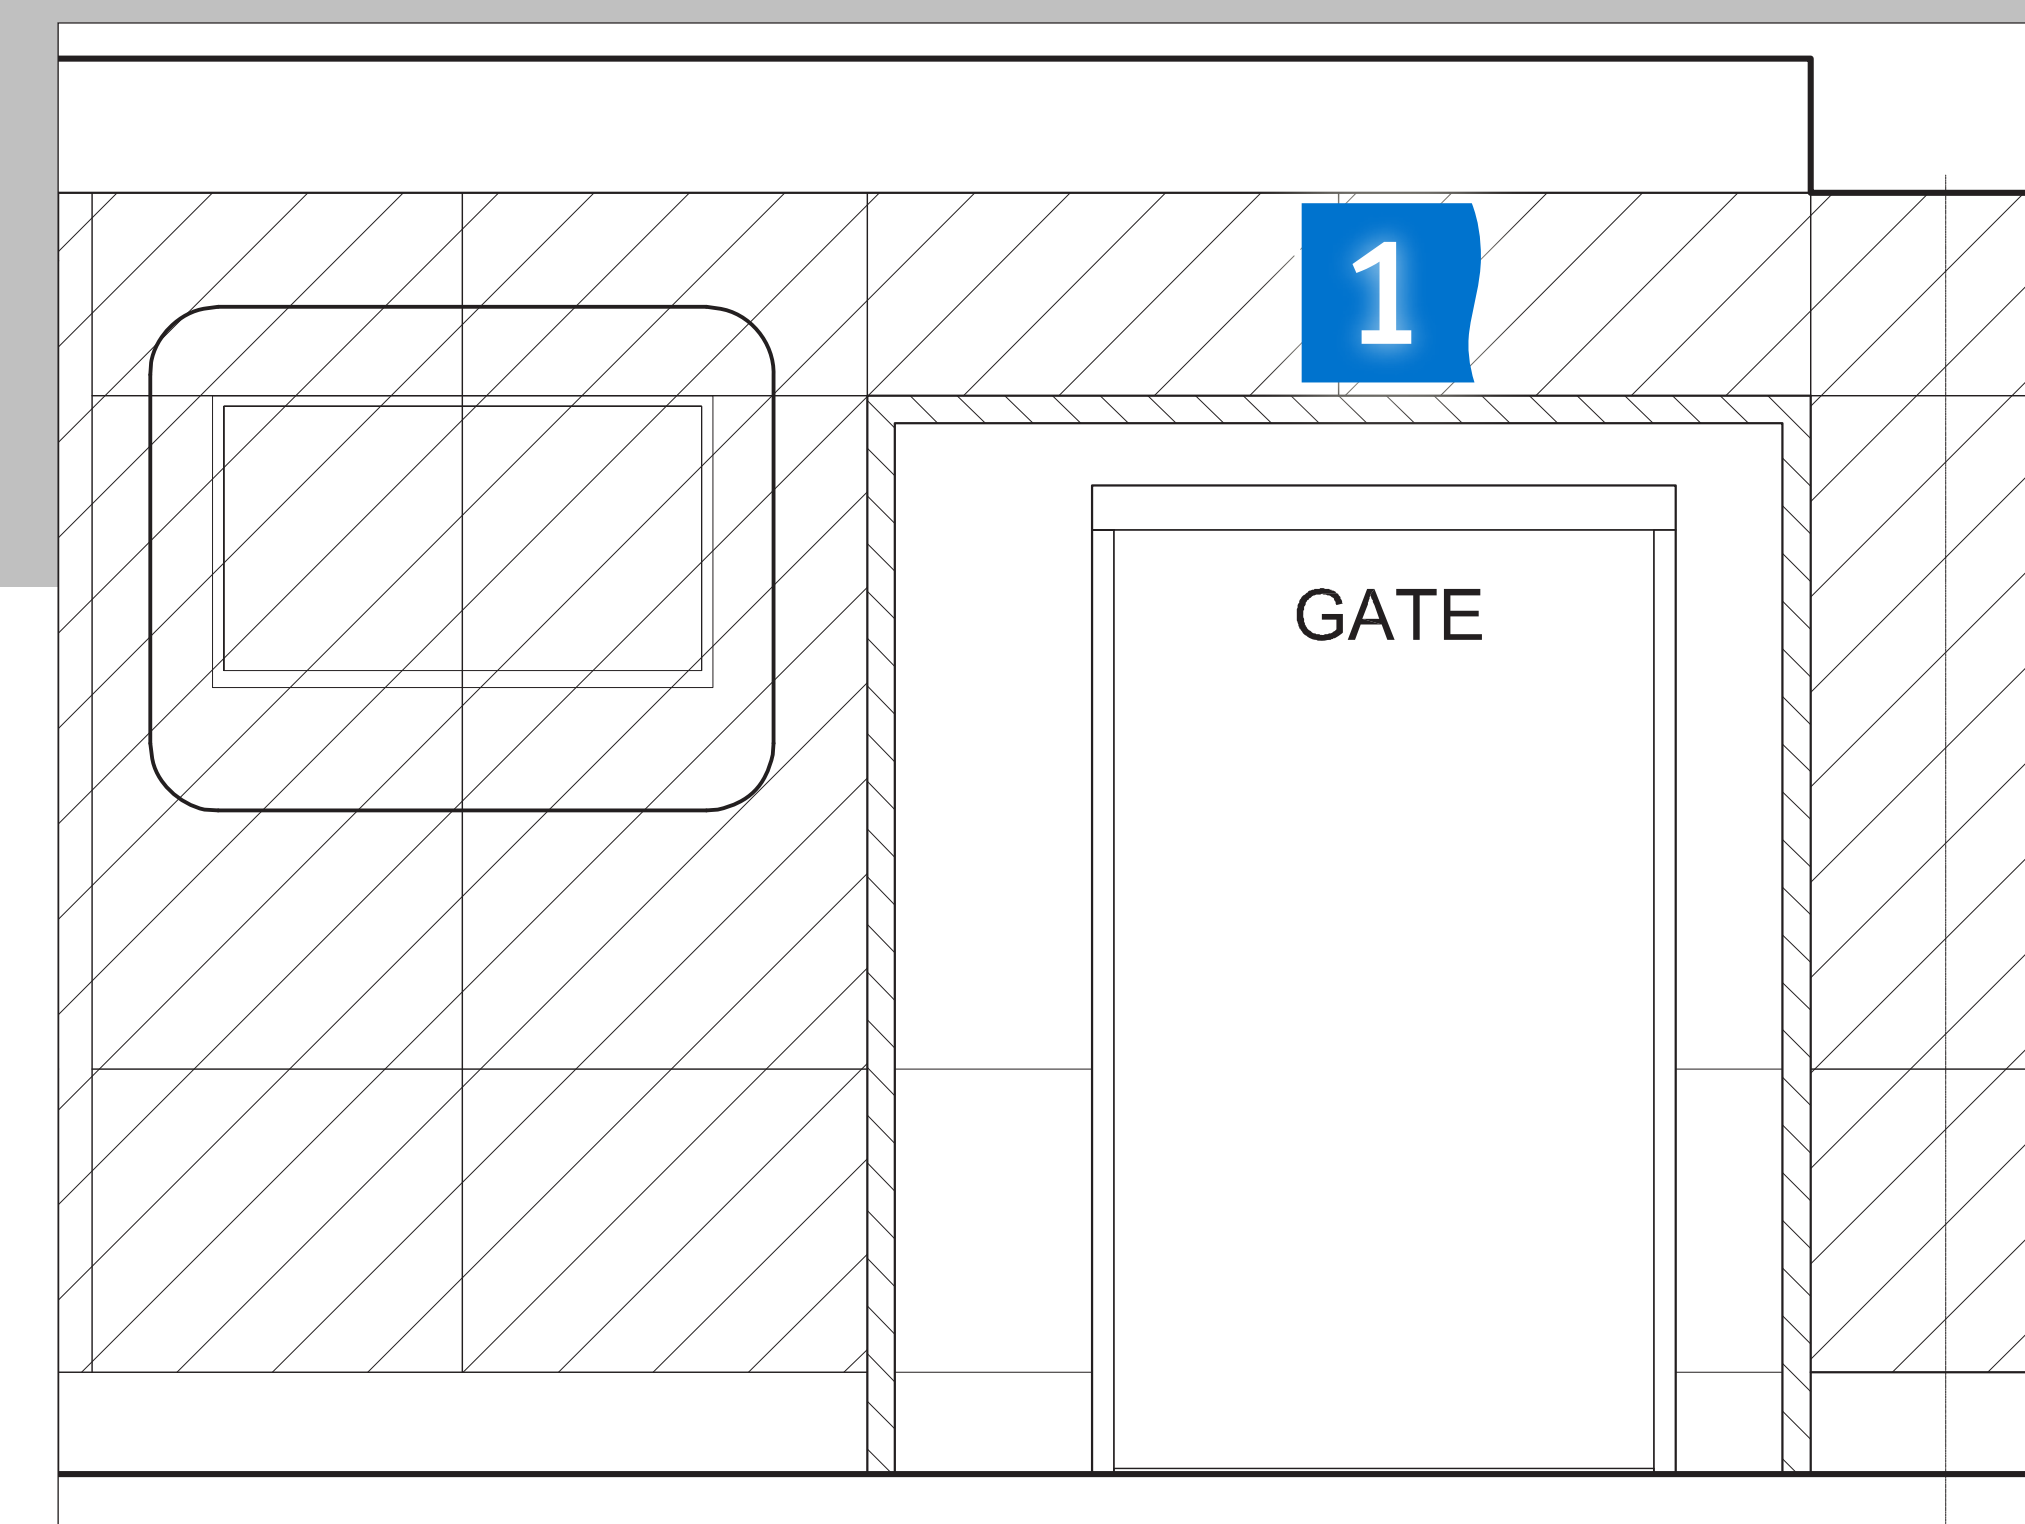

**Halo Lit - Fabricated Aluminum Pan**

- (A) Depth: 2.0"
- Paint to match PMS 285C
- LED illumination
- Mounting: Stud with 1.0" Stand-offs

**Illuminated Push Thru Lettering**

- (B) Thickness: .75 Translucent acrylic .5" proud of face
- Font: Meta B 770 wt
- 7328** White

# takeform

11601 Maple Ridge Rd, Medina, NY, 14103  
P 800.528.1398 F 585.798.8889  
www.takeform.net

## Rendering

Project:  
Wilmington International Airport

Date: 05.28.19 Drawn By: AKD

Filename:  
WIL0066\_68733\_RND\_rev3

Design Review By:

Revisions:  
06.13.19AKD add J.2, L  
06.27.19AKD updt/add signs  
07.26.19AEG update Type D

Scale: 1 1/2" = 1'

Notes:  
▪ Sign copy shown is for sample purposes only

**Product Approval**

As Is  As Noted

Approved By: .....

Date: .....

# AG-6