



UNC Wilmington Alderman and King Hall Renovation

SCO ID#: 22-24639-01A

Addendum Number 1: June 29, 2023

Project: UNCW King Hall Renovation
601 Hamilton Drive
Wilmington, NC 28403


CMaR Contractor: Muter Construction, LLC.
Preconstruction Contact: Brad Milne
Office: 919-404-8330
Mobile: 919-397-6971
Email: bmilne@muterconstruction.com

Addendum One has been issued for your review. The following items are included in this document.

- 1) Bid Date and time are now as follows:
 - a. Bid Date: July 25th, 2023. Bids are due by 2:00pm. Bid will be opened starting at 2:00pm.
 - b. Bid delivery:
 - i. **Hand-delivered to UNCW Veterans Hall (Room 1032) 1040 Walton Dr., Wilmington, NC, between 1:00 - 2:00 PM on July 25, 2023.** Paid Parking is available in East Parking Deck (971 Reynolds Dr.), or free parking is available at Visitor Lot (4941 Riegel Rd., Wilmington).
 - ii. **Mailed/shipped to Muter Construction (c/o Brad Milne) 111 E. Vance Street, Zebulon, NC 27597. Mailed or shipped bids to Muter must be received by 5:00 pm on July 24, 2023.**
 - c. Bid opening location:
 - i. **UNCW Veterans Hall (Room 1032) 1040 Walton Dr., Wilmington, NC**
- 2) Please place your sealed bid inside an envelope if mailing. On the cover of your sealed bid envelope please clearly state the following:

Proposal for UNCW King Hall Renovation
SCO ID# 22-24639-01A
Your Company Name
Bid Package Number(s) and Description(s)
- 3) It is the bidder's responsibility that bids be received on time and at the proper location prior to the closing time.
- 4) If bidding multiple packages, you must submit separate envelopes for each package.
- 5) Please do not visit the project site any other time without first notifying and coordinating with Brad Milne at Muter Construction. Contact information is at the top of this addendum.
- 6) Bidders are reminded to review all drawings, specifications and bid manual documents so they provide a complete bid. Exclusions or qualifications are grounds for disqualification.
- 7) **Bids MUST INCLUDE** the following or they may be considered non-responsive and not opened:
 - a. Form of Proposal
 - b. Minority Business Participation Forms - Bid must include:
 - i. Identification of HUB Certified / Minority Business Participation

- ii. Either Affidavit A or Affidavit B
 - iii. Bid Bond of 5% (if bids are equal to or greater than \$500,000)
- 8) The HUB and Minority Business Participation goal for this project is 10%.
- 9) Payment and Performance Bonds are required to be included in your bid price if your bid price is equal to or greater than \$300,000.00.
- 10) Specification Section 000102 – Supplementary General Conditions Article 23 – Time of Completion, Delays, Extensions, section “i” Liquidated Damages shall be changed to \$500/day.
- 11) BP23 – HVAC Installation shall include the following in their base bid:
 - a. \$9,000 for AHU storage
 - b. \$5,000 for extended AHU warranty.
- 12) During demolition or abatement, if removal of items includes removing supports for items that are connected to materials to be removed, ie. pipe supports or j-boxes, as shown in the attached photos of the chimney in the Mechanical room, those items shall be temporarily supported by the demo contractor during their work and provisions made for adjustments and permanent support or connections upon completion of their work and shall be accounted for and included in their pricing. This shall be the same for all floors.
- 13) The current construction schedule is as follows (10 months):
 - a. Anticipated NTP – August 14th, 2023
 - b. Anticipated Substantial Completion Date – June 14th, 2024
- 14) Plan sheet E2.1.1 Attic Plan – Lighting is old and does not apply. This was replaced with sheet E2.3 – Attic & Roof Plans dated Feb. 10, 2023.
- 15) Bid questions have been asked are listed here below with responses:
 - a. **Question:** Can we remove a window for material delivery?
Answer: The window shown below at Stair 201 shall be removed, stored on site in Room 104 and wrapped in plastic by BP02 – Selective Demolition and Abatement. The window shall be replaced by BP08A – Aluminum Storefront-Windows-Glazing and BP09E – Paint-Wall Coverings shall carry an allowance of \$2,500 for paint and repair work. A temporary removable plywood partition shall be installed by BP01-General Trades and Site Labor. The window to be removed is shown here.

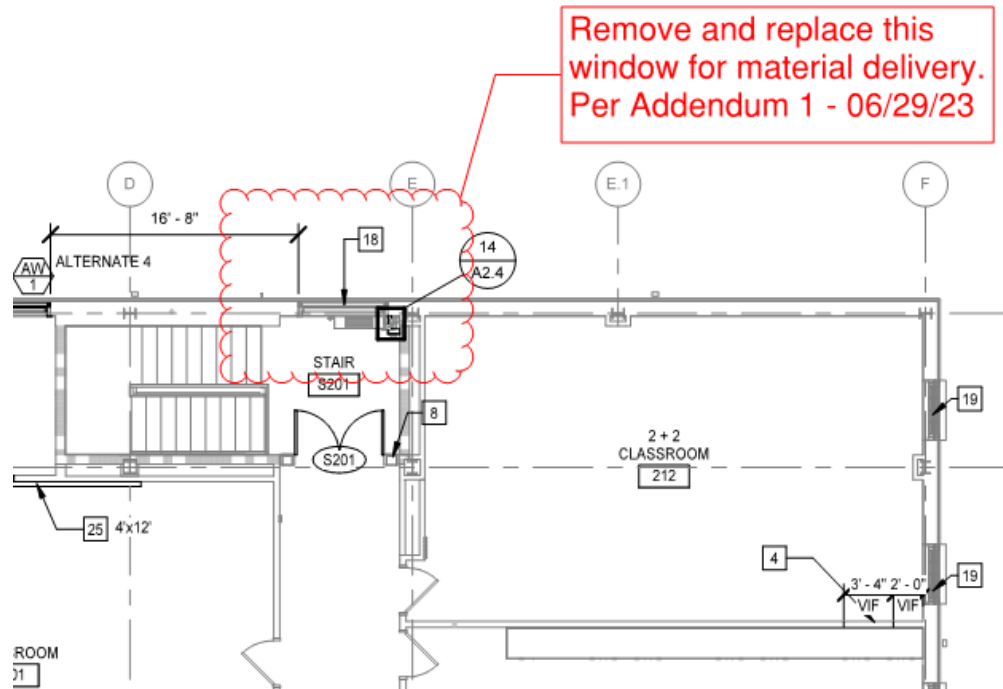

- b. **Question:** Are the early AHU's for King Hall only.
Answer: Yes. The early AHU package was for King Hall only. The approved material submittal is attached for reference. The contact for this equipment is John Blakeney, TRS-Sesco. (919) 618-5779 or john.blakeney@coolsys.com if there are any questions regarding material specifications.
- c. **Question:** Can we park in the adjacent parking lots.
Answer: Parking in adjacent lots is not acceptable and any tickets received for parking in unapproved areas shall be paid for by the contractor receiving the parking tickets. There will be parking provided in designated fenced areas per the logistics plan. There is also parking available at the "Cinema Lot" across College Road if needed and will be coordinated with UNCW at that time for no charge.
- d. **Question:** At the second floor of King Hall there is a new janitor's closet. Will FRP be installed behind the sink 4' in each direction and 4' high? If FRP will be added, please confirm which bid package it will be added to.
Answer: See updated A2.1 sheet indicating FRP locations. This shall be included in BP09A – Drywall-Metal Stud-Insulation bid package.
- e. **Question:** Will a combination bid package for drywall and ACT be allowed to provide savings to UNCW?
Answer: Revised Bid Form is attached for BP09A – Drywall-Metal Stud-Insulation which includes an Add Alternate Line for ACT Ceilings.
- f. **Question:** Confirm that all drywall ceilings will remain and only be patched.
Answer: The only drywall ceilings to remain are in the Theater and the elevator equipment room on the second floor. The drawings indicate that it is anticipated one corner of the ceilings in the auditorium needing to be removed and patched to do work. The diagonal hatch pattern on the demo drawings describes these locations as well.
- g. **Question:** Please clarify the floor patching allowance in BP09B – Ceramic Tiling and BP09D – Flooring.

- Answer:** The floor patching allowance is for excessive floor patching that may be found after removal of the existing floor finishes and prior to installing new floor finishes. The base bid shall include a normal amount of floor patching.
- h. **Question:** Who provides and who installs the putty pads for inwall utility boxes.
Answer: Specification Section 09 29 00 Gypsum Board includes Putty Pads. These shall be provided and installed by BP09A – Drywall-Metal Stud-Insulation package.
- i. **Question:** When will plans be released for Alderman?
Answer: Plans are being designed currently for Alderman Hall renovations and are expected to be released for pricing this fall.
- j. **Question:** Clarify abatement/demo schedule and number of mobilizations for window removal if Alternate 1 is accepted. Will all windows be allowed to be removed at one time and who protects openings?
Answer: The Abatement/Demo contractor, BP02 – Selective Demolition and Abatement, shall removal all windows in one mobilization. General Trades, BP01-General Trades and Site Labor shall install protection immediately upon window removal to consist of plywood sheeting to create wind/water resistant protection at all window openings. General Trades shall also remove and prepare the openings for the window installation in a manner consistent and acceptable to the installation schedule. All blocking, trim, drywall repair, paint, etc. required upon new window installation shall be by the individual packages assigned to those scopes of work as indicated on their respective bid forms.
- k. **Question:** Can you clarify the base bid for abatement and demo for areas that are not to be touched vs. alternates, such as Alt. 3A - Classroom 104 or Alt. 3 - First Floor Offices?
Answer: If alternates are accepted, demo/abatement in those areas is to take place as indicated on the bid forms for alternates. If the alternates are not taken, the demo/abatement shall not take place in those areas.
- l. **Question:** Can you clarify who cuts roof openings for new equipment, penetrations, etc.
Answer: Openings in the roof for equipment or penetrations shall be cut by the demo contractor, BP02 – Selective Demolition and Abatement, locations and sizes to be provided by the Mechanical Contractor, BP23 – HVAC Installation. Roofing contractor, BP07 – Roofing, to provide temporary protection of roof openings for watertightness. Equipment curbs to be provided by Mechanical Contractor and set by Roofing Contractor in coordination with each other. Multiple mobilizations may be required by each subcontractor based on schedule of equipment and material delivery. At no time shall the roof openings be unprotected by any trade.
- m. **Question:** Can you confirm which trades demo MEP items?
Answer: Electrical contractor, BP26 – Electrical-Communications-Fire Alarm, shall make safe all electrical items. Each trade is responsible for demolition of their items, ie. electrical = Electrical Contractor, plumbing = Plumbing Contractor, mechanical = Mechanical Contractor.

Attachments included in this Addendum:

1. Prebid Sign-in Sheet from 06/22/23
2. Prebid Agenda from 06/22/23
3. Mechanical room pictures indicating items to be supported at completion of demolition.
4. Early Equipment Package Submittal 237313 Modular Indoor AHU's for reference
5. 1963 King Hall Original Drawings
6. A2.1 revised
7. A3.2.1 revised
8. Bid Form BP09A – Drywall-Metal Stud-Insulation-FRP (revised)
9. Bid Form BP09E – Painting-Wall Coverings (revised)
10. Bid Form BP23 – HVAC Installation (revised)

Larry Pickmore
Bryan Hammonds

Trifecta lcrickmove@trifectainc.com
Workhorse Industries Bryan@wh-ind.com

919-524-5216
843 593 2528

Project: UNCW King & Alderman Hall Renovations
SCO ID#: 22-24639-01A
Description: Pre-bid Meeting
Date/Time: 06/22/2023 @ 10:00am
Location: King Hall, 601 Hamilton Dr., Wilmington, NC

Spencer Clark
Glen Collins
Tim McERRITT

DH Griffin
DARF
Tim's HVAC, INC timherritt@timshvac.com

Saclark@dhgriffin.com
dgcollinsedari.com
336-707-8268
919-772-4777
910-604-1485

| Name (Print) | Company | Email | Phone Number |
|------------------|----------------------------|-----------------------------------|---------------------------|
| Brod Milne | Muter | bmilne@muterconstruction.com | 919-397-6971 |
| Nic Troutman | UNCW | troutmann@uncw.edu | 910-617-4318 |
| MATTHEW HIMES | MACSONS | mhimes@macsons.com | 910-747-9417 |
| BACAR QUESADA | GREY INTERIORS | bquesada@greyintllc.com | 669-205-2479 |
| GREG PHILLIGIN | Pitt Electric | GPhilligin@PittElectric.com | 910-530-0561 |
| JIM PORCH | FLOOR COVERINGS INTL | jim.porch@fcintl.com | 910-575-5248 |
| Mitch McRae | Flooring Solutions | M.McRae@FlooringSolutions.com | 843-206-9596 |
| Derek Johnson | Foss Demolition | Djohnson@Fossdemolition.com | 910-409-7607 |
| Jim Wallace | GUNG HO DEMO | jim.gunghodemolition.com | 910-880-2701 |
| Aaron Assad | Melton Electric | aaron.assad@meltonelectric-sc.com | 704-974-9584 |
| Tim Dupree | Carolina Comm. floor cover | tim@ccfloorcovering.com | 910-777-3223 910-343-3350 |
| Matt Albrecht | Hanover Coatings inc | alatt@hanovercoatingsinc.com | 910-457-6910 |
| Jill Edwards | Hanover Coatings | Jill@hanovercoatingsinc.com | 910-313-6866 |
| MICHAEL GARRISON | DIV 9 | MGARRISON@DIV9INC.COM | 910-392-0882 |
| Phillip James | BFPE Int | pjames@bfpe.com | 910-409-8809 |
| JAKE SMITH | BHIND DEMOLITION | Jsmith@bhinddemolition.com | (843) 340-7508 |
| JON WELLS | HAMPSTEAD PLEC | hampstead@pletc.com | 910-471-2038 |
| Brooke Perkinson | Hanover Interiors Inc | brooke@hanoverinteriorsinc.com | 910-262-1895 |
| John Wirsen | | jcwirsen@hanoverinteriorsinc.com | 910-352-4451 |
| Brian Sanders | EHS/Alloy | bsanders@alloygroup.com | 919-201-7451 |
| Nick Dial | Enpuricon | ndial@enpuricon.com | 919-500-8037 |

- Bid Opening Location: UNCW Veterans Hall (Room 1032)
 1040 Walton Drive
 Wilmington, NC 28403

NOTE: Be sure to allow enough time for parking and for entering the building.

- Bid Bonds will be required for bids equal to or greater than \$500,000. P&P bonds will be required for successful bidders if their bid price equal to or greater than \$300,000.
- Deadline for Contractor Questions:
 - All questions, substitution requests, and clarification requests shall be submitted to the Construction Manager in writing via email. Neither the Designers nor the Owner shall be responsible for oral instructions.
 - Questions should be emailed to Brad Milne at bmilne@muterconstruction.com. Bidders are asked not to contact the Owner or Design Team consultants directly.
 - All questions, substitution requests, and/or clarifications must be submitted by June 23rd, at COB.

4. BID OPENING:

Sealed proposals will only be received from prequalified, invited Subcontractors and are to be received no later than 2:00 pm on July 18th, 2023, and will be opened and read aloud at 2:00pm starting with the lowest bid package number. Participants may view the formal bid opening in person at the address listed above. Bids that arrive late will not be accepted. It is the bidder's responsibility to make sure the bids are delivered and received on time. Bids must be in a sealed envelope clearly identified on the front as:

Proposal for UNCW King Hall Renovations
SCO ID# 22-24639-01A
Your Company Name
Bid Package Number and Description

Prequalification: Bids will be accepted from prequalified bidders only. Please go to www.muterconstruction.com for a list of prequalified bidders for these bid packages.

5. **PROJECT DESCRIPTION:** This project encompasses the renovation of both Alderman Hall and King Hall. Alderman Hall, a two-story 26,108 SF building: envelope repairs, code deficiency corrections (ADA, egress, and restroom improvements), mechanical/electrical replacements, and new finishes in individual suites and corridors. King Hall, a two-story 22,298 SF building: code deficiency corrections (ADA, egress, and restroom improvements), new fire alarm system, mechanical/electrical replacements, programmatic renovations of the second floor to accommodate the Honors College, and new finishes in the public spaces on the first floor.

6. **BID PACKAGES INCLUDED:** (01) General Trades; (02) Selective Demolition and Abatement; (05) Misc. Metals; (06) Architectural Woodwork/Cabinets/Millwork; (07) Roofing; (08A) Aluminum Storefront/Glazing; (08B) Door, Frames & Hardware; (09A) Drywall/Metal Stud Framing/Thermal Insulation; (09B) Tile; (09C) Acoustic Ceilings ;(09D) Flooring; (09E) Painting and Wall Coverings; (10B) Interior Signage; (22) Plumbing; (23) HVAC; (26) Electrical/Communications/Fire Alarm

7. **ADDENDUM:** No addendum has been issued to date.
 - All questions are requested by COB Friday, June 23rd.
 - All bidding RFI's shall be submitted to bmilne@muterconstruction.com only. Emails sent to any other person or email address will not receive a response.
 - All addendums will be issued through Building Connected. If needed via email, please contact Brad Milne.
 - Addendum No. 1 is scheduled to be sent out by Thursday, June 29th. If you do not receive an addendum, please submit a request to bmilne@muterconstruction.com

8. **CONSTRUCTION DURATION:**
 - The work for this project will be between July 2023 and May 2024 (10 months).

9. **SCHEDULE OF ALLOWANCES (spec. section 01 21 00 – Allowances)**
 - Allowance No. 1 – 200 lf of Cat 6 ethernet cable.

10. **UNIT PRICES (spec. section 01 22 00 – Unit Prices)**
 - Unit Price No. 1 – Furnish and install Cat 6 ethernet cable per lf.

11. **ALTERNATES (spec. section 01 23 00 - Alternates)**
 - Alternate No. 1 – Replace existing windows
 - Alternate No. 2 – Recoat flat roof
 - Alternate No. 3 – Carpet, paint, base in first floor offices
 - Alternate No. 3A – Carpet, paint, base in Classroom 104
 - Alternate No. 4 – Install 2 new windows and window shades in exterior wall
 - Alternate No. 5 – Scrape and paint exterior wood trim
 - Alternate No. 6 – Replace door frames with new rate frames w/ rated glass
 - Alternate No. 7 – Wayfinding signage
 - Alternate No. 8 – Remodel and reconfigure first floor men's toilet room
 - Alternate No. 9 – Heat pump water heater

SCHEDULE OF PROPRIETARY ALTERNATES

- Alternate No. 10 – Door hardware
- Alternate No. 11 – Building automation controller and flow meters
- Alternate No. 12 – Communications horizontal cabling system
- Alternate No. 13 – Two-way communication system
- Alternate No. 14 – Fire Alarm System

12. **Minority/HUB Participation:** The goal for this project for minority/HUB participation is ten percent (10%). Please reference the bid package manual for minority forms and additional information regarding minority/HUB requirements. Contact Brad Milne at bmilne@muterconstruction.com or by phone at (919) 397-6971 (cell) or (919) 404-8330 (office) for inquiries regarding minority/HUB participation or other questions and requirements.

13. Thank you for coming. Questions?



| Project | | Project No. | Date |
|--|---------|-------------|---------------|
| UNCW – Alderman Hall and King Hall Renovations | | 620589 | 02/27/2023 |
| Submittal Title | Section | Reviewed By | Submittal No. |
| Modular Indoor AHU's - Early Equipment Package | 237313 | SJL | 237313-2.0 |

NOTES

IF THIS SUBMITTAL CONTAINS DEVIATIONS FROM THE CONTRACT DOCUMENTS, IT IS THE RESPONSIBILITY OF THE CONTRACTOR TO SPECIFICALLY INFORM THE ARCHITECT IN WRITING OF ALL SUCH DEVIATIONS; AND ALL SUCH DEVIATIONS SHALL BE INCORPORATED INTO THE CONTRACT DOCUMENTS BY THE ISSUANCE OF ONE OF THE FOLLOWING AUTHORIZING SUCH DEVIATIONS, PRIOR TO PROCEEDING WITH FABRICATION, MANUFACTURE AND/OR CONSTRUCTION:

- 1) Field Clarification (or other form used to convey minor changes to the Work);
- 2) Change Order; or
- 3) Construction Change Directive

This review and these comments are subject to the limitations indicated in the *General Conditions of the Contract for Construction*, and as follows:

- 1) Architect's review is for the limited purpose of checking for conformance with information given and the design concept expressed in the Contract Documents;
- 2) Architect's review is not conducted for the purpose of determining the accuracy and completeness of other details such as dimensions and quantities, or for substantiating instructions for installation or performance of equipment or systems, all of which shall remain the responsibility of the Contractor as required by the Contract Documents;
- 3) Architect's review shall not constitute approval of safety precautions or of any construction means, methods, techniques, sequences, or procedures; and
- 4) Architect's approval as noted of a specific item shall not indicate approval as noted of an assembly of which the item is a component.

Notations indicated on this submittal do not relieve the Contractor from complying with the requirements of the Contract Documents.

The Contractor shall verify that all necessary approvals as noted are obtained prior to proceeding with the fabrication, manufacturing, purchasing, and/or construction of any item, component, system, or assembly.

The Contractor's responsibilities include, but are not limited to, the following:

- 1) Correlation and confirmation of dimensions and quantities;
- 2) Means, methods, techniques, sequences, and procedures of construction;
- 3) Coordination of the Work of all trades; and
- 4) Performance of all Work in a safe and satisfactory manner

ACTION TAKEN:

- | | |
|---|---|
| <input checked="" type="checkbox"/> Approved as Noted | <input type="checkbox"/> Revise and Resubmit |
| <input type="checkbox"/> Rejected/Resubmit | <input type="checkbox"/> Not Reviewed / No Action Taken |
| <input type="checkbox"/> Not Submitted | <input type="checkbox"/> Color Selection Required |

REMARKS

Response (Approved as Noted) From: Seth Lehman (Moseley Architects)

Remarks:

AAN, no exceptions taken.

Notes regarding Submittal Review Action Taken:

Approved as Noted: The Contractor is advised that fabrication, manufacturing, purchasing, and/or construction may proceed based on this submittal provided that the work is in full compliance with the Contract Documents.

Revise and Resubmit: The Contractor is advised that fabrication, manufacturing, purchasing, and/or construction may **not** proceed based on this submittal. Provide revised submittal until such time **Approved as Noted** is received from the Architect.

Rejected / Resubmit: The Contractor is advised that fabrication, manufacturing, purchasing, and/or construction may **not** proceed based on this submittal. Provide new submittal which is in full compliance with the Contract Documents until such time **Approved as Noted** is received from the Architect.

Color Selection Required: The Contractor is advised that color selections for the entire project, or portion thereof, will be provided after receipt of **all** color charts / samples required for the Project.

Not Reviewed / No Action Taken: Contractor is advised that this submittal has not been reviewed.

Not Submitted: Contractor is advised that the Contract Documents require a submittal for this Work. Provide a submittal which is in full compliance with the Contract Documents until such time **Approved as Noted** is received from the Architect.

2202 - UNCW - Alderman Hall and King Hall Renovations



910-962-4169
601 South College Road
Wilmington, North Carolina 28403
United States

Muter Construction
111 East Vance Street
Zebulon, North Carolina 27597
United States
(919)404-8330

Title
Modular Indoor AHU's - Early Equipment Package

Submittal Manager
Declan Murphy

Spec Section
233713 - Diffusers, Registers, and Grilles

Type
Product Information

Number **Rev**
233713-1 0

Description
product Data: For each air-handling unit.

SUBMITTAL REVIEW STAMP

MUTER CONSTRUCTION REVIEWED
 REVIEWED WITH CORRECTIONS
 REJECTED

Submittal has been reviewed and is submitted in accordance with the Contract Documents. Contractor's review is for general conformance with Construction Documents. It is the subcontractor/material supplier's responsibility to ensure that this submittal and all products provided to the project are in complete conformance with the Construction Documents.

BY: Declan Murphy DATE: 2/27/23



Thermal Resource Solutions

7215 Ogden Business Lane, Suite 109
Wilmington, NC 28411
Phone: (910) 686-2487 Fax: (910) 686-2488

RE-SUBMITTAL DATA AIR HANDLING UNITS Drawings Dated 10/10/22

Date: February 24, 2023

Project: UNCW King Hall
Furnish Air Handling Units

Location: Wilmington, NC

Contractor: Muter Construction

Engineer: Moseley Architects

Manufacturer: VTS

NOTES:

1. See pages 2 thru 16 for new fan performances.
2. Coil connections to be verified prior to release.
3. Contractor to review section splits and advise if changes need to be made.
4. Contractor to coordinate quantities, horsepower & voltage with VFD Supplier.

CURRENT LEAD TIME IS 18 WEEKS

Sales Contact: John Blakeney
john.blakeney@trshvac.com

TRS PO#: 20-01512

THE FOLLOWING SUBMITTAL IS PROVIDED FOR APPROVAL



Technical data for item 1

Offer number 11C.3/LIVE.USA/DW/2023-23

Project name UNCW King Hall – TRS NC;
 John Blakeney

Type SingleSupply
Unit Type: Indoor
Project Tag AHU-01 Top Section
Size AVS030
Set AVS030-R-EV


Supply airflow 2 3300.00 CFM
External pressure 3.80 in wg

Insulation thickness 2.0 in
Insulation Polyurethane Foam

SFP Winter 1.03 HP/kcfm
SFP Summer 1.19 HP/kcfm

Weight of the set (+/- 10%)* 409 lb

Inspection Panels

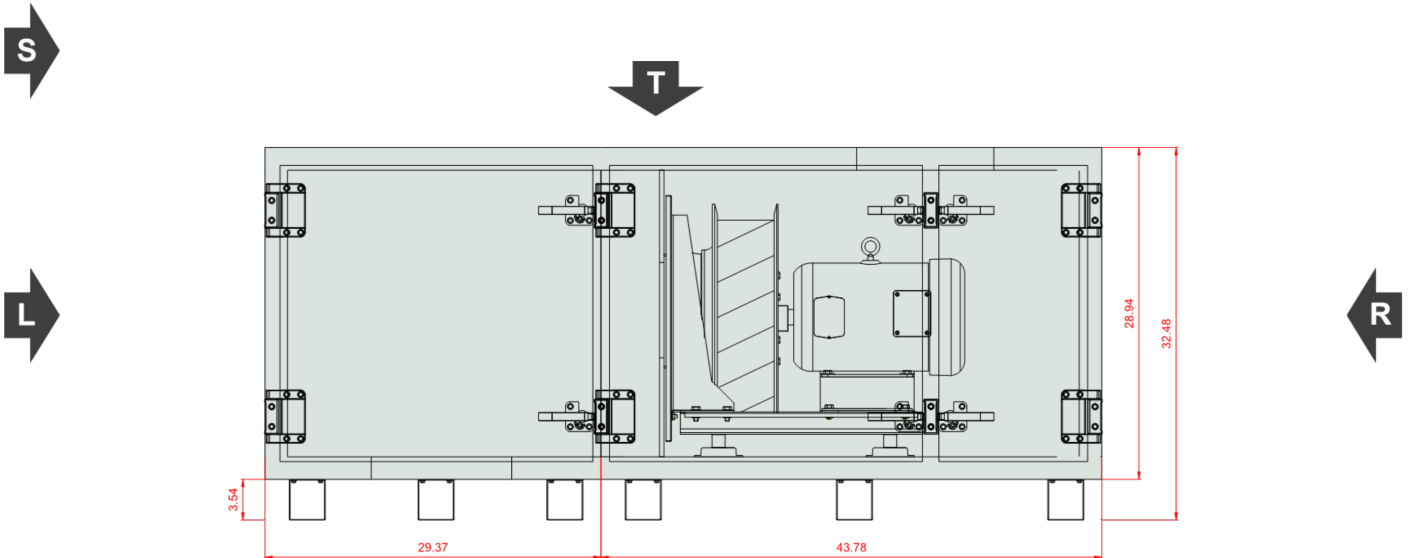


Comment 1:




Technical data for item 1

Offer number 11C.3/LIVE.USA/DW/2023-23


Front View (left)

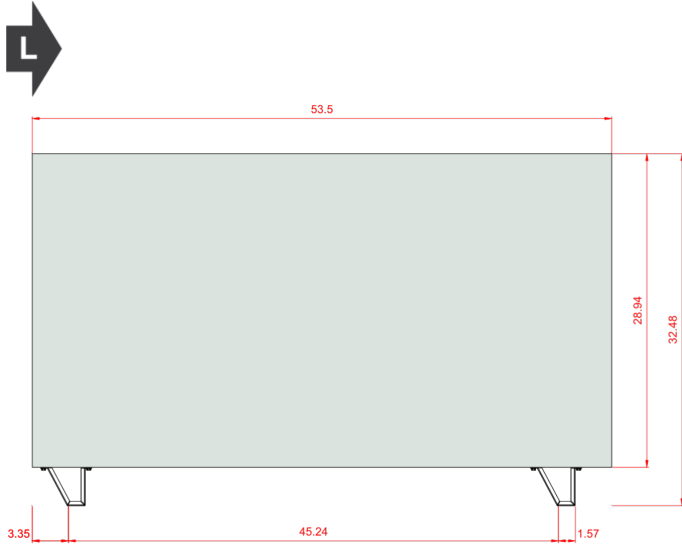

Front View (right)

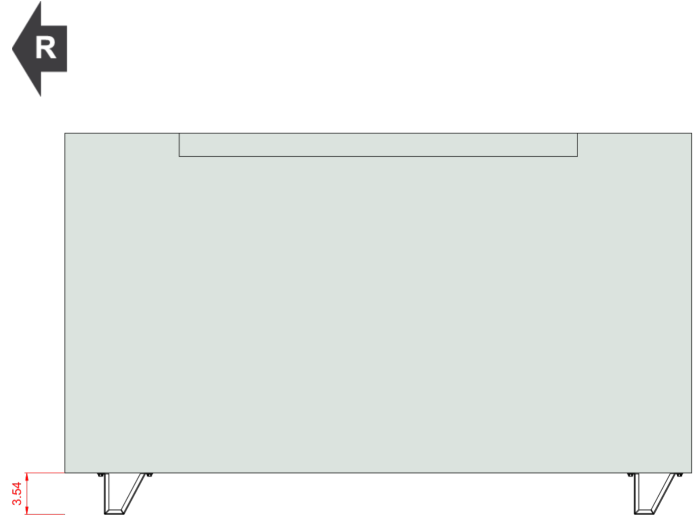

Top View

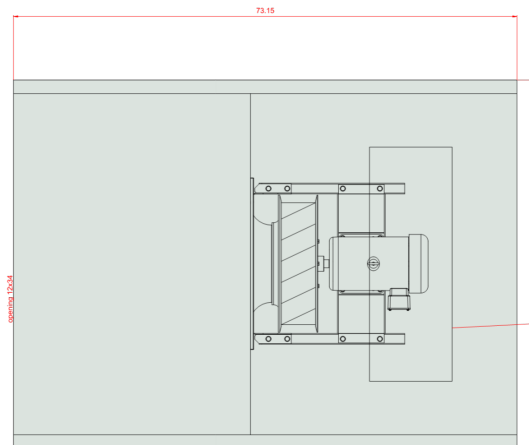

Sizes [in]

| | | | | |
|----------------------|-----------|----------|----------|---------|
| Air intake Supply DS | 34,3x12,3 | Lt 73.1 | Hid 25.0 | Wi 49.6 |
| Air outlet Supply US | 34x12 | LtA 73.1 | Hiu 25.0 | W 53.5 |
| | | | Hi 25.0 | |
| | | | H 32.5 | |
| | | | Hf 3.5 | |

Unit design

Concealed Skeleton Design – all framework is inside the unit, unexposed to ambient air and secure against thermal-bridging and condensation.

Casing mechanical strength (deflection): -10 in WC to +10 in WC: L=1/300 (model box EN 1886)





Technical data for item 1

Offer number 11C.3/LIVE.USA/DW/2023-23

Casing Air Leakage: -1.6 in WC: 0.009 CFM/ft²; +2.8 in WC: 0.026 CFM/ft²
 Casing Thermal Resistance: R = 13.1 Hr×ft²×F / BTU
 Thermal bridges coefficient Kb = 0.52 (Class TB3, EN 1886: 2007)

Temperature Conditions

| | Reference atmospheric pressure 760 mmHg | | | Winter outdoor reference temperature 16.3 °F | | |
|--------|---|---------|---------------------------|--|---------|---------------------------|
| | External air | | | Return air | | |
| | DBT | WBT | DA | DBT | WBT | DA |
| Summer | 94.3 °F | 80.6 °F | 0.0708 lb/ft ³ | 68.0 °F | 63.0 °F | 0.0746 lb/ft ³ |
| Winter | 16.3 °F | 13.5 °F | 0.0833 lb/ft ³ | 71.6 °F | 56.2 °F | 0.0744 lb/ft ³ |

Supply

Empty section

Type EMP.SEC AVS030 Standard

Winter operation

Air velocity 456 FPM

Summer operation

Air velocity 539 FPM

Resp_EmptySection_Info_Name

EmptySections

Plug-Fan Set

Fan Section PLUG_DD_450_5,00_4

Qty in section x 1

Air Standard Calculations made for real air density

Fan Set Designed for wet operating conditions

The fan system effects is taken into account in the fan performances.

Fan PLUG_VS_450_AF_Px 1

| | | | |
|-------------------------|-------------|-------------------------------------|-------------|
| Total Static Pressure | 3.95 in wg | Impeller efficiency: Static / Total | 65 %/68 % |
| Dynamic pressure | 0.20 in wg | Shaft power | 3.40 HP x 1 |
| External pressure | 3.80 in wg | Working revolutions | 2185 rpm |
| Total Pressure | 4.15 in wg | | |
| Winter operation | | Summer operation | |
| Air Volume Flow | 2947.48 CFM | Air Volume Flow | 3481.30 CFM |

Fan Additional Info

Fan Type: Direct Driven Plenum Fan

Fan Wheel Diameter: 450 [mm]

Vibro-Acoustics Insulation: Rubber-in-Shear Floor Mounted Isolator

Motor AC_Premium Eff._F_184T_TEFC_4p_5_60x 1

460V

60Hz





Technical data for item 1

Offer number 11C.3/LIVE.USA/DW/2023-23

| | | | |
|-------------------------------------|------------------|--------------------------------------|-------------|
| FLA | 6.7 A | MCA | 8.4 A |
| MCB | 15.0 A | Maximum Overcurrent Protection (MOP) | 15.1 A |
| Short-Circuit Current Rating (SCCR) | 6.0 kA | | |
| Motor enclosure | TEFC | Rated Current | 6.7 A x 1 |
| IEC Size | 184T | Rated revolutions | 1750 rpm |
| Operational Voltage | 460 V/3 ph | Rated Power | 5.00 HP x 1 |
| Name plate RPM | 460 V/3 ph/60 Hz | Motor Version | V-Series |

Electric Motor Additional Info

Supplier: Baldor
 Motor poles: 4

VFD

| | | | |
|--------------------|----------|---------------------------|-----------------------|
| | _AC | | _AC |
| VFD | Required | Connecting Point | CP Provided by others |
| VFD Qty in section | 1 | VFD Voltage Supply | 460/3/60 V/ph/Hz |
| VFD Settings | 75 Hz | VFD Rated Power | 5.00 HP x 1 |
| VFD in selection | Excluded | VFD HMI | No |
| | | VFD 1PH ModBus Comm Board | No |

Winter operation

| | |
|--------------|---------------|
| Air Pressure | 760 mmHg |
| Air Density | 0.0833 lb/ft³ |

Summer operation

| | |
|--------------|---------------|
| Air Pressure | 760 mmHg |
| Air Density | 0.0708 lb/ft³ |

Acoustic data

| Acoustic power level [dB] | Frequency | 63 [Hz] | 125 [Hz] | 250 [Hz] | 500 [Hz] | 1000 [Hz] | 2000 [Hz] | 4000 [Hz] | 8000 [Hz] | Lw [dB] |
|---------------------------|-----------|---------|----------|----------|----------|-----------|-----------|-----------|-----------|---------|
| Inlet | [dB] | 74.3 | 79.2 | 85.7 | 86.3 | 83.1 | 79.9 | 75.1 | 71.2 | 91.0 |
| Outlet | [dB] | 76.3 | 81.2 | 87.7 | 88.3 | 85.1 | 81.9 | 77.1 | 73.2 | 93.0 |
| Environment | [dB] | 54.5 | 69.7 | 74.3 | 74.3 | 71.4 | 68.4 | 47.6 | 34.7 | 79.3 |

| Acoustic pressure level at 1 meter distance [dB] | Frequency | 63 [Hz] | 125 [Hz] | 250 [Hz] | 500 [Hz] | 1000 [Hz] | 2000 [Hz] | 4000 [Hz] | 8000 [Hz] | Lp [dB] |
|--|-----------|---------|----------|----------|----------|-----------|-----------|-----------|-----------|---------|
| | [dB] | 41.2 | 62.7 | 67.3 | 67.3 | 64.4 | 61.4 | 40.6 | 27.7 | 72.3 |

AHU Discharge and intake Opening Sizes & Unit Accessories

Supply

Controls Selection Mode: No controls

| AHU Discharge and Intake Opening Sizes | Supply |
|--|----------------|
| Air Inlet | Down 34,3x12,3 |
| Air Outlet | Top 34x12 |

Unit Another Accessories

| | | |
|-----------------------|-----------|---------------------------|
| Internal Marine Light | INT.LHT_1 | 2 Accessories Quantity |
| Hinged Access | HNG_1 | 1 Accessories Quantity |

Control application



Technical data for item 1

Offer number 11C.3/LIVE.USA/DW/2023-23

Functional Code


AS|0|0|0|0|0|0|0|0|6|0|0|0|0|0|0|1

Section splits

| Transport Sections | Mass [lb] | LENGTH [in] | WIDTH [in] | HEIGHT [in] |
|--------------------|-----------|-------------|------------|-------------|
| 1 | 110 | 29.4 | 53.5 | 32.5 |
| 2 | 280 | 43.8 | 53.5 | 32.5 |

Transport Sections Dims

Resp_TransportSections_SectionsLengthMODRangeChanged

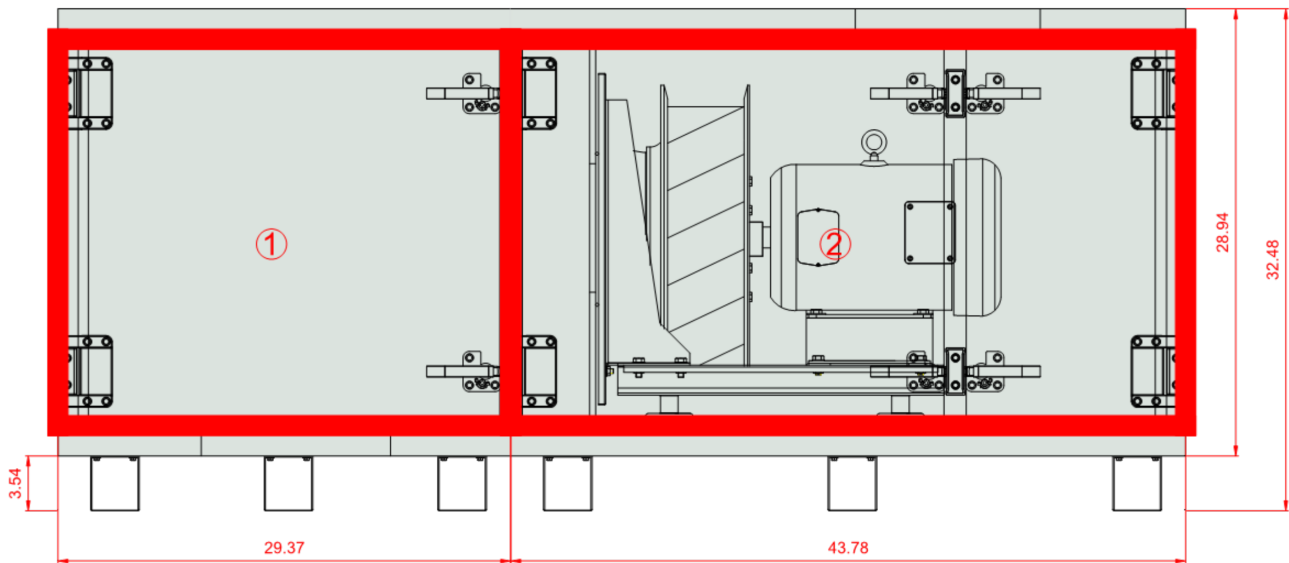

VTS America Inc.
 3535 Gravel Springs Rd. Extension, Suite 201; Buford, GA
 30519; United States of America
 +1 470 809 6811; +1 470 809 6815
 darrin.winecoff@vtsgroup.com



Technical data for item 3

Offer number 11C.3/LIVE.USA/DW/2023-23

Project name UNCW King Hall – TRS NC;
 John Blakeney


Type SingleSupply
Unit Type: Indoor
Project Tag AHU-02 Top Section
Size AVS055
Set AVS055-L-EV

Supply airflow 2 5500.00 CFM
External pressure 3.92 in wg

Insulation thickness 2.0 in
Insulation Polyurethane Foam
Weight of the set (+/- 10%)* 668 lb

SFP Winter 0.92 HP/kcfm
SFP Summer 1.08 HP/kcfm


Inspection Panels

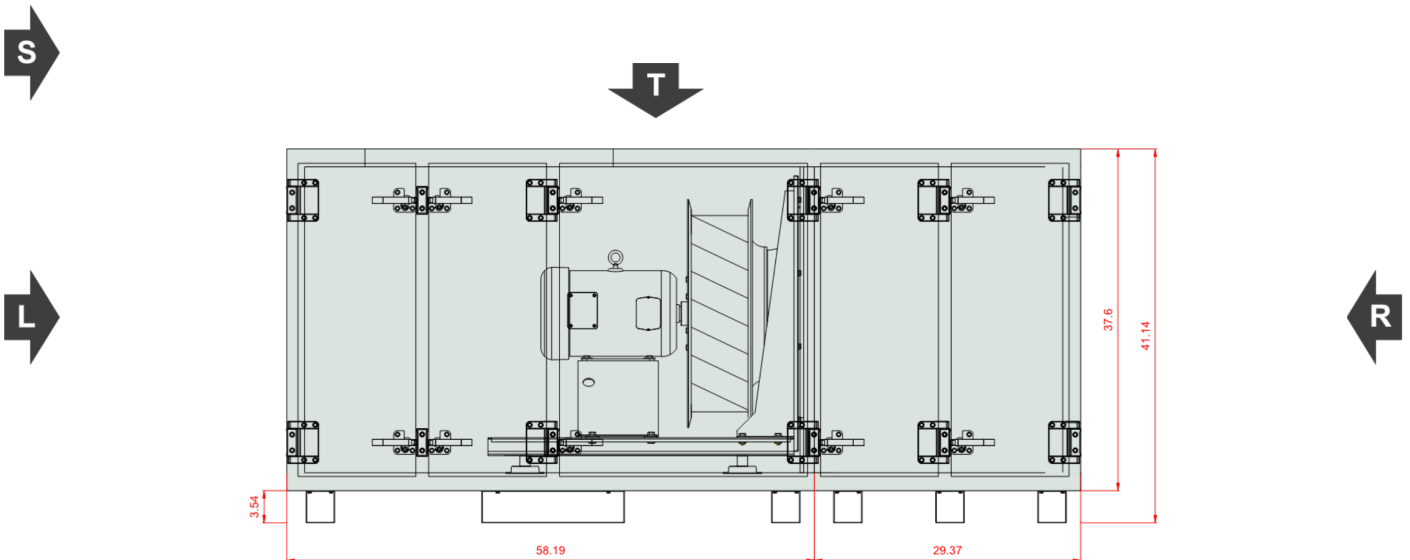


Comment 1:




Front View (left)

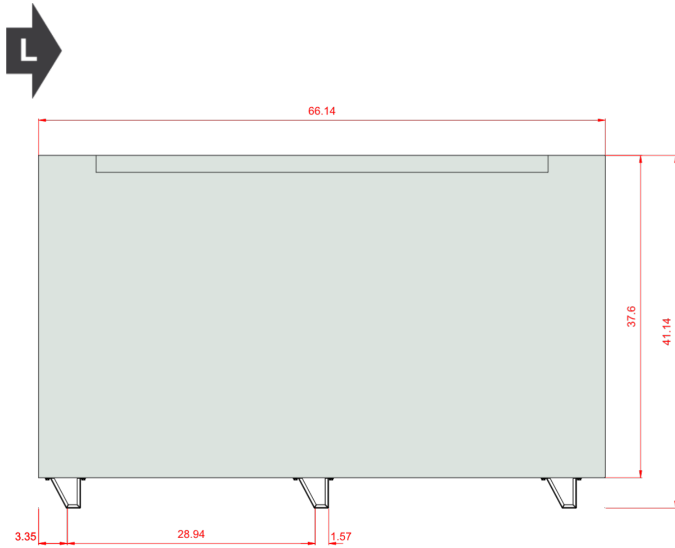

Front View (right)

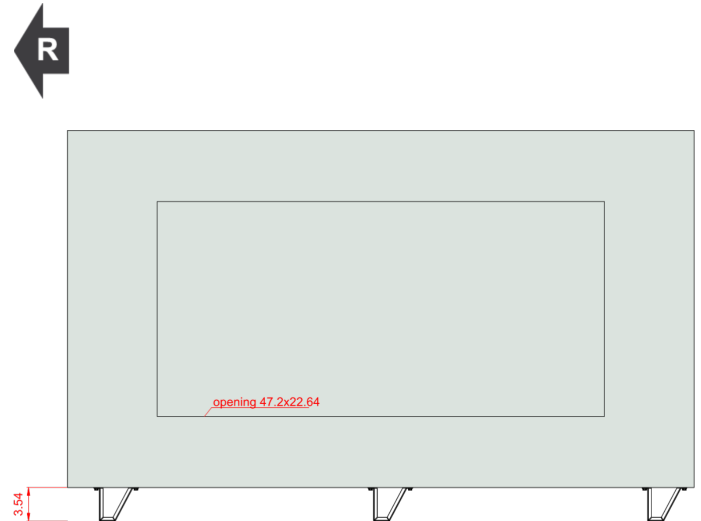

Top View

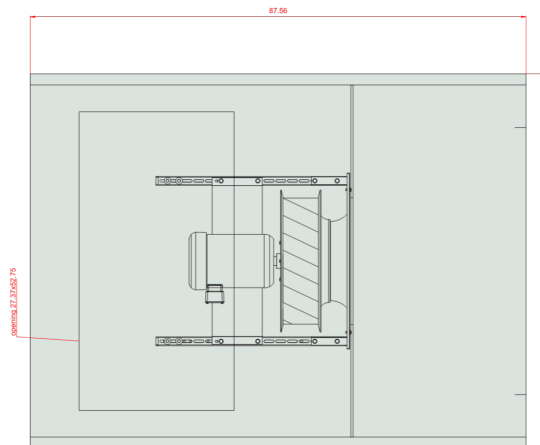

Sizes [in]

| | | | | |
|----------------------|-----------|----------|----------|---------|
| Air intake Supply FS | 47,2x22,6 | Lt 87.6 | Hid 33.7 | Wi 62.2 |
| Air outlet Supply US | 52,8x27,4 | LtA 87.6 | Hiu 33.7 | W 66.1 |
| | | | Hi 33.7 | |
| | | | H 41.1 | |
| | | | Hf 3.5 | |

Unit design

Concealed Skeleton Design – all framework is inside the unit, unexposed to ambient air and secure against thermal-bridging and condensation.

Casing mechanical strength (deflection): -10 in WC to +10 in WC: L=1/300 (model box EN 1886)



Technical data for item 3

Offer number 11C.3/LIVE.USA/DW/2023-23

Casing Air Leakage: -1.6 in WC: 0.009 CFM/ft²; +2.8 in WC: 0.026 CFM/ft²
 Casing Thermal Resistance: R = 13.1 Hr×ft²×F / BTU
 Thermal bridges coefficient Kb = 0.52 (Class TB3, EN 1886: 2007)

Temperature Conditions

| | Reference atmospheric pressure 760 mmHg | | | Winter outdoor reference temperature 16.3 °F | | |
|--------|---|---------|---------------------------|--|---------|---------------------------|
| | External air | | | Return air | | |
| | DBT | WBT | DA | DBT | WBT | DA |
| Summer | 94.3 °F | 80.6 °F | 0.0708 lb/ft ³ | 68.0 °F | 63.0 °F | 0.0746 lb/ft ³ |
| Winter | 16.3 °F | 13.5 °F | 0.0833 lb/ft ³ | 71.6 °F | 56.2 °F | 0.0744 lb/ft ³ |

Supply

Empty section

Type EMP.SEC AVS055 Medium

Winter operation

Air velocity 476 FPM

Summer operation

Air velocity 562 FPM

Resp_EmptySection_Info_Name

EmptySections

Plug-Fan Set

Fan Section PLUG_DD_560_7,50_4

Qty in section x 1

Air Standard Calculations made for real air density

Fan Set Designed for wet operating conditions

The fan system effects is taken into account in the fan performances.

Fan PLUG_VS_560_AF_Px 1

| | | | |
|-------------------------|-------------|-------------------------------------|-------------|
| Total Static Pressure | 3.98 in wg | Impeller efficiency: Static / Total | 71 %/75 % |
| Dynamic pressure | 0.22 in wg | Shaft power | 5.23 HP x 1 |
| External pressure | 3.92 in wg | Working revolutions | 1713 rpm |
| Total Pressure | 4.20 in wg | | |
| Winter operation | | Summer operation | |
| Air Volume Flow | 4912.47 CFM | Air Volume Flow | 5802.17 CFM |

Fan Additional Info

Fan Type: Direct Driven Plenum Fan

Fan Wheel Diameter: 560 [mm]

Vibro-Acoustics Insulation: Rubber-in-Shear Floor Mounted Isolator

Motor AC_Premium Eff._F_213T_TEFC_4p_7.5_60x
1

460V

60Hz





Technical data for item 3

Offer number 11C.3/LIVE.USA/DW/2023-23

| | | | |
|-------------------------------------|------------------|--------------------------------------|-------------|
| FLA | 9.5 A | MCA | 11.9 A |
| MCB | 15.0 A | Maximum Overcurrent Protection (MOP) | 21.4 A |
| Short-Circuit Current Rating (SCCR) | 6.0 kA | | |
| Motor enclosure | TEFC | Rated Current | 9.5 A x 1 |
| IEC Size | 213T | Rated revolutions | 1770 rpm |
| Operational Voltage | 460 V/3 ph | Rated Power | 7.50 HP x 1 |
| Name plate RPM | 460 V/3 ph/60 Hz | Motor Version | V-Series |

Electric Motor Additional Info

Supplier: Baldor
 Motor poles: 4

VFD

| | _AC | | _AC |
|--------------------|----------|---------------------------|-----------------------|
| VFD | Required | Connecting Point | CP Provided by others |
| VFD Qty in section | 1 | VFD Voltage Supply | 460/3/60 V/ph/Hz |
| VFD Settings | 58 Hz | VFD Rated Power | 7.50 HP x 1 |
| VFD in selection | Excluded | VFD HMI | No |
| | | VFD 1PH ModBus Comm Board | No |

Winter operation

| | |
|--------------|---------------|
| Air Pressure | 760 mmHg |
| Air Density | 0.0833 lb/ft³ |

Summer operation

| | |
|--------------|---------------|
| Air Pressure | 760 mmHg |
| Air Density | 0.0708 lb/ft³ |

Acoustic data

| Acoustic power level [dB] | Frequency | 63 [Hz] | 125 [Hz] | 250 [Hz] | 500 [Hz] | 1000 [Hz] | 2000 [Hz] | 4000 [Hz] | 8000 [Hz] | Lw [dB] |
|---------------------------|-----------|---------|----------|----------|----------|-----------|-----------|-----------|-----------|---------|
| Inlet | [dB] | 74.4 | 79.3 | 85.8 | 86.4 | 83.2 | 80.0 | 75.2 | 71.3 | 91.1 |
| Outlet | [dB] | 76.4 | 81.3 | 87.8 | 88.4 | 85.2 | 82.0 | 77.2 | 73.3 | 93.1 |
| Environment | [dB] | 54.6 | 69.8 | 74.4 | 74.4 | 71.5 | 68.5 | 47.7 | 34.8 | 79.4 |

| Acoustic pressure level at 1 meter distance [dB] | Frequency | 63 [Hz] | 125 [Hz] | 250 [Hz] | 500 [Hz] | 1000 [Hz] | 2000 [Hz] | 4000 [Hz] | 8000 [Hz] | Lp [dB] |
|--|-----------|---------|----------|----------|----------|-----------|-----------|-----------|-----------|---------|
| | [dB] | 41.3 | 62.8 | 67.4 | 67.4 | 64.5 | 61.5 | 40.7 | 27.8 | 72.4 |

AHU Discharge and intake Opening Sizes & Unit Accessories

Supply

Controls Selection Mode: No controls

| | |
|---|-------------------------|
| AHU Discharge and Intake Opening Sizes | Supply |
| Air Inlet | Front (Small) 47,2x22,6 |
| Air Outlet | Top 52,8x27,4 |

Unit Another Accessories

| | | |
|-----------------------|-----------|---------------------------|
| Internal Marine Light | INT.LHT_1 | 2 Accessories Quantity |
| Hinged Access | HNG_1 | 1 Accessories Quantity |

Control application



Technical data for item 3

Offer number 11C.3/LIVE.USA/DW/2023-23

Functional Code


AS|0|0|0|0|0|0|0|0|6|0|0|0|0|0|0|1

Section splits

| Transport Sections | Mass [lb] | LENGTH [in] | WIDTH [in] | HEIGHT [in] |
|--------------------|-----------|-------------|------------|-------------|
| 1 | 165 | 29.4 | 66.1 | 41.1 |
| 2 | 481 | 58.2 | 66.1 | 41.1 |

Transport Sections Dims

Resp_TransportSections_SectionsLengthMODRangeChanged

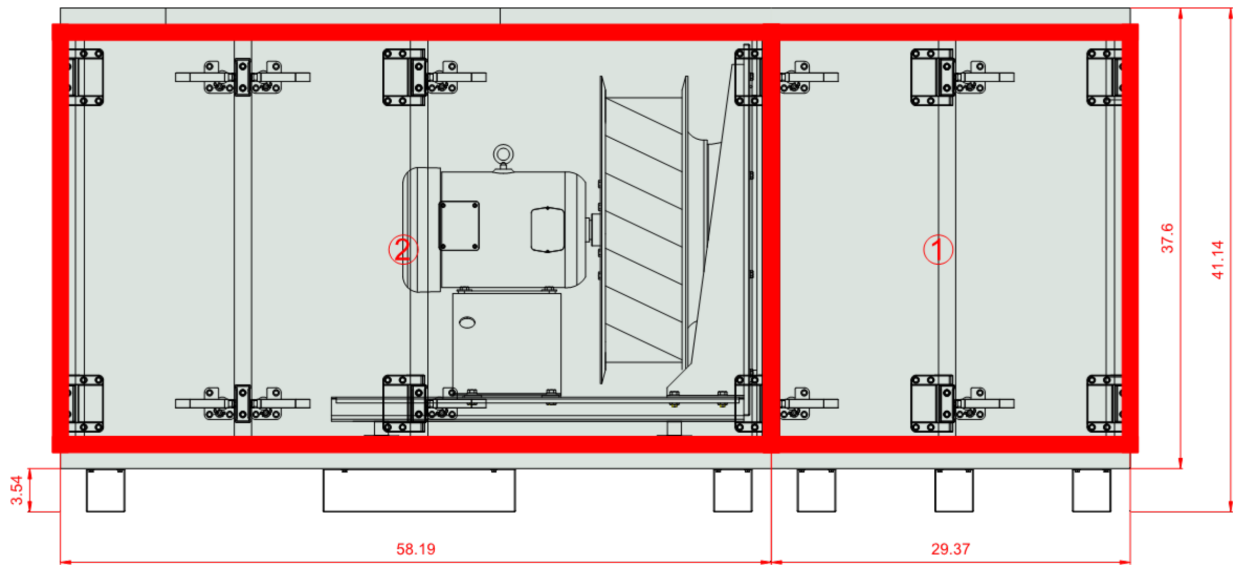

VTS America Inc.
 3535 Gravel Springs Rd. Extension, Suite 201; Buford, GA
 30519; United States of America
 +1 470 809 6811; +1 470 809 6815
 darrin.winecoff@vtsgroup.com



Technical data for item 5

Offer number 11C.3/LIVE.USA/DW/2023-23

Project name UNCW King Hall – TRS NC;
 John Blakeney


Type SingleSupply
Unit Type: Indoor
Project Tag AHU-03 Top Section
Size AVS100
Set AVS100-R-EV

Supply airflow 2 10500.00 CFM
External pressure 3.99 in wg

Insulation thickness 2.0 in
Insulation Polyurethane Foam
Weight of the set (+/- 10%)* 1092 lb

SFP Winter 0.95 HP/kcfm
SFP Summer 1.11 HP/kcfm

Inspection Panels

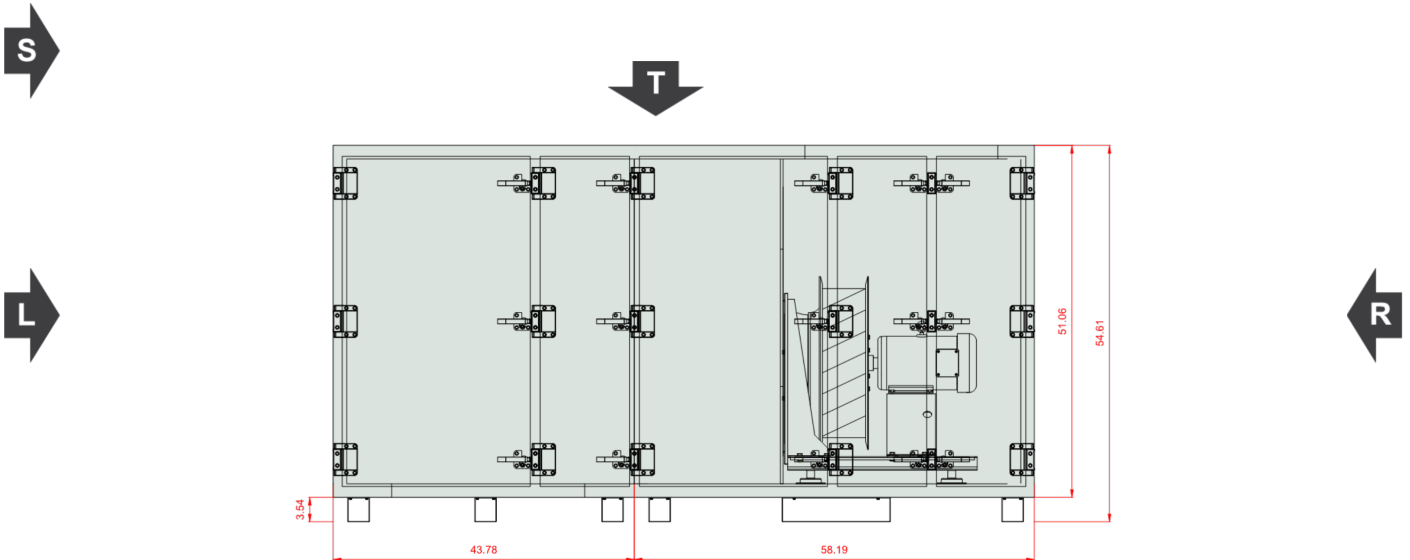


Comment 1:




Technical data for item 5

Offer number 11C.3/LIVE.USA/DW/2023-23


Front View (left)

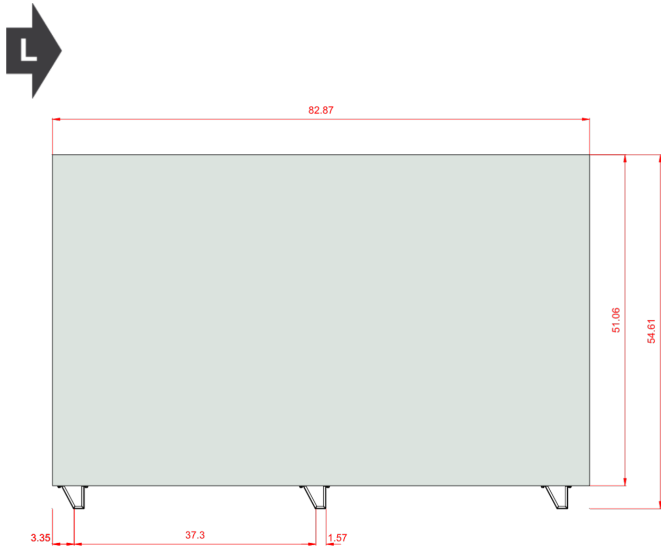

Front View (right)

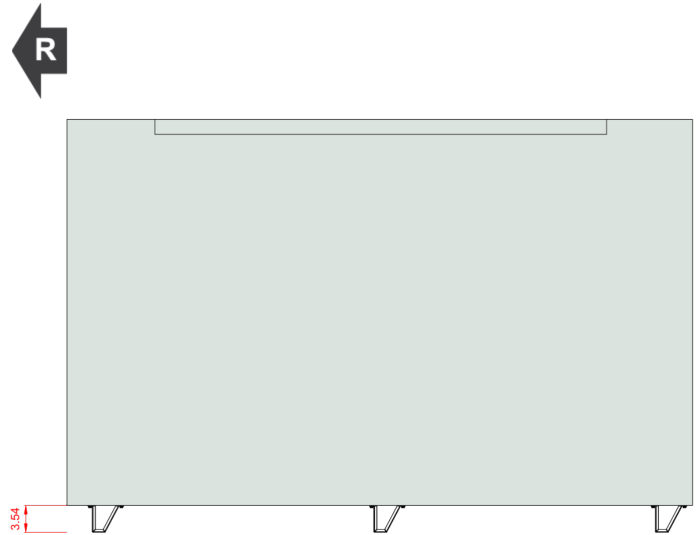

Top View

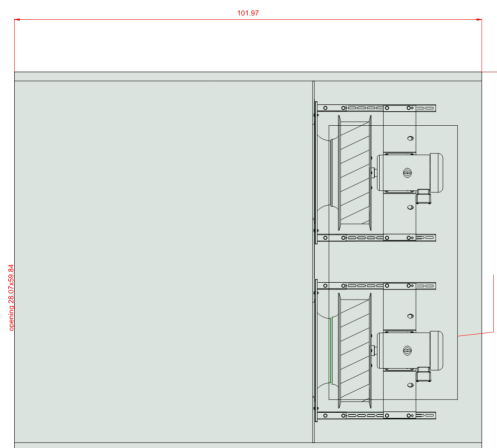

Sizes [in]

| | | | | |
|----------------------|-----------|-----------|----------|---------|
| Air intake Supply DS | 59,8x28,1 | Lt 102.0 | Hid 47.1 | Wi 78.9 |
| Air outlet Supply US | 59,8x28,1 | LtA 102.0 | Hiu 47.1 | W 82.9 |
| | | | Hi 47.1 | |
| | | | H 54.6 | |
| | | | Hf 3.5 | |

Unit design

Concealed Skeleton Design – all framework is inside the unit, unexposed to ambient air and secure against thermal-bridging and condensation.

Casing mechanical strength (deflection): -10 in WC to +10 in WC: L=1/300 (model box EN 1886)





Technical data for item 5

Offer number 11C.3/LIVE.USA/DW/2023-23

Casing Air Leakage: -1.6 in WC: 0.009 CFM/ft²; +2.8 in WC: 0.026 CFM/ft²
 Casing Thermal Resistance: R = 13.1 Hr×ft²×F / BTU
 Thermal bridges coefficient Kb = 0.52 (Class TB3, EN 1886: 2007)

Temperature Conditions

| | Reference atmospheric pressure 760 mmHg | | | Winter outdoor reference temperature 16.3 °F | | |
|--------|---|---------|---------------------------|--|---------|---------------------------|
| | External air | | | Return air | | |
| | DBT | WBT | DA | DBT | WBT | DA |
| Summer | 94.3 °F | 80.6 °F | 0.0708 lb/ft ³ | 68.0 °F | 63.0 °F | 0.0746 lb/ft ³ |
| Winter | 16.3 °F | 13.5 °F | 0.0833 lb/ft ³ | 71.6 °F | 56.2 °F | 0.0744 lb/ft ³ |

Supply

Empty section

Type EMP.SEC AVS100 Long

Winter operation

Air velocity 438 FPM

Summer operation

Air velocity 517 FPM

Resp_EmptySection_Info_Name

EmptySections

Plug-Fan Set

Fan Section PLUG_DD_560_7,50_4

Qty in section x 2

Air Standard Calculations made for real air density

Fan Set Designed for wet operating conditions

The fan system effects is taken into account in the fan performances.

Fan PLUG_VS_560_AF_Px 2

| | | | |
|-------------------------|-------------|-------------------------------------|--------------|
| Total Static Pressure | 4.09 in wg | Impeller efficiency: Static / Total | 71 %/75 % |
| Dynamic pressure | 0.20 in wg | Shaft power | 5.13 HP x 2 |
| External pressure | 3.99 in wg | Working revolutions | 1703 rpm |
| Total Pressure | 4.29 in wg | | |
| Winter operation | | Summer operation | |
| Air Volume Flow | 9378.35 CFM | Air Volume Flow | 11076.87 CFM |

Fan Additional Info

Fan Type: Direct Driven Plenum Fan

Fan Wheel Diameter: 560 [mm]

Vibro-Acoustics Insulation: Rubber-in-Shear Floor Mounted Isolator

Motor AC_Premium Eff._F_213T_TEFC_4p_7.5_60x
2

460V

60Hz





Technical data for item 5

Offer number 11C.3/LIVE.USA/DW/2023-23

| | | | |
|-------------------------------------|------------------|--------------------------------------|-------------|
| FLA | 19.0 A | MCA | 23.8 A |
| MCB | 30.0 A | Maximum Overcurrent Protection (MOP) | 30.9 A |
| Short-Circuit Current Rating (SCCR) | 6.0 kA | | |
| Motor enclosure | TEFC | Rated Current | 9.5 A x 2 |
| IEC Size | 213T | Rated revolutions | 1770 rpm |
| Operational Voltage | 460 V/3 ph | Rated Power | 7.50 HP x 2 |
| Name plate RPM | 460 V/3 ph/60 Hz | Motor Version | V-Series |

Electric Motor Additional Info

Supplier: Baldor
 Motor poles: 4

VFD

| | | | |
|--------------------|----------|---------------------------|-----------------------|
| | _AC | | _AC |
| VFD | Required | Connecting Point | CP Provided by others |
| VFD Qty in section | 2 | VFD Voltage Supply | 460/3/60 V/ph/Hz |
| VFD Settings | 58 Hz | VFD Rated Power | 7.50 HP x 2 |
| VFD in selection | Excluded | VFD HMI | No |
| | | VFD 1PH ModBus Comm Board | No |

Winter operation

| | |
|--------------|---------------|
| Air Pressure | 760 mmHg |
| Air Density | 0.0833 lb/ft³ |

Summer operation

| | |
|--------------|---------------|
| Air Pressure | 760 mmHg |
| Air Density | 0.0708 lb/ft³ |

Acoustic data

| Acoustic power level [dB] | Frequency | 63 [Hz] | 125 [Hz] | 250 [Hz] | 500 [Hz] | 1000 [Hz] | 2000 [Hz] | 4000 [Hz] | 8000 [Hz] | Lw [dB] |
|---------------------------|-----------|---------|----------|----------|----------|-----------|-----------|-----------|-----------|---------|
| Inlet | [dB] | 74.4 | 79.3 | 85.8 | 86.4 | 83.2 | 80.0 | 75.2 | 71.3 | 91.1 |
| Outlet | [dB] | 76.4 | 81.3 | 87.8 | 88.4 | 85.2 | 82.0 | 77.2 | 73.3 | 93.1 |
| Environment | [dB] | 54.6 | 69.8 | 74.4 | 74.4 | 71.5 | 68.5 | 47.7 | 34.8 | 79.4 |

| Acoustic pressure level at 1 meter distance [dB] | Frequency | 63 [Hz] | 125 [Hz] | 250 [Hz] | 500 [Hz] | 1000 [Hz] | 2000 [Hz] | 4000 [Hz] | 8000 [Hz] | Lp [dB] |
|--|-----------|---------|----------|----------|----------|-----------|-----------|-----------|-----------|---------|
| | [dB] | 41.3 | 62.8 | 67.4 | 67.4 | 64.5 | 61.5 | 40.7 | 27.8 | 72.4 |

AHU Discharge and intake Opening Sizes & Unit Accessories

Supply

Controls Selection Mode: No controls

| AHU Discharge and Intake Opening Sizes | Supply |
|--|----------------|
| Air Inlet | Down 59,8x28,1 |
| Air Outlet | Top 59,8x28,1 |

Unit Another Accessories

| | | |
|-----------------------|-----------|---------------------------|
| Internal Marine Light | INT.LHT_1 | 2 Accessories Quantity |
| Hinged Access | HNG_1 | 1 Accessories Quantity |

Control application



Technical data for item 5

Offer number 11C.3/LIVE.USA/DW/2023-23

Functional Code


AS|0|0|0|0|0|0|0|0|6|0|0|0|0|0|0|0|1

Section splits

| Transport Sections | Mass [lb] | LENGTH [in] | WIDTH [in] | HEIGHT [in] |
|--------------------|-----------|-------------|------------|-------------|
| 1 | 282 | 43.8 | 82.9 | 54.6 |
| 2 | 793 | 58.2 | 82.9 | 54.6 |

Transport Sections Dims

Resp_TransportSections_SectionsLengthMODRangeChanged

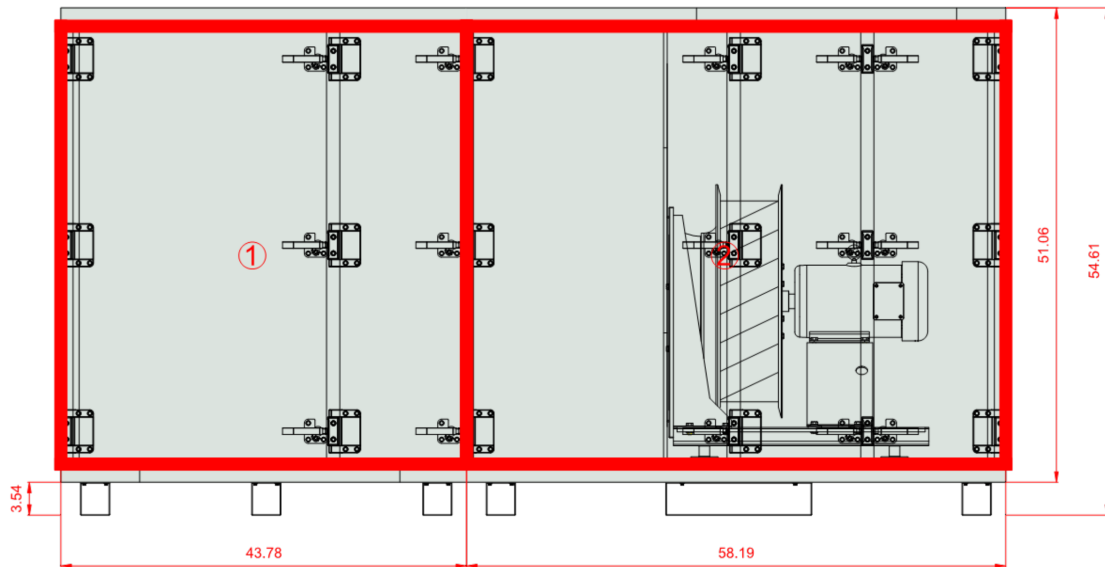

RESPONSES TO SUBMITTAL COMMENTS DATED 1/25/23:

1. Cooling coil cabinet construction is specified to be stainless steel. Provide stainless steel casing or provide corrosion resistant coating. Provide additional details for coating for review.

The factory will apply “Blygold CasingGuard” in the cooling coil sections only. See attached data sheet.

2. Provide 5 hp motor for AHU-01 supply fan. Static is low as submitted. Component pressure drops are 0.58,0.62, 0.09, 0.76 for filters and coils, which results with a 3.8” total static pressure (assuming 50% dirty filters). No pressure drop data is provided for outside air or return air dampers, these should be included in the internal static pressure calculation. The 1.75” ESP scheduled is all losses outside of the unit.

Unit was updated for 5HP motor, 3.8” TSP, and float ESP.

3. Provide 7.5 hp motor for AHU-02 supply fan. Static is low as submitted. Component pressure drops are 0.59,0.64, 0.16, 0.78 for filters and coils, which results with a 3.92” total static pressure (assuming 50% dirty filters). No pressure drop data is provided for outside air or return air dampers, these should be included in the internal static pressure calculation. The 1.75” ESP scheduled is all losses outside of the unit.

Unit was updated for 7.5HP, 3.92” TSP and float ESP.

4. Provide 7.5 hp motors for AHU-03 supply fans. Static is low as submitted. Component pressure drops are 0.59, 0.64, 0.09, 0.92 for filters and coils, which results with a 3.99” total static pressure (assuming 50% dirty filters). No pressure drop data is provided for outside air or return air dampers, these should be included in the internal static pressure calculation. The 1.75” ESP scheduled is all losses outside of the unit.

Unit was updated for 7.5HP, 3.99” TSP and float ESP.

5. Revise acoustic calculations at higher fan speeds and horsepower for all units.

Revised accordingly.

6. 460 and 480 V can be used interchangeably. The motor voltages are acceptable.

7. Condensate traps shall be Trent technologies traps as indicated on drawings and specifications.

Per the spec, contractor shall provide kit and field install condensate drain in accordance with Trent Technologies installation instructions. Units now have 8” base rail to accommodate the Trent Trap.

8. Motors sections indicates that all motors 7.5 hp and greater use shaft grounding rings. Provide shaft grounding rings for all motors.

Shaft grounding rings provided on all motors.

9. Provide the cooling coil water flow velocity and/or Reynolds number at design water flow.

AHU-01

HWC 0.38 FPS
CHWC 1.36 FPS

AHU-02

HWC 1.05 FPS
CHWC 3.51 FPS

AHU-03

HWC 2.23 FPS
CHWC 7.69 FPS

10. Round view windows are indicated as an accessory. Please confirm these are on the cooling coil access door and have a UV protective coating.

Viewing windows will be provided in the sections with UV lamps and include a protective coating.

11. Wire each fan individually for AHU-3. Each fan will be powered by its own independent VFD.

All VTS fans are wired separately to a junction box. VFD's by others.

12. UVC lights shall have door interlock switch as scheduled to disable UVC light upon opening the AHU access door.

This is standard on units with UV.

13. AHU-3 access doors and coil connections are reversed. Access doors and coils should be on the opposite side of the unit.


This has been updated.

14. No wiring diagram included for marine lights. Confirm these are factory wired and provided with unit mounted switch.


Yes, these are factory wired and include a mounted switch.

15. AHU's designed with 6" base rail. 3.5" base rail submitted. Confirm that condensate drain discharge height is high enough for use with Trent Technologies condensate trap. Drain discharge height not indicate in unit drawings.

Bottom units now provided with 8" rails to accommodate Trent Trap.

| | | | |
|--|---|---|----------------------------|
| Project Name: UNCW King Hall – TRS NC; John Blakeney | VTS America Inc. 3535 Gravel Springs Rd. Extension, Suite 201, Buford, GA 30519 |  | |
| Offer Code 11B.3/LIVE.USA/DW/2023-23 | Prepared for: THERMAL RESOURCE SALES - WILMINGTON 7215 OGDEN BUSINESS LANE, WILMINGTON, NC, 28411 | | |
| Prepared by: Darrin Winecoff - VTS America Inc. | | Page: 1 of 73 | Date: February 09, 2023 |




| | | |
|--|--|---|
| Project Name: UNCW King Hall – TRS NC; John Blakeney | VTS America Inc. 3535 Gravel Springs Rd. Extension, Suite 201, Buford, GA 30519 |  |
| Offer Code 11B.3/LIVE.USA/DW/2023-23 | Prepared for: THERMAL RESOURCE SALES - WILMINGTON 7215 OGDEN BUSINESS LANE, WILMINGTON,NC, 28411 | |
| Prepared by: Darrin Winecoff - VTS America Inc. | Page: 2 of 73 | Date: February 09, 2023 |

Content


| | | |
|---------|--|----|
| 1 | The AVS Standard range Air Handling Units General Specifications | 4 |
| 1.1 | General | 4 |
| 1.2 | Components and specifications | 4 |
| 1.2.1 | Unit construction - Casing | 4 |
| 1.2.2 | Fans sets | 4 |
| 1.2.2.1 | General Description | 4 |
| 1.2.2.2 | Fan impeller mechanical and thermal specifications: | 4 |
| 1.2.2.3 | Motors | 5 |
| 1.2.2.4 | Fan Power Supply Point | 5 |
| 1.2.3 | Filters | 5 |
| 1.2.4 | Hydronic Heating Coils | 5 |
| 1.2.5 | Hydronic Cooling Coils | 5 |
| 1.2.6 | Air Dampers | 6 |
| 2 | Selections for the UNCW King Hall – TRS NC; John Blakeney | 7 |
| 2.1 | AHU-01 Top Section, Supply | 8 |
| 2.1.1 | General AHU Data | 8 |
| 2.1.2 | AHU-01 Top Section, Supply - Dimensions, media connection points | 8 |
| 2.1.3 | AHU-01 Top Section, Supply - Drawings – AHU Sections Shipping Details , Supply | 14 |
| 2.1.4 | AHU-01 Top Section, Supply - Performance Data | 15 |
| 2.1.5 | AHU-01 Top Section, Supply - Fan Performance Data , Supply | 16 |
| 2.1.7 | Submittal_Chapter2_1_12_Title_ElectricHeaterPowerConnectionDiagram | 0 |
| 2.2 | AHU-01 Bottom Section, Supply | 19 |
| 2.2.1 | General AHU Data | 19 |
| 2.2.2 | AHU-01 Bottom Section, Supply - Dimensions, media connection points | 20 |
| 2.2.3 | AHU-01 Bottom Section, Supply - Performance Data | 26 |
| 2.2.4 | Moist Air Processes | 29 |
| 2.2.5 | Submittal_Chapter2_1_12_Title_ElectricHeaterPowerConnectionDiagram | 0 |
| 2.3 | AHU-02 Top Section, Supply | 30 |
| 2.3.1 | General AHU Data | 30 |
| 2.3.2 | AHU-02 Top Section, Supply - Dimensions, media connection points | 30 |
| 2.3.3 | AHU-02 Top Section, Supply - Drawings – AHU Sections Shipping Details , Supply | 36 |
| 2.3.4 | AHU-02 Top Section, Supply - Performance Data | 37 |
| 2.3.5 | AHU-02 Top Section, Supply - Fan Performance Data , Supply | 38 |
| 2.3.7 | Submittal_Chapter2_1_12_Title_ElectricHeaterPowerConnectionDiagram | 0 |
| 2.4 | AHU-02 Bottom Section, Supply | 41 |
| 2.4.1 | General AHU Data | 41 |
| 2.4.2 | AHU-02 Bottom Section, Supply - Dimensions, media connection points | 42 |
| 2.4.3 | AHU-02 Bottom Section, Supply - Performance Data | 48 |
| 2.4.4 | Moist Air Processes | 51 |
| 2.4.5 | Submittal_Chapter2_1_12_Title_ElectricHeaterPowerConnectionDiagram | 0 |
| 2.5 | AHU-03 Top Section, Supply | 52 |
| 2.5.1 | General AHU Data | 52 |
| 2.5.2 | AHU-03 Top Section, Supply - Dimensions, media connection points | 52 |
| 2.5.3 | AHU-03 Top Section, Supply - Drawings – AHU Sections Shipping Details , Supply | 58 |
| 2.5.4 | AHU-03 Top Section, Supply - Performance Data | 59 |
| 2.5.5 | AHU-03 Top Section, Supply - Fan Performance Data , Supply | 60 |
| 2.5.7 | Submittal_Chapter2_1_12_Title_ElectricHeaterPowerConnectionDiagram | 0 |
| 2.6 | AHU-03 Bottom Section, Supply | 63 |



| | | |
|--|---|---|
| Project Name: UNCW King Hall – TRS NC; John Blakeney | VTS America Inc. 3535 Gravel Springs Rd. Extension, Suite 201, Buford, GA 30519 |  |
| Offer Code 11B.3/LIVE.USA/DW/2023-23 | Prepared for: THERMAL RESOURCE SALES - WILMINGTON 7215 OGDEN BUSINESS LANE, WILMINGTON, NC, 28411 | |
| Prepared by: Darrin Winecoff - VTS America Inc. | Page: 3 of 73 | Date: February 09, 2023 |

| | | |
|-------|---|----|
| 2.6.1 | General AHU Data | 63 |
| 2.6.2 | AHU-03 Bottom Section, Supply - Dimensions, media connection points | 64 |
| 2.6.3 | AHU-03 Bottom Section, Supply - Performance Data | 70 |
| 2.6.4 | Moist Air Processes | 73 |
| 2.6.5 | Submittal_Chapter2_1_12_Title_ElectricHeaterPowerConnectionDiagram | 0 |



| | | |
|--|---|---|
| Project Name: UNCW King Hall – TRS NC; John Blakeney | VTS America Inc. 3535 Gravel Springs Rd. Extension, Suite 201, Buford, GA 30519 |  |
| Offer Code 11B.3/LIVE.USA/DW/2023-23 | Prepared for: THERMAL RESOURCE SALES - WILMINGTON 7215 OGDEN BUSINESS LANE, WILMINGTON, NC, 28411 | |
| Prepared by: Darrin Winecoff - VTS America Inc. | Page: 4 of 73 | Date: February 09, 2023 |

1 The AVS Standard range Air Handling Units General Specifications

1.1 General

The VENTUS AVS range consists of 15 unit sizes: AVS 8, AVS 12, AVS 16, AVS 20, AVS 30, AVS 40, AVS 55, AVS 65, AVS 85, AVS 100, AVS 130, AVS 170, AVS 230, AVS 300 and AVS 380.. The number following the AVS indicates the airflow of each unit at cooling coil air velocity \approx 500 FPM. For example, a AVS 170 has a maximum airflow of \approx 17000 CFM. The ratings shown are based on tests and procedures performed in accordance with AMCA Publications no. 211, no. 311, and no. 511 and comply with the requirements of the AMCA Certified Ratings Program.

1.2 Components and specifications

The following chapter shows general information about all components of VENTUS AVS Air Handling Units. Information included below is common for the entire range of AVS units and is adequate for all units selected for the (UNCW King Hall – TRS NC; John Blakeney) project.

1.2.1 Unit construction - Casing

General Casing Characteristics:

- Concealed Skeleton Design – all framework is inside the unit, unexposed to ambient air and secure against thermal-bridging and condensation.
- Shipping sections, have both double tongue-and-groove and joint sections available.
- Panel thickness: 2.0 in Double Wall
- Insulation material: Rigid Close-Cell Polyurethane Foam
- External skin: 22 gauge steel, AluZinc Coating, exceeding 2,000 hours on the Salt Spray Test (ASTM B117) + thin organic coating
- Internal skin: Hot-dip galvanized 25 gauge steel + thin organic coating
- Color: Metallic Silver
- Panel operation temperature: -40 to +190 °F
- Panel moisture absorption: 0.04%
- PPU density: 2.62 lb/ft³
- Linear Density: 2 lb/ft²
- Casing mechanical strength (deflection): -10 in WC to +10 in WC: L=1/300
- Casing Air Leakage: -1.6 in WC: 0.009 CFM/ft²; +2.8 in WC: 0.026 CFM/ft²
- Casing Thermal Resistance: $R = 13.1 \text{ Hr} \times \text{ft}^2 \times \text{F} / \text{BTU}$
- Casing Thermal bridging: $K_b = 0.69$ (Class TB2, EN 1886: 2007)
- Designed for indoor and outdoor installation
- Casing fire rating: Non-fire spreading (ASTM E84).

1.2.2 Fans sets

Each component of fan sets has been described in individual paragraphs, as per below.

1.2.2.1 General Description


All fans installed in VENTUS AVS Air Handling Units are certified according to the AMCA 210 and AMCA 310: Laboratory Methods for Testing Fans. All units shall be equipped with direct driven plenum Fans, with air foil backward-curved impellers with 7 blades made of a polymer composite material; the impellers are installed directly on the motor shafts. All power and sound ratings have been certified by AMCA. All Fan Assemblies are belt-less + AMCA Arrangement 4.

1.2.2.2 Fan impeller mechanical and thermal specifications:

Impellers are featured with the following mechanical specification

- Number of blades: 7
- Composite Material made of SAN (AS) +20 GF
- Density: (ASTM-D792] 74.5 lb/ft³
- Tensile strength: 15.2 PSI [ASTM D-638]
- Impeller balancing: Statically and dynamically balanced to the grade of G=6.3, in accordance to ISO 1940-1 and ANSI D 2.19



| | | |
|--|---|---|
| Project Name: UNCW King Hall – TRS NC; John Blakeney | VTS America Inc. 3535 Gravel Springs Rd. Extension, Suite 201, Buford, GA 30519 |  |
| Offer Code 11B.3/LIVE.USA/DW/2023-23 | Prepared for: THERMAL RESOURCE SALES - WILMINGTON 7215 OGDEN BUSINESS LANE, WILMINGTON, NC, 28411 | |
| Prepared by: Darrin Winecoff - VTS America Inc. | Page: 5 of 73 | Date: February 09, 2023 |

- Operating temperature range: -22 °F to 140 °F
- Heat deflection temperature: 215 °F [ASTM D-648]
- Flammability according to UL: HB

1.2.2.3 Motors

Fans are driven by TEFC (Totally Enclosed Fan Cooled) foot mounted motors with double shielded bearings and range from 3 to 15 HP, all motors from 7.5 HP up to 15 HP includes shaft grounding rings as standard. All of the motors used are 3 phase. Nominal frequency: 60 Hz. Insulation class: F. Efficiency class: Premium. Bearing life: L10 = 150,000 h. Motors used in submitted air handling units are (Motor HP, Number of Poles, Approx. Rated Revolutions at 60Hz, and Motor Physical size).

1.2.2.4 Fan Power Supply Point

Connecting Points Features:

- Single power supply connection for each fan section
- Built in short circuit protection (circuit breakers) and main disconnect switch
- Enclosure class: NEMA 4

1.2.3 Filters

Available filters are (depending on selection):

1.2.4 Hydronic Heating Coils

Hydronic heating coils are featured with the following specifications


- Coil casing: Hot-dip Galvanized steel
- Type: Cu-Al: Copper tubes, Aluminum fins
- Fins: Aluminum, mechanically bonded to the pipes, spacing: 10 fins per Inch, 0.006" thick, Corrugated
- Tube wall thickness: 0.020"
- Tube spacing: 1¼"
- Tube diameter: ½ O.D.
- Operational
- Row spacing: 1.08"
- Tube diameter: ½" O.D.
- Maximum operating pressure: 300 PSI
- Entering medium maximum temperature: 285 °F
- Maximum glycol content: 50%
- Tube wall thickness: 0.020"
- Tube spacing: 1¼"
- Row spacing: 1.08"
- Tube diameter: ½" O.D.
- Number of rows available: 1, 2, 3, 4
- Maximum operating pressure: 300 PSI
- Entering medium maximum temperature: 285 °F
- Maximum glycol content: 50%

1.2.5 Hydronic Cooling Coils

Hydronic cooling coils are featured with the following specification

- Coil casing: Galvanized steel or optional Stainless Steel
- Type: Cu-Al: Copper tubes, Aluminum fins
- Fin: Aluminum, mechanically bonded to the pipes
- Spacing: 10 fins per Inch, 0.006" thick
- Tube wall thickness: 0.020"
- Tube diameter: ½" O.D.
- Operational
- Tube spacing: 1¼"
- Tube diameter: ½" O.D.
- Maximum operating pressure: 300 PSI
- Entering medium maximum temperature: 285 °F
- Maximum glycol content: 50%
- Tube wall thickness: 0.020"
- Tube spacing: 1¼"
- Row spacing: 1.08"
- Tube diameter: ½" O.D.
- Number of rows available: 4, 6, 8
- Maximum operating pressure: 300 PSI





| | | |
|--|---|---|
| Project Name: UNCW King Hall – TRS NC; John Blakeney | VTS America Inc. 3535 Gravel Springs Rd. Extension, Suite 201, Buford, GA 30519 |  |
| Offer Code 11B.3/LIVE.USA/DW/2023-23 | Prepared for: THERMAL RESOURCE SALES - WILMINGTON 7215 OGDEN BUSINESS LANE, WILMINGTON, NC, 28411 | |
| Prepared by: Darrin Winecoff - VTS America Inc. | Page: 6 of 73 | Date: February 09, 2023 |

1.2.6 Air Dampers TAMCO 9000 SW Series per Spec

All air dampers installed in VTS Air Handling Units are certified according to AMCA 511: Laboratory Methods for Testing Fans for Ratings

- Aluminum blades protected with rubber seals on the edges
- Damper Frame material: Aluminum
- Damper Length: 4.92"
- Damper tightness class according to AMCA: Low Leak
- Damper shaft: square: 0.6x0.6"
- Damper shaft: square: 0.6x0.6"

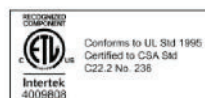

| | | |
|--|---|---|
| Project Name: UNCW King Hall – TRS NC; John Blakeney | VTS America Inc. 3535 Gravel Springs Rd. Extension, Suite 201, Buford, GA 30519 |  |
| Offer Code 11B.3/LIVE.USA/DW/2023-23 | Prepared for: THERMAL RESOURCE SALES - WILMINGTON 7215 OGDEN BUSINESS LANE, WILMINGTON, NC, 28411 | |
| Prepared by: Darrin Winecoff - VTS America Inc. | Page: 7 of 73 | Date: February 09, 2023 |


2 Selections for the UNCW King Hall – TRS NC; John Blakeney


The following Air Handling Units are included in this submittal. Detailed information is listed on further pages.

| No. | Project Tag | Model name | Quantity | Page |
|-----|-------------------------------|----------------|----------|------|
| 1 | AHU-01 Top Section, Supply | AVS030-R-EV | 1 | 8 |
| 2 | AHU-01 Bottom Section, Supply | AVS030-L-MFHEC | 1 | 19 |
| 3 | AHU-02 Top Section, Supply | AVS055-L-EV | 1 | 30 |
| 4 | AHU-02 Bottom Section, Supply | AVS055-R-MFHEC | 1 | 41 |
| 5 | AHU-03 Top Section, Supply | AVS100-R-EV | 1 | 52 |
| 6 | AHU-03 Bottom Section, Supply | AVS100-L-MFHEC | 1 | 63 |

For each Air Handling Unit detailed information includes:

- Detailed Drawings (CAD version available on request)
- Connecting point - Fan Power Supply and VFD Communication connections
- Air Handling Unit performance data
- Fan curves with operational point marked and motor limit

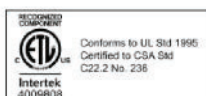

| | | |
|--|---|---|
| Project Name: UNCW King Hall – TRS NC; John Blakeney | VTS America Inc. 3535 Gravel Springs Rd. Extension, Suite 201, Buford, GA 30519 |  |
| Offer Code 11B.3/LIVE.USA/DW/2023-23 | Prepared for: THERMAL RESOURCE SALES - WILMINGTON 7215 OGDEN BUSINESS LANE, WILMINGTON, NC, 28411 | |
| Project Tag AHU-01 Top Section, Supply | Page: 8 of 73 | Date: February 09, 2023 |

2.1 **AHU-01 Top Section, Supply**

2.1.1 **General AHU Data**

| | | | |
|----------------------------|---------------------------|-----------------------------|-----------------------|
| AHU Tag | AHU-01 Top Section | AHU Size | AVS030 |
| Application | Execution: Indoor | AHU Set | AVS030-R-EV |
| AHU Type | Supply unit | Width | 53.5 in |
| Insulation Thickness | 2.0 in | AHU Support | AHU Support Type1 |
| Insulation | PUR | AHU Support Height | 3.5 in |
| Weight | 409 lb | Shipping Sections | 2 |
| Elevation | 0 ft | Coil Connection Side | Right Hand Side (RHS) |
| Total length | 73.1 in | | |
| Fan Section Voltage | 460/3/60 V/ph/Hz | | |
| Unit Execution Side | Right Hand Side (RHS) | | |

Supply

| | |
|-------------------|-------------|
| AirFlow | 3300.00 CFM |
| External Pressure | 0.00 in wg |
| Calculation Mode | Real |

Fan Section

| | | | |
|-------------------|------|----------|--------|
| Motor Rated Power | 5 HP | Impeller | VS 450 |
|-------------------|------|----------|--------|

Empty Section

| | |
|-------------------------|-------------------------|
| EMP.SEC AVS030 Standard | EMP.SEC AVS030 Standard |
|-------------------------|-------------------------|

AHU Discharge and Intake Opening Sizes & Unit Accessories


Controls Selection Mode : No controls


| | |
|---|----------------|
| AHU Discharge and Intake Opening Sizes | Supply |
| Air Inlet | Down 34.3x12.3 |
| Air Outlet | Top 34x12 |

Unit Another Accessories


| | |
|-----------------------|------------|
| Internal Marine Light | Quantity 2 |
| Hinged Access | Quantity 1 |

2.1.2 **AHU-01 Top Section, Supply - Dimensions, media connection points**

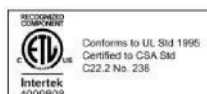



| | | |
|--|---|---|
| Project Name: UNCW King Hall – TRS NC; John Blakeney | VTS America Inc. 3535 Gravel Springs Rd. Extension, Suite 201, Buford, GA 30519 |  |
| Offer Code 11B.3/LIVE.USA/DW/2023-23 | Prepared for: THERMAL RESOURCE SALES - WILMINGTON 7215 OGDEN BUSINESS LANE, WILMINGTON, NC, 28411 | |
| Project Tag AHU-01 Top Section, Supply | Page: 9 of 73 | Date: February 09, 2023 |

Inspection side

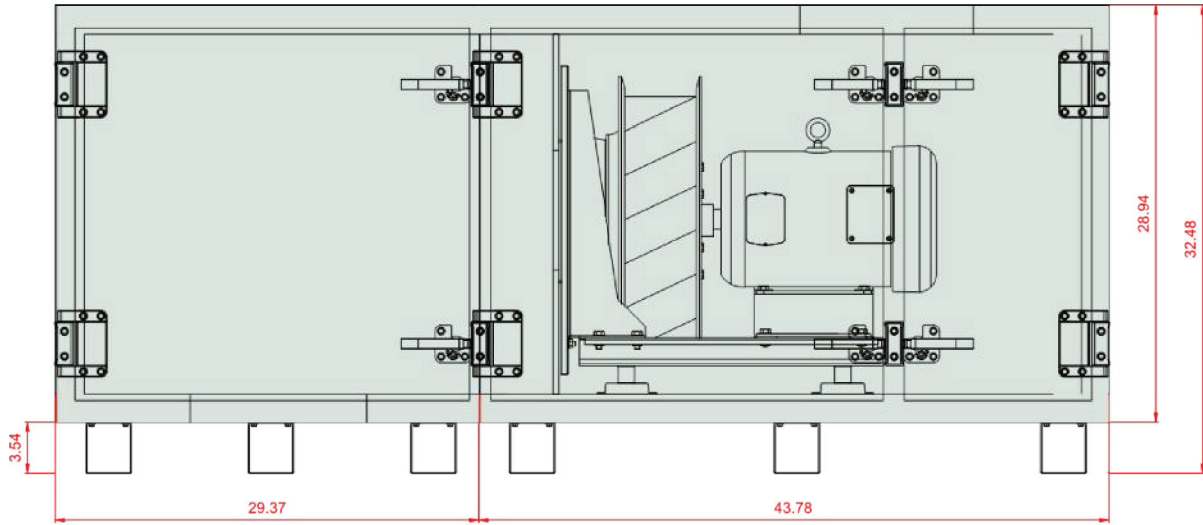


Top View

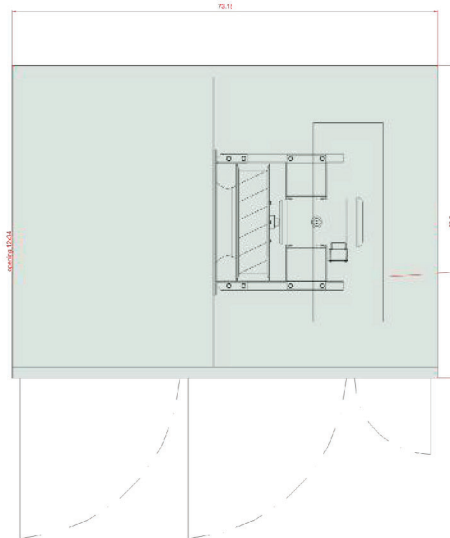



| | | |
|--|---|---|
| Project Name: UNCW King Hall – TRS NC; John Blakeney | VTS America Inc. 3535 Gravel Springs Rd. Extension, Suite 201, Buford, GA 30519 |  |
| Offer Code 11B.3/LIVE.USA/DW/2023-23 | Prepared for: THERMAL RESOURCE SALES - WILMINGTON 7215 OGDEN BUSINESS LANE, WILMINGTON, NC, 28411 | |
| Project Tag AHU-01 Top Section, Supply | Page: 10 of 73 | Date: February 09, 2023 |

End - Front Openings **End - Back Openings**

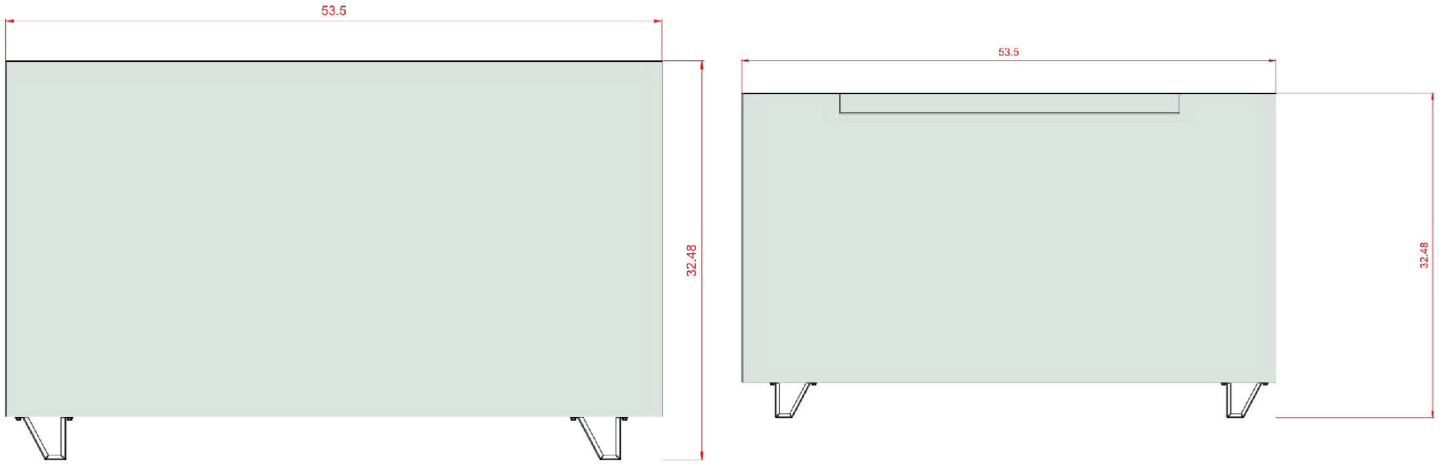

Coil Connections - Inspection side view

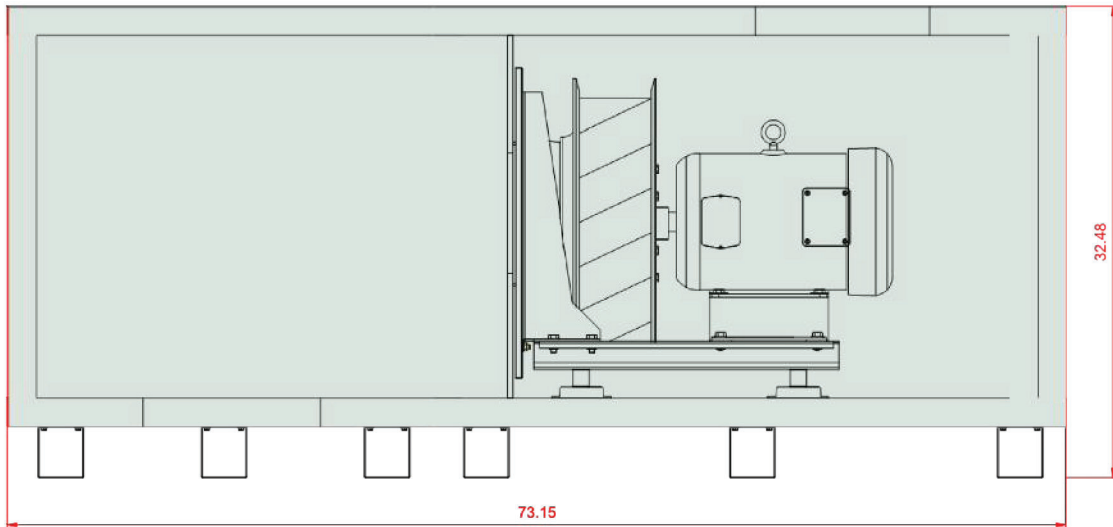


| | | |
|--|---|---|
| Project Name: UNCW King Hall – TRS NC; John Blakeney | VTS America Inc. 3535 Gravel Springs Rd. Extension, Suite 201, Buford, GA 30519 |  |
| Offer Code 11B.3/LIVE.USA/DW/2023-23 | Prepared for: THERMAL RESOURCE SALES - WILMINGTON 7215 OGDEN BUSINESS LANE, WILMINGTON, NC, 28411 | |
| Project Tag AHU-01 Top Section, Supply | Page: 11 of 73 | Date: February 09, 2023 |


Coil connection rules

Coil dimensions




| | | |
|--|---|---|
| Project Name: UNCW King Hall – TRS NC; John Blakeney | VTS America Inc. 3535 Gravel Springs Rd. Extension, Suite 201, Buford, GA 30519 |  |
| Offer Code 11B.3/LIVE.USA/DW/2023-23 | Prepared for: THERMAL RESOURCE SALES - WILMINGTON 7215 OGDEN BUSINESS LANE, WILMINGTON, NC, 28411 | |
| Project Tag AHU-01 Top Section, Supply | Page: 12 of 73 | Date: February 09, 2023 |


Coil Connections - Top View

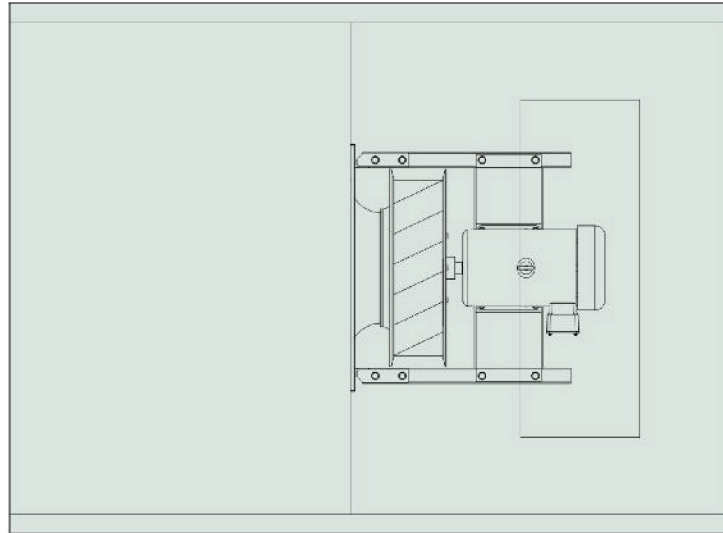


Sections split for transportation

| Section number | Section weight [lb] | Section length [in] | Section width [in] | Section height [in] |
|----------------|---------------------|---------------------|--------------------|---------------------|
| 1 | 110 | 29.4 | 53.5 | 32.5 |
| 2 | 280 | 43.8 | 53.5 | 32.5 |

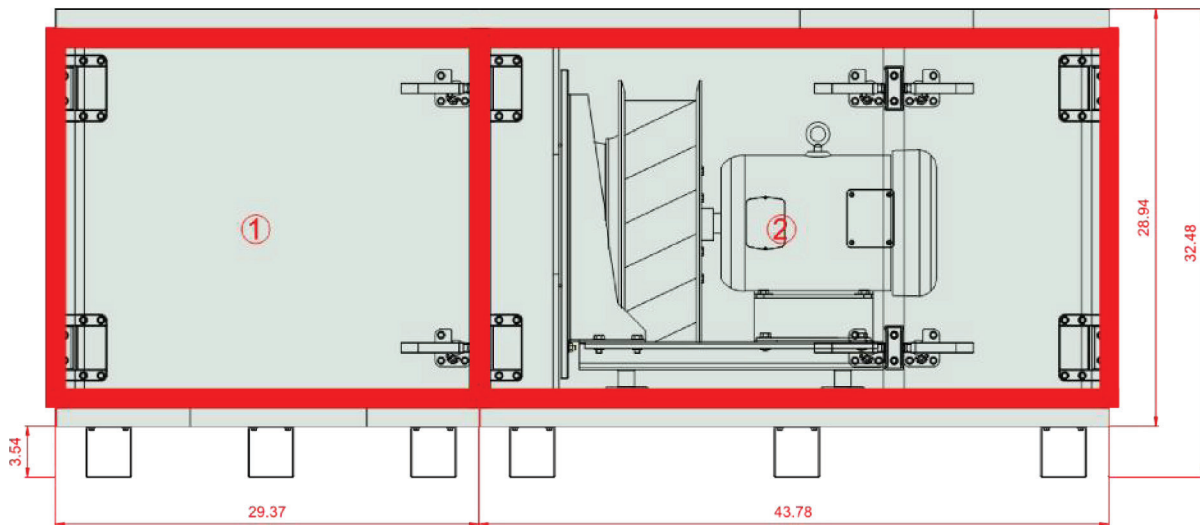

| | | |
|--|---|---|
| Project Name: UNCW King Hall – TRS NC; John Blakeney | VTS America Inc. 3535 Gravel Springs Rd. Extension, Suite 201, Buford, GA 30519 |  |
| Offer Code 11B.3/LIVE.USA/DW/2023-23 | Prepared for: THERMAL RESOURCE SALES - WILMINGTON 7215 OGDEN BUSINESS LANE, WILMINGTON, NC, 28411 | |
| Project Tag AHU-01 Top Section, Supply | Page: 13 of 73 | Date: February 09, 2023 |


Top view - Service space

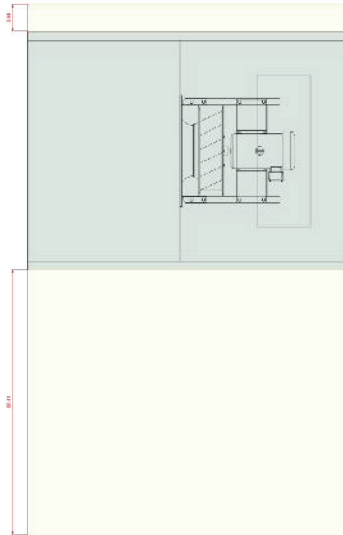

The AHU installation clearance is defined by:

- Non-Access Side – minimum space required for unit operation or coil connection
- Access Side – minimum space require allowing opening access door to a position perpendicular to the direction of Air Flow, and removal of side load filter
- Clearance for VFD's, or other high-voltage devices must be provided per NEC requirements
- Clearance for coil removal must be provided per coil drawing through the access side of the unit



Frame Top View, within the AHU outline contour

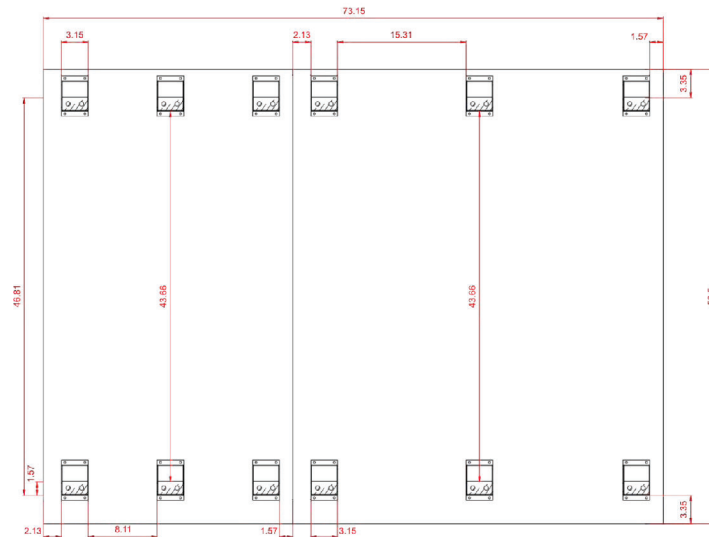


| | | |
|--|---|----------------------------|
| Project Name: UNCW King Hall – TRS NC; John Blakeney | VTS America Inc. 3535 Gravel Springs Rd. Extension, Suite 201, Buford, GA 30519 | |
| Offer Code 11B.3/LIVE.USA/DW/2023-23 | Prepared for: THERMAL RESOURCE SALES - WILMINGTON 7215 OGDEN BUSINESS LANE, WILMINGTON, NC, 28411 | |
| Project Tag AHU-01 Top Section, Supply | Page: 14 of 73 | Date: February 09, 2023 |

2.1.3 AHU-01 Top Section, Supply - Drawings – AHU Sections Shipping Details , Supply

Fan Section Electric Connections

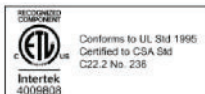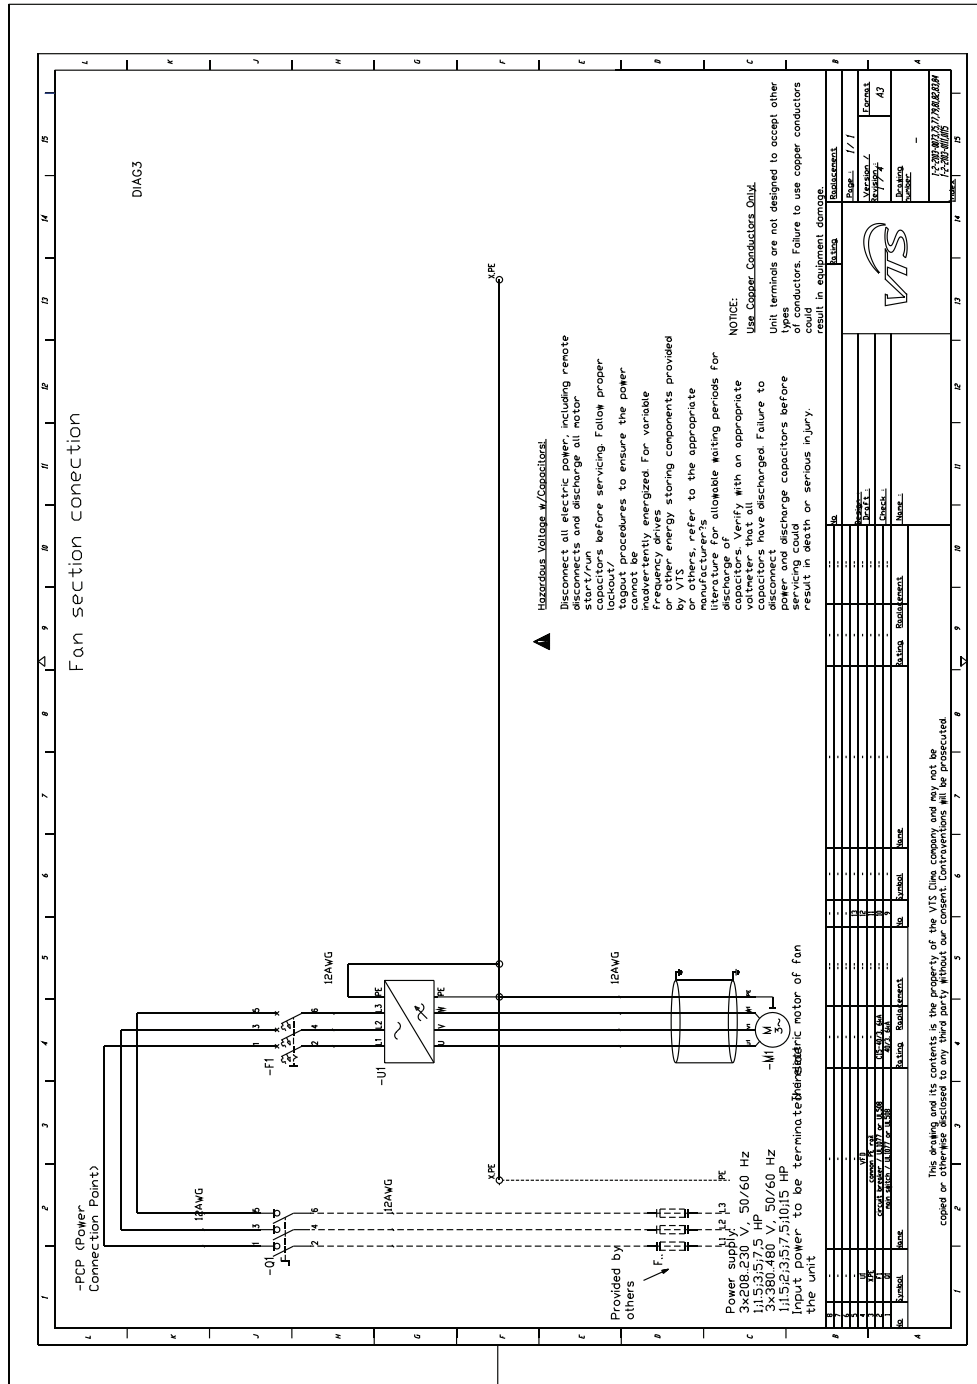

| | | |
|--|---|---|
| Project Name: UNCW King Hall – TRS NC; John Blakeney | VTS America Inc. 3535 Gravel Springs Rd. Extension, Suite 201, Buford, GA 30519 |  |
| Offer Code 11B.3/LIVE.USA/DW/2023-23 | Prepared for: THERMAL RESOURCE SALES - WILMINGTON 7215 OGDEN BUSINESS LANE, WILMINGTON, NC, 28411 | |
| Project Tag AHU-01 Top Section, Supply | Page: 15 of 73 | Date: February 09, 2023 |

2.1.4 AHU-01 Top Section, Supply - Performance Data

Supply tier

Empty section

Type EMP.SEC AVS030 Standard

Heating operations

Pressure drop

Air velocity 456 FPM

Cooling operations

Pressure drop

Air velocity 539 FPM

Resp_EmptySection_Info_Name

EmptySections

Plug-Fan Set

Fan Section PLUG_DD_450_5,00_4

| | | | |
|-----------------------|---------------|----------------|--|
| Fan Set Assembly Type | FLX1 (Gasket) | Qty in section | x 1 |
| | | Air Standard | Calculations made for real air density |

Fan Set Designed for wet operating conditions

The fan system effects is taken into account in the fan performances.

Fan PLUG_VS_450_AF_Px 1

| | | | |
|-----------------------|------------|-------------------------------------|-------------|
| Total Static Pressure | 5.70 in wg | Impeller efficiency: Static / Total | 64 %/67 % |
| Dynamic pressure | 0.20 in wg | Shaft power | 4.96 HP x 1 |
| External pressure | 5.55 in wg | Working revolutions | 2509 rpm |
| Total Pressure | 5.90 in wg | | |

Fan Additional Info

Fan Type: Direct Driven Plenum Fan

Fan Wheel Diameter: 450 [mm]

Vibro-Acoustics Insulation: Rubber-in-Shear Floor Mounted Isolator


Motor AC_Premium Eff._F_184T_TEFC_4p_5_60x 1

460V

60Hz

| | | | |
|-------------------------------------|--------|--------------------------------------|-----------|
| FLA | 6.7 A | MCA | 8.4 A |
| MCB | 15.0 A | Maximum Overcurrent Protection (MOP) | 15.1 A |
| Short-Circuit Current Rating (SCCR) | 6.0 kA | | |
| Motor enclosure | TEFC | Rated Current | 6.7 A x 1 |
| IEC Size | 184T | Rated revolutions | 1750 rpm |



| | | |
|--|---|---|
| Project Name: UNCW King Hall – TRS NC; John Blakeney | VTS America Inc. 3535 Gravel Springs Rd. Extension, Suite 201, Buford, GA 30519 |  |
| Offer Code 11B.3/LIVE.USA/DW/2023-23 | Prepared for: THERMAL RESOURCE SALES - WILMINGTON 7215 OGDEN BUSINESS LANE, WILMINGTON, NC, 28411 | |
| Project Tag AHU-01 Top Section, Supply | Page: 16 of 73 | Date: February 09, 2023 |

| | | | |
|---------------------|------------------|---------------|--------------------|
| Operational Voltage | 460 V/3 ph | Rated Power | 5.00 HP x 1 |
| Name plate RPM | 460 V/3 ph/60 Hz | Motor Version | V-Series |

Electric Motor Additional Info

Supplier: Baldor
Motor poles: 4

VFD BY OTHERS

| | | | |
|--------------------|----------|---------------------------|-----------------------|
| VFD | Required | Connecting Point | CP Provided by others |
| VFD Qty in section | 1 | VFD Voltage Supply | 460/3/60 V/ph/Hz |
| VFD Settings | 86 Hz | VFD Rated Power | 5.00 HP x 1 |
| VFD in selection | Excluded | VFD HMI | No |
| | | VFD 1PH ModBus Comm Board | No |

Acoustic data

| Frequency | | 63 Hz | 125 Hz | 250 Hz | 500 Hz | 1000 Hz | 2000 Hz | 4000 Hz | 8000 Hz | Lw dB(A) |
|------------------------|----|-------|--------|--------|--------|---------|---------|---------|---------|----------|
| Intake | dB | 77,8 | 82,7 | 89,2 | 89,8 | 86,6 | 83,4 | 78,6 | 74,7 | 94,5 |
| Outlet | dB | 79,8 | 84,7 | 91,2 | 91,8 | 88,6 | 85,4 | 80,6 | 76,7 | 96,5 |
| Environment | dB | 58 | 73,2 | 77,8 | 77,8 | 74,9 | 71,9 | 51,1 | 38,2 | 82,8 |
| Sound Pressure* | dB | 44,7 | 66,2 | 70,8 | 70,8 | 67,9 | 64,9 | 44,1 | 31,2 | 75,8 |

(*) Approximate data of sound pressure


2.1.5 AHU-01 Top Section, Supply - Fan Performance Data, Supply

| | |
|---------------------------|-------------|
| Number of fans in section | 1 |
| Airflow per Fan | 3481.30 CFM |
| Total Pressure Increase | 5.90 in wg |
| Static pressure | 5.70 in wg |
| External pressure | 5.55 in wg |
| Velocity Pressure | 0.20 in wg |
| Static Efficiency | 64 % |
| Total Efficiency | 67 % |
| Shaft Power | 4.96 HP |
| Fan revolutions | 2509 rpm |
| VFD Setting | 86 Hz |
| Acoustic Power Level | 82,8 dB |
| Acoustic Pressure Level | 75,8 dB |

Internal Pressure Drop


| | |
|------------|--|
| Function | Pressure Drop |
| | Pressure Drop in Winter (at 50% Dirty Filters) |
| All | 0.17 in wg |





| | | |
|--|---|---|
| Project Name: UNCW King Hall – TRS NC; John Blakeney | VTS America Inc. 3535 Gravel Springs Rd. Extension, Suite 201, Buford, GA 30519 |  |
| Offer Code 11B.3/LIVE.USA/DW/2023-23 | Prepared for: THERMAL RESOURCE SALES - WILMINGTON 7215 OGDEN BUSINESS LANE, WILMINGTON, NC, 28411 | |
| Project Tag AHU-01 Top Section, Supply | Page: 17 of 73 | Date: February 09, 2023 |

| | |
|---------------|------------|
| Inlet | 0.08 in wg |
| Empty Section | 0.01 in wg |
| Outlet | 0.08 in wg |



| | | |
|--|---|---|
| Project Name: UNCW King Hall – TRS NC; John Blakeney | VTS America Inc. 3535 Gravel Springs Rd. Extension, Suite 201, Buford, GA 30519 |  |
| Offer Code 11B.3/LIVE.USA/DW/2023-23 | Prepared for: THERMAL RESOURCE SALES - WILMINGTON 7215 OGDEN BUSINESS LANE, WILMINGTON, NC, 28411 | |
| Project Tag AHU-01 Top Section, Supply | Page: 18 of 73 | Date: February 09, 2023 |

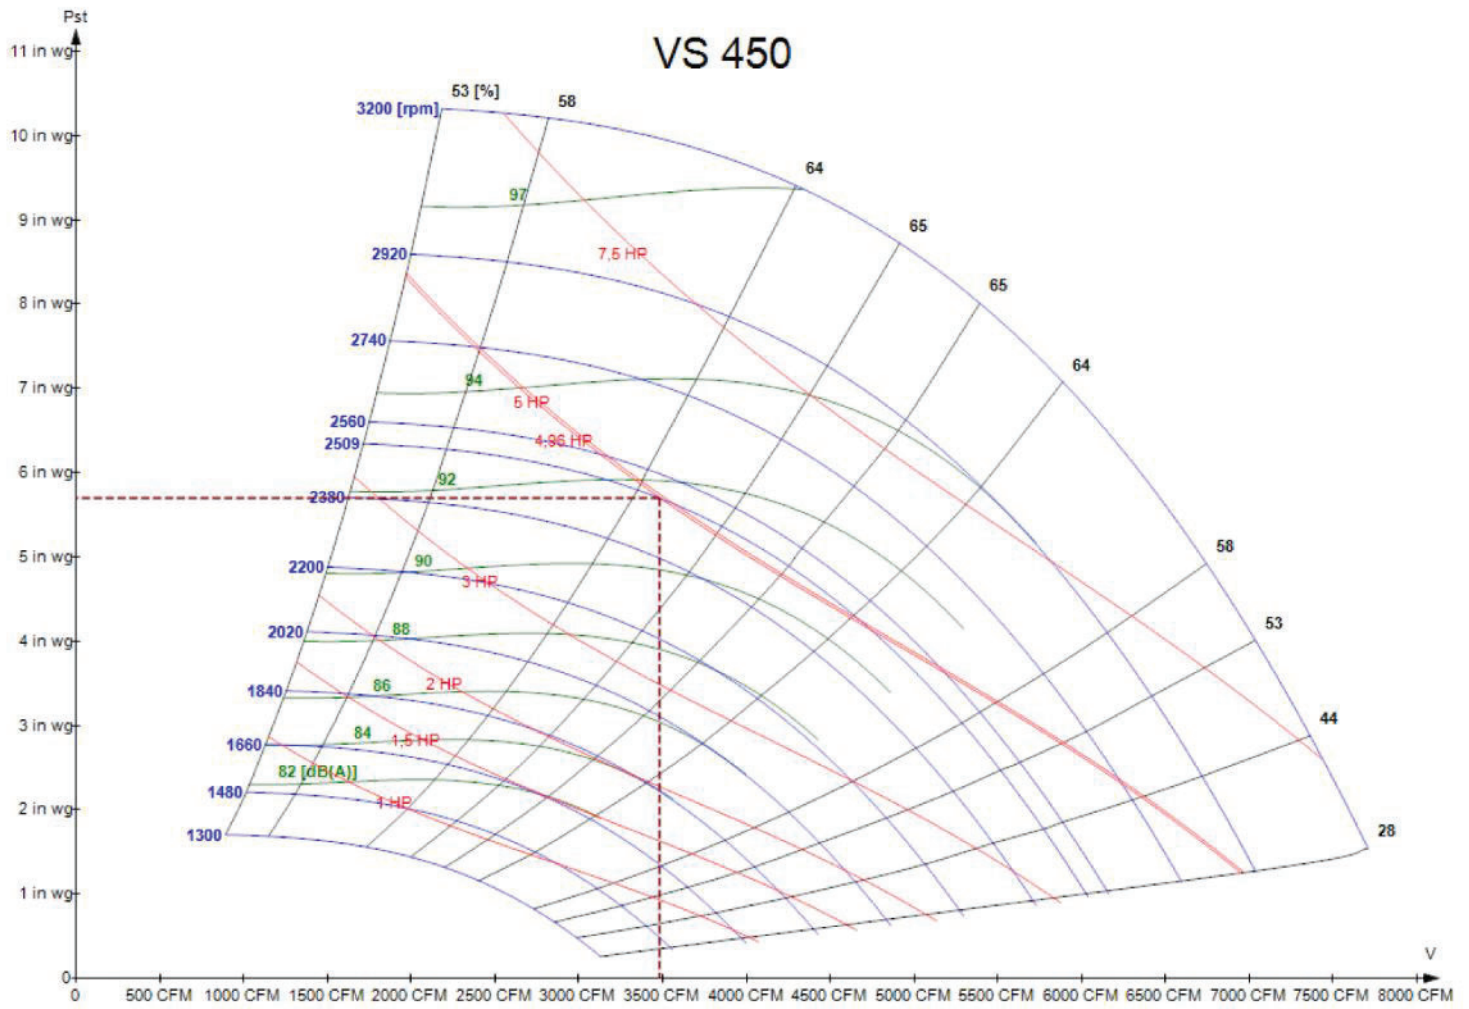

| | | |
|--|---|---|
| Project Name: UNCW King Hall – TRS NC; John Blakeney | VTS America Inc. 3535 Gravel Springs Rd. Extension, Suite 201, Buford, GA 30519 |  |
| Offer Code 11B.3/LIVE.USA/DW/2023-23 | Prepared for: THERMAL RESOURCE SALES - WILMINGTON 7215 OGDEN BUSINESS LANE, WILMINGTON, NC, 28411 | |
| Project Tag AHU-01 Bottom Section, Supply | Page: 19 of 73 | Date: February 09, 2023 |

2.2 AHU-01 Bottom Section, Supply

2.2.1 General AHU Data

| | | | |
|----------------------------|------------------------------|-----------------------------|-----------------------|
| AHU Tag | AHU-01 Bottom Section | AHU Size | AVS030 |
| Application | Execution: Indoor | AHU Set | AVS030-L-MFHEC |
| AHU Type | Supply unit | Width | 53.5 in |
| Insulation Thickness | 2.0 in | AHU Support | AHU Support Type1 |
| Insulation | PUR | AHU Support Height | 8.0 in |
| Weight | 816 lb | Shipping Sections | 3 |
| Elevation | 0 ft | | |
| Total length | 116.4 in | | |
| Unit Execution Side | Left Hand Side (LHS) | Coil Connection Side | Left Hand Side (LHS) |

Supply

| | |
|-------------------|-------------|
| AirFlow | 3300.00 CFM |
| External Pressure | 0.00 in wg |
| Calculation Mode | Real |

Mixing

Mixing Section

Coils

| | | | |
|------------------|---------|----------------------|-------------------------------|
| Hot Water Heater | Rows: 1 | Chilled Water Cooler | Rows: 8 HIGH PERFORMANCE COIL |
|------------------|---------|----------------------|-------------------------------|

Filters

| | |
|-----------------------|-----------------------|
| MERV8/2".Flat.Int.Sld | MERV8/2".Flat.Int.Sld |
|-----------------------|-----------------------|

Empty Section

| | |
|-----------------------|-----------------------|
| EMP.SEC AVS030 Medium | EMP.SEC AVS030 Medium |
|-----------------------|-----------------------|

AHU Discharge and Intake Opening Sizes & Unit Accessories


Controls Selection Mode : Air damper actuator

| AHU Discharge and Intake Opening Sizes | Supply |
|--|-------------------------|
| Air Inlet | Front (Small) 34.0x12.0 |
| Air Inlet (2nd) | Top 34.0x12.0 |
| Air Outlet | Front (Small) 34.3x12.3 |
| Air Damper | Supply |
| Air Inlet | Provided with Actuators |
| Air Inlet (2nd) | Provided with Actuators |

Unit Another Accessories

| | |
|-----------------------|------------|
| Round View Window | Quantity 1 |
| Internal Marine Light | Quantity 3 |
| Hinged Access | Quantity 1 |
| UV Lamp | Quantity 1 |




| | | |
|--|---|---|
| Project Name: UNCW King Hall – TRS NC; John Blakeney | VTS America Inc. 3535 Gravel Springs Rd. Extension, Suite 201, Buford, GA 30519 |  |
| Offer Code 11B.3/LIVE.USA/DW/2023-23 | Prepared for: THERMAL RESOURCE SALES - WILMINGTON 7215 OGDEN BUSINESS LANE, WILMINGTON, NC, 28411 | |
| Project Tag AHU-01 Bottom Section, Supply | Page: 20 of 73 | Date: February 09, 2023 |

Differential Pressure Gauge
Rails


Quantity 2
Quantity 1


2.2.2 AHU-01 Bottom Section, Supply - Dimensions, media connection points

Inspection side

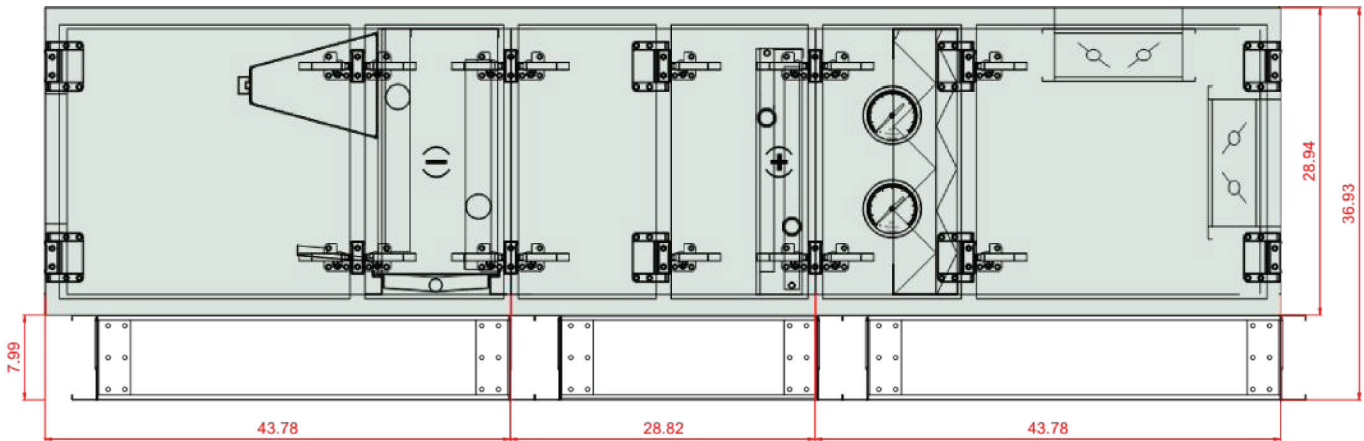



Top View

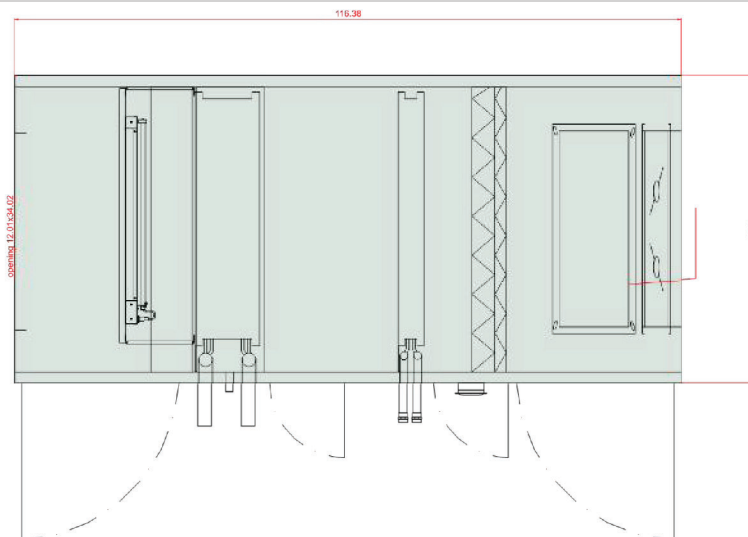


| | | |
|--|---|---|
| Project Name: UNCW King Hall – TRS NC; John Blakeney | VTS America Inc. 3535 Gravel Springs Rd. Extension, Suite 201, Buford, GA 30519 |  |
| Offer Code 11B.3/LIVE.USA/DW/2023-23 | Prepared for: THERMAL RESOURCE SALES - WILMINGTON 7215 OGDEN BUSINESS LANE, WILMINGTON, NC, 28411 | |
| Project Tag AHU-01 Bottom Section, Supply | Page: 21 of 73 | Date: February 09, 2023 |


End - Front Openings

End - Back Openings

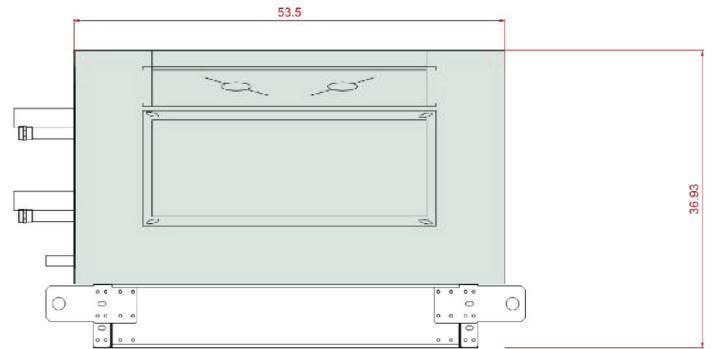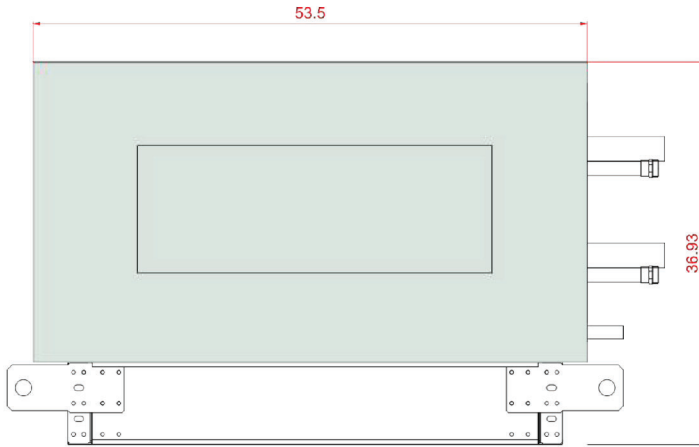


Coil Connections - Inspection side view

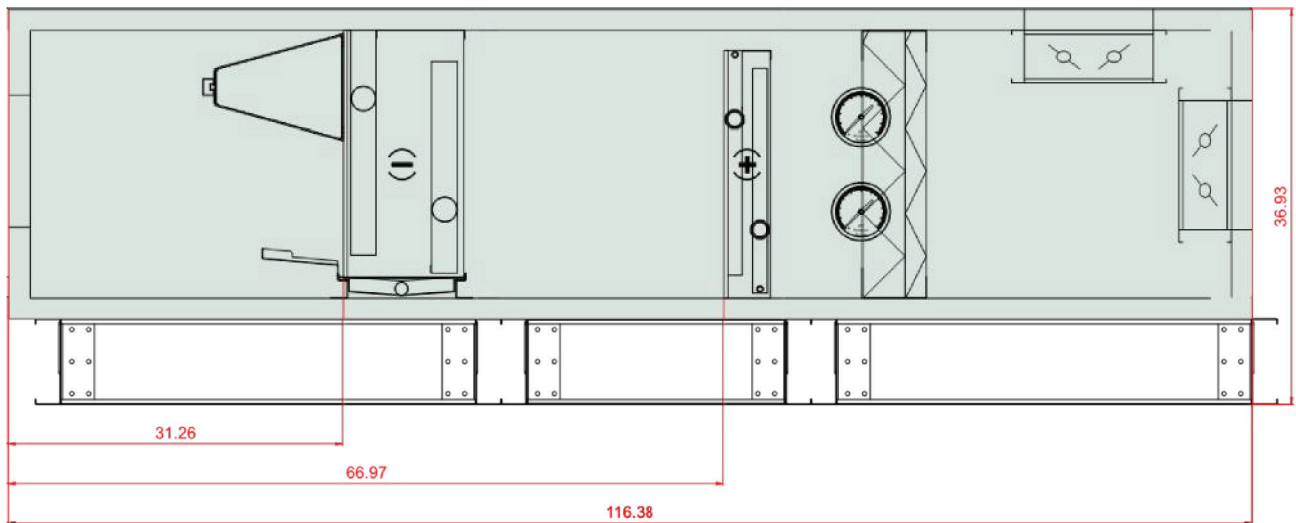

| | | |
|--|---|---|
| Project Name: UNCW King Hall – TRS NC; John Blakeney | VTS America Inc. 3535 Gravel Springs Rd. Extension, Suite 201, Buford, GA 30519 |  |
| Offer Code 11B.3/LIVE.USA/DW/2023-23 | Prepared for: THERMAL RESOURCE SALES - WILMINGTON 7215 OGDEN BUSINESS LANE, WILMINGTON, NC, 28411 | |
| Project Tag AHU-01 Bottom Section, Supply | Page: 22 of 73 | Date: February 09, 2023 |


Coil connection rules

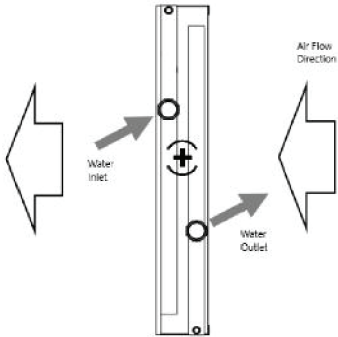


Coil dimensions

C_cw_8|1|1|SH|N


H_hw_1|1|1|SH|N

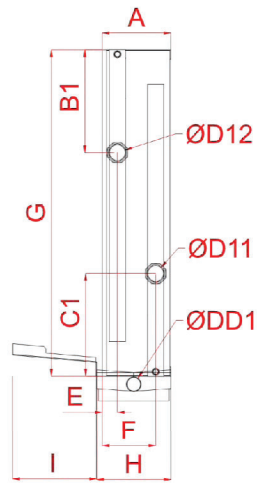


| | | | | | |
|-------|------|------|-------|------|-------|
| A | B1 | C1 | E | F | G |
| 11.38 | 6.46 | 6.46 | 1.9 | 9.48 | 23.11 |
| D11 | D12 | DD1 | H | I | L |
| 2.01 | 2.01 | 1.26 | 11.81 | 7.1 | 41.34 |

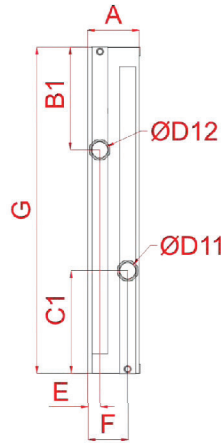


| | | | | |
|-------|------|------|-------|------|
| A | B1 | C1 | E | F |
| 4.49 | 6.46 | 6.46 | 1.06 | 3.43 |
| G | D11 | D12 | L | |
| 23.11 | 1.26 | 1.26 | 41.34 | |

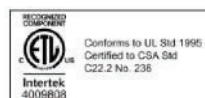


| | | |
|--|---|---|
| Project Name: UNCW King Hall – TRS NC; John Blakeney | VTS America Inc. 3535 Gravel Springs Rd. Extension, Suite 201, Buford, GA 30519 |  |
| Offer Code 11B.3/LIVE.USA/DW/2023-23 | Prepared for: THERMAL RESOURCE SALES - WILMINGTON 7215 OGDEN BUSINESS LANE, WILMINGTON, NC, 28411 | |
| Project Tag AHU-01 Bottom Section, Supply | Page: 23 of 73 | Date: February 09, 2023 |


Coil Connections - Top View

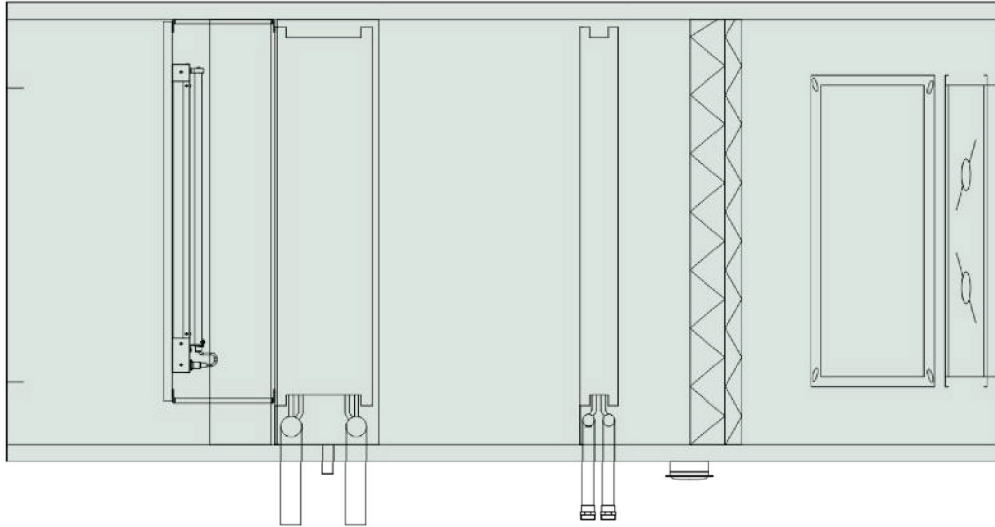


Sections split for transportation

| Section number | Section weight [lb] | Section length [in] | Section width [in] | Section height [in] |
|----------------|---------------------|---------------------|--------------------|---------------------|
| 1 | 252 | 43.8 | 53.5 | 36.9 |
| 2 | 162 | 28.8 | 53.5 | 36.9 |
| 3 | 344 | 43.8 | 53.5 | 36.9 |

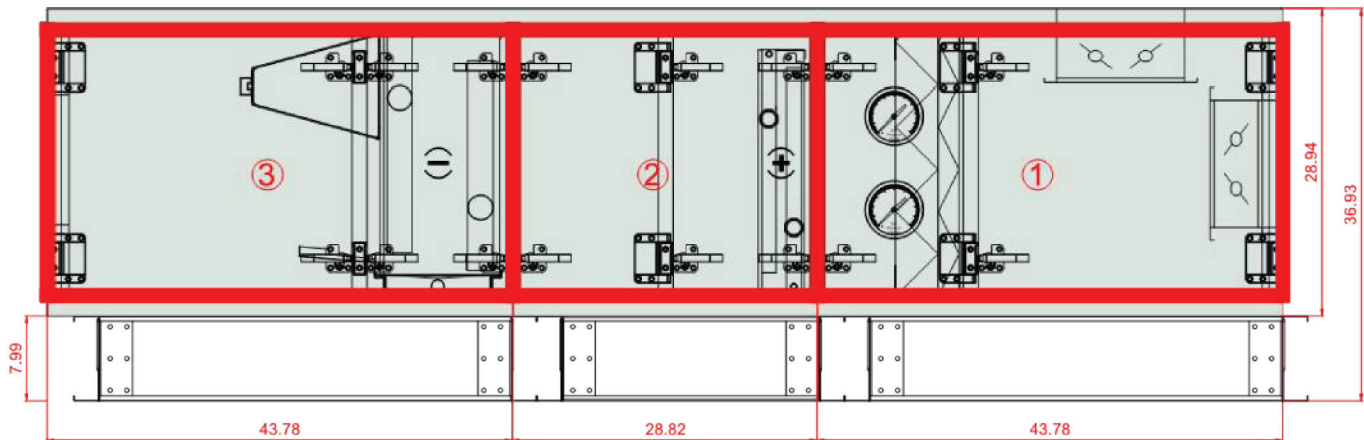

| | | |
|--|---|---|
| Project Name: UNCW King Hall – TRS NC; John Blakeney | VTS America Inc. 3535 Gravel Springs Rd. Extension, Suite 201, Buford, GA 30519 |  |
| Offer Code 11B.3/LIVE.USA/DW/2023-23 | Prepared for: THERMAL RESOURCE SALES - WILMINGTON 7215 OGDEN BUSINESS LANE, WILMINGTON, NC, 28411 | |
| Project Tag AHU-01 Bottom Section, Supply | Page: 24 of 73 | Date: February 09, 2023 |



Top view - Service space

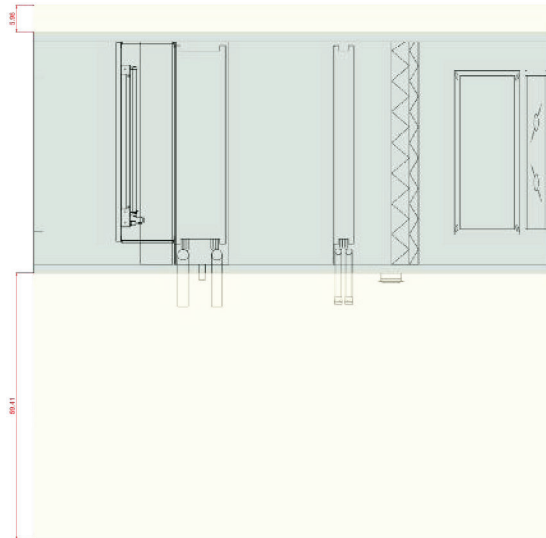


The AHU installation clearance is defined by:

- Non-Access Side – minimum space required for unit operation or coil connection
- Access Side – minimum space require allowing opening access door to a position perpendicular to the direction of Air Flow, and removal of side load filter
- Clearance for VFD's, or other high-voltage devices must be provided per NEC requirements
- Clearance for coil removal must be provided per coil drawing through the access side of the unit


Frame Top View, within the AHU outline contour

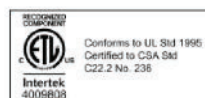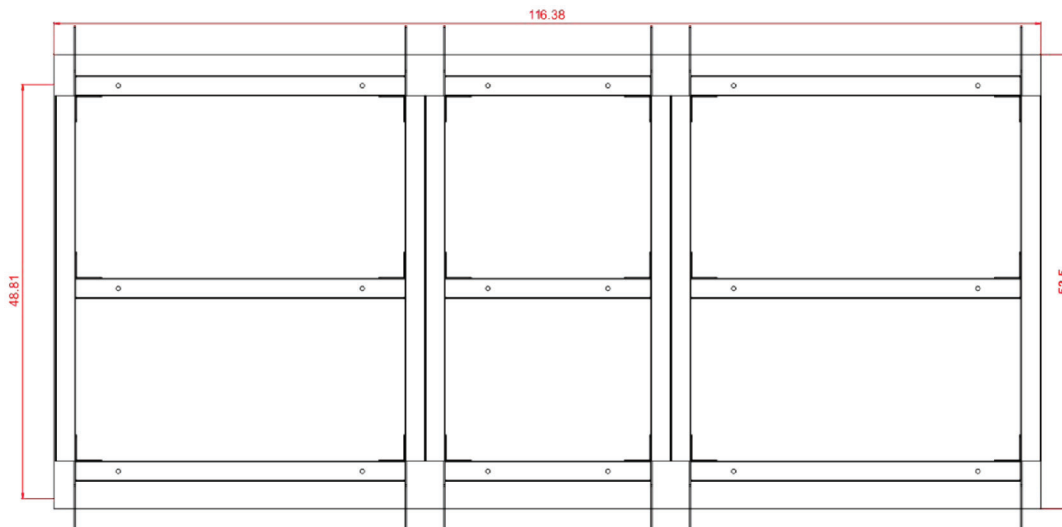

| | | |
|--|---|---|
| Project Name: UNCW King Hall – TRS NC; John Blakeney | VTS America Inc. 3535 Gravel Springs Rd. Extension, Suite 201, Buford, GA 30519 |  |
| Offer Code 11B.3/LIVE.USA/DW/2023-23 | Prepared for: THERMAL RESOURCE SALES - WILMINGTON 7215 OGDEN BUSINESS LANE, WILMINGTON, NC, 28411 | |
| Project Tag AHU-01 Bottom Section, Supply | Page: 25 of 73 | Date: February 09, 2023 |


Depending on fan static pressure, (negative pressure side of the fan) additional height of the condensate drainage may be required. In order to achieve minimum water column height in water traps.

Positive Pressure Trap

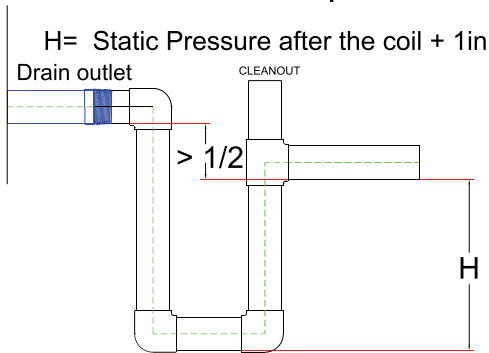


Drain Pan Connection 1" MPT

Negative Pressure Trap

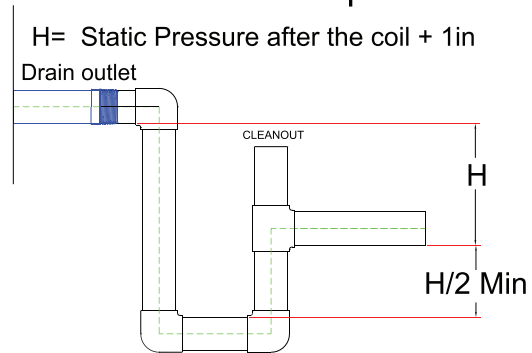

Drain Pan Connection 1" MPT



| | | |
|--|--|---|
| Project Name: UNCW King Hall – TRS NC; John Blakeney | VTS America Inc. 3535 Gravel Springs Rd. Extension, Suite 201, Buford, GA 30519 |  |
| Offer Code 11B.3/LIVE.USA/DW/2023-23 | Prepared for: THERMAL RESOURCE SALES - WILMINGTON 7215 OGDEN BUSINESS LANE, WILMINGTON,NC, 28411 | |
| Project Tag AHU-01 Bottom Section, Supply | Page: 26 of 73 | Date: February 09, 2023 |

2.2.3 **AHU-01 Bottom Section, Supply - Performance Data**

Supply tier

Mixing section

Mixing Box

Heating operations

| | |
|----------------------------|-----------------|
| Recirculation | 0 % |
| Supply inlet | 16.3 °F/13.5 °F |
| Exhaust inlet DBT/WBT | 32.0 °F/20.7 °F |
| Supply outlet DBT/WBT | 16.3 °F/13.5 °F |
| Sensible recovery capacity | 0.0 MBH |

Cooling operations

| | |
|----------------------------|-----------------|
| Recirculation | 0 % |
| Supply inlet | 94.3 °F/80.6 °F |
| Exhaust inlet DBT/WBT | 32.0 °F/20.7 °F |
| Supply outlet DBT/WBT | 94.3 °F/80.6 °F |
| Sensible recovery capacity | 0.0 MBH |

Resp_MixingChamber_Info_Name

Mixings

Set of Two Flat Filters

Type MERV8/2".Flat.Int.Sld

(ISO16890) - EFF CLASS E Flat[11.0]

Heating operations

| | |
|------------------------------|------------|
| 50% Dirty Air Pressure Drop | 0.58 in wg |
| Initial Air Pressure Drop | 0.18 in wg |
| 100% Dirty Air Pressure Drop | 0.98 in wg |
| Air velocity | 507 FPM |

Cooling operations

| | |
|------------------------------|------------|
| 50% Dirty Air Pressure Drop | 0.60 in wg |
| Initial Air Pressure Drop | 0.22 in wg |
| 100% Dirty Air Pressure Drop | 0.98 in wg |
| Air velocity | 509 FPM |

Air Filter Sizes

| | |
|--|-------------|
| P,FLT merv8 15,5 x 24,5 (1-2-0301-0091) | 3,000 x Pcs |
| P,FLT merv13 15,5 x 24,5 (1-2-0301-0100) | 3,000 x Pcs |

Type MERV13/4".Flat.Int.Sld

(ISO16890) - EFF CLASS E Flat[12.0]

Heating operations

| | |
|------------------------------|------------|
| 50% Dirty Air Pressure Drop | 0.62 in wg |
| Initial Air Pressure Drop | 0.26 in wg |
| 100% Dirty Air Pressure Drop | 0.98 in wg |
| Air velocity | 507 FPM |


Cooling operations

| | |
|------------------------------|------------|
| 50% Dirty Air Pressure Drop | 0.65 in wg |
| Initial Air Pressure Drop | 0.31 in wg |
| 100% Dirty Air Pressure Drop | 0.98 in wg |
| Air velocity | 509 FPM |

Air Filter Sizes

| | |
|---|-------------|
| P,FLT merv8 15,5 x 24,5 (1-2-0301-0091) | 3,000 x Pcs |
|---|-------------|



| | | |
|--|--|---|
| Project Name: UNCW King Hall – TRS NC; John Blakeney | VTS America Inc. 3535 Gravel Springs Rd. Extension, Suite 201, Buford, GA 30519 |  |
| Offer Code 11B.3/LIVE.USA/DW/2023-23 | Prepared for: THERMAL RESOURCE SALES - WILMINGTON 7215 OGDEN BUSINESS LANE, WILMINGTON,NC, 28411 | |
| Project Tag AHU-01 Bottom Section, Supply | Page: 27 of 73 | Date: February 09, 2023 |

P,FLT merv13 15,5 x 24,5 (1-2-0301- 3,000 x Pcs 0100)

Hot Water Coil

Type WCL AVS030 1R DT SH.St.St.Std **Number of rows** 1 **Connection Supply/Return:** 1 1/4" - 11 1/2 NPT/1 1/4" - 11 1/2 NPT

| | | | |
|------------------------|-------------------|-----------------------------|-------------------|
| Medium | Water | Maximum working pressure | 246 PSIG |
| Intake air DBT / WBT | 45.0 °F / 35.0 °F | Discharge air DBT / WBT | 60.0 °F / 43.0 °F |
| Air velocity | 471 FPM | Pressure drop Wet / Dry Wet | 0.09 in wg |
| Total heating capacity | 53.4 MBH | Medium temperature | 130.0 °F/100.0 °F |
| Medium flow rate | 3.56 GPM | Medium pressure drop | 0.703 ft wg |

Hot Water Coild Additional Info

Rows: 1
 Coils tube: 1/2"
 Coil volume in cubic inches: 189.2
 Finned Length: 3' 5 5/16" (1050mm)
 Finned Height: 1' 10 1/2"(572mm)
 Coil Connection: 1 1/4"-111/2 NPT
 Coil casing material: galvanized steel
 Single Coil

Empty section

Type EMP.SEC AVS030 Medium

Heating operations

Pressure drop
 Air velocity 498 FPM

Cooling operations

Pressure drop
 Air velocity 539 FPM

Resp_EmptySection_Info_Name

EmptySections


Chilled Water Coil

Type WCL AVS030 8R DT SH.St.Ss.Std **Number of rows** 8 **Connection Supply/Return:** 2" - 11 1/2 NPT/2" - 11 1/2 NPT

HIGH PERFORMANCE COIL AVS030_WCL_8 High Performance, Stainless Steel Casing WCL AVS030 8R

| | | | |
|------------------------------------|--------------------|------------------------------------|-------------------------|
| Medium | Water | Maximum working pressure | 246 PSIG |
| Intake air DBT / WBT | 75.2 °F / 63.2 °F | Discharge air DBT / WBT | 52.0 °F / 51.0 °F |
| Air velocity | 486 FPM | Pressure drop Wet / Dry Wet / Dry | 0.76 in wg / 0.56 in wg |
| Cooling capacity: Sensible / Total | 83.7 MBH/114.4 MBH | Medium temperature: Inlet / Outlet | 42.0 °F/60.0 °F |
| Medium flow rate | 12.65 GPM | Medium pressure drop | 3.119 ft wg |




| | | |
|--|--|---|
| Project Name: UNCW King Hall – TRS NC; John Blakeney | VTS America Inc. 3535 Gravel Springs Rd. Extension, Suite 201, Buford, GA 30519 |  |
| Offer Code 11B.3/LIVE.USA/DW/2023-23 | Prepared for: THERMAL RESOURCE SALES - WILMINGTON 7215 OGDEN BUSINESS LANE, WILMINGTON,NC, 28411 | |
| Project Tag AHU-01 Bottom Section, Supply | Page: 28 of 73 | Date: February 09, 2023 |



Chilled water cooler Additional Info


Rows: 8
 Coils tube: 1/2"
 Coil volume in cubic inches: 1150.3
 Finned Length: 3' 5 5/16" (1050mm)
 Finned Height: 1' 10 1/2"(572mm)
 Coil Connection: 2"-111/2 NPT
 Drain pan made of stainless steel
 Single Coil



| | | |
|--|---|---|
| Project Name: UNCW King Hall – TRS NC; John Blakeney | VTS America Inc. 3535 Gravel Springs Rd. Extension, Suite 201, Buford, GA 30519 |  |
| Offer Code 11B.3/LIVE.USA/DW/2023-23 | Prepared for: THERMAL RESOURCE SALES - WILMINGTON 7215 OGDEN BUSINESS LANE, WILMINGTON, NC, 28411 | |
| Project Tag AHU-01 Bottom Section, Supply | Page: 29 of 73 | Date: February 09, 2023 |

2.2.4 **Moist Air Processes**

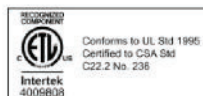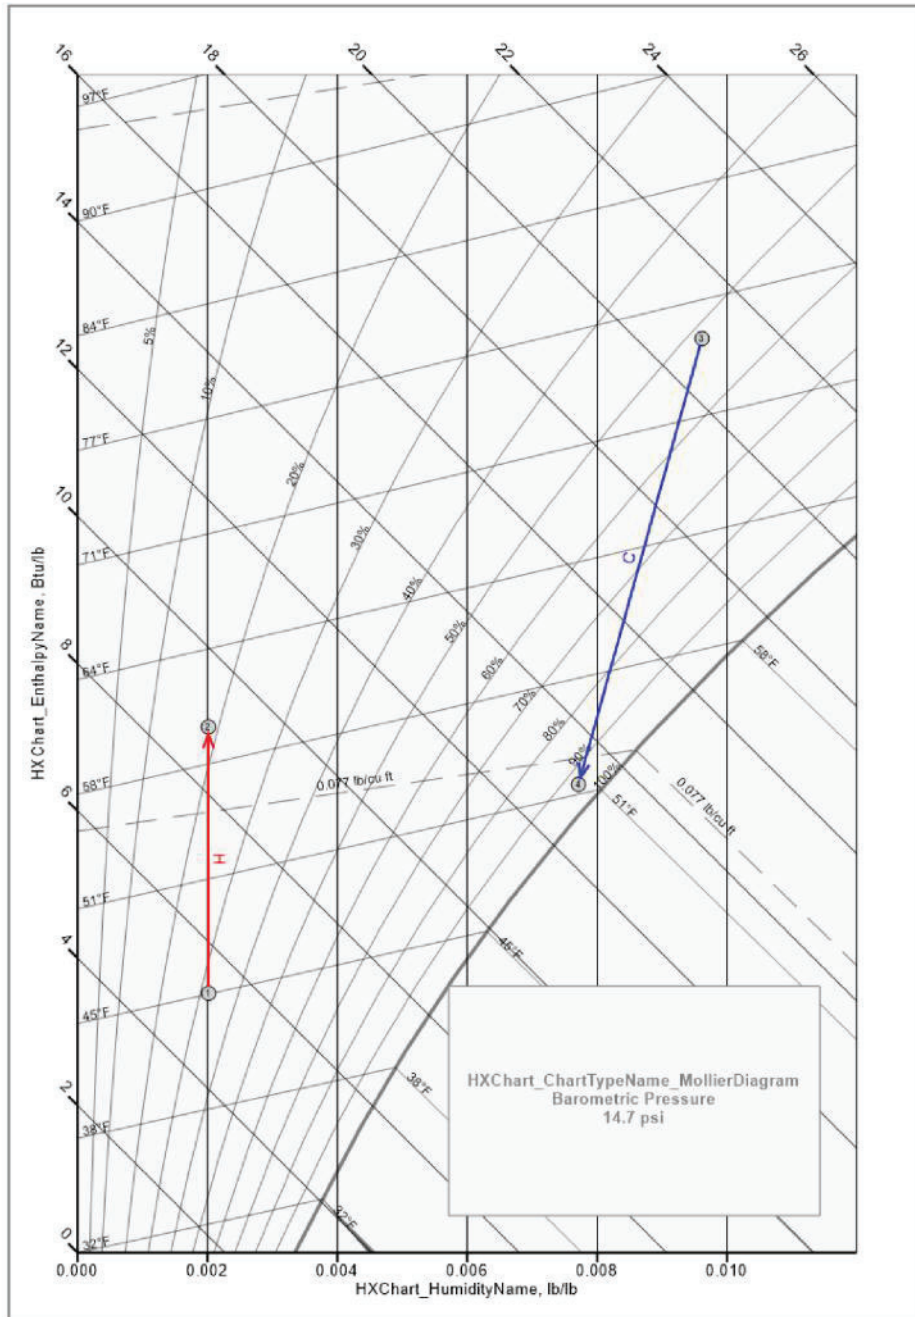

| | | |
|--|--|---|
| Project Name: UNCW King Hall – TRS NC; John Blakeney | VTS America Inc. 3535 Gravel Springs Rd. Extension, Suite 201, Buford, GA 30519 |  |
| Offer Code 11B.3/LIVE.USA/DW/2023-23 | Prepared for: THERMAL RESOURCE SALES - WILMINGTON 7215 OGDEN BUSINESS LANE, WILMINGTON,NC, 28411 | |
| Project Tag AHU-02 Top Section, Supply | Page: 30 of 73 | Date: February 09, 2023 |

2.3 AHU-02 Top Section, Supply

2.3.1 General AHU Data

| | | | |
|----------------------------|---------------------------|-----------------------------|----------------------|
| AHU Tag | AHU-02 Top Section | AHU Size | AVS055 |
| Application | Execution: Indoor | AHU Set | AVS055-L-EV |
| AHU Type | Supply unit | Width | 66.1 in |
| Insulation Thickness | 2.0 in | AHU Support | AHU Support Type1 |
| Insulation | PUR | AHU Support Height | 3.5 in |
| Weight | 665 lb | Shipping Sections | 2 |
| Elevation | 0 ft | Coil Connection Side | Left Hand Side (LHS) |
| Total length | 87.6 in | | |
| Fan Section Voltage | 460/3/60 V/ph/Hz | | |
| Unit Execution Side | Left Hand Side (LHS) | | |

Supply

| | |
|-------------------|-------------|
| AirFlow | 5500.00 CFM |
| External Pressure | 0.00 in wg |
| Calculation Mode | Real |

Fan Section

| | | | |
|-------------------|--------|----------|--------|
| Motor Rated Power | 7,5 HP | Impeller | VS 560 |
|-------------------|--------|----------|--------|

Empty Section

| | |
|-----------------------|-----------------------|
| EMP.SEC AVS055 Medium | EMP.SEC AVS055 Medium |
|-----------------------|-----------------------|

AHU Discharge and Intake Opening Sizes & Unit Accessories


Controls Selection Mode : No controls


| | |
|---|-------------------------|
| AHU Discharge and Intake Opening Sizes | Supply |
| Air Inlet | Front (Small) 47.2x22.6 |
| Air Outlet | Top 52.8x27.4 |

Unit Another Accessories


| | |
|-----------------------|------------|
| Internal Marine Light | Quantity 2 |
| Hinged Access | Quantity 1 |

2.3.2 AHU-02 Top Section, Supply - Dimensions, media connection points

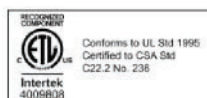



| | | |
|--|---|---|
| Project Name: UNCW King Hall – TRS NC; John Blakeney | VTS America Inc. 3535 Gravel Springs Rd. Extension, Suite 201, Buford, GA 30519 |  |
| Offer Code 11B.3/LIVE.USA/DW/2023-23 | Prepared for: THERMAL RESOURCE SALES - WILMINGTON 7215 OGDEN BUSINESS LANE, WILMINGTON, NC, 28411 | |
| Project Tag AHU-02 Top Section, Supply | Page: 31 of 73 | Date: February 09, 2023 |

Inspection side

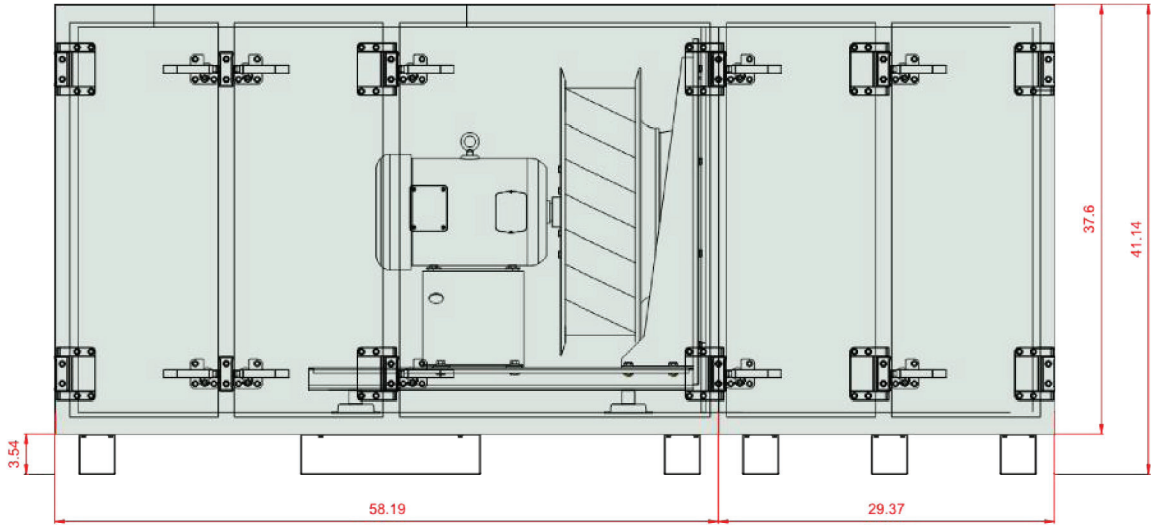



Top View

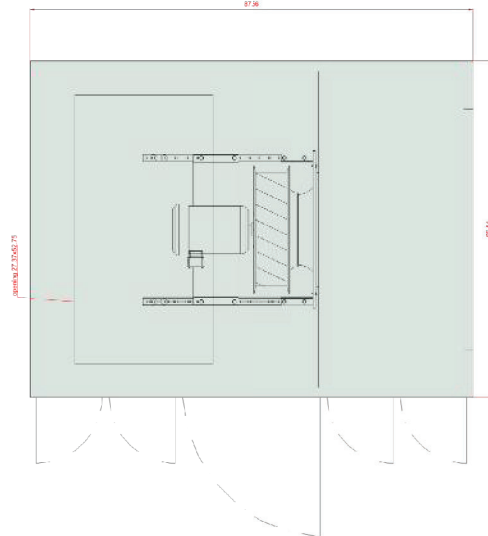



| | | |
|--|---|---|
| Project Name: UNCW King Hall – TRS NC; John Blakeney | VTS America Inc. 3535 Gravel Springs Rd. Extension, Suite 201, Buford, GA 30519 |  |
| Offer Code 11B.3/LIVE.USA/DW/2023-23 | Prepared for: THERMAL RESOURCE SALES - WILMINGTON 7215 OGDEN BUSINESS LANE, WILMINGTON, NC, 28411 | |
| Project Tag AHU-02 Top Section, Supply | Page: 32 of 73 | Date: February 09, 2023 |


End - Front Openings

End - Back Openings

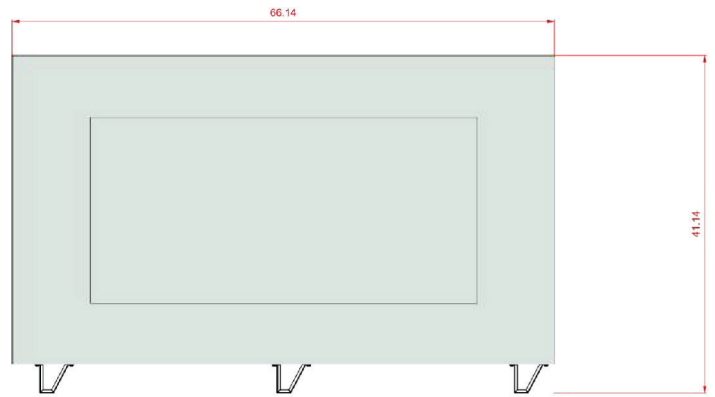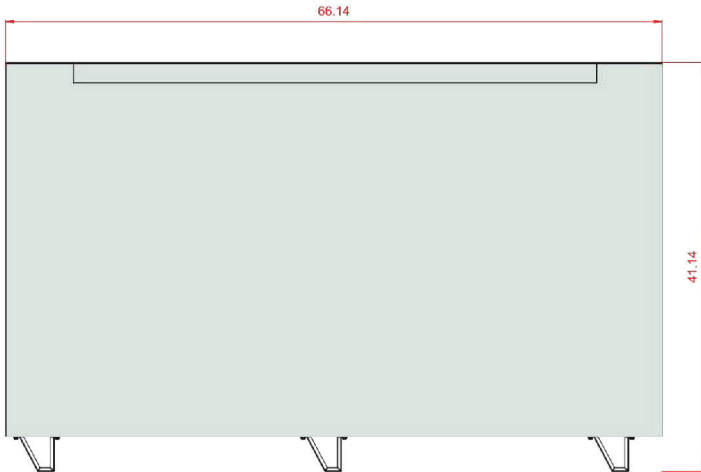


Coil Connections - Inspection side view

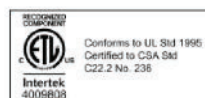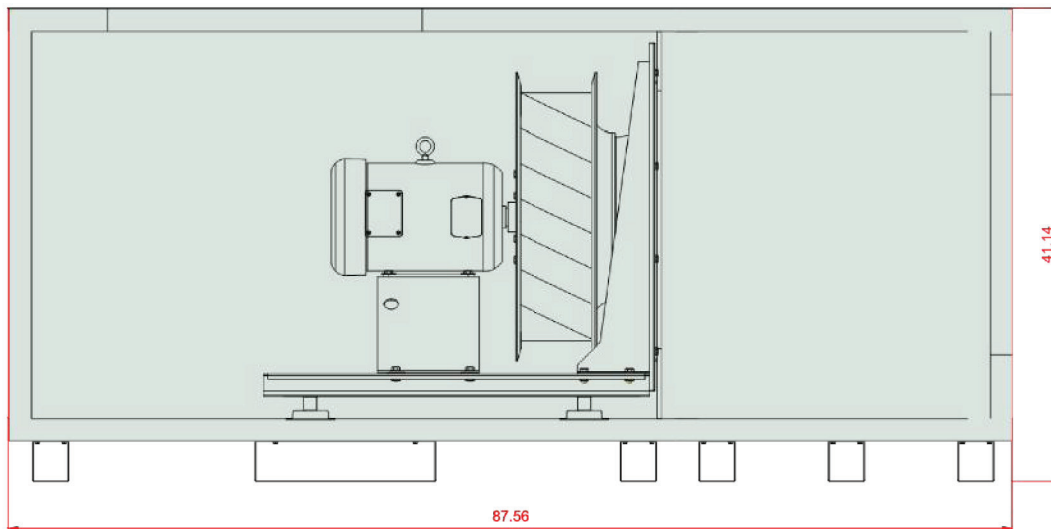


| | | |
|--|---|---|
| Project Name: UNCW King Hall – TRS NC; John Blakeney | VTS America Inc. 3535 Gravel Springs Rd. Extension, Suite 201, Buford, GA 30519 |  |
| Offer Code 11B.3/LIVE.USA/DW/2023-23 | Prepared for: THERMAL RESOURCE SALES - WILMINGTON 7215 OGDEN BUSINESS LANE, WILMINGTON, NC, 28411 | |
| Project Tag AHU-02 Top Section, Supply | Page: 33 of 73 | Date: February 09, 2023 |


Coil connection rules

Coil dimensions

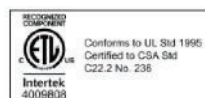


| | | |
|--|---|---|
| Project Name: UNCW King Hall – TRS NC; John Blakeney | VTS America Inc. 3535 Gravel Springs Rd. Extension, Suite 201, Buford, GA 30519 |  |
| Offer Code 11B.3/LIVE.USA/DW/2023-23 | Prepared for: THERMAL RESOURCE SALES - WILMINGTON 7215 OGDEN BUSINESS LANE, WILMINGTON, NC, 28411 | |
| Project Tag AHU-02 Top Section, Supply | Page: 34 of 73 | Date: February 09, 2023 |


Coil Connections - Top View

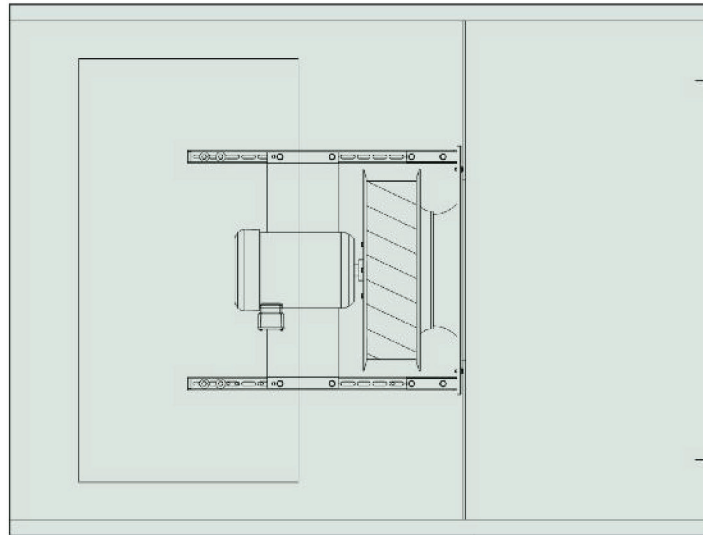


Sections split for transportation

| Section number | Section weight [lb] | Section length [in] | Section width [in] | Section height [in] |
|----------------|---------------------|---------------------|--------------------|---------------------|
| 1 | 162 | 29.4 | 66.1 | 41.1 |
| 2 | 481 | 58.2 | 66.1 | 41.1 |

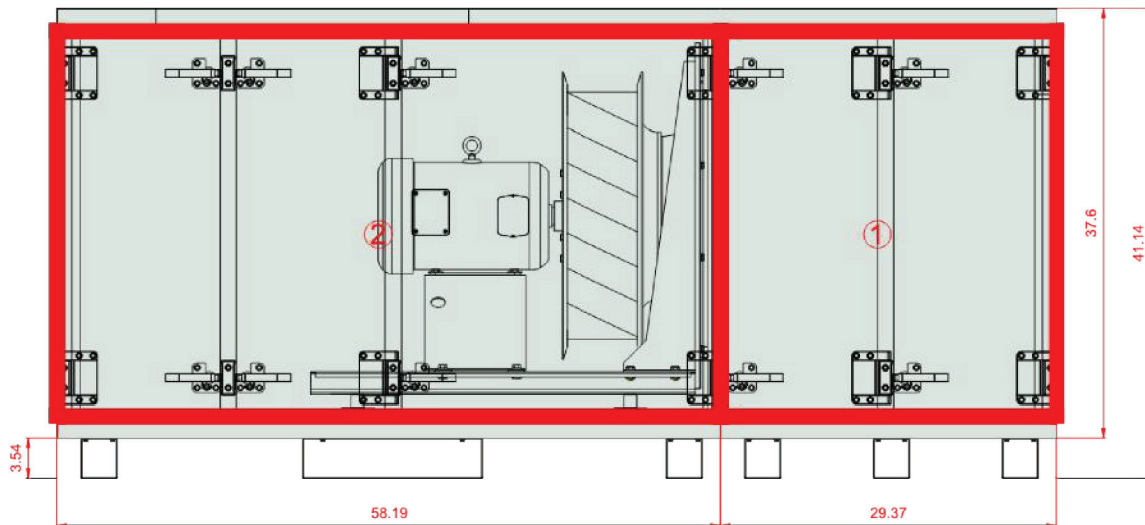

| | | |
|--|---|---|
| Project Name: UNCW King Hall – TRS NC; John Blakeney | VTS America Inc. 3535 Gravel Springs Rd. Extension, Suite 201, Buford, GA 30519 |  |
| Offer Code 11B.3/LIVE.USA/DW/2023-23 | Prepared for: THERMAL RESOURCE SALES - WILMINGTON 7215 OGDEN BUSINESS LANE, WILMINGTON, NC, 28411 | |
| Project Tag AHU-02 Top Section, Supply | Page: 35 of 73 | Date: February 09, 2023 |


Top view - Service space

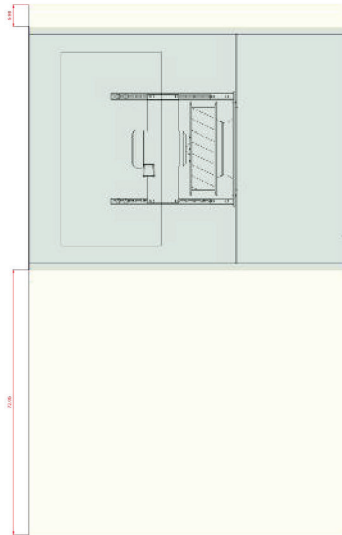


The AHU installation clearance is defined by:

- Non-Access Side – minimum space required for unit operation or coil connection
- Access Side – minimum space require allowing opening access door to a position perpendicular to the direction of Air Flow, and removal of side load filter
- Clearance for VFD's, or other high-voltage devices must be provided per NEC requirements
- Clearance for coil removal must be provided per coil drawing through the access side of the unit


Frame Top View, within the AHU outline contour

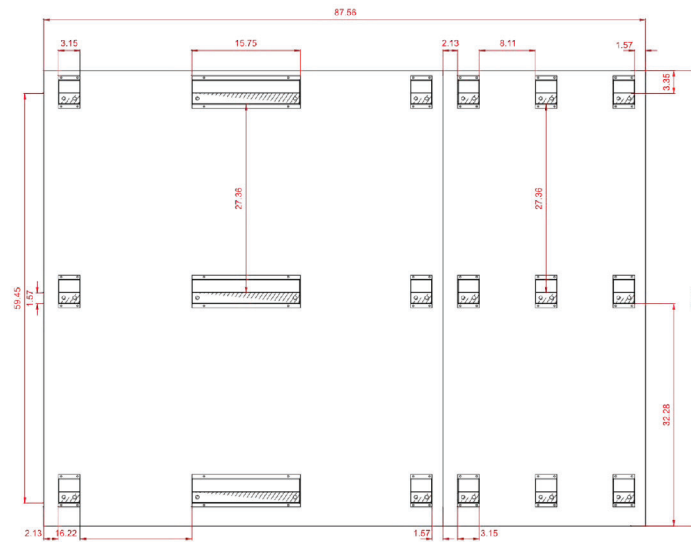


| | | |
|--|---|---|
| Project Name: UNCW King Hall – TRS NC; John Blakeney | VTS America Inc. 3535 Gravel Springs Rd. Extension, Suite 201, Buford, GA 30519 |  |
| Offer Code 11B.3/LIVE.USA/DW/2023-23 | Prepared for: THERMAL RESOURCE SALES - WILMINGTON 7215 OGDEN BUSINESS LANE, WILMINGTON, NC, 28411 | |
| Project Tag AHU-02 Top Section, Supply | Page: 36 of 73 | Date: February 09, 2023 |

2.3.3 AHU-02 Top Section, Supply - Drawings – AHU Sections Shipping Details , Supply

Fan Section Electric Connections

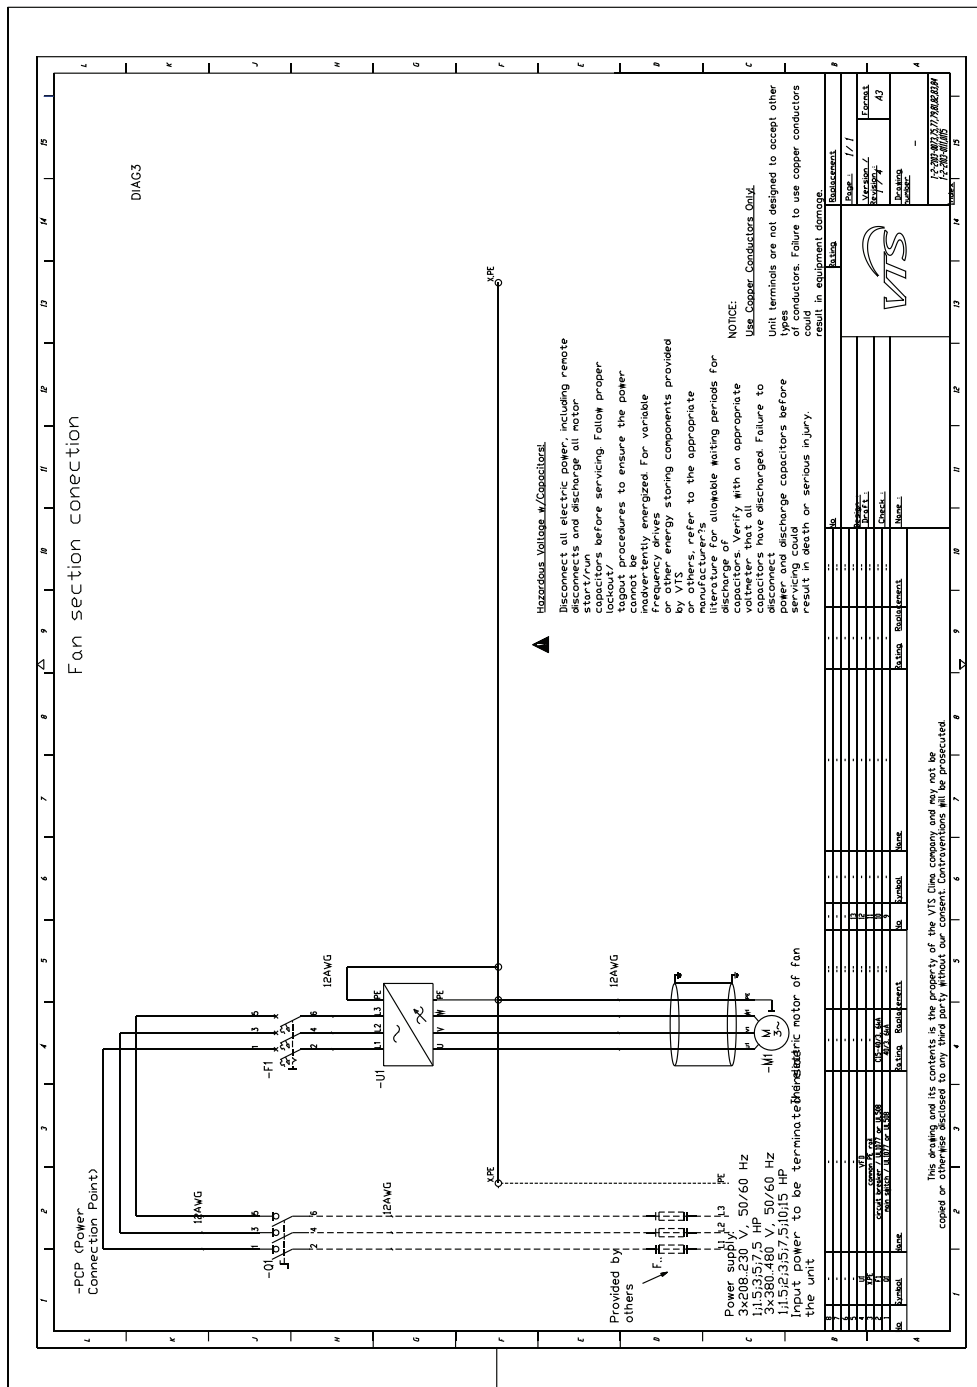

| | | |
|--|---|---|
| Project Name: UNCW King Hall – TRS NC; John Blakeney | VTS America Inc. 3535 Gravel Springs Rd. Extension, Suite 201, Buford, GA 30519 |  |
| Offer Code 11B.3/LIVE.USA/DW/2023-23 | Prepared for: THERMAL RESOURCE SALES - WILMINGTON 7215 OGDEN BUSINESS LANE, WILMINGTON, NC, 28411 | |
| Project Tag AHU-02 Top Section, Supply | Page: 37 of 73 | Date: February 09, 2023 |

2.3.4 AHU-02 Top Section, Supply - Performance Data

Supply tier

Empty section

Type EMP.SEC AVS055 Medium

Heating operations

Pressure drop

Air velocity 476 FPM

Cooling operations

Pressure drop

Air velocity 562 FPM

Resp_EmptySection_Info_Name

EmptySections

Plug-Fan Set

Fan Section PLUG_DD_560_7,50_4

| | | | |
|-----------------------|---------------|----------------|--|
| Fan Set Assembly Type | FLX1 (Gasket) | Qty in section | x 1 |
| | | Air Standard | Calculations made for real air density |

Fan Set Designed for wet operating conditions

The fan system effects is taken into account in the fan performances.

Fan PLUG_VS_560_AF_Px 1

| | | | |
|-----------------------|------------|-------------------------------------|-------------|
| Total Static Pressure | 5.50 in wg | Impeller efficiency: Static / Total | 71 %/73 % |
| Dynamic pressure | 0.22 in wg | Shaft power | 7.26 HP x 1 |
| External pressure | 5.44 in wg | Working revolutions | 1924 rpm |
| Total Pressure | 5.72 in wg | | |

Fan Additional Info

Fan Type: Direct Driven Plenum Fan


Fan Wheel Diameter: 560 [mm]


Vibro-Acoustics Insulation: Rubber-in-Shear Floor Mounted Isolator

Motor AC_Premium Eff._F_213T_TEFC_4p_7.5_60x 1

460V 60Hz

| | | | |
|-------------------------------------|--------|--------------------------------------|-----------|
| FLA | 9.5 A | MCA | 11.9 A |
| MCB | 15.0 A | Maximum Overcurrent Protection (MOP) | 21.4 A |
| Short-Circuit Current Rating (SCCR) | 6.0 kA | | |
| Motor enclosure | TEFC | Rated Current | 9.5 A x 1 |
| IEC Size | 213T | Rated revolutions | 1770 rpm |

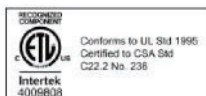

| | | |
|--|--|---|
| Project Name: UNCW King Hall – TRS NC; John Blakeney | VTS America Inc. 3535 Gravel Springs Rd. Extension, Suite 201, Buford, GA 30519 |  |
| Offer Code 11B.3/LIVE.USA/DW/2023-23 | Prepared for: THERMAL RESOURCE SALES - WILMINGTON 7215 OGDEN BUSINESS LANE, WILMINGTON,NC, 28411 | |
| Project Tag AHU-02 Top Section, Supply | Page: 38 of 73 | Date: February 09, 2023 |

| | | | |
|---------------------|------------------|---------------|--------------------|
| Operational Voltage | 460 V/3 ph | Rated Power | 7.50 HP x 1 |
| Name plate RPM | 460 V/3 ph/60 Hz | Motor Version | V-Series |

Electric Motor Additional Info

Supplier: Baldor
Motor poles: 4

VFD BY OTHERS

| | | | |
|--------------------|----------|---------------------------|-----------------------|
| VFD | Required | Connecting Point | CP Provided by others |
| VFD Qty in section | 1 | VFD Voltage Supply | 460/3/60 V/ph/Hz |
| VFD Settings | 65 Hz | VFD Rated Power | 7.50 HP x 1 |
| VFD in selection | Excluded | VFD HMI | No |
| | | VFD 1PH ModBus Comm Board | No |

Acoustic data

| Frequency | | 63 Hz | 125 Hz | 250 Hz | 500 Hz | 1000 Hz | 2000 Hz | 4000 Hz | 8000 Hz | Lw dB(A) |
|------------------------|----|-------|--------|--------|--------|---------|---------|---------|---------|----------|
| Intake | dB | 77,3 | 82,2 | 88,7 | 89,3 | 86,1 | 82,9 | 78,1 | 74,2 | 94 |
| Outlet | dB | 79,3 | 84,2 | 90,7 | 91,3 | 88,1 | 84,9 | 80,1 | 76,2 | 96 |
| Environment | dB | 57,4 | 72,7 | 77,3 | 77,3 | 74,4 | 71,4 | 50,6 | 37,7 | 82,2 |
| Sound Pressure* | dB | 44,1 | 65,7 | 70,3 | 70,3 | 67,4 | 64,4 | 43,6 | 30,7 | 75,2 |

(*) Approximate data of sound pressure


2.3.5 AHU-02 Top Section, Supply - Fan Performance Data, Supply

| | |
|---------------------------|-------------|
| Number of fans in section | 1 |
| Airflow per Fan | 5802.17 CFM |
| Total Pressure Increase | 5.72 in wg |
| Static pressure | 5.50 in wg |
| External pressure | 5.44 in wg |
| Velocity Pressure | 0.22 in wg |
| Static Efficiency | 71 % |
| Total Efficiency | 73 % |
| Shaft Power | 7.26 HP |
| Fan revolutions | 1924 rpm |
| VFD Setting | 65 Hz |
| Acoustic Power Level | 82,2 dB |
| Acoustic Pressure Level | 75,2 dB |

Internal Pressure Drop


| | |
|------------|--|
| Function | Pressure Drop |
| | Pressure Drop in Winter (at 50% Dirty Filters) |
| All | 0.07 in wg |





| | | |
|--|---|---|
| Project Name: UNCW King Hall – TRS NC; John Blakeney | VTS America Inc. 3535 Gravel Springs Rd. Extension, Suite 201, Buford, GA 30519 |  |
| Offer Code 11B.3/LIVE.USA/DW/2023-23 | Prepared for: THERMAL RESOURCE SALES - WILMINGTON 7215 OGDEN BUSINESS LANE, WILMINGTON, NC, 28411 | |
| Project Tag AHU-02 Top Section, Supply | Page: 39 of 73 | Date: February 09, 2023 |

| | |
|---------------|------------|
| Inlet | 0.03 in wg |
| Empty Section | 0.02 in wg |
| Outlet | 0.02 in wg |



| | | |
|--|---|---|
| Project Name: UNCW King Hall – TRS NC; John Blakeney | VTS America Inc. 3535 Gravel Springs Rd. Extension, Suite 201, Buford, GA 30519 |  |
| Offer Code 11B.3/LIVE.USA/DW/2023-23 | Prepared for: THERMAL RESOURCE SALES - WILMINGTON 7215 OGDEN BUSINESS LANE, WILMINGTON, NC, 28411 | |
| Project Tag AHU-02 Top Section, Supply | Page: 40 of 73 | Date: February 09, 2023 |

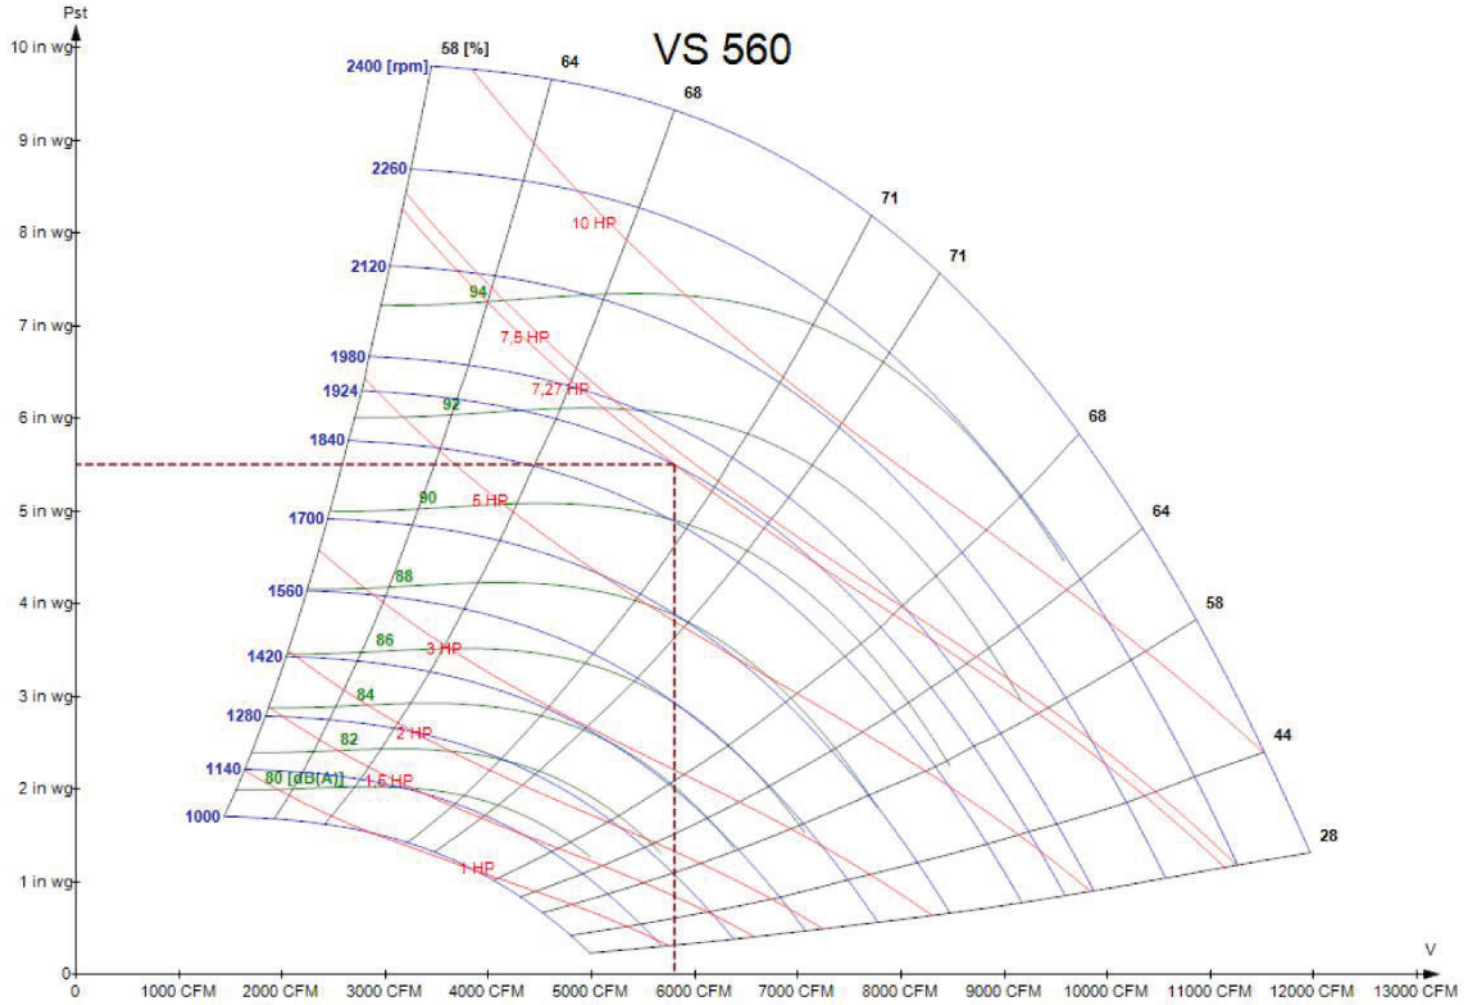

| | | |
|--|---|---|
| Project Name: UNCW King Hall – TRS NC; John Blakeney | VTS America Inc. 3535 Gravel Springs Rd. Extension, Suite 201, Buford, GA 30519 |  |
| Offer Code 11B.3/LIVE.USA/DW/2023-23 | Prepared for: THERMAL RESOURCE SALES - WILMINGTON 7215 OGDEN BUSINESS LANE, WILMINGTON, NC, 28411 | |
| Project Tag AHU-02 Bottom Section, Supply | Page: 41 of 73 | Date: February 09, 2023 |

2.4 AHU-02 Bottom Section, Supply

2.4.1 General AHU Data

| | | | |
|----------------------------|------------------------------|-----------------------------|--------------------------|
| AHU Tag | AHU-02 Bottom Section | AHU Size | AVS055 |
| Application | Execution: Indoor | AHU Set | AVS055-R-MFHEC |
| AHU Type | Supply unit | Width | 66.1 in |
| Insulation Thickness | 2.0 in | AHU Support | AHU Support Type1 |
| Insulation | PUR | AHU Support Height | 8.0 in |
| Weight | 1191 lb | Shipping Sections | 3 |
| Elevation | 0 ft | | |
| Total length | 116.4 in | | |
| Unit Execution Side | Right Hand Side (RHS) | Coil Connection Side | Right Hand Side (RHS) |

Supply

| | |
|-------------------|-------------|
| AirFlow | 5500.00 CFM |
| External Pressure | 0.00 in wg |
| Calculation Mode | Real |

Mixing

Mixing Section

Coils

| | | | |
|------------------|---------|----------------------|-------------------------------|
| Hot Water Heater | Rows: 2 | Chilled Water Cooler | Rows: 8 HIGH PERFORMANCE COIL |
|------------------|---------|----------------------|-------------------------------|

Filters

| | |
|-----------------------|-----------------------|
| MERV8/2".Flat.Int.Sld | MERV8/2".Flat.Int.Sld |
|-----------------------|-----------------------|

Empty Section

| | |
|-----------------------|-----------------------|
| EMP.SEC AVS055 Medium | EMP.SEC AVS055 Medium |
|-----------------------|-----------------------|

AHU Discharge and Intake Opening Sizes & Unit Accessories


Controls Selection Mode : Air damper actuator

| | |
|---|-------------------------|
| AHU Discharge and Intake Opening Sizes | Supply |
| Air Inlet | Front (Small) 47.2x22.6 |
| Air Inlet (2nd) | Top 47.2x22.6 |
| Air Outlet | Front (Small) 47.2x22.6 |
| Air Damper | Supply |
| Air Inlet | Provided with Actuators |
| Air Inlet (2nd) | Provided with Actuators |

Unit Another Accessories

| | |
|-----------------------|------------|
| Round View Window | Quantity 1 |
| Internal Marine Light | Quantity 3 |
| Hinged Access | Quantity 1 |
| UV Lamp | Quantity 1 |




| | | |
|--|---|---|
| Project Name: UNCW King Hall – TRS NC; John Blakeney | VTS America Inc. 3535 Gravel Springs Rd. Extension, Suite 201, Buford, GA 30519 |  |
| Offer Code 11B.3/LIVE.USA/DW/2023-23 | Prepared for: THERMAL RESOURCE SALES - WILMINGTON 7215 OGDEN BUSINESS LANE, WILMINGTON, NC, 28411 | |
| Project Tag AHU-02 Bottom Section, Supply | Page: 42 of 73 | Date: February 09, 2023 |

Differential Pressure Gauge
Rails


Quantity 2
Quantity 1


2.4.2 AHU-02 Bottom Section, Supply - Dimensions, media connection points

Inspection side


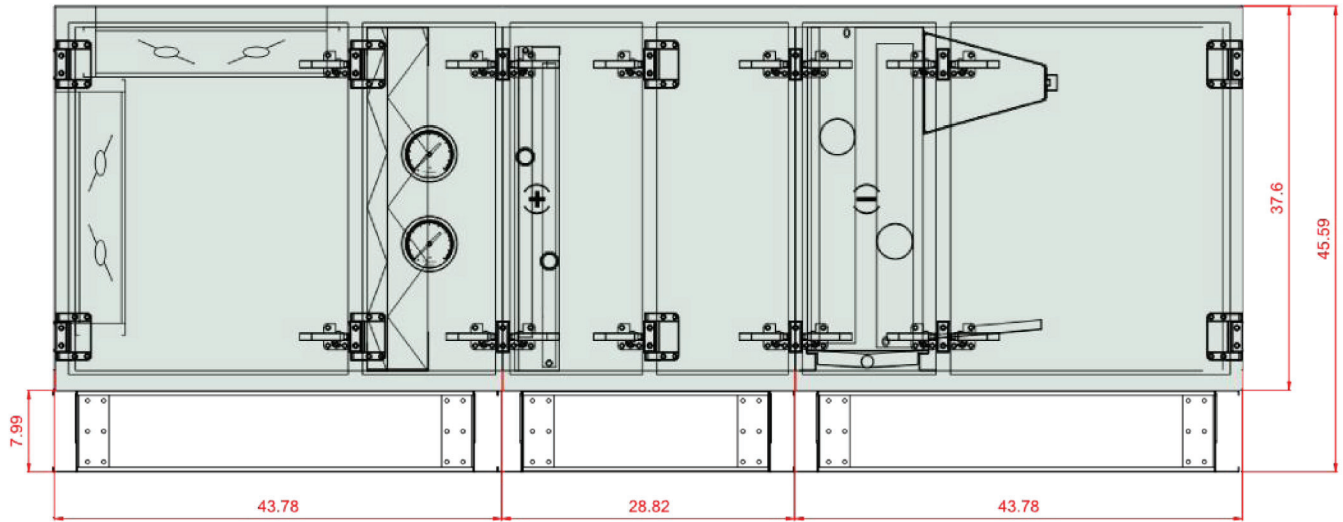


Top View


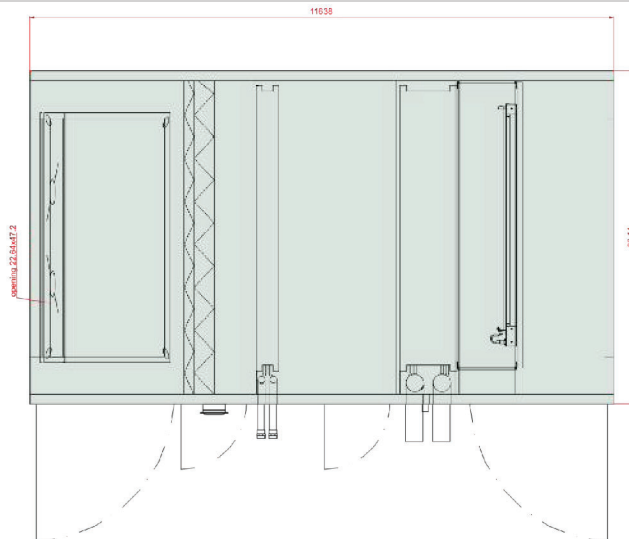



| | | |
|--|---|---|
| Project Name: UNCW King Hall – TRS NC; John Blakeney | VTS America Inc. 3535 Gravel Springs Rd. Extension, Suite 201, Buford, GA 30519 |  |
| Offer Code 11B.3/LIVE.USA/DW/2023-23 | Prepared for: THERMAL RESOURCE SALES - WILMINGTON 7215 OGDEN BUSINESS LANE, WILMINGTON, NC, 28411 | |
| Project Tag AHU-02 Bottom Section, Supply | Page: 43 of 73 | Date: February 09, 2023 |

End - Front Openings **End - Back Openings**

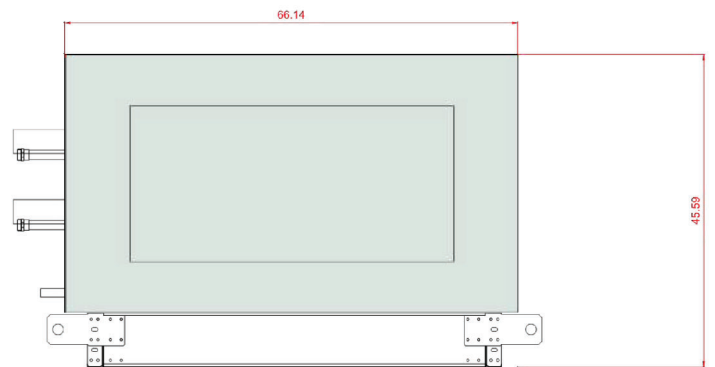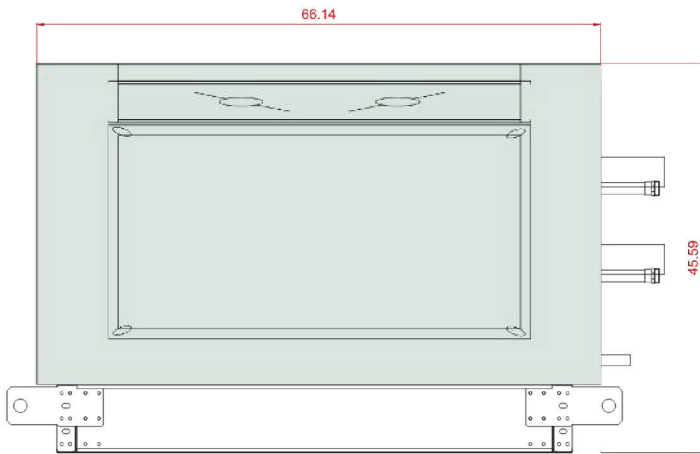


Coil Connections - Inspection side view

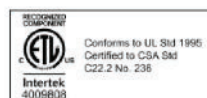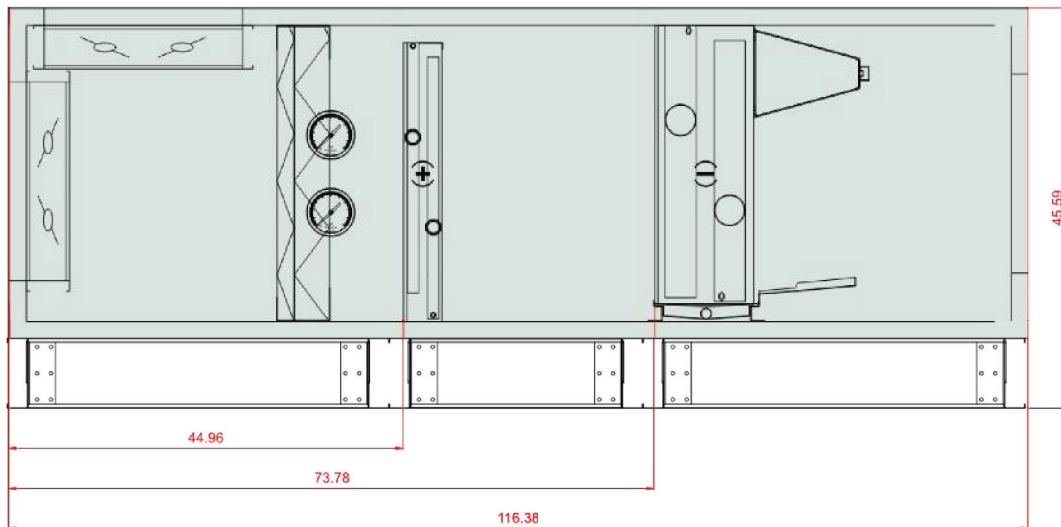

| | | |
|--|---|---|
| Project Name: UNCW King Hall – TRS NC; John Blakeney | VTS America Inc. 3535 Gravel Springs Rd. Extension, Suite 201, Buford, GA 30519 |  |
| Offer Code 11B.3/LIVE.USA/DW/2023-23 | Prepared for: THERMAL RESOURCE SALES - WILMINGTON 7215 OGDEN BUSINESS LANE, WILMINGTON, NC, 28411 | |
| Project Tag AHU-02 Bottom Section, Supply | Page: 44 of 73 | Date: February 09, 2023 |



Coil connection rules

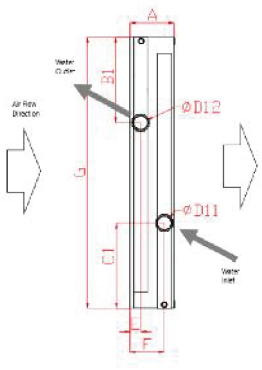


Coil dimensions


H_hw_2[11]SHIN

C_cw_8[11]SHIN

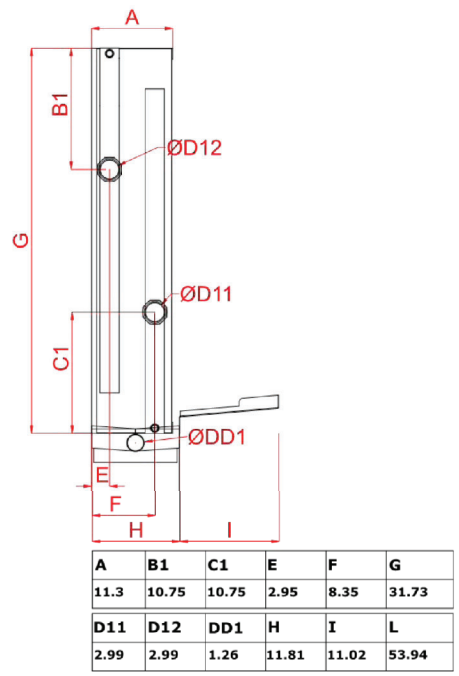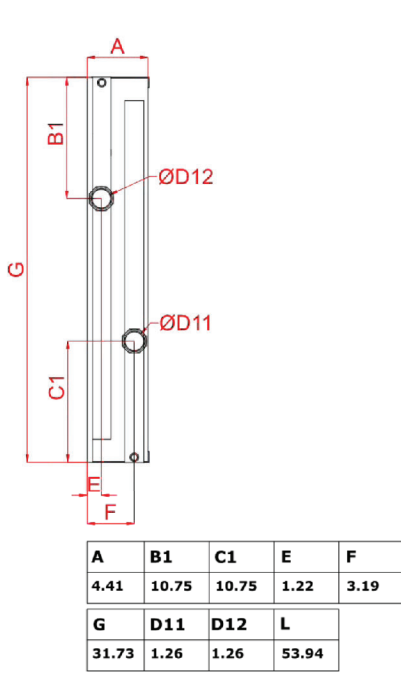



| | | |
|--|---|---|
| Project Name: UNCW King Hall – TRS NC; John Blakeney | VTS America Inc. 3535 Gravel Springs Rd. Extension, Suite 201, Buford, GA 30519 |  |
| Offer Code 11B.3/LIVE.USA/DW/2023-23 | Prepared for: THERMAL RESOURCE SALES - WILMINGTON 7215 OGDEN BUSINESS LANE, WILMINGTON, NC, 28411 | |
| Project Tag AHU-02 Bottom Section, Supply | Page: 45 of 73 | Date: February 09, 2023 |


Coil Connections - Top View

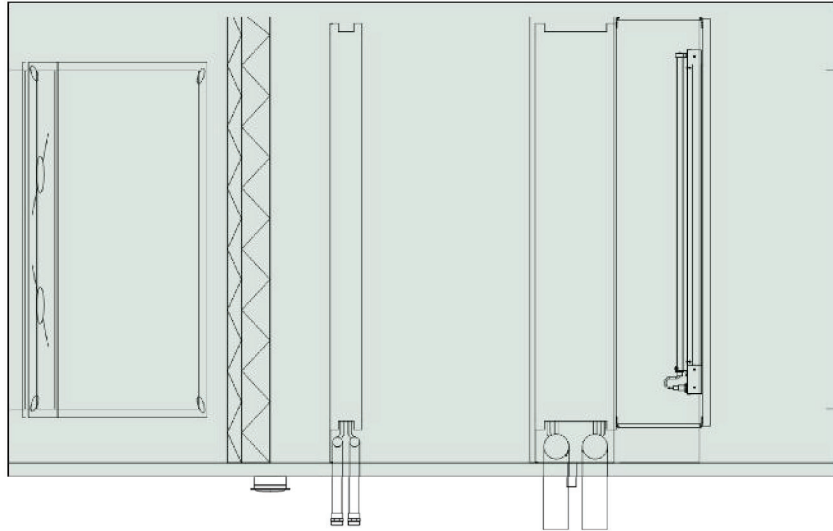


Sections split for transportation

| Section number | Section weight [lb] | Section length [in] | Section width [in] | Section height [in] |
|----------------|---------------------|---------------------|--------------------|---------------------|
| 1 | 394 | 43.8 | 66.1 | 45.6 |
| 2 | 232 | 28.8 | 66.1 | 45.6 |
| 3 | 506 | 43.8 | 66.1 | 45.6 |

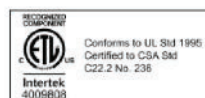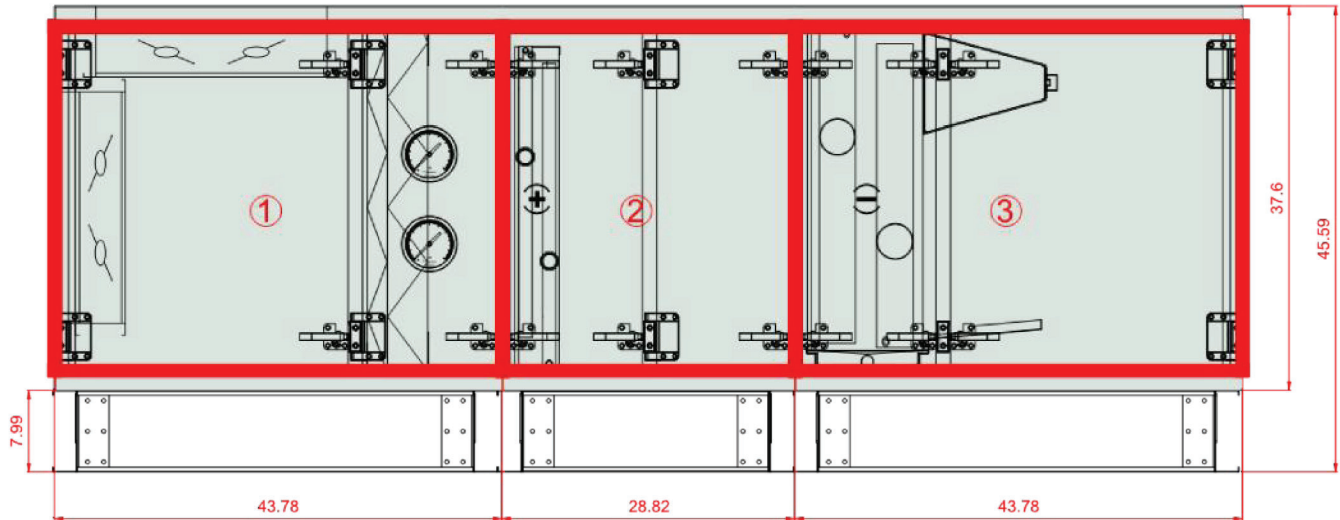

| | | |
|--|---|---|
| Project Name: UNCW King Hall – TRS NC; John Blakeney | VTS America Inc. 3535 Gravel Springs Rd. Extension, Suite 201, Buford, GA 30519 |  |
| Offer Code 11B.3/LIVE.USA/DW/2023-23 | Prepared for: THERMAL RESOURCE SALES - WILMINGTON 7215 OGDEN BUSINESS LANE, WILMINGTON, NC, 28411 | |
| Project Tag AHU-02 Bottom Section, Supply | Page: 46 of 73 | Date: February 09, 2023 |



Top view - Service space

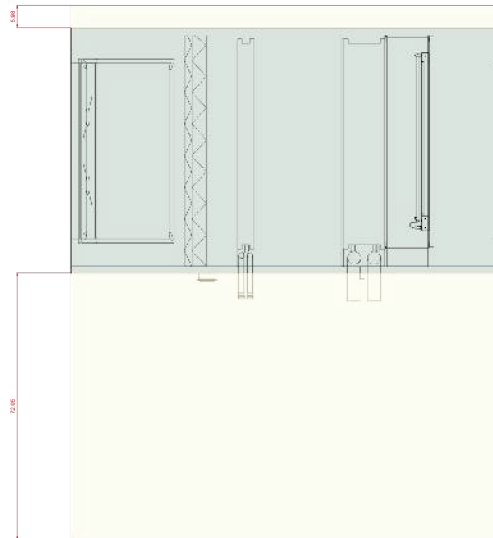


The AHU installation clearance is defined by:

- Non-Access Side – minimum space required for unit operation or coil connection
- Access Side – minimum space require allowing opening access door to a position perpendicular to the direction of Air Flow, and removal of side load filter
- Clearance for VFD's, or other high-voltage devices must be provided per NEC requirements
- Clearance for coil removal must be provided per coil drawing through the access side of the unit


Frame Top View, within the AHU outline contour

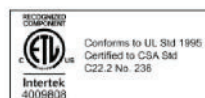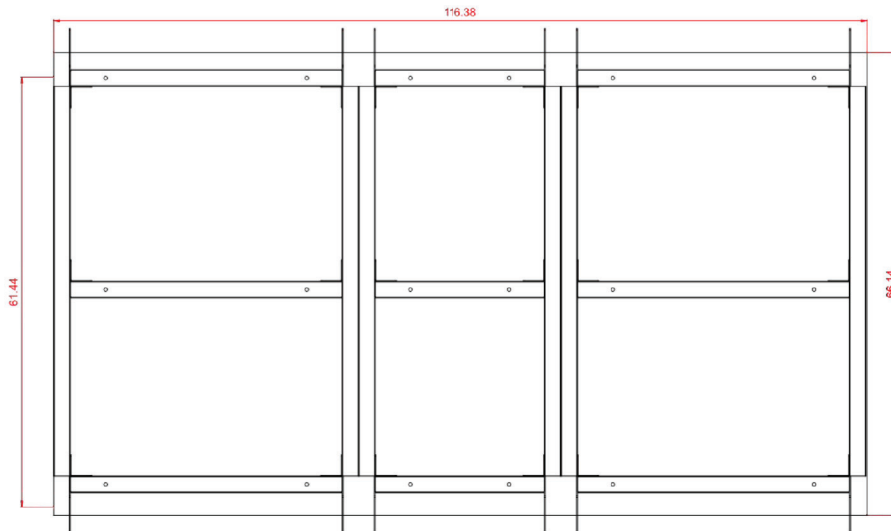

| | | |
|--|---|---|
| Project Name: UNCW King Hall – TRS NC; John Blakeney | VTS America Inc. 3535 Gravel Springs Rd. Extension, Suite 201, Buford, GA 30519 |  |
| Offer Code 11B.3/LIVE.USA/DW/2023-23 | Prepared for: THERMAL RESOURCE SALES - WILMINGTON 7215 OGDEN BUSINESS LANE, WILMINGTON, NC, 28411 | |
| Project Tag AHU-02 Bottom Section, Supply | Page: 47 of 73 | Date: February 09, 2023 |


Depending on fan static pressure, (negative pressure side of the fan) additional height of the condensate drainage may be required. In order to achieve minimum water column height in water traps.

Positive Pressure Trap

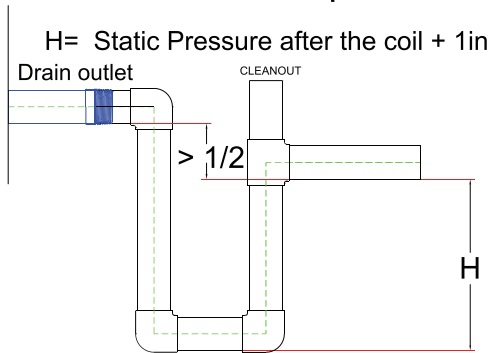



Drain Pan Connection 1" MPT

Negative Pressure Trap

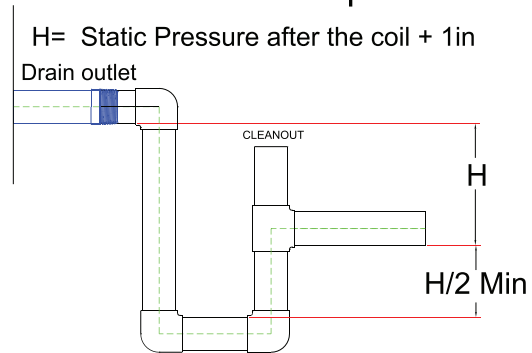

Drain Pan Connection 1" MPT

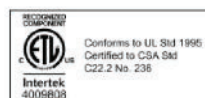

| | | |
|--|--|---|
| Project Name: UNCW King Hall – TRS NC; John Blakeney | VTS America Inc. 3535 Gravel Springs Rd. Extension, Suite 201, Buford, GA 30519 |  |
| Offer Code 11B.3/LIVE.USA/DW/2023-23 | Prepared for: THERMAL RESOURCE SALES - WILMINGTON 7215 OGDEN BUSINESS LANE, WILMINGTON,NC, 28411 | |
| Project Tag AHU-02 Bottom Section, Supply | Page: 48 of 73 | Date: February 09, 2023 |

2.4.3 **AHU-02 Bottom Section, Supply - Performance Data**

Supply tier

 **Mixing section**

Mixing Box

Heating operations

| | |
|----------------------------|-----------------|
| Recirculation | 0 % |
| Supply inlet | 16.3 °F/13.5 °F |
| Exhaust inlet DBT/WBT | 32.0 °F/20.7 °F |
| Supply outlet DBT/WBT | 16.3 °F/13.5 °F |
| Sensible recovery capacity | 0.0 MBH |

Cooling operations

| | |
|----------------------------|-----------------|
| Recirculation | 0 % |
| Supply inlet | 94.3 °F/80.6 °F |
| Exhaust inlet DBT/WBT | 32.0 °F/20.7 °F |
| Supply outlet DBT/WBT | 94.3 °F/80.6 °F |
| Sensible recovery capacity | 0.0 MBH |

Resp_MixingChamber_Info_Name

Mixings

 **Set of Two Flat Filters**

Type MERV8/2".Flat.Int.Sld

(ISO16890) - EFF CLASS E Flat[11.0]

Heating operations

| | |
|------------------------------|------------|
| 50% Dirty Air Pressure Drop | 0.59 in wg |
| Initial Air Pressure Drop | 0.20 in wg |
| 100% Dirty Air Pressure Drop | 0.98 in wg |
| Air velocity | 529 FPM |

Cooling operations

| | |
|------------------------------|------------|
| 50% Dirty Air Pressure Drop | 0.61 in wg |
| Initial Air Pressure Drop | 0.23 in wg |
| 100% Dirty Air Pressure Drop | 0.98 in wg |
| Air velocity | 531 FPM |

Air Filter Sizes

| | |
|--|-------------|
| P,FLT merv8 15,5 x 19,5 (1-2-0301-0089) | 6,000 x Pcs |
| P,FLT merv13 15,5 x 19,5 (1-2-0301-0098) | 6,000 x Pcs |

Type MERV13/4".Flat.Int.Sld

(ISO16890) - EFF CLASS E Flat[12.0]

Heating operations

| | |
|------------------------------|------------|
| 50% Dirty Air Pressure Drop | 0.64 in wg |
| Initial Air Pressure Drop | 0.29 in wg |
| 100% Dirty Air Pressure Drop | 0.98 in wg |
| Air velocity | 529 FPM |


Cooling operations

| | |
|------------------------------|------------|
| 50% Dirty Air Pressure Drop | 0.66 in wg |
| Initial Air Pressure Drop | 0.34 in wg |
| 100% Dirty Air Pressure Drop | 0.98 in wg |
| Air velocity | 531 FPM |

Air Filter Sizes

| | |
|---|-------------|
| P,FLT merv8 15,5 x 19,5 (1-2-0301-0089) | 6,000 x Pcs |
|---|-------------|



| | | |
|--|--|---|
| Project Name: UNCW King Hall – TRS NC; John Blakeney | VTS America Inc. 3535 Gravel Springs Rd. Extension, Suite 201, Buford, GA 30519 |  |
| Offer Code 11B.3/LIVE.USA/DW/2023-23 | Prepared for: THERMAL RESOURCE SALES - WILMINGTON 7215 OGDEN BUSINESS LANE, WILMINGTON,NC, 28411 | |
| Project Tag AHU-02 Bottom Section, Supply | Page: 49 of 73 | Date: February 09, 2023 |

P,FLT merv13 15,5 x 19,5 (1-2-0301- 6,000 x Pcs 0098)

Hot Water Coil

Type WCL AVS055 2R DT SH.St.St.Std **Number of rows** 2 **Connection Supply/Return:** 1 1/4"-11 1/2 NPT/1 1/4"-11 1/2 NPT

| | | | |
|------------------------|-------------------|-----------------------------|-------------------|
| Medium | Water | Maximum working pressure | 246 PSIG |
| Intake air DBT / WBT | 35.0 °F / 25.0 °F | Discharge air DBT / WBT | 60.0 °F / 40.1 °F |
| Air velocity | 452 FPM | Pressure drop Wet / Dry Wet | 0.16 in wg |
| Total heating capacity | 147.1 MBH | Medium temperature | 130.0 °F/100.0 °F |
| Medium flow rate | 9.82 GPM | Medium pressure drop | 0.874 ft wg |

Hot Water Coild Additional Info

Rows: 2
 Coils tube: 1/2"
 Coil volume in cubic inches: 635.3
 Finned Length: 4' 5 15/16" (1370mm)
 Finned Height: 2' 7 1/4"(794mm)
 Coil Connection: 1 1/4"-111/2 NPT
 Coil casing material: galvanized steel
 Single Coil

Empty section

Type EMP.SEC AVS055 Medium

Heating operations

Pressure drop
 Air velocity 519 FPM

Cooling operations

Pressure drop
 Air velocity 562 FPM

Resp_EmptySection_Info_Name

EmptySections


Chilled Water Coil

Type WCL AVS055 8R DT SH.St.Ss.Std **Number of rows** 8 **Connection Supply/Return:** 3" - 8 NPT/3" - 8 NPT

HIGH PERFORMANCE COIL AVS055_WCL_8 High Performance, Stainless Steel Casing WCL AVS055 8R

| | | | |
|------------------------------------|---------------------|------------------------------------|-------------------------|
| Medium | Water | Maximum working pressure | 246 PSIG |
| Intake air DBT / WBT | 81.5 °F / 69.5 °F | Discharge air DBT / WBT | 52.0 °F / 51.9 °F |
| Air velocity | 469 FPM | Pressure drop Wet / Dry Wet / Dry | 0.78 in wg / 0.47 in wg |
| Cooling capacity: Sensible / Total | 177.8 MBH/296.1 MBH | Medium temperature: Inlet / Outlet | 42.0 °F/60.0 °F |
| Medium flow rate | 32.76 GPM | Medium pressure drop | 6.961 ft wg |




| | | |
|--|--|---|
| Project Name: UNCW King Hall – TRS NC; John Blakeney | VTS America Inc. 3535 Gravel Springs Rd. Extension, Suite 201, Buford, GA 30519 |  |
| Offer Code 11B.3/LIVE.USA/DW/2023-23 | Prepared for: THERMAL RESOURCE SALES - WILMINGTON 7215 OGDEN BUSINESS LANE, WILMINGTON,NC, 28411 | |
| Project Tag AHU-02 Bottom Section, Supply | Page: 50 of 73 | Date: February 09, 2023 |



Chilled water cooler Additional Info


Rows: 8
 Coils tube: 1/2"
 C_VOL_2483_7_CI
 Finned Length: 4' 5 15/16" (1370mm)
 Finned Height: 2' 7 1/4"(794mm)
 Coil Connection: 3"-8 NPT
 Drain pan made of stainless steel
 Single Coil



| | | |
|--|---|---|
| Project Name: UNCW King Hall – TRS NC; John Blakeney | VTS America Inc. 3535 Gravel Springs Rd. Extension, Suite 201, Buford, GA 30519 |  |
| Offer Code 11B.3/LIVE.USA/DW/2023-23 | Prepared for: THERMAL RESOURCE SALES - WILMINGTON 7215 OGDEN BUSINESS LANE, WILMINGTON, NC, 28411 | |
| Project Tag AHU-02 Bottom Section, Supply | Page: 51 of 73 | Date: February 09, 2023 |

2.4.4 **Moist Air Processes**

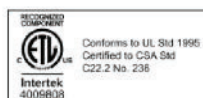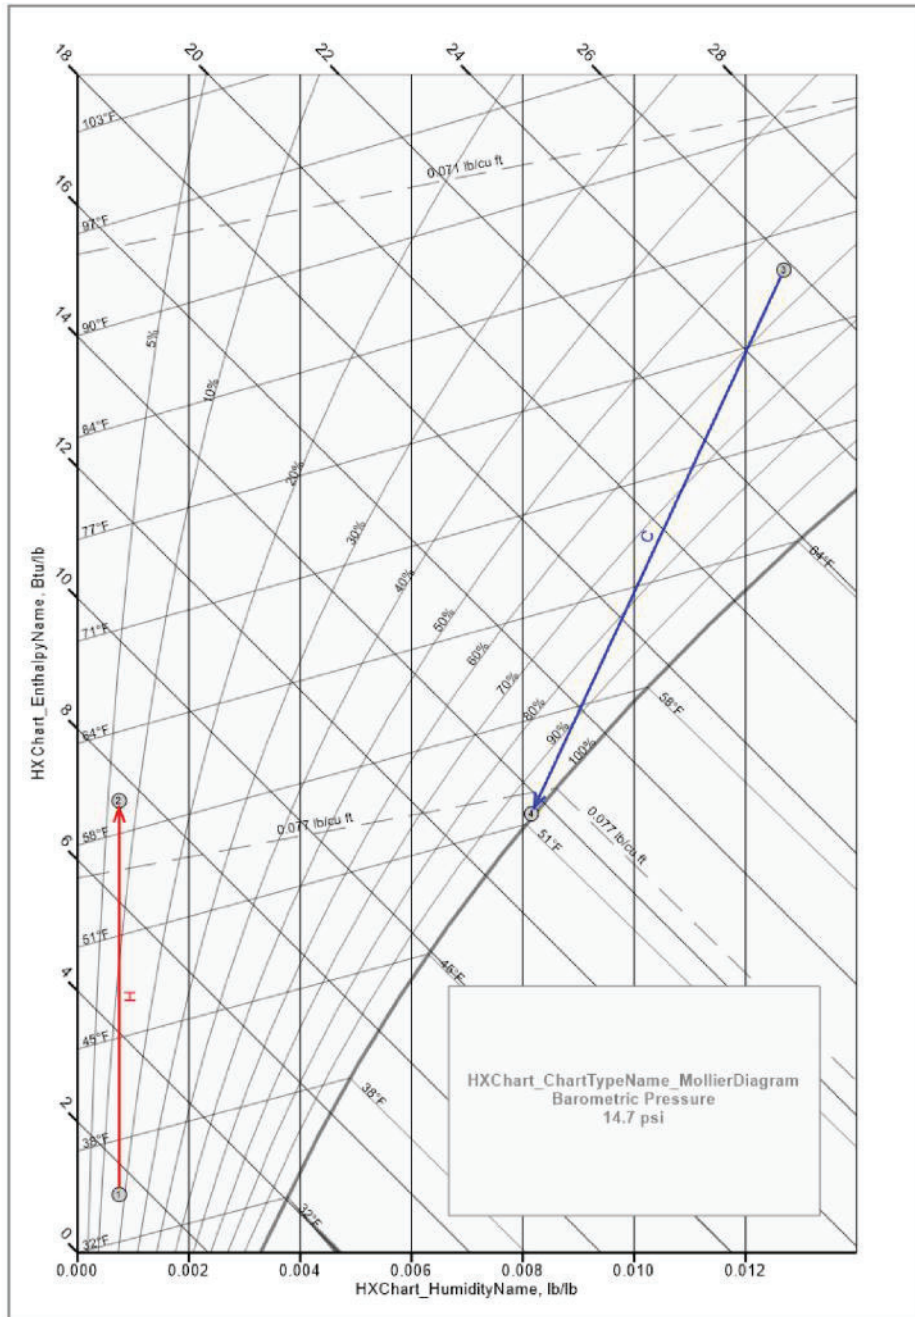

| | | |
|--|---|---|
| Project Name: UNCW King Hall – TRS NC; John Blakeney | VTS America Inc. 3535 Gravel Springs Rd. Extension, Suite 201, Buford, GA 30519 |  |
| Offer Code 11B.3/LIVE.USA/DW/2023-23 | Prepared for: THERMAL RESOURCE SALES - WILMINGTON 7215 OGDEN BUSINESS LANE, WILMINGTON, NC, 28411 | |
| Project Tag AHU-03 Top Section, Supply | Page: 52 of 73 | Date: February 09, 2023 |

2.5 AHU-03 Top Section, Supply

2.5.1 General AHU Data

| | | | |
|----------------------------|---------------------------|-----------------------------|-----------------------|
| AHU Tag | AHU-03 Top Section | AHU Size | AVS100 |
| Application | Execution: Indoor | AHU Set | AVS100-R-EV |
| AHU Type | Supply unit | Width | 82.9 in |
| Insulation Thickness | 2.0 in | AHU Support | AHU Support Type1 |
| Insulation | PUR | AHU Support Height | 3.5 in |
| Weight | 1092 lb | Shipping Sections | 2 |
| Elevation | 0 ft | Coil Connection Side | Right Hand Side (RHS) |
| Total length | 102.0 in | | |
| Fan Section Voltage | 460/3/60 V/ph/Hz | | |
| Unit Execution Side | Right Hand Side (RHS) | | |

Supply

| | |
|-------------------|--------------|
| AirFlow | 10500.00 CFM |
| External Pressure | 0.00 in wg |
| Calculation Mode | Real |

Fan Section

| | | | |
|-------------------|--------|----------|--------|
| Motor Rated Power | 7,5 HP | Impeller | VS 560 |
|-------------------|--------|----------|--------|

Empty Section

| | |
|---------------------|---------------------|
| EMP.SEC AVS100 Long | EMP.SEC AVS100 Long |
|---------------------|---------------------|

AHU Discharge and Intake Opening Sizes & Unit Accessories

Controls Selection Mode : No controls


| | |
|---|----------------|
| AHU Discharge and Intake Opening Sizes | Supply |
| Air Inlet | Down 59.8x28.1 |
| Air Outlet | Top 59.8x28.1 |

Unit Another Accessories


| | |
|-----------------------|------------|
| Internal Marine Light | Quantity 2 |
| Hinged Access | Quantity 1 |

2.5.2 AHU-03 Top Section, Supply - Dimensions, media connection points





| | | |
|--|---|---|
| Project Name: UNCW King Hall – TRS NC; John Blakeney | VTS America Inc. 3535 Gravel Springs Rd. Extension, Suite 201, Buford, GA 30519 |  |
| Offer Code 11B.3/LIVE.USA/DW/2023-23 | Prepared for: THERMAL RESOURCE SALES - WILMINGTON 7215 OGDEN BUSINESS LANE, WILMINGTON, NC, 28411 | |
| Project Tag AHU-03 Top Section, Supply | Page: 53 of 73 | Date: February 09, 2023 |

Inspection side

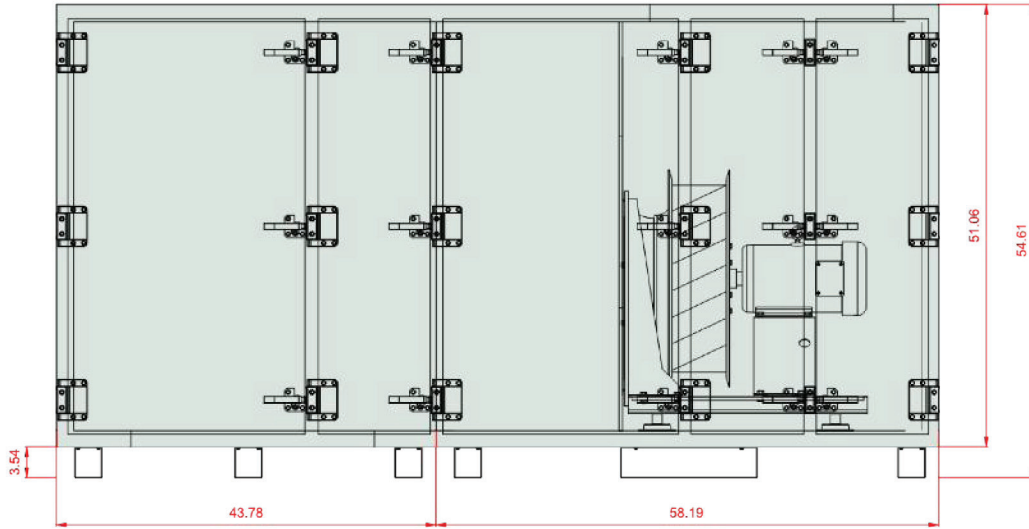



Top View

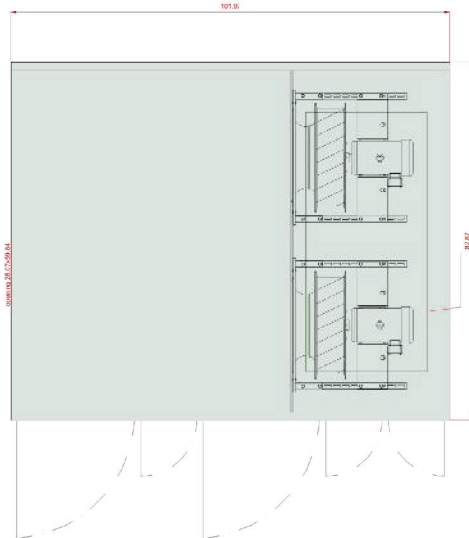



| | | |
|--|---|---|
| Project Name: UNCW King Hall – TRS NC; John Blakeney | VTS America Inc. 3535 Gravel Springs Rd. Extension, Suite 201, Buford, GA 30519 |  |
| Offer Code 11B.3/LIVE.USA/DW/2023-23 | Prepared for: THERMAL RESOURCE SALES - WILMINGTON 7215 OGDEN BUSINESS LANE, WILMINGTON, NC, 28411 | |
| Project Tag AHU-03 Top Section, Supply | Page: 54 of 73 | Date: February 09, 2023 |


End - Front Openings

End - Back Openings

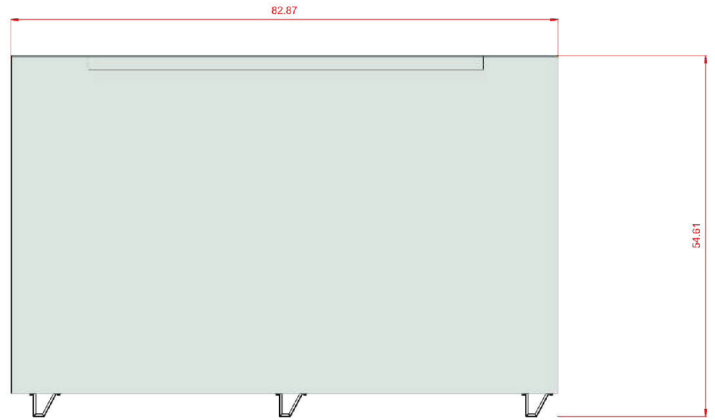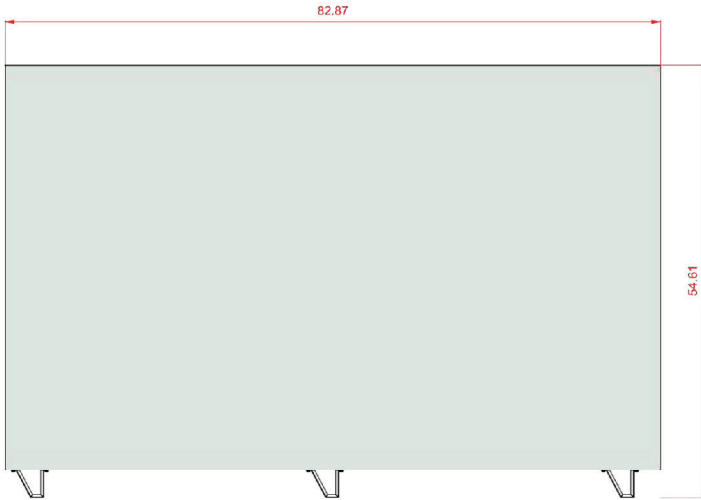


Coil Connections - Inspection side view

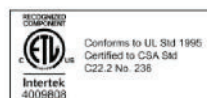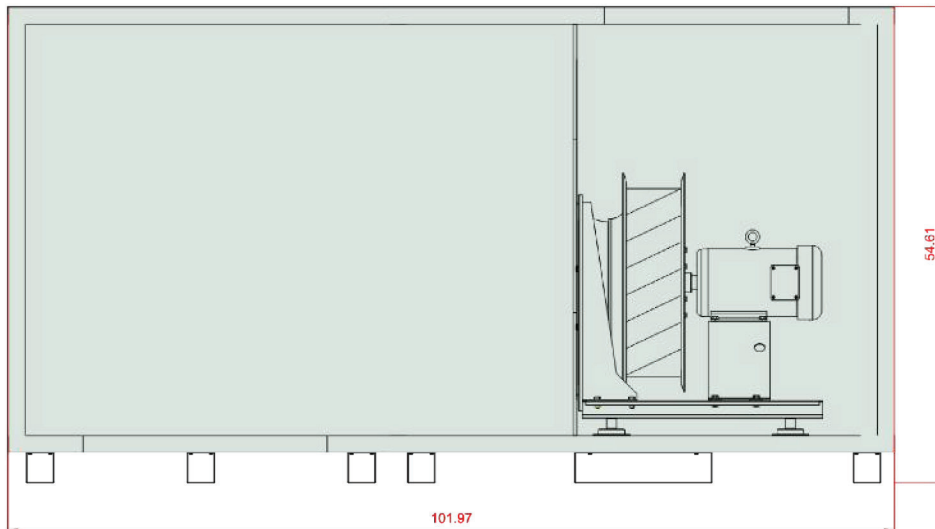


| | | | |
|--|---|-------------------|---|
| Project Name: UNCW King Hall – TRS NC; John Blakeney | VTS America Inc. 3535 Gravel Springs Rd. Extension, Suite 201, Buford, GA 30519 | |  |
| Offer Code 11B.3/LIVE.USA/DW/2023-23 | Prepared for: THERMAL RESOURCE SALES - WILMINGTON 7215 OGDEN BUSINESS LANE, WILMINGTON, NC, 28411 | | |
| Project Tag AHU-03 Top Section, Supply | | Page: 55 of 73 | Date: February 09, 2023 |


Coil connection rules

Coil dimensions

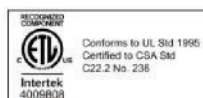



| | | |
|--|---|---|
| Project Name: UNCW King Hall – TRS NC; John Blakeney | VTS America Inc. 3535 Gravel Springs Rd. Extension, Suite 201, Buford, GA 30519 |  |
| Offer Code 11B.3/LIVE.USA/DW/2023-23 | Prepared for: THERMAL RESOURCE SALES - WILMINGTON 7215 OGDEN BUSINESS LANE, WILMINGTON, NC, 28411 | |
| Project Tag AHU-03 Top Section, Supply | Page: 56 of 73 | Date: February 09, 2023 |


Coil Connections - Top View

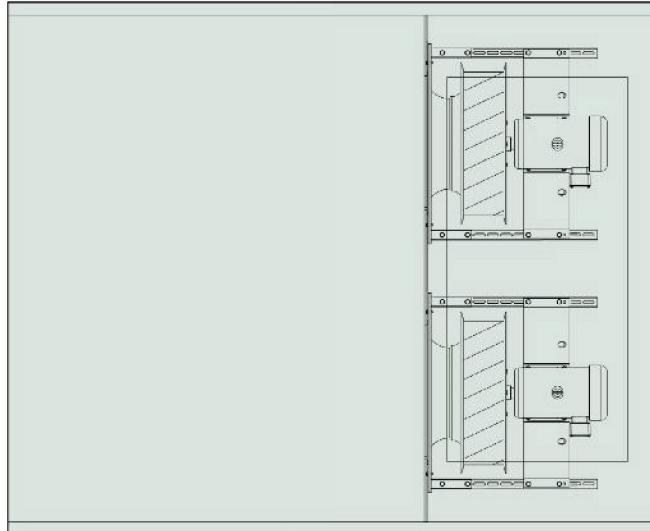


Sections split for transportation

| Section number | Section weight [lb] | Section length [in] | Section width [in] | Section height [in] |
|----------------|---------------------|---------------------|--------------------|---------------------|
| 1 | 282 | 43.8 | 82.9 | 54.6 |
| 2 | 793 | 58.2 | 82.9 | 54.6 |

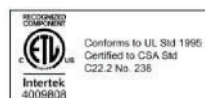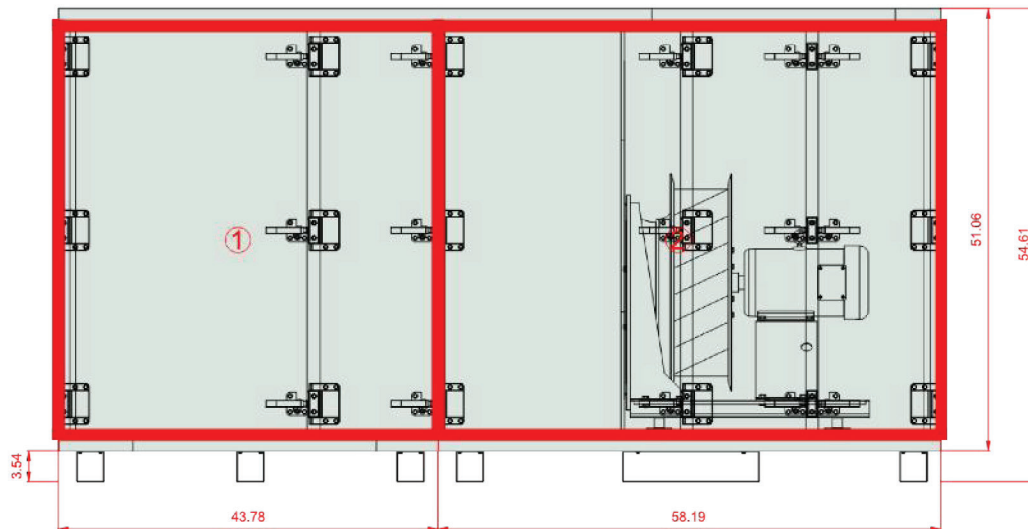

| | | |
|--|---|---|
| Project Name: UNCW King Hall – TRS NC; John Blakeney | VTS America Inc. 3535 Gravel Springs Rd. Extension, Suite 201, Buford, GA 30519 |  |
| Offer Code 11B.3/LIVE.USA/DW/2023-23 | Prepared for: THERMAL RESOURCE SALES - WILMINGTON 7215 OGDEN BUSINESS LANE, WILMINGTON, NC, 28411 | |
| Project Tag AHU-03 Top Section, Supply | Page: 57 of 73 | Date: February 09, 2023 |



Top view - Service space

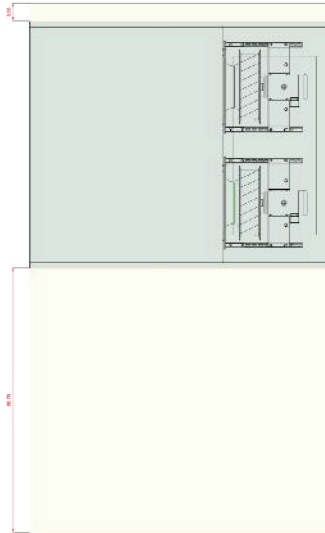


The AHU installation clearance is defined by:

- Non-Access Side – minimum space required for unit operation or coil connection
- Access Side – minimum space require allowing opening access door to a position perpendicular to the direction of Air Flow, and removal of side load filter
- Clearance for VFD's, or other high-voltage devices must be provided per NEC requirements
- Clearance for coil removal must be provided per coil drawing through the access side of the unit


Frame Top View, within the AHU outline contour

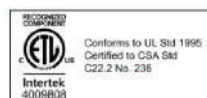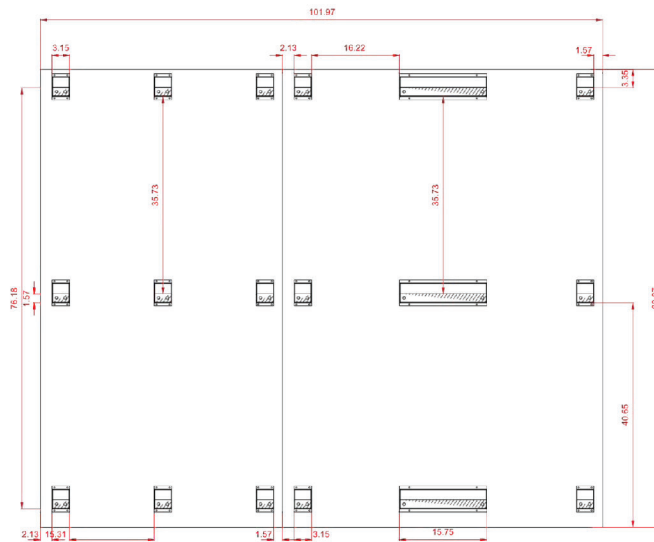


| | | |
|--|---|---|
| Project Name: UNCW King Hall – TRS NC; John Blakeney | VTS America Inc. 3535 Gravel Springs Rd. Extension, Suite 201, Buford, GA 30519 |  |
| Offer Code 11B.3/LIVE.USA/DW/2023-23 | Prepared for: THERMAL RESOURCE SALES - WILMINGTON 7215 OGDEN BUSINESS LANE, WILMINGTON, NC, 28411 | |
| Project Tag AHU-03 Top Section, Supply | Page: 58 of 73 | Date: February 09, 2023 |

2.5.3 AHU-03 Top Section, Supply - Drawings – AHU Sections Shipping Details , Supply

Fan Section Electric Connections

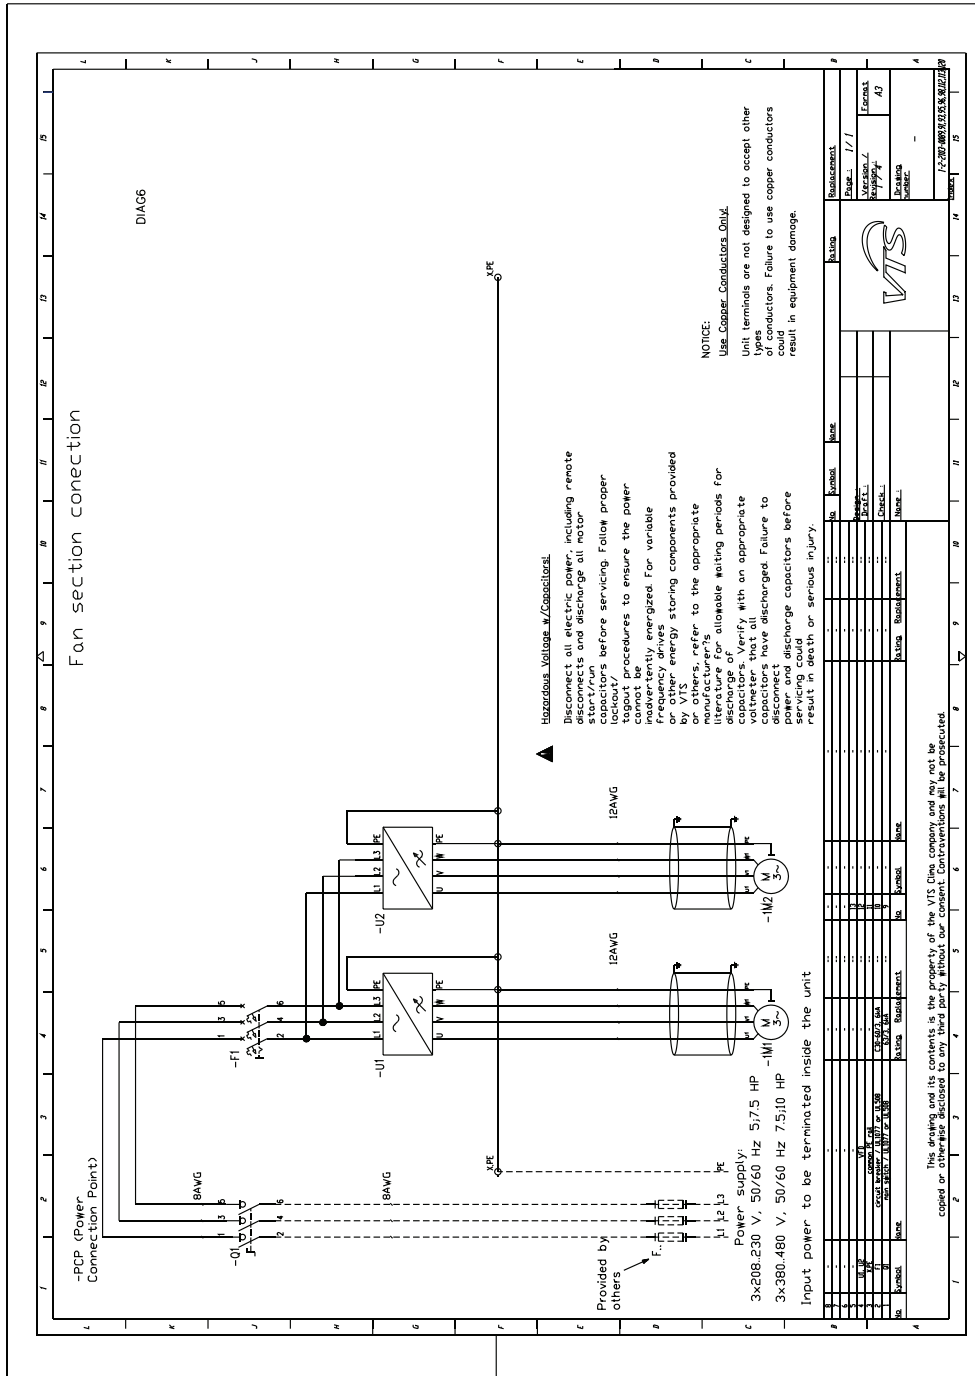

| | | |
|--|---|---|
| Project Name: UNCW King Hall – TRS NC; John Blakeney | VTS America Inc. 3535 Gravel Springs Rd. Extension, Suite 201, Buford, GA 30519 |  |
| Offer Code 11B.3/LIVE.USA/DW/2023-23 | Prepared for: THERMAL RESOURCE SALES - WILMINGTON 7215 OGDEN BUSINESS LANE, WILMINGTON, NC, 28411 | |
| Project Tag AHU-03 Top Section, Supply | Page: 59 of 73 | Date: February 09, 2023 |

2.5.4 AHU-03 Top Section, Supply - Performance Data

Supply tier

Empty section

Type EMP.SEC AVS100 Long

Heating operations

Pressure drop

Air velocity 438 FPM

Cooling operations

Pressure drop

Air velocity 517 FPM

Resp_EmptySection_Info_Name

EmptySections

Plug-Fan Set

Fan Section PLUG_DD_560_7,50_4

| | | | |
|-----------------------|---------------|----------------|--|
| Fan Set Assembly Type | FLX1 (Gasket) | Qty in section | x 2 |
| | | Air Standard | Calculations made for real air density |

Fan Set Designed for wet operating conditions
The fan system effects is taken into account in the fan performances.

Fan PLUG_VS_560_AF_Px 2

| | | | |
|-----------------------|------------|-------------------------------------|-------------|
| Total Static Pressure | 5.74 in wg | Impeller efficiency: Static / Total | 70 %/73 % |
| Dynamic pressure | 0.20 in wg | Shaft power | 7.28 HP x 2 |
| External pressure | 5.64 in wg | Working revolutions | 1937 rpm |
| Total Pressure | 5.94 in wg | | |


Fan Additional Info

Fan Type: Direct Driven Plenum Fan
Fan Wheel Diameter: 560 [mm]
Vibro-Acoustics Insulation: Rubber-in-Shear Floor Mounted Isolator

Motor AC_Premium Eff._F_213T_TEFC_4p_7.5_60x 2

| | | | |
|-------------------------------------|--------|--------------------------------------|-----------|
| 460V | | 60Hz | |
| FLA | 19.0 A | MCA | 23.8 A |
| MCB | 30.0 A | Maximum Overcurrent Protection (MOP) | 30.9 A |
| Short-Circuit Current Rating (SCCR) | 6.0 kA | Rated Current | 9.5 A x 2 |
| Motor enclosure | TEFC | Rated revolutions | 1770 rpm |
| IEC Size | 213T | | |



| | | |
|--|---|---|
| Project Name: UNCW King Hall – TRS NC; John Blakeney | VTS America Inc. 3535 Gravel Springs Rd. Extension, Suite 201, Buford, GA 30519 |  |
| Offer Code 11B.3/LIVE.USA/DW/2023-23 | Prepared for: THERMAL RESOURCE SALES - WILMINGTON 7215 OGDEN BUSINESS LANE, WILMINGTON, NC, 28411 | |
| Project Tag AHU-03 Top Section, Supply | Page: 60 of 73 | Date: February 09, 2023 |

| | | | |
|---------------------|------------------|---------------|-------------|
| Operational Voltage | 460 V/3 ph | Rated Power | 7.50 HP x 2 |
| Name plate RPM | 460 V/3 ph/60 Hz | Motor Version | V-Series |

Electric Motor Additional Info

Supplier: Baldor
Motor poles: 4

VFD BY OTHERS

| | | | |
|--------------------|----------|---------------------------|-----------------------|
| VFD | Required | Connecting Point | CP Provided by others |
| VFD Qty in section | 2 | VFD Voltage Supply | 460/3/60 V/ph/Hz |
| VFD Settings | 66 Hz | VFD Rated Power | 7.50 HP x 2 |
| VFD in selection | Excluded | VFD HMI | No |
| | | VFD 1PH ModBus Comm Board | No |

Acoustic data

| Frequency | | 63 Hz | 125 Hz | 250 Hz | 500 Hz | 1000 Hz | 2000 Hz | 4000 Hz | 8000 Hz | Lw dB(A) |
|------------------------|----|-------|--------|--------|--------|---------|---------|---------|---------|----------|
| Intake | dB | 77,6 | 82,5 | 89 | 89,6 | 86,4 | 83,2 | 78,4 | 74,5 | 94,3 |
| Outlet | dB | 79,6 | 84,5 | 91 | 91,6 | 88,4 | 85,2 | 80,4 | 76,5 | 96,3 |
| Environment | dB | 57,8 | 73 | 77,6 | 77,6 | 74,7 | 71,7 | 50,9 | 38 | 82,6 |
| Sound Pressure* | dB | 44,5 | 66 | 70,6 | 70,6 | 67,7 | 64,7 | 43,9 | 31 | 75,6 |

(*) Approximate data of sound pressure


2.5.5 AHU-03 Top Section, Supply - Fan Performance Data , Supply

| | |
|---------------------------|-------------|
| Number of fans in section | 2 |
| Airflow per Fan | 5538.43 CFM |
| Total Pressure Increase | 5.94 in wg |
| Static pressure | 5.74 in wg |
| External pressure | 5.64 in wg |
| Velocity Pressure | 0.20 in wg |
| Static Efficiency | 70 % |
| Total Efficiency | 73 % |
| Shaft Power | 7.28 HP |
| Fan revolutions | 1937 rpm |
| VFD Setting | 66 Hz |
| Acoustic Power Level | 82,6 dB |
| Acoustic Pressure Level | 75,6 dB |

Internal Pressure Drop


| Function | Pressure Drop |
|----------|--|
| | Pressure Drop in Winter (at 50% Dirty Filters) |
| All | 0.11 in wg |





| | | |
|--|---|---|
| Project Name: UNCW King Hall – TRS NC; John Blakeney | VTS America Inc. 3535 Gravel Springs Rd. Extension, Suite 201, Buford, GA 30519 |  |
| Offer Code 11B.3/LIVE.USA/DW/2023-23 | Prepared for: THERMAL RESOURCE SALES - WILMINGTON 7215 OGDEN BUSINESS LANE, WILMINGTON, NC, 28411 | |
| Project Tag AHU-03 Top Section, Supply | Page: 61 of 73 | Date: February 09, 2023 |

| | |
|---------------|------------|
| Inlet | 0.05 in wg |
| Empty Section | 0.01 in wg |
| Outlet | 0.05 in wg |



| | | |
|--|---|---|
| Project Name: UNCW King Hall – TRS NC; John Blakeney | VTS America Inc. 3535 Gravel Springs Rd. Extension, Suite 201, Buford, GA 30519 |  |
| Offer Code 11B.3/LIVE.USA/DW/2023-23 | Prepared for: THERMAL RESOURCE SALES - WILMINGTON 7215 OGDEN BUSINESS LANE, WILMINGTON, NC, 28411 | |
| Project Tag AHU-03 Top Section, Supply | Page: 62 of 73 | Date: February 09, 2023 |

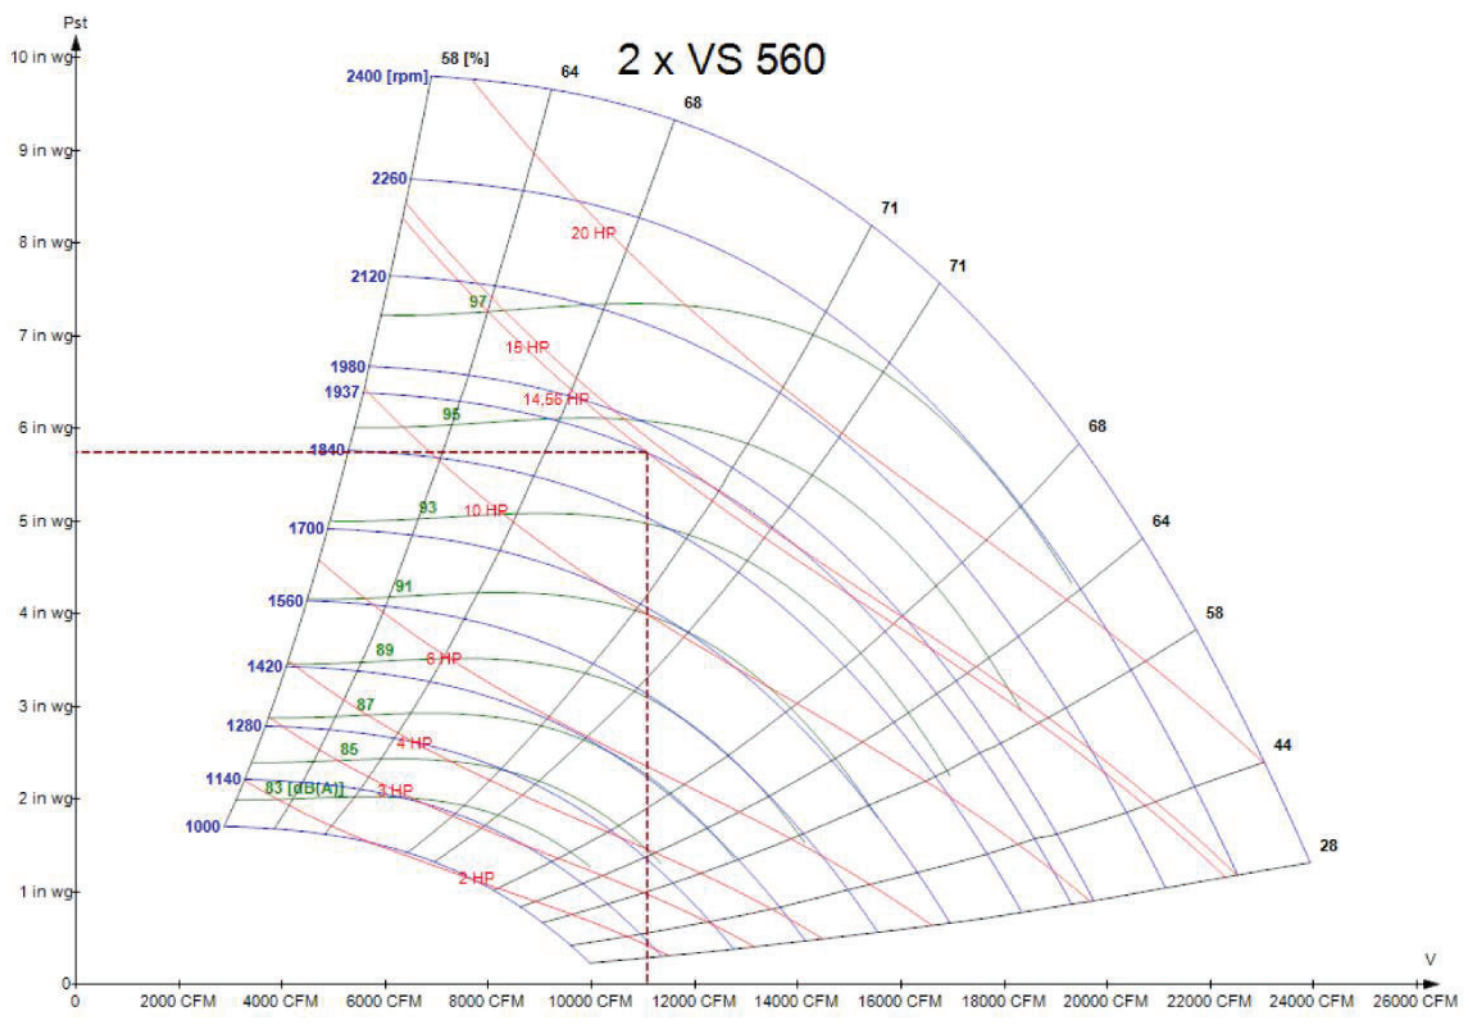

| | | |
|--|--|---|
| Project Name: UNCW King Hall – TRS NC; John Blakeney | VTS America Inc. 3535 Gravel Springs Rd. Extension, Suite 201, Buford, GA 30519 |  |
| Offer Code 11B.3/LIVE.USA/DW/2023-23 | Prepared for: THERMAL RESOURCE SALES - WILMINGTON 7215 OGDEN BUSINESS LANE, WILMINGTON,NC, 28411 | |
| Project Tag AHU-03 Bottom Section, Supply | Page: 63 of 73 | Date: February 09, 2023 |

2.6 AHU-03 Bottom Section, Supply

2.6.1 General AHU Data

| | | | |
|----------------------------|------------------------------|-----------------------------|-----------------------|
| AHU Tag | AHU-03 Bottom Section | AHU Size | AVS100 |
| Application | Execution: Indoor | AHU Set | AVS100-L-MFHEC |
| AHU Type | Supply unit | Width | 82.9 in |
| Insulation Thickness | 2.0 in | AHU Support | AHU Support Type1 |
| Insulation | PUR | AHU Support Height | 8.0 in |
| Weight | 1962 lb | Shipping Sections | 3 |
| Elevation | 0 ft | | |
| Total length | 145.2 in | | |
| Unit Execution Side | Left Hand Side (LHS) | Coil Connection Side | Left Hand Side (LHS) |

Supply

| | |
|-------------------|--------------|
| AirFlow | 10500.00 CFM |
| External Pressure | 0.00 in wg |
| Calculation Mode | Real |

Mixing

Mixing Section

Coils

| | | | |
|------------------|---------|----------------------|-------------------------------|
| Hot Water Heater | Rows: 1 | Chilled Water Cooler | Rows: 8 HIGH PERFORMANCE COIL |
|------------------|---------|----------------------|-------------------------------|

Filters

| | |
|-----------------------|-----------------------|
| MERV8/2".Flat.Int.Sld | MERV8/2".Flat.Int.Sld |
|-----------------------|-----------------------|


Empty Section


| | |
|-----------------------|-----------------------|
| EMP.SEC AVS100 Medium | EMP.SEC AVS100 Medium |
|-----------------------|-----------------------|

AHU Discharge and Intake Opening Sizes &Unit Accessories

Controls Selection Mode : Air damper actuator

| | |
|---|-------------------------|
| AHU Discharge and Intake Opening Sizes | Supply |
| Air Inlet | Front (Small) 59.8x28.1 |
| Air Inlet (2nd) | Top 59.8x28.1 |
| Air Outlet | Front (Small) 59.8x28.1 |
| AirDamper | Supply |
| Air Inlet | Provided with Actuators |
| Air Inlet (2nd) | Provided with Actuators |
| Unit Another Accessories | |
| Round View Window | Quantity 1 |
| Internal Marine Light | Quantity 3 |
| Hinged Access | Quantity 1 |
| UV Lamp | Quantity 1 |

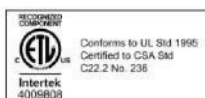


| | | |
|--|---|---|
| Project Name: UNCW King Hall – TRS NC; John Blakeney | VTS America Inc. 3535 Gravel Springs Rd. Extension, Suite 201, Buford, GA 30519 |  |
| Offer Code 11B.3/LIVE.USA/DW/2023-23 | Prepared for: THERMAL RESOURCE SALES - WILMINGTON 7215 OGDEN BUSINESS LANE, WILMINGTON, NC, 28411 | |
| Project Tag AHU-03 Bottom Section, Supply | Page: 64 of 73 | Date: February 09, 2023 |

Rails


Quantity 1


2.6.2 AHU-03 Bottom Section, Supply - Dimensions, media connection points

Inspection side

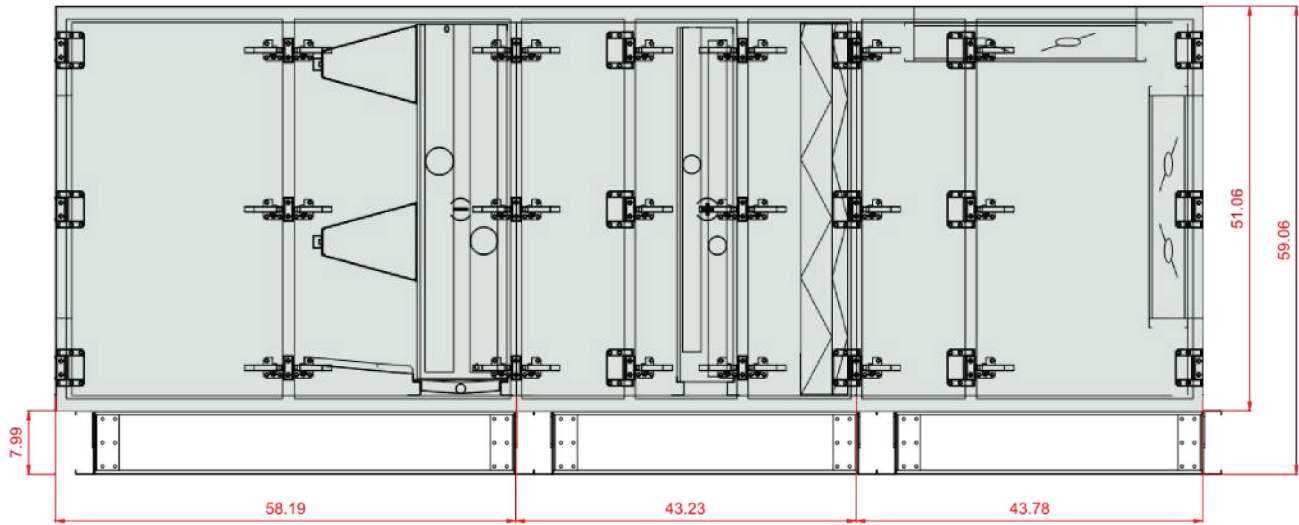



Top View

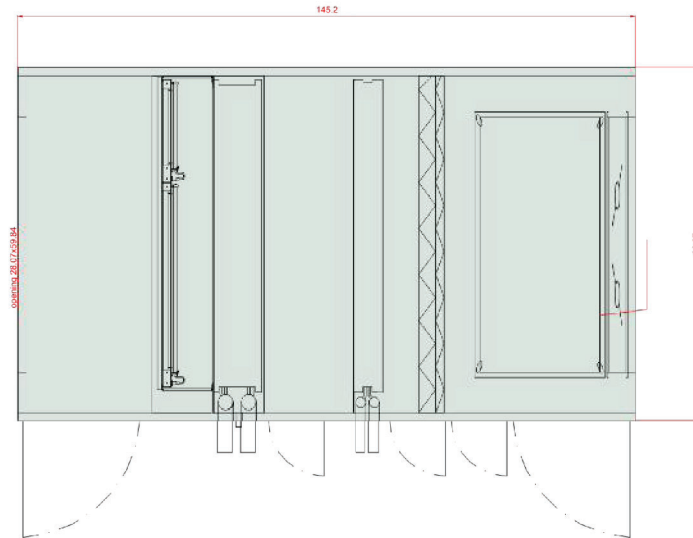



| | | |
|--|---|---|
| Project Name: UNCW King Hall – TRS NC; John Blakeney | VTS America Inc. 3535 Gravel Springs Rd. Extension, Suite 201, Buford, GA 30519 |  |
| Offer Code 11B.3/LIVE.USA/DW/2023-23 | Prepared for: THERMAL RESOURCE SALES - WILMINGTON 7215 OGDEN BUSINESS LANE, WILMINGTON, NC, 28411 | |
| Project Tag AHU-03 Bottom Section, Supply | Page: 65 of 73 | Date: February 09, 2023 |


End - Front Openings

End - Back Openings

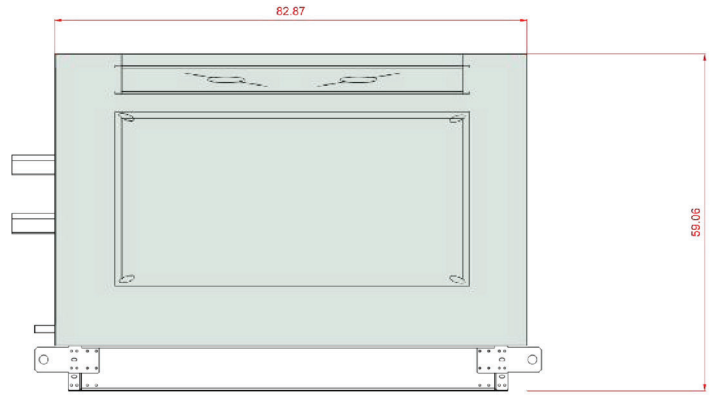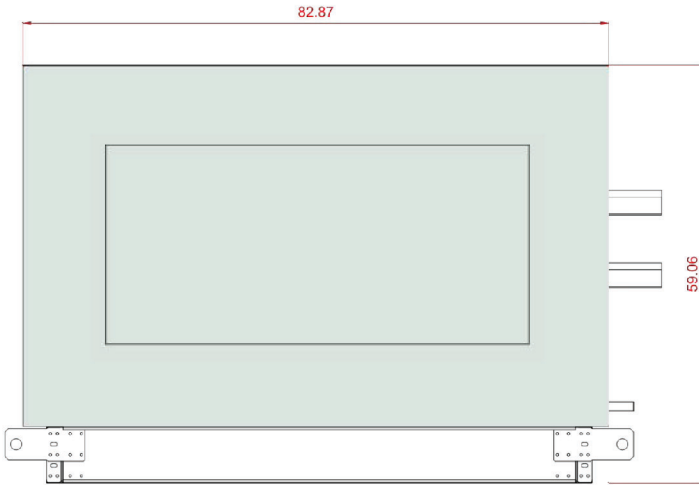


Coil Connections - Inspection side view

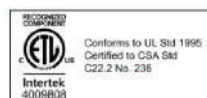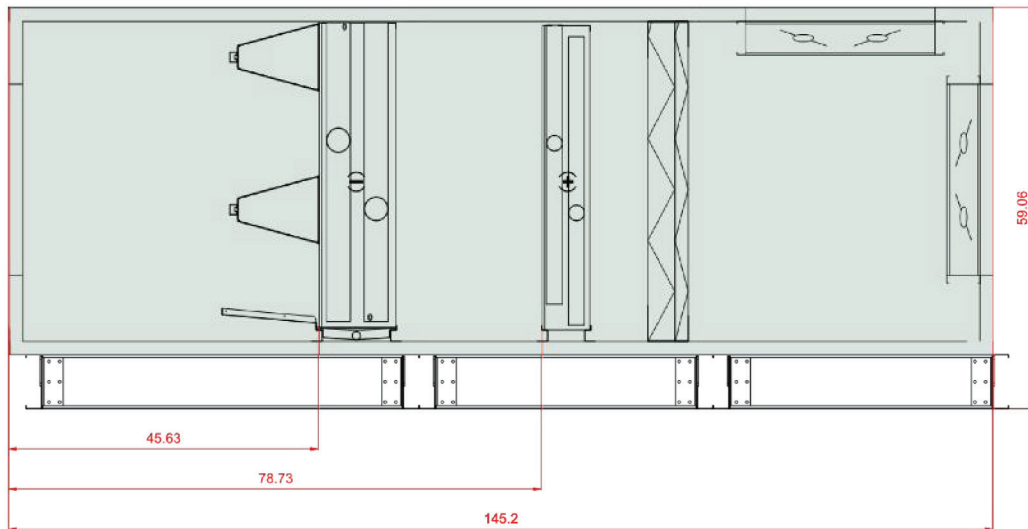

| | | |
|--|---|---|
| Project Name: UNCW King Hall – TRS NC; John Blakeney | VTS America Inc. 3535 Gravel Springs Rd. Extension, Suite 201, Buford, GA 30519 |  |
| Offer Code 11B.3/LIVE.USA/DW/2023-23 | Prepared for: THERMAL RESOURCE SALES - WILMINGTON 7215 OGDEN BUSINESS LANE, WILMINGTON, NC, 28411 | |
| Project Tag AHU-03 Bottom Section, Supply | Page: 66 of 73 | Date: February 09, 2023 |


Coil connection rules

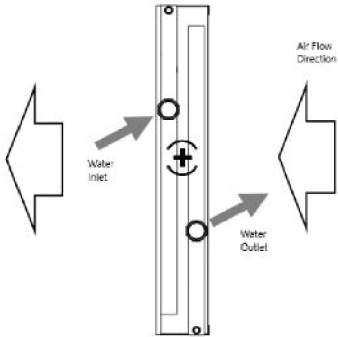


Coil dimensions

C_cw_8|1|1|SH|N

H_hw_1|1|1|SH|N

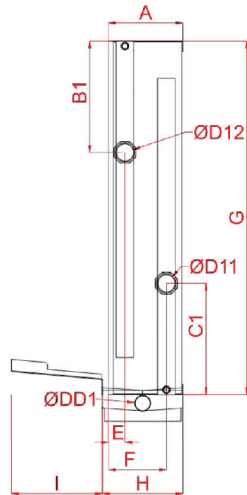


| | | | | | |
|------------|------------|------------|----------|----------|----------|
| A | B1 | C1 | E | F | G |
| 11.34 | 17.24 | 17.24 | 2.97 | 8.37 | 44.76 |
| D11 | D12 | DD1 | H | I | L |
| 2.99 | 2.99 | 1.26 | 11.81 | 13.86 | 70.47 |

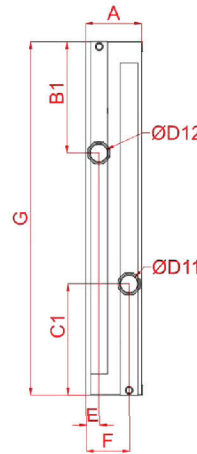


| | | | | |
|----------|------------|------------|----------|----------|
| A | B1 | C1 | E | F |
| 7.2 | 17.24 | 17.24 | 1.99 | 5.22 |
| G | D11 | D12 | L | |
| 44.76 | 2.01 | 2.01 | 70.47 | |





| | | |
|--|---|---|
| Project Name: UNCW King Hall – TRS NC; John Blakeney | VTS America Inc. 3535 Gravel Springs Rd. Extension, Suite 201, Buford, GA 30519 |  |
| Offer Code 11B.3/LIVE.USA/DW/2023-23 | Prepared for: THERMAL RESOURCE SALES - WILMINGTON 7215 OGDEN BUSINESS LANE, WILMINGTON, NC, 28411 | |
| Project Tag AHU-03 Bottom Section, Supply | Page: 67 of 73 | Date: February 09, 2023 |


Coil Connections - Top View

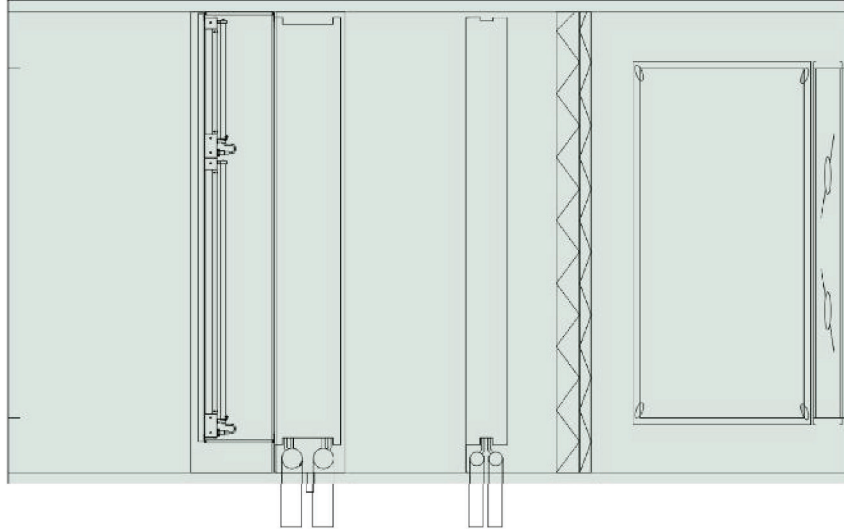


Sections split for transportation

| Section number | Section weight [lb] | Section length [in] | Section width [in] | Section height [in] |
|----------------|---------------------|---------------------|--------------------|---------------------|
| 1 | 464 | 43.8 | 82.9 | 59.1 |
| 2 | 528 | 43.2 | 82.9 | 59.1 |
| 3 | 885 | 58.2 | 82.9 | 59.1 |

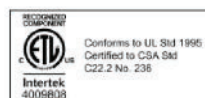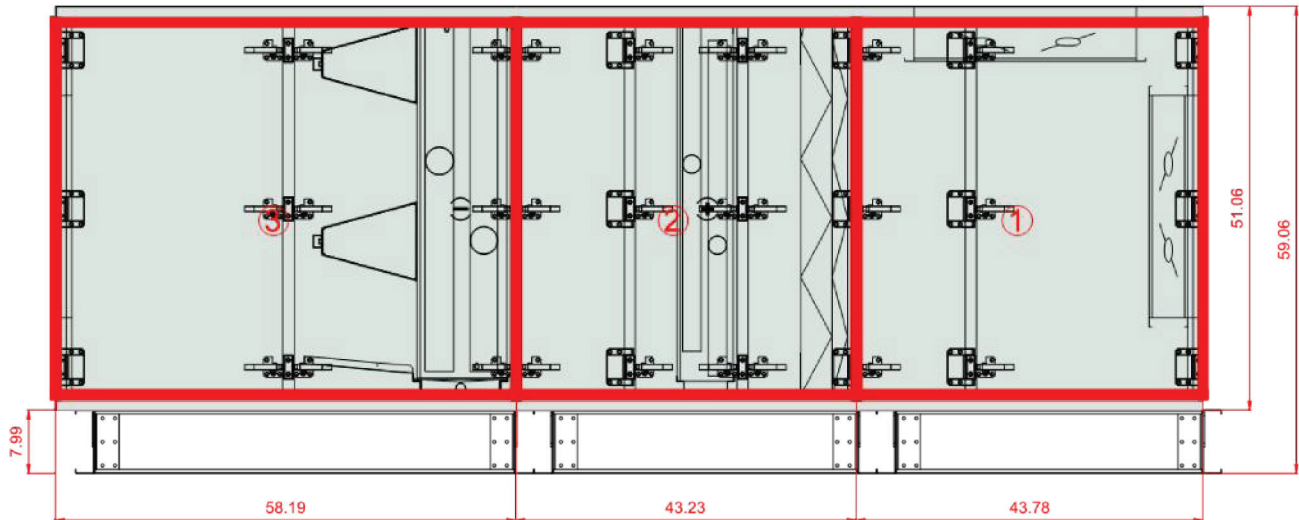

| | | |
|--|---|---|
| Project Name: UNCW King Hall – TRS NC; John Blakeney | VTS America Inc. 3535 Gravel Springs Rd. Extension, Suite 201, Buford, GA 30519 |  |
| Offer Code 11B.3/LIVE.USA/DW/2023-23 | Prepared for: THERMAL RESOURCE SALES - WILMINGTON 7215 OGDEN BUSINESS LANE, WILMINGTON, NC, 28411 | |
| Project Tag AHU-03 Bottom Section, Supply | Page: 68 of 73 | Date: February 09, 2023 |



Top view - Service space

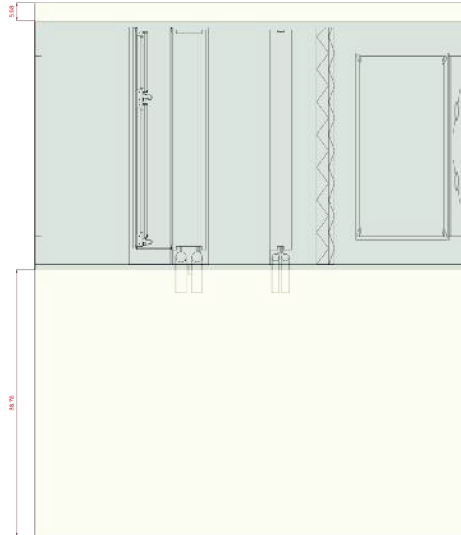


The AHU installation clearance is defined by:

- Non-Access Side – minimum space required for unit operation or coil connection
- Access Side – minimum space require allowing opening access door to a position perpendicular to the direction of Air Flow, and removal of side load filter
- Clearance for VFD's, or other high-voltage devices must be provided per NEC requirements
- Clearance for coil removal must be provided per coil drawing through the access side of the unit


Frame Top View, within the AHU outline contour

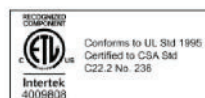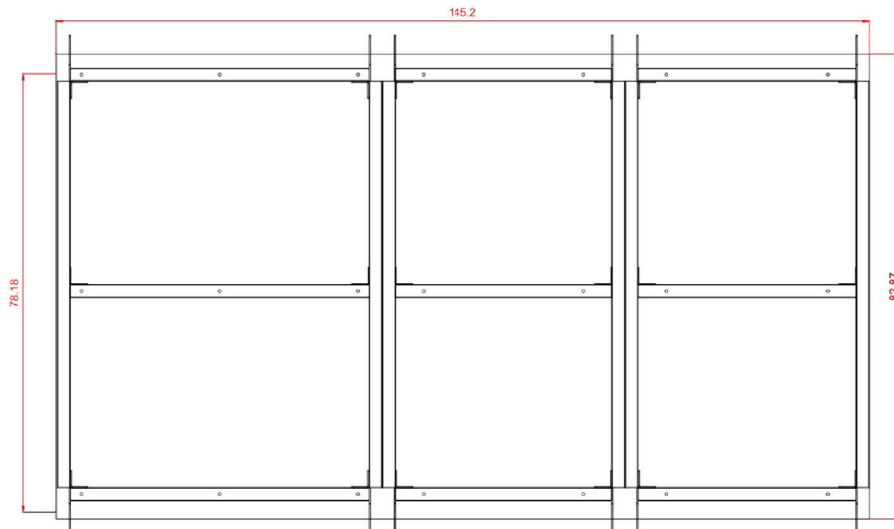

| | | |
|--|---|---|
| Project Name: UNCW King Hall – TRS NC; John Blakeney | VTS America Inc. 3535 Gravel Springs Rd. Extension, Suite 201, Buford, GA 30519 |  |
| Offer Code 11B.3/LIVE.USA/DW/2023-23 | Prepared for: THERMAL RESOURCE SALES - WILMINGTON 7215 OGDEN BUSINESS LANE, WILMINGTON, NC, 28411 | |
| Project Tag AHU-03 Bottom Section, Supply | Page: 69 of 73 | Date: February 09, 2023 |


Depending on fan static pressure, (negative pressure side of the fan) additional height of the condensate drainage may be required. In order to achieve minimum water column height in water traps.

Positive Pressure Trap

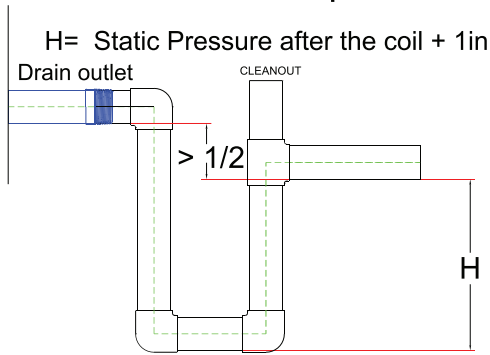


Drain Pan Connection 1" MPT

Negative Pressure Trap

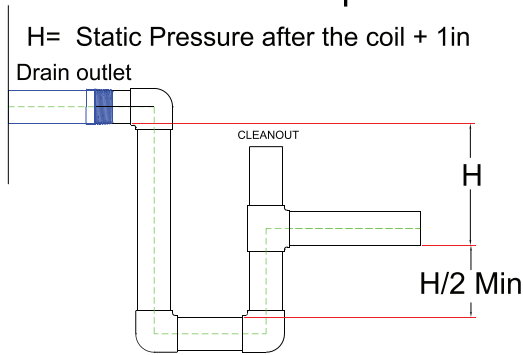

Drain Pan Connection 1" MPT



| | | |
|--|--|---|
| Project Name: UNCW King Hall – TRS NC; John Blakeney | VTS America Inc. 3535 Gravel Springs Rd. Extension, Suite 201, Buford, GA 30519 |  |
| Offer Code 11B.3/LIVE.USA/DW/2023-23 | Prepared for: THERMAL RESOURCE SALES - WILMINGTON 7215 OGDEN BUSINESS LANE, WILMINGTON,NC, 28411 | |
| Project Tag AHU-03 Bottom Section, Supply | Page: 70 of 73 | Date: February 09, 2023 |

2.6.3 **AHU-03 Bottom Section, Supply - Performance Data**

Supply tier



Mixing section

Mixing Box

Heating operations

| | |
|----------------------------|-----------------|
| Recirculation | 0 % |
| Supply inlet | 16.3 °F/13.5 °F |
| Exhaust inlet DBT/WBT | 32.0 °F/20.7 °F |
| Supply outlet DBT/WBT | 16.3 °F/13.5 °F |
| Sensible recovery capacity | 0.0 MBH |

Cooling operations

| | |
|----------------------------|-----------------|
| Recirculation | 0 % |
| Supply inlet | 94.3 °F/80.6 °F |
| Exhaust inlet DBT/WBT | 32.0 °F/20.7 °F |
| Supply outlet DBT/WBT | 94.3 °F/80.6 °F |
| Sensible recovery capacity | 0.0 MBH |

Resp_MixingChamber_Info_Name

Mixings



Set of Two Flat Filters

Type MERV8/2".Flat.Int.Sld

(ISO16890) - EFF CLASS E Flat[11.0]

Heating operations

| | |
|------------------------------|------------|
| 50% Dirty Air Pressure Drop | 0.58 in wg |
| Initial Air Pressure Drop | 0.17 in wg |
| 100% Dirty Air Pressure Drop | 0.98 in wg |
| Air velocity | 487 FPM |

Cooling operations

| | |
|------------------------------|------------|
| 50% Dirty Air Pressure Drop | 0.59 in wg |
| Initial Air Pressure Drop | 0.20 in wg |
| 100% Dirty Air Pressure Drop | 0.98 in wg |
| Air velocity | 488 FPM |

Air Filter Sizes

| | |
|--|-------------|
| P,FLT merv8 19,5 x 19,5 (1-2-0301-0093) | 4,000 x Pcs |
| P,FLT merv8 19,5 x 24,5 (1-2-0301-0095) | 4,000 x Pcs |
| P,FLT merv13 19,5 x 19,5 (1-2-0301-0102) | 4,000 x Pcs |
| P,FLT merv13 19,5 x 24,5 (1-2-0301-0104) | 4,000 x Pcs |

Type MERV13/4".Flat.Int.Sld

(ISO16890) - EFF CLASS E Flat[12.0]


Heating operations

| | |
|------------------------------|------------|
| 50% Dirty Air Pressure Drop | 0.61 in wg |
| Initial Air Pressure Drop | 0.24 in wg |
| 100% Dirty Air Pressure Drop | 0.98 in wg |

Cooling operations

| | |
|------------------------------|------------|
| 50% Dirty Air Pressure Drop | 0.64 in wg |
| Initial Air Pressure Drop | 0.29 in wg |
| 100% Dirty Air Pressure Drop | 0.98 in wg |



| | | |
|--|---|---|
| Project Name: UNCW King Hall – TRS NC; John Blakeney | VTS America Inc. 3535 Gravel Springs Rd. Extension, Suite 201, Buford, GA 30519 |  |
| Offer Code 11B.3/LIVE.USA/DW/2023-23 | Prepared for: THERMAL RESOURCE SALES - WILMINGTON 7215 OGDEN BUSINESS LANE, WILMINGTON, NC, 28411 | |
| Project Tag AHU-03 Bottom Section, Supply | Page: 71 of 73 | Date: February 09, 2023 |

Air velocity 487 FPM Air velocity 488 FPM

Air Filter Sizes

P,FLT merv8 19,5 x 19,5 (1-2-0301-0093) 4,000 x Pcs
P,FLT merv8 19,5 x 24,5 (1-2-0301-0095) 4,000 x Pcs
P,FLT merv13 19,5 x 19,5 (1-2-0301-0102) 4,000 x Pcs
P,FLT merv13 19,5 x 24,5 (1-2-0301-0104) 4,000 x Pcs

+ Hot Water Coil

Type WCL AVS100 1R DT SH.St.St.Std **Number of rows** 1 **Connection Supply/Return:** 2"-11 1/2 NPT/2"-11 1/2 NPT

| | | | |
|------------------------|-------------------|-----------------------------|-------------------|
| Medium | Water | Maximum working pressure | 246 PSIG |
| Intake air DBT / WBT | 40.0 °F / 30.0 °F | Discharge air DBT / WBT | 60.0 °F / 41.8 °F |
| Air velocity | 461 FPM | Pressure drop Wet / Dry Wet | 0.09 in wg |
| Total heating capacity | 225.7 MBH | Medium temperature | 130.0 °F/100.0 °F |
| Medium flow rate | 15.07 GPM | Medium pressure drop | 0.651 ft wg |

Hot Water Coild Additional Info

Rows: 1
Coils tube: 1/2"
Coil volume in cubic inches: 791.5
Finned Length: 5' 10 1/2" (1790mm)
Finned Height: 3' 7 3/4"(1112mm)
Coil Connection: 2"-11 1/2 NPT
Coil casing material: galvanized steel
Single Coil

Empty section

Type EMP.SEC AVS100 Medium

| | |
|---------------------------|---------------------------|
| Heating operations | Cooling operations |
| Pressure drop | Pressure drop |
| Air velocity 478 FPM | Air velocity 517 FPM |

Resp_EmptySection_Info_Name


EmptySections

- Chilled Water Coil

Type WCL AVS100 8R DT SH.St.Ss.Std **Number of rows** 8 **Connection Supply/Return:** 2x 3"-8 NPT/2x 3"-8 NPT

HIGH PERFORMANCE COIL AVS100_WCL_8 High Performance, Stainless Steel



| | | |
|--|---|---|
| Project Name: UNCW King Hall – TRS NC; John Blakeney | VTS America Inc. 3535 Gravel Springs Rd. Extension, Suite 201, Buford, GA 30519 |  |
| Offer Code 11B.3/LIVE.USA/DW/2023-23 | Prepared for: THERMAL RESOURCE SALES - WILMINGTON 7215 OGDEN BUSINESS LANE, WILMINGTON, NC, 28411 | |
| Project Tag AHU-03 Bottom Section, Supply | Page: 72 of 73 | Date: February 09, 2023 |


Casing WCL AVS100 8R

| | | | |
|------------------------------------|---------------------|------------------------------------|-------------------------|
| Medium | Water | Maximum working pressure | 246 PSIG |
| Intake air DBT / WBT | 80.4 °F / 71.4 °F | Discharge air DBT / WBT | 52.0 °F / 52.0 °F |
| Air velocity | 489 FPM | Pressure drop Wet / Dry Wet / Dry | 0.92 in wg / 0.47 in wg |
| Cooling capacity: Sensible / Total | 330.2 MBH/648.6 MBH | Medium temperature: Inlet / Outlet | 42.0 °F/60.0 °F |
| Medium flow rate | 71.75 GPM | Medium pressure drop | 9.351 ft wg |



Chilled water cooler Additional Info


Rows: 8
Coils tube: 1/2"
Coil volume in cubic inches: 3812.2
Finned Length: 5' 10 1/2" (1790mm)
Finned Height: 3' 7 3/4"(1112mm)
Coil Connection: 3"-8 NPT
Drain pan made of stainless steel
Single Coil




| | | |
|--|---|---|
| Project Name: UNCW King Hall – TRS NC; John Blakeney | VTS America Inc. 3535 Gravel Springs Rd. Extension, Suite 201, Buford, GA 30519 |  |
| Offer Code 11B.3/LIVE.USA/DW/2023-23 | Prepared for: THERMAL RESOURCE SALES - WILMINGTON 7215 OGDEN BUSINESS LANE, WILMINGTON, NC, 28411 | |
| Project Tag AHU-03 Bottom Section, Supply | Page: 73 of 73 | Date: February 09, 2023 |

2.6.4 **Moist Air Processes**

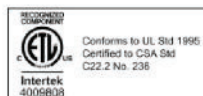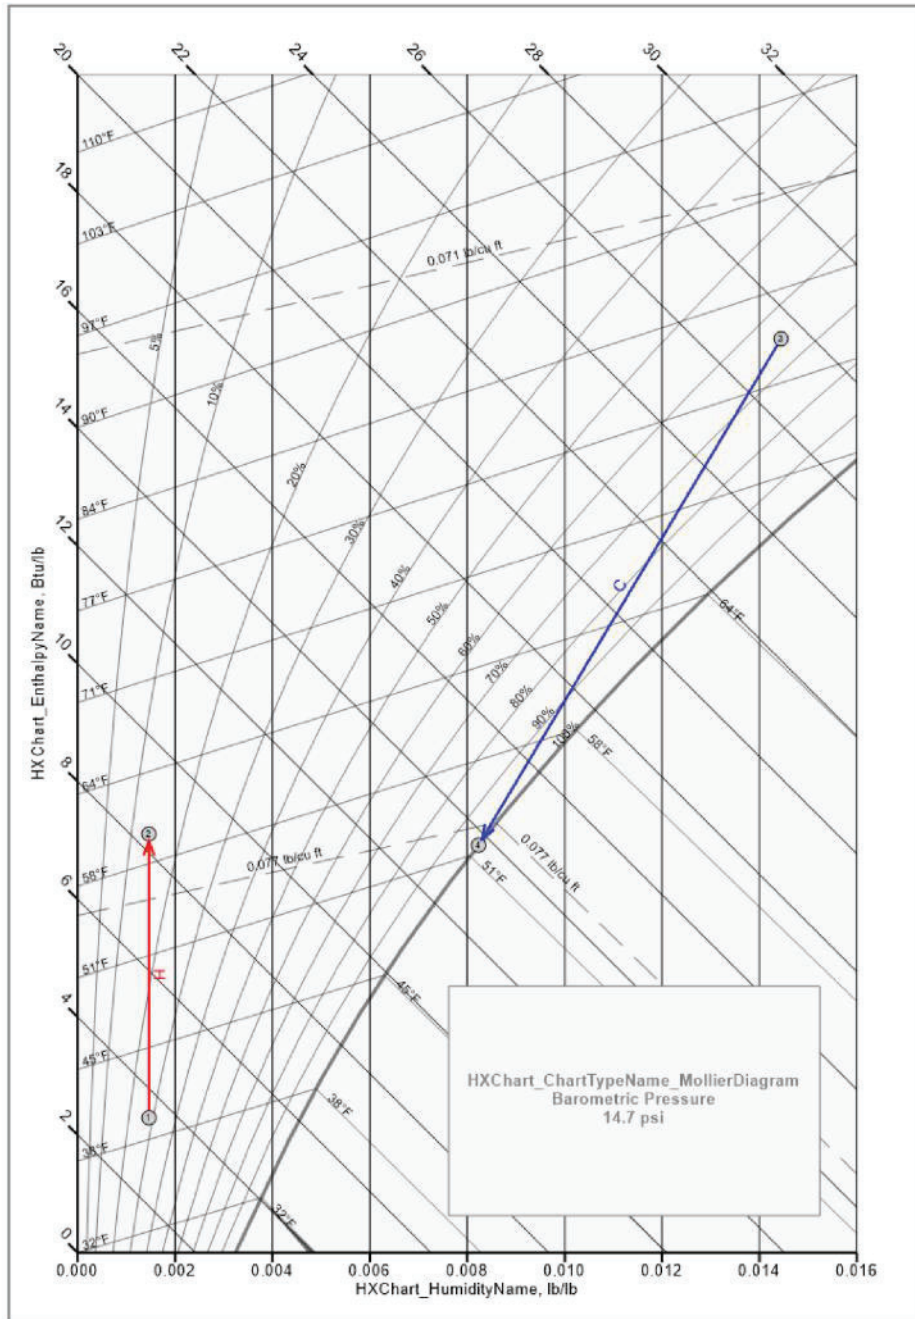

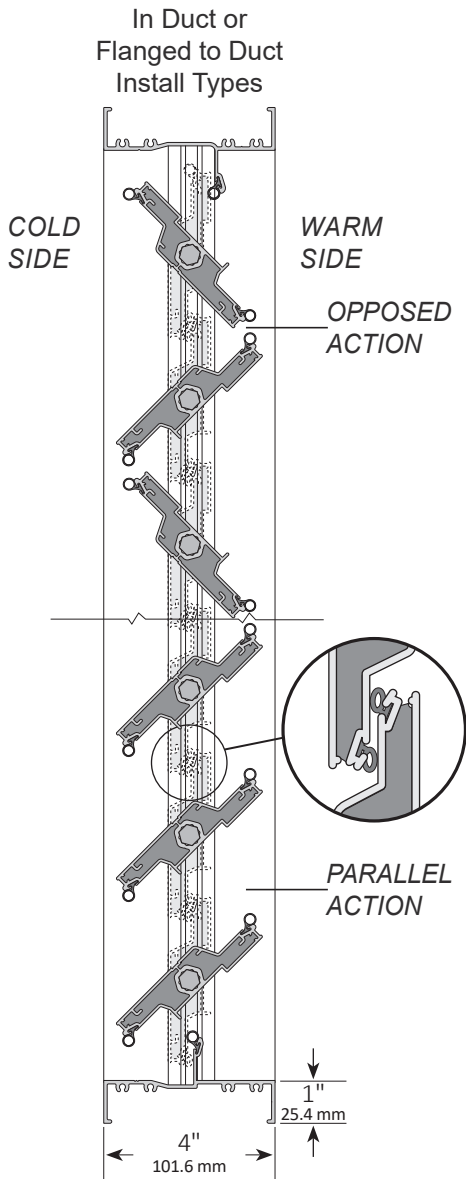

Extended Rear Flange Install Type

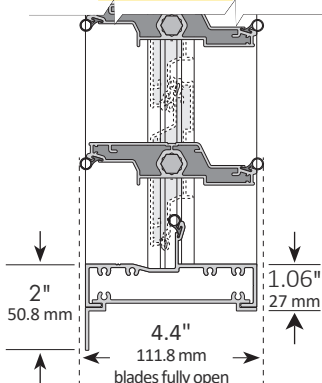

1. Extruded aluminum (6063-T5) damper frame is not less than 0.080" (2.03 mm) in thickness. Damper frame is 4" (101.6 mm) deep x 1" (25.4 mm), with mounting flanges on both sides of frame. Damper frame has a 2" (50.8 mm) mounting flange on the rear of the damper, when ordered as Extended Rear Flange install type.
2. Blades are 4" (101.6 mm) deep extruded aluminum (6063-T5) profiles, internally insulated with expanded polyurethane foam and thermally broken. Complete blade has an insulating factor of R-2.29. Each blade seal extends only 0.2" (5.1 mm) beyond the frame when in the full open position. All blades are symmetrically pivoted.
3. Blade seals are extruded EPDM. Frame seals are extruded silicone. Seals are secured in an integral slot within the aluminum extrusions. Blade and frame seals are mechanically fastened to prevent shrinkage and movement over the life of the damper.
4. Bearings are composed of a Celcon inner bearing - fixed around a 7/16" (11.11 mm) aluminum hexagon blade pivot pin - rotating within a polycarbonate outer bearing inserted in the frame. This eliminates action between metal-to-metal or metal-to-plastic riding surfaces.
5. Adjustable 7/16" (11.11 mm) hexagonal drive rod, U-bolt fastener, and hexagonal retaining nuts are zinc-plated steel. These provide a positive connection to blades and linkage.
6. Aluminum and corrosion-resistant zinc-plated steel linkage hardware is installed in the frame side, complete with cup-point trunnion screws for a slip-proof grip.
7. Dampers are designed for operation in temperatures ranging from -40°F (-40°C) to 212°F (100°C).
8. Leakage rate through a 36" x 36" (915 mm x 915 mm) does not exceed 1.19 cfm/ft² (6.0 l/s/m²) against 1 in. w.g. (0.25 kPa) differential static pressure. Tested in accordance with ANSI/AMCA Standard 500-D.
9. Dampers are custom made to required size, without blanking off free area. The blade stop is set at a fixed height and is a continuous and integral part of the top and bottom frames.
10. Dampers are available with either opposed blade action or parallel blade action.
11. Dampers are available in four install types: Installed In Duct, Flanged to Duct, Extended Rear Flange, and Square to Round Transition. (See Install Type pages for details.)
12. Installation of dampers must be in accordance with TAMCO's current on-line installation guidelines. (Printed installation guidelines are provided with each damper shipment, however all technical information available on TAMCO's web site at www.tamcodampers.com supersedes information contained within printed versions.)
13. Intermediate structural support is required to resist applied pressure loads for dampers that consist of two or more sections in both height and width. (See TAMCO Aluminum Damper Installation Guidelines.)

OPTIONS FOR NP - NARROW PROFILE:

For each option listed, replace the lines above with their corresponding lines below.

SC - SEVERE COLD TEMPERATURE OPTION:

3. Blade and frame seals are extruded silicone, for reduced air leakage at colder temperatures. Blade and frame seals are secured in an integral slot within the aluminum extrusions and are mechanically fastened to prevent shrinkage and movement over the life of the damper.
8. Leakage rate through a 48" x 36" (1220 mm x 915 mm) does not exceed 1.07 cfm/ft² (5.4 l/s/m²) against 1 in. w.g. (0.25 kPa) differential static pressure. Tested in accordance with ANSI/AMCA Standard 500-D.


MR - MOISTURE RESISTANCE OPTION:

1. Extruded aluminum (6063-T5) damper frame is not less than 0.080" (2.03 mm) in thickness. Damper frame is 4" (101.6 mm) deep x 1" (25.4 mm), with mounting flanges on both sides of frame. Damper frame has a 2" (50.8 mm) mounting flange on the rear of the damper, when ordered as Extended Rear Flange install type. Frame is assembled using stainless steel screws.
5. Adjustable 7/16" (11.11 mm) hexagonal drive rod, U-bolt fastener, and hexagonal retaining nuts are stainless steel. These provide a positive connection to blades and linkage.
6. Aluminum and stainless steel linkage hardware is installed in the frame side, complete with stainless steel cup-point trunnion screws for a slip-proof grip.

SW - SALT WATER RESISTANCE OPTION:

1. Extruded aluminum (6063-T5) damper frame is not less than 0.080" (2.03 mm) in thickness. Damper frame is 4" (101.6 mm) deep x 1" (25.4 mm), with mounting flanges on both sides of frame. Damper frame has a 2" (50.8 mm) mounting flange on the rear of the damper, when ordered as Extended Rear Flange install type. Aluminum frame is clear anodized to a minimum depth of 0.7 mil (18 microns). Frame is assembled using stainless steel screws.
2. Blades are 4" (101.6 mm) deep extruded aluminum (6063-T5) profiles, internally insulated with expanded polyurethane foam and thermally broken. Complete blade has an insulating factor of R-2.29. Each blade seal extends only 0.2" (5.1 mm) beyond the frame when in the full open position. All blades are symmetrically pivoted. Extruded aluminum blades are clear anodized to a minimum depth of 0.7 mil (18 microns).
3. Blade and frame seals are extruded silicone, for reduced air leakage at colder temperatures. Blade and frame seals are secured in an integral slot within the aluminum extrusions and are mechanically fastened to prevent shrinkage and movement over the life of the damper.
5. Adjustable 7/16" (11.11 mm) hexagonal drive rod, U-bolt fastener, and hexagonal retaining nuts are stainless steel. These provide a positive connection to blades and linkage.
6. Clear anodized aluminum and stainless steel linkage hardware is installed in the frame side, complete with stainless steel cup-point trunnion screws for a slip-proof grip.
8. Leakage rate through a 48" x 36" (1220 mm x 915 mm) does not exceed 1.07 cfm/ft² (5.4 l/s/m²) against 1 in. w.g. (0.25 kPa) differential static pressure. Tested in accordance with ANSI/AMCA Standard 500-D.

VELOCITY VS. PRESSURE DROP

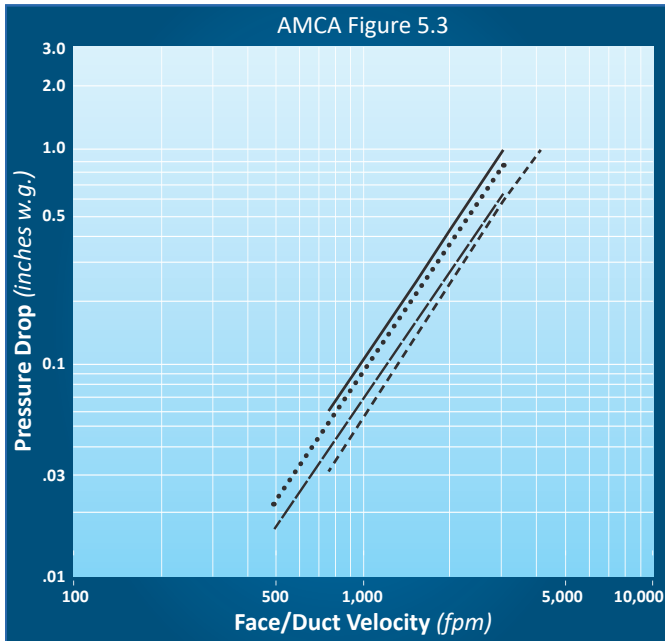

LEGEND:


12" x 12" (305 mm x 305 mm) ———
12" x 24" (305 mm x 610 mm) - - - - -

24" x 12" (610 mm x 305 mm)
24" x 24" (610 mm x 610 mm) - - - - -

FIG. 5.3 Test damper is fully ducted with a 5 diameter duct run upstream, and a 6 diameter duct run downstream. Air Performance testing was conducted in accordance with ANSI/AMCA Standard 500-D.

Pressure drop values are based on Flanged to Duct install type. Pressure drop will be greater for In Duct install type dampers.

BLADE DESIGN PRESSURE LIMITATIONS

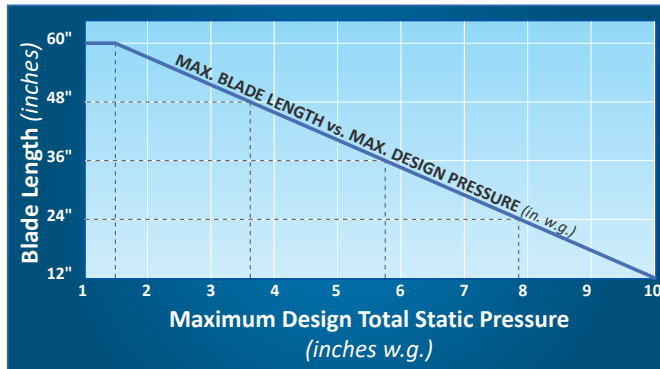

Series 9000 dampers with NP – Narrow Profile, whose blade length exceeds the maximum design pressure, may be reconfigured to maintain a blade length compatible with the required system pressure by increasing the number of sections per damper and thereby reducing each damper section's blade length. Appropriate intermediate structural support will be required for all multiple-section damper assemblies. (Refer to line 13 of the Submittal Data and to TAMCO's Aluminum Damper Installation Guidelines.)

Example:

A single-section damper of 60" w x 36" h (1524 mm x 915 mm) at 5 in. w.g. (1.24 kPa) would need to be built in two sections of 30" w x 36" h (762 mm x 915 mm).

Thermally Insulated Damper with Thermally Broken Blades

- > Always provide opening width and height dimensions, when ordering.
- > Width dimension is always parallel to blades.
- > Height dimension is always perpendicular to blades.

INSTALLED IN DUCT TYPE ▼

- > Applies to SP and NP Profiles only. Not available for WP Profile.
- > Finished damper O.D. is $\frac{1}{2}$ " (12.7 mm) less than opening width and height dimensions.

MINIMUM SECTION SIZE:

6½" w x 6¾" h (166 mm x 172 mm)

MAXIMUM SECTION SIZE:

25 ft² (2.3 m²)

60" w x 60" h or (1524 mm x 1524 mm) or

48" w x 75" h (1220 mm x 1905 mm)



FLANGED TO DUCT TYPE ▼

- > For SP and NP Profiles, finished damper O.D. is 2" (50.8 mm) greater than opening width and height dimensions.
- > For WP Profile, finished damper O.D. is 3.25" (82.6 mm) greater than opening width and height dimensions.

MINIMUM SECTION SIZE:


4½" w x 4¾" h (115 mm x 108 mm)

MAXIMUM SECTION SIZE:

25 ft² (2.3 m²)

60" w x 60" h or (1524 mm x 1524 mm) or

48" w x 75" h (1220 mm x 1905 mm)

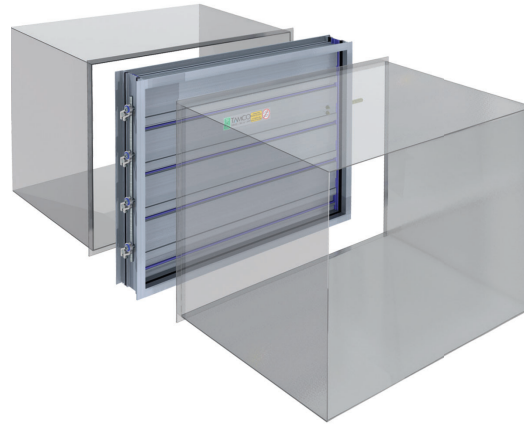

EXTENDED REAR FLANGE TYPE ▼

- > Applies to SP and NP Profiles only. Not available for WP Profile.
- > Finished damper O.D. is 4" (101.6 mm) greater than opening width and height dimensions.

MINIMUM SECTION SIZE:

4½" w x 4¾" h (115 mm x 108 mm)

MAXIMUM SECTION SIZE:

25 ft² (2.3 m²)

60" w x 60" h or (1524 mm x 1524 mm) or

48" w x 75" h (1220 mm x 1905 mm)

- > Extended Rear Flange install type dampers are not designed so that the front of the damper may be inserted into an opening, as the side frame members extend to the full height of the rear flange.





American Ultraviolet

Coil Clean (CC) Series

American Ultraviolet High-output CC Series utility fixtures

are designed specifically for HVAC applications. They can be mounted in various configurations for optimum pass-by air decontamination and/or to irradiate cooling coils and drain pans. Individual fixtures can be mounted to plenum walls or multiple fixtures can mount to frame assemblies that span supply ducts or cooling coils.


Applications

CC Series fixtures from American Ultraviolet are ideal for internal installation in medium to large air handling systems in commercial, industrial, health care and institutional buildings.

CC Series Fixtures are offered as single and double lamp configurations with “moisture proof” construction. They may be mounted individually; in built-up banks; or in parallel rack-system configurations in a variety of locations, including coils, drain pans, ductwork, mixed air plenums and exhaust systems. The CC Series is available in five lengths (18”, 24”, 36”, 48”, and 60”) and four voltage options (115, 208, 230 or 277 VAC), providing installation flexibility to accommodate virtually any system.

CC Series fixtures are designed for “moisture-proof” applications with UVC lamps that incorporate a built-in outer quartz sleeve with protective boot on the power end for sealing purposes. Power is brought to the lamp through a waterproof connector that is securely sealed to the lamp with coated lead wires. Lamps are rated for two-year continuous operational life with approximately 20% drop in UVC output at end of lamp life.

CC Series

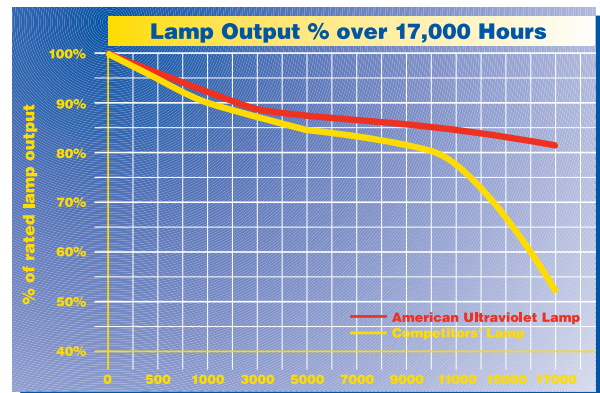

Benefits

- Improves Indoor Air Quality (IAQ) by reducing bacteria, viruses and mold that either grow or pass through the air handling systems. Reduces the risk of cold, flu, allergies and other illness associated with air handling systems
- “Green” lamps contain $\leq 8\text{mg}$ of mercury
- Two-year (17,000 hours) guarantee on lamps with only 20% decrease in output over the two years
- Five-year, non-prorated warranty on the ballast
- Continuously cleans coils, drain pans, plenums and ducts - eliminating costly cleaning programs and the use of harmful chemicals and disinfectants
- Reduces HVAC energy costs by restoring heat transfer and net cooling capacity
- Produces no ozone or other secondary contaminants
- Plug-in connections mean no field wiring required to connect fixture to fixture when building banks of rack systems



American Ultraviolet

Since 1960. It's all we do.

AUV CC SERIES

Coil Clean (CC) Series

CC SERIES SPECIFICATIONS:

Every CC Series fixture is manufactured and factory assembled in the U.S.A., and tested prior to shipment. Each assembly consists of housing, reflector, electronic ballast(s), lamp bracket, plug-in power connectors and high output lamp(s).

FIXTURE: Housings are constructed of heavy gauge hospital grade stainless steel. Reflectors are fabricated from the highest grade bright annealed polished stainless steel, which has a reflectivity rate of 88% when exposed to short-wave UVC in the range of 254 nm. All components are in one integrated assembly to maximize serviceability.

BALLAST: The solid-state electronic ballast (furnished with this series), is a Class P rapid start with a power factor minimum of .95. It is available as a 120, 208, 230, or 277 VAC 50/60 Hz and is designed to maximize photon production in air temperatures of 35 to 175 degrees F. Minimum ballast start temperature is minus 20 degrees F. Ballasts have a RFI - EMI rating as defined by FCC part 18A for industrial / commercial applications in regards to suppression. Ballasts are UL listed and suitable for use in air handling spaces.

LAMPS: CC Series UVC lamps are high-output (800mA), T5 tube diameter, and constructed from hard glass tubing for superior UV transmittance. Lamps are "green", containing ≤ 8 mg of mercury (Hg) and they produce no ozone. Lamps shall retain, at minimum, 80% of initial output after 17,000 hours of use. They are sealed for moisture protection with a water-tight connection. Electrodes are designed to maximize plasma convection and stability for superior lamp performance. Lamps are rated to produce 11.7 microwatts/cm² per linear inch of lamp arc length at a distance of one meter. This output has been independently tested in airstreams of 400 feet per minute velocities at temperatures of 45 degrees F.

INDEPENDENT TESTING: Units are tested in accordance with the general provisions of IES Lighting Handbook, 1981 Applications Volume, and provide output per 1" arc length of not less than 11.7 μ W/cm² at 1 meter in a 400 fpm airstream of 45° F.



Water-tight lamp connection



Connect multiple fixtures to one power source



Hardwire fixtures are also available

| | | CC Series Fixture Offerings | | | | | |
|---------------------|-----------------------|-----------------------------|-------------|-----------------------|------------|-------------------|--|
| | | 120VAC 50/60Hz | | 208/230VAC 50/60Hz | | 277VAC 50/60Hz | |
| | | End-to-End Plug-in | Hardwire | End-to-End Plug-in | Hardwire | Hardwire | |
| 2-LAMP UNITS | Fixture Length | | | | | | |
| | 18" | CC18-2-120C | CC18-2-120 | CC18-2-230C | CC18-2-230 | CC18-2-277 | |
| | 24" | CC24-2-120C | CC24-2-120 | CC24-2-230C | CC24-2-230 | CC24-2-277 | |
| | 36" | CC36-2-120C | CC36-2-120 | CC36-2-230C | CC36-2-230 | CC36-2-277 | |
| | 48" | CC48-2-120C | CC48-2-120 | CC48-2-230C | CC48-2-230 | CC48-2-277 | |
| 60" | CC60-2-120C | CC60-2-120 | CC60-2-230C | CC60-2-230 | CC60-2-277 | | |
| 1-LAMP UNITS | Fixture Length | | | | | | |
| | 18" | CC18-1-120C | CC18-1-120 | CC18-1-230C | CC18-1-230 | CC18-1-277 | |
| | 24" | CC24-1-120C | CC24-1-120 | CC24-1-230C | CC24-1-230 | CC24-1-277 | |
| | 36" | CC36-1-120C | CC36-1-120 | CC36-1-230C | CC36-1-230 | CC36-1-277 | |
| | 48" | CC48-1-120C | CC48-1-120 | CC48-1-230C | CC48-1-230 | CC48-1-277 | |
| 60" | CC60-1-120C | CC60-1-120 | CC60-1-230C | CC60-1-230 | CC60-1-277 | | |

All CC Fixtures are 3.07" wide and 5.2" deep (including lamps). **End-to-End Plug-in units require one (1) female junction box and one end cover per row; Junction Box 2540-15B, End Cover 2540-18.** Amperage draw provided on submittal drawings. **Cord kits available for 120V hardwire units to plug into standard 120V receptacle.**



American Ultraviolet

Since 1960. It's all we do.

www.americanultraviolet.com

212 South Mt. Zion Road • Lebanon, IN 46052
(765) 483-9514 • (800) 288-9288 • Fax: (765) 483-9525

Represented by:


Light Wiring Diagram

Feed Here

120/1/60

Neu

Hot

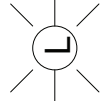

This drawing and its contents is the property of the VTS Clima company and may not be copied or otherwise disclosed to any third party without our consent. Contravenions will be prosecuted.

| No | Symbol | Name | Rating | Replacement |
|---------|--------|------|--------|---------------------|
| Design: | | | | Page: |
| Draft: | | | | Version / Revision: |
| Check: | | | | Format |
| Name: | | | | A3 |
| | | | | Drawing number |
| | | | | XXX.XXX.XXX |
| | | | | Index |





Cabinet & Casing Coating

- ✓ *Corrosion protection*
- ✓ *UV resistant*
- ✓ *For harsh environments (C1-C5M)*
- ✓ *Abrasion resistant*

Blygold HVAC Cabinet & Casing protection

Blygold casing coatings provide a long lasting corrosion protection for HVAC equipment. The coatings are developed to be the perfect add-on to the standard applied OEM coatings systems. The Blygold coating techniques and procedures create protection on all vulnerable surfaces like cutting edges, screws and bolts, tubing and construction parts. The protective coatings can be applied in the factory as well as on-site.


Blygold has been specializing in HVAC equipment coating for more than 40 years. Our applicators know how to handle this vulnerable equipment. Blygold maintains a quality standard that makes customers come back over and over again not only in coating application, but also in logistics and service.



*Special coatings
and unique
applications:
HVAC equipment
protection calls
for specialists*

Blygold Casing Coating compliant with ISO 12944-6

To assist corrosion experts, engineers and consultant in selecting the best corrosion protection option for every specific situation, guidelines are set in ISO 12944-6. This international standard describes different corrosion classes, and sets the benchmark on corrosion protection of steel structures by protective paint systems. Blygold coating formulas are compliant with ISO 12944-6.

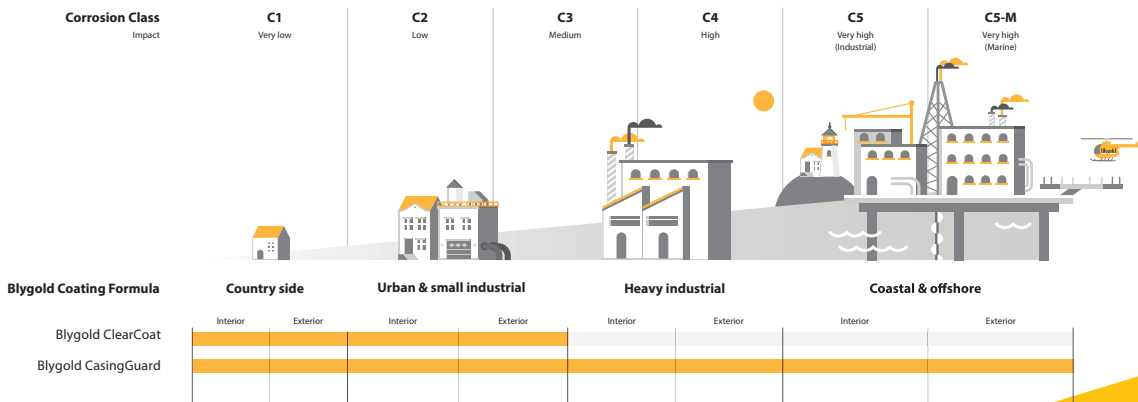

Designed for the job!

Ever since Blygold was founded in 1976, our core business focused specifically on corrosion protection of HVAC equipment and especially heat exchangers. This makes us unique, and it's the reason why still today Blygold is global market leader in this industry. Our own R&D department is constantly testing and improving our range of products and services. This mentality makes Blygold the benchmark application in our industry. Blygold products are always specifically designed for their purpose. Blygold PoluAl coatings are designed to offer maximum corrosion protection without affecting the efficiency of the heat exchanger. Blygold ClearCoat and Blygold CasingGuard offer optimal protection for cabinet and casings. Blygold CasingGuard system is to be used in severe corrosive conditions while the Blygold ClearCoat system provides good protection for moderate corrosive applications. Your local Blygold representative can help you in deciding which coating system is most suitable for your application.

BLYGOLD CASINGGUARD



Blygold developed the Casing Guard coating system for the most severe exposure conditions. HVAC equipment at oil platforms, coastal environments or wastewater plants are examples where the system has a long track record. All reasonable accessible surfaces are thoroughly pretreated, primed with Refamac 3509 and finished with Refamac 3800. The primer creates excellent adhesion to OEM coatings and bare metals, special metallic pigments provide the first corrosion protective barrier. The finishing coating "3800" is designed to create coverage even on vulnerable sharp edges. The thin layer technology creates a smooth and extremely protective finish with limited layer thickness.

BLYGOLD CLEARCOAT



Blygold Clearcoat is a transparent coating system that enhances the existing OEM coating properties. The coating adheres directly to several coating types without special primer or pre-treatment. The finished surface has a high gloss and has an extremely long resistance against UV exposure. The application of the Blygold Clearcoat will also bring back faded colours of HVAC equipment. The thin and smooth film has repellent properties that limits the adhesion of pollution. The coating is applied after thorough cleaning of all visible surfaces of the HVAC equipment. Because of the transparency of the coating, the unit will maintain the original OEM colour.

| TECHNICAL INFORMATION | BLYGOLD CASINGGUARD | BLYGOLD CLEARCOAT |
|--|--|-----------------------------------|
| Color | Ral 7001 (or as specified) | Transparent |
| Pretreatment | Degreasing, sanding and primecoat Refamac 3509 | Degreasing (Blygold CoilClean AP) |
| Substrates | Bare metals, plastics & OEM coatings | OEM coatings |
| Gloss retention ASTM G154 / ISO11507 | 5.000h >75% | 30.000h >90% |
| Adhesion ASTM 3359 b | 5B | 5B |
| Saltspray test ASTM B117 / ISO 9227-NSS | >7.500h | >4.000h (OEM coating dependent) |
| Pull of test ISO 4624 / ASTM D4541 | 9,3 MPa / 9,1 MPa | ND |
| Class acc. standard ISO 12944 PART 6 | C5-I | C3-C4 (as finish in system) |
| Layer thickness | 4-6 mil (100-150 micron) | 1-2 mil (25-50 micron) |
| Abrasion resistance ASTM D4060 | - | 150 mg / 4.000 turns |
| Flexibility ASTM D522 | - | 10 mm |



BLYGOLD INTERNATIONAL

Blygold is an innovative and forward-thinking company offering unique and sustainable high-quality protection against corrosion. With over 40 years experience, we have the know-how and state-of-the-art products and techniques to solve any corrosion problem. Our multitude of success stories says it all.

Application protocols

To protect air-conditioning equipment from corrosion in aggressive conditions, the quality of the application process is just as important as the applied product. Blygold has developed specific application protocols for air-conditioning equipment of all different dimensions, geometries and materials.

Global network

To ensure our products are applied according to these protocols, Blygold works with trained and certified applicators only. Our global network of qualified Blygold applicators can offer local support in over 60 countries around the world.



Quality

- ✓ Over 40 years of experience
- ✓ Unique application techniques
- ✓ Unrivalled test results
- ✓ All trained & qualified applicators
- ✓ ISO 9001 Certified



Innovation

- ✓ Revolutionary R&D
- ✓ Inhouse laboratory
- ✓ Deep understanding of the market
- ✓ Global awareness of customer needs
- ✓ Problem solving mentality



Sustainability

- ✓ Lifetime extension
- ✓ Energy saving & Eco Friendly
- ✓ Life Cycle Cost reduction
- ✓ Maintenance friendly
- ✓ Corporate Social Responsibility

Blygold[®]
CORROSION PROTECTION

P.O. box 44 3990 DA Houten T. +31 30 634 43 44
The Netherlands E. info@blygold.com
www.blygold.com

Your local Blygold applicator

WILMINGTON COLLEGE

EDUCATION AND PSYCHOLOGY

BUILDING

BALLARD, McKIM and SAWYER Architects
Gardner - Kline Assoc. Structural Engineers
Henry Von Oesen and Assoc. Engineers

President William H. Wagoner

BOARD OF TRUSTEES

MR. L. BRADFORD TILLERY JR. - CHAIRMAN
 MR. FREDERICK GRAHAM - VICE CHAIRMAN
 MRS. C. D. HOGUE, JR. - SECRETARY
 MR. B. D. SCHWARTZ - TREASURER
 MR. ADDISON HEWLETT, JR.
 MR. WILLIAM HORACE CORBETT
 MR. FREDERICK COVILLE
 MR. ALAN A. MARSHALL
 DR. C. E. HARTFORD
 MR. JAMES M. SMITH
 MR. RAIFORD G. TRASK
 MR. EUGENE B. TOMLINSON, JR.

ARCHITECTURAL

- A-1 SITE PLAN
- A-2 SITE DETAILS
- A-3 FIRST FLOOR PLAN
- A-4 SECOND FLOOR PLAN
- A-5 FINISH SCHEDULE
- A-6 ELEVATIONS
- A-7 SMALL SCALE SECTIONS
- A-8 AUDITORIUM DETAILS, TOILETS, CABINETS
- A-9 STAIRS, PORCH DETAILS
- A-10 STEEL STUD DETAILS, RAMP, RAILING DETAILS
- A-11 DOOR & FRAME SCHEDULE & DETAILS
- A-12 REFLECTED CEILING PLAN
- A-13 BUILT-IN FURNISHINGS PLANS

STRUCTURAL

- S-1 FOUNDATION PLAN AND DETAILS
- S-2 FIRST FLOOR FRAMING PLAN
- S-3 SECOND FLOOR FRAMING PLAN, GENERAL NOTES
- S-4 SECOND FLOOR CEILING STRUCTURE, TRUSS DETAILS
- S-5 ROOF FRAMING PLAN
- S-6 TRUSS DETAILS
- S-7 TRUSS DETAILS
- S-8 PILING PLAN

EQUIPMENT

- EQ-1 LABORATORY CASEWORK

PLUMBING


- P-1 SMALL SCALE PLANS, FIXTURE SCHEDULE
- P-2 LARGE SCALE PLANS, RISER DIAGRAMS
- P-3 LARGE SCALE PLANS, DETAILS

ELECTRICAL

- E-1 LIGHTING PLANS, GENERAL NOTES, POWER RISER DIAGRAM
- E-2 RECEPTACLE PLANS, NOTES, LEGEND
- E-3 DETAILS, NOTES
- E-4 PANEL SCHEDULES, SITE PLAN

MECHANICAL

- M-1 BOILER ROOM PLAN, DETAILS
- M-2 AIR DISTRIBUTION PLANS
- M-3 CONTROLS, SCHEDULES

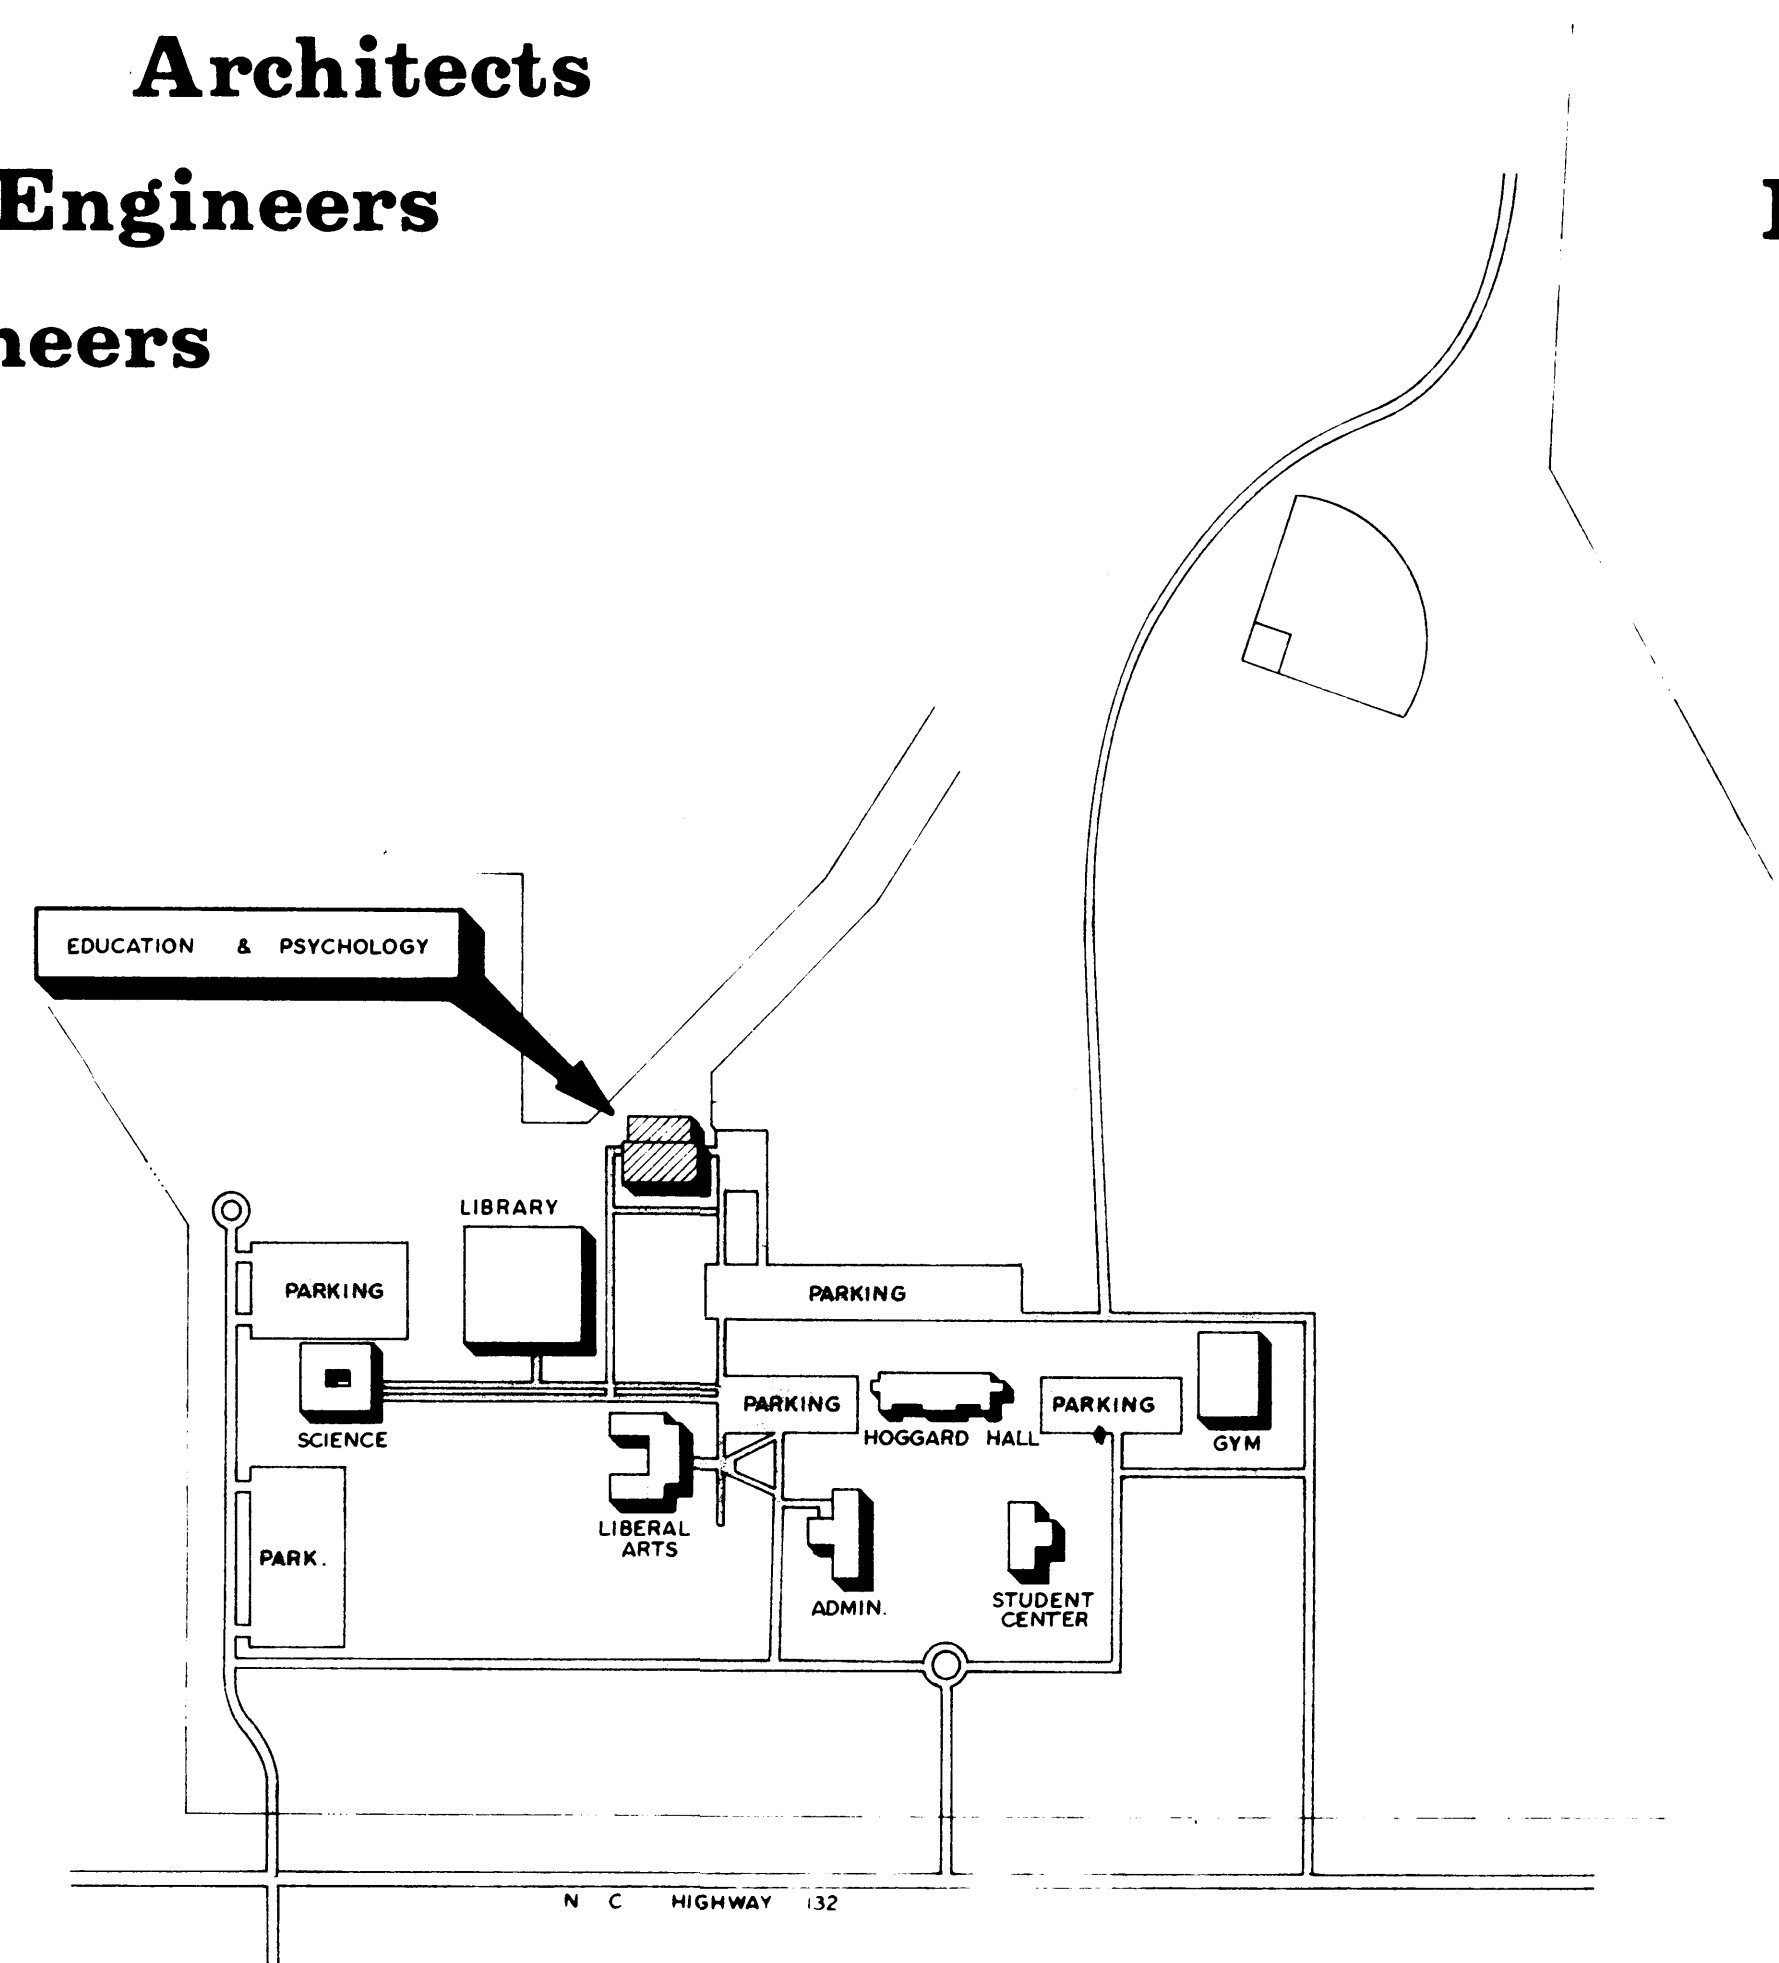

LEGEND OF SYMBOLS

| | | | |
|---------------------------------|-----------------------------|----------------------------------|----------------|
| BRICK PLAN SECTION ELEVATION | ACOUSTICAL TILE SECTION | ELEVATION LETTER DRAWING SH. NO. | INTERIOR ELEV. |
| MASONRY BLOCK PLAN & SECTION | PLASTER SECTION ELEVATION | DOOR NUMBER | DOOR |
| CONCRETE PLAN SECTION ELEVATION | INSULATION SECTION | SECTION LETTER DRAWING SH. NO. | SECTION |
| GRAVEL & CRUSHED STONE, SECTION | WOOD SECTION FINISH ROUGH | WINDOW | WINDOW |
| STEEL SECTION OR PLAN | TERRAZZO SECTION | DETAIL NUMBER DRAWING SH. NO. | DETAIL |
| STUD WALL (STEEL) PLAN | HARD TILE SECTION ELEVATION | SPACE NUMBER | SPACES |
| METAL PLAN OR SECTION ELEVATION | PLYWOOD SECTION ELEVATION | | |

PROJECT DATA

| | |
|------------------------------|---------|
| SQUARE FEET..... | 22,288 |
| CUBIC FEET..... | 755,552 |
| HEATING MBH..... | 900 |
| AIR COND. - TONS REFRIG..... | 90 |
| PLUMBING FIXTURE UNITS..... | 194 |
| WATER - G.P.M..... | 87 |
| ELECTRICAL LOAD - KW..... | 280 |

"AS-BUILT" DRAWING

DATE

SET

WILMINGTON COLLEGE EDUCATION & PSYCHOLOGY BUILDING
 WILMINGTON, NORTH CAROLINA
 BOARD OF TRUSTEES - L. BRADFORD TILLERY, JR. CHAIRMAN - DR. WILLIAM M. RANDALL, PRESIDENT



BALLARD, McKIM, & SAWYER, AIA
 612 SOUTH SEVENTEENTH STREET
 WILMINGTON, NORTH CAROLINA

PROJECT NO. 4-3-00358-0



CODE 66737 - ITEM 6

CONSTRUCTION NOTES

1. CLEAR AND GRADE ALL AREAS WITHIN PROJECT LIMIT EXCEPT TREES TO REMAIN WHERE DESIGNATED.
2. CONSTRUCTION JOINTS: SEE DETAIL THIS SHEET.

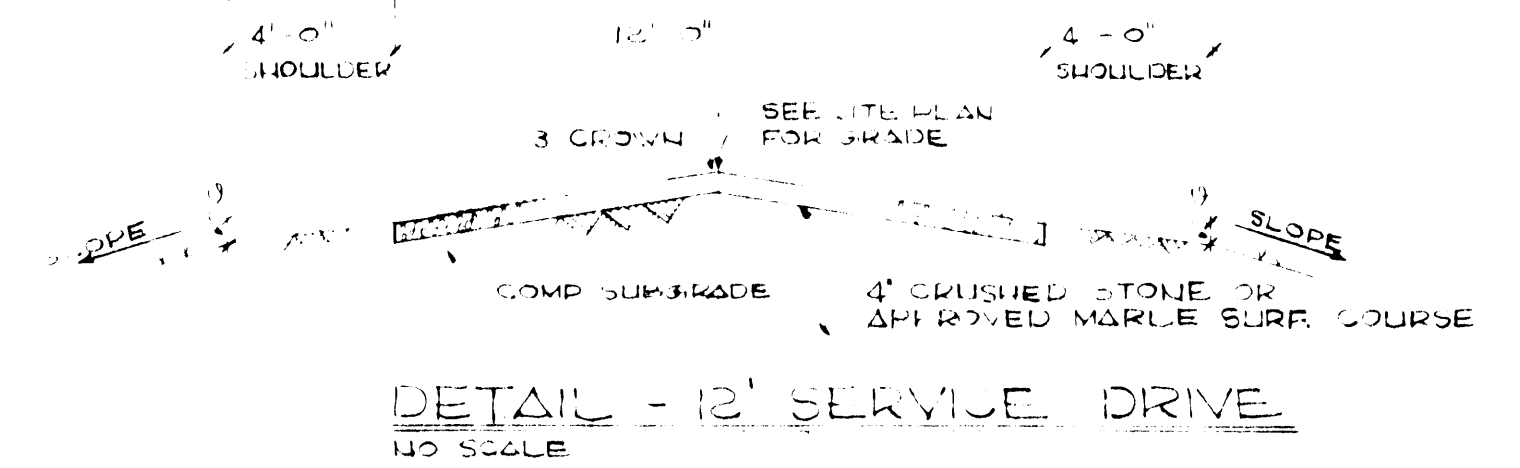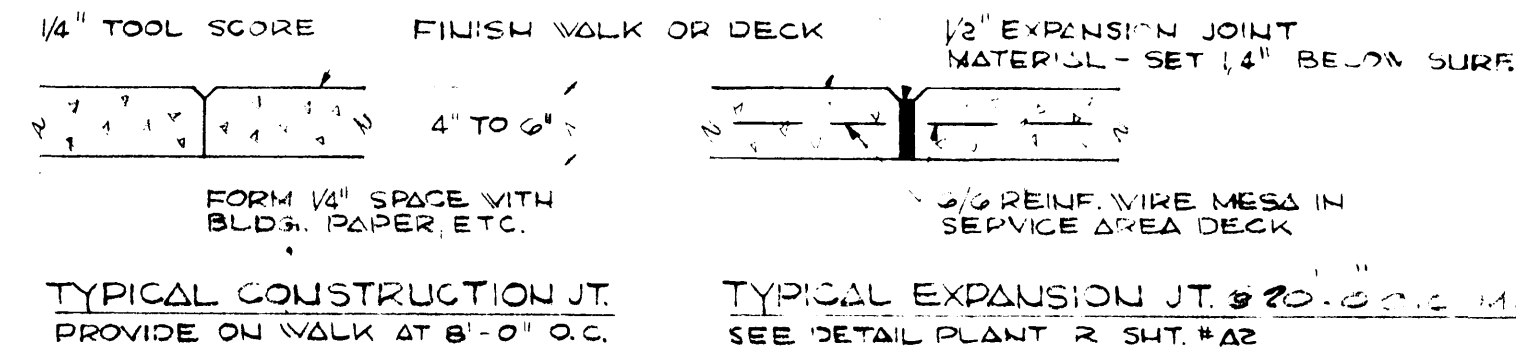

DETAIL - CONSTRUCTION JOINTS
NO SCALE

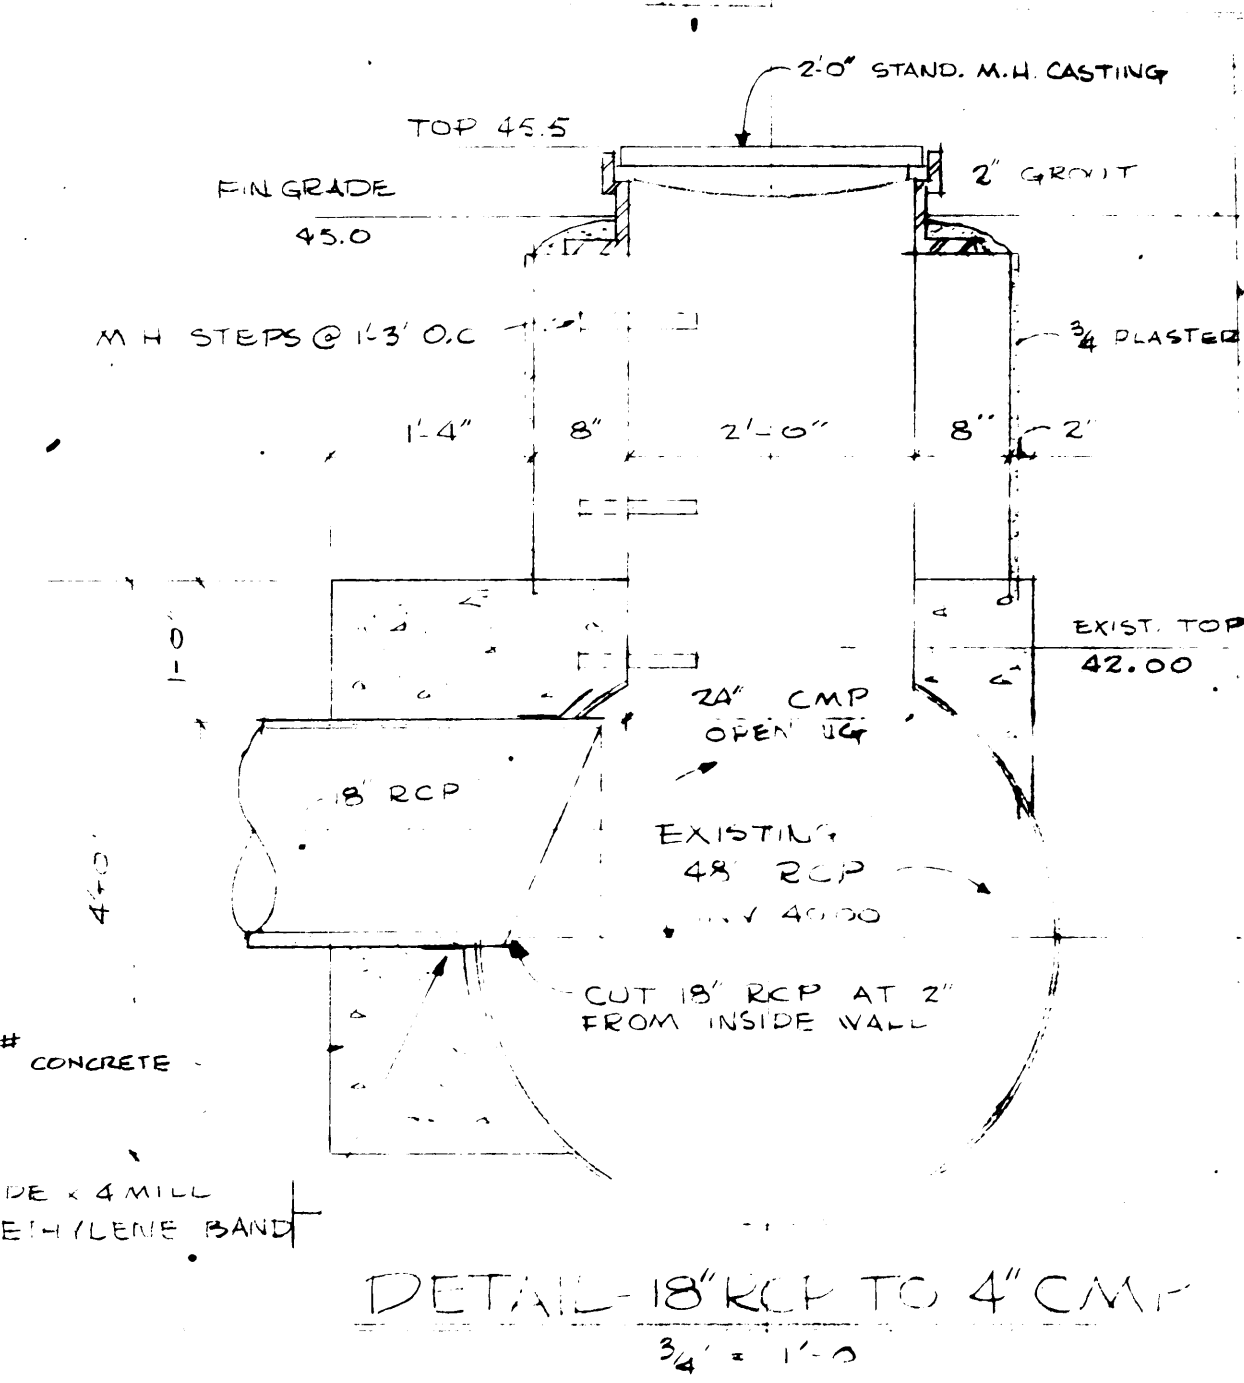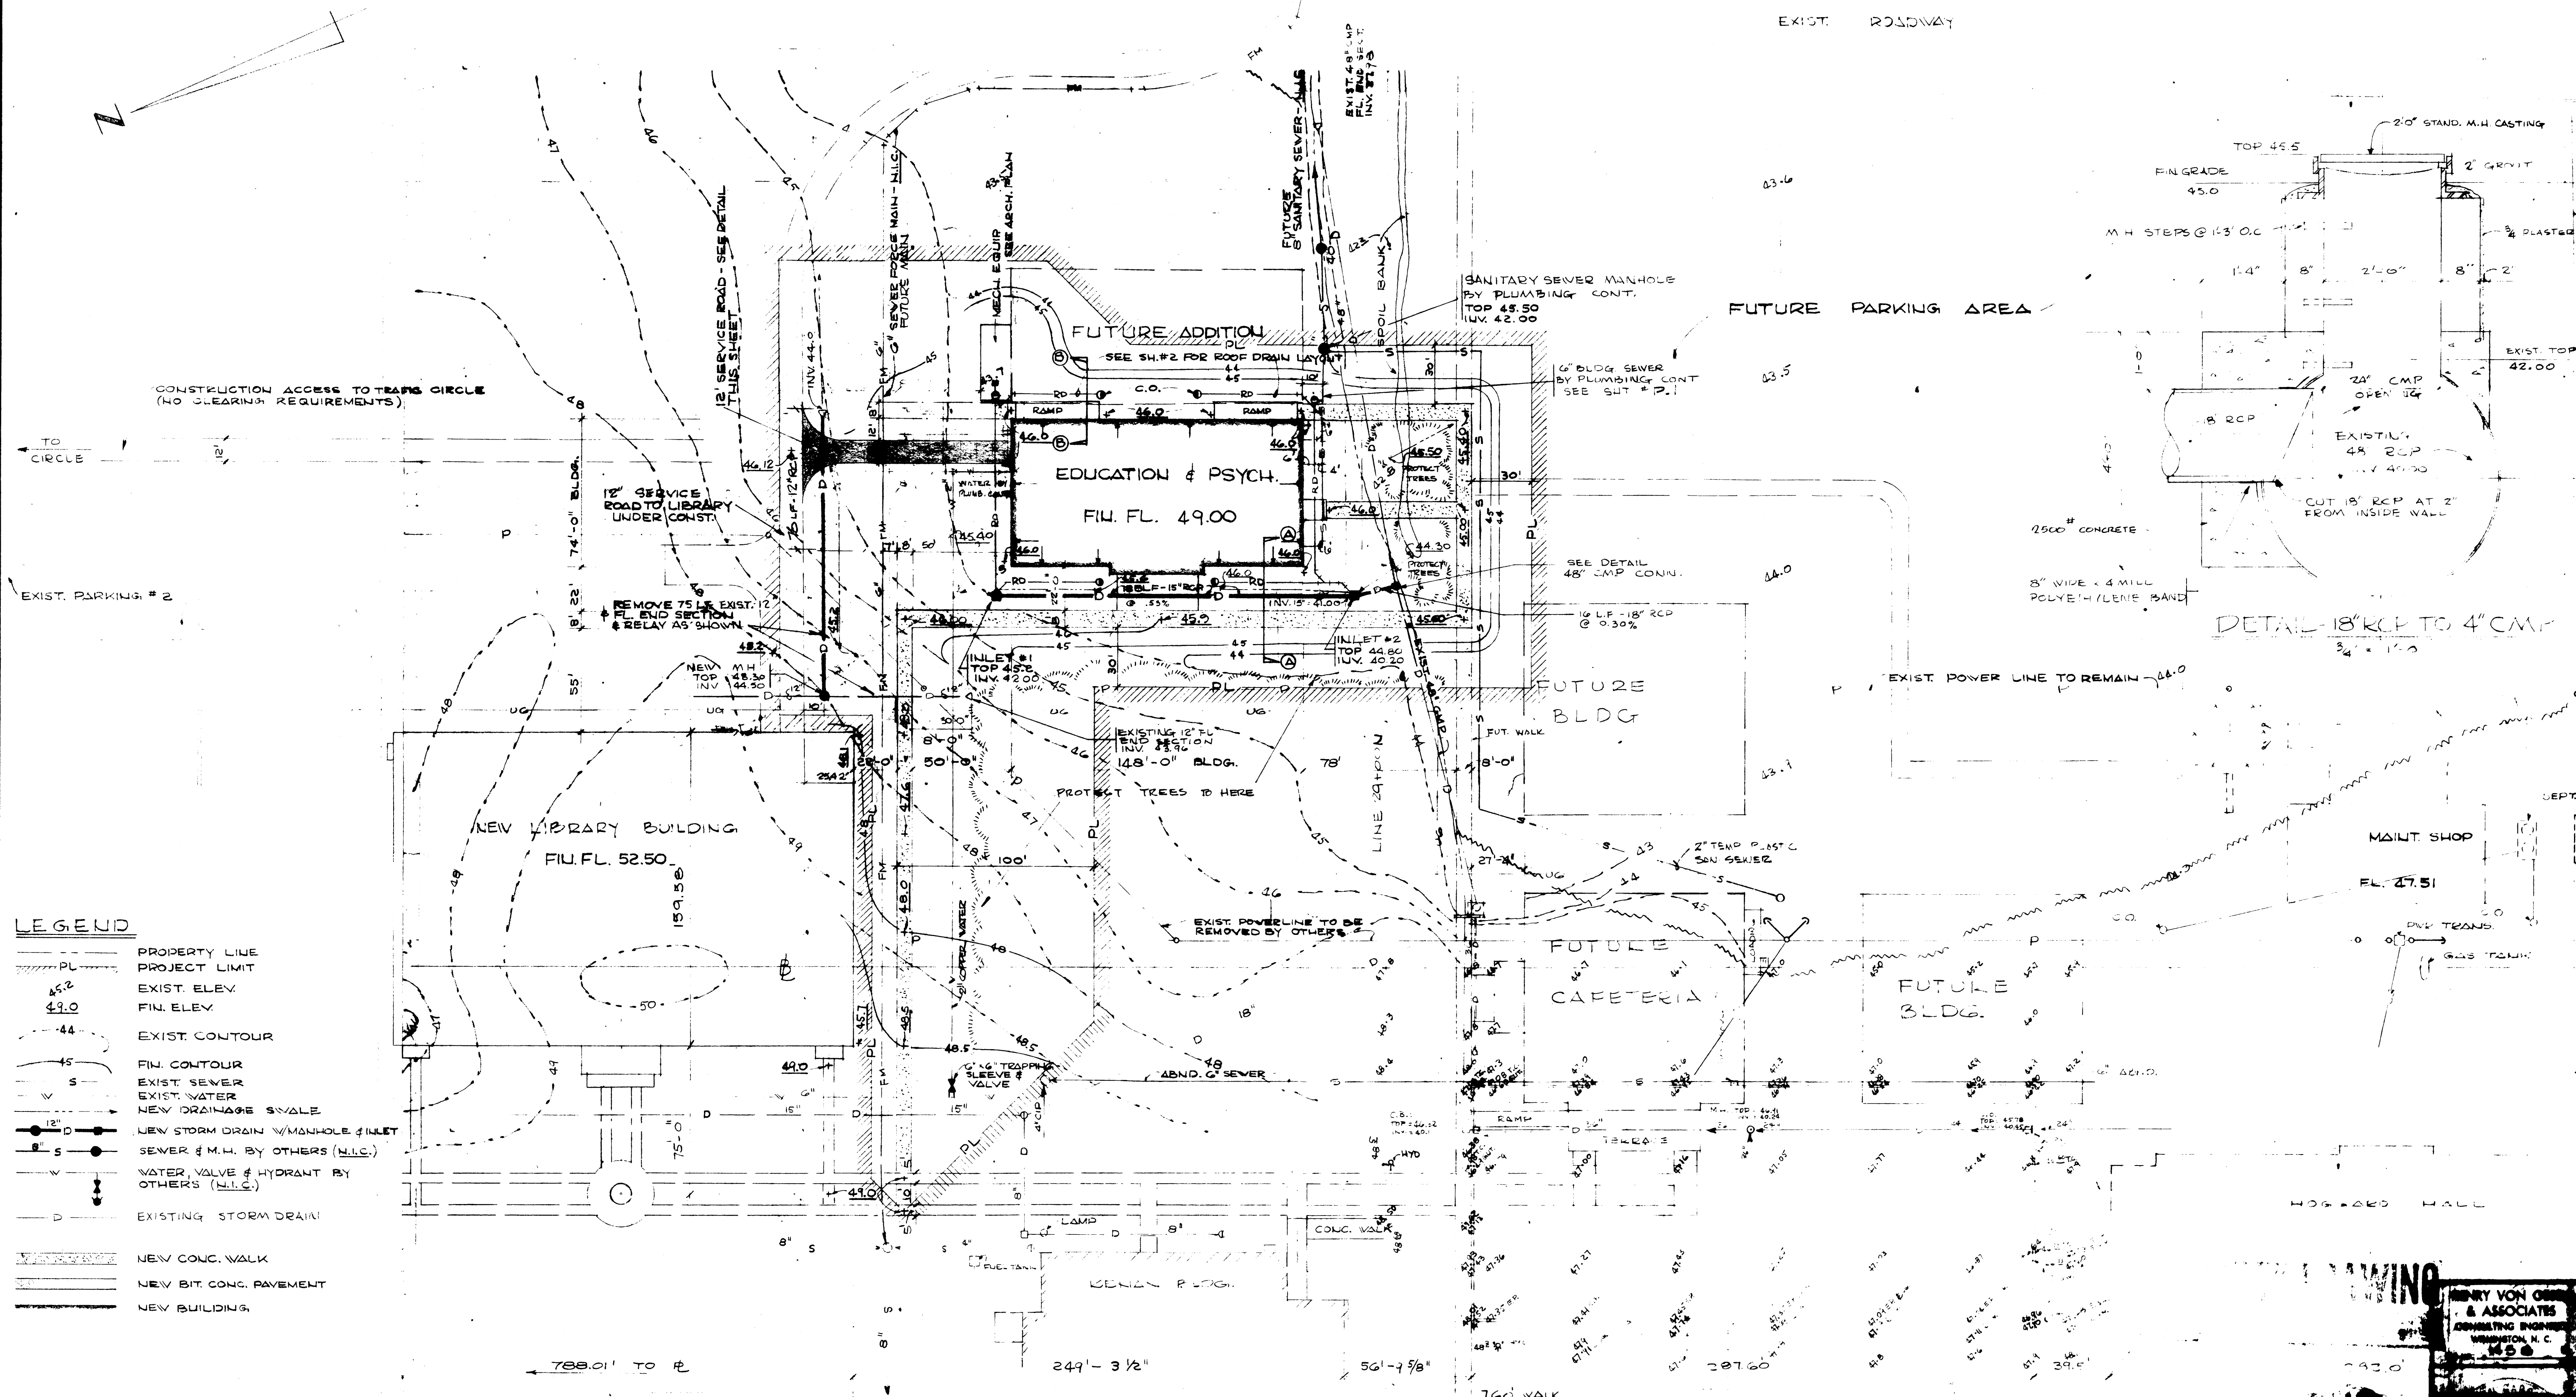

SITE PLAN

"AS-BUILT" DRAWING
DATE _____


HENRY VON GERN & ASSOCIATES
REGISTERED ENGINEER
WILMINGTON, N.C.
1998

WILMINGTON COLLEGE EDUCATION & PSYCHOLOGY BUILDING
WILMINGTON, NORTH CAROLINA
BOARD OF TRUSTEES - L. BRADFORD TILLERY, JR. CHAIRMAN - DR. WILLIAM M. RANDALL, PRESIDENT


BALLARD, MCKIM, & SAWYER, AIA
612 SOUTH SEVENTEENTH STREET
WILMINGTON, NORTH CAROLINA

7/16/98
DRAWN BY: HM
CHECKED BY: [Signature]
DATE: 7/16/98
SHEET NO. A-1


Southern Photo Print & Supply Co., Greensboro, N. C. 110 1-47

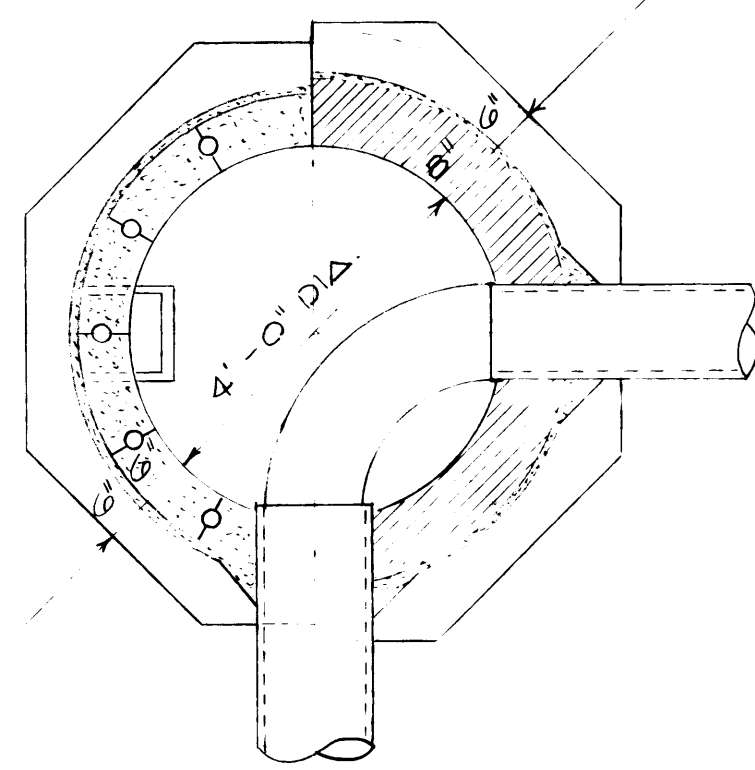


PLAN

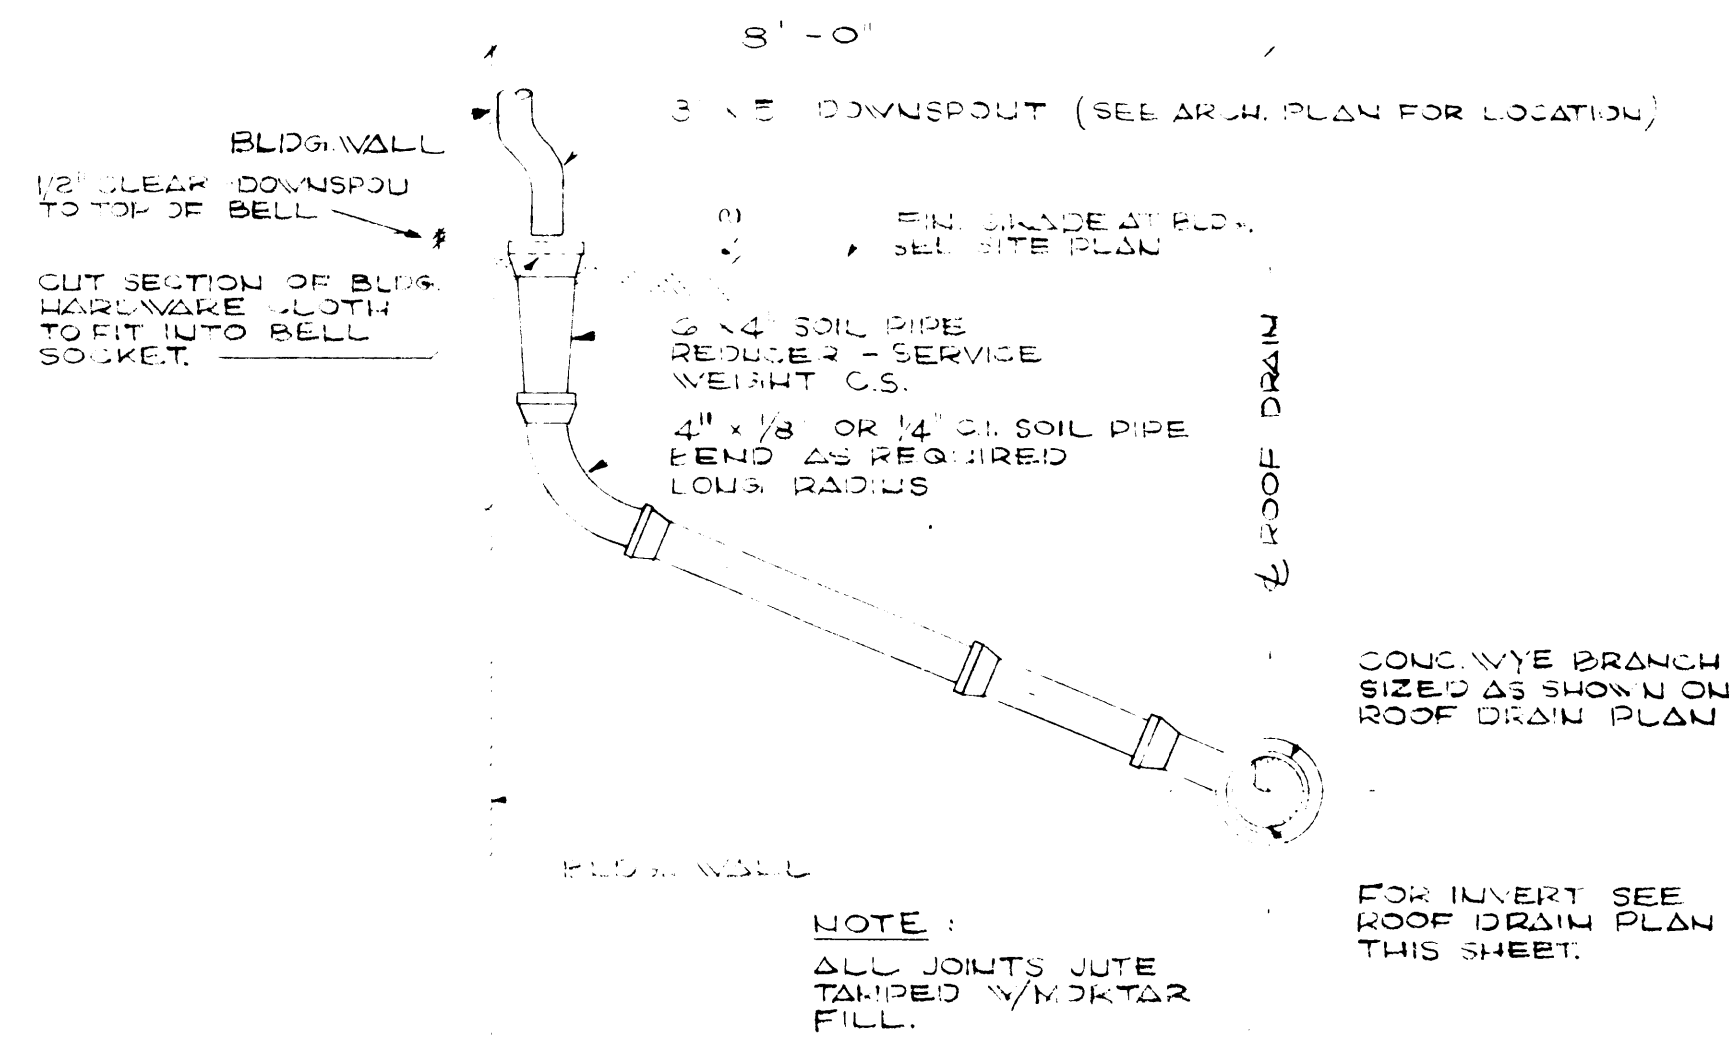


DETAIL A2 - DOWNSPOUT CONNECTION

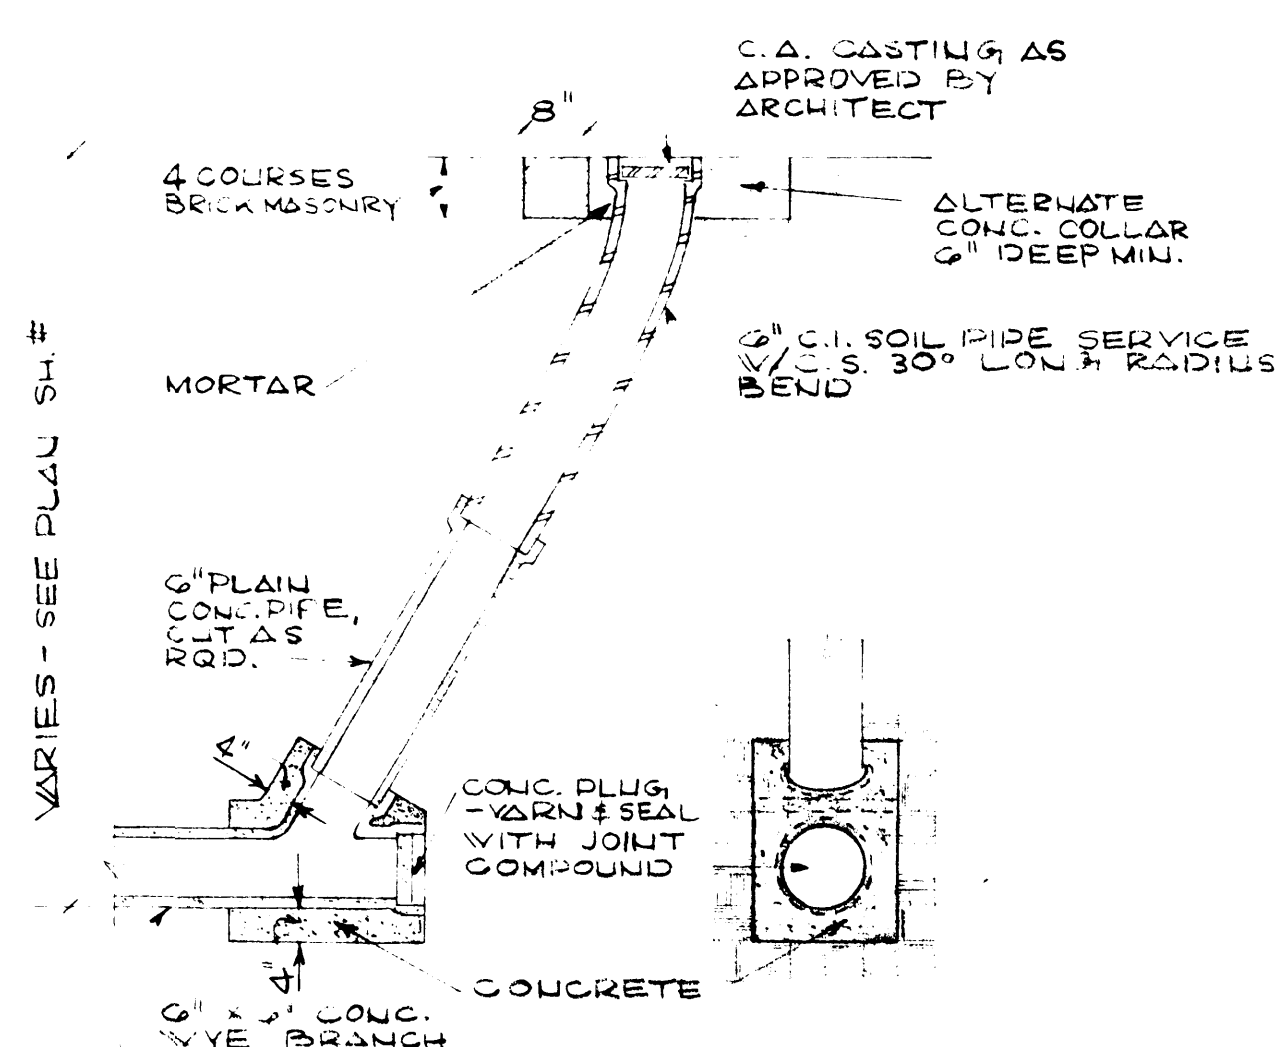

DETAIL B2 - ROOF DRAIN CLEANOUT

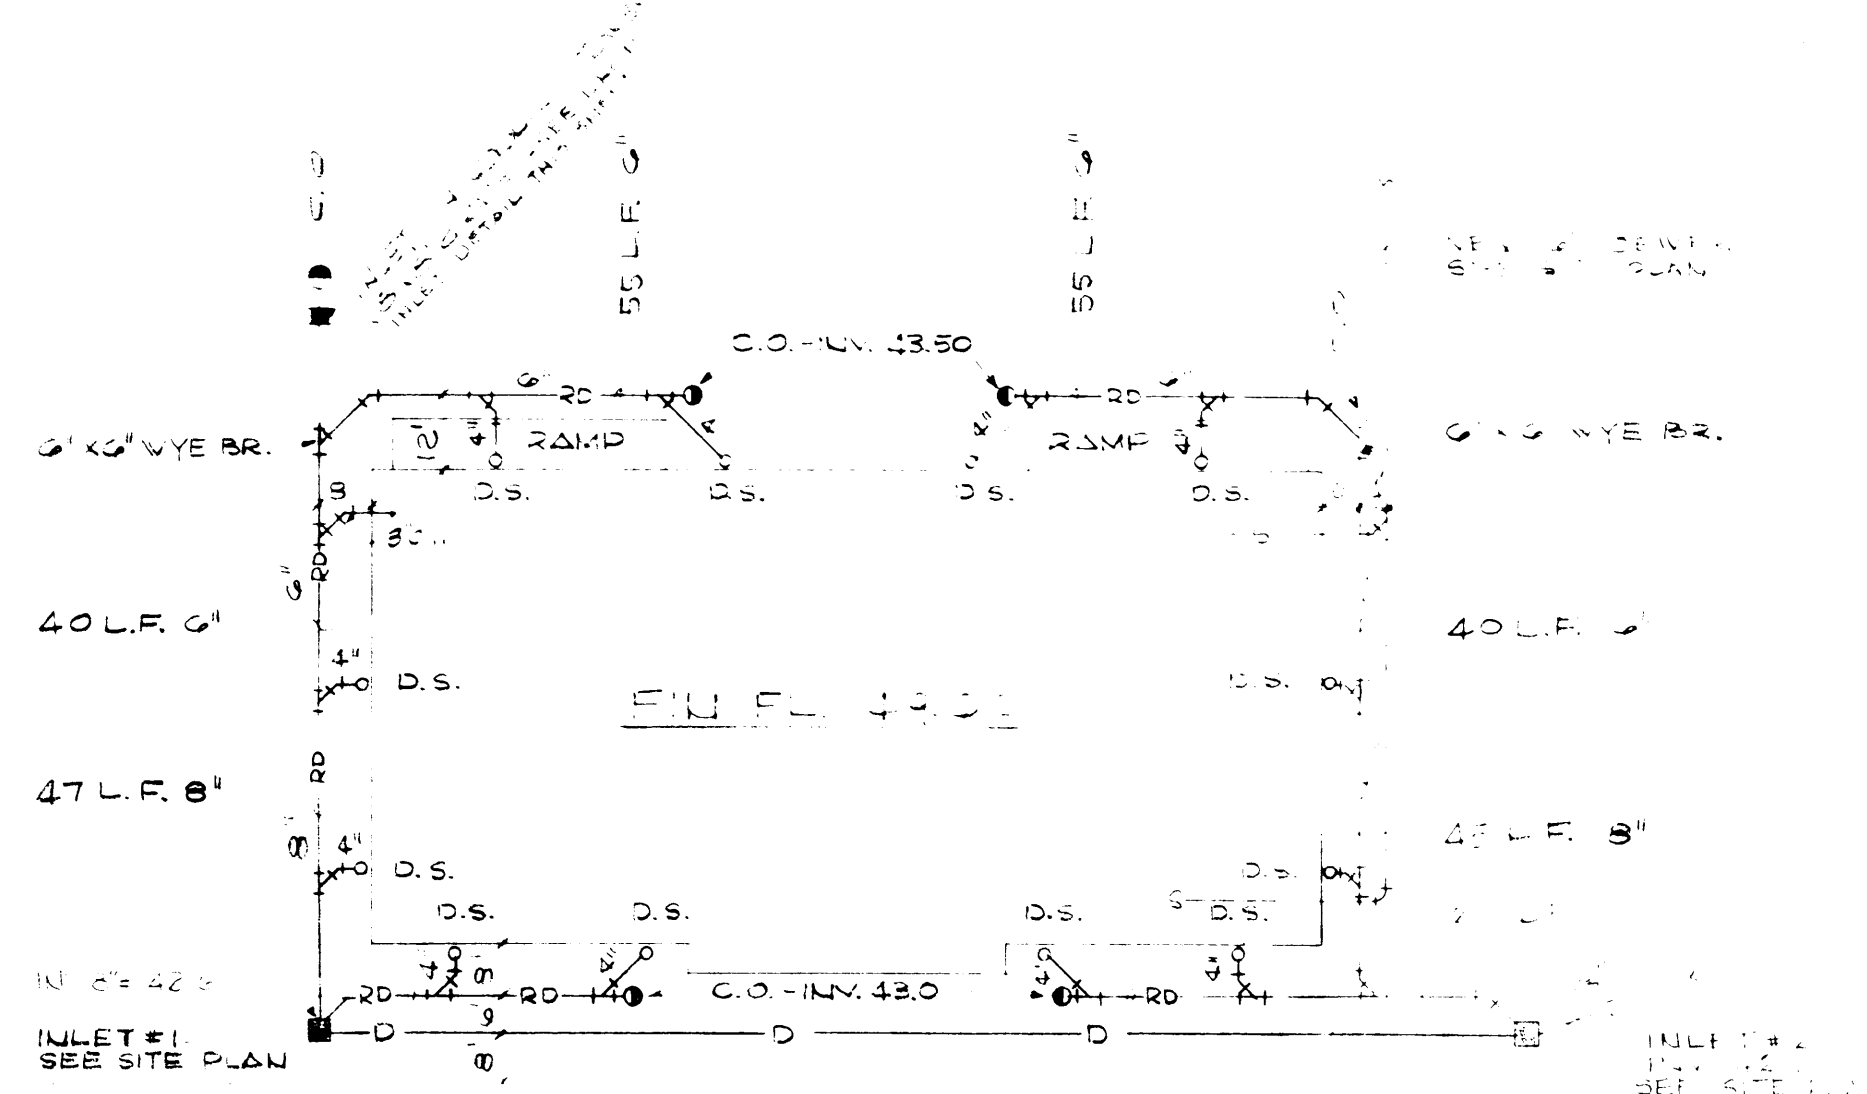


PLAN OF ROOF DRAIN COLLECTION SYSTEM

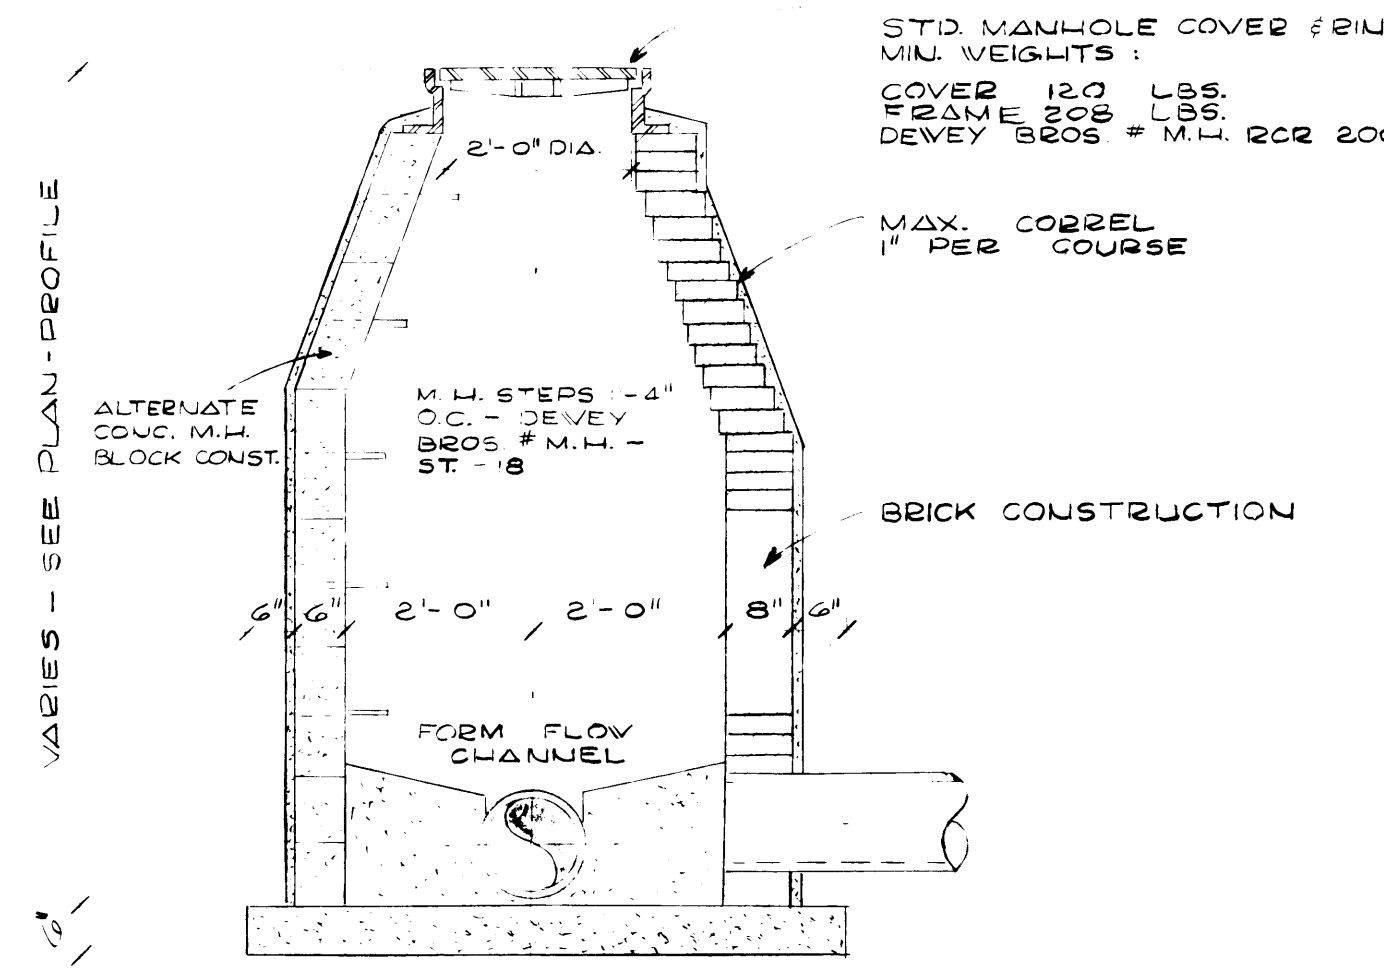


SECTION


TYPICAL DETAIL SANITARY SEWER

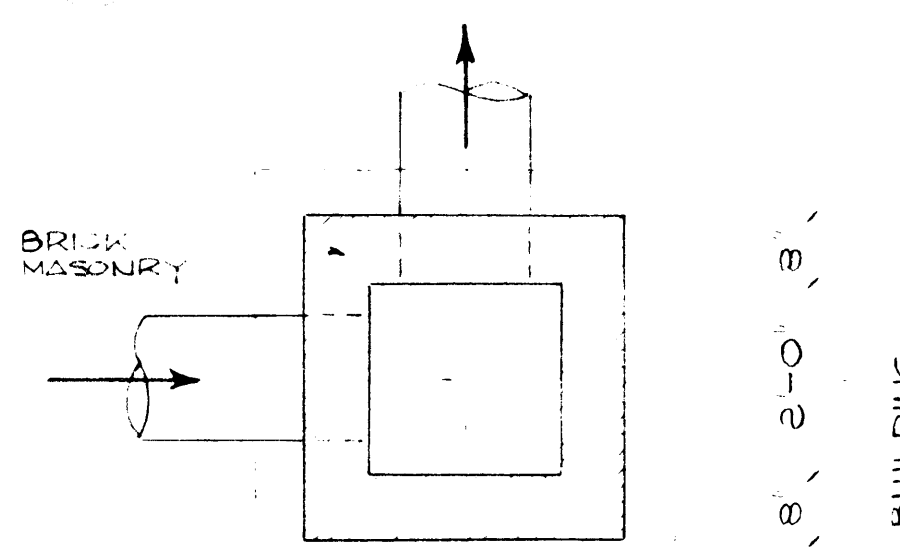


PLAN

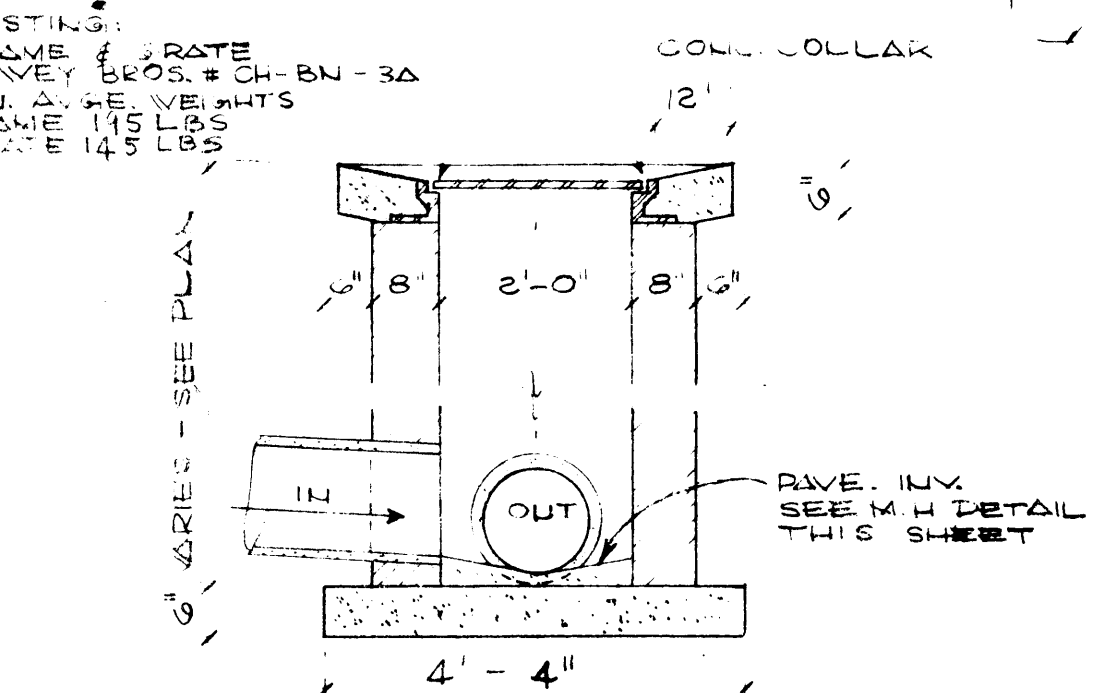

DETAIL - DROP INLET

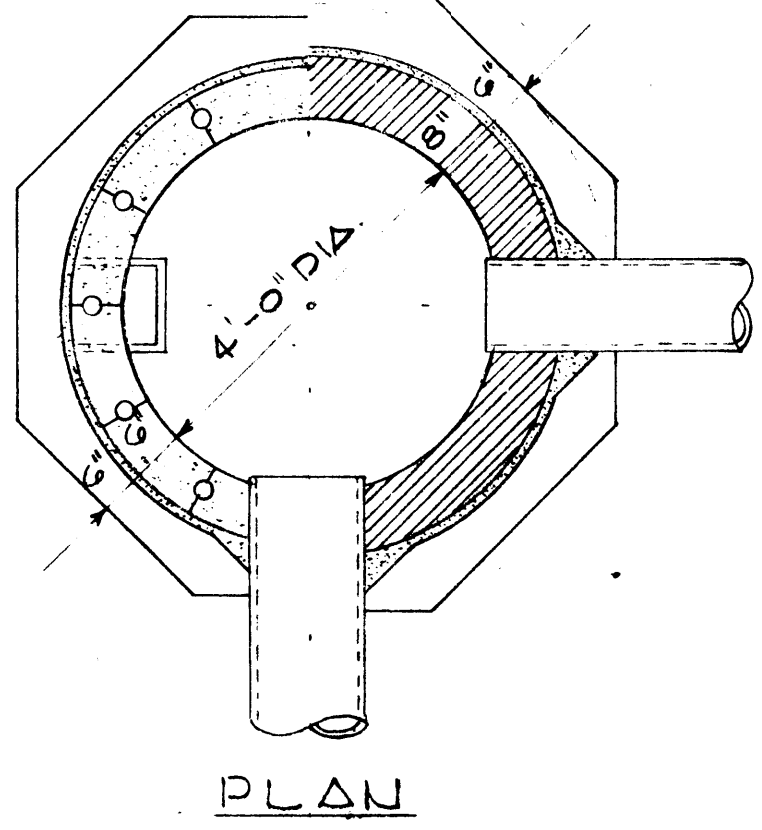


PLAN

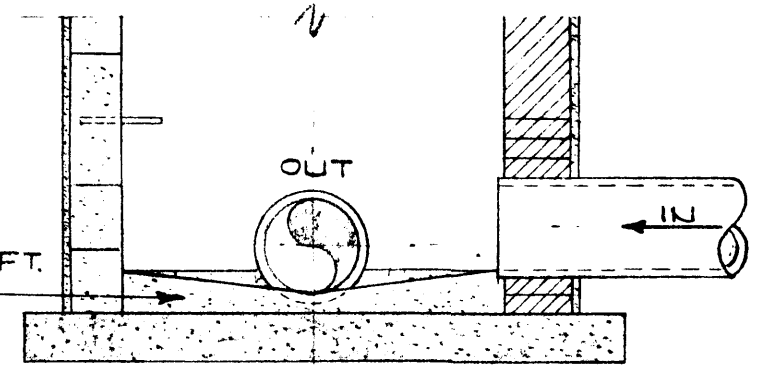


SECTION

STORM DRAIN DETAIL

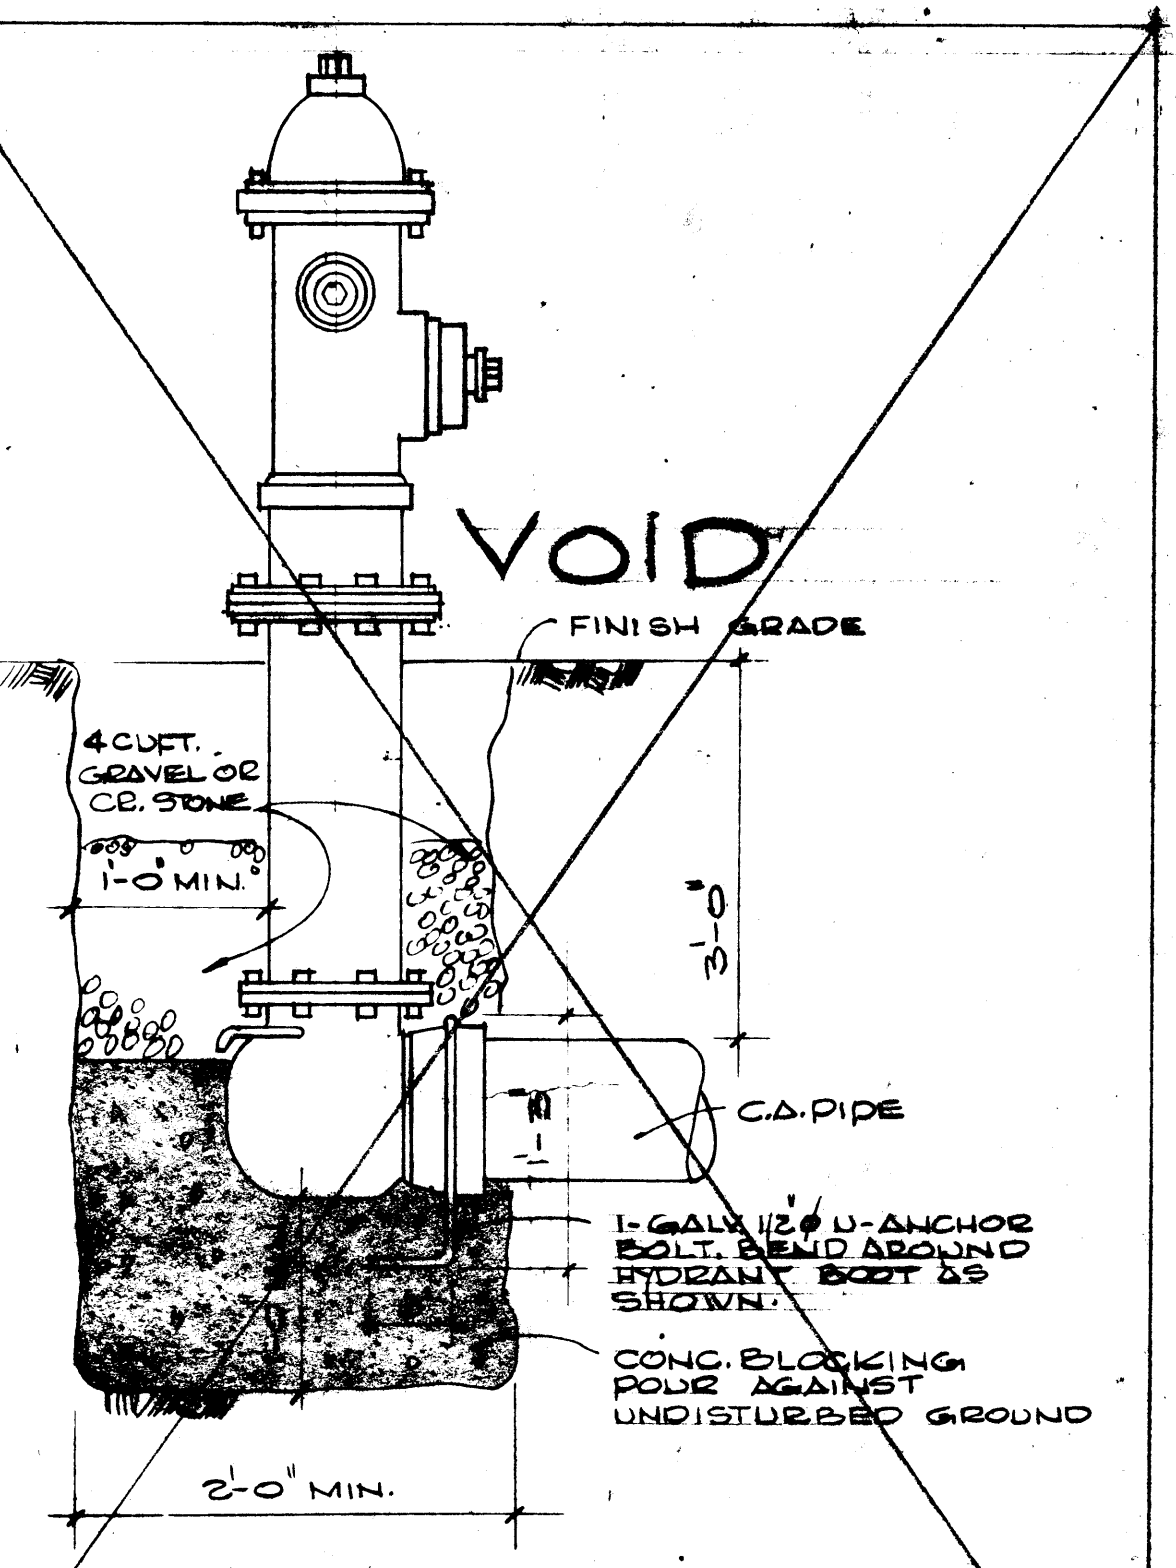


VALVE DETAIL

NO SCALE

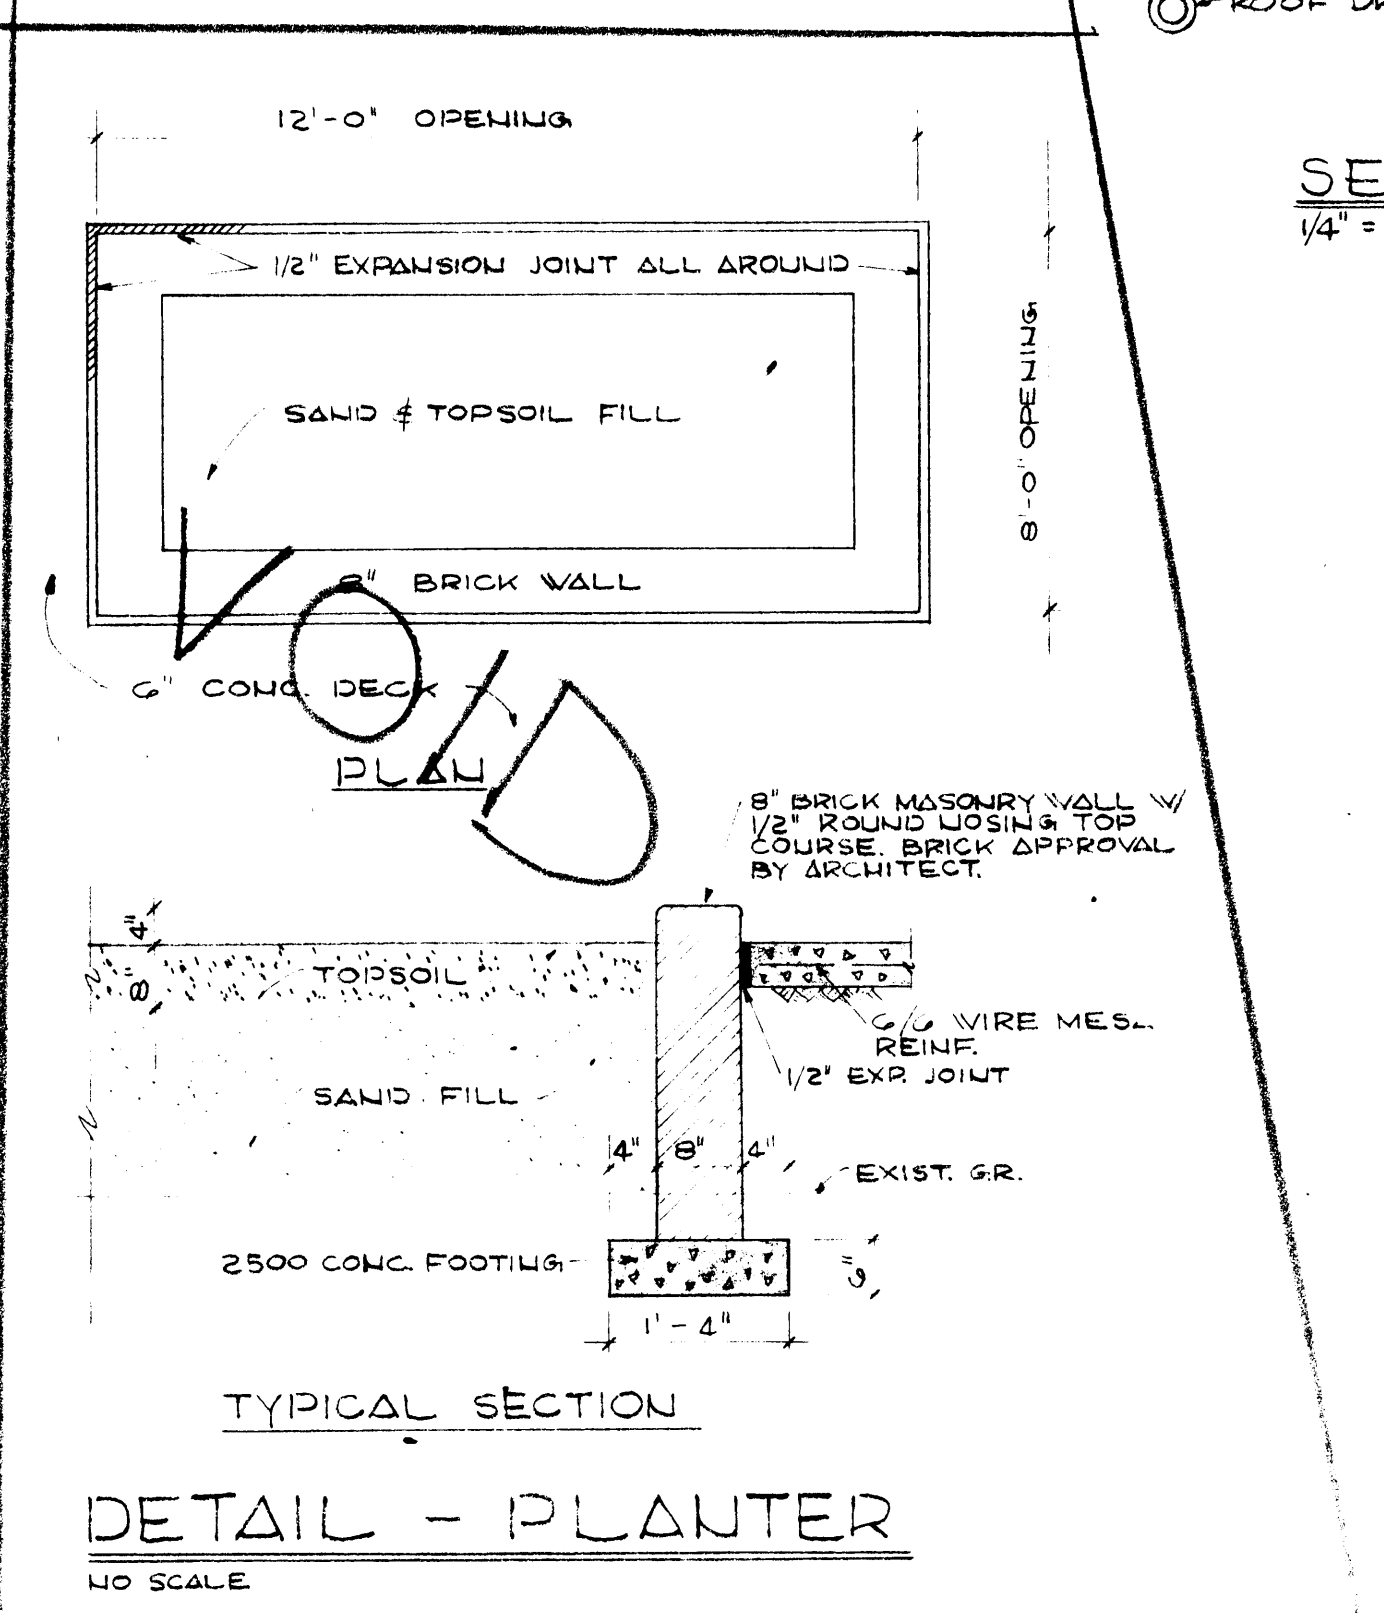

DETAIL - PLANTER

NO SCALE

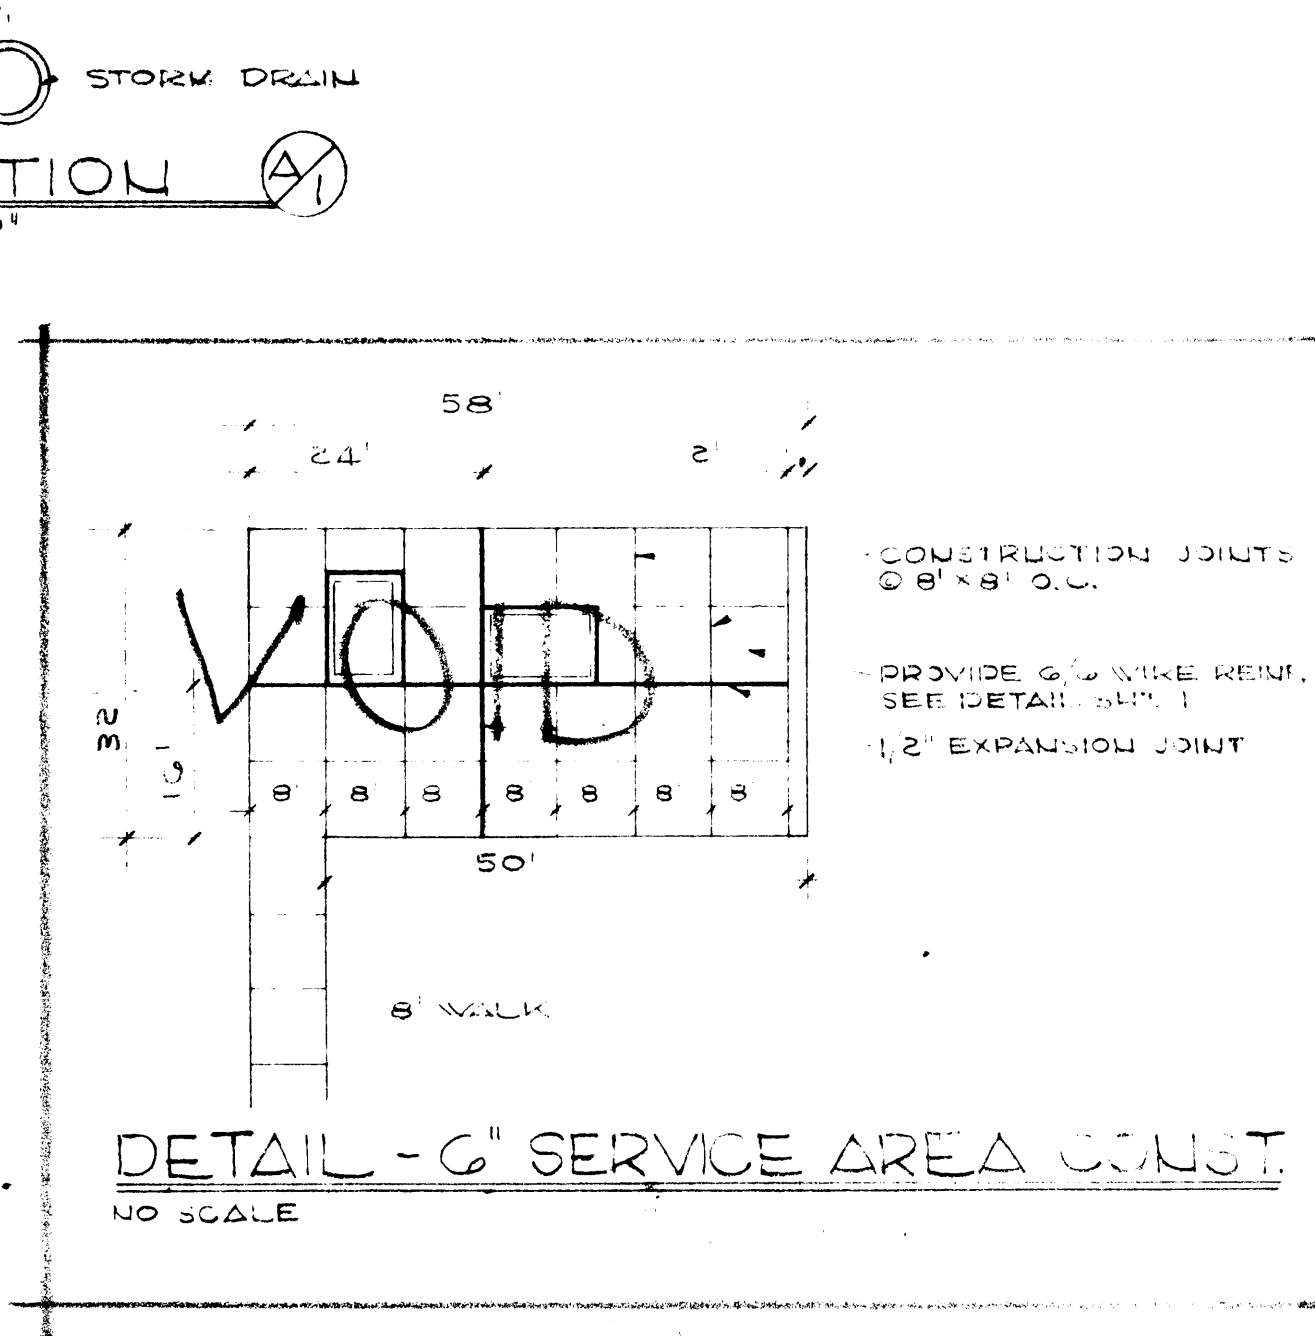


DETAIL - 6" SERVICE AREA CONST.

NO SCALE

HENRY VON OESSEN & ASSOCIATES
CONSULTING ENGINEERS
WILMINGTON, N. C.
FILE NO. 14 DP-2

"AS-BUILT" DRAWING
DATE


WILMINGTON COLLEGE EDUCATION & PSYCHOLOGY BUILDING
WILMINGTON, NORTH CAROLINA
BOARD OF TRUSTEES - L. BRADFORD TILLERY, JR., CHAIRMAN - DR. WILLIAM M. RANDALL, PRESIDENT
BALLARD, McKIM, & SAWYER, AIA
612 SOUTH SEVENTEENTH STREET
WILMINGTON, NORTH CAROLINA
DRAWN BY: HVS
CHECKED BY: HVS
DATE: 12/2/89
SHEET NO. A-2

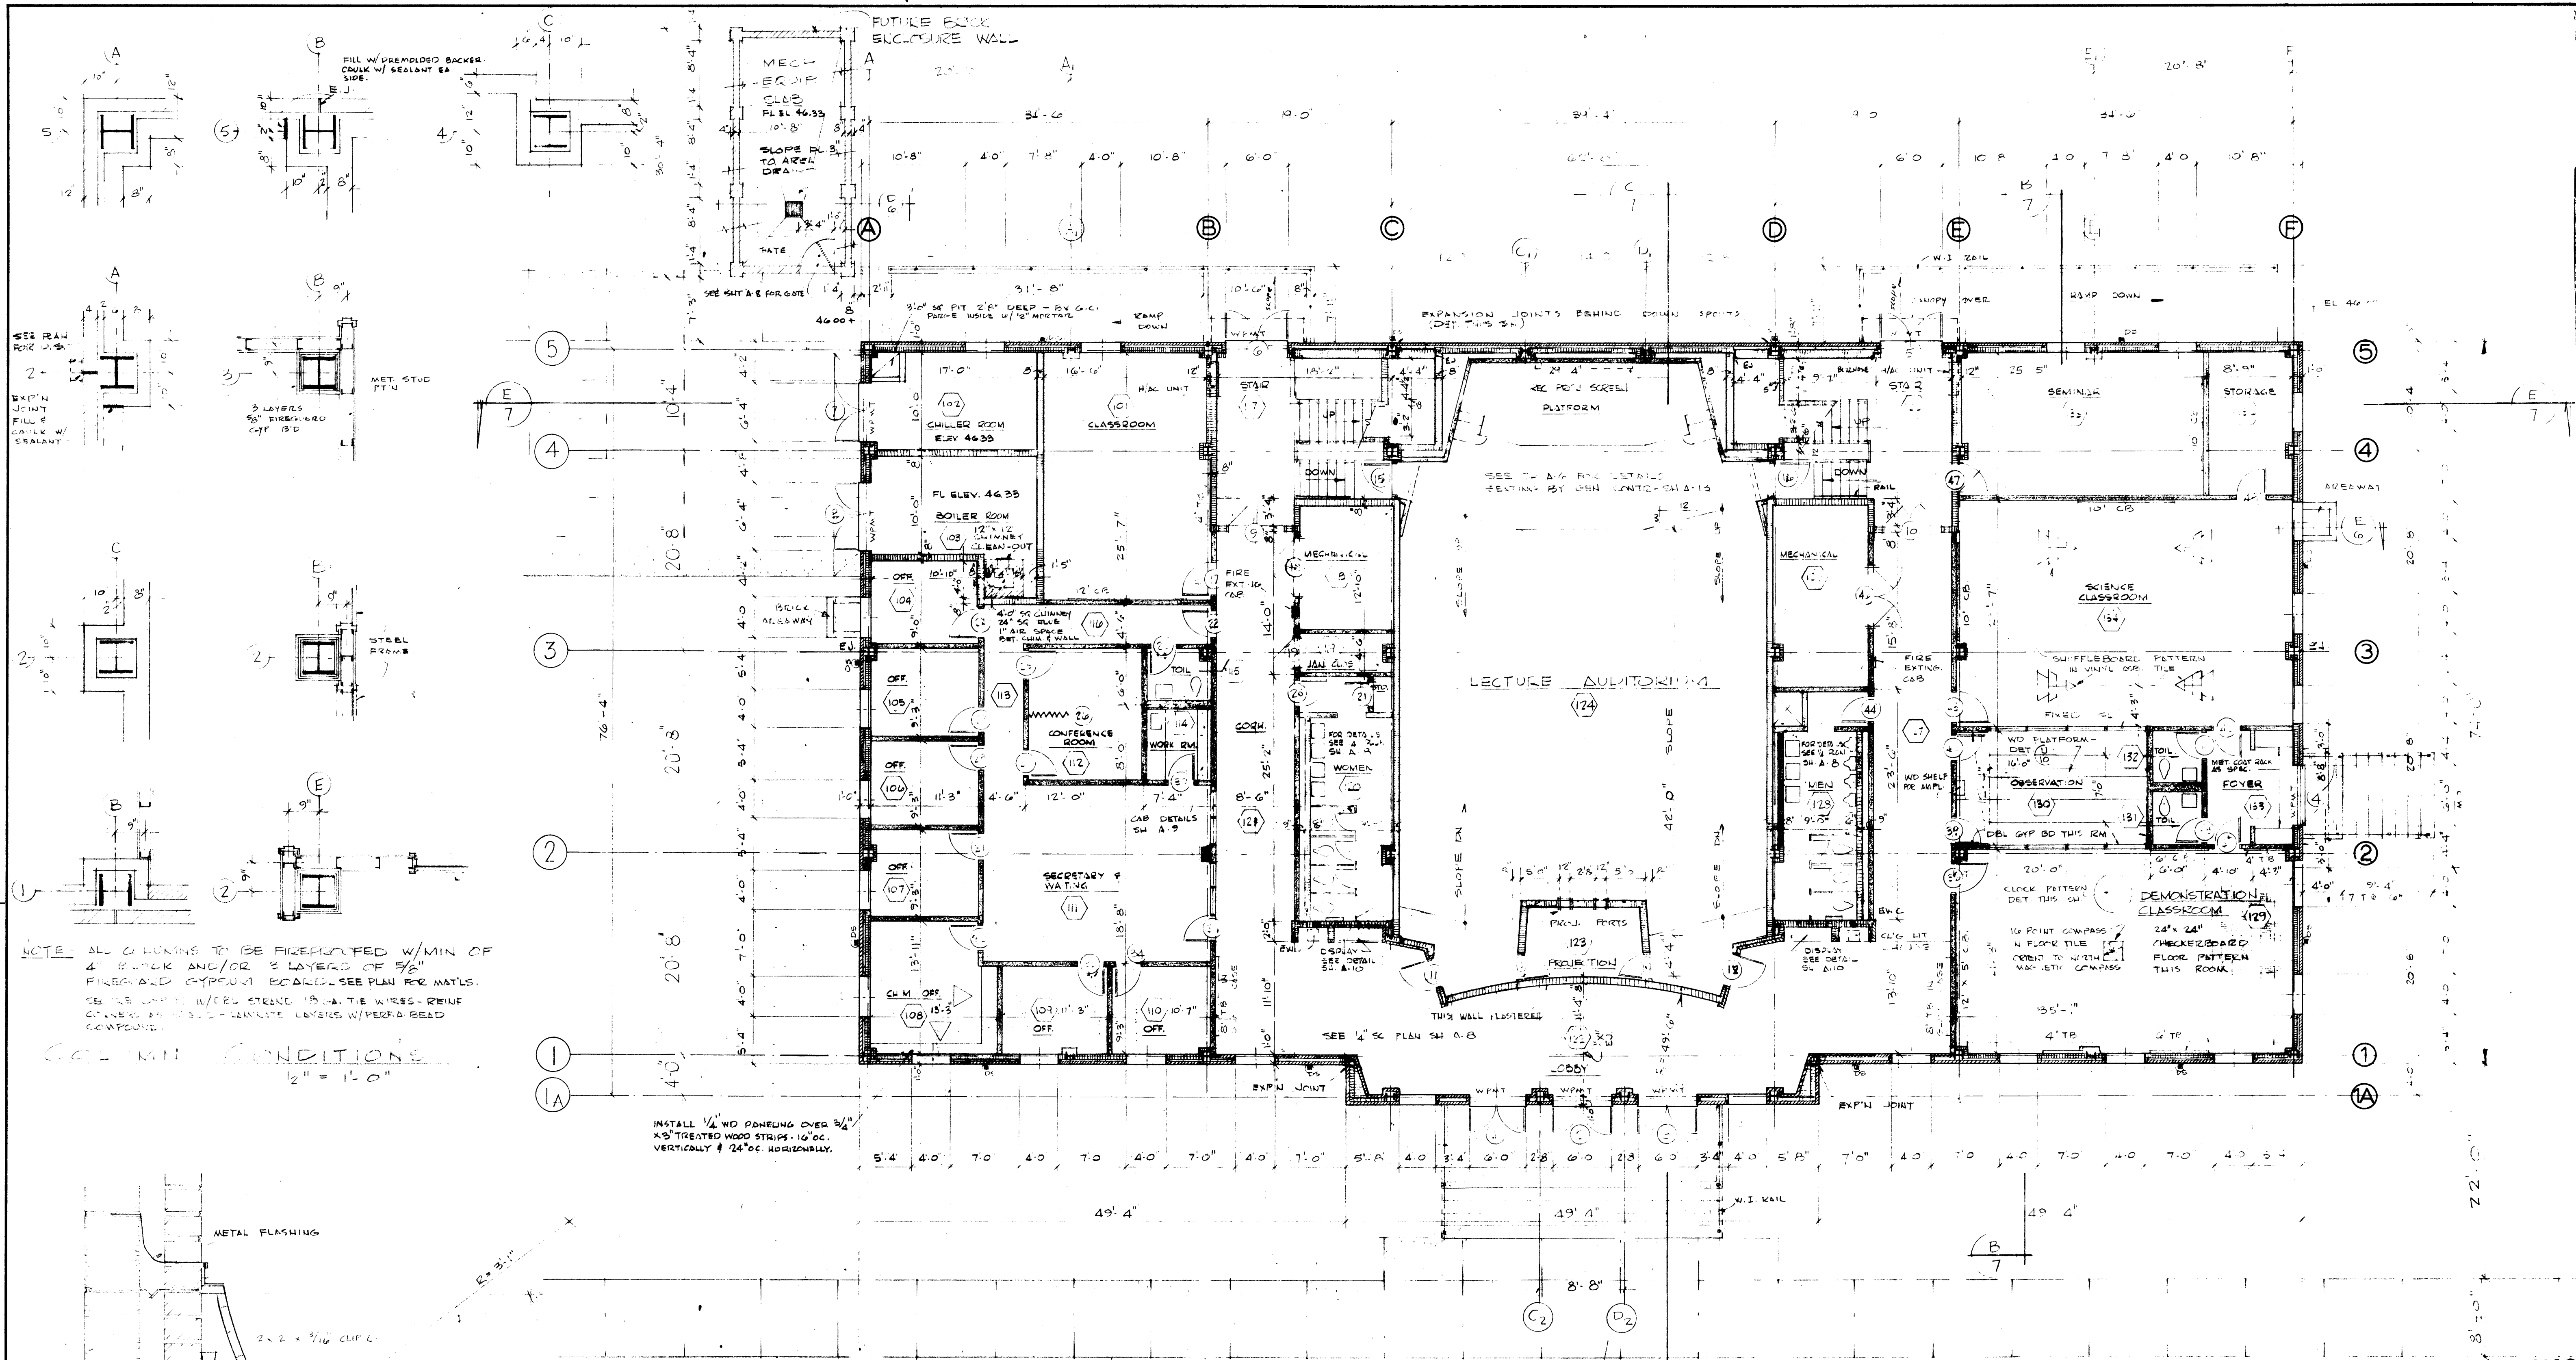

NOTE: ALL COLONIES TO BE FIREPROTECTED W/ MIN OF 4" BRICK AND/OR 3 LAYERS OF 5/8" FIBER AND GYPSUM BOARD. SEE PLAN FOR DETAILS. SEE PLAN FOR WIRE-REINCE CONCRETE AND REINFORCING LAYERS W/ PERFA REID COMPOUND.

COLONIAL CONDITIONS
1/2" = 1'-0"

INSTALL 1/2" WOOD PANELING OVER 3/4" X 3" TREATED WOOD STRIPS, 16" OC, VERTICALLY @ 24" OC HORIZONTALLY.

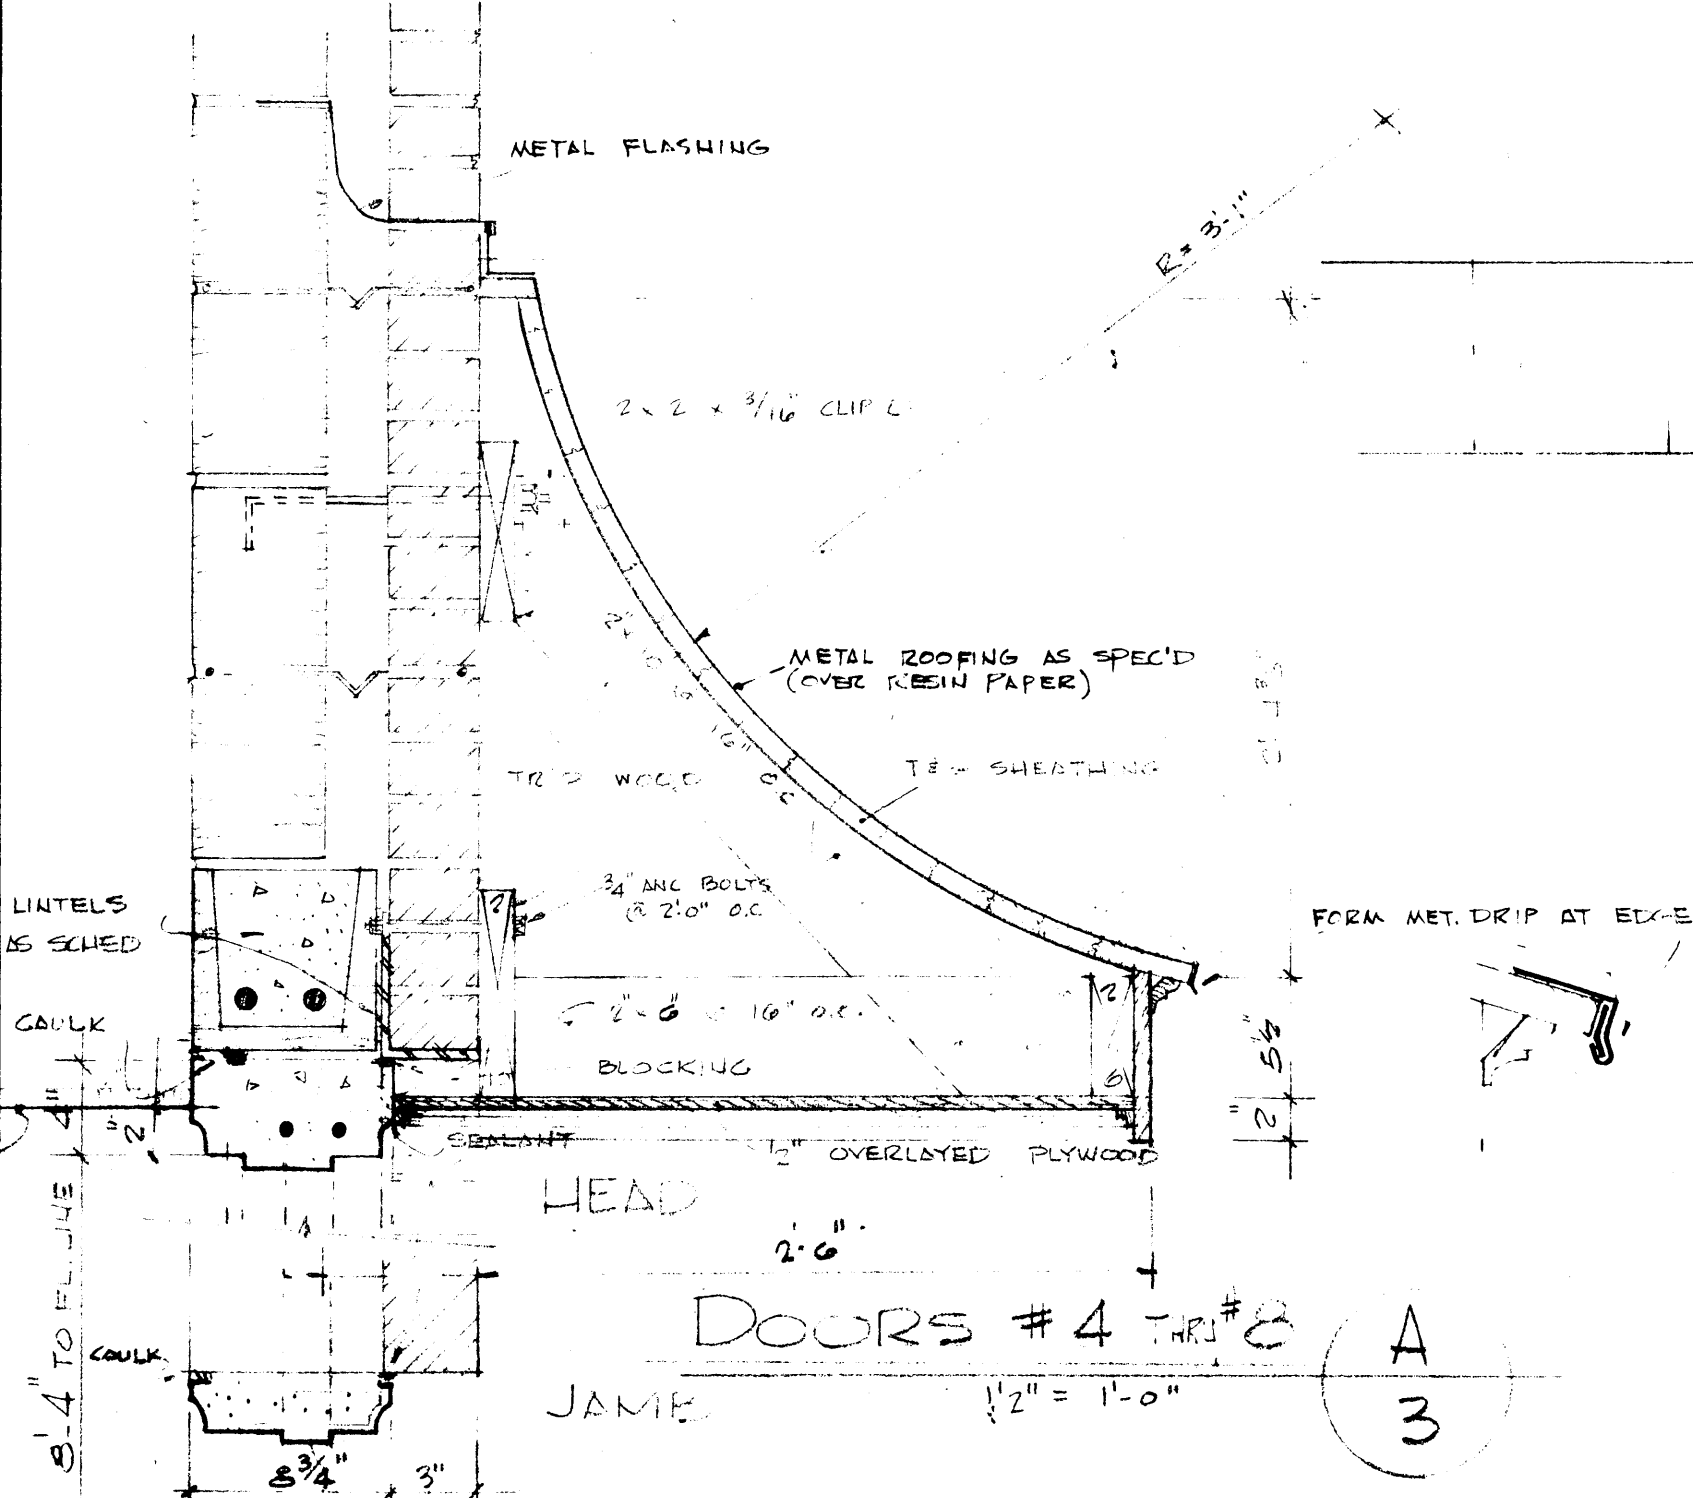

DOORS #4 THRU #8
1/2" = 1'-0"

WILMINGTON COLLEGE
EDUCATION AND
PSYCHOLOGY BUILDING
AIDED BY \$ FEDERAL LOAN

COLLEGE HOUSING PROGRAM
PROJECT NO. _____

U.S. DEPT. OF HOUSING AND REGIONAL DEVELOPMENT


BALLARD, MCKIM, & SAWYER, AIA, ARCHITECTS

DESIGNED BY BALLARD, MCKIM, & SAWYER, AIA, ARCHITECTS
DRAWN BY _____
CHECKED BY _____
DATE _____

| DEPTH | COLOR OF LETTERING |
|-------|--------------------|
| 1" | WHITE |
| 2" | WHITE |
| 3" | WHITE |
| 4" | WHITE |
| 5" | WHITE |
| 6" | WHITE |
| 7" | WHITE |
| 8" | WHITE |
| 9" | WHITE |
| 10" | WHITE |
| 11" | WHITE |
| 12" | WHITE |
| 13" | WHITE |
| 14" | WHITE |
| 15" | WHITE |
| 16" | WHITE |
| 17" | WHITE |
| 18" | WHITE |
| 19" | WHITE |
| 20" | WHITE |

"AS-BUILT" DRAWING
DATE JUN 10 1955

FIRST FLOOR PLAN
1/2" = 1'-0"

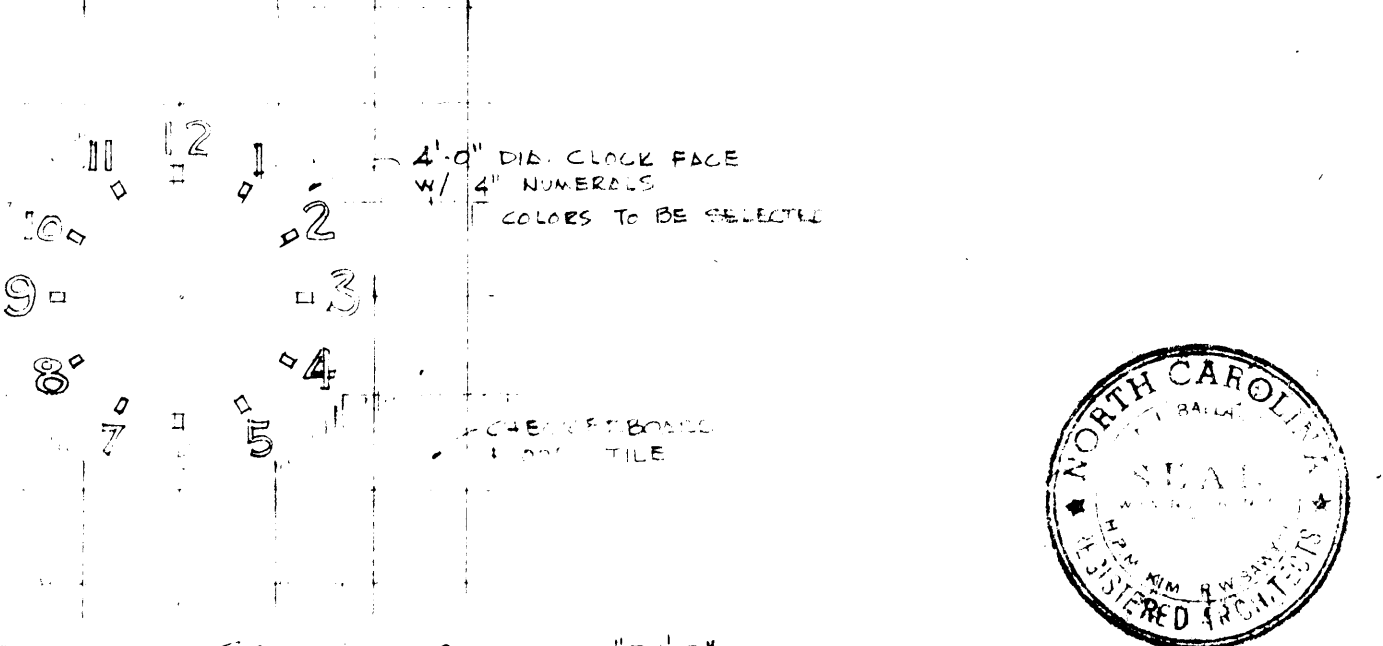

WILMINGTON COLLEGE EDUCATION & PSYCHOLOGY BUILDING
WILMINGTON, NORTH CAROLINA


BOARD OF TRUSTEES - L. BRADFORD TILLEY, JR. CHAIRMAN - DR. WILLIAM M. RANDALL, PRESIDENT

BALLARD, MCKIM, & SAWYER, AIA
412 SOUTH SEVENTEENTH STREET
WILMINGTON, NORTH CAROLINA



7-C-792
DRAWN BY _____
CHECKED BY _____
DATE _____
SHEET NO. _____

A-3


CODE 66737 - ITEM 6

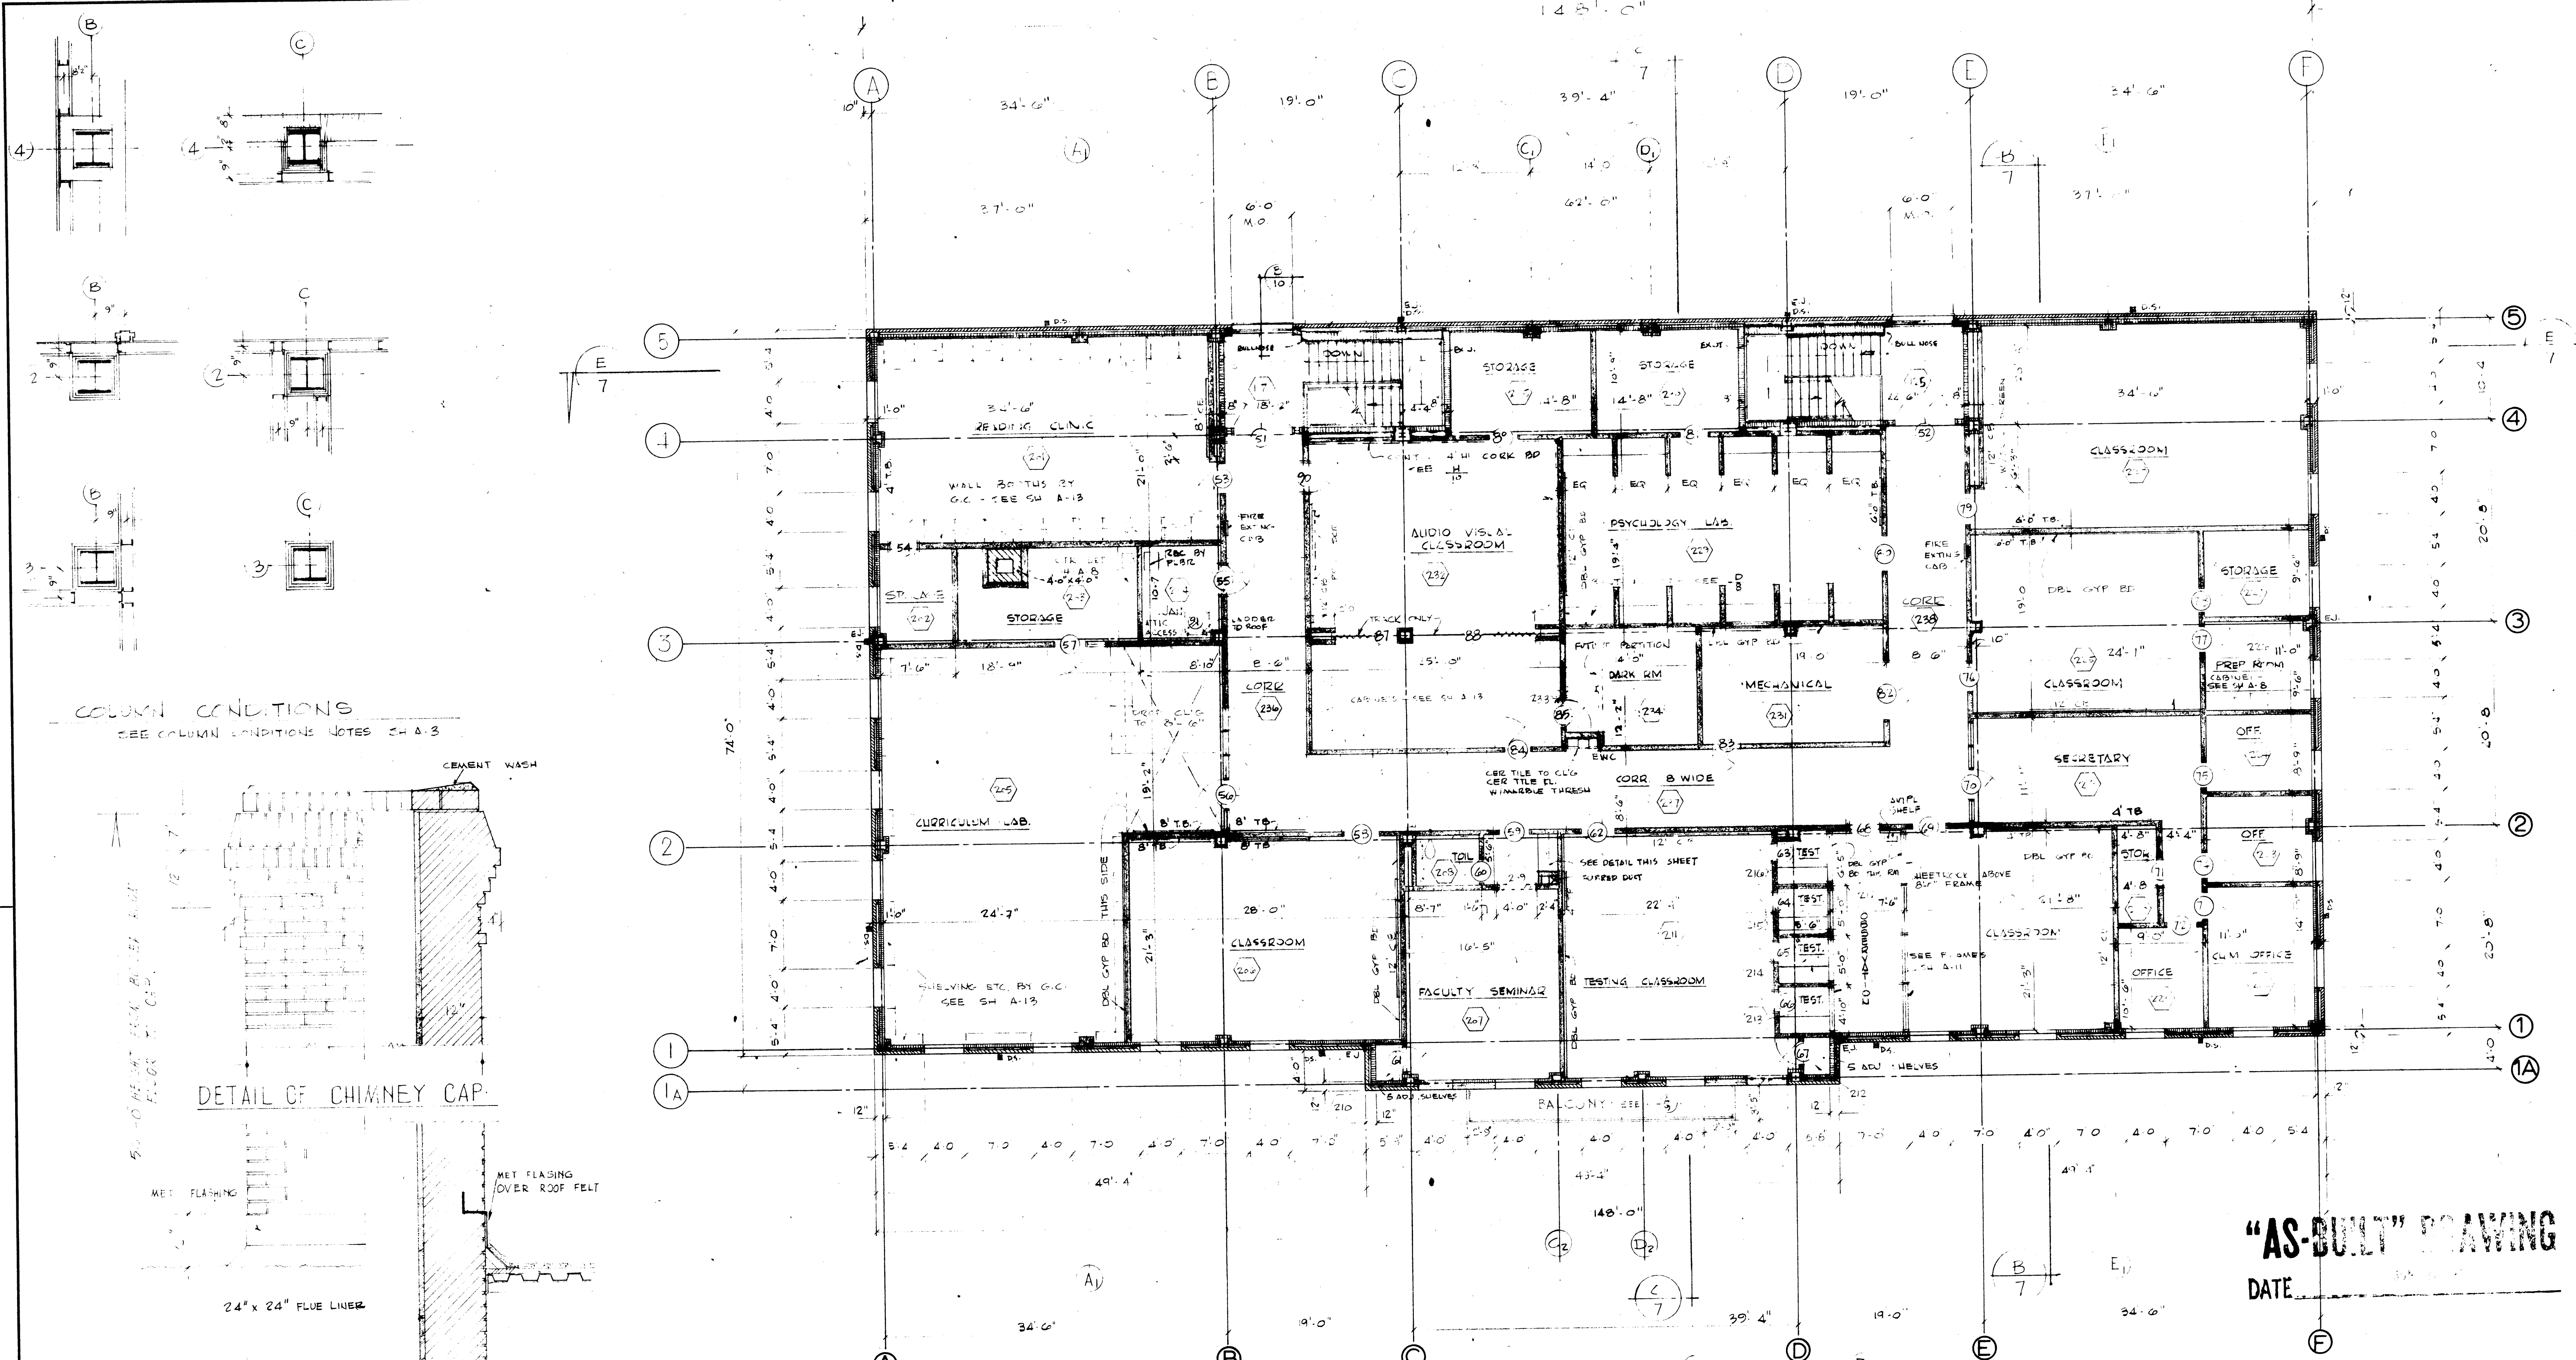

COLUMN CONDITIONS
SEE COLUMN CONDITIONS NOTES CH A-3

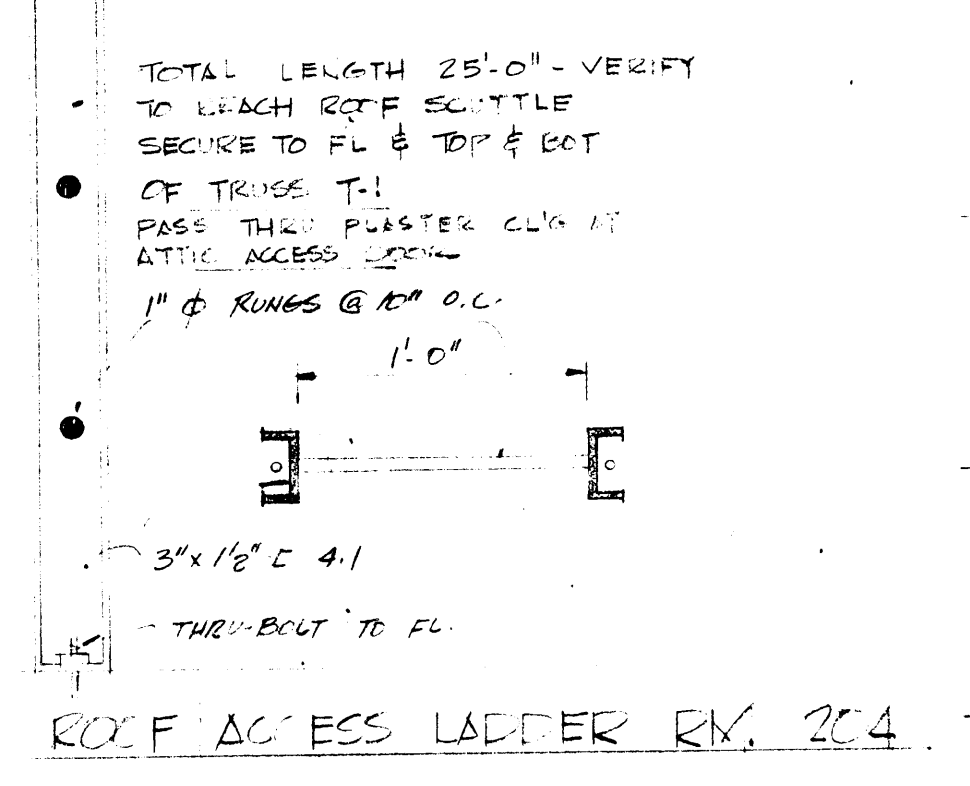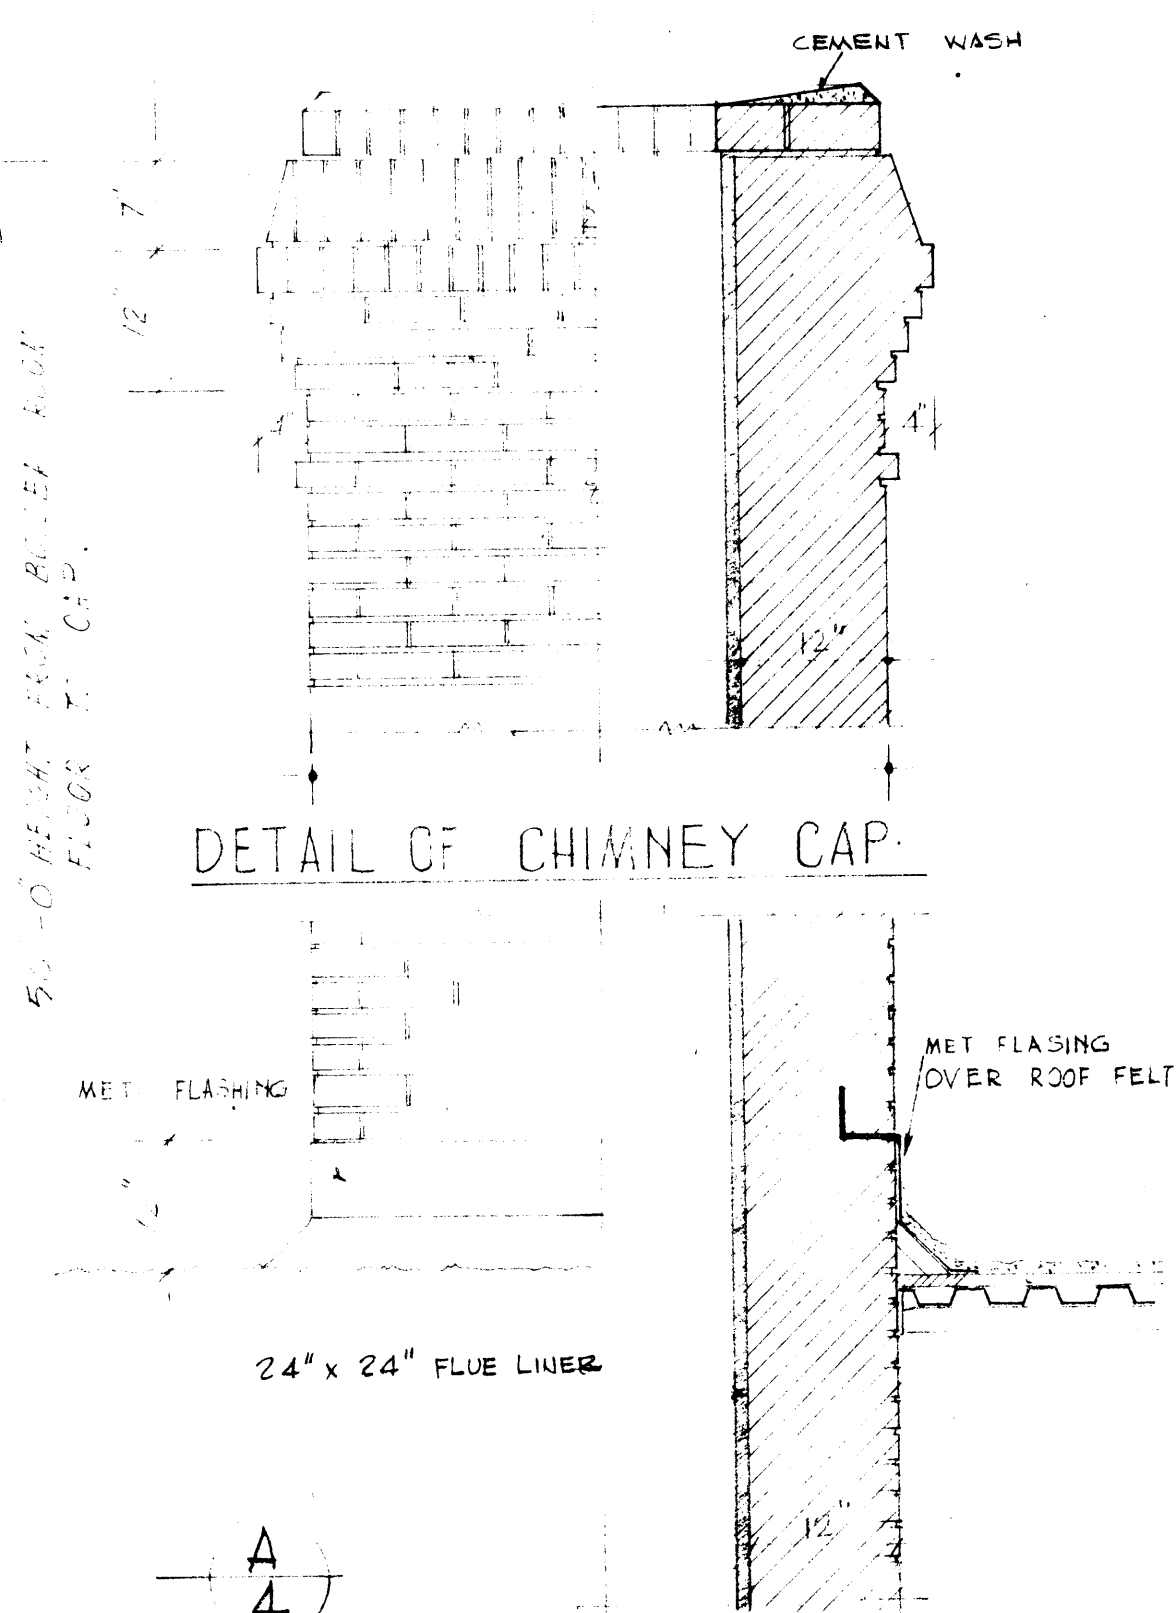

SECOND FLOOR PLAN
1/4" = 1'-0"

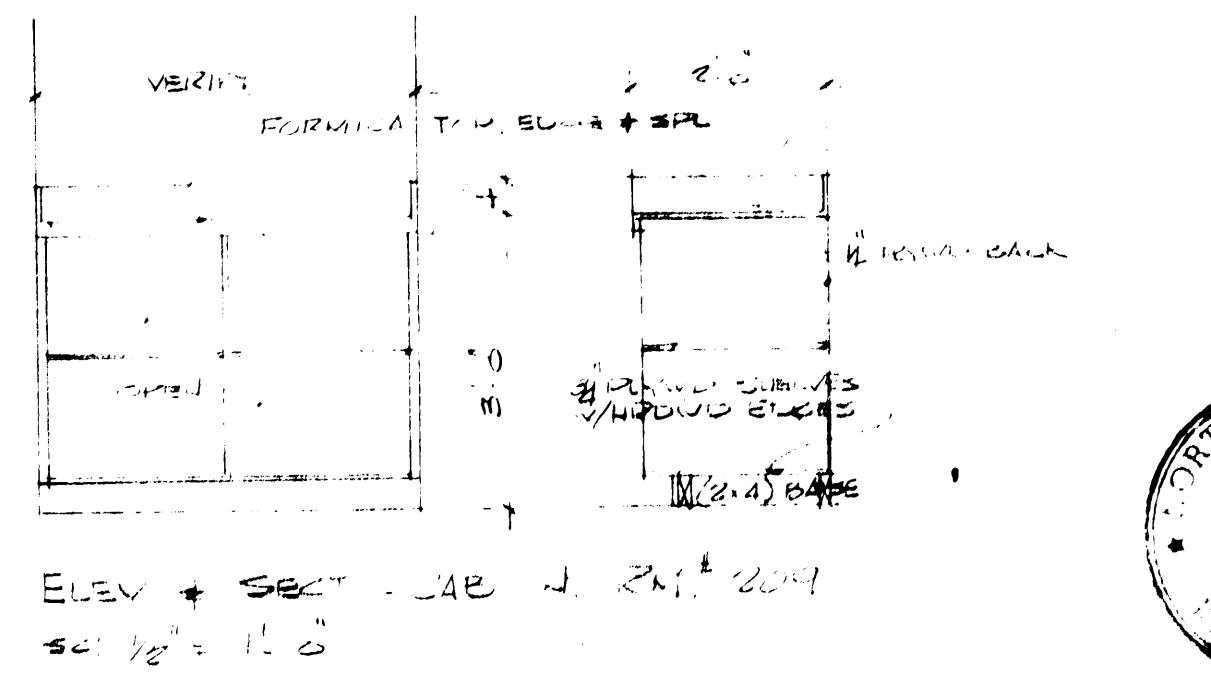


"AS-BUILT" DRAWING
DATE _____

ROOM FINISH SCHEDULE

| ROOM NO. | SPACE | FLOOR | BASE | WALLS | CEILING | CLG. HGT. | REMARKS | |
|----------|-------------------------|-------|----------|-------|---------|-----------|--|-----|
| 101 | CLASSROOM | VAT | V | PB GB | AT | 9'-2" | | 101 |
| 102 | CHILLER ROOM | S.C. | - | UNF. | P | | HANG CLG. DIRECTLY BELOW JOISTS | 102 |
| 103 | BOILER ROOM | S.C. | - | UNF. | P | | HANG CLG. DIRECTLY BELOW JOISTS | 103 |
| 104 | OFFICE | VAT | V | PB GB | AT | 9'-2" | | 104 |
| 105 | OFFICE | VAT | V | PB GB | AT | 9'-2" | | 105 |
| 106 | OFFICE | VAT | V | PB GB | AT | 9'-2" | | 106 |
| 107 | OFFICE | VAT | V | PB GB | AT | 9'-2" | | 107 |
| 108 | OFFICE | VAT | WD | WP | AT | 9'-2" | MOUNT PANELING OVER SUBTRACK. APPLY PANELING ON EXTERIOR WALLS OVER WOOD FURRING STRIPS. STAIN BASE, WOOD WINDOW ETC TO MATCH PANELING | 108 |
| 109 | OFFICE | VAT | V | PB GB | AT | 9'-2" | | 109 |
| 110 | OFFICE | VAT | V | PB GB | AT | 9'-2" | | 110 |
| 111 | SECRETARY | VAT | V | GB | AT | 8'-0" | | 111 |
| 112 | CONFERENCE ROOM | VAT | V | GB | AT | 8'-0" | | 112 |
| 113 | LOCKER | VAT | V | GB | AT | 8'-0" | | 113 |
| 114 | WORK ROOM | VAT | V | GB | AT | 8'-0" | | 114 |
| 115 | TOILET | VAT | V | GB | AT | 8'-0" | | 115 |
| 116 | CORRIDOR | VAT | V | GB | AT | 8'-0" | | 116 |
| 117 | STAIR | VAT | V | VIT | AT | 8'-6" | SEE DET. - | 117 |
| 118 | MECHANICAL ROOM | S.C. | V | UNF | AT | | COORDINATE CLG. HT. W/ MECH EQUIP. | 118 |
| 119 | JANITOR'S CLOSET | S.C. | V | VIT | P | 8'-0" | | 119 |
| 120 | WOMEN'S TOILET | C.T. | C.T. | VIT | P | 8'-6" | MARBLE THRESH | 120 |
| 121 | CORRIDOR | VAT | V | VIT | AT | 8'-0" | SEE ALT. FOR TERRAZZO | 121 |
| 122 | LOBBY | VAT | V & C.T. | PB | AT | 10'-4" | C.T. BASE ON BRICK & PLAS WALLS. V. BASE ON ST. STUD (PLAST ON CURVED WALL) | 122 |
| 123 | PROJECTION ROOM | VAT | V | PB | AT | 9'-0" | | 123 |
| 124 | LECTURE AUDITORIUM | VAT | V | PB GB | P | VARIES | SEE A-B FOR CEILING FINISH & FLOOR PATTERN. ACoustICAL PANELS ON REAR WALLS. | 124 |
| 125 | STAR | VAT | V | VIT | AT | 8'-6" | SEE DET. SH. A-9 - | 125 |
| 126 | MECHANICAL ROOM | S.C. | V | UNF | AT | | COORDINATE CLG. HT. W/ MECH EQUIP. | 126 |
| 127 | LOCKER | VAT | V | VIT | AT | 8'-0" | | 127 |
| 128 | MEN'S TOILET | C.T. | C.T. | VIT | P | 8'-6" | MARBLE THRESH | 128 |
| 129 | DEMONSTRATION CLASSROOM | VAT | V | PB GB | AT | 9'-2" | 24" x 24" CHECKERBOARD PATTERN - 48" x 48" CLOCK PATTERN - 24" x 24" COMPASS PATTERN (16 POINTS - ORIENT NORTH) | 129 |
| 130 | OBSERVATION ROOM | VAT | V | GB | AT | 9'-2" | DBA GYP BR ALL WALLS CARRY OUT TO 2" FL WOOD PLATFORM - SEE DET. | 130 |
| 131 | TOILET | C.T. | C.T. | VIT | P | 8'-0" | ON 1/2" SETTING BED - SLOPE TO DRAIN - MARBLE THRESH FLOOR | 131 |
| 132 | TOILET | C.T. | C.T. | VIT | P | 8'-0" | ON 1/2" SETTING BED - SLOPE TO DRAIN - MARBLE THRESH FLOOR | 132 |
| 133 | FOYER | VAT | V | PB GB | AT | 8'-6" | | 133 |
| 134 | SCIENCE CLASSROOM | VAT | V | PB GB | AT | 9'-2" | SHUFFLEBOARD PATTERN IN FLOOR | 134 |
| 135 | SEMINAR ROOM | VAT | V | PB GB | AT | 9'-2" | | 135 |
| 136 | STORAGE | VAT | V | PB GB | AT | 9'-2" | | 136 |
| 137 | STORAGE | VAT | V | PB GB | AT | 9'-2" | | 137 |
| 138 | STORAGE | VAT | V | PB GB | AT | 9'-2" | | 138 |

| ROOM NO. | SPACE | FLOOR | BASE | WALLS | CEILING | CLG. HGT. | REMARKS | |
|----------|------------------------|-------|------|-------|---------|-----------|--|-----|
| 201 | READING ROOM | VAT | V | PB GB | AT | 9'-2" | | 201 |
| 202 | STORAGE | VAT | V | PB GB | AT | 9'-2" | | 202 |
| 203 | STORAGE | VAT | V | GB | AT | 8'-2" | | 203 |
| 204 | JANITOR'S CLOSET | VAT | V | VIT | P | 8'-0" | | 204 |
| 205 | CURRICULUM LAB | VAT | WD | PB GB | AT | 9'-2" | DIAPH CLG. AT CHAIRS DESK TO 8'-6" STAIN WD. BASE TO MATCH FURNISHINGS - SEE ALT. FOR CARPET | 205 |
| 206 | CLASSROOM | VAT | V | PB GB | AT | 9'-2" | | 206 |
| 207 | FACULTY REST ROOM | VAT | V | PB GB | AT | 9'-2" | | 207 |
| 208 | TOILET | VAT | V | GB | AT | 8'-0" | | 208 |
| 209 | ALCOVE | VAT | V | GB | AT | 8'-0" | | 209 |
| 210 | STORAGE | VAT | V | PB GB | AT | 8'-0" | 8 SH. SHELVES - 3/4" PLYWOOD W/WD NOSING | 210 |
| 211 | CLASSROOM | VAT | V | PB GB | AT | 9'-2" | | 211 |
| 212 | STORAGE | VAT | V | PB GB | AT | 8'-0" | 8 SH. SHELVES - 3/4" PLYWOOD W/WD NOSING | 212 |
| 213 | TESTING BOOTH | VAT | V | GB | AT | 8'-0" | | 213 |
| 214 | TESTING BOOTH | VAT | V | GB | AT | 8'-0" | | 214 |
| 215 | TESTING BOOTH | VAT | V | GB | AT | 8'-0" | | 215 |
| 216 | TESTING BOOTH | VAT | V | GB | AT | 8'-0" | | 216 |
| 217 | OBSERVATION ROOM | VAT | V | PB GB | AT | 8'-0" | DR. W/ F. IN ALL WALLS THIS RM. | 217 |
| 218 | CLASSROOM | VAT | V | PB GB | AT | 9'-2" | | 218 |
| 219 | RECEPTION | VAT | V | GB | AT | 8'-0" | | 219 |
| 220 | STORAGE | VAT | V | GB | AT | 8'-0" | | 220 |
| 221 | OFFICE | VAT | V | PB GB | AT | 9'-2" | | 221 |
| 222 | OFFICE | VAT | V | PB GB | AT | 9'-2" | | 222 |
| 223 | OFFICE | VAT | V | PB GB | AT | 9'-2" | | 223 |
| 224 | OFFICE | VAT | V | PB GB | AT | 9'-2" | | 224 |
| 225 | CLASSROOM | VAT | V | GB | AT | 9'-2" | | 225 |
| 226 | OFFICE | VAT | V | PB GB | AT | 9'-2" | | 226 |
| 227 | STORAGE | VAT | V | PB GB | AT | 9'-2" | | 227 |
| 228 | CLASSROOM | VAT | V | PB GB | AT | 9'-2" | | 228 |
| 229 | PSYCHOLOGY LAB | VAT | V | PB GB | AT | 9'-2" | | 229 |
| 230 | STORAGE | VAT | V | PB GB | AT | 9'-2" | | 230 |
| 231 | VEGETABLE ROOM | S.C. | V | GB | AT | | COORDINATE CLG. HT. W/ MECH EQUIP. | 231 |
| 232 | AUDIO VISUAL CLASSROOM | VAT | V | PB GB | AT | 9'-2" | COR. BOARD ON WALLS - SEE "H" | 232 |
| 233 | ALCOVE | VAT | V | GB | AT | 8'-0" | | 233 |
| 234 | LAB ROOM | VAT | V | GB | AT | 8'-0" | | 234 |
| 235 | STORAGE | VAT | V | PB GB | AT | 9'-2" | | 235 |
| 236 | LOCKER | VAT | V | VIT | AT | 8'-0" | | 236 |
| 237 | LOCKER | VAT | V | VIT | AT | 8'-0" | | 237 |
| 238 | LOCKER | VAT | V | VIT | AT | 8'-0" | | 238 |
| 115 | STAIR LANDING | VAT | V | VIT | AT | 8'-6" | | |
| 125 | TALE LANDING | VAT | V | VIT | AT | 8'-6" | | |

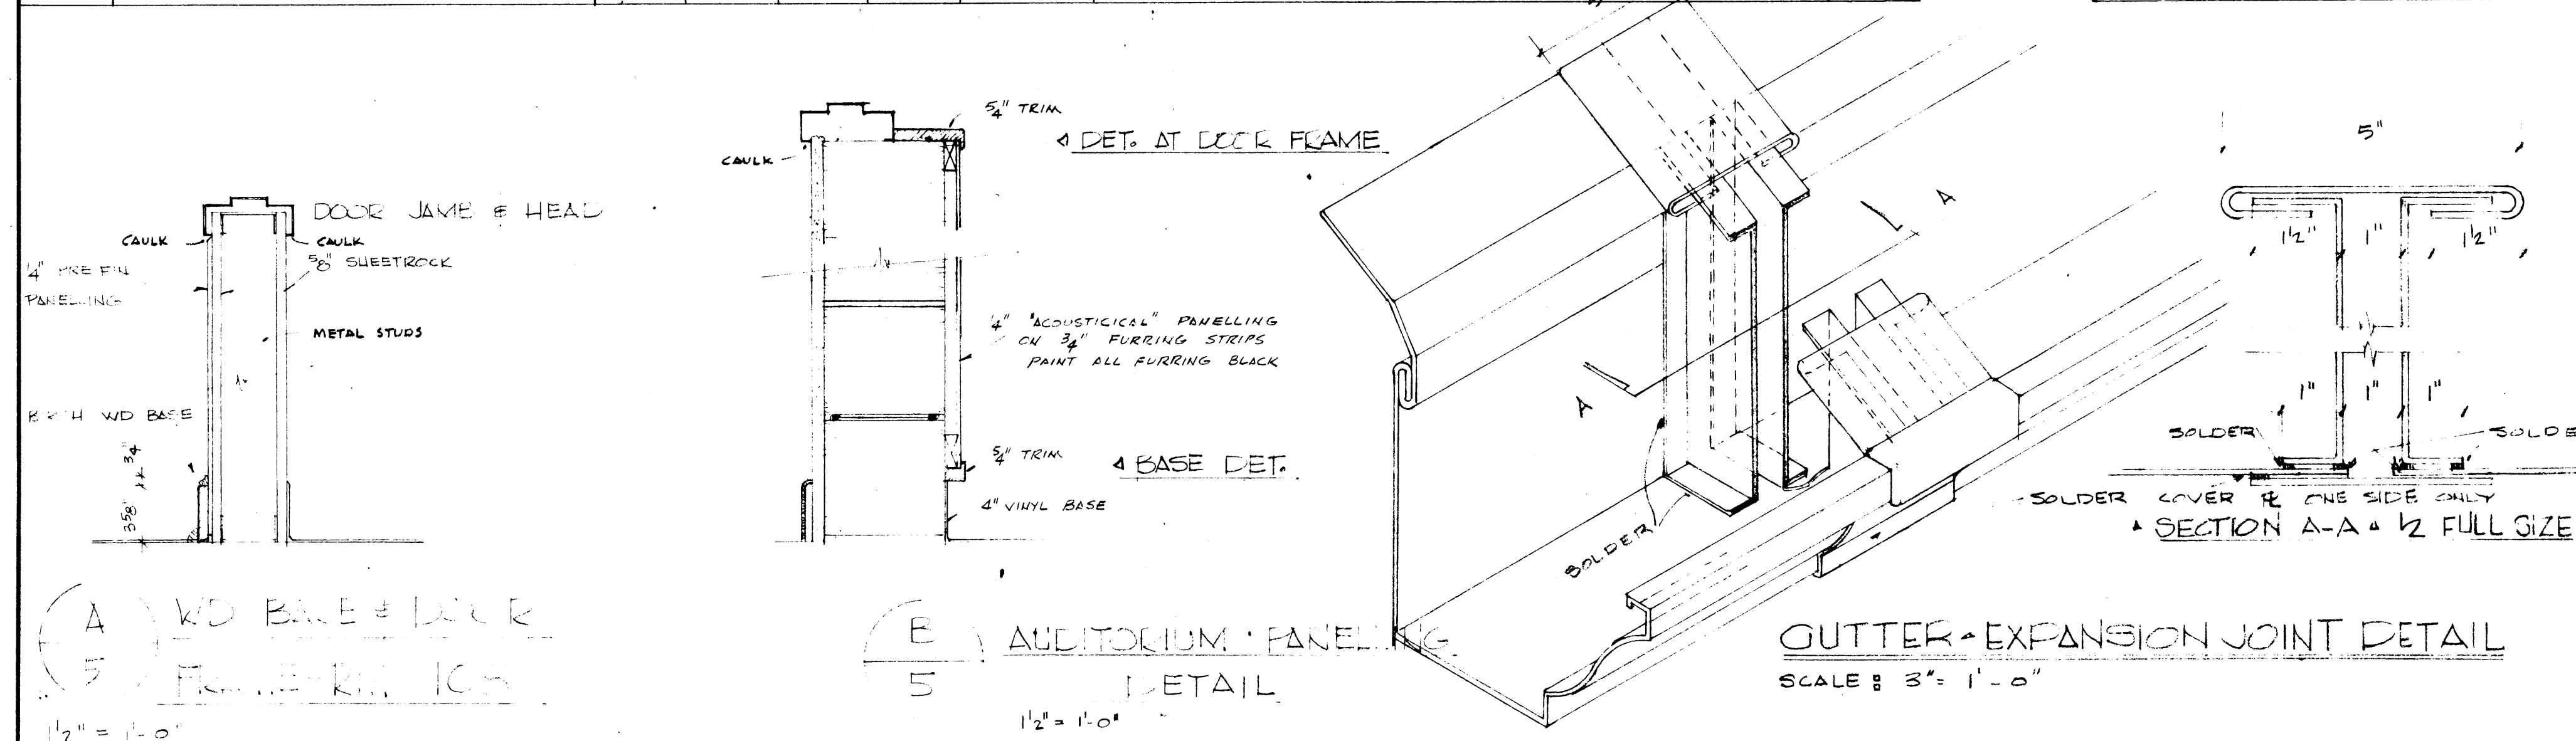

"AS-BUILT" DRAWING


DATE: JUN 15 1971

| ABBREVIATIONS | |
|---------------|--|
| AT | ASYMPTIC TILE |
| PB | FACE BRICK |
| GB | GYPSUM MILL BOARDS, PAINTED |
| P | PLASTER, PAINTED |
| PB | PAINTED MISCELLANEOUS BLOCK |
| C.T. | CERAMIC TILE |
| SC | SMOOTH CONCRETE |
| UNF | UNFINISHED GYP BR. TAPEL. NOT PAINTED. |
| V | VINYL, 4" HIGH |
| VAT | VINYL ASBESTOS TILE |
| VIT | VITREOUS COATING |
| WP | PRE-FINISHED WOOD PANELING |
| Tz | TERRAZZO |


BALLARD, McKIM, & SAWYER, AIA
 612 SOUTH SEVENTEENTH STREET
 WILMINGTON, NORTH CAROLINA

7-6-792
 DRAWN BY: JEFF SWP
 CHECKED BY:
 DATE: JUN 15 1971
 SHEET NO. A-5


WILMINGTON COLLEGE EDUCATION & PSYCHOLOGY BUILDING
 WILMINGTON, NORTH CAROLINA
 BOARD OF TRUSTEES - L. BRADFORD TILLERY, JR. CHAIRMAN - DR. WILLIAM M. RANDALL, PRESIDENT
 CODE 66737 - ITEM 6

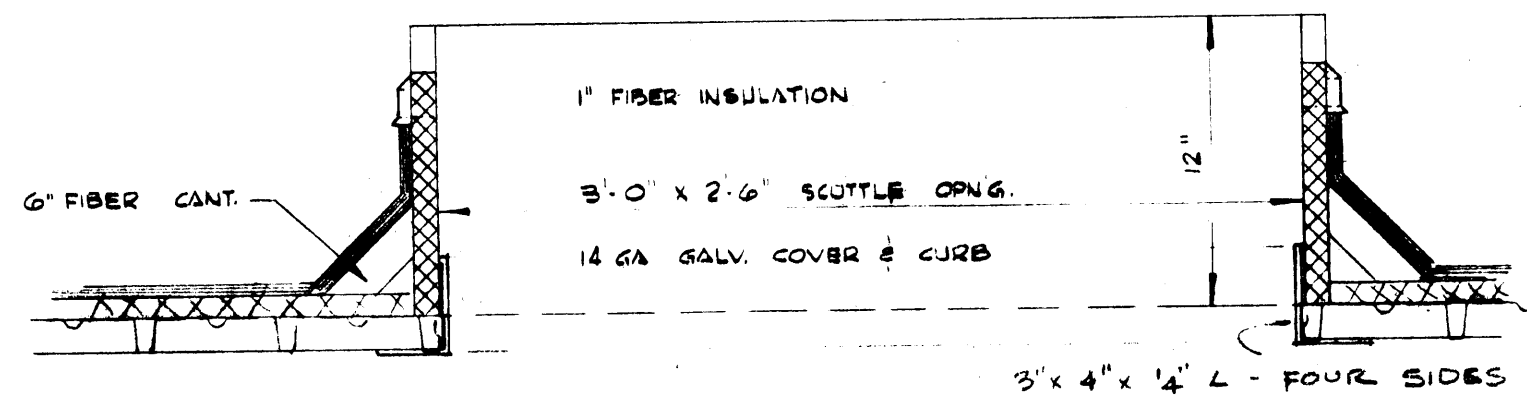


A ROOF SCUTTLE DETAIL
SCALE: 1/2" = 1'-0"
SEE 2ND FL. PLAN SH A-2 FOR LOCAT.

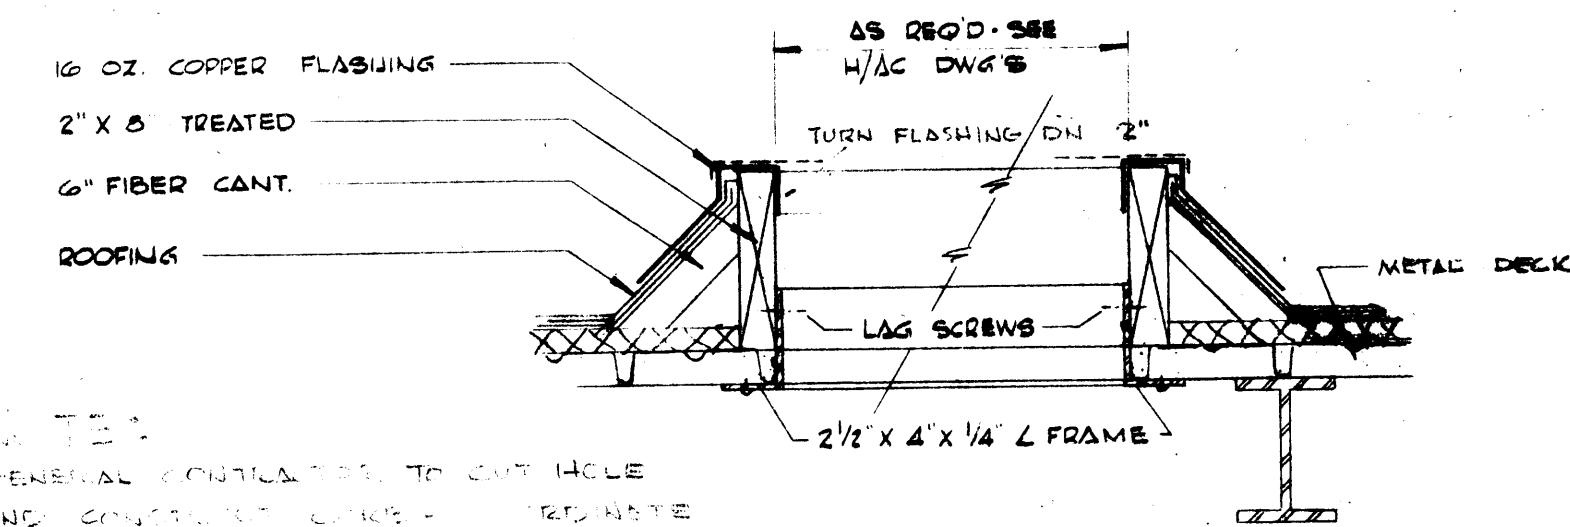


B ROOF CURB DETAIL
SCALE: 1/2" = 1'-0"

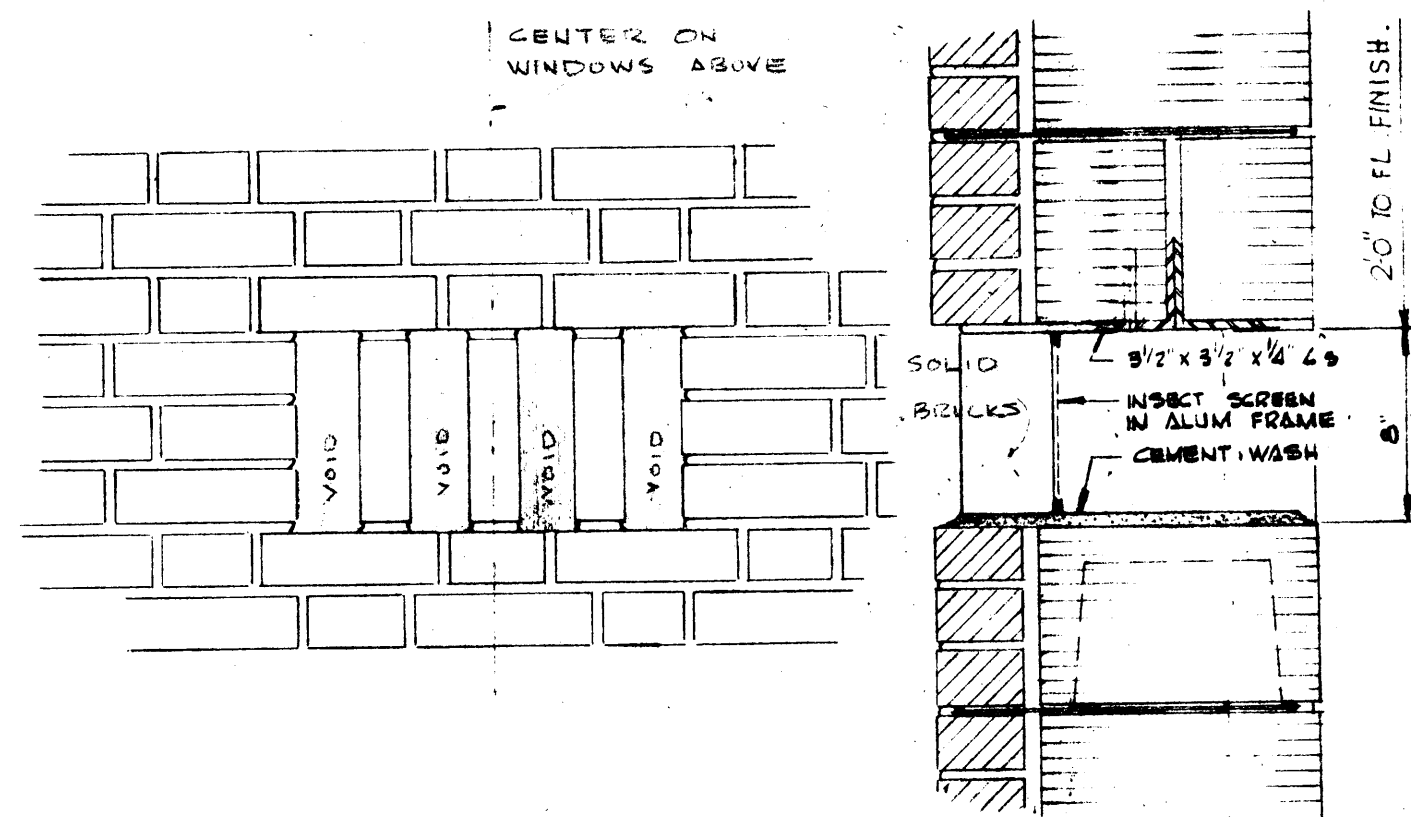


CRAWL SPACE VENT. DET. C
SCALE: 1/2" = 1'-0"

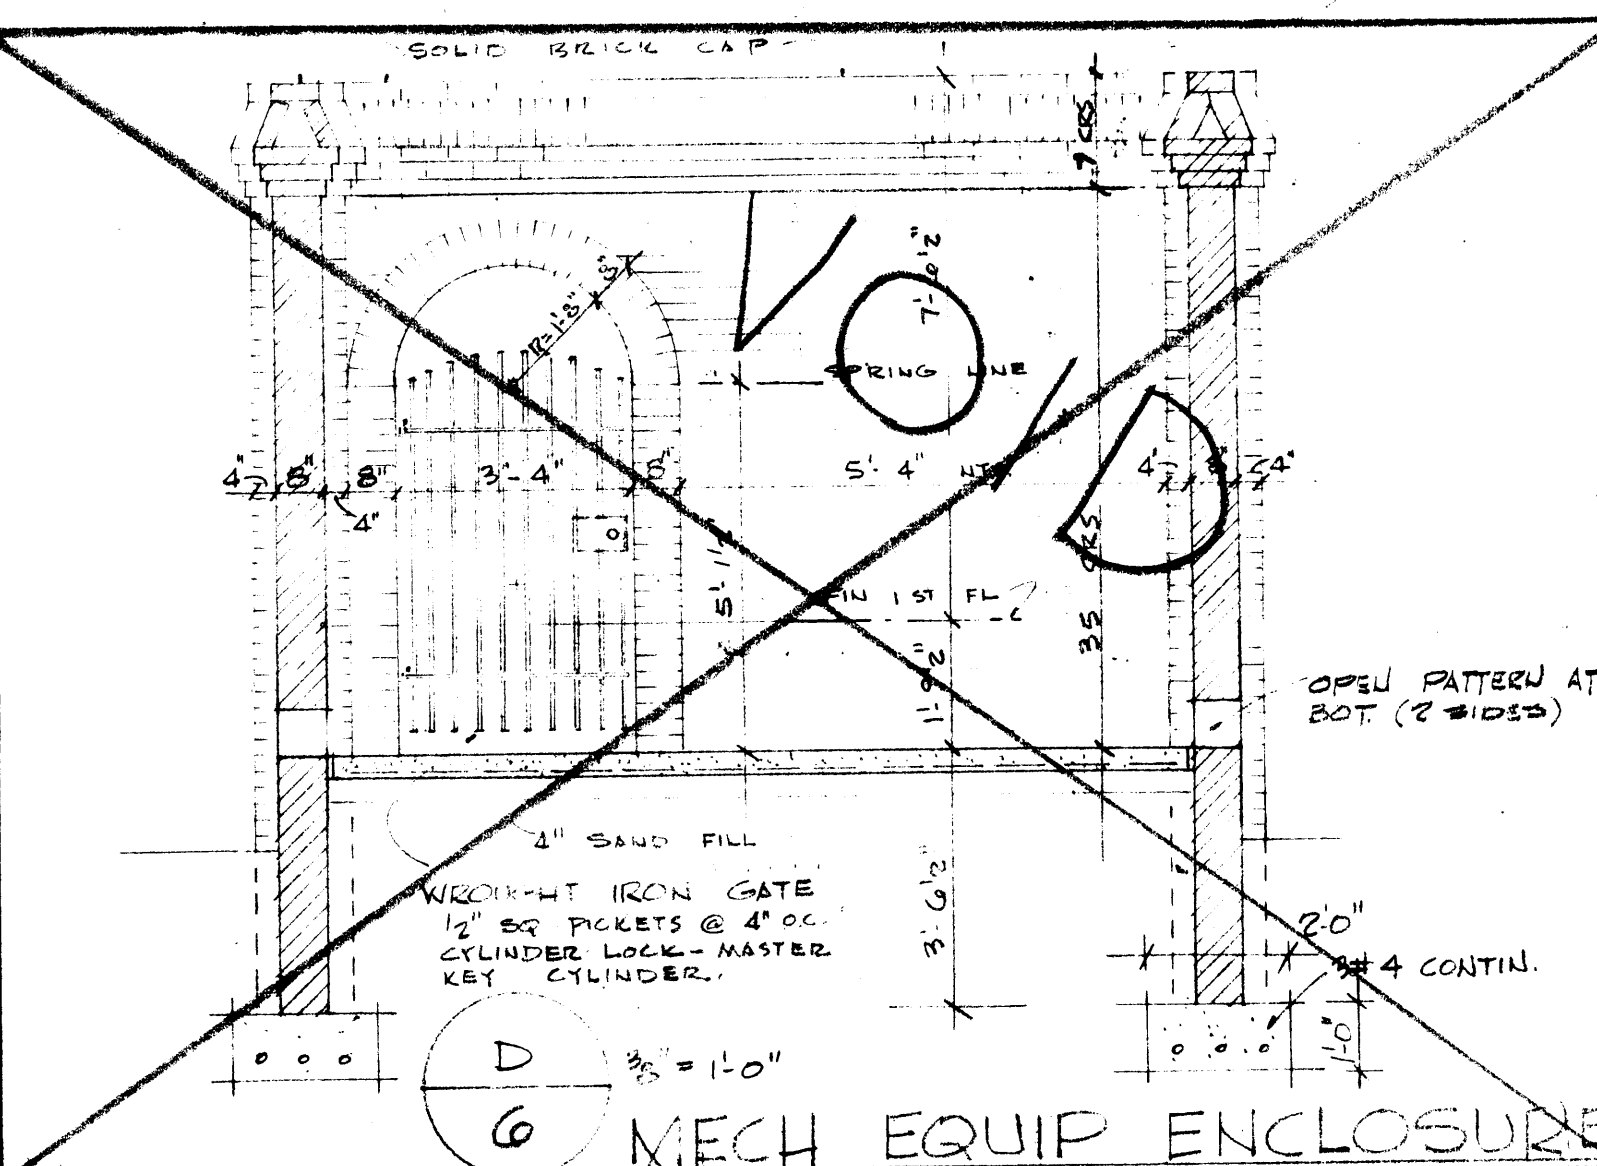


D MECH EQUIP ENCLOSURE

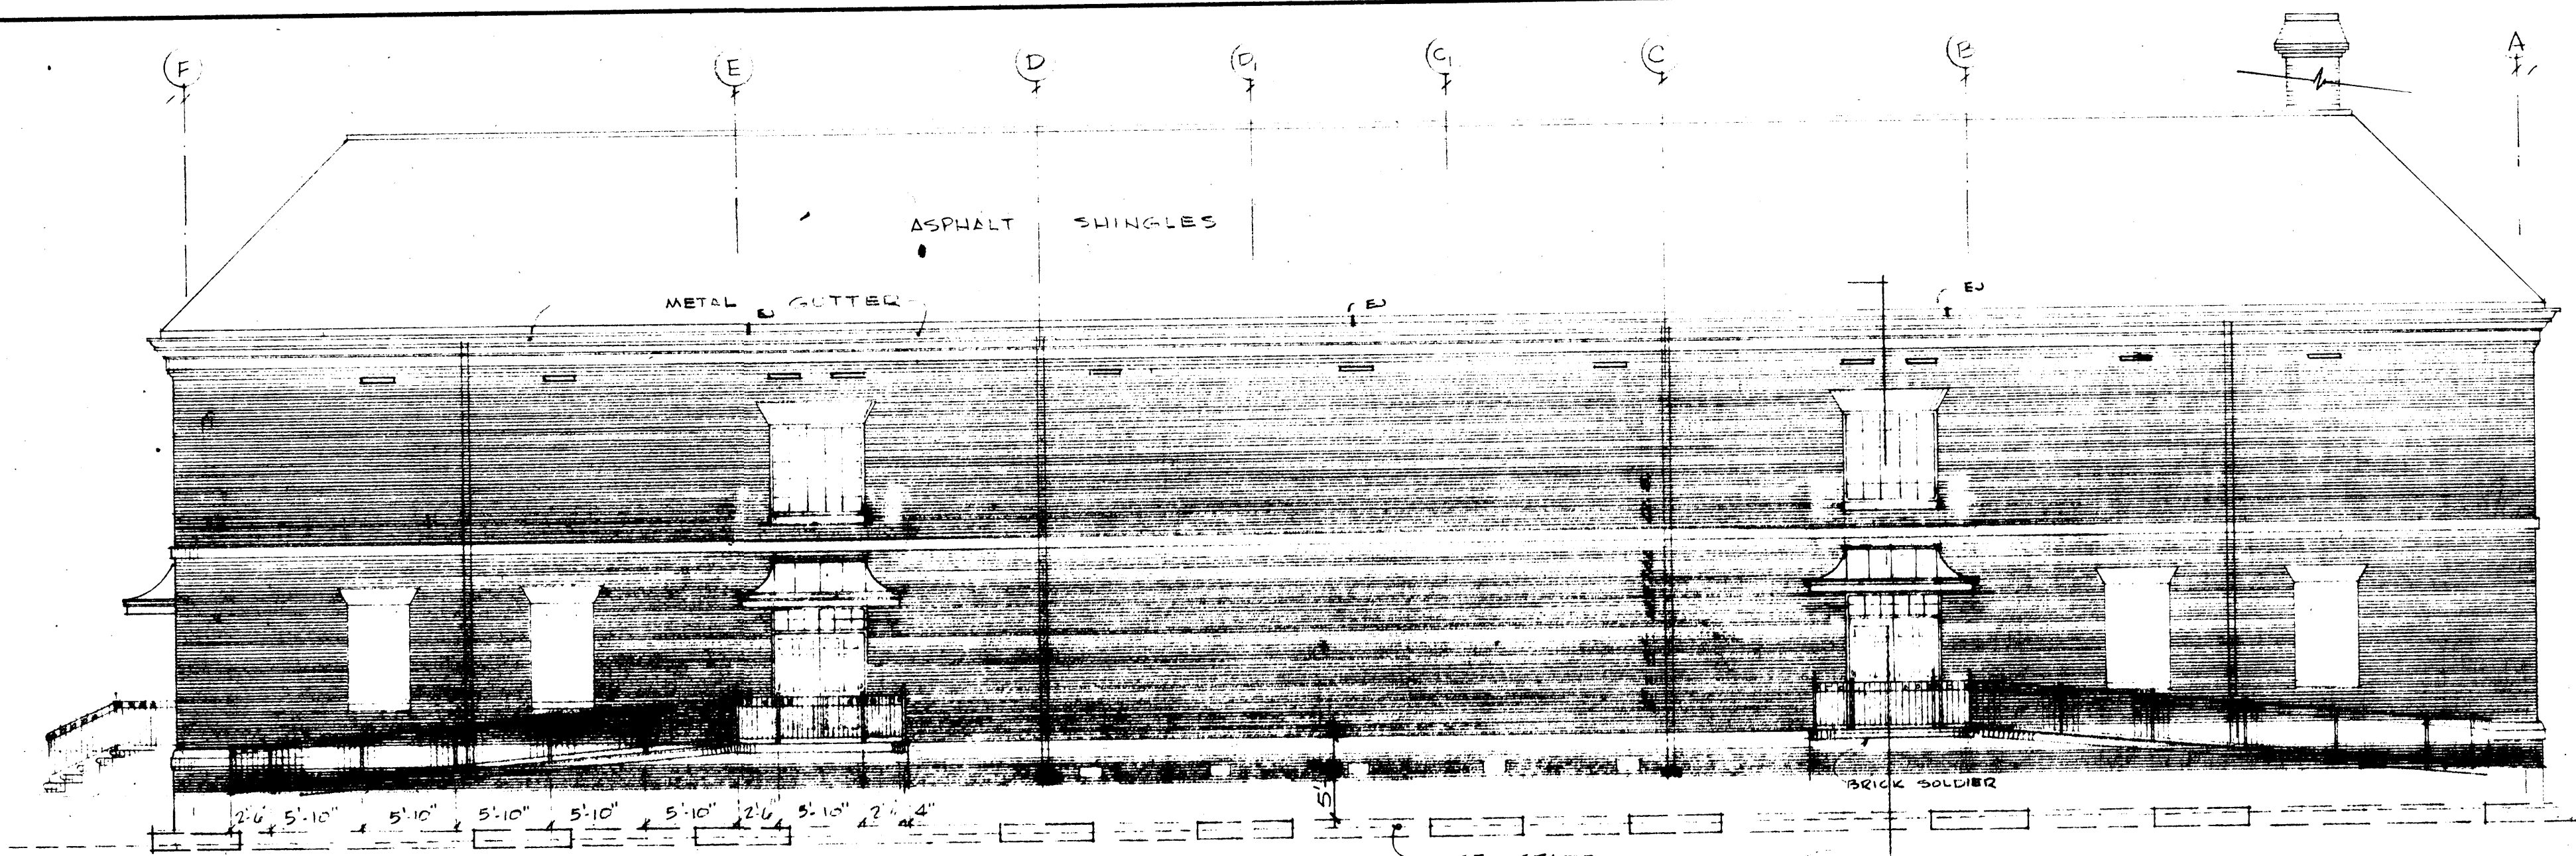


EAST ELEVATION

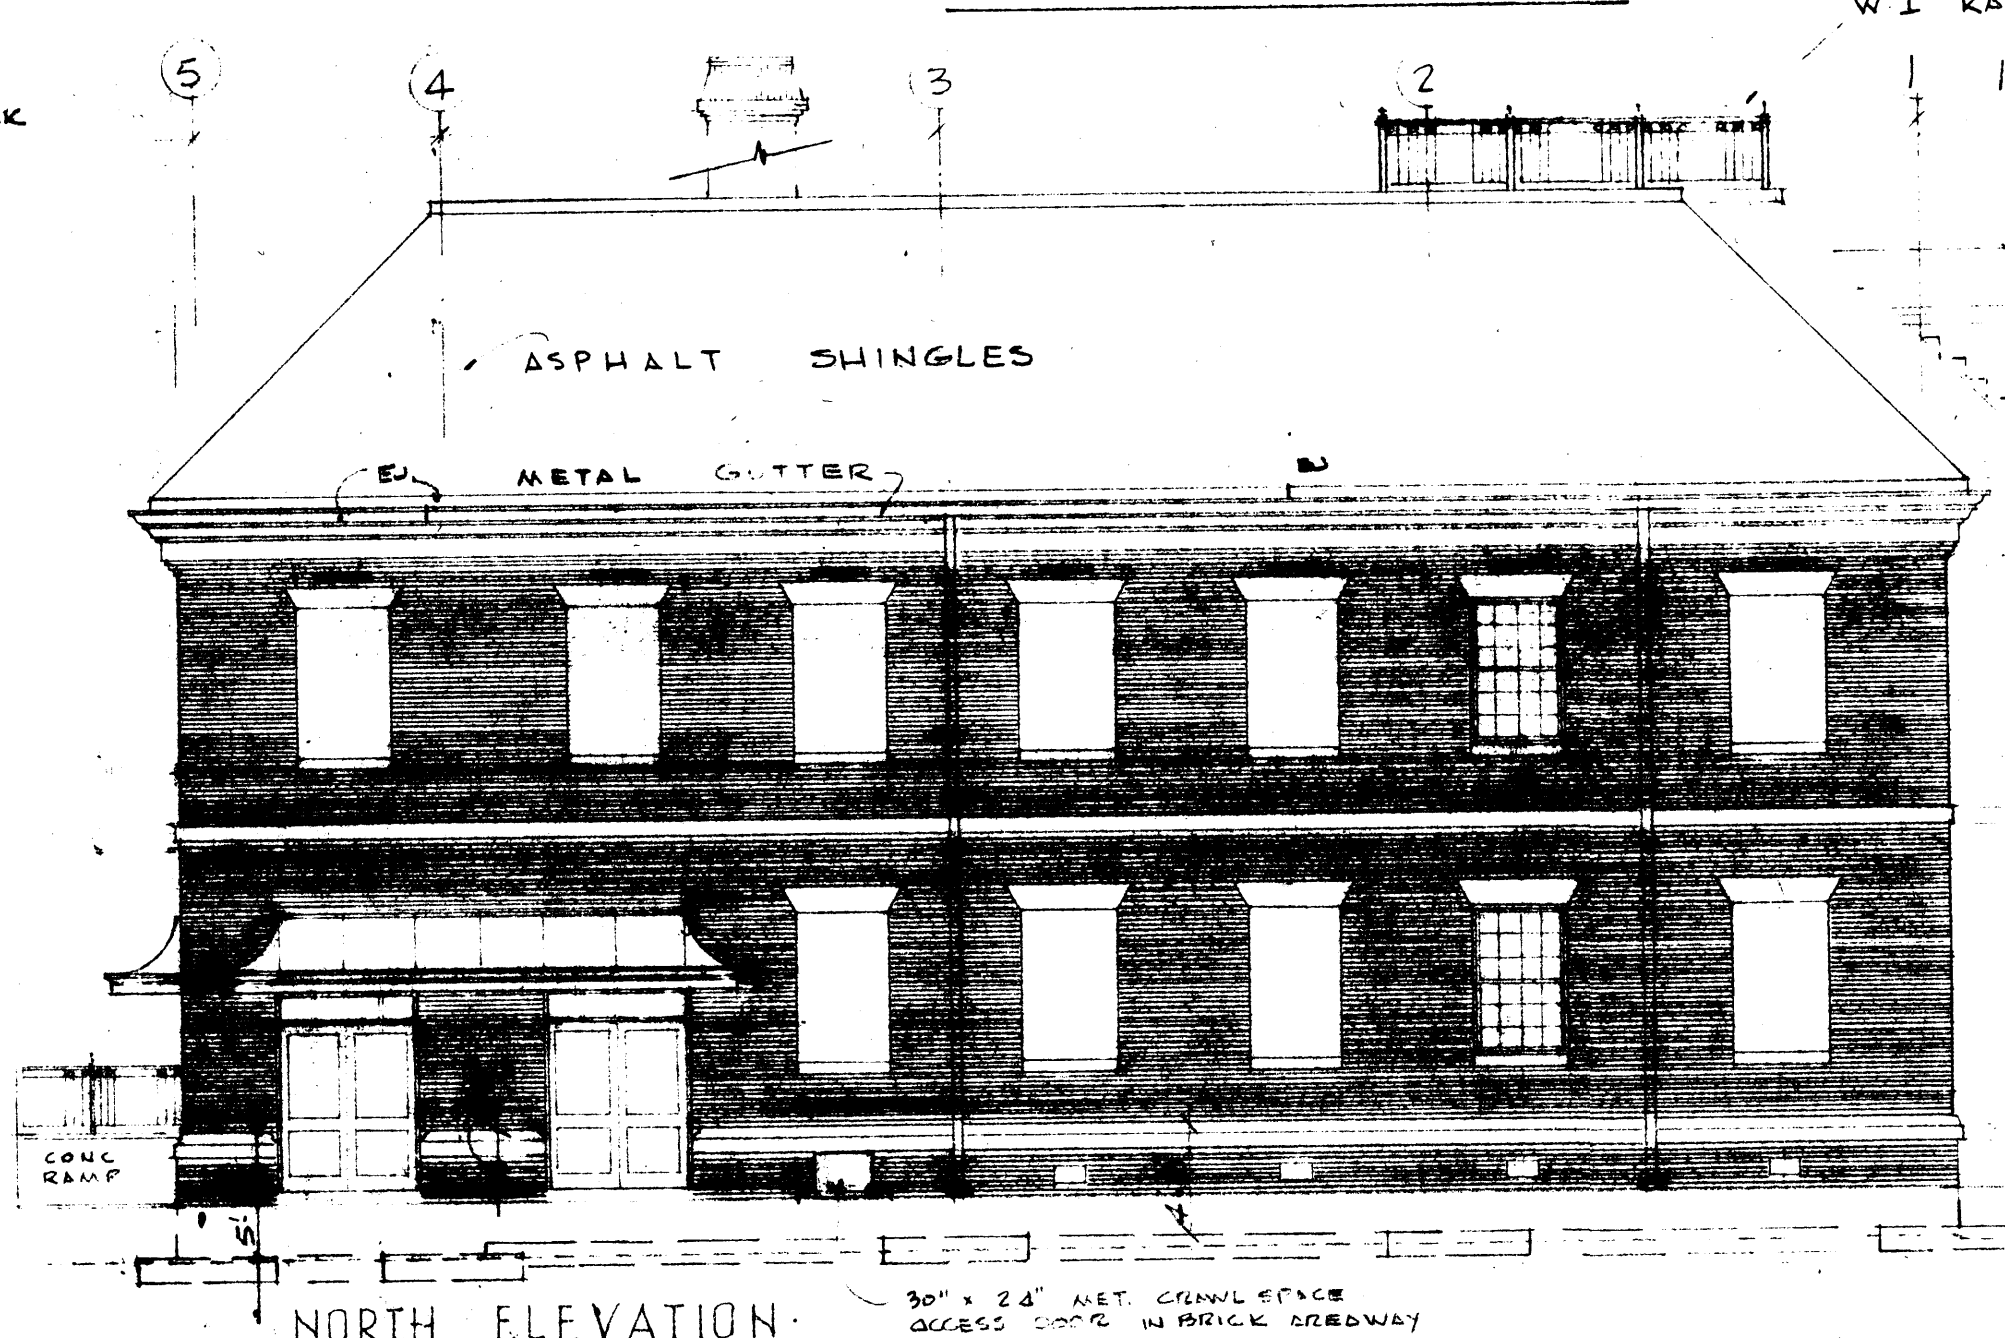


NORTH ELEVATION

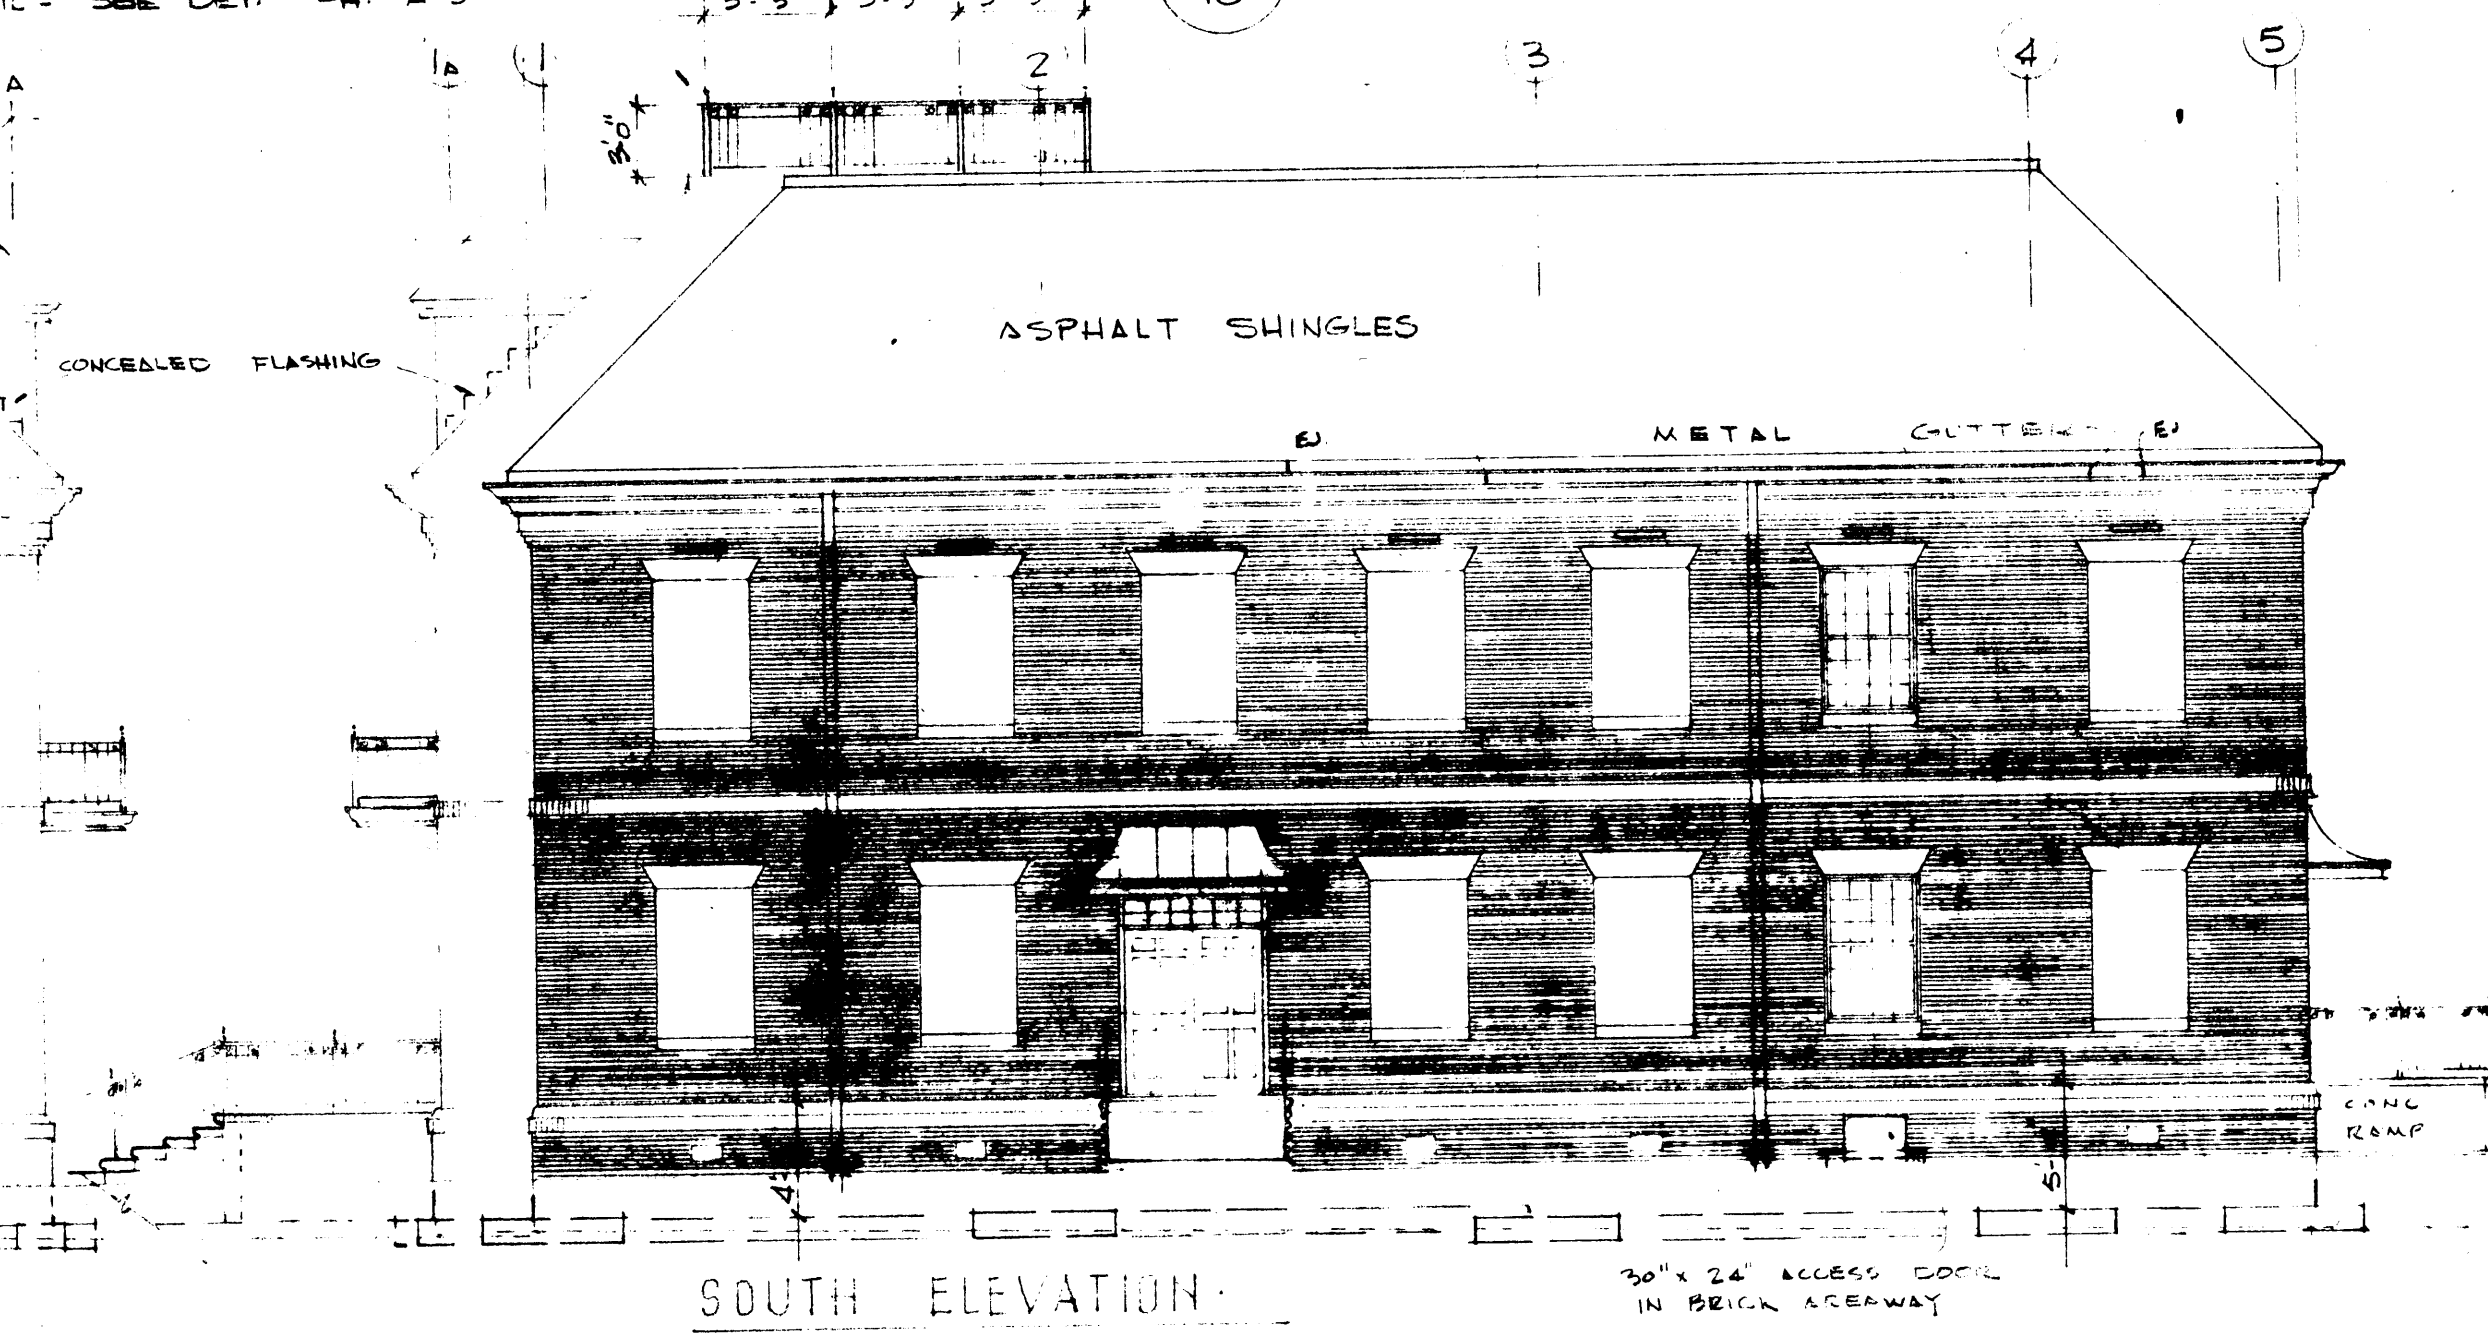

SOUTH ELEVATION

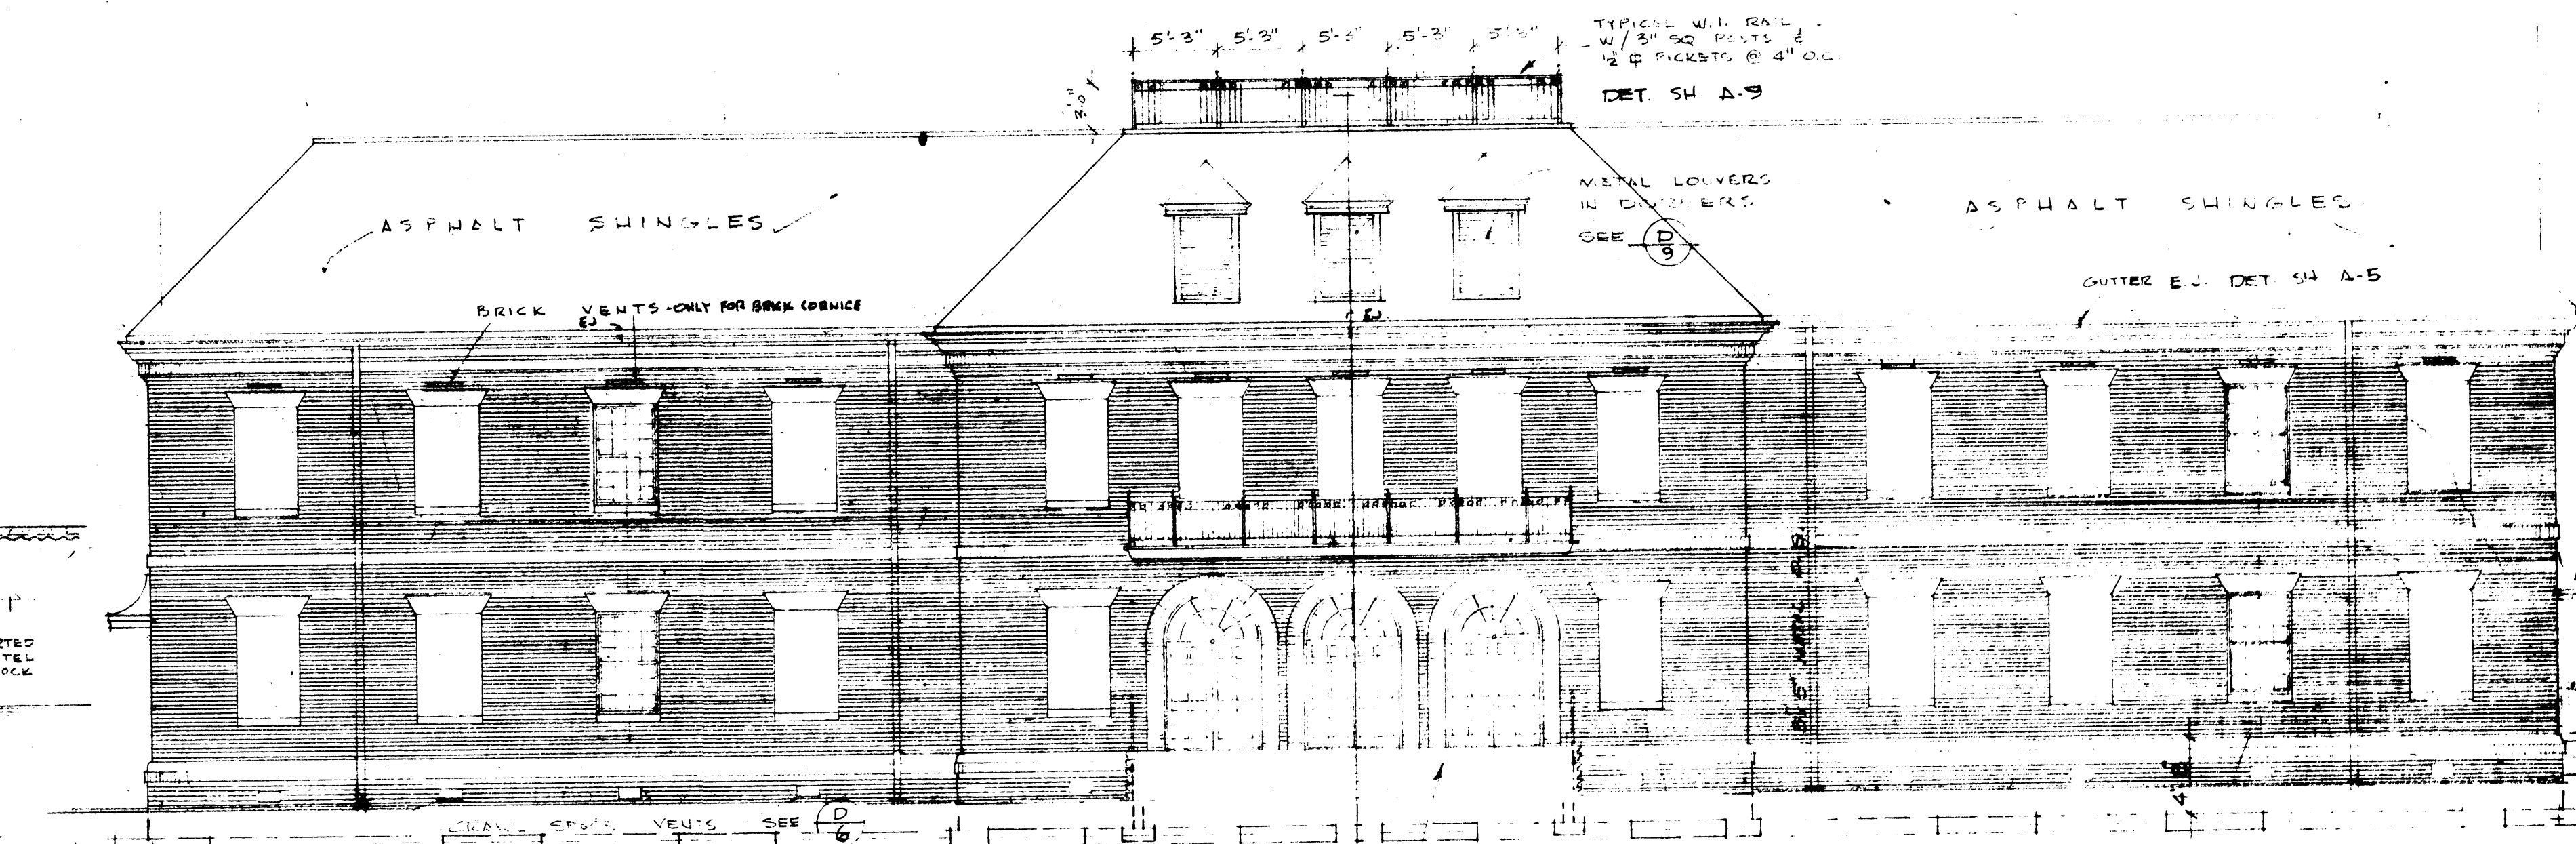

WEST ELEVATION

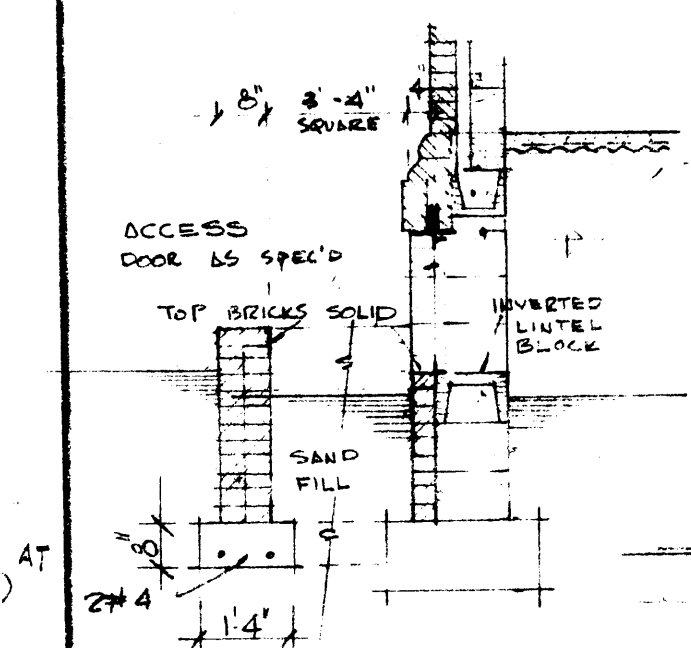

E CRAWL SPACE ACCESS AREA











WILMINGTON COLLEGE EDUCATION & PSYCHOLOGY BUILDING
 WILMINGTON, NORTH CAROLINA
 BALLARD, McKIM, & SAWYER, AIA
 512 SOUTH SEVENTEENTH STREET
 WILMINGTON, NORTH CAROLINA

BALLARD, McKIM, & SAWYER, AIA
 512 SOUTH SEVENTEENTH STREET
 WILMINGTON, NORTH CAROLINA



"AS-BUILT" DRAWING
DATE _____

T.C. 192
 JUN 10 1959
 A-6

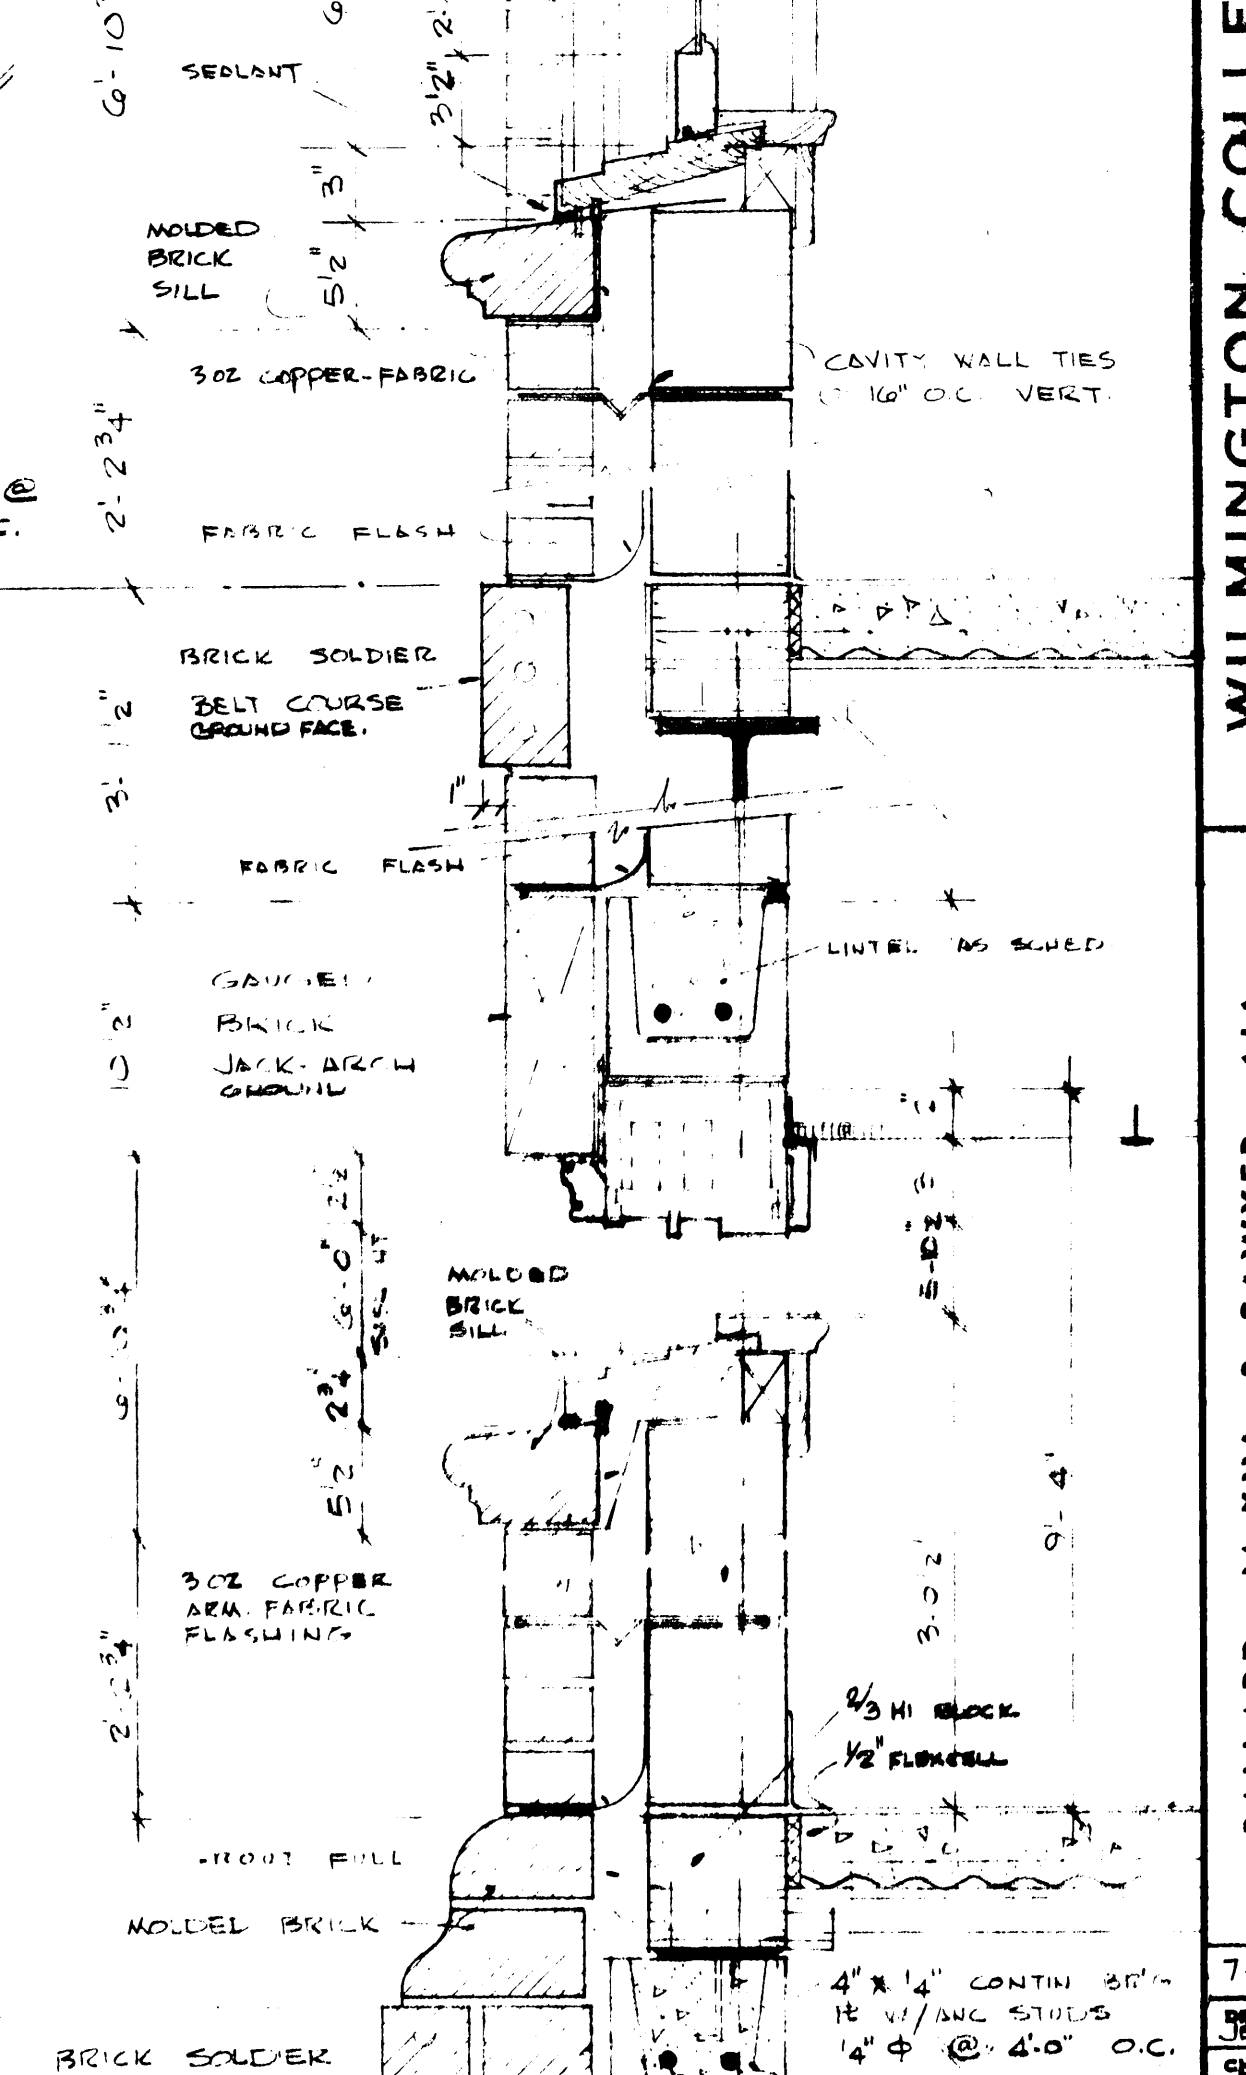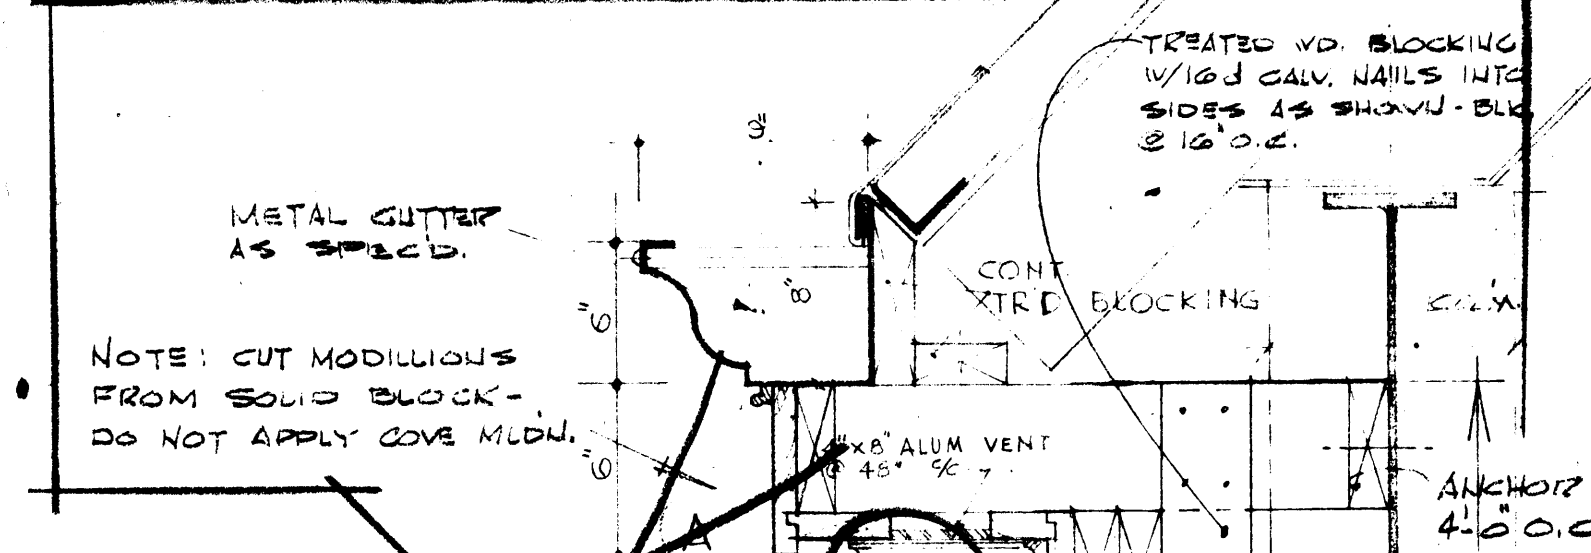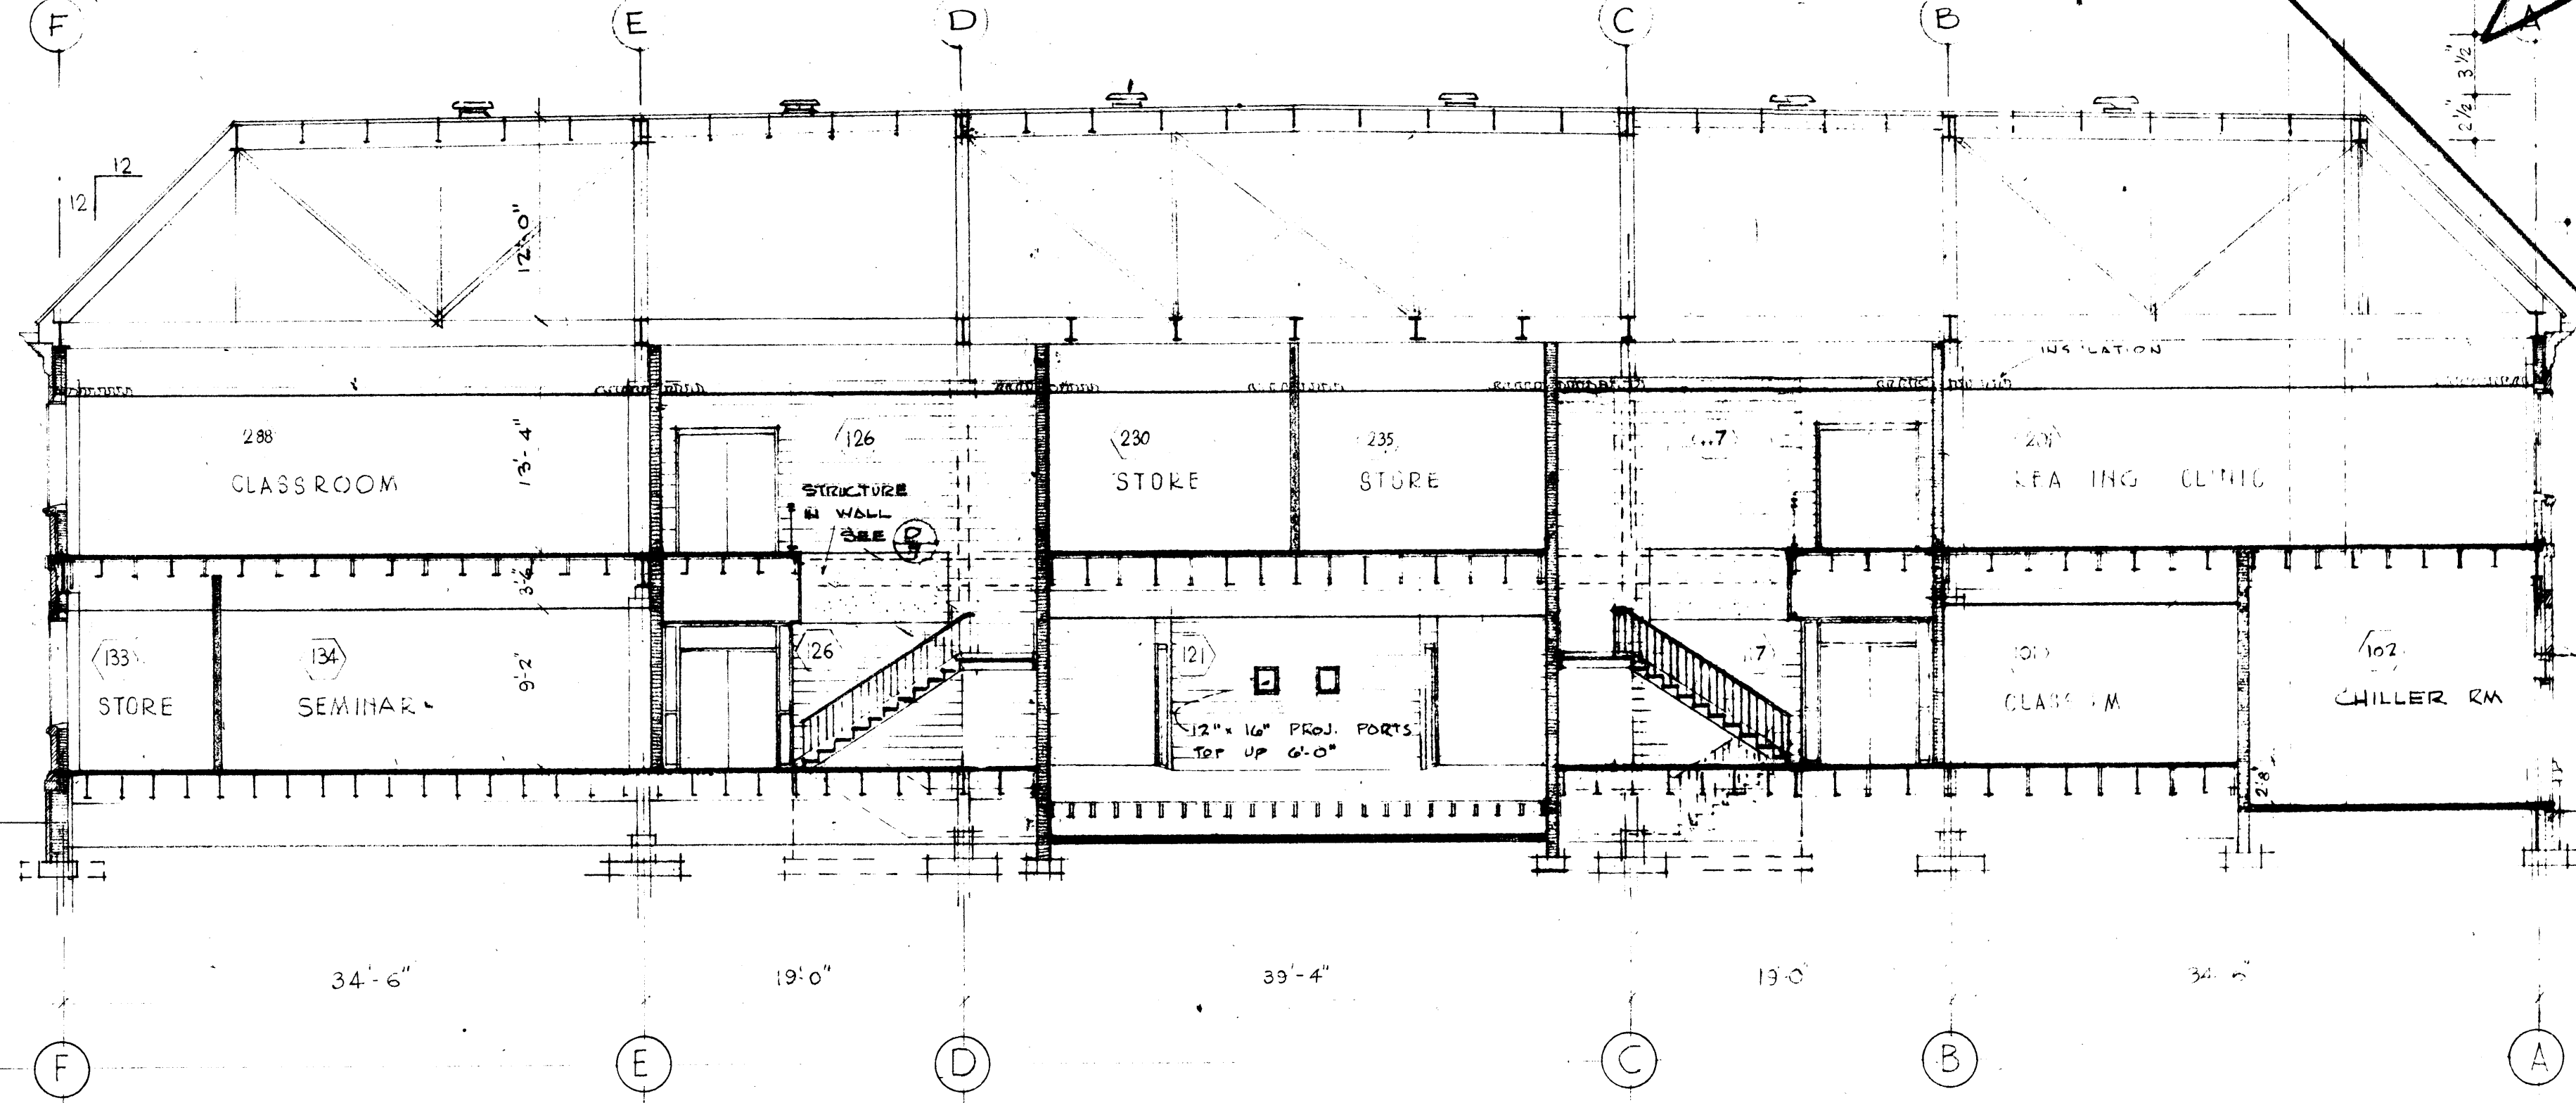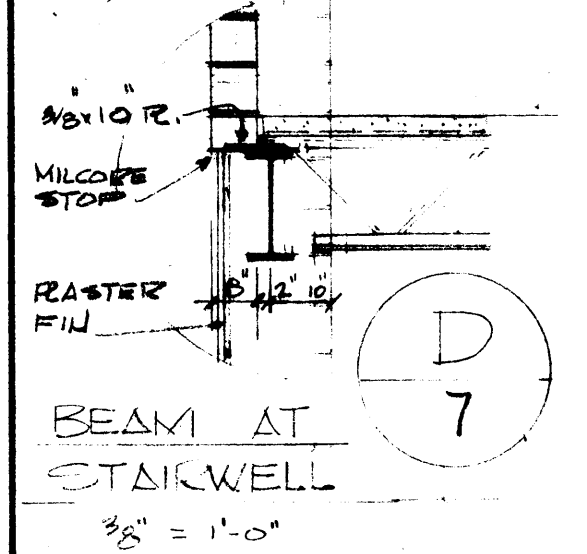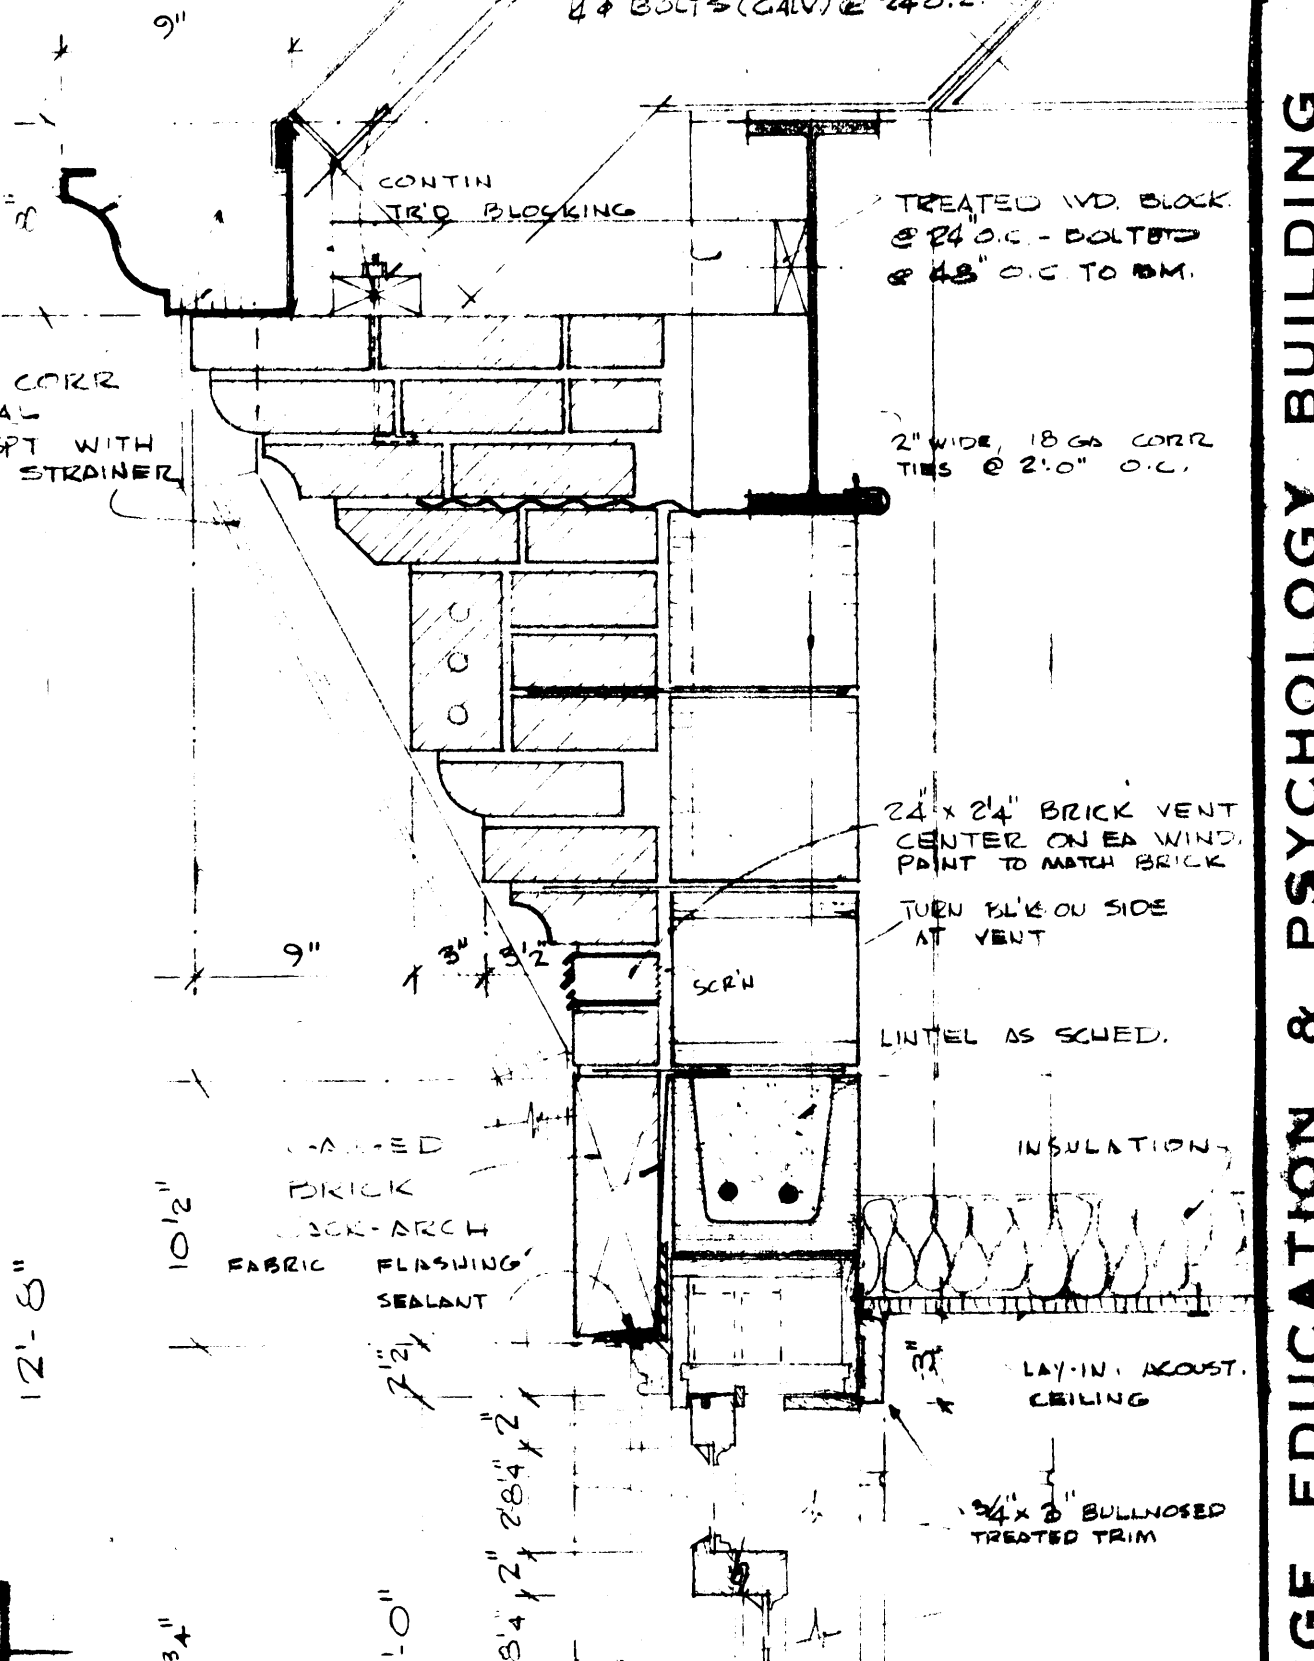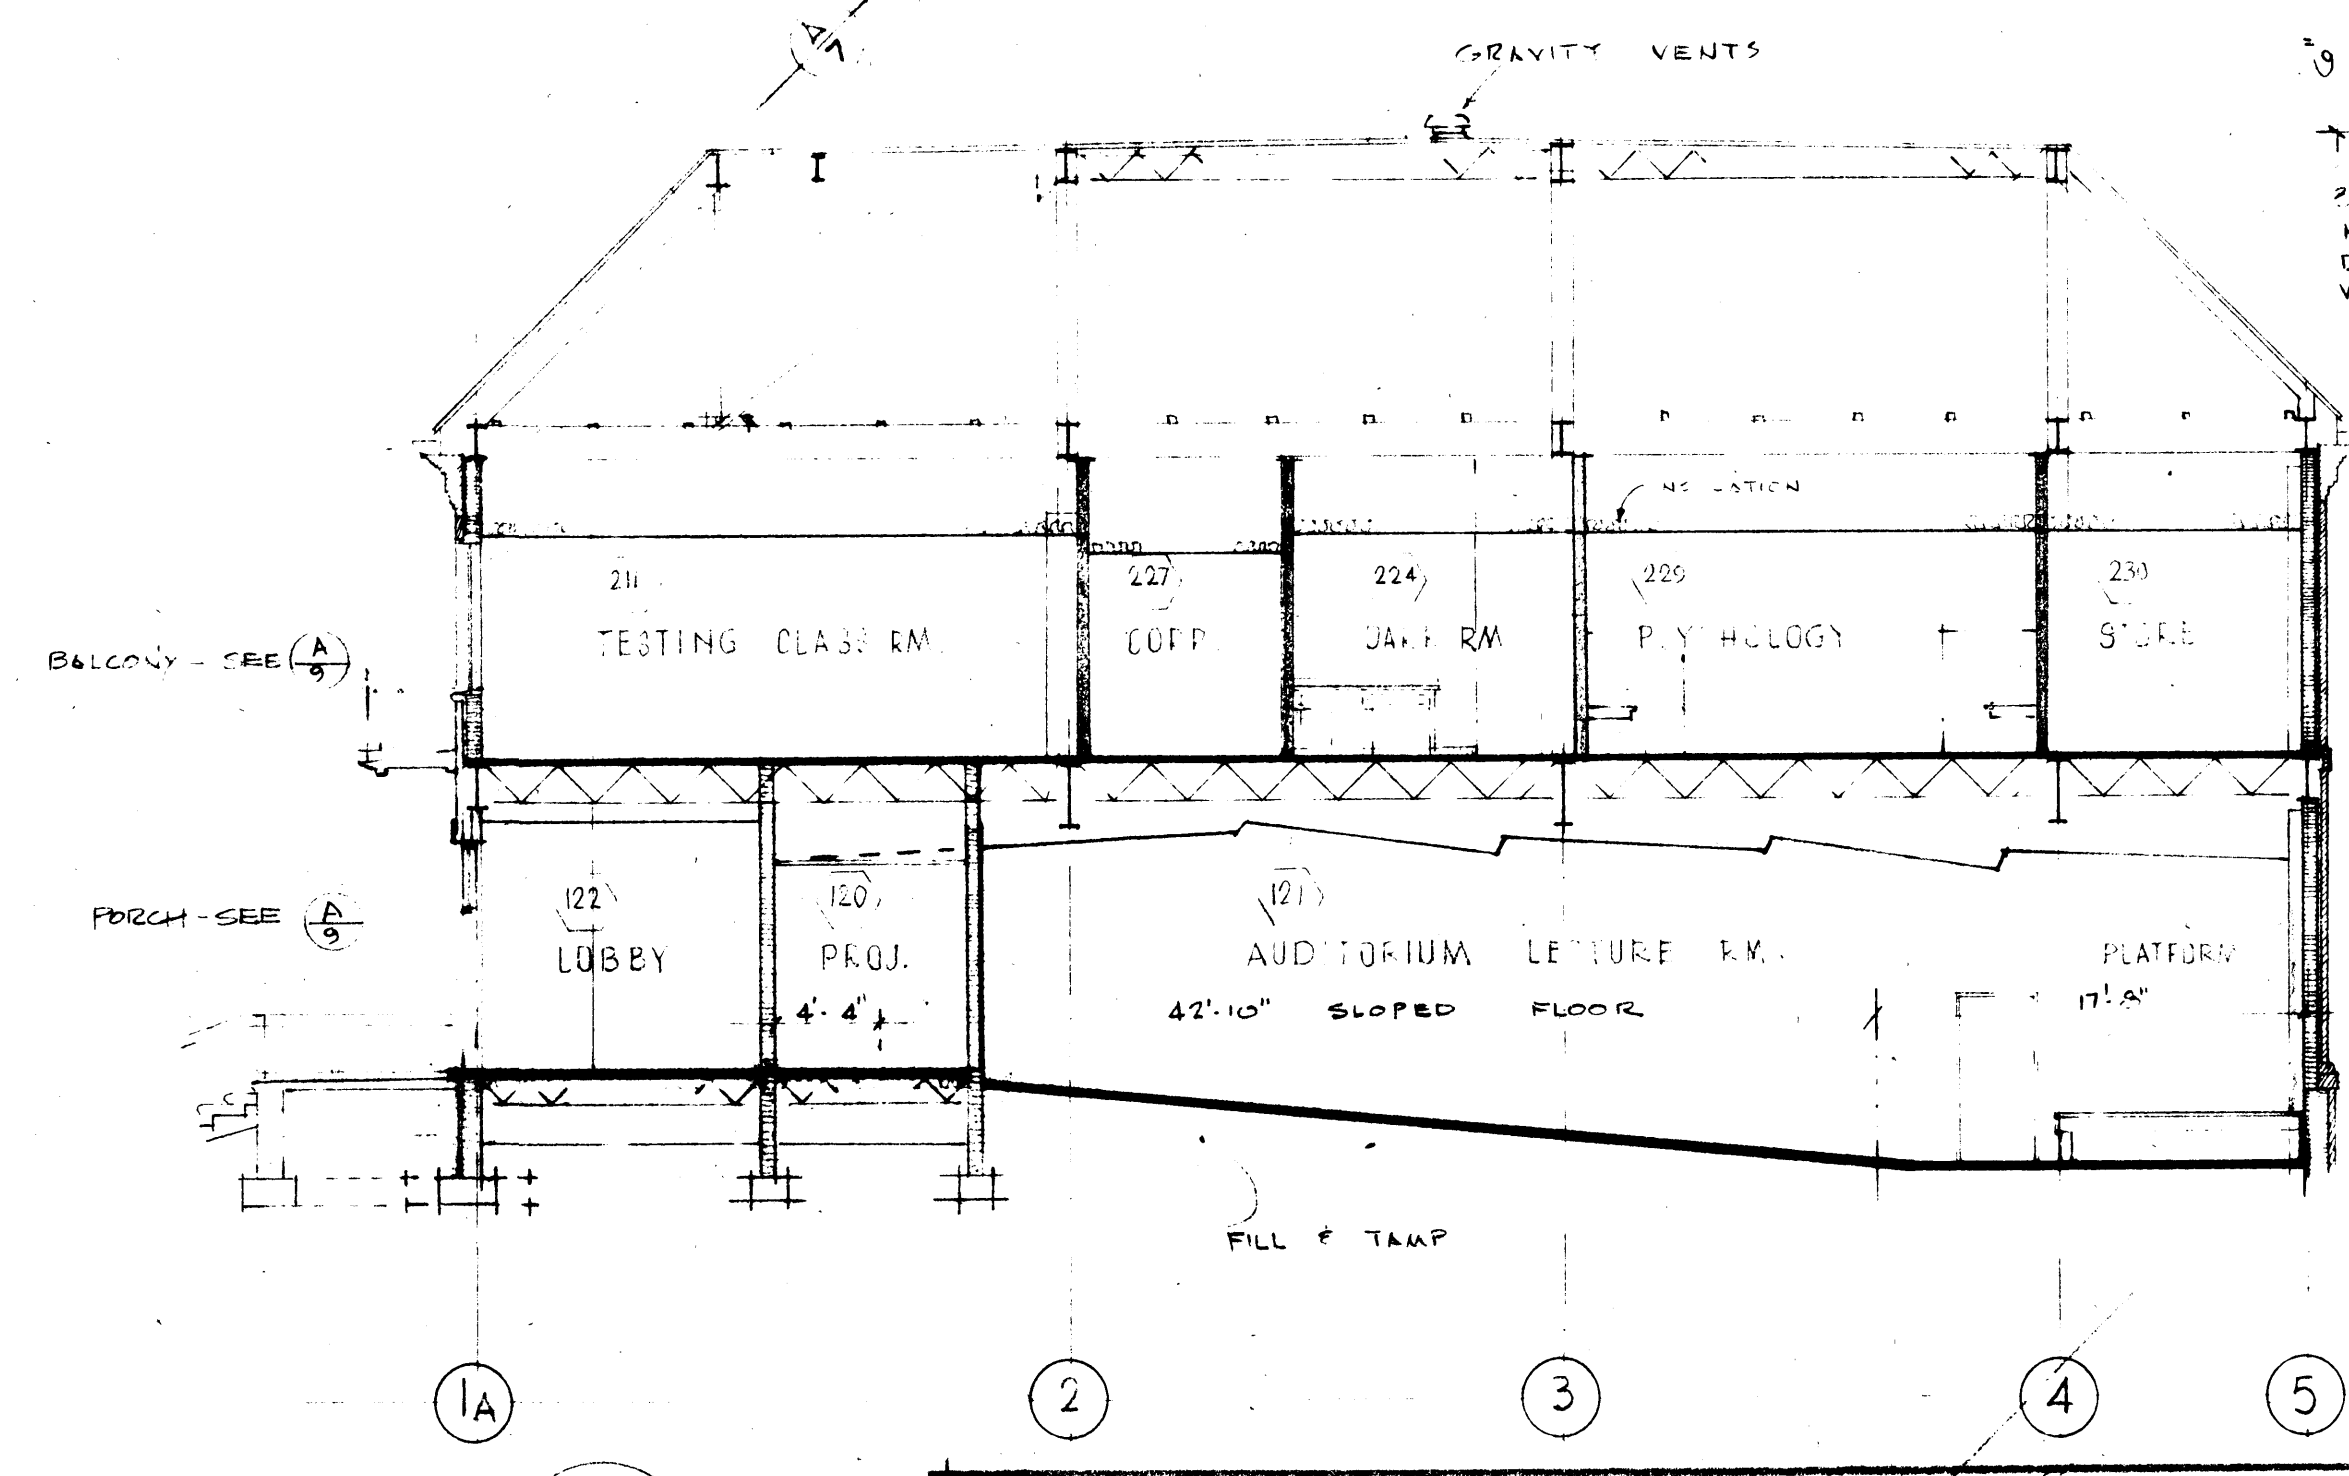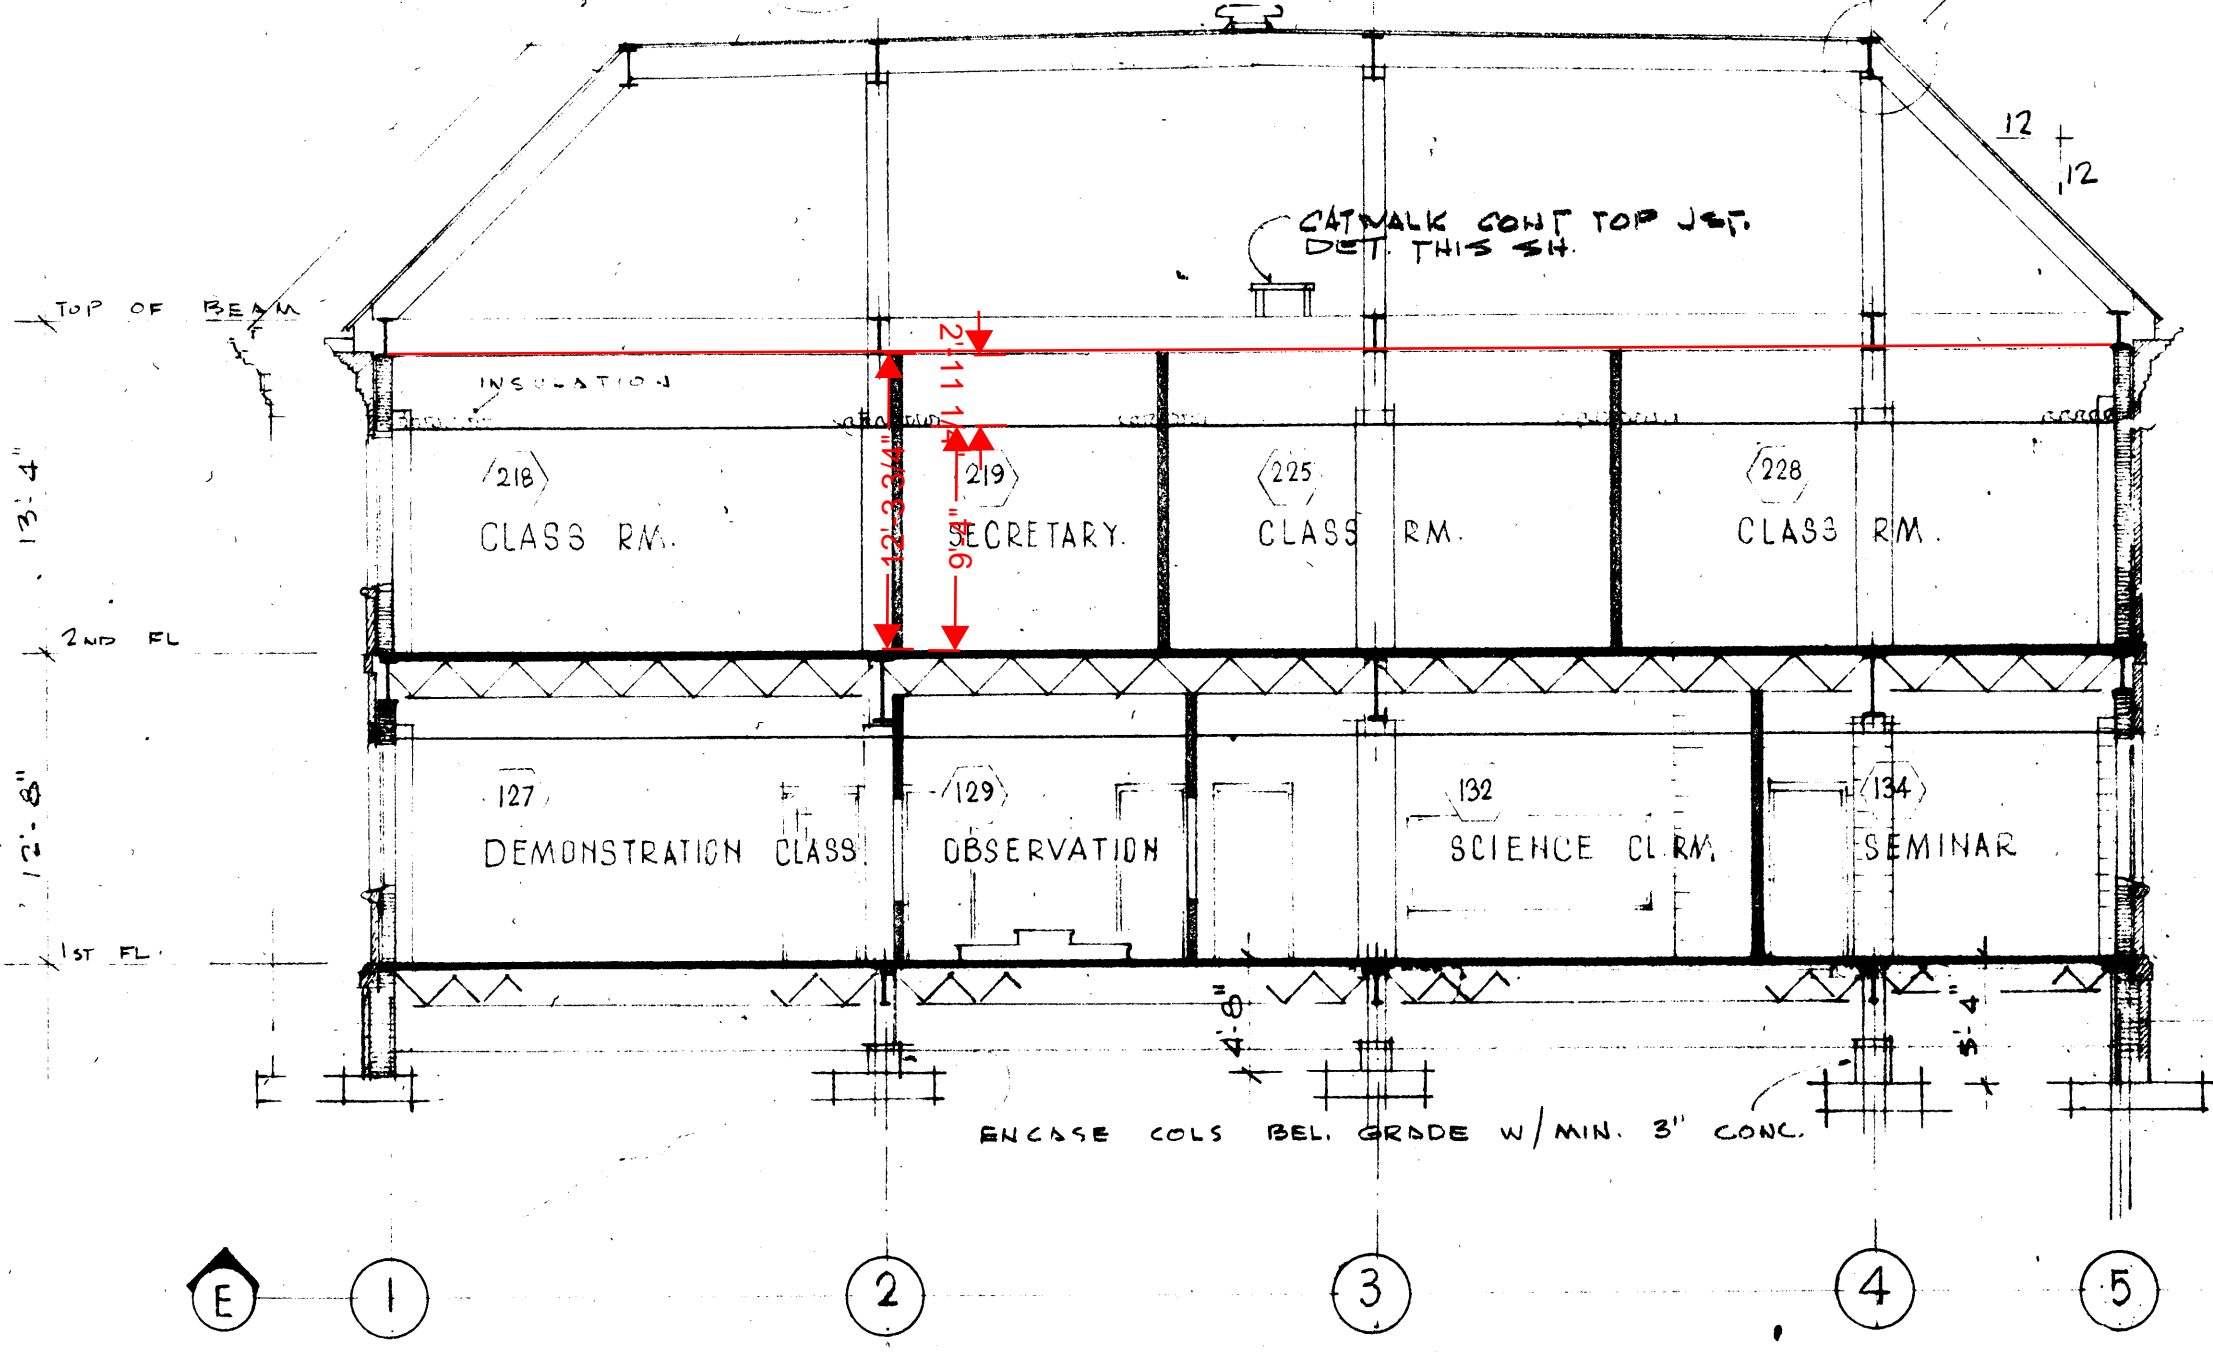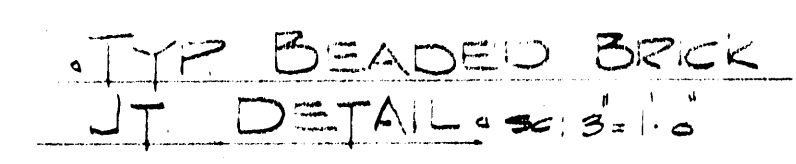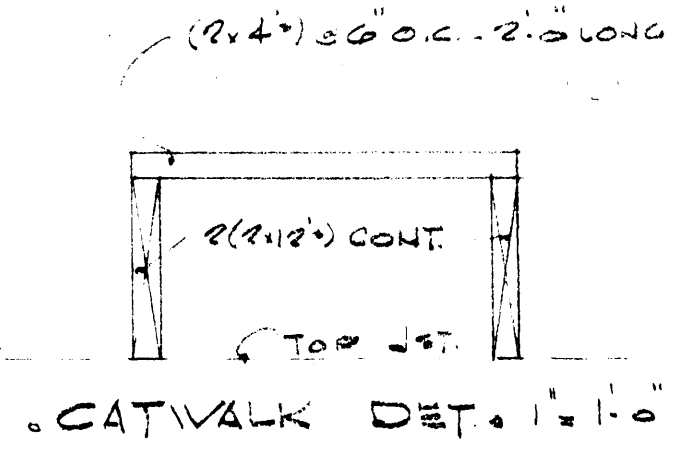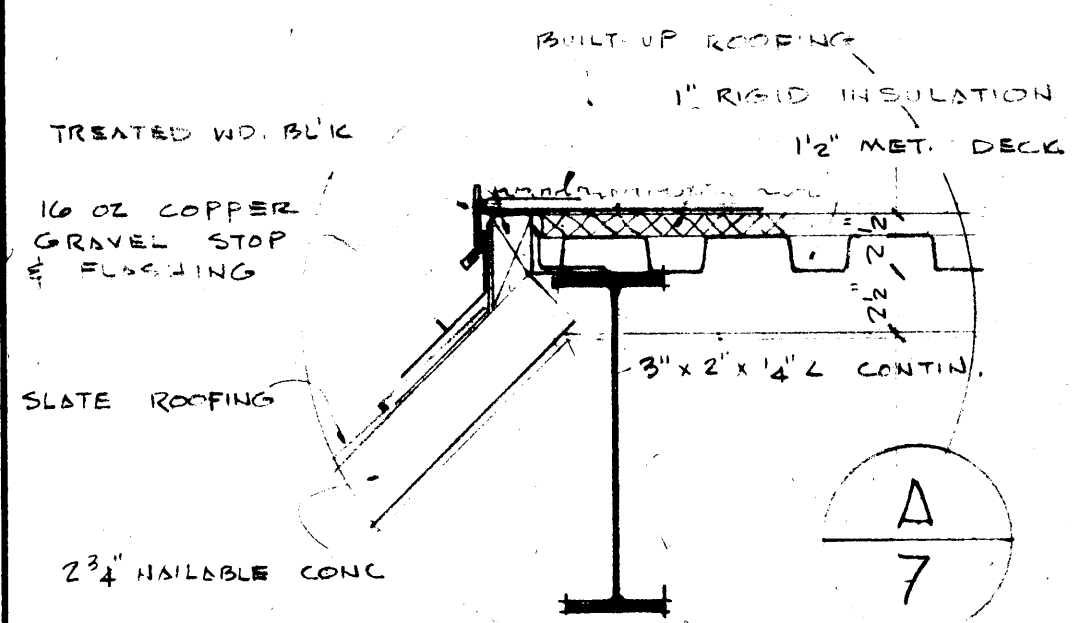

ALTERNATE WOODEN CORNICE - G 7




TYP. WINDOW & WALL

WILMINGTON COLLEGE EDUCATION & PSYCHOLOGY BUILDING
WILMINGTON, NORTH CAROLINA
BOARD OF TRUSTEES - BRADFORD TILLERY, JR. CHAIRMAN - DR. WILLIAM M. RANDALL, PRESIDENT

BALLARD, McKIM, & SAWYER, AIA
412 SOUTH SPENCER STREET
WILMINGTON, NORTH CAROLINA

7-C-792
A-7

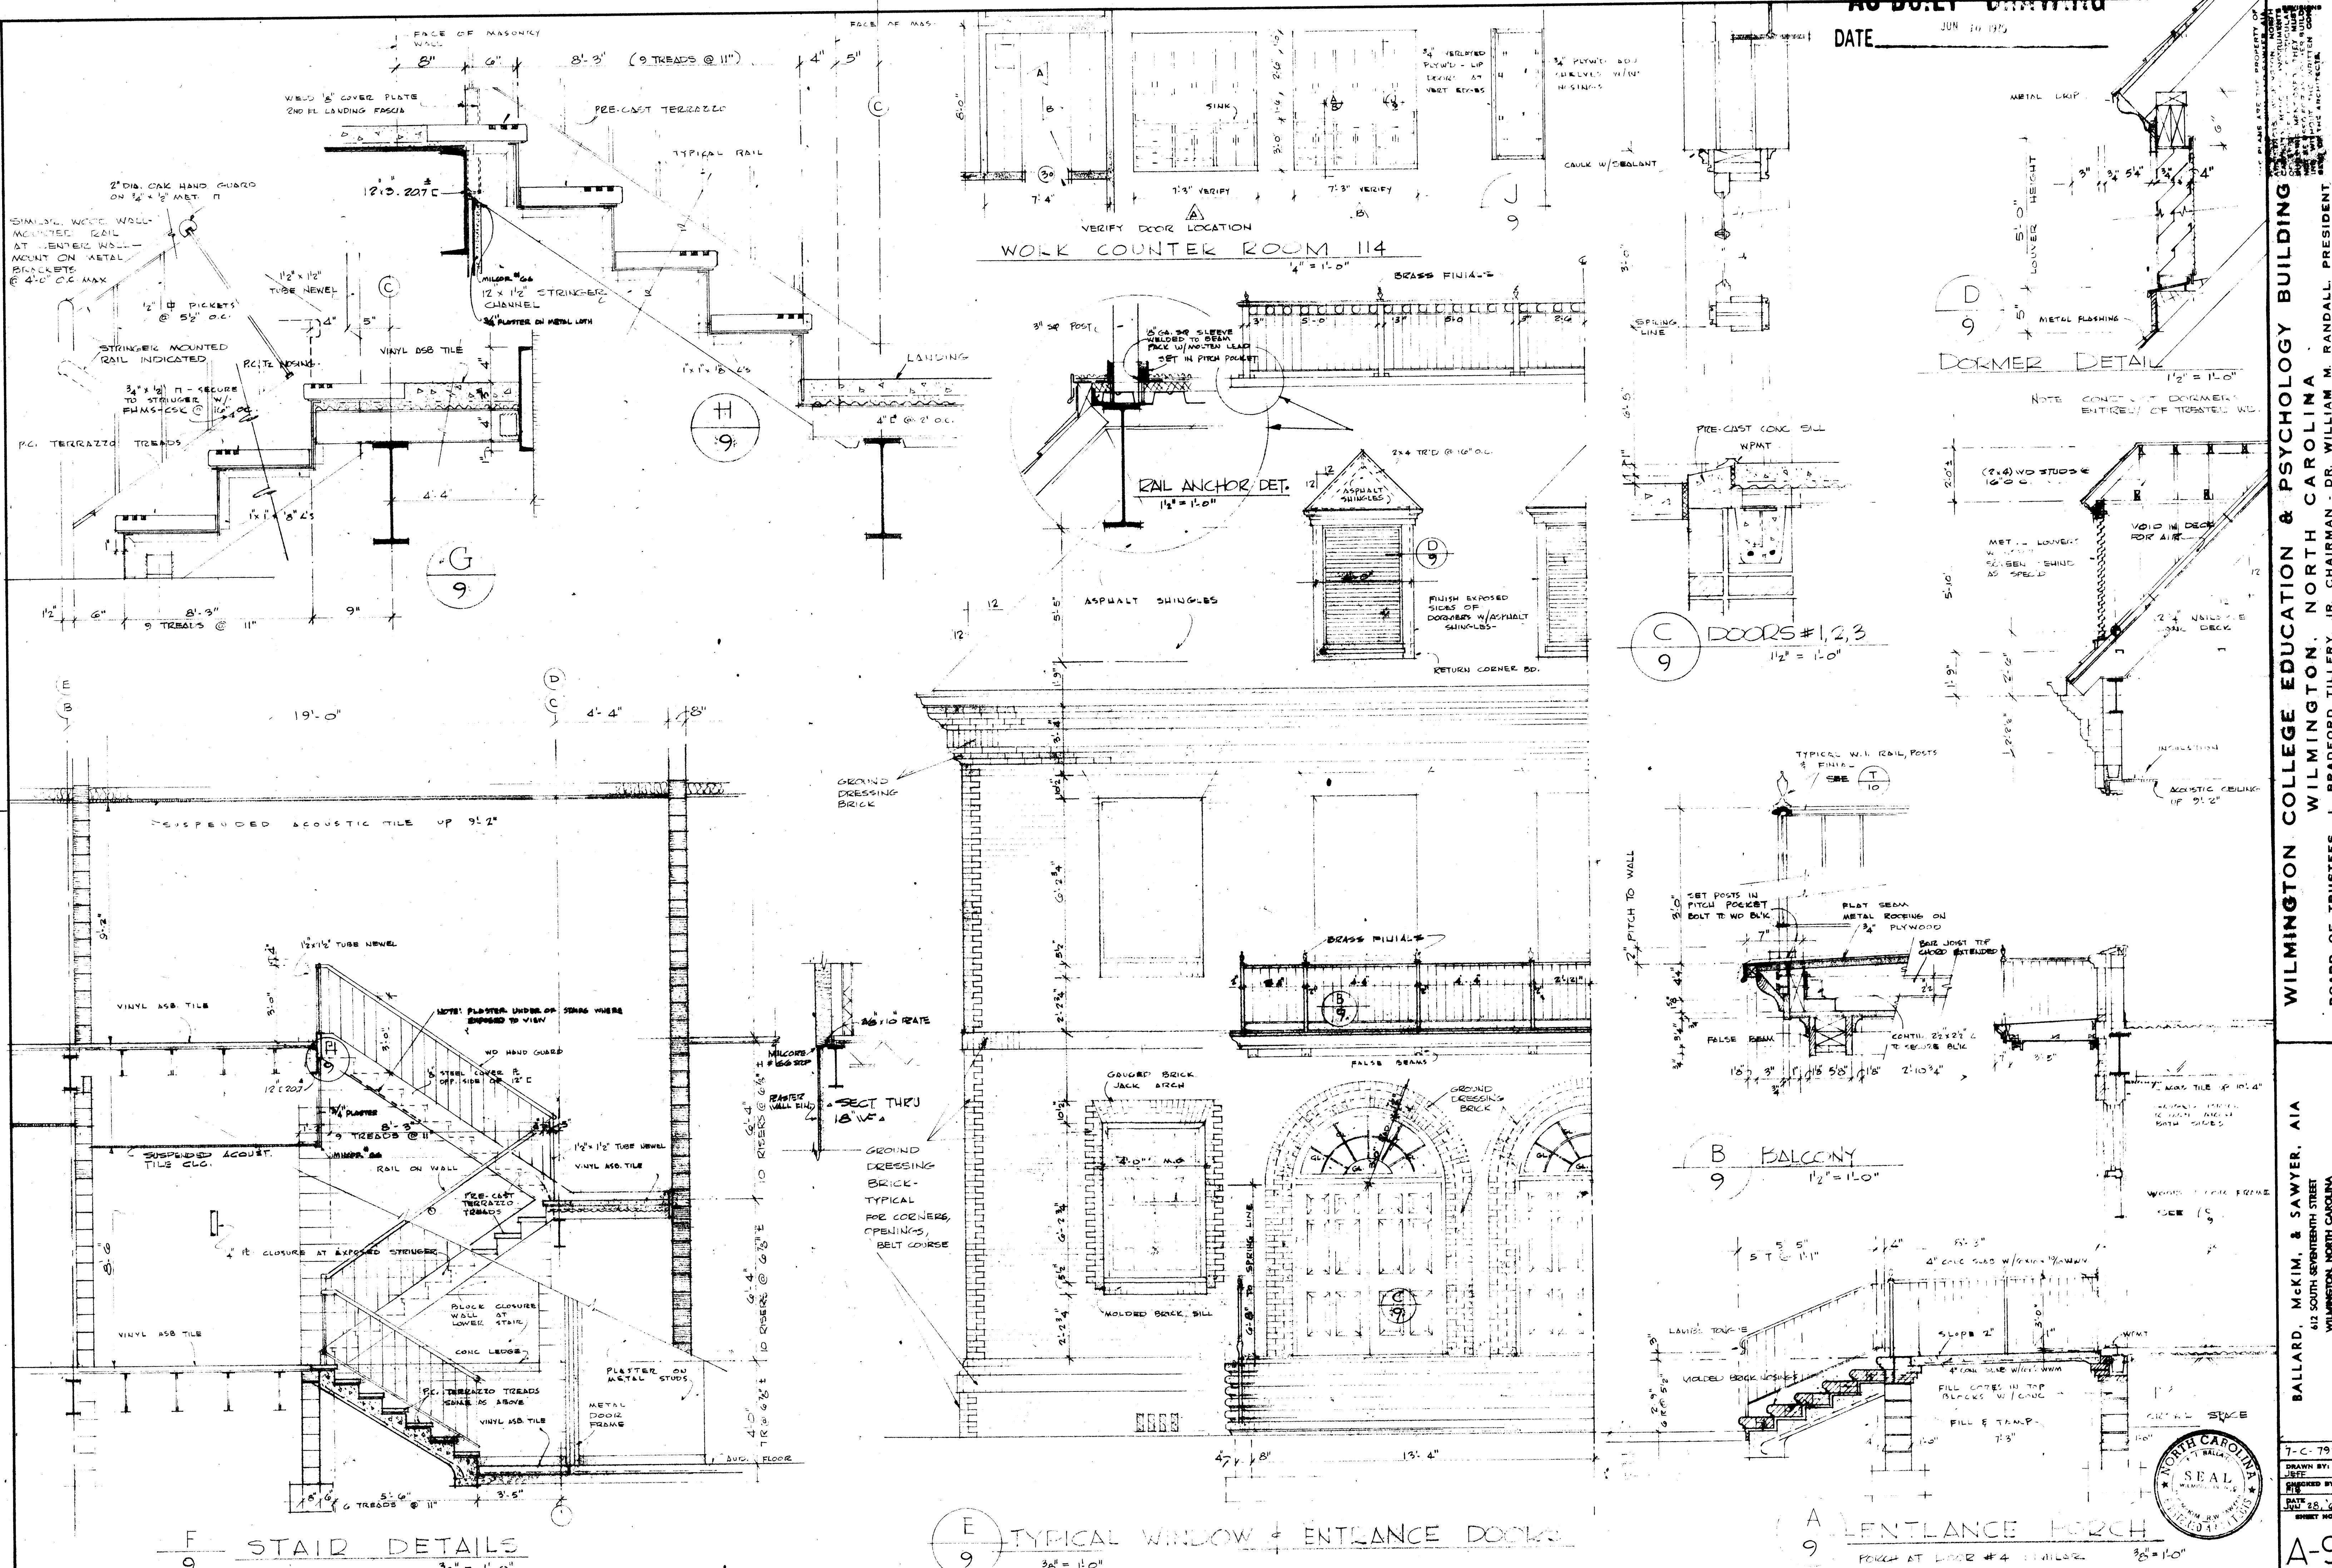

F STAIR DETAILS 38" = 1'-0"

E TYPICAL WINDOW & ENTRANCE DOORS 38" = 1'-0"


A ENTRANCE PORCH 38" = 1'-0"

WILMINGTON COLLEGE EDUCATION & PSYCHOLOGY BUILDING
WILMINGTON, NORTH CAROLINA
BOARD OF TRUSTEES - L. BRADFORD TILLERY, JR. CHAIRMAN - DR. WILLIAM M. RANDALL, PRESIDENT

BALLARD, McKIM, & SAWYER, AIA
612 SOUTH SEVENTEENTH STREET
WILMINGTON, NORTH CAROLINA
7-C-792
DRAWN BY
CHECKED BY
DATE JUL 25 1975
SHEET NO. A-9



CODE 66737 - ITEM 6

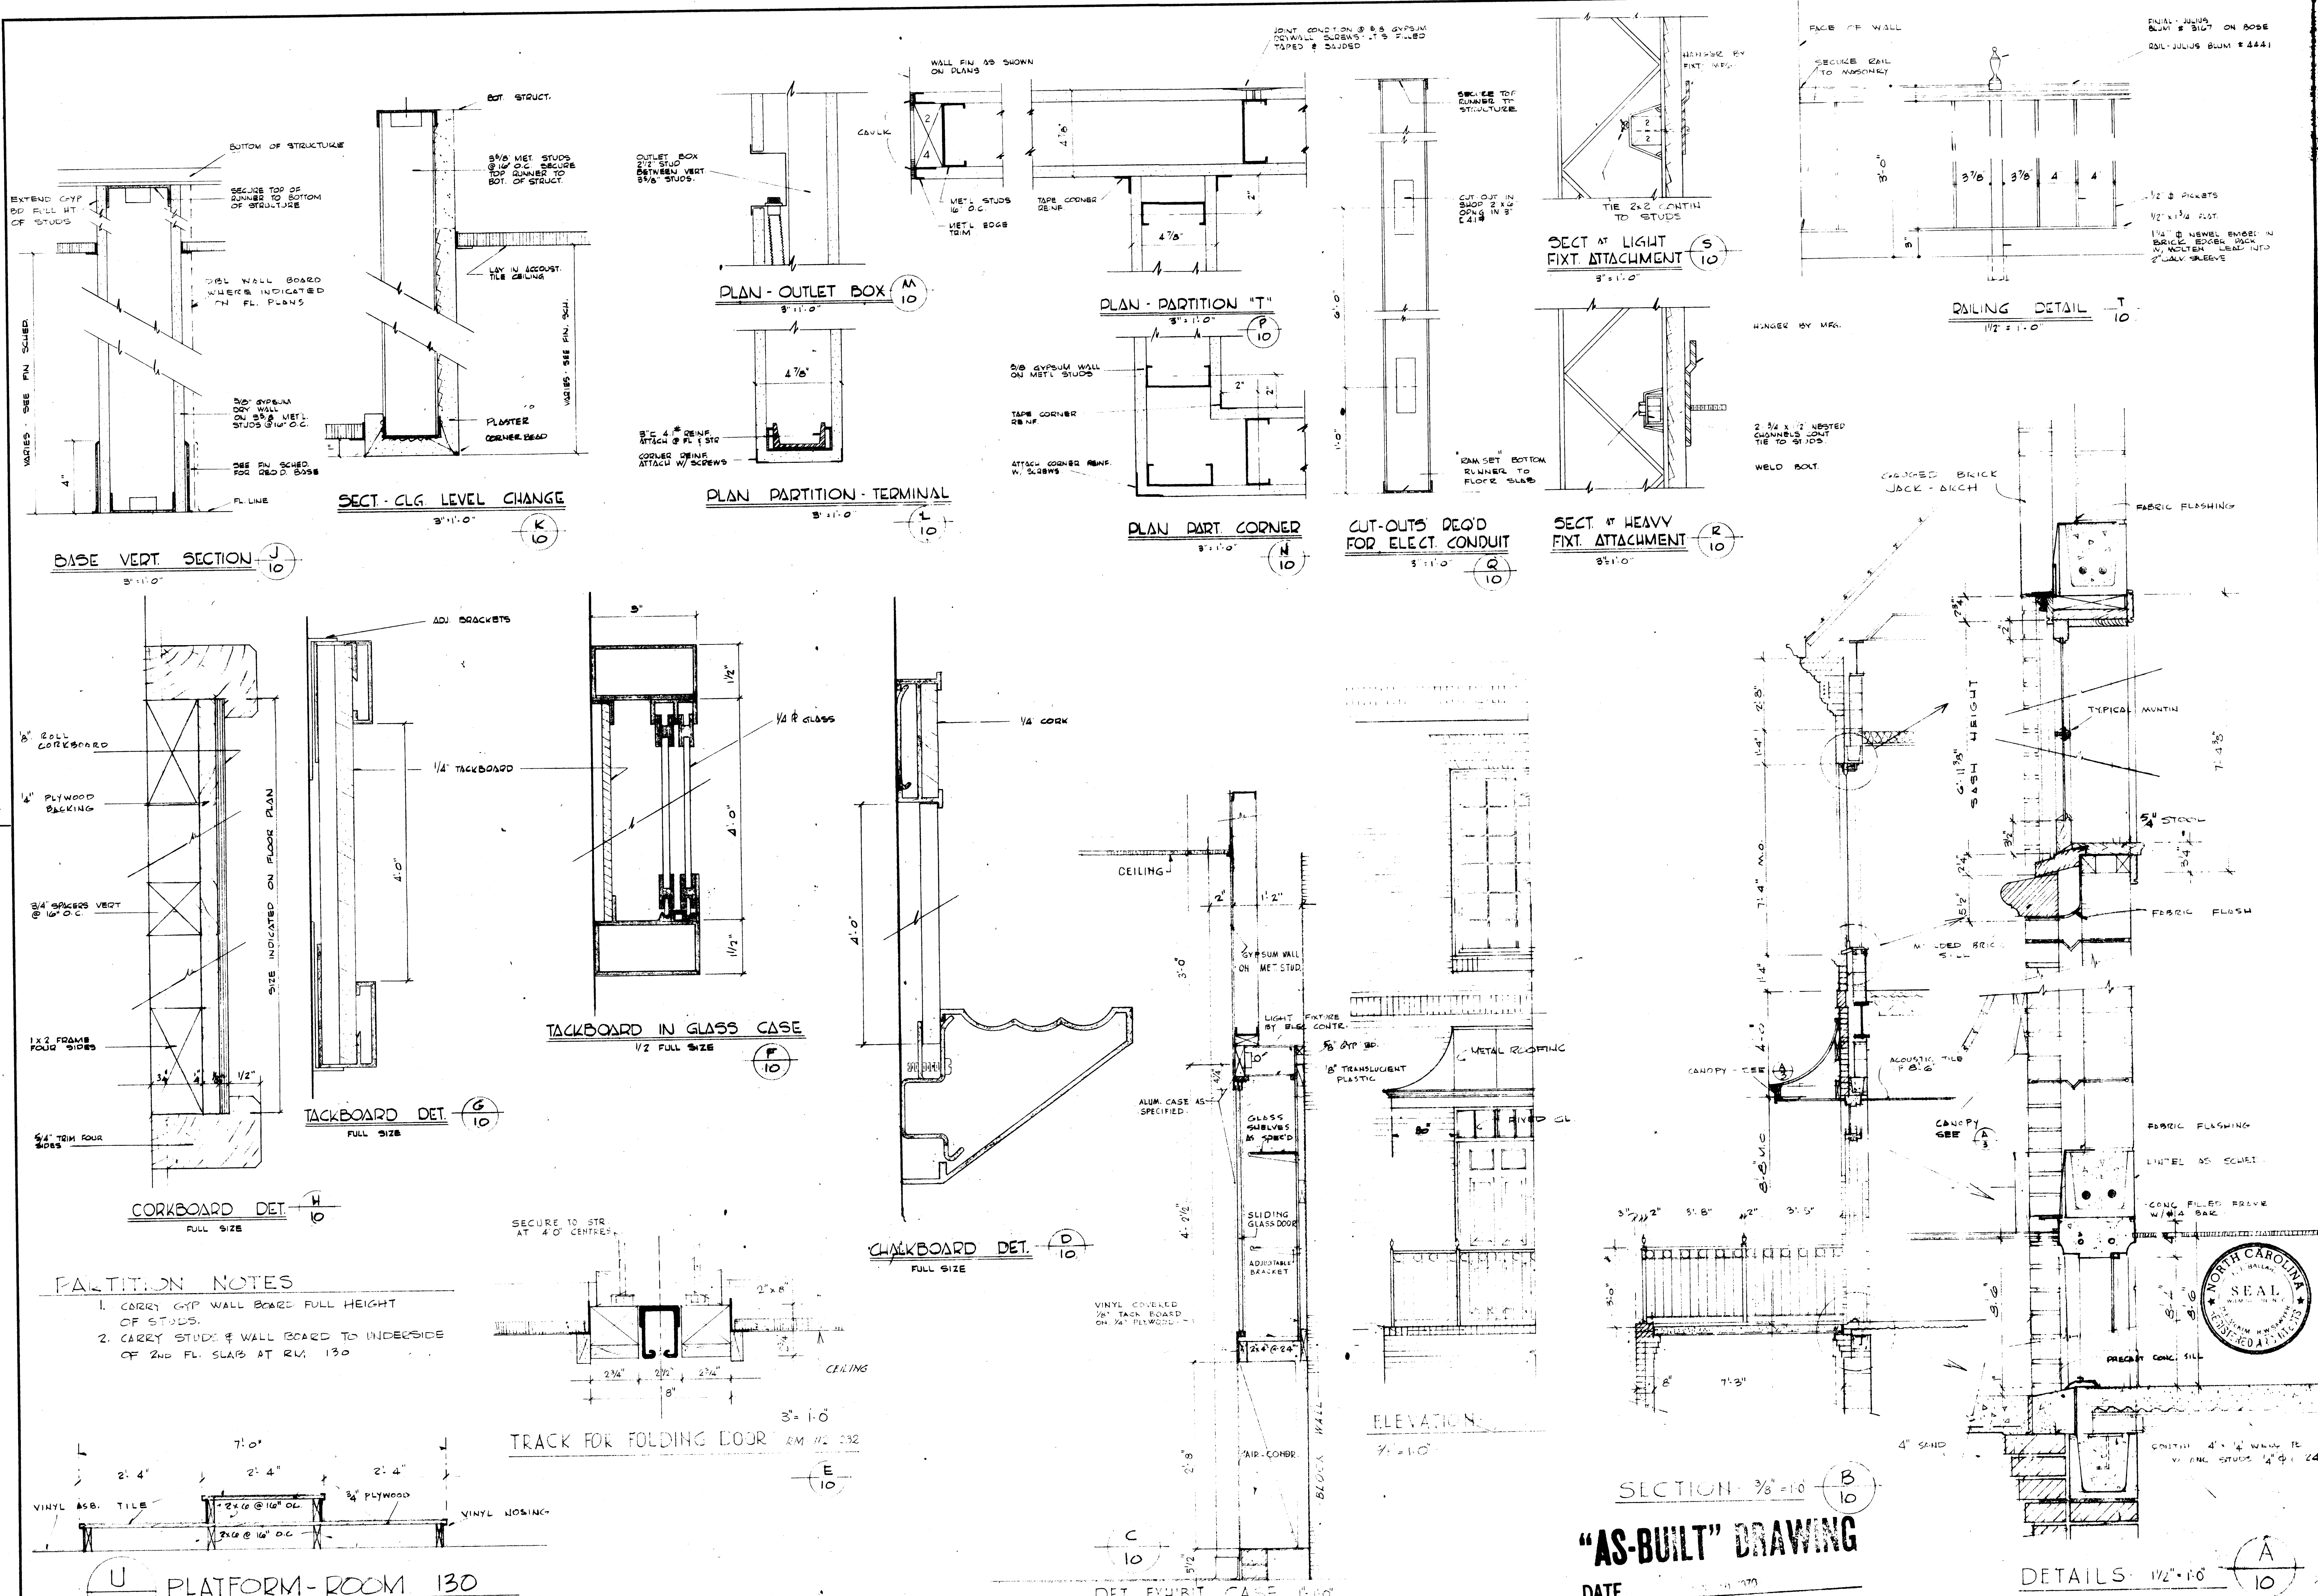

- PARTITION NOTES**
- CARRY GYP WALL BOARD FULL HEIGHT OF STUDS.
 - CARRY STUDS & WALL BOARD TO UNDERSIDE OF 2ND FL. SLAB AT RM. 130

"AS-BUILT" DRAWING
DATE

WILMINGTON COLLEGE EDUCATION & PSYCHOLOGY BUILDING
 WILMINGTON, NORTH CAROLINA
 BOARD OF TRUSTEES - L. BRADFORD TILLERY, JR. CHAIRMAN - DR. WILLIAM M. RANDALL, PRESIDENT

BALLARD, McKIM, & SAWYER, AIA
 612 SOUTH SEVENTEENTH STREET
 WILMINGTON, NORTH CAROLINA











740-792
 11/28/68
 A-10

CODE 66737 - ITEM 6

DOOR & FRAME SCHEDULE


| DOOR NO. | SPACE NO. | DOOR SIZE | DOOR TYPE | FRAME TYPE | FRAME PROFILE | HWY GROUP | KEY GROUP | DOOR NO. |
|----------|-----------|-----------------|-----------|------------|---------------|-----------|-----------|----------|
| 1 | 122 | 2'-2"8" x 6'-8" | A | WD | - | H-1 | a | 1 |
| 2 | 122 | 2'-2"8" x 6'-8" | A | WD | - | H-1 | b | 2 |
| 3 | 122 | 2'-2"8" x 7'-0" | A | WD | - | H-1 | c | 3 |
| 4 | 133 | 2'-2"4" x 7'-0" | A | SM | 8 3/4" | H-1 | d | 4 |
| 5 | 125 | 2'-2"4" x 7'-0" | A | WD | 8 3/4" | H-1 | e | 5 |
| 6 | 117 | 2'-2"0" x 7'-0" | A | WD | 8 3/4" | H-1 | f | 6 |
| 7 | 102 | 2'-3'0" x 7'-0" | E | SM | 8 3/4" | H-2 | g | 7 |
| 8 | 103 | 2'-3'0" x 7'-0" | E | SM | 8 3/4" | H-2 | h | 8 |
| 9 | 117 | 2'-3'0" x 7'-0" | C | SM | 8 3/4" | H-5 | i | 9 |
| 10 | 125 | 2'-3'0" x 7'-0" | C | SM | 8 3/4" | H-5 | j | 10 |
| 11 | 124 | 3'-0" x 7'-0" | B | SM | 6" | H-10 | k | 11 |
| 12 | 124 | 3'-0" x 7'-0" | B | SM | 6" | H-10 | l | 12 |
| 13 | 125 | 2'-8" x 7'-0" | B | SM | 8 3/4" | H-6 | m | 13 |
| 14 | 125 | 2'-8" x 7'-0" | B | SM | 8 3/4" | H-6 | n | 14 |
| 15 | 124 | 3'-0" x 7'-0" | B | SM | 6" | H-10 | o | 15 |
| 16 | 124 | 3'-0" x 7'-0" | B | SM | 6" | H-10 | p | 16 |
| 17 | 101 | 3'-0" x 7'-0" | C | SS | 6" | H-6 | q | 17 |
| 18 | 118 | 2'-3'0" x 7'-0" | B | SS | 6" | H-3 | r | 18 |
| 19 | 119 | 3'-0" x 7'-0" | B | SS | 6" | H-7 | s | 19 |
| 20 | 120 | 2'-8" x 7'-0" | B | SS | 6" | H-4 | t | 20 |
| 21 | 120 | 2'-8" x 7'-0" | B | SS | 6" | H-7 | u | 21 |
| 22 | 116 | 3'-0" x 7'-0" | B | SS | 6" | H-6 | v | 22 |
| 23 | 116 | 2'-6" x 7'-0" | B | SS | 6" | H-12 | w | 23 |
| 24 | 104 | 2'-8" x 7'-0" | C | SS | 6" | H-3 | x | 24 |
| 25 | 112 | 2'-8" x 7'-0" | B | SS | 6" | H-11 | y | 25 |
| 26 | 112 | 11'-6" x 8'-0" | WD | - | - | - | z | 26 |
| 27 | 105 | 2'-8" x 7'-0" | C | SS | 6" | H-3 | aa | 27 |
| 28 | 106 | 2'-8" x 7'-0" | C | SS | 6" | H-3 | ab | 28 |
| 29 | 112 | 2'-8" x 7'-0" | B | SS | 6" | H-11 | ac | 29 |
| 30 | 114 | 2'-6" x 7'-0" | C | SS | 6" | H-3 | ad | 30 |
| 31 | 107 | 2'-8" x 7'-0" | C | SS | 6" | H-3 | ae | 31 |
| 32 | 108 | 2'-8" x 7'-0" | C | SS | 6" | H-3 | af | 32 |
| 33 | 109 | 2'-8" x 7'-0" | C | SS | 6" | H-3 | ag | 33 |
| 34 | 110 | 2'-8" x 7'-0" | C | SS | 6" | H-3 | ah | 34 |
| 35 | 111 | 3'-0" x 7'-0" | D | SS | 6" | H-6 | ai | 35 |
| 36 | 127 | 3'-0" x 7'-0" | C | SS | 6" | H-6 | aj | 36 |
| 37 | 133 | 3'-0" x 7'-0" | C | SS | 6" | H-6 | ak | 37 |
| 38 | 131 | 2'-0" x 7'-0" | B | SS | 6" | H-12 | al | 38 |
| 39 | 132 | 2'-0" x 7'-0" | B | SS | 6" | H-6 | am | 39 |
| 40 | 130 | 3'-0" x 7'-0" | B | SS | 6" | H-6 | an | 40 |
| 41 | 130 | 3'-0" x 7'-0" | B | SS | 6" | H-12 | ao | 41 |
| 42 | 134 | 3'-0" x 7'-0" | C | SS | 6" | H-6 | ap | 42 |
| 43 | 133 | 3'-0" x 7'-0" | C | SS | 6" | H-6 | aq | 43 |
| 44 | 128 | 2'-8" x 7'-0" | B | SS | 6" | H-4 | ar | 44 |
| 45 | - | - | - | - | - | - | as | 45 |
| 46 | 126 | 2'-8" x 7'-0" | B | SS | 6" | H-3 | at | 46 |
| 47 | 136 | 3'-0" x 7'-0" | C | SM | 8 3/4" | H-6 | au | 47 |
| 48 | 136 | 3'-0" x 7'-0" | C | SS | 6" | H-7 | av | 48 |

| DOOR NO. | SPACE NO. | DOOR SIZE | DOOR TYPE | FRAME TYPE | FRAME PROFILE | DATE | HWY GROUP | KEY GROUP | DOOR NO. |
|----------|-----------|-----------------|-----------|------------|---------------|-------------------------------------|-----------|-----------|----------|
| 51 | 115 | 2'-3'0" x 7'-0" | C | SM | 8 3/4" | SEE ELEV. THIS SHEET - UL "B" LABEL | H-5 | - | 51 |
| 52 | 126 | 2'-3'0" x 7'-0" | C | SM | 8 3/4" | DO UL "B" LABEL | H-5 | - | 52 |
| 53 | 201 | 3'-0" x 7'-0" | C | SS | 6" | 20 x 20 L | H-6 | g | 53 |
| 54 | 202 | 3'-0" x 7'-0" | C | SS | 6" | 10" x 20" L TOP & BOTTOM | H-7 | o | 54 |
| 55 | 204 | 3'-0" x 7'-0" | B | SS | 6" | SEE SPEC. FRAME DET. 28 x 20 L | H-6 | g | 55 |
| 56 | 205 | 3'-0" x 7'-0" | D | SS | 6" | SEE SPEC. FRAME DET. 28 x 10 L | H-3 | g | 56 |
| 57 | 203 | 3'-0" x 7'-0" | D | SS | 6" | SEE SPEC. FRAME DET. 28 x 10 L | H-6 | d | 57 |
| 58 | 206 | 3'-0" x 7'-0" | C | SS | 6" | 20 x 20 L | H-6 | d | 58 |
| 59 | 209 | 3'-0" x 7'-0" | B | SS | 6" | 20 x 20 L | H-12 | - | 59 |
| 60 | 208 | 2'-0" x 7'-0" | B | SS | 6" | - | H-7 | h | 60 |
| 61 | 210 | 2'-0" x 7'-0" | B | SS | 6" | - | H-6 | e | 61 |
| 62 | 211 | 3'-0" x 7'-0" | C | SS | 6" | 20 x 20 L | H-11 | - | 62 |
| 63 | 216 | 2'-0" x 7'-0" | C | SS | 6" | 8 x 16 L | H-11 | - | 63 |
| 64 | 215 | 2'-0" x 7'-0" | C | SS | 6" | 8 x 16 L | H-11 | - | 64 |
| 65 | 214 | 2'-0" x 7'-0" | C | SS | 6" | 8 x 16 L | H-11 | - | 65 |
| 66 | 213 | 2'-0" x 7'-0" | C | SS | 6" | 8 x 16 L | H-7 | l | 66 |
| 67 | 212 | 2'-0" x 7'-0" | B | SS | 6" | - | H-6 | e | 67 |
| 68 | 217 | 3'-0" x 7'-0" | B | SS | 6" | 20 x 20 L | H-6 | e | 68 |
| 69 | 218 | 3'-0" x 7'-0" | C | SS | 6" | 20 x 20 L | H-6 | e | 69 |
| 70 | 219 | 3'-0" x 7'-0" | D | SS | 6" | SEE SPEC. FRAME DET. 28 x 20 L | H-7 | h | 70 |
| 71 | 220 | 2'-8" x 7'-0" | B | SS | 6" | - | H-3 | k | 71 |
| 72 | 221 | 2'-8" x 7'-0" | C | SS | 6" | 10 x 20 L | H-3 | k | 72 |
| 73 | 222 | 2'-8" x 7'-0" | C | SS | 6" | 10 x 20 L | H-3 | k | 73 |
| 74 | 223 | 2'-8" x 7'-0" | C | SS | 6" | 10 x 20 L | H-3 | k | 74 |
| 75 | 224 | 2'-8" x 7'-0" | C | SS | 6" | 10 x 20 L | H-3 | k | 75 |
| 76 | 225 | 3'-0" x 7'-0" | C | SS | 6" | 20 x 20 L | H-6 | e | 76 |
| 77 | 226 | 3'-0" x 7'-0" | D | SS | 6" | 10 x 20 L | H-3 | e | 77 |
| 78 | 227 | 3'-0" x 7'-0" | D | SS | 6" | - | H-6 | e | 78 |
| 79 | 228 | 3'-0" x 7'-0" | C | SS | 6" | 20 x 20 L | H-6 | e | 79 |
| 80 | 229 | 3'-0" x 7'-0" | C | SS | 6" | 20 x 20 L | H-6 | e | 80 |
| 81 | 230 | 3'-0" x 7'-0" | C | SS | 6" | 10 x 20 L | H-7 | e | 81 |
| 82 | 231 | 2'-3'0" x 7'-0" | B | SS | 6" | - | H-7 | l | 82 |
| 83 | 231 | 3'-0" x 7'-0" | B | SS | 6" | - | H-6 | e | 83 |
| 84 | 232 | 3'-0" x 7'-0" | B | SS | 6" | 20 x 20 L | H-9 | g | 84 |
| 85 | 233 | 3'-0" x 7'-0" | B | SS | 6" | 20 x 20 LIGHTPROOF LOWERS AS SPEC'D | H-9 | g | 85 |
| 86 | 233 | 3'-0" x 7'-0" | B | SS | 6" | 20 x 20 LIGHTPROOF LOWERS AS SPEC'D | - | - | 86 |
| 87 | 232 | 6'-6" x 9'-4" | WD | - | - | - | - | - | 87 |
| 88 | 232 | 12'-8" x 9'-4" | WD | - | - | - | - | - | 88 |
| 89 | 235 | 3'-0" x 7'-0" | C | SS | 6" | 10 x 20 L | H-7 | g | 89 |
| 90 | 232 | 3'-0" x 7'-0" | B | SS | 6" | 20 x 20 L | H-6 | g | 90 |

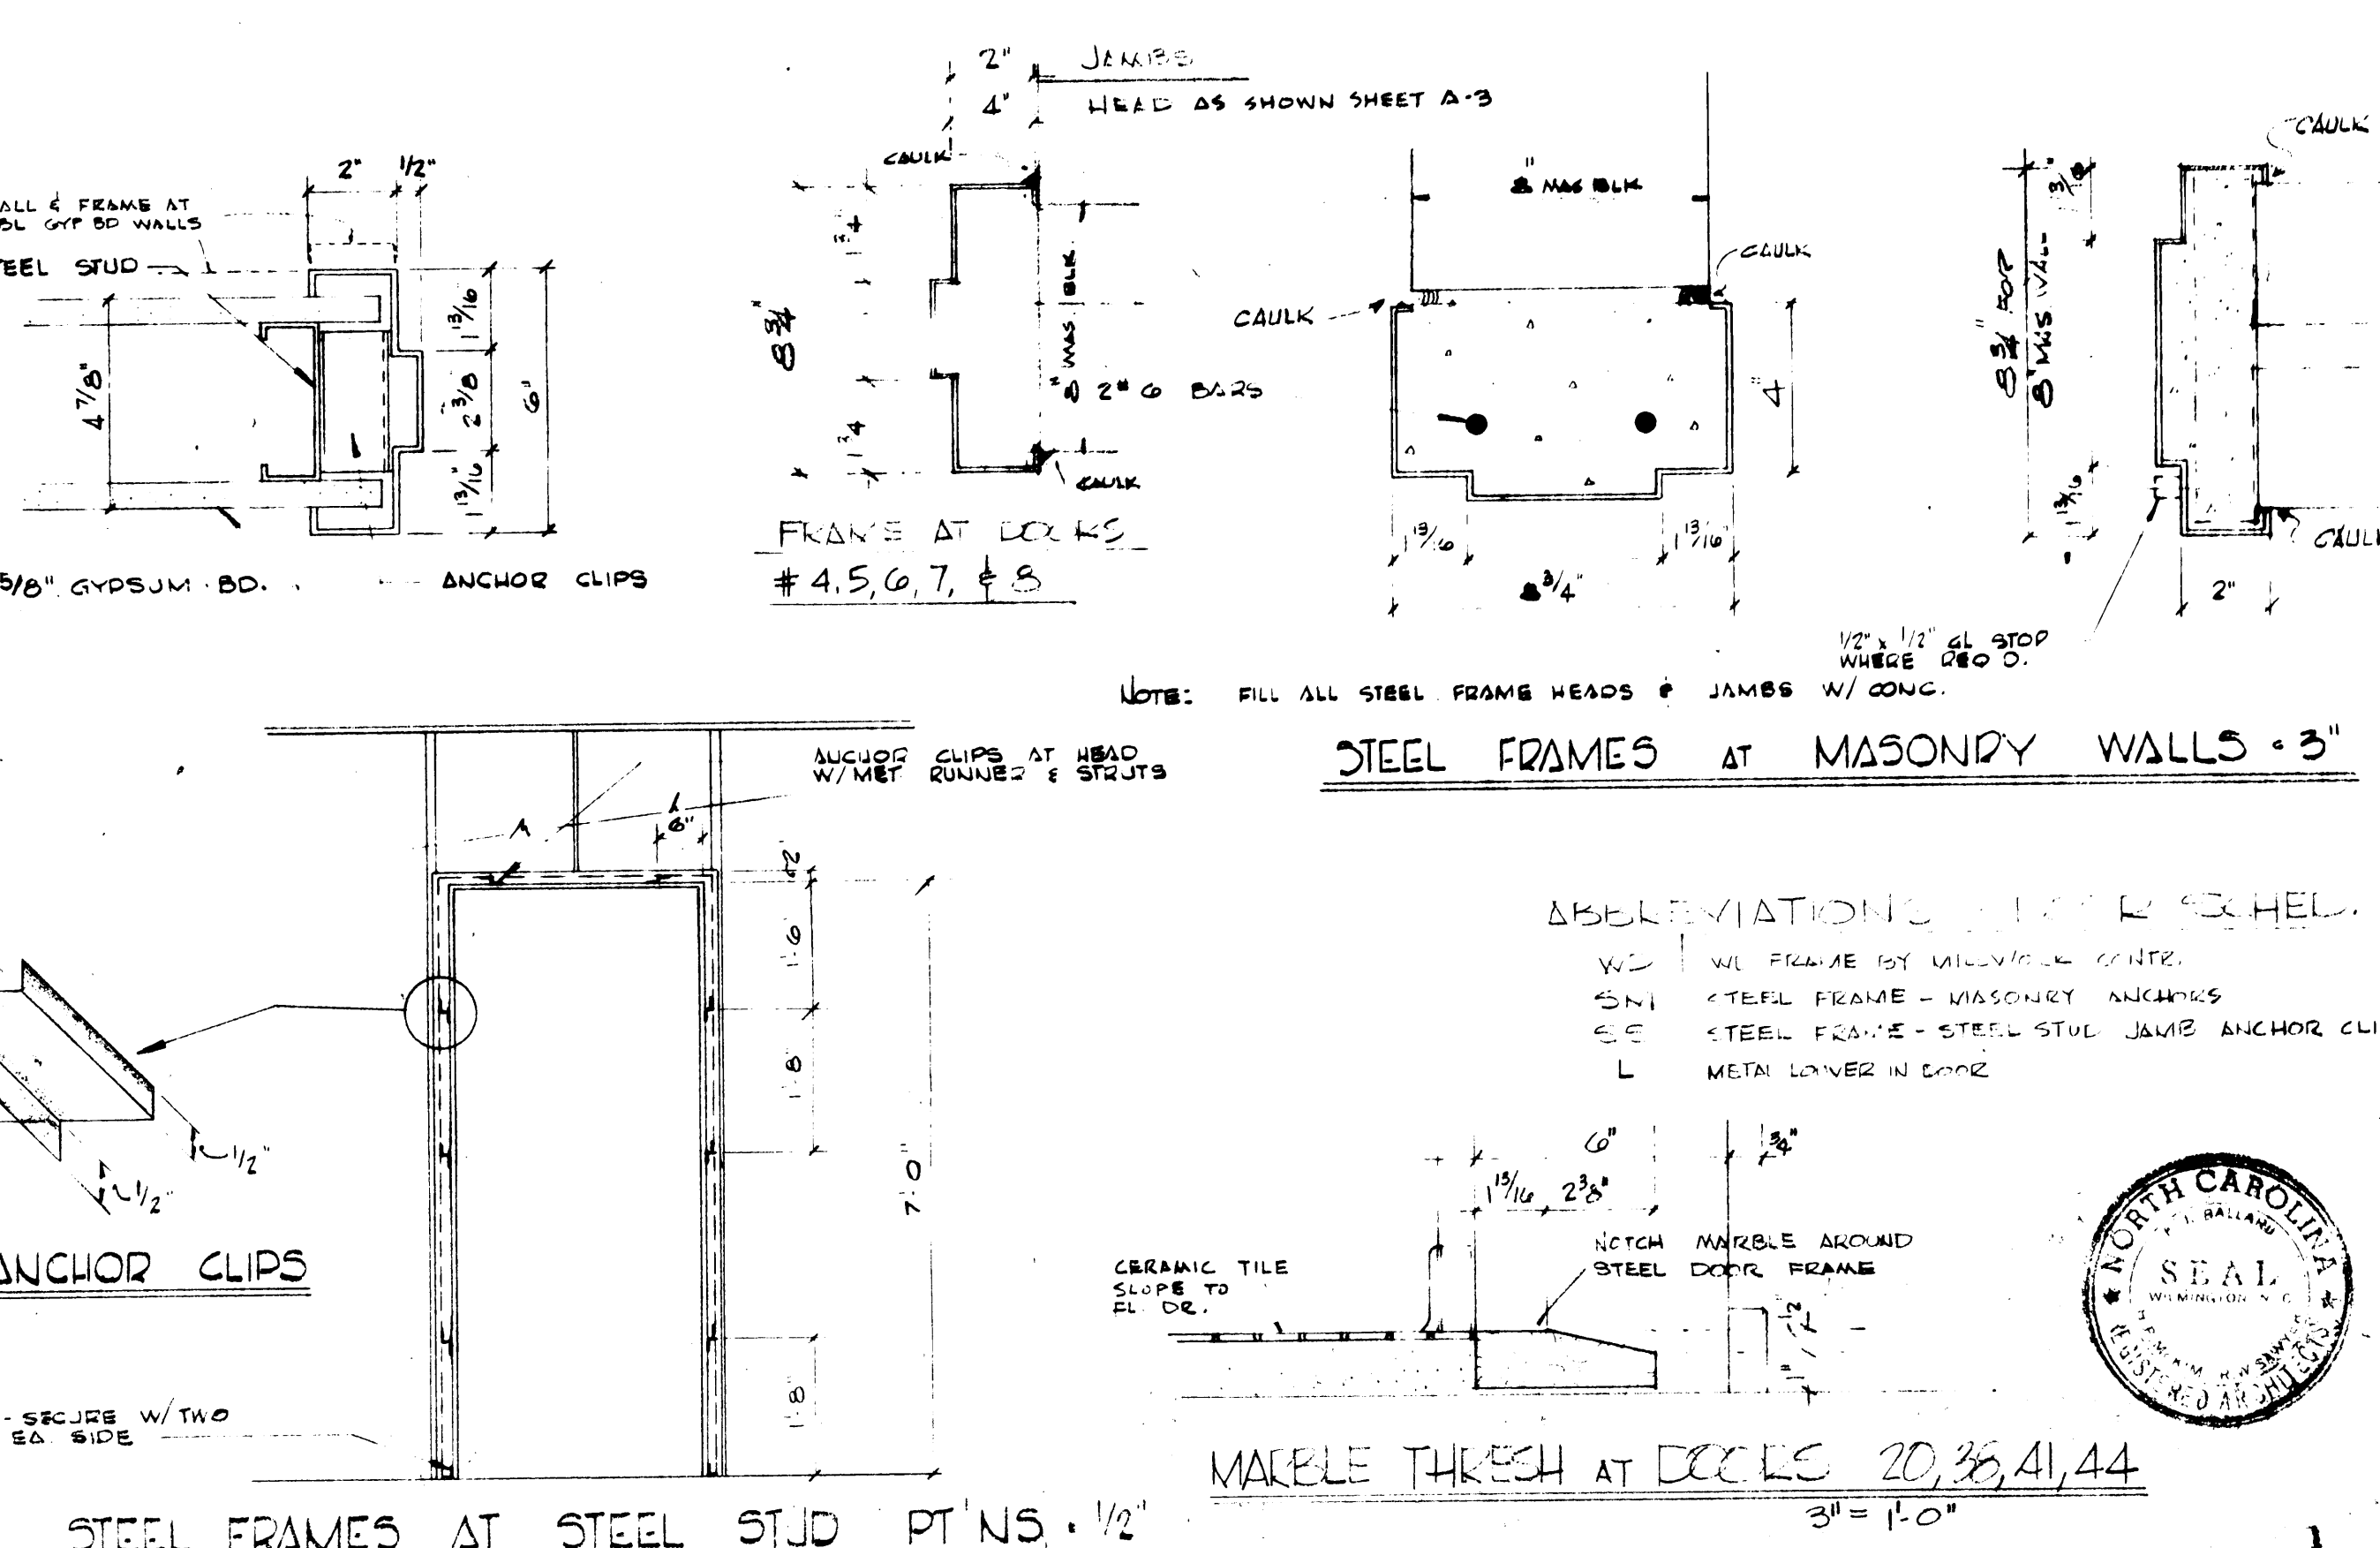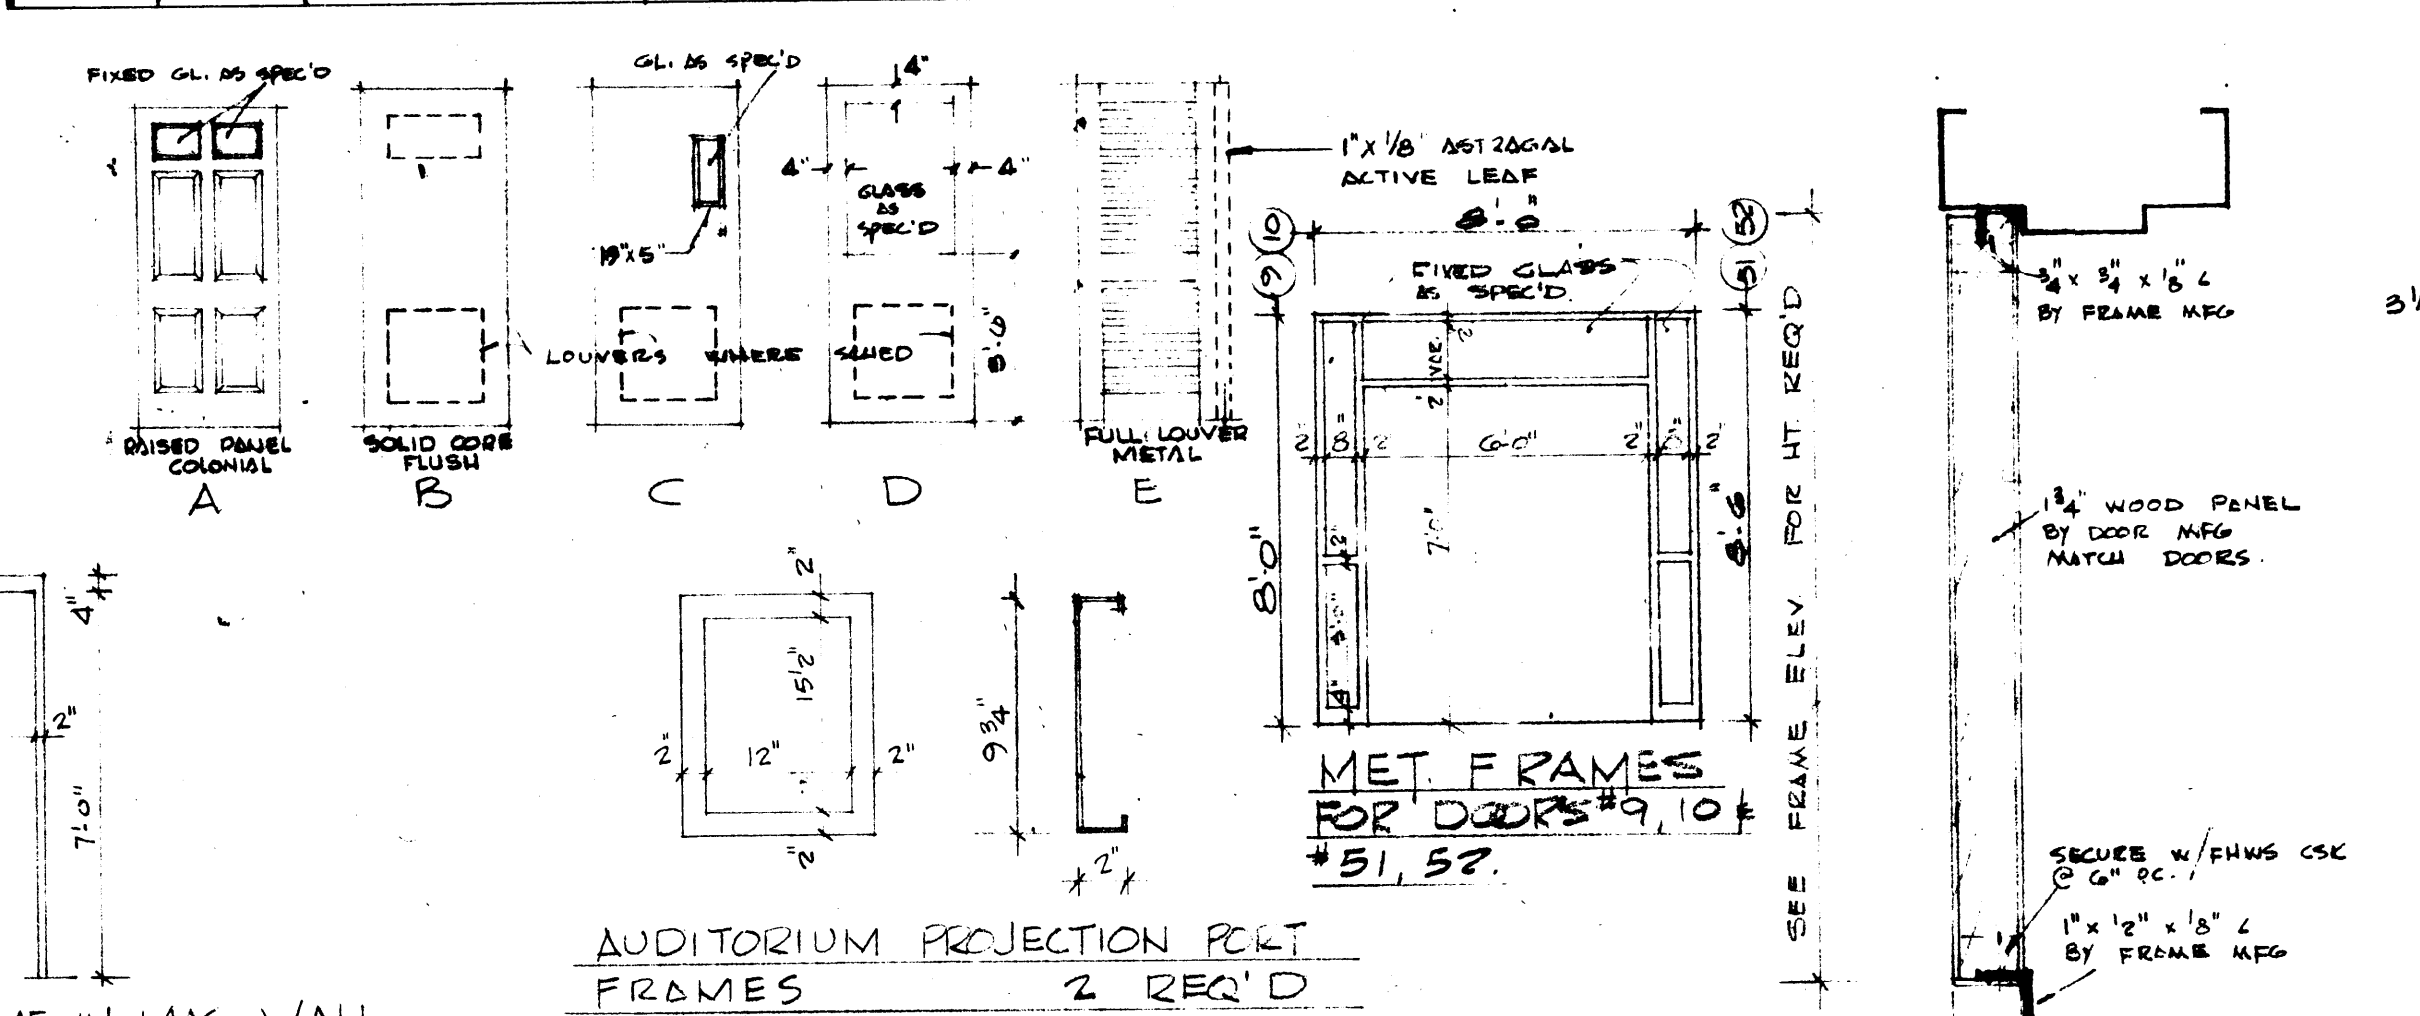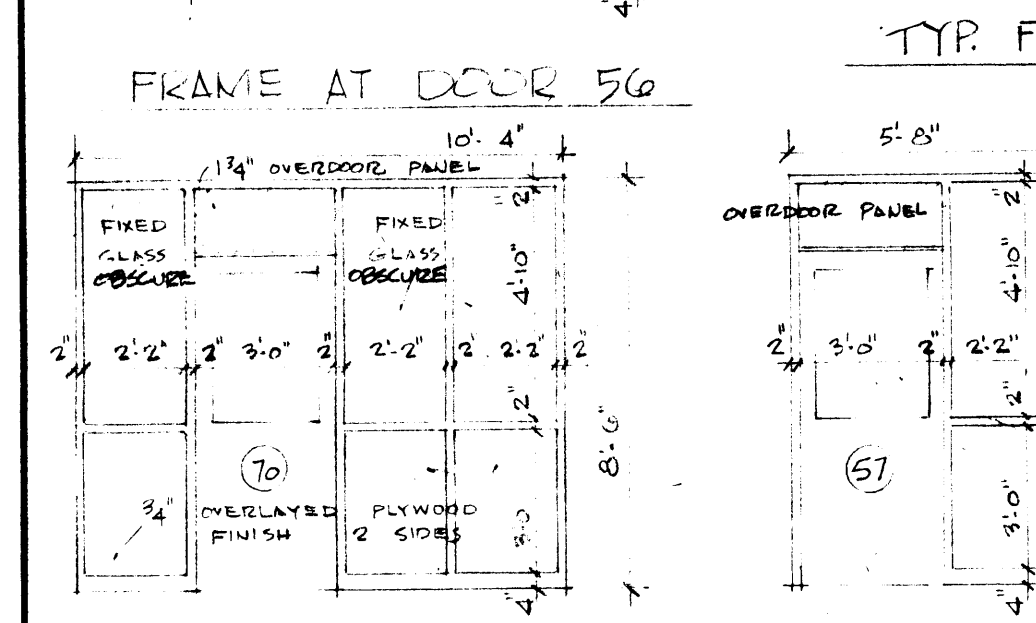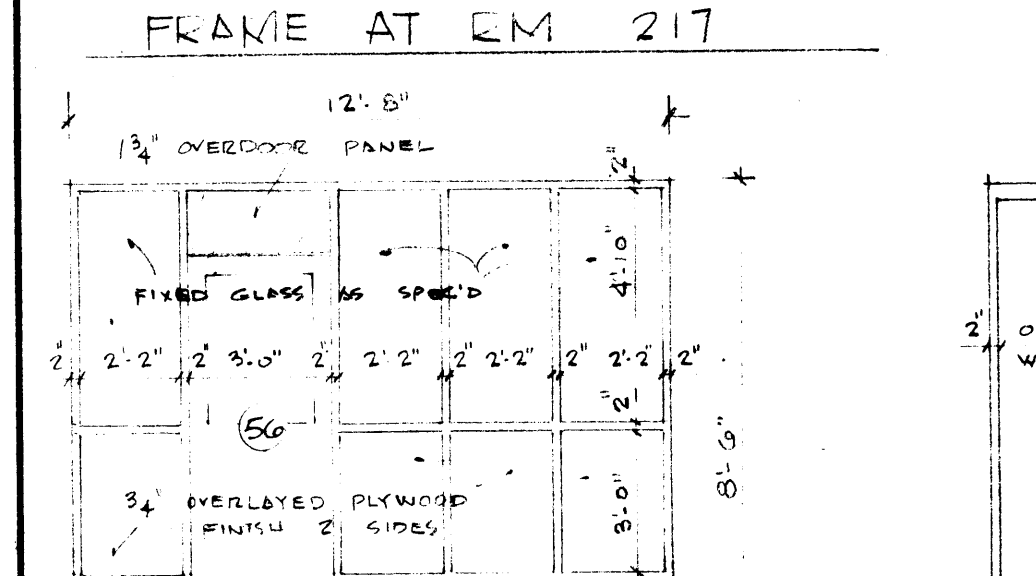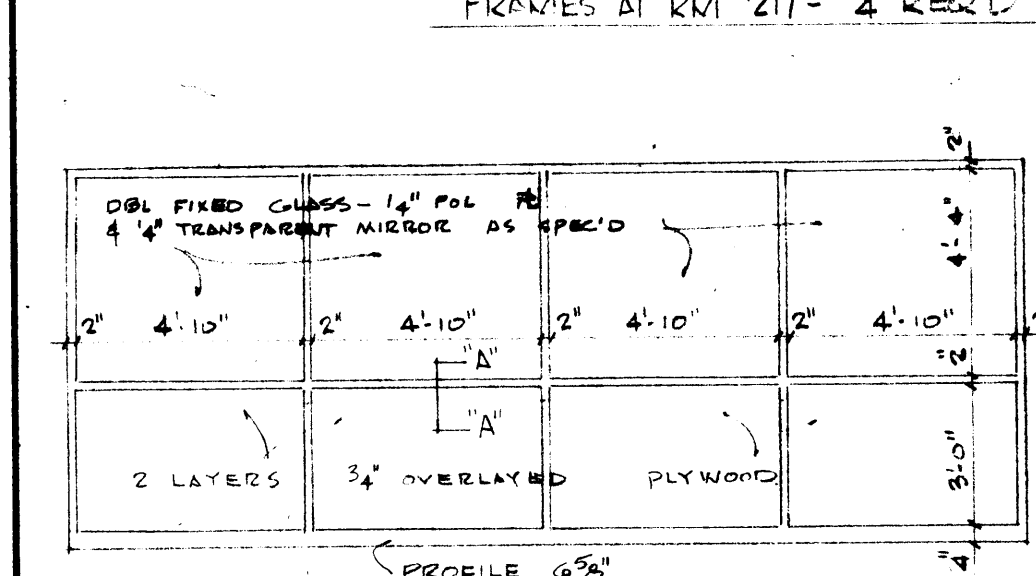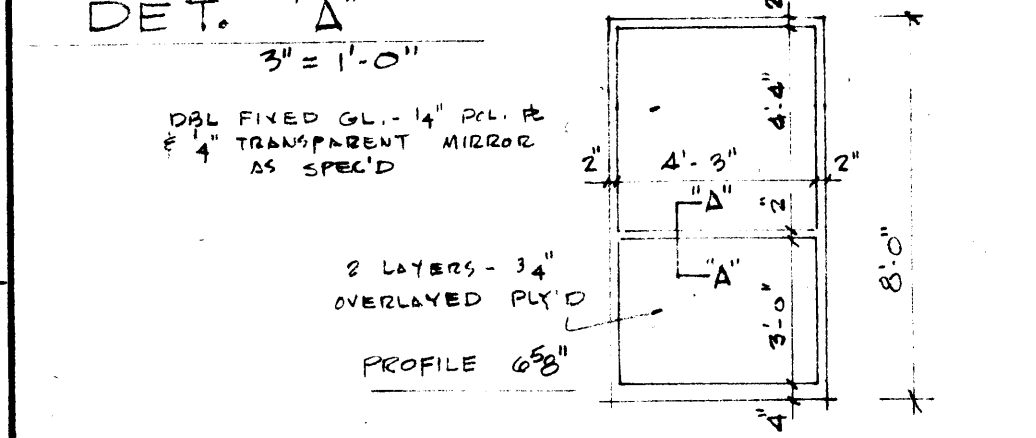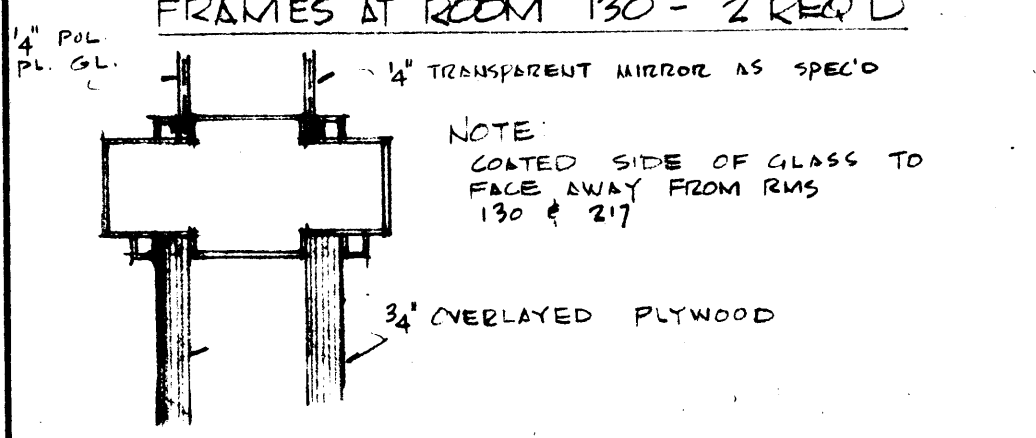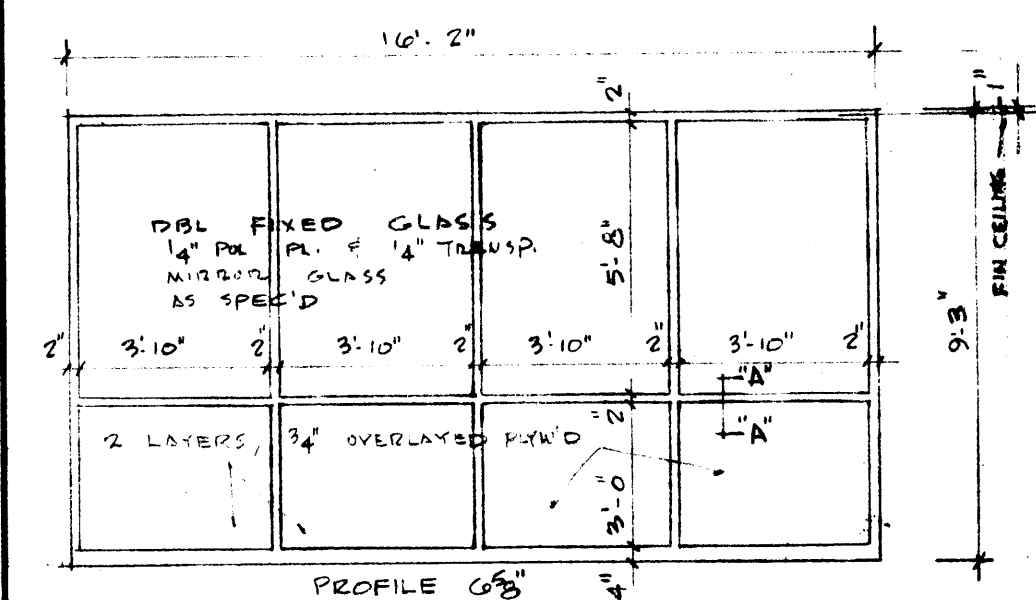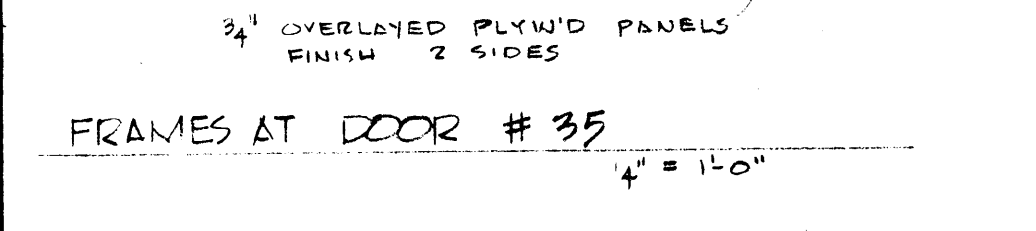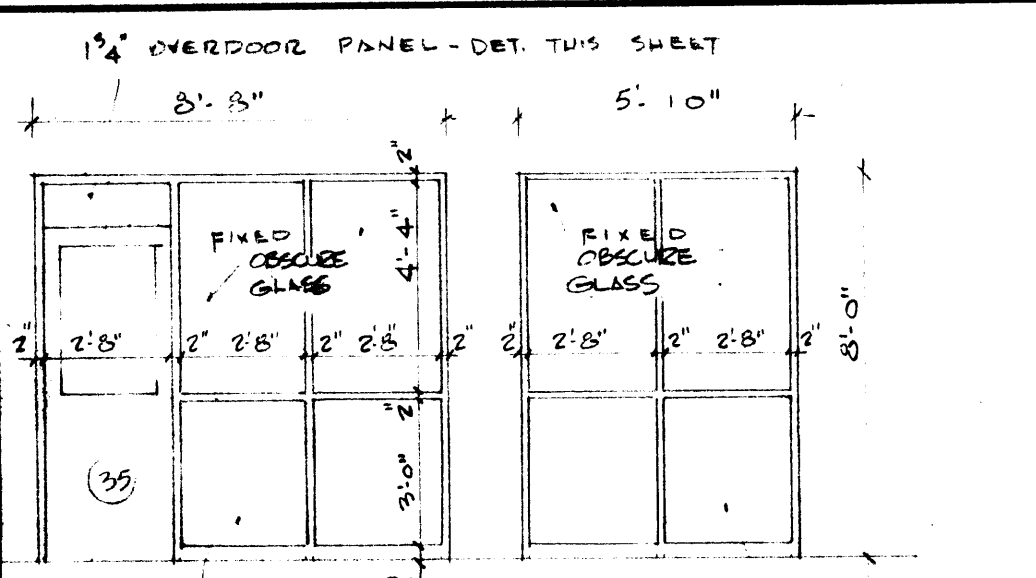


- KEY GROUPINGS - SEE SCHED.
- a. DOORS 1, 3, 7, 8, 18, 19, 21, 46, 55, 82, 83 - MECH ENCL GATE, ALL PRODUCTS
 - b. DOORS 2, 5, 6, KEY ALIKE, PASS GROUPS "f" & "k"
 - c. DOORS 11, 12, 13, 14, 15, 16, KEY ALIKE
 - d. DOORS 17, 22, 35, 40, 47, 53, 59, 25, 29
 - e. DOORS 39, 62, 68, 69, 70, 74, 77, 78, 79, 80, 84, 84, KEY ALIKE - PASS BY "b" & "f"
 - f. DOORS 24, 27, 28, 31, 32, 33, 34 - SEPARATE KEYS TO PASS "d" & "g" - PASS BY "f"
 - g. DOORS 53, 54, 56, 57, "BB", 80, 89, 90 - KEY ALIKE - PASS BY "f"
 - h. DOORS 30, 61, 71 SEPARATE KEYS
 - i. DOORS 67, 73 - KEY ALIKE
 - j. DOORS 4, 36, 37, 42, 43, 48 KEY ALIKE
 - k. DOORS 72, 73, 74, 75 - SEPARATE KEYS - PASS BY "b" - PASS "e"

WILMINGTON COLLEGE EDUCATION & PSYCHOLOGY BUILDING
 WILMINGTON, NORTH CAROLINA
 BOARD OF TRUSTEES - L. BRADFORD TILLERY, JR. CHAIRMAN - DR. WILLIAM W. RANDALL, PRESIDENT
 BALLARD, McKIM, & SAWYER, AIA
 612 SOUTH SEVENTEENTH STREET
 WILMINGTON, NORTH CAROLINA
 T.C. 792
 DRAWN BY: [Signature]
 CHECKED BY: [Signature]
 DATE: JUN 23, 1970
 SHEET NO. A-11

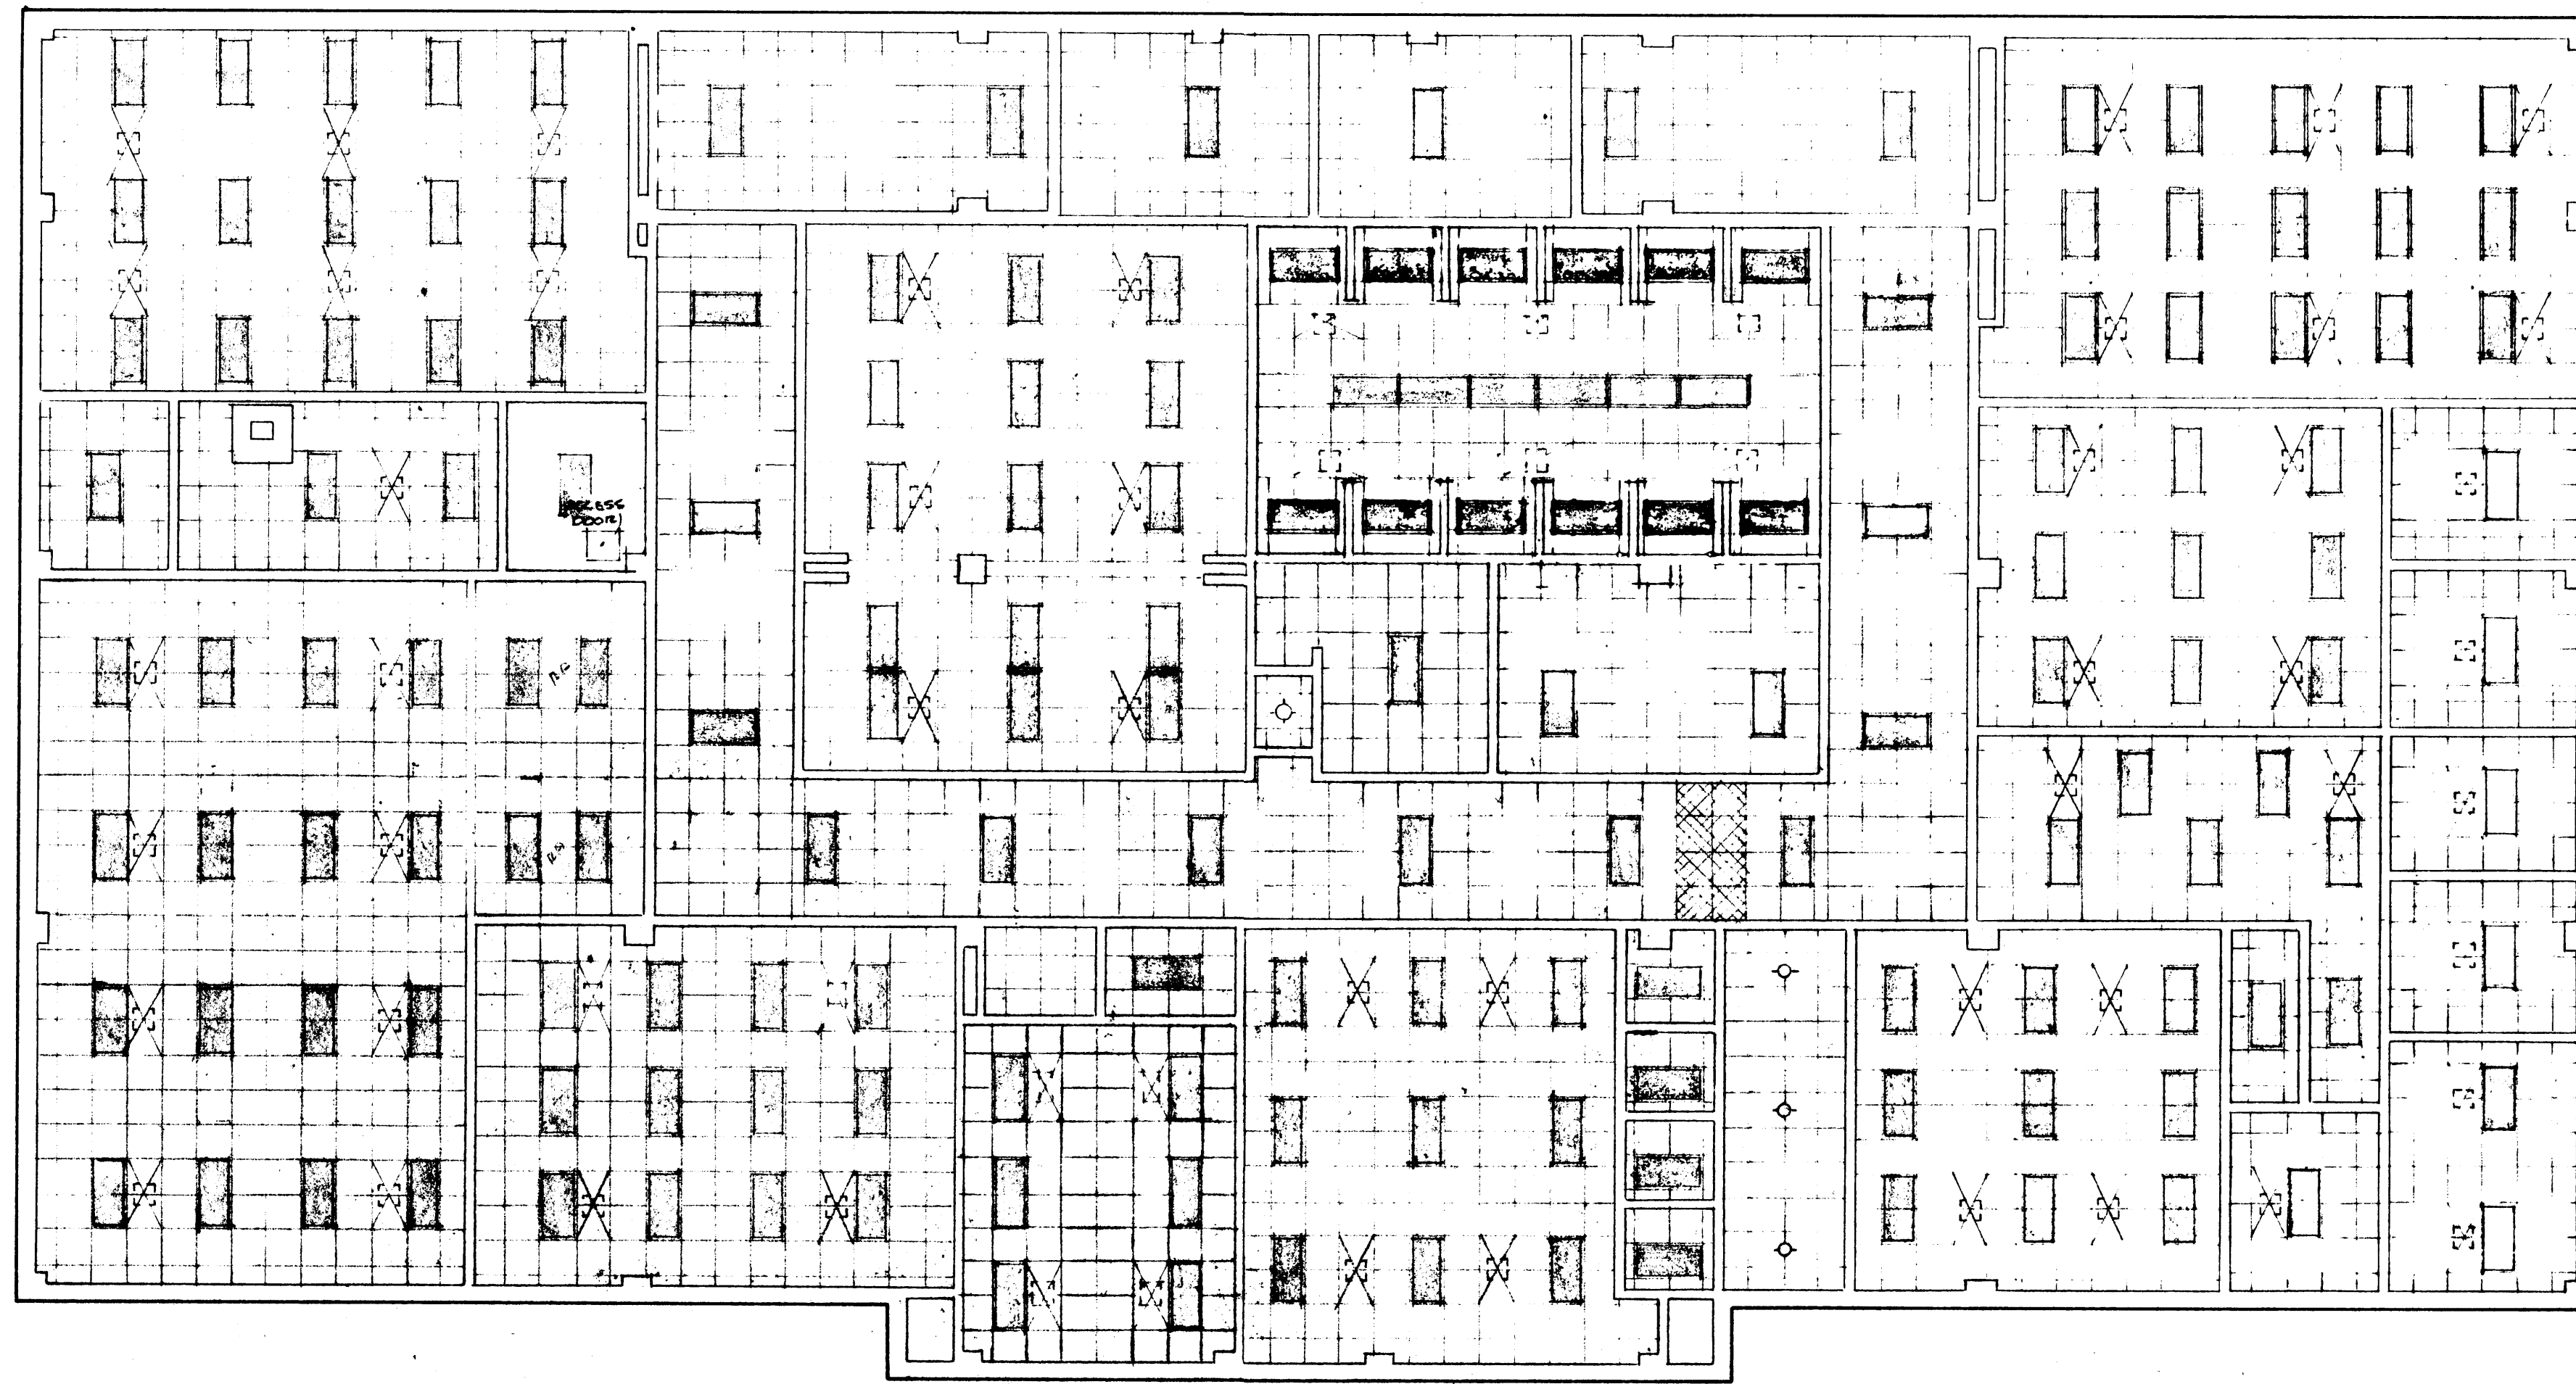


REFLECTED CEILING PLAN SECOND FLOOR

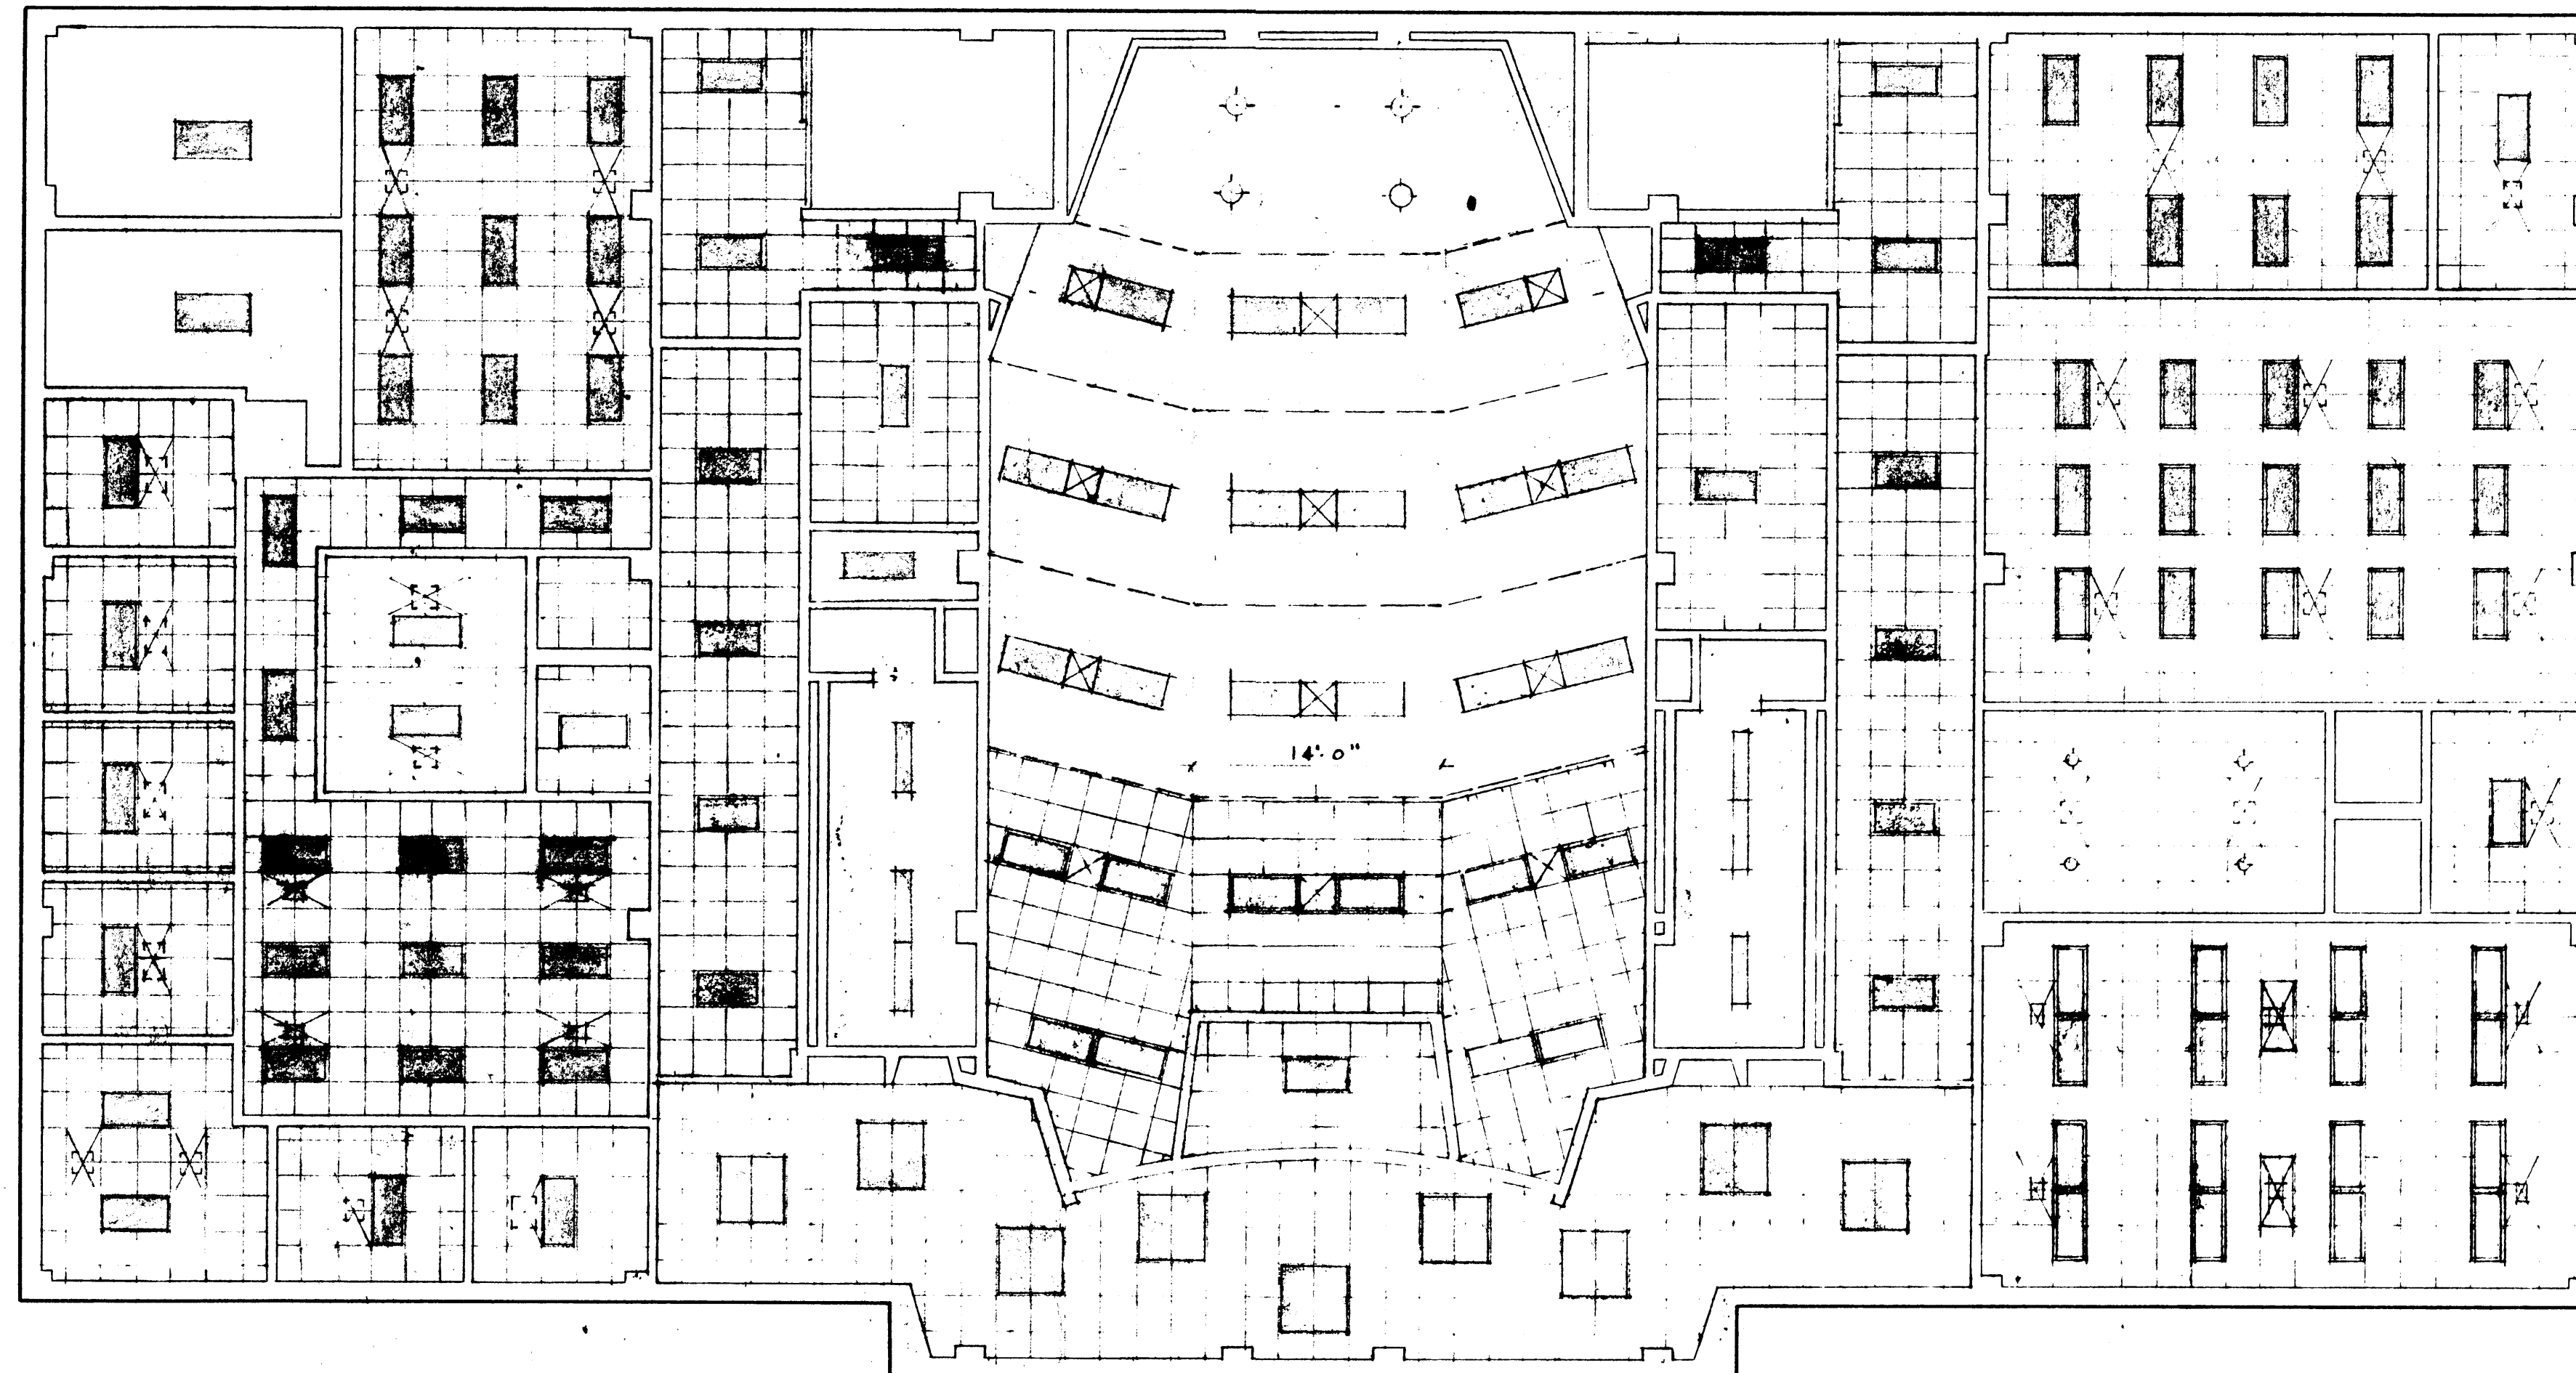

REFLECTED CEILING PLAN FIRST FLOOR


5 JUNE 1969 KMP

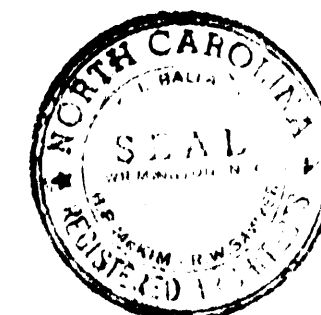

"AS-BUILT" DRAWING




DATE _____

THE PLANING AND ARCHITECTURE OF THE UNIVERSITY OF NORTH CAROLINA
 ARCHITECTS AND ENGINEERS
 612 SOUTH SEVENTH STREET
 WILMINGTON, NORTH CAROLINA 28401
 BOARD OF TRUSTEES - L. BRADFORD TILLERY, JR. CHAIRMAN - DR. WILLIAM M. RANDALL, PRESIDENT
 WILMINGTON COLLEGE EDUCATION & PSYCHOLOGY BUILDING
 WILMINGTON, NORTH CAROLINA
 CODE 66737 - ITEM 8
 BALLARD, McKIM, & SAWYER, AIA
 612 SOUTH SEVENTH STREET
 WILMINGTON, NORTH CAROLINA
 7-C-792
 DRAWN BY: SCAL
 CHECKED BY: SCAL
 DATE: JUN 24 1969
 SHEET NO. A-12





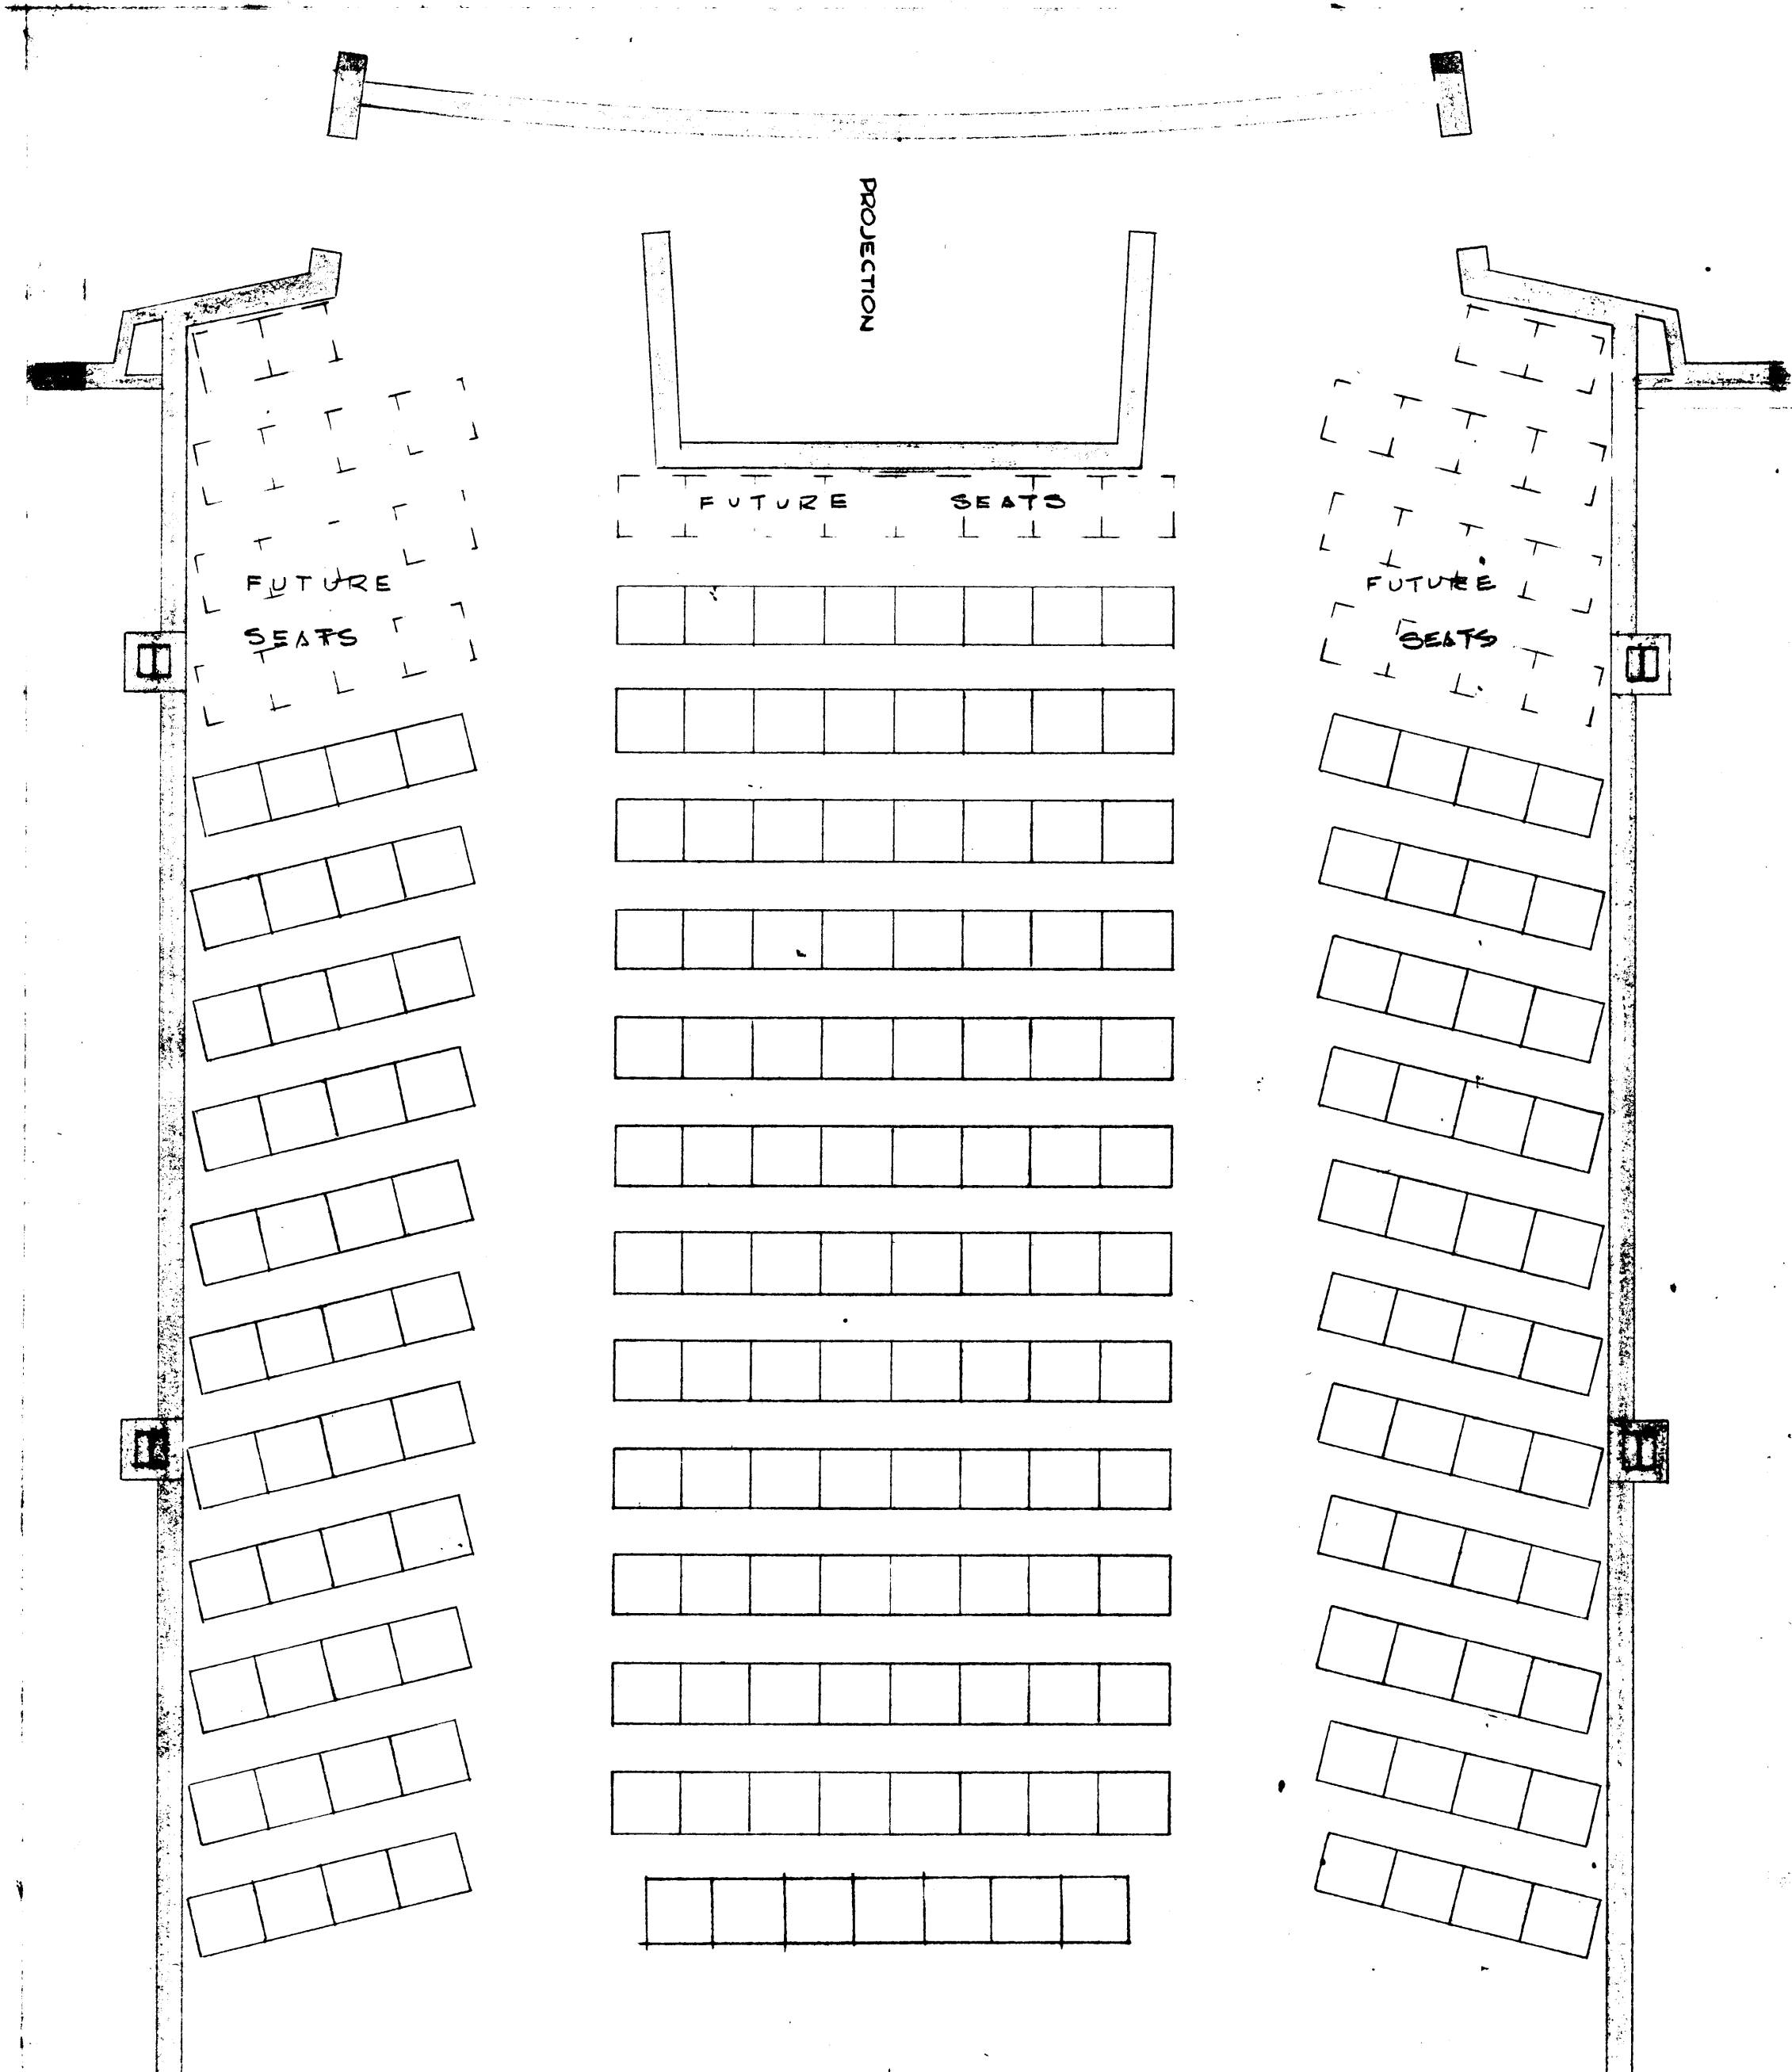


LECTURE AUDITORIUM - 1/4"

NOTE: EQUIPMENT SHOWN AVAILABLE IN 3'-0" x 4'-0" SEE PLAN FOR SIZE. SHT.

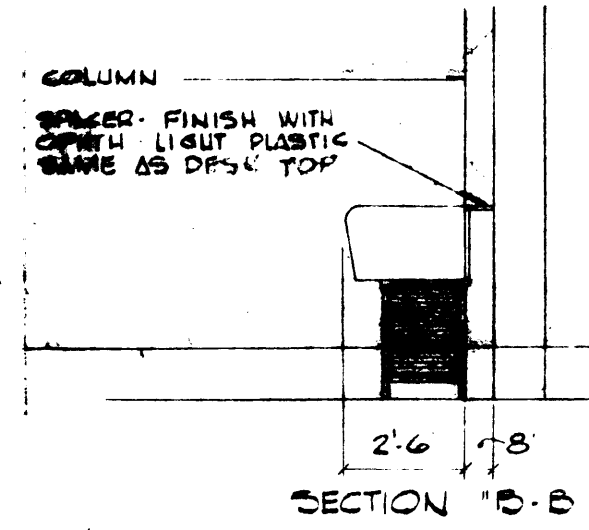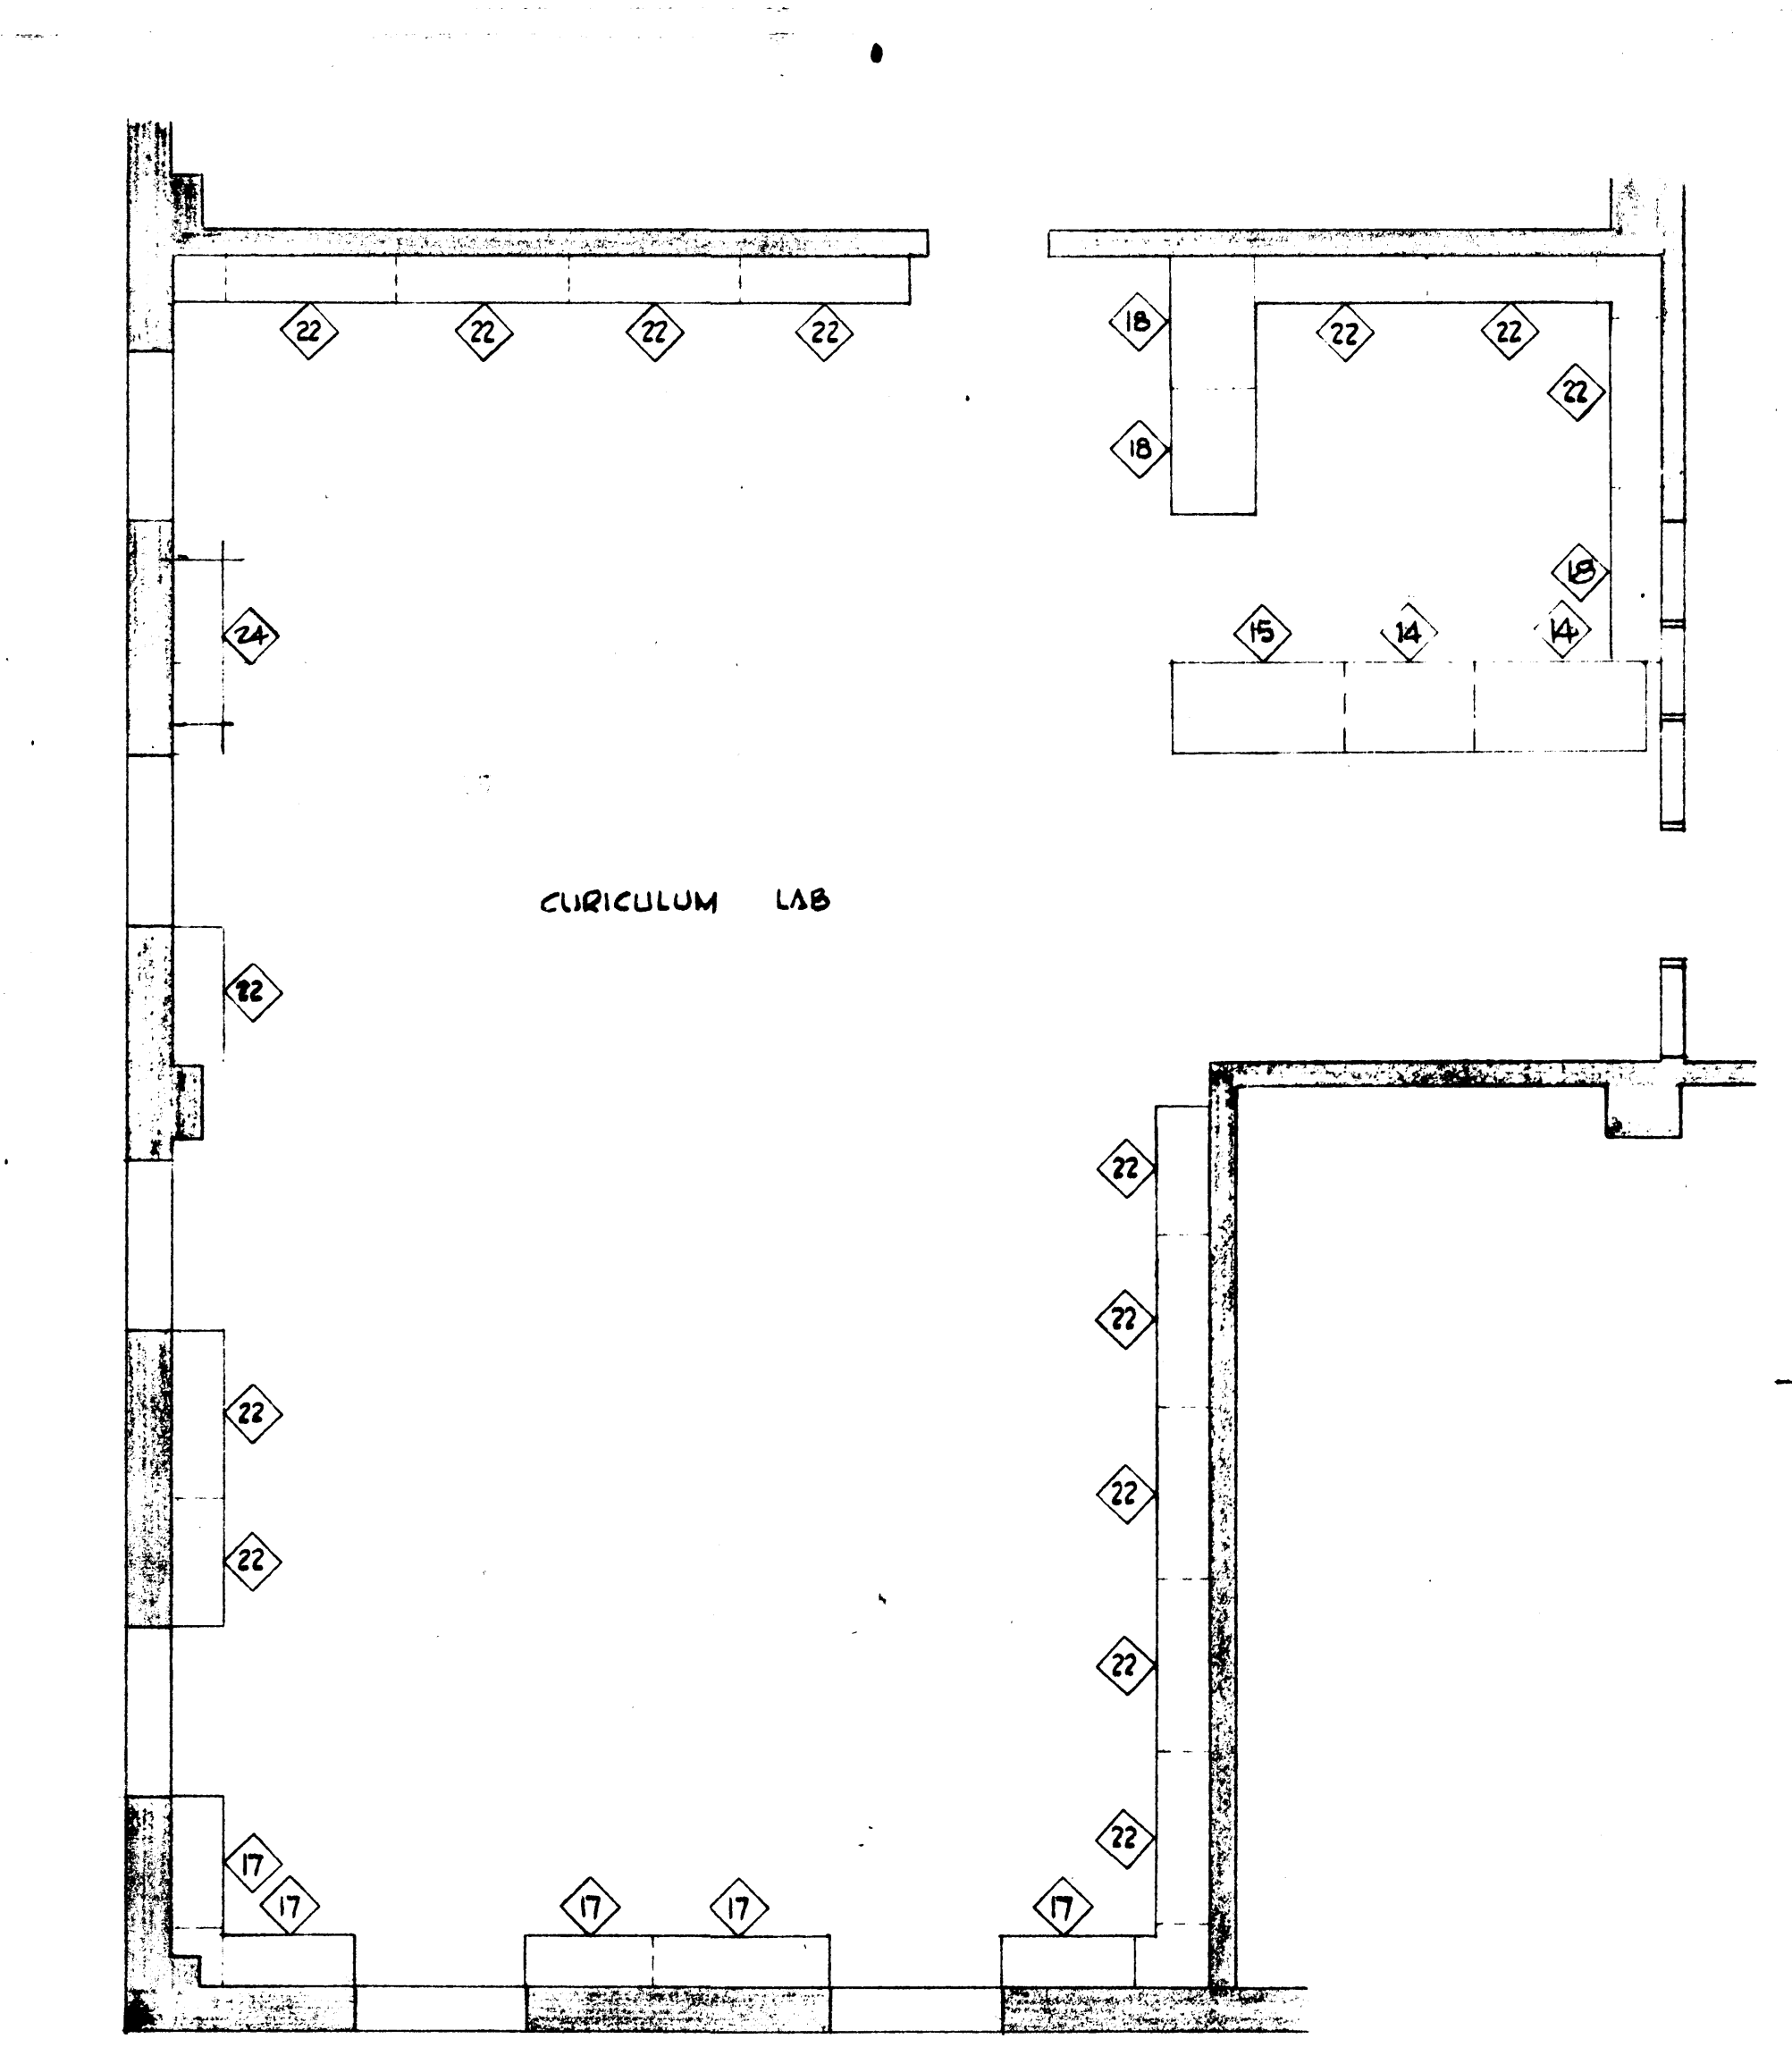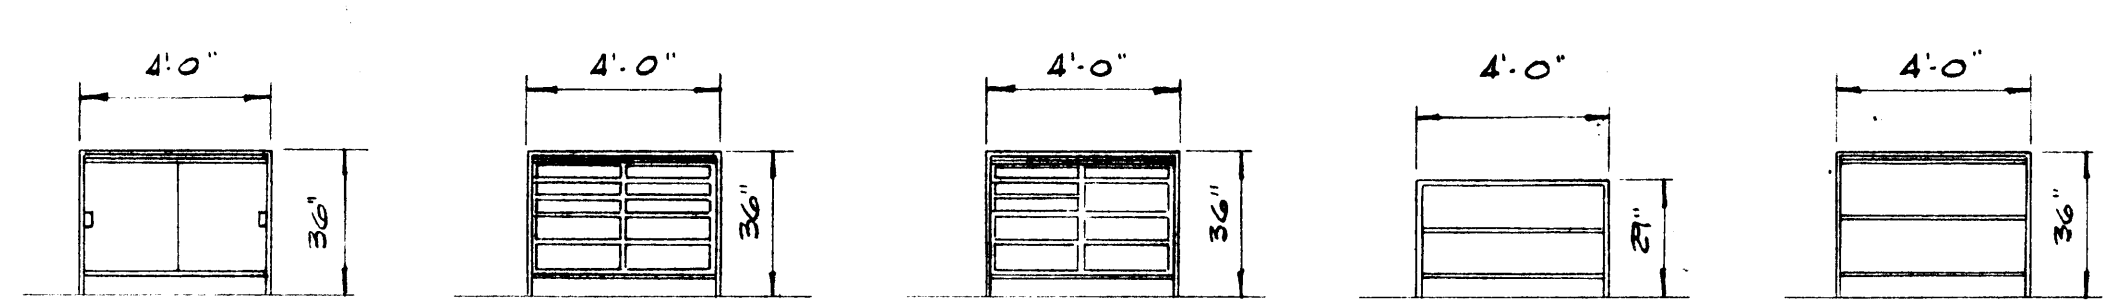

COLUMN
SPACE FINISH WITH
OPAL LIGHT PLASTIC
GLASS AS TOP

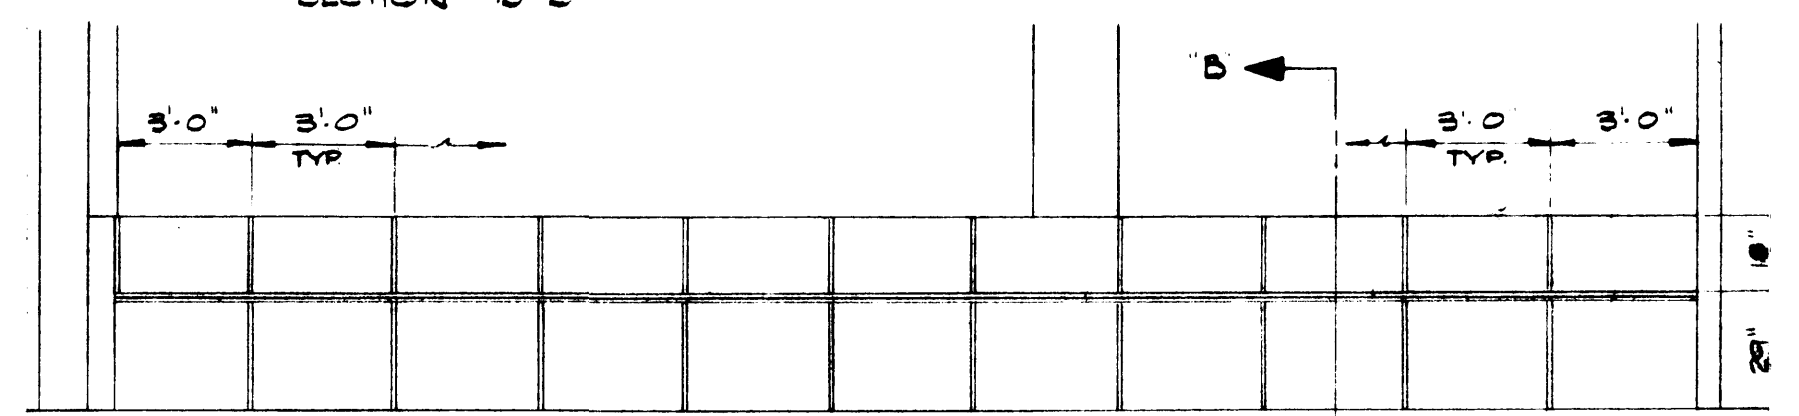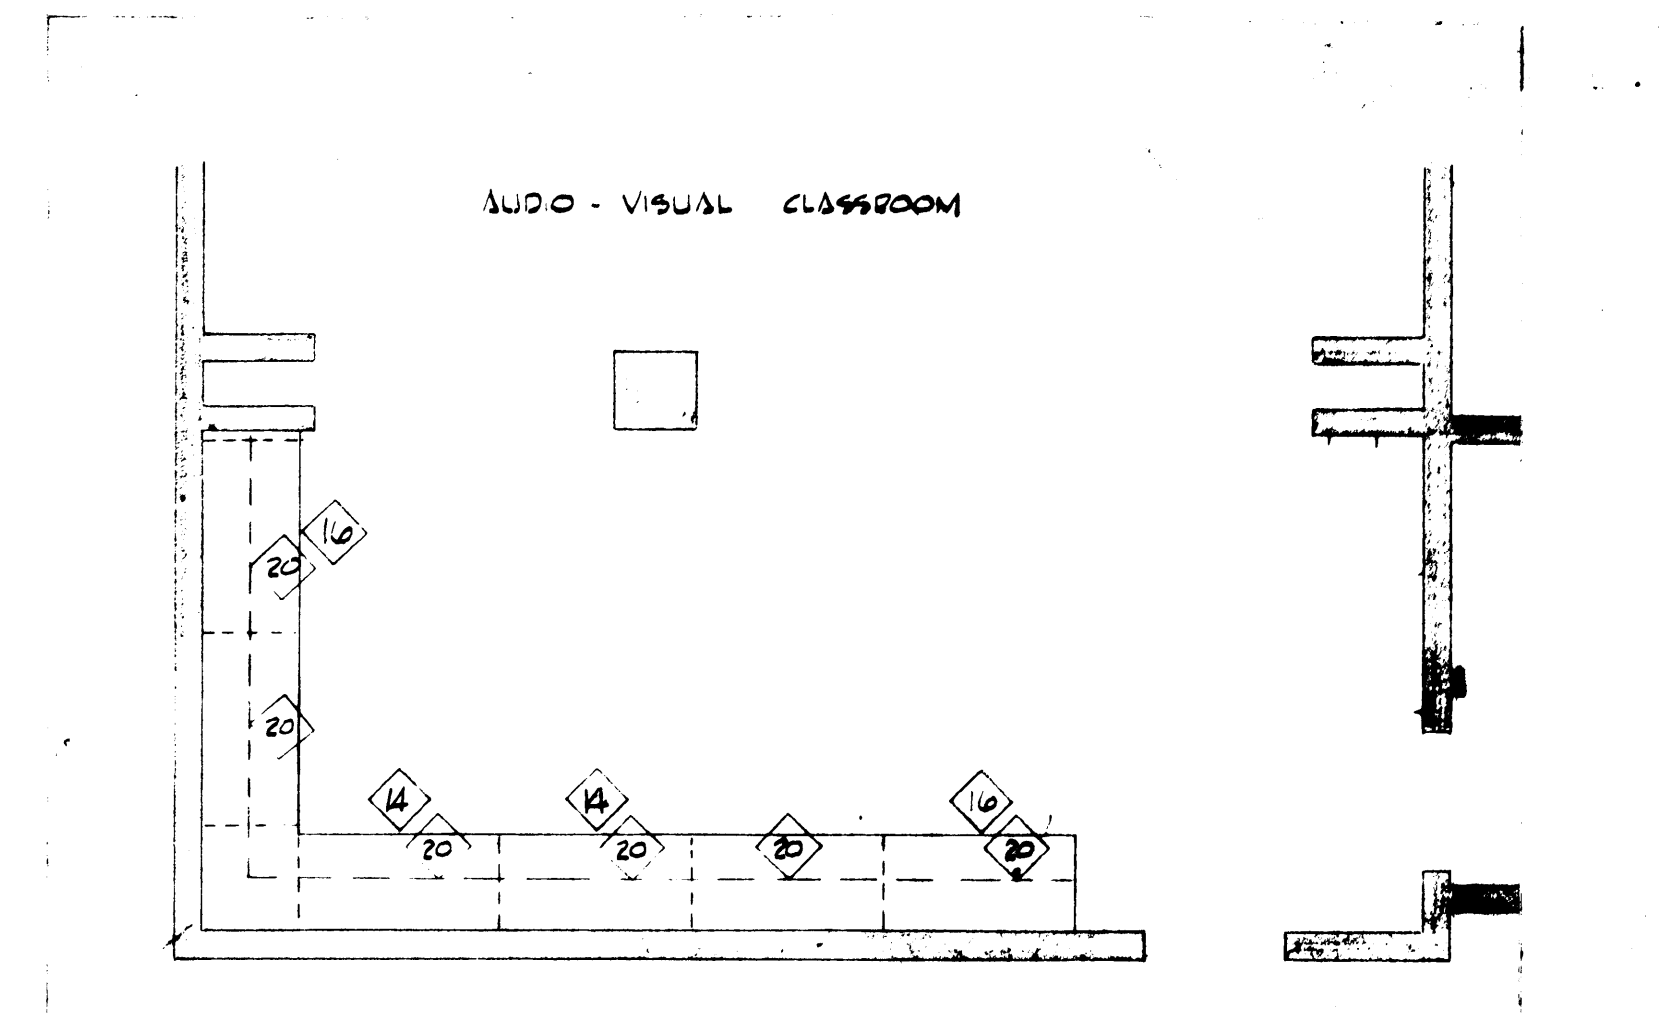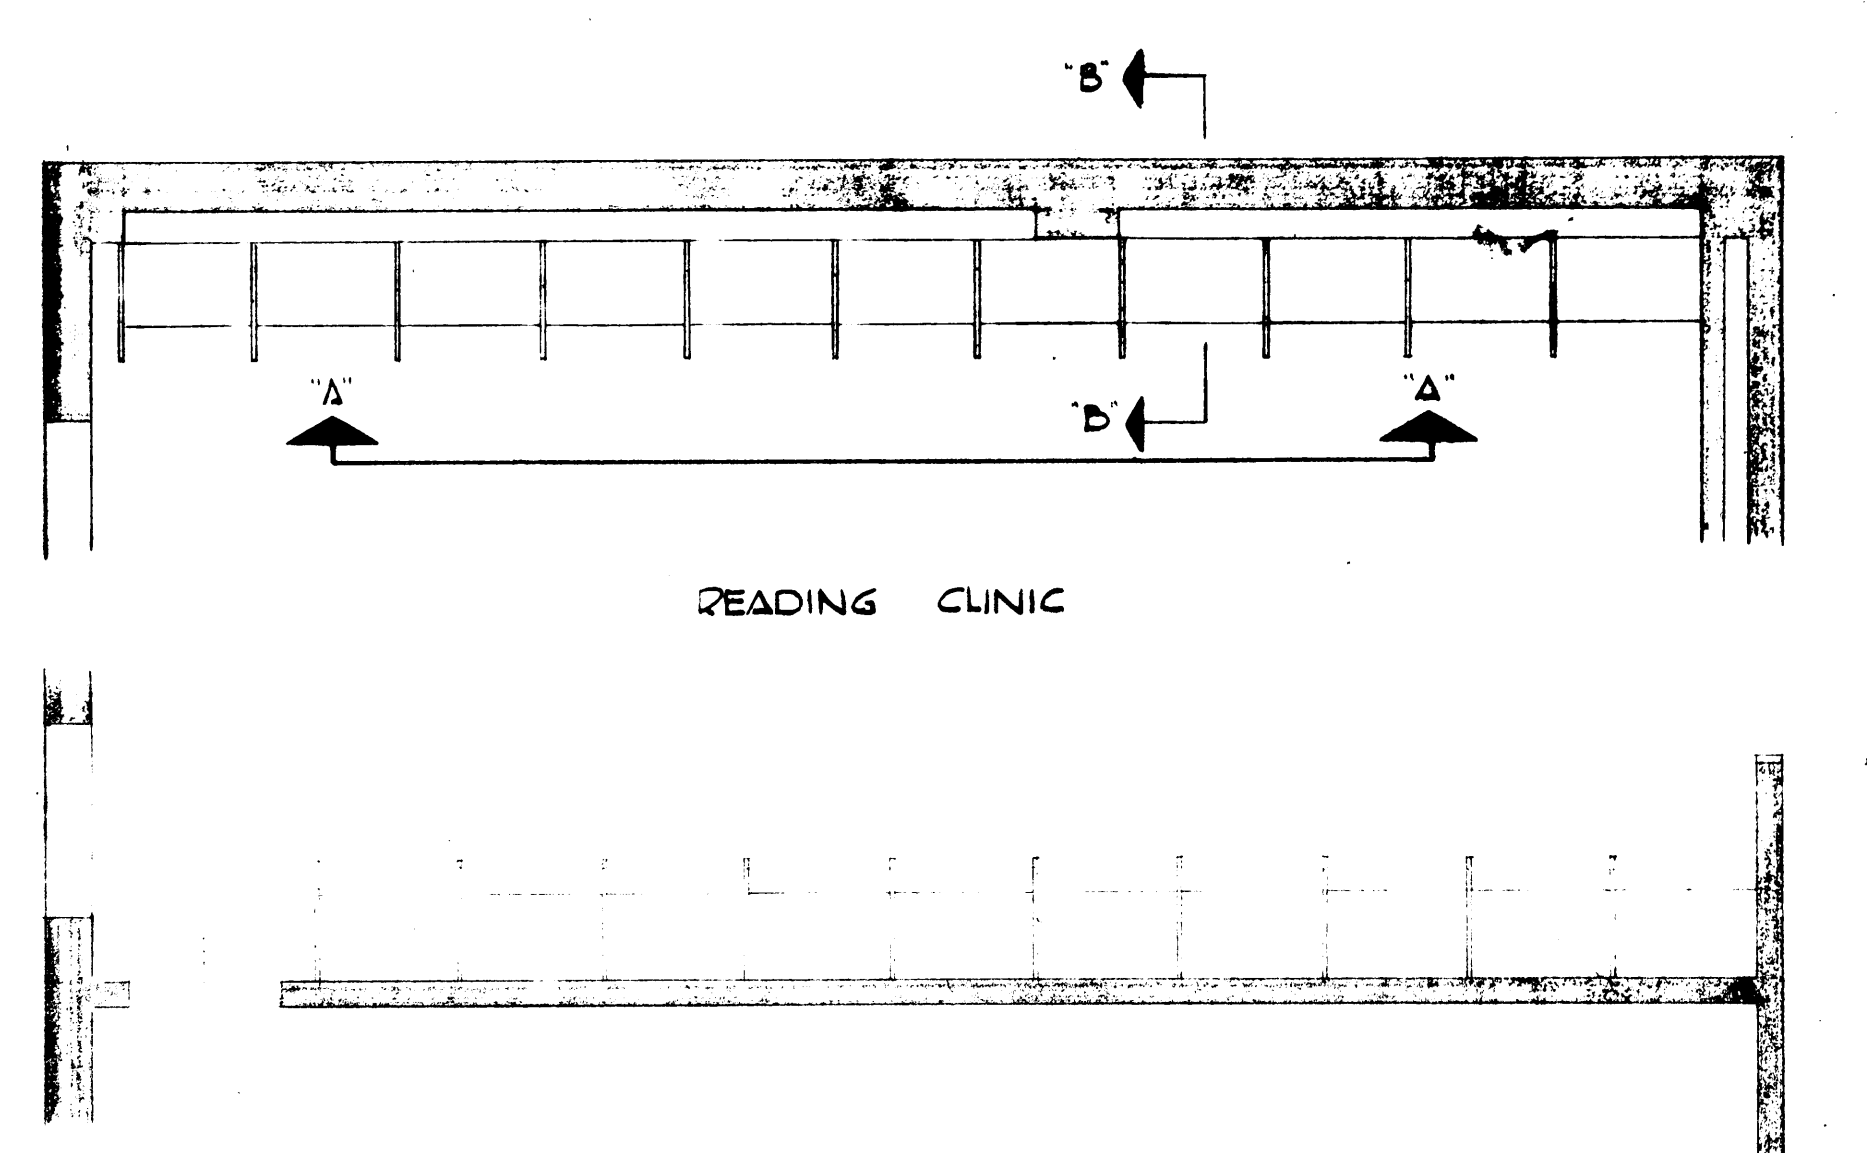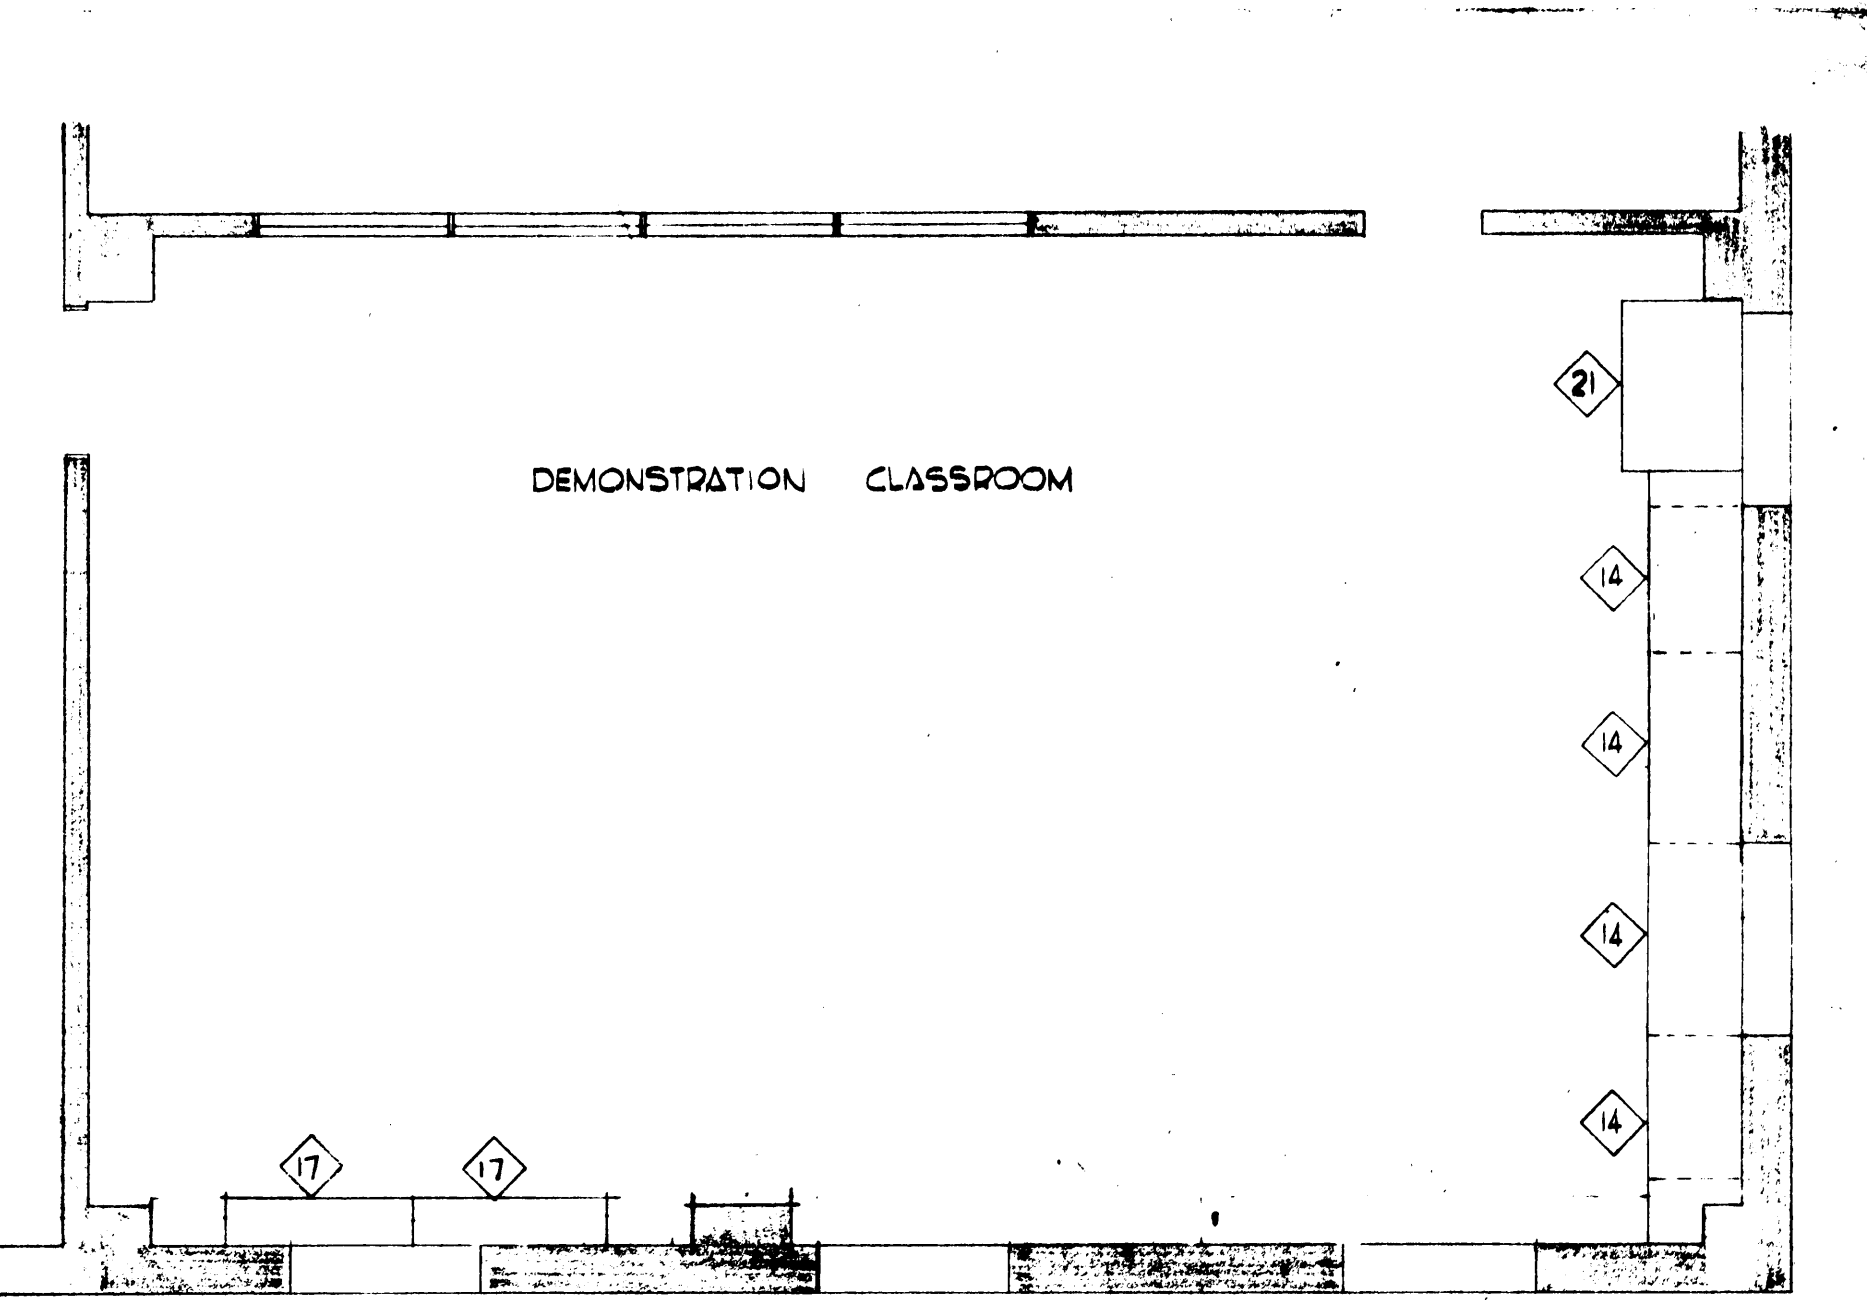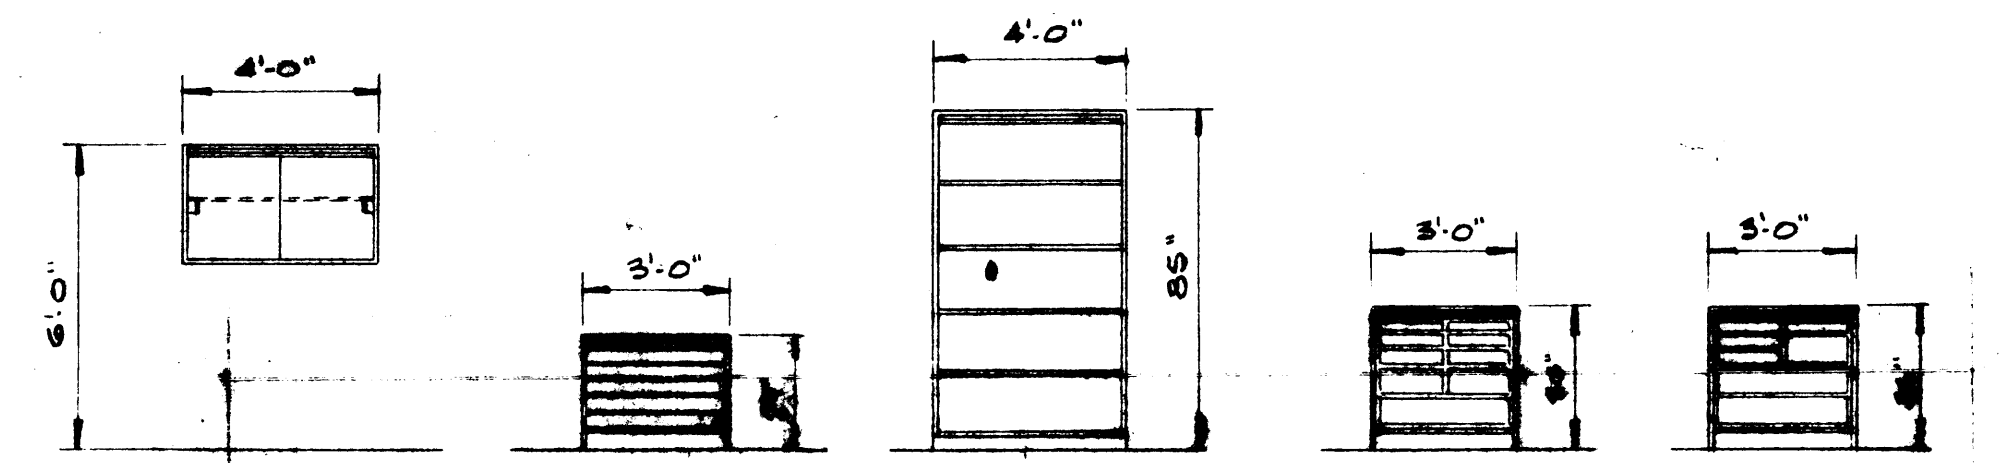

ELEVATION 'A-A'

"AS-BUILT" DRAWING

DATE _____





WILMINGTON COLLEGE EDUCATION & PSYCHOLOGY BUILDING
 WILMINGTON, NORTH CAROLINA
 BOARD OF TRUSTEES: L. BRADFORD TILLEY, JR., CHAIRMAN; DR. WILLIAM M. RANDALL, PRESIDENT

BALLARD, MCKIM, & SAWYER, AIA
 412 SOUTH SEVENTH STREET
 WILMINGTON, NORTH CAROLINA

7-C-792
 DRAWN BY: J.S.
 CHECKED BY: J.S.
 DATE: 10/20/60
 A-13

CODE 66737 - ITEM 6

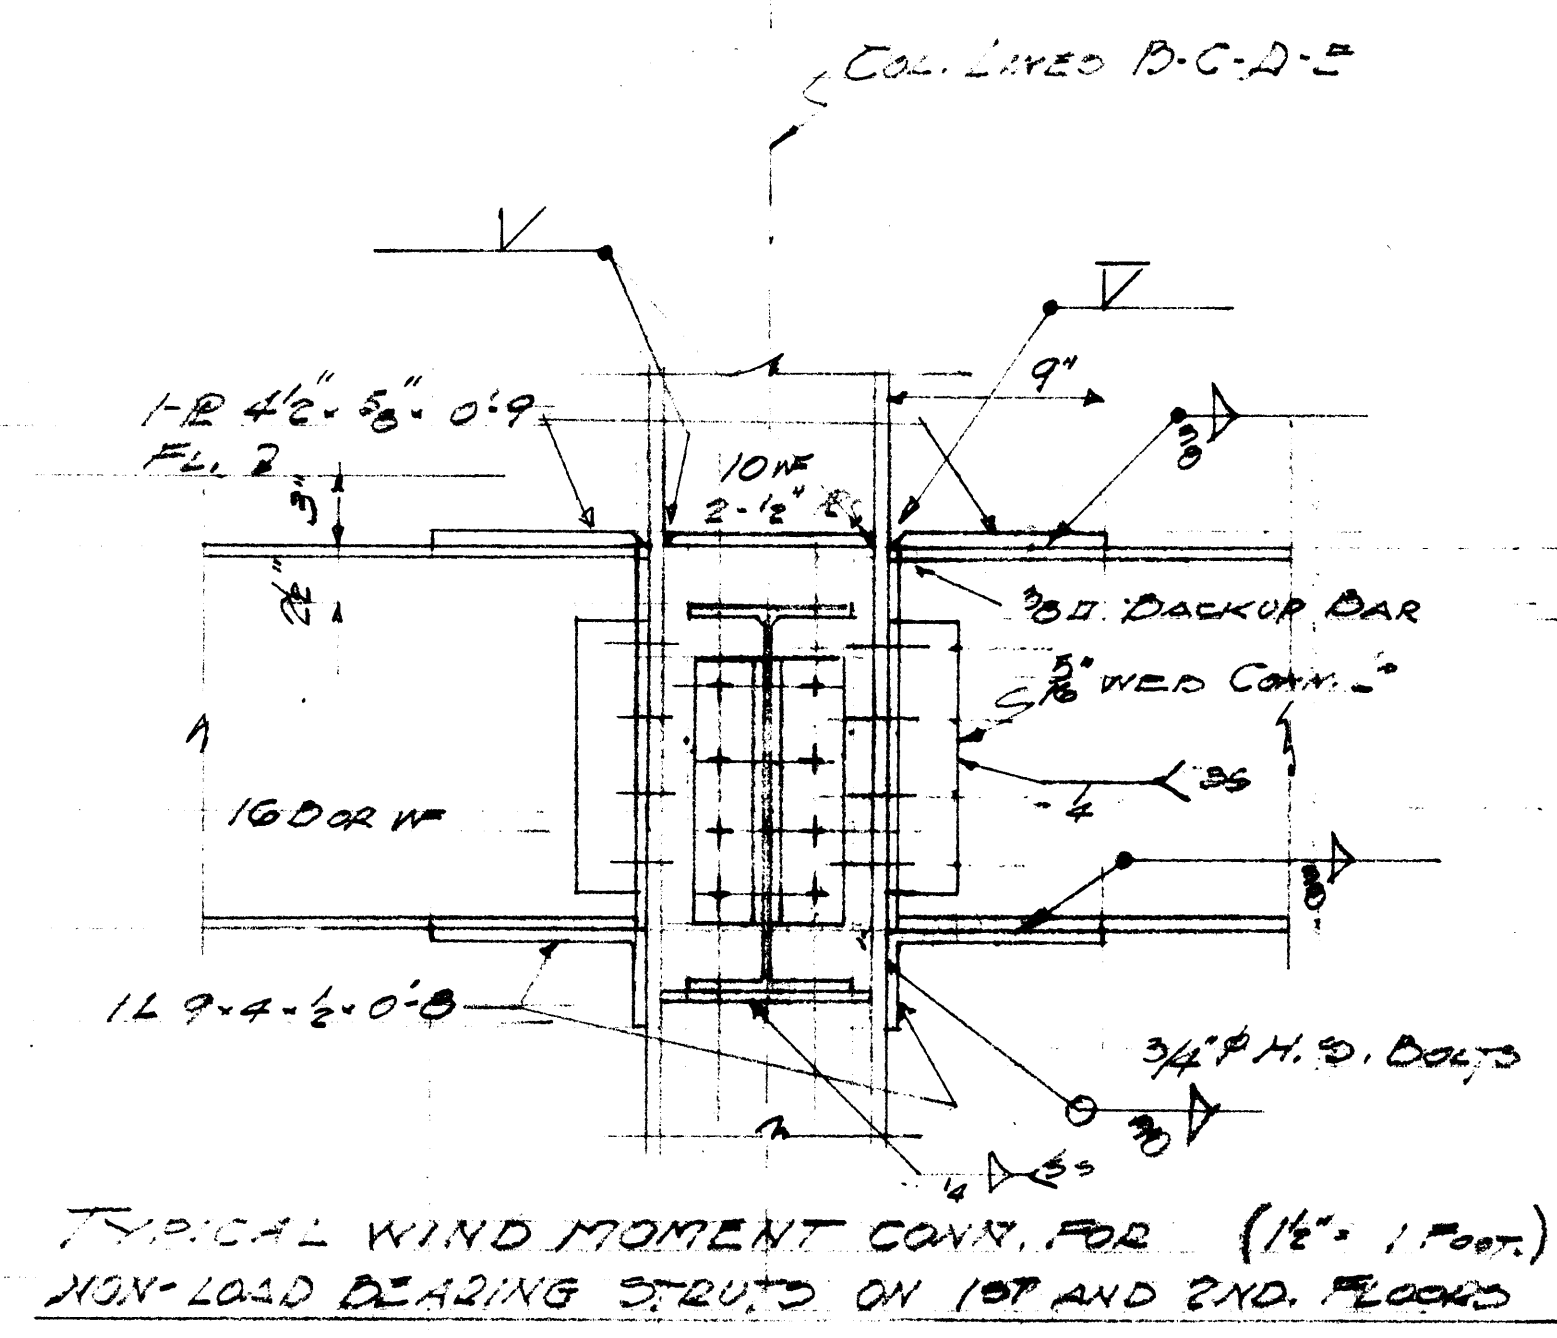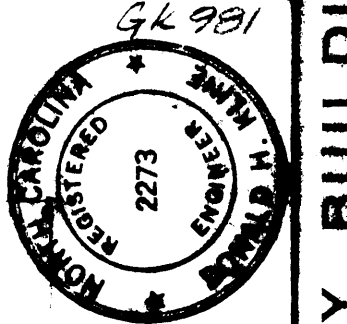



FIRST FLOOR FRAMING PLAN 6'-0\" ELEV. 4'-0\" TOP OF 3\" CONCRETE
 TOP OF STEEL - 3\" UNLESS NOTED

LINTEL SCHEDULE

| | |
|-----|--|
| L-1 | 12 4\" 3/2\" 5/8\" AND 8\" BLOCK LINTEL W/ 2\" 4\" BARS |
| L-2 | 8\" 0\" 10\" 4\" 1/4\" 8 |
| L-3 | 8\" 0\" 10\" 4\" 1/4\" 8 |
| L-4 | 8\" BLOCK LINTEL - 2\" 4\" BARS |
| L-5 | 2\" 0\" 3/2\" 3/2\" 4 |
| L-6 | 2\" 0\" 3/2\" 3/2\" 4 |

AS-BUILT DRAWING
 DATE _____

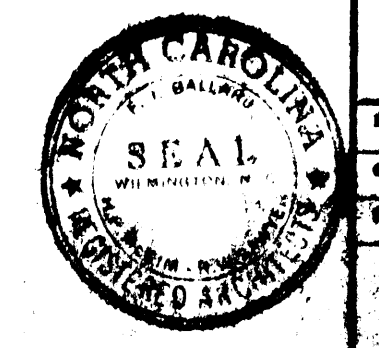

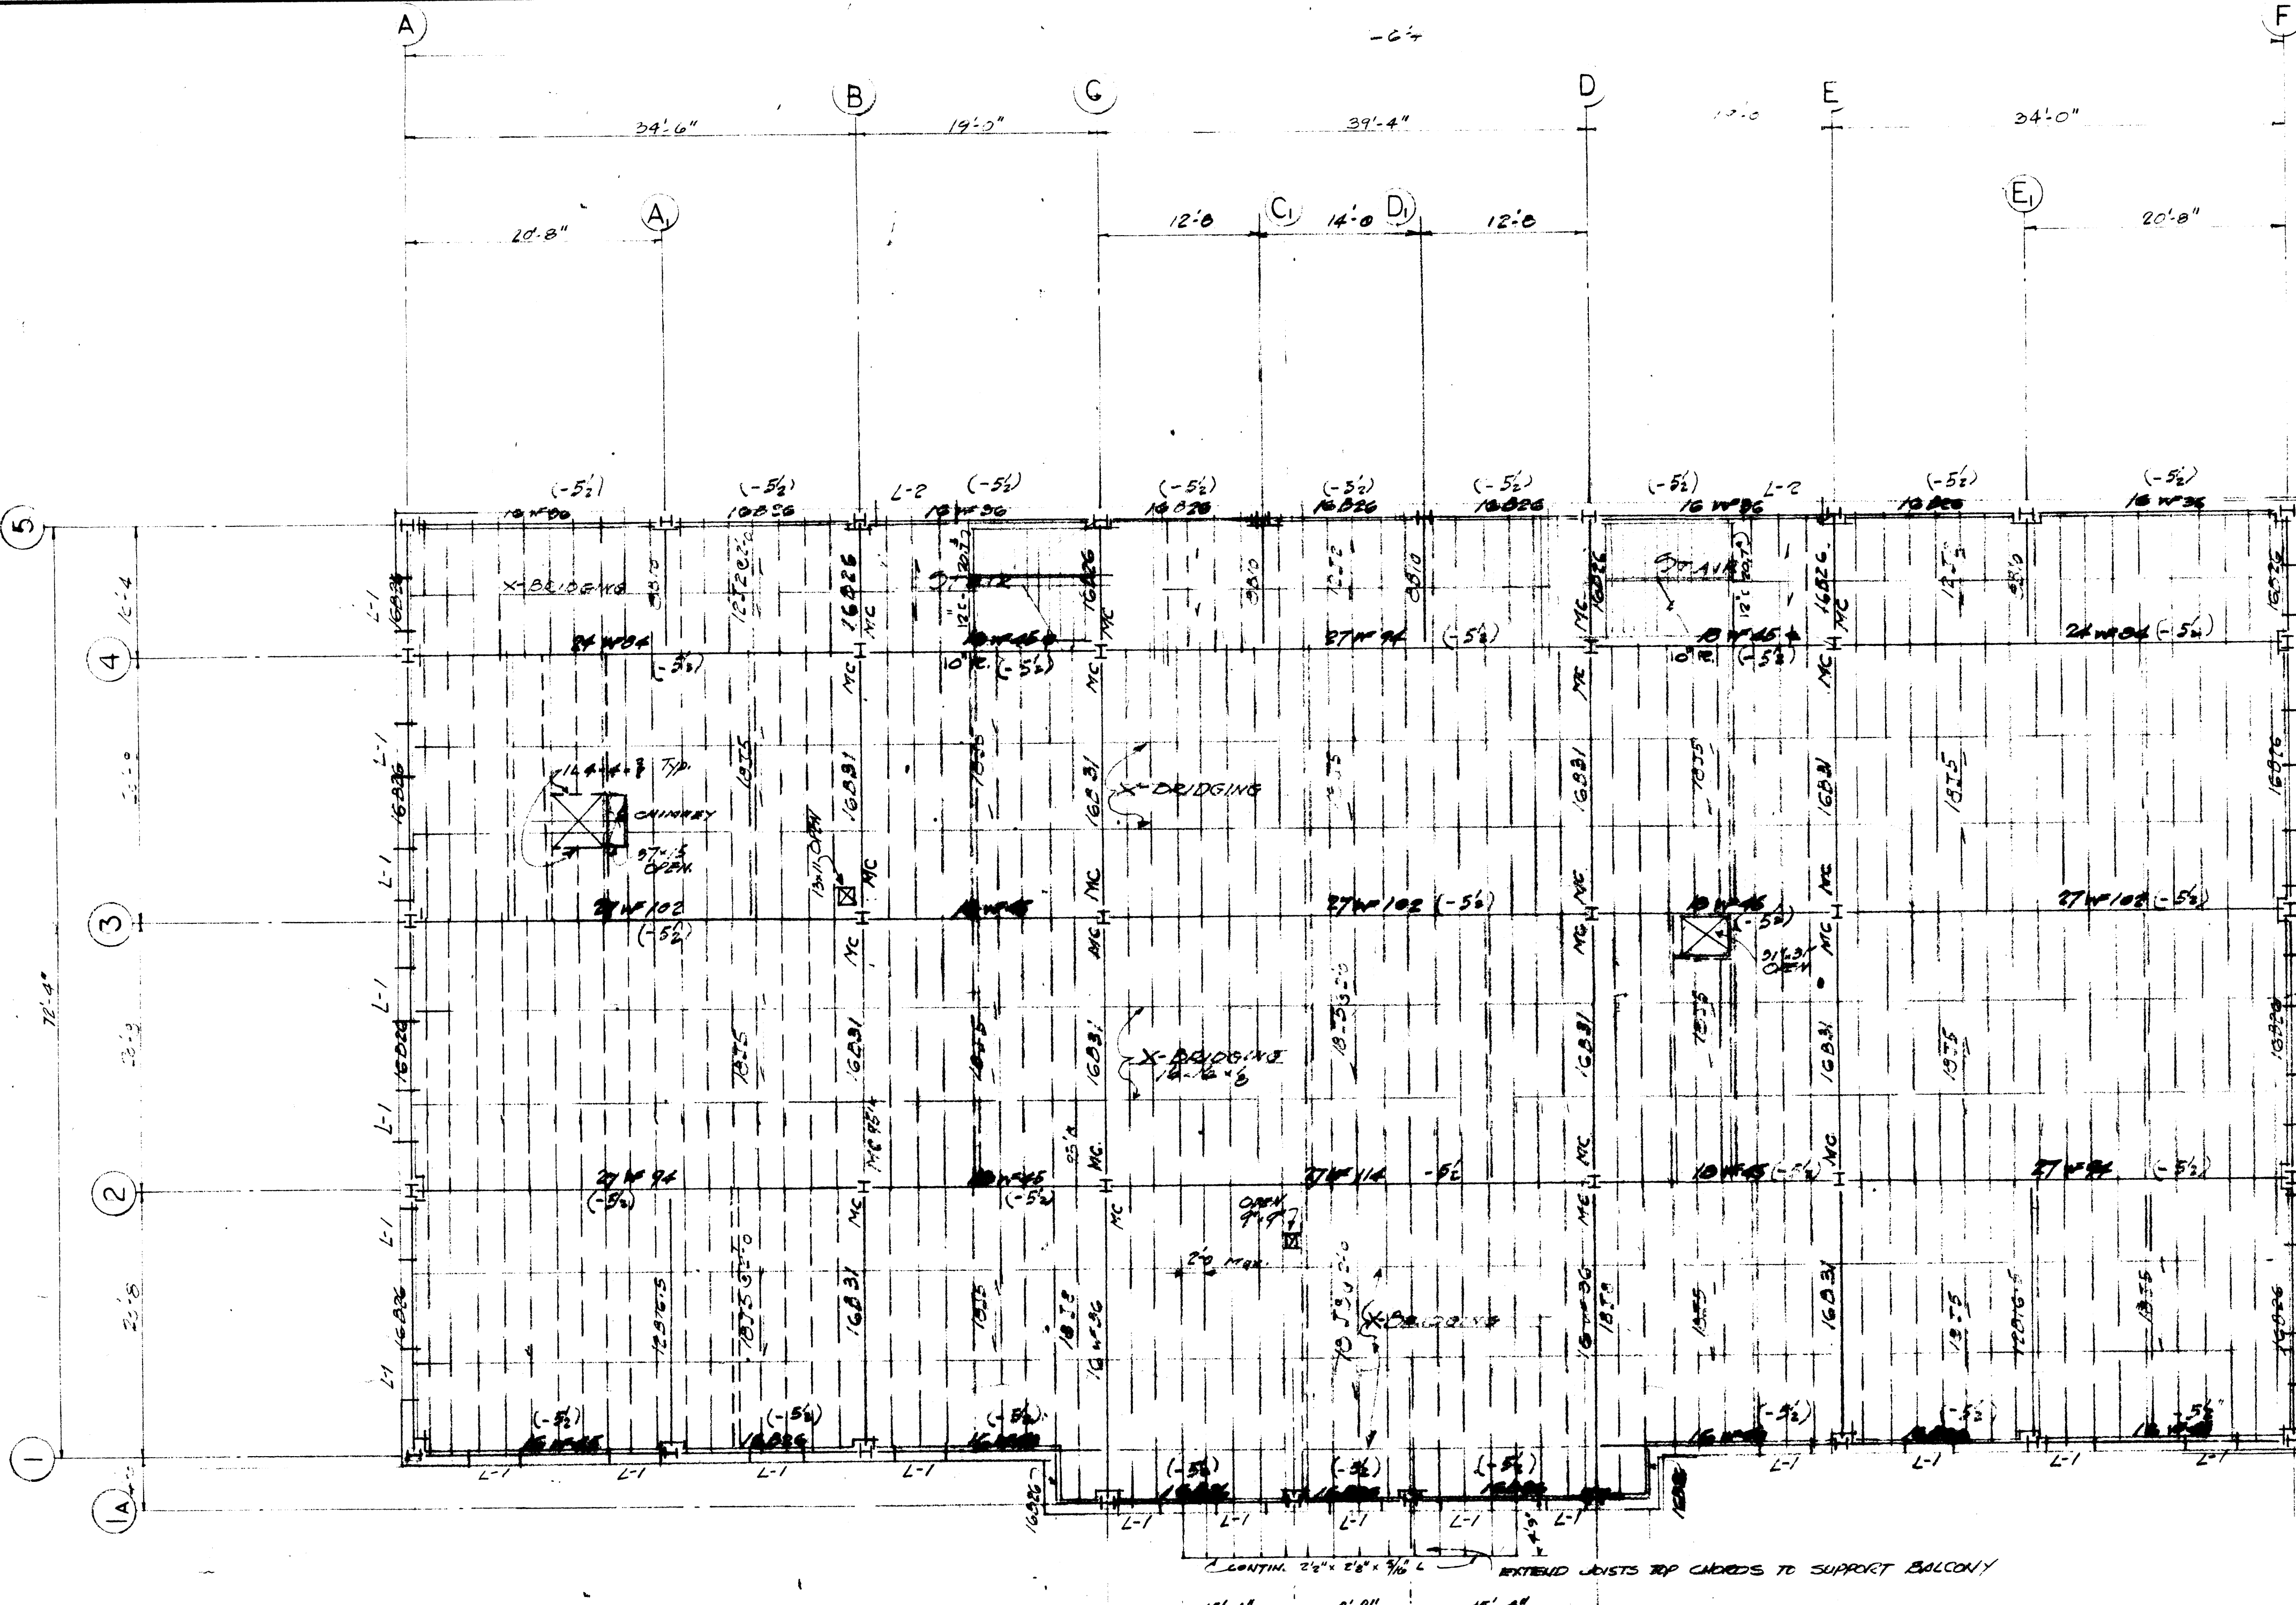

SECOND FLOOR FRAMING PLAN 18'-0"

1/4" FIN. FLOOR 6'-0" TOP OF STEEL -3" U.O.N.

- STEEL JOISTS:**
- STEEL, DESIGN, FABRICATION, AND ERECTION: STANDARD SPECIFICATIONS OF THE STEEL JOIST INSTITUTE.
 - BOTTOM CHORD OF JOISTS TO BE 2 ANGLES. PROVIDE CEILING EXTENSIONS AS SHOWN ON ARCHITECT'S DRAWINGS.
 - BRIDGING (SPACING PER SJI SPECS.) ALL BRIDGING TO BE CROSSED ANGLES WELDED IN PLACE.
 - WELD JOISTS TO STEEL SUPPORTS WITH 1" OF 3/16" FILLET EACH SIDE OF JOIST, U.O.N. ALL WELDING TO BE BY WELDERS AS UNDER "STRUCTURAL STEEL".
 - WHERE JOISTS BUTT OVER A 4" FLANGE, WELD JOISTS TOGETHER AS WELL AS TO BEAM. LENGTH OF JOISTS TO BE EXACT.
 - WELD DECK TO JOISTS PER DECK MFR'S RECOMMENDATIONS, U.O.N.
 - UNDER JOISTS, PROVIDE CONCRETE LINTEL BLOCKS REINFORCED.
 - PROVIDE DOUBLE JOISTS UNDER ALL PARTITIONS PARALLEL TO JOISTS, U.O.N.
 - WHERE JOIST LAYOUT PERMITS, THE BEARING END OF ALL JOISTS ARE TO BE CENTERED OVER THE BEAM. DIAGONAL MEMBERS AND BASE PLATE ARE TO BE SO DETAILED. A TOP CHORD EXTENSION IS NOT ACCEPTABLE IN LIEU OF THE SPECIAL BEARING DETAIL. NOTE ON ERECTION DRAWINGS THE BEARING CONDITION AT THESE JOISTS.
 - THE DESIGN OF ALL JOISTS FURNISHED SHALL HAVE BEEN SUBMITTED TO AND APPROVED BY THE STEEL JOIST INSTITUTE.

- STRUCTURAL MASONRY:**
- LOAD-BEARING MASONRY PIERS OR WALLS, MASONRY RETAINING WALLS, FOUNDATION WALLS, WALLS DESIGNATED ON DRAWINGS AS SHEAR WALLS AND OTHER MASONRY SO DESIGNATED ON DRAWINGS ARE CONSIDERED HERE TO BE STRUCTURAL MASONRY.
 - COMPRESSIVE STRENGTH OF MASONRY UNITS:
CLAY UNITS 3000 PSI
CONCRETE UNITS 2000 PSI ON NET AREA
 - COMPRESSIVE STRENGTH AT 28 DAYS OF MORTAR FOR STRUCTURAL MASONRY TO BE 2500 PSI MINIMUM. OTHER PROPERTIES OF MORTAR TO BE IN ACCORDANCE WITH ASTM C161 AND C270.
 - WHERE CONCRETE FILL IS SHOWN IN HOLLOW MASONRY UNITS, USE CONCRETE OR MORTAR OF 2500 PSI MINIMUM 28-DAY STRENGTH. COMPACT WELL TO FILL VOIDS COMPLETELY.
 - REINFORCING GRADE AND DETAILS AS FOR CONCRETE. TIE IN POSITION AND PLACE CONCRETE AROUND REINF DURING CONSTRUCTION OF MASONRY. DO NOT PUSH REINF DOWN INTO PREVIOUSLY PLACED CONCRETE FILL. SET BOLTS SIMILARLY.
 - TIE WYTHES WITH HORIZONTAL REINF AS SPECIFIED.

GENERAL NOTES


- GENERAL:
- DESIGN LIVE LOADS:
ROOF: 30 LBS PER SQ FT.
FLOOR AREAS: MECHANICAL - 150
CORRIDORS - 100
STAIRS - 100
OTHER AREAS - 60
WIND: 35 LBS PER SQ FT.
 - "U.O.N." MEANS "UNLESS OTHERWISE NOTED".
 - SUBMIT ALL STRUCTURAL SHOP DRAWINGS IN QUADRUPPLICATE. DO NOT FABRICATE MATERIAL UNTIL APPROVAL OF ARCHITECT IS RECEIVED.
 - ALL SPECIFICATIONS REFER TO LATEST EDITION.
 - ALL LINTELS BEAR 8" MINIMUM EACH SIDE OF OPENINGS.
 - CONTRACTOR RESPONSIBLE FOR DISSEMINATION OF REVISIONS TO CONTRACT DOCUMENTS AND REQUIREMENTS TO ALL SUB-CONTRACTORS.
 - ALL SAFETY REGULATIONS TO BE FOLLOWED STRICTLY.
 - NOTES BELOW ARE NOT INTENDED TO REPLACE WRITTEN SPECIFICATIONS. SEE SPECIFICATIONS FOR REQUIREMENTS IN ADDITION TO GENERAL NOTES.
 - METHOD OF ERECTION OF ALL STRUCTURAL MATERIAL IS ERECTOR'S RESPONSIBILITY. CONSULT ARCHITECT IN CASE OF QUESTIONS.
 - STRUCTURAL FRAME TO BE BRACED UNTIL ERECTION IS COMPLETE AND PERMANENT CONNECTIONS, VERTICAL BRACING, OR MASONRY BRACING IS INSTALLED.

- FOUNDATIONS:**
- ALLOWABLE SOIL PRESSURE ASSUMED 5000 PSF MINIMUM, TO BE VERIFIED IN THE FIELD BEFORE CONSTRUCT.
 - NO THUS DENOTES ELEVATION OF TOP OF WALL FOOTINGS OR GRADE BEAMS, U.O.N.
 - NO THUS DENOTES ELEVATION OF TOP OF COLUMN FOOTINGS, U.O.N.
 - FTGS TO BE RAISED OR LOWERED FROM ELEVATIONS SHOWN ON DRAWINGS AS DIRECTED BY ARCHITECT WITH ADJUSTMENT IN CONTRACT USING UNIT PRICES.
 - WALLS ACTING AS RETAINING WALLS SHALL NOT BE BACKFILLED WITHOUT BRACING UNTIL ALL SUPPORTING SOIL AND SLABS IN PLACE AND AT ADEQUATE STRENGTH.
 - PROVIDE WELL-BRACED SHORING AT EXCAVATIONS NEAR EXISTING BUILDINGS TO PREVENT SETTLEMENT.
 - COMPACT ALL FILL UNDER BUILDING TO 95% MAXIMUM DENSITY AS DETERMINED BY ASTM D1557. PLACE IN LAYERS 8" MAXIMUM LOOSE THICKNESS. VERIFY FIELD DENSITY, ASTM D1556, WITH AT LEAST ONE TEST PER 5000 SQ FT PER LAYER. ALL TESTS TO BE AT EXPENSE OF OWNER.
 - SELECT AND PLACE POROUS BACKFILL AT RETAINING WALLS CAREFULLY.

- CONCRETE:**
- CONCRETE COMPRESSIVE STRENGTH IN 28 DAYS: 3000 LBS PER SQ INCH.
 - REINFORCING BARS: INTERMEDIATE GRADE NEW BILLET STEEL DEFORMED BARS, ASTM A15 AND A305.
 - WELDED WIRE FABRIC: ASTM A185
 - USE REGULAR STONE CONCRETE FOR ALL CONCRETE.
 - GROUT: ONE PART TYPE I PORTLAND CEMENT AND 2 1/2 PARTS SAND BY VOLUME.
 - BAR DETAILS AND SUPPORTS: ACI BUILDING CODE AND ACI DETAILING MANUAL. LAP ALL SPLICES 50 DIAMETER, U.O.N.
 - CLEAR DISTANCE FROM FACE OF CONCRETE ON MAIN STEEL:
SLABS 3/4"
BEAMS, COLS, AND WALLS 1 1/2"
FOOTINGS 3" BOTTOM - SIDES 2"
 - PROVIDE WIRE MESH IN ALL SLABS ON THE GROUND, 1 1/2" FROM TOP OF SLAB:
4" SLABS 66-1010
5" SLABS 66-66
 - PROVIDE 3/8" X 45° CHAMFER ON ALL EXPOSED CONCRETE EDGES.
 - PROVIDE DOUBLE JOISTS UNDER ALL PARTITIONS PARALLEL TO JOISTS, U.O.N.
 - WELDING TO BE BY WELDERS AS UNDER "STRUCTURAL STEEL".
 - ALL 3" CONCRETE FLOOR SLABS REINFORCED WITH W.W.F. 66-1010.

- STRUCTURAL STEEL:**
- STRUCTURAL STEEL: ASTM A36
 - DESIGN, FABRICATION, AND ERECTION: AISC SPECIFICATIONS FOR BUILDINGS.
 - DESIGN CONNECTIONS FOR FULL STRENGTH OF MEMBER UNLESS LOADS ARE SHOWN ON THE DRAWINGS. SHOP CONNECTIONS: WELDED. FIELD CONNECTIONS: 2" HIGH TENSILE STRENGTH BOLTS, ASTM A325, U.O.N.
 - WELDS SHALL BE MADE ONLY BY OPERATORS CERTIFIED BY THE STANDARD QUALIFICATION PROCEDURE OF THE AMERICAN WELDING SOCIETY FOR TYPE OF WELD REQUIRED.
 - PROVIDE ERECTION BOLTS AS REQUIRED FOR WELDED CONNECTIONS. ERECTION BOLTS EXPOSED OUTSIDE SHALL BE REMOVED AND HOLES PLUGGED AS DIRECTED BY THE ARCHITECT. GRIND IF REQUIRED.
 - RETURN ALL WELDS AT CORNERS TWICE THE NOMINAL SIZE OF THE WELD MINIMUM.
 - WELDED CONNECTIONS TO EXISTING MEMBERS CARRYING STRESS TO BE MADE TO REDUCE WARPING TO MINIMUM. SHORE OR BRACE EXISTING MEMBER DURING WELDING OPERATION.
 - GENERAL CONTRACTOR TO SUBMIT A STATEMENT BY ERECTOR THAT HE IS FAMILIAR WITH SPECIFICATIONS FOR STRUCTURAL JOINTS USING ASTM A325 BOLTS AS ENDORSED BY THE AISC.
 - PROVIDE 8x8x0'-8" BASE PLATE WITH 2-1/2x1'-0" ANCHOR BOLTS UNDER ALL BEAMS BEARING ON MASONRY, U.O.N.
 - PROVIDE 3/4" MINIMUM GROUT UNDER COLUMN BASE PLATES. GROUT TO CONTAIN A NONSHRINK ADMIXTURE EQUAL TO "EMBECCO".
 - PROVIDE HOLES FOR BLOCKING AS PER ARCHITECT'S DRAWINGS.
 - DEFORMED BAR ANCHORS SHOWN WELDED TO STEEL SHAPES TO BE FURNISHED WITH SHAPES. BARS TO BE ASTM A15 AND A305.
 - WHERE MEMBERS WERE DESIGNED USING PLASTIC STRENGTH, FOLLOW AISC SPECIFICATIONS FOR SPECIAL FABRICATION TECHNIQUES.
 - FABRICATOR SHALL PROVIDE ALL BOLTS NECESSARY FOR ERECTION.
 - ALL STEEL SHAPES SHOWN ON STRUCTURAL DRAWINGS BY STRUCTURAL STEEL CONTRACTOR UNLESS NOTED MISCELLANEOUS STEEL.
 - UNLESS NOTED, ALL END CONNECTIONS FOR BEAMS TO BE PROPORTIONED FOR REACTIONS FOR FULL UNIFORM WORKING LOAD ON CORRESPONDING SPAN.

"AS-BUILT" DRAWING
DATE _____ JUN 10 1973

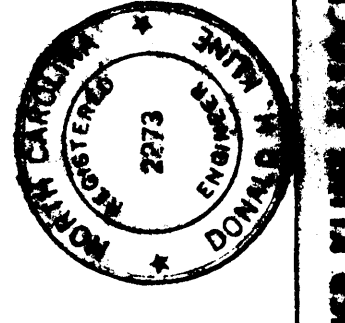

GARDNER-KLINE ASSOCIATES
CONSULTING ENGINEERS
WILMINGTON, NORTH CAROLINA
42981

WILMINGTON COLLEGE EDUCATION & PSYCHOLOGY BUILDING
WILMINGTON, NORTH CAROLINA
BOARD OF TRUSTEES - L. BRADFORD TILLEY, JR. CHAIRMAN - DR. WILLIAM M. RANDALL, PRESIDENT.



BALLARD, McKIM, & SAWYER, AIA
612 SOUTH SEVENTEENTH STREET
WILMINGTON, NORTH CAROLINA

DRAWN BY
DATE

"AS-BUILT" DRAWING

DATE _____


GARDNER-KRINE ASSOCIATES
CONSULTING ENGINEERS
DURHAM/RALEIGH, NORTH CAROLINA

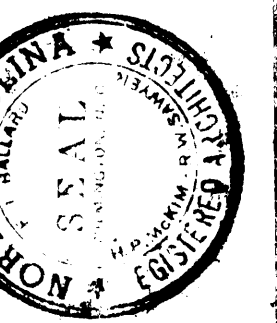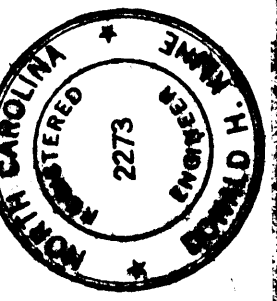

WILMINGTON COLLEGE EDUCATION & PSYCHOLOGY BUILDING
WILMINGTON, NORTH CAROLINA
BOARD OF TRUSTEES: L. BRADFORD TILLEY, JR. CHAIRMAN - DR. WILLIAM M. RANSALL, PRESIDENT


CODE 66737 - ITEM 6

BALLARD, MCKIM, & SAWYER, AIA
613 SOUTH SEVENTEENTH STREET
WILMINGTON, NORTH CAROLINA

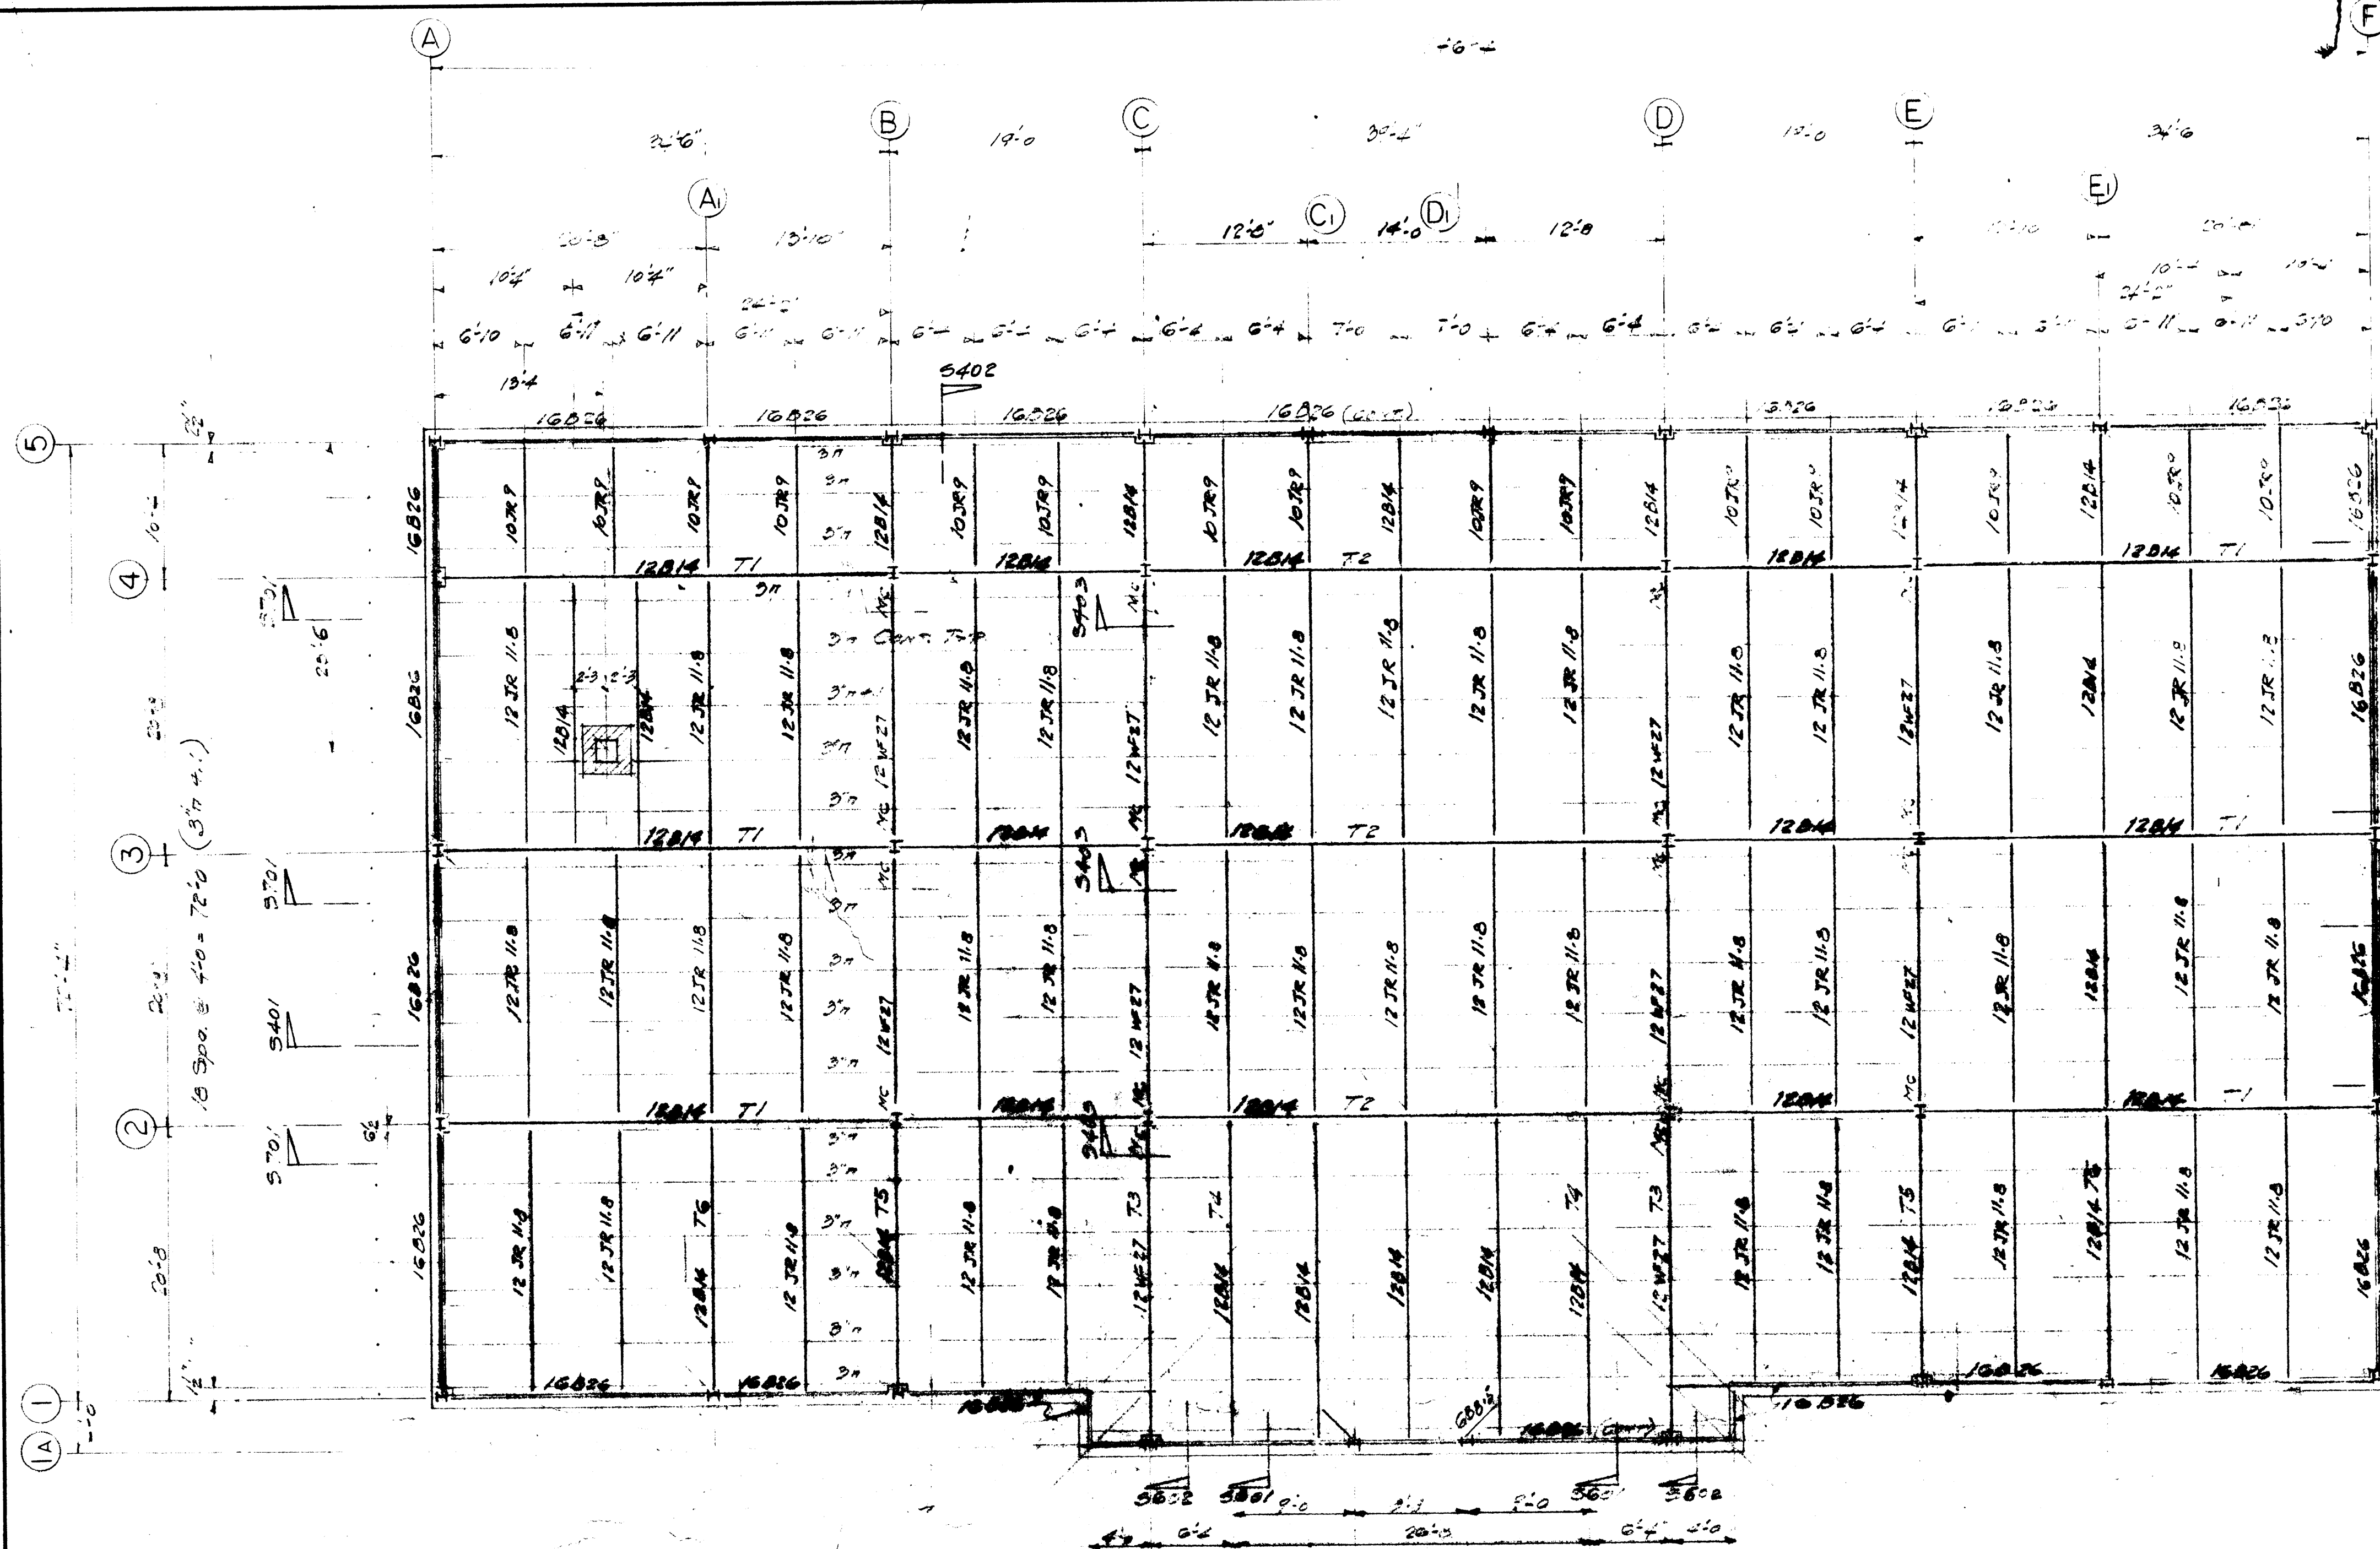


EL. TOP OF 12' CEILING JOISTS - 75'0 -
CEILING STRUCTURE AND BOTTOM CHORD OF ROOF TRUSSES


10 EQUAL SPACES (HEAD JOISTS)

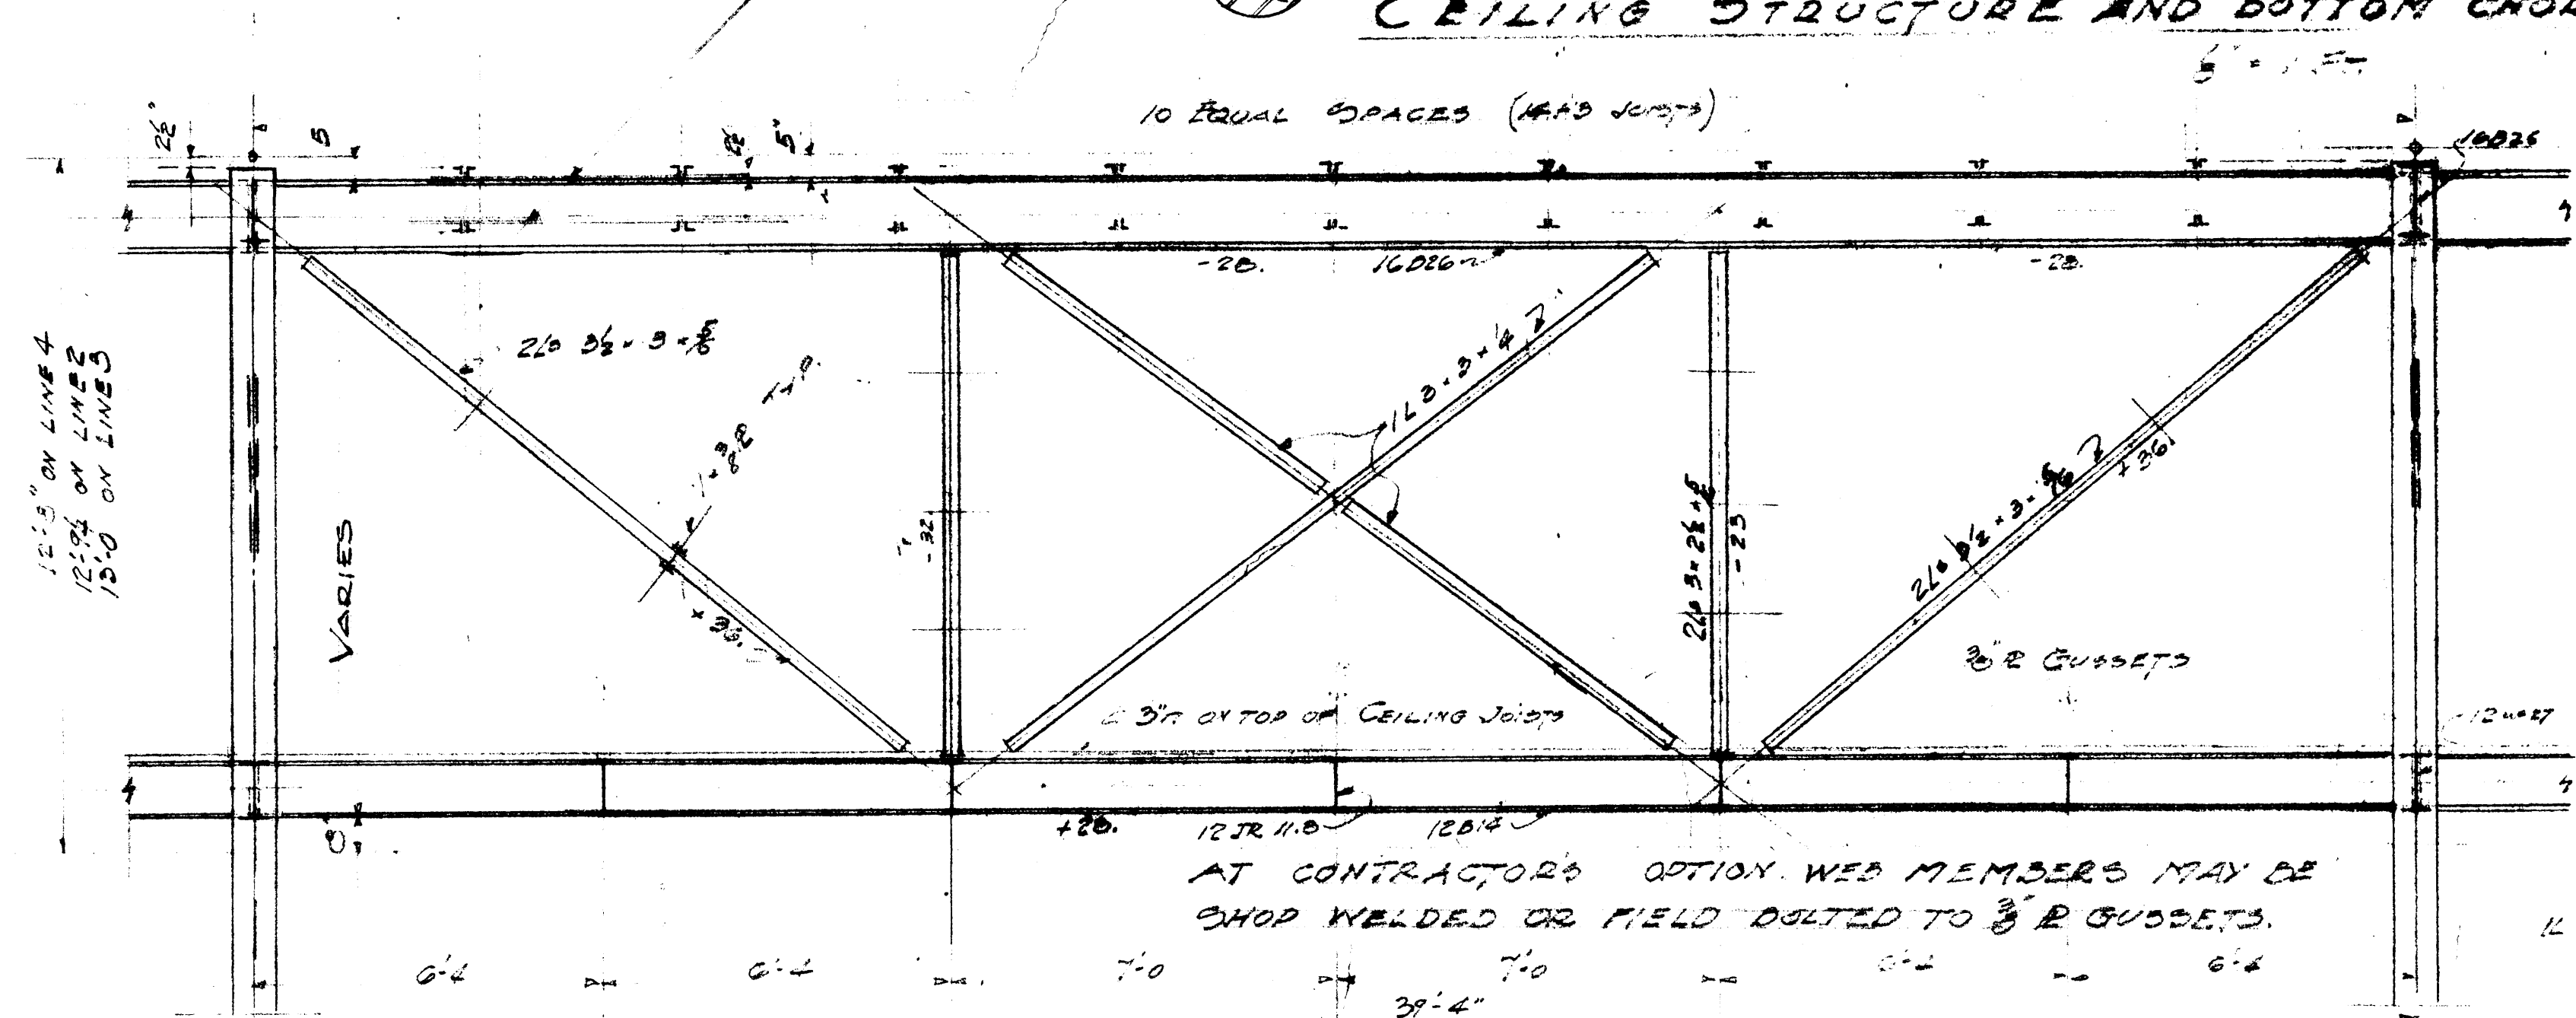

HORIZONTAL ROOF TRUSS - T2 26'-0" - 5403

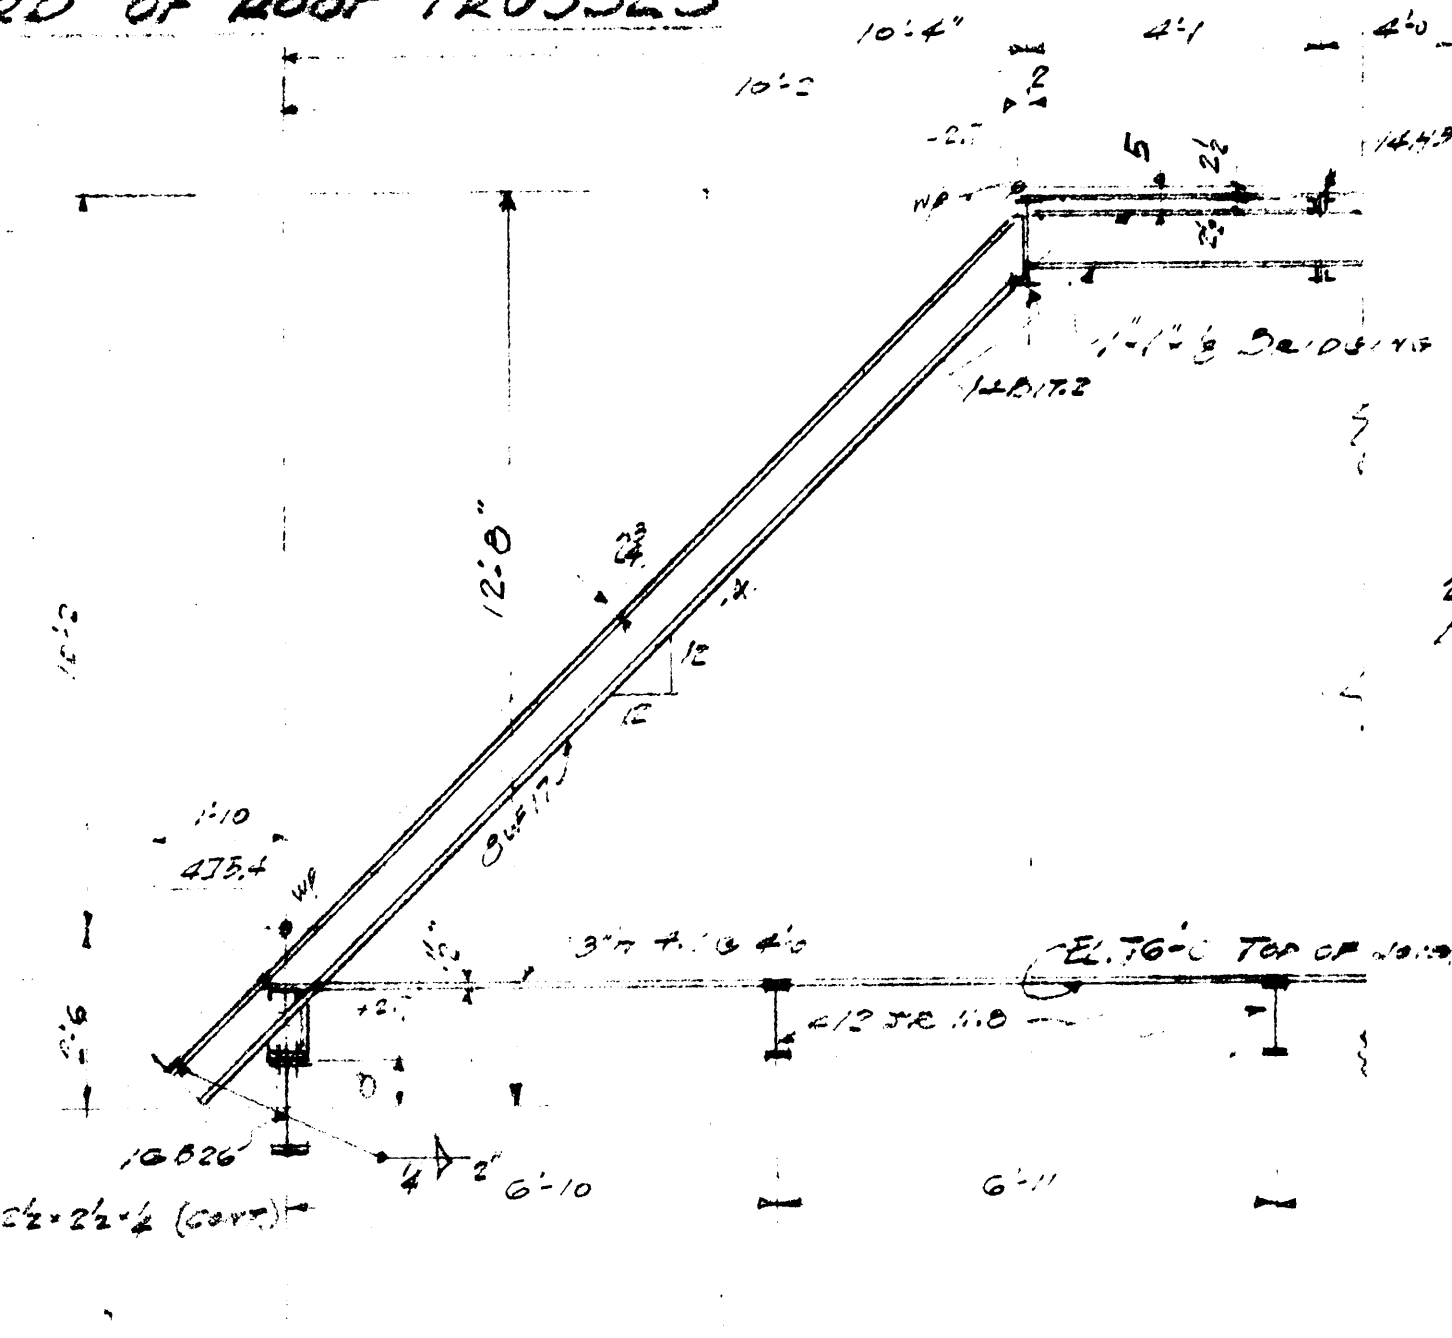


RAFTER DEC-5401

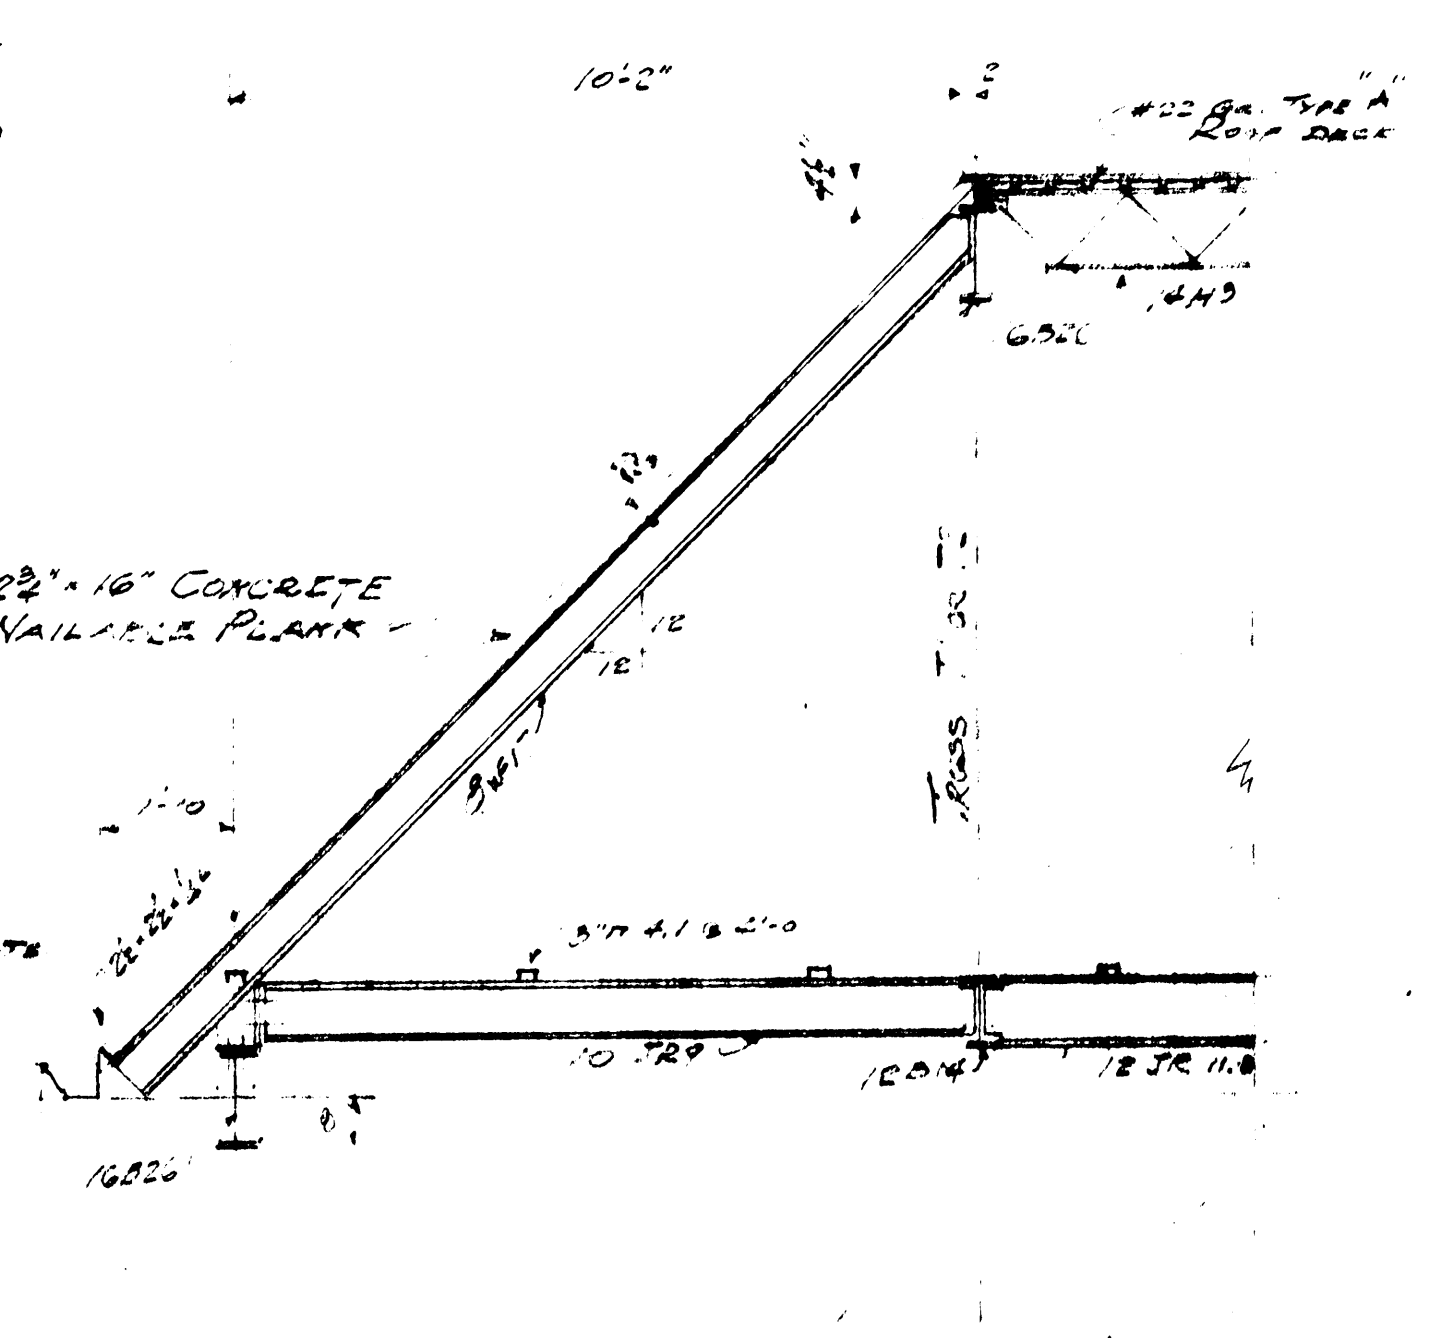

RAFTER - DEC-2402




"AS-BUILT" DRAWING
 DATE JUN 10 1988

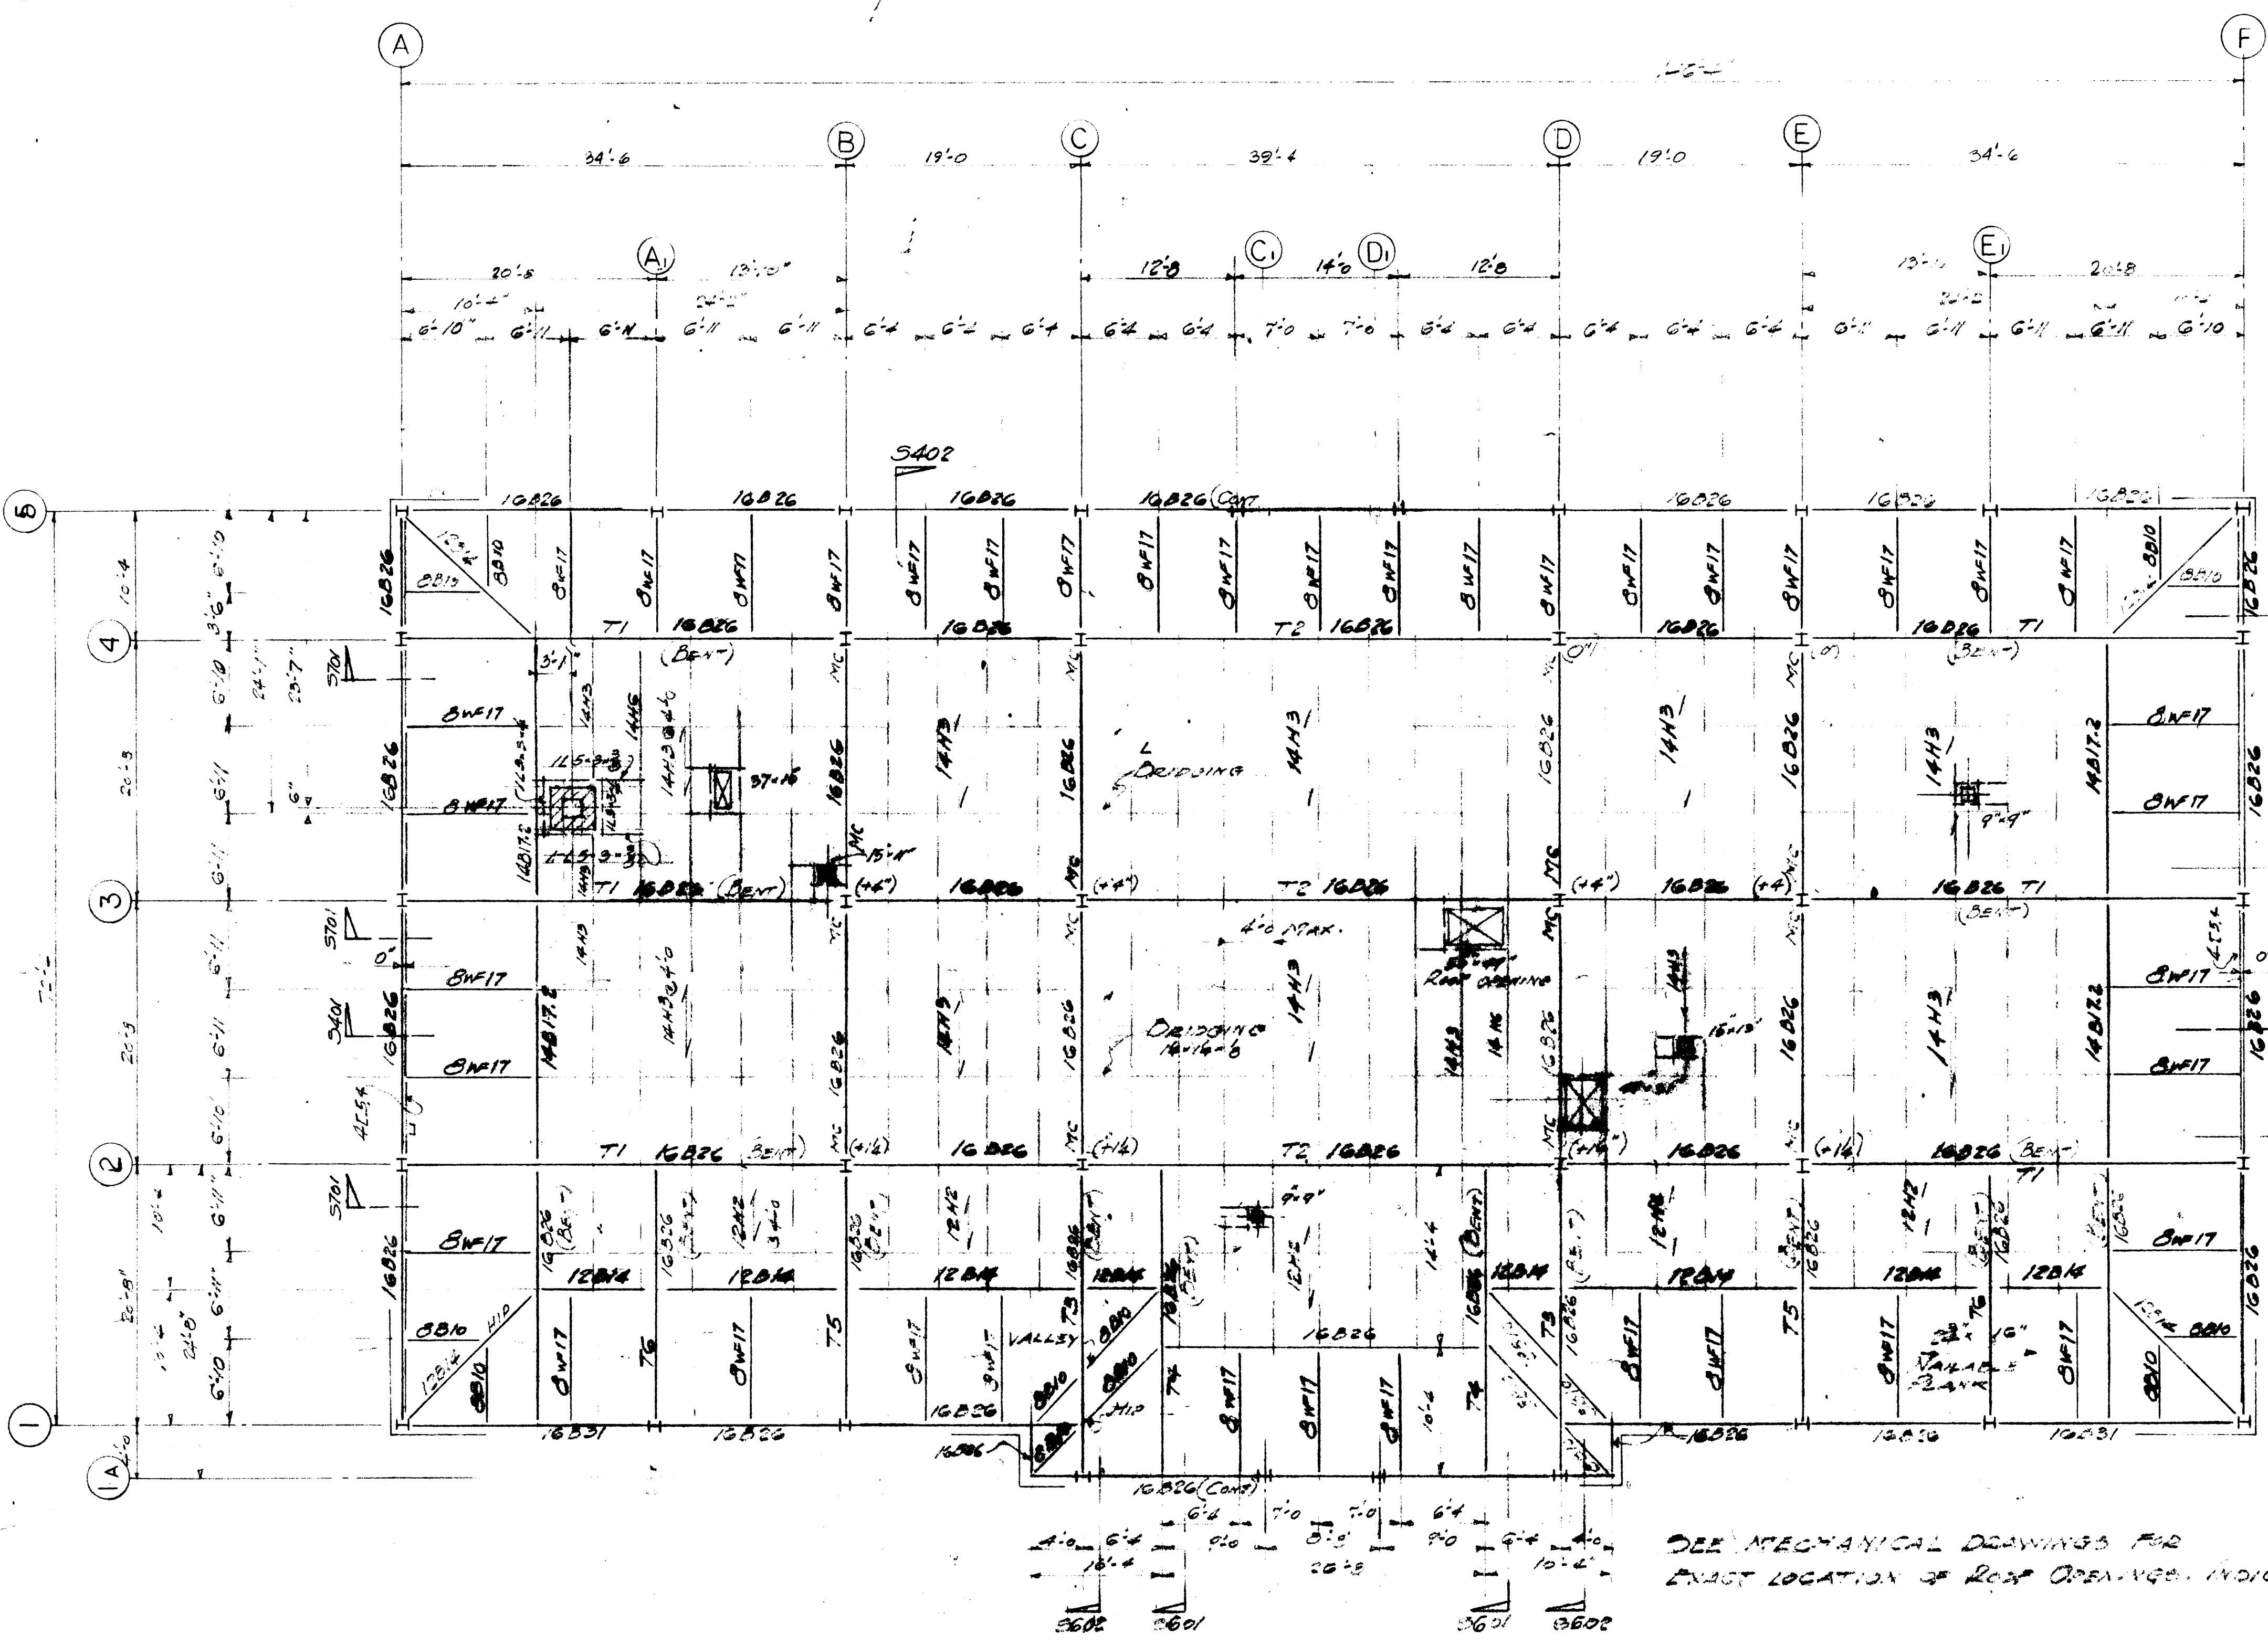

SEE MECHANICAL DRAWINGS FOR
 EXACT LOCATION OF ROOF OPENINGS. INDICATED



ROOF FRAMING PLAN 1/8" = 1'-0"

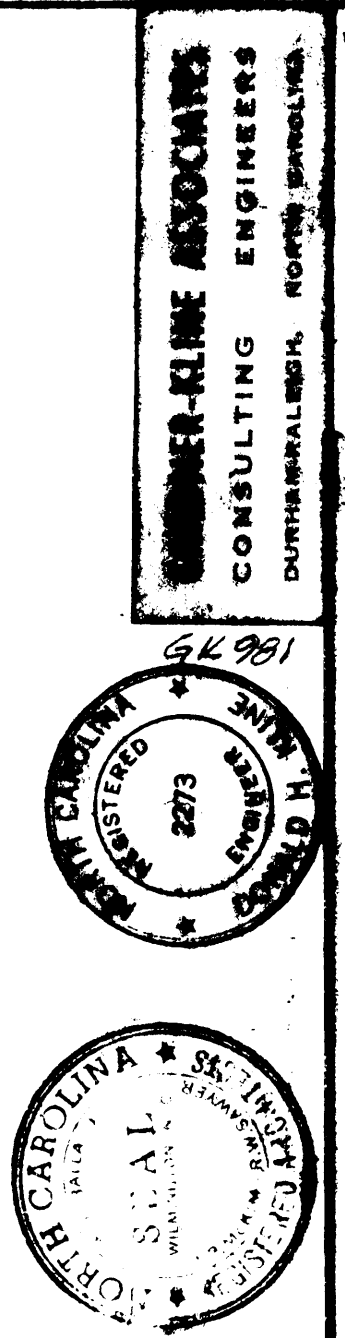

WILMINGTON COLLEGE EDUCATION & PSYCHOLOGY BUILDING
 WILMINGTON, NORTH CAROLINA
 BOARD OF TRUSTEES: C. BRADY TILLEY, JR., CHAIRMAN; DR. WILLIAM M. RANDALL, PRESIDENT

BALLARD, McKIM, & SAWYER, AIA
 412 SOUTH SEVENTEENTH STREET
 WILMINGTON, NORTH CAROLINA

CODE 66737 - ITEM 6

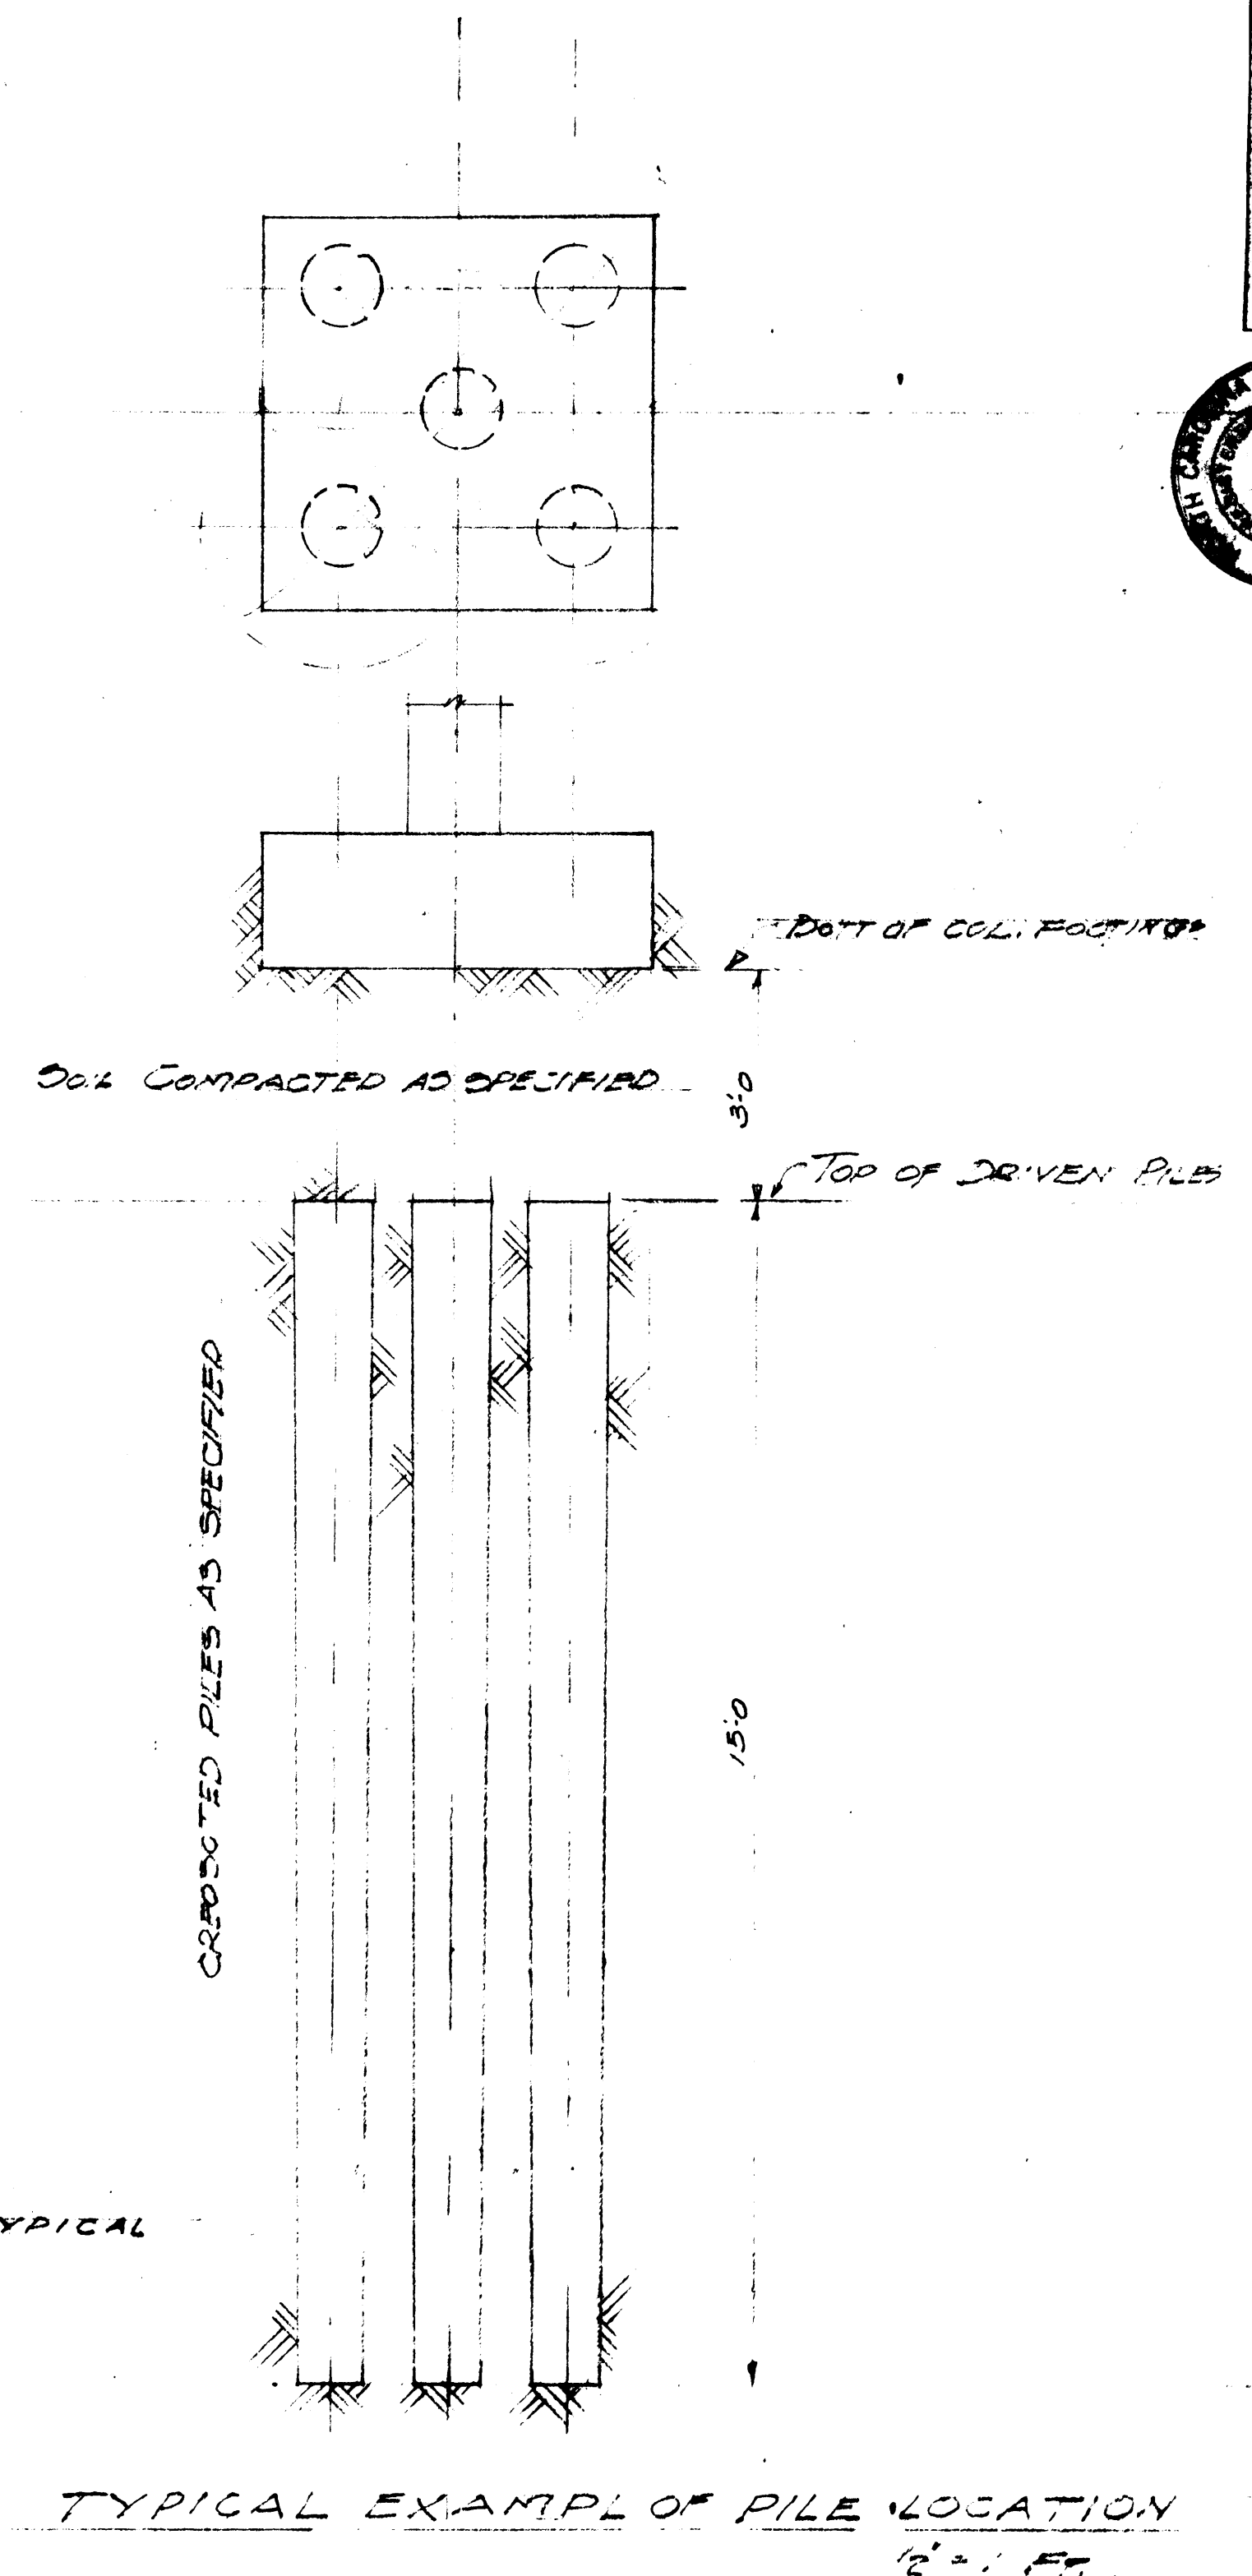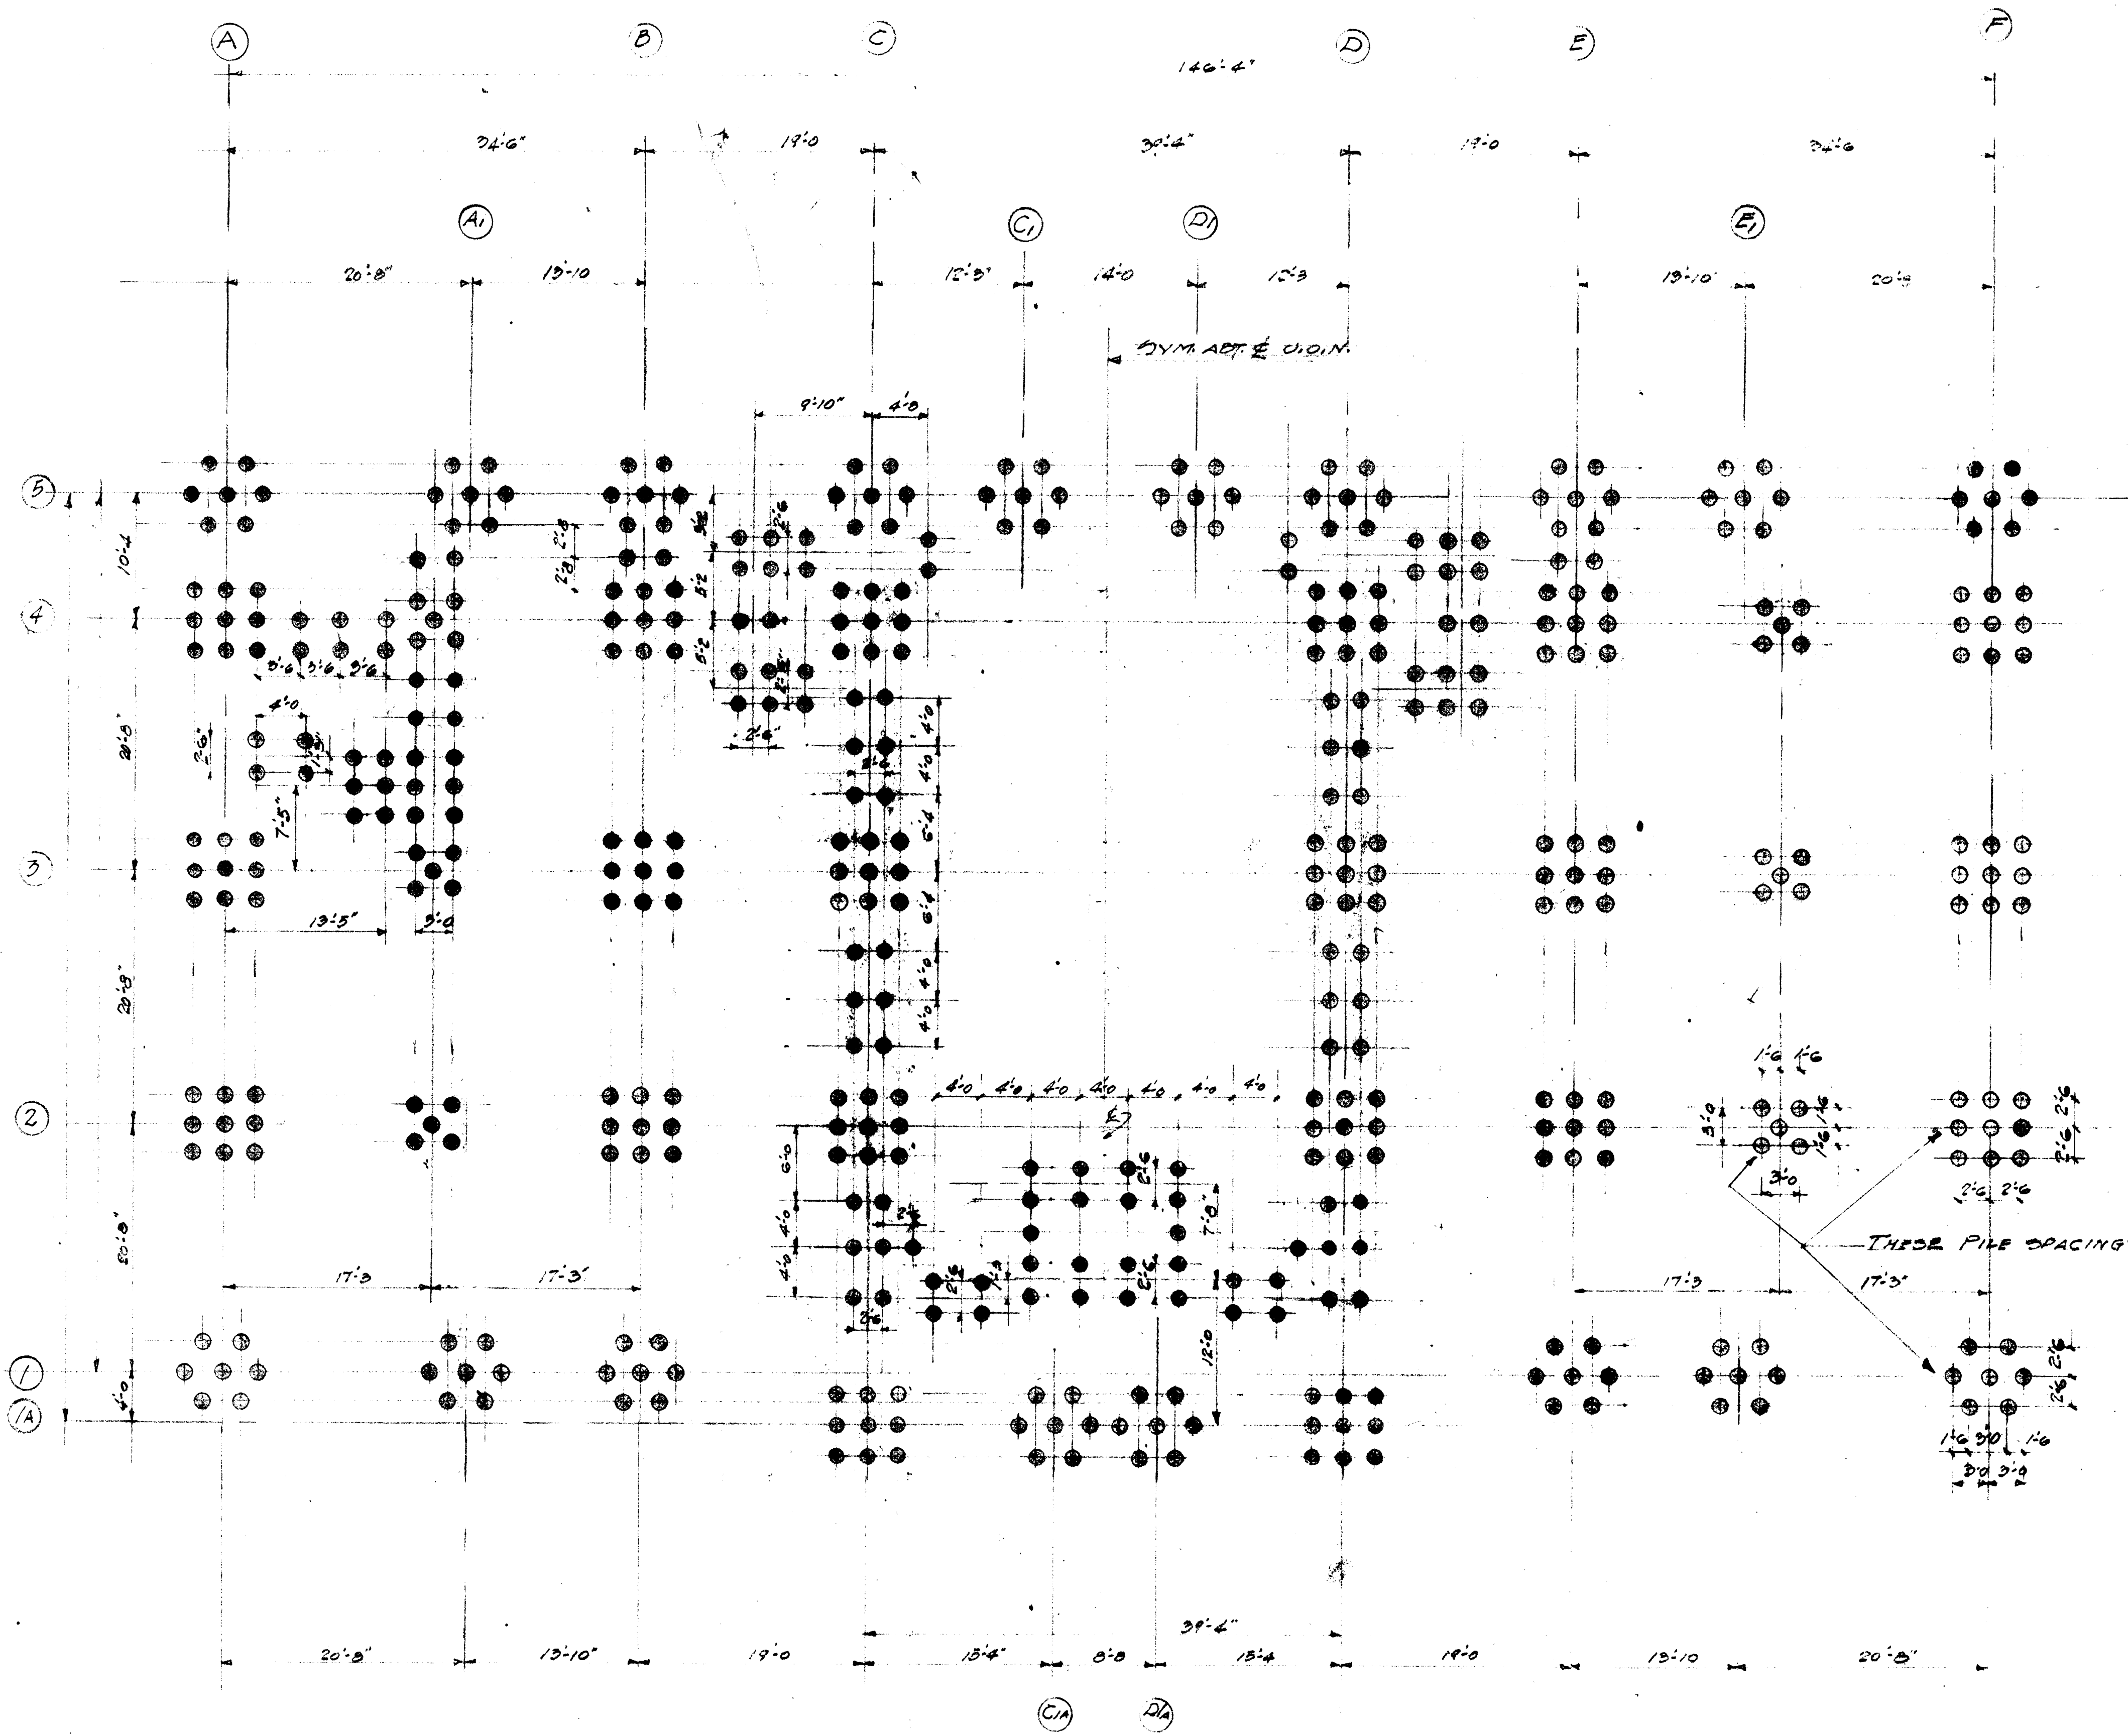

FOUNDATION PLAN 1/2" = 1'-0"

CANNON-KLINE ASSOCIATES
 CONSULTING ENGINEERS
 DURHAM, N.C. 27701






WILMINGTON COLLEGE EDUCATION & PSYCHOLOGY BUILDING
 WILMINGTON, NORTH CAROLINA
 BOARD OF TRUSTEES - L. BRADY TILLEY, JR. CHAIRMAN - DR. WILLIAM M. RANDALL, PRESIDENT

BALLARD, McKIM, & SAWYER, AIA
 412 SOUTH SPRENTOWN STREET
 WILMINGTON, NORTH CAROLINA


DRAWN BY: [Signature]
 CHECKED BY: [Signature]
 DATE: JUN 10 1968
 SHEET NO. 58

"AS-BUILT" DRAWING
 DATE: _____


CODE 66737 - ITEM 6

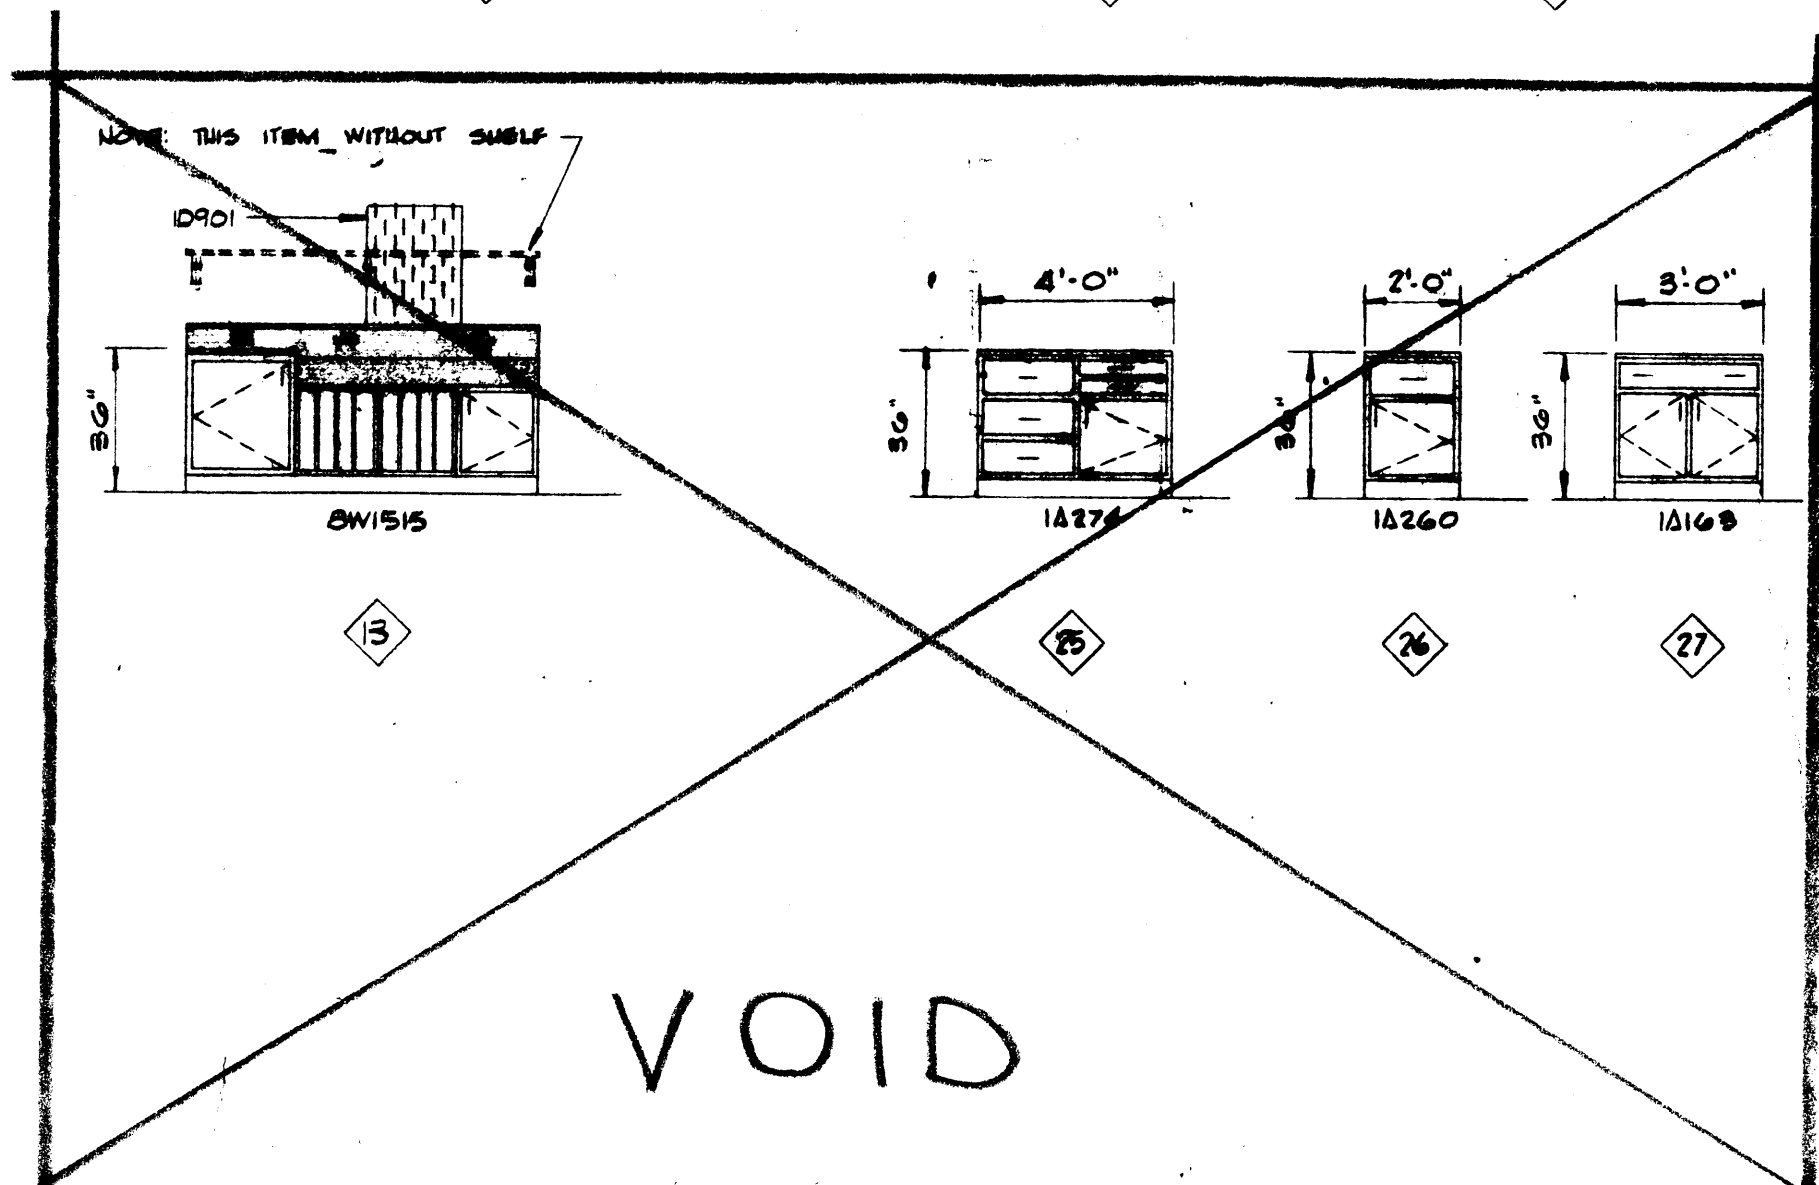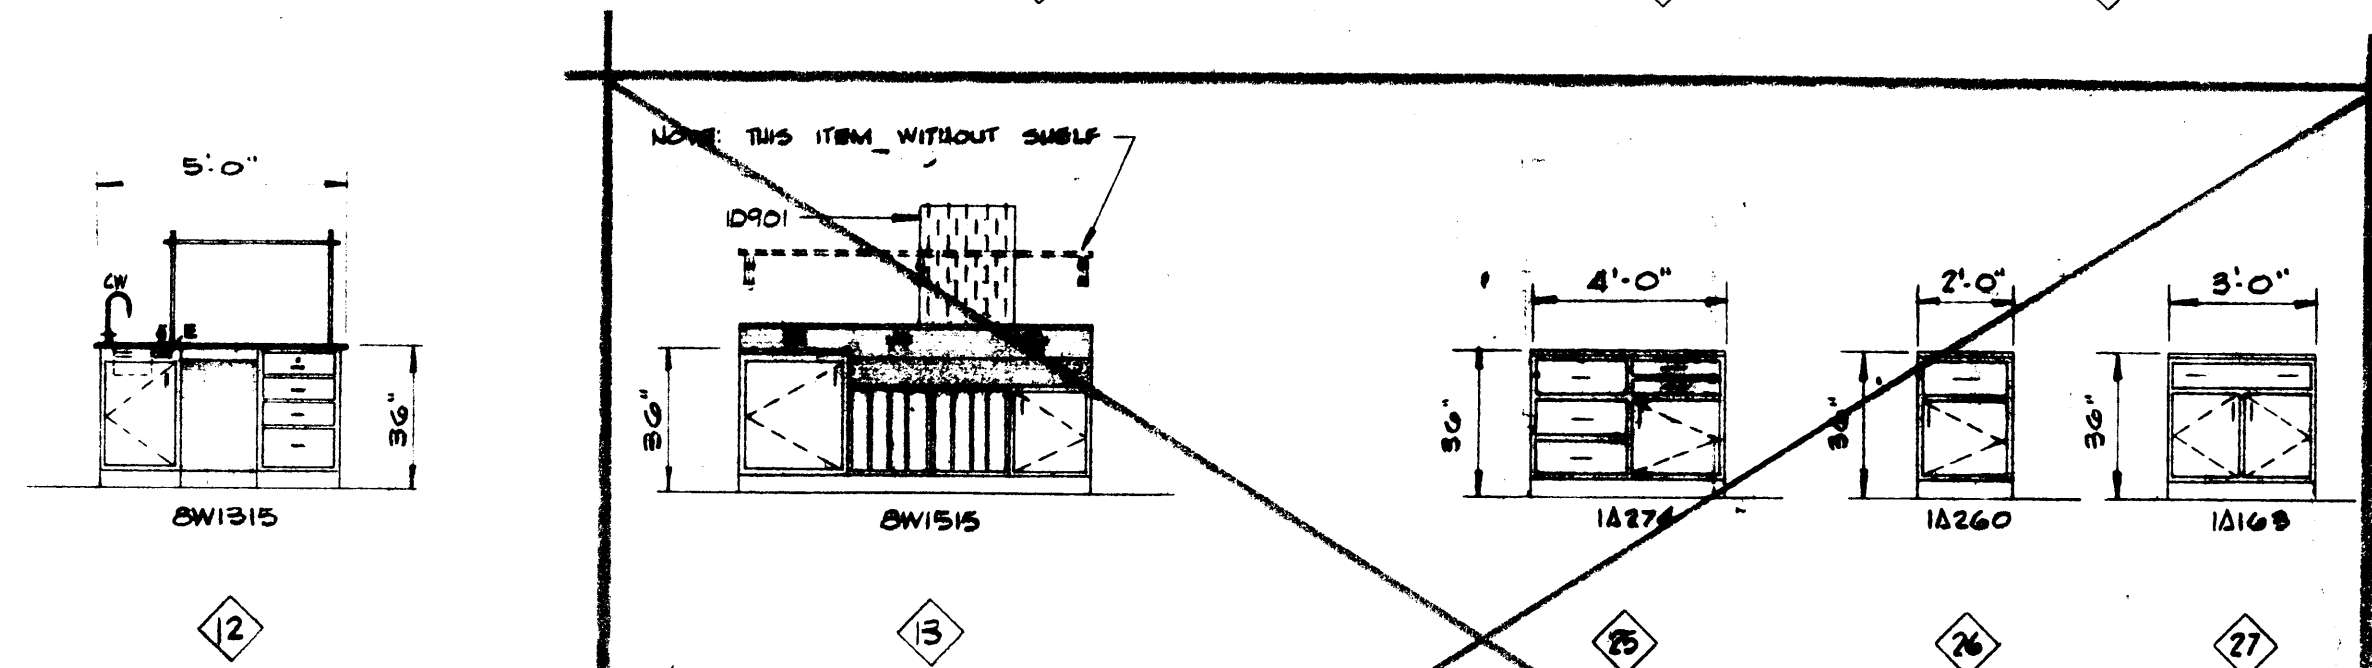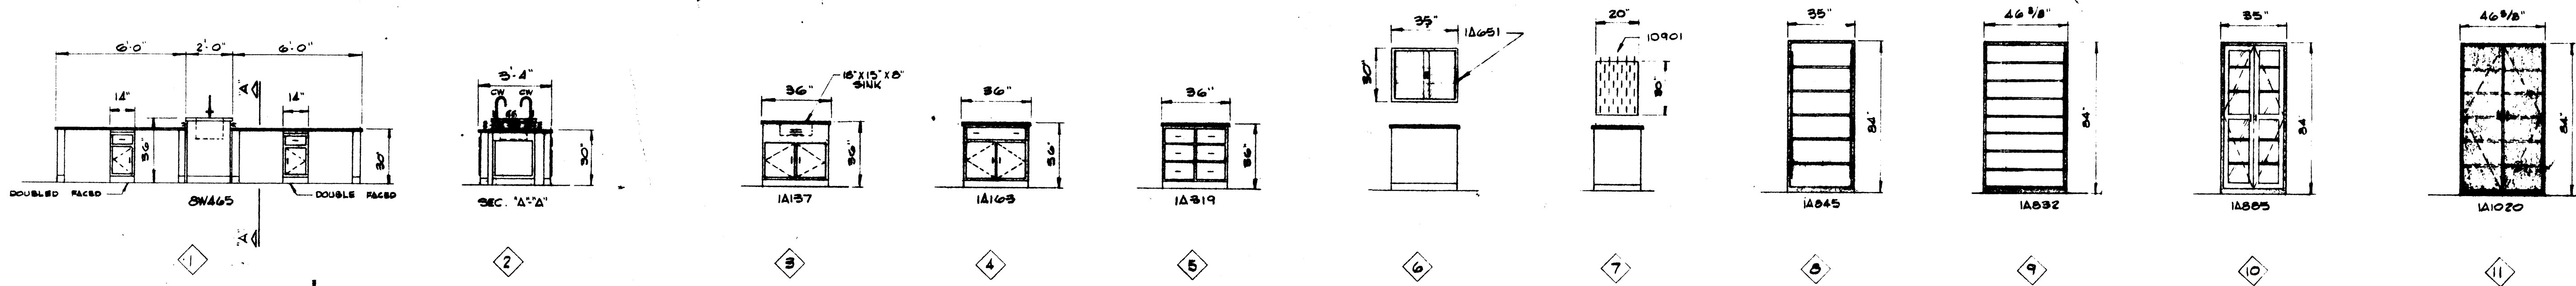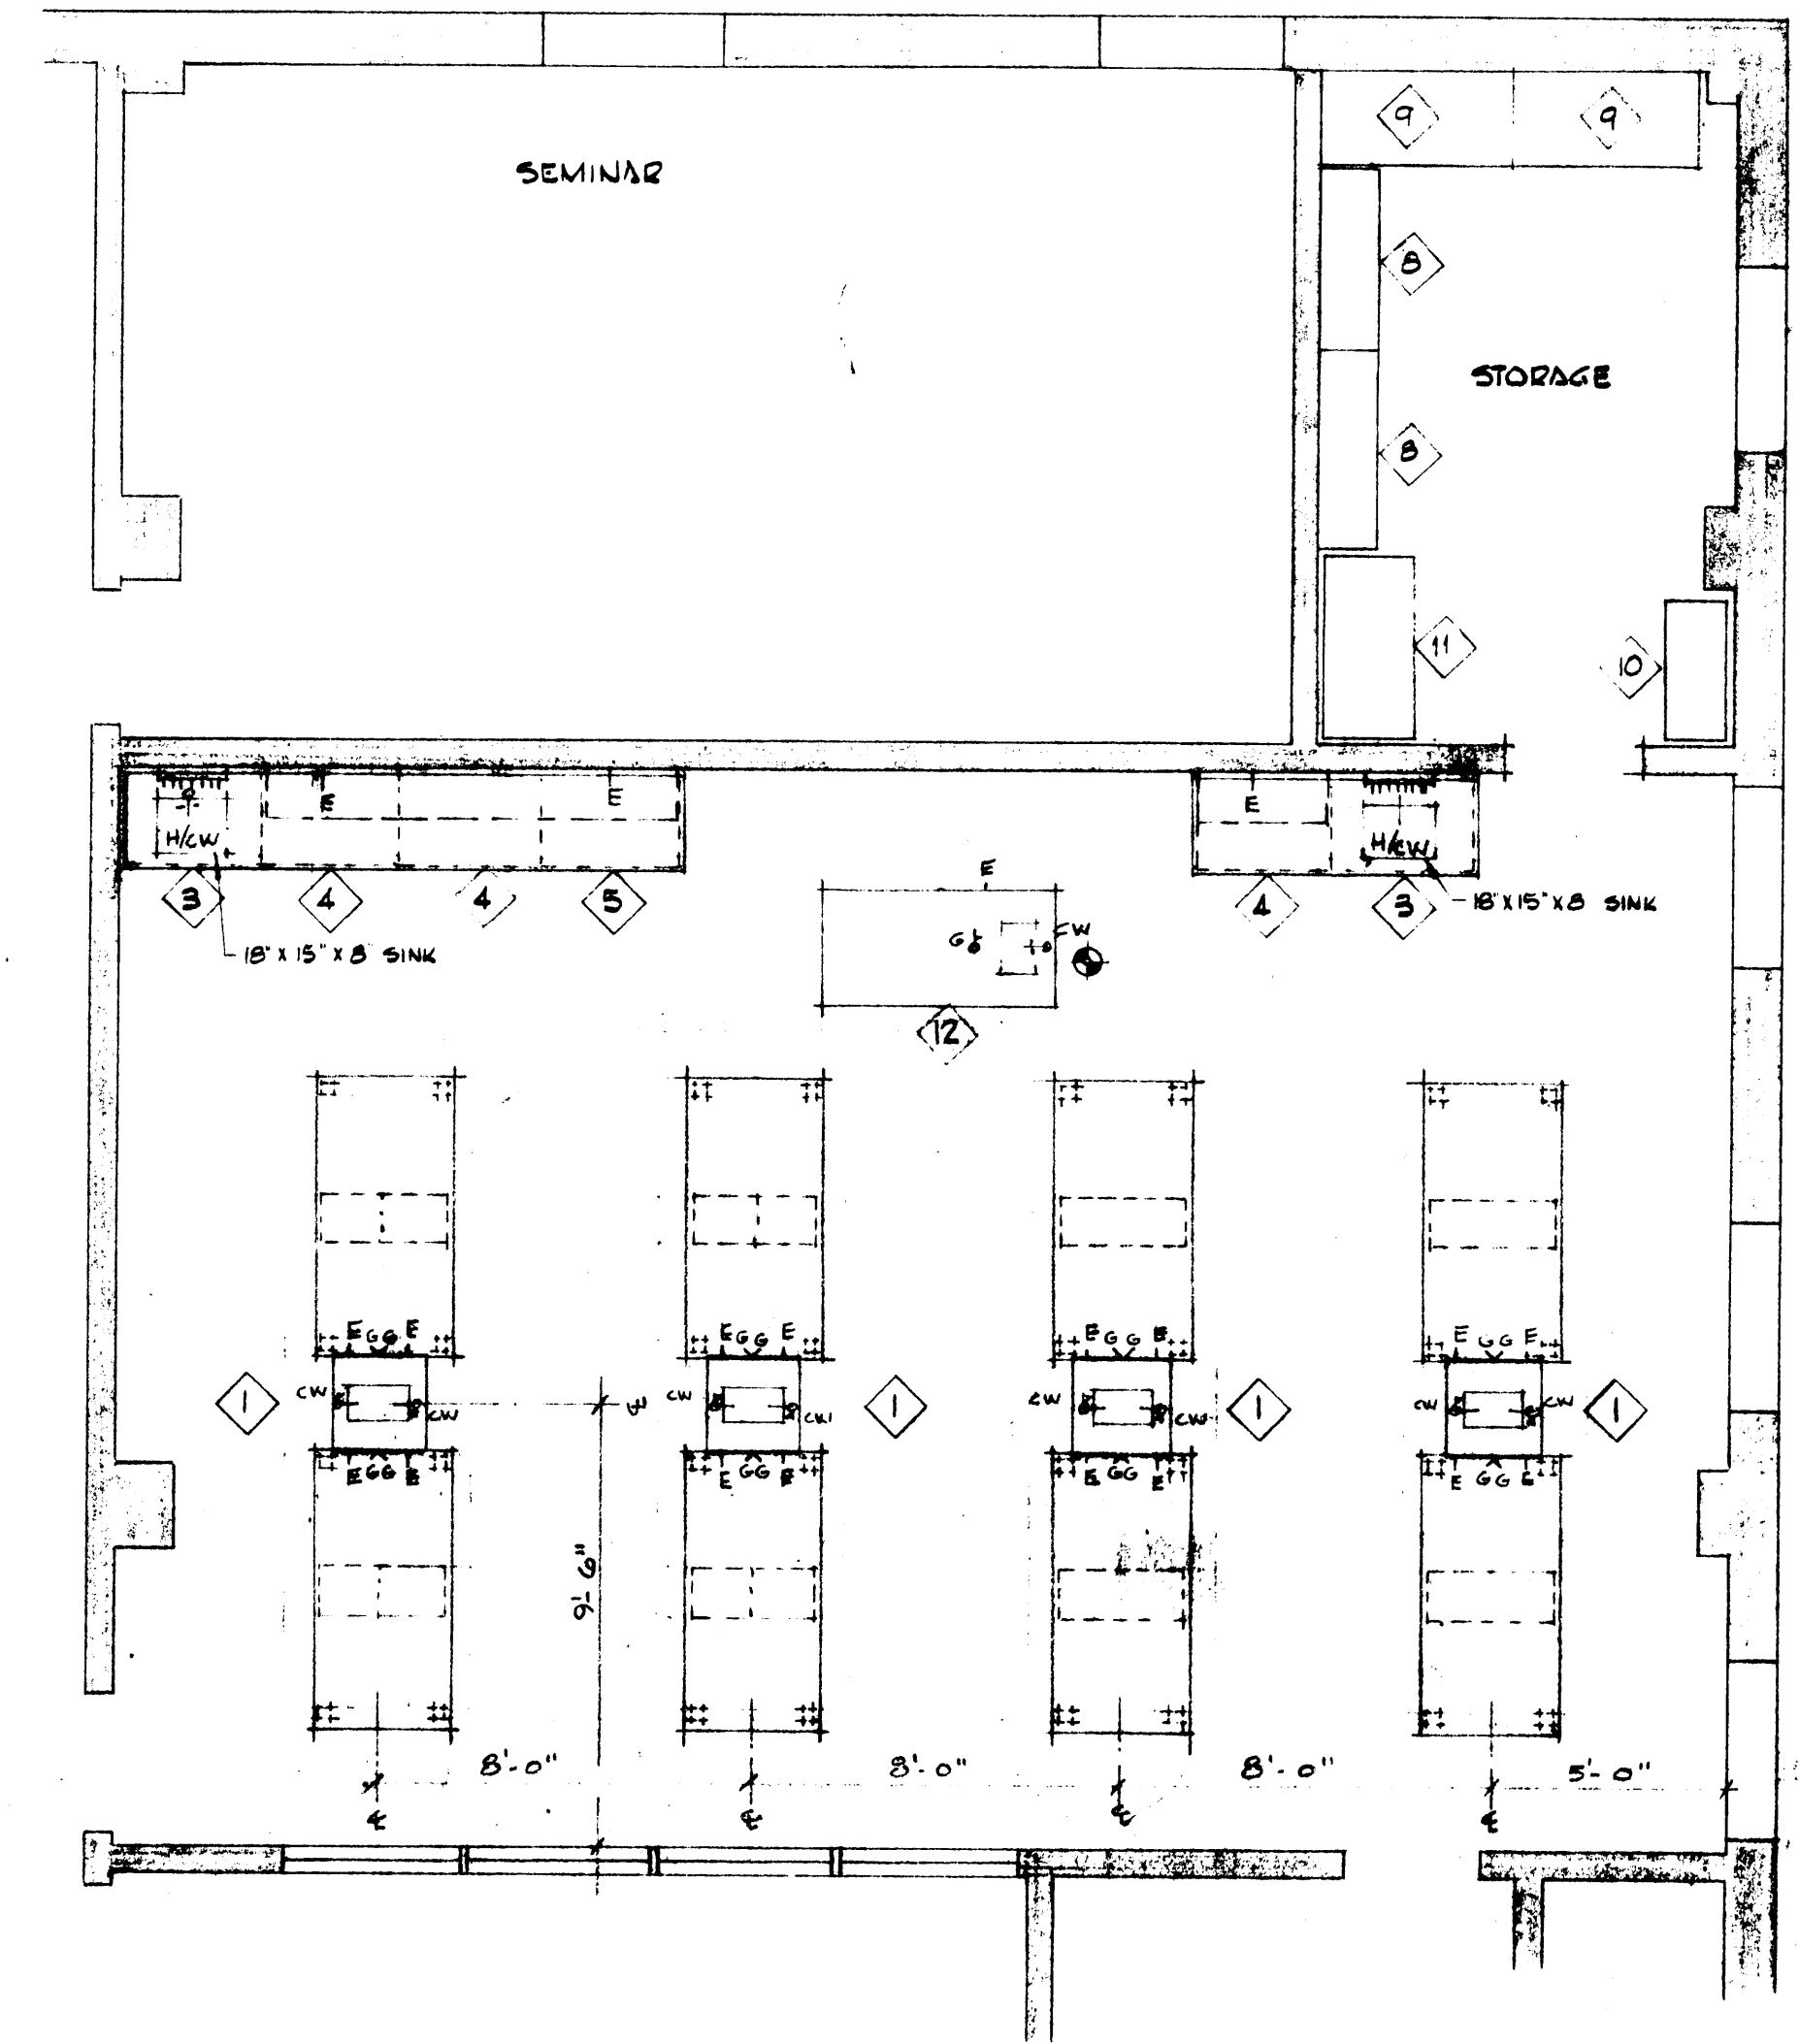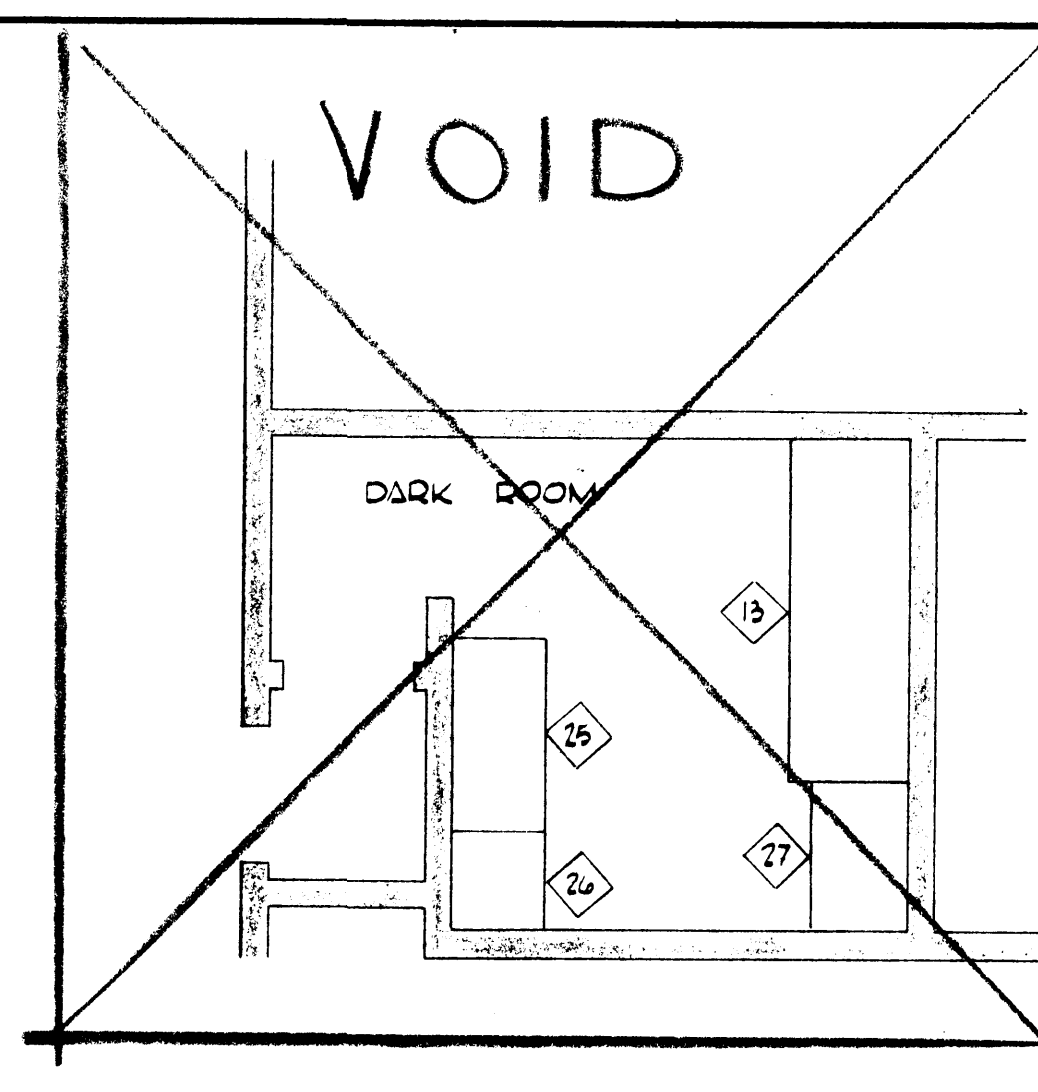


"AS-BUILT" DRAWING
 DATE JUN 10 1970

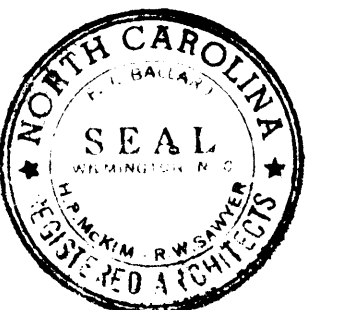


WILMINGTON COLLEGE EDUCATION & PSYCHOLOGY BUILDING
 WILMINGTON, NORTH CAROLINA
 BOARD OF TRUSTEES: L. BRADFORD TILLEY, JR. CHAIRMAN; DR. WILLIAM M. RANDALL, PRESIDENT
 CODE 66737 - ITEM 6
 BALLARD, McKIM, & SAWYER, AIA
 612 SOUTH SEVENTEENTH STREET
 WILMINGTON, NORTH CAROLINA
 7-C-792
 JUN 10 1970
 EQ

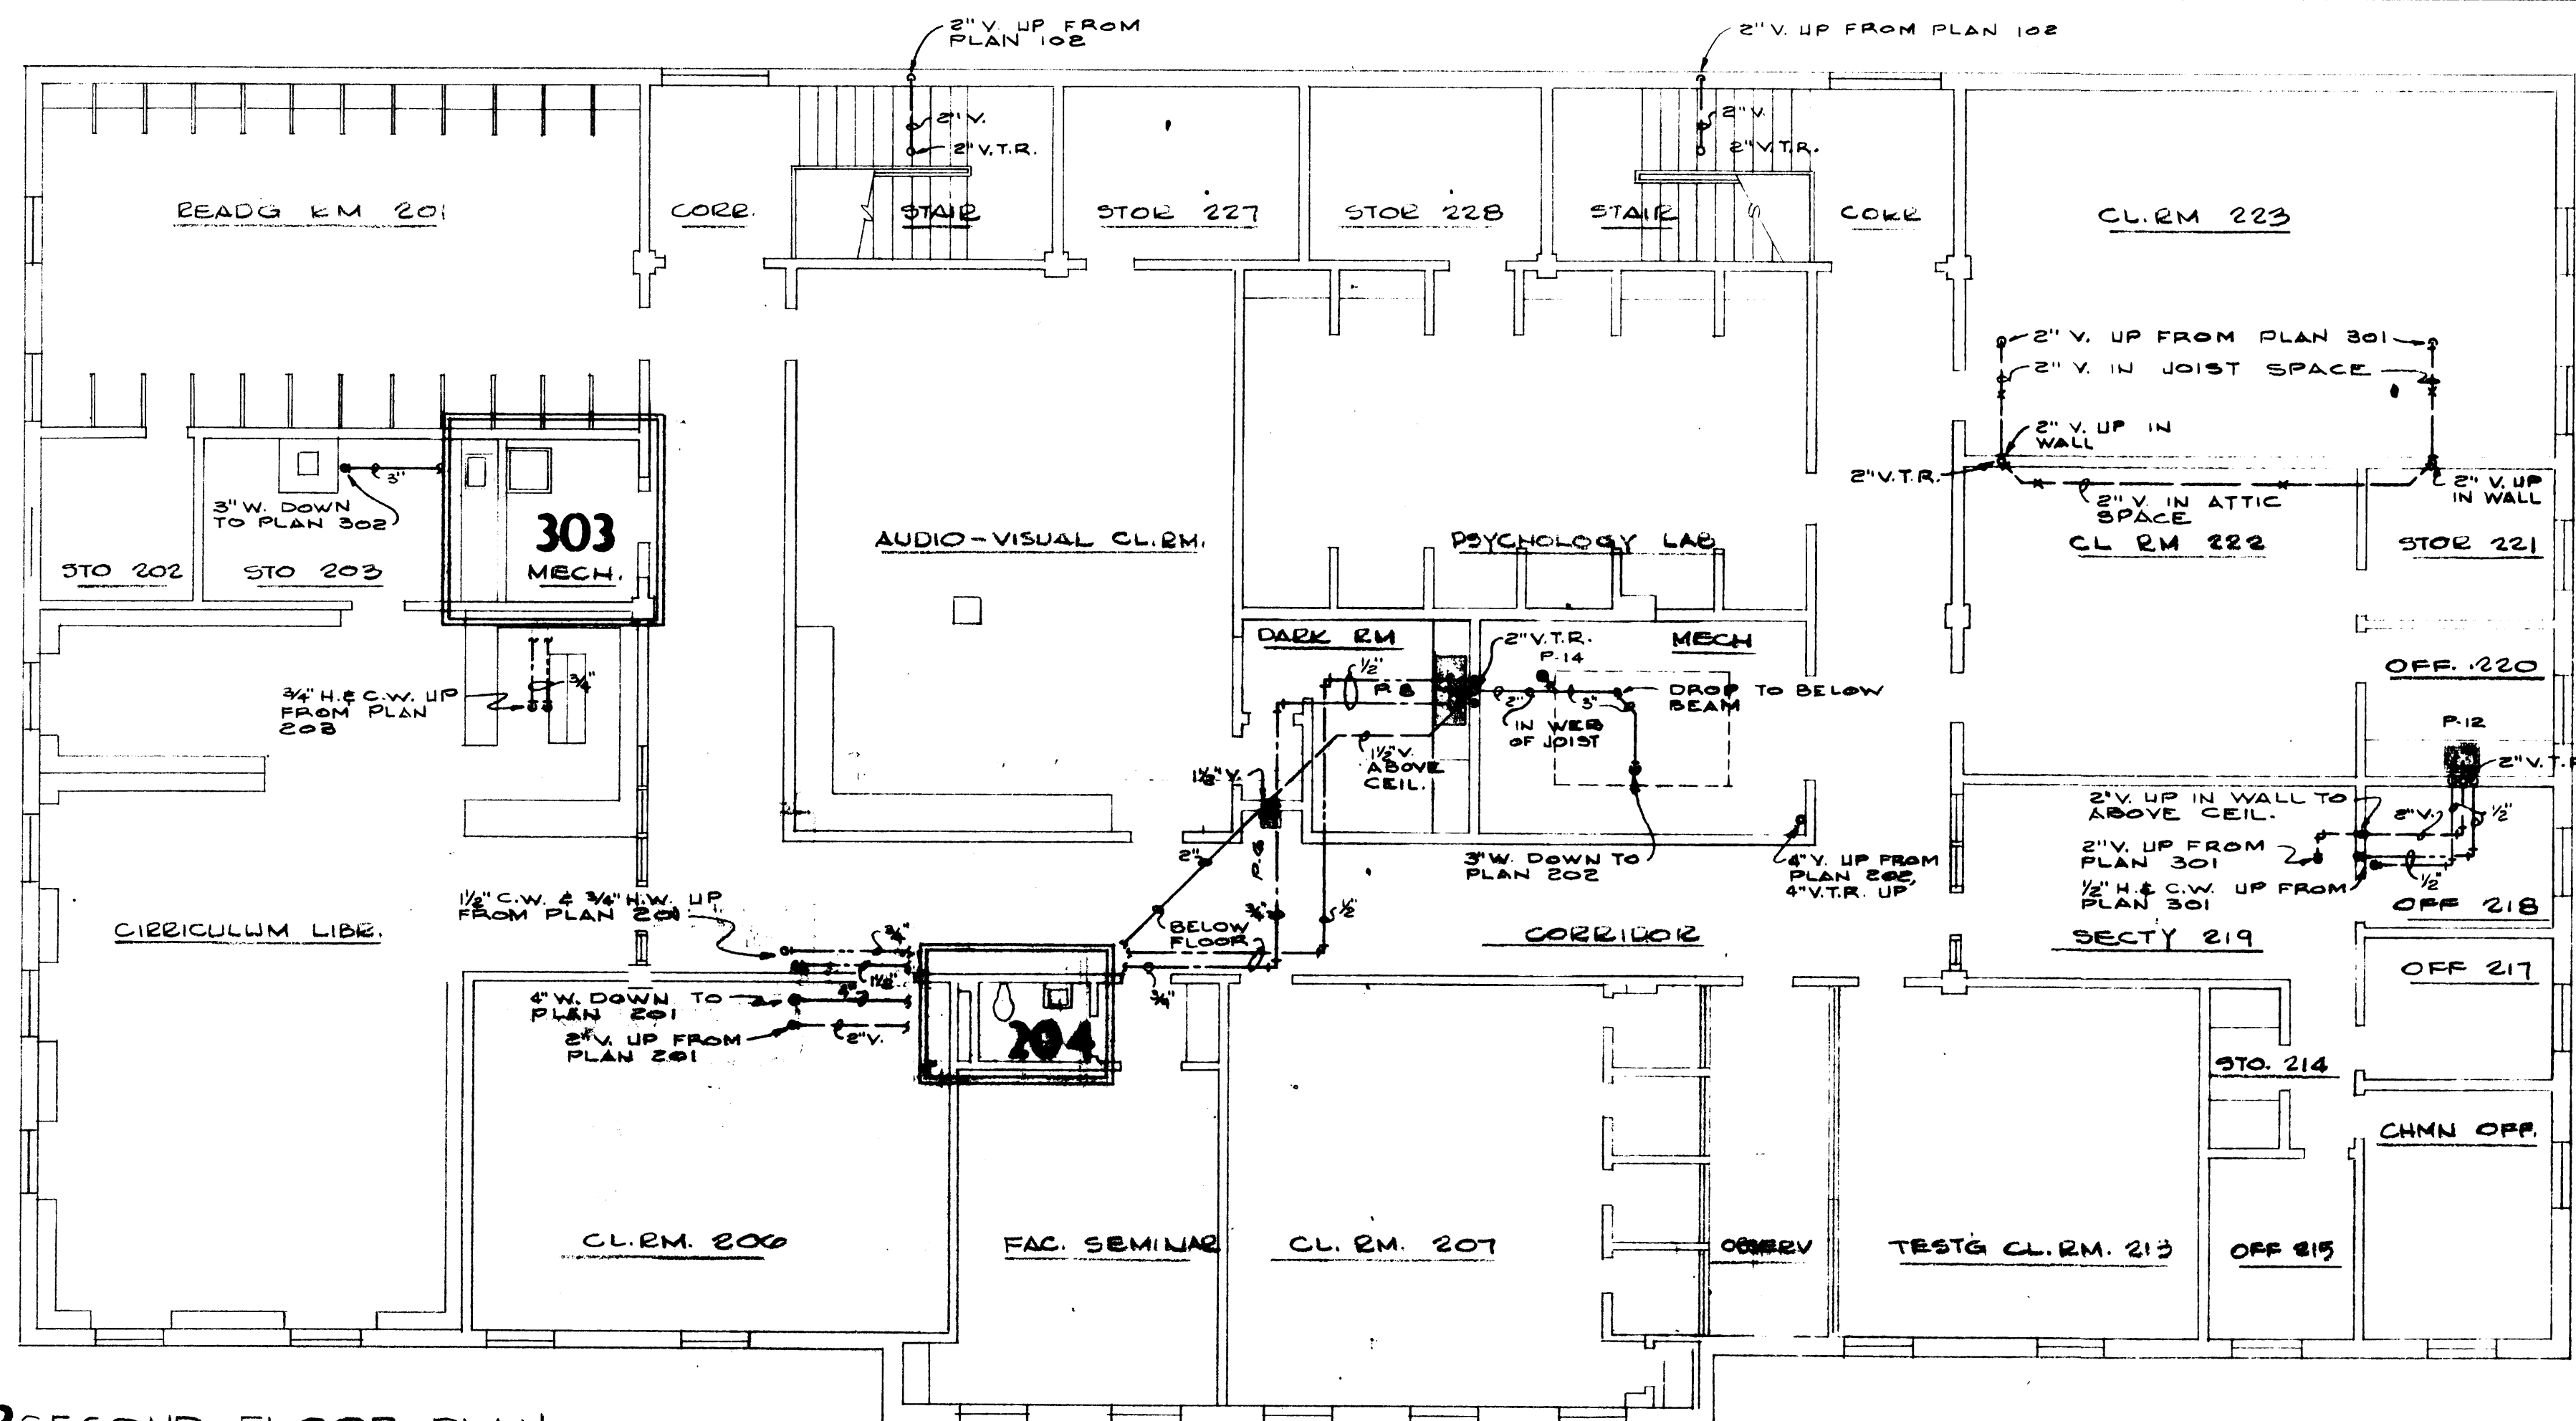

103 SECOND FLOOR PLAN
SCALE: 1/8" = 1'-0"

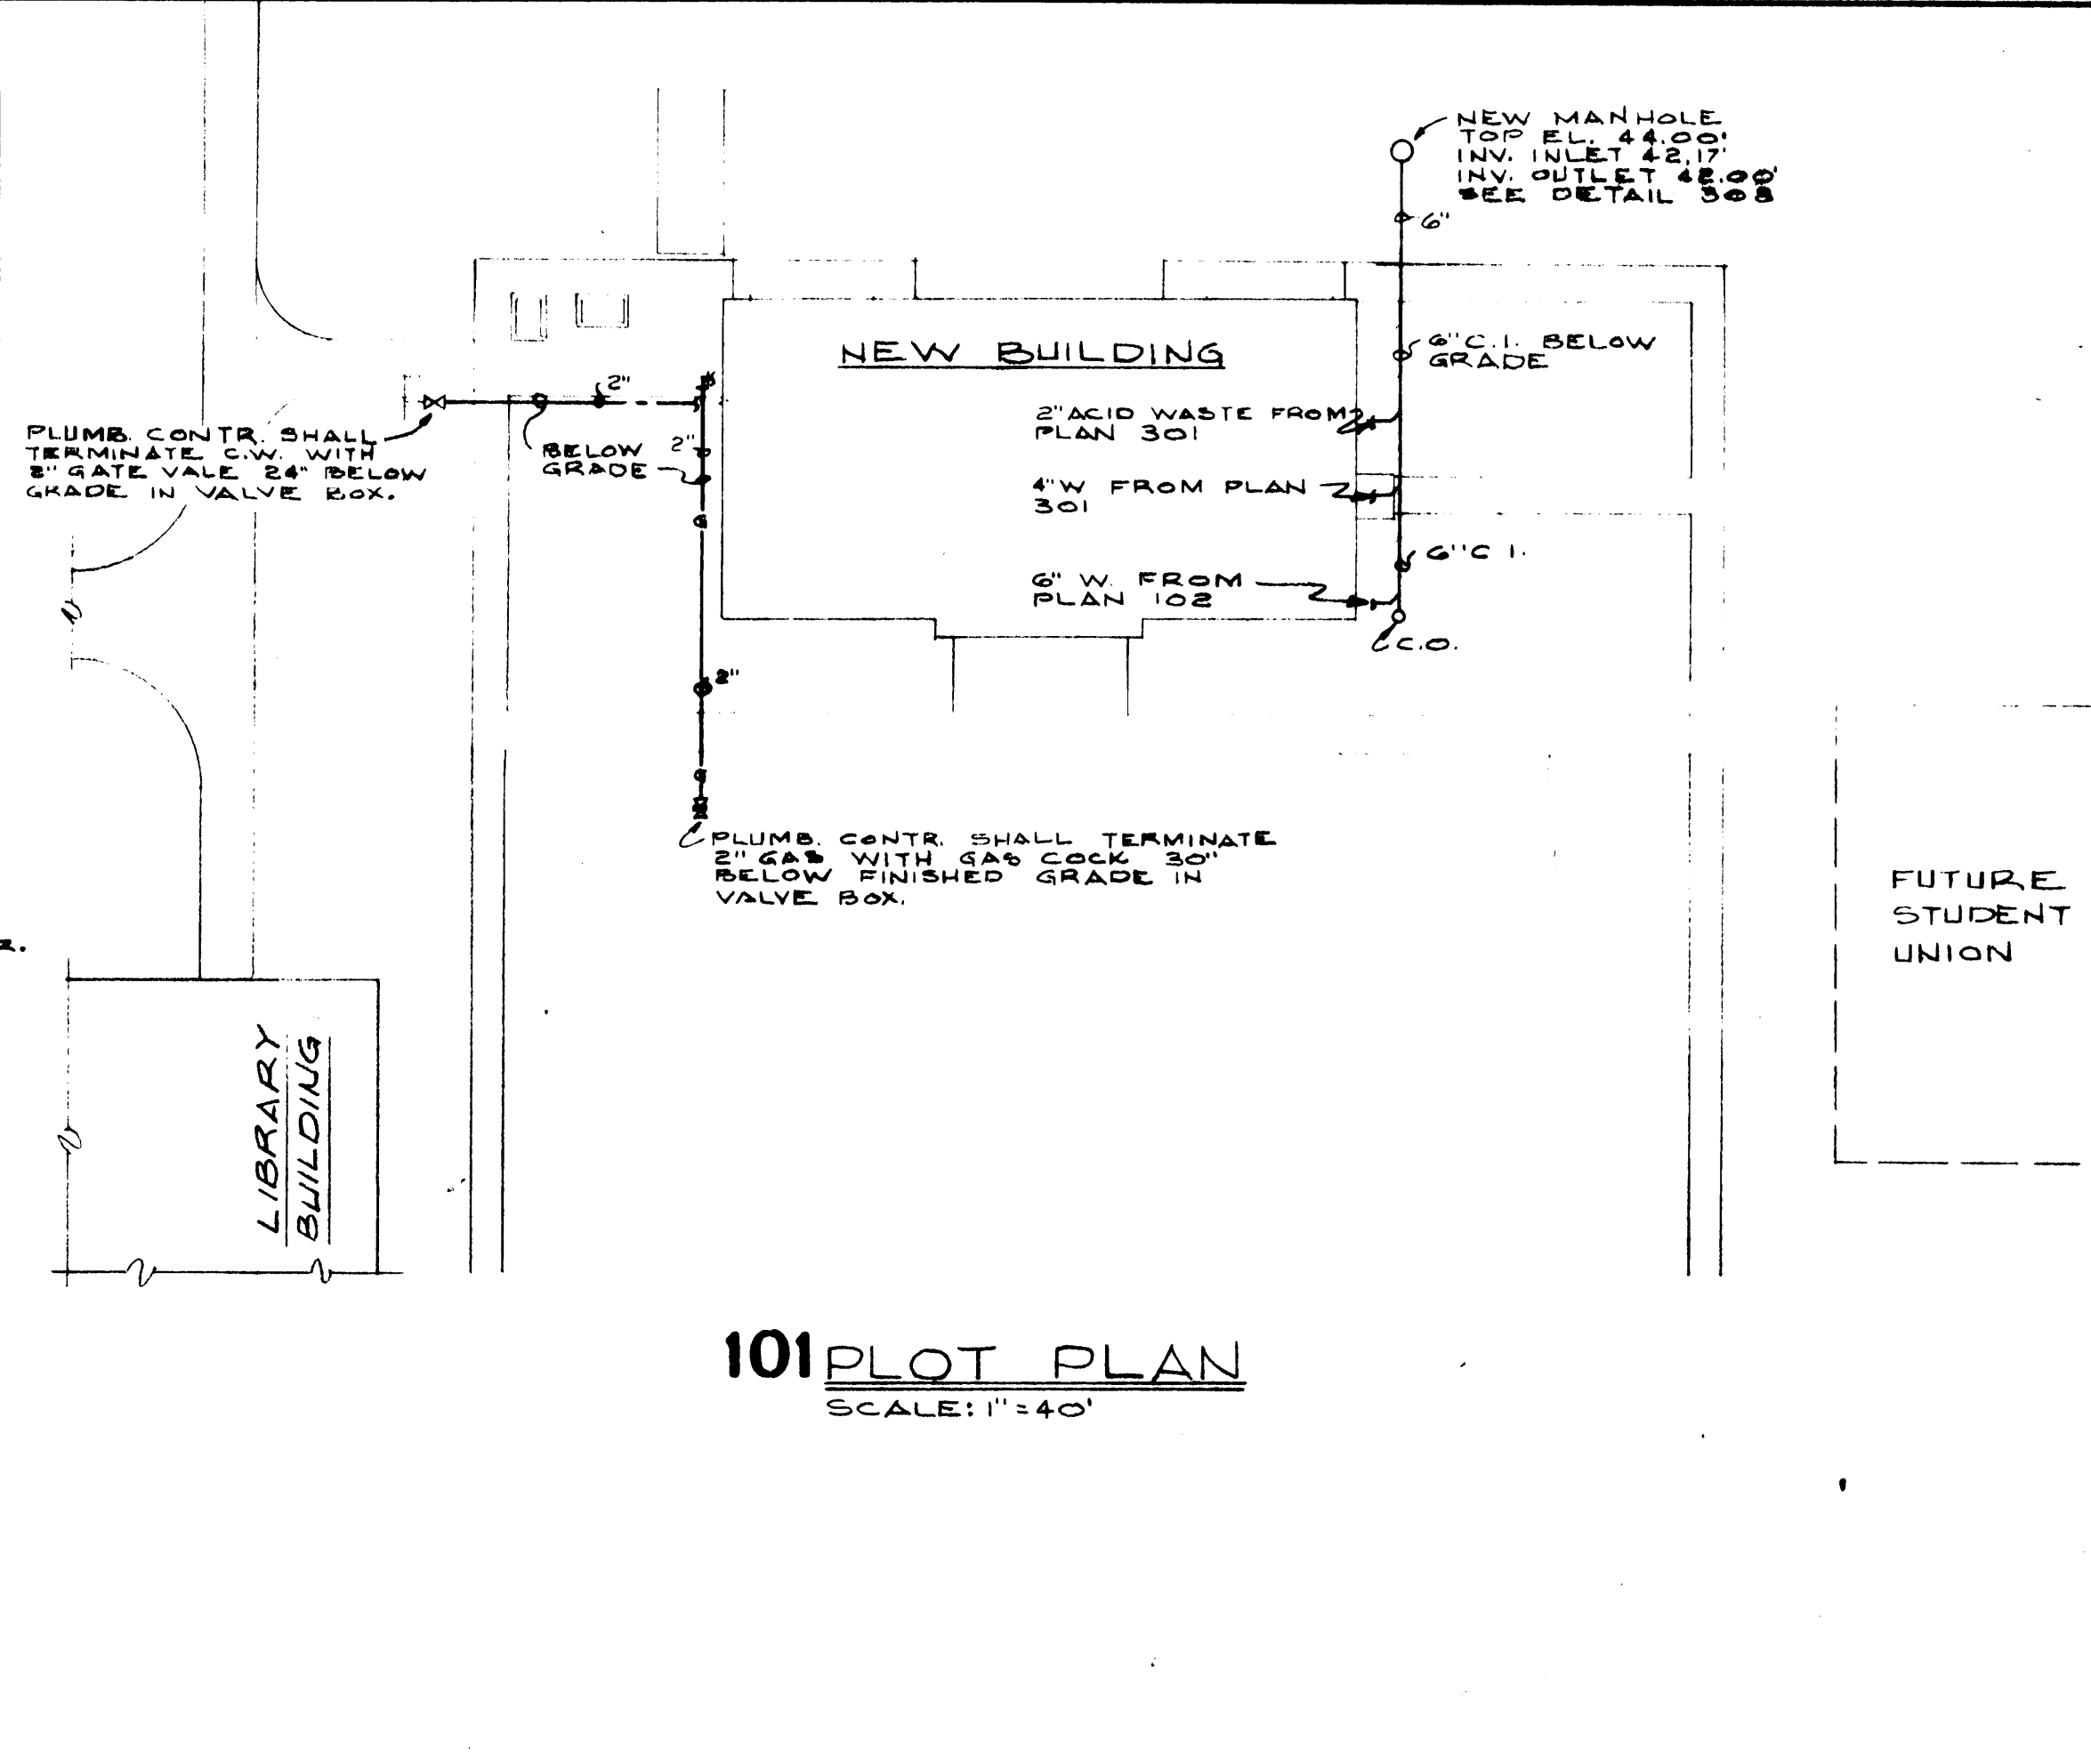

101 PLOT PLAN
SCALE: 1" = 40'

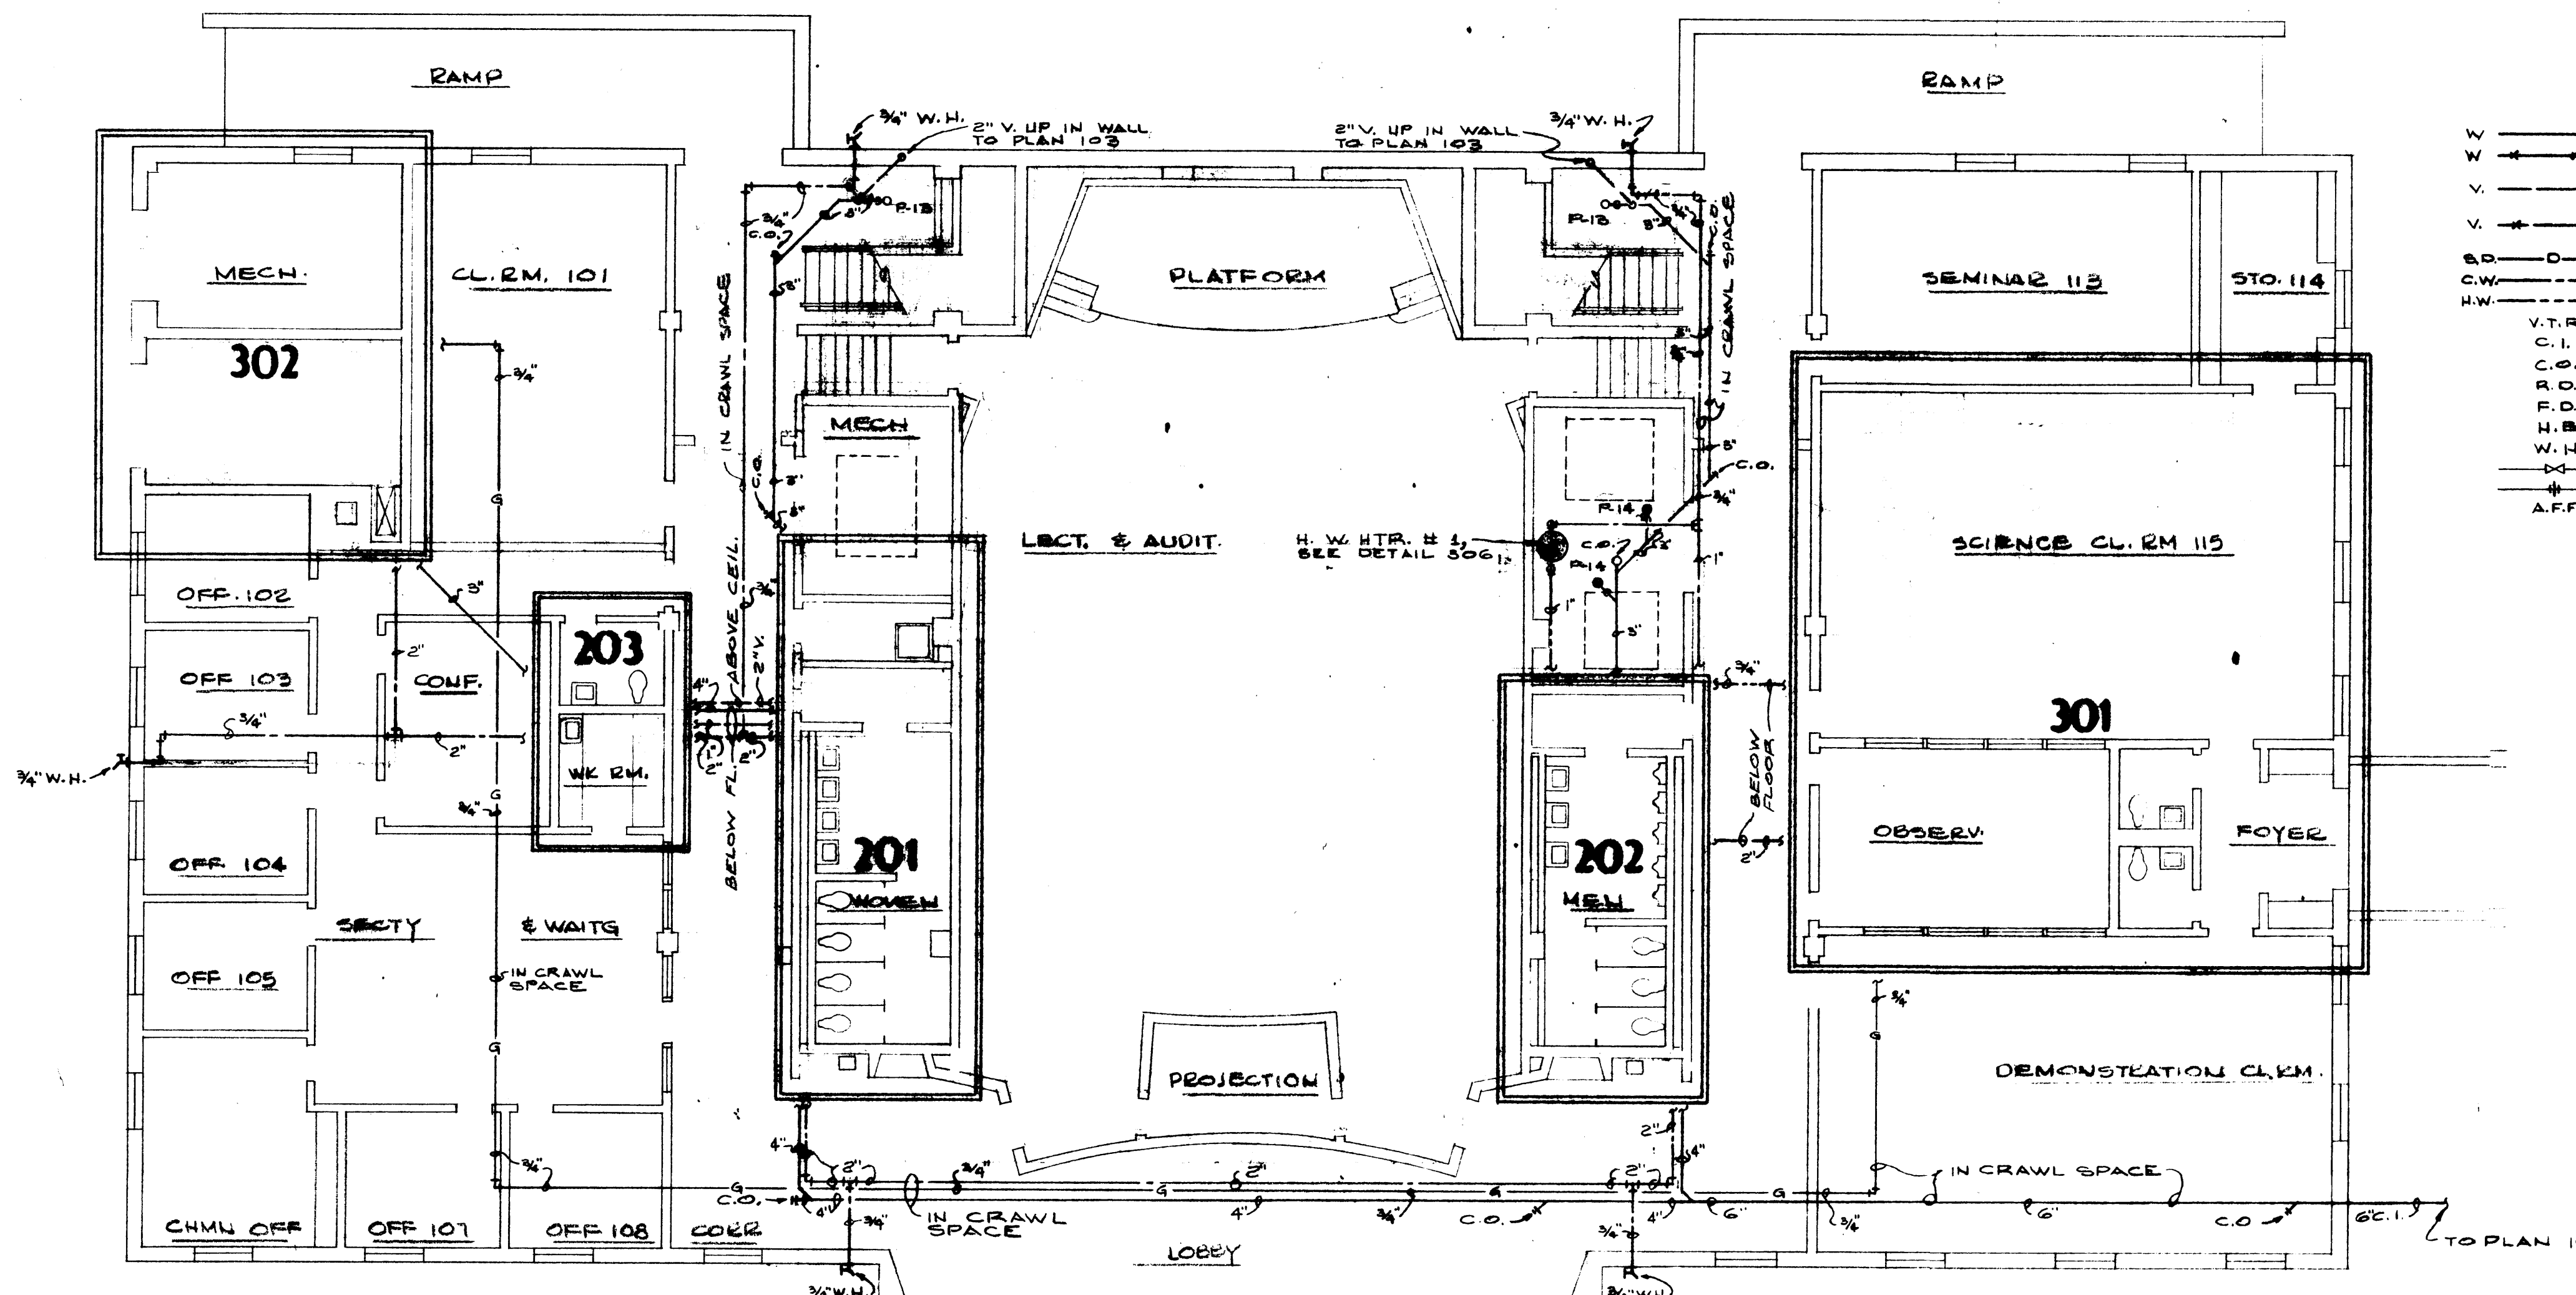

102 FIRST FLOOR PLAN
SCALE: 1/8" = 1'-0"

LEGEND

W — WASTE PIPING (CAST IRON)
 W — WASTE PIPING (HIGH SILICON CAST IRON)
 V — VENT PIPING (SERVICE WEIGHT CAST IRON SYSTEM)
 V — VENT PIPING (HIGH SILICON CAST IRON SYSTEM)
 SD — STORM OR ROOF DRAIN PIPING
 CW — COLD WATER PIPING
 HW — HOT WATER PIPING
 V.T.R. — VENT THRU ROOF
 C.I. — CAST IRON
 C.O. — CLEANOUT
 R.D. — ROOF DRAIN
 F.D. — FLOOR DRAIN
 H.B. — HOSE BIBB
 W.H. — WALL HYDRANT
 G.V. — GATE VALVE
 U — UNION
 A.F.F. — ABOVE FINISHED FLOOR

PLUMBING FIXTURE SCHEDULE

| MARK | DESCRIPTION | WASTE | CW | HW | REMARKS |
|------|--------------------|--------|------|------|--------------------|
| P-1 | WATER CLOSET | 4" | 1" | — | |
| P-2 | URINAL | 2" | 1" | — | |
| P-3 | LAVATORY | 1 1/2" | 1/2" | 1/2" | |
| P-4 | COUNTERTOP SINK | 1 1/2" | 1/2" | 1/2" | |
| P-5 | MOP RECEPTOR | 3" | 1/2" | 1/2" | |
| P-6 | ELEG. WATER COOLER | 1 1/2" | 1/2" | — | |
| P-7 | SCIENCE TABLE | 2" | 3/4" | — | 3/4" GAS |
| P-8 | DARK ROOM SINK | 2" | 1/2" | 1/2" | |
| P-9 | INSTRUCTOR'S DESK | 2" | 1/2" | — | 1/2" GAS |
| P-10 | WORK SINK | 2" | 1/2" | 1/2" | |
| P-11 | WATER CLOSET | 4" | 1" | — | RIM MTD 50" A.F.F. |
| P-12 | WORK SINK/DISPOSAL | 1 1/2" | 1/2" | 1/2" | |
| P-13 | FLOOR DRAIN | 3" | — | — | |
| P-14 | FLOOR DRAIN | 3" | — | — | |
| P-15 | FLOOR DRAIN | 3" | — | — | |

- PLUMBING NOTES:**
- DRAWINGS ARE SCHEMATIC ONLY & ARE NOT INTENDED TO SHOW ALL FITTINGS &/OR OFFSETS REQUIRED OR EXACT LOCATION OF EQUIPMENT.
 - GRADE WASTE PIPING 1/4" PER FOOT WHERE POSSIBLE, 1/8" PER FOOT MINIMUM.
 - PROVIDE SHOCK ARRESTERS AT ALL FIXTURE RUN-OUTS IN ACCORDANCE WITH PDI STANDARD WH-201.
 - PROVIDE AN INDIVIDUAL SHUT-OFF VALVE ON EACH FIXTURE SUPPLY LINE.
 - ALL WATER PIPING BELOW GRADE TO BE TYPE 'K' COPPER & PIPING ABOVE GRADE TO BE TYPE 'L' HARD DRAWN COPPER.
 - INSTALL HOSE BIBBS 18" ABOVE FINISHED FLOOR.
 - ALL WASTE, VENT & WATER PIPING TO BE RUN CONCEALED UNLESS NOTED OTHERWISE.
 - ALL FLOOR DRAINS ARE 3" INSIDE CAULK UNLESS NOTED OTHERWISE.
 - INSTALL WALL HYDRANTS 18" ABOVE FINISHED GRADE.


TOTAL CONNECTED LOAD
 194 FIXTURE UNITS WASTE
 87 GPM COLD WATER DEMAND

"AS-BUILT" DRAWING
 DATE JUN 10 1974



HENRY VON OESSEN & ASSOCIATES
 CONSULTING ENGINEERS
 412 SOUTH SEVENTH STREET
 WILMINGTON, NORTH CAROLINA


THE PLANS ARE THE PROPERTY OF HENRY VON OESSEN & ASSOCIATES, CONSULTING ENGINEERS. NO PART OF THESE PLANS ARE TO BE REPRODUCED OR TRANSMITTED IN ANY FORM OR BY ANY MEANS, ELECTRONIC OR MECHANICAL, WITHOUT THE WRITTEN CONSENT OF HENRY VON OESSEN & ASSOCIATES.
WILMINGTON COLLEGE EDUCATION & PSYCHOLOGY BUILDING
 WILMINGTON, NORTH CAROLINA
 BOARD OF TRUSTEES - L. BRADFORD TILLEY, JR. CHAIRMAN - DR. WILLIAM M. RANDALL, PRESIDENT
 CODE 6673 - ITEM 6

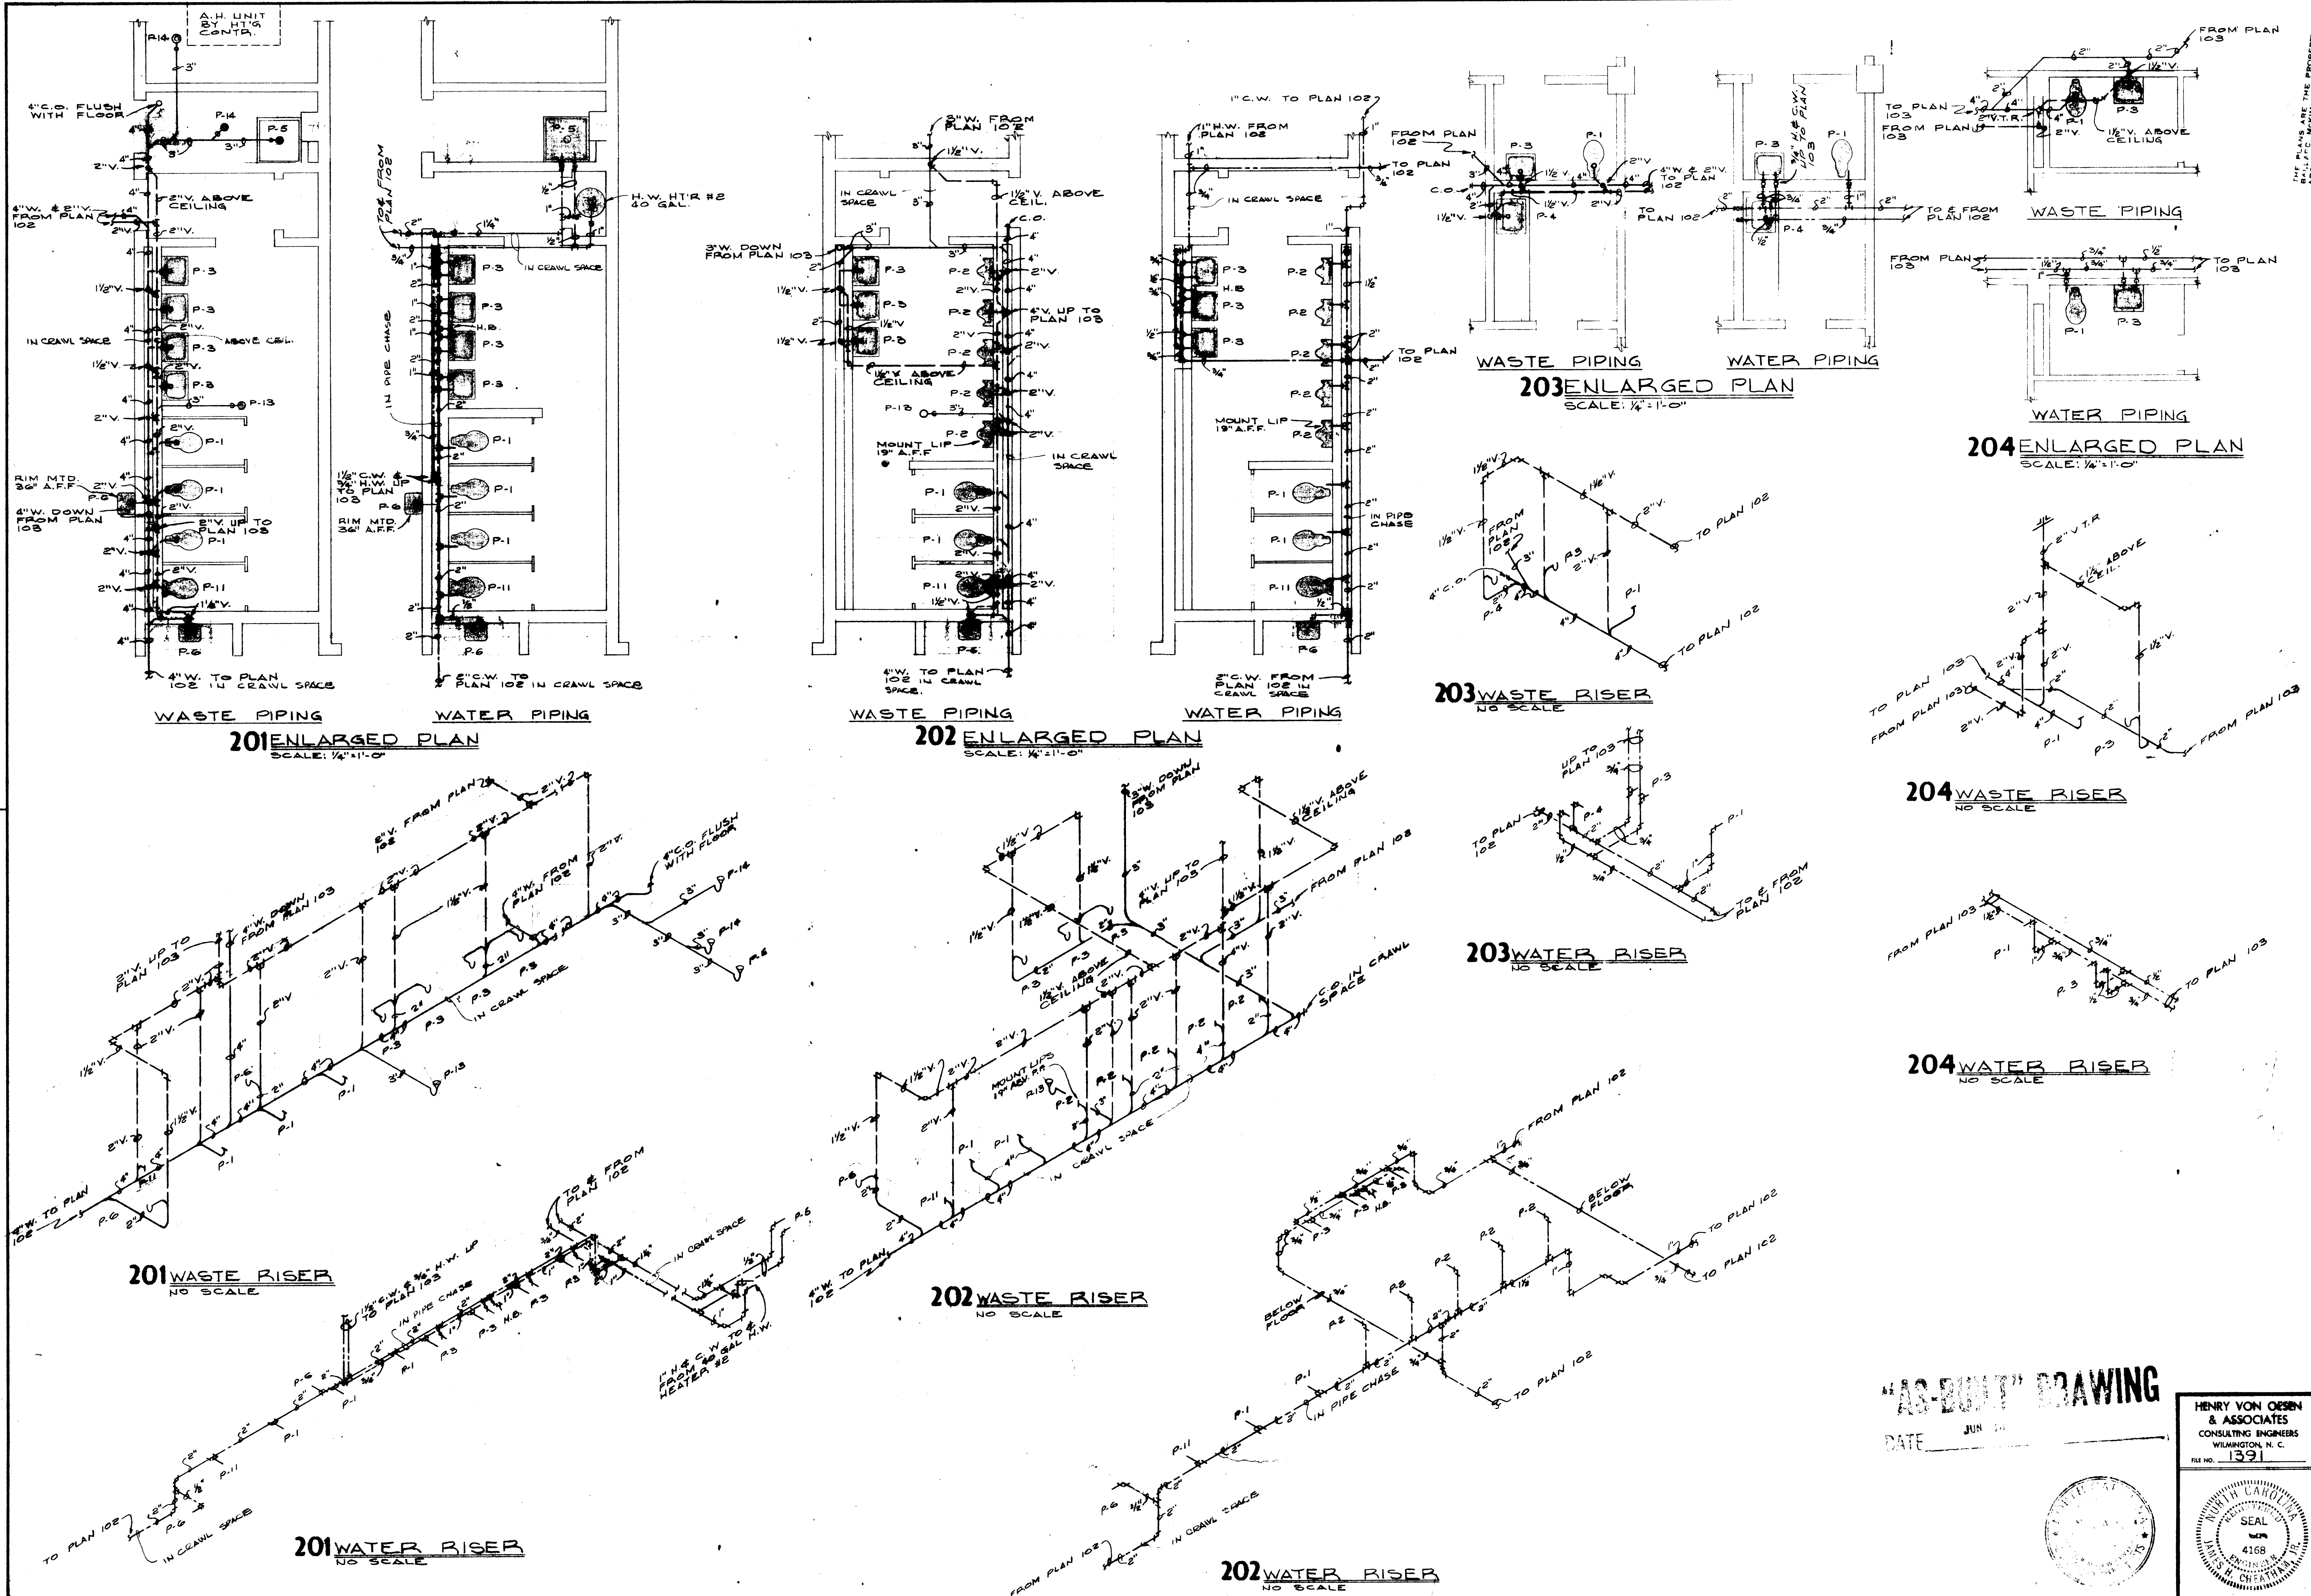


REVISIONS
 THE PLANS ARE THE PROPERTY OF HENRY VON OESSEN & ASSOCIATES, CONSULTING ENGINEERS, WILMINGTON, NORTH CAROLINA. ANY REVISIONS MUST BE MADE BY THE ARCHITECT.
 WILMINGTON COLLEGE EDUCATION & PSYCHOLOGY BUILDING
 WILMINGTON, NORTH CAROLINA
 BOARD OF TRUSTEES - L. BRADFORD TILLERY, JR., CHAIRMAN - DR. WILLIAM M. RANDALL, PRESIDENT
 CODE 66737 - ITEM 6

"AS-BUILT" DRAWING
 DATE JUN 11 1968


HENRY VON OESSEN & ASSOCIATES
 CONSULTING ENGINEERS
 WILMINGTON, N. C.
 FILE NO. 1391

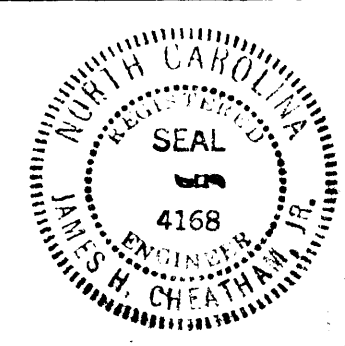


DRAWN BY: J.S.V.
 CHECKED BY: J.S.V.
 DATE: JUN 11 1968
 SHEET NO. P-2
 OF 5

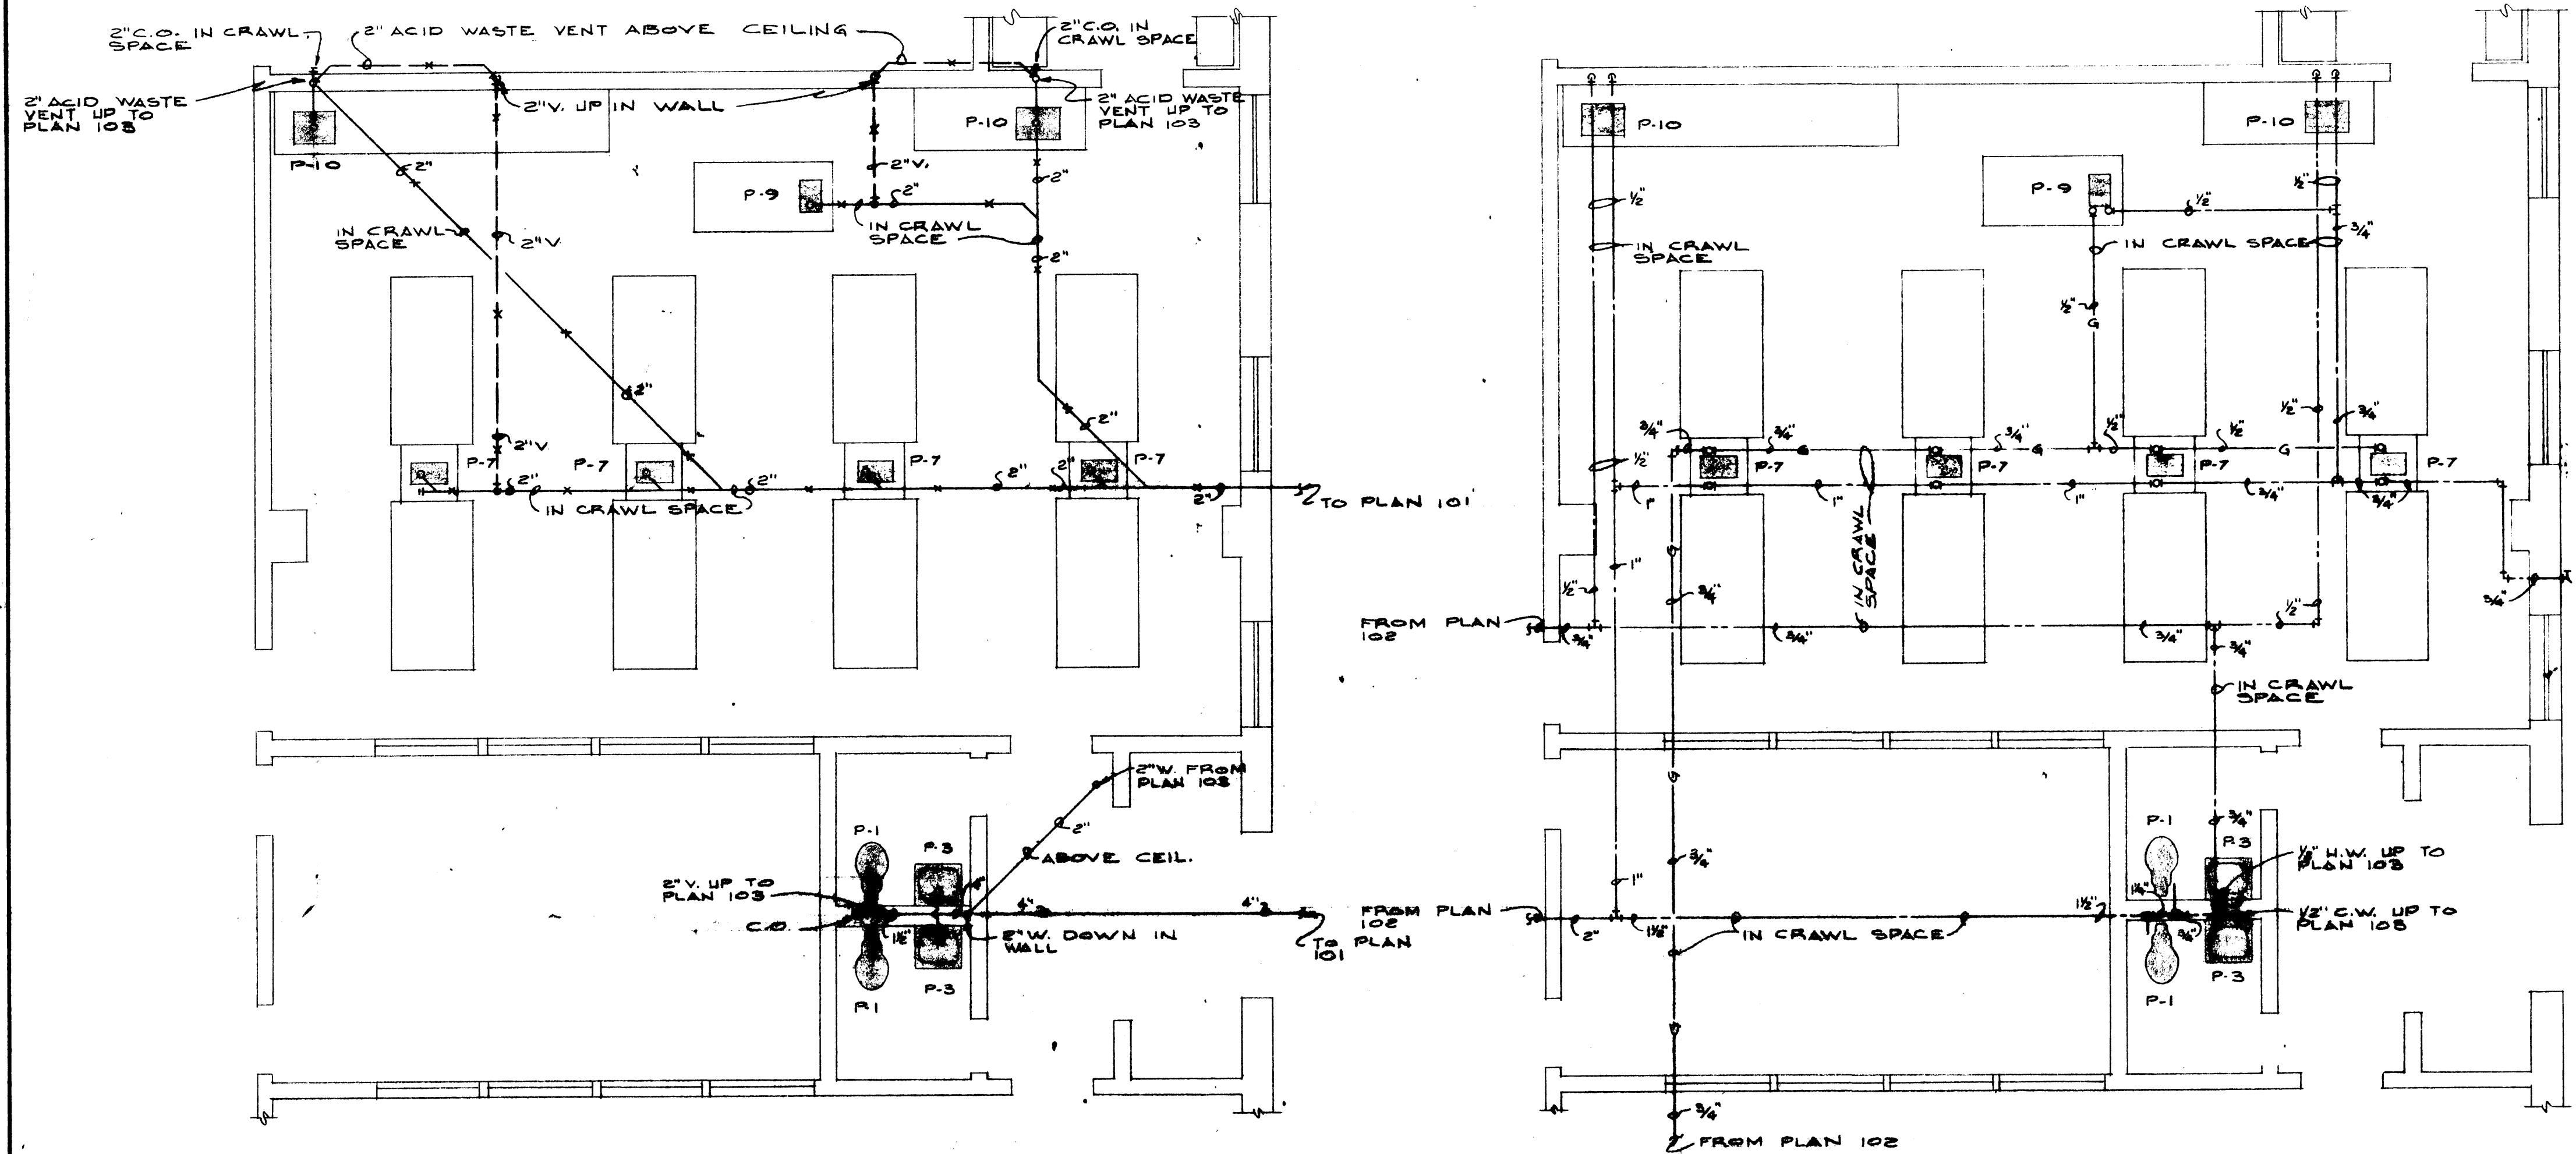

301 ENLARGED SCIENCE AREA PLAN
SCALE: 1/4" = 1'-0"

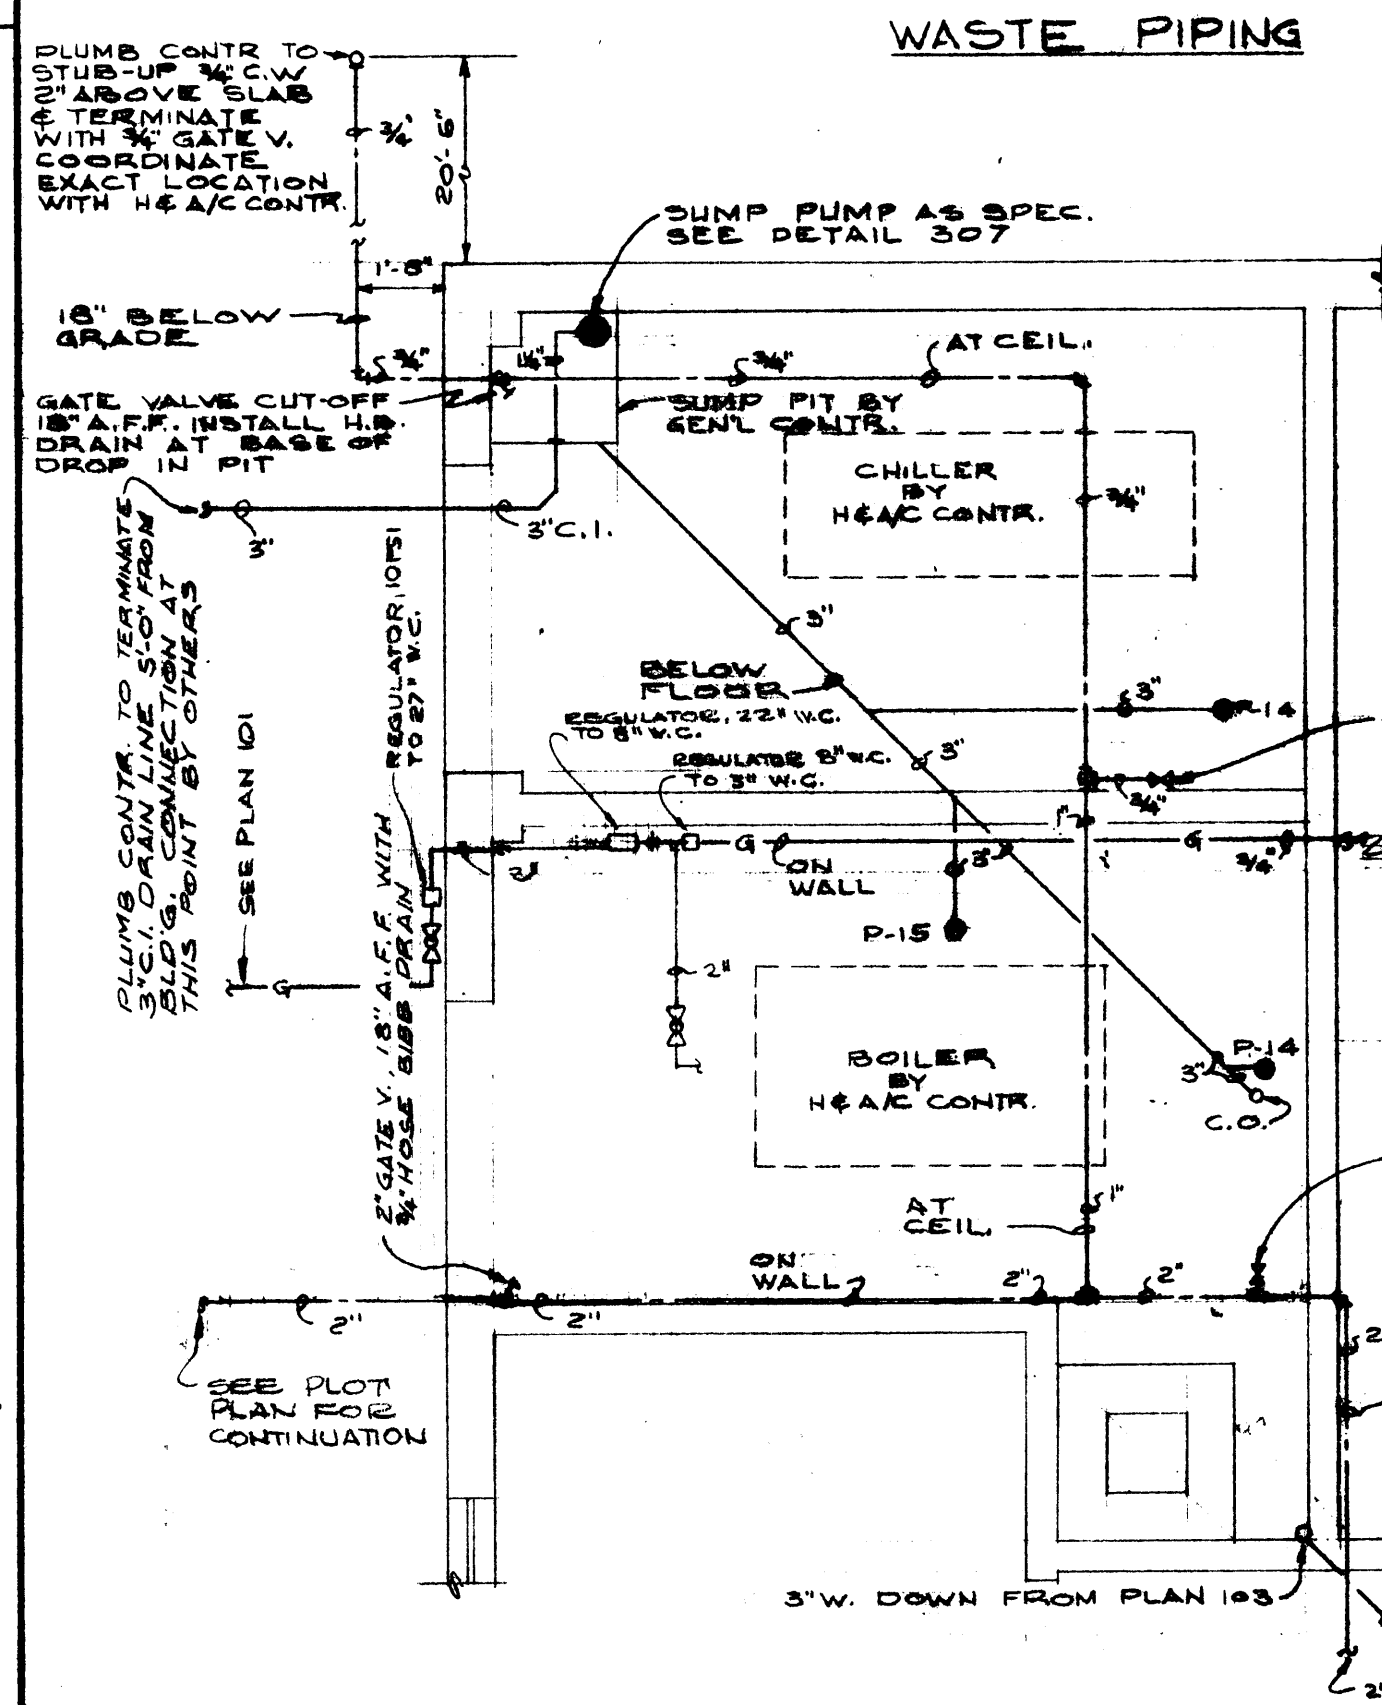


302 ENLARGED PLAN
SCALE: 1/4" = 1'-0"

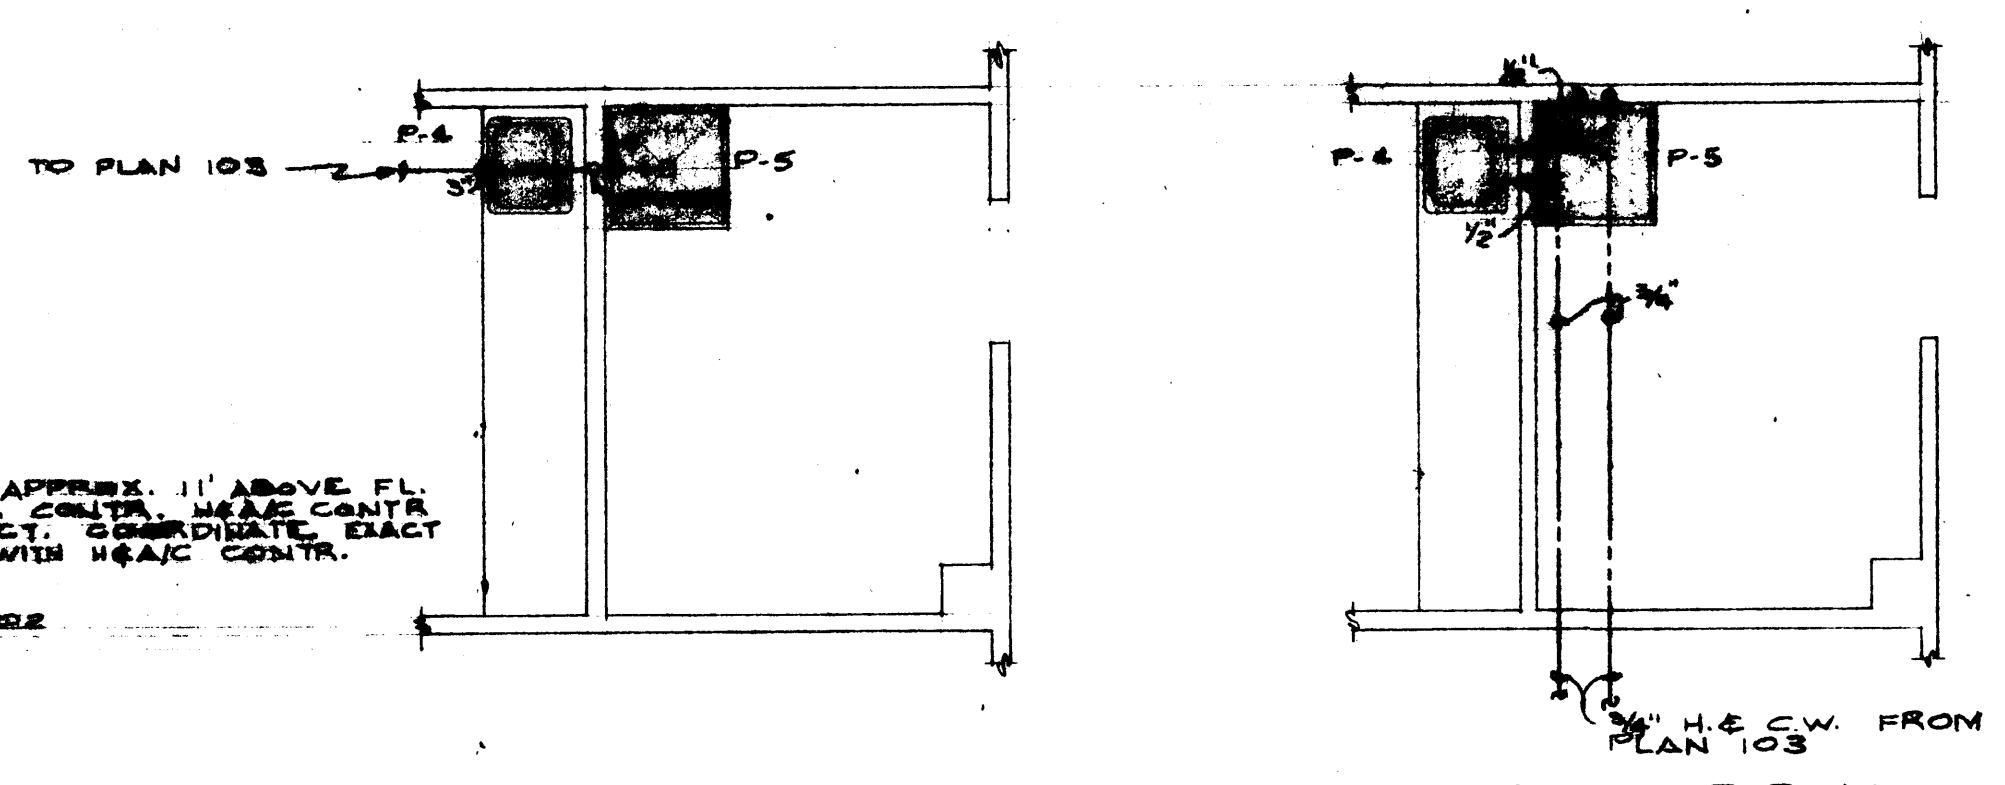


303 ENLARGED PLAN
SCALE: 1/4" = 1'-0"


307 SUMP PUMP PIPING DETAIL
NO SCALE

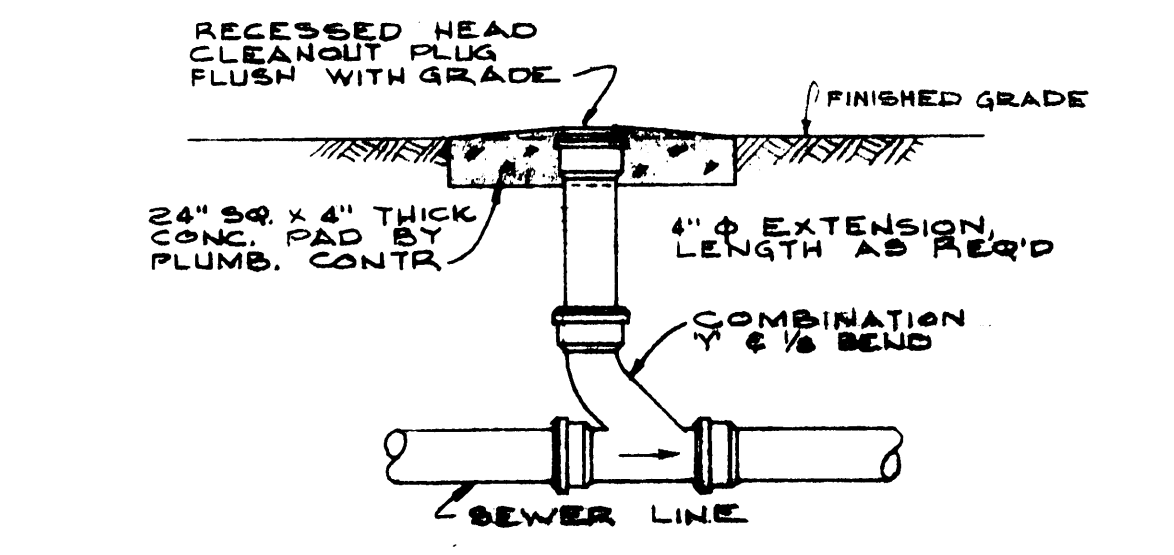



304 EXTERIOR CLEANOUT DETAIL
NO SCALE

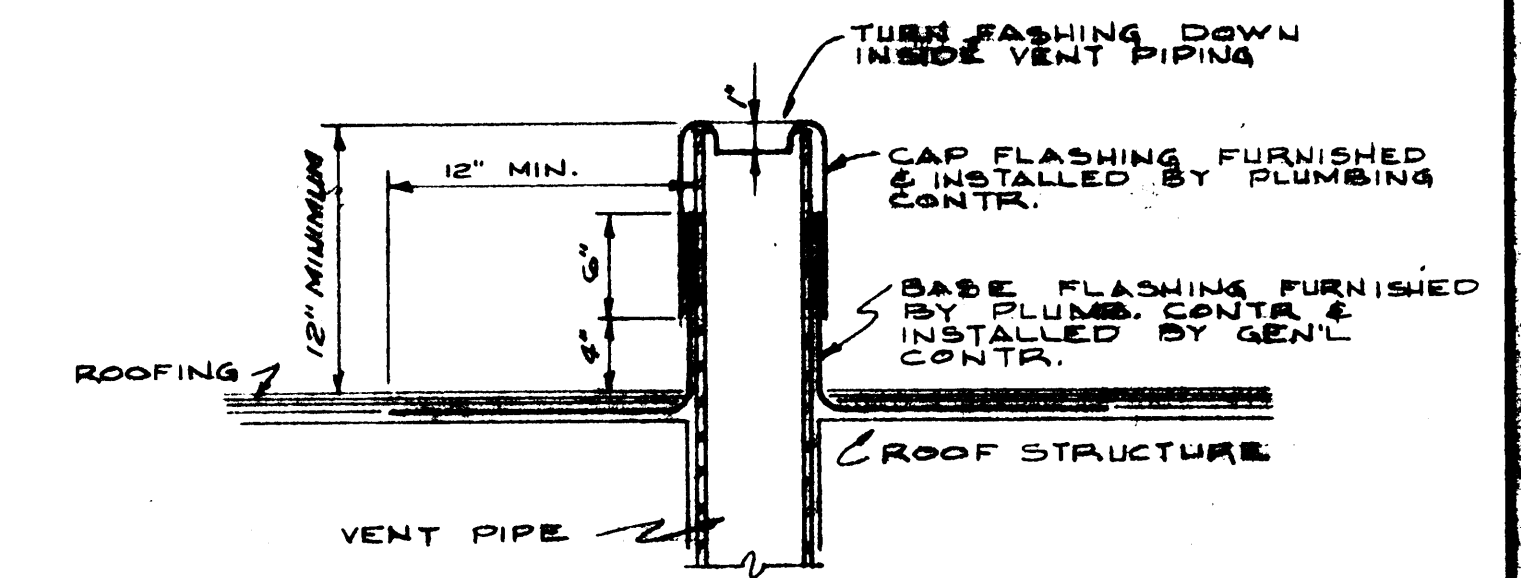

305 VENT FLASHING DETAIL
NO SCALE

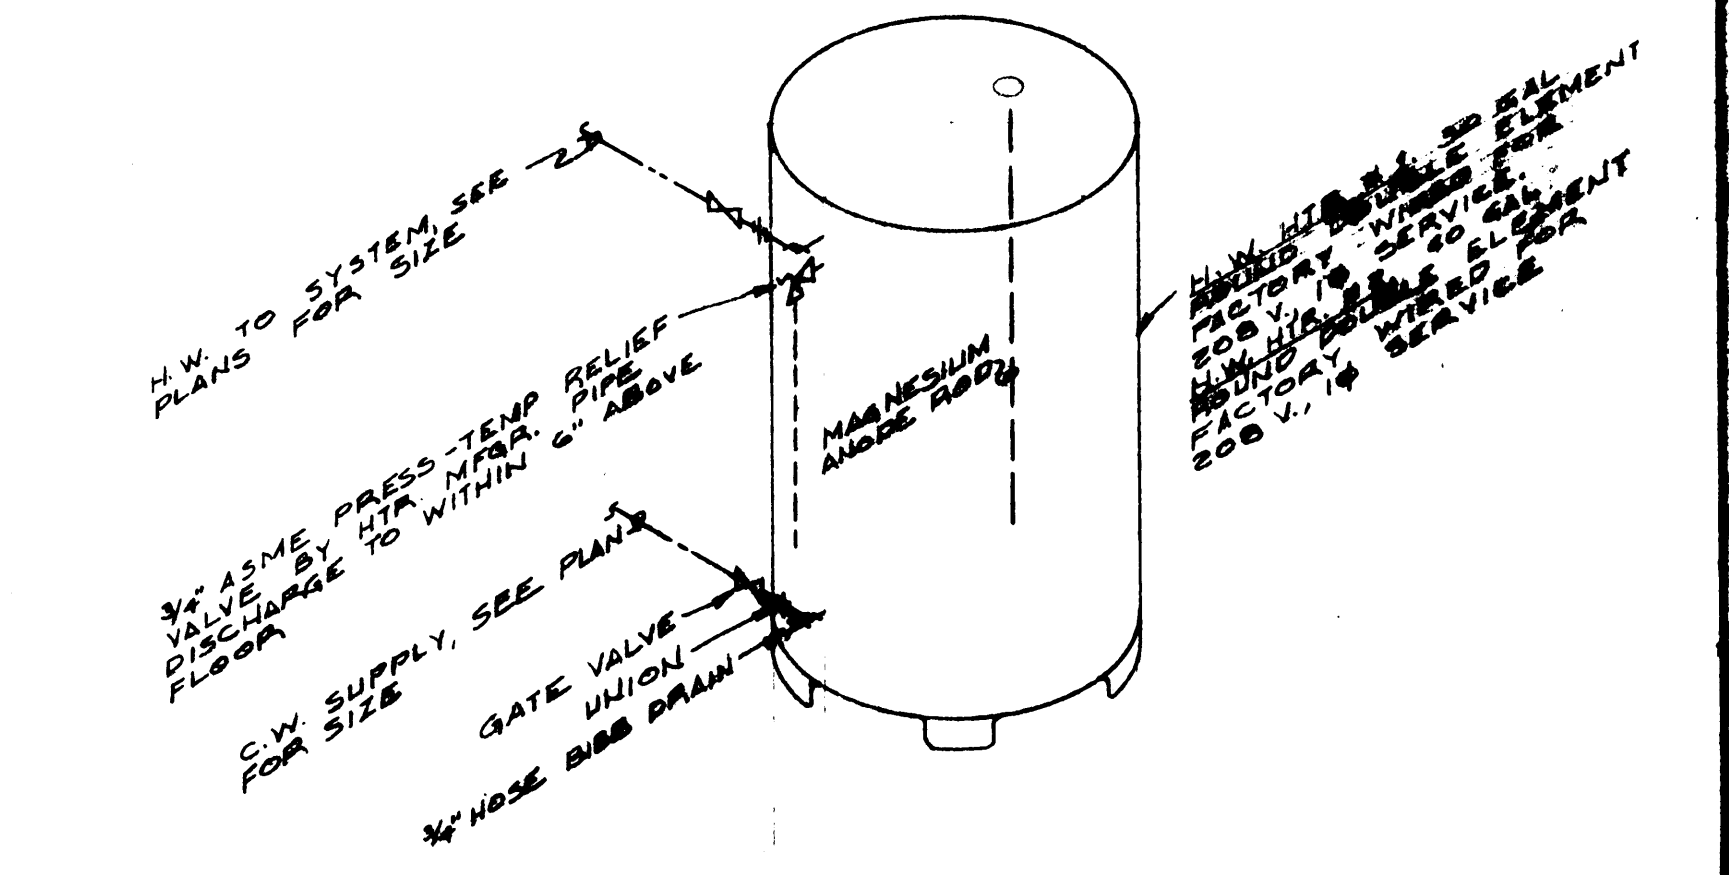

306 TYPICAL HOT WATER HEATER PIPING SCHEMATIC
NO SCALE

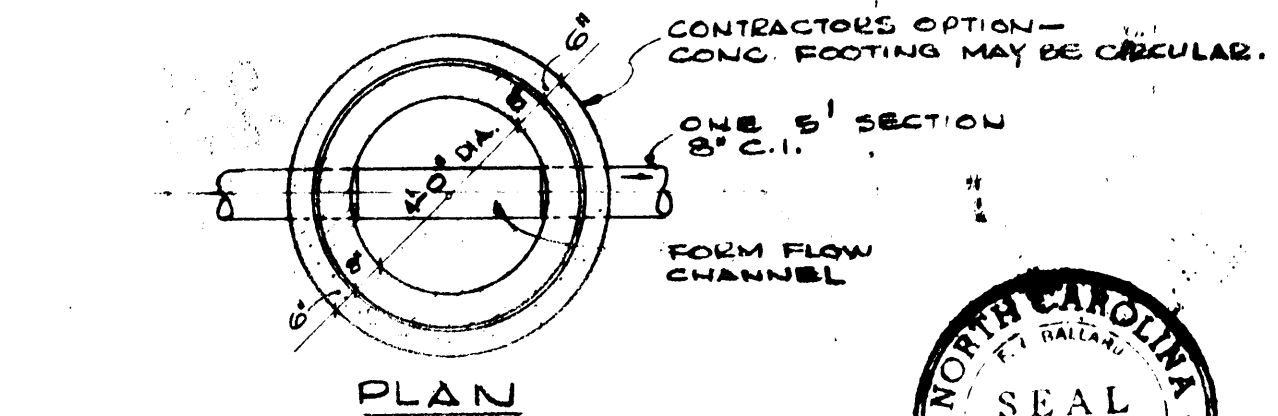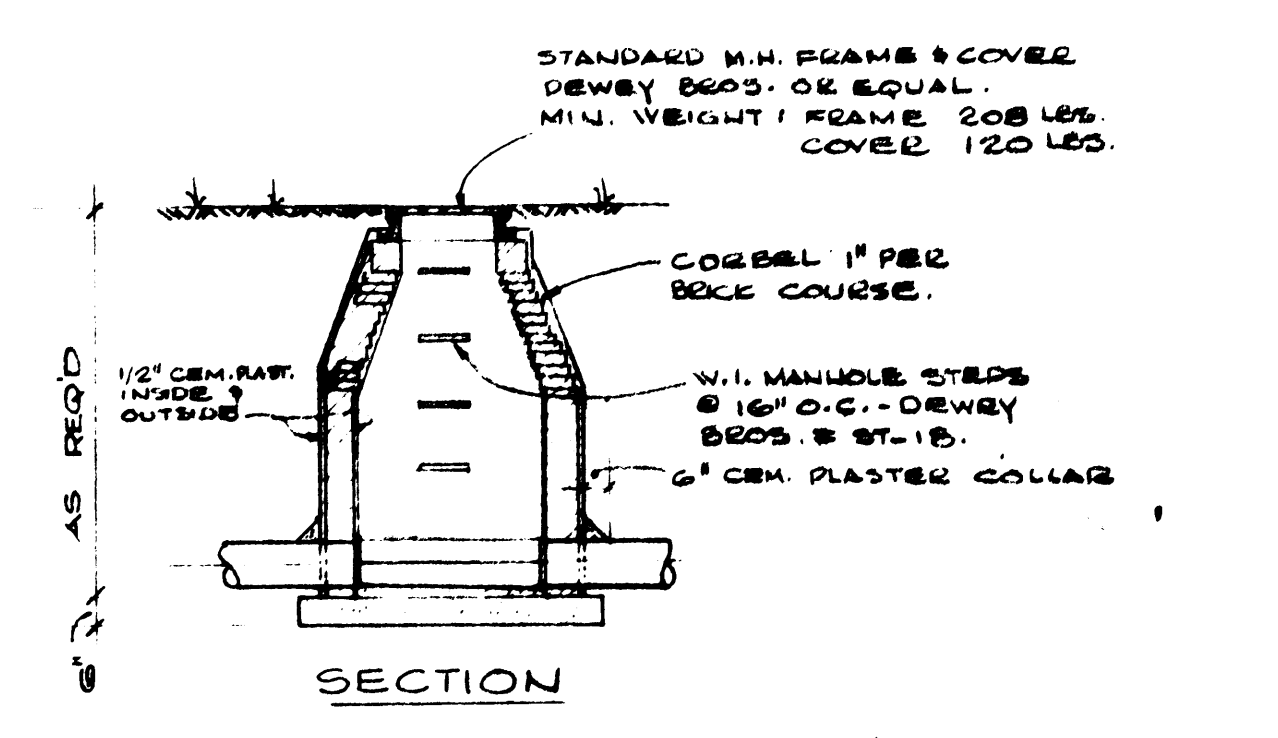


308 MANHOLE DETAIL
NO SCALE




"AS-BUILT" DRAWING
DATE JUN 10 1970



BALLARD, McKIM, & SAWYER, AIA
 42 SOUTH SPRENGER STREET
 WILMINGTON, NORTH CAROLINA
 WILMINGTON COLLEGE EDUCATION & PSYCHOLOGY BUILDING
 WILMINGTON, NORTH CAROLINA
 DR. WILLIAM M. RANDALL, PRESIDENT
 L. BRADFORD VILLEY, JR., CHAIRMAN
 J. L. BRADFORD VILLEY, JR., CHAIRMAN
 C.B.E. 68737 - ITEM 6

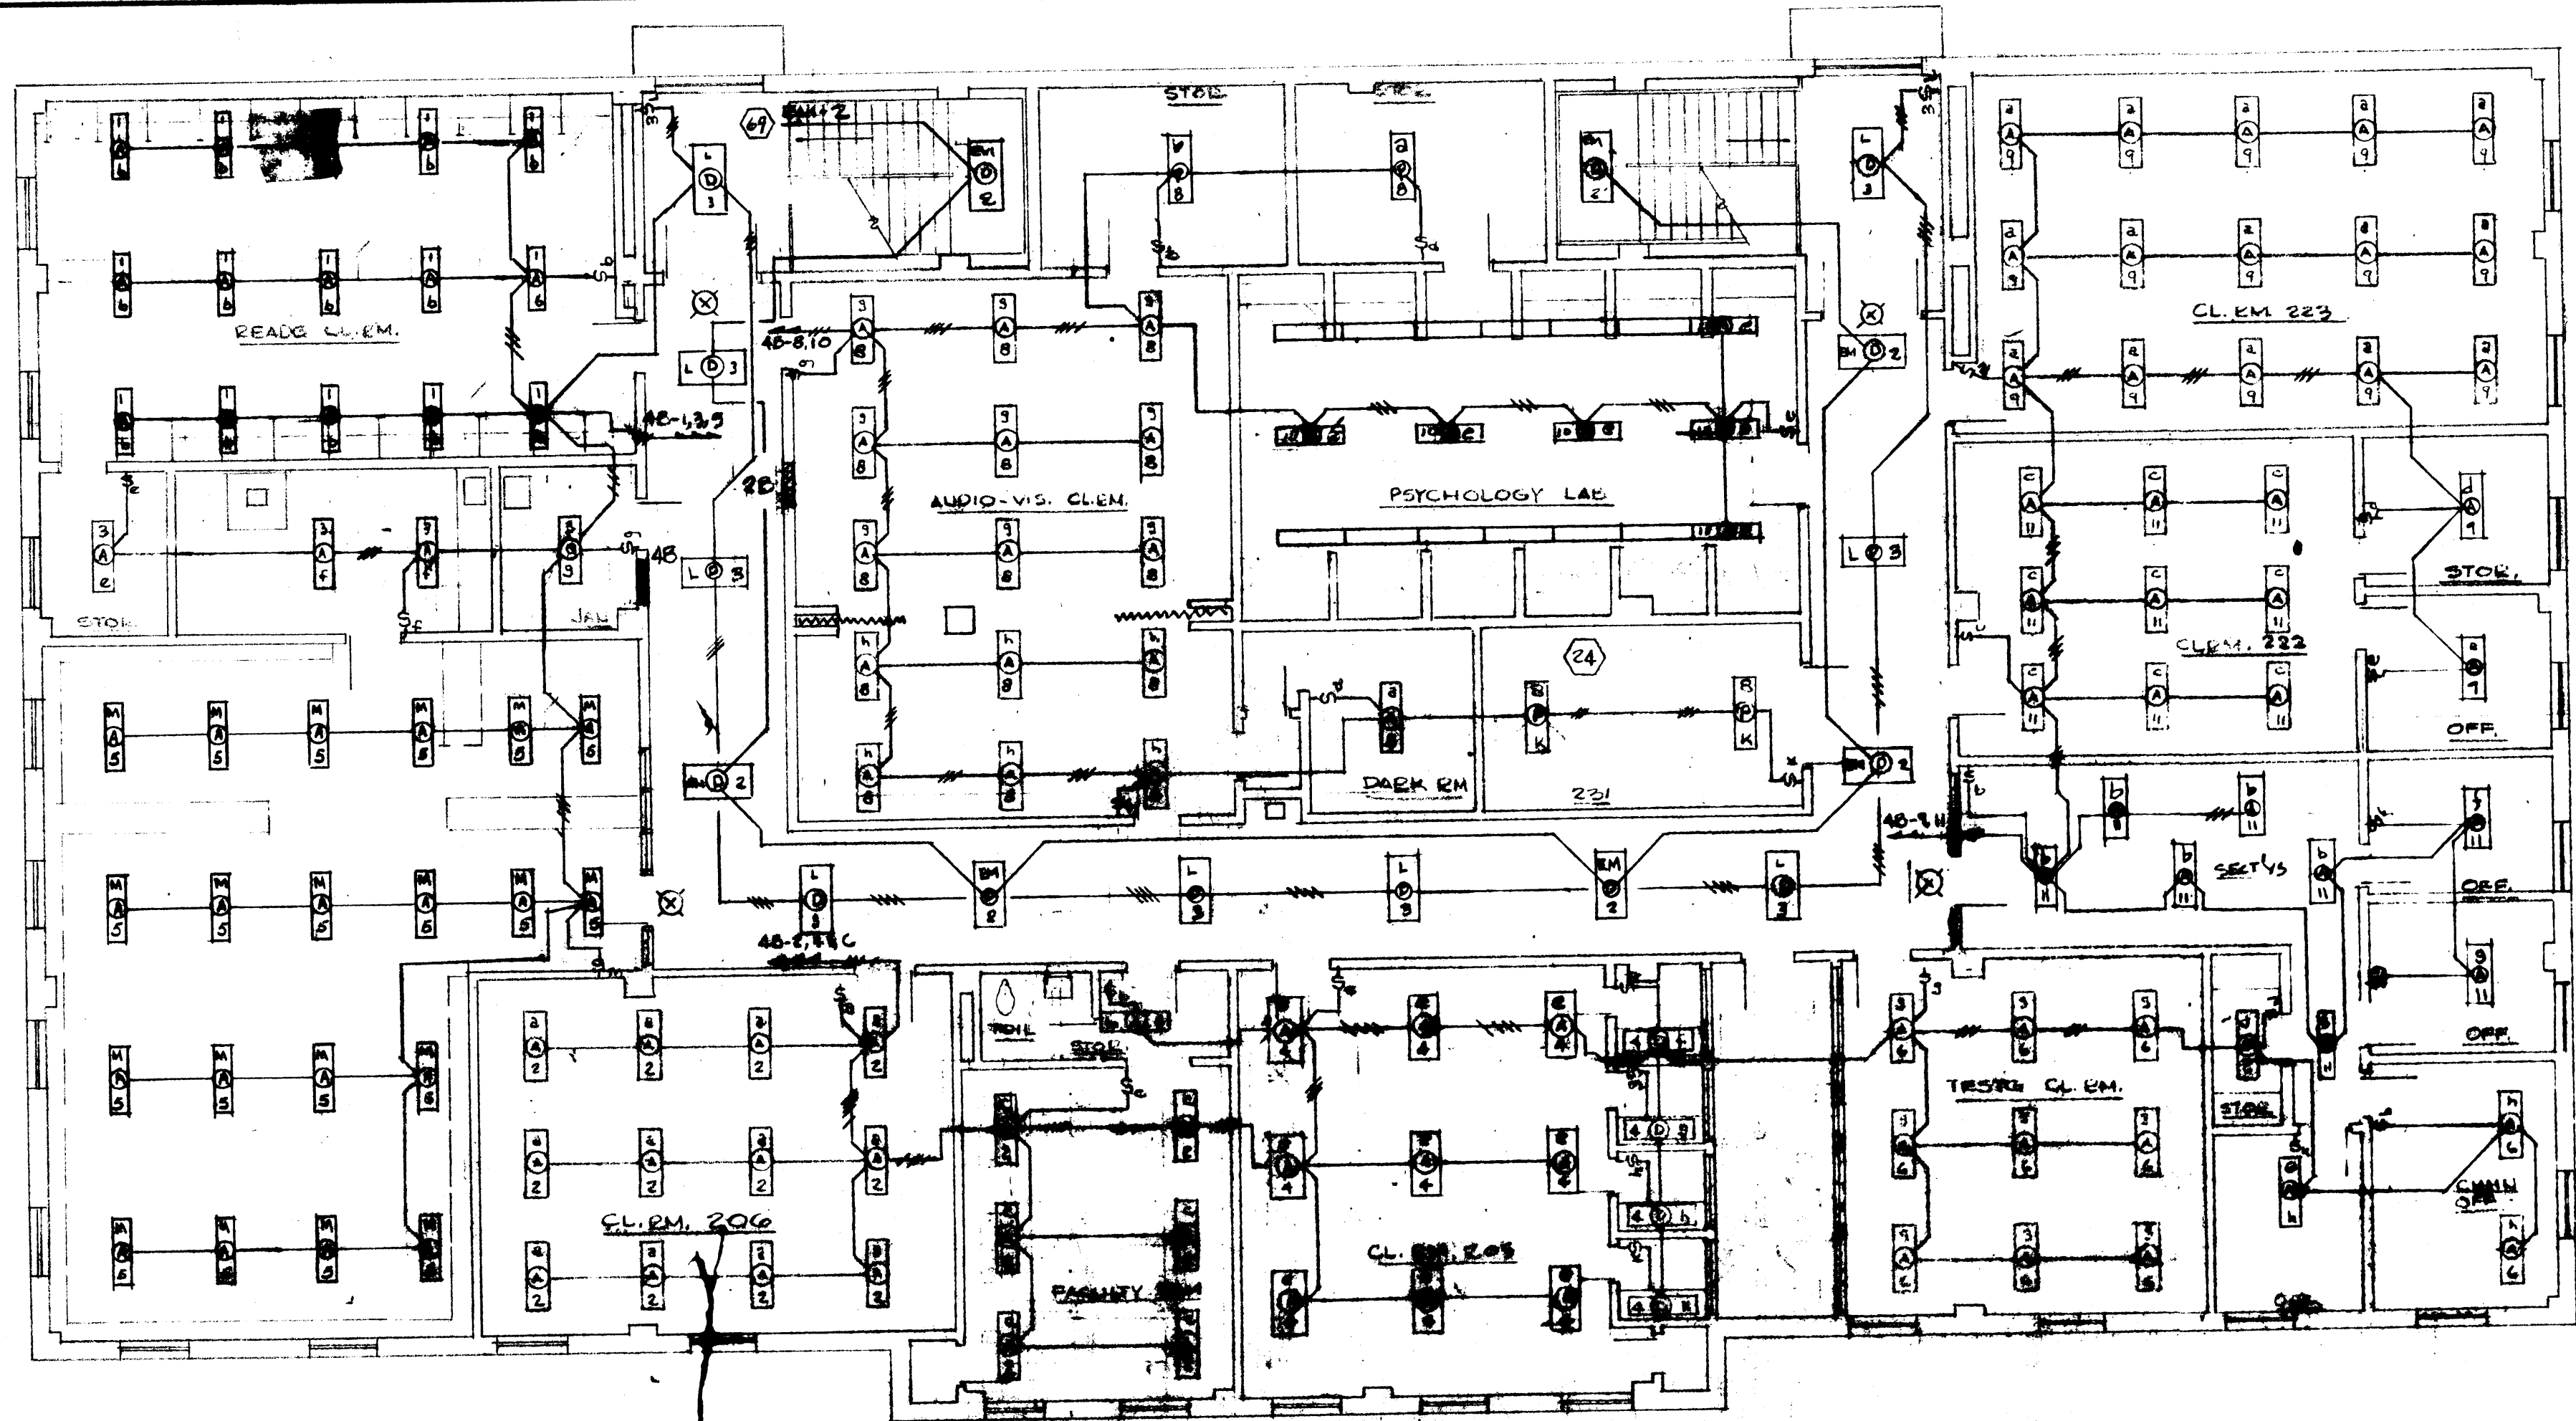

SECOND FLOOR LIGHTING PLAN
SCALE 1/8" = 1'-0"

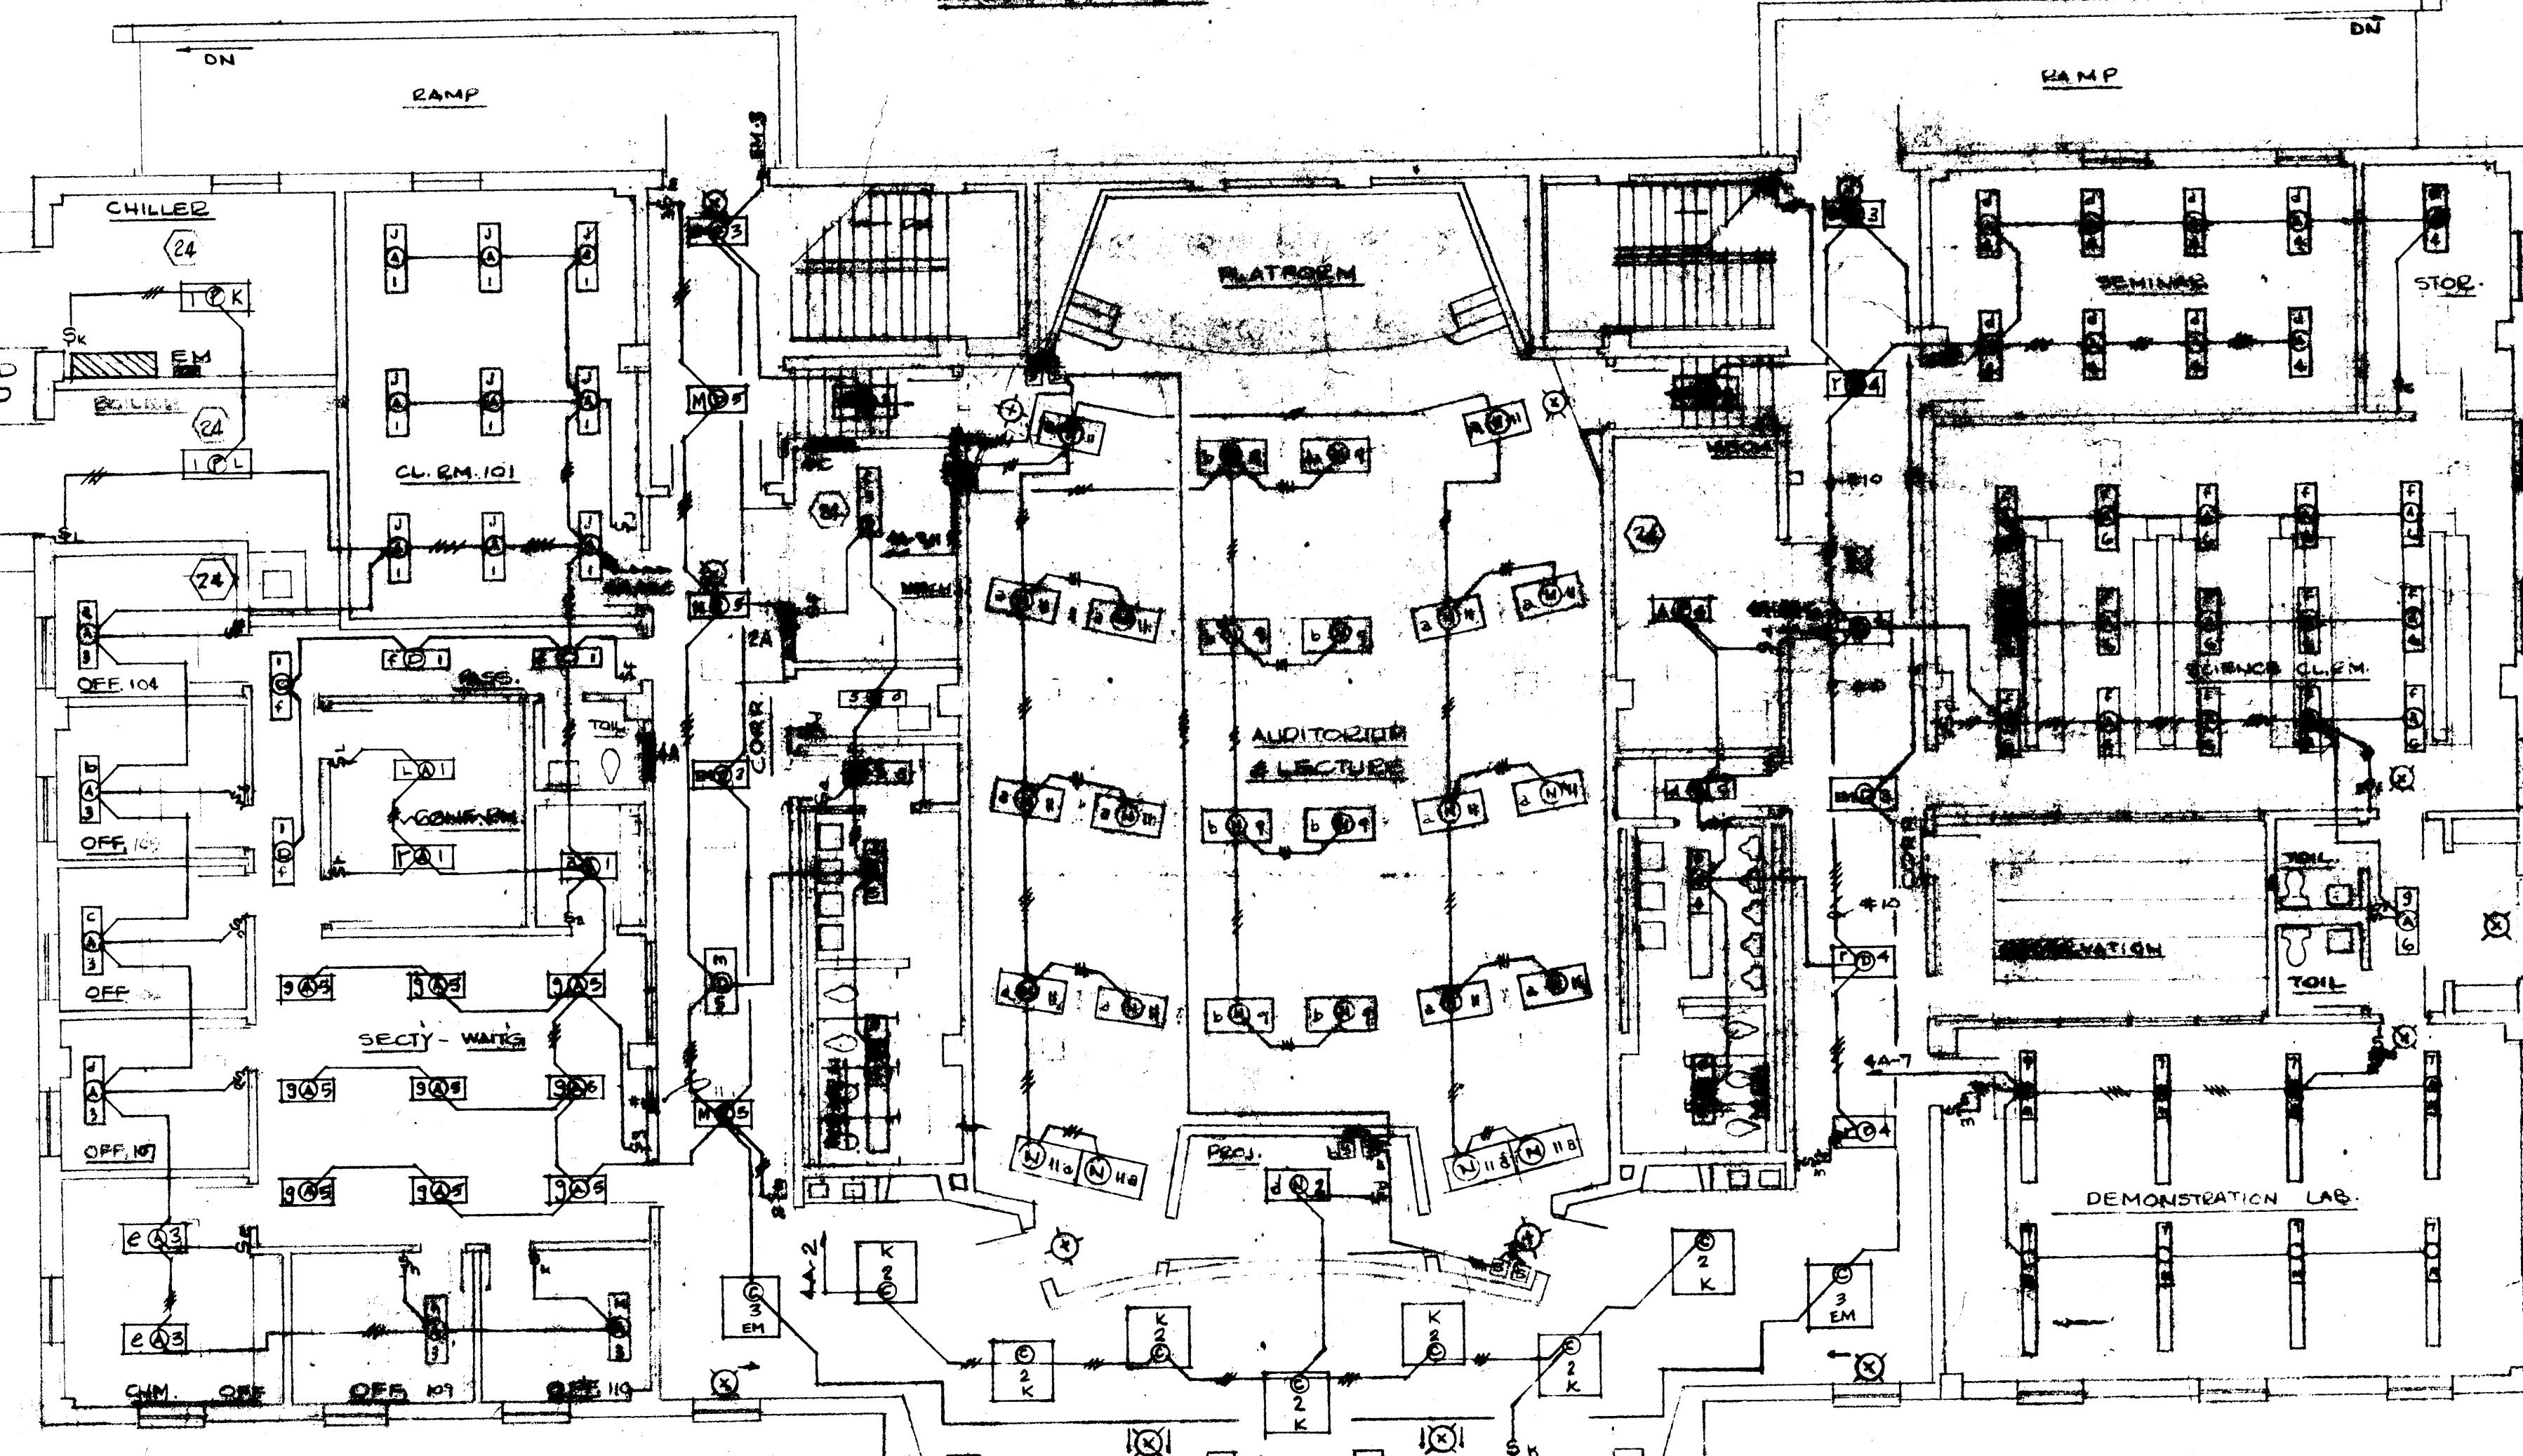

FIRST FLOOR LIGHTING PLAN
SCALE 1/8" = 1'-0"


GENERAL FLUORESCENT LIGHTING FIXTURE NOTE:
ELECTRICAL CONTRACTOR SHALL INSTALL ALL FLUORESCENT
FIXTURES AS INDICATED ON THE REFLECTED CEILING
PLAN - SHEET A-12 WIRING CONNECTION & SWITCHING
SHALL BE AS PER LIGHTING PLAN SHEET E-1

NOTE:
DO NOT SCALE THESE DRAWINGS. FOR EXACT ARCHITECTURAL
OR STRUCTURAL DIMENSIONS SEE ARCHITECTURAL
OR STRUCTURAL DRAWINGS.

NOTES

- 1 4 - 500 MCM THW IN 3/2" CONDUIT
- 2 3# 8 THW IN 2 1/4" CONDUIT
- 3 3# 12 THW IN 2 1/4" CONDUIT
- 4 3# 1/0 THW IN 2" CONDUIT
- 5 4# 2 THW IN 1 1/2" CONDUIT
- 6 3# 4 THW IN 1 1/4" CONDUIT
- 7 2# 12 THW IN 3/4" CONDUIT
- 8 2# 10 THW IN 3/4" CONDUIT
- 9 GROUND TO 2" COLD WATER PIPE IN BOILER ROOM WITH APPROVED TYPE GROUNDING CLAMP.
GROUND RACEWAY CARRYING GROUNDING CONDUCTOR AT SAME POINT, GROUNDING POINT
SHALL BE VISIBLE AND ACCESSIBLE UPON COMPLETION OF CONSTRUCTION.
- 10 1# 1/0 TW (GREEN) IN 1" CONDUIT
- 11 PAINT PANEL CASE WITH TWO COATS OF "FIRE ENGINE RED" ENAMEL, STENCIL WORD
"EMERGENCY" IN WHITE LETTERS 1" HIGH ACROSS DOOR OF PANEL CASE
- 12 480V DELTA-208/120V WIND VOLTAGE, 45 KVA DELTA TYPE 24 TRANSFORMER, PLO. 24 WITH 4-2 1/2%
TAPS.
- 13 3# 10 THW IN 3/4" CONDUIT
- 14 4# 1 THW IN 2" CONDUIT
- 15 ELECTRICAL CONTRACTOR SHALL COORDINATE LOCATION OF LTR. FIXTURE WITH MECHANICAL EQUIPMENT
TO AVOID CONFLICT.
- 16 480-120/240 VOLT SINGLE PHASE TRANSFORMER, WESTINGHOUSE TYPE GC, 1KVA OR EQUAL BY
G. E. OR A-C
- 17 4"x4"x1/8" GALV. SHEET STEEL GUTTER WITH SCREW-FASTENED COVER.
- 18 1# 8 TW (GREEN) IN 3/4" CONDUIT
- 19 EXTEND DOWN TO EM PANEL LOCATED IN MAIN 1ST FLOOR MECHANICAL ROOM.

POWER RACK DIAGRAM GENERAL NOTE:
ELECTRICAL CONTRACTOR SHALL FURNISH & INSTALL A
COMPLETE ELECTRICAL SYSTEM AS INDICATED. CIRCUIT
TO A/C EQUIPMENT, BOILER, P.R.U.'S, & E.W.N.'S SHALL
TERMINATE IN A JUNCTION BOX OR GUTTER LOCATED
ADJACENT TO MECHANICAL EQUIPMENT.

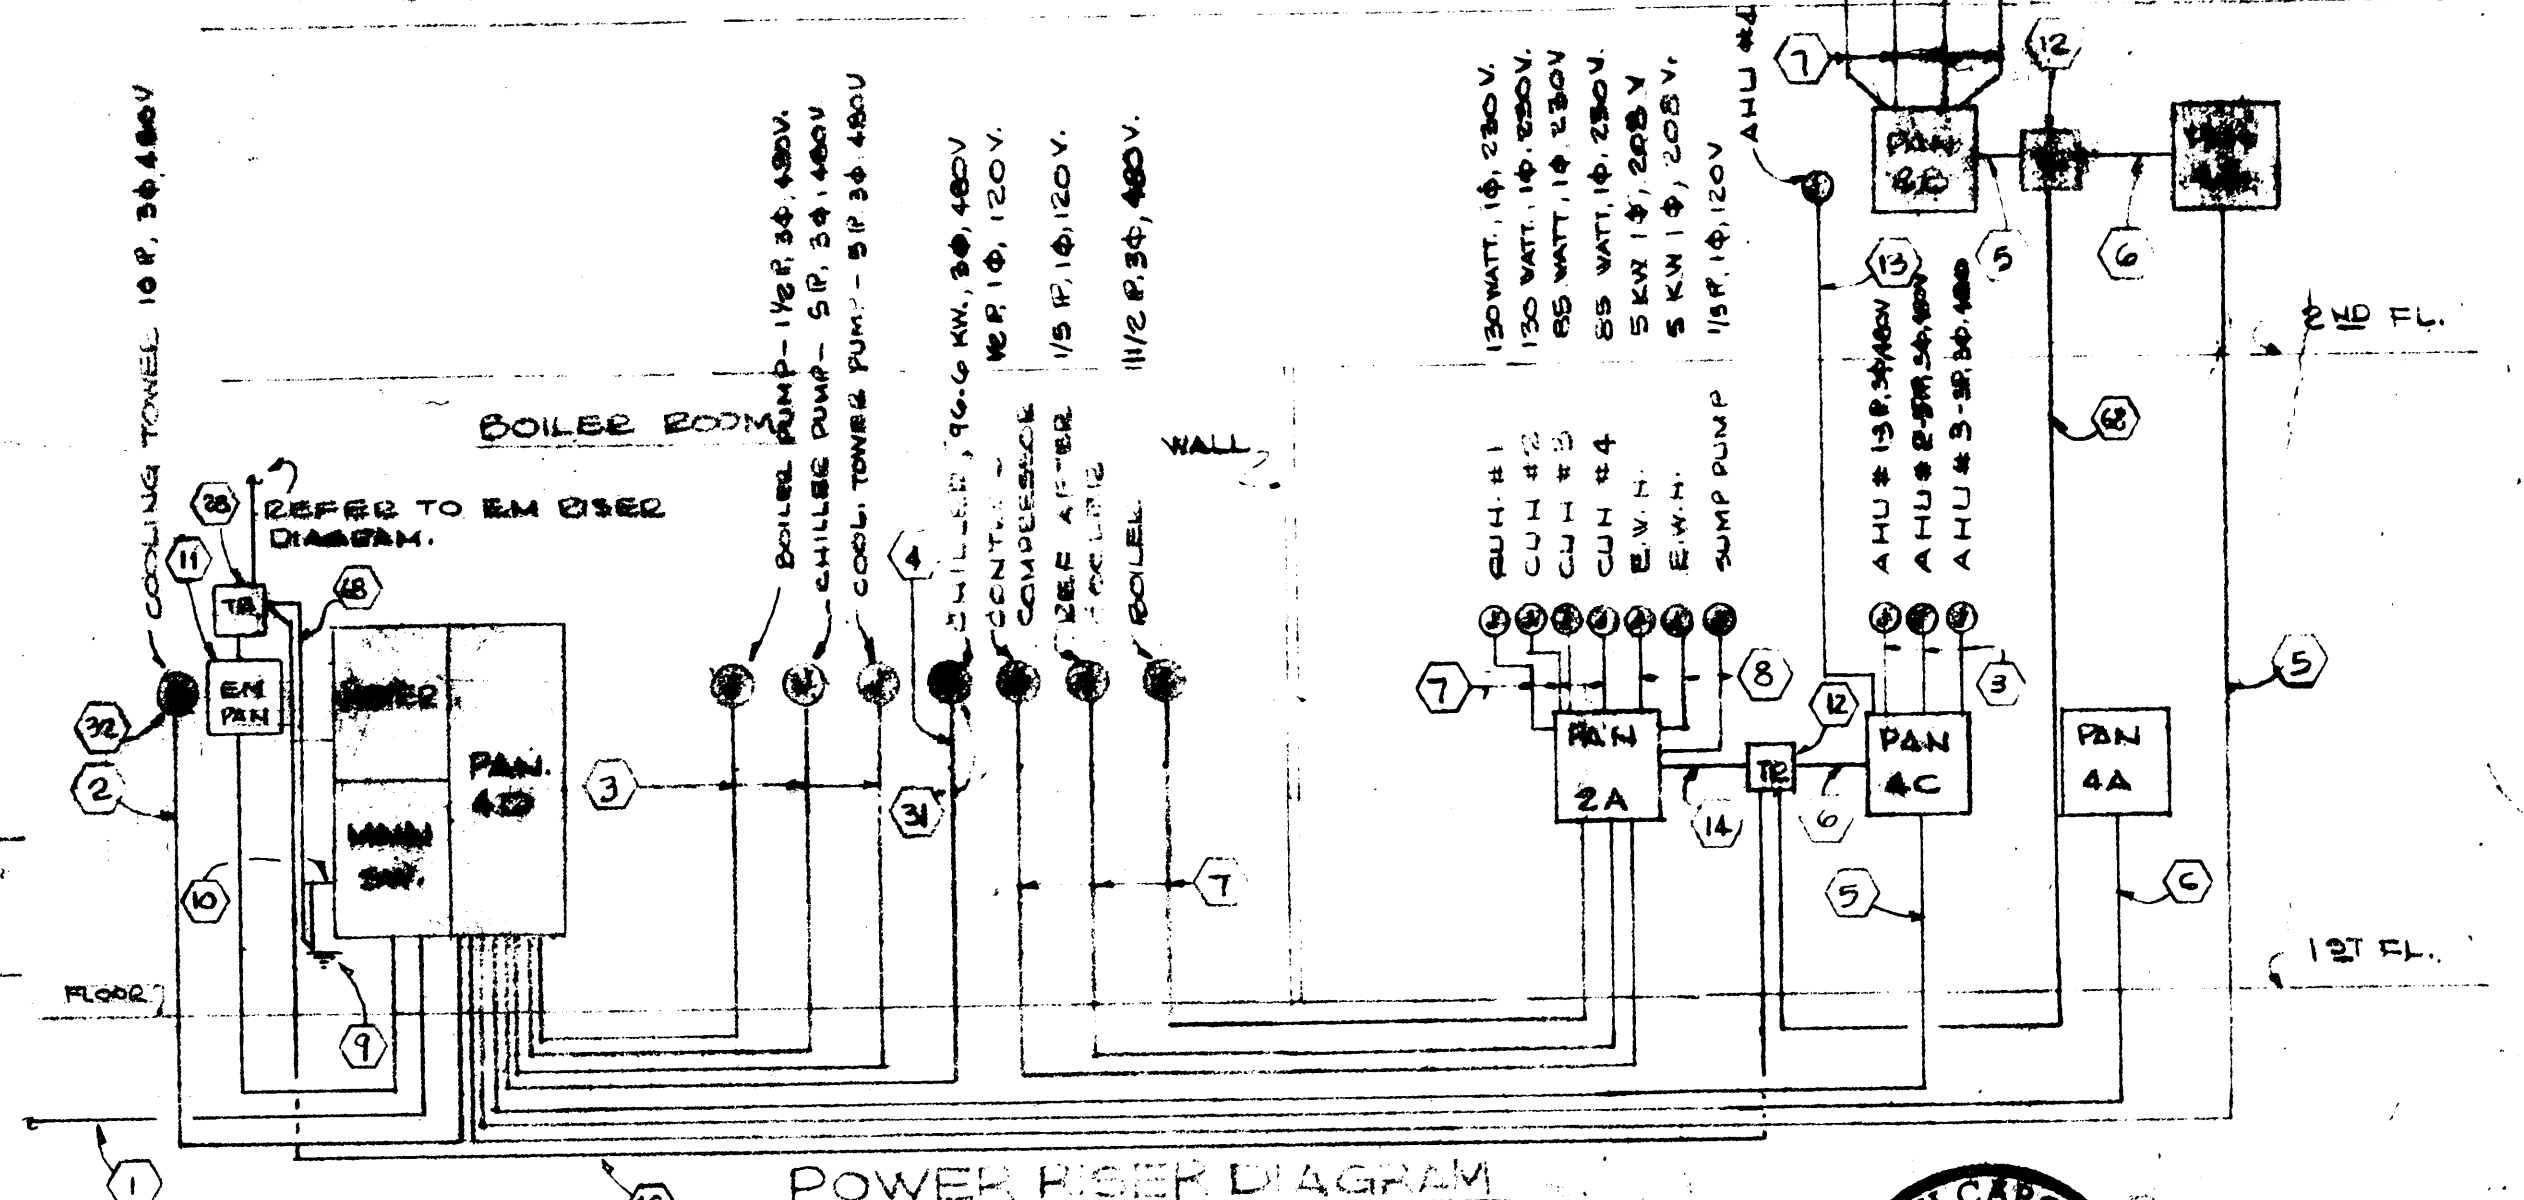

POWER RACK DIAGRAM
NO SCALE
"AS-BUILT" DRAWING
JUN 70

CAUTION DATE
THIS IS A 277/480 VOLT ELECTRICAL SYSTEM
PERSONS NOT FAMILIAR WITH THIS TYPE SYSTEM
SHOULD NOT ATTEMPT REPAIRS.

PROVIDE DECAL AS ABOVE FOR EACH SWITCH, MOTOR,
STARTER & PANEL. BLACK LETTERS ON YELLOW BACKGROUND.




WON OSEN
& ASSOCIATES
CONSULTING ENGINEERS
WILMINGTON, N. C.




WILMINGTON COLLEGE EDUCATION & PSYCHOLOGY BUILDING
 WILMINGTON, NORTH CAROLINA
 TRUSTEES: BRADFORD TILLEY, JR. CHAIRMAN - DR. WILLIAM M. RANDALL, PRESIDENT

BALLARD, McKIM, & SAWYER, AIA
 612 SOUTH SEVENTEENTH STREET
 WILMINGTON, NORTH CAROLINA

6637-ITEM

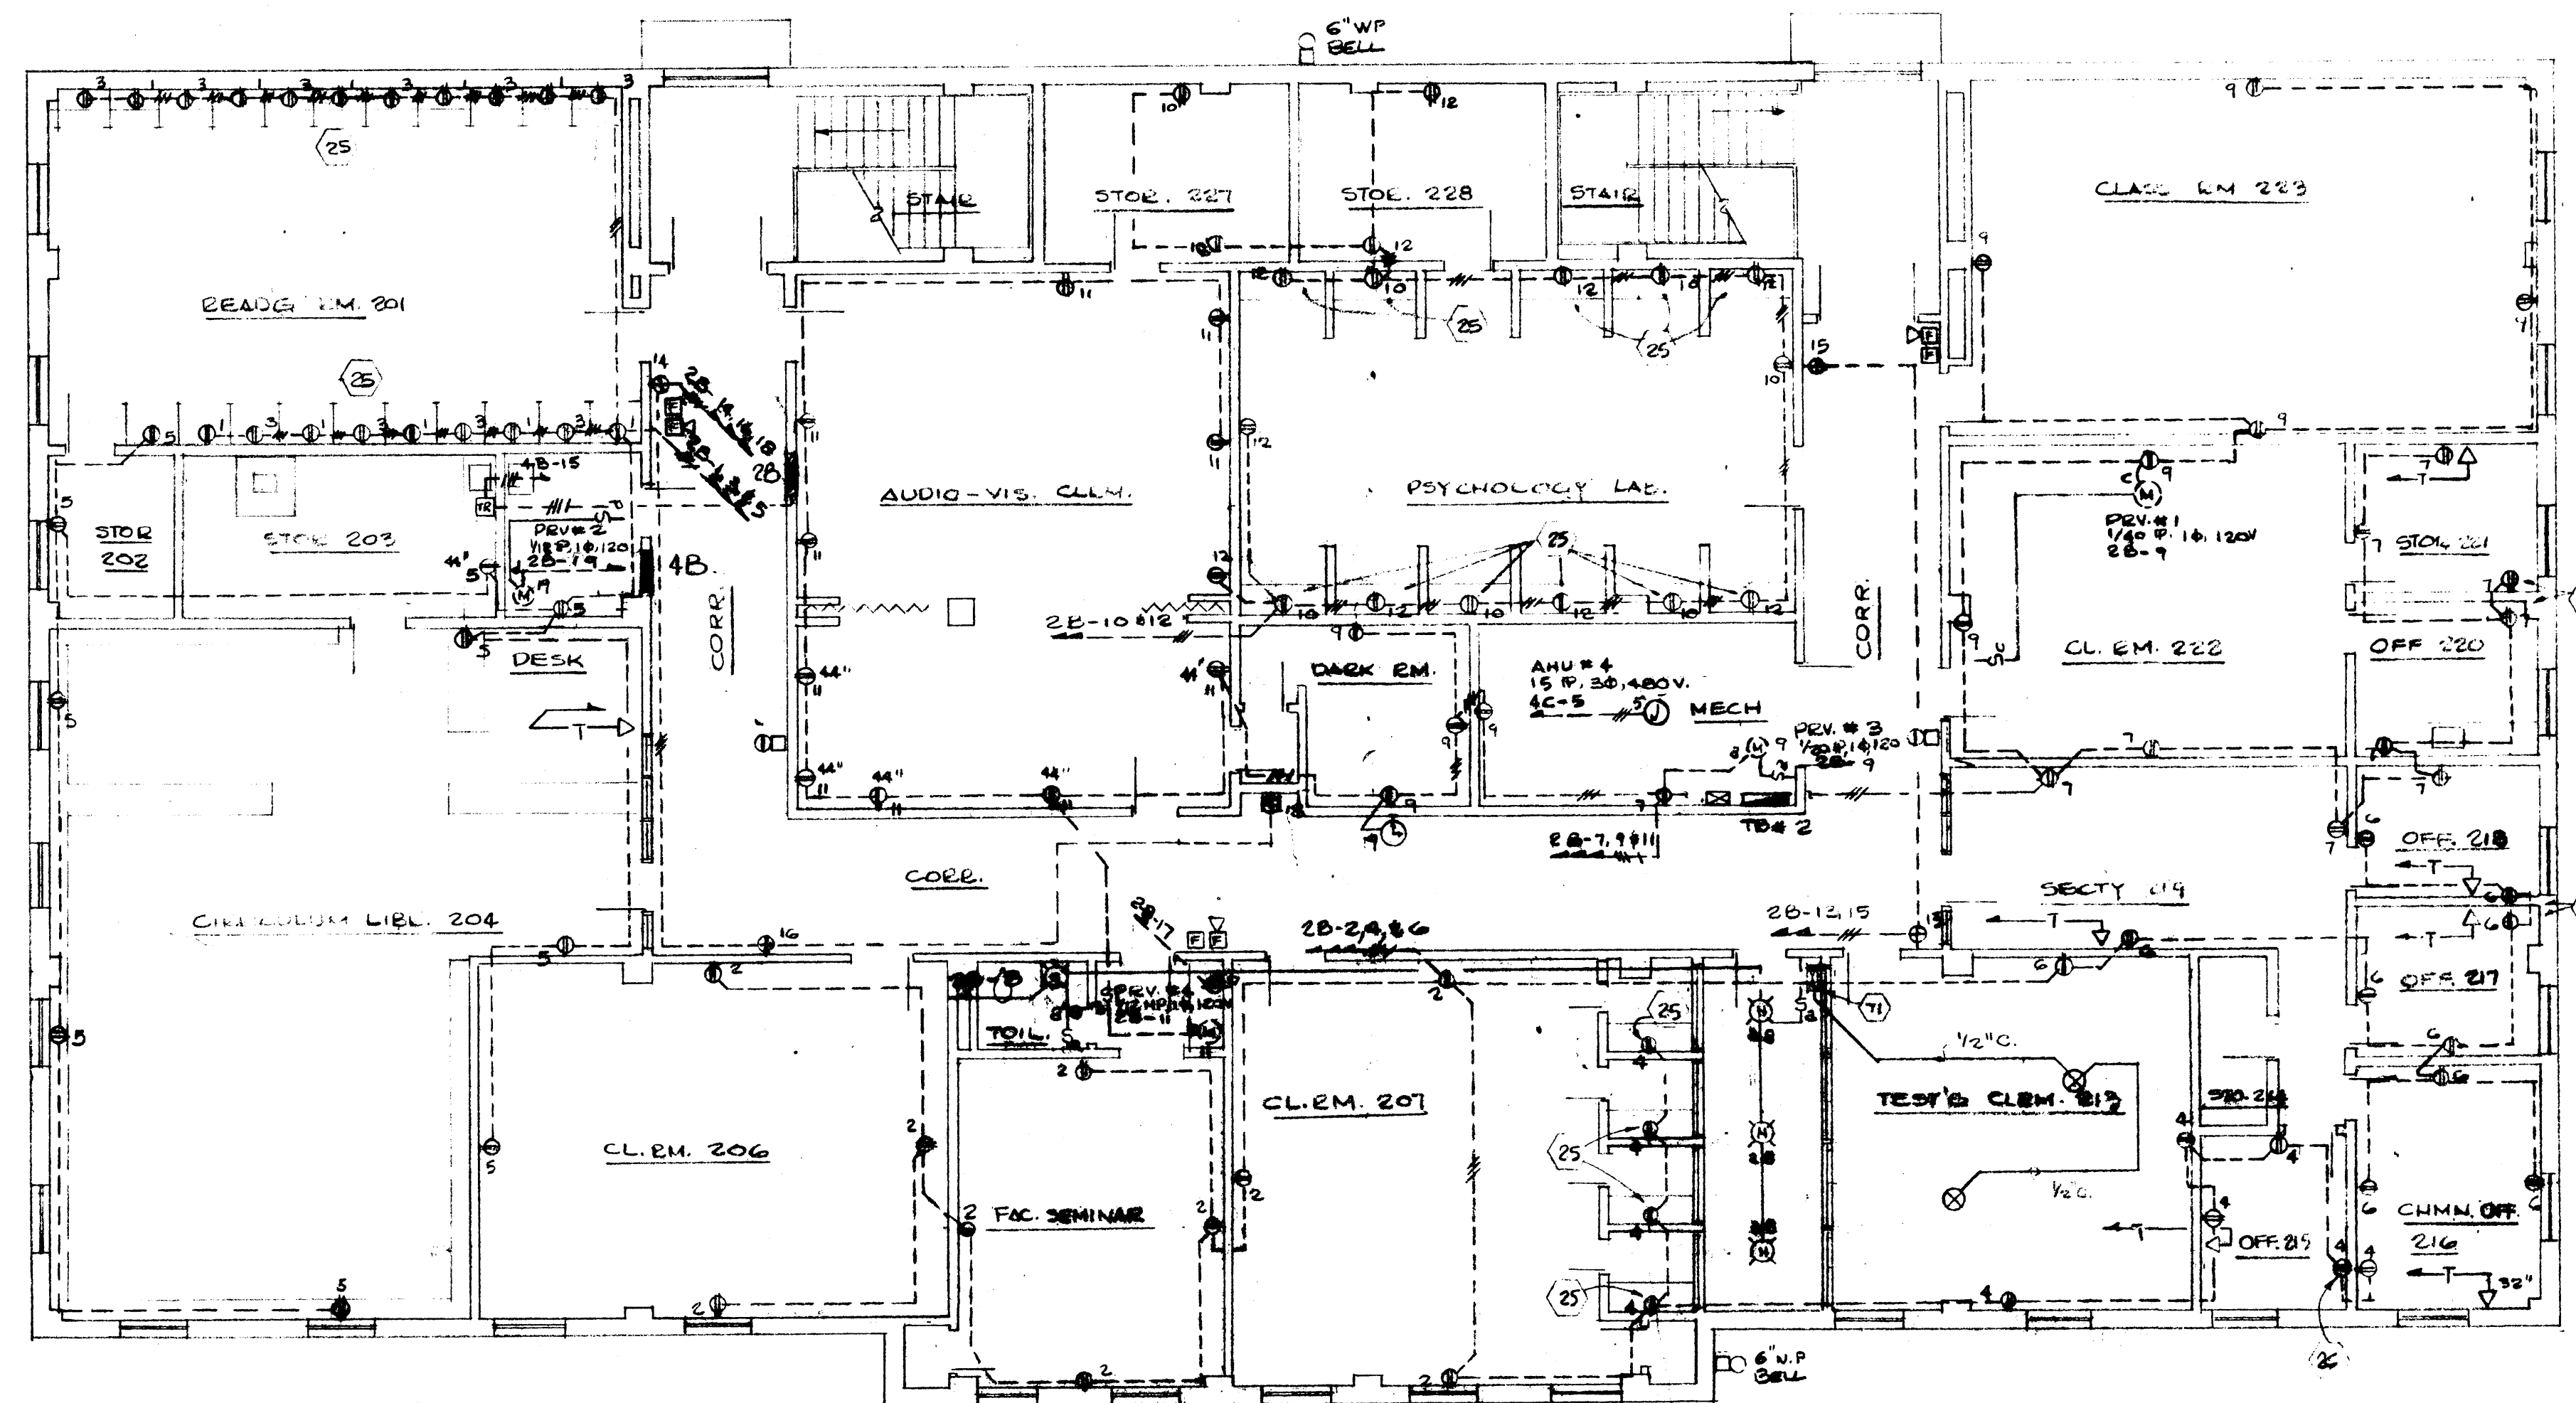

SECOND FLOOR ELECTRICAL RECEPT, POWER, TELEPHONE & FIRE ALARM PLAN
SCALE 1/8" = 1'-0"

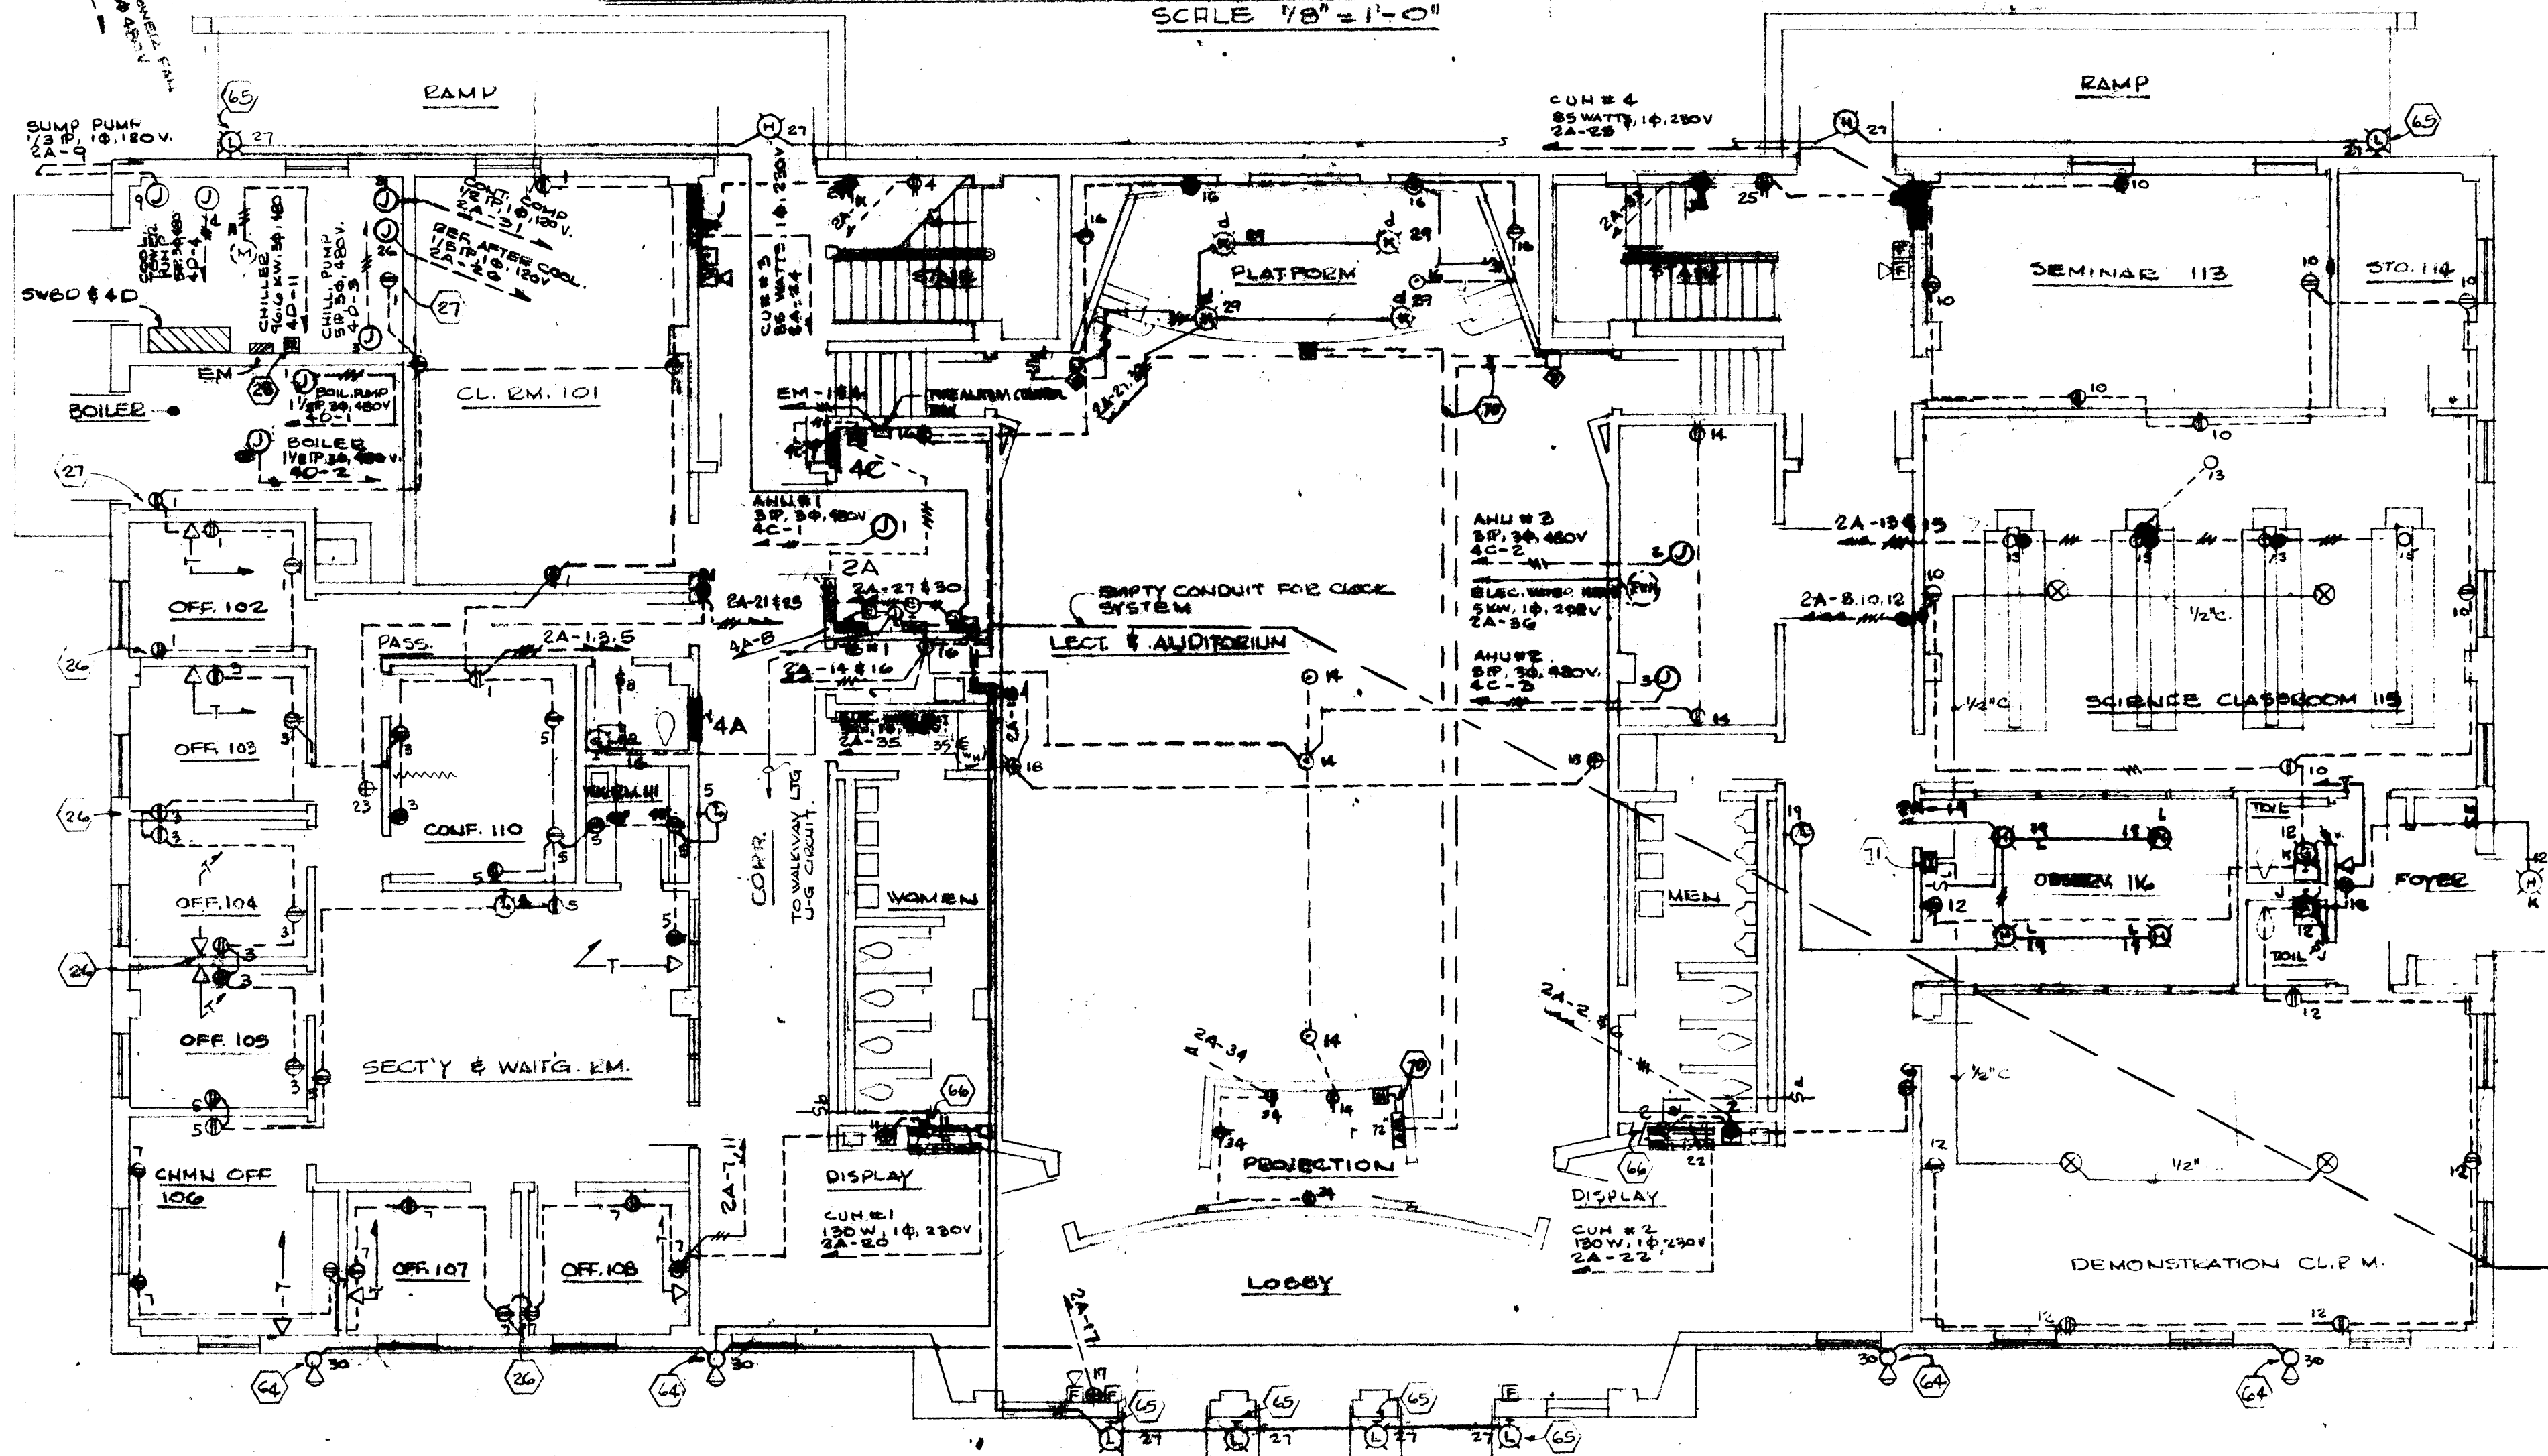


FIRST FLOOR ELECTRICAL RECEPT, POWER, TELEPHONE & FIRE ALARM PLAN
SCALE 1/8" = 1'-0"

NOTES

- SYMBOL DESCRIPTION
- (1) 2# 12 TW IN 3/4" CONDUIT.
 - (2) PAINT PANEL CASE WITH TWO COATS OF "FIRE ENGINE RED" ENAMEL. STENCIL WORD "EMERGENCY" IN WHITE LETTERS 1" HIGH ACROSS DOOR OF PANEL CASE.
 - (3) U.T. RECEPT. CLOS. THIS AREA ABOVE DESC. FLOOR TO CENTERLINE RECEPTACLE BOX 45".
 - (4) COORDINATE RECEPT. LOCATION WITH MECHANICAL CONTRACTOR TO CLEAR MECHANICAL EQUIPMENT.
 - (5) 480 - 120/240 V. 1Φ TRANSFORMER, WESTINGHOUSE TYPE GC, 1 KVA OR EQUAL G.E. OR A.C.
 - (6) CONNECT EM PANEL FEEDER TO LINE SIDE OF SV. BOARD MAIN SWITCH.
 - (7) 3# 10 TW IN 3/4" CONDUIT
 - (8) MOUNT FLOODLIGHT ONE FOOT ABOVE GRADE ON OUTSIDE OF BLDG. WALL, USE STONCO JUNCTION BOX #140 WITH MINIMUM OF THREE 1/2" TAPPED HOLES IN BOX & ONE 1/2" HOLE ON COVER PLATE. THIS ASSEMBLY SHALL BE WATER-TIGHT.
 - (9) MOUNT CENTERLINE OF OUTLET BOX 6'-0" ABOVE FINISH FLOOR.
 - (10) SEE ARCHITECTURAL SHEET A-B, DETAIL B/B FOR MTD. STRIP LIGHT.
 - (11) STUD 5'-0" OUTSIDE BLDG. CAP. & LEAVE FOR USE BY OTHERS, SEE PLOT PLAN.
 - (12) EMPTY 3/4" AUDIO SYSTEM CONDUIT.
 - (13) 1" x 4" x 4" JUNCTION BOX & 1" BUSBARS AS AMPLIFIER.

REVISED
JUNE 6, 1961

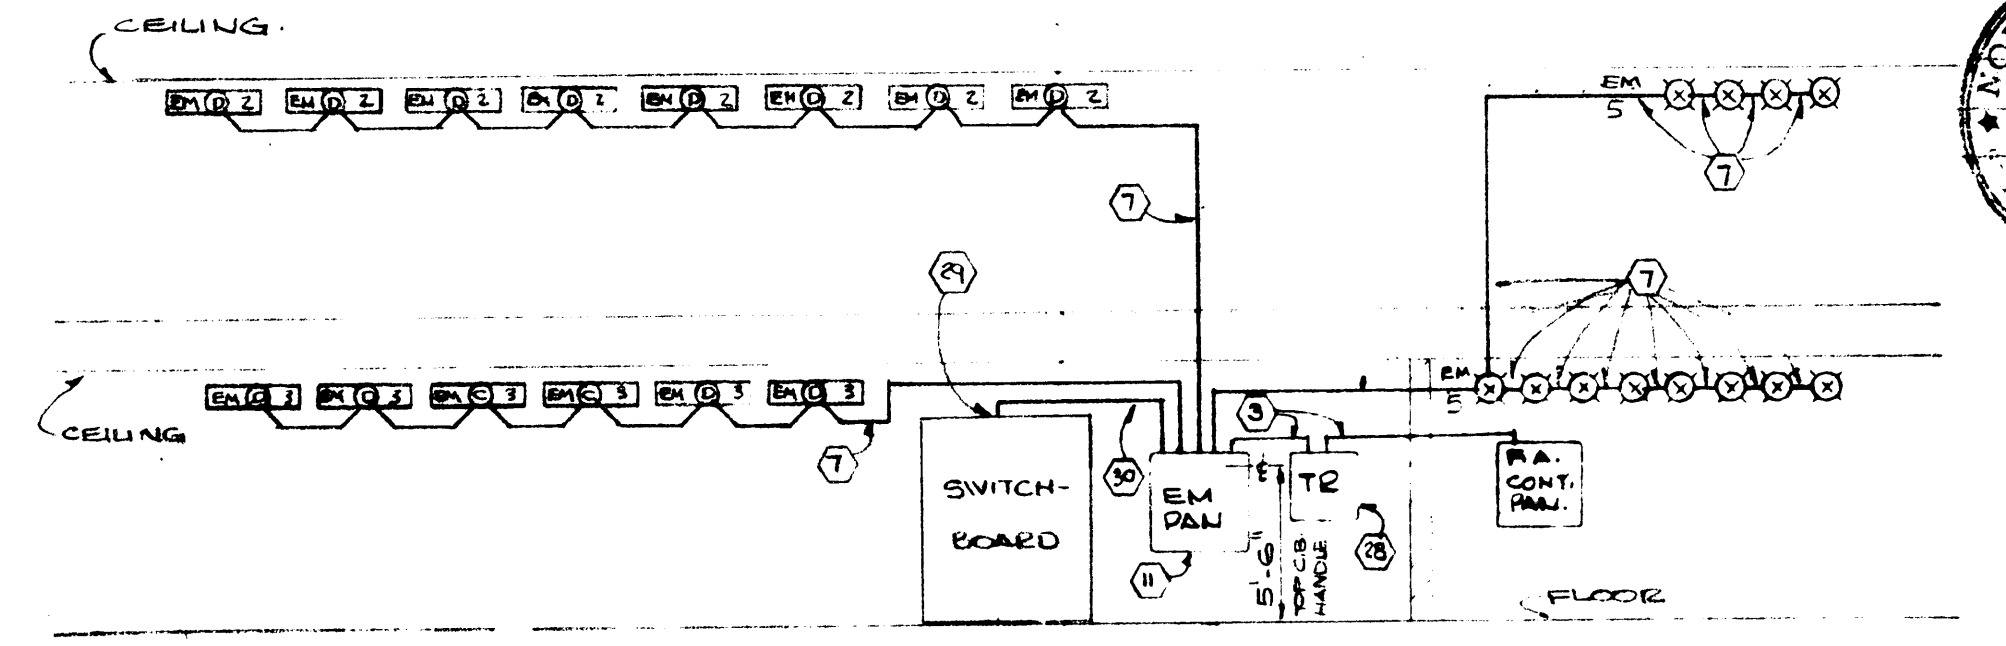


EXIT LTG. & EMERGENCY CR. RISER DIAGRAM
NO SCALE

LEGEND

- SYMBOL DESCRIPTION
- LOW VOLTAGE RELAY (SEE NOTE #1) #100-2 V.I. #100-2 #1 - LEFT SIDE FRAME & 4 - 2" x 2" L.V. RELAY, SEE SPEC.
 - FLUSH MTD. CLOCK CHIME CABINET.
 - A.H.U. AIR HANDLING UNIT BY OTHERS.
 - NORMALLY OPEN SWITCH (TYPE 1) DOUBLE THROW MOVEMENT CONTACT SWITCH ONE #176-5 OR EQUAL.
 - FILE HOLES, FLUSH GRILLE TYPE, EDWARDS # 260A OR EQUAL. MT. 8'-0" ABOVE FLOOR.
 - MANUAL STATION, BREAK-GATE TYPE, EDWARDS # 21C SPO OR EQUAL, MTD. HT. 54" ABOVE FIN. FL.
 - E.W.C. ELEC. WATER COOL. FURN. & INSTALLED BY OTHERS, POWER WIRED & CONNECTED BY ELEC. CONTR.
 - 6" WEATHER PROOF BELL, SEE SPECS.
 - SYMBOLO FOR SPECIAL NOTE, SEE NOTES.
 - TRANSFORMER, SEE NOTES.
 - FLUORESCENT CEILING OUTLET, SEE FIXTURE SCHEDULE. □ INDICATES SW. CONTROLLING, 10" INDICATES CIR. NO.
 - FLUORESCENT WALL BRACKET OUTLET, SEE FIXTURE SCHEDULE.
 - CHIMES, SEE SPECS. □ MICROPHONE OUTLET, EQ. BY OTHERS □ SPEAKER OUTLET, EQUIPMENT BY OTHERS.
 - INCANDESCENT WALL BRACKET OUTLET, SEE FIXTURE SCHEDULE.
 - INCANDESCENT CEILING OUTLET, SEE FIXTURE SCHEDULE.
 - CONDUIT DOWN. □ LAD. EM. SPEAKER.
 - ELECTRICAL JUNCTION BOX, SEE NOTES.
 - TIME CLOCK SW. (TYPE 1) #100-2 V.I. #100-2 #1 - LEFT SIDE FRAME & 4 - 2" x 2" L.V. RELAY, SEE SPEC.
 - DUPLEX GROUNDING RECEPT. 125 V. 20 A. HUBBELL # 5591 W/91091 ST. STL. PLATE, MTD. HT. 12" ABV. FIN. FL.
 - UNLESS OTHERWISE INDICATED: □ DURANE APPROX. # 4A 215 MODIFIED - SEE SPECIFICATIONS.
 - WIRING OUTLET, SEE SPECIAL NOTES.
 - CONDUIT UP.
 - FLUSH ELECTRICAL RECEPT. 125 V. 20 A. HUBBELL # 5591 W/91091 ST. STL. PLATE, MTD. HT. 12" ABV. FIN. FL.
 - SING. POLE FLUSH WALL SW. 15A, 120/277 VAC. HUBBELL # 5591 W/91091 ST. STL. PLATE, MTD. HT. 50".
 - 3-WAY FLUSH WALL SW. 15A, 120/277 VAC. HUBBELL # 5591 W/91091 ST. STL. PLATE, MTD. HT. 50".
 - SYSTEM CLOCK, SIMPLEX, SEE SPEC. "2" WHERE INDICATED, VENOTE'S DOUBLE-FACE, MTD. HT. 7'-10" ABOVE FIN. FLOOR. IN DROPPED CEILING AREA, VERIFY MTD. HT. WITH ARCHITECT.
 - CONVECTION UNIT HEATER.
 - ELECTRICAL WIRING, SEE PANEL SCHEDULES.
 - ELECTRICAL WIRING, SEE PANEL SCHEDULES.
 - RACEWAY CONCEALED IN OR BELOW FLOOR.
 - RACEWAY CONCEALED IN WALLS OR CEILING, SEE PANEL SCHEDULES.
 - MOTORS, P.F. & AND VOLTAGE MARKED.
 - WALL MTD. TELE RECEPT. 125 V. 20 A. FIN. FL. UNLESS OTHERWISE INDICATED. CONDUIT SIZE INDICATED.
 - DISCONNECT SWITCH, SEE NOTES.
 - SURF. MTD. RACEWAY TERMINAL BOARD 9" x 4" x 4" x 3/4" W/4" x 1/2" WOOD BOARD.
 - E.W.H. ELEC. WATER HEATER, FURNISHED & INSTALLED BY OTHERS, POWER WIRED & CONNECTED BY ELECTRICAL CONTRACTOR.
 - SING. GND. RECEPT. 125 V. 20 A. HUBBELL # 5591 W/91091 ST. STL. PLATE, MTD. HT. 12" ABV. FIN. FLOOR UNLESS OTHERWISE INDICATED.
 - FLOODLIGHTS - 11A - 2A/400 W/12" BEAM 4.

"DRAFT" DRAWING

HENRY VON OESSEN & ASSOCIATES
ENGINEERING ARCHITECTS
WASHINGTON, N.C.




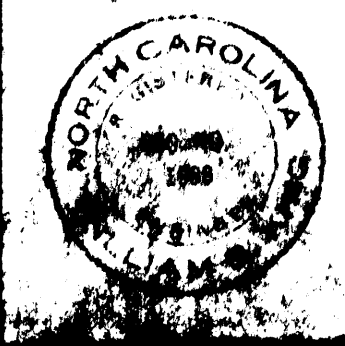


WILMINGTON COLLEGE EDUCATION & PSYCHOLOGY BUILDING
 WILMINGTON, NORTH CAROLINA
 BOARD OF TRUSTEES - L. BRAYBORD TILLEY, JR. CHAIRMAN - DR. WILLIAM M. RANDALL, PRESIDENT
 BALLARD, MCKIM, & SAWYER, AIA
 401 SOUTH SPENTERTH STREET
 WILMINGTON, NORTH CAROLINA
 DESE 66737 - ITEM 6







| SYM | DESCRIPTION |
|-----|---|
| 19 | UNDISTURBED EARTH. |
| 20 | BACKFILL WITH EXCAVATED MATERIAL IN COMPACTED LAYERS OF 2" MAX. GAUGED EGGS. |
| 21 | "ALLEN SYSTEM" PVC MARKER TAPE. |
| 22 | DIRECT BURIAL ELECTRICAL CABLE. |
| 23 | SELECTED FILL MATERIAL FREE FROM DEBRIS & LARGE PIECES OF ORGANIC MATTER OR COARSE BUILDERS SAND. |
| 24 | 1" EMPTY CONDUIT TO ATTIC SPACE, CAP & LEAVE FOR FUTURE USE. |
| 25 | 3/4" CONDUIT W/ #12 TW WIRE AS REQUIRED FOR CLOCK & CHIMES. |
| 26 | 1/4" CONDUIT W/ #12 TW WIRE AS REQUIRED FOR CLOCKS & CHIMES. |
| 27 | FLUSH MTD. CLOCK-CHIME CABINET |
| 28 | 3" RIGID STEEL CONDUIT, ENCASE IN CONC. PORTIONS LOCATED BELOW GRADE. |
| 29 | 3/4" CONDUIT W/ #12 TW WIRE AS REQUIRED FOR CLOCK & CHIMES. |
| 30 | 3/2" ID FIBER DUCT TO CONDUIT ADAPTER LOCATED 5 FEET OUTSIDE PLUS. |
| 31 | 3" FIBER DUCT CONDUIT ENCASED IN CONCRETE W/ #12 TW WIRE AS REQUIRED. |
| 32 | 1" EMPTY CONDUIT TO CRAWL SPACE, CAP & LEAVE FOR FUTURE USE. |
| 33 | 100 AMP COPPER, EXTERNALLY MOUNTED, NEUTRAL TIE BAR. |
| 34 | 300 KVA, 12470 GND WYE / 12000-208 GND WYE / 120 VOLTS, 3-PHASE, 4-WIRE PAD MOUNTED TRANSFORMER, SEE SPECS. |

| SYM | DESCRIPTION |
|-----|--|
| 44 | CURRENT LIMITING POWER FUSE CLIP MOUNTED 1/2" FROM TOP OF SWITCHING & REMOVAL FUSE RATED AT 20 AMP. SEE SPECS. |
| 45 | SINGLE CONDUCTOR, 15 KV. POTHEAD, SEE SPECS. |
| 46 | 500 MCM THW SECONDARY CONDUCTOR. |
| 47 | 1/0 THW (GREEN) GND CONDUCTOR IN 1" CONDUIT. |
| 48 | CONNECT GND CONDUCTOR TO METALLIC FRAME OF SWITCHGEAR W/ PRESSURE TYPE LUG & BRASS BOLTS. |
| 49 | 3/2" INSULATION-LINED GND PUSHING. |
| 50 | 3/2" SERVICE ENTRANCE CONDUIT. |
| 51 | TRANSFORMER PAD, SEE DETAIL "B". |
| 52 | #4, 15 KV. SHIELDED DIRECT BURIAL CABLE SEE SPECIFICATIONS. |
| 53 | #4 600 VOLT THW W/NEOPRENE JACKET FOR DUCT ENDWARD. |
| 54 | TO CAMPUS PAD MOUNTED SECTIONALIZING SWITCH, SEE ELECTRICAL SITE PLAN E. 4. |
| 55 | 3/4" X 10 FT COPPER CLAD GND ROD DRIVEN 11 FT INTO EARTH, BRASS OR ALUMINUM GND CONDUCTOR TO ROD. |
| 56 | BRASS OR ALUMINUM GND CONDUCTORS. |
| 57 | #2 BARE STANDED COPPER GROUNDING CONDUCTOR 1 FT. BELOW GRADE. |
| 58 | CONNECT TO EXTERIOR OF TRANSFORMER CASE W/ PRESSURE LUG & BRASS BOLTS. |

| SYM | DESCRIPTION |
|-----|---|
| 60 | 3/2" CONDUIT UNDER. |
| 61 | 2" EMPTY FIBER DUCT CONDUIT ENCASED IN CONCRETE, LEAVE W/ 1/2" FROM WALL. STOP 5'-0" OUTSIDE BUILDING & LEAVE FOR USE BY OTHERS SEE PLAN. |

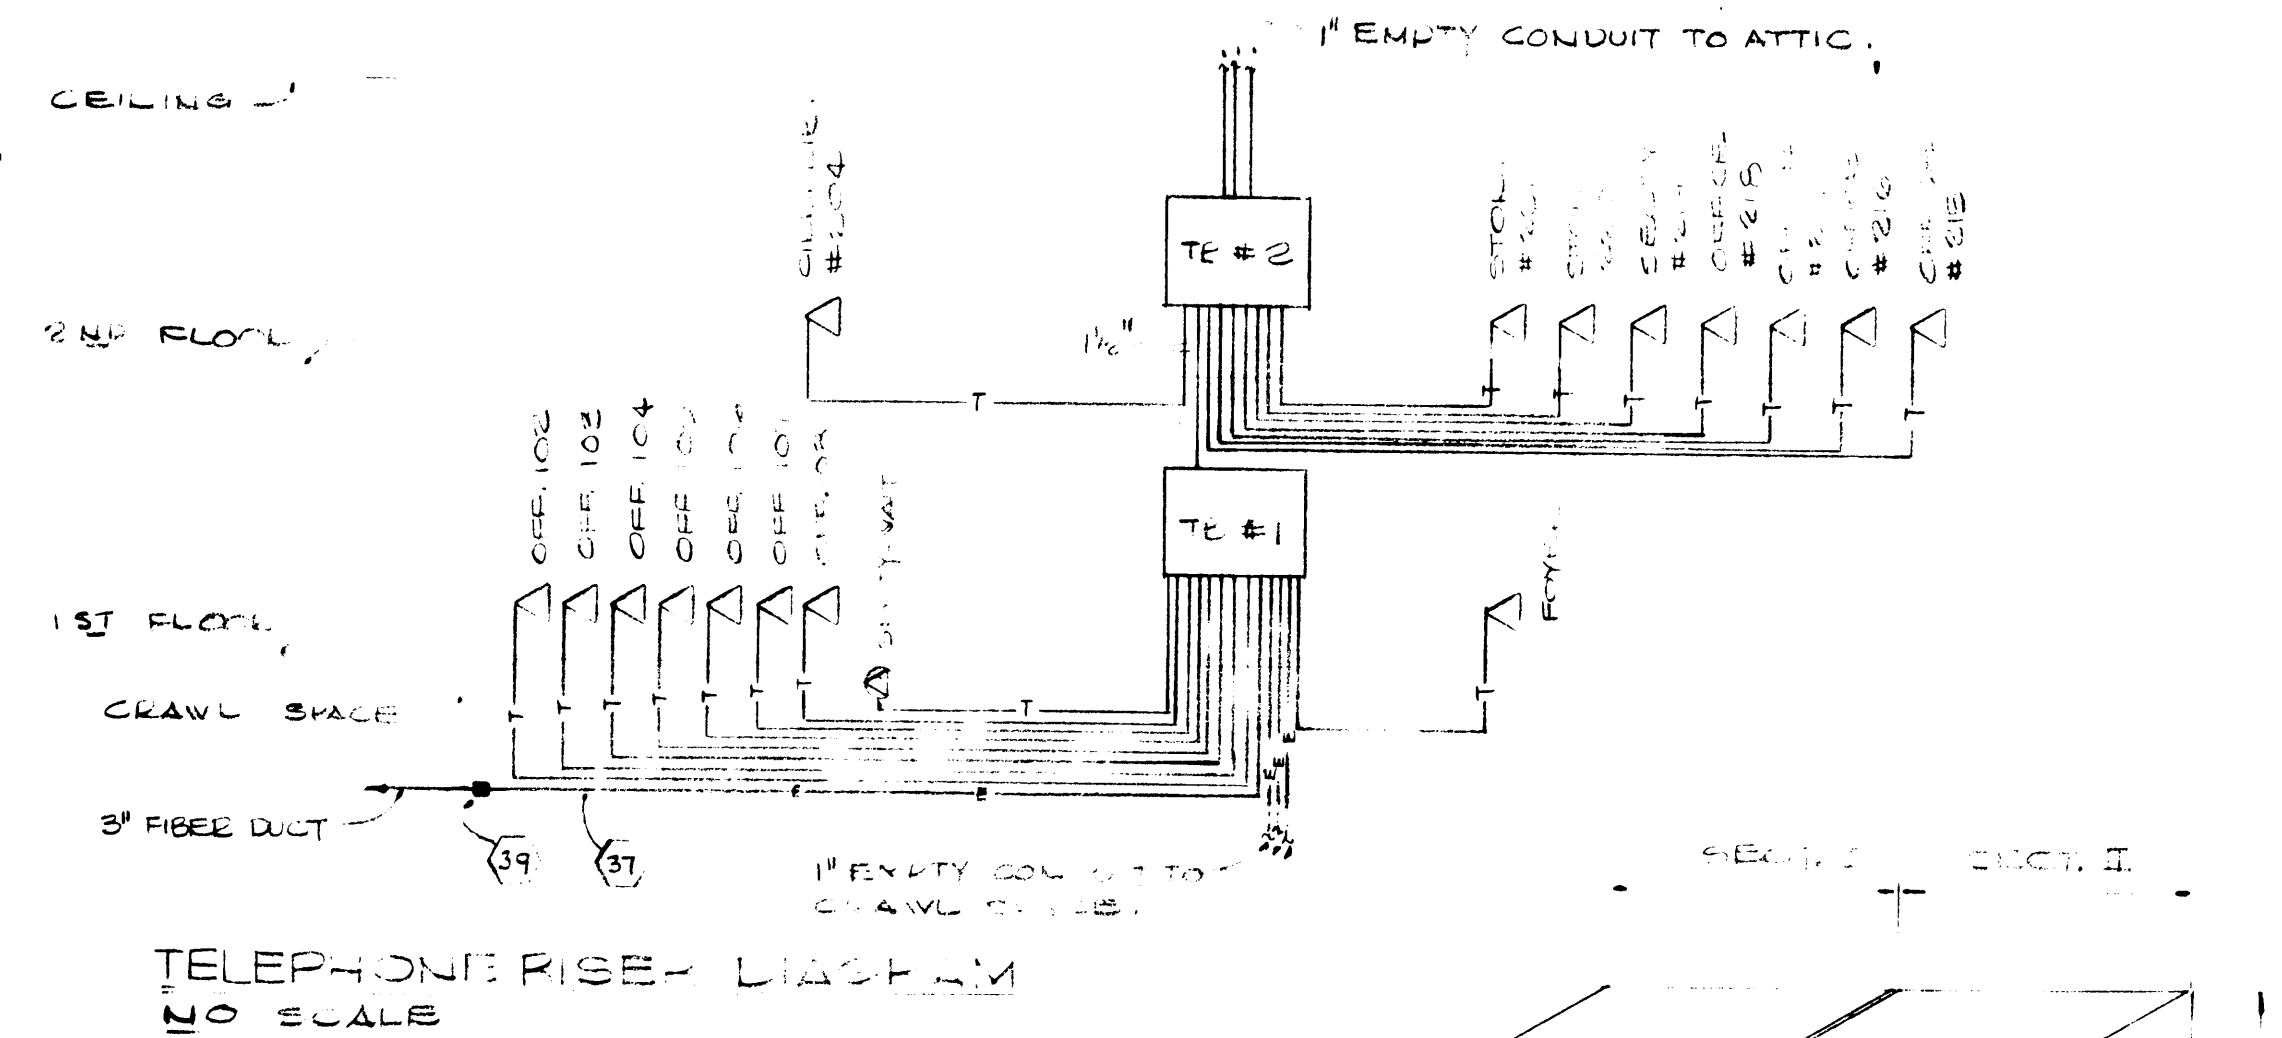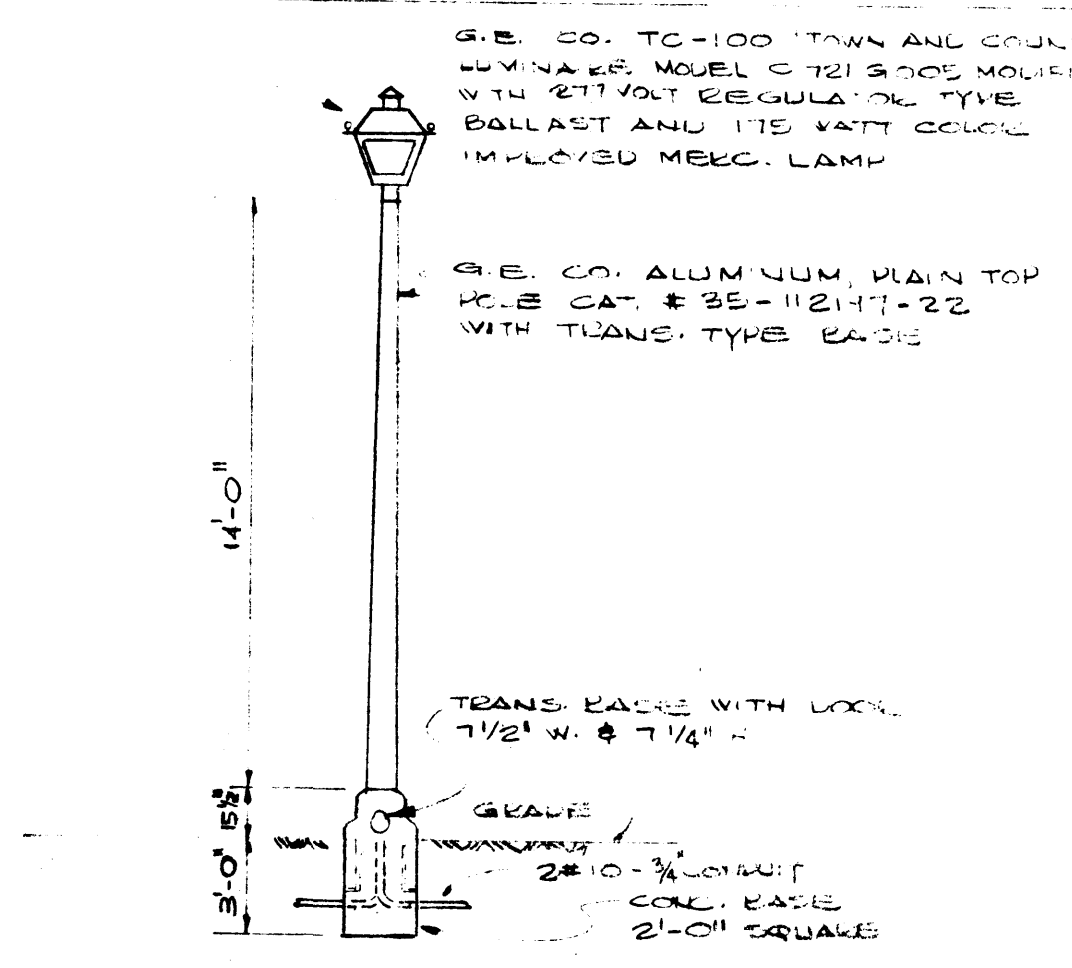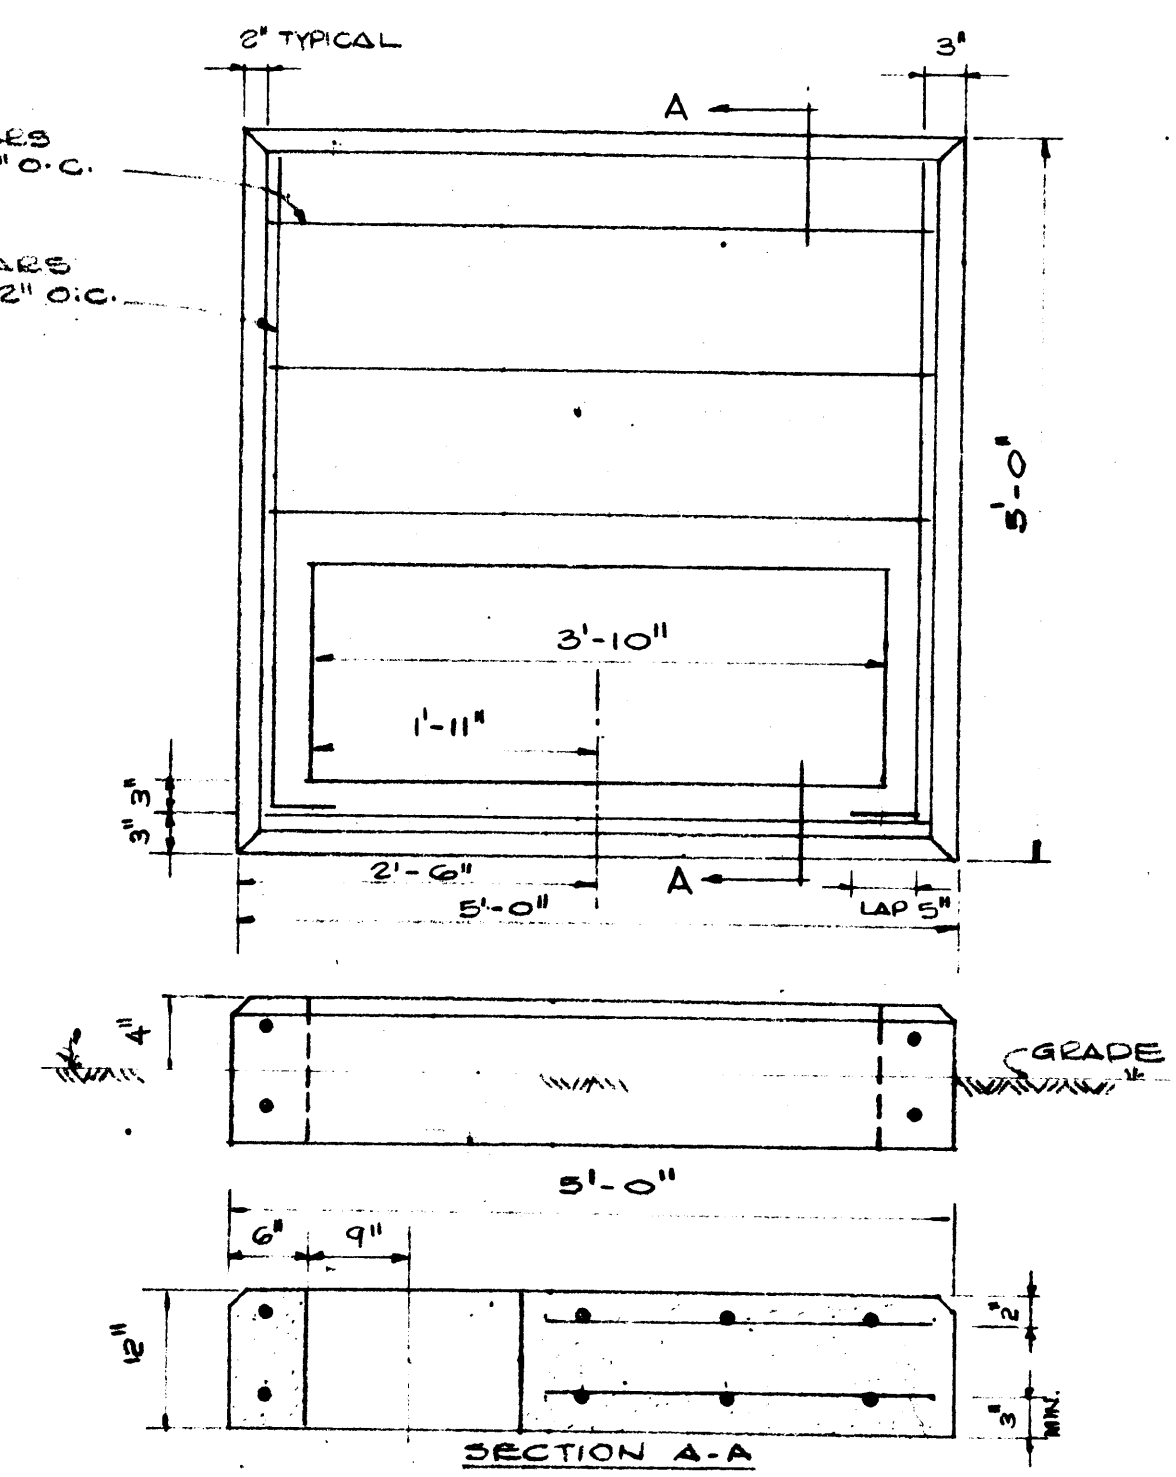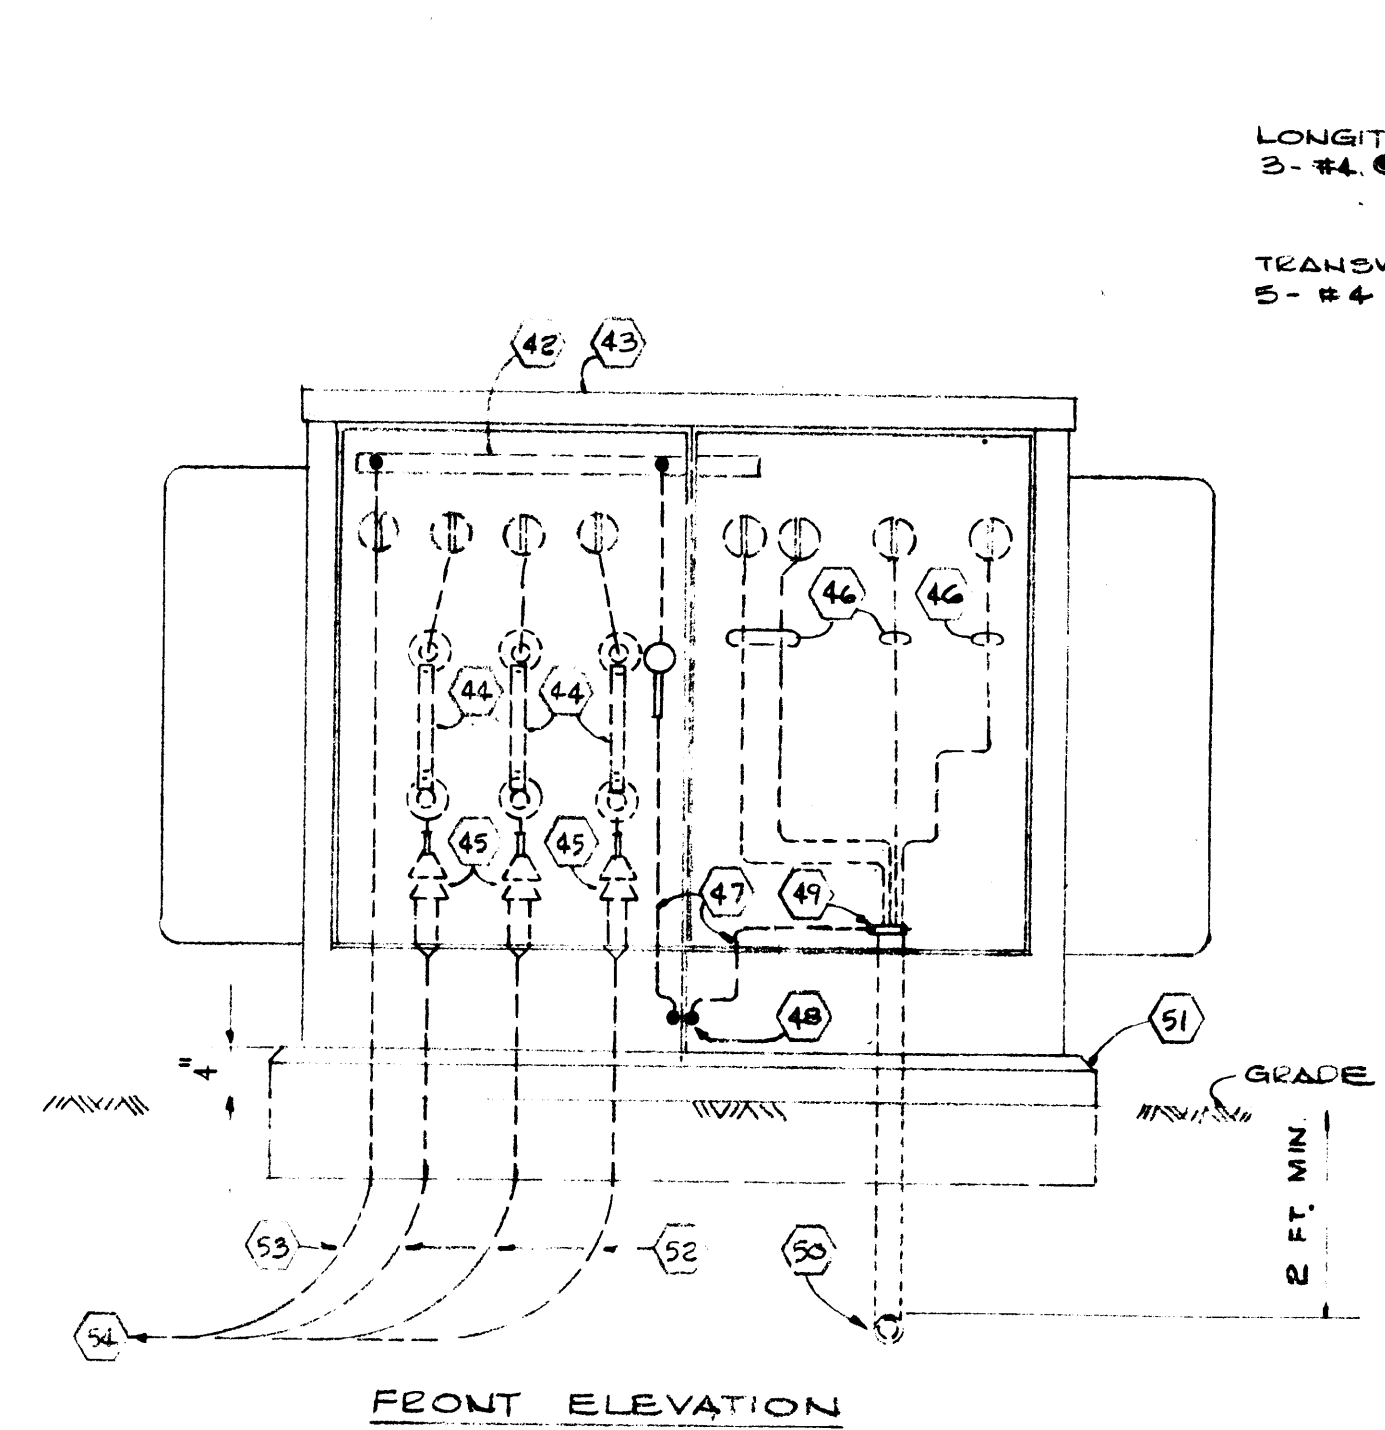

- NOTES:
1. ALL REINF. BARS #4.
 2. MIN. SPACING REINF. BARS TO OUTSIDE SURFACE OF CONCRETE 2".
 3. MIN. SPACING REINF. BAR TO BOTTOM SURFACES 3".
 4. PAD DESIGNED FOR 8000 LB. GROSS WEIGHT. OTHER EQUIP. WILL REQUIRE ADJUSTMENT OF DIMENSIONS.
 5. PROVIDE ANCHOR BOLTS WHERE, AND AS REQUIRED BY MANUFACTURER.

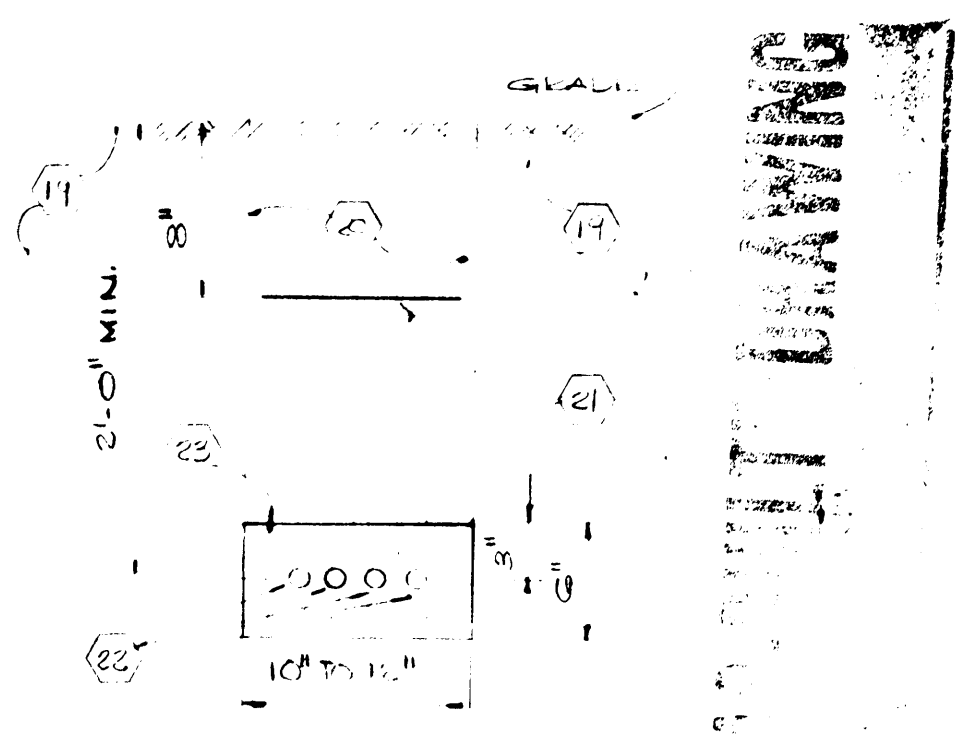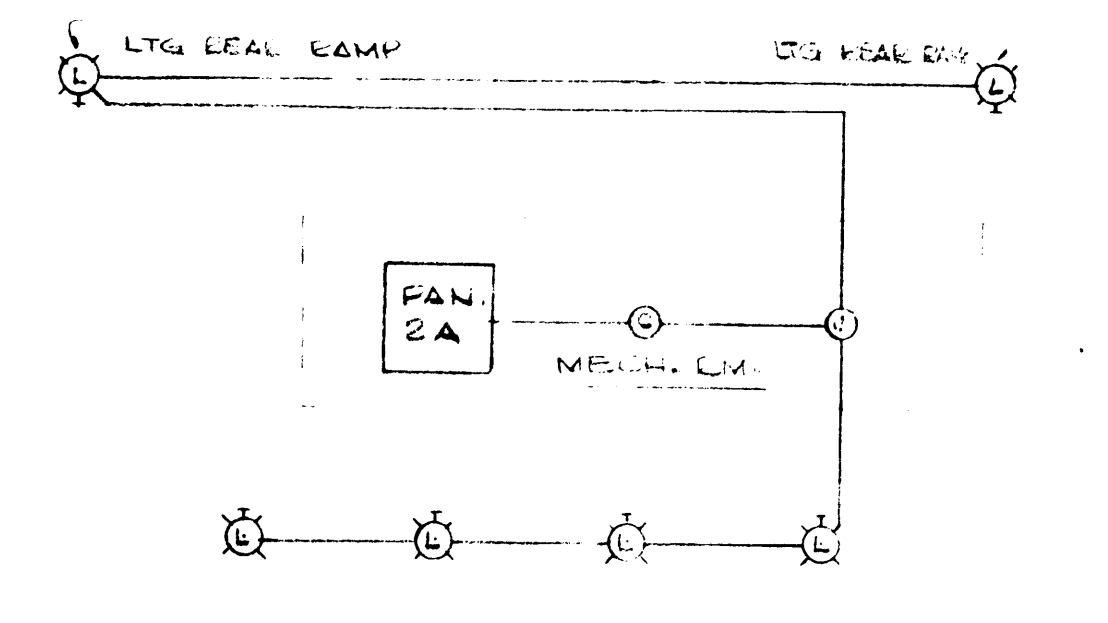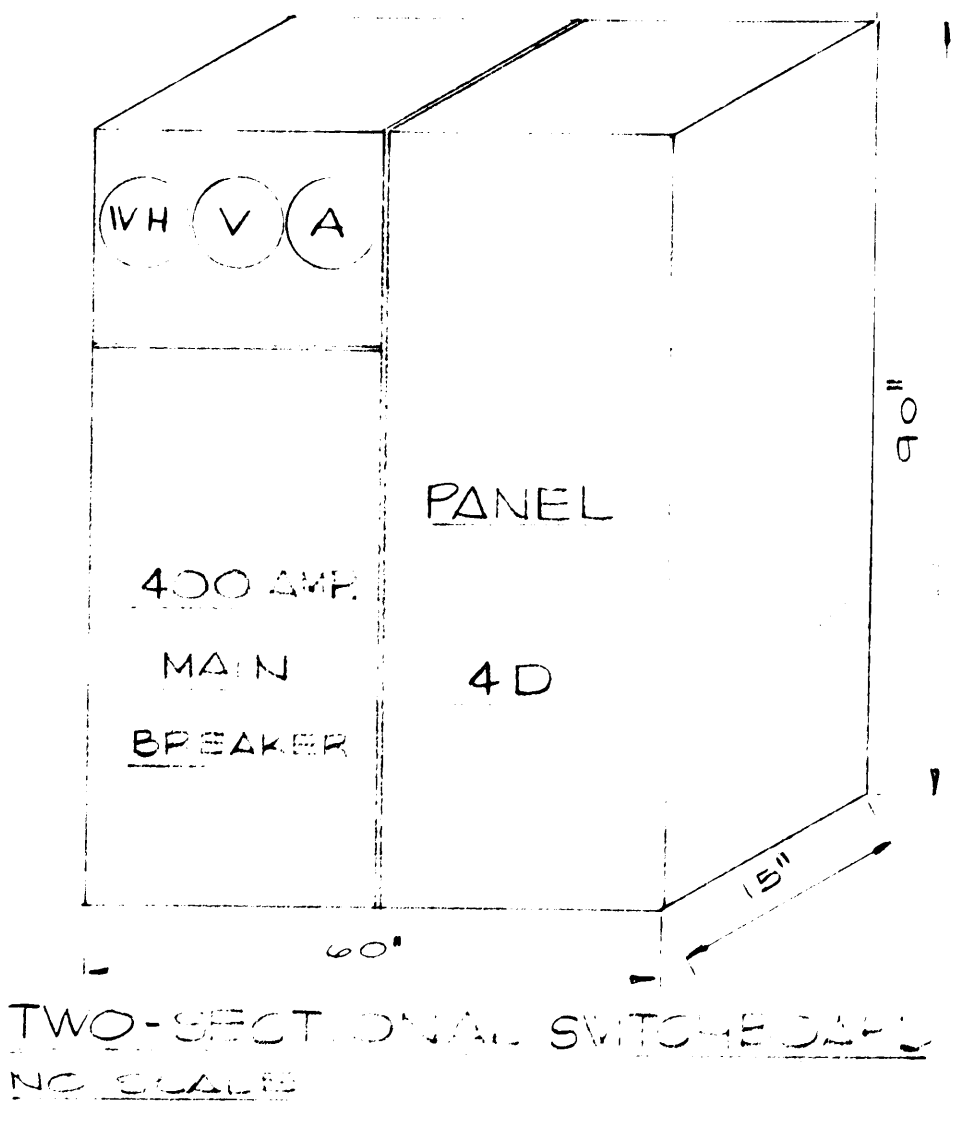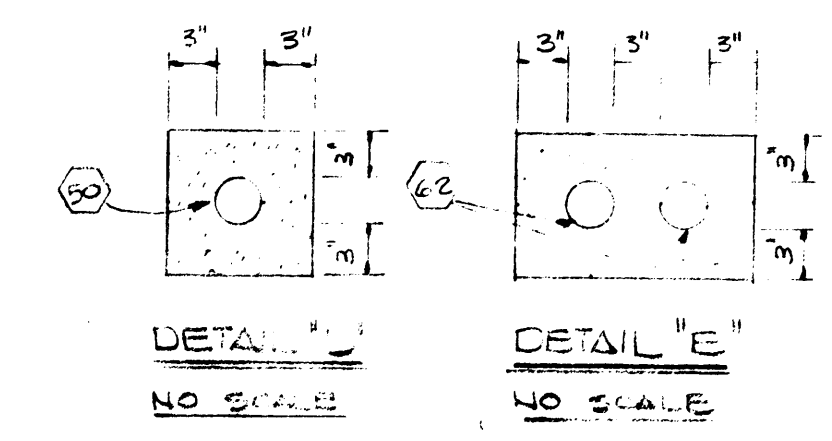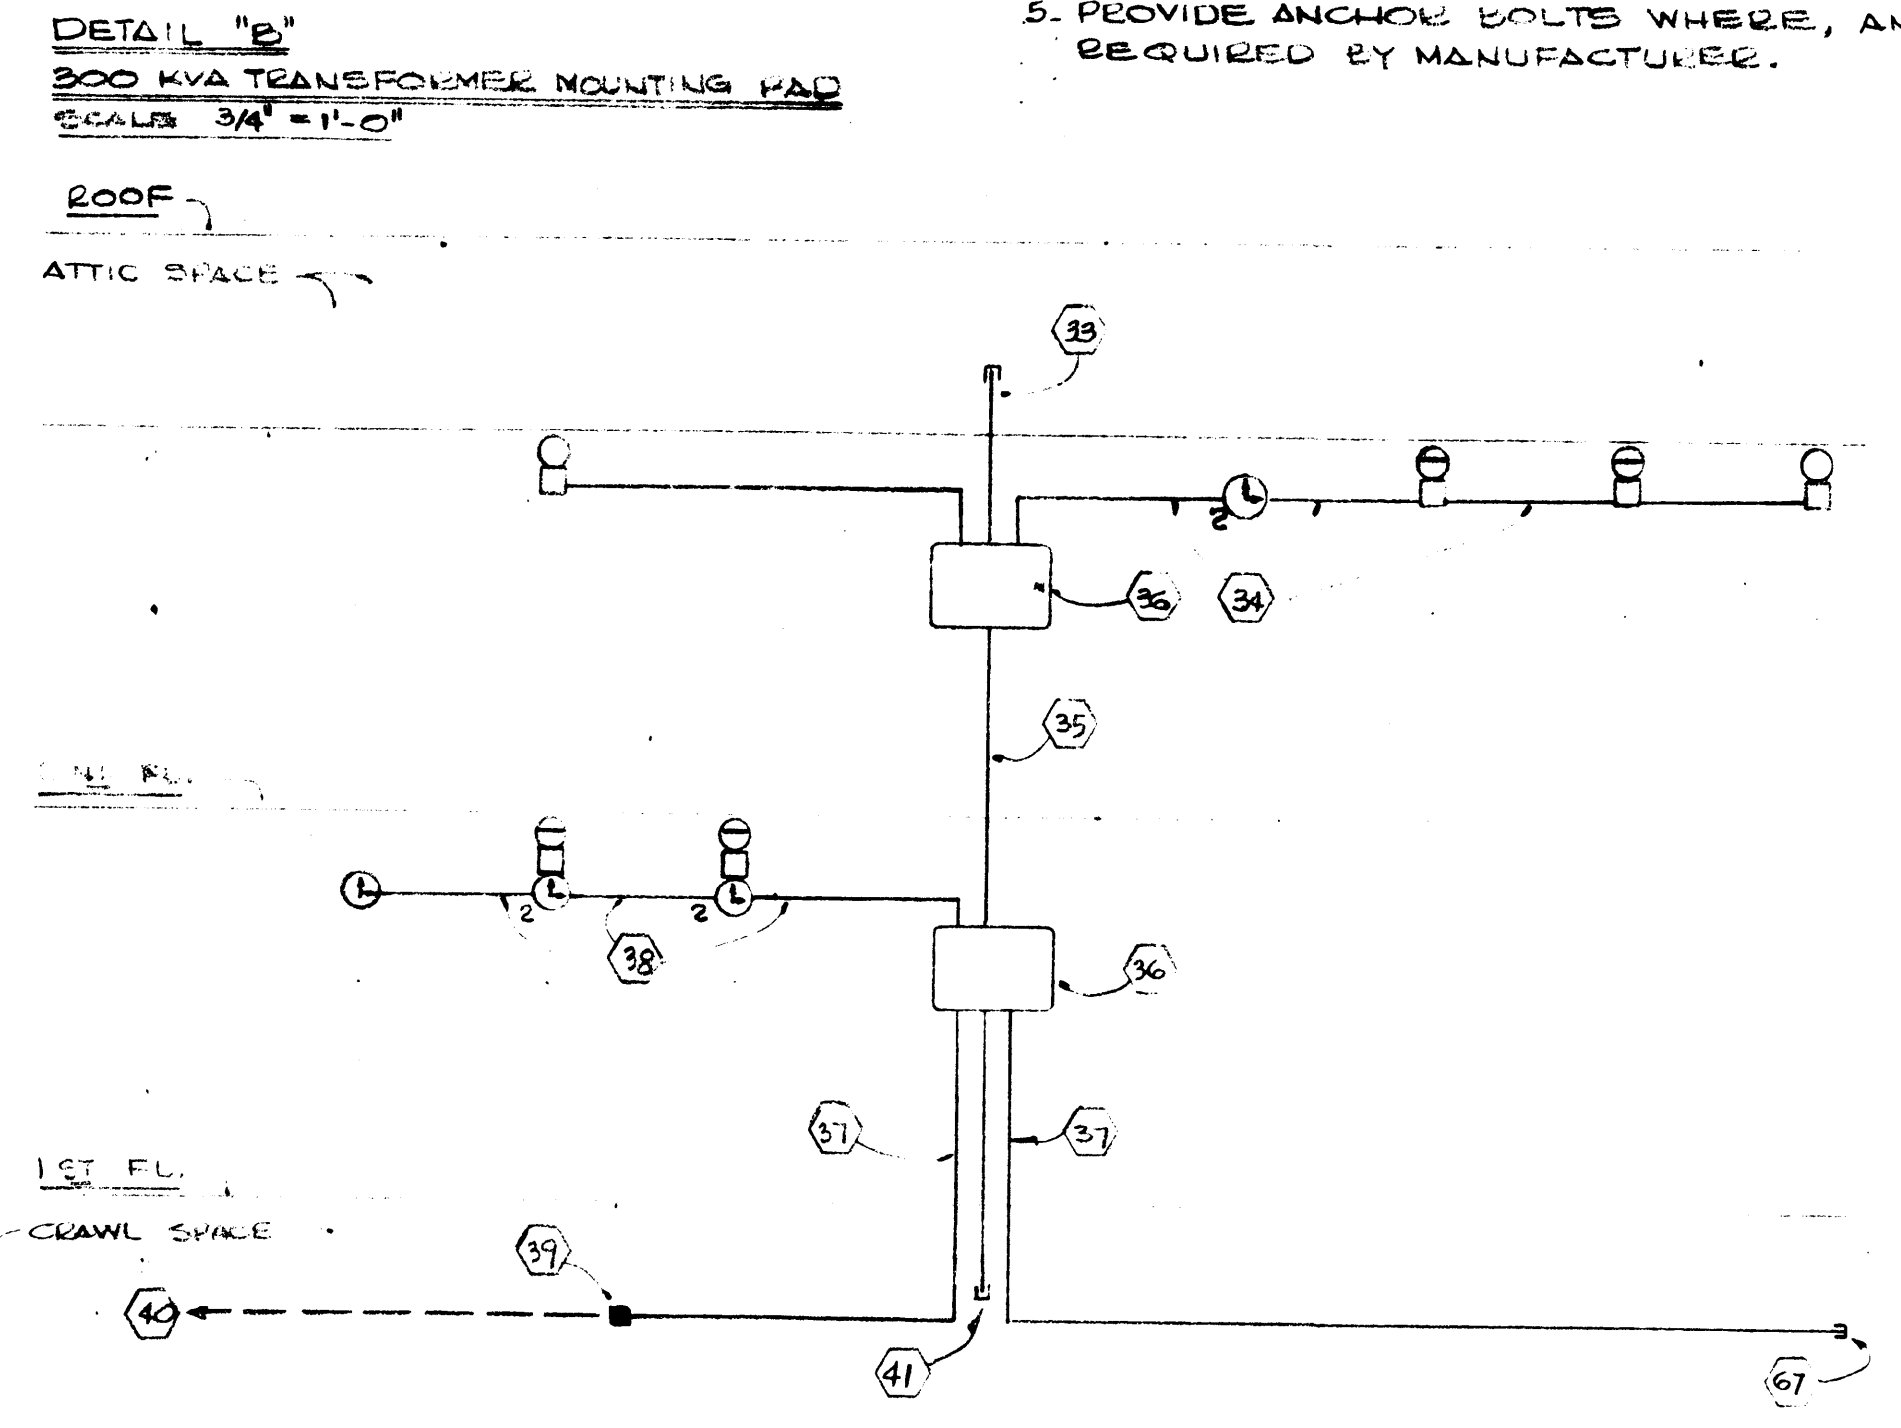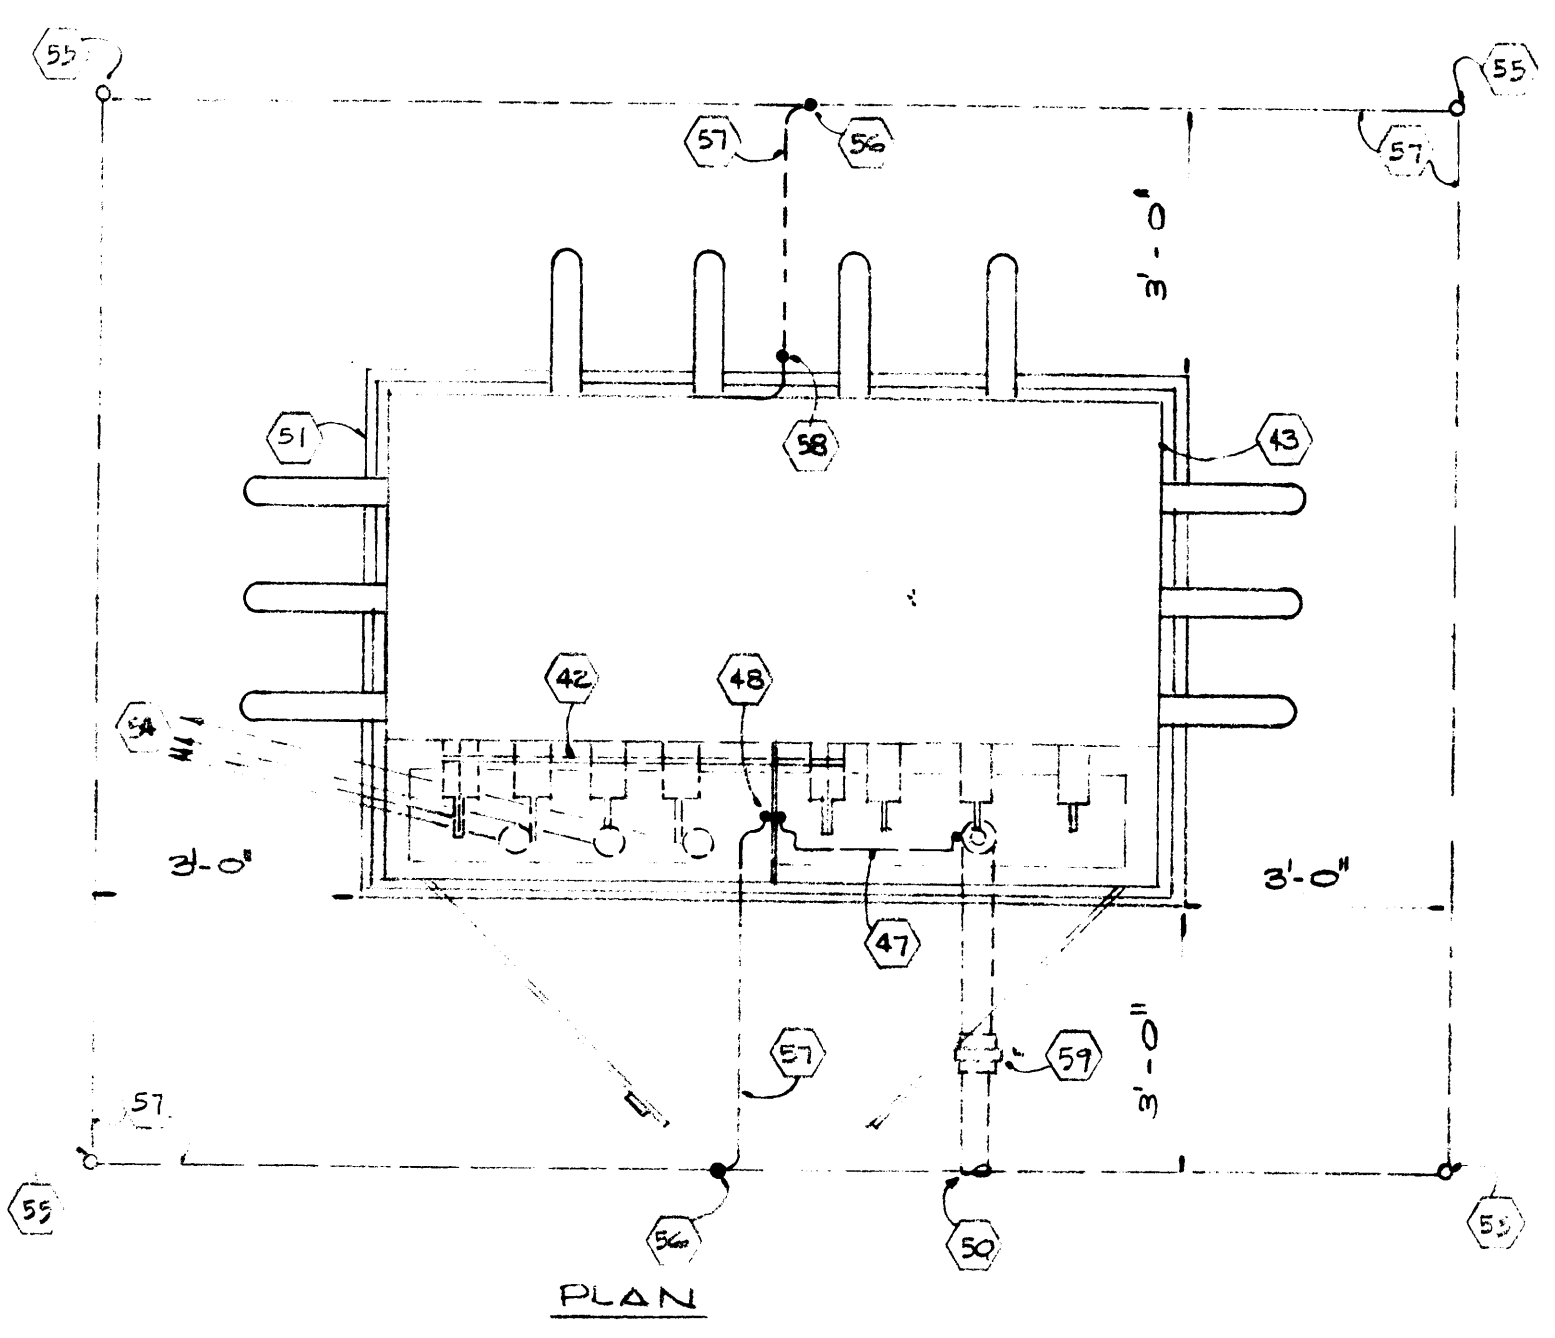

HENRY VON OESSEN & ASSOCIATES
CONSULTING ENGINEERS
WILMINGTON, N. C.
1291

PANEL SCHEDULES

PANEL SCHEDULES

NOTES

| SYM NO | CONNECTED TO | WATT LOAD | PHASE | | | CIR. BKR. | NO. WIRES | WIRE SIZE | TYPE | |
|----------------------|---|-----------|-------|------|-------|-----------|-----------|-----------|--------|------|
| | | | A | B | C | | | | | |
| 1 | LTG. CLRM. 101, PASS, MECH, CONF 5WK RM. | 3800 | 3800 | | | Y1E | 1 | 20 | 2#12TW | 3/4" |
| 2 | ENTRANCE & PROJECTION BOOTH | 3100 | 3100 | | | | | | | |
| 3 | OFFS., 104, 105, 106, 107, CHMN, 109, 110 | 3200 | | 3200 | | | | | | |
| 4 | CORR. MECHRM, TOIL, SEMINAR & STOR. | 3600 | | 3600 | | | | | | |
| 5 | CORR. MECHRM, JAN, TOIL, SECTY. | 3200 | | 3200 | | | | | | |
| 6 | SEMINAR LAB. & SIDE ENTRANCE | 3200 | | 3200 | | | | | | |
| 7 | DEMONSTRATION CLRM. | 3200 | 3200 | | | | | | | 3/4" |
| 8 | LTG. WALKWAYS | 1750 | | 1750 | | | | 20 | 2#8TW | 3/4" |
| 9 | LTG. CENTER ROWS AUDITORIUM | 1600 | | 1600 | | | | 20 | 2#12TW | 3/4" |
| 10 | SPARE | | | | | | | | | |
| 11 | LTG. OUTSIDE ROWS AUDITORIUM | 3600 | | 3600 | | | | | 2#12TW | 3/4" |
| 12 | SPARE | | | | | | | | | |
| 13 | SPARE | | | | | | | | | |
| 14 | SPARE | | | | | | | | | |
| TOTAL CONNECTED LOAD | | 28900 | 10100 | 8400 | 10300 | | | | | |

| SYM NO | CONNECTED TO | WATT LOAD | PHASE | | | CIR. BKR. | NO. WIRES | WIRE SIZE | TYPE | |
|----------------------|--|-----------|-------|-------|-------|-----------|-----------|-----------|--------|--------|
| | | | A | B | C | | | | | |
| 1 | LTG. BREAKING CLERM. | 3000 | 3000 | | | Y1E | 1 | 20 | 2#12TW | 3/4" |
| 2 | CLERM. 204, 207, FACULTY SEMINAR | 3600 | | 3600 | | | | | | |
| 3 | JAN, STOL. & CORRIDOR | 2900 | | 2900 | | | | | | |
| 4 | CLERM. 205 & OBSERVATION | 2400 | | 2400 | | | | | | |
| 5 | CLERM. 206 LIBRARY | 4000 | | 4000 | | | | | | |
| 6 | TEST CLRM, OFFICES & LAB. | 3100 | | 3100 | | | | | | |
| 7 | SPACE | | | | | | | | | |
| 8 | LTG. AUD-VIS, MECH, PARK RM. & STOR. RM. | 2900 | | 2900 | | | | | 2#12TW | 3/4" |
| 9 | STOR. OFF. CLERM. 223 | 3800 | | 3800 | | | | | 2#12TW | |
| 10 | PSYCHOLOGY LAB. | 3600 | | 3600 | | | | | 2#12TW | |
| 11 | CLERM. 223, STORAGE & OFFICES | 3800 | | 3800 | | | | | 2#12TW | 3/4" |
| 12 | SPACE | | | | | | | | | |
| 13 | SPACE | | | | | | | | | |
| 14 | SPACE | | | | | | | | | |
| 15 | PANEL 2B THRU TRANSFORMER | 23850 | 8550 | 8100 | 7200 | 3 | 70 | | 3#4TW | 1 1/2" |
| TOTAL CONNECTED LOAD | | 51950 | 19050 | 20800 | 18100 | | | | | |

DESCRIPTION

3#4, 15KV GROUNDING NEUTRAL & #4 600V DIRECT BURIAL CABLE LEGAL TO SPECIFICATIONS

REFER TO DETAIL "A" SHEET E-3 FOR CABLE INSTALLATION

PAD MOUNTED TRANSFORMER, SEE TRANSFORMER SPECIFICATIONS & DETAILS B & C

DISTRIBUTION SYSTEM PAD MOUNTED SECTIONALIZING SWITCH.

PROVIDE PRIMARY TERMINALS & CONNECT TO SWITCH.

1-3" TELEPHONE & 1-2" CLOCK SYSTEM RIGID DUCT CONDUITS, SEE DETAIL "D"

DRILL HOLE IN EXISTING MASONRY WALL FOR INSTALLATION OF 2" RIGID DUCT CONDUIT.

LEAVE AROUND CONDUIT WITH CEMENT GROUT.

3" EMPTY RIGID DUCT CONDUIT RELEASED IN CONDUIT, LEAVE W/ #16 FISH WIRE.

SEE DETAIL "D" & "E" FOR CONDUIT


STUB 5'-0" OUTSIDE BUILDING, CAP & LEAVE FOR USE BY OTHERS, SEE PLOT PLAN.

| SYM NO | CONNECTED TO | WATT LOAD | PHASE | | | CIR. BKR. | NO. WIRES | WIRE SIZE | TYPE | |
|----------------------|--|-----------|-------|------|-------|-----------|-----------|-----------|--------|------|
| | | | A | B | C | | | | | |
| 1 | RECEPT. CLERM. 101, 102, 110, CHILLER & BATH. | 1800 | 1800 | | | Y1E | 1 | 20 | 2#12TW | 3/4" |
| 2 | E.W.C. & STRIP LIGHT | 720 | | 720 | | | | | | |
| 3 | OFF. 103, 104, 105, CONF. 110 | 1800 | | 1800 | | | | | | |
| 4 | SPARE | | | | | | | | | |
| 5 | RECEPT. OFF. 105, 106, 107, 108, 109, 110, 111 | 1800 | | 1800 | | | | | 2#12TW | 3/4" |
| 6 | CORRIDOR CLEANING | 720 | | 720 | | | | | | |
| 7 | OFF. 106, 107, 108 | 1620 | | 1620 | | | | | | |
| 8 | CORR. CLEANING | 720 | | 720 | | | | | | |
| 9 | PUMP PUMP | 720 | | 720 | | | | | | |
| 10 | SEMINAR, STORAGE, SCIENCE | 1620 | | 1620 | | | | | | |
| 11 | E.W.C. & STRIP LIGHT | 720 | | 720 | | | | | | |
| 12 | DEMSTY, OBSERV. FORK ENTITLNT. | 1710 | | 1710 | | | | | | |
| 13 | SCIENCE CLRM. TABLES | 720 | | 720 | | | | | | |
| 14 | MECH. JAN. AUDITORIUM FLOOR | 1440 | | 1440 | | | | | | |
| 15 | SCIENCE CLRM. TABLES | 720 | | 720 | | | | | | |
| 16 | MECH. TOIL, U. PATROX, 15, 16, 17, 18 | 1410 | | 1410 | | | | | | |
| 17 | LOBBY CLEANING | 720 | | 720 | | | | | | |
| 18 | AUDITORIUM CLEANING | 720 | | 720 | | | | | | |
| 19 | LTG. OBSERVATION & CLOCK | 600 | | 600 | | | | | | |
| 20 | CUH #1 | 130 | | 130 | | | | | | |
| 21 | RECEPT. CORRIDOR CLEANING | 720 | | 720 | | | | | | |
| 22 | CUH #2 | 130 | | 130 | | | | | | |
| 23 | RECEPT. CORRIDOR CLEANING | 720 | | 720 | | | | | | |
| 24 | CUH #3 | 85 | | 85 | | | | | | |
| 25 | CUH #4 | 85 | | 85 | | | | | | |
| 26 | REF. AFTER COOLER (V.S.H.R.) | 480 | | 480 | | | | | | |
| 27 | LTG. REAR RAMP & ENT. LTG. | 1200 | | 1200 | | | | | | |
| 28 | LTG. LOBBY | 1000 | | 1000 | | | | | 2#12TW | 3/4" |
| 29 | LTG. STAGE AREAS (INCAND.) | 1500 | | 1500 | | | | | 2#12TW | 3/4" |
| 30 | LTG. EXTERIOR FLOOR LTG. | 1600 | | 1600 | | | | | 2#12TW | 3/4" |
| 31 | CONTROL COMPRESSOR (1/2 H.P.) | 1200 | | 1200 | | | | 20 | 2#12TW | 3/4" |
| 32 | LTG. STAGE AREAS | 1650 | | 1650 | | | | 20 | 2#12TW | 3/4" |
| 33 | SPACE | | | | | | | 20 | | |
| 34 | SPACE | | | | | | | 20 | | |
| 35 | ELEC. WATER HEATER #1 | 5000 | | 2500 | 2500 | 2 | 30 | | 2#10TW | 3/4" |
| 36 | ELEC. WATER HEATER #2 | 5000 | | 2500 | 2500 | 2 | 30 | | 2#10TW | 3/4" |
| TOTAL CONNECTED LOAD | | 40700 | 16165 | 9040 | 15495 | | | | | |

| SYM NO | CONNECTED TO | WATT LOAD | PHASE | | | CIR. BKR. | NO. WIRES | WIRE SIZE | TYPE | |
|----------------------|---|-----------|-------|------|------|-----------|-----------|-----------|--------|------|
| | | | A | B | C | | | | | |
| 1 | RECEPT. READING ROOM BOOTH (10) | 1800 | 1800 | | | Y1E | 1 | 20 | 2#12TW | 3/4" |
| 2 | CLERM. 204, 207, FACULTY SEMINAR (10) | 1800 | 1800 | | | | | | | |
| 3 | READING ROOM BOOTH (10) | 1800 | | 1800 | | | | | | |
| 4 | TEST RM, OFF. 215, CHMN. OFF. (10) | 1800 | | 1800 | | | | | | |
| 5 | CHILLER UNIT, CLERM. 206 (10) | 1620 | | 1620 | | | | | | |
| 6 | TEST RM, SECTY. OFF. CHMN. OFF. (10) | 1800 | | 1800 | | | | | | |
| 7 | MECH. SECTY. CLERM. OFFS. | 1800 | | 1800 | | | | | | |
| 8 | LTG. (INCAND.) TOIL, DARK RM. & OBSERV. | 750 | | 750 | | | | | | |
| 9 | RECEPT. CLERM. 223, STOR. OFF. CLERM. 223 | 1500 | | 1500 | | | | | | 3/4" |
| 10 | STOR. 227, PSYCHOLOGY LAB (7) | 1460 | | 1460 | | | | | | 3/4" |
| 11 | AUD-VIS. CLERM. 223, PREV. #4 (9) | 1620 | | 1620 | | | | | | 3/4" |
| 12 | STOR. 228, PSYCHO. LAB. (8) | 1640 | | 1640 | | | | | | 3/4" |
| 13 | CORRIDOR CLEANING (1) | 720 | | 720 | | | | | | 3/4" |
| 14 | CORRIDOR CLEANING (1) | 720 | | 720 | | | | | | 3/4" |
| 15 | CORRIDOR CLEANING (1) | 720 | | 720 | | | | | | 3/4" |
| 16 | CORRIDOR CLEANING (1) | 720 | | 720 | | | | | | 3/4" |
| 17 | PRE SEMINAR COFFEE MAKER | 300 | | 300 | | | | | | |
| 18 | RECEPT. ELEC. T.V. WATER COOLER (1) | 720 | | 720 | | | | | 2#12TW | 3/4" |
| 19 | PREV. #4 | 480 | | 480 | | | | | 2#12TW | 3/4" |
| 20 | SPACE | | | | | | | | | |
| 21 | SPACE | | | | | | | | | |
| 22 | SPACE | | | | | | | | | |
| 23 | SPACE | | | | | | | | | |
| 24 | SPACE | | | | | | | | | |
| TOTAL CONNECTED LOAD | | 24070 | 8070 | 9300 | 7100 | | | | | |

PANEL SCHEDULE (CONT'D)

| SYM NO | CONNECTED TO | WATT LOAD | PHASE | CIR. BKR. | NO. WIRES | WIRE SIZE | TYPE | COND. SIZE | REMARKS | |
|--------------|-----------------------------|-----------|-------|-----------|-----------|-----------|------|------------|---------|------|
| | | | | | | | | | | A |
| 1 | FIRE ALARM CONTROL CABINET | 1000 | 1000 | | | Y1E | 1 | 20 | 3#12TW | 3/4" |
| 2 | EMERG. LTG. HALLWAY 2ND FL. | 1600 | | 1600 | | | | | 2#12TW | 3/4" |
| 3 | EMERG. LTG. HALLWAY 1ST FL. | 1600 | | 1600 | | | | | 2#12TW | 3/4" |
| 4 | FIRE ALARM CONTROL CABINET | 1000 | | 1000 | | | | | 3#12TW | 3/4" |
| 5 | EXIT LIGHTS | 360 | | 360 | | | | | 2#12TW | 3/4" |
| MANV. BROKEN | | 2560 | 2560 | 2600 | | | | | 2#8TW | 3/4" |

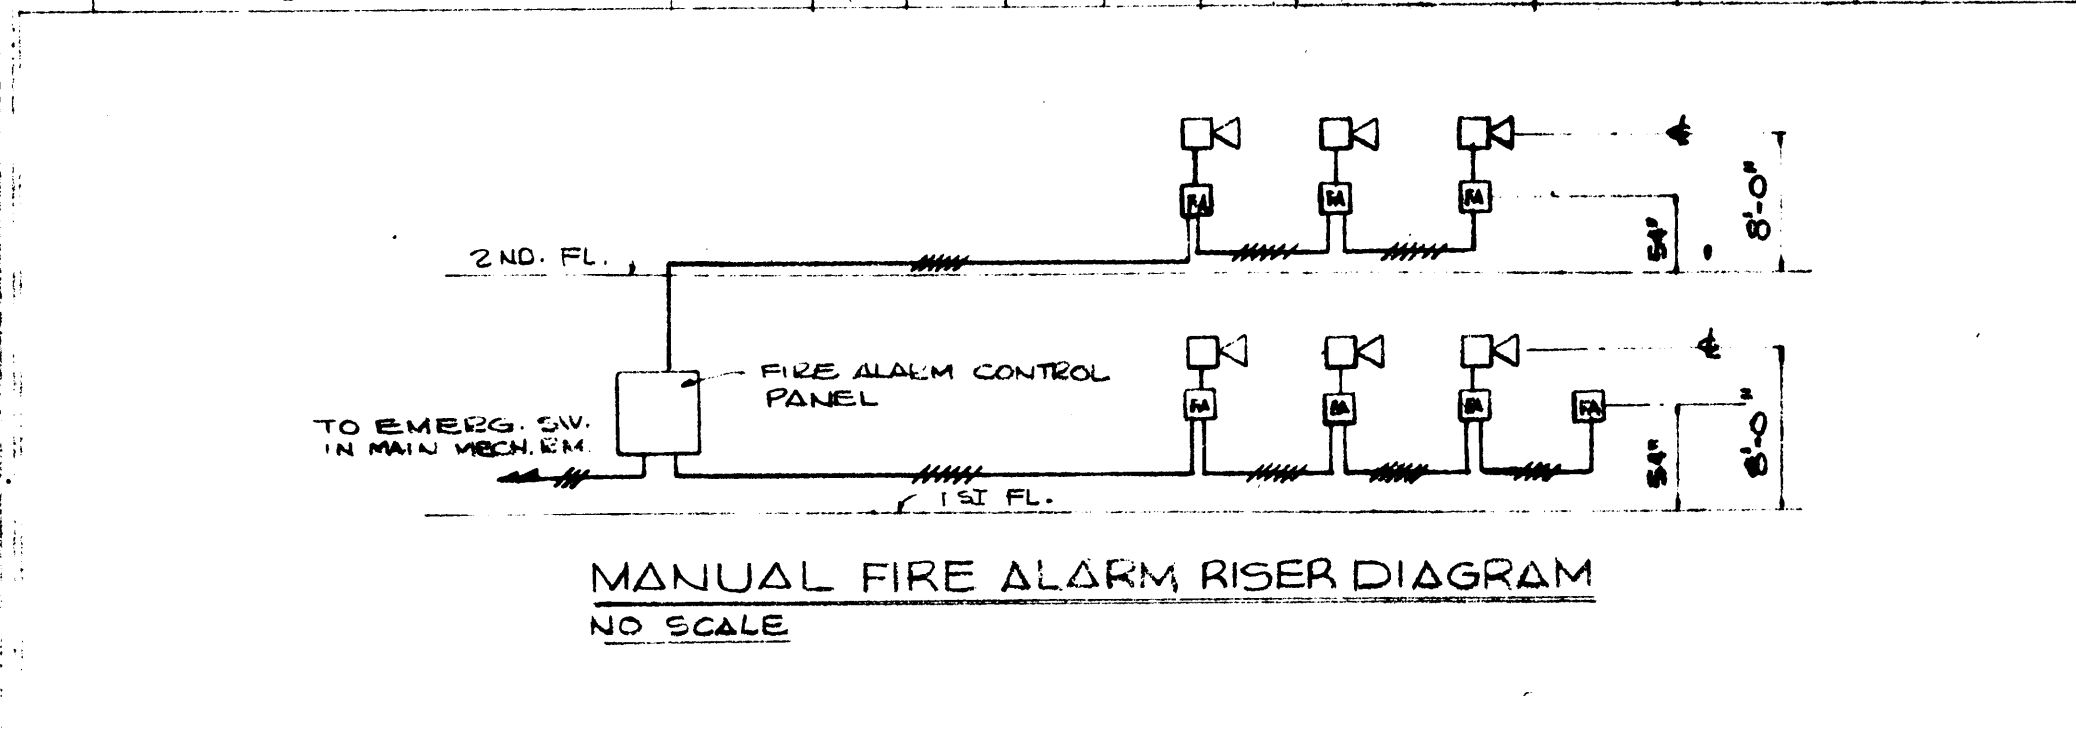


FIXTURE SCHEDULE


| SYM | MAX. WATTS | NO. & SIZE LAMPS | DESCRIPTION | MANUFACTURED | MFG. HT. |
|-----|------------|------------------|---|-------------------------|------------------|
| R | 50 | 1-ROTIC ON/ES | STRIP LIGHT | PITTSBURGH # A-140 | CEILING |
| A | 200 | 4-F40T12 ON/ES | 2'x4' 4-LAMP FLOOR W/VIRGIN ACRYLIC LENS IN STEEL FRAME. | DAYBRITE 44T42-WF882-4 | CEILING |
| B | 100 | 2-F40T12 ON/ES | VIRGIN ACRYLIC FRAMED LENS IN 2'x4' RECESSED HOUSING. | DAYBRITE #44T22-WF882-4 | CEILING |
| C | 300 | 6-F40T12 ON/ES | 4'x4' STEEL HOUSING W/89% REFLECTANCE & ALUM. PARACHEX GOLD LOUVER. | PITTSBURGH BLACK 644P8 | CEILING |
| D | 100 | 2-F40T12 ON/ES | 2'x4' 2-LAMP FLOOR W/VIRGIN ACRYLIC LENS IN STEEL FRAME. | DAYBRITE 44T22-WF882-4 | CEILING |
| E | 200 | 200 PAR46 | ADJUSTMENT INCANDESCENT FIXTURE W/ LONGITUDINAL GRILLE. | MARCO #JA 5-T272 | CEILING |
| G | 100 | 1-100 WIF | CAST AL. HOUS. W/ BICOLORED FIN. & ROUND THER. HOUS. GL. SPHERE & GUIDED CONVEYER OUTLET. | PEREGRINE #WB 6-10 | CEILING |
| H | 150 | 1-150 WIF | RECESSED FIXTURE W/ RECESSED PEREGRINE LENS. | MARCO #JE 8-T33 | CEILING |
| K | 300 | 1-300 WIF | INCANDESCENT FIXTURE W/ HEAT SHIELD. BLACK PHENOLIC POLYGRIDDLE Baffle. | MARCO #JE 10-T190 | CEILING |
| L | 200 | 4-50W | WEATHERTIGHT CAST ALUM. CARRIAGE LANTERN W/ FROSTED CHIMNEY. | HADCO # 81427 | MT. 10' AW. H.E. |
| N | 200 | 4-F40T12 ON/ES | 2'x4' VIRGIN ACRYLIC FRAMED LENS. | DAYBRITE 44T42-WF882-4 | CEILING |
| P | 100 | 2-F40T12 ON/ES | INDUSTRIAL W/UP-LITE FOR 277 VOLT. SERVICE. | MILLER # 8102-04 | CEILING |
| Q | 200 | 4-F40T12 ON/ES | 2'x4' 4-LAMP LAMPS W/VIRGIN ACRYLIC LENS IN STEEL FRAME. | DAYBRITE 44T42-WF882-4 | CEILING |
| X | 20 | 2-6W T-5 | CAST AL. HOUSING & STENCIL W/ LAMP LIFE MULTIPLE, DOWN LIGHT. (277V) ARROW RIGHT. | MSPHILBEN # 300-6MA | CEILING |
| Y | 20 | 2-6W T-5 | CAST AL. HOUSING & STENCIL W/ LAMP LIFE MULTIPLE, DOWN LIGHT. (277V) ARROW LEFT. | MSPHILBEN # 300-6MA | CEILING |
| Z | 20 | 2-6W T-5 | CAST AL. HOUSING & STENCIL W/ LAMP LIFE MULTIPLE, DOWN LIGHT. (277V) ARROW UP. | MSPHILBEN # 300-6MA | CEILING |

PANEL SCHEDULES


| SYM NO | CONNECTED TO | WATT LOAD | PHASE | | | CIR. BKR. | NO. WIRES | WIRE SIZE | TYPE | |
|--------|--------------------|-----------|-------|------|------|-----------|-----------|-----------|--------|------|
| | | | A | B | C | | | | | |
| 1 | BOILER PUMP | 2000 | 666 | 666 | 668 | FAH | 3 | 20 | 3#12TW | 3/4" |
| 2 | BOILER | 2000 | 666 | 666 | 668 | FAH | 3 | 20 | 3#12TW | 3/4" |
| 3 | CHILLER PUMP | 6200 | 2066 | 2066 | 2068 | FAH | 3 | 20 | 3#12TW | 3/4" |
| 4 | COOLING TOWER PUMP | | | | | | | | | |

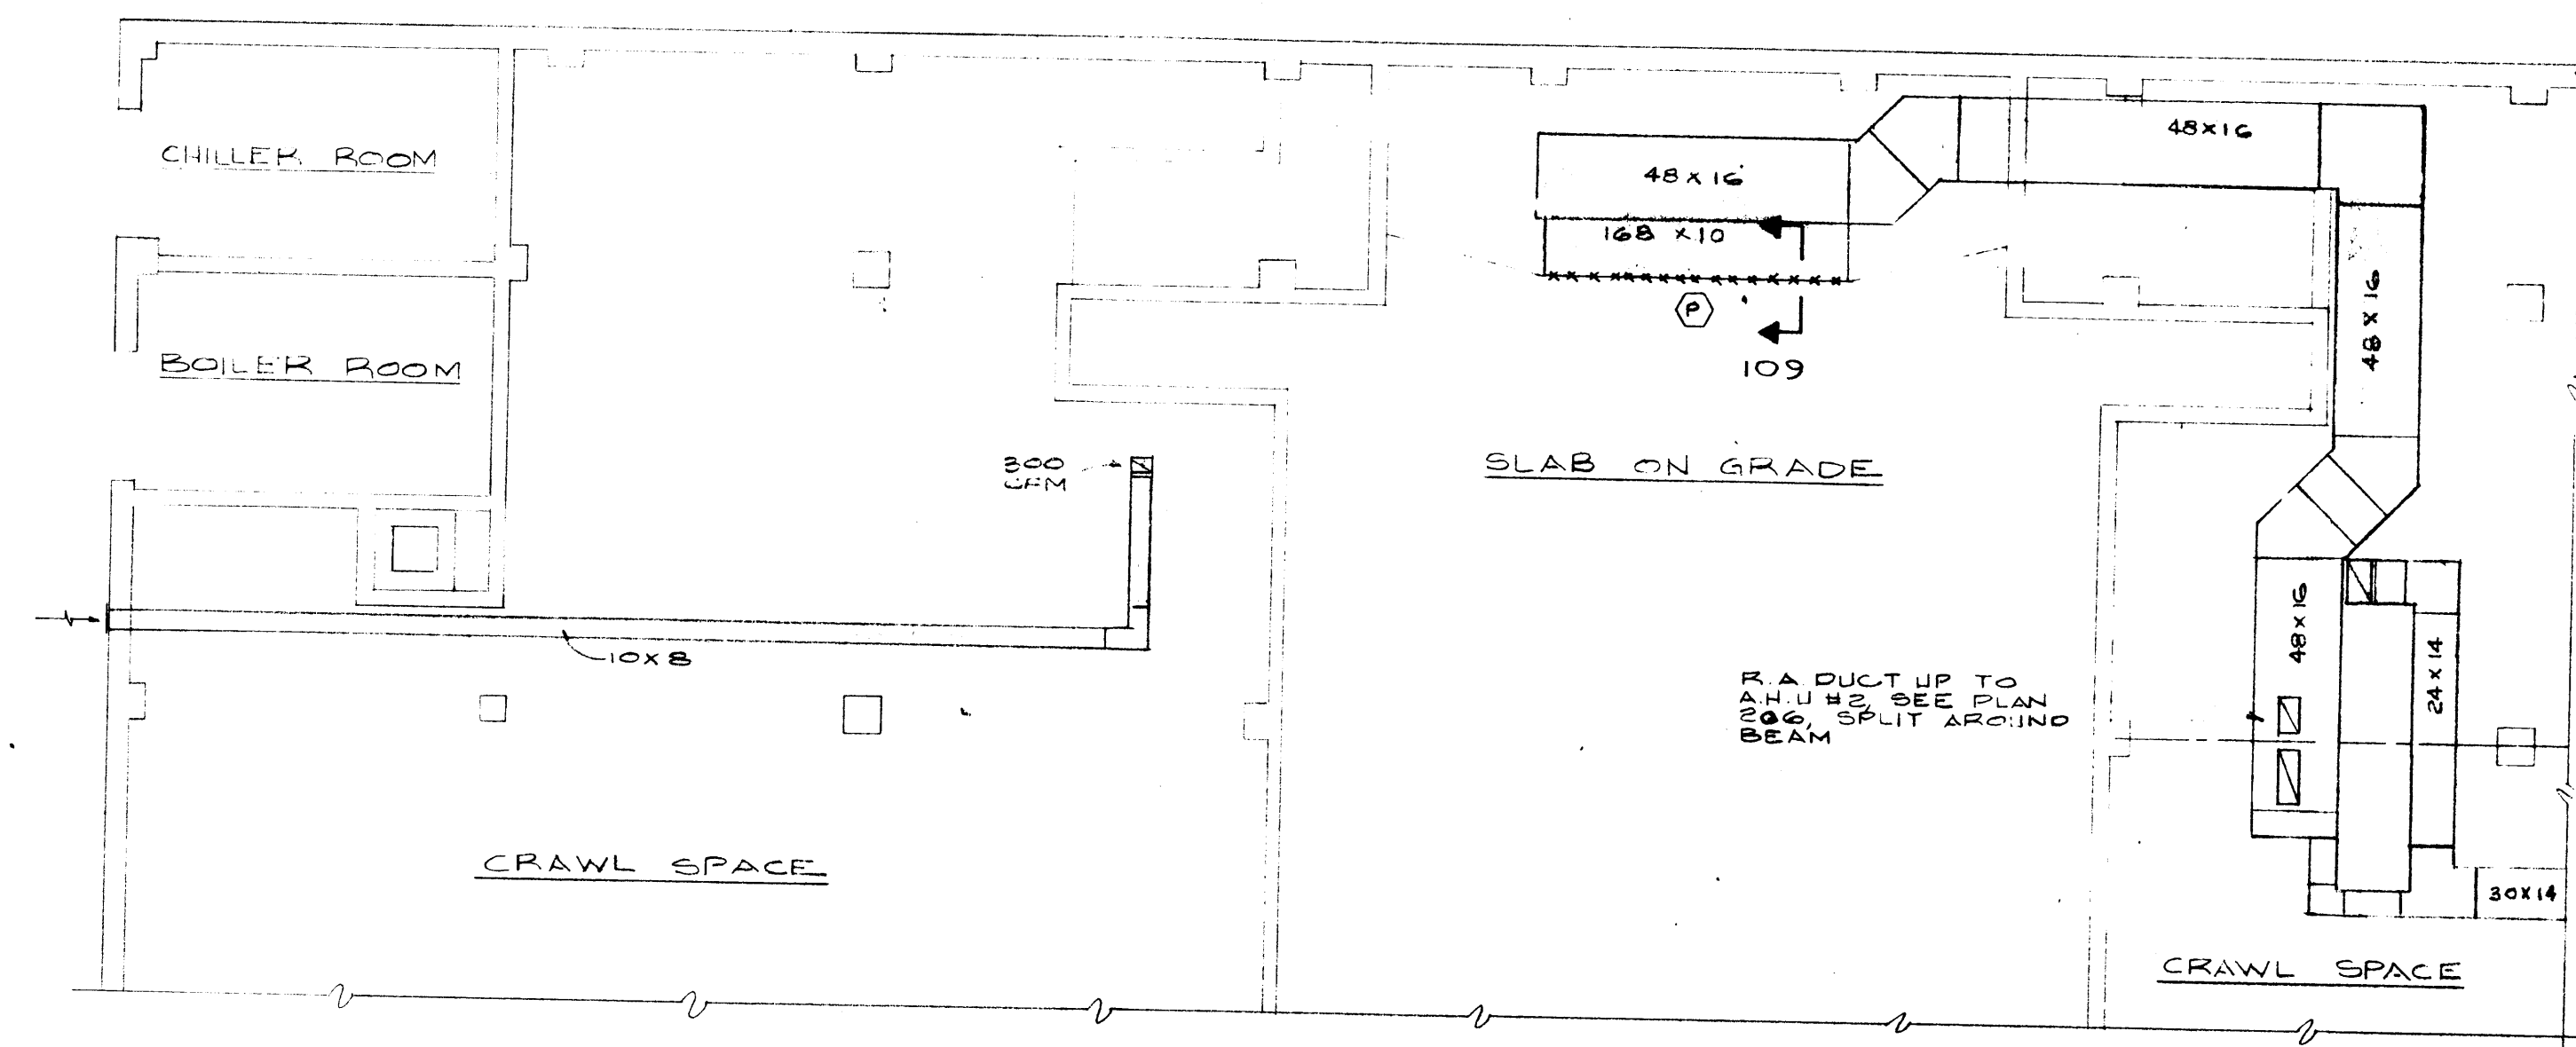


101 PARTIAL FOUNDATION PLAN
SCALE: 1/8"=1'-0"

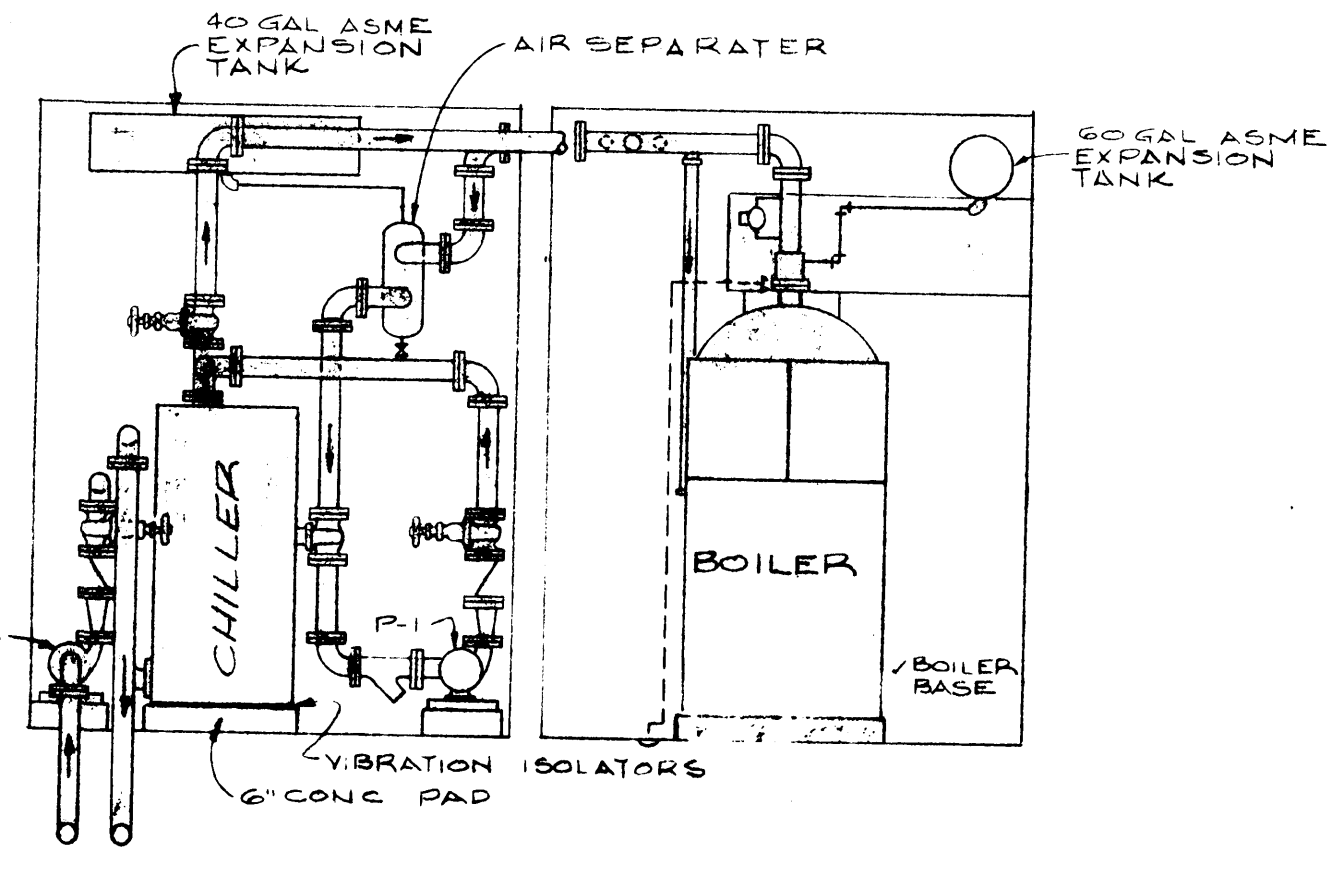


103 SECTION
SCALE: 1/4"=1'-0"

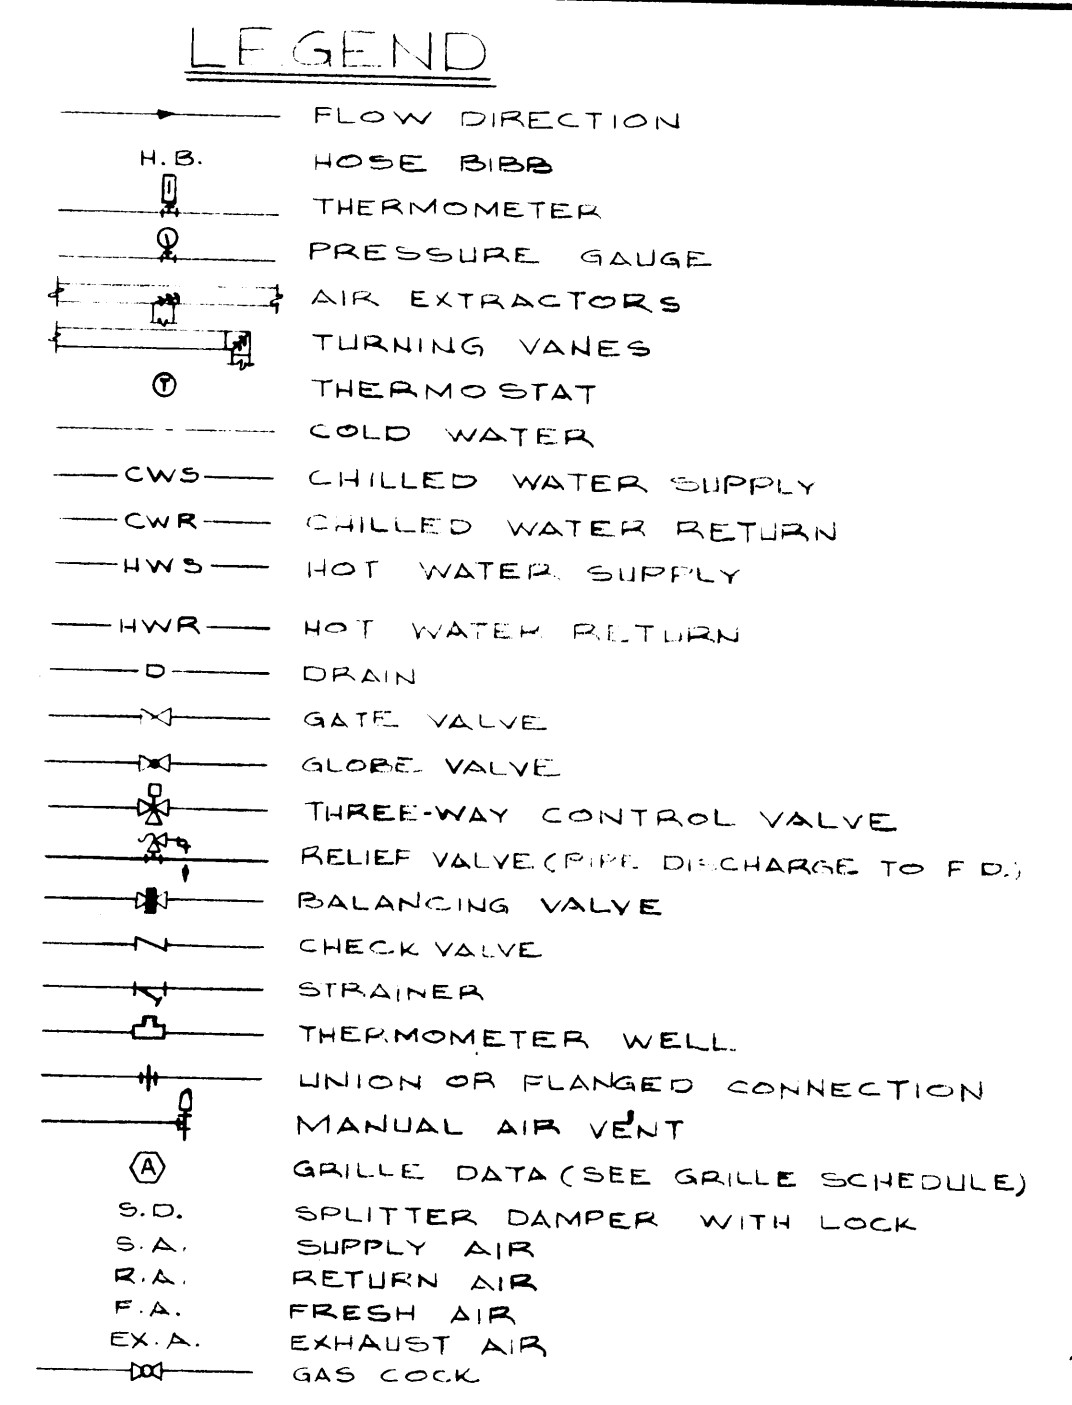


NOTE:
ACTUAL DIMENSIONS FOR FIREBOX SHALL BE IN ACCORDANCE WITH THE PUBLISHED RECOMMENDATIONS PROVIDED BY THE BURNER MANUFACTURER

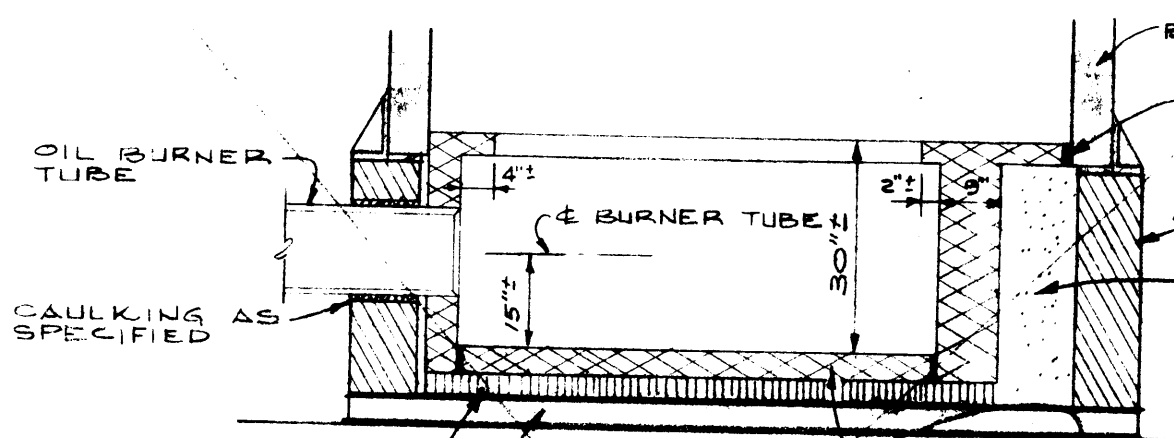


104 FIREBOX DETAILS

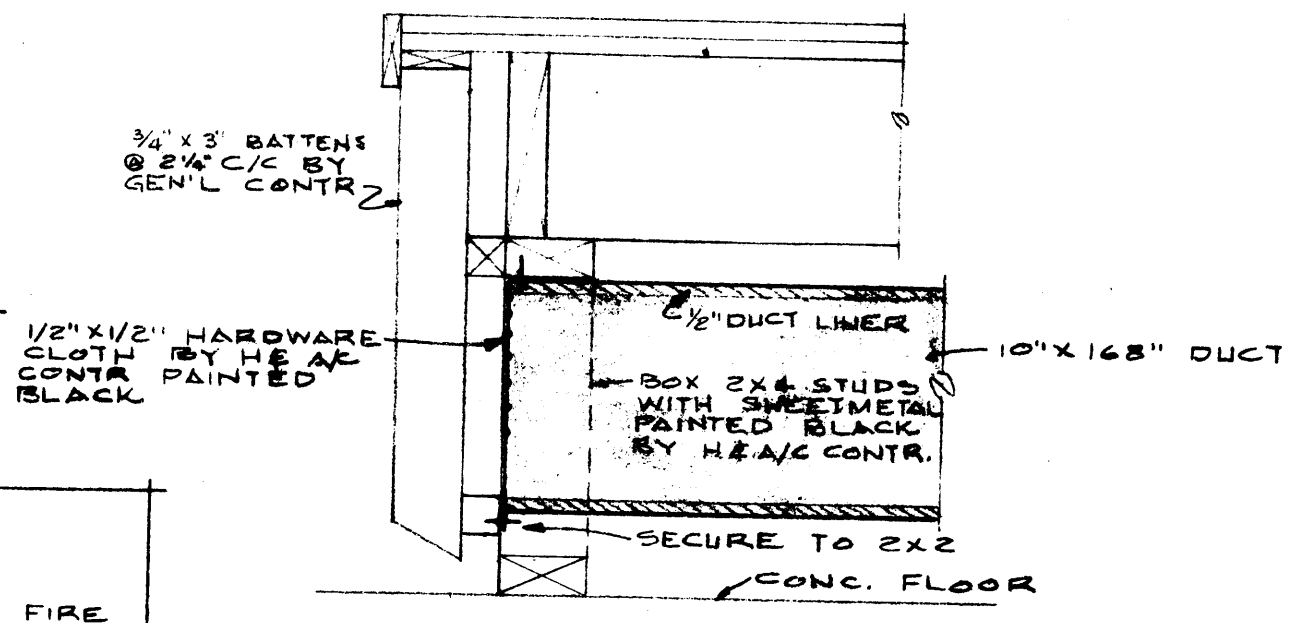

109 SECTION
NO SCALE

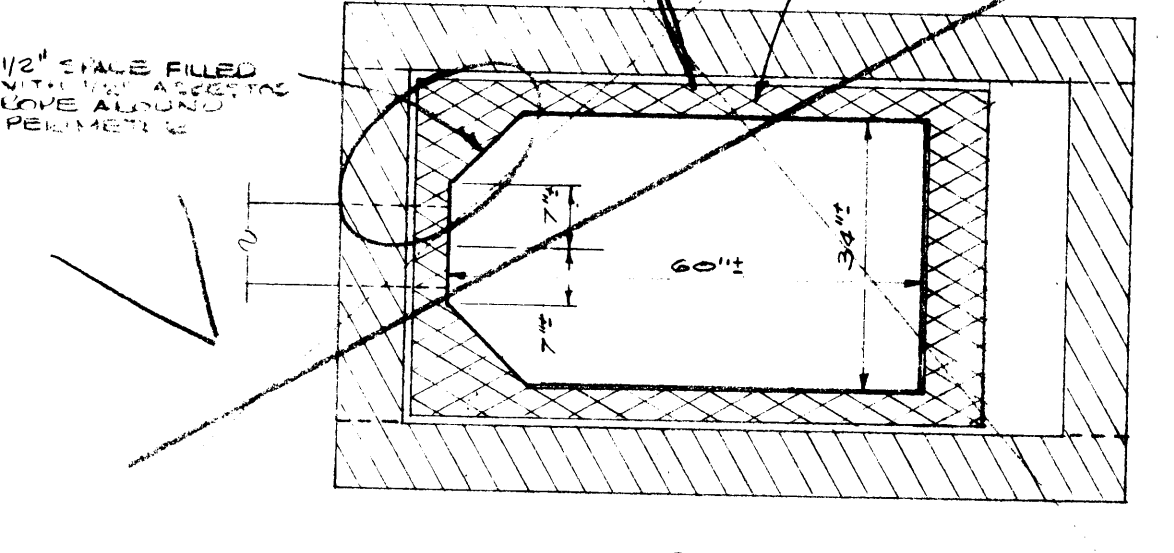


106 OIL LINE COVER DETAIL
NO SCALE

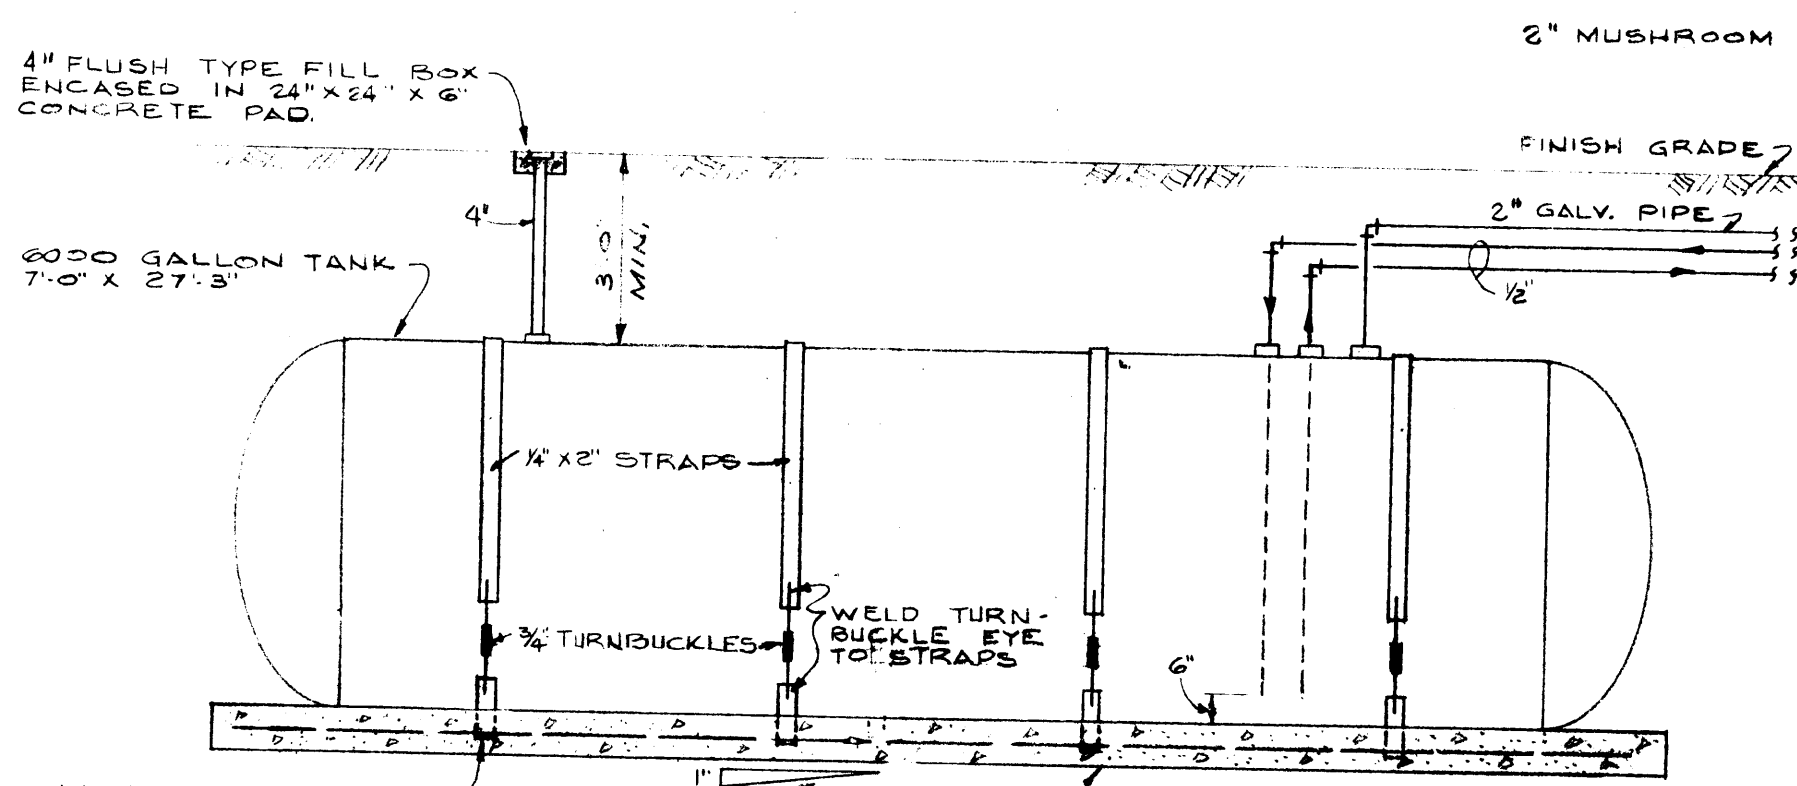


105 OIL PIPING & TANK DETAIL
NO SCALE


| HEATING & AIR CONDITIONING LOADS | |
|----------------------------------|----------|
| 50% NET BOILER CAP | 1677 MBH |
| BLDG HEATING LOAD | 900 MBH |
| SPARE CAPACITY | 777 MBH |
| TOTAL BUILDING COOLING LOAD | 90 TON |

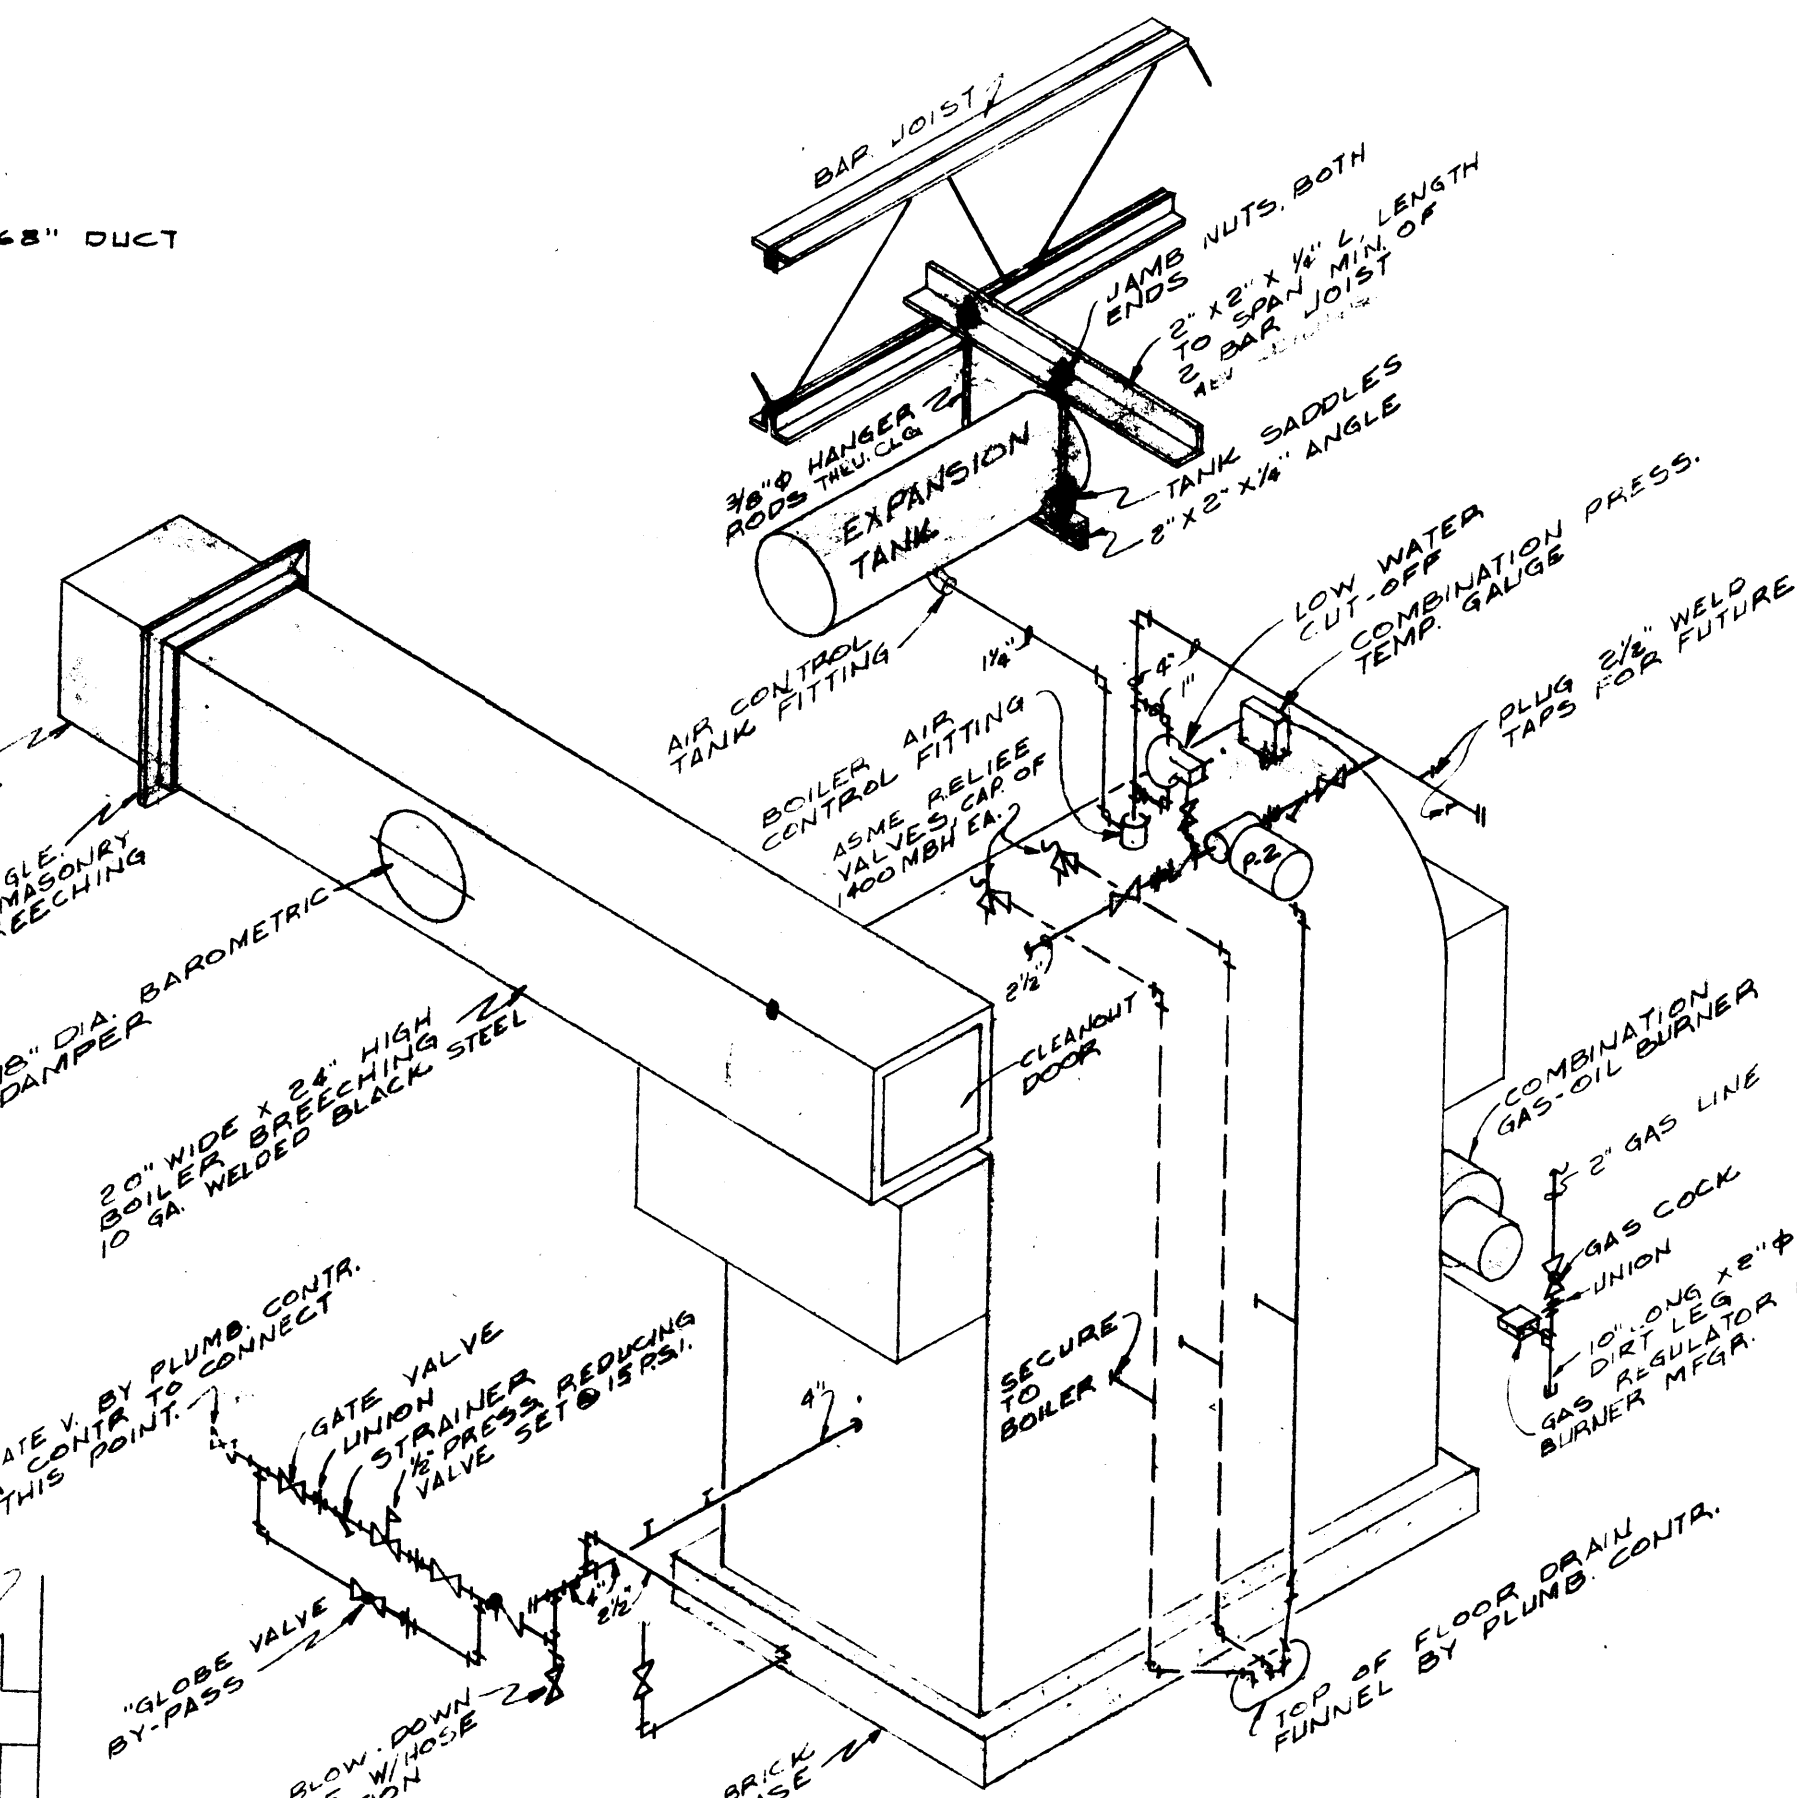

107 BOILER PIPING ISOMETRIC
NO SCALE

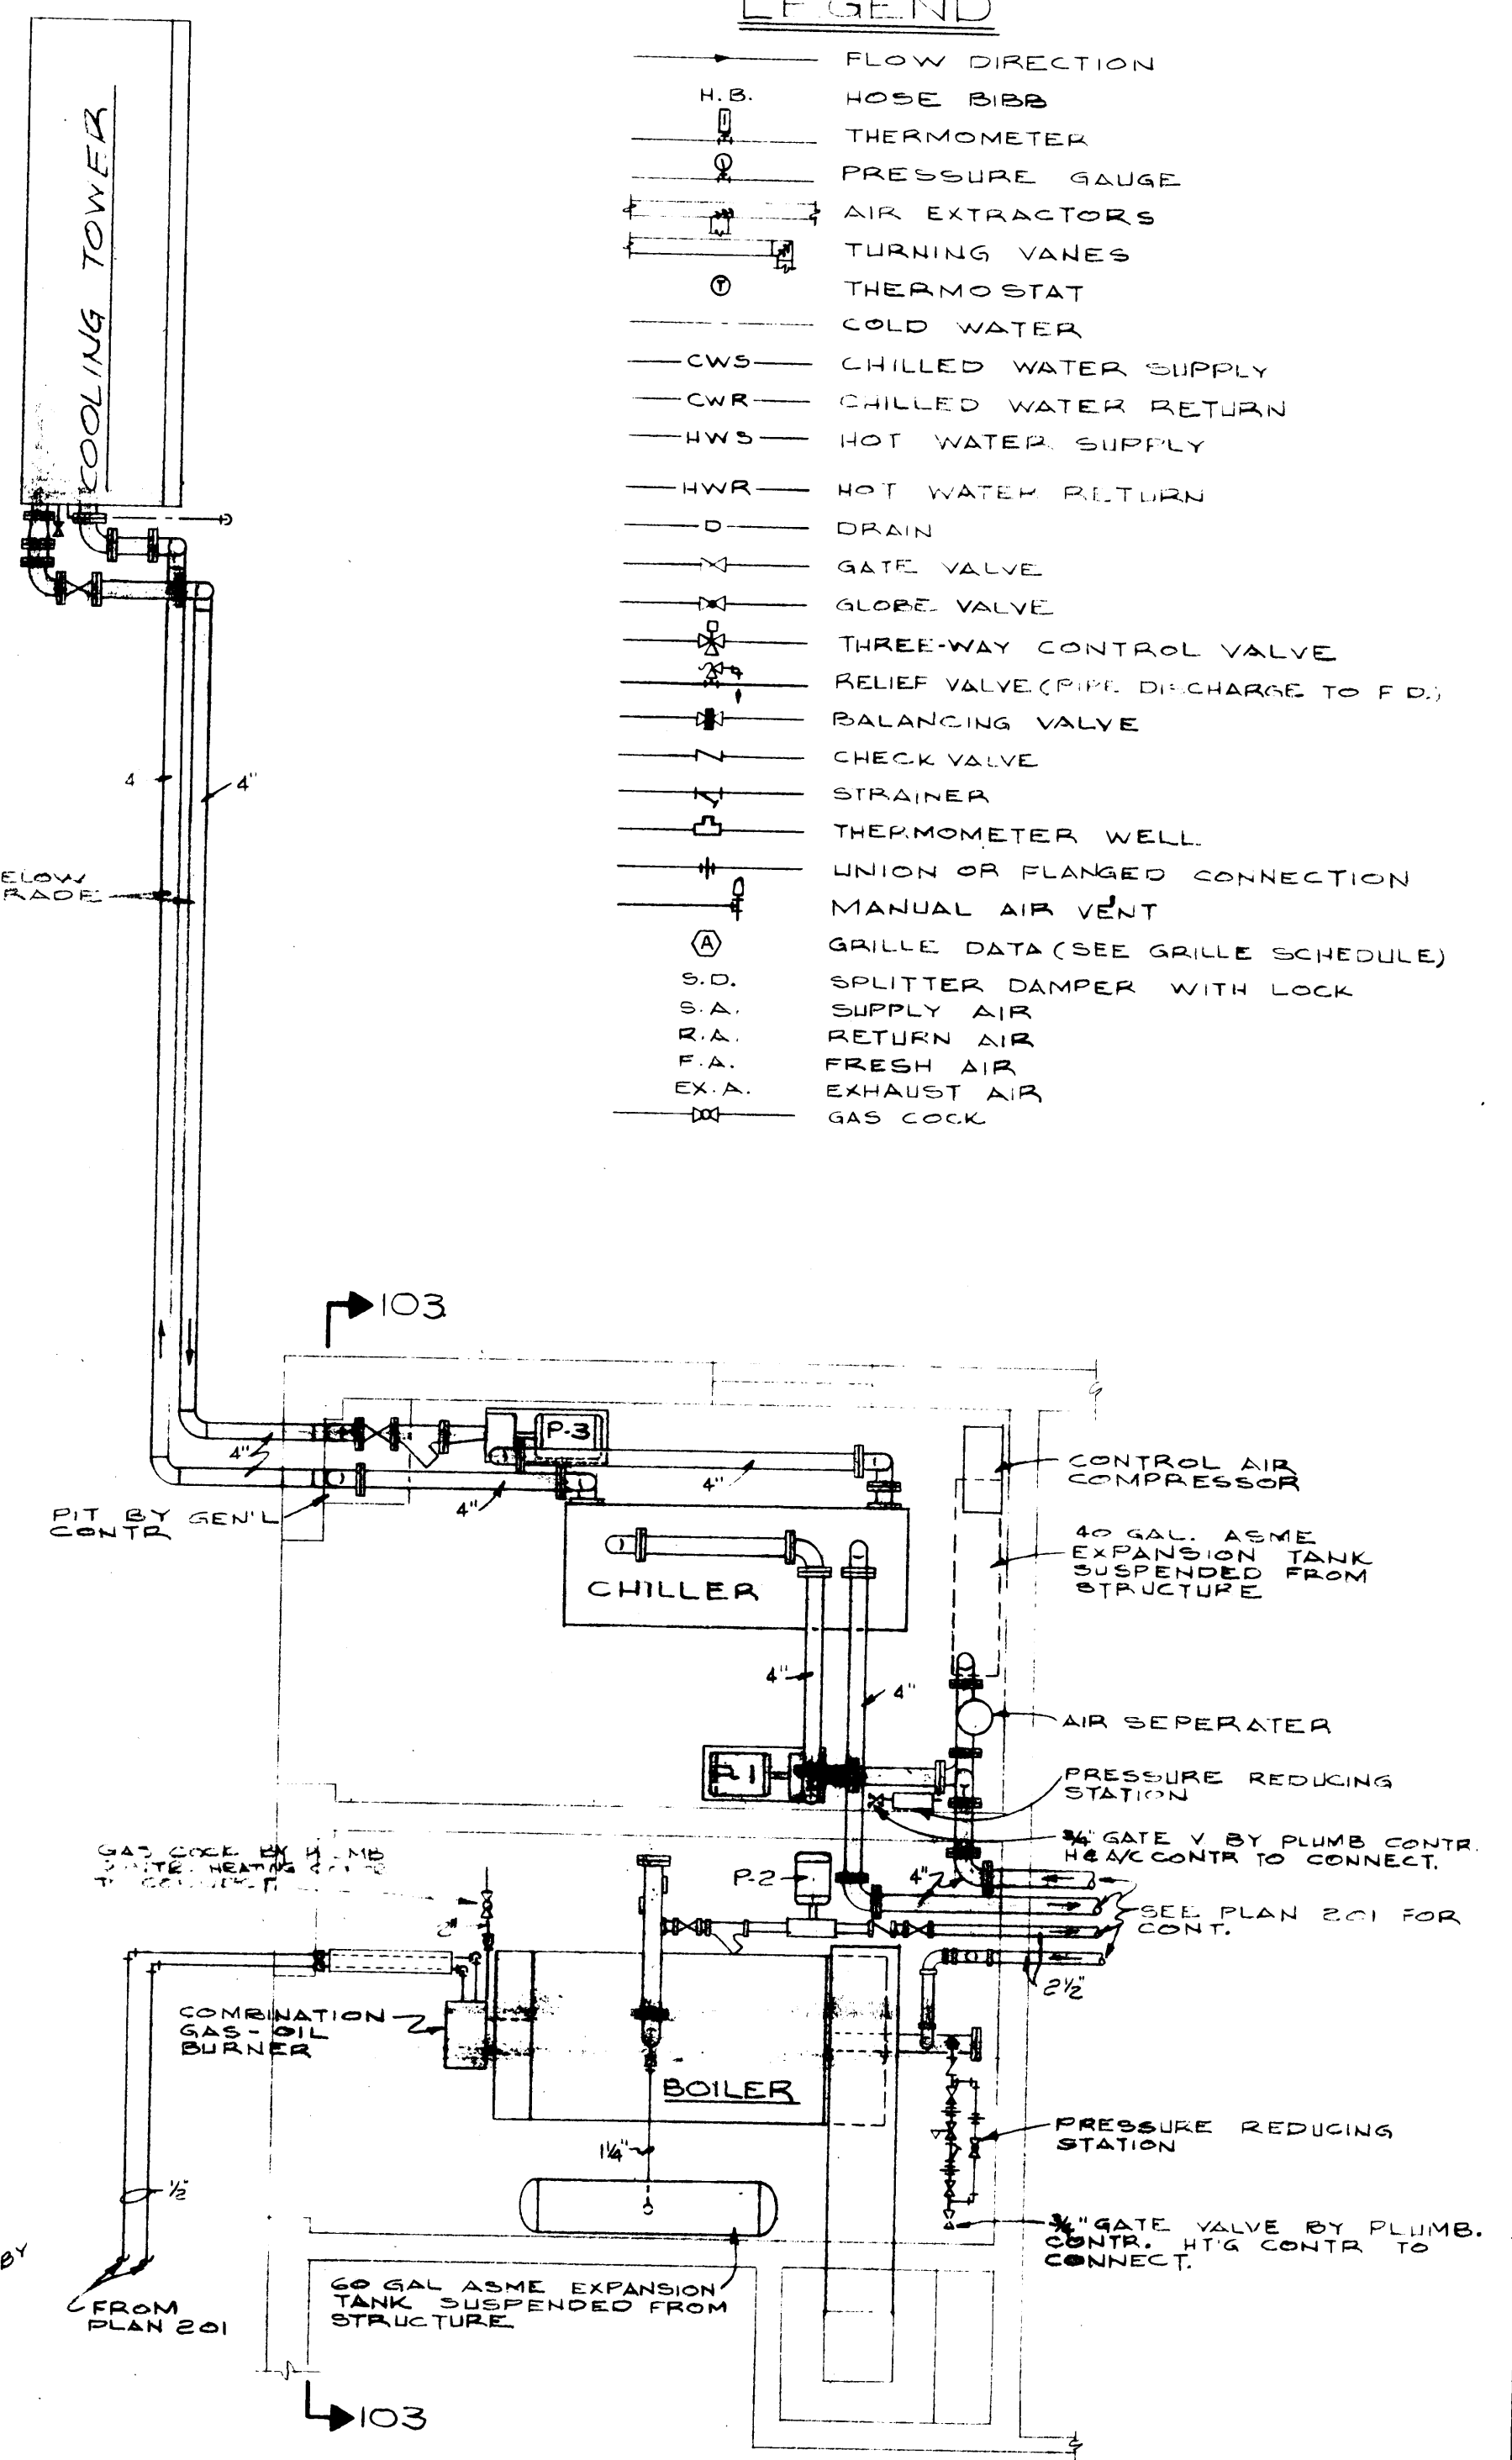


102 CHILLER & BOILER RM PLAN
SCALE: 1/4"=1'-0"

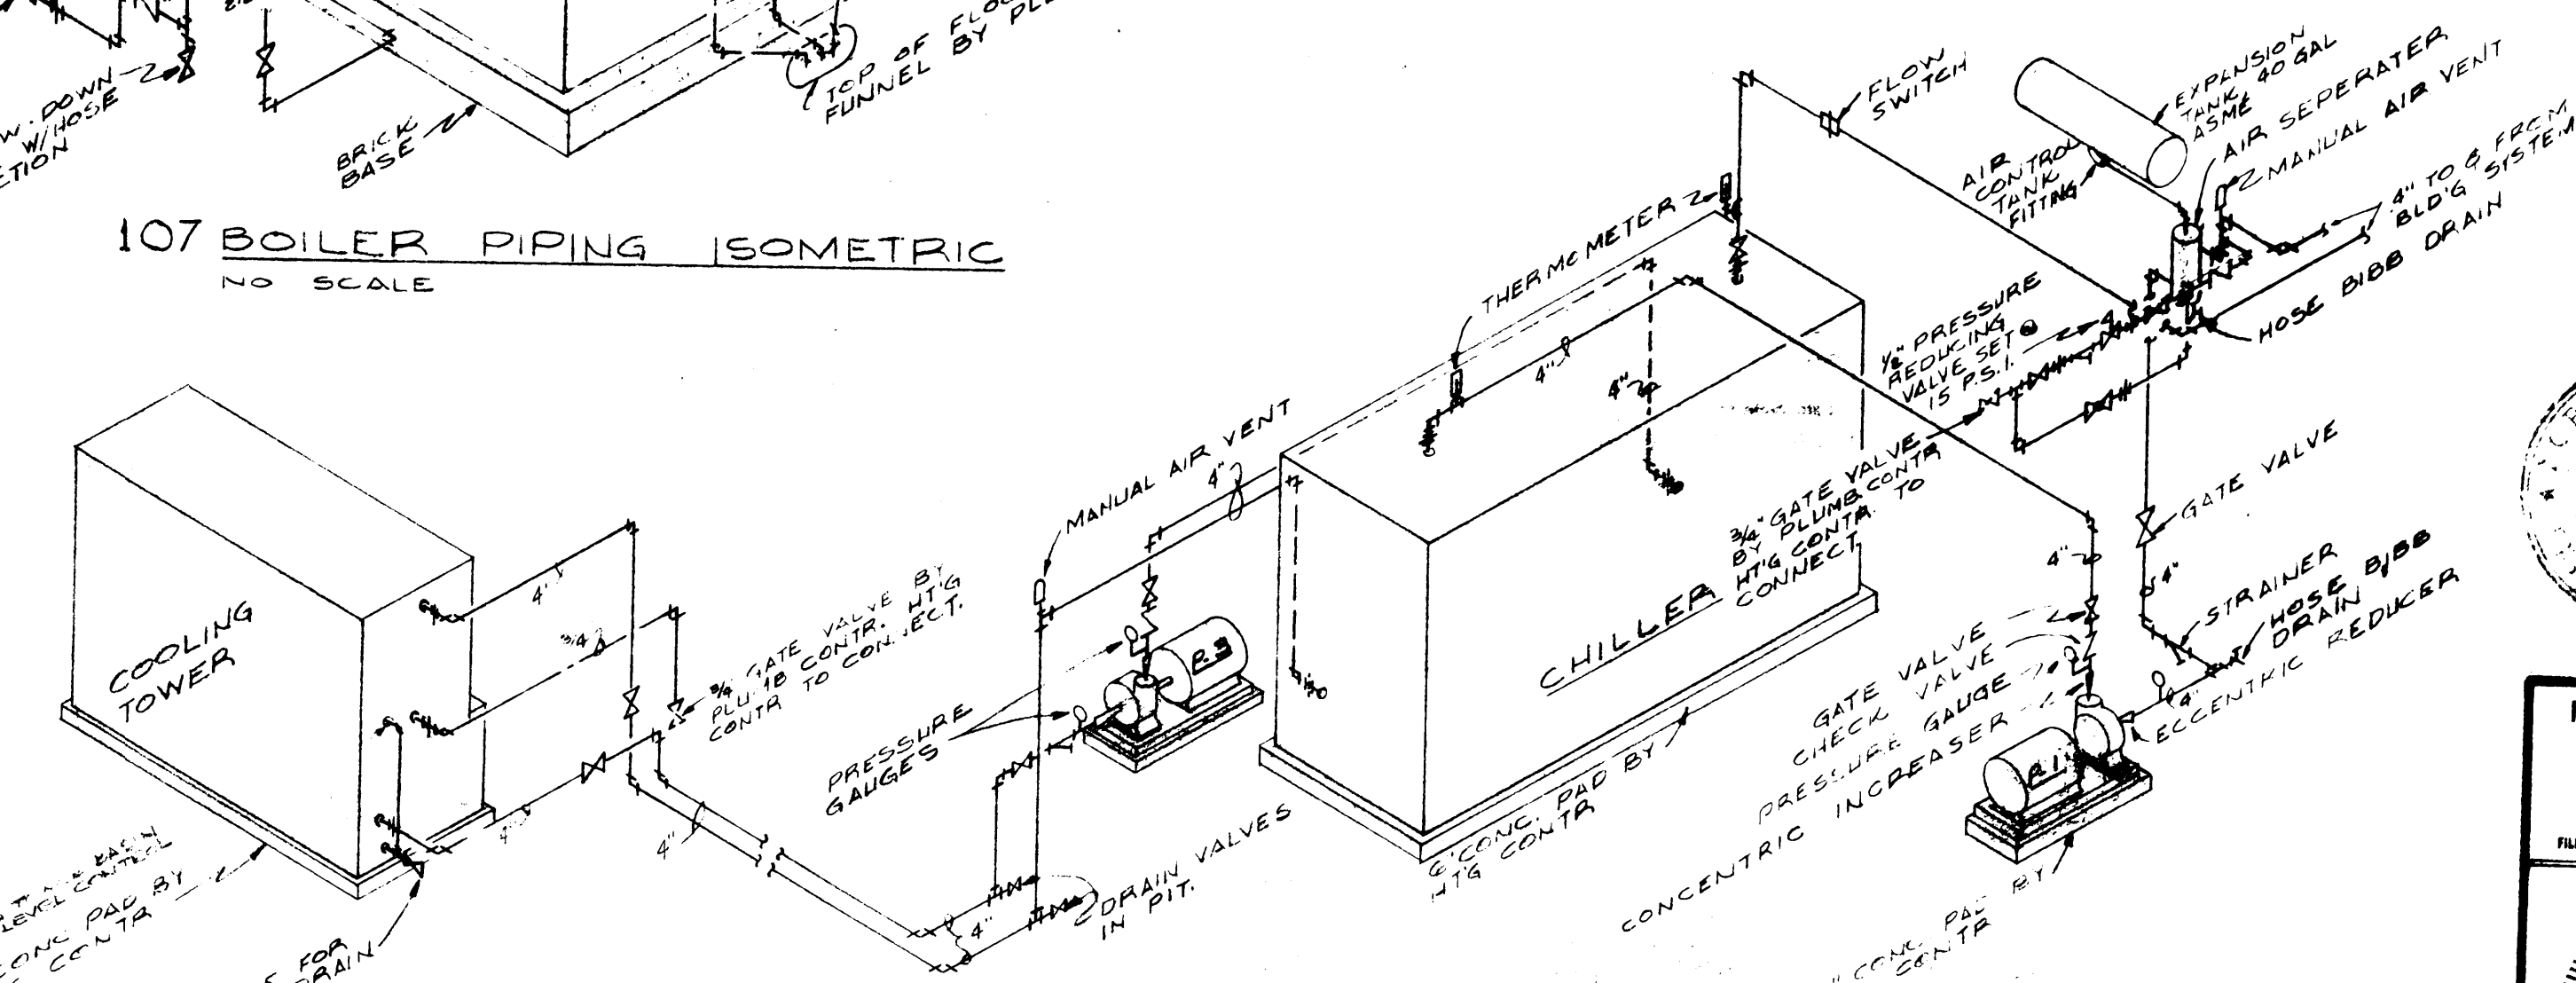


108 TOWER & CHILLER PIPING ISOMETRIC
NO SCALE

WILMINGTON COLLEGE EDUCATION & PSYCHOLOGY BUILDING
 WILMINGTON, NORTH CAROLINA
 BOARD OF TRUSTEES - L. BRADFORD TILLEY, JR. CHAIRMAN - DR. WILLIAM M. RANDALL, PRESIDENT
 BALLARD, McKim, & SAWYER, AIA
 612 SOUTH SPENTERTH STREET
 WILMINGTON, NORTH CAROLINA
 C.O.D.E. 66737 - ITEM 6

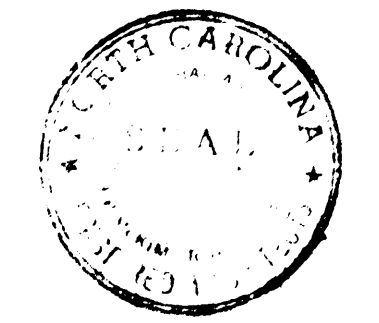


HENRY VON OESSEN & ASSOCIATES
CONSULTING ENGINEERS
WILMINGTON, N. C.
FILE NO. 1391

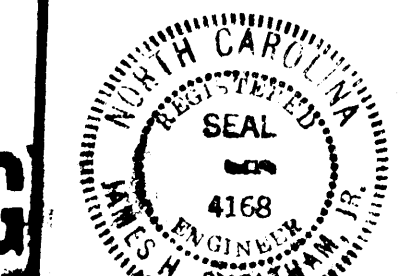


"AS-BUILT" DRAWING


203 PARTIAL ATTIC PLAN
SCALE: 1/8"=1'-0"

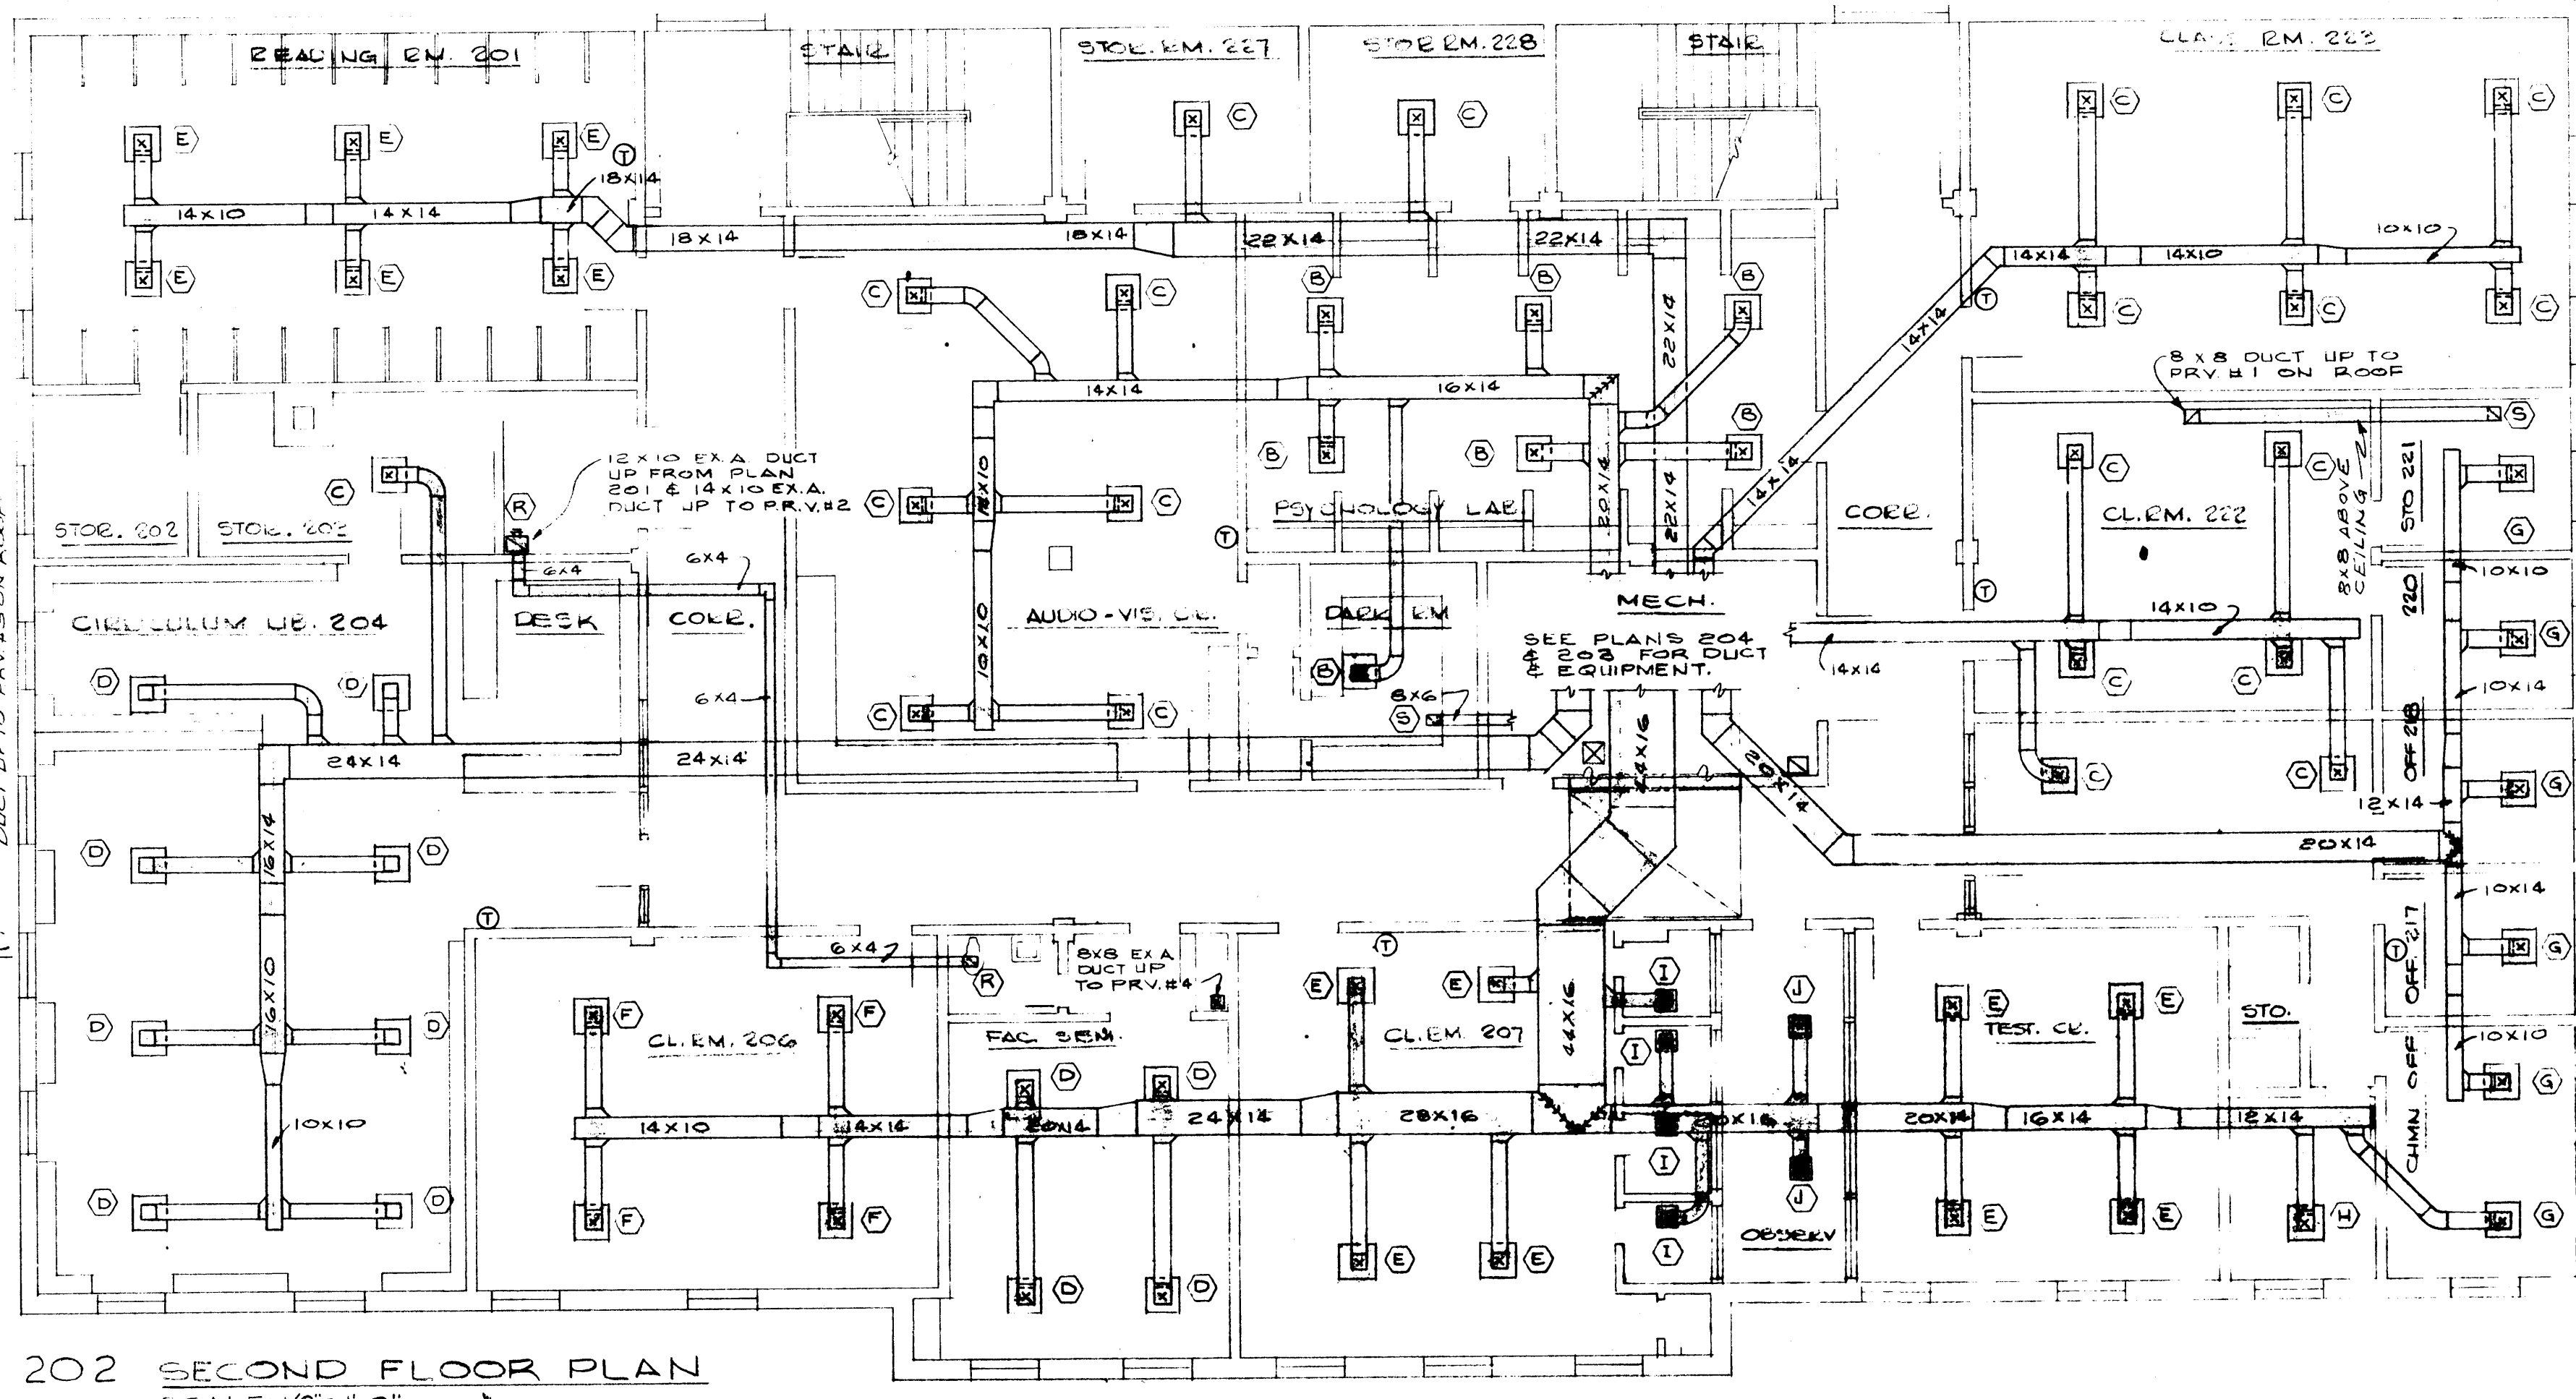


202 SECOND FLOOR PLAN
SCALE: 1/8"=1'-0"

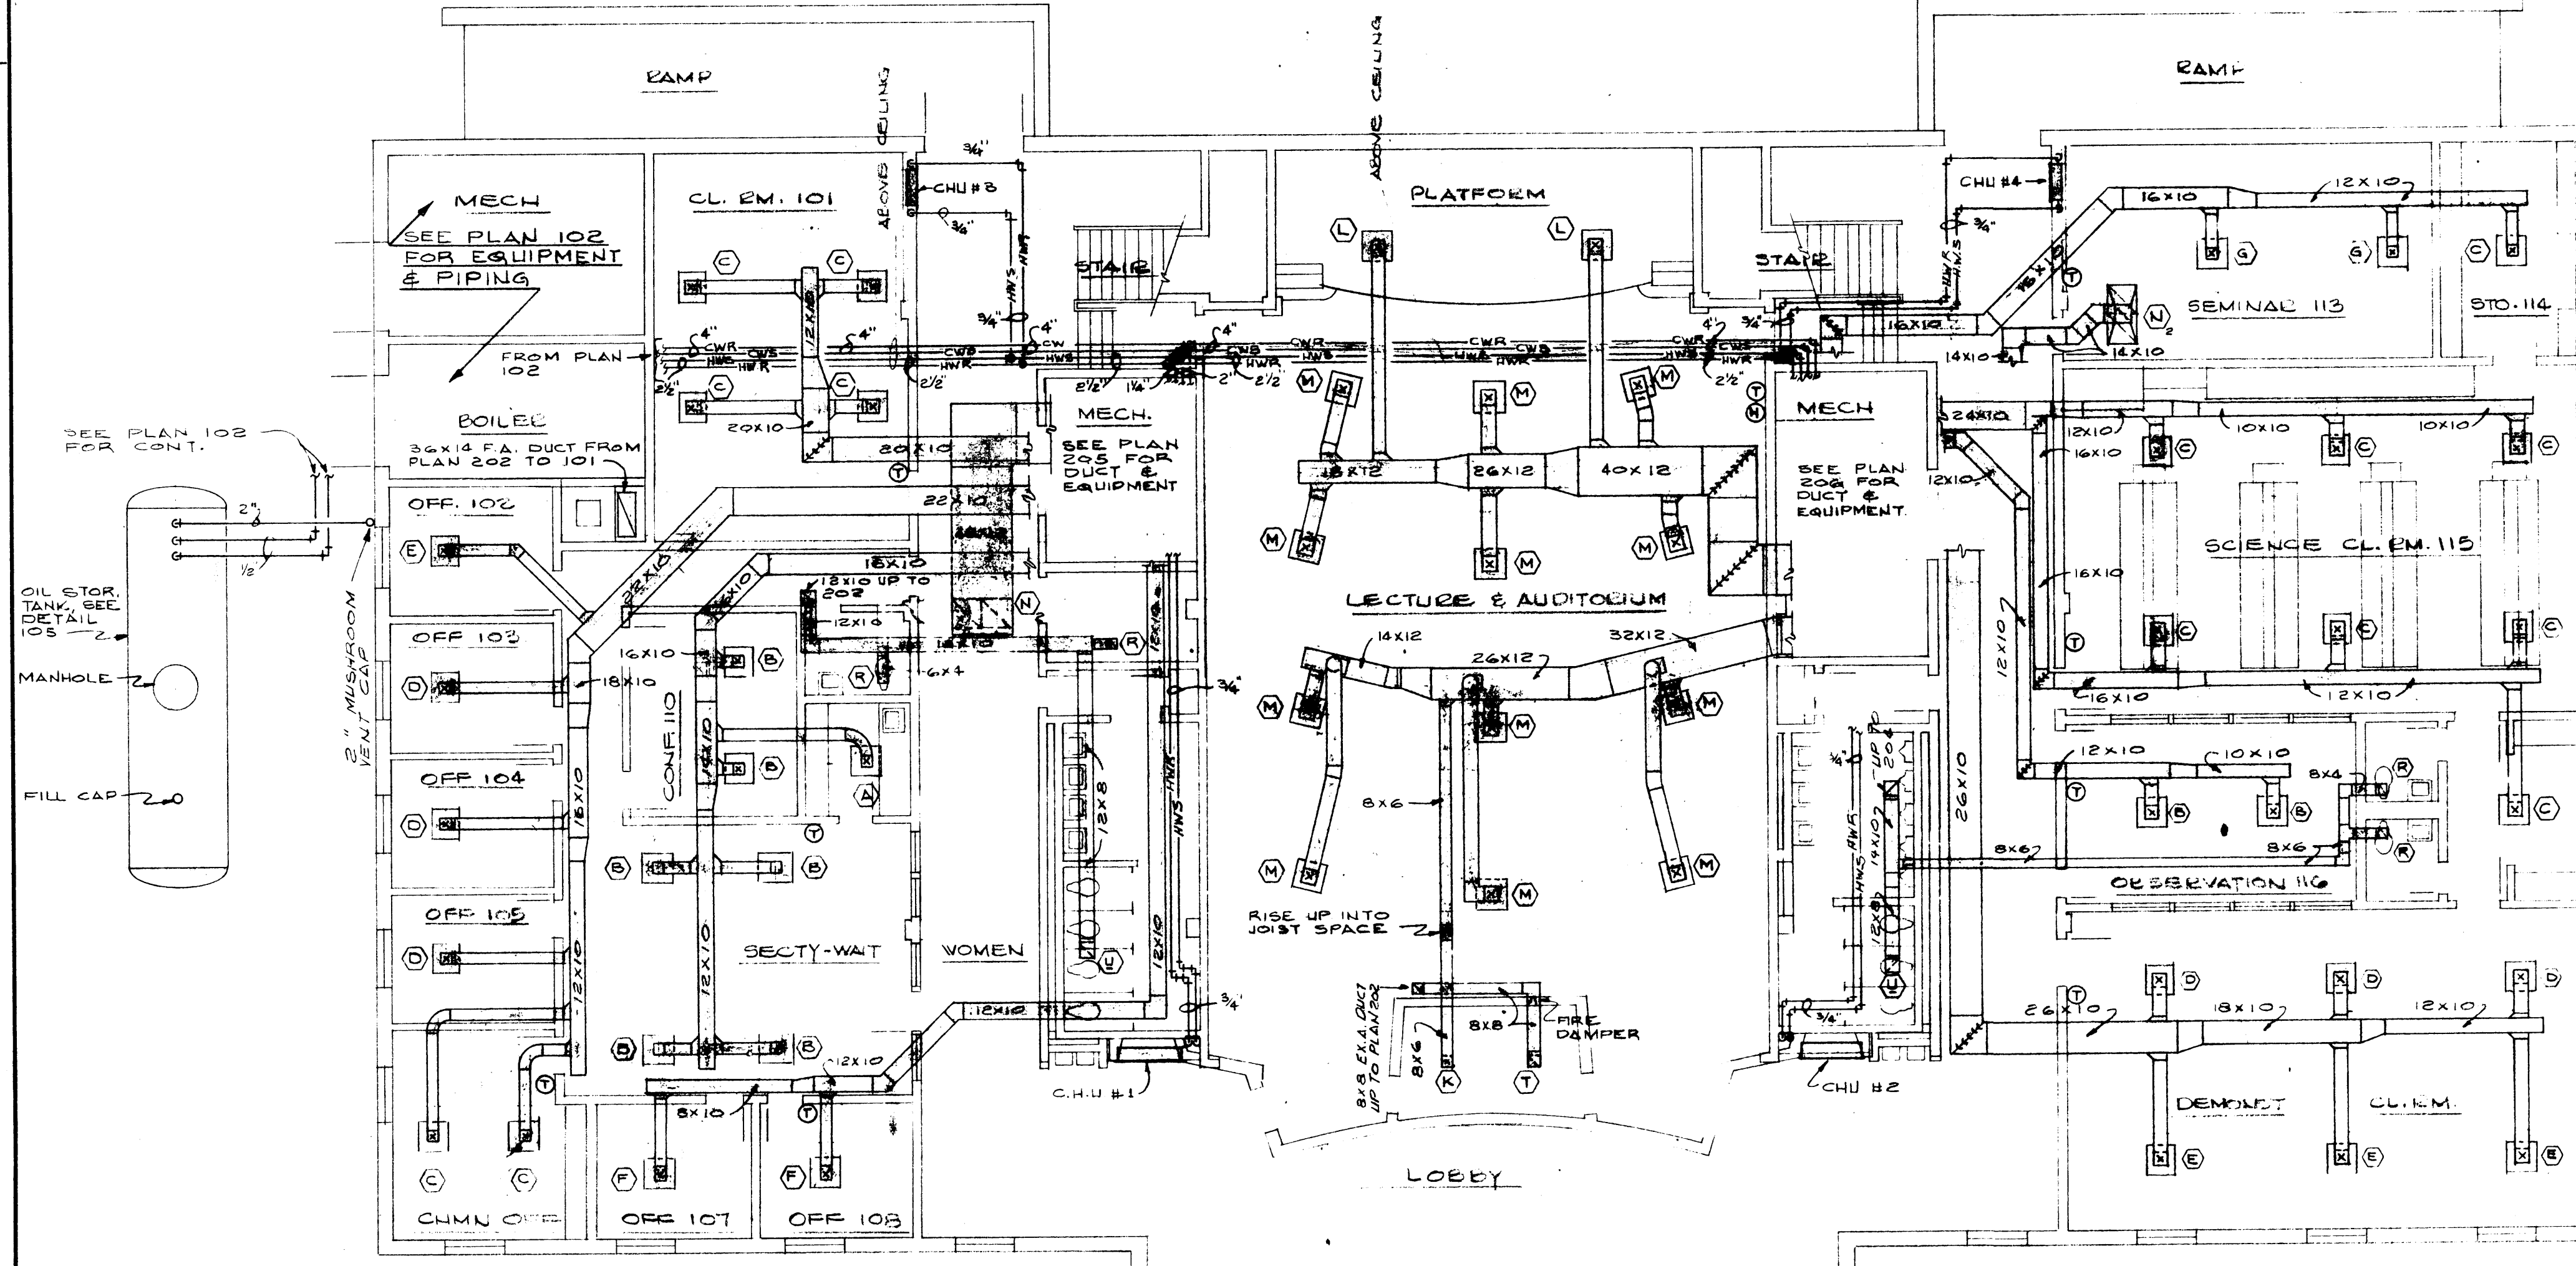


201 FIRST FLOOR PLAN
SCALE: 1/8"=1'-0"

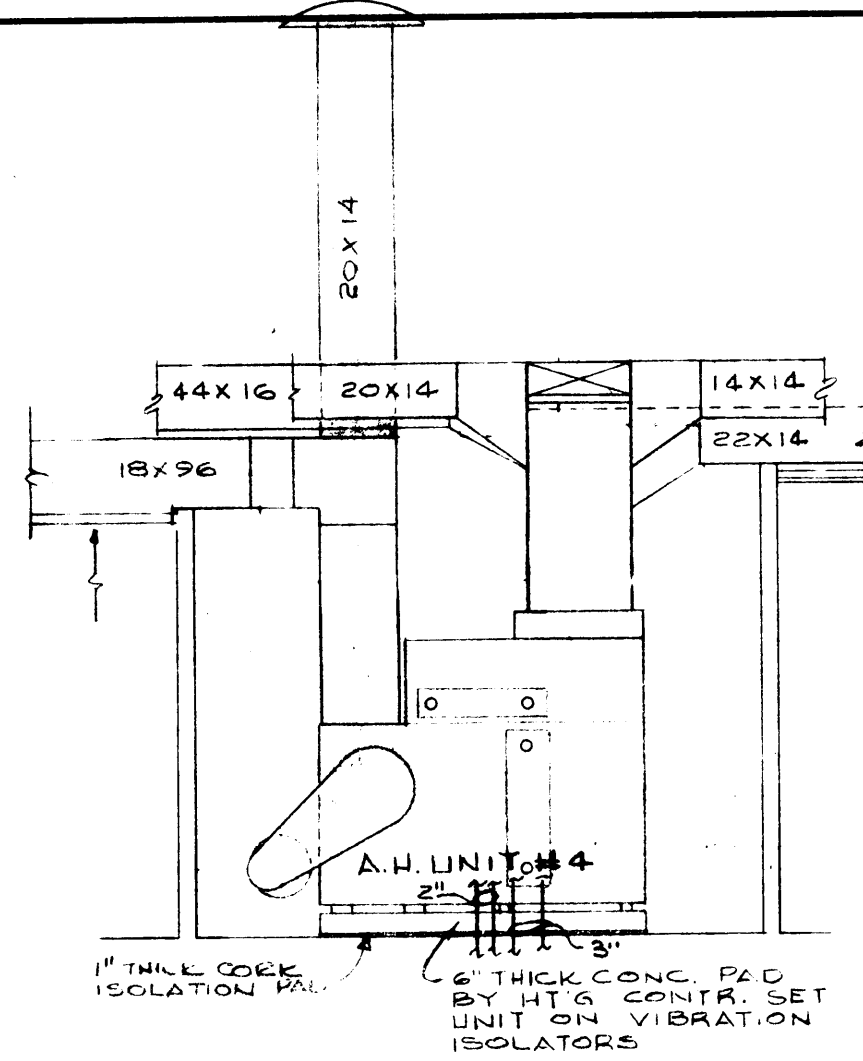


207 SECTION
SCALE: 1/4"=1'-0"

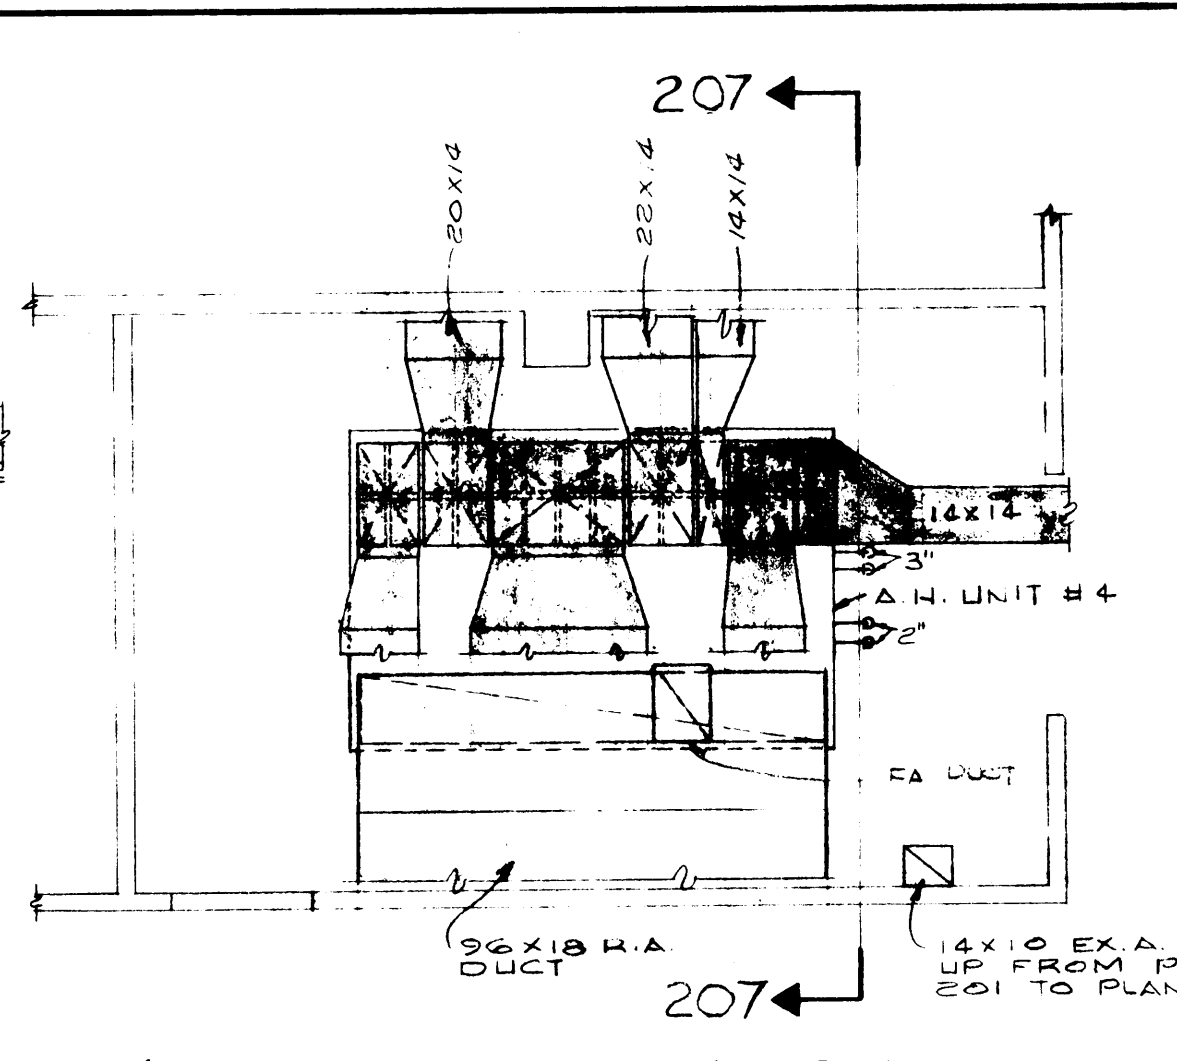


204 PLAN OF MECH. RM. # 231
SCALE: 1/4"=1'-0"

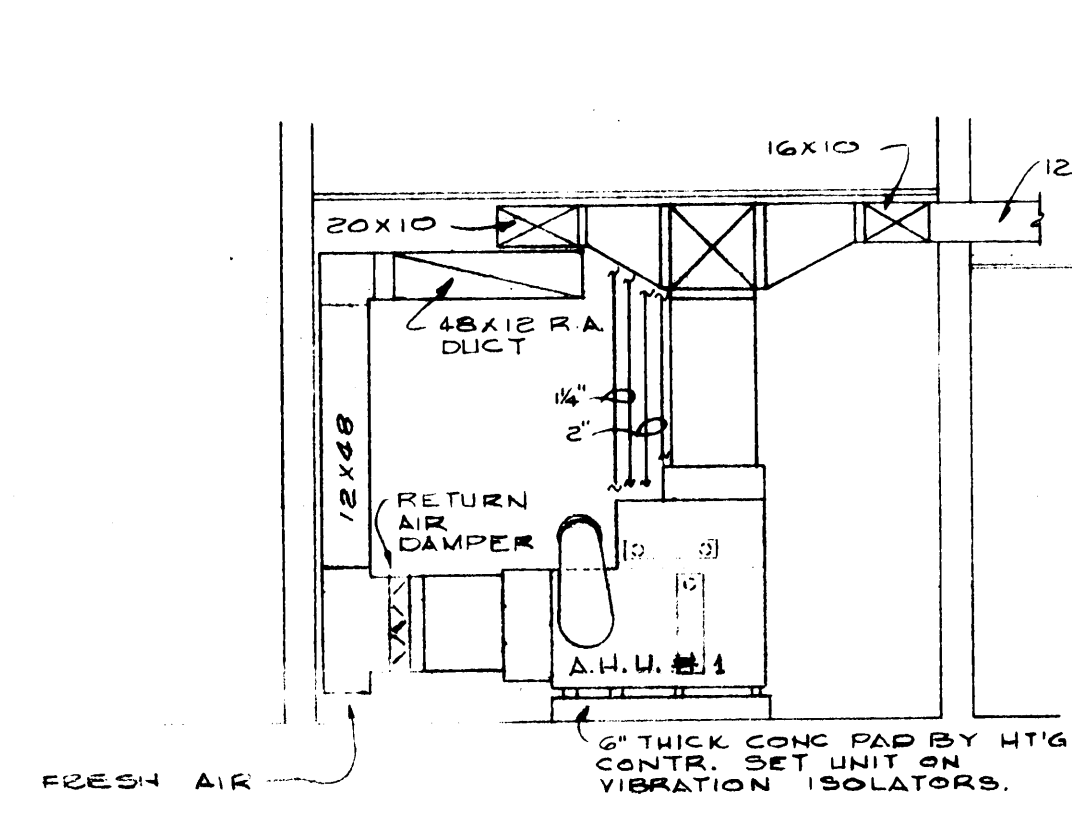


208 SECTION
SCALE: 1/4"=1'-0"

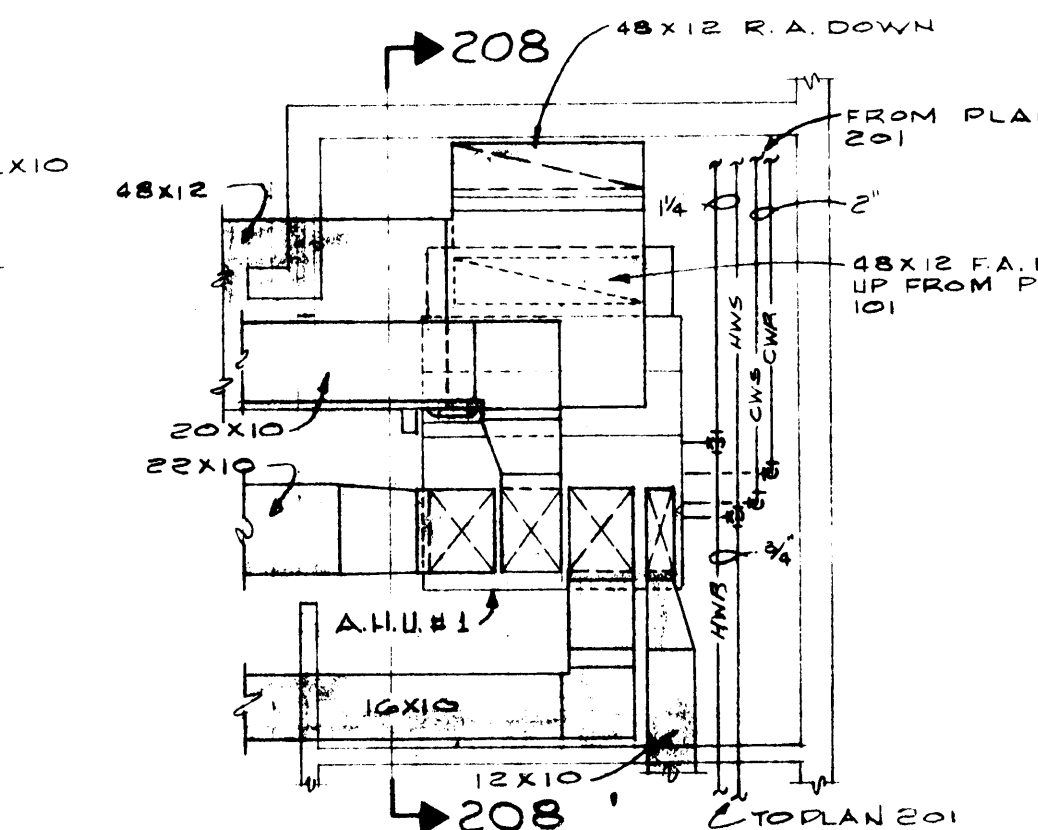


205 PLAN OF MECH. RM. # 118
SCALE: 1/4"=1'-0"

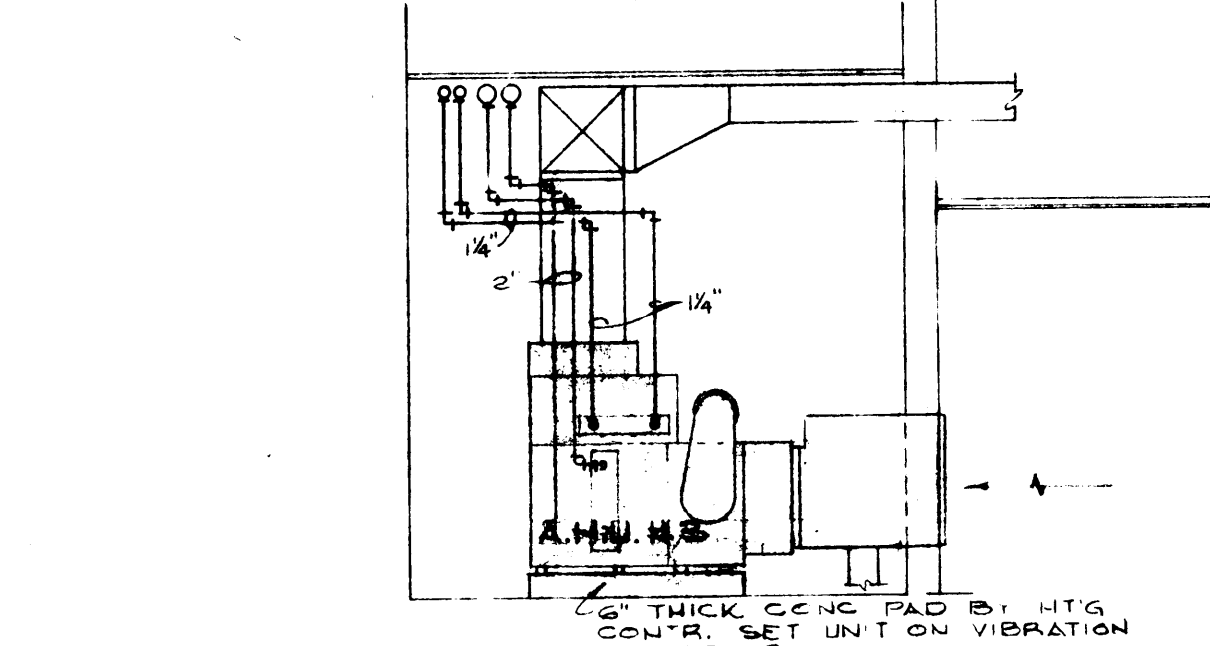


209 SECTION
SCALE: 1/4"=1'-0"

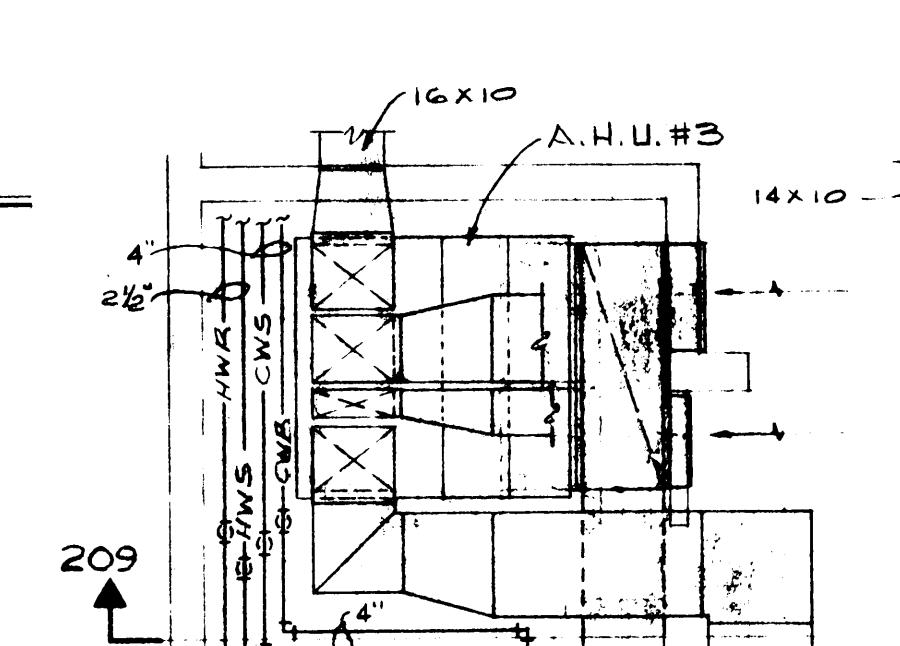

206 PLAN OF MECH. RM. # 126
SCALE: 1/4"=1'-0"

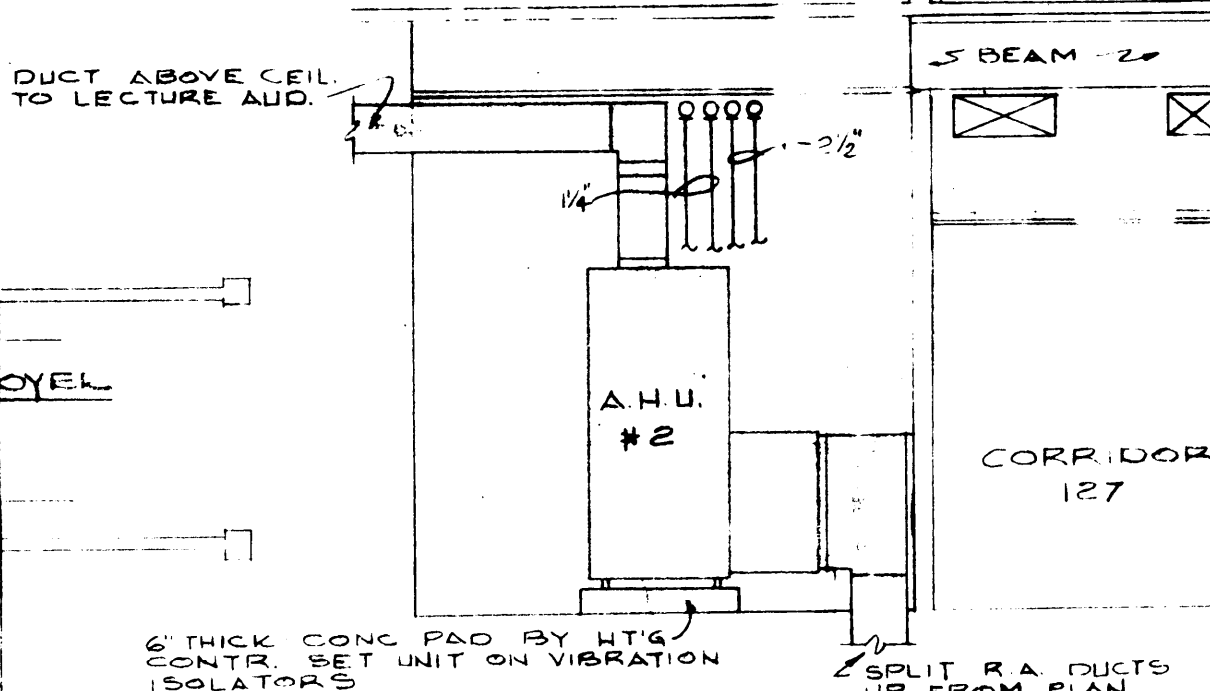

210 SECTION
SCALE: 1/4"=1'-0"

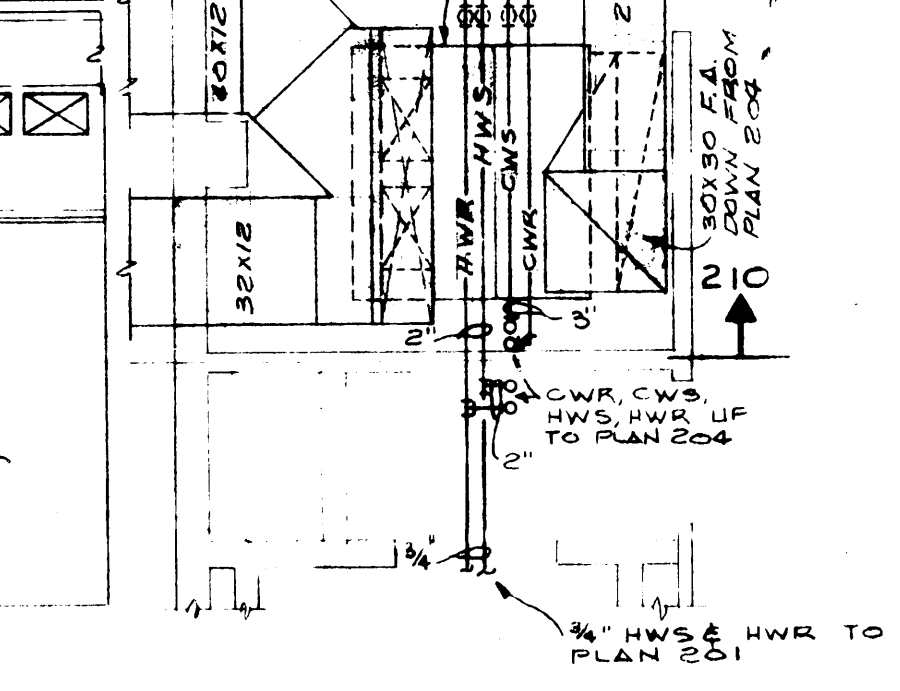


206 PLAN OF MECH. RM. # 126
SCALE: 1/4"=1'-0"

NOTE:
SEE REFLECTED CEILING PLAN SHEET A-10
FOR EXACT GRILLE & REGISTER LOCATION




QUALITY DRAWING



HENRY VON OESEN & ASSOCIATES
CONSULTING ENGINEERS
WILMINGTON, N. C.
FILE NO. 1391

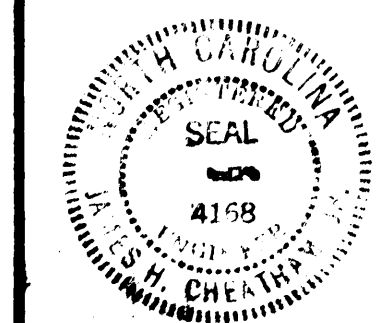

BALLARD, MCKIM, & SAWYER, AIA
 415 SOUTH SEVENTEENTH STREET
 WILMINGTON, NORTH CAROLINA
 BOARD OF TRUSTEES - L. BRADFORD TILLERY, JR. CHAIRMAN - DR. WILLIAM M. RANDALL, PRESIDENT
 WILMINGTON COLLEGE EDUCATION & PSYCHOLOGY BUILDING
 WILMINGTON, NORTH CAROLINA
 CODE 66737 - ITEM 6

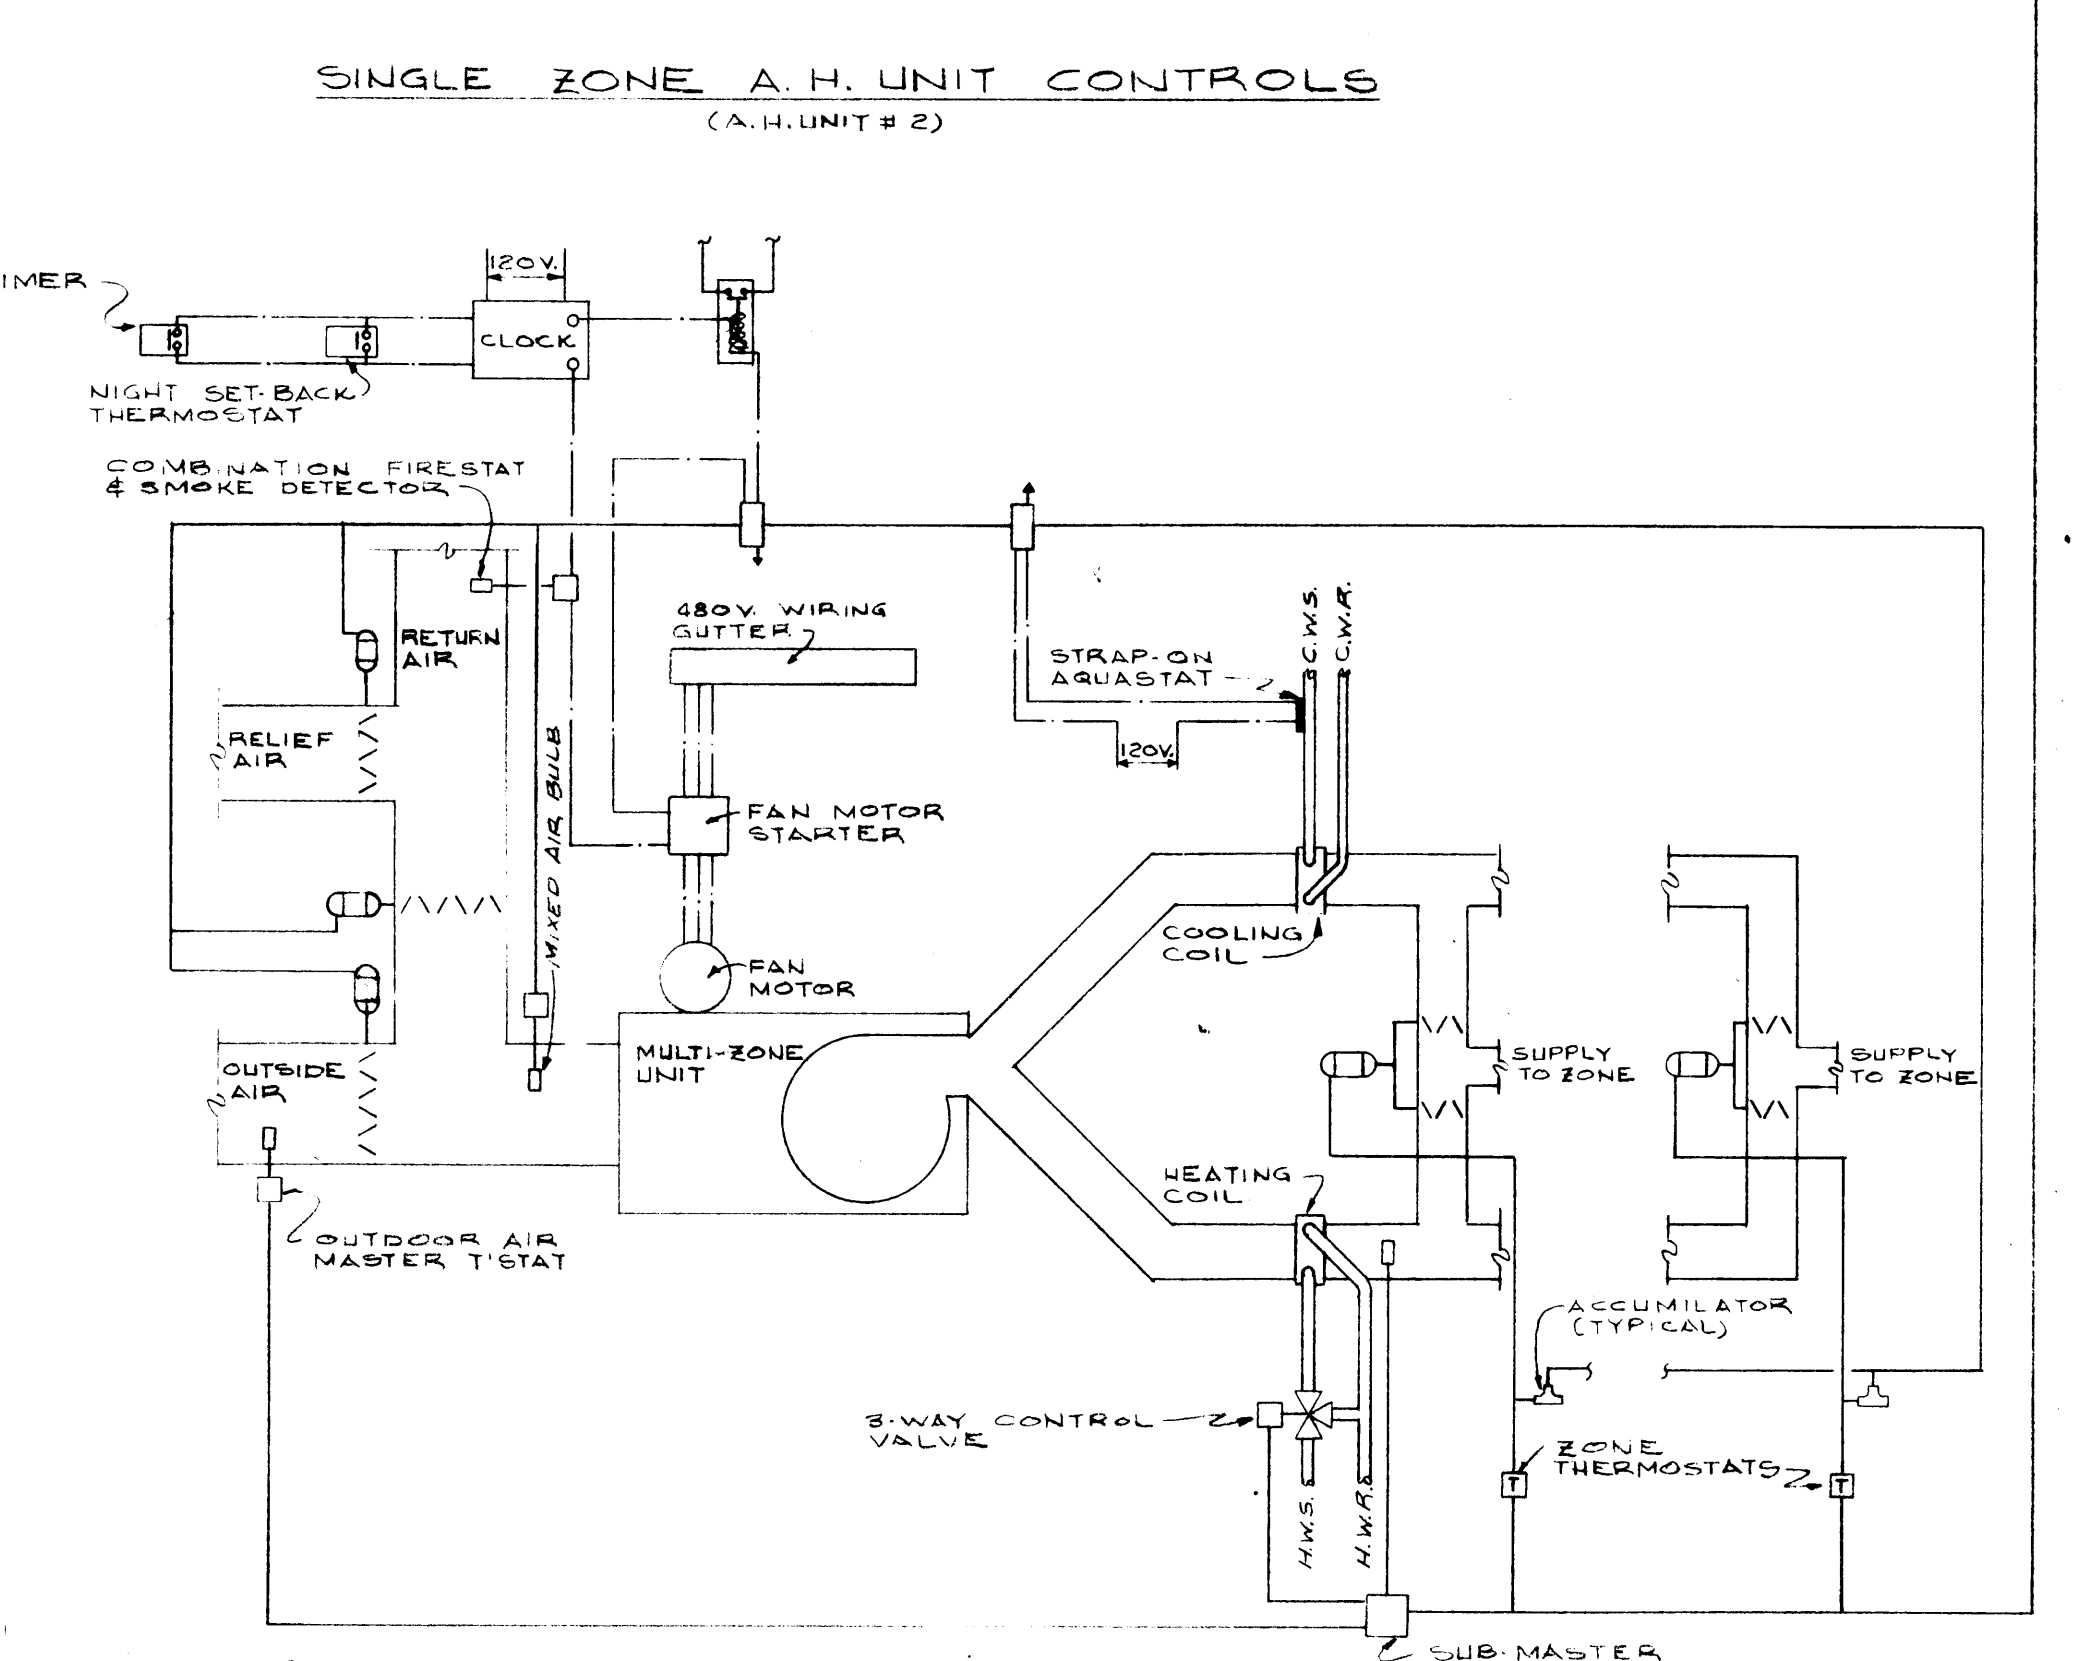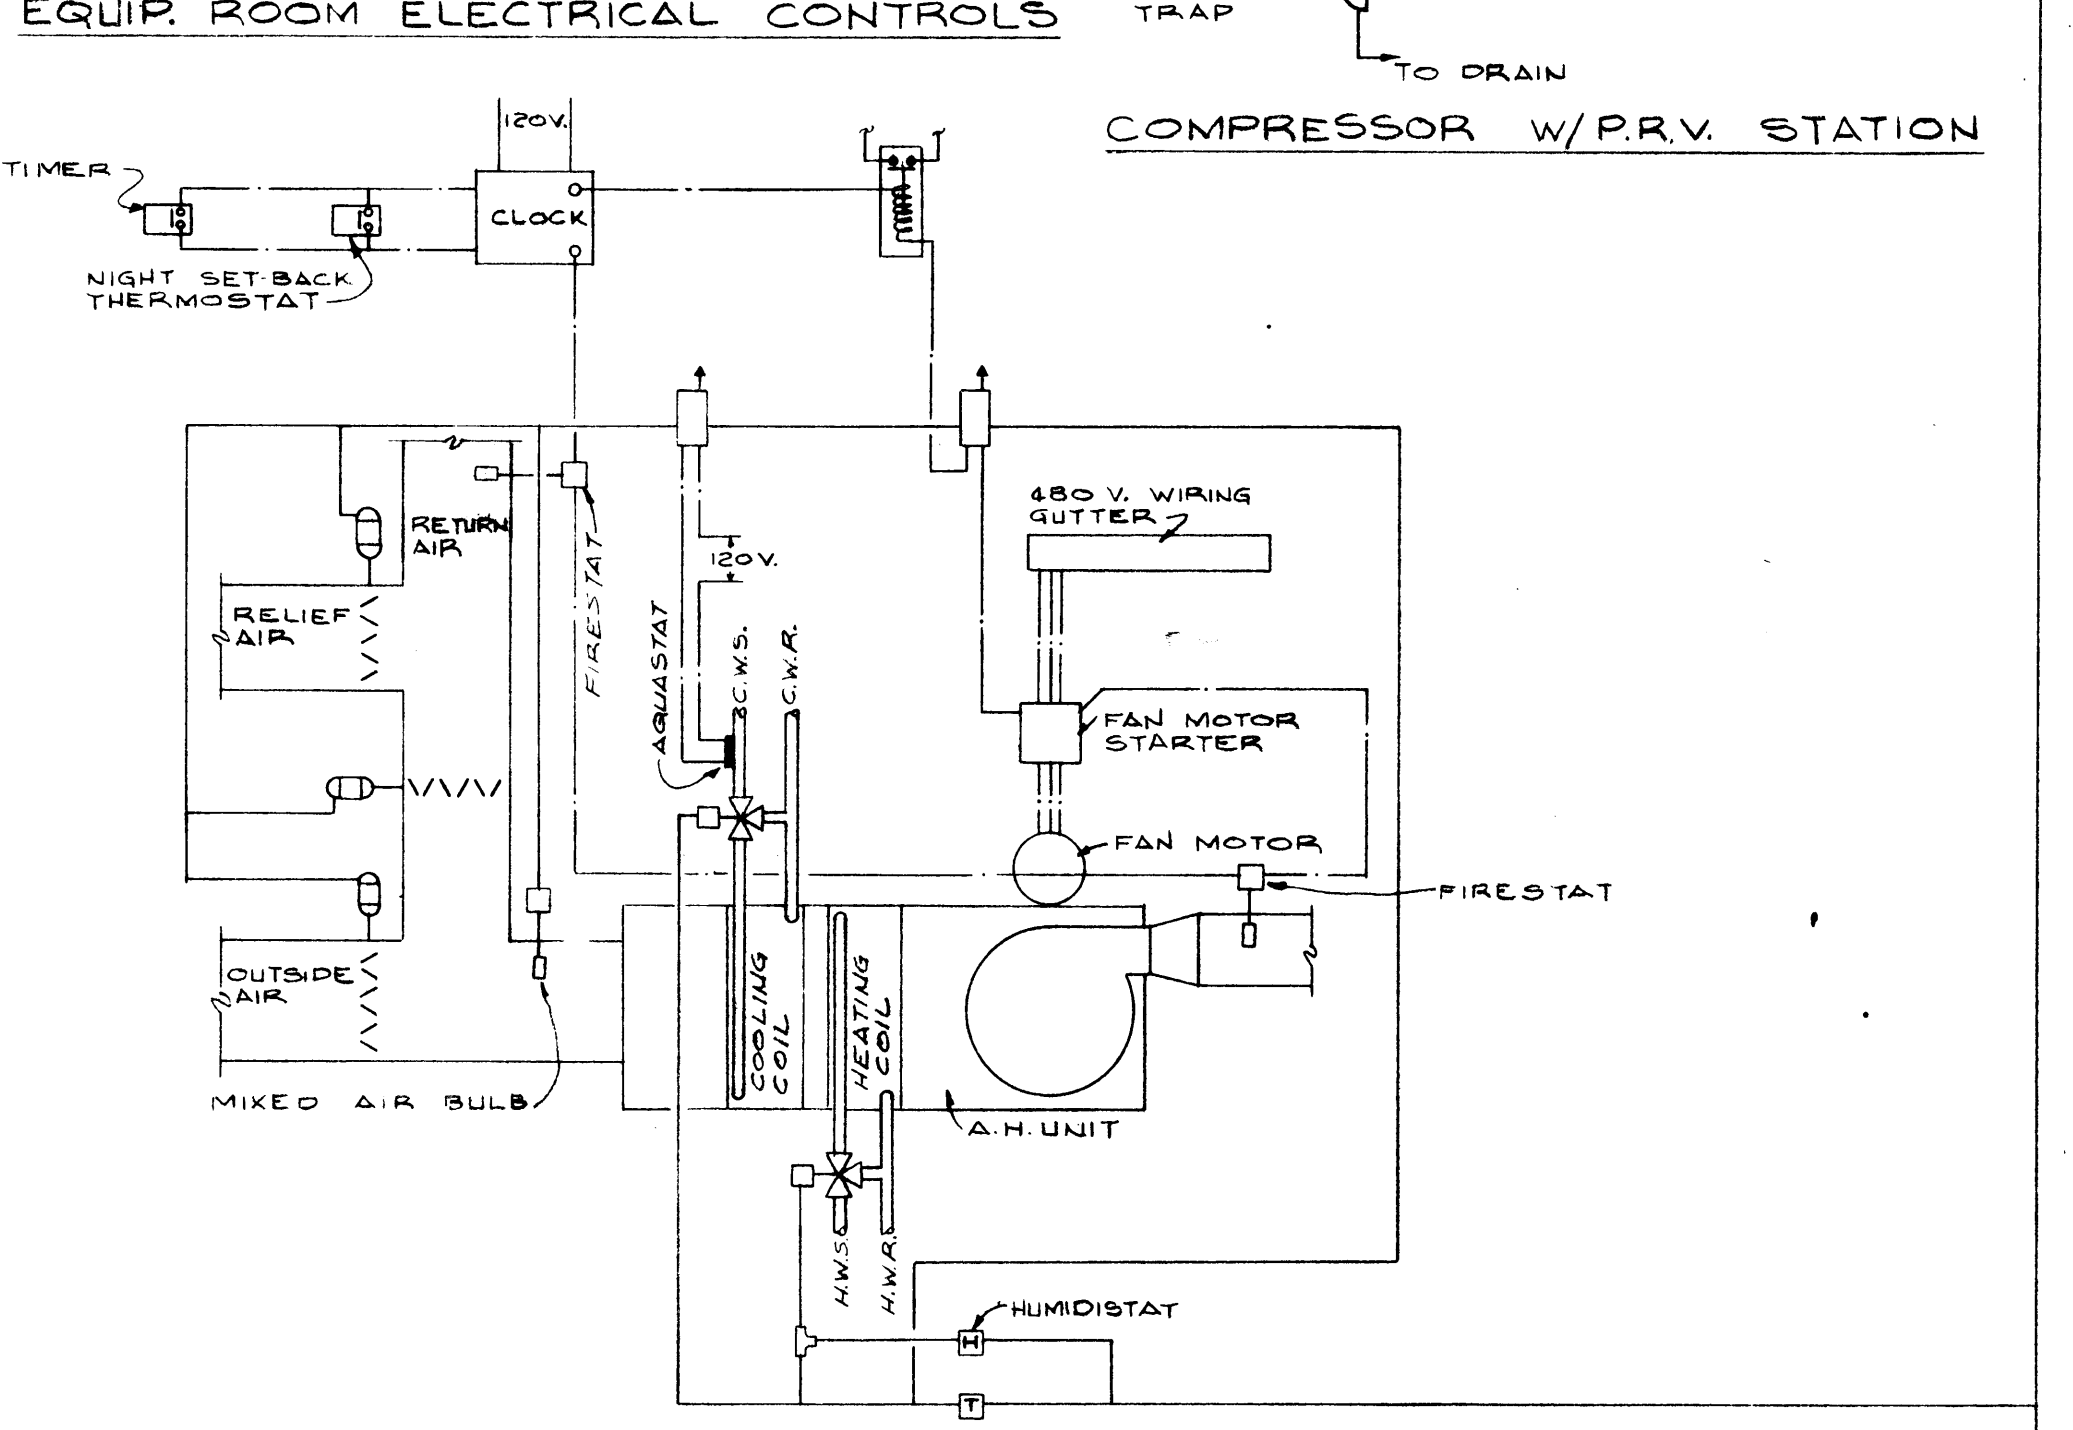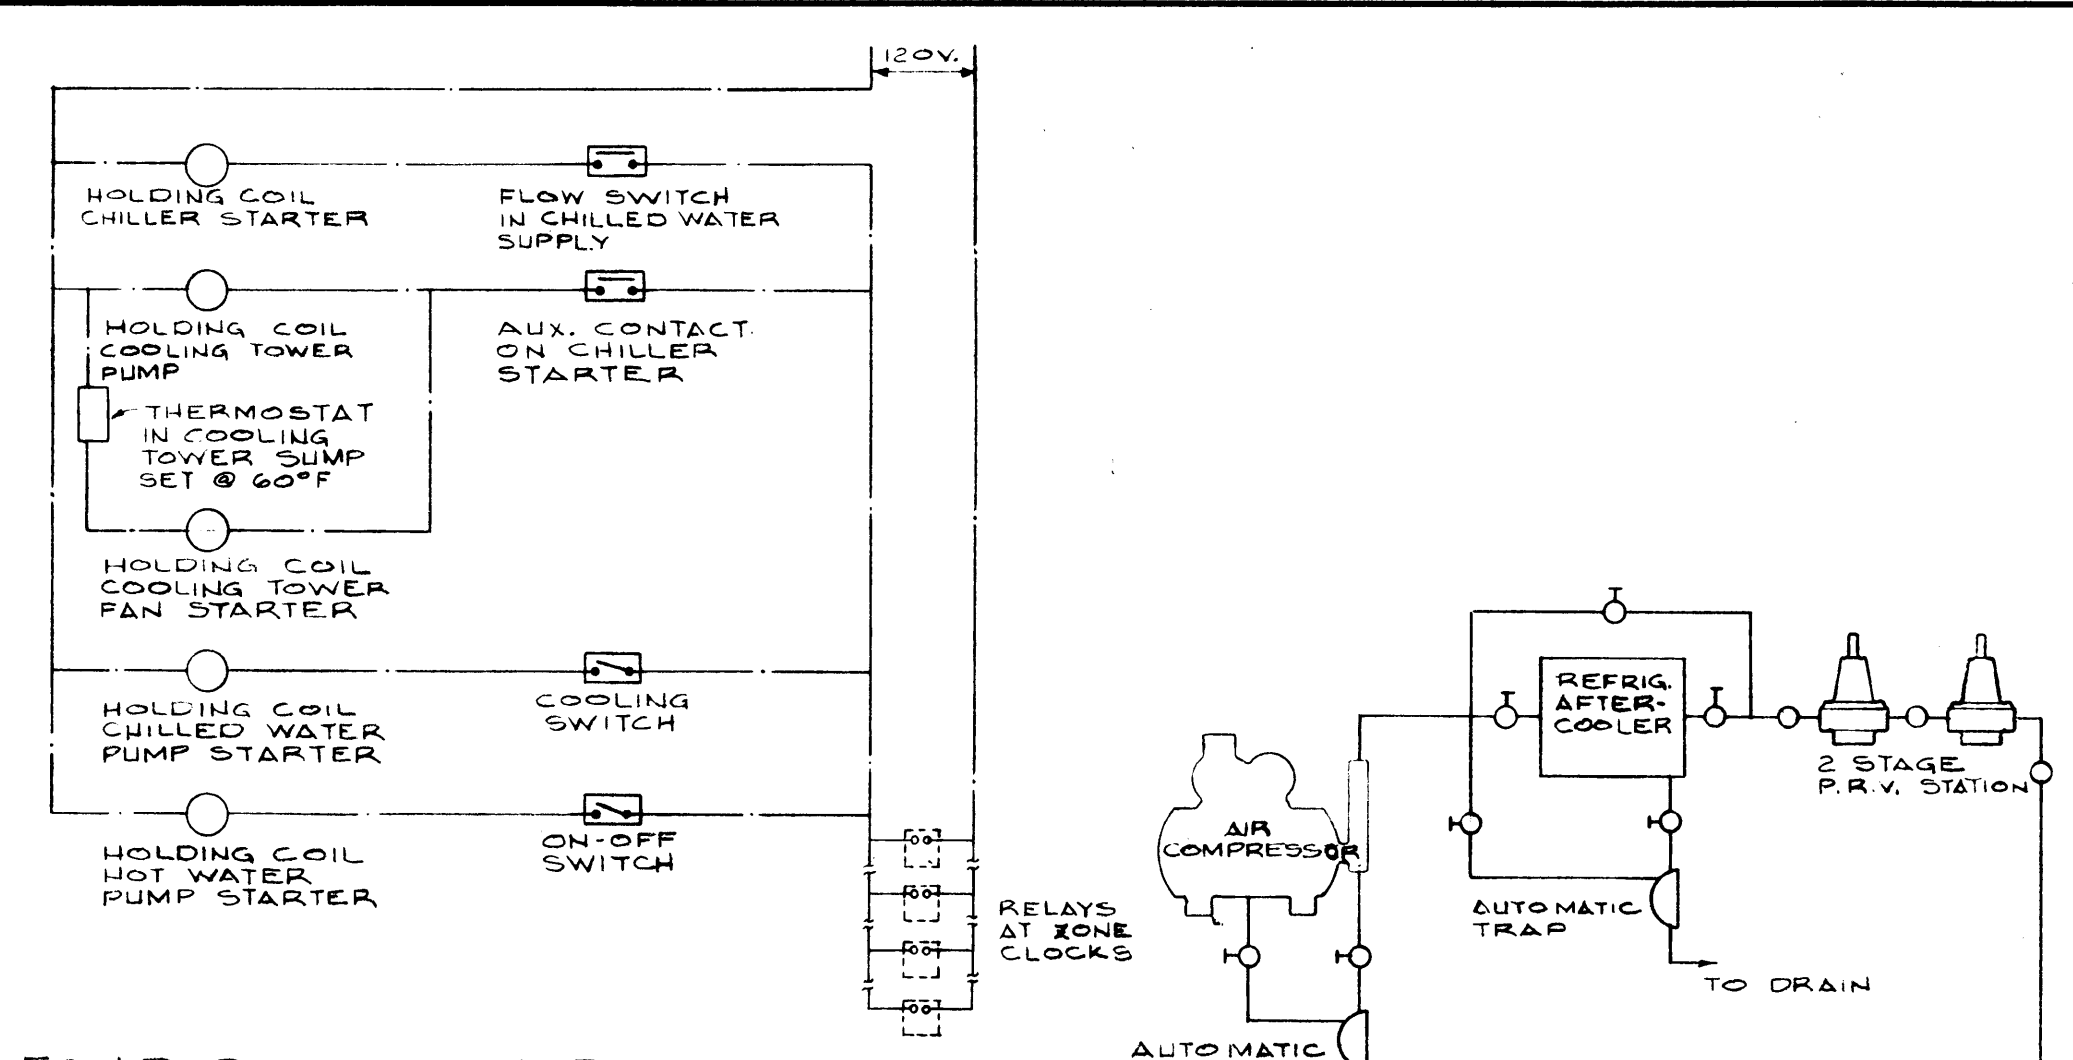

CONTROL DIAGRAM
NO SCALE

SCHEDULE OF METAL GAUGE, JOINTS AND BRACING FOR DUCT WORK

| U.S. STD. GALV. IRON | MAXIMUM SIZE IN INCHES | TYPE OF TRANSVERSE JOINT CONNECTIONS: | BRACING |
|----------------------|------------------------|--|--|
| 24 | UP TO 12" | S, DRIVE, POCKET OR BAR SLIPS ON 7'-10" CENTERS | NONE |
| 24 | 13" TO 24" | S, DRIVE, POCKET OR BAR SLIPS ON 7'-10" CENTERS | NONE |
| | 25" TO 30" | S DRIVE, 1" POCKET OR 1" BAR SLIPS ON 7'-10" CENTERS* | 1" X 1/2" L'S 4'-0" FROM JOINT |
| | 31" TO 40" | DRIVE, 1" POCKET OR 1" BAR SLIPS ON 7'-10" CENTERS* | 1" X 1/2" L'S 4'-0" FROM JOINT |
| 22 | 41" TO 60" | 1 1/2" L CONNECTIONS OR 1 1/2" POCKET OR 1 1/2" BAR SLIPS WITH 1/2" X 1/8" BAR REINFORCING ON 7'-10" CENTERS.* | 1 1/2" X 1/2" X 1/8" L'S 4'-0" FROM JOINT |
| 20 | 61" & UP | 1 1/2" L CONNECTIONS OR 1 1/2" POCKET OR 1 1/2" BAR SLIPS, 3'-4" MAX CENTERS WITH 1 1/2" X 1/8" BAR REINFORCING. | 1 1/2" X 1/2" X 1/8" DIAGONALS OR 1 1/2" X 1/2" X 1/8" L'S, 2'-0" FROM JOINT |

* DUCT SECTIONS OF 3'-9" MAY BE USED WITH BRACING L'S OMITTED INSTEAD OF 7'-10" LENGTH'S WITH ALL UNINSULATED DUCTS 18" AND LARGER TO BE CROSS BROKEN. CROSS BRACING MAY BE ELIMINATED IF TWO GAUGES HEAVIER METAL IS USED.

NOTE: THE DUCT WORK CONTRACTOR SHALL TAKE PROPER MEASUREMENTS ON THE JOBS AND CHECK SPACE FOR CLEARANCES, OBSTRUCTIONS, ETC., BEFORE FABRICATING DUCT WORK. DUCTS MAY BE ADJUSTED SLIGHTLY IN SIZE IN ORDER TO FIT CONSTRUCTION CONDITIONS AS LONG AS THE CROSS SECTIONAL AREA OF THE DUCTS REMAIN THE SAME IN SIZE AS GIVEN ON THE PLANS.

AIR HANDLING UNIT SCHEDULE

| SYM. | AIR QUANTITY - CFM | | EXT. S.P. | MAX. H.P. | ELECTRIC SERVICE | COOLING COIL | | | | HEATING COIL | | REMARKS | | |
|---------|--------------------|---------|-----------|-----------|------------------|--------------|------|------|------|--------------|-----|---------|------|-------------|
| | TOTAL | OUTSIDE | | | | EDB | EWB | LDB | WDB | GTH | GPM | | W.T. | GTH |
| AHU # 1 | 4,300 | 350 | 3/4" | 3 | 480V, 3Φ | 79.5 | 86.4 | 58.1 | 57.6 | 119,700 | 24 | 80,000 | 8 | MULTI-ZONE |
| AHU # 2 | 7,000 | 2,500 | 3/4" | 5 | 480V, 3Φ | 84.1 | 70.3 | 6.9 | 57.7 | 291,400 | 58 | 220,000 | 22 | SINGLE ZONE |
| AHU # 3 | 4,350 | 800 | 3/4" | 3 | 480V, 3Φ | 81.8 | 68.0 | 58.1 | 54.9 | 155,200 | 31 | 130,000 | 13 | MULTI-ZONE |
| AHU # 4 | 17,450 | 2,500 | 1" | 15 | 480V, 3Φ | 80.6 | 67.0 | 58.5 | 54.9 | 559,300 | 112 | 450,000 | 45 | MULTI-ZONE |

CHILLER SCHEDULE



| SYM. | CAPACITY TONS REF. | TOTAL HEAT REJECTION TONS OF REF. | COOLER | | CONDENSER | | ELECTRICAL | | REMARKS | | |
|---------|--------------------|-----------------------------------|-------------|--------|-------------|--------|------------|------|----------|-----|----------------------|
| | | | L.W.T. (°F) | G.P.M. | E.W.T. (°F) | G.P.M. | VOLTAGE | AMPS | | | |
| CHILLER | 90 | 115 | 44 | 226 | 15' | 85 | 270 | 20' | 480V, 3Φ | 800 | MULTIPLE COMPRESSORS |

* AMPS - MAX. INSTANTANEOUS CURRENT FLOW DURING STARTING.

COOLING TOWER SCHEDULE

| SYM. | CAPACITY TONS | WATER GPM | MAX. SPRAY PRESSURE REQUIRED AT INLET (PSIG) | WATER TEMP (°F) | | OUTSIDE WET BULB | FAN MOTOR HP | ELECTRICAL | CFM | REMARKS |
|---------------|---------------|-----------|--|-----------------|-----|------------------|--------------|------------|--------|------------------|
| | | | | IN | OUT | | | | | |
| COOLING TOWER | 115 | 270 | 5 PSIG | 95 | 85 | 80° | 10 | 480V, 3Φ | 19,500 | CENTRIFUGAL FANS |

* BASED ON TOTAL HEAT REJECTION OF THE CHILLER

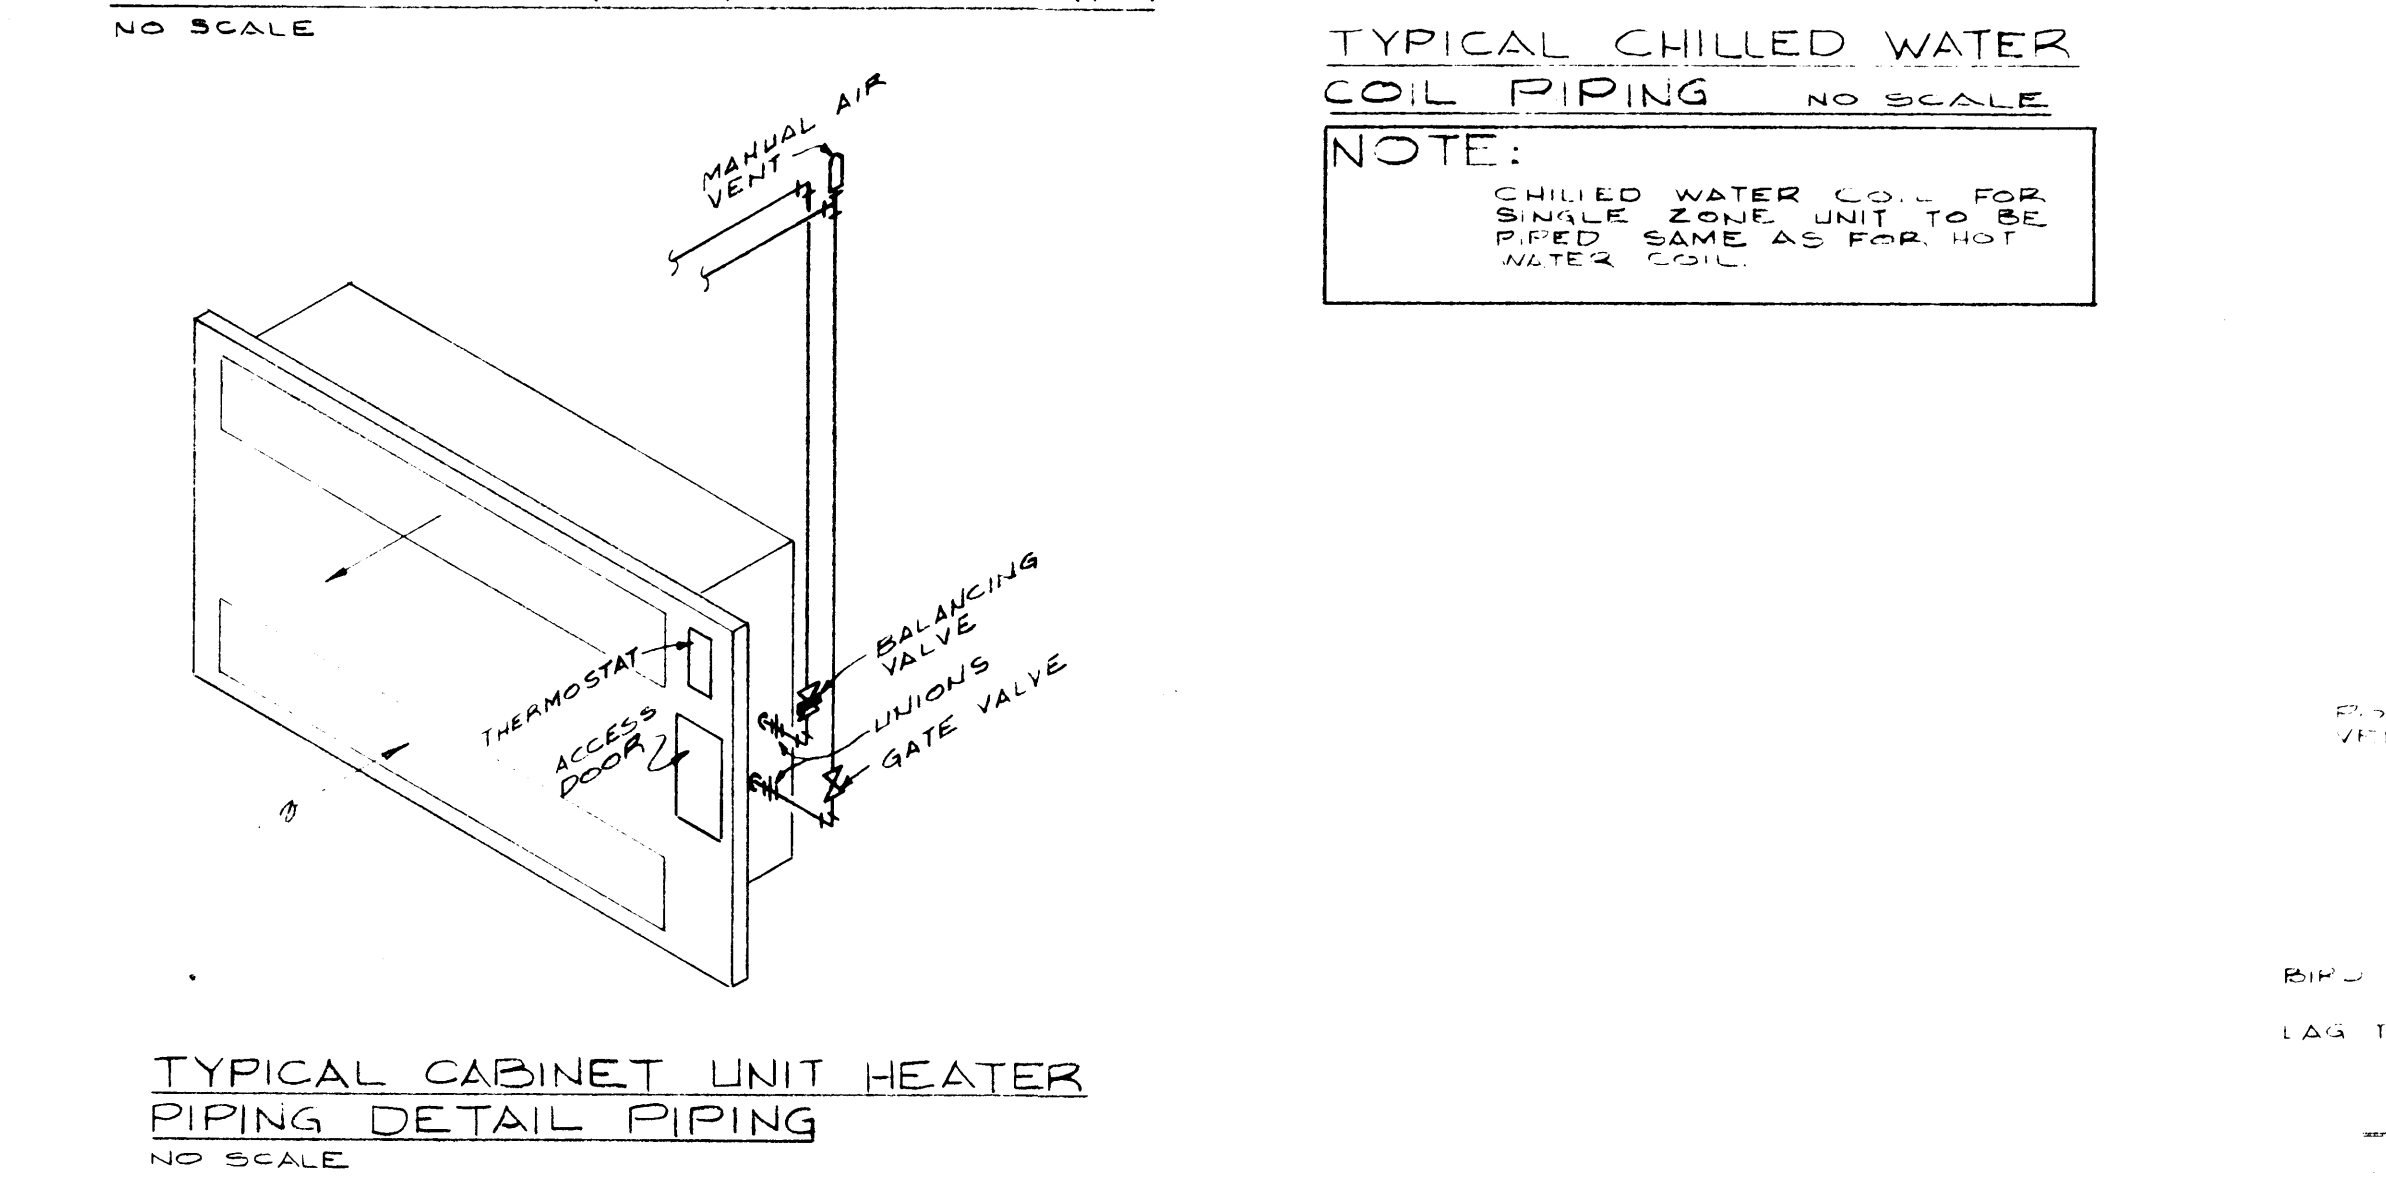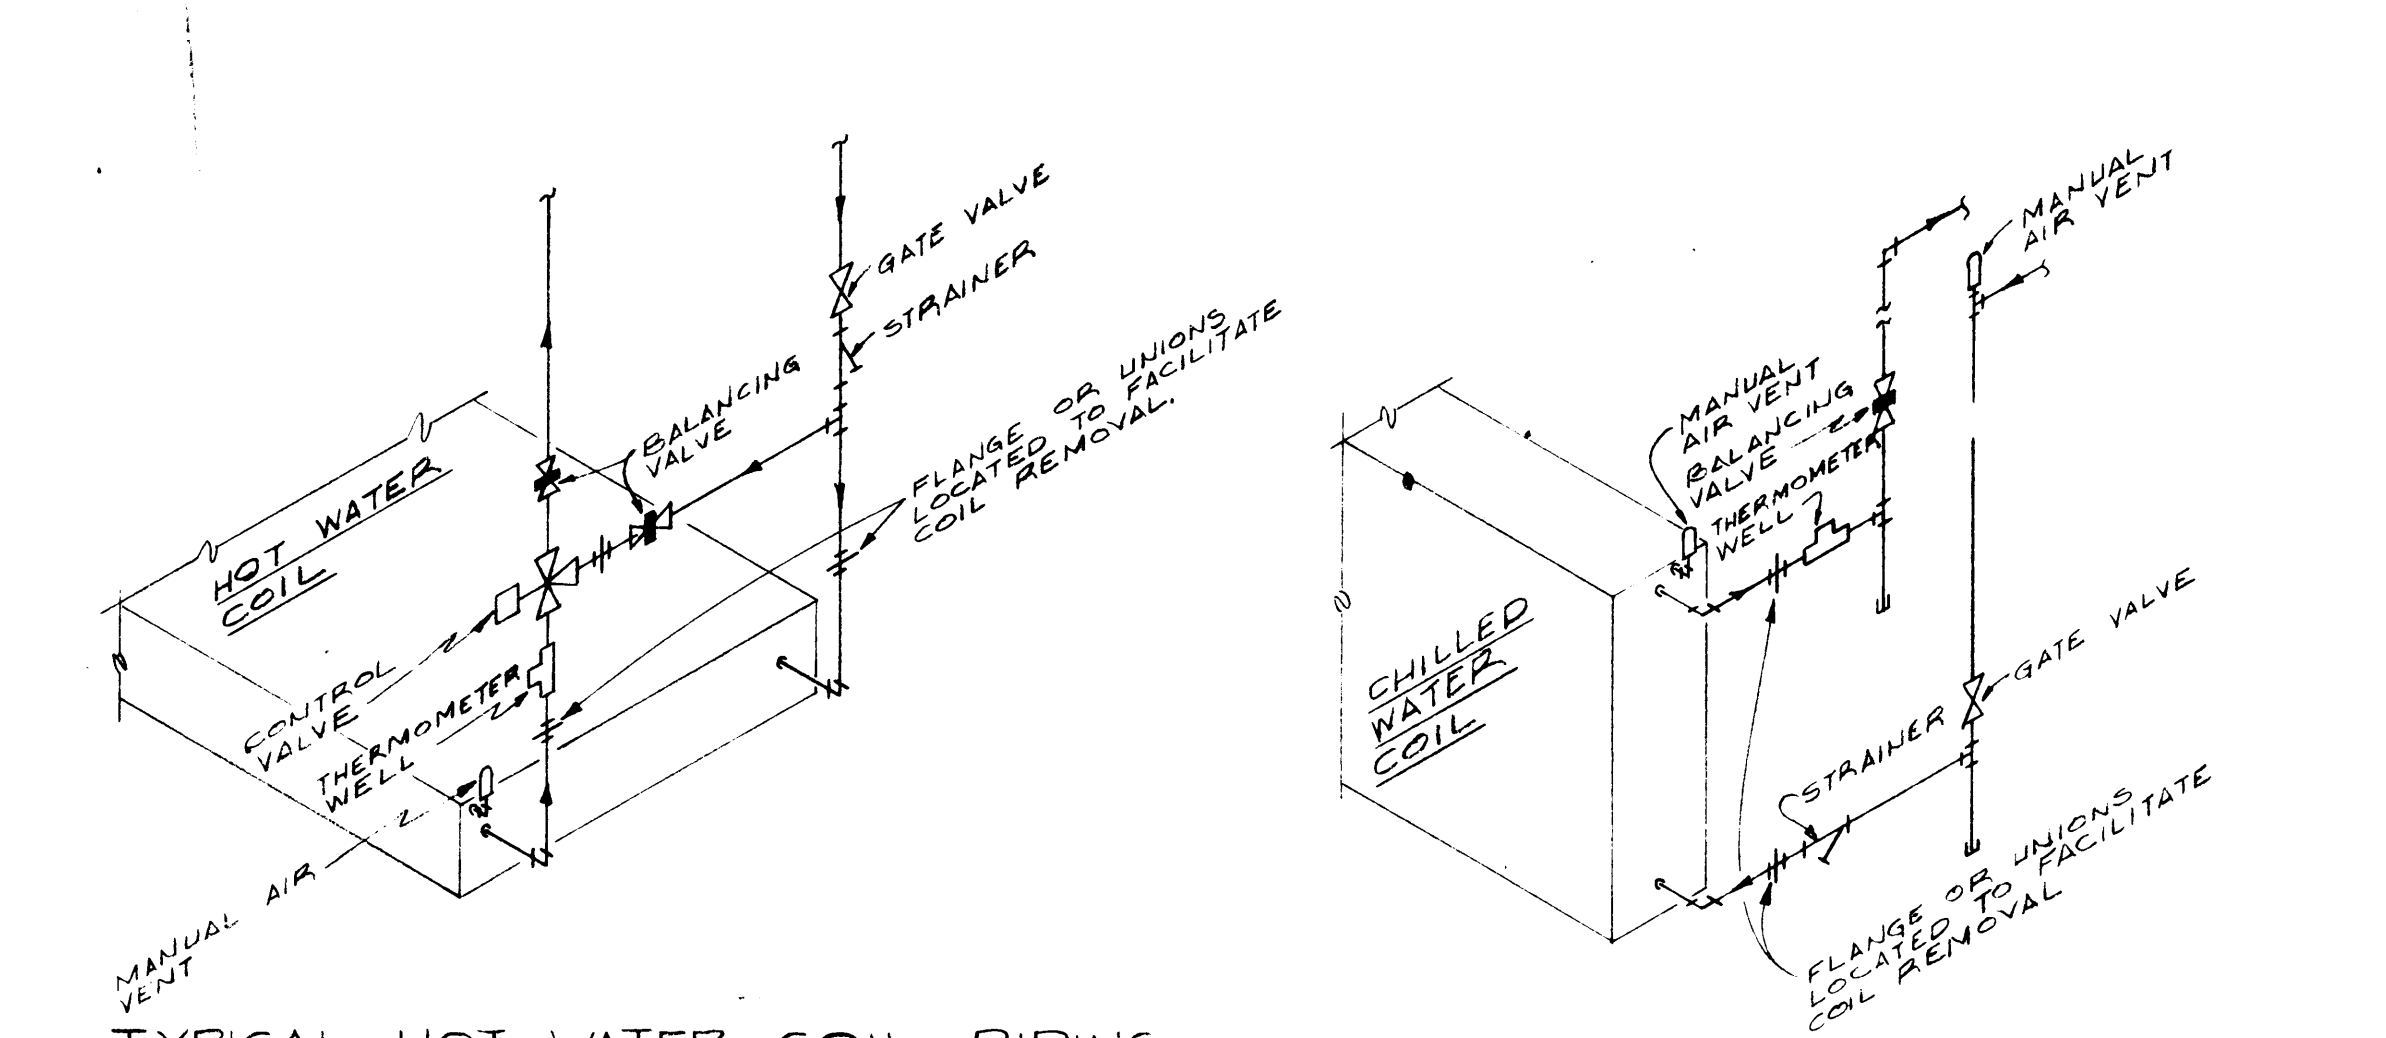

GRILLE & DIFFUSER SCHEDULE

| SYM. | CFM | NECK SIZE | TYPE | RUNOUT SIZE | REMARKS |
|-------|------------|-----------|---------------------------|-------------|--------------------|
| (A) | 50 | 6" | CEILING SUPPLY DIFFUSER | 6" Φ | 4-WAY BLOW |
| (B) | 150 | 8" | | 8" Φ | |
| (C) | 200 | 8" | | 8" Φ | |
| (D) | 250 | 8" | | 8" Φ | |
| (E) | 300 | 10" | | 10" Φ | |
| (F) | 350 | 10" | | 10" Φ | |
| (G) | 400 | 10" | | 10" Φ | |
| (H) | 500 | 12" | | 12" Φ | |
| (I) | 50 | 6" | | 6" Φ | |
| (J) | 100 | 6" | | 6" Φ | |
| (K) | 200 | 8" | | 8" Φ | |
| (L) | 400 | 10" | | 10" Φ | |
| (M) | 500 | 12" | | 12" Φ | |
| VARS | TWO 24X24 | | RETURN AIR GRILLE | | FOR INVERTED T-BAR |
| VARS | FOUR 24X24 | | RETURN AIR GRILLE | | FOR INVERTED T-BAR |
| 4,500 | | | 1/2" GALV. HARDWARE CLOTH | | |
| 3,750 | TWO 24X24 | | RETURN AIR GRILLE | | FOR INVERTED T-BAR |
| 75 | 4X6 | | EXHAUST GRILLE | | EQUIP WITH FLANGE |
| 200 | 8X6 | | EXHAUST GRILLE | | |
| 250 | 8X8 | | EXHAUST GRILLE | | |
| 500 | 12X12 | | EXHAUST GRILLE | | |

PUMP SCHEDULE

| SYM. | GPM FLOW | FEET HEAD | H.P. | R.P.M. | ELEC. SERVICE | REMARKS |
|------|----------|-----------|-------|--------|---------------|--------------------|
| P-1 | 225 | 50 | 5 | 1750 | 480 3 | CHILLER PUMP |
| P-2 | 94 | 20 | 1 1/2 | 1750 | 480 3 | BOILER PUMP |
| P-3 | 270 | 50 | 5 | 1750 | 480 3 | COOLING TOWER PUMP |

POWER VENTILATOR SCHEDULE

| SYM. | CFM | S.P. | RPM | H.P. | MAX. T.F. S.P.E.I.D. | ELECTRICAL | TYPE | REMARKS |
|--------|-----|------|------|------|----------------------|------------|-----------|---------|
| PRV #1 | 650 | 1/4" | 1550 | 1/20 | 3676 | 120 VOLT | ROOF VENT | |
| PRV #2 | 800 | 1/4" | 1145 | 1/12 | 3320 | 120 VOLT | ROOF VENT | |
| PRV #3 | 850 | 1/4" | 675 | 1/12 | 2562 | 120 VOLT | ROOF VENT | |
| PRV #4 | 250 | 1/4" | 1550 | 1/40 | 3019 | 120 VOLT | ROOF VENT | |


BOILER SCHEDULE

| SYM. | S&I GROSS RATING | FIRING RATE | HEATING SURFACE | TRIM | REMARKS |
|--------|------------------|-------------|-----------------|--------|--------------------|
| BOILER | 4,100 MBH | 22 GPH | 3,322 SQ. FT. | 429 °F | 247 °F + HOT WATER |

CABINET UNIT HEATER SCHEDULE

| SYM. | BTU/HR | GPM* | HIGH SPEED RPM | WATTS | ELECTRICAL | REMARKS |
|--------|--------|------|----------------|-------|------------|---------------|
| CHU #1 | 45,000 | 4.5 | 775 | 130 | 115V-1Φ | SEMI-RECESSED |
| CHU #2 | 45,000 | 4.5 | 775 | 130 | 115V-1Φ | |
| CHU #3 | 15,000 | 1.5 | 1050 | 85 | 115V-1Φ | |
| CHU #4 | 15,000 | 1.5 | 1050 | 85 | 115V-1Φ | |

* MAX. WATER PRESSURE UNDER 5'

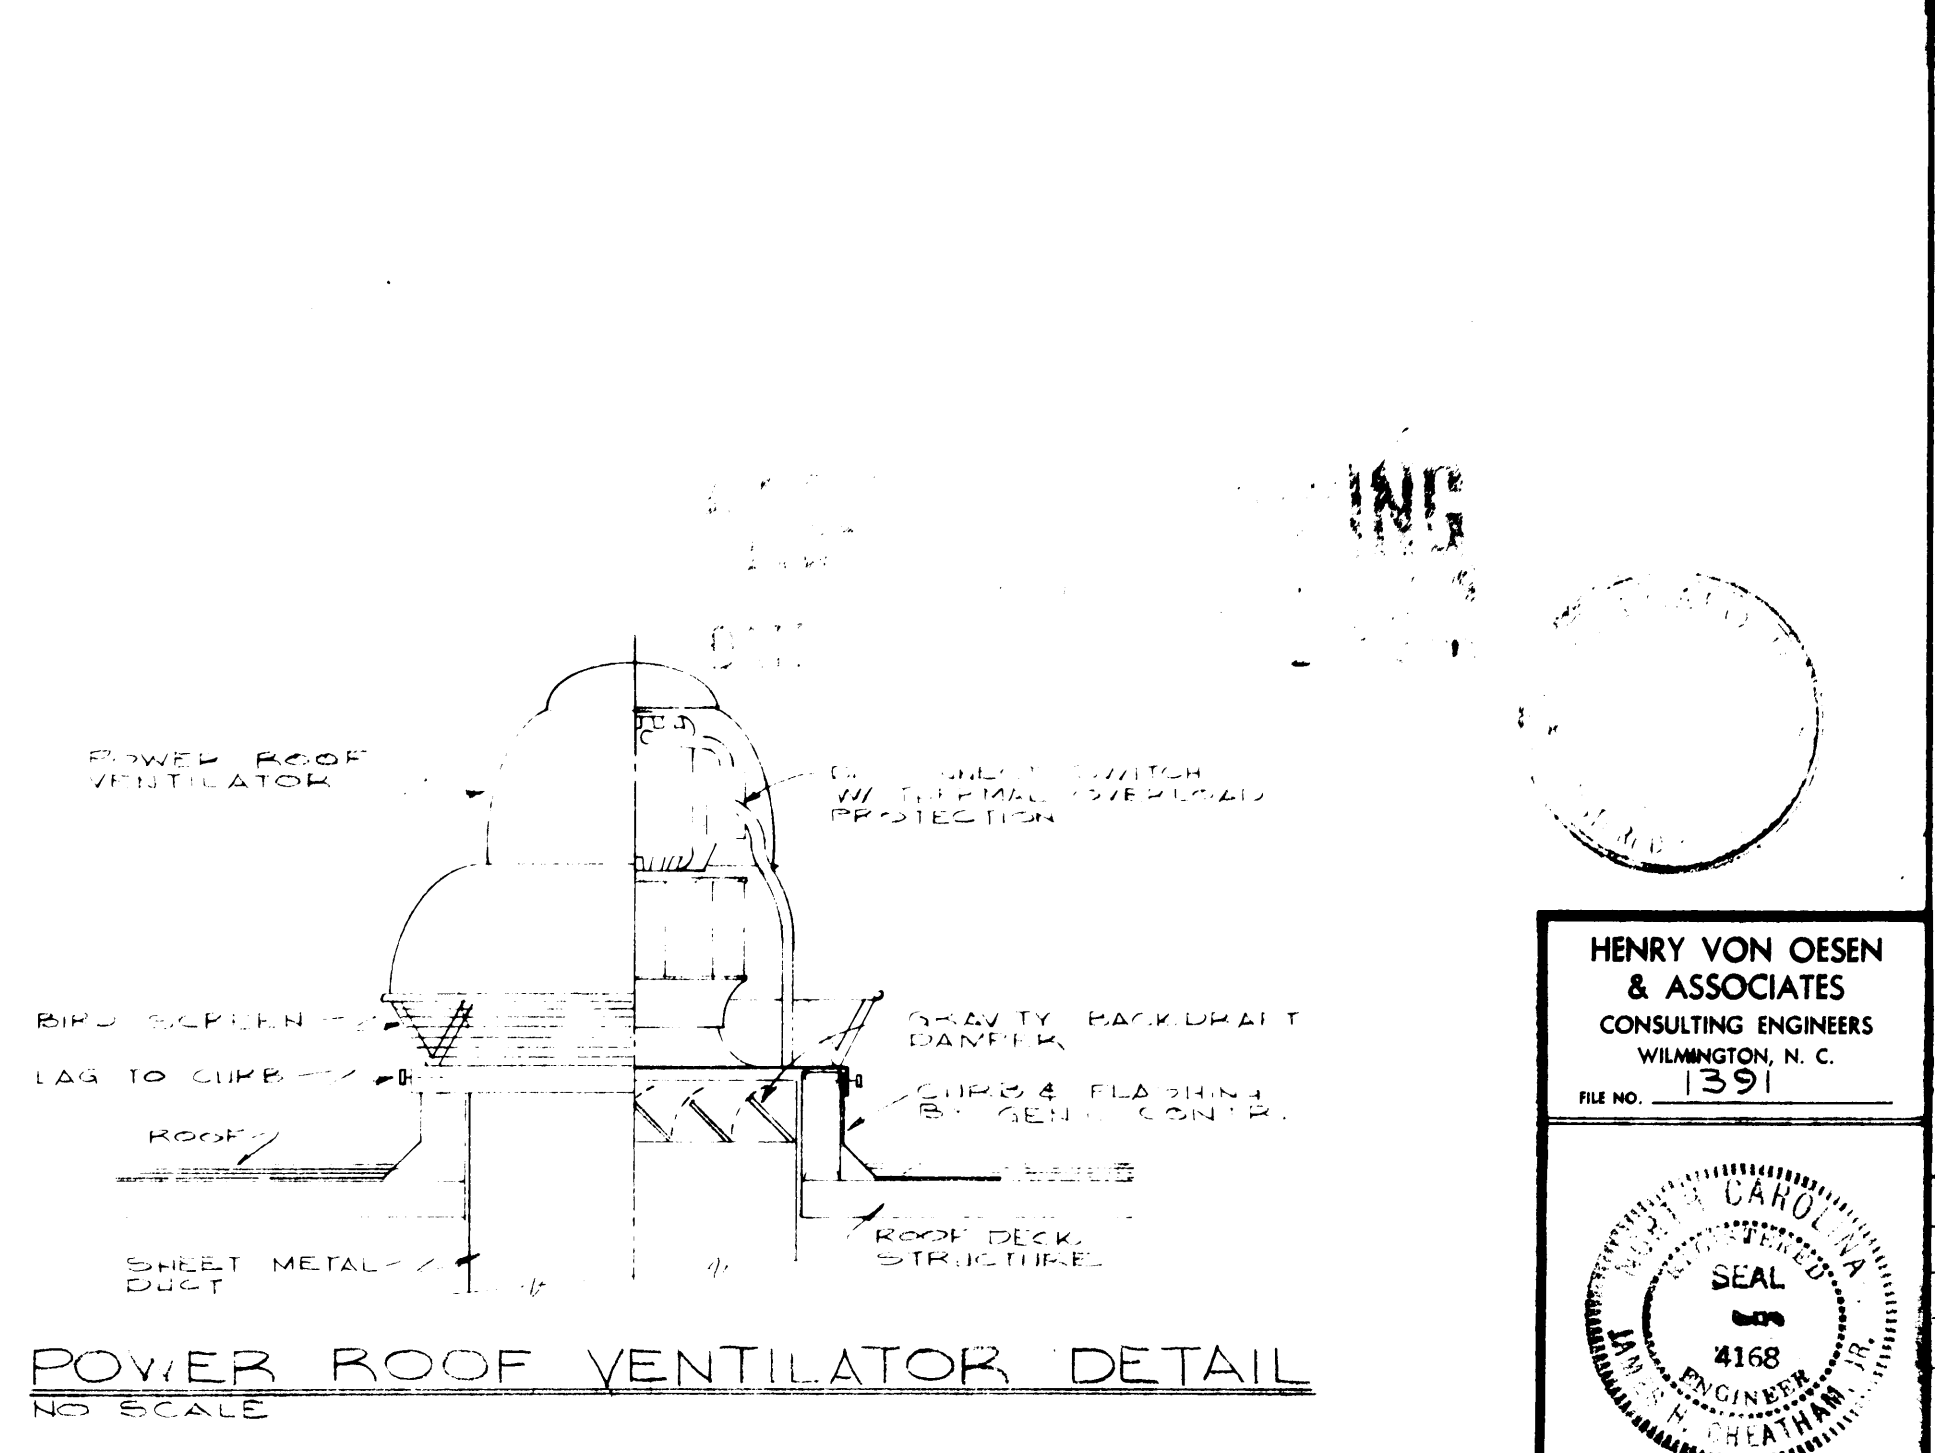

WILMINGTON COLLEGE EDUCATION & PSYCHOLOGY BUILDING
WILMINGTON, NORTH CAROLINA
BOARD OF TRUSTEES - L. BRADFORD TILLER, JR. CHAIRMAN - DR. WILLIAM M. RANDALL, PRESIDENT

BALLARD, McKIM, & SAWYER, AIA
612 SOUTH SEVENTEENTH STREET
WILMINGTON, NORTH CAROLINA

HENRY VON OESSEN & ASSOCIATES
CONSULTING ENGINEERS
WILMINGTON, N. C.
FILE NO. 1391

SEAL
4168
ENGINEER
WILMINGTON, N. C.

DRAWN BY: J.G.W.
CHECKED BY: J.G.W.
DATE: 4-1-64

SHEET NO. M-3
OF 3



| | |
|--------------|-------------------|
| PROJECT NO: | 620589 |
| DATE: | FEBRUARY 10, 2023 |
| REVISIONS: | |
| DATE: | |
| DESCRIPTION: | |

KING HALL ALTERNATE SUMMARY

ALTERNATE #1: REPLACE EXISTING WINDOWS AND WINDOW SHADES REFER TO A1.1, A2.1, A3.1.1, AND A3.2.2

ALTERNATE #2: RECOAT FLATROOF REFER TO A2.2

ALTERNATE #3: PROVIDE CARPET PAINT AND BASE IN FIRST FLOOR OFFICES REFER TO A1.1 AND A3.0.1

ALTERNATE #3A: PROVIDE CARPET PAINT AND BASE IN FIRST FLOOR CLASSROOM 104 REFER TO A1.1 AND A3.0.1

ALTERNATE #4: PROVIDE 2 NEW EXTERIOR WINDOWS AND WINDOW SHADES AT ROOM 201A REFER TO A1.1, A2.1, A3.1.1, A3.2.1, AND A4.1

ALTERNATE #5: SCRAPE AND PAINT EXTERIOR TRIM REFER TO A4.1

ALTERNATE #6: REPLACE HOLLOW METAL FRAMES @ DOORS S100, S101.2, S200, AND S201 REFER TO A2.1, A3.1.1, AND A3.2.1

ALTERNATE #7: CUSTOM WAYFINDING REFER TO A4.1

ALTERNATE #8: RECONFIGURE AND UPDATE MENS TOILET ROOM REFER TO A1.1, A2.1, AND A2.3

FLOOR PLAN GENERAL NOTES

A. REFER TO A3.0.1 FOR FINISH SCHEDULE AND PLANS FOR CASEWORK AND FINISH INFORMATION

B. REFER TO LS2.1 FOR RATED ASSEMBLIES LEGEND INDICATED BY (XII)

FLOOR PLAN KEYNOTES

REPRESENTED BY (A)

APPLIES TO DRAWINGS A2.1 - A2.m

- CONCRETE SLAB INFILL; REFER TO FLOOR INFILL SUPPORT DETAIL S1.1 FOR ADDITIONAL INFORMATION
- PATCH ROOF; REFER TO DETAIL 3/A2.2
- 6" CFPS-F FILLED WITH BATT INSULATION
- REPAIR GYP WALL PATCH; FINISH TO MATCH EXISTING ADJACENT
- EXISTING RATED HORIZONTAL ASSEMBLIES TO REMAIN
- REINSTALL SHELVING
- REINSTALL SHELVING
- ALTERNATE #6 INSTALL NEW 45 MIN HOLLOW METAL FRAME REFER TO A3.1.1 FOR ADDITIONAL INFORMATION
- AUTO OPERATOR
- ROOF MEMBRANE
- 1/2" COVER BOARD
- 1 1/2" MIN TAPERED POLYISOCYANURATE INSULATION
- 1 1/2" CORRUGATED METAL DECK; REFER TO ROOF INFILL DETAIL ON S1.1 FOR ADDITIONAL INFORMATION
- UNISTRUT; REFER TO ROOF INFILL DETAIL ON S1.1 FOR ADDITIONAL INFORMATION
- FILL EXISTING STUD CAVITY WITH SOUND ATTENUATION BLANKETS
- PATCH CMU WALL ABOVE WHERE DUCTWORK WAS REMOVED; VERIFY DIMENSIONS AND LOCATIONS OF OPENINGS IN FIELD
- OFCI SEMI RECESSED AED CABINET; 3'-0" AFF MAX TO LATCH
- ALTERNATE #1 REPLACE EXISTING WINDOW WITH AW 1; REFER TO A3.1.1 AND 12/A3.2.2 FOR ADDITIONAL INFORMATION
- ALTERNATE #1 REPLACE EXISTING WINDOW WITH AW 1; REFER TO A3.1.1 AND 10/A3.2.2 FOR ADDITIONAL INFORMATION
- PATCH AND REPAIR WALL WHERE PIPE INSTALLATION OCCURS
- INSTALL DOOR REEFING DEVICE
- EXISTING COLUMN WRAP TO REMAIN
- VERIFY LOCATION OF JOISTS BELOW AND COORDINATE PLUMBING PENETRATIONS
- MARKER BOARD
- BENCH REFER TO 8/A8.1 FOR ADDITIONAL INFORMATION
- NEW CATWALK
- NEW CATWALK
- 1 1/2" PAINTED STEEL PIPE POST 4'-0" OC MAX
- 1 1/2" PAINTED STEEL PIPE RAIL
- PAINTED STEEL GUARD AROUND PERIMETER OF CATWALK
- 4" HIGH BY 4" LONG FRP AT WALLS ADJACENT TO SINK

TOILET ASSEMBLIES

APPLIES TO DRAWING A2.1
 REPRESENTED BY (TA)

| MARK | REMARKS | PLAN | MARK | REMARKS | PLAN |
|------|----------|------|------|----------------------|------|
| TA1 | | | TA9 | NOTE D | |
| TA2 | OMIT (E) | | TA10 | NOTE D | |
| TA3 | | | TA11 | CENTER OVER LAVATORY | |
| TA4 | OMIT (E) | | | | |
| TA7 | | | | | |
| TA8 | OMIT (E) | | | | |

LEGEND NOTES:

A. HANDING/ORIENTATION MAY VARY. REFER TO PLANS FOR PROPER ORIENTATION.

B. PLUMBING FIXTURE GRAPHICS IN THIS LEGEND ARE REPRESENTATIVE ONLY. ACTUAL PLUMBING FIXTURES MAY VARY.

C. COATROBE HOOKS INDICATED ON THE BACK OF TOILET COMPARTMENT DOORS ARE PART OF THE TOILET COMPARTMENT ASSEMBLY AND ARE NOT CONSIDERED A TOILET ACCESSORY.

D. URINAL PARTITIONS SHALL EXTEND NOT LESS THAN 1'-10" OR TO A POINT NOT LESS THAN 6" BEYOND THE OUTERMOST FRONT LIP OF THE URINAL AS MEASURED FROM THE FINISHED BACK WALL SURFACE, WHICHEVER IS GREATER.

TOILET ACCESSORIES SCHEDULE

| MARK | DESCRIPTION | MOUNTING HEIGHT | REMARKS |
|------|--|---|--------------------------------------|
| A | 38" HORIZONTAL GRAB BAR | REFER TO WATER CLOSET ELEVATIONS | |
| B | 42" HORIZONTAL GRAB BAR | REFER TO WATER CLOSET ELEVATIONS | |
| C | 18" VERTICAL GRAB BAR | REFER TO WATER CLOSET ELEVATIONS | |
| D | TOILET TISSUE DISPENSER | REFER TO WATER CLOSET ELEVATIONS | OWNER FURNISHED CONTRACTOR INSTALLED |
| E | SANITARY NAPKIN DISPOSAL | REFER TO WATER CLOSET ELEVATIONS | OWNER FURNISHED CONTRACTOR INSTALLED |
| F | SOAP DISPENSER | 3'-4" AFF TO DISPENSING OUTLET | |
| G | MIRROR (24" x 48"), OVER LAV AND CONTERTOP | 3'-4" AFF TO BOTTOM OF REFLECTIVE SURFACE | OWNER FURNISHED CONTRACTOR INSTALLED |
| Q | PAPER TOWEL DISPENSER | 3'-4" AFF TO DISPENSING OUTLET | |
| R | CHANGING STATION | 3'-8" MAX AFF TO LATCH | OWNER FURNISHED CONTRACTOR INSTALLED |









1. ACCESSORY ITEMS ARE IDENTIFIED BY () ON PLANS. LETTERS CORRESPOND TO SCHEDULE ABOVE.

2. ACTUAL DIMENSIONS OF ACCESSORIES MAY VARY. COORDINATE DIFFERENCES, IF ANY.

3. REFER TO ALL CASEWORK ELEVATIONS FOR ADDITIONAL TOILET ACCESSORY LOCATIONS.

4. PROVIDE MOP AND BROOM HOLDER W/ SHELF () AT ALL CUSTODIAL/JANITORIAL SINKS. MOUNT AT 5'-0" AFF TO CENTERLINE AND LOCATE ON SIDE WALL OF SINK (NOT ON WALL ABOVE FAUCET).

5. PROVIDE ROBE HOOK ON INTERIOR FACE OF ALL TOILET ROOM DOORS WHEREIN ONLY ONE WATER CLOSET IS PROVIDED. MOUNT AT 3'-11" AFF TO TOP.

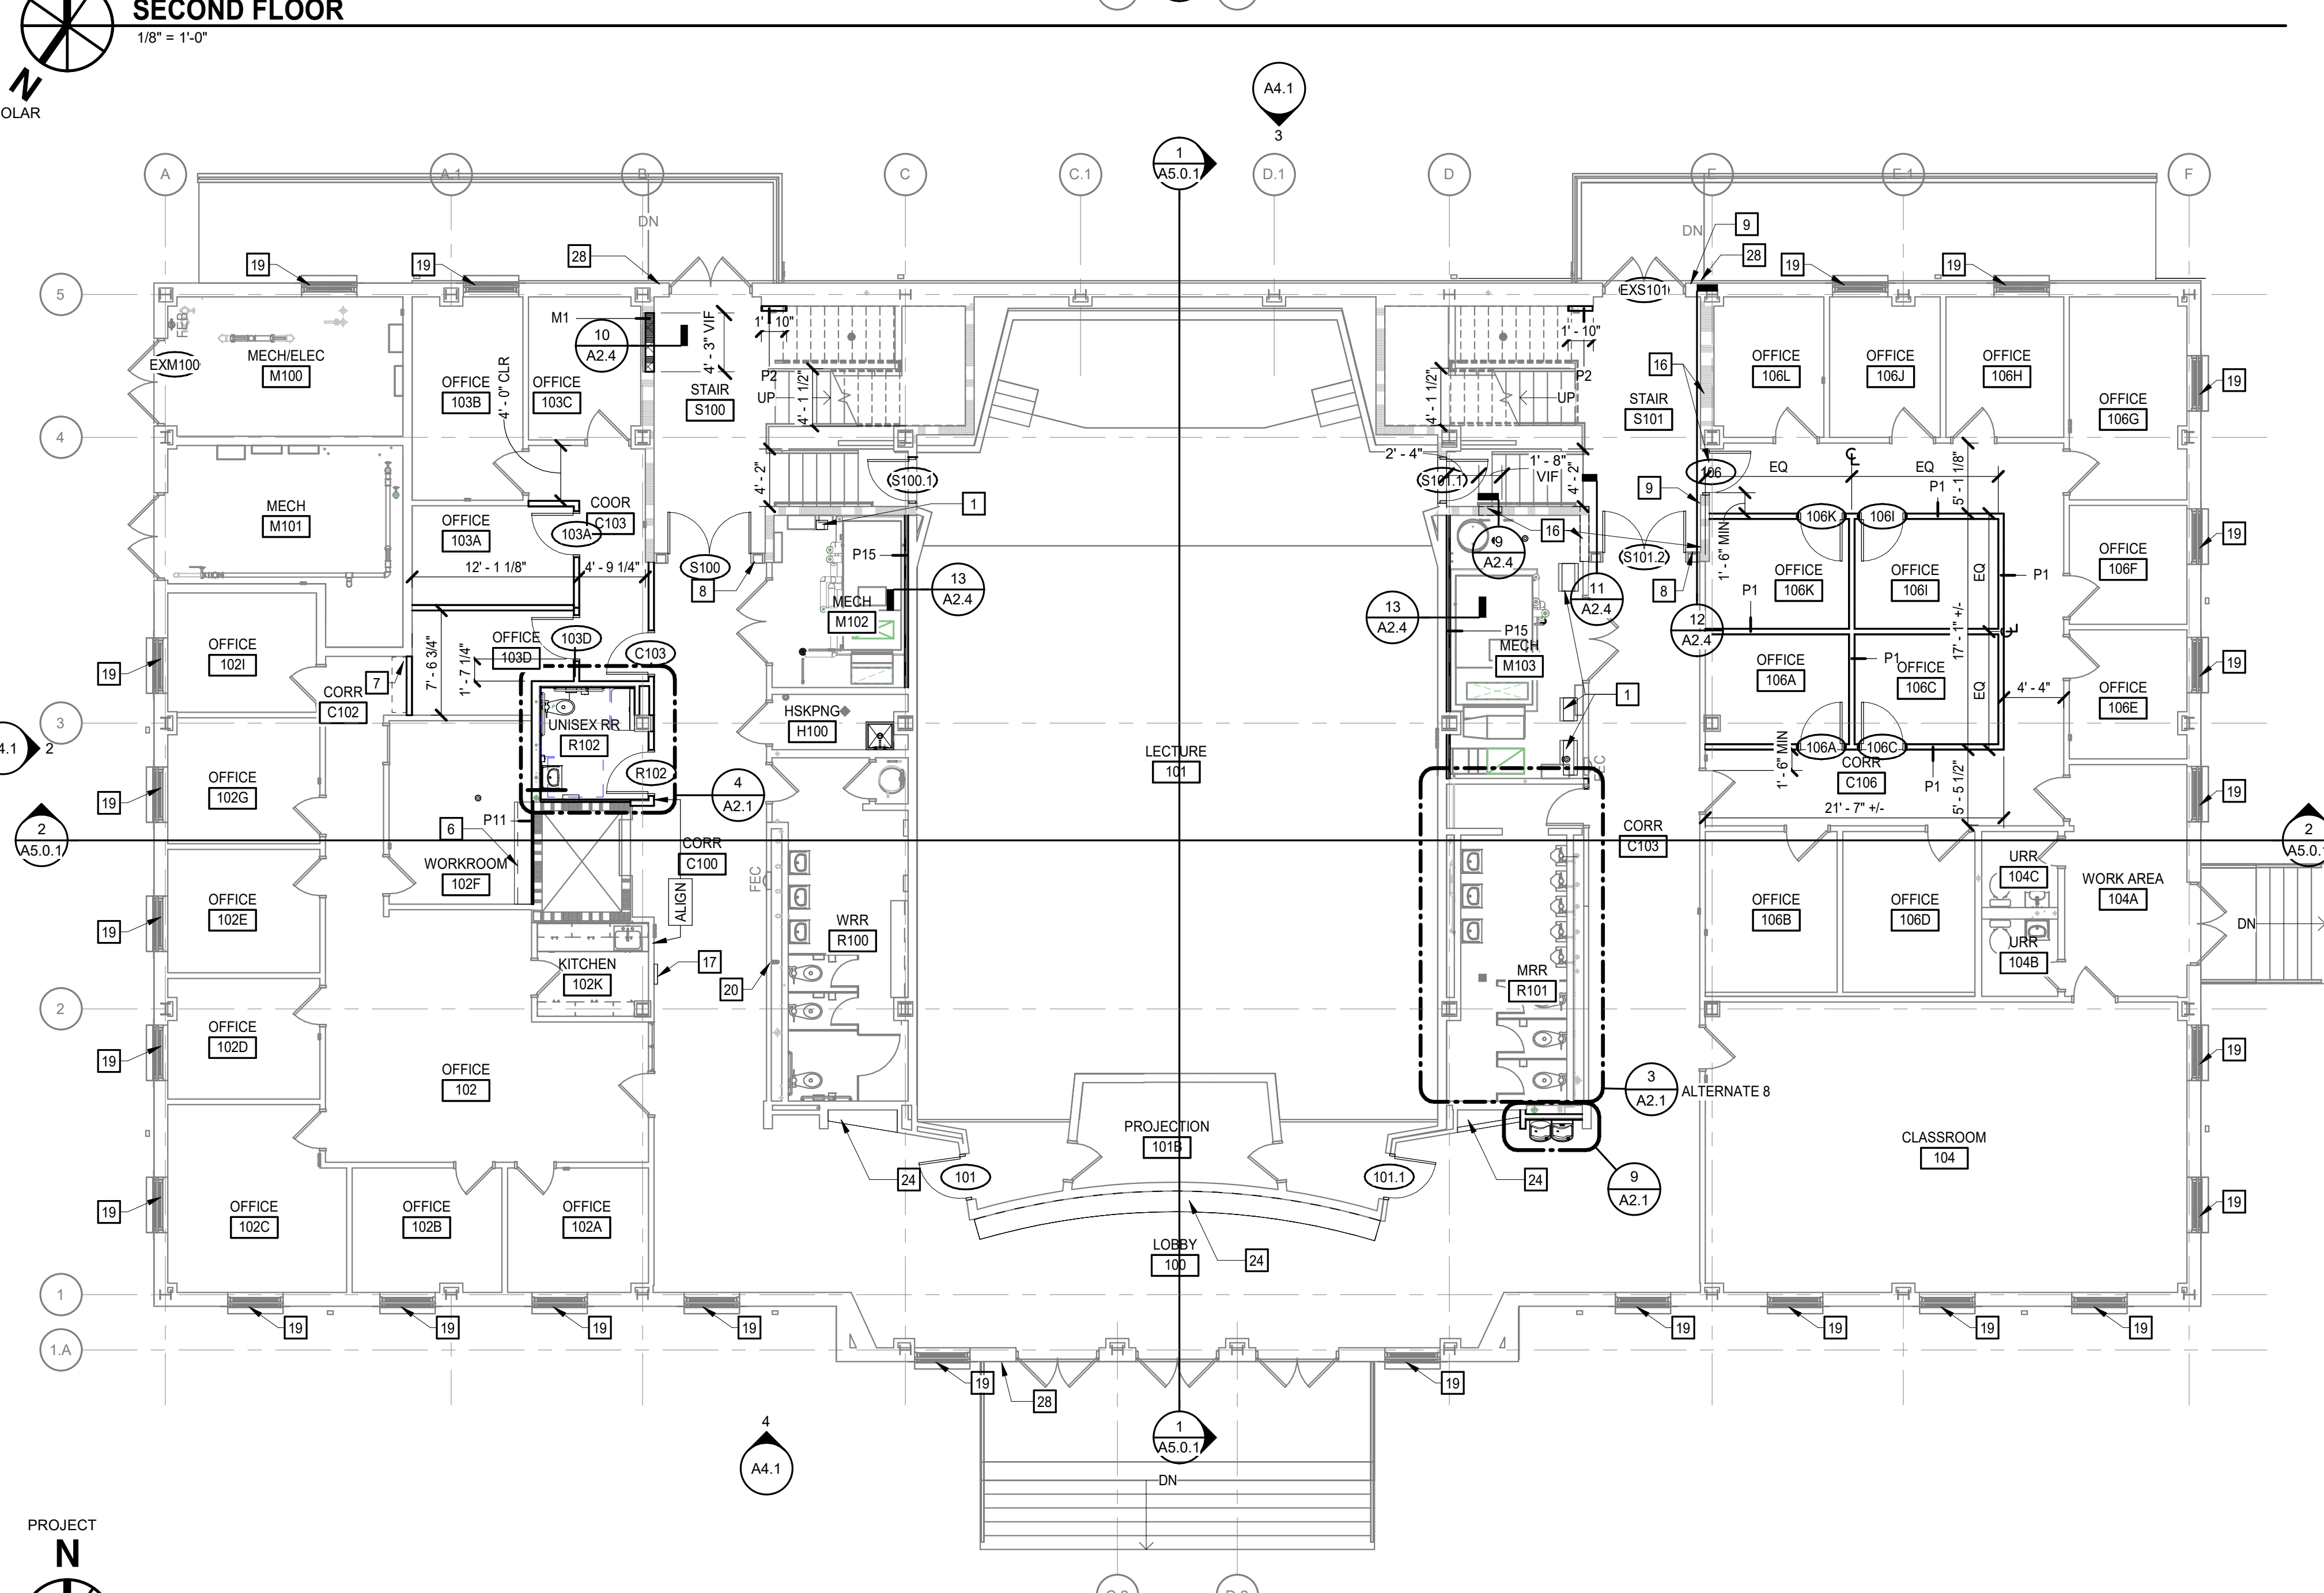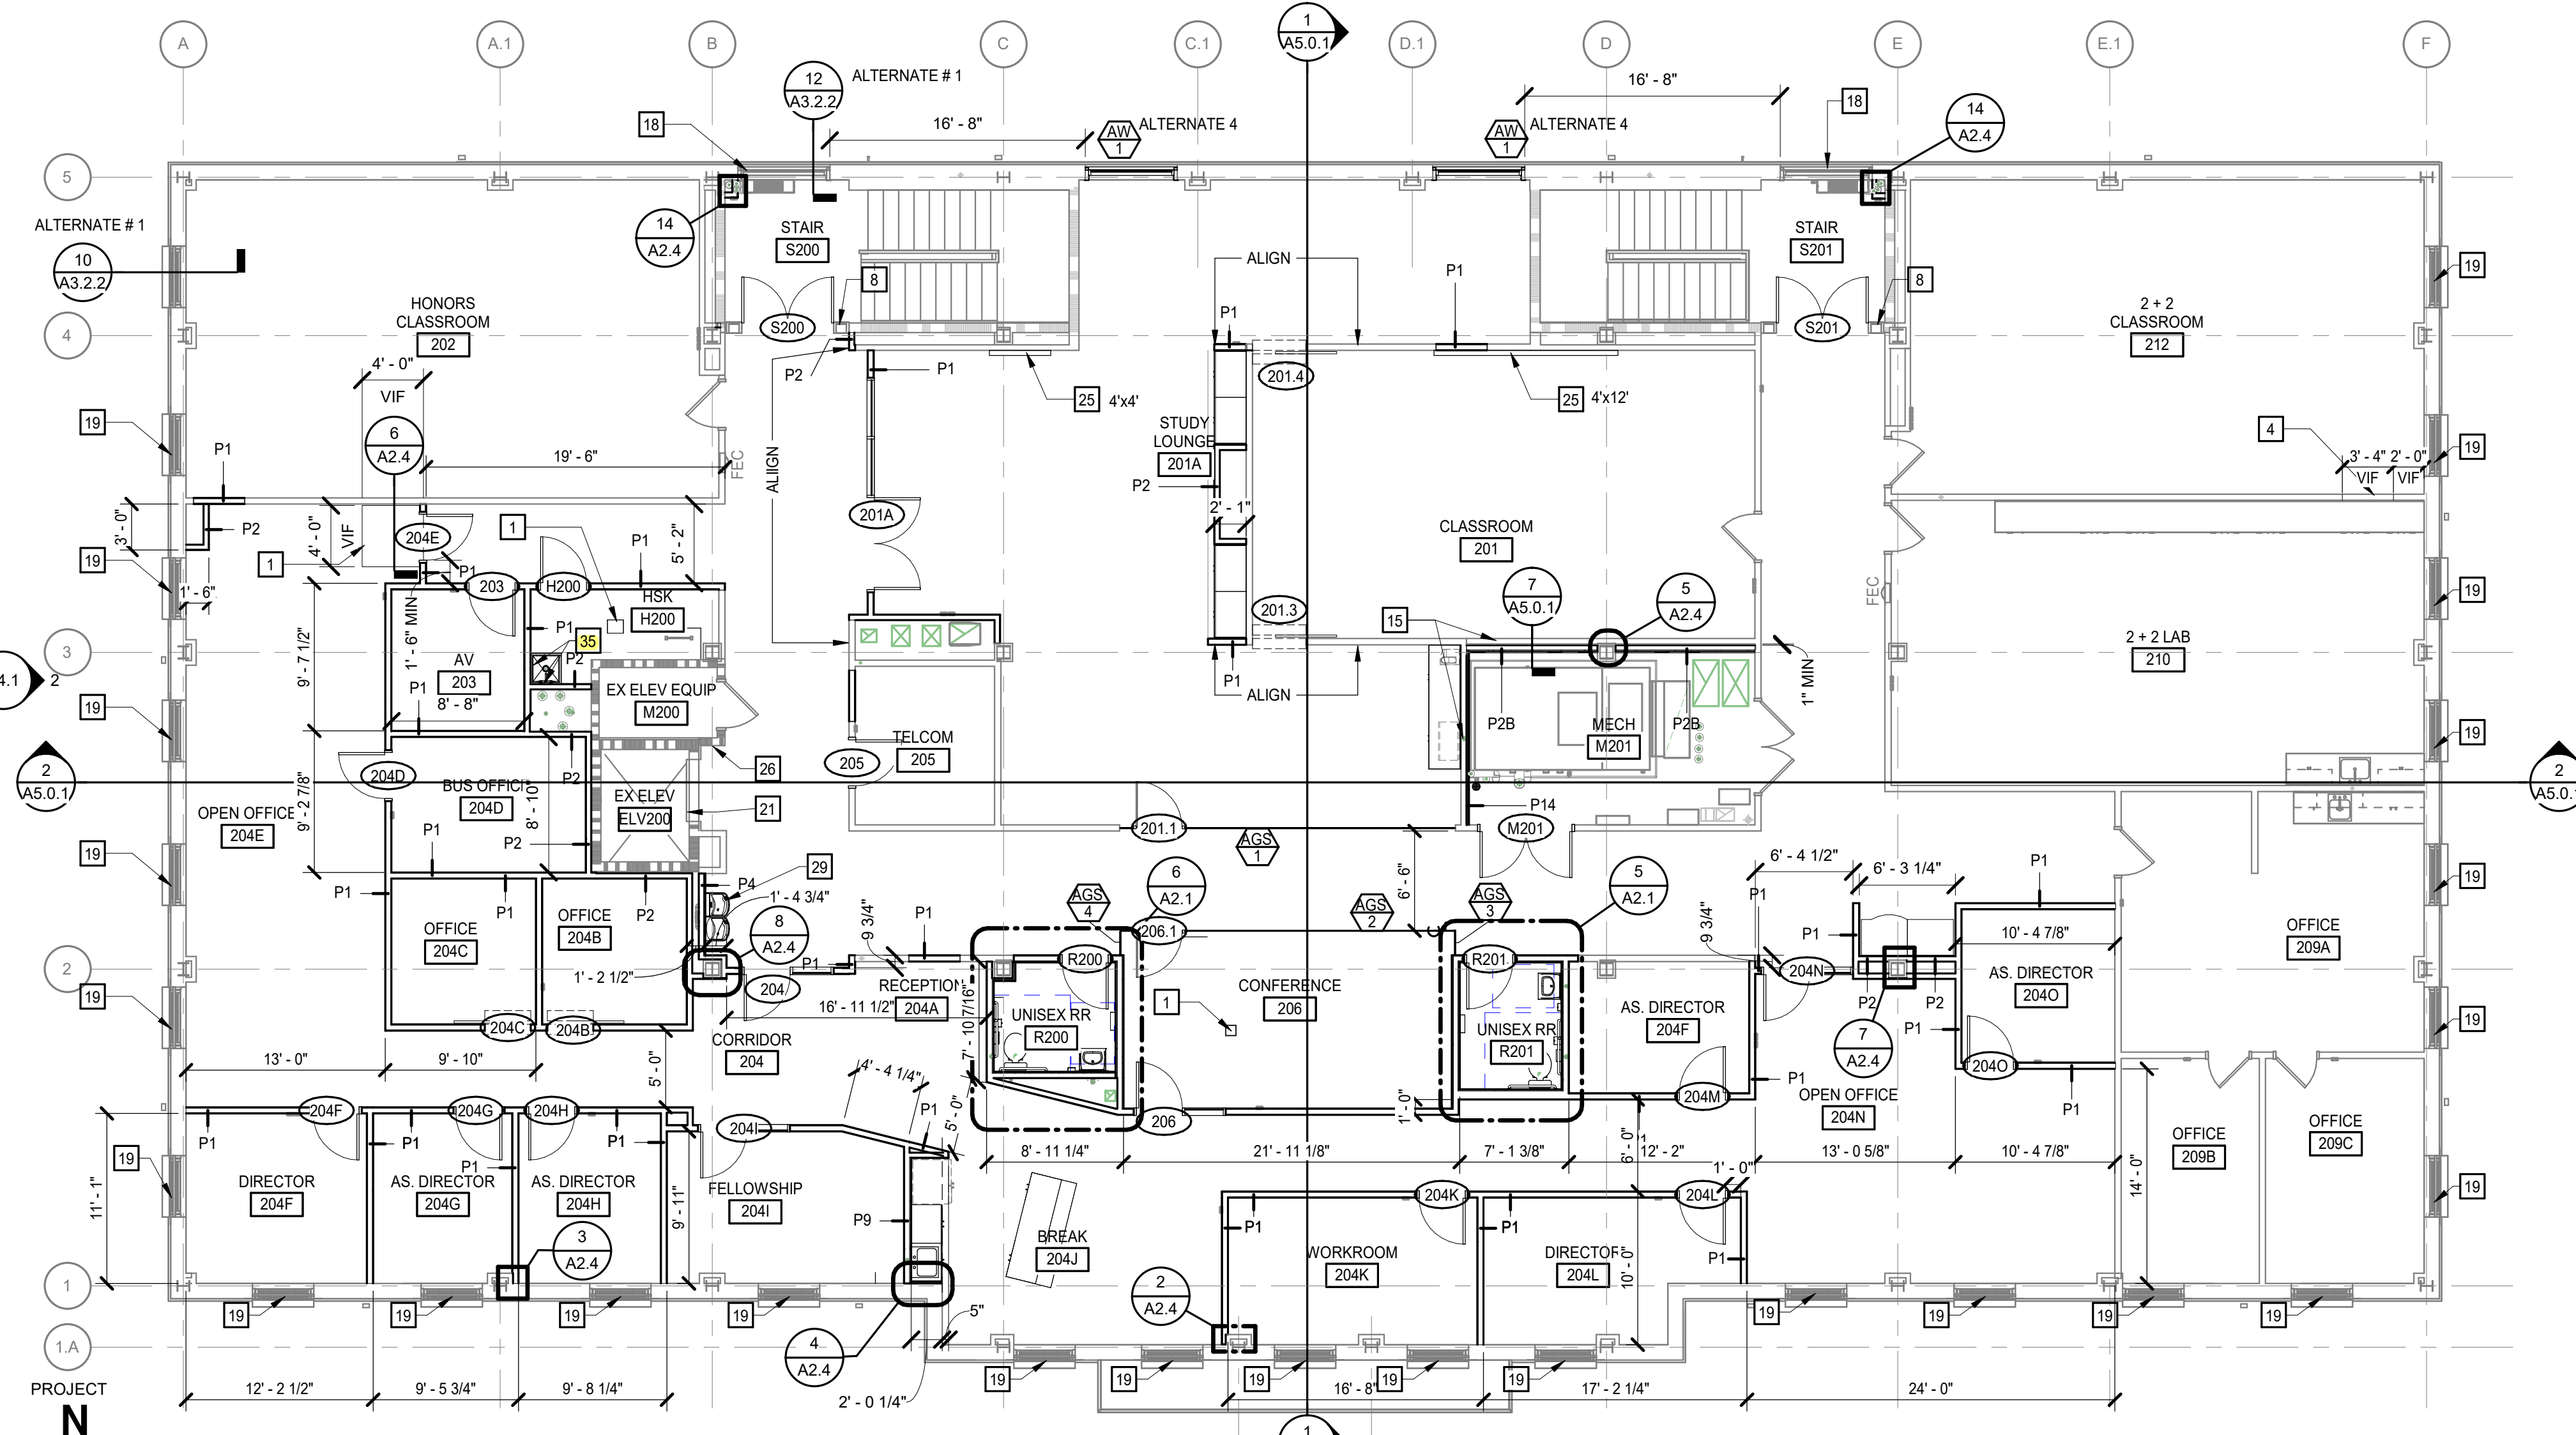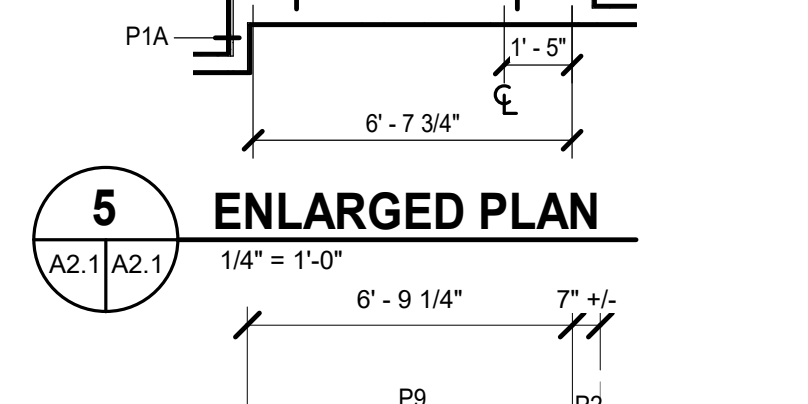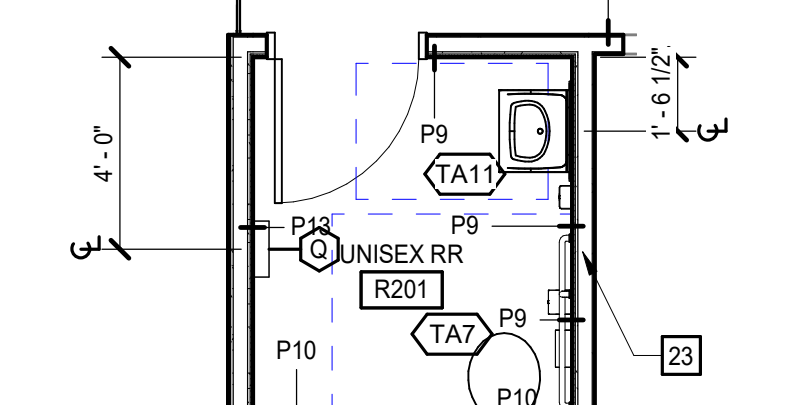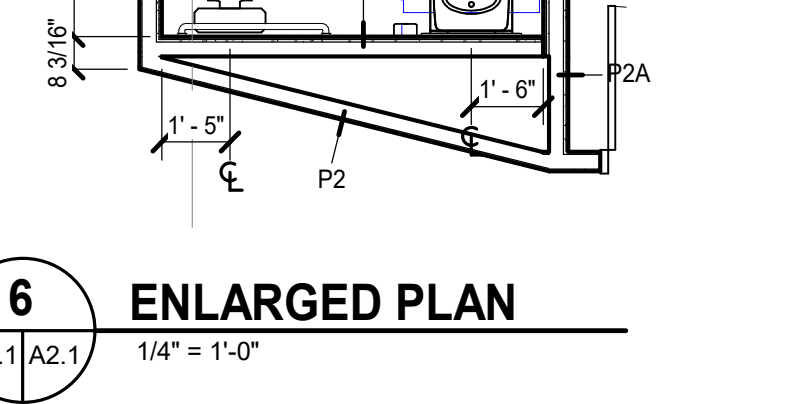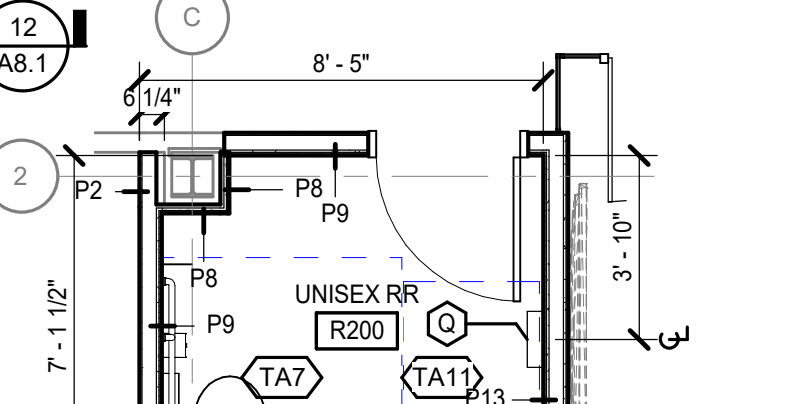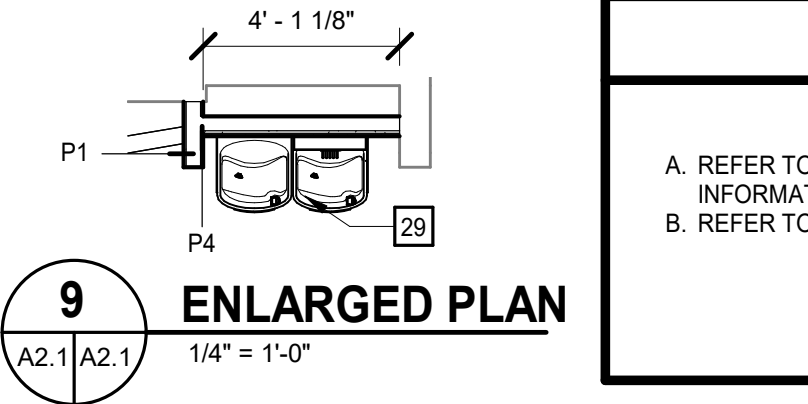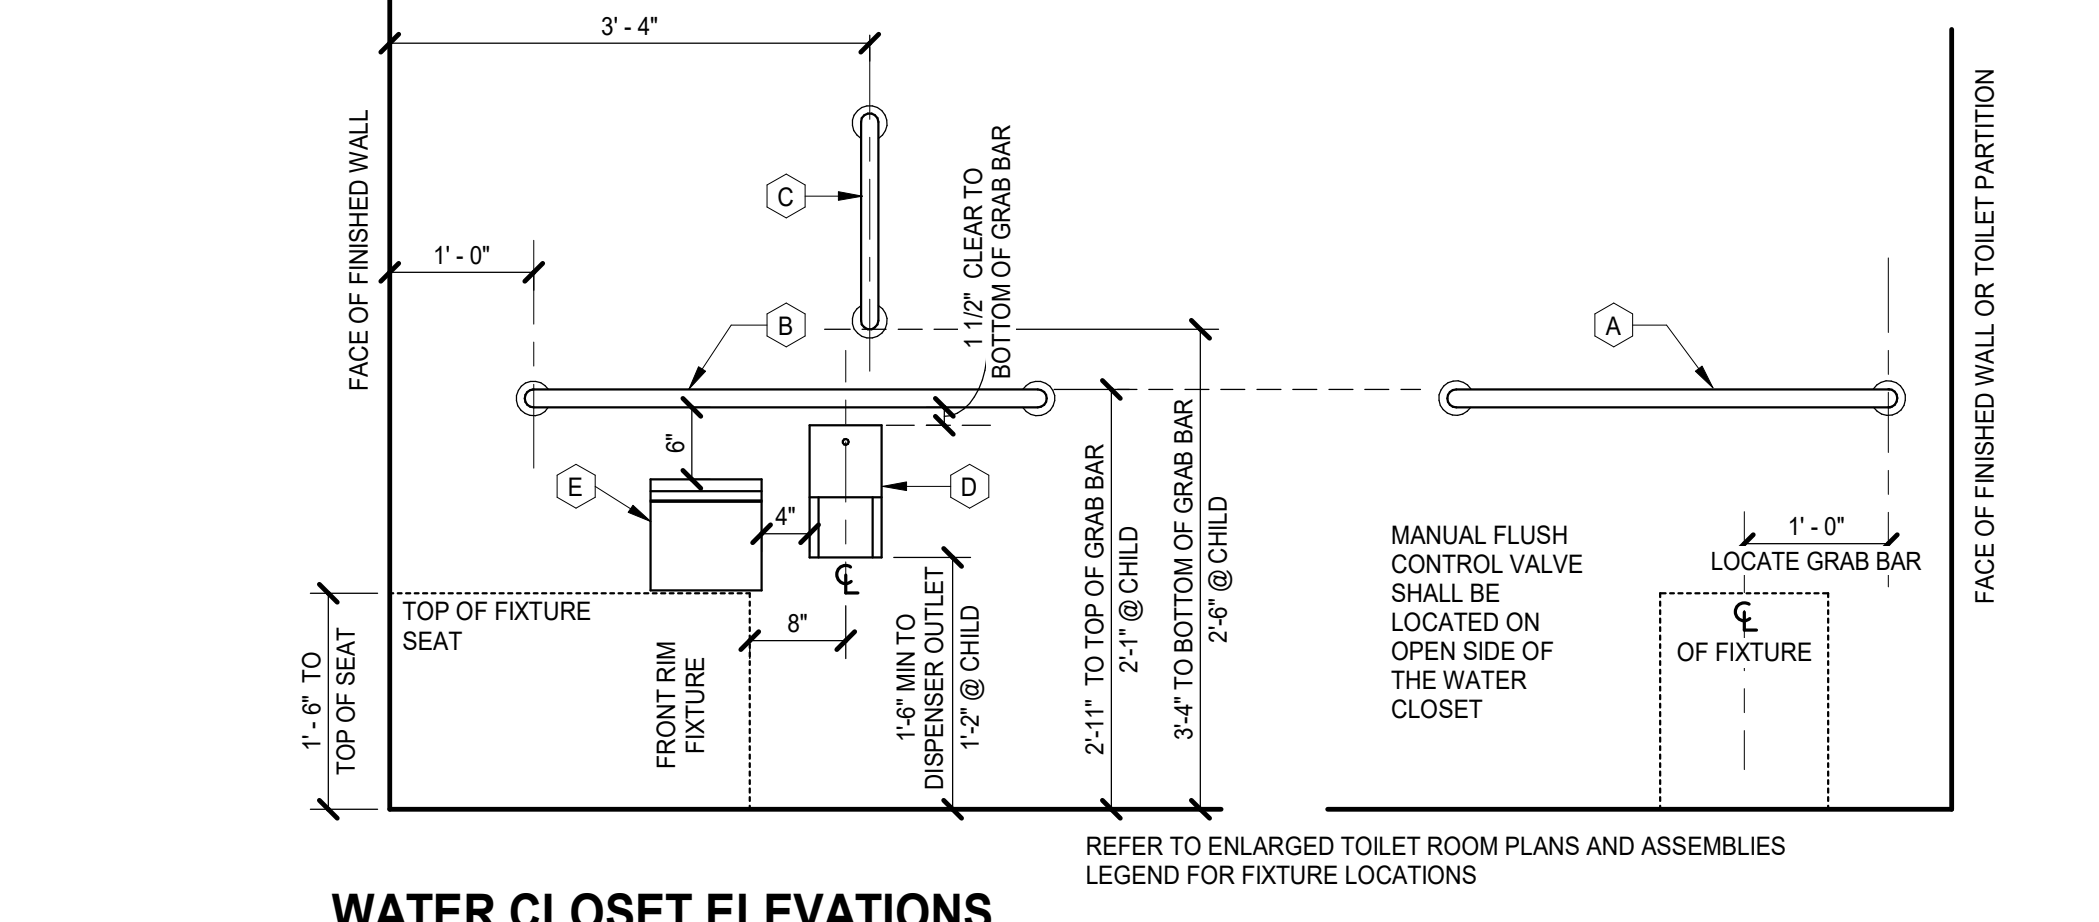





| | |
|--------------|-------------------|
| PROJECT NO: | 620589 |
| DATE: | FEBRUARY 10, 2023 |
| REVISIONS: | |
| DATE: | |
| DESCRIPTION: | |

| DOOR AND FRAME DETAIL KEYNOTES | |
|-------------------------------------|---|
| REPRESENTED BY [] | |
| APPLIES TO DRAWINGS A3.2.1 - A3.2.n | |
| 1 | ANCHORAGES, REINFORCING, SPECIFIC PARTITION CONSTRUCTION AND/OR LINTELS ARE NOT SHOWN FOR CLARITY. |
| 2 | REFER TO FRAME SECTION IN DOOR SCHEDULE FOR TYPE. |
| 3 | SEALANT, ALL SIDES - TOOL TO 90°. |
| 4 | BACKBEND RETURN @ GB LOCATIONS ONLY. |
| 5 | 9/16" @ MAS. 1/2" @ GB. |
| 6 | 1/4" @ JAMBS, UNO, DIMENSION @ HEAD & SILL VARIES. |
| 7 | BULLNOSE @ CMU JAMBS & SILLS. |
| 8 | 0" @ GB LOCATIONS, 1/16" @ MAS LOCATIONS. |
| 9 | GROUT SOLID |
| 10 | 5/8" GYPSUM BOARD |
| 11 | PARTITION AS SCHEDULED REFER TO PLAN |
| 12 | FINISH FLOOR, TYPE VARIES REFER TO FINISH SCHEDULE AND PLANS |
| 13 | EXISTING CMU WALL |
| 14 | LOUVER BLIND |
| 15 | ROLLER BLINDS REFER TO A2.3 RCP PLANS FOR LOCATIONS |
| 16 | LOUVER BLIND LOCATION VARIES |
| 17 | ALUMINUM WINDOW |
| 18 | CUSTOM ALUMINUM SILL EXTENSION |
| 19 | CONTINUOUS SEALANT |
| 20 | WOOD SILL |
| 21 | WOOD TRIM |
| 22 | FACE BRICK SILL; COLOR AND PROFILE TO MATCH EXISTING |
| 23 | WOOD BLOCKING |
| 24 | METAL FLASHING |
| 25 | CUSTOM ALUMINUM TRIM |
| 26 | STEEL LINTEL; REFER TO STRUCTURAL DRAWINGS |
| 27 | CONTINUOUS SEALANT AND BACKER ROD |
| 28 | NOTCH EXISTING CMU TO ACCOMMODATE LINTEL |
| 29 | WEEP |
| 30 | NOTCH BRICK |
| 31 | REMOVE AND PATCH GYPSUM AS REQUIRED TO FINISH OPENING AND INSTALL DOOR HARDWARE |
| 32 | ALTERNATE # 6: REMOVE DOOR FRAME REFER TO ALTERNATE 6 DEMOLITION PLAN A1.1 FOR ADDITIONAL INFORMATION |
| 33 | WOOD BLOCKING AS REQUIRED TO MOUNT DOOR TRACK |
| 34 | C/SFAS |
| 35 | EXISTING MASONRY WALL |
| 36 | BARN DOOR TRACK |
| 37 | EXISTING BRICK SILL TO REMAIN |
| 38 | EXISTING LINTEL TO REMAIN |
| 39 | EXISTING FLASHING TO REMAIN |
| 40 | METAL FLASHING |
| 41 | PEEL AND STICK AIR BARRIER TRANSITION MEMBRANE |
| 42 | CONTINUOUS TERMINATION BAR AND SEALANT |


| GENERAL NOTES | |
|---------------|--|
| A. | UNLESS INDICATED OTHERWISE, ALL DETAIL NUMBERS IN THE DOOR AND FRAME SCHEDULE FOR HEAD, JAMB AND SILL CONDITIONS REFER TO DRAWINGS A3.2.1 - A3.2.n. |
| B. | DOOR AND FRAME DETAILS INDICATE GENERAL CHARACTERISTICS OF DOOR AND FRAME SIZES AND COMPONENTS AND MAY NOT INDICATE EXACT FIELD CONDITIONS OR REQUIREMENTS. COORDINATE DETAILS WITH OTHER DRAWINGS AND SPECS TO DETERMINE ALL COMPONENTS (E.G. SEALANTS, ANCHORS, HARDWARE, LINTELS, CLIPS) REQUIRED FOR COMPLETE AND FUNCTIONAL INSTALLATION. |
| C. | DOOR SWINGS ON FLOOR PLANS TAKE PRECEDENCE OVER SWINGS INDICATED ELSEWHERE (E.G. ELEVATIONS). |

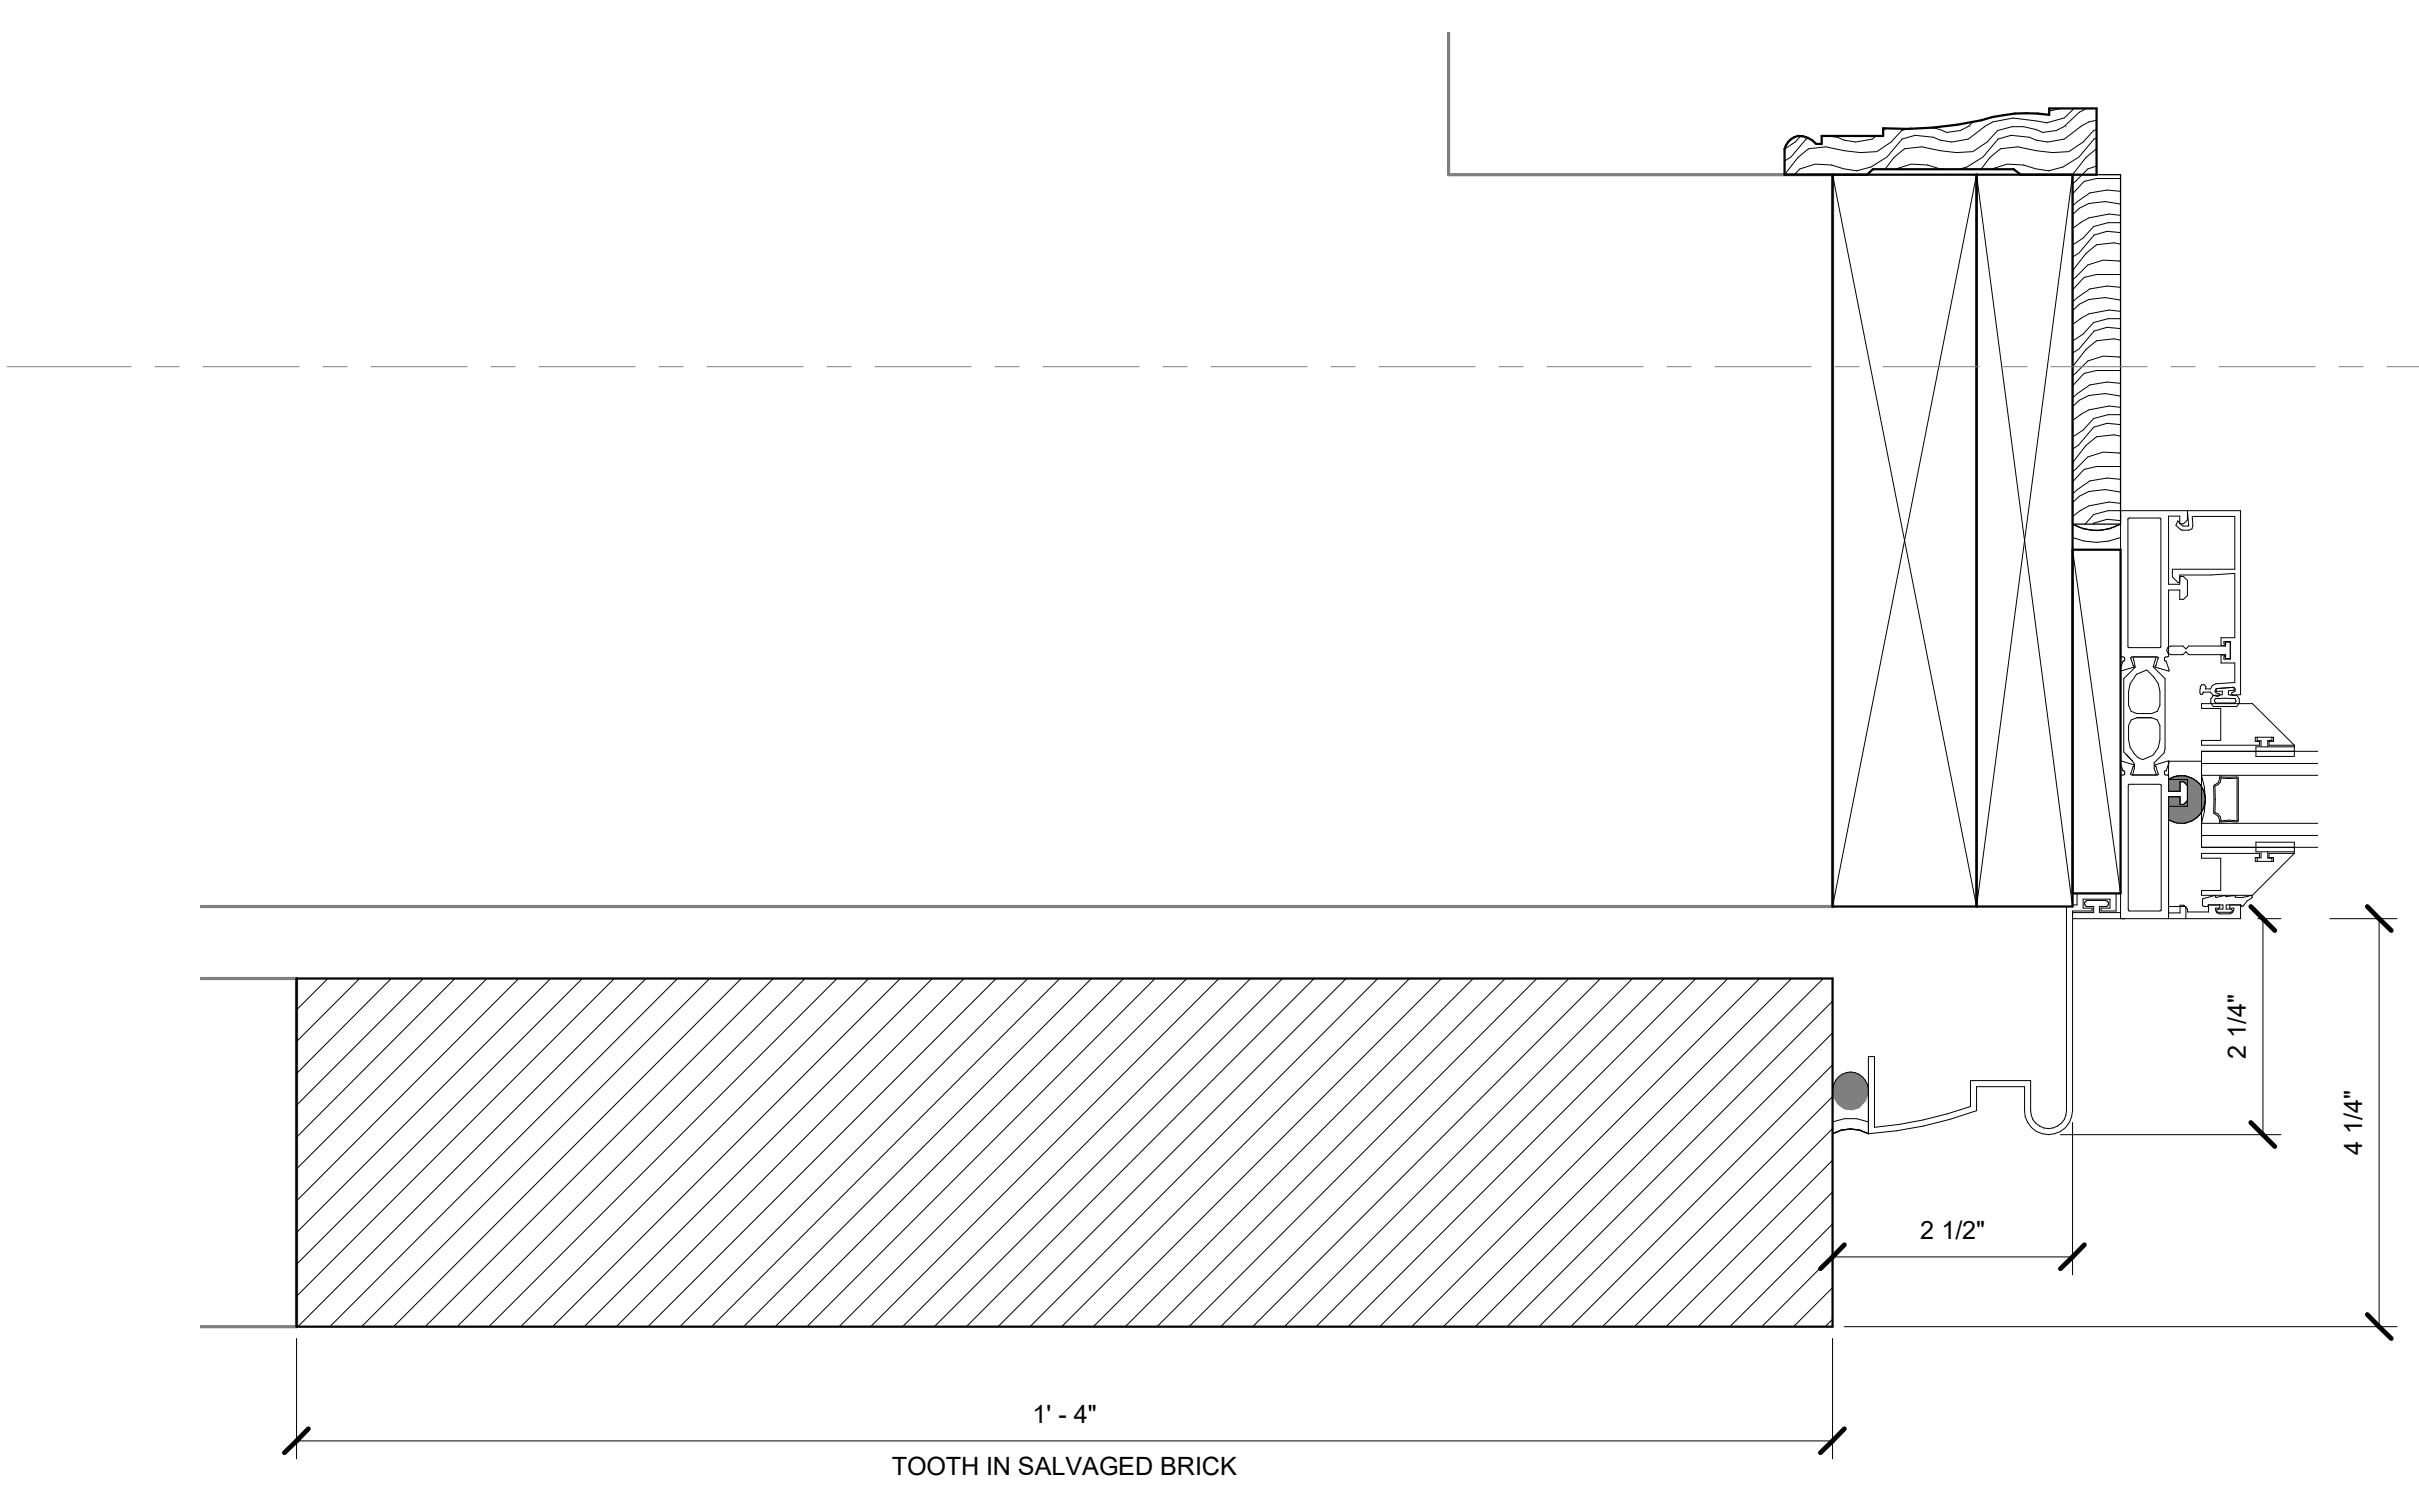


9 ALTERNATE #4 JAMB
A3.1.1 A3.2.1 6" = 1'-0"

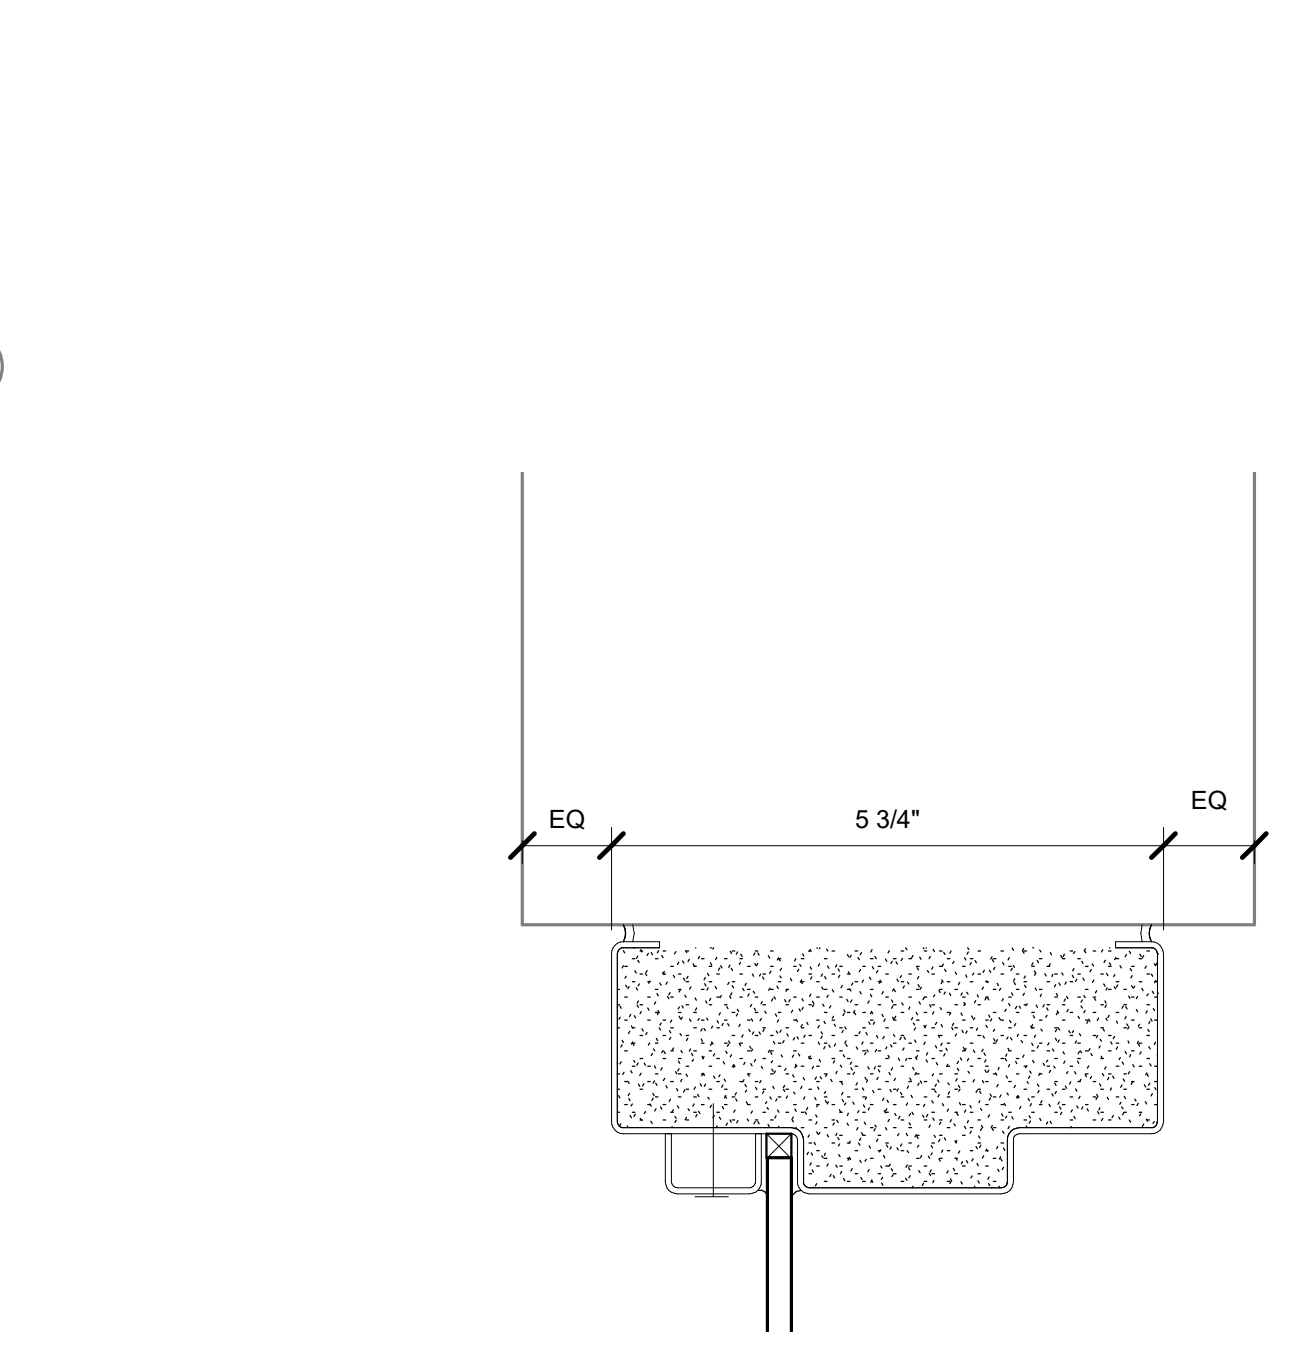


6 HEAD/JAMB DETAIL ALTERNATE #6
A3.1.1 A3.2.1 6" = 1'-0"

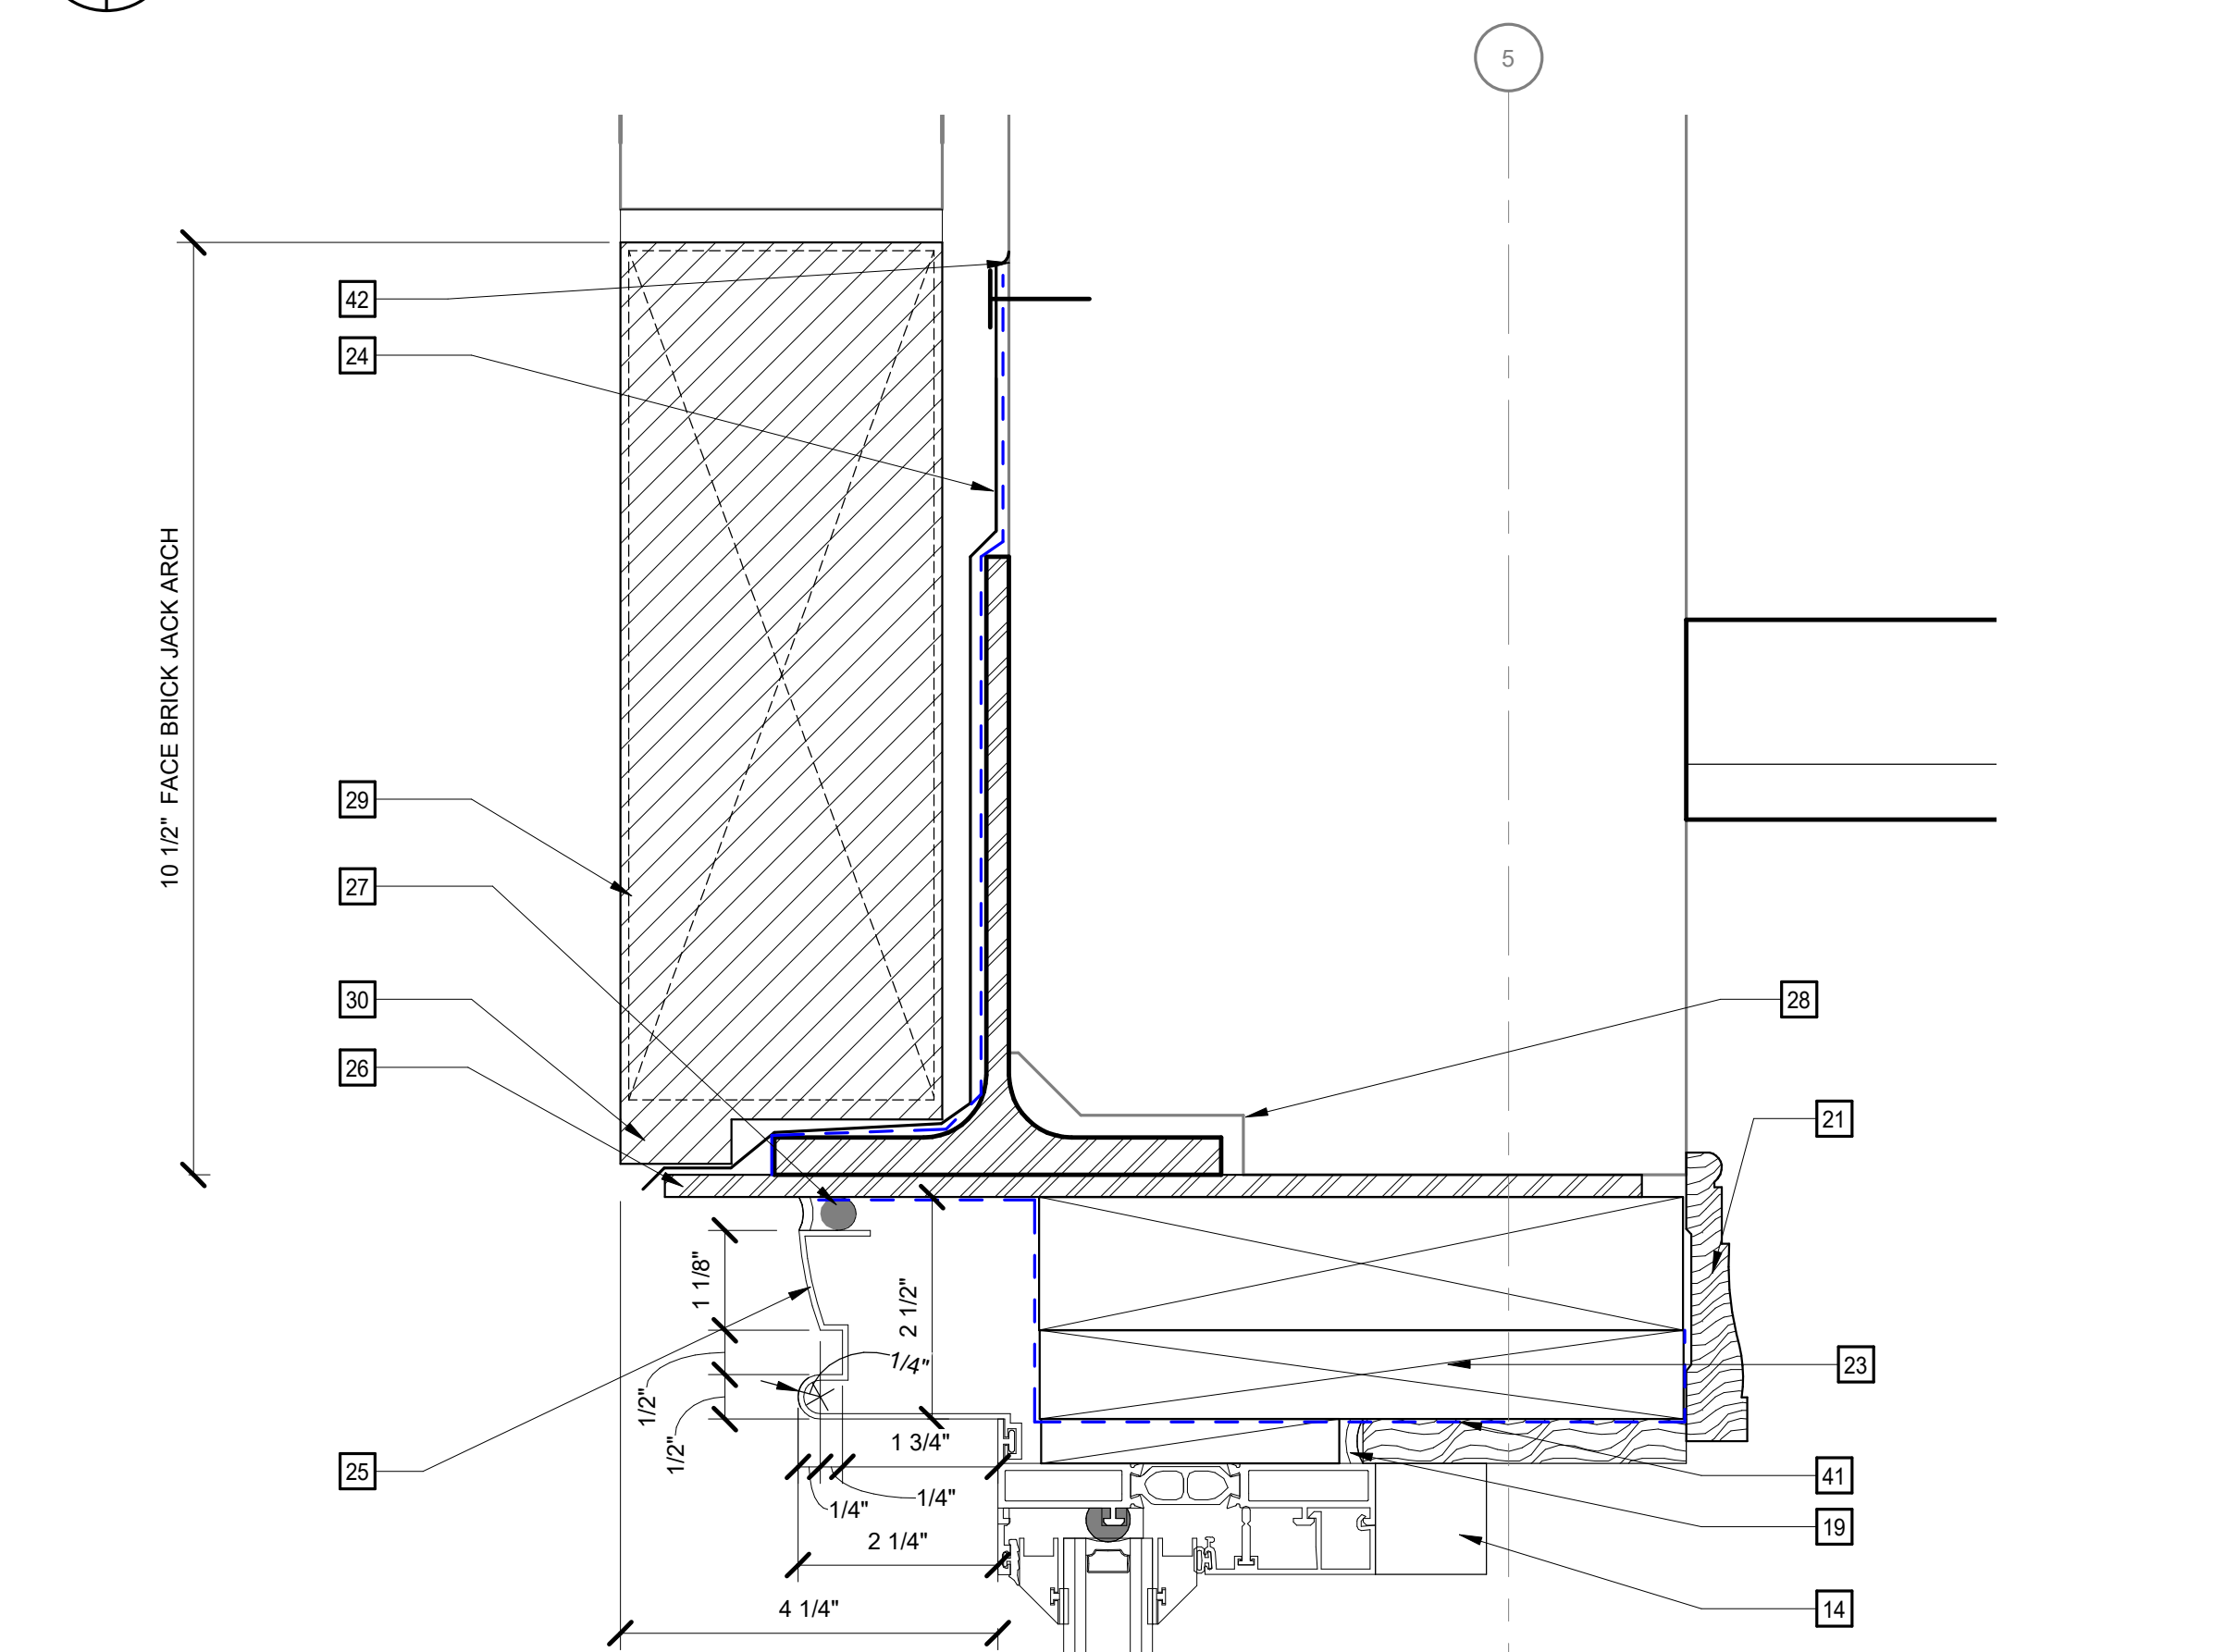


8 ALTERNATE #4 HEAD DETAIL
A3.1.1 A3.2.1 6" = 1'-0"

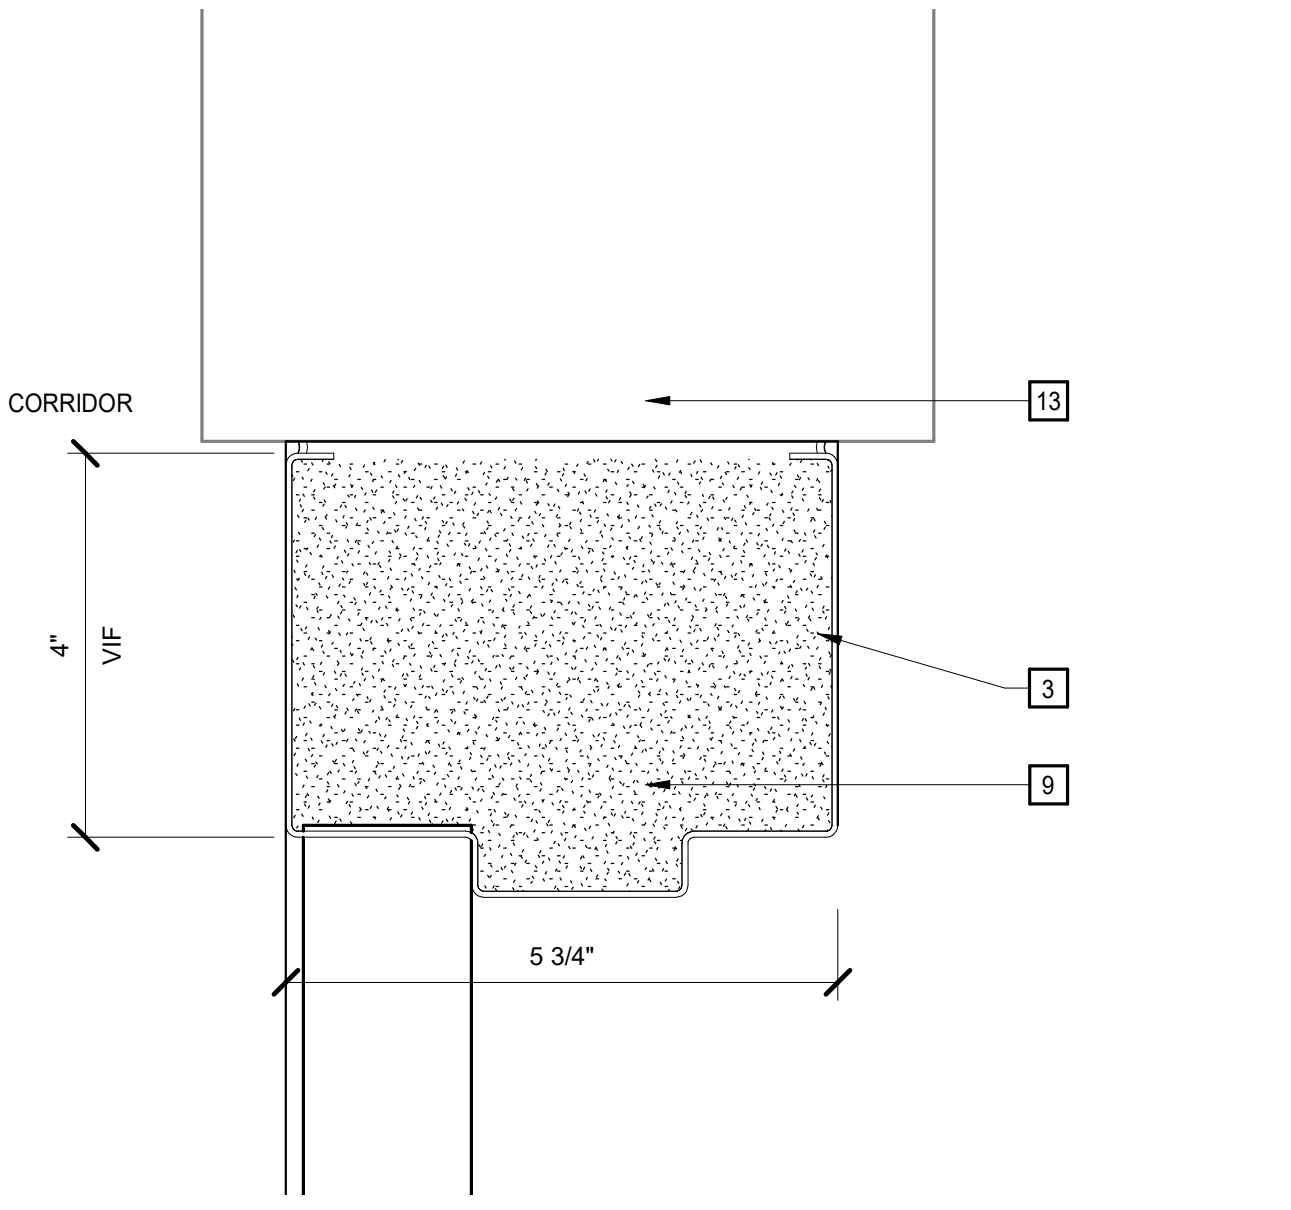


5 HEAD/JAMB DETAIL
A3.1.1 A3.2.1 6" = 1'-0"

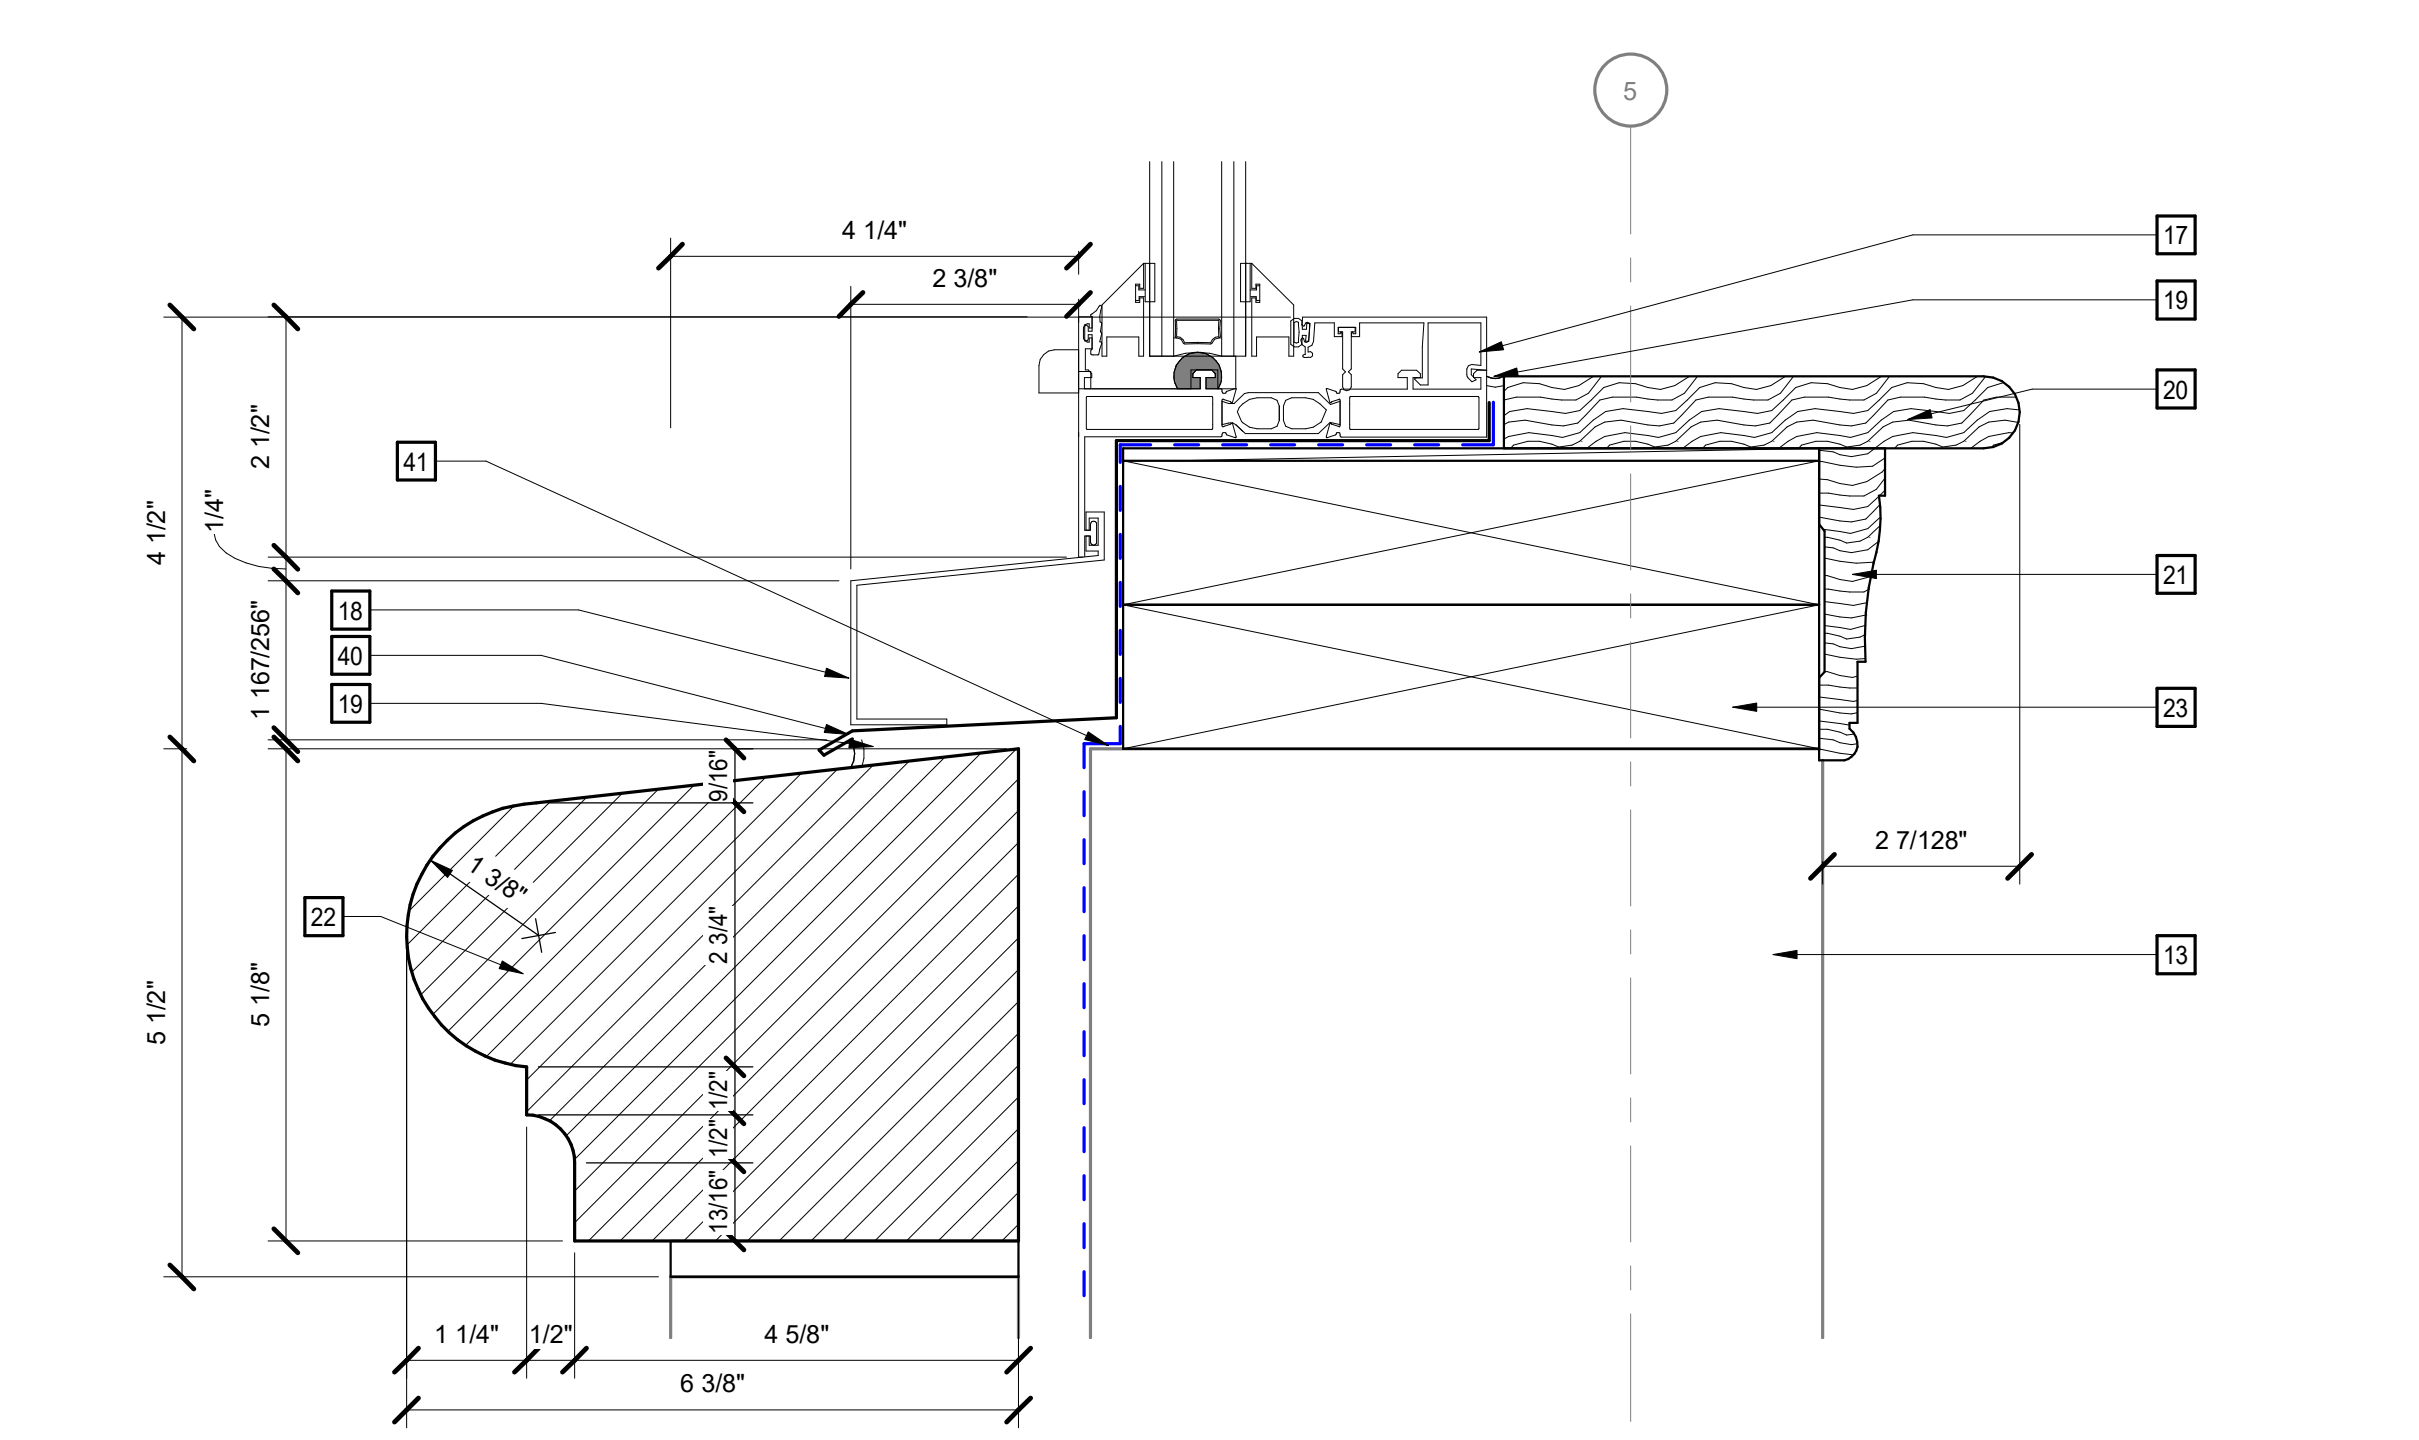


7 ALTERNATE #4 SILL
A3.1.1 A3.2.1 6" = 1'-0"

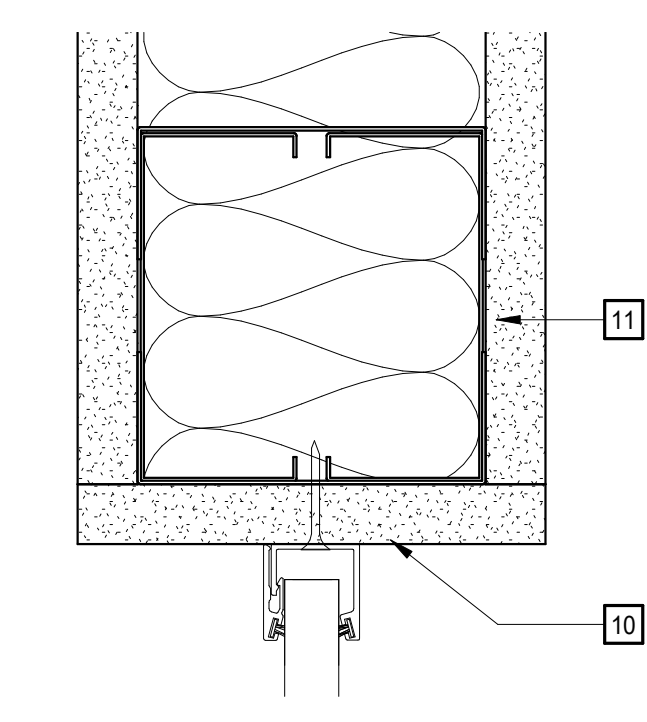


4 HEAD/JAMB DETAIL
A3.1.1 A3.2.1 6" = 1'-0"

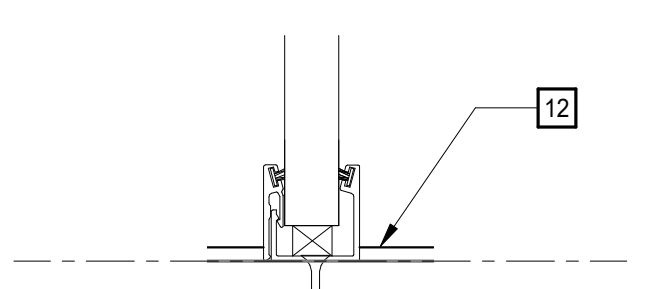


3 SILL DETAIL
A3.1.1 A3.2.1 6" = 1'-0"

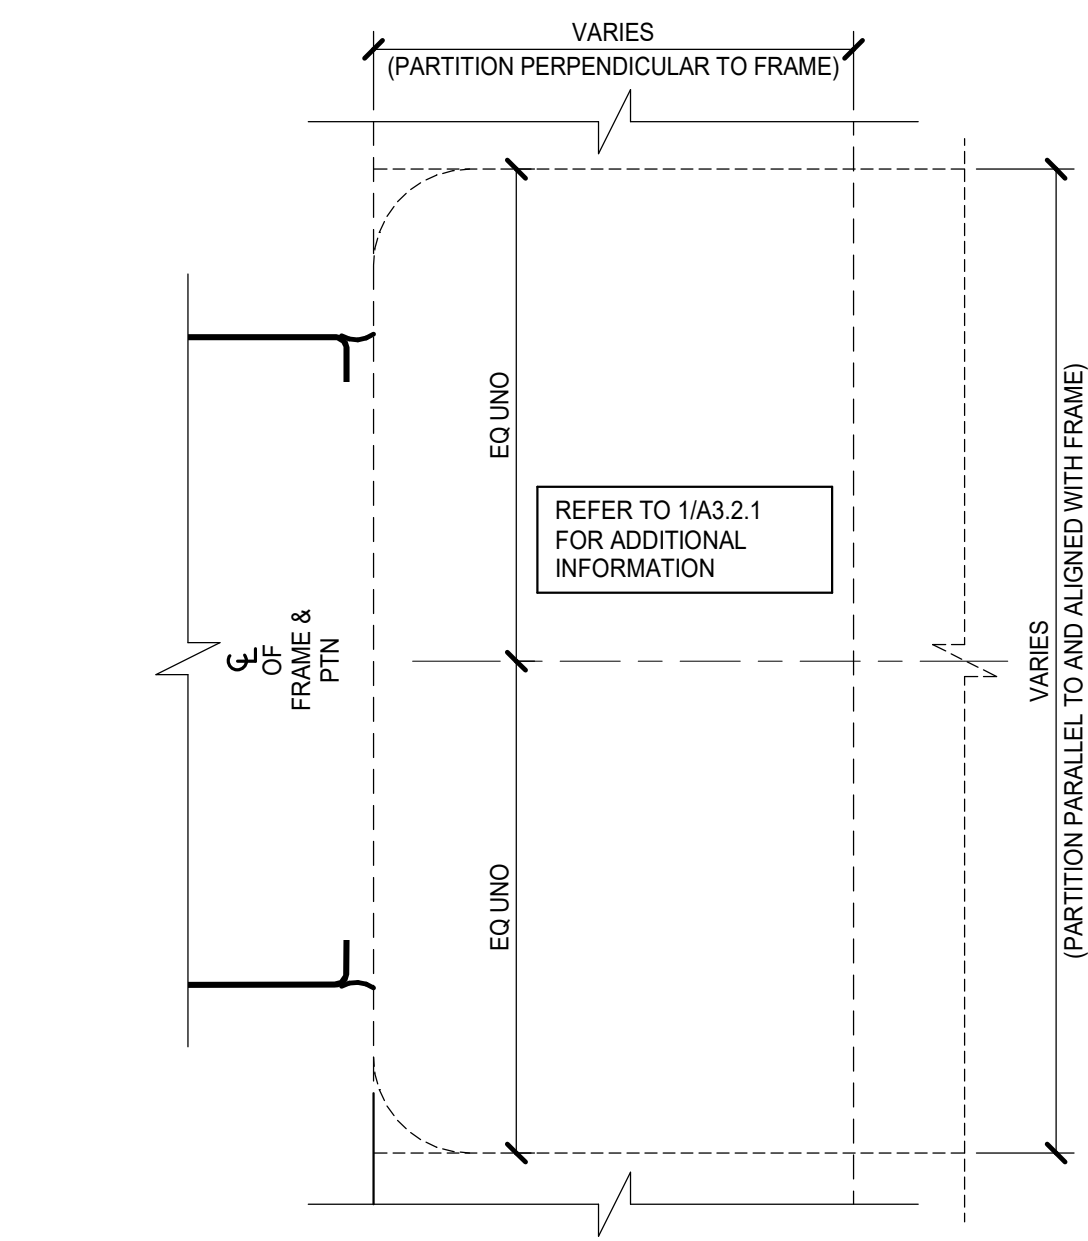



2 INTERIOR BETWEEN THE JAMB - BUTTED HEAD/JAMB/SILL
A3.2.1 6" = 1'-0"

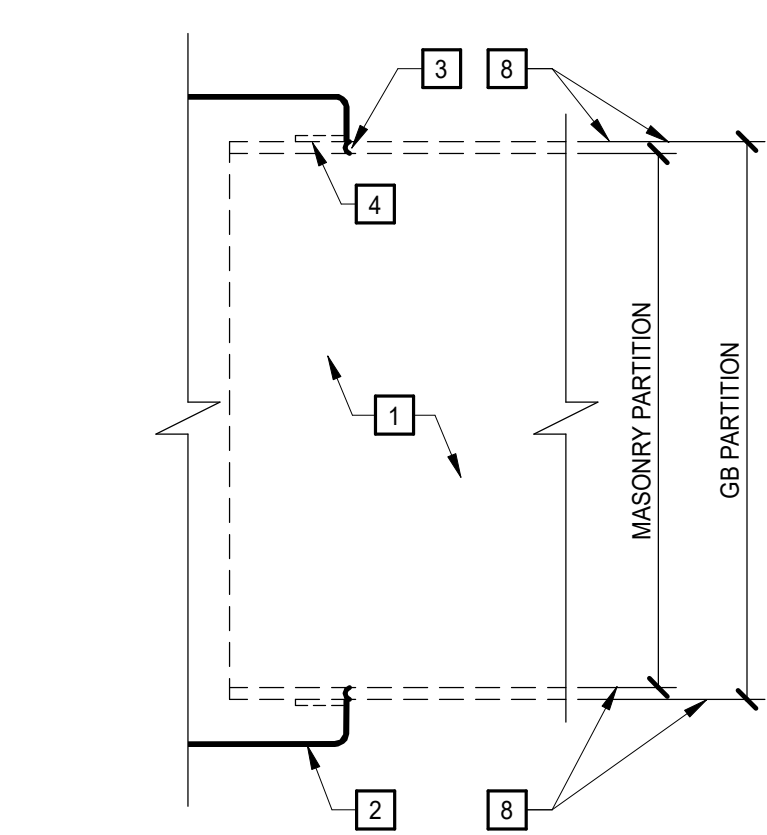

1 INTERIOR WRAP HEAD/JAMB/SILL
A3.2.1 6" = 1'-0"

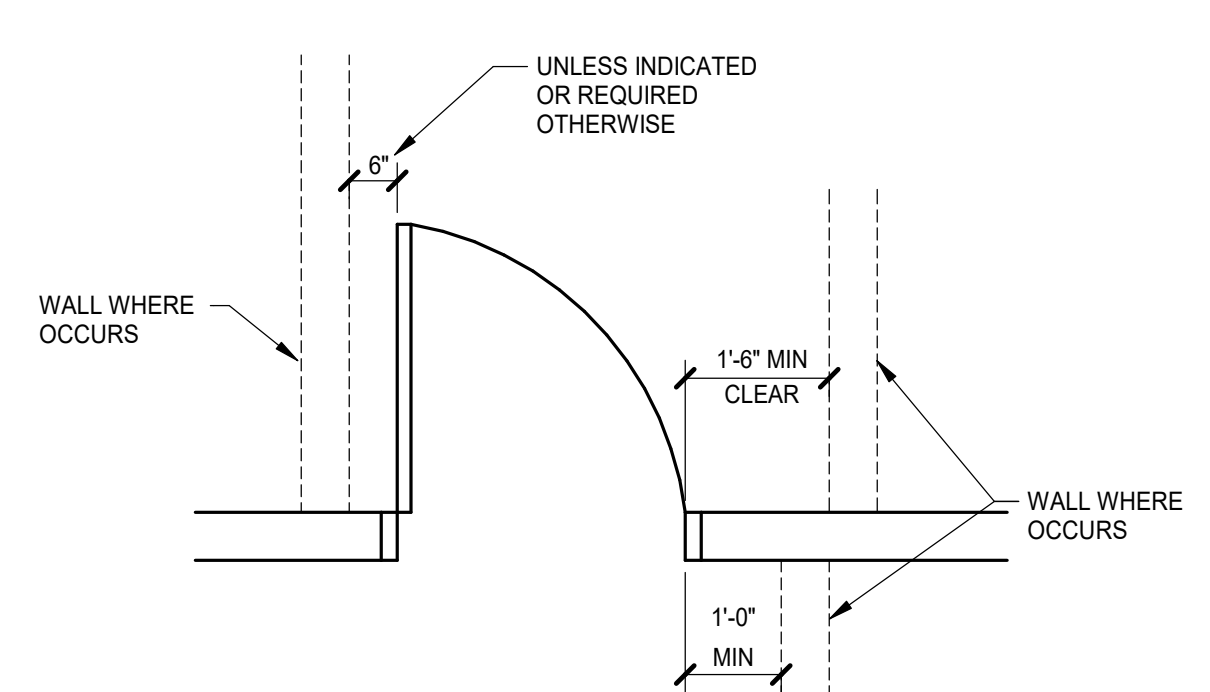


MANEUVERING CLEARANCE AT DOORS

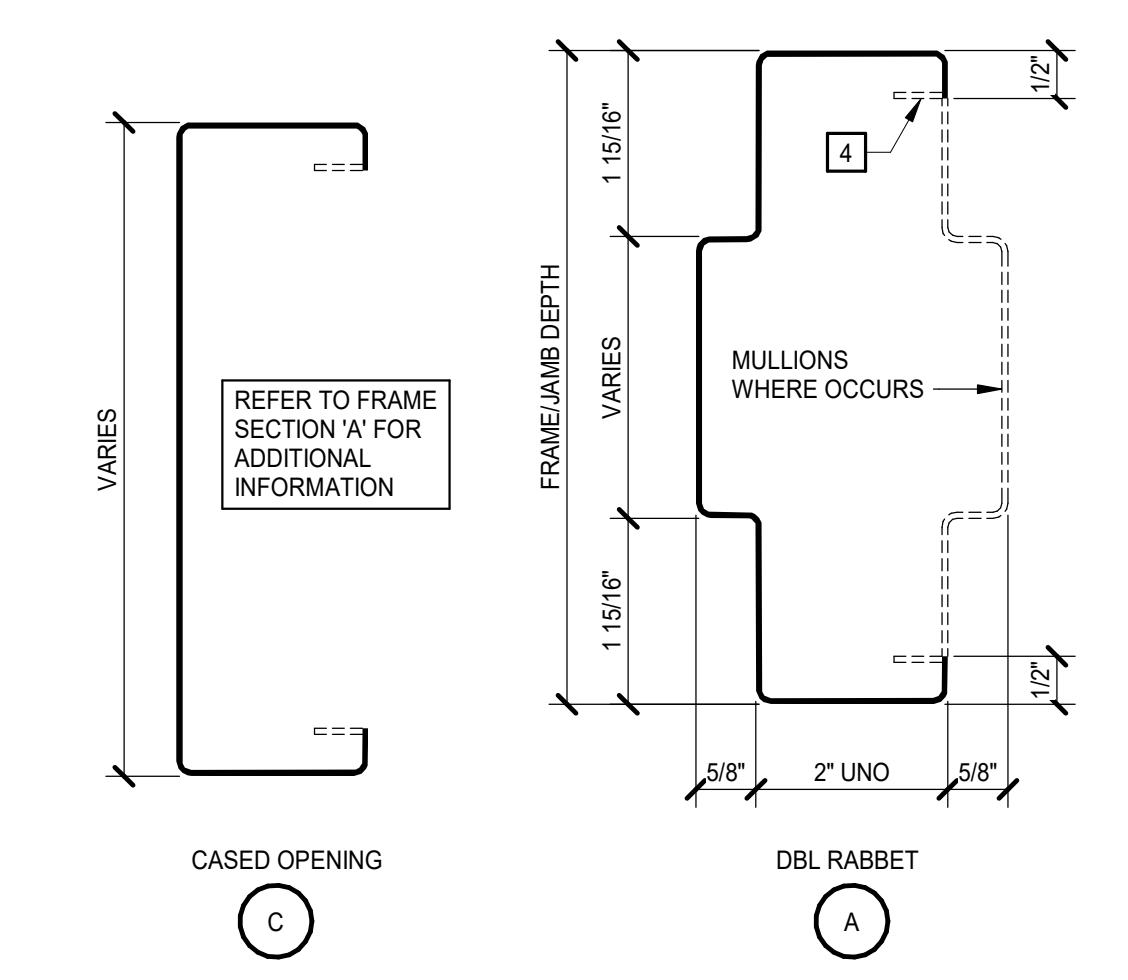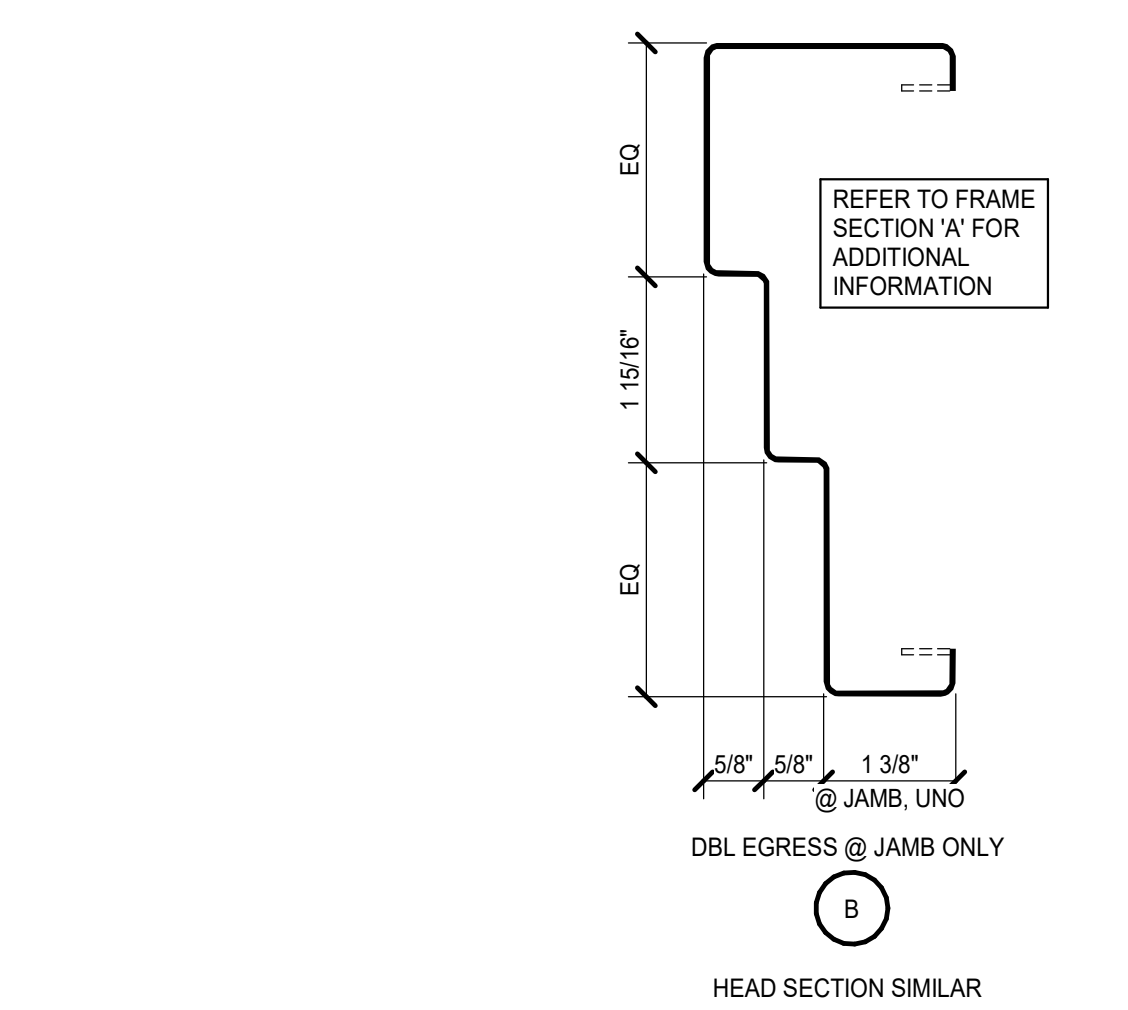

STEEL FRAME SECTIONS

1. ALL FRAME/JAMB DEPTHS, OTHER THAN WRAP CONDITIONS, SHALL BE 5 3/4" UNO.
2. ALL FRAME/JAMB DEPTHS AT WRAP CONDITIONS SHALL BE SIZED TO SUIT PARTITION.
3. DOORS, PANELS, GLAZING, STOPS, AND OTHER FRAME INFILLS ARE NOT SHOWN IN FRAME SECTIONS AS THEY VARY - PROVIDE SAME WHERE INDICATED.

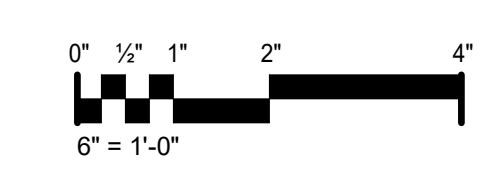

Project: UNCW King Hall Renovations

Bid Package: BP09A – Drywall, Metal Studs, Insulation, FRP

Bidder: _____

NC License # (if applicable) _____

Date: _____

Bid Time: _____

The undersigned, as bidder, hereby declares that the only person or persons interested in this proposal as principal or principals is or are named herein and that no other person than herein mentioned has any interest in this proposal or in the contract to be entered into; that this proposal is made without connection with any other person, company or parties making a bid or proposal; and that it is in all respects fair and in good faith without collusion or fraud. The bidder further declares that he has examined the site of the work and the contract documents relative thereto, and has read all special provisions furnished prior to the opening of bids; that he has satisfied himself relative to the work to be performed. The bidder further declares that he and his subcontractors have fully complied with NCGS 64, Article 2 in regards to E-Verification as required by Section 2.(c) of Session Law 2013-418, codified as N.C. Gen. Stat. § 143-129(j).

BID PACKAGE(s): BP09A – Drywall, Metal Studs, Insulation, FRP

Base Bid:

_____ Dollars (\$)

ALLOWANCES (included in base bid)

1. None

ALTERNATES

Should any of the alternates as described in the contract documents be accepted, the amount written below shall be the amount to be "added to" or "deducted from" the base bid. (Strike out "Add" or "Deduct" as appropriate.)

1. Alternate No. 1 – Replace existing windows and window shades
_____ Dollars (\$) (Add/Deduct)
2. Alternate No. 4 – Provide 2 new exterior windows at Room 201A
_____ Dollars (\$) (Add/Deduct)
3. Alternate No. 6 – Replace hollow metal frames @ doors S100, S101.2, S200, and S201
_____ Dollars (\$) (Add/Deduct)
4. Alternate No. 8 – Reconfigure and update men's toilet room
_____ Dollars (\$) (Add/Deduct)
5. Voluntary Alternate No. V1 – Add Scope of work from BP09C – Acoustic Ceilings
_____ Dollars (\$) (Add/Deduct)

UNIT PRICES (not included in base bid)

Unit prices quoted and accepted shall apply throughout the life of the contract, except as otherwise specifically noted. Unit prices shall be applied, as appropriate, to compute the total value of changes in the base bid quantity of the work all in accordance with the contract documents.

1. None

MINORITY BUSINESS PARTICIPATION REQUIREMENTS

Provide with the bid - Under GS 143-128.2(c) the undersigned bidder shall identify on its bid (Identification of Minority Business Participation Form) the minority businesses that it will use on the project with the total dollar value of the bids that will be performed by the minority businesses. Also list the good faith efforts (Affidavit A) made to solicit minority participation in the bid effort.

NOTE: A contractor that performs all of the work with its own workforce may submit an Affidavit (B) to that effect in lieu of Affidavit (A) required above. The MB Participation Form must still be submitted even if there is zero participation.

After the bid opening - The Owner will consider all bids and alternates and determine the lowest responsible, responsive bidder. Upon notification of being the apparent low bidder, the bidder shall then file within 72 hours of the notification of being the apparent lowest bidder, the following:

An Affidavit (C) that includes a description of the portion of work to be executed by minority businesses, expressed as a percentage of the total contract price, which is equal to or more than the 10% goal established. This affidavit shall give rise to the presumption that the bidder has made the required good faith effort and Affidavit D is not necessary;

* OR *

If less than the 10% goal, Affidavit (D) of its good faith effort to meet the goal shall be provided. The document must include evidence of all good faith efforts that were implemented, including any advertisements, solicitations and other specific actions demonstrating recruitment and selection of minority businesses for participation in the contract.

Note: Bidders must always submit with their bid the Identification of Minority Business Participation Form listing all MB contractors, vendors and suppliers that will be used. If there is no MB participation, then enter none or zero on the form. Affidavit A or Affidavit B, as applicable, also must be submitted with the bid. Failure to file a required affidavit or documentation with the bid or after being notified apparent low bidder is grounds for rejection of the bid.

PROPOSAL SIGNATURE PAGE

The undersigned further agrees that in the case of failure on his part to execute the said contract and the bonds within ten (10) consecutive calendar days after being given written notice of the award of contract, the certified check, cash or bid bond accompanying this bid shall be paid into the funds of the owner's account set aside for the project, as liquidated damages for such failure; otherwise the certified check, cash or bid bond accompanying this proposal shall be returned to the undersigned.

Respectfully submitted this day of _____

(Name of firm or corporation making bid)

WITNESS:

(Proprietorship or Partnership)

By: _____
Signature

Name: _____
Print or type

Title _____
(Owner/Partner/Pres./V.Pres)

Address _____

ATTEST:

By: _____

License No. _____

Title: _____
(Corp. Sec. or Asst. Sec. only)

Federal I.D. No. _____

Email Address: _____

(CORPORATE SEAL)

Addendum received and used in computing bid:

Addendum No. 1 _____ Addendum No. 3 _____ Addendum No. 5 _____ Addendum No. 7 _____

Addendum No. 2 _____ Addendum No. 4 _____ Addendum No. 6 _____ Addendum No. 8 _____

Project: UNCW King Hall Renovations

Bid Package: BP09E – Painting and Wall Coverings

Bidder: _____

NC License # (if applicable) _____

Date: _____

Bid Time: _____

The undersigned, as bidder, hereby declares that the only person or persons interested in this proposal as principal or principals is or are named herein and that no other person than herein mentioned has any interest in this proposal or in the contract to be entered into; that this proposal is made without connection with any other person, company or parties making a bid or proposal; and that it is in all respects fair and in good faith without collusion or fraud. The bidder further declares that he has examined the site of the work and the contract documents relative thereto, and has read all special provisions furnished prior to the opening of bids; that he has satisfied himself relative to the work to be performed. The bidder further declares that he and his subcontractors have fully complied with NCGS 64, Article 2 in regards to E-Verification as required by Section 2.(c) of Session Law 2013-418, codified as N.C. Gen. Stat. § 143-129(j).

BID PACKAGE(s): BP09E – Painting and Wall Coverings

Base Bid:

_____ Dollars (\$)

ALLOWANCES (included in base bid)

1. Include \$2,500 for paint and repairs at window in room "Stair 201" _____(initial)

ALTERNATES

Should any of the alternates as described in the contract documents be accepted, the amount written below shall be the amount to be "added to" or "deducted from" the base bid. (Strike out "Add" or "Deduct" as appropriate.)

1. Alternate No. 1 – Replace existing windows and window shades
_____ Dollars (\$) (Add/Deduct)
2. Alternate No. 3 – Provide carpet, paint, and base in first floor offices
_____ Dollars (\$) (Add/Deduct)
3. Alternate No. 3A – Provide carpet, paint and base in first floor Classroom 104
_____ Dollars (\$) (Add/Deduct)
4. Alternate No. 4 – Provide 2 new exterior windows at Room 201A
_____ Dollars (\$) (Add/Deduct)
5. Alternate No. 5 – Scrape and paint exterior trim
_____ Dollars (\$) (Add/Deduct)
6. Alternate No. 6 – Replace hollow metal frames (painting)
_____ Dollars (\$) (Add/Deduct)
7. Alternate No. 8 – Reconfigure and update men's toilet room
_____ Dollars (\$) (Add/Deduct)

UNIT PRICES (not included in base bid)

Unit prices quoted and accepted shall apply throughout the life of the contract, except as otherwise specifically noted. Unit prices shall be applied, as appropriate, to compute the total value of changes in the base bid quantity of the work all in accordance with the contract documents.

1. None

MINORITY BUSINESS PARTICIPATION REQUIREMENTS

Provide with the bid - Under GS 143-128.2(c) the undersigned bidder shall identify on its bid (Identification of Minority Business Participation Form) the minority businesses that it will use on the project with the total dollar value of the bids that will be performed by the minority businesses. Also list the good faith efforts (Affidavit A) made to solicit minority participation in the bid effort.

NOTE: A contractor that performs all of the work with its own workforce may submit an Affidavit (B) to that effect in lieu of Affidavit (A) required above. The MB Participation Form must still be submitted even if there is zero participation.

After the bid opening - The Owner will consider all bids and alternates and determine the lowest responsible, responsive bidder. Upon notification of being the apparent low bidder, the bidder shall then file within 72 hours of the notification of being the apparent lowest bidder, the following:

An Affidavit (C) that includes a description of the portion of work to be executed by minority businesses, expressed as a percentage of the total contract price, which is equal to or more than the 10% goal established. This affidavit shall give rise to the presumption that the bidder has made the required good faith effort and Affidavit D is not necessary;

* OR *

If less than the 10% goal, Affidavit (D) of its good faith effort to meet the goal shall be provided. The document must include evidence of all good faith efforts that were implemented, including any advertisements, solicitations and other specific actions demonstrating recruitment and selection of minority businesses for participation in the contract.

Note: Bidders must always submit with their bid the Identification of Minority Business Participation Form listing all MB contractors, vendors and suppliers that will be used. If there is no MB participation, then enter none or zero on the form. Affidavit A or Affidavit B, as applicable, also must be submitted with the bid. Failure to file a required affidavit or documentation with the bid or after being notified apparent low bidder is grounds for rejection of the bid.

PROPOSAL SIGNATURE PAGE

The undersigned further agrees that in the case of failure on his part to execute the said contract and the bonds within ten (10) consecutive calendar days after being given written notice of the award of contract, the certified check, cash or bid bond accompanying this bid shall be paid into the funds of the owner's account set aside for the project, as liquidated damages for such failure; otherwise the certified check, cash or bid bond accompanying this proposal shall be returned to the undersigned.

Respectfully submitted this day of _____

(Name of firm or corporation making bid)

WITNESS:

(Proprietorship or Partnership)

By: _____

Signature

Name: _____

Print or type

Title _____

(Owner/Partner/Pres./V.Pres)

Address _____

ATTEST:

By: _____

License No. _____

Title: _____

Federal I.D. No. _____

(Corp. Sec. or Asst. Sec. only)

Email Address: _____

(CORPORATE SEAL)

Addendum received and used in computing bid:

Addendum No. 1 _____ Addendum No. 3 _____ Addendum No. 5 _____ Addendum No. 7 _____
Addendum No. 2 _____ Addendum No. 4 _____ Addendum No. 6 _____ Addendum No. 8 _____

Project: UNCW King Hall Renovations

Bid Package: BP23 – HVAC Installation

Bidder: _____

NC License # (if applicable) _____

Date: _____

Bid Time: _____

The undersigned, as bidder, hereby declares that the only person or persons interested in this proposal as principal or principals is or are named herein and that no other person than herein mentioned has any interest in this proposal or in the contract to be entered into; that this proposal is made without connection with any other person, company or parties making a bid or proposal; and that it is in all respects fair and in good faith without collusion or fraud. The bidder further declares that he has examined the site of the work and the contract documents relative thereto, and has read all special provisions furnished prior to the opening of bids; that he has satisfied himself relative to the work to be performed. The bidder further declares that he and his subcontractors have fully complied with NCGS 64, Article 2 in regards to E-Verification as required by Section 2.(c) of Session Law 2013-418, codified as N.C. Gen. Stat. § 143-129(j).

BID PACKAGE(s): BP23 – HVAC Installation

Base Bid:

_____ Dollars (\$)

ALLOWANCES (included in base bid)

1. Include \$9,000 for AHU storage fees _____(initial)
2. Include \$5,000 for extended warranty _____(initial)

ALTERNATES

Should any of the alternates as described in the contract documents be accepted, the amount written below shall be the amount to be "added to" or "deducted from" the base bid. (Strike out "Add" or "Deduct" as appropriate.)

1. Alternate No. 8 – Reconfigure and update men's toilet room
_____ Dollars (\$) (Add/Deduct)
2. Owner Preferred Alternate No. 11 – Building Automation Controller and Flow Meter
_____ Dollars (\$) (Add/Deduct)
3. Owner Preferred Alternate No. 14 – Fire Alarm System (duct detector work)
_____ Dollars (\$) (Add/Deduct)

UNIT PRICES (not included in base bid)

Unit prices quoted and accepted shall apply throughout the life of the contract, except as otherwise specifically noted. Unit prices shall be applied, as appropriate, to compute the total value of changes in the base bid quantity of the work all in accordance with the contract documents.

1. None

MINORITY BUSINESS PARTICIPATION REQUIREMENTS

Provide with the bid - Under GS 143-128.2(c) the undersigned bidder shall identify on its bid (Identification of Minority Business Participation Form) the minority businesses that it will use on the project with the total dollar value of the bids that will be performed by the minority businesses. Also list the good faith efforts (Affidavit A) made to solicit minority participation in the bid effort.

NOTE: A contractor that performs all of the work with its own workforce may submit an Affidavit (B) to that effect in lieu of Affidavit (A) required above. The MB Participation Form must still be submitted even if there is zero participation.

After the bid opening - The Owner will consider all bids and alternates and determine the lowest responsible, responsive bidder. Upon notification of being the apparent low bidder, the bidder shall then file within 72 hours of the notification of being the apparent lowest bidder, the following:

An Affidavit (C) that includes a description of the portion of work to be executed by minority businesses, expressed as a percentage of the total contract price, which is equal to or more than the 10% goal established. This affidavit shall give rise to the presumption that the bidder has made the required good faith effort and Affidavit D is not necessary;

* OR *

If less than the 10% goal, Affidavit (D) of its good faith effort to meet the goal shall be provided. The document must include evidence of all good faith efforts that were implemented, including any advertisements, solicitations and other specific actions demonstrating recruitment and selection of minority businesses for participation in the contract.

Note: Bidders must always submit with their bid the Identification of Minority Business Participation Form listing all MB contractors, vendors and suppliers that will be used. If there is no MB participation, then enter none or zero on the form. Affidavit A or Affidavit B, as applicable, also must be submitted with the bid. Failure to file a required affidavit or documentation with the bid or after being notified apparent low bidder is grounds for rejection of the bid.

PROPOSAL SIGNATURE PAGE

The undersigned further agrees that in the case of failure on his part to execute the said contract and the bonds within ten (10) consecutive calendar days after being given written notice of the award of contract, the certified check, cash or bid bond accompanying this bid shall be paid into the funds of the owner's account set aside for the project, as liquidated damages for such failure; otherwise the certified check, cash or bid bond accompanying this proposal shall be returned to the undersigned.

Respectfully submitted this day of _____

(Name of firm or corporation making bid)

WITNESS:

(Proprietorship or Partnership)

By: _____

Signature

Name: _____

Print or type

Title _____

(Owner/Partner/Pres./V.Pres)

Address _____

ATTEST:

By: _____

License No. _____

Title: _____

Federal I.D. No. _____

(Corp. Sec. or Asst. Sec. only)

Email Address: _____

(CORPORATE SEAL)

Addendum received and used in computing bid:

Addendum No. 1 _____ Addendum No. 3 _____ Addendum No. 5 _____ Addendum No. 7 _____

Addendum No. 2 _____ Addendum No. 4 _____ Addendum No. 6 _____ Addendum No. 8 _____